


ENGINEERING COPY

MUNICIPAL NATURAL GAS SYSTEM
AS BUILT
CITY OF HARRIMAN, TENN.
OWNER

**BARNARD AND BURK
CONSULTING ENGINEERS
BATON ROUGE, LA.**

JULY, 1953

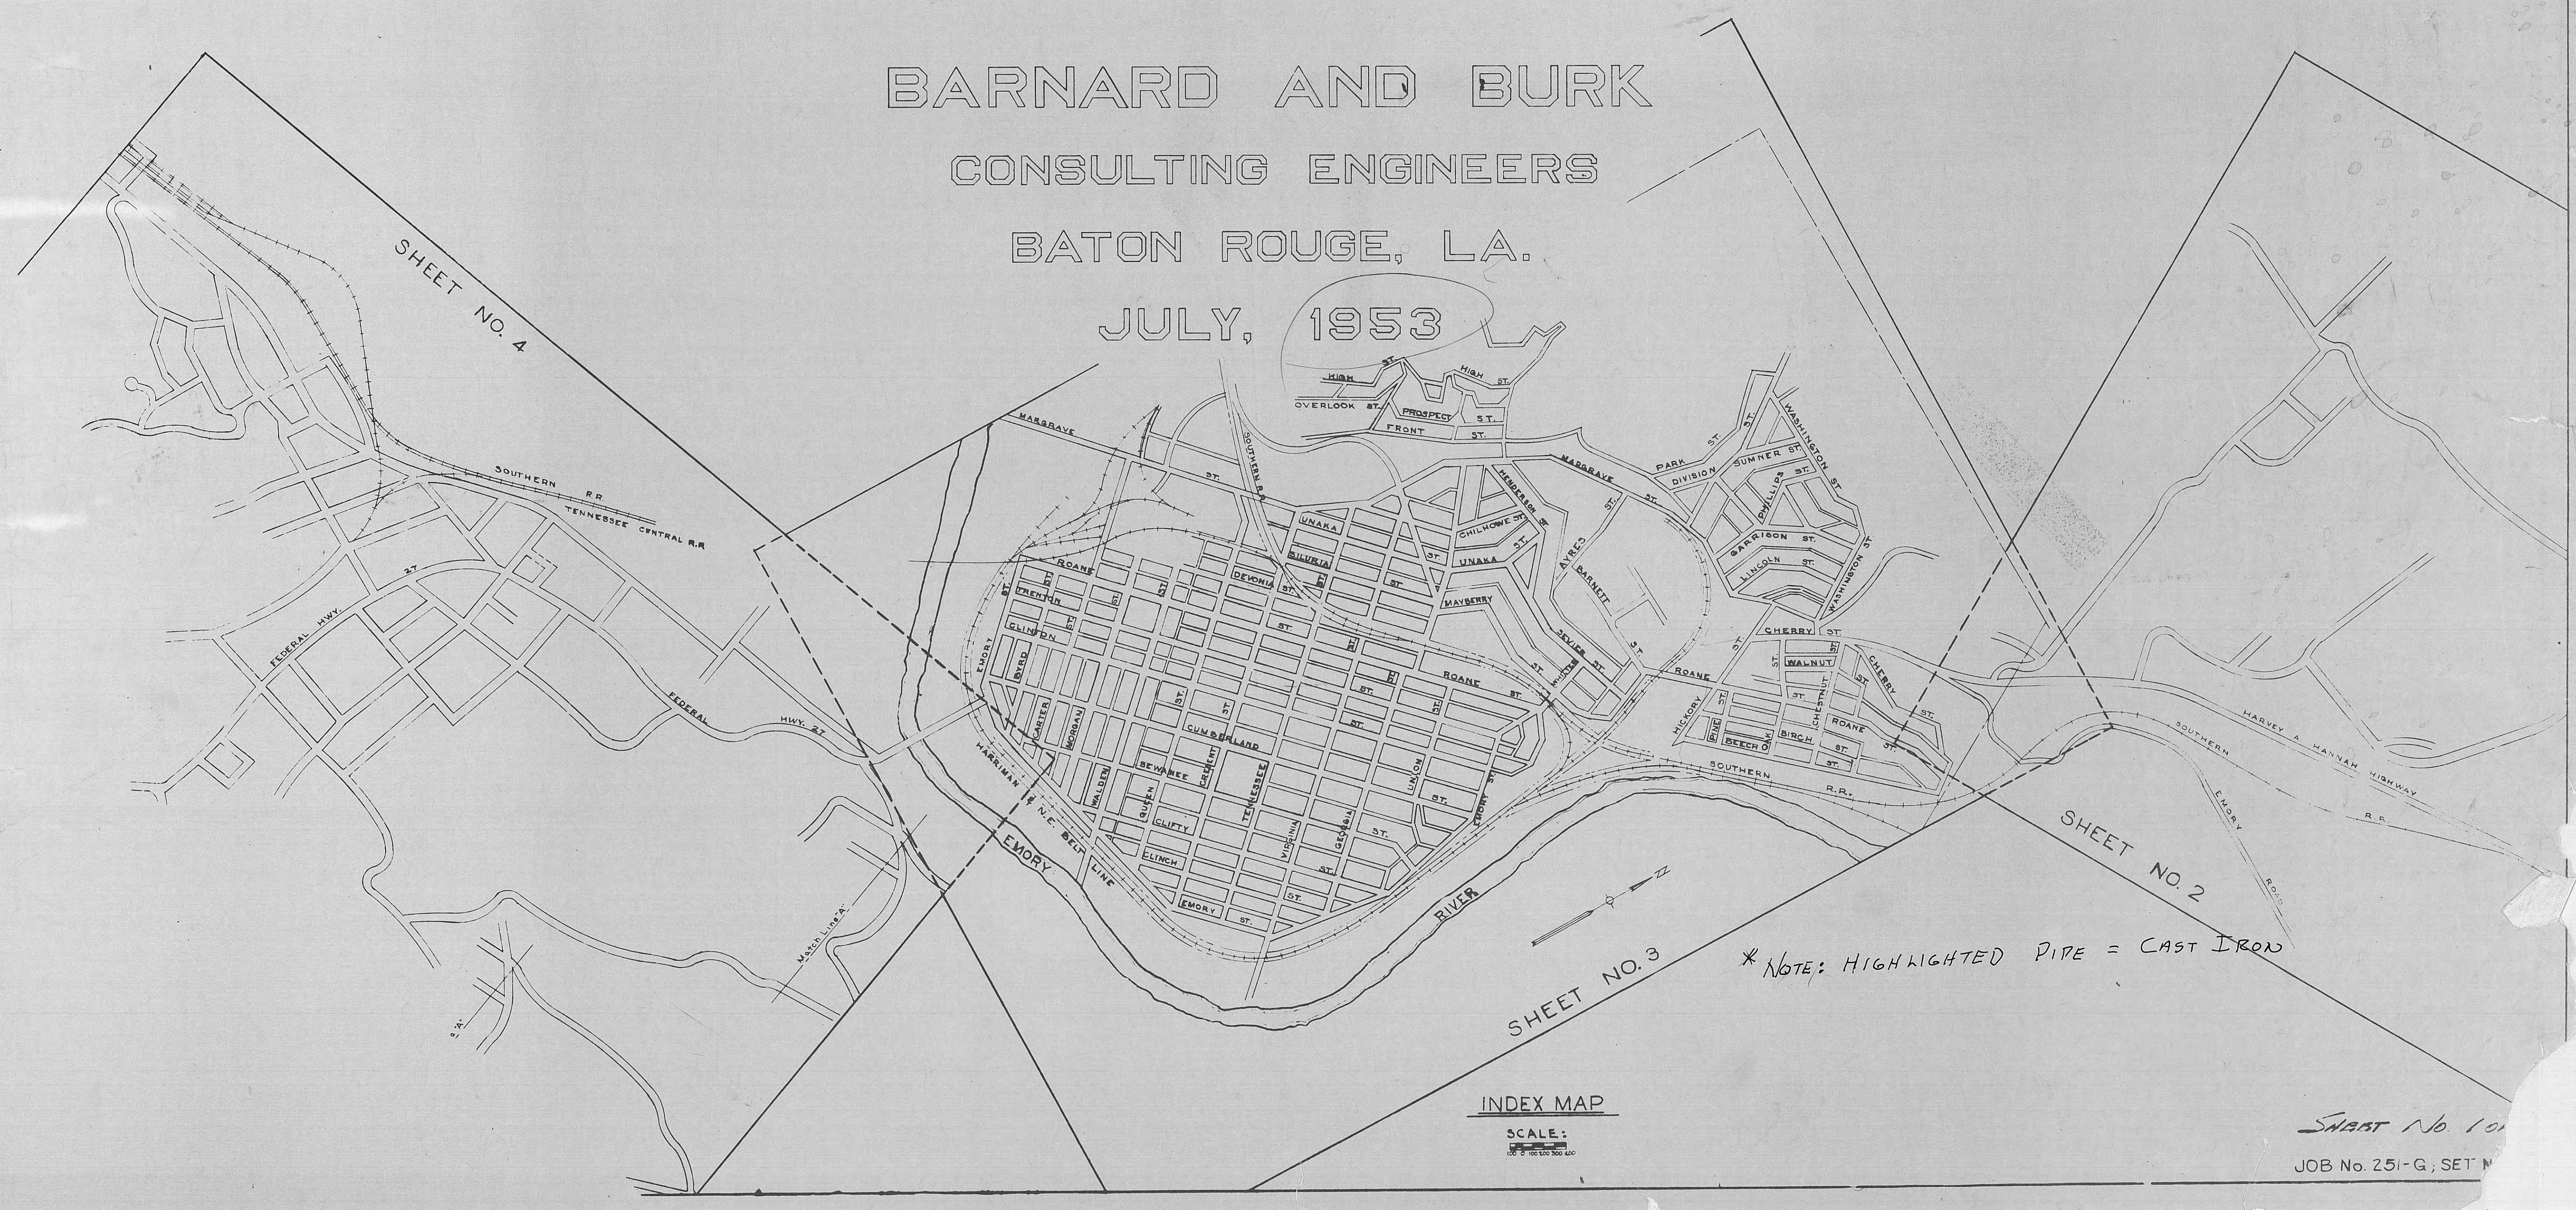




**MATCH LINE
SHEET NO. 9**


**ARNARD & BURK
CONSULTING ENGINEERS
223 NICHOLSON DRIVE
BATON ROUGE 2, LA.**

SHEET NO. 10 OF 35

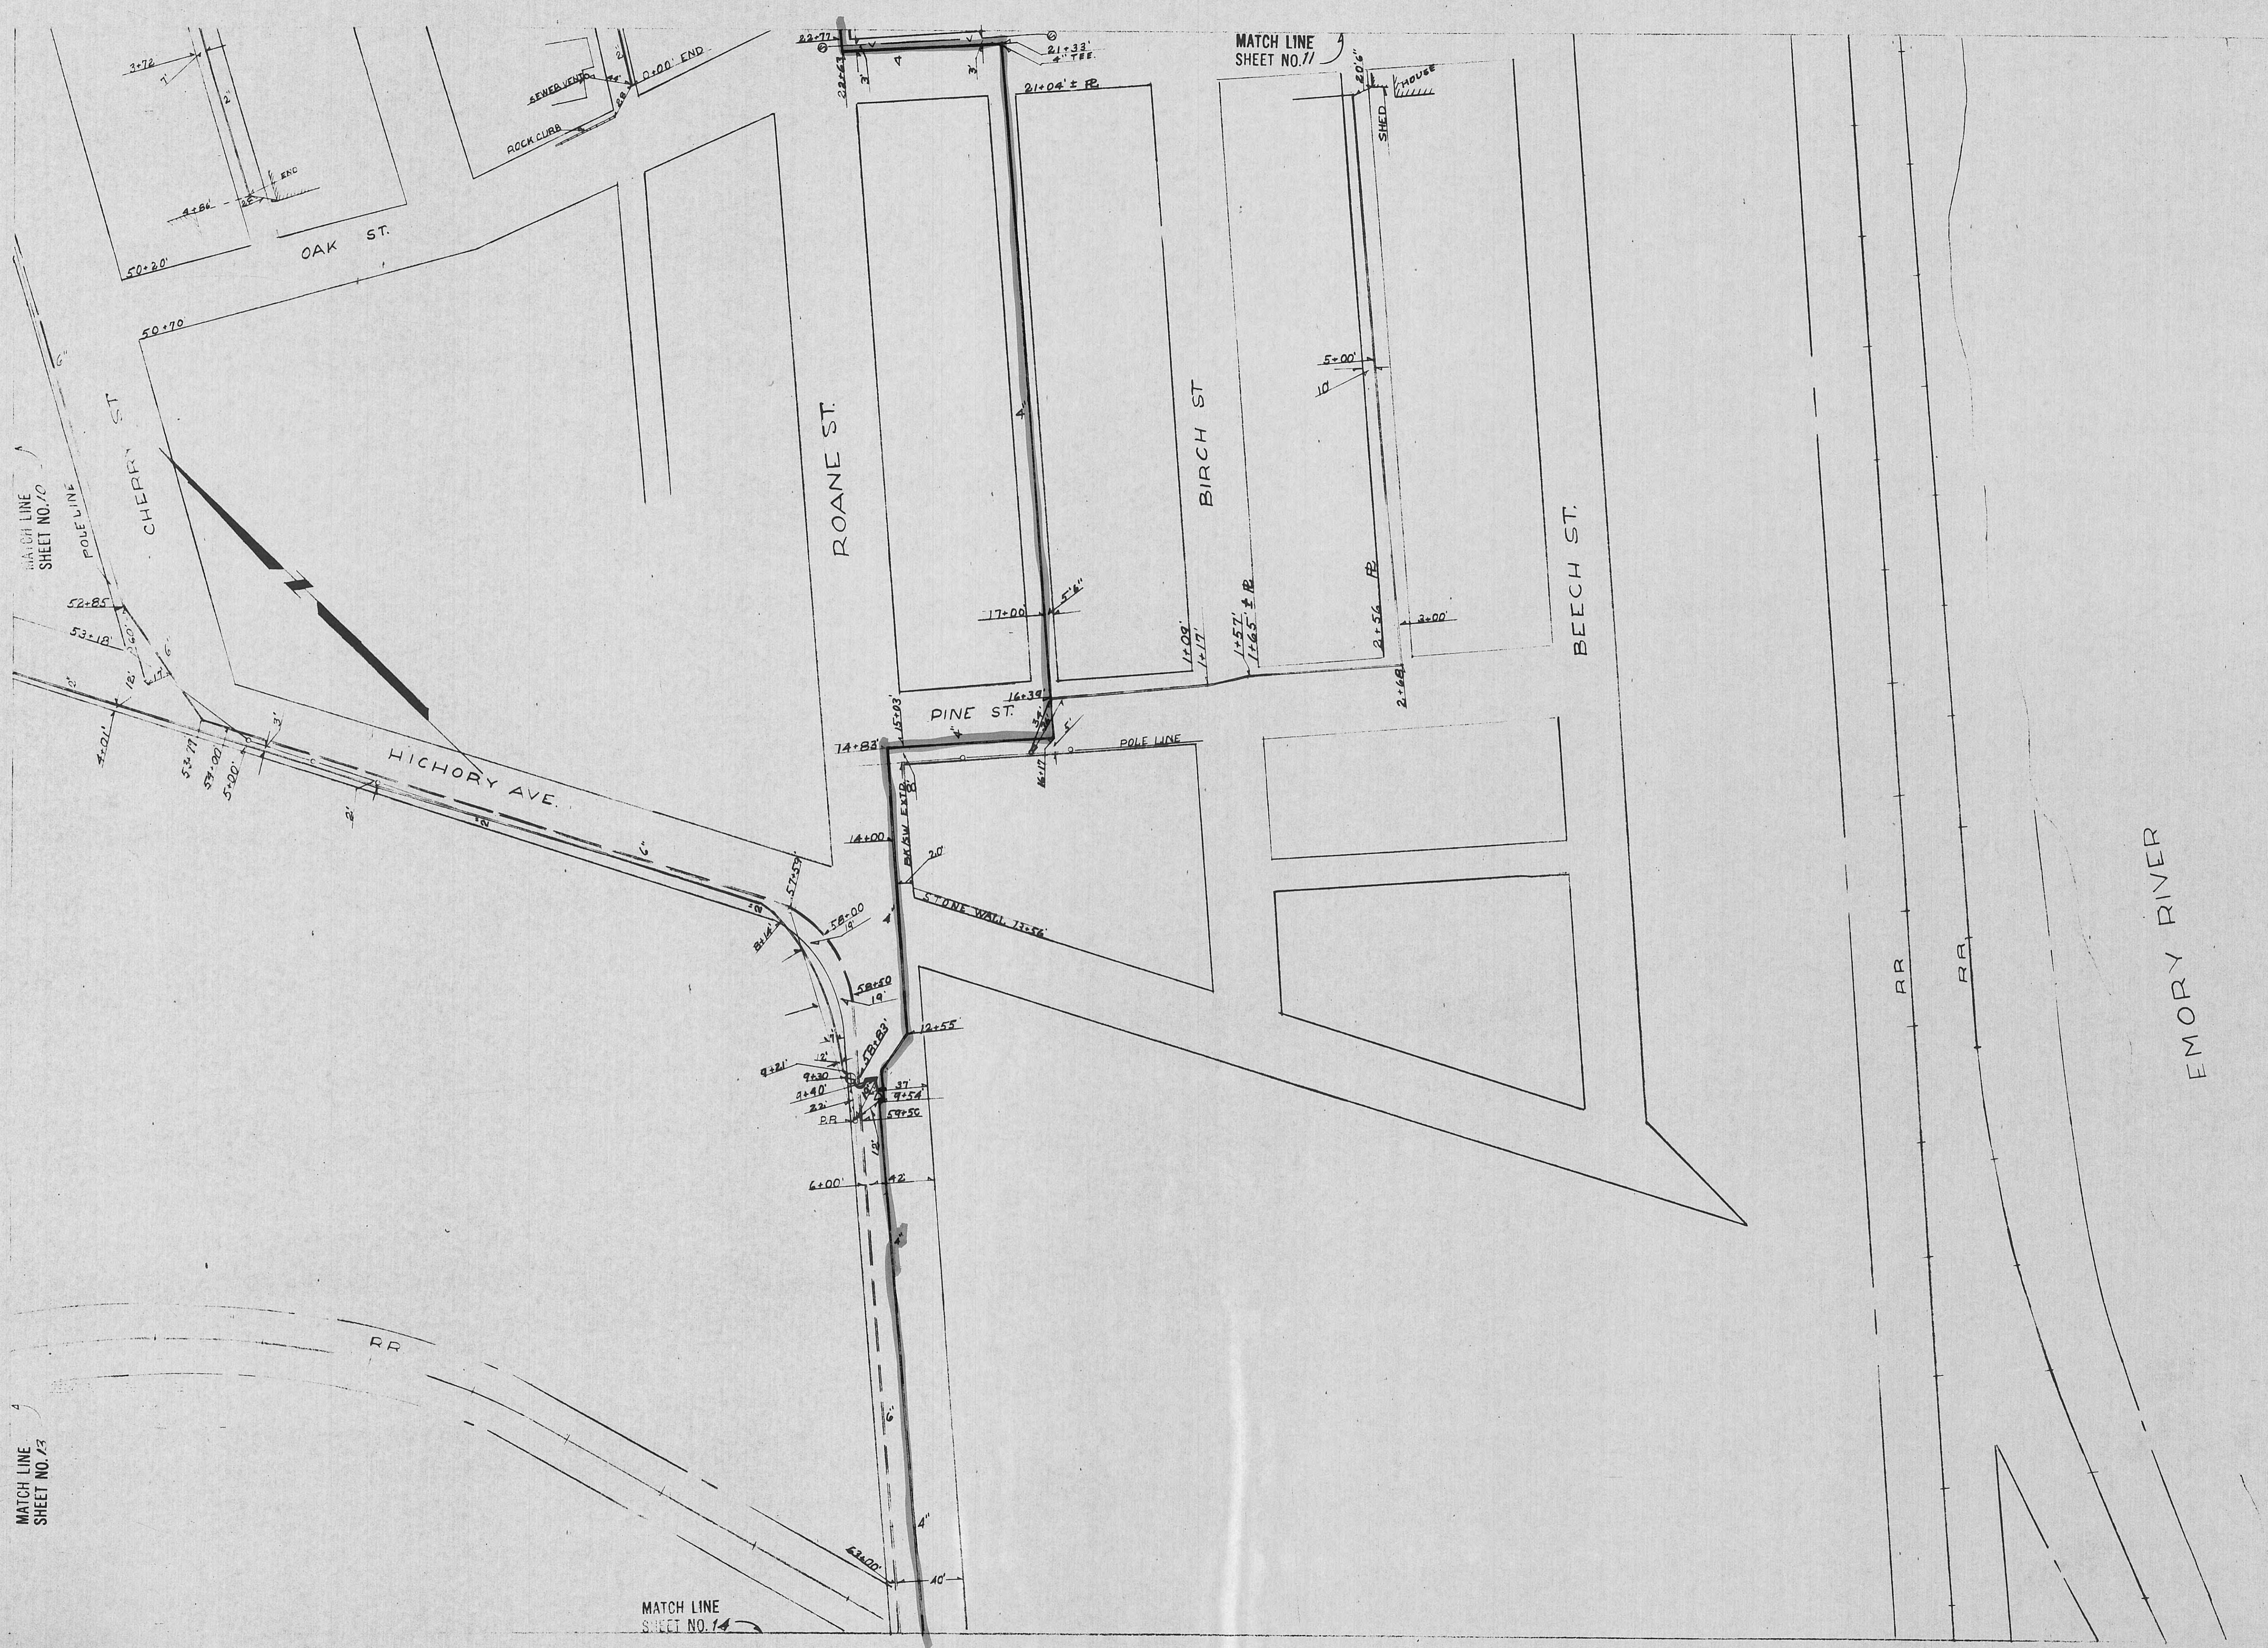

BARNARD & BURK
CONSULTING ENGINEERS
023 NICHOLSON DRIVE
BATON ROUGE 2, LA.

BATON ROUGE 2, LA.
SHEET NO. 12 OF 35

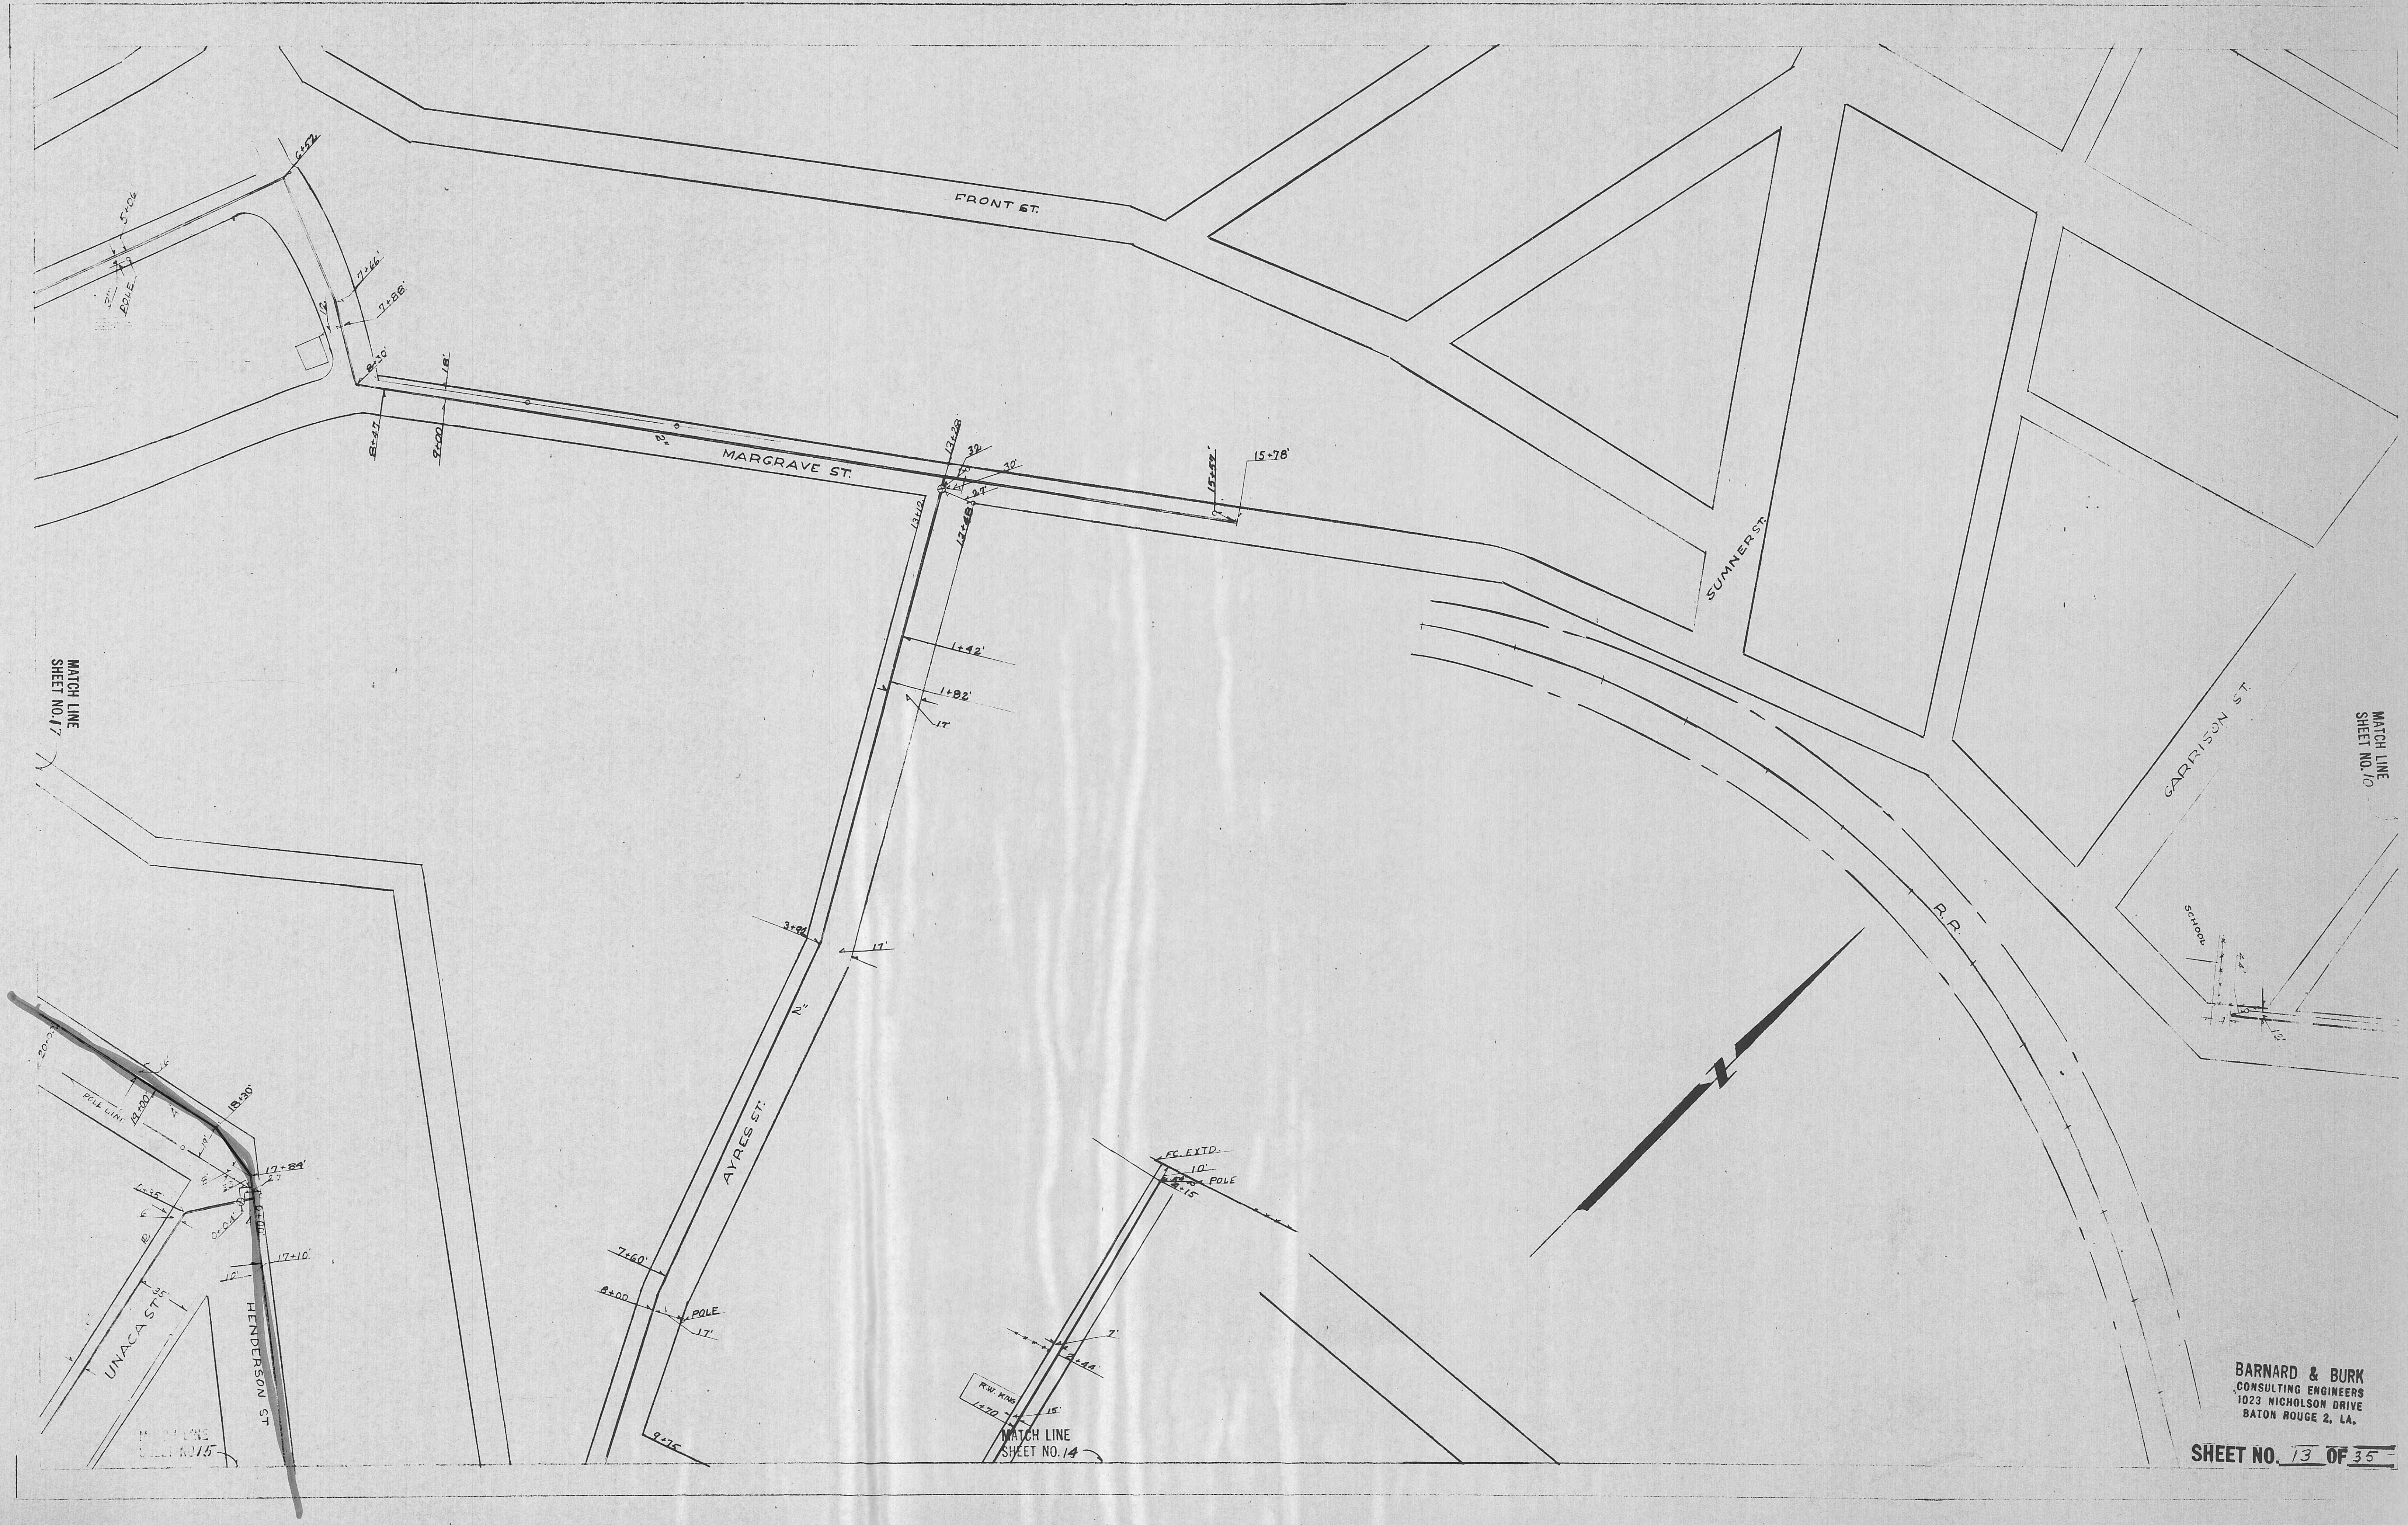

**MATCH LINE
SHEET NO. /0**





ARD & BURK
LTING ENGINEERS
NICHOLSON DRIVE
N ROUGE 2, LA.

SHEET NO. 13 OF 35




BARNARD & BURK
CONSULTING ENGINEERS
1023 NICHOLSON DRIVE
BATON ROUGE 2, LA.

SHEET NO. 14 OF 35

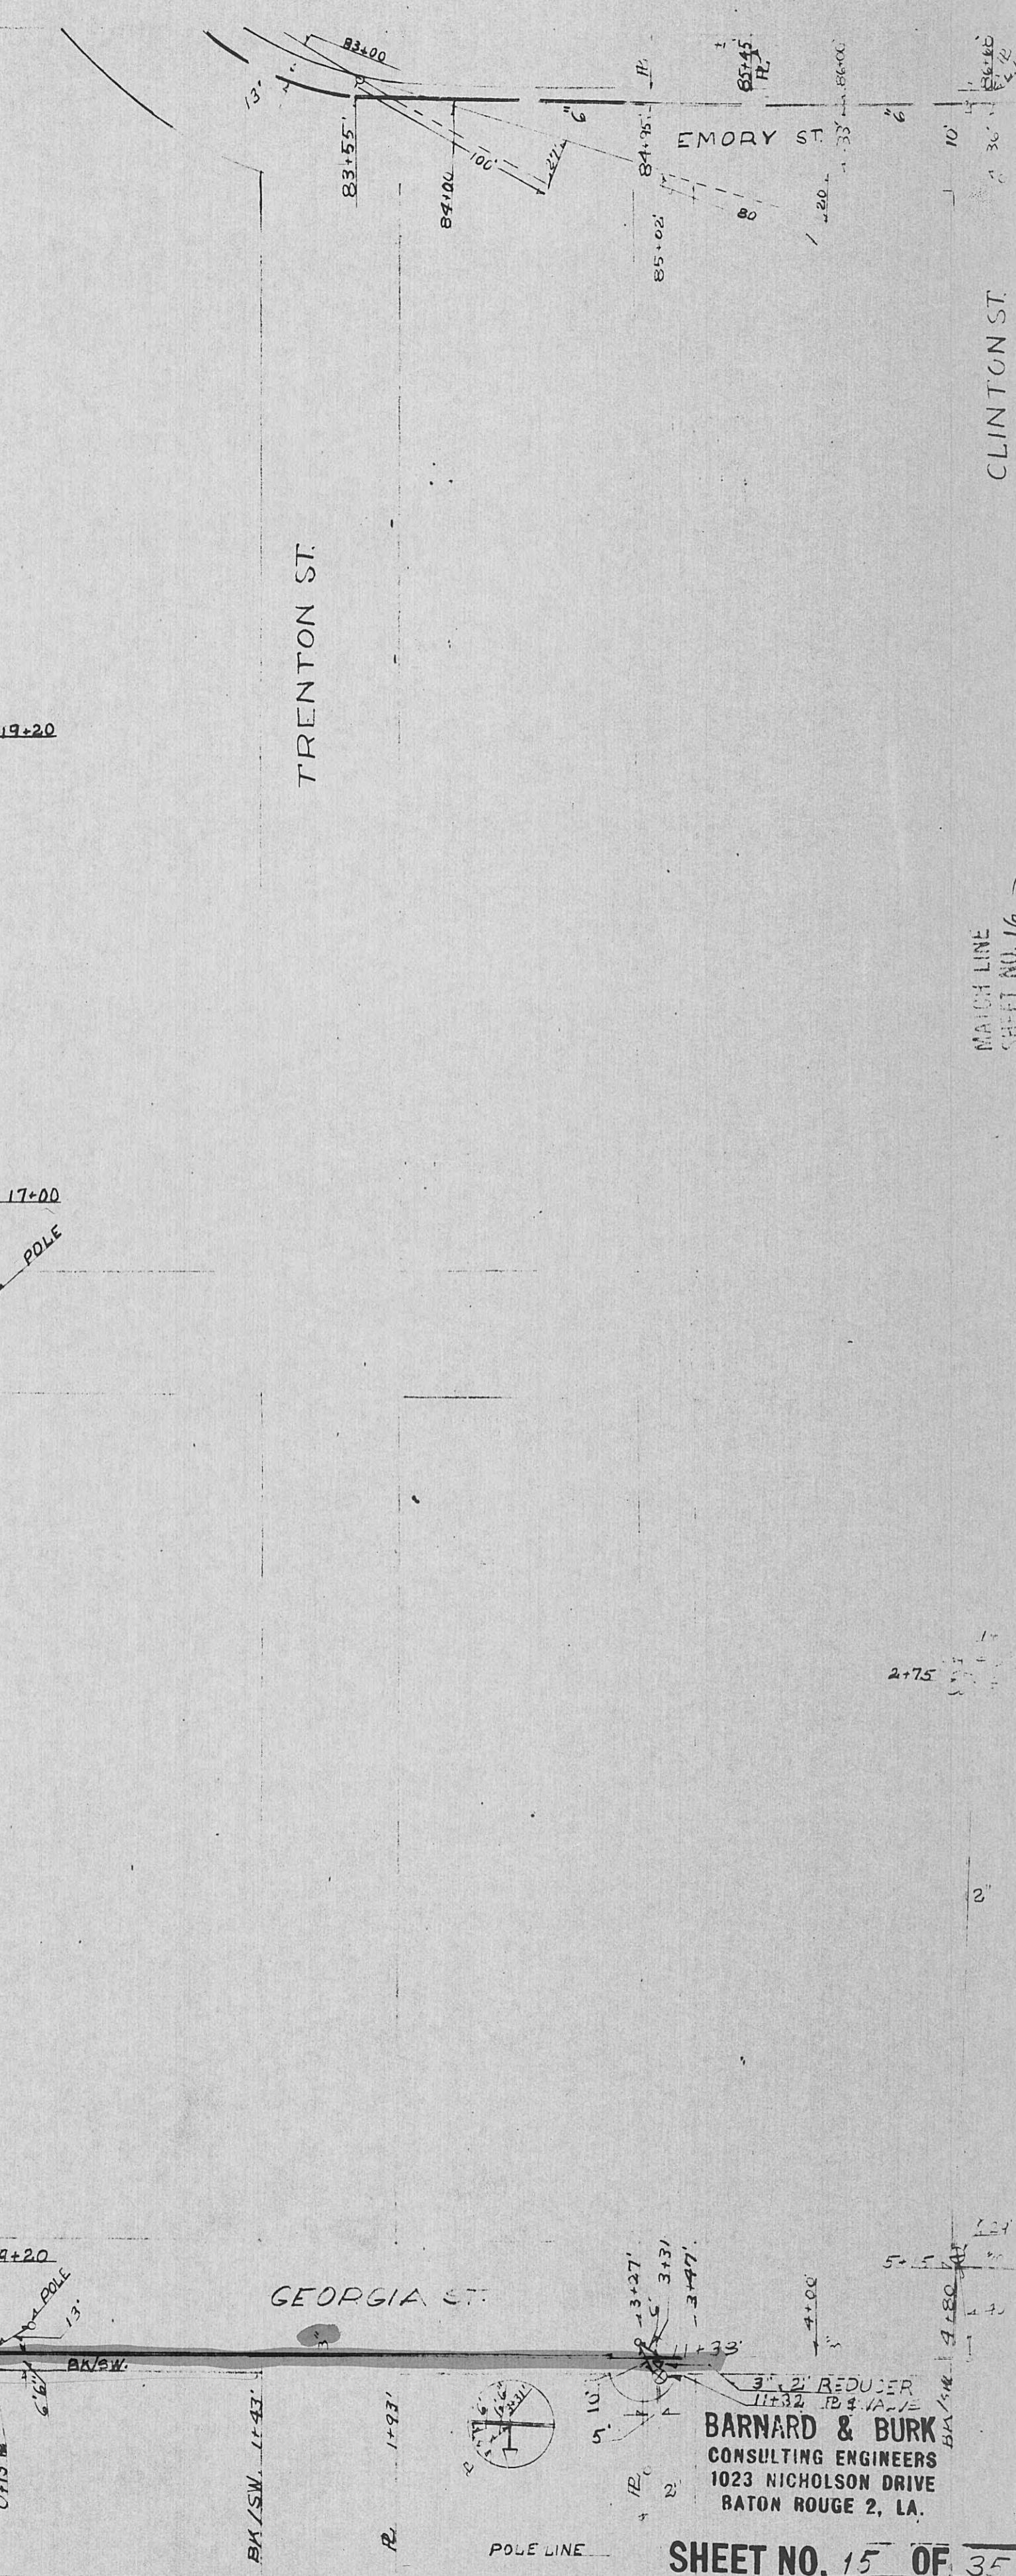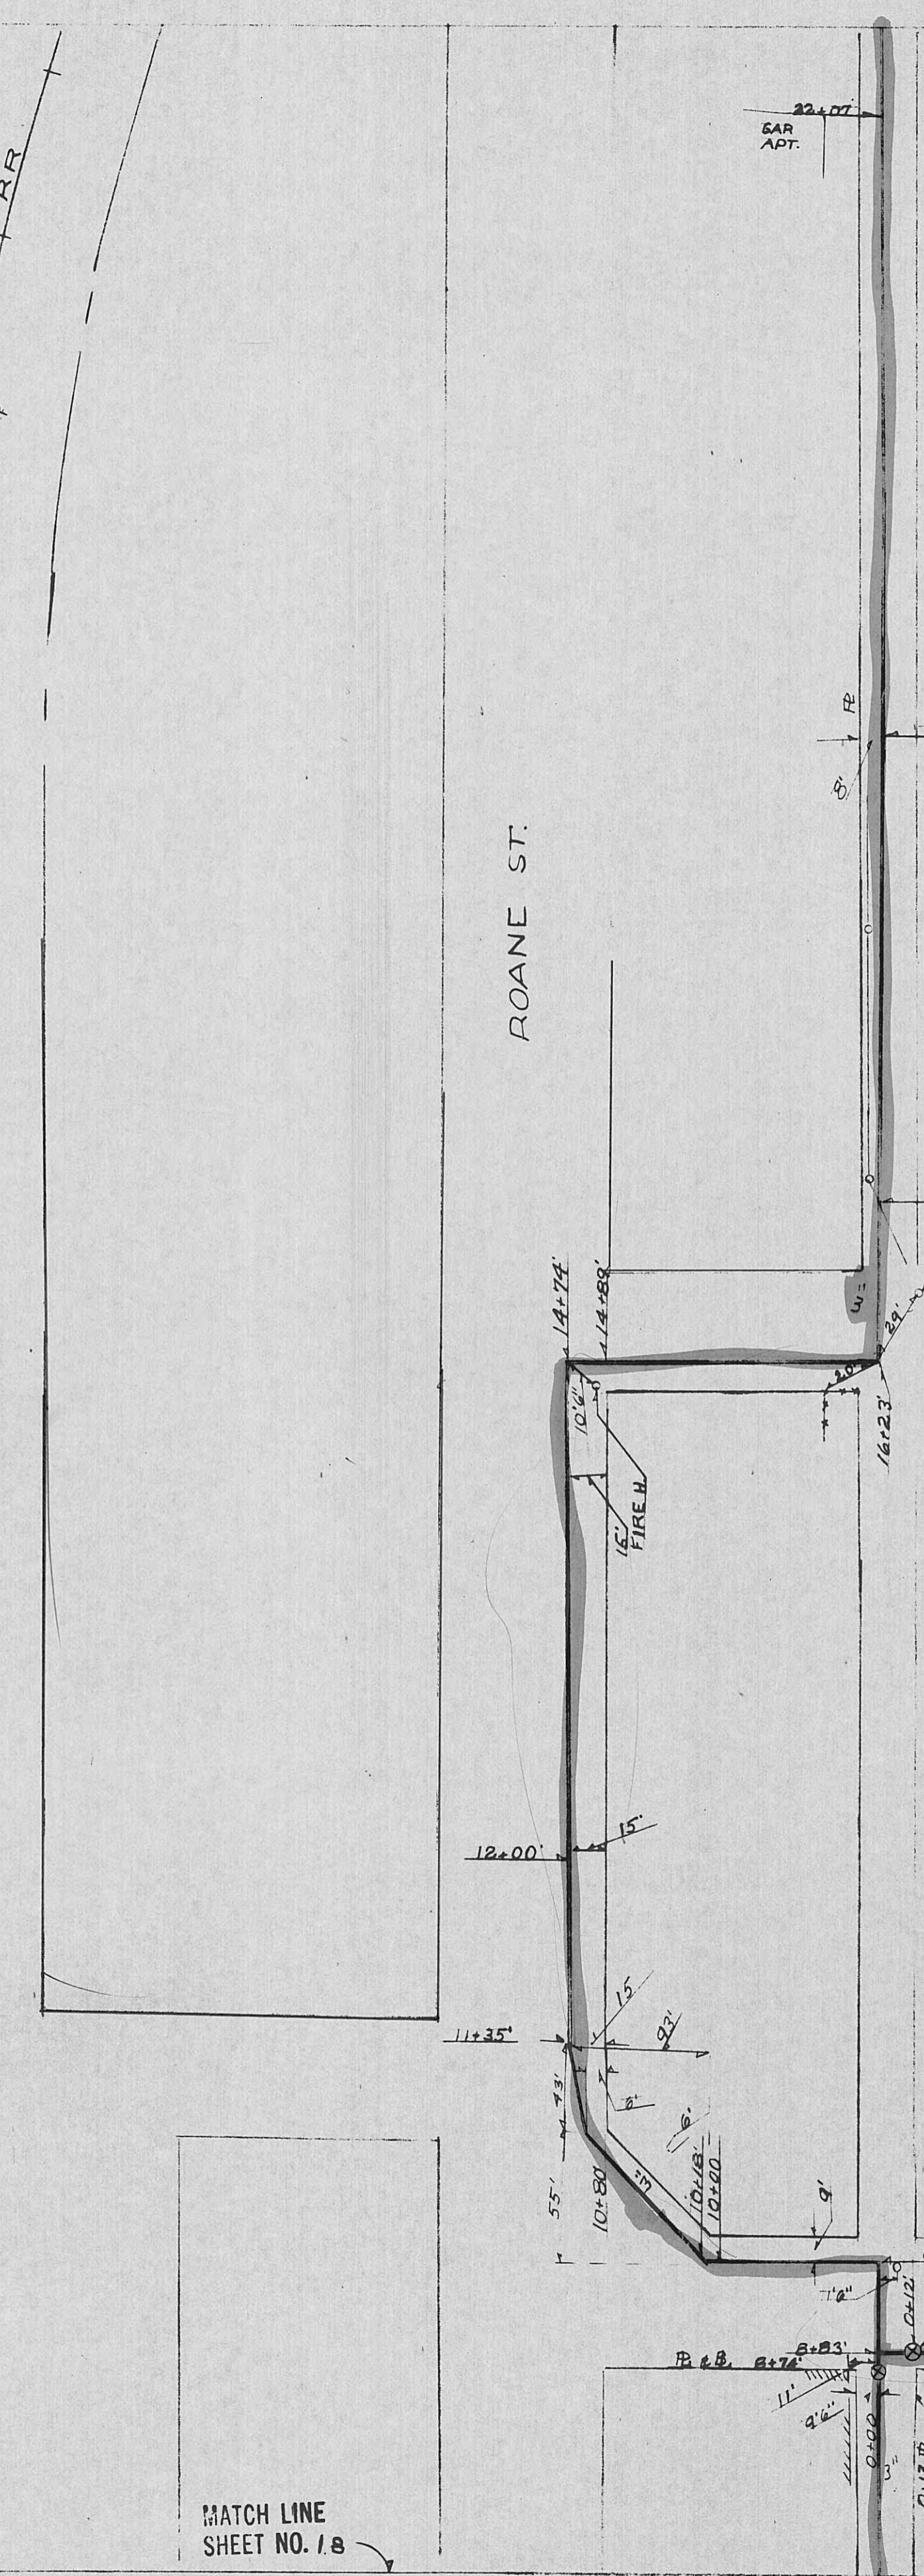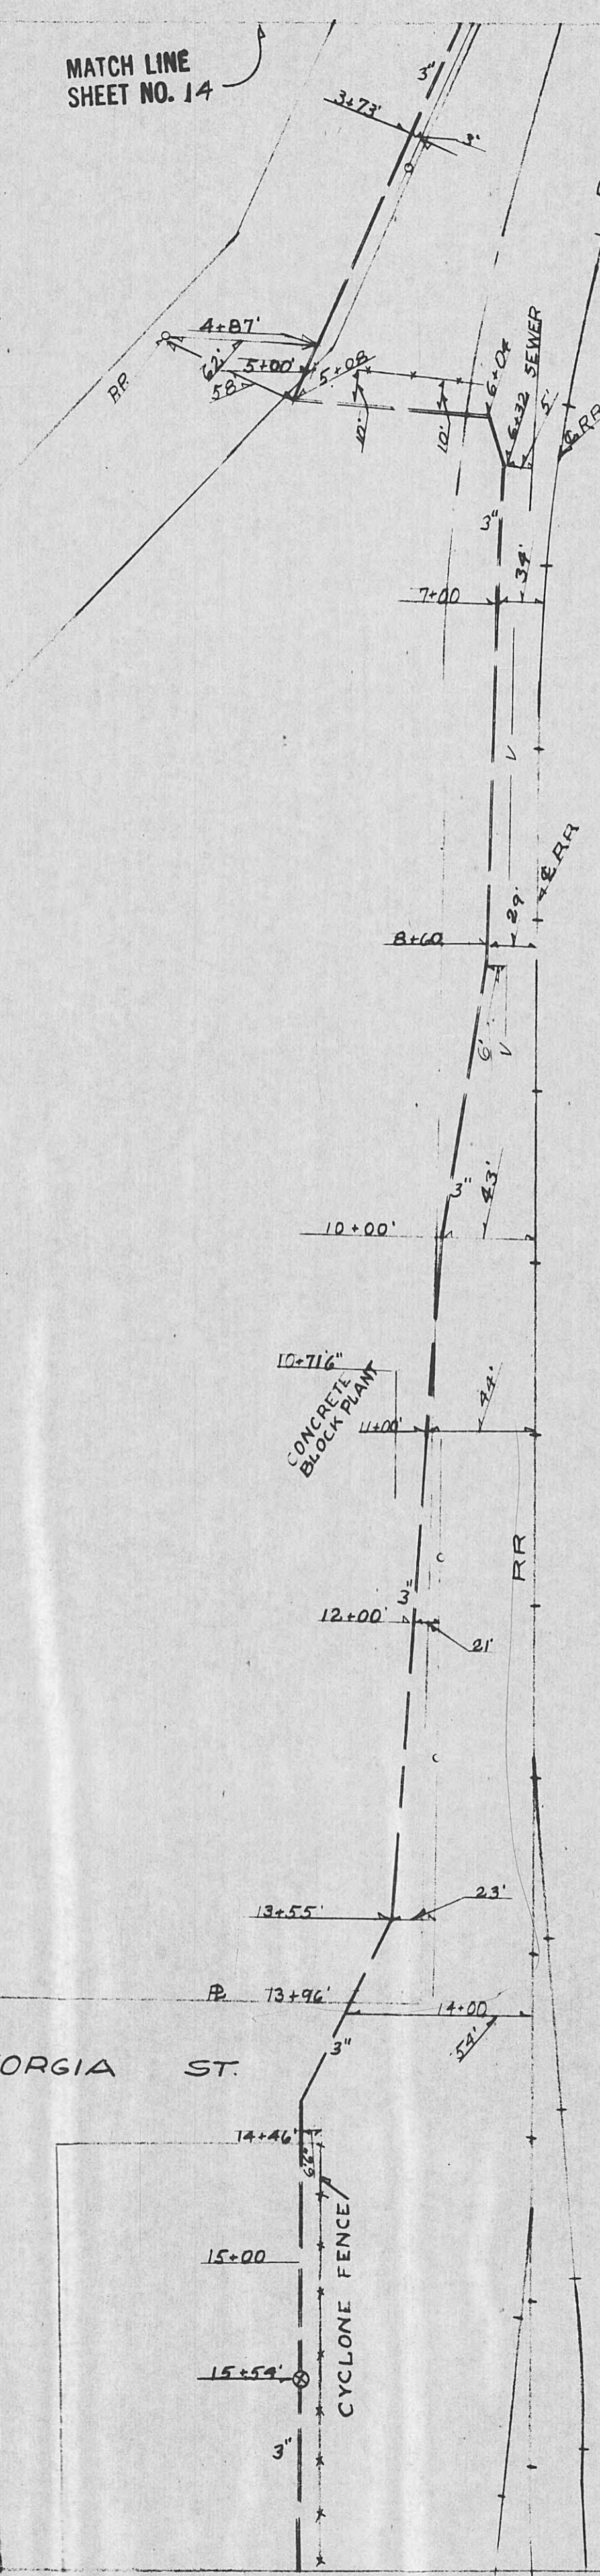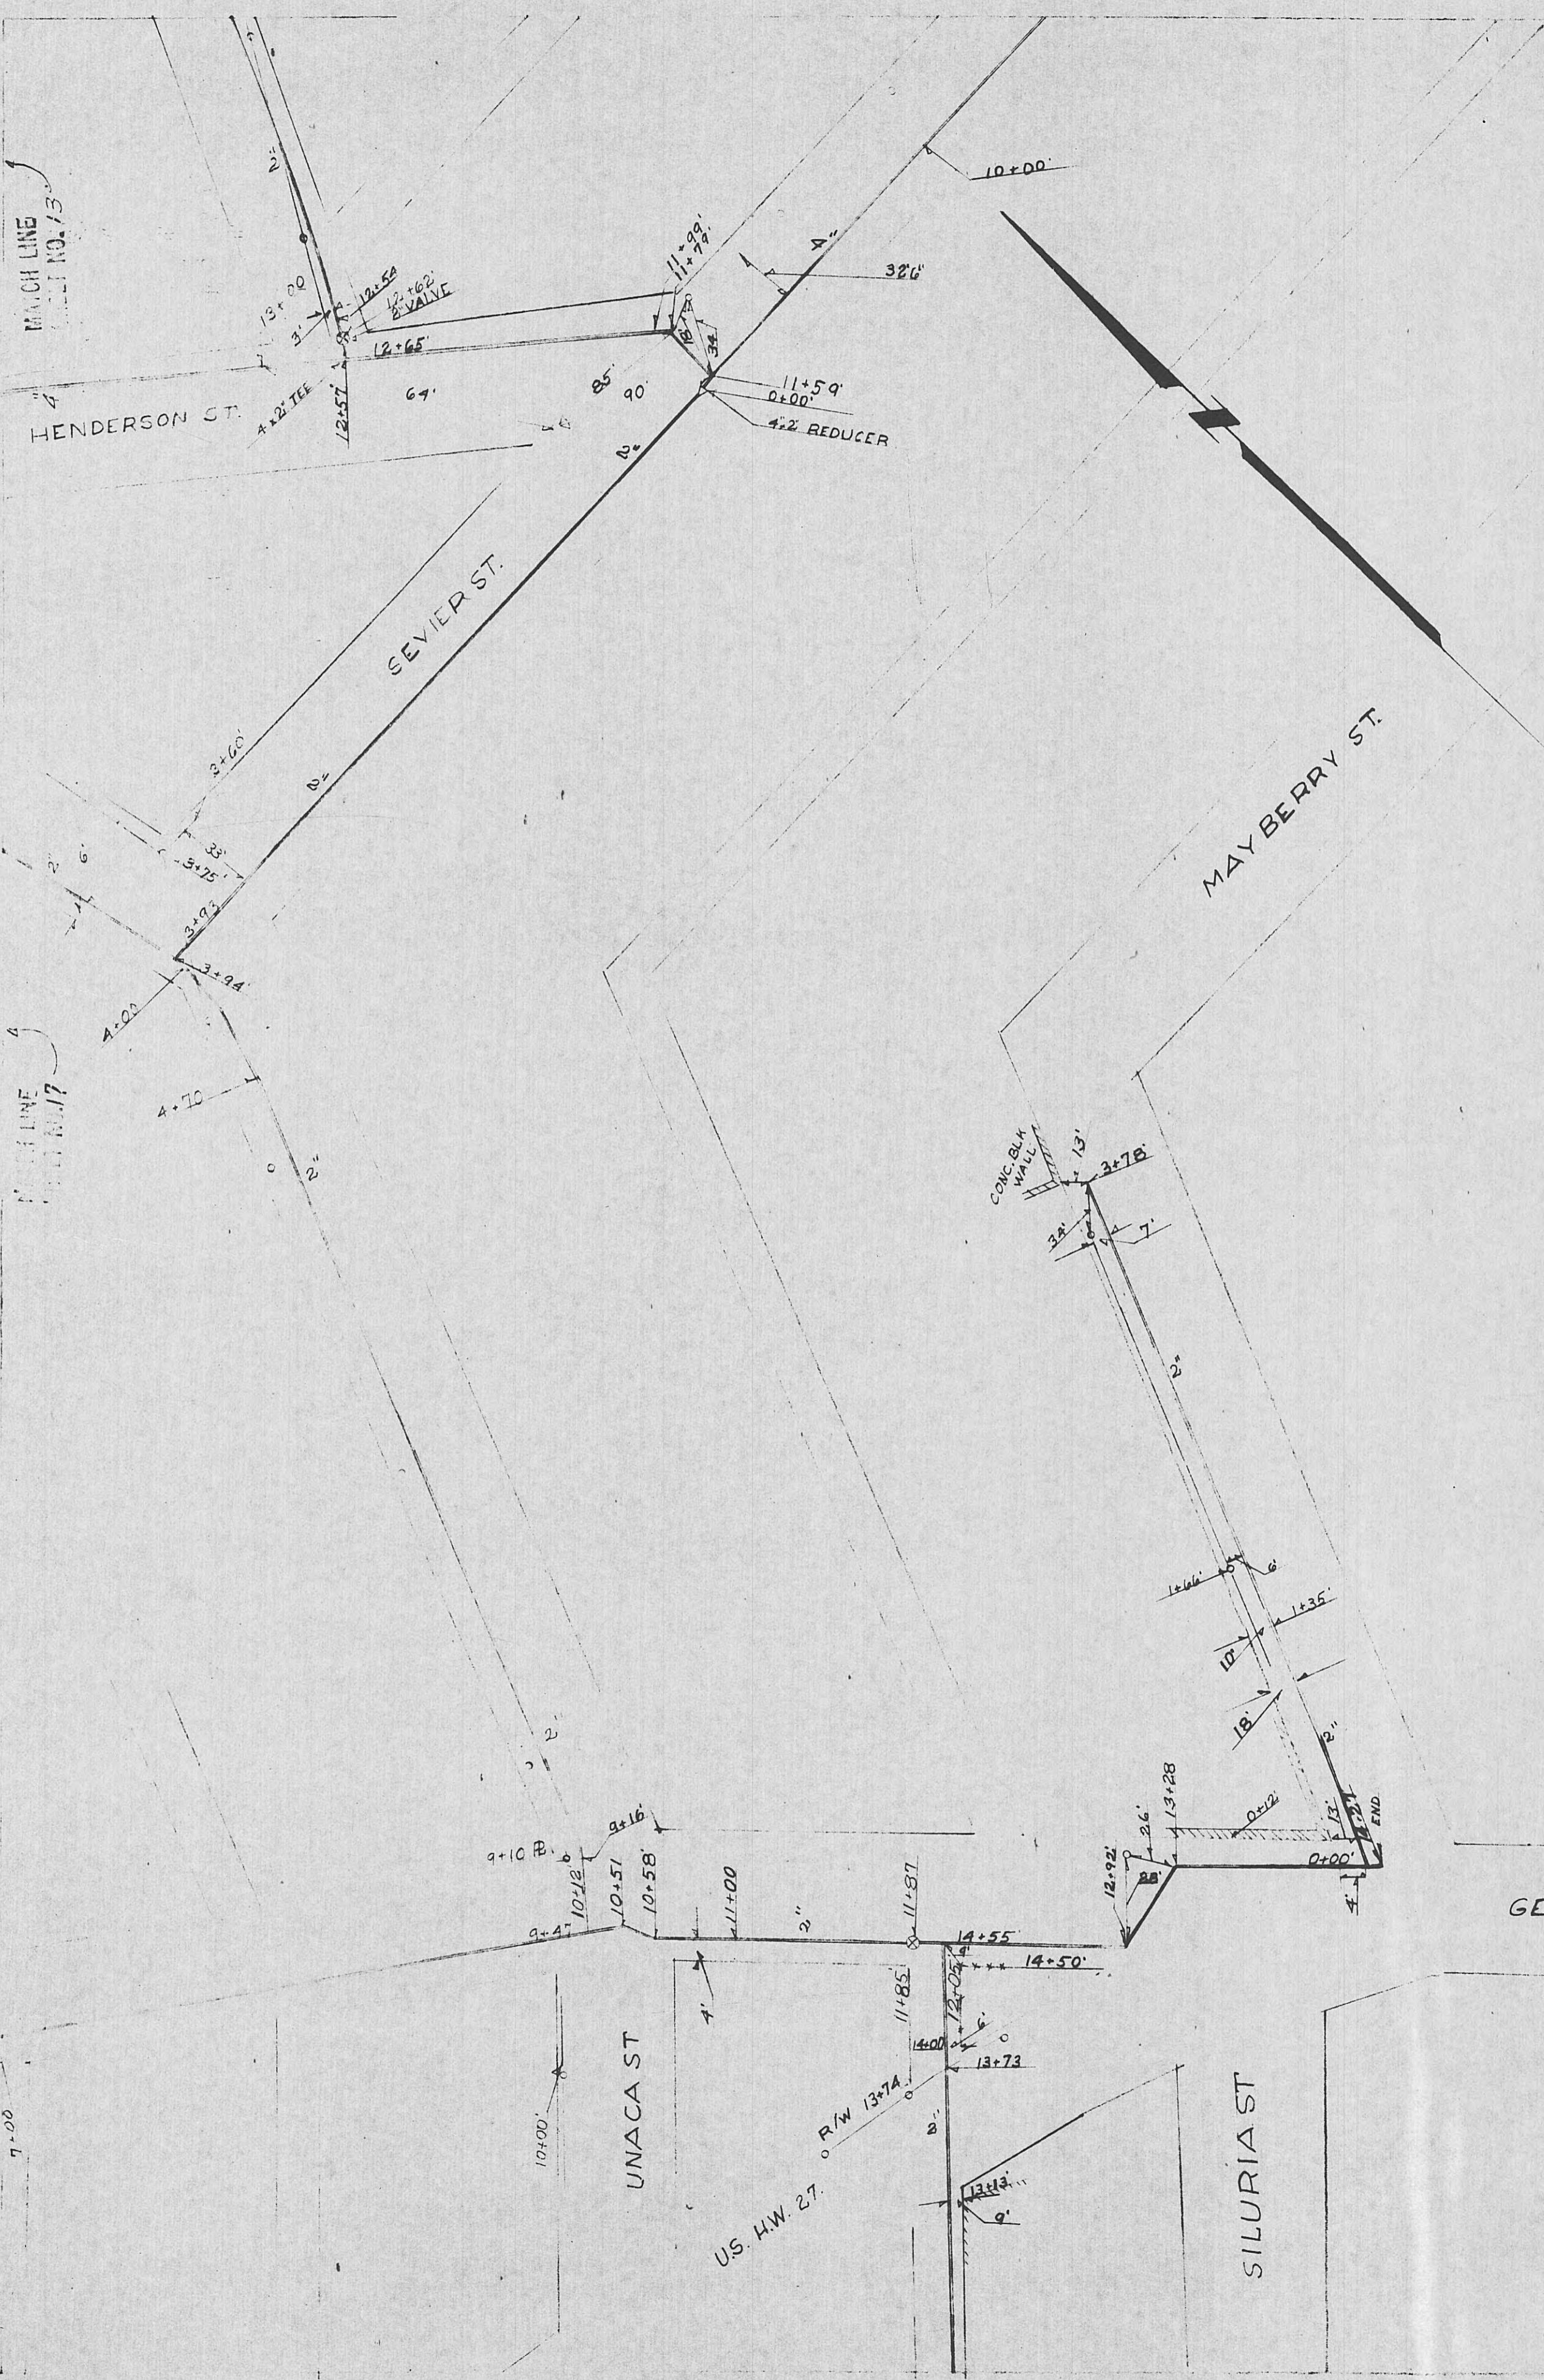


MATCH LINE
SHEET NO 15


LINE 15

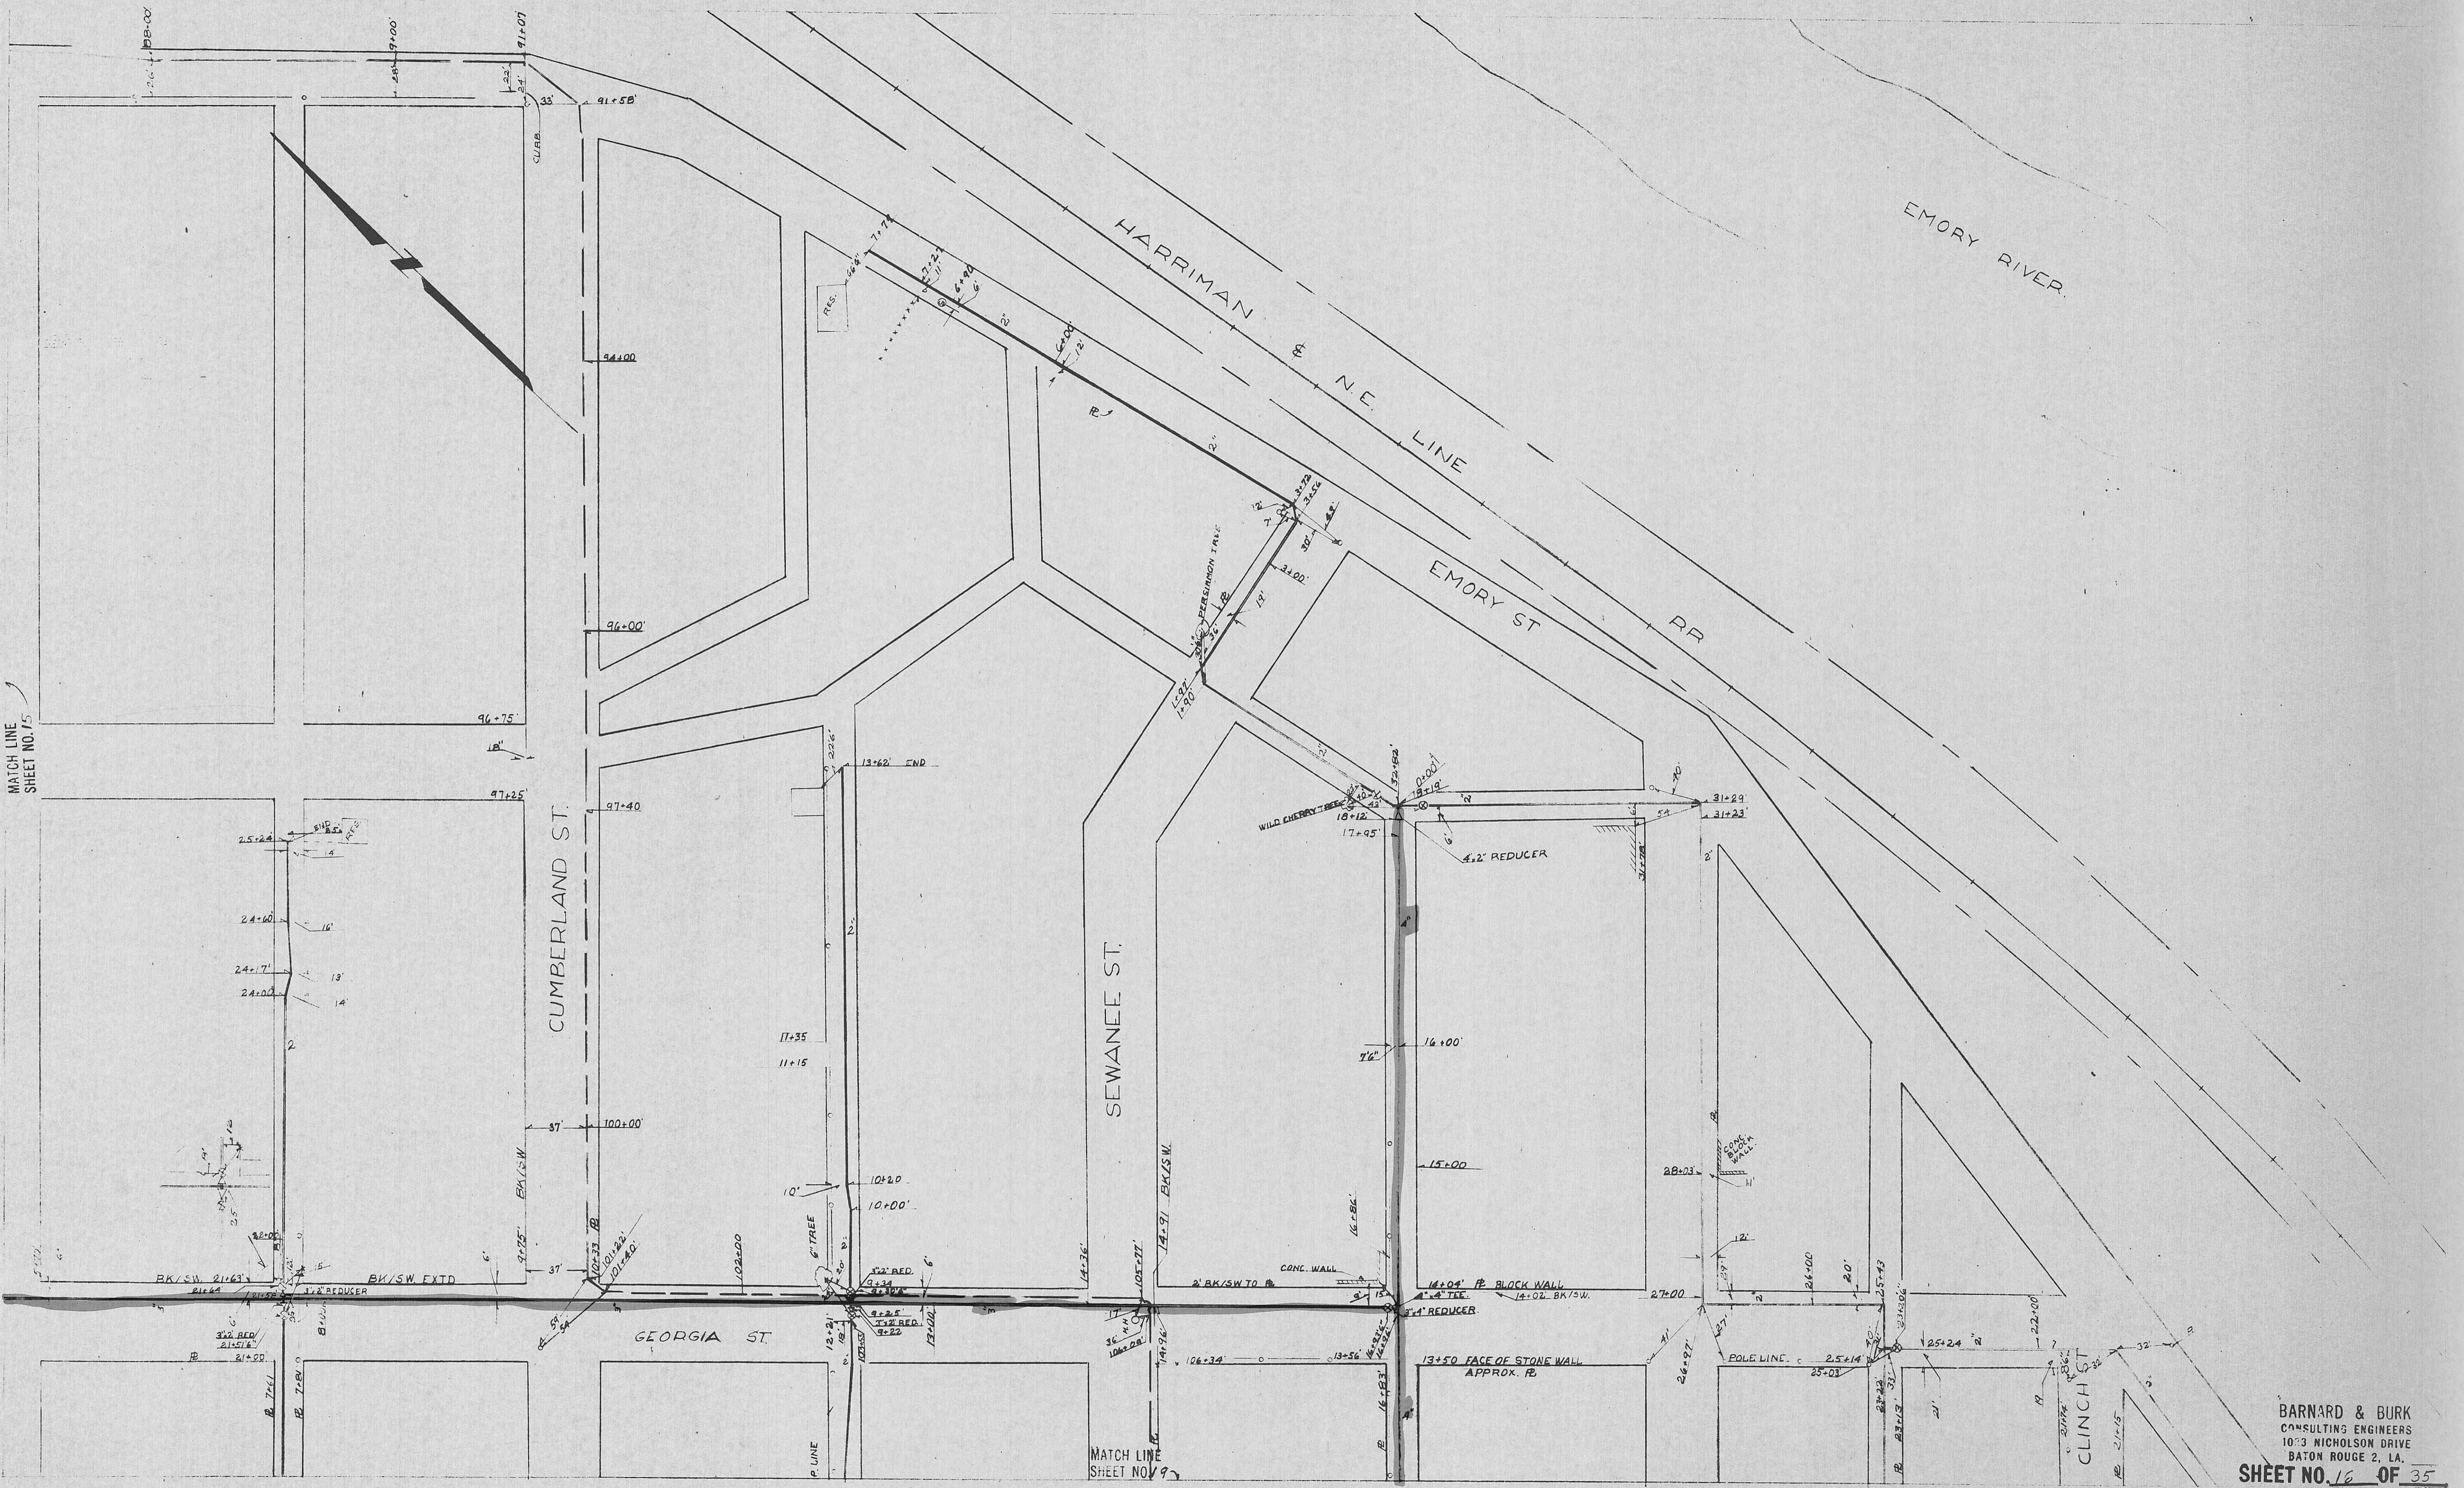

MATCH
SHEET

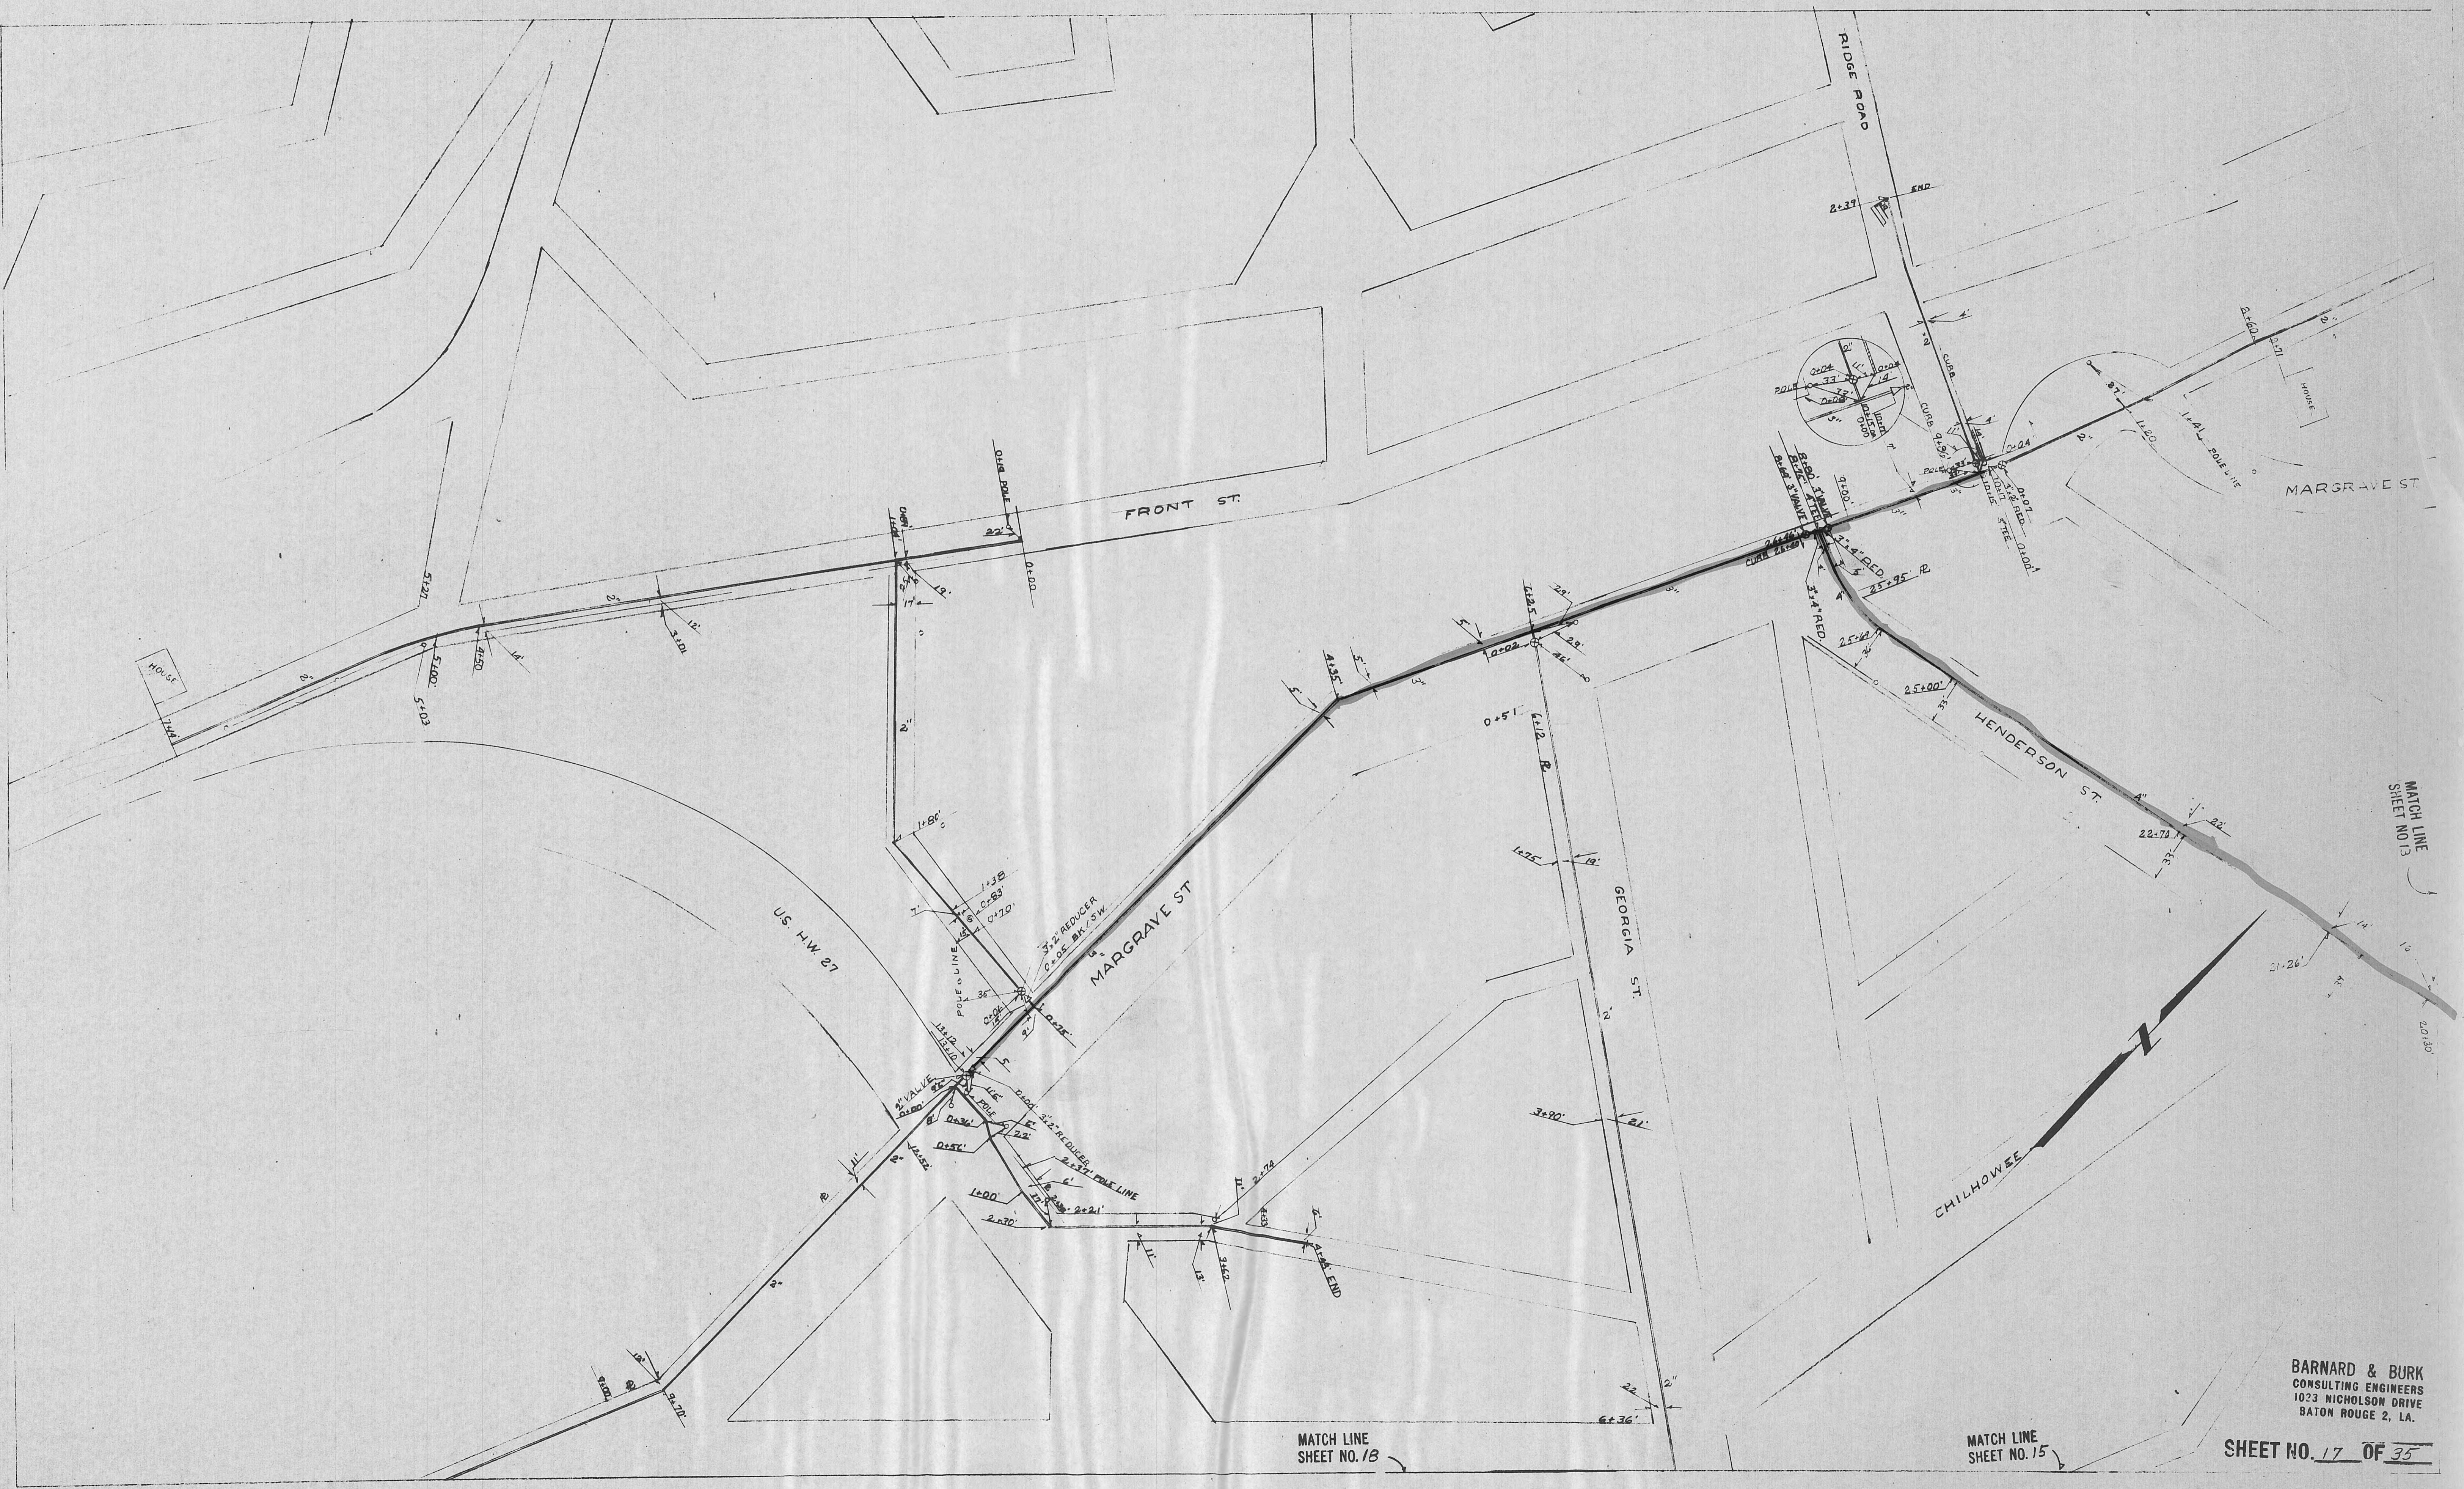


MATCH LINE
SHEET NO. 17

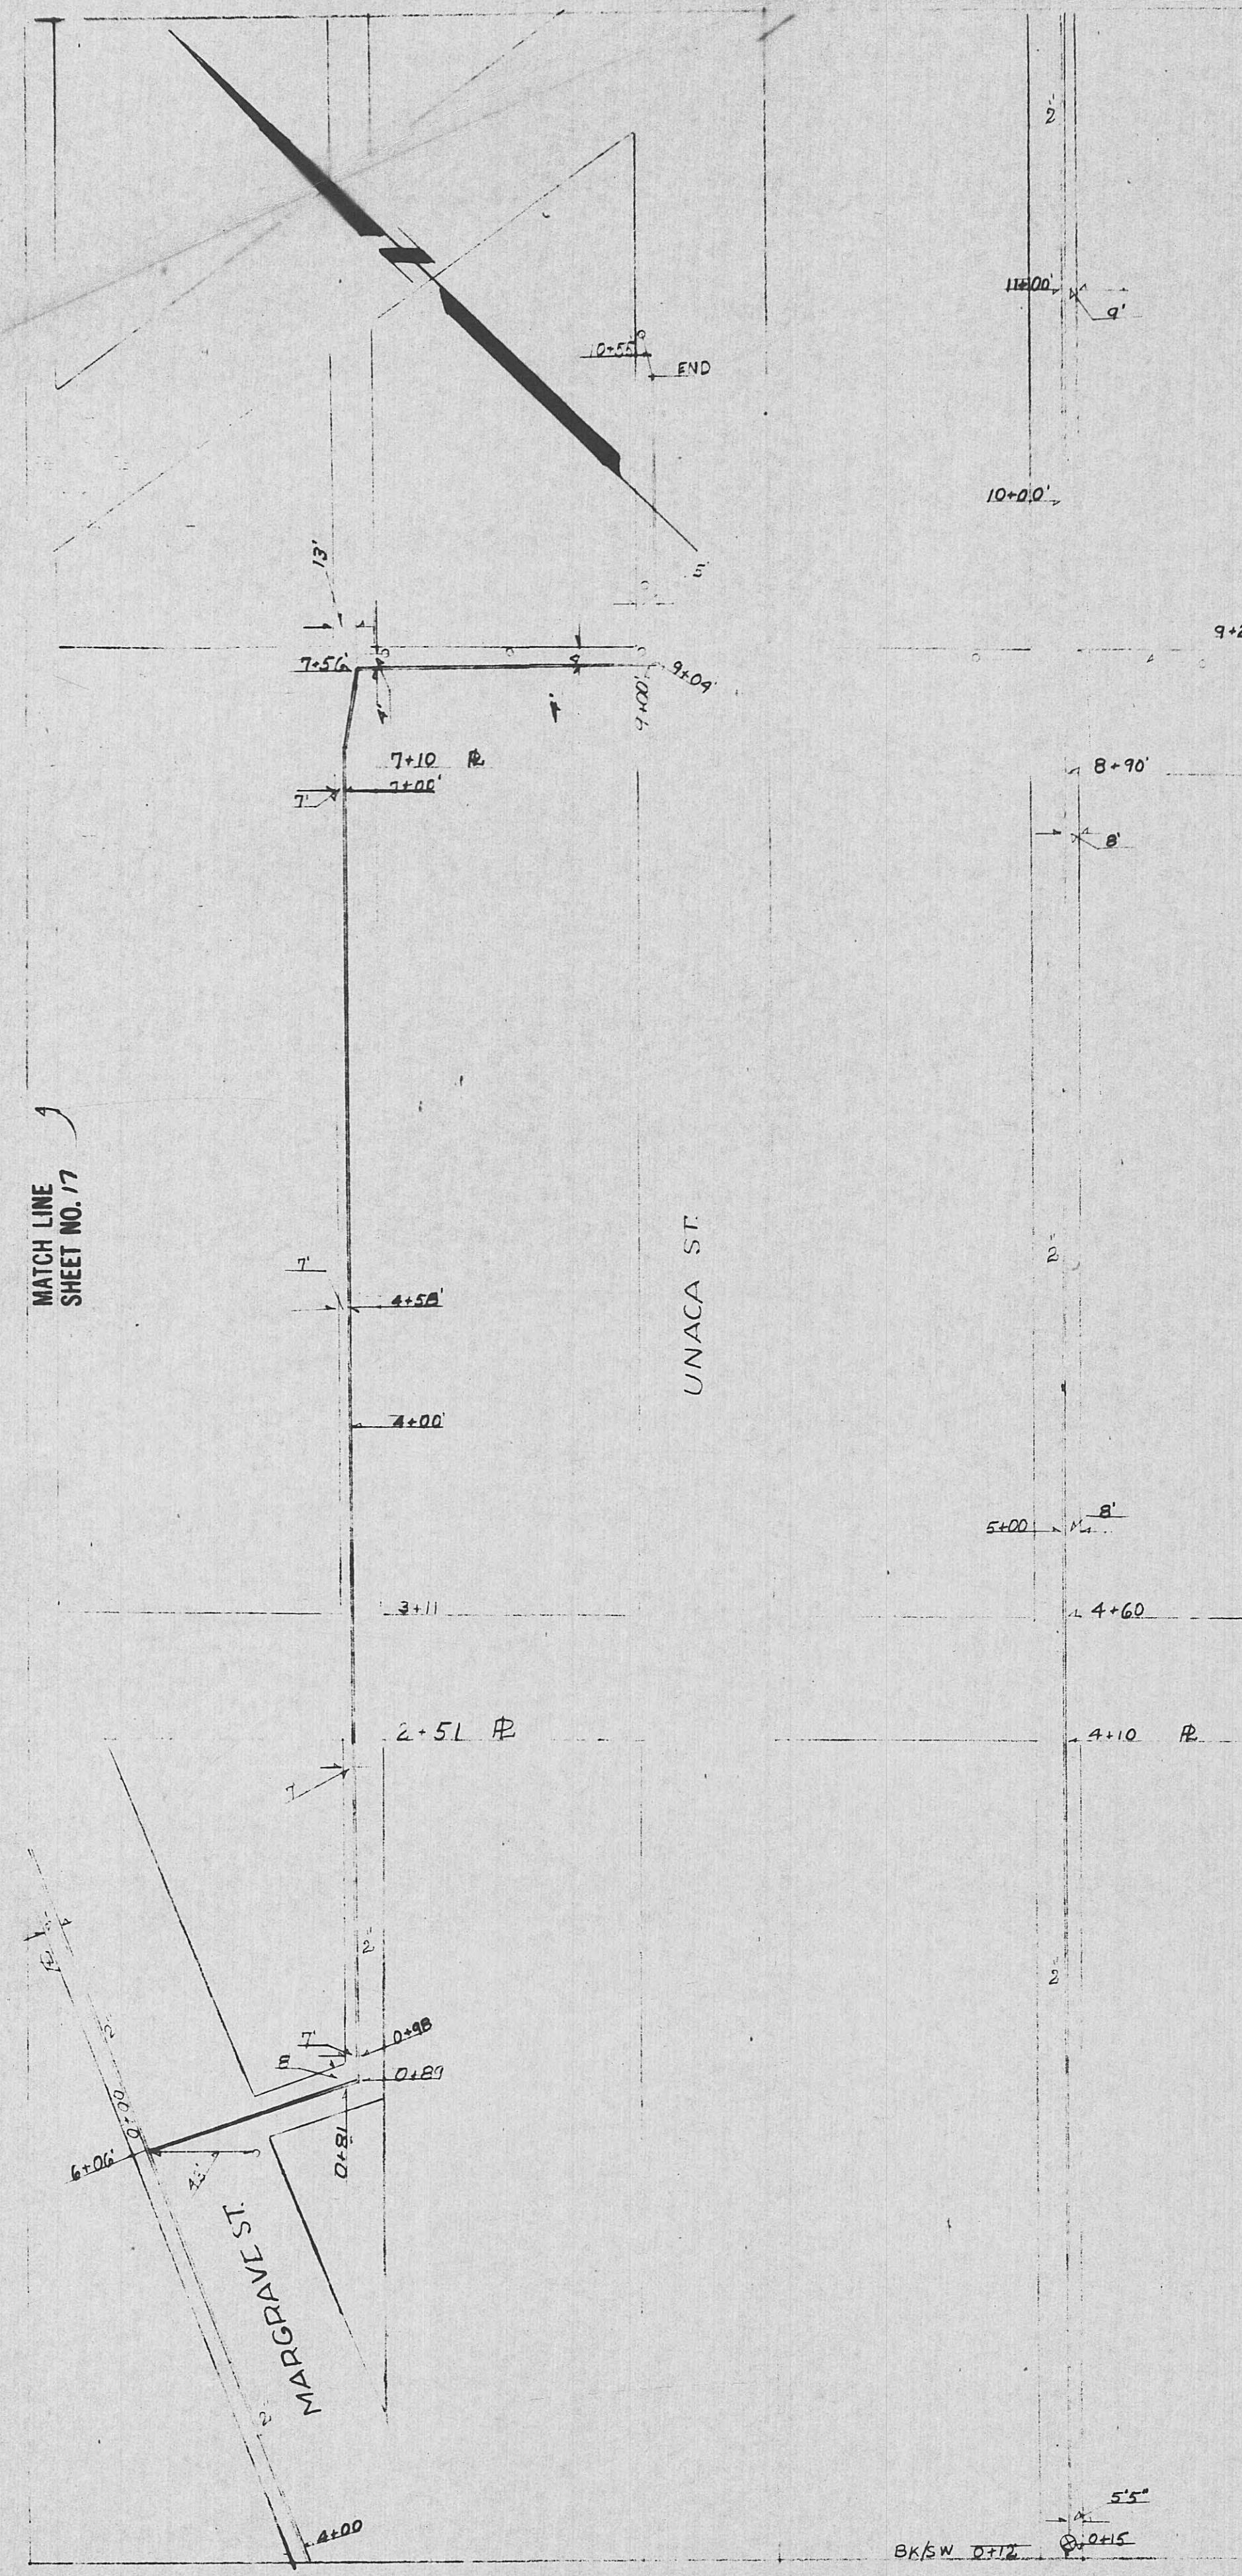

UNACA ST.

SIGURIA ST

TENNESSEE ST.

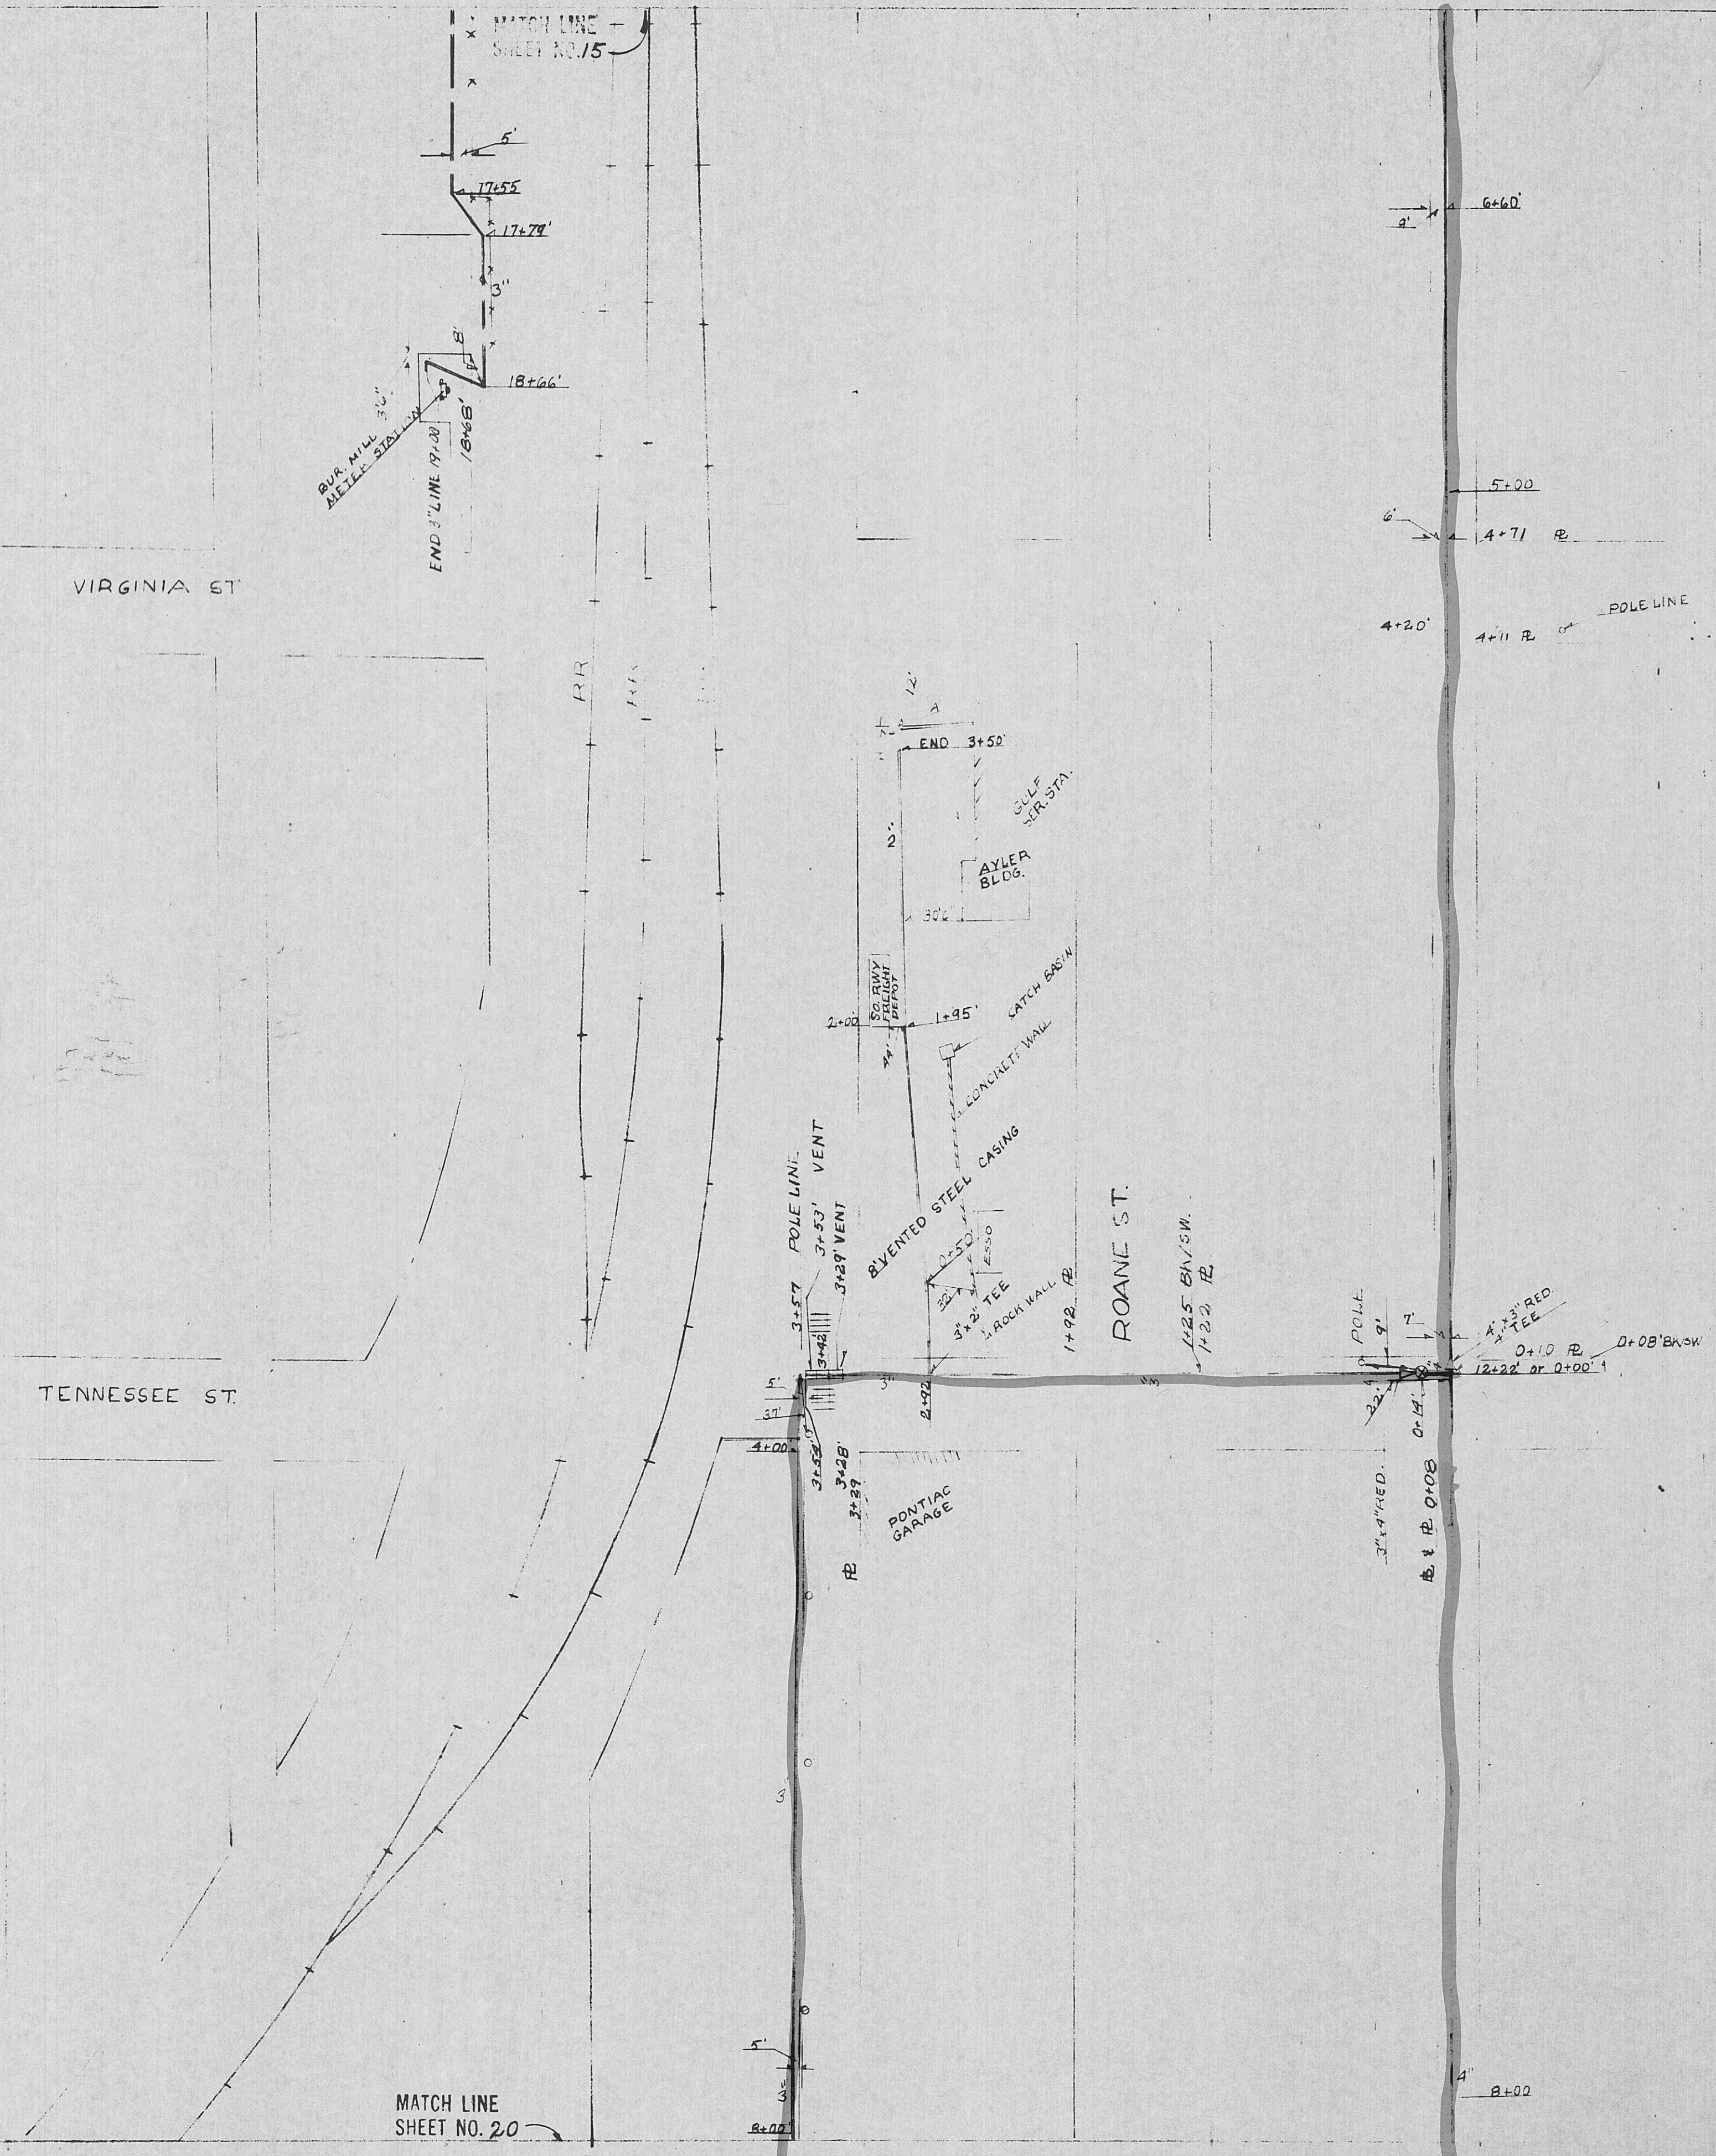


MATCH LINE
SHEET NO.

SHEET NO. 18 OF 35

SHEET NO. 19


**BARNARD & BURK
CONSULTING ENGINEERS
1023 NICHOLSON DRIVE
BATON ROUGE 2, LA.**

MATCH LINE
SHEET NO. 18

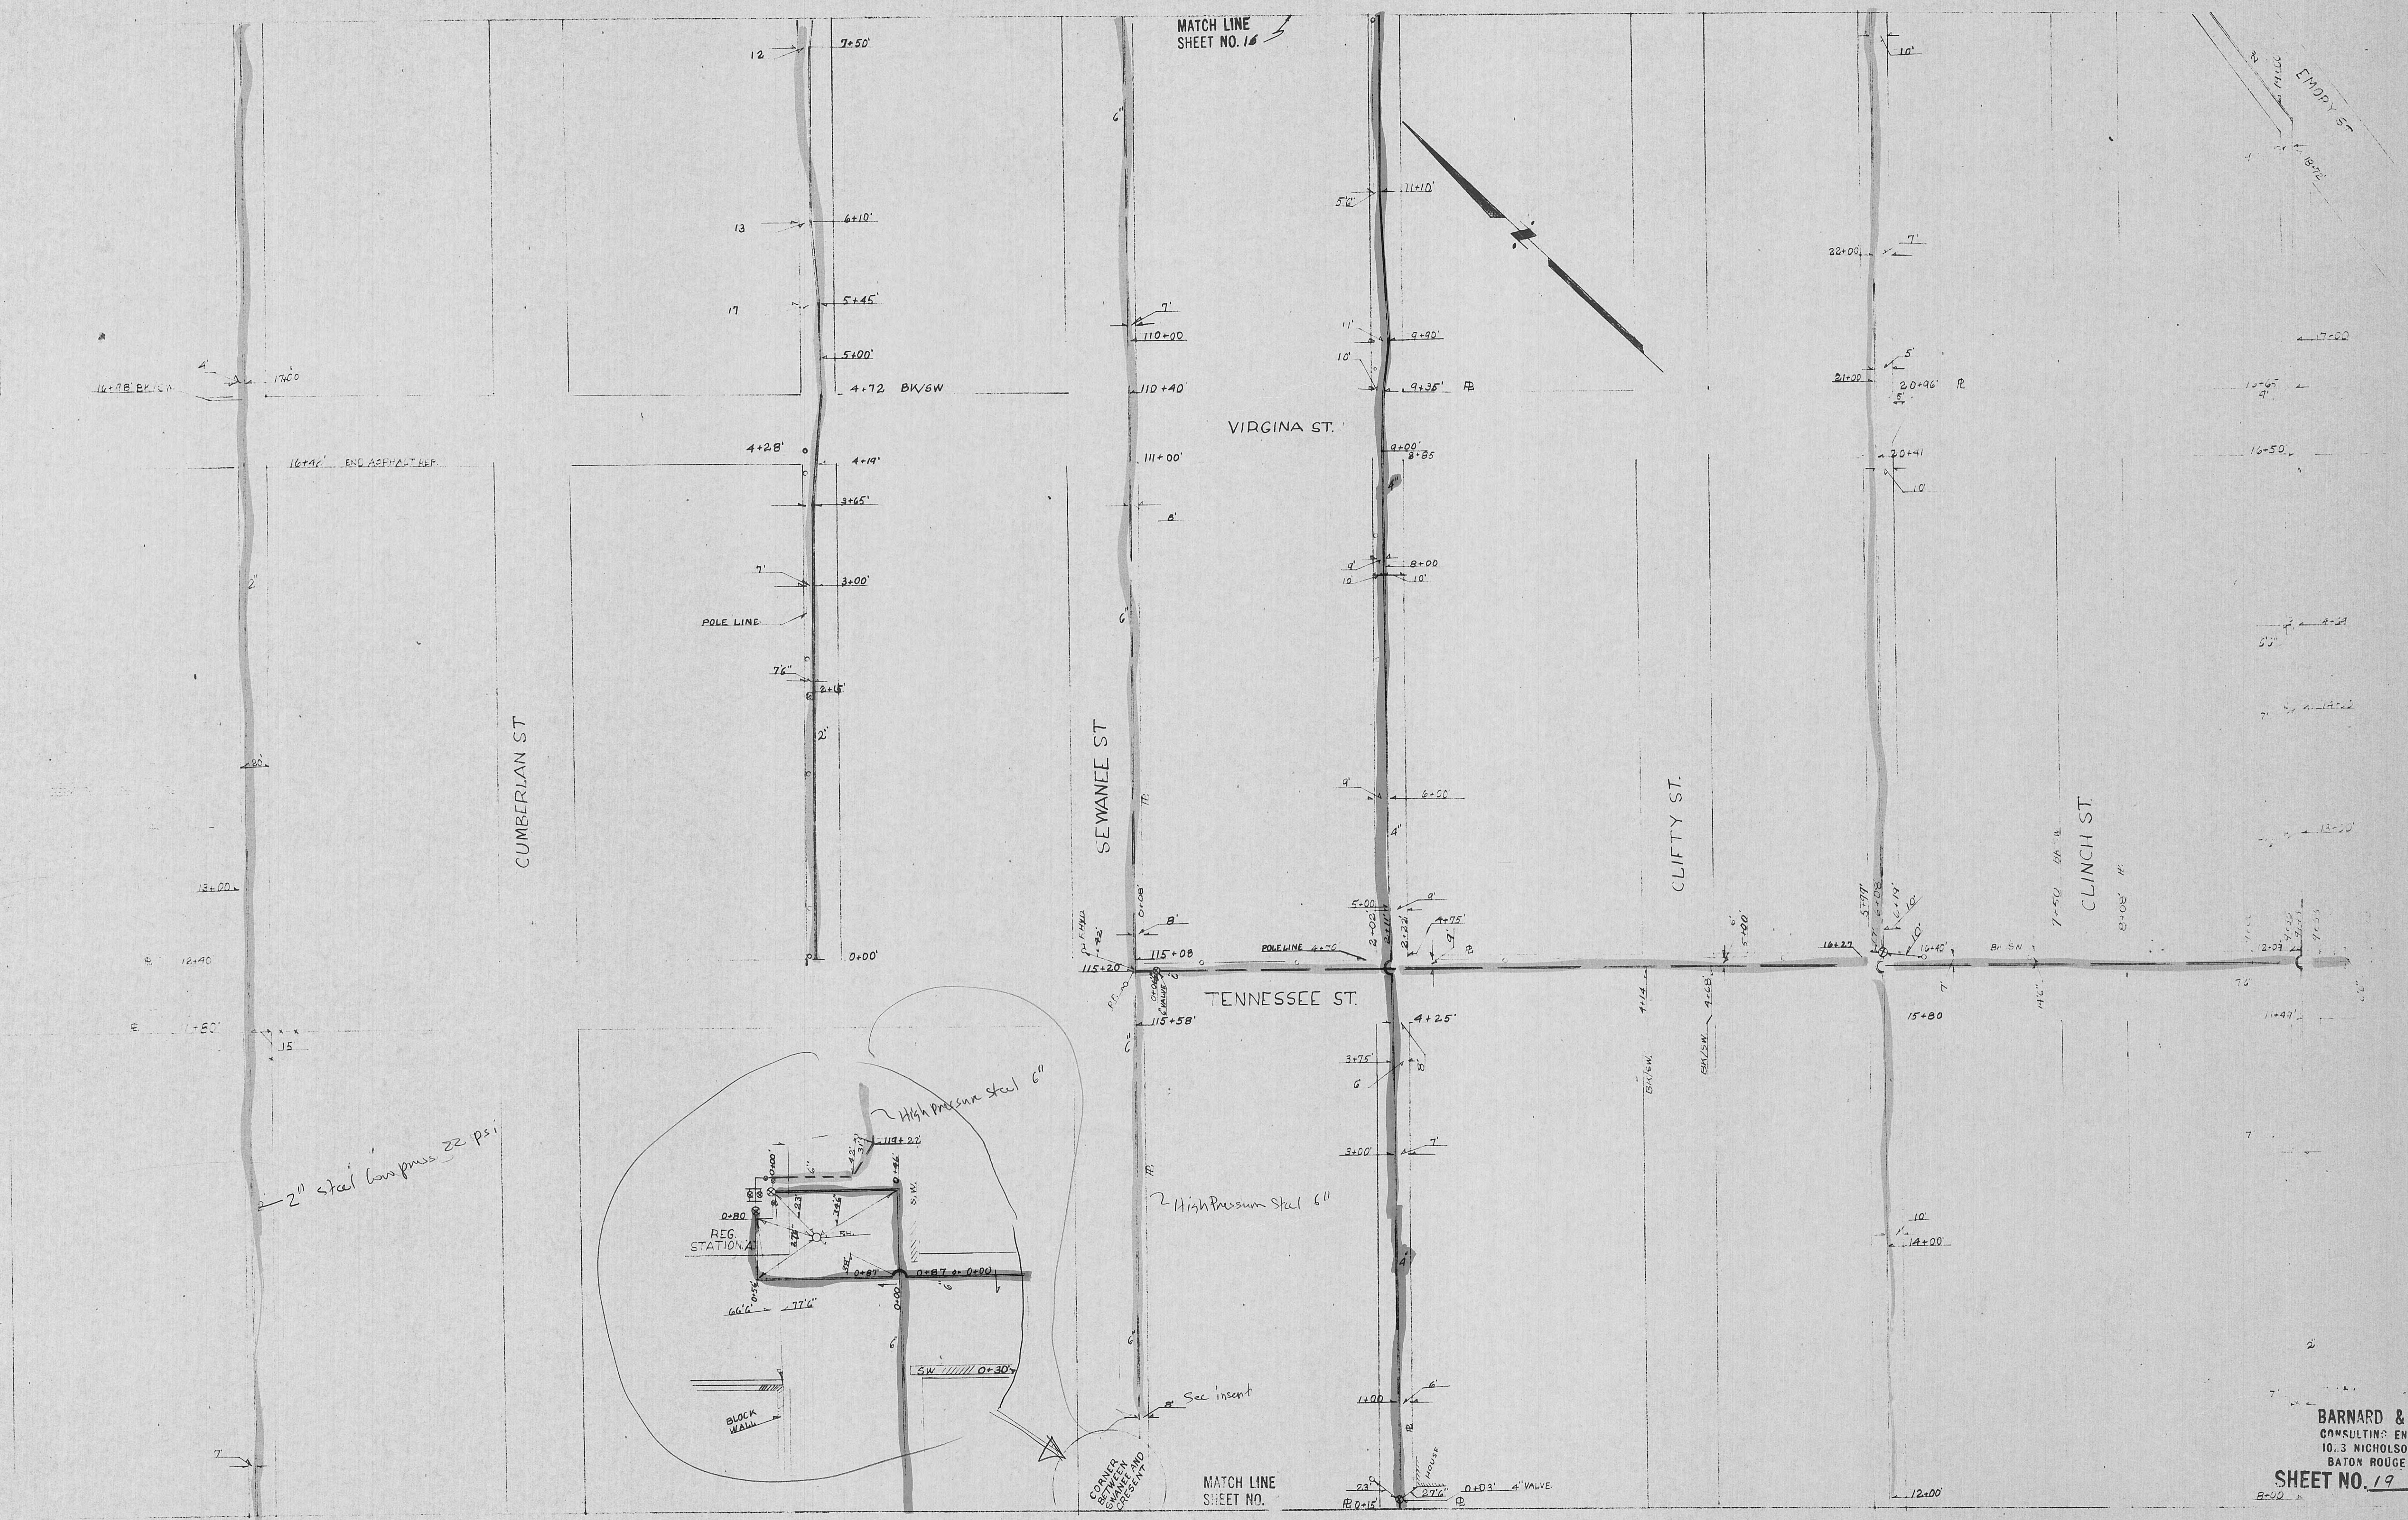

**HARD & BURK
BUILDING ENGINEERS
NICHOLSON DRIVE
MONROVIA 2, LA.**

SHEET NO. 19 OF 35

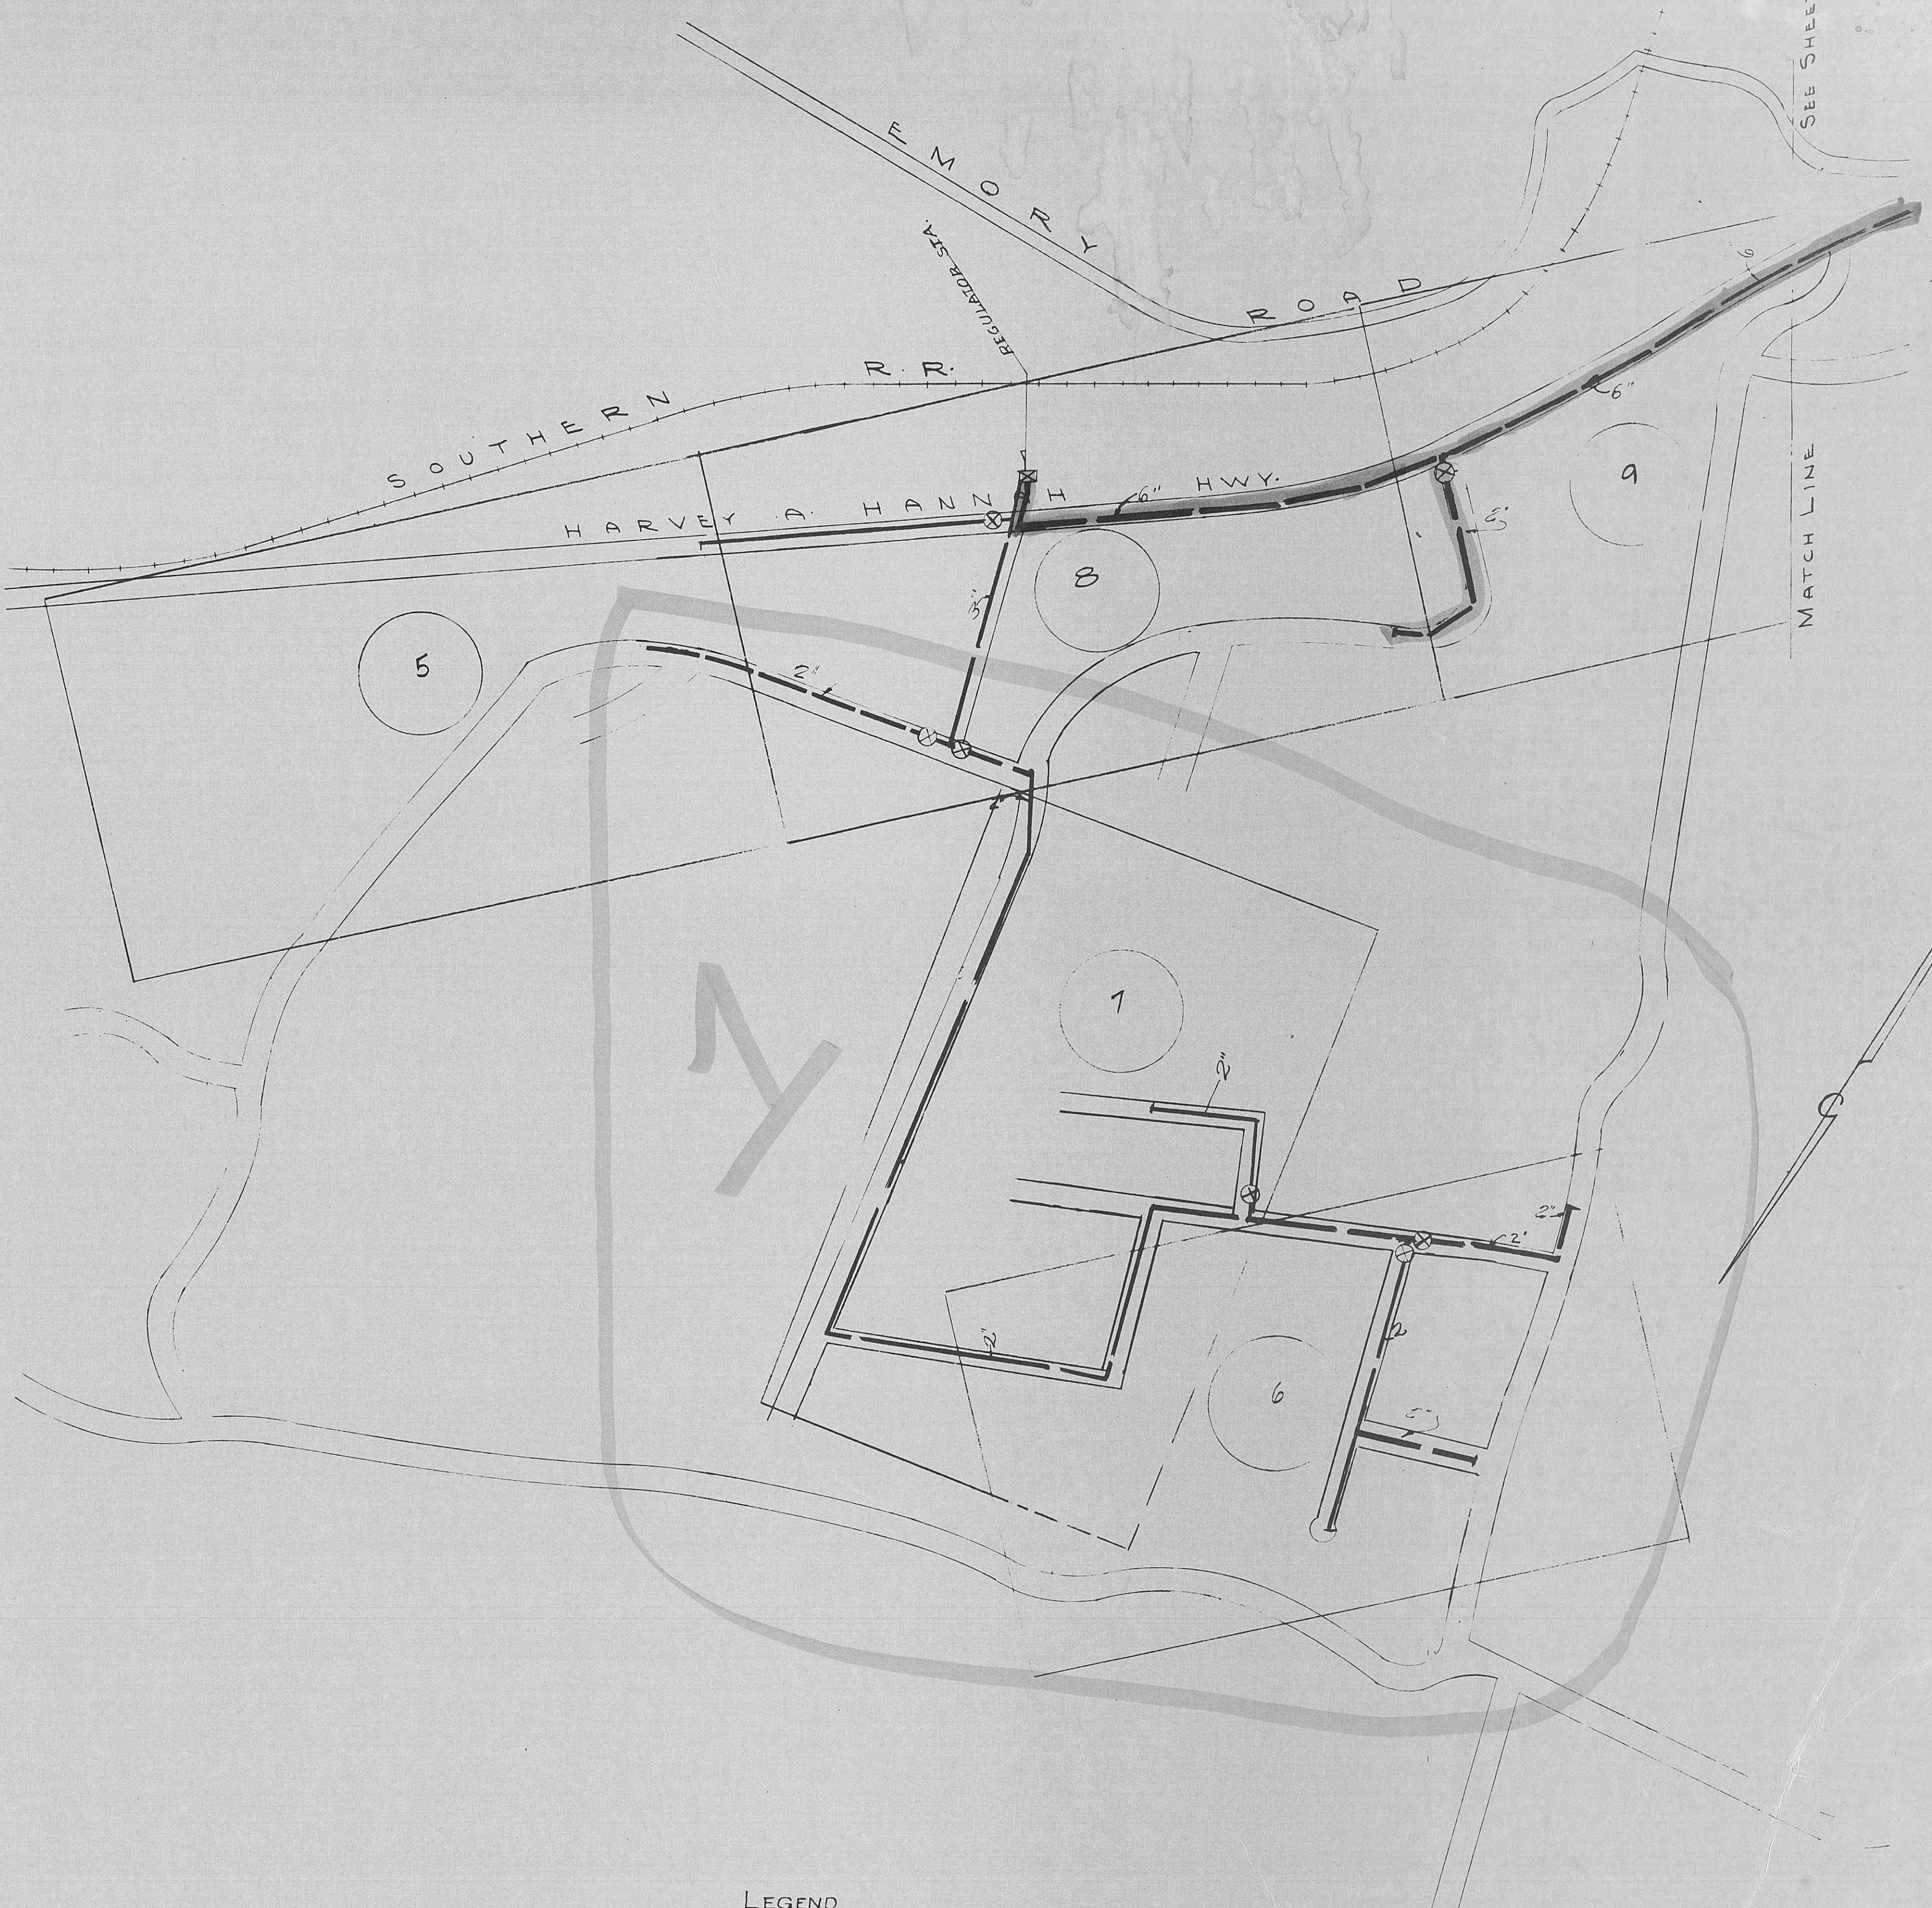



LEGEND

- GAS LINES
- HIGH PRESSURE TRANS. LINES
- VALVES
- TRAP
- BLIND FLANGE. BOLTED TO SLIP ON FLANGE OR VALVE

CITY OF HARRIMAN, TENN.	
BARNARD & BURK CONSULTING ENGINEERS BATON ROUGE, LA.	
DESIGNED BY:	SCALE:
DRAWN BY:	1" = 300'
CHECKED BY:	DATE:
APPROVED:	JOB NO.


SHEET 3

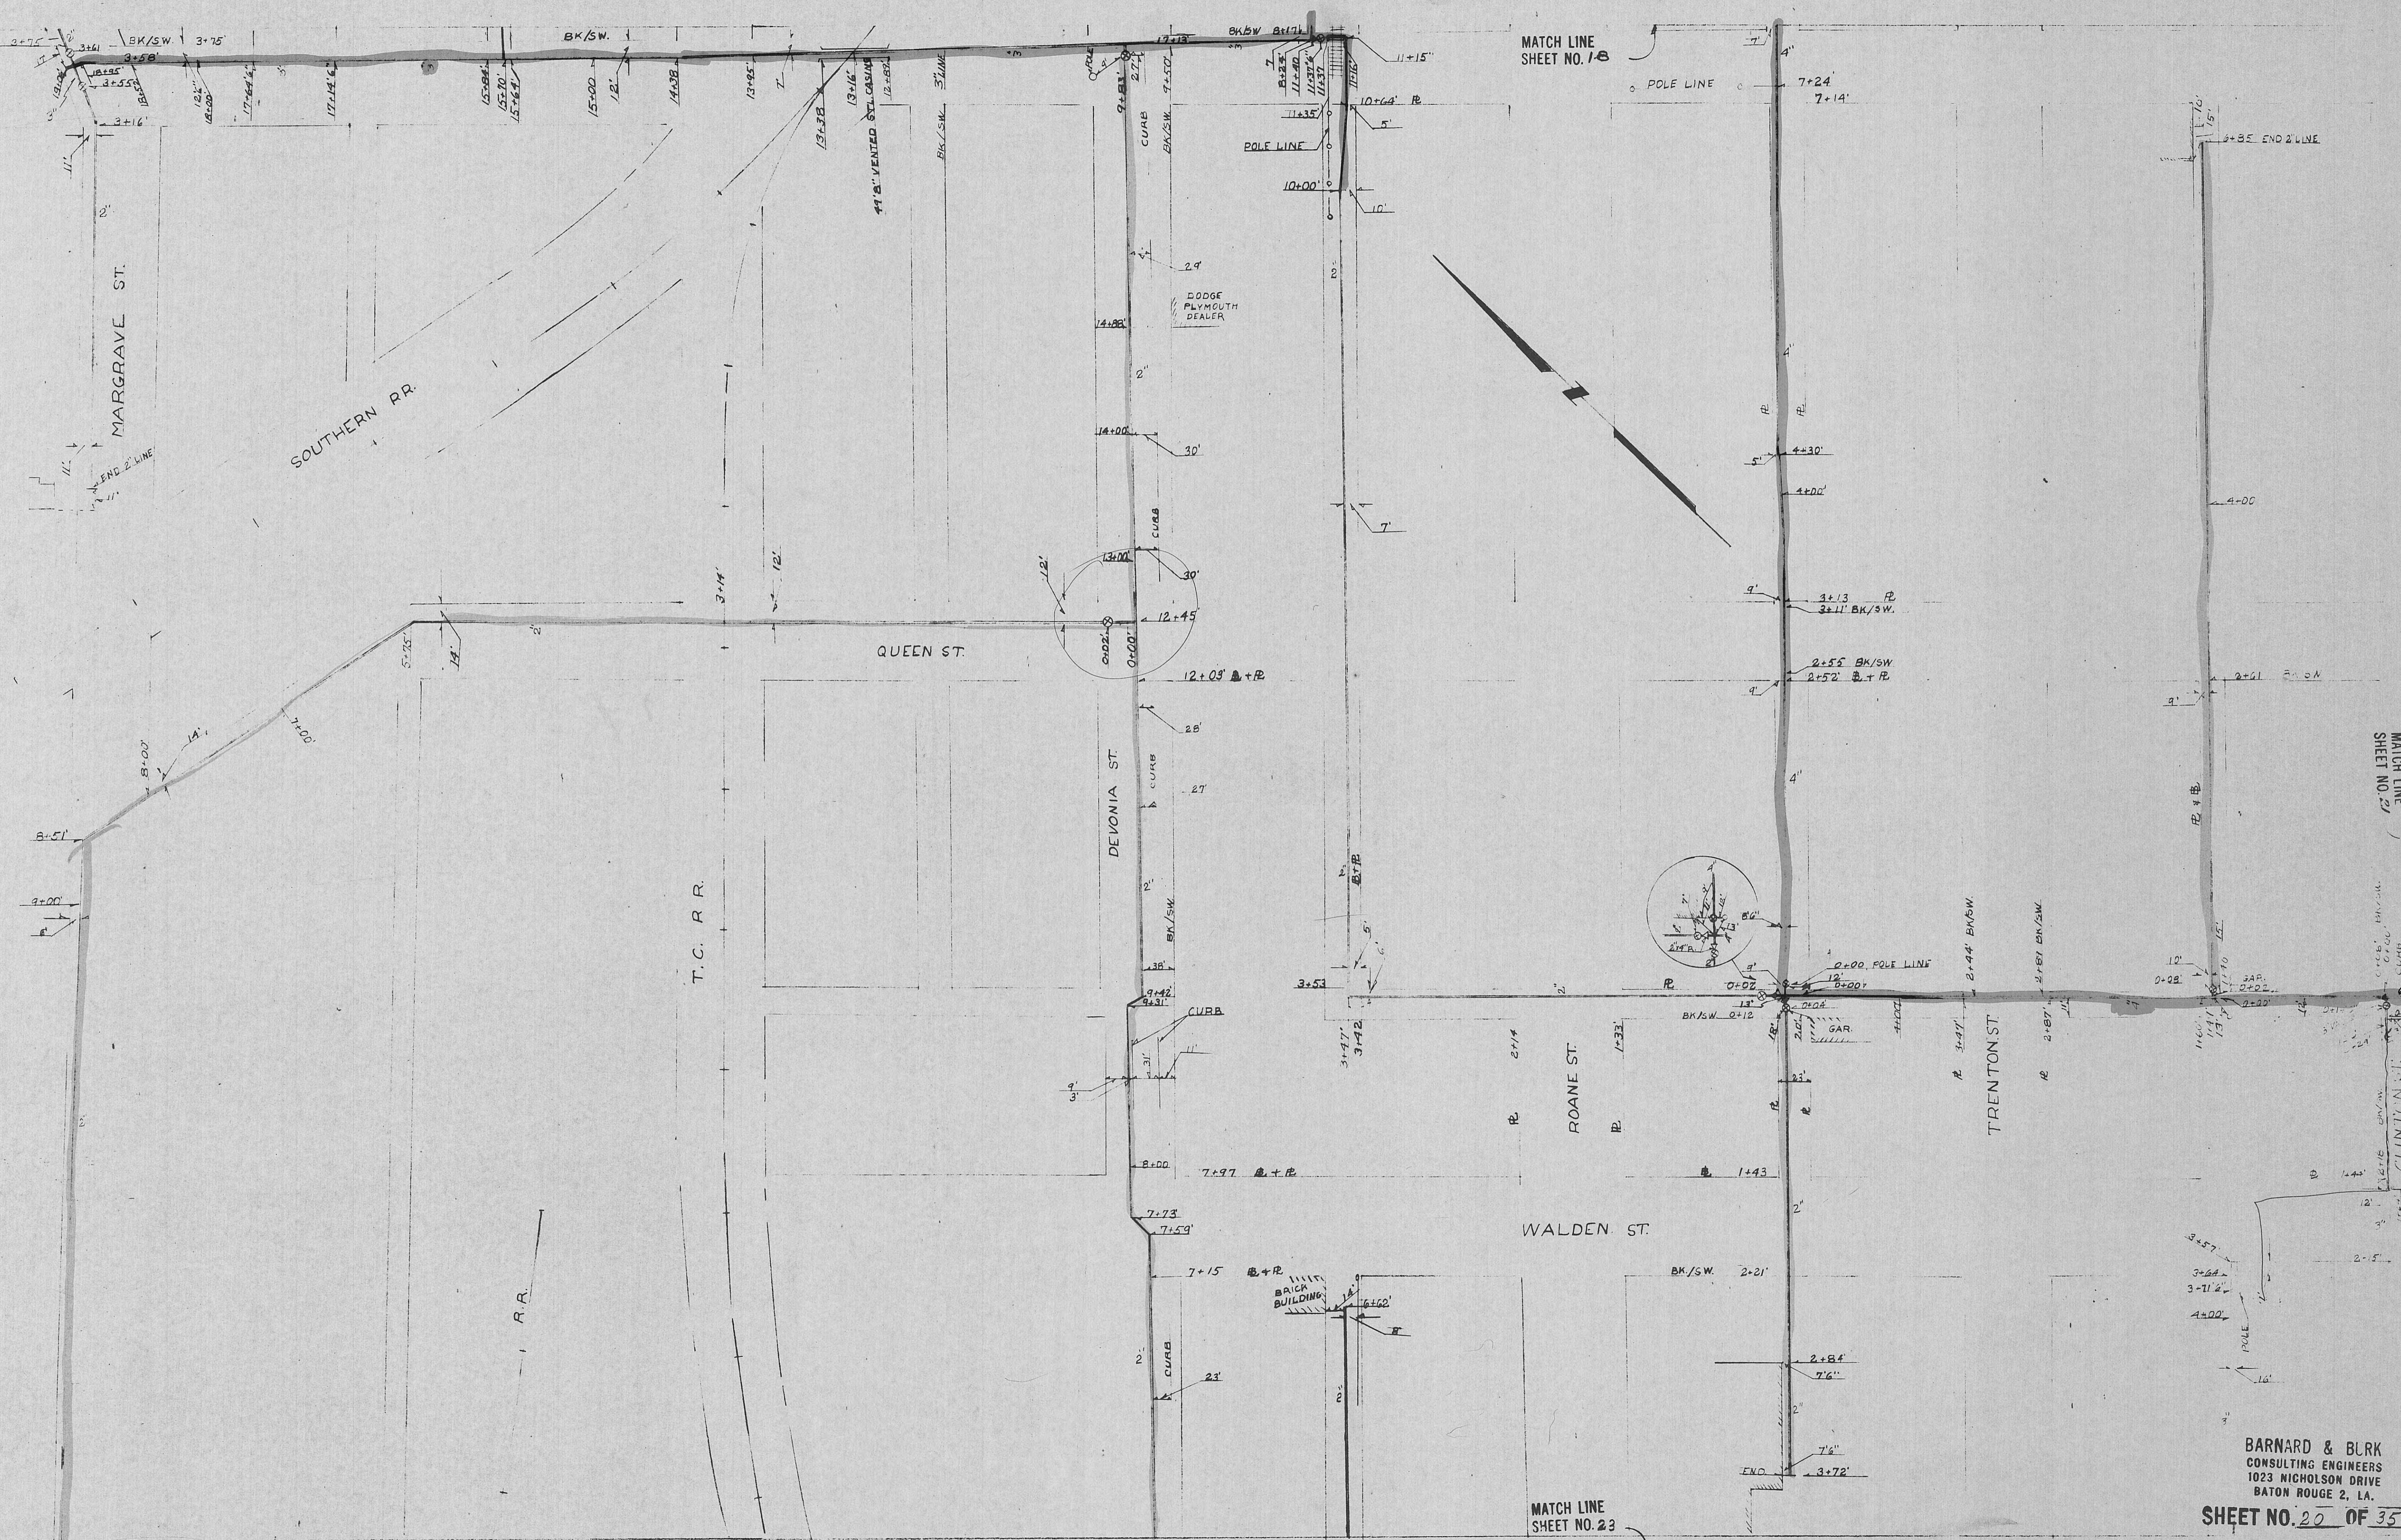

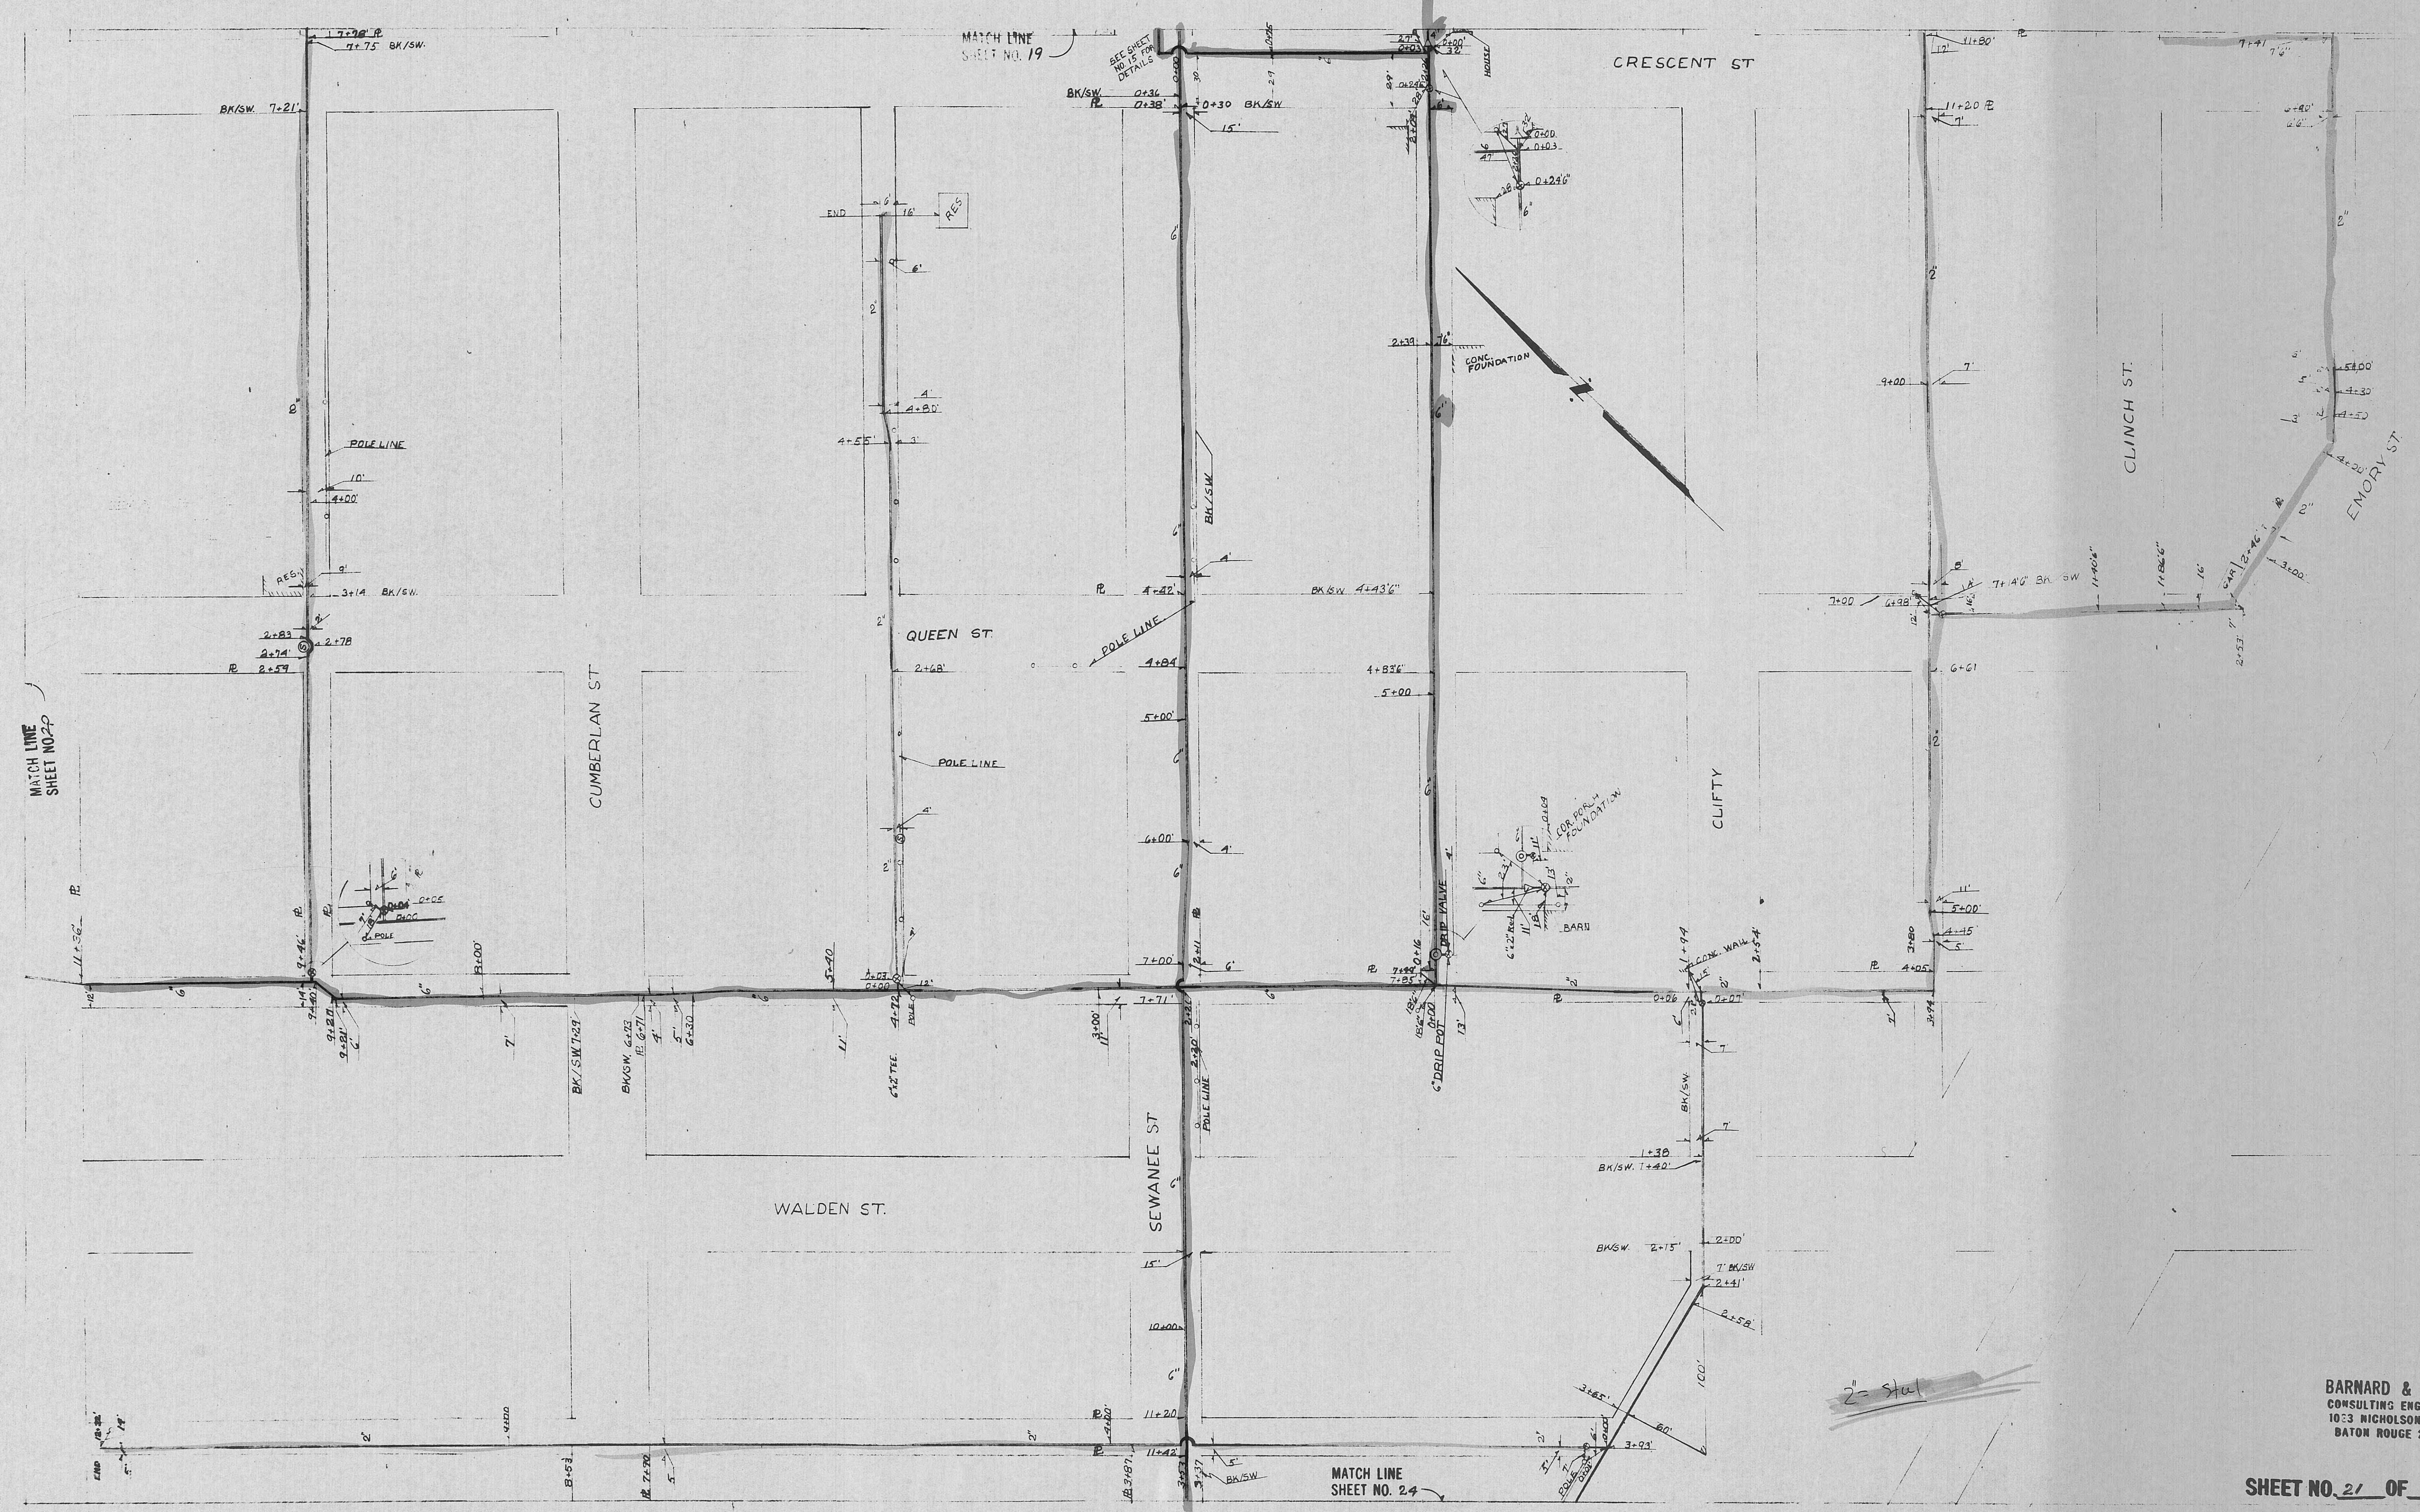

**BARNARD & BURK
CONSULTING ENGINEERS
1033 NICHOLSON DRIVE
BATON ROUGE 2, LA.**

SHEET NO. 21 OF 35

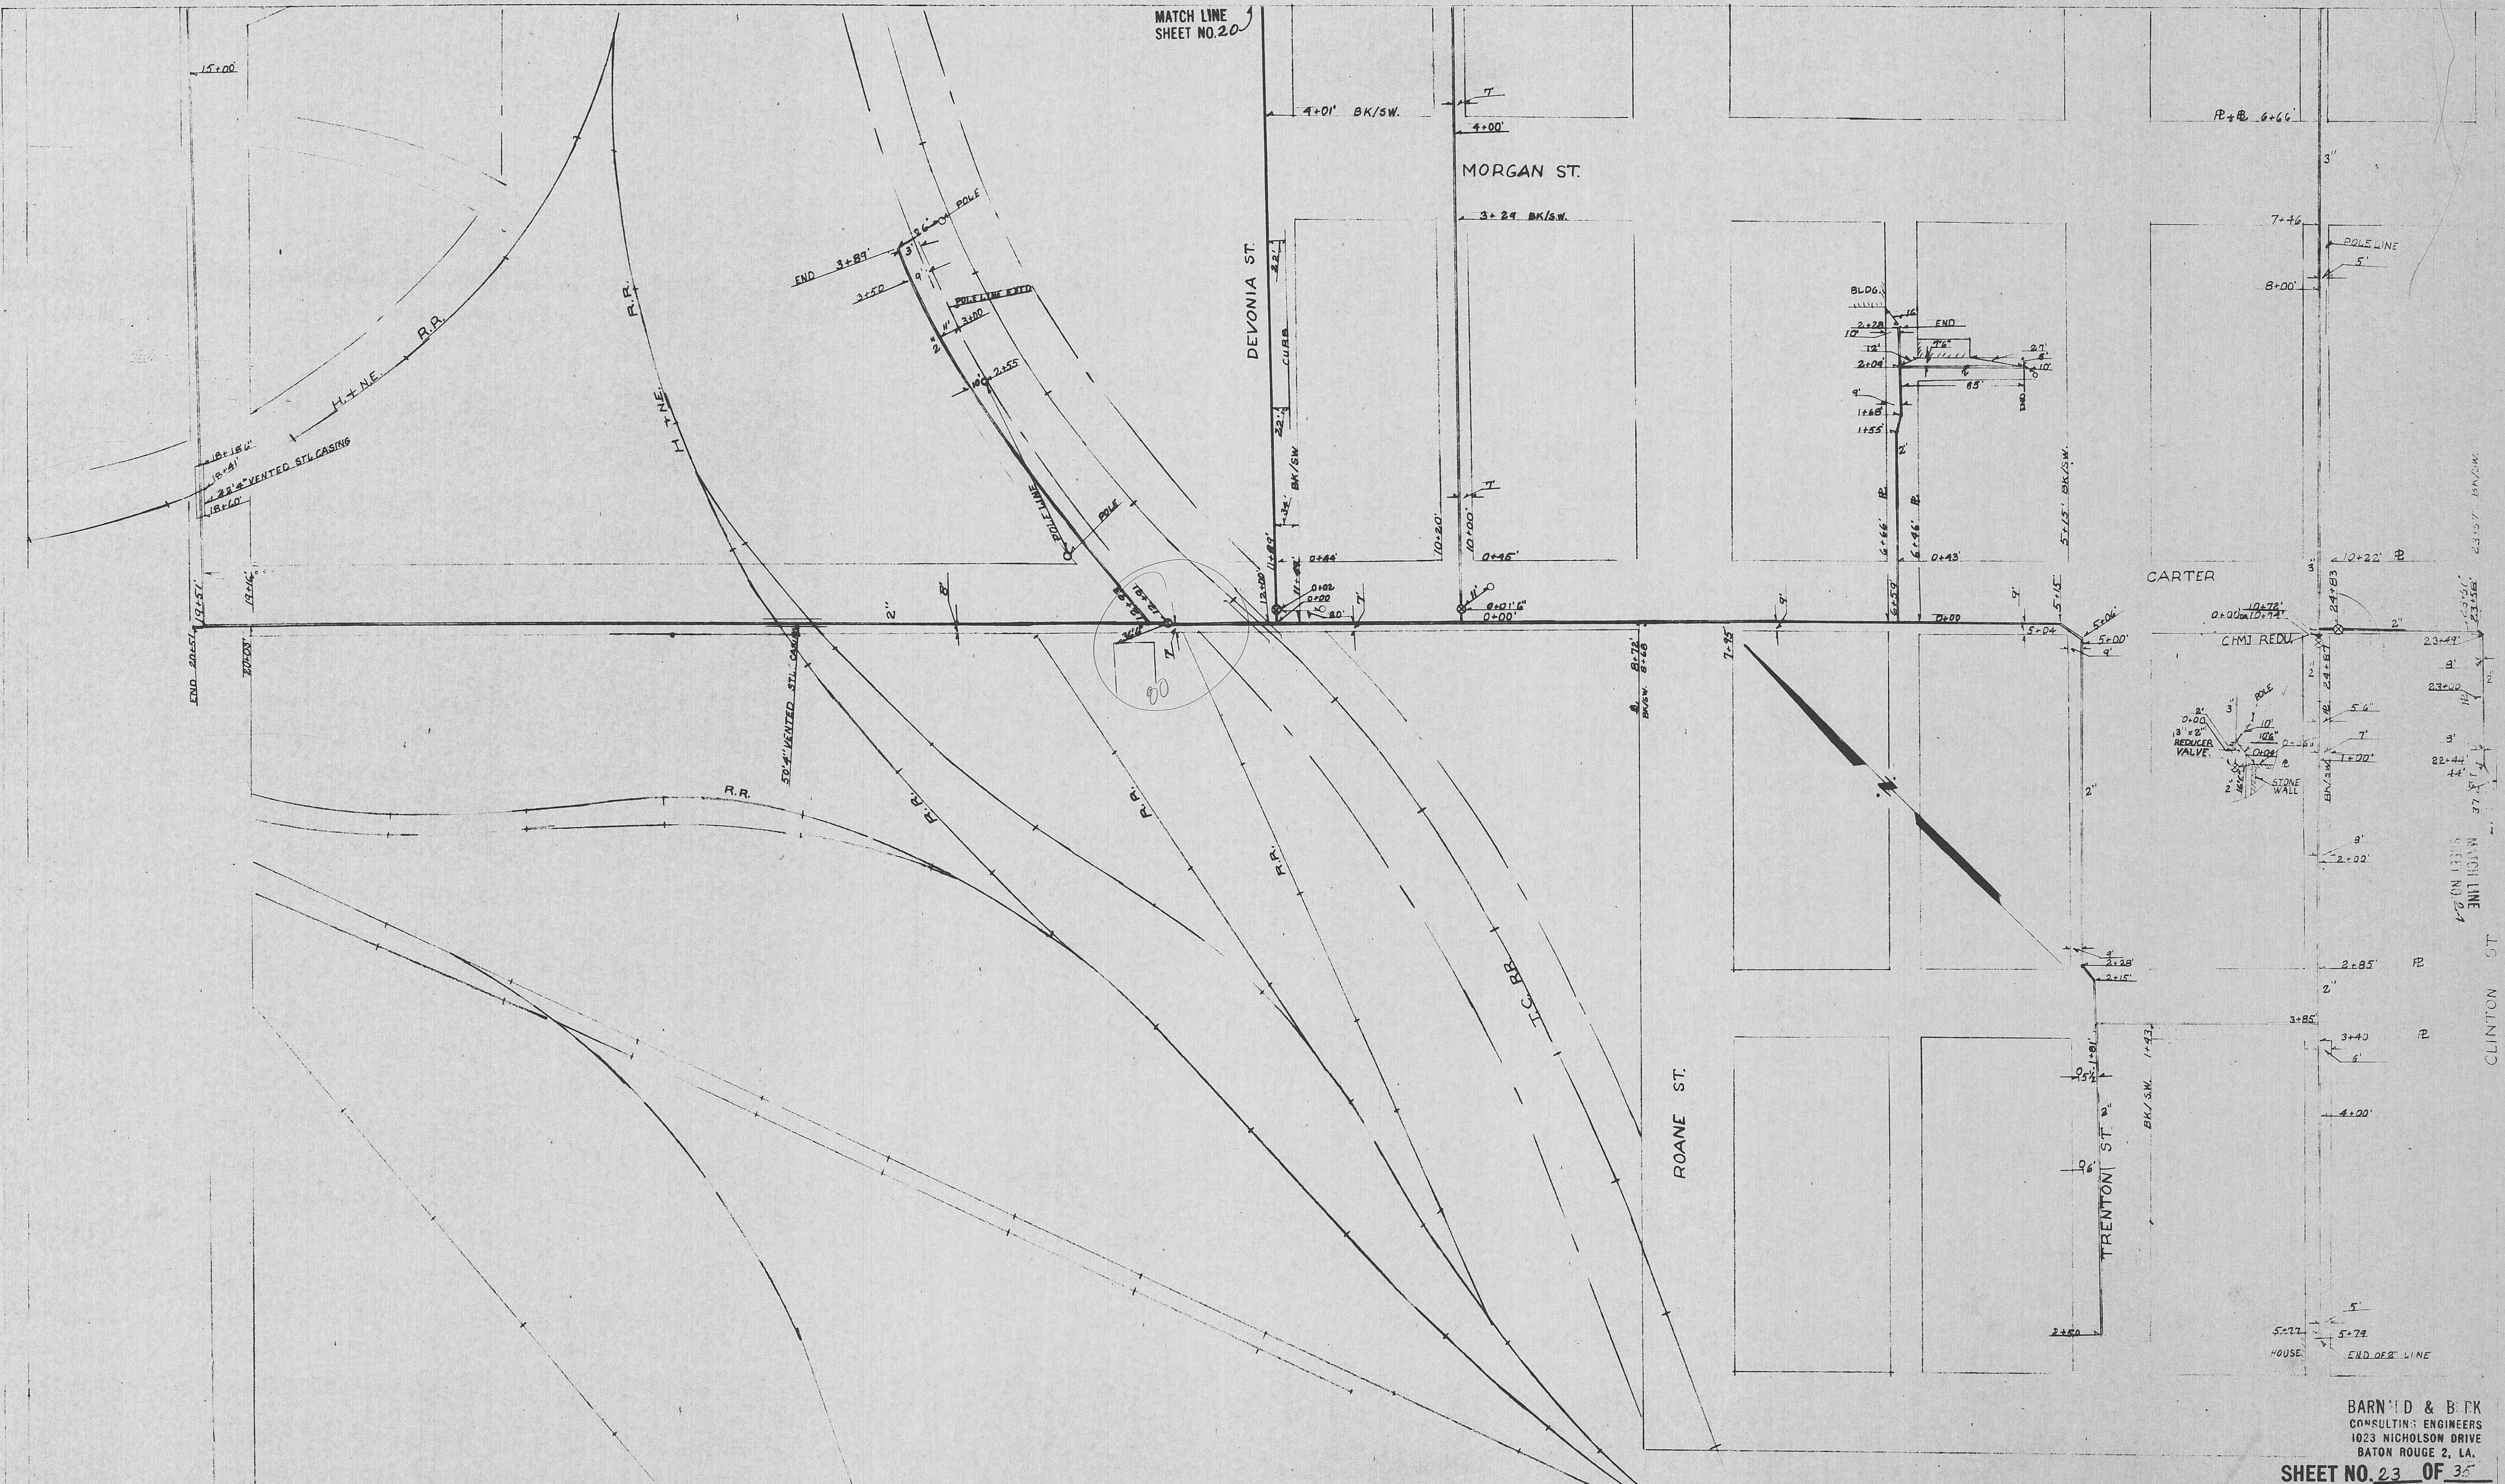

BARNARD & BIRK
CONSULTING ENGINEERS
1023 NICHOLSON DRIVE
BATON ROUGE 2, LA.
NO. 66 85 35

SHEET NO. 23 OF 35

MATCH LINE
SHEET NO. 23

CLINTON
EAST 21° 77'
E 21° 75'
6' " TR

11437

BACK OF SK 19'
6-21-1

MATCH SHEET

MORGAN. ST

CARTER


5' 12' 5' 5'

25

1

**D & BURK
G ENGINEERS
OLSON DRIVE
UIGE 2-14**


SHEET NO. 24 OF 35

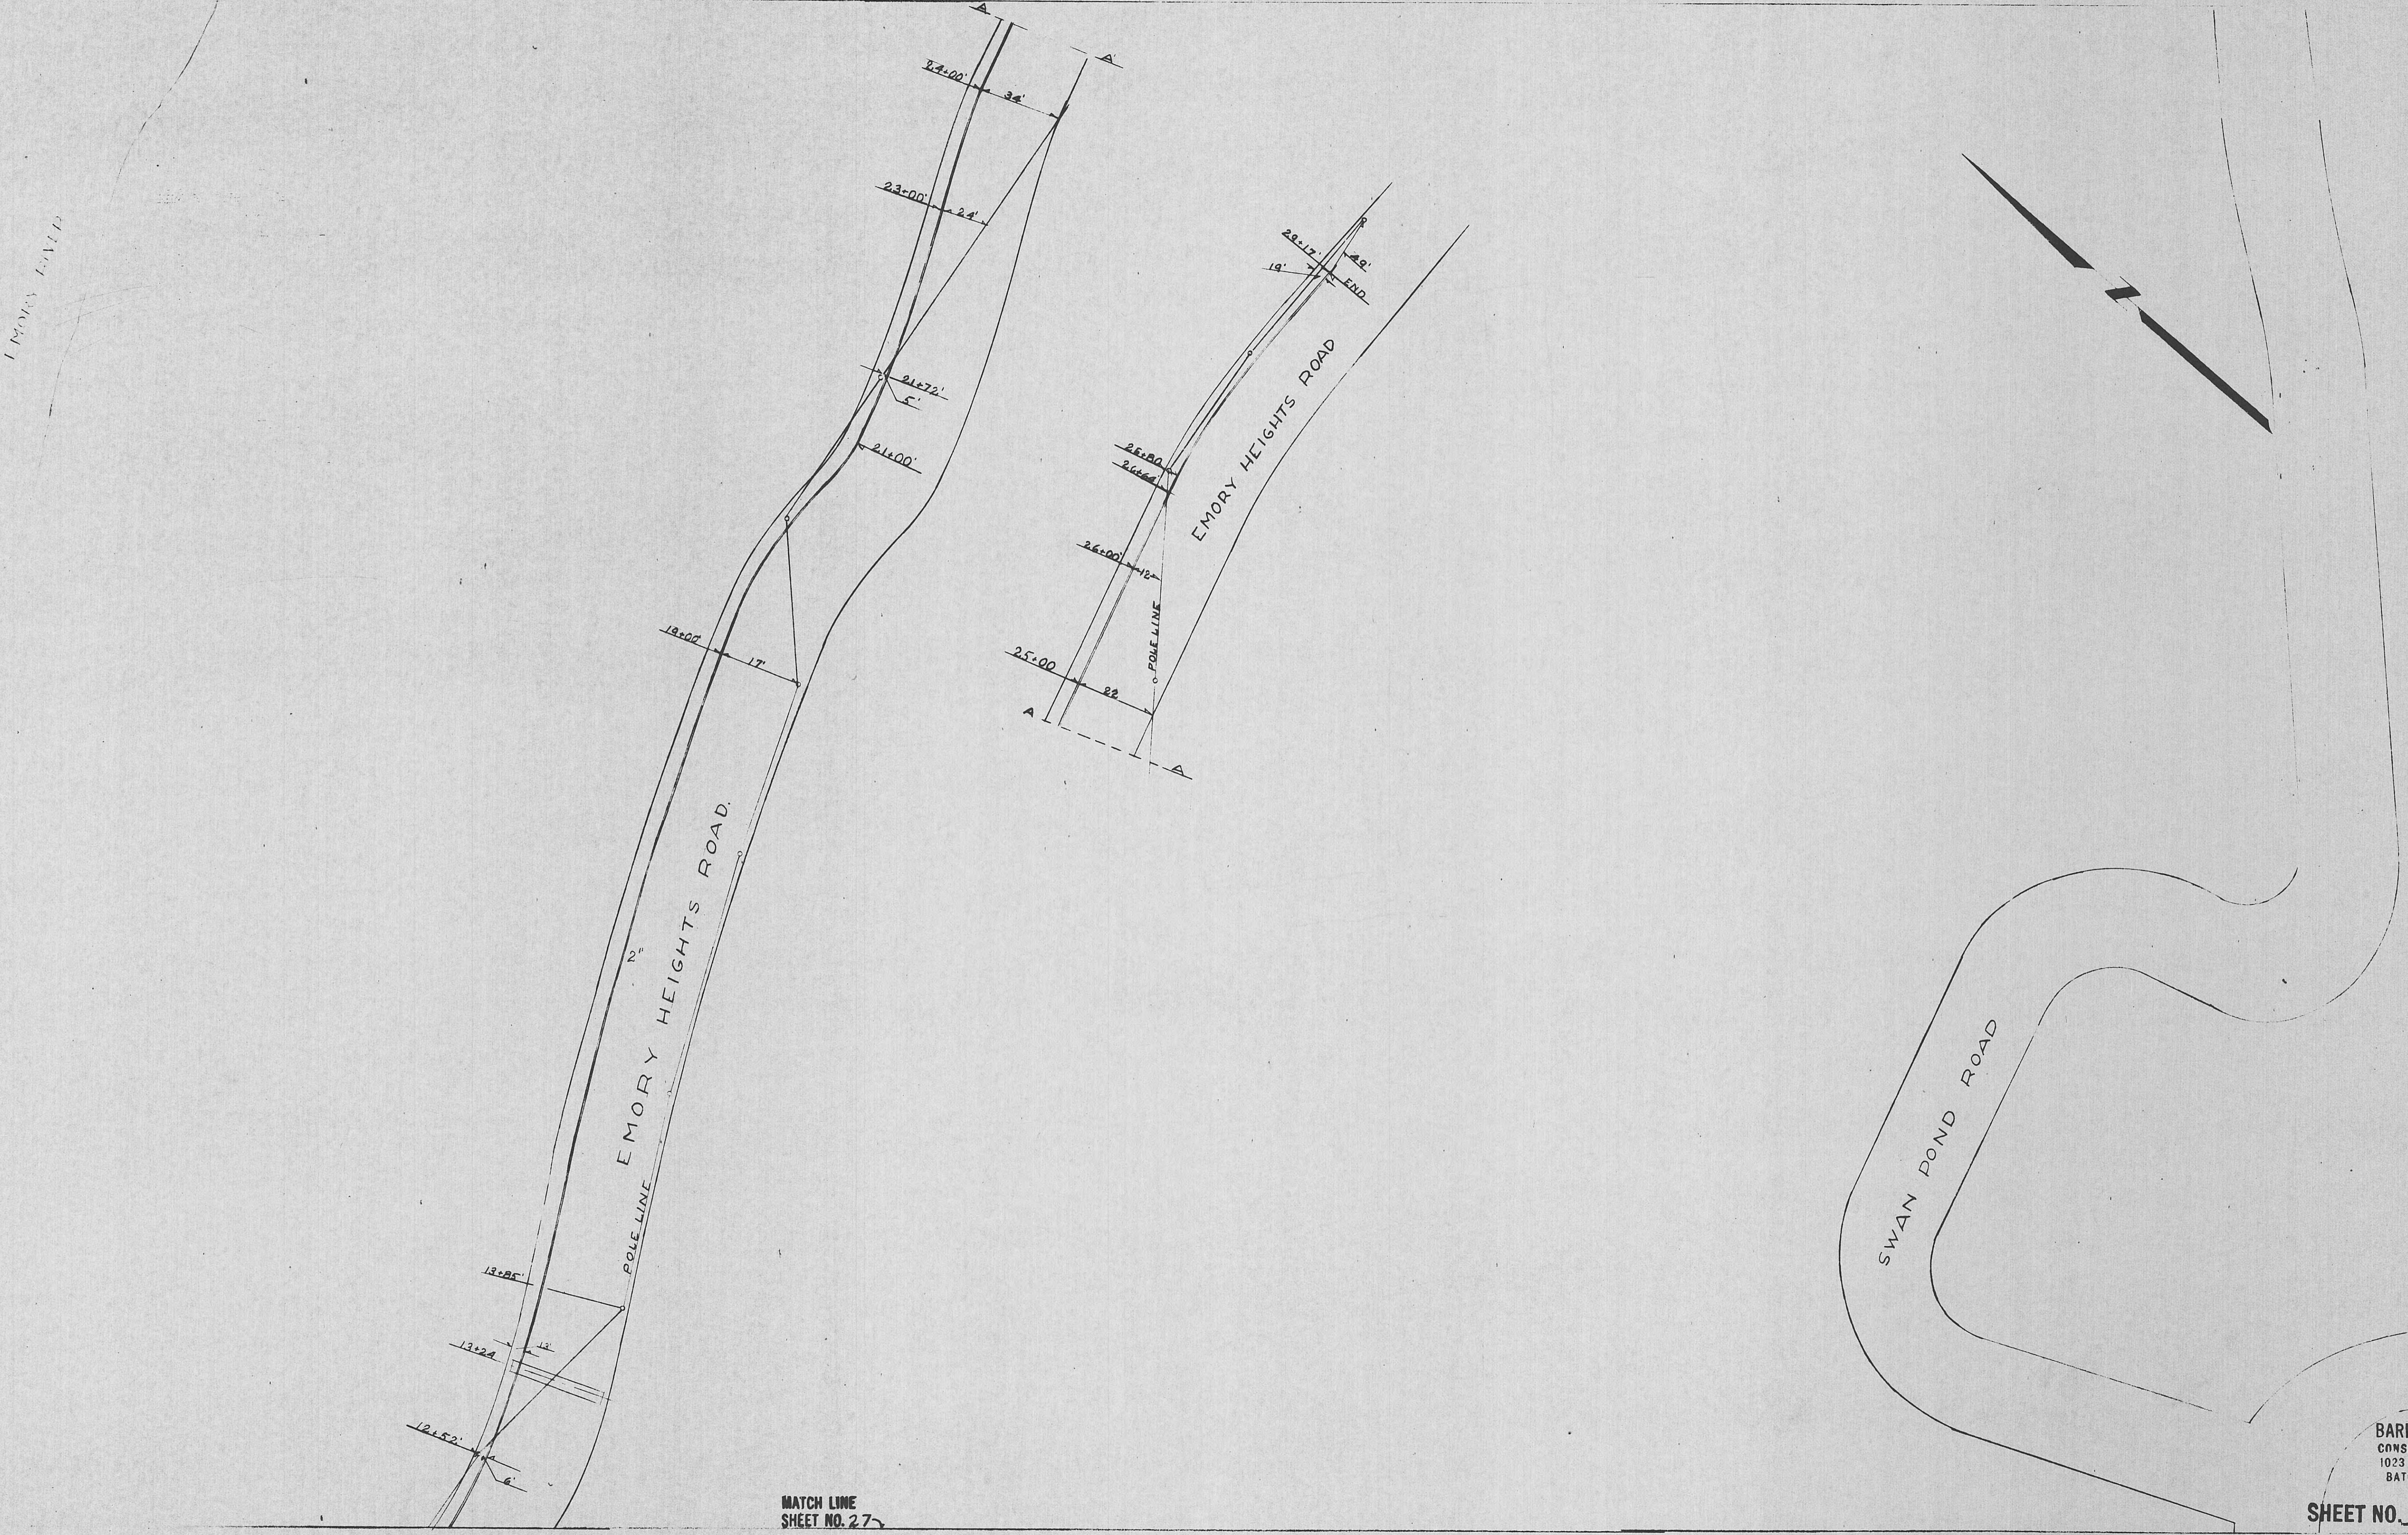

MATCH LINE
 SHEET NO. 27

BARNARD & BURK
 CONSULTING ENGINEERS
 1023 NICHOLSON DRIVE
 BATON ROUGE 2, LA.

SHEET NO. 25 OF 35

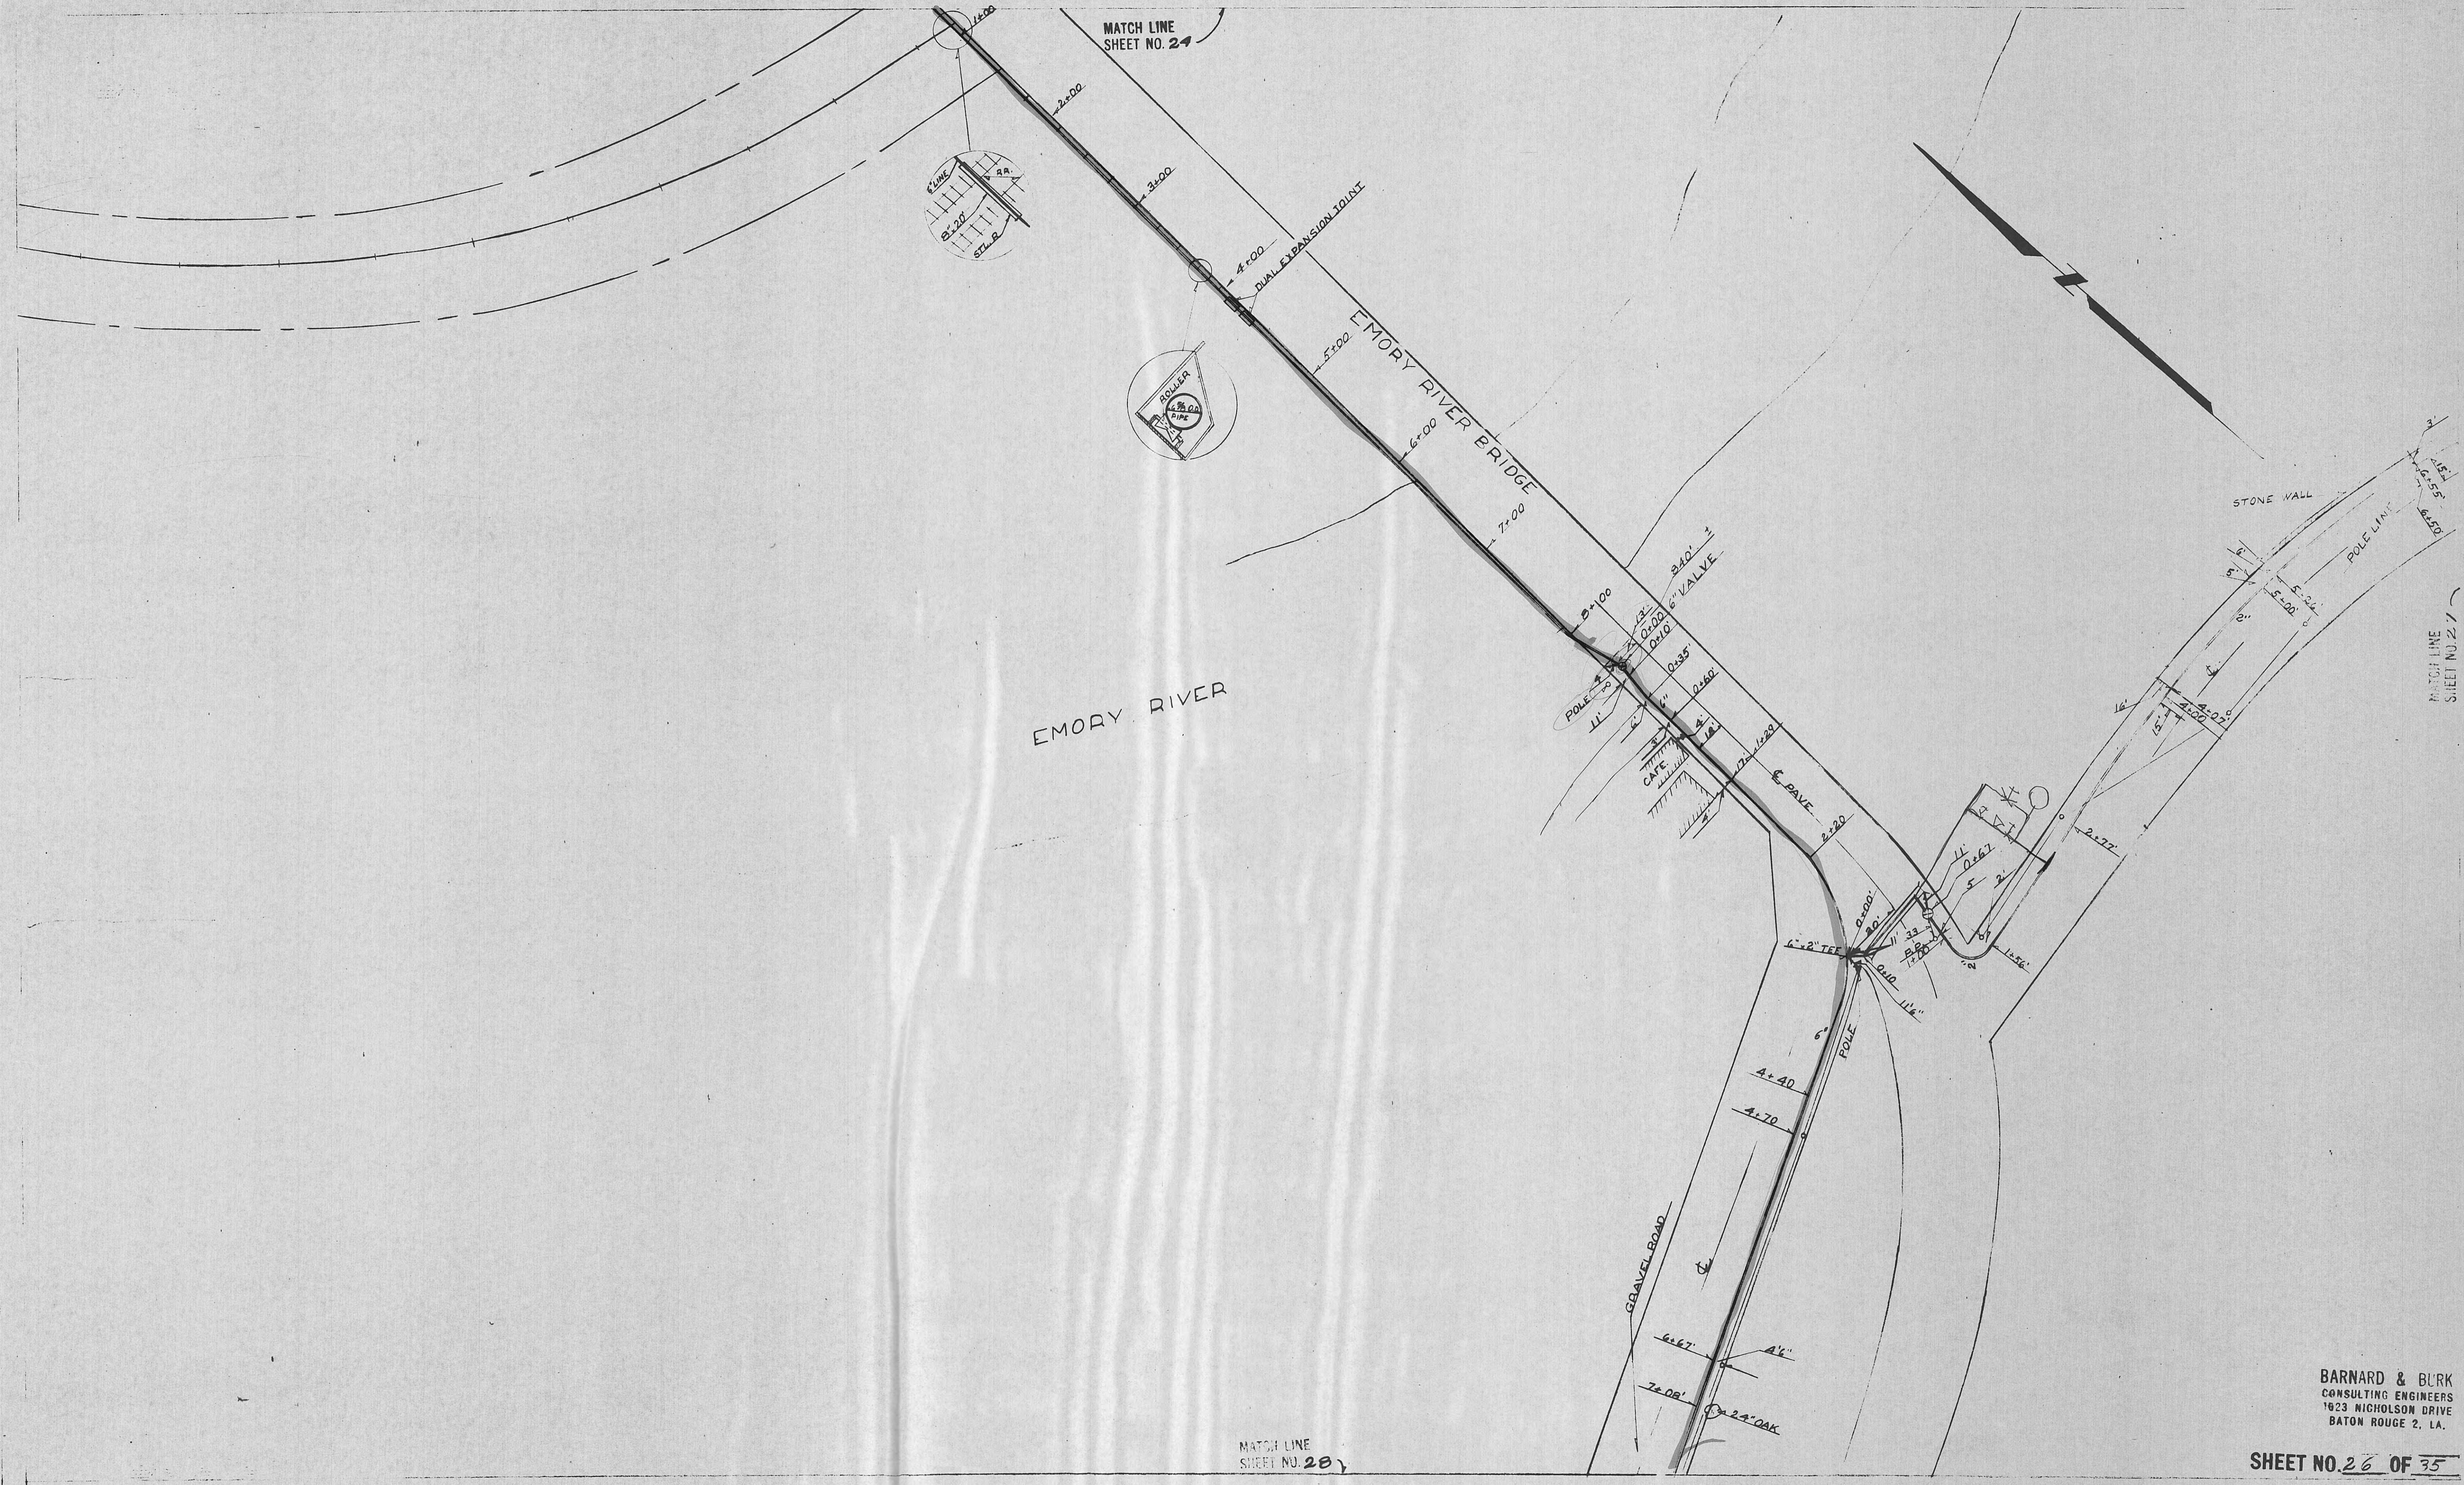

BARNARD & BURK
CONSULTING ENGINEERS
1023 NICHOLSON DRIVE
BATON ROUGE 2, LA.

SHEET NO. 26 OF 35

A hand-drawn site plan for Match Line Sheet No. 25. The plan shows a road network with several labeled components:


- POWER POLE**: Located at 9+36' and 9+00'.
- 2" VALVE**: Located at 0+10'.
- PAVE**: A section of road labeled "PAVE" with dimensions 25' and 20'.
- END**: A point marked at the end of a line.
- ROCK WALL**: A wall labeled "ROCK WALL" with a height of 2'.
- HOUSE**: A building labeled "HOUSE".
- STEPS**: Stairs labeled "STEPS".
- REFS.**: Reference points labeled "REFS." with a distance of 20'.


The plan also includes elevation markings such as 8+00', 0+40', 0+33', 0+38', 0+47', 0+50', 0+59', 1+00', 1+90', 2+50', 2+51', and 3+51'. Roads are labeled with names like "EMORY" and "HEIGHTS ROAD". A vertical line on the left is labeled "HIGH ST." at the bottom.


ROAD TO SWAN POND


**BARNARD & BURK
CONSULTING ENGINEERS
1023 NICHOLSON DRIVE
BATON ROUGE 2, LA.**

SHEET NO. 27 OF 35

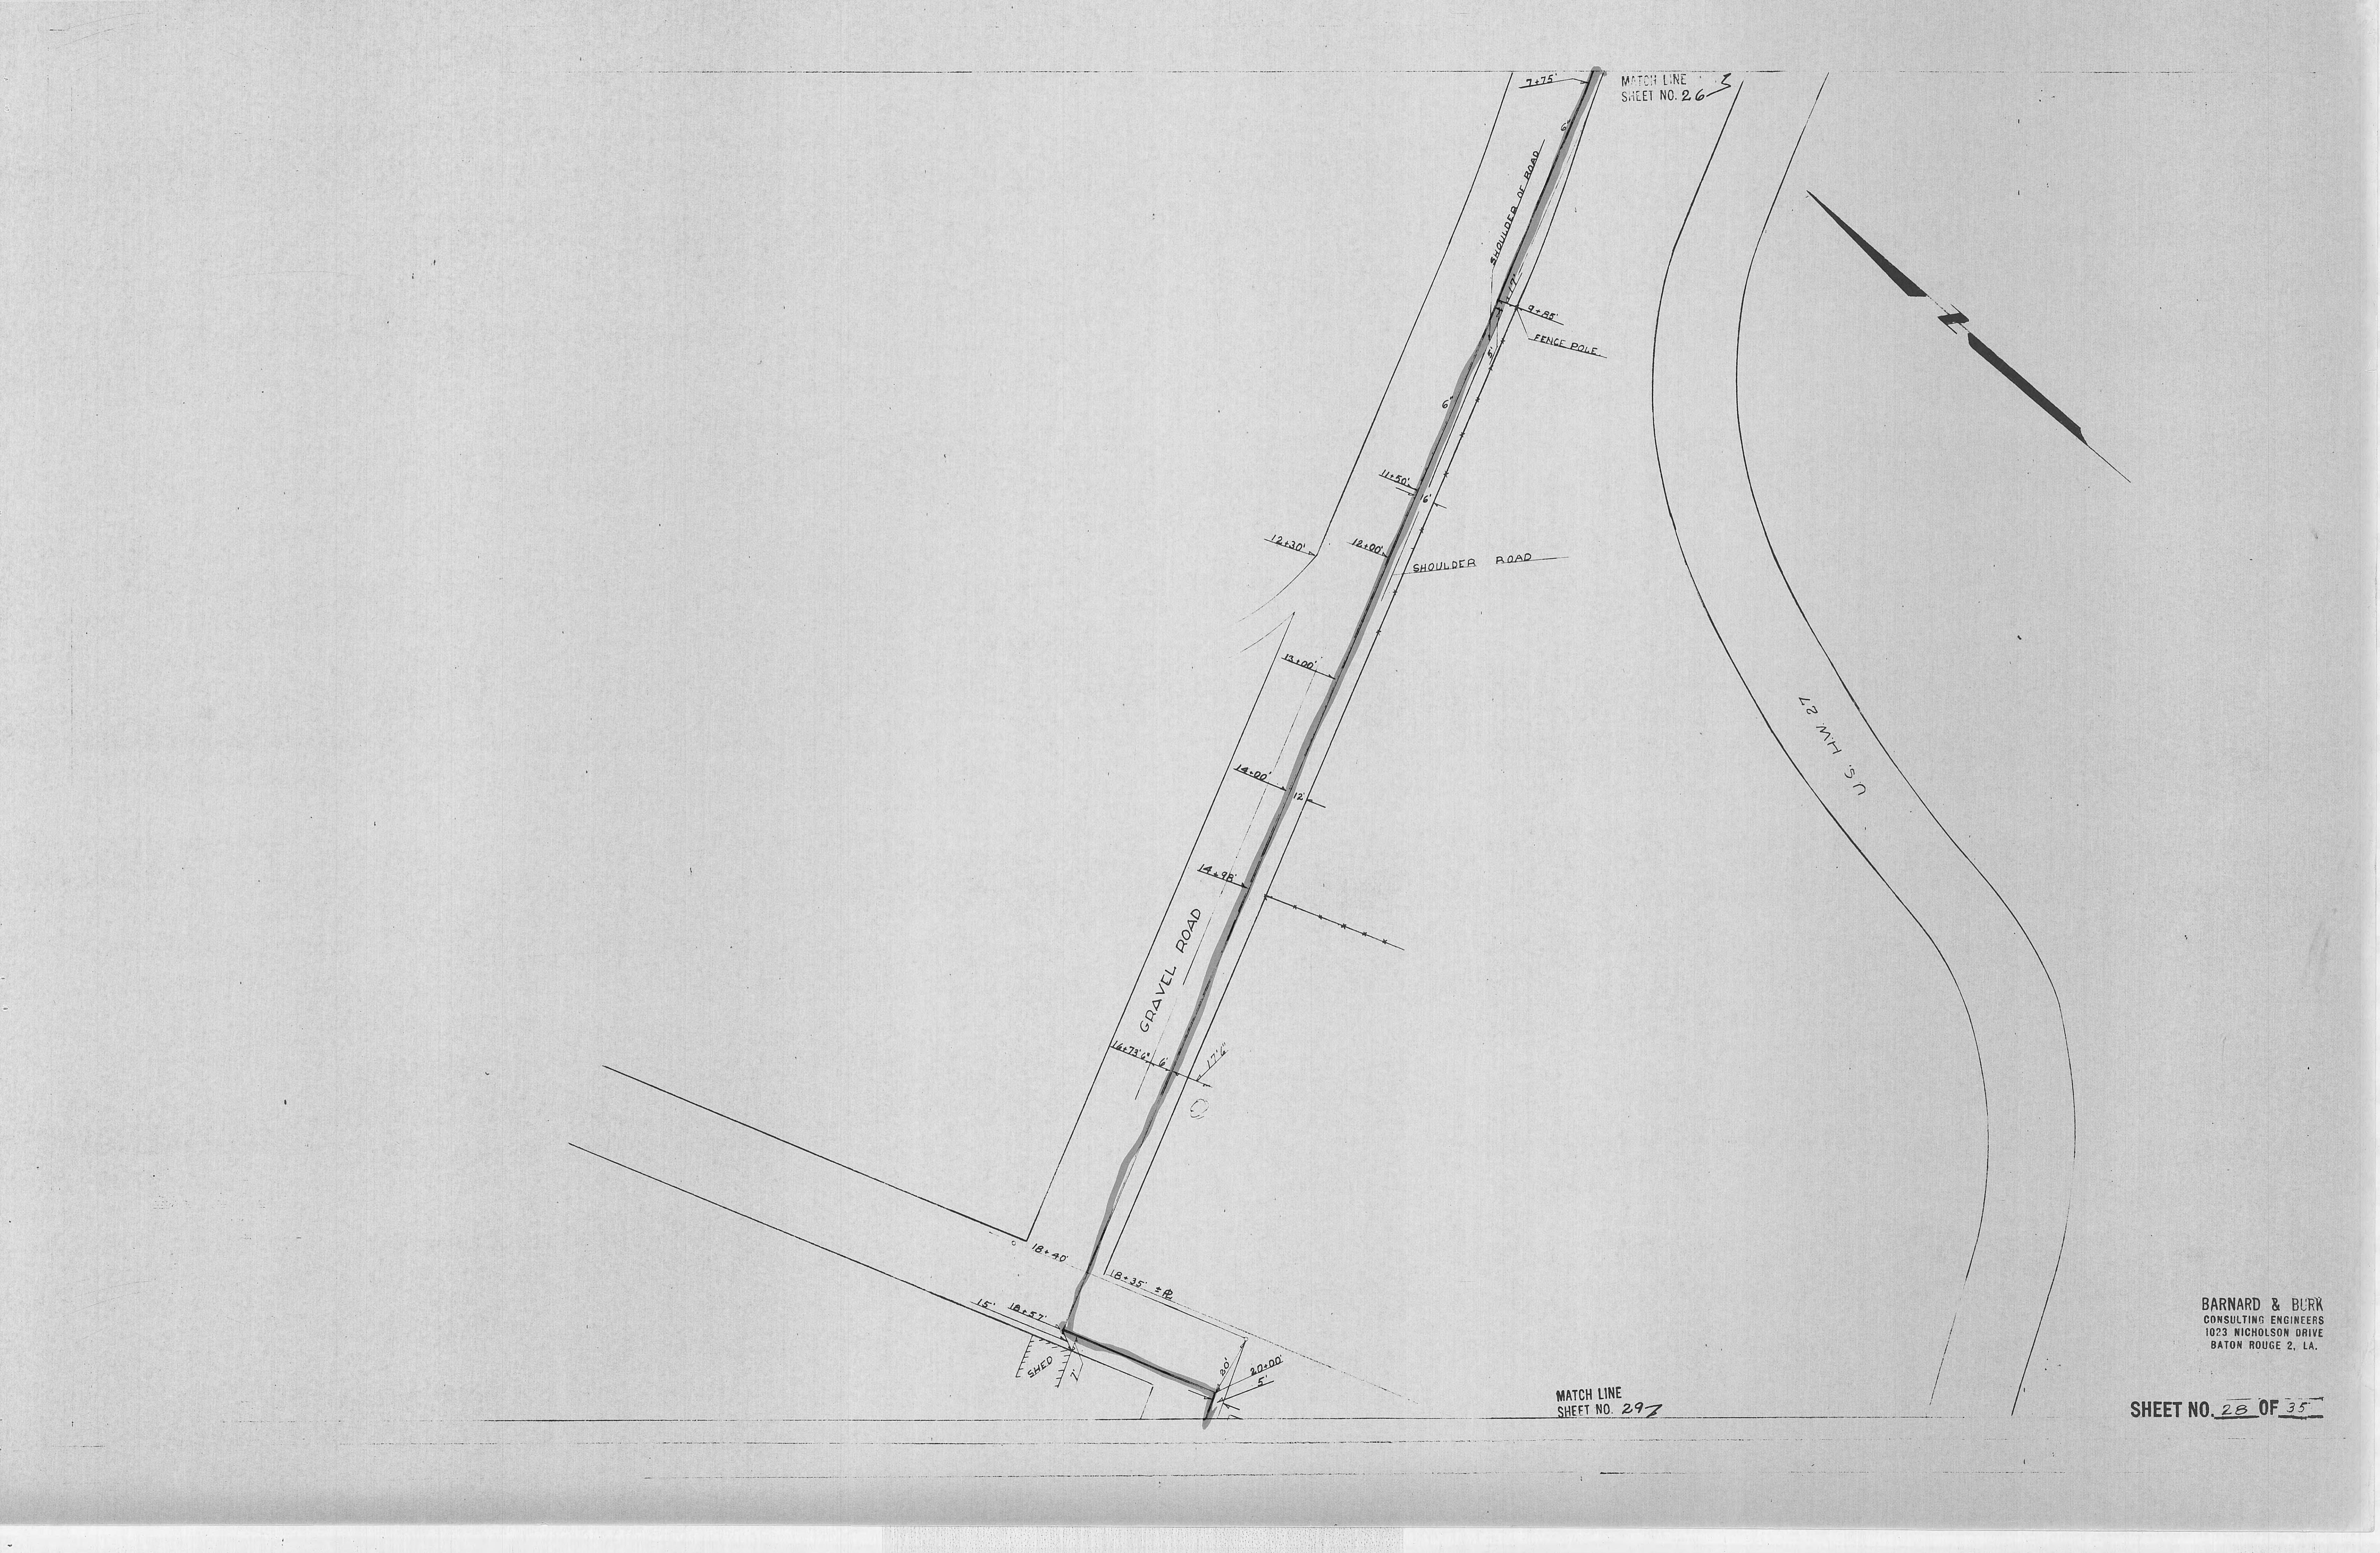

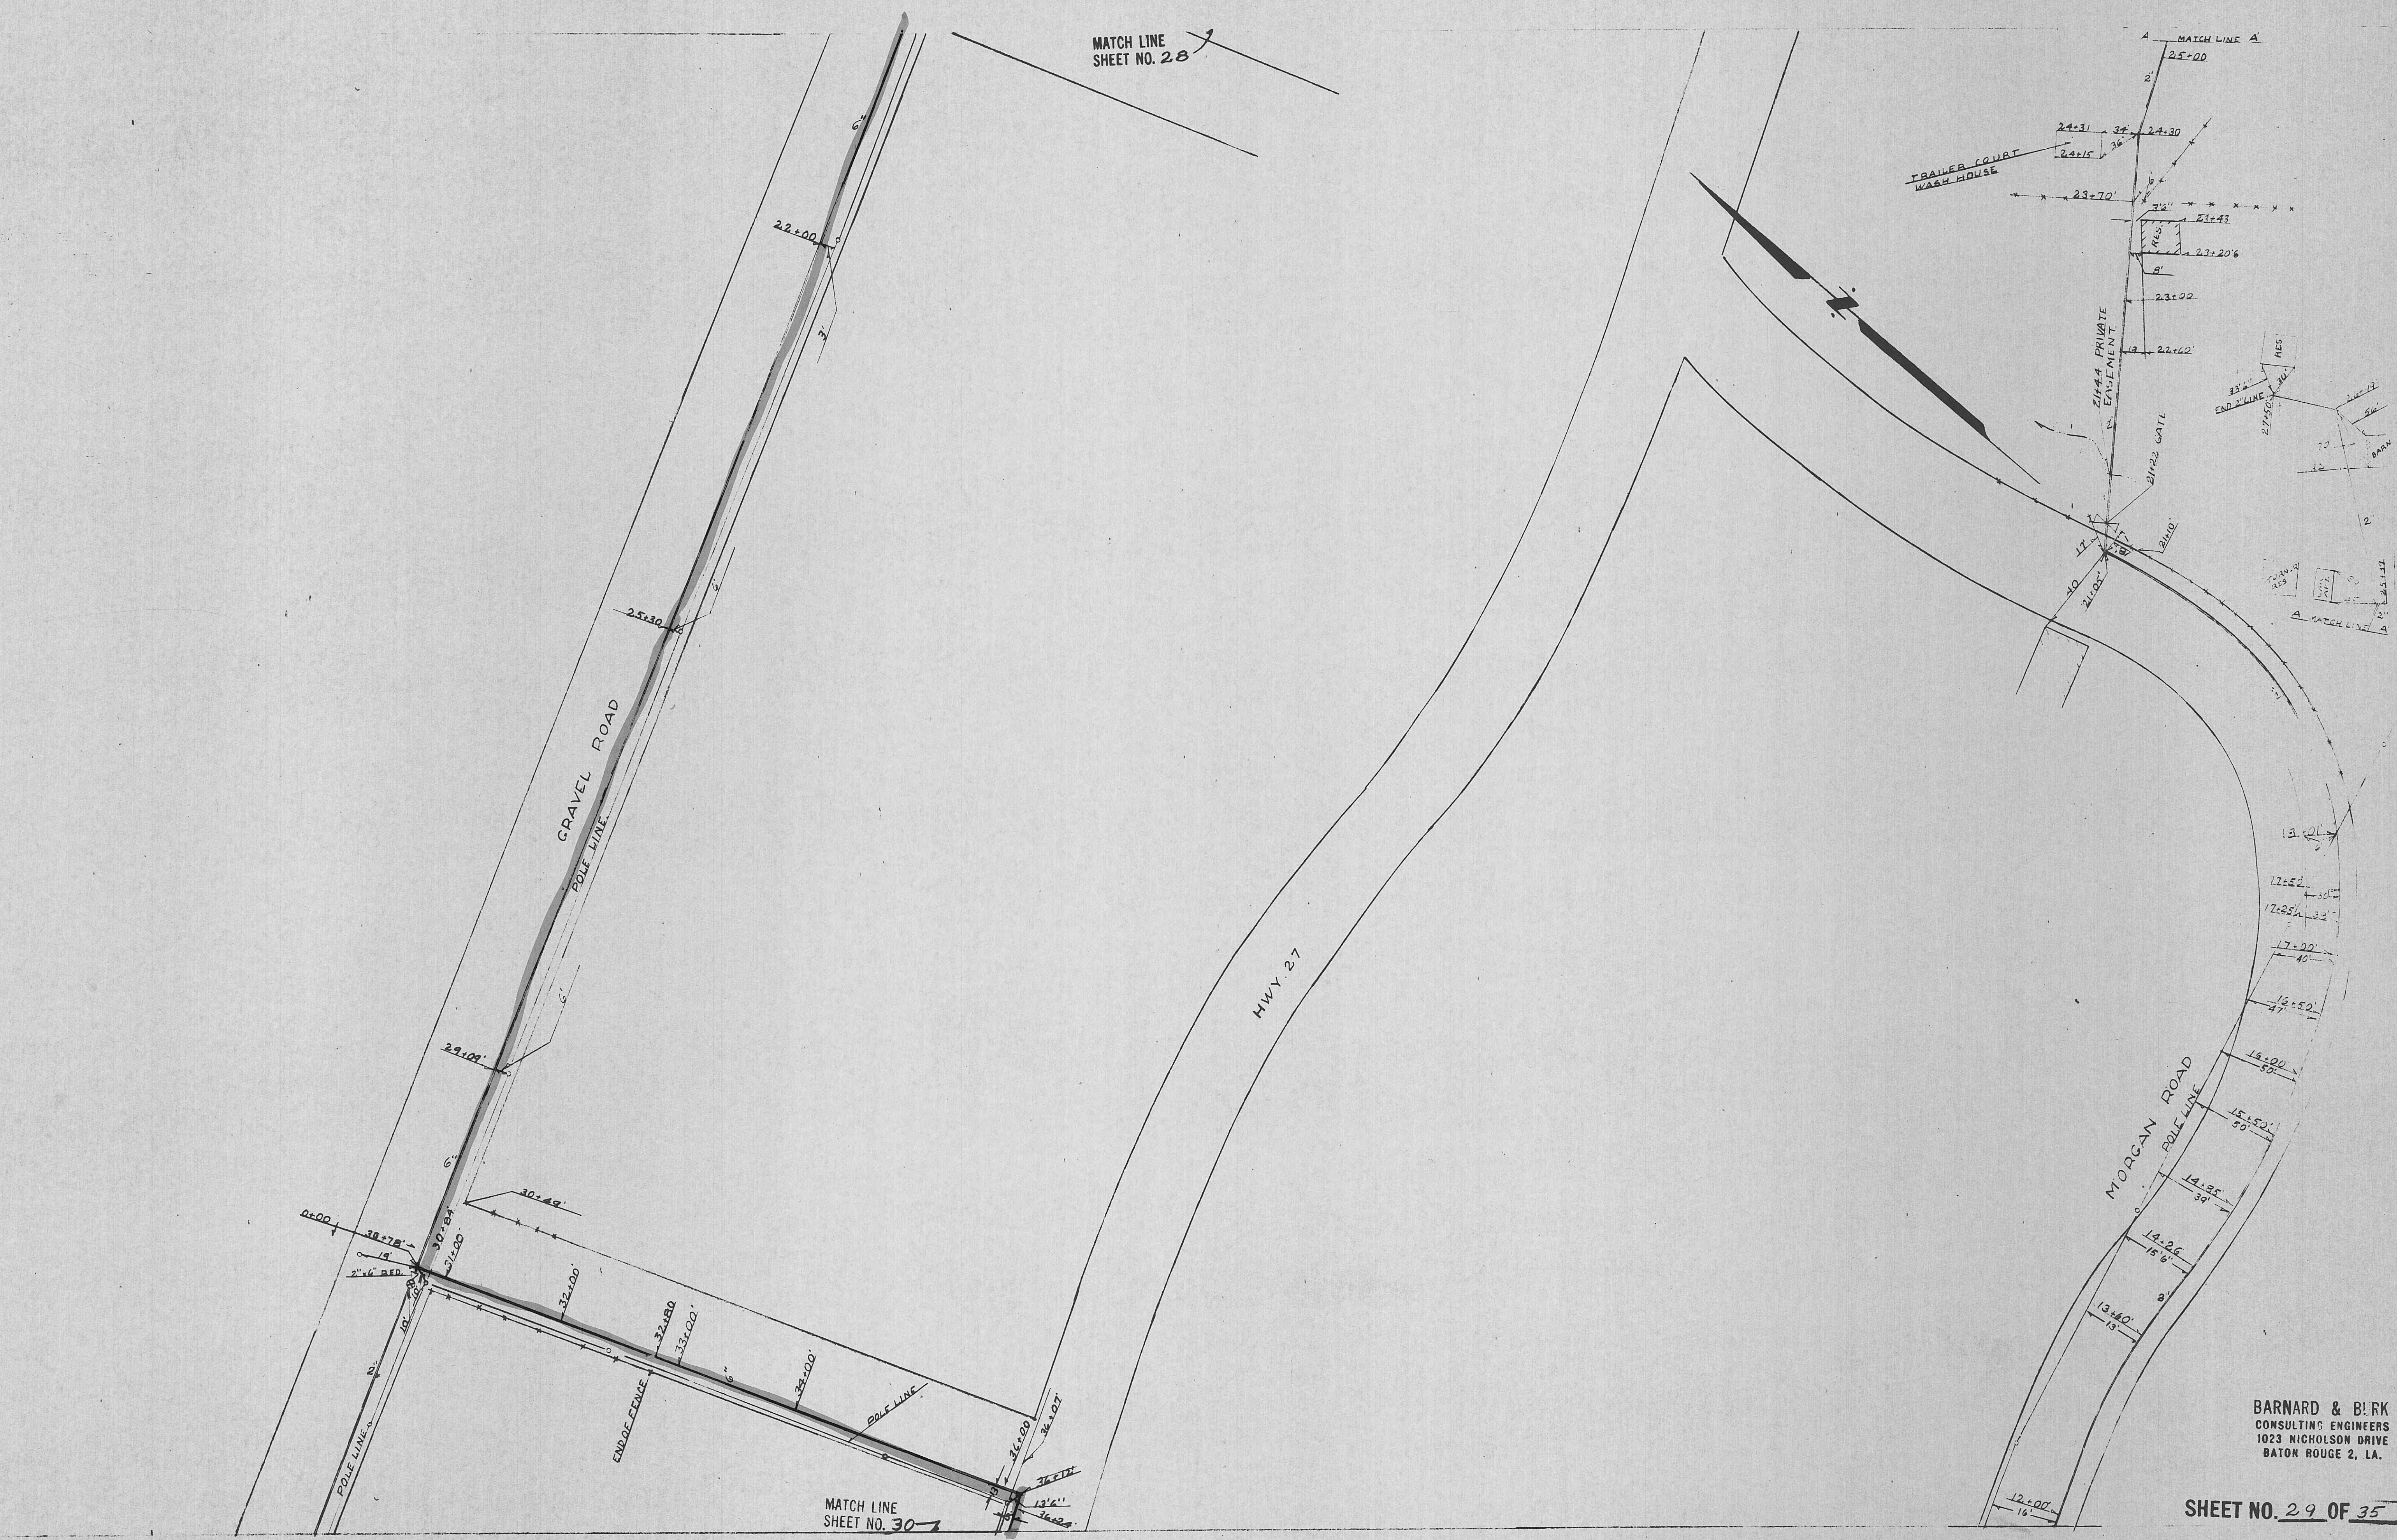


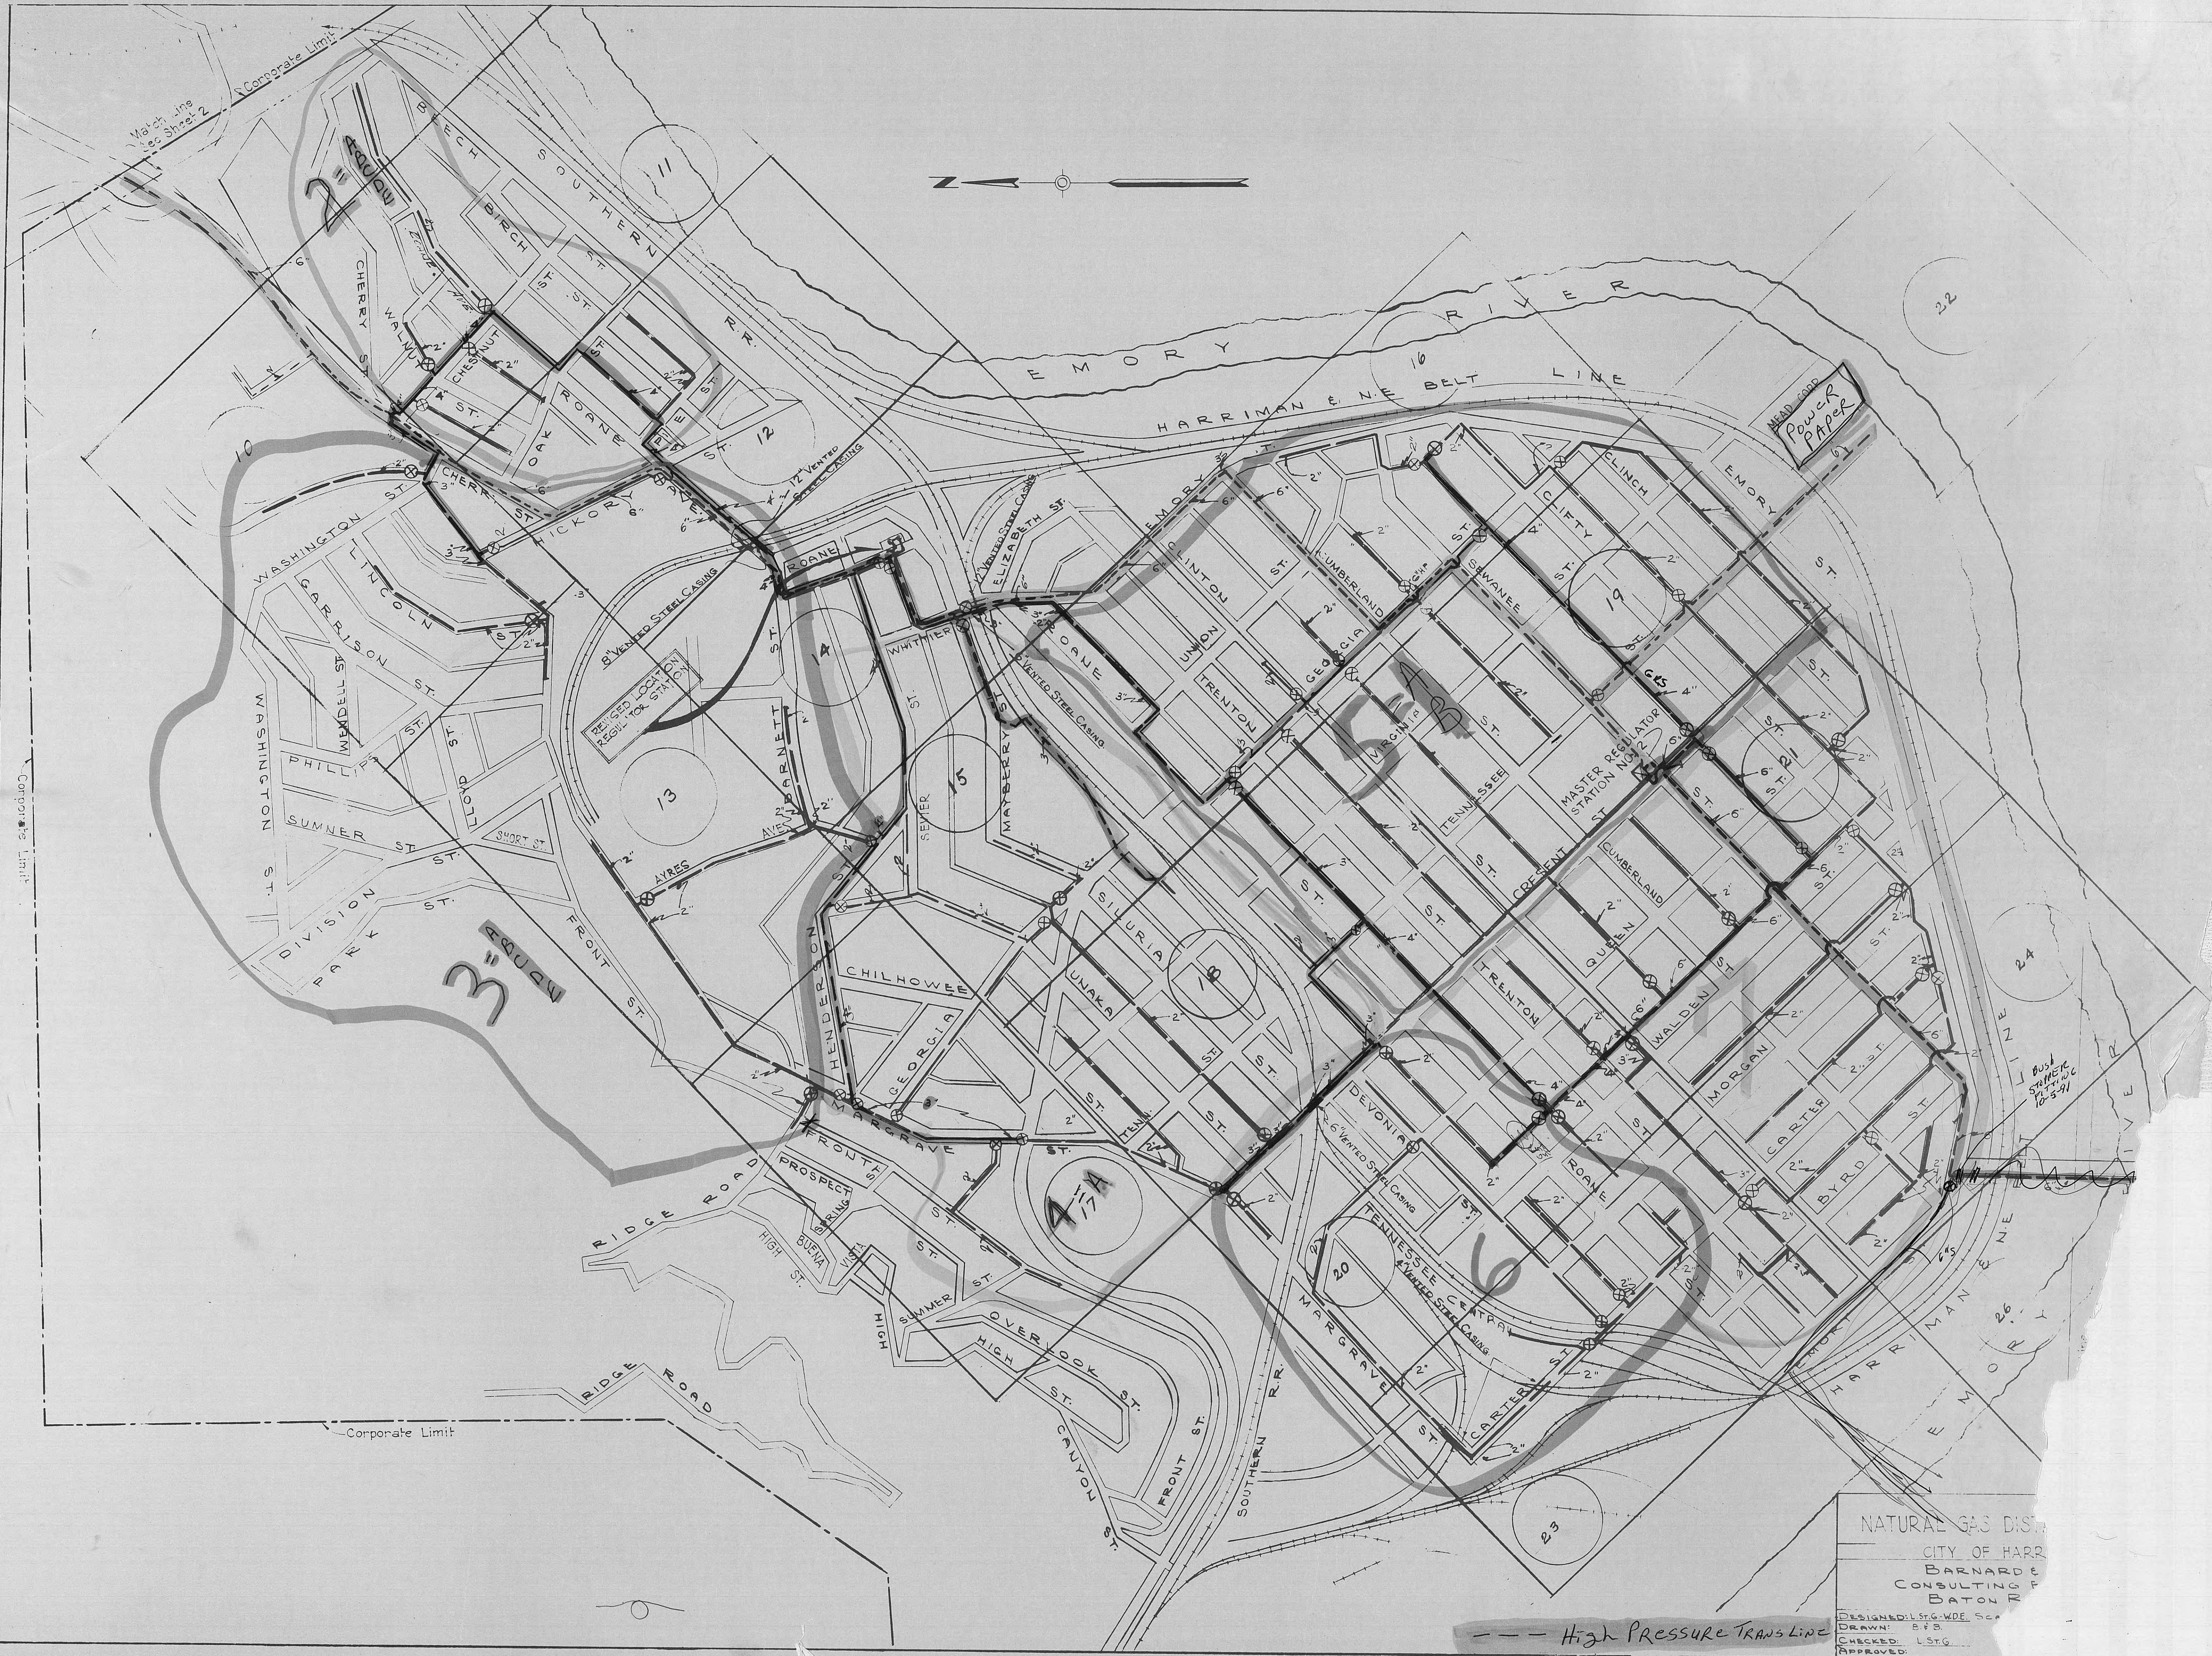

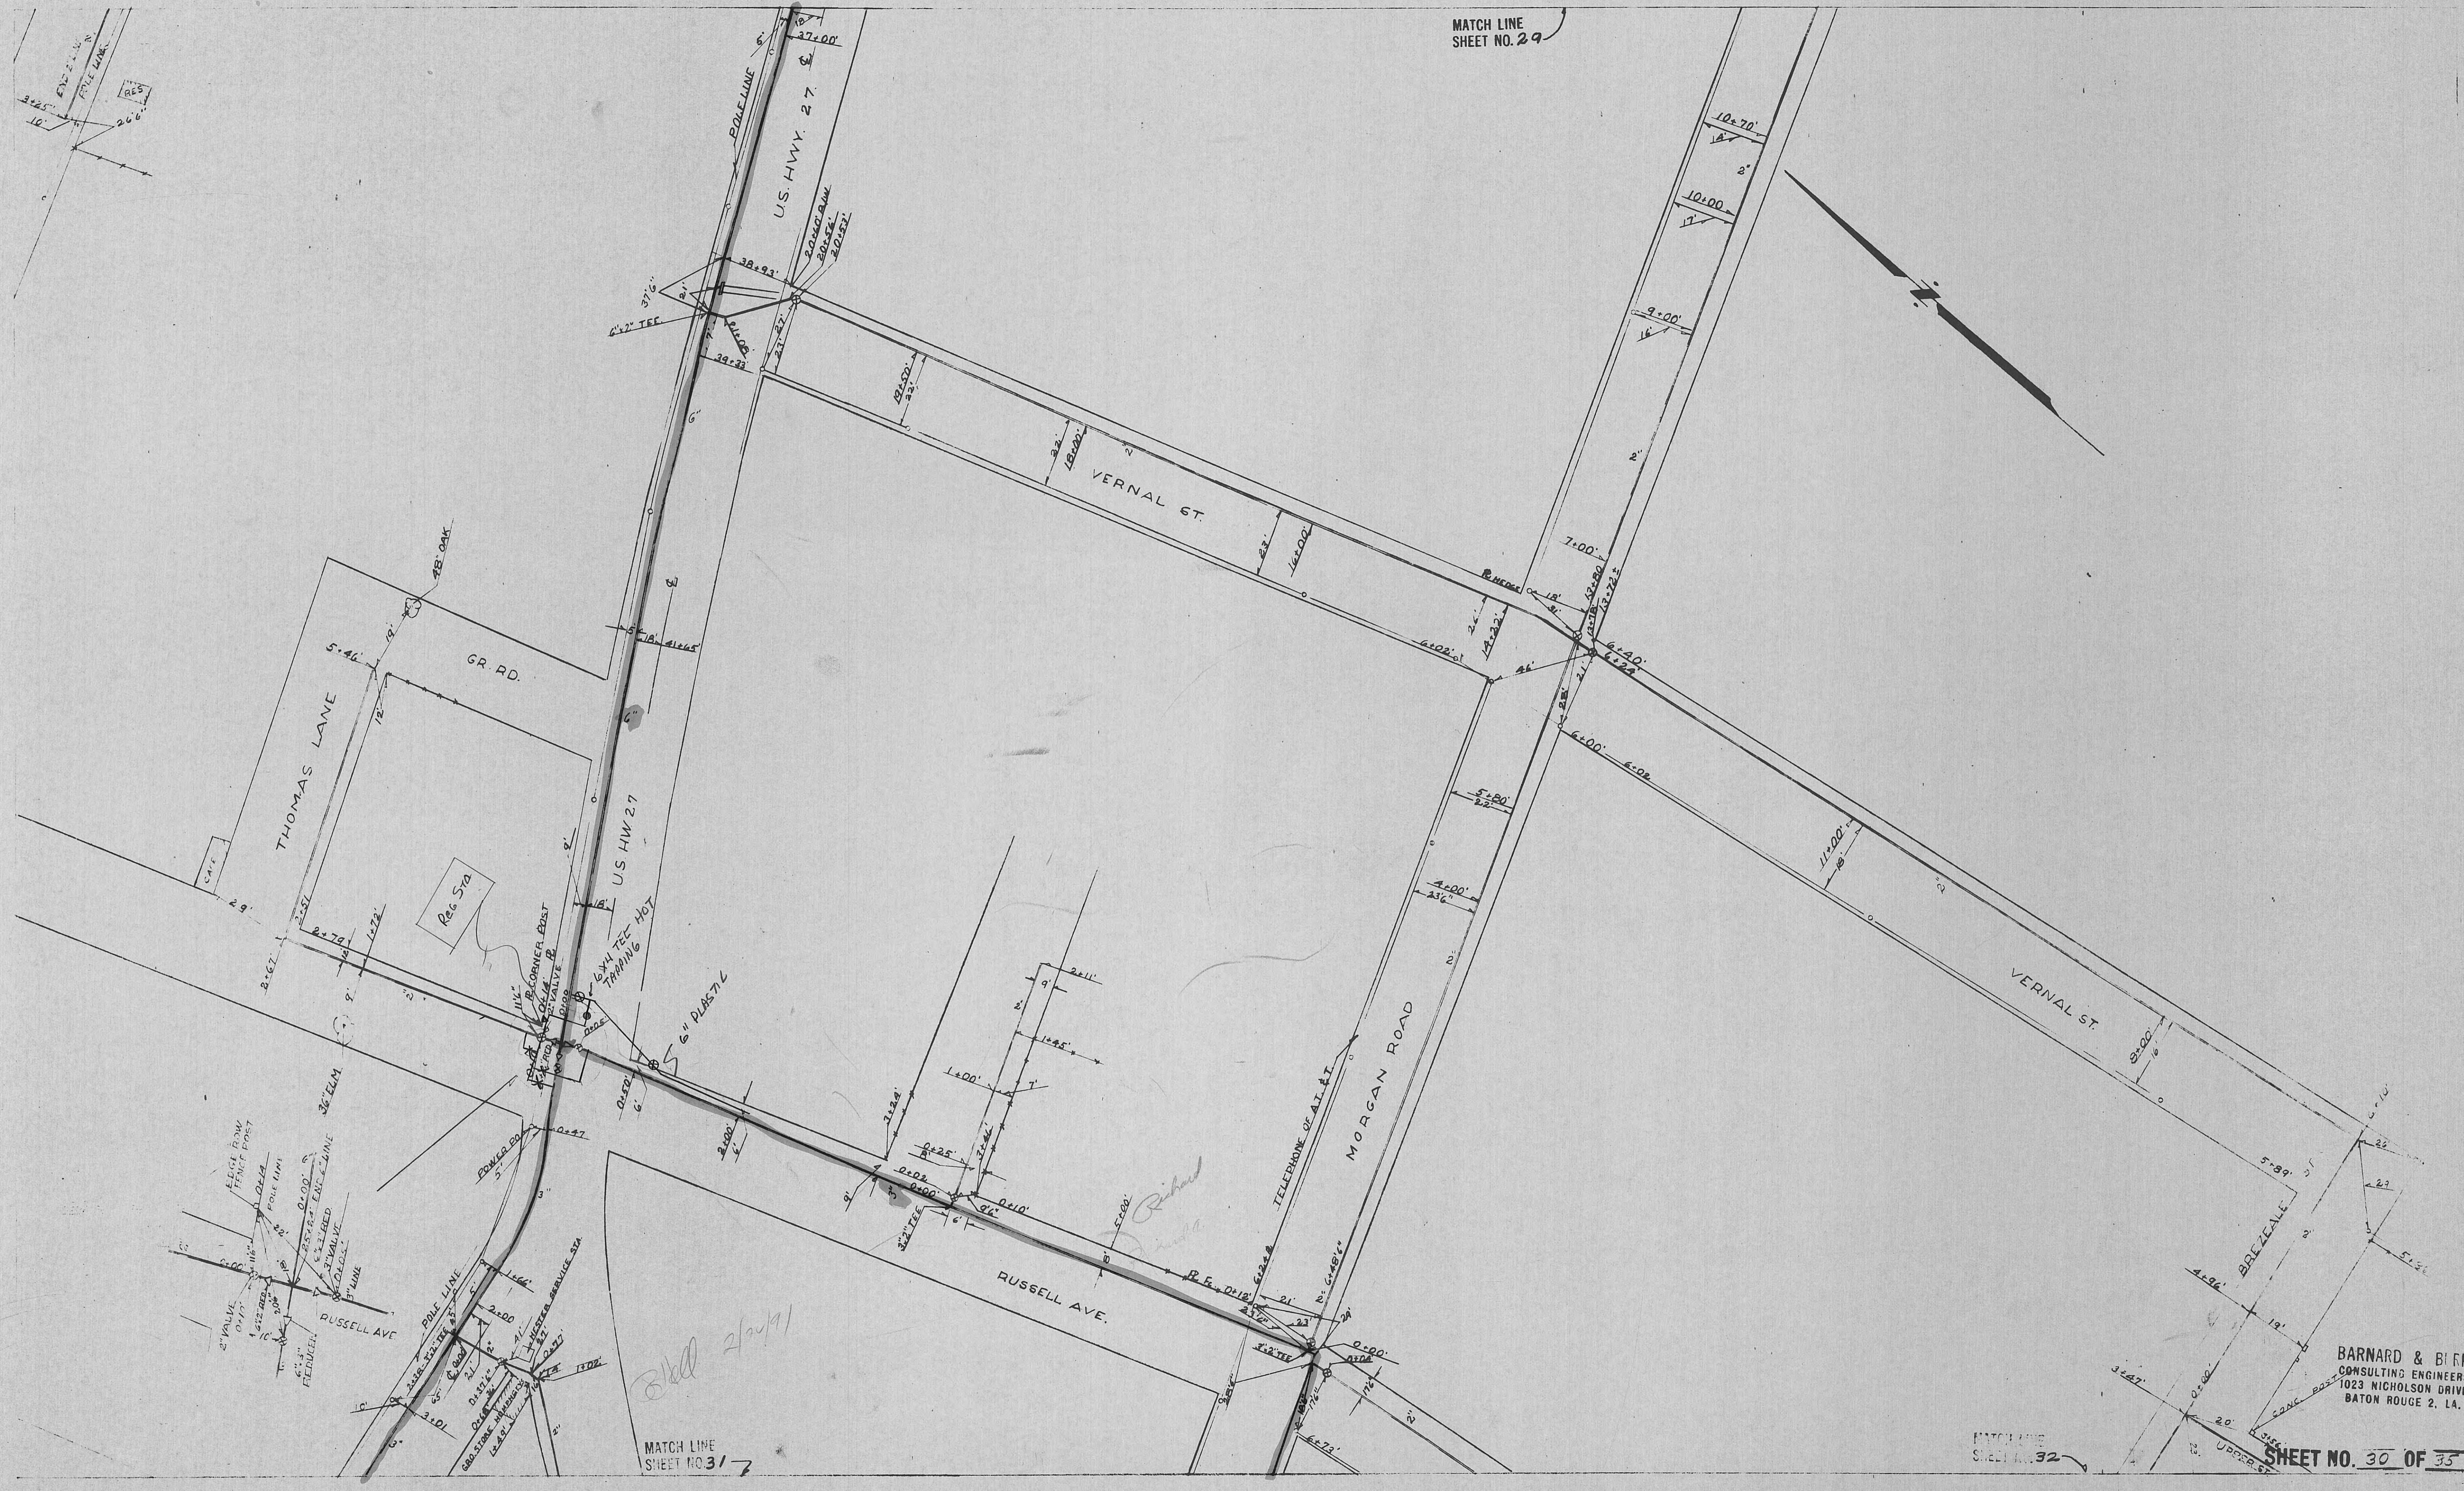


BARNARD & BIRK
CONSULTING ENGINEERS
1023 NICHOLSON DRIVE
BATON ROUGE 2, LA.

SHEET NO. 30 OF 35

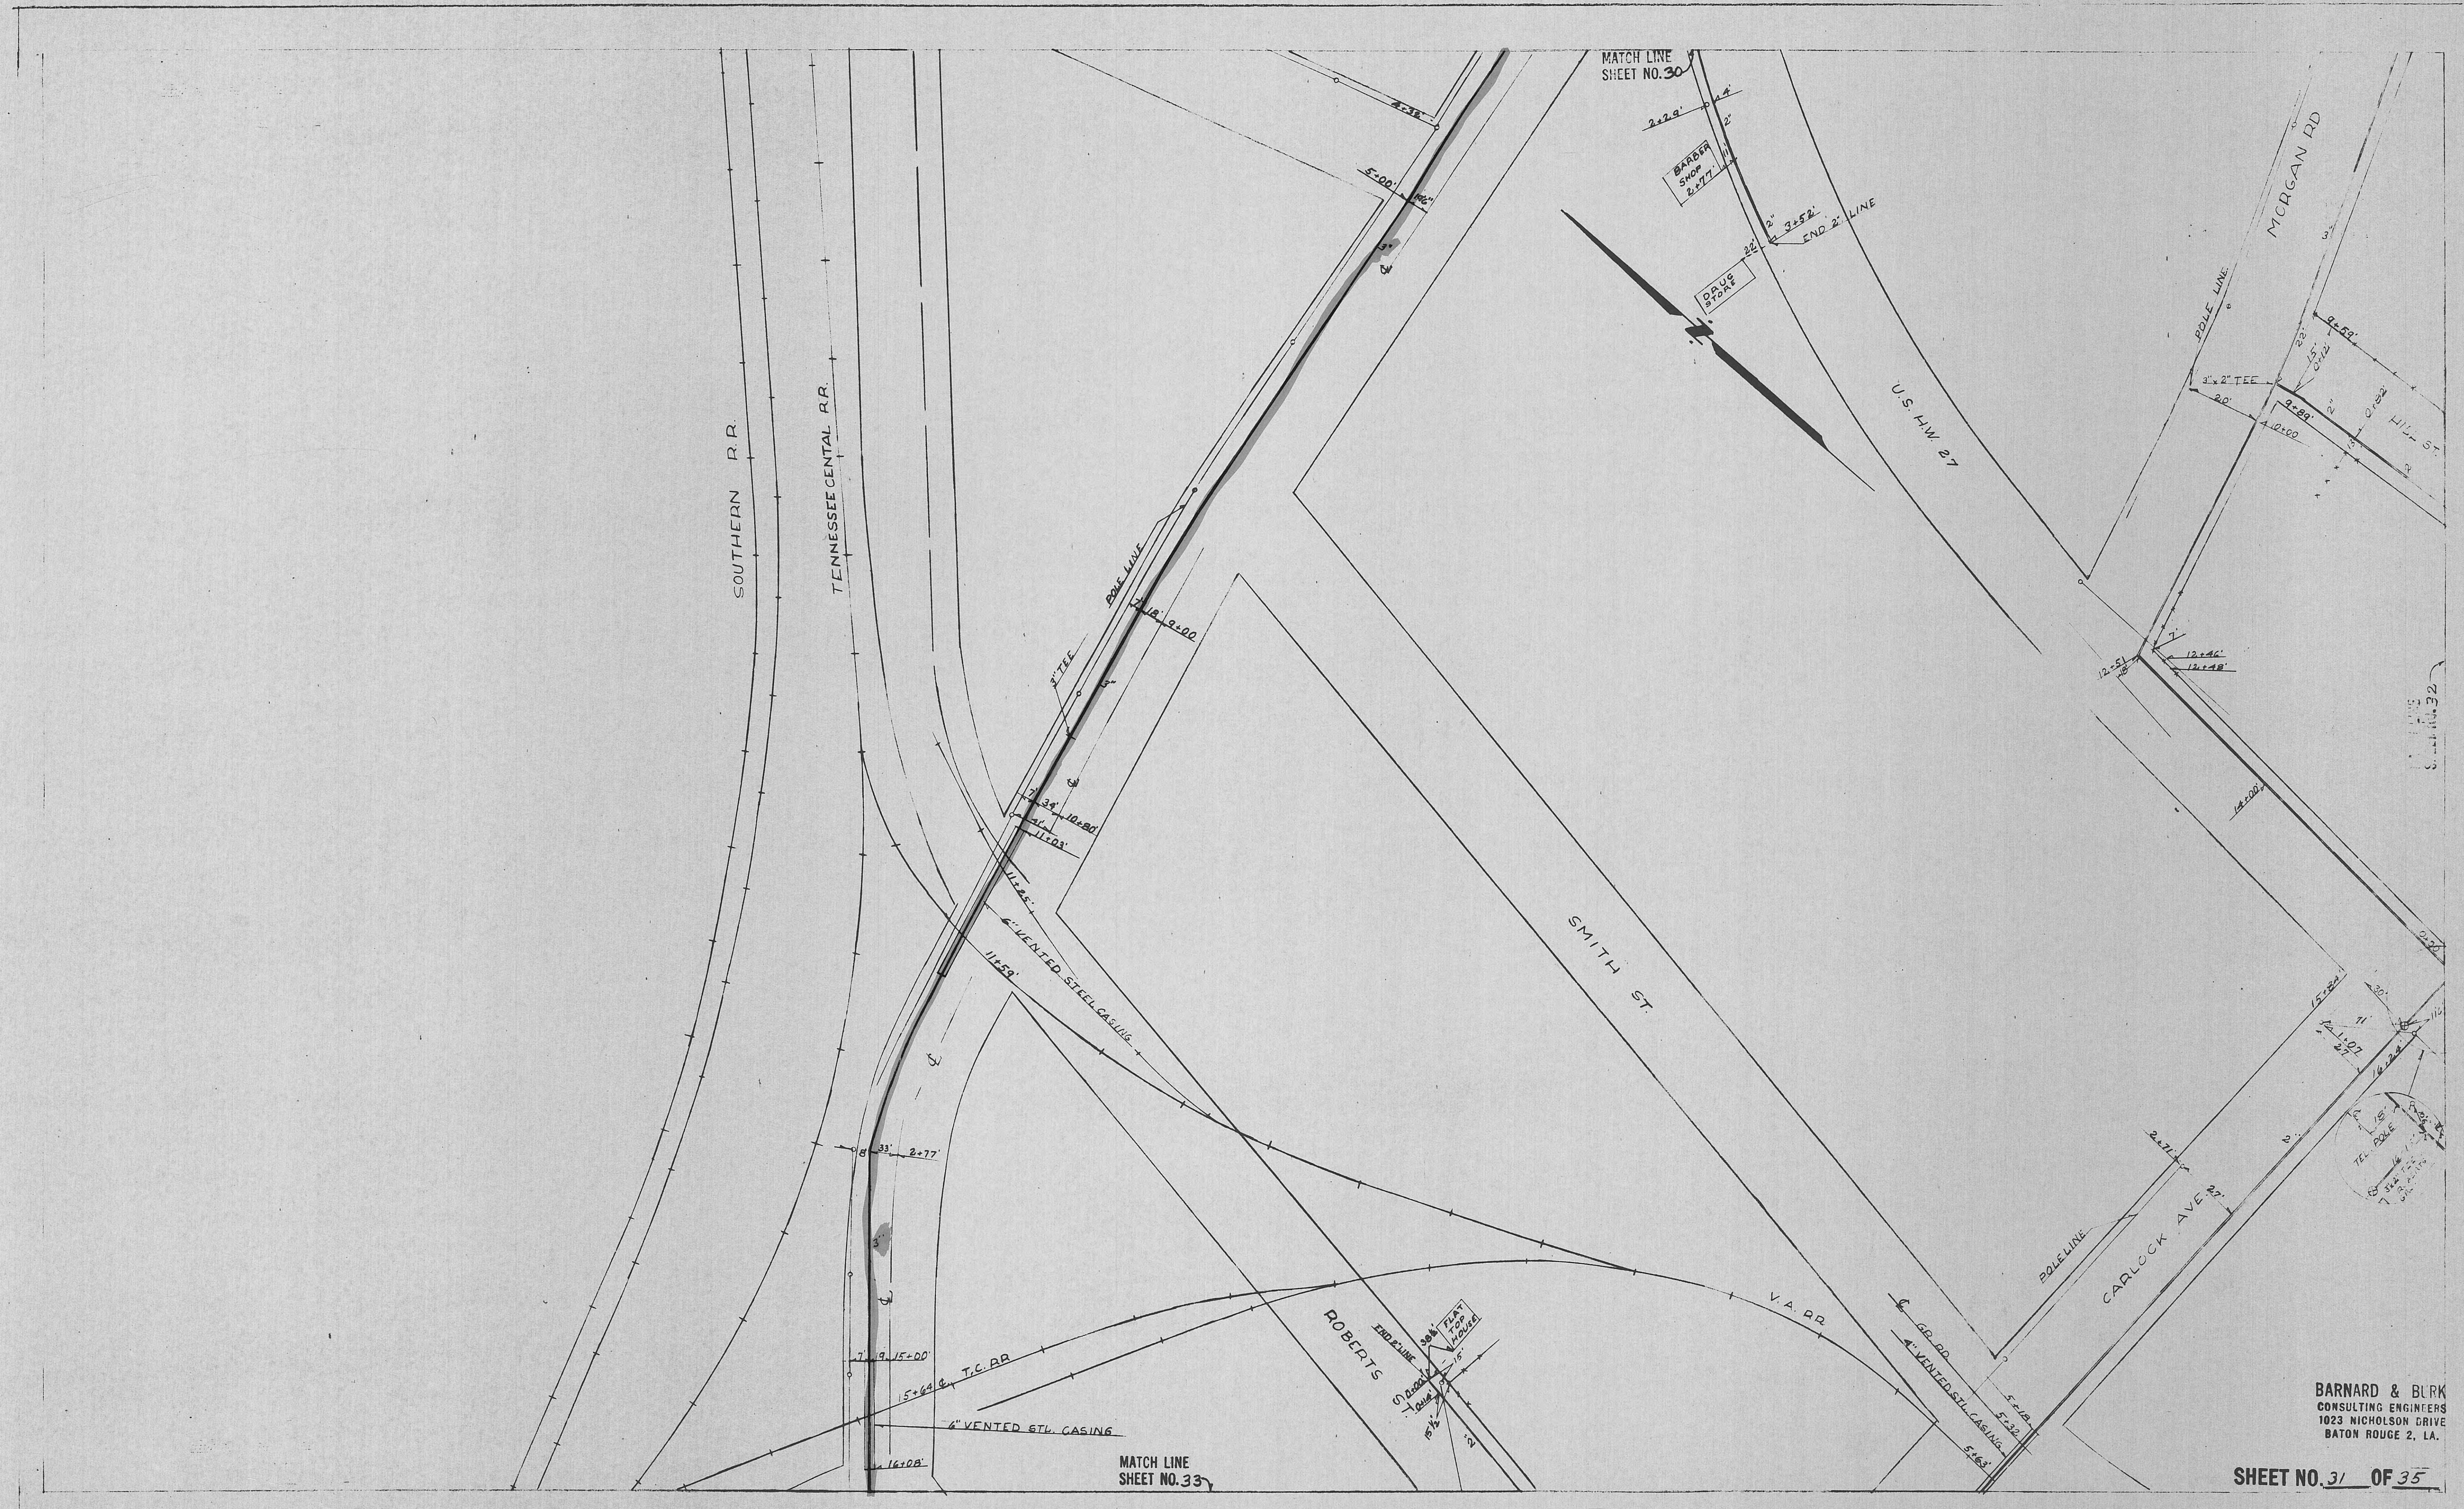


**BARNARD & BURK
CONSULTING ENGINEERS
1023 NICHOLSON DRIVE
BATON ROUGE 2, LA.**

SHEET NO. 31 OF 35

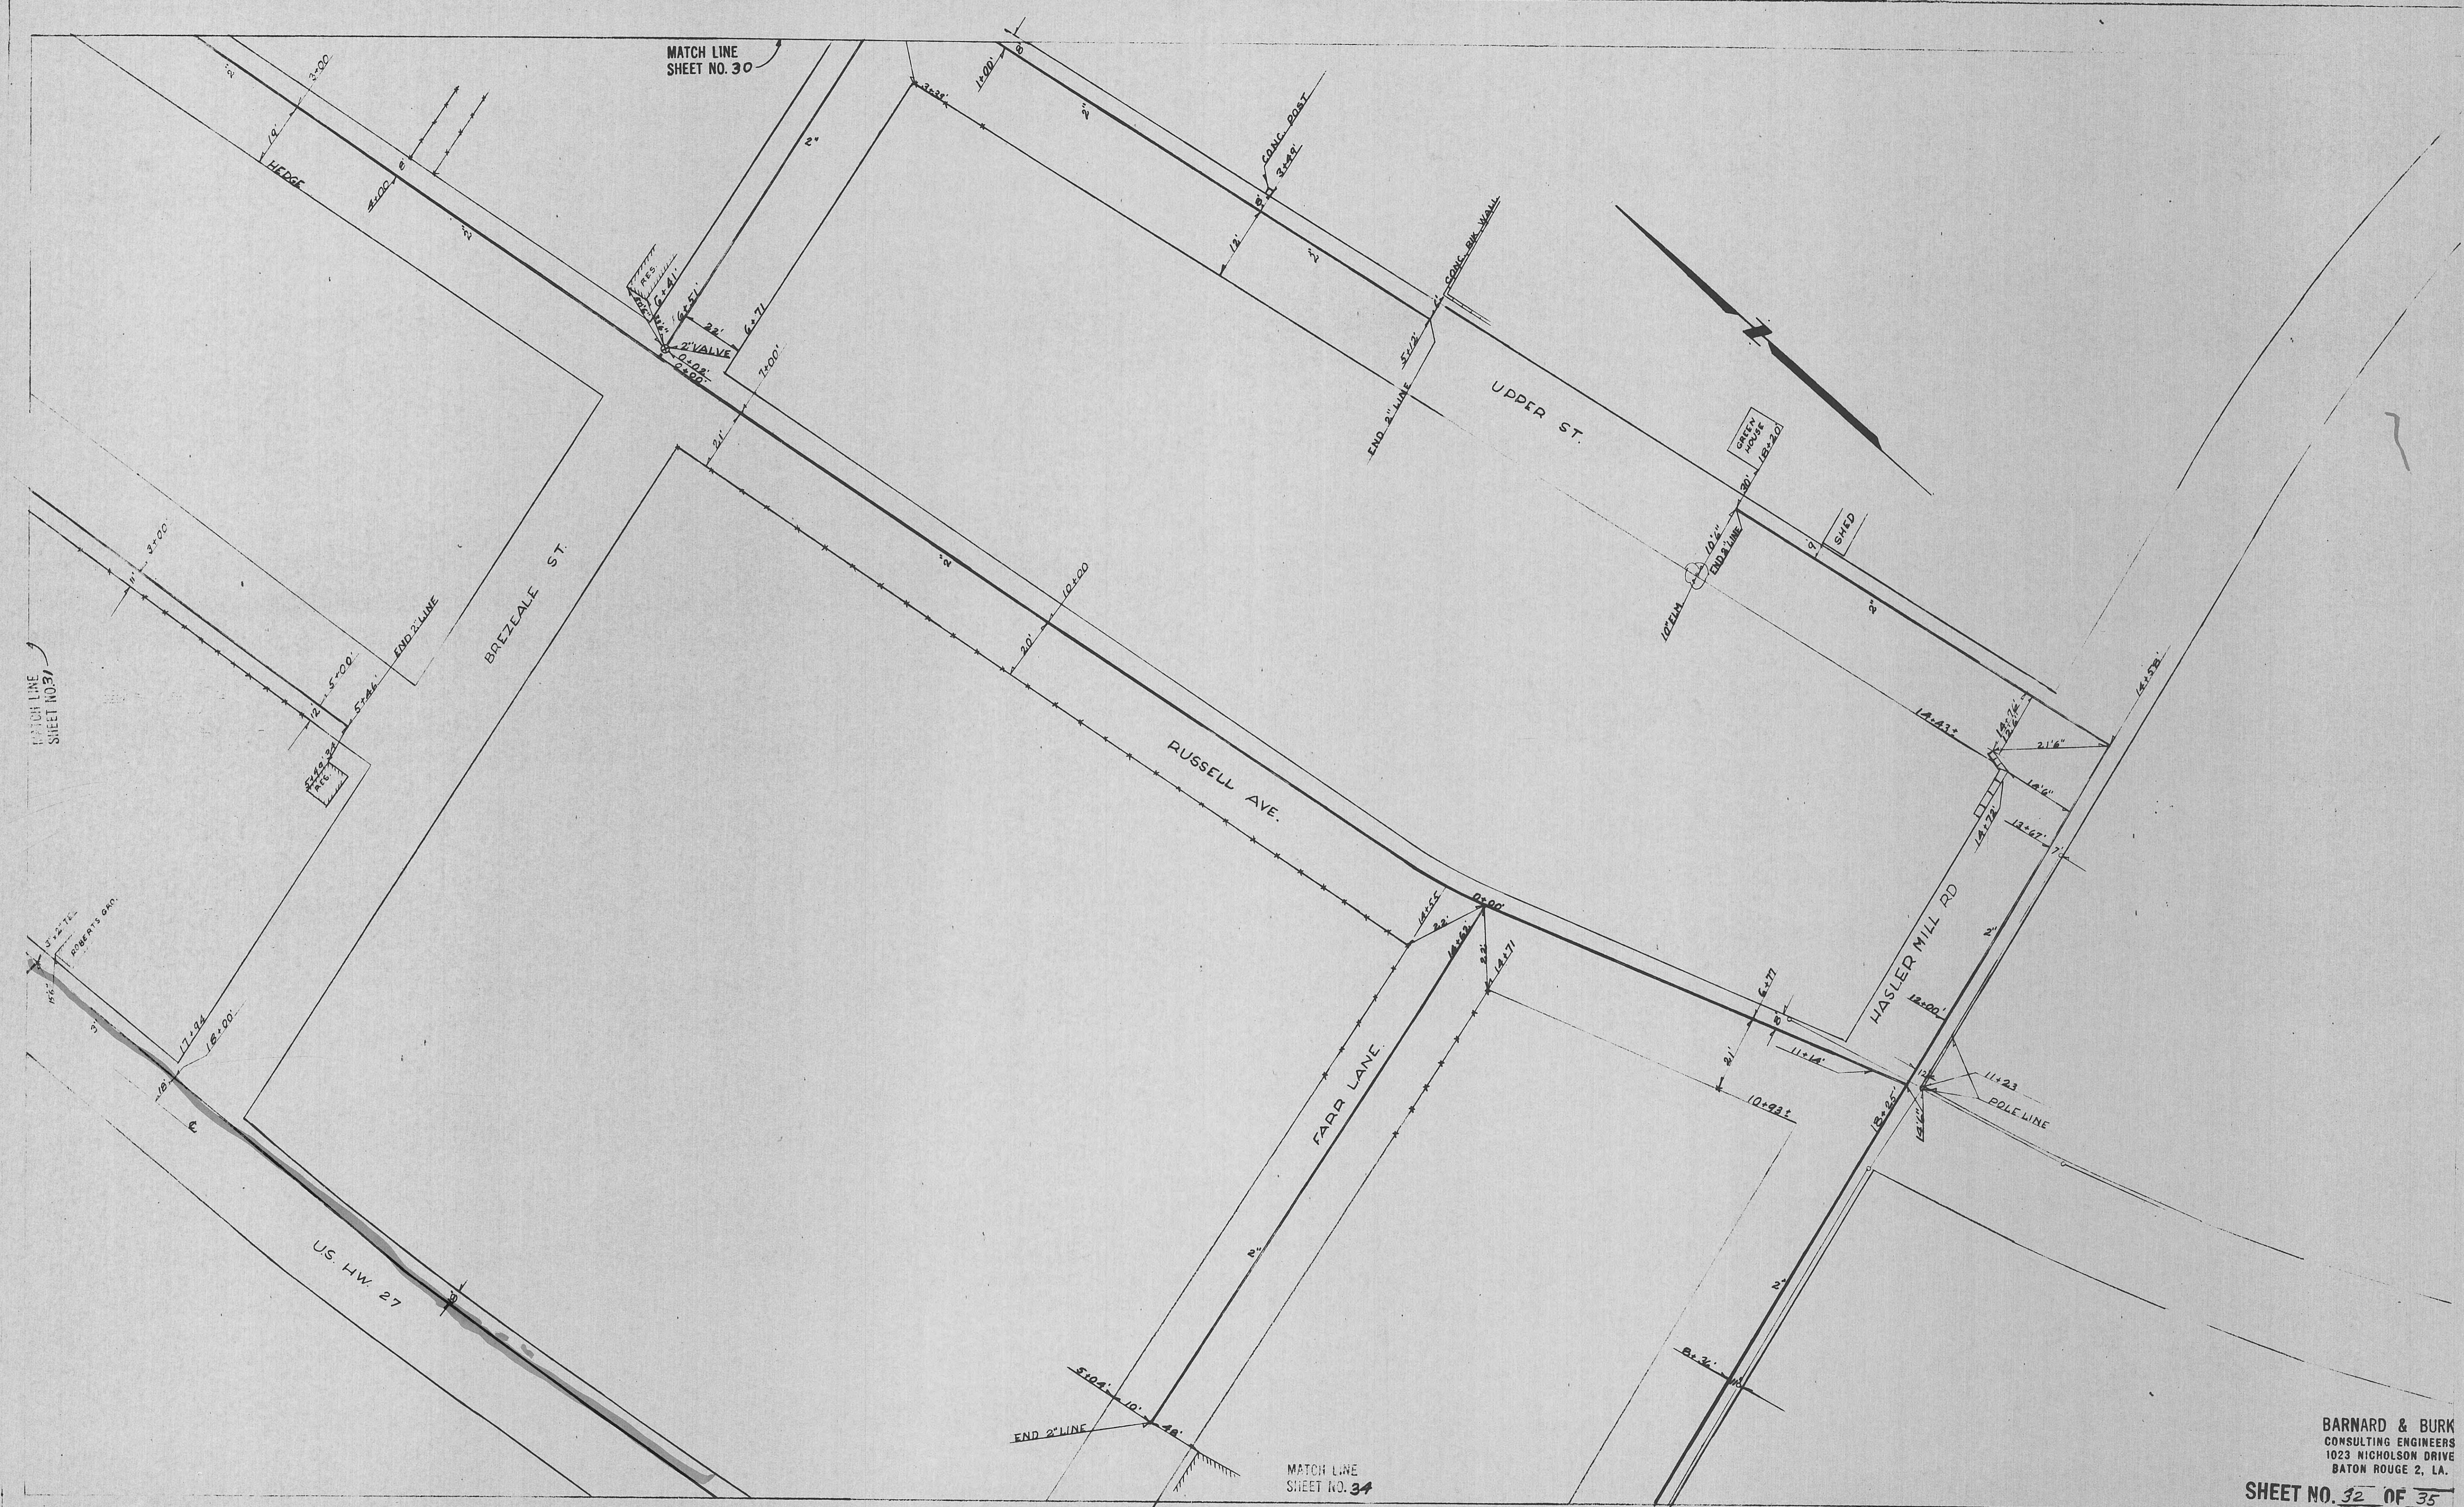

**BARNARD & BURK
CONSULTING ENGINEERS
1023 NICHOLSON DRIVE
BATON ROUGE 2, LA.**


SHEET NO. 32 OF 35

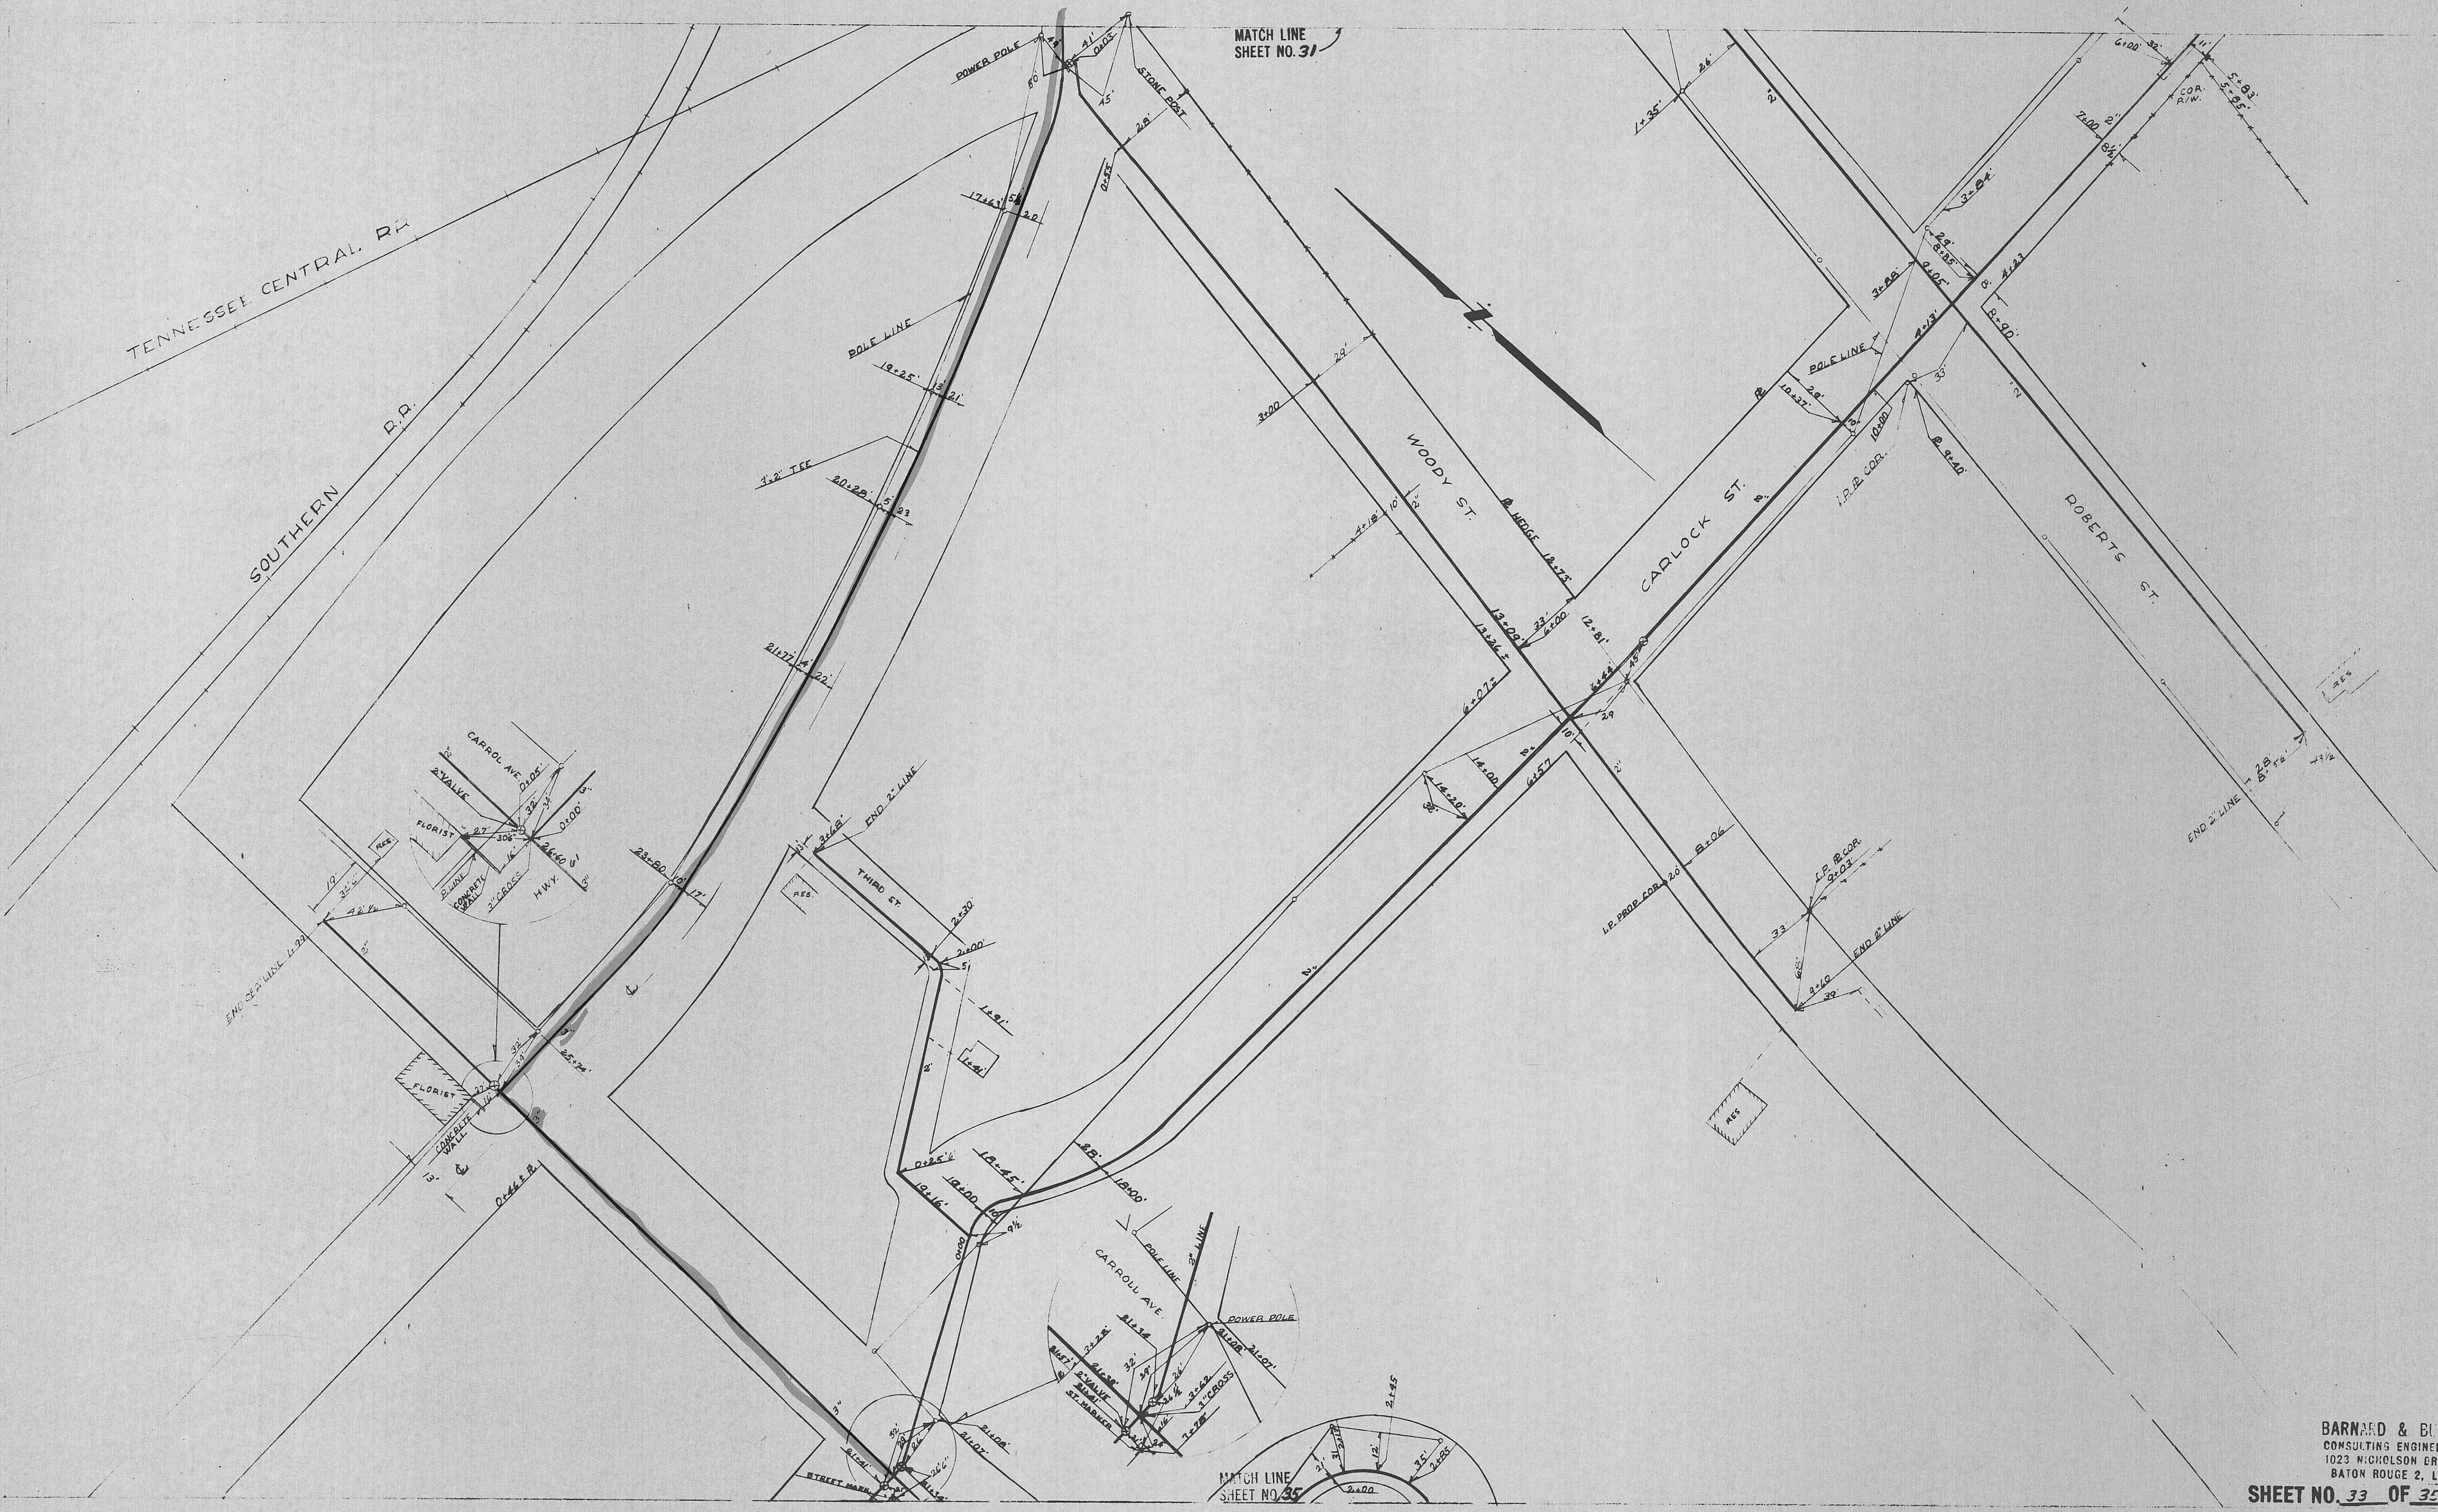

**BARNARD & BURK
CONSULTING ENGINEERS
1023 NICHOLSON DRIVE
BATON ROUGE 2 LA**


SHEET NO. 33 OF 35

MATCH LINE
SHEET NO. 3

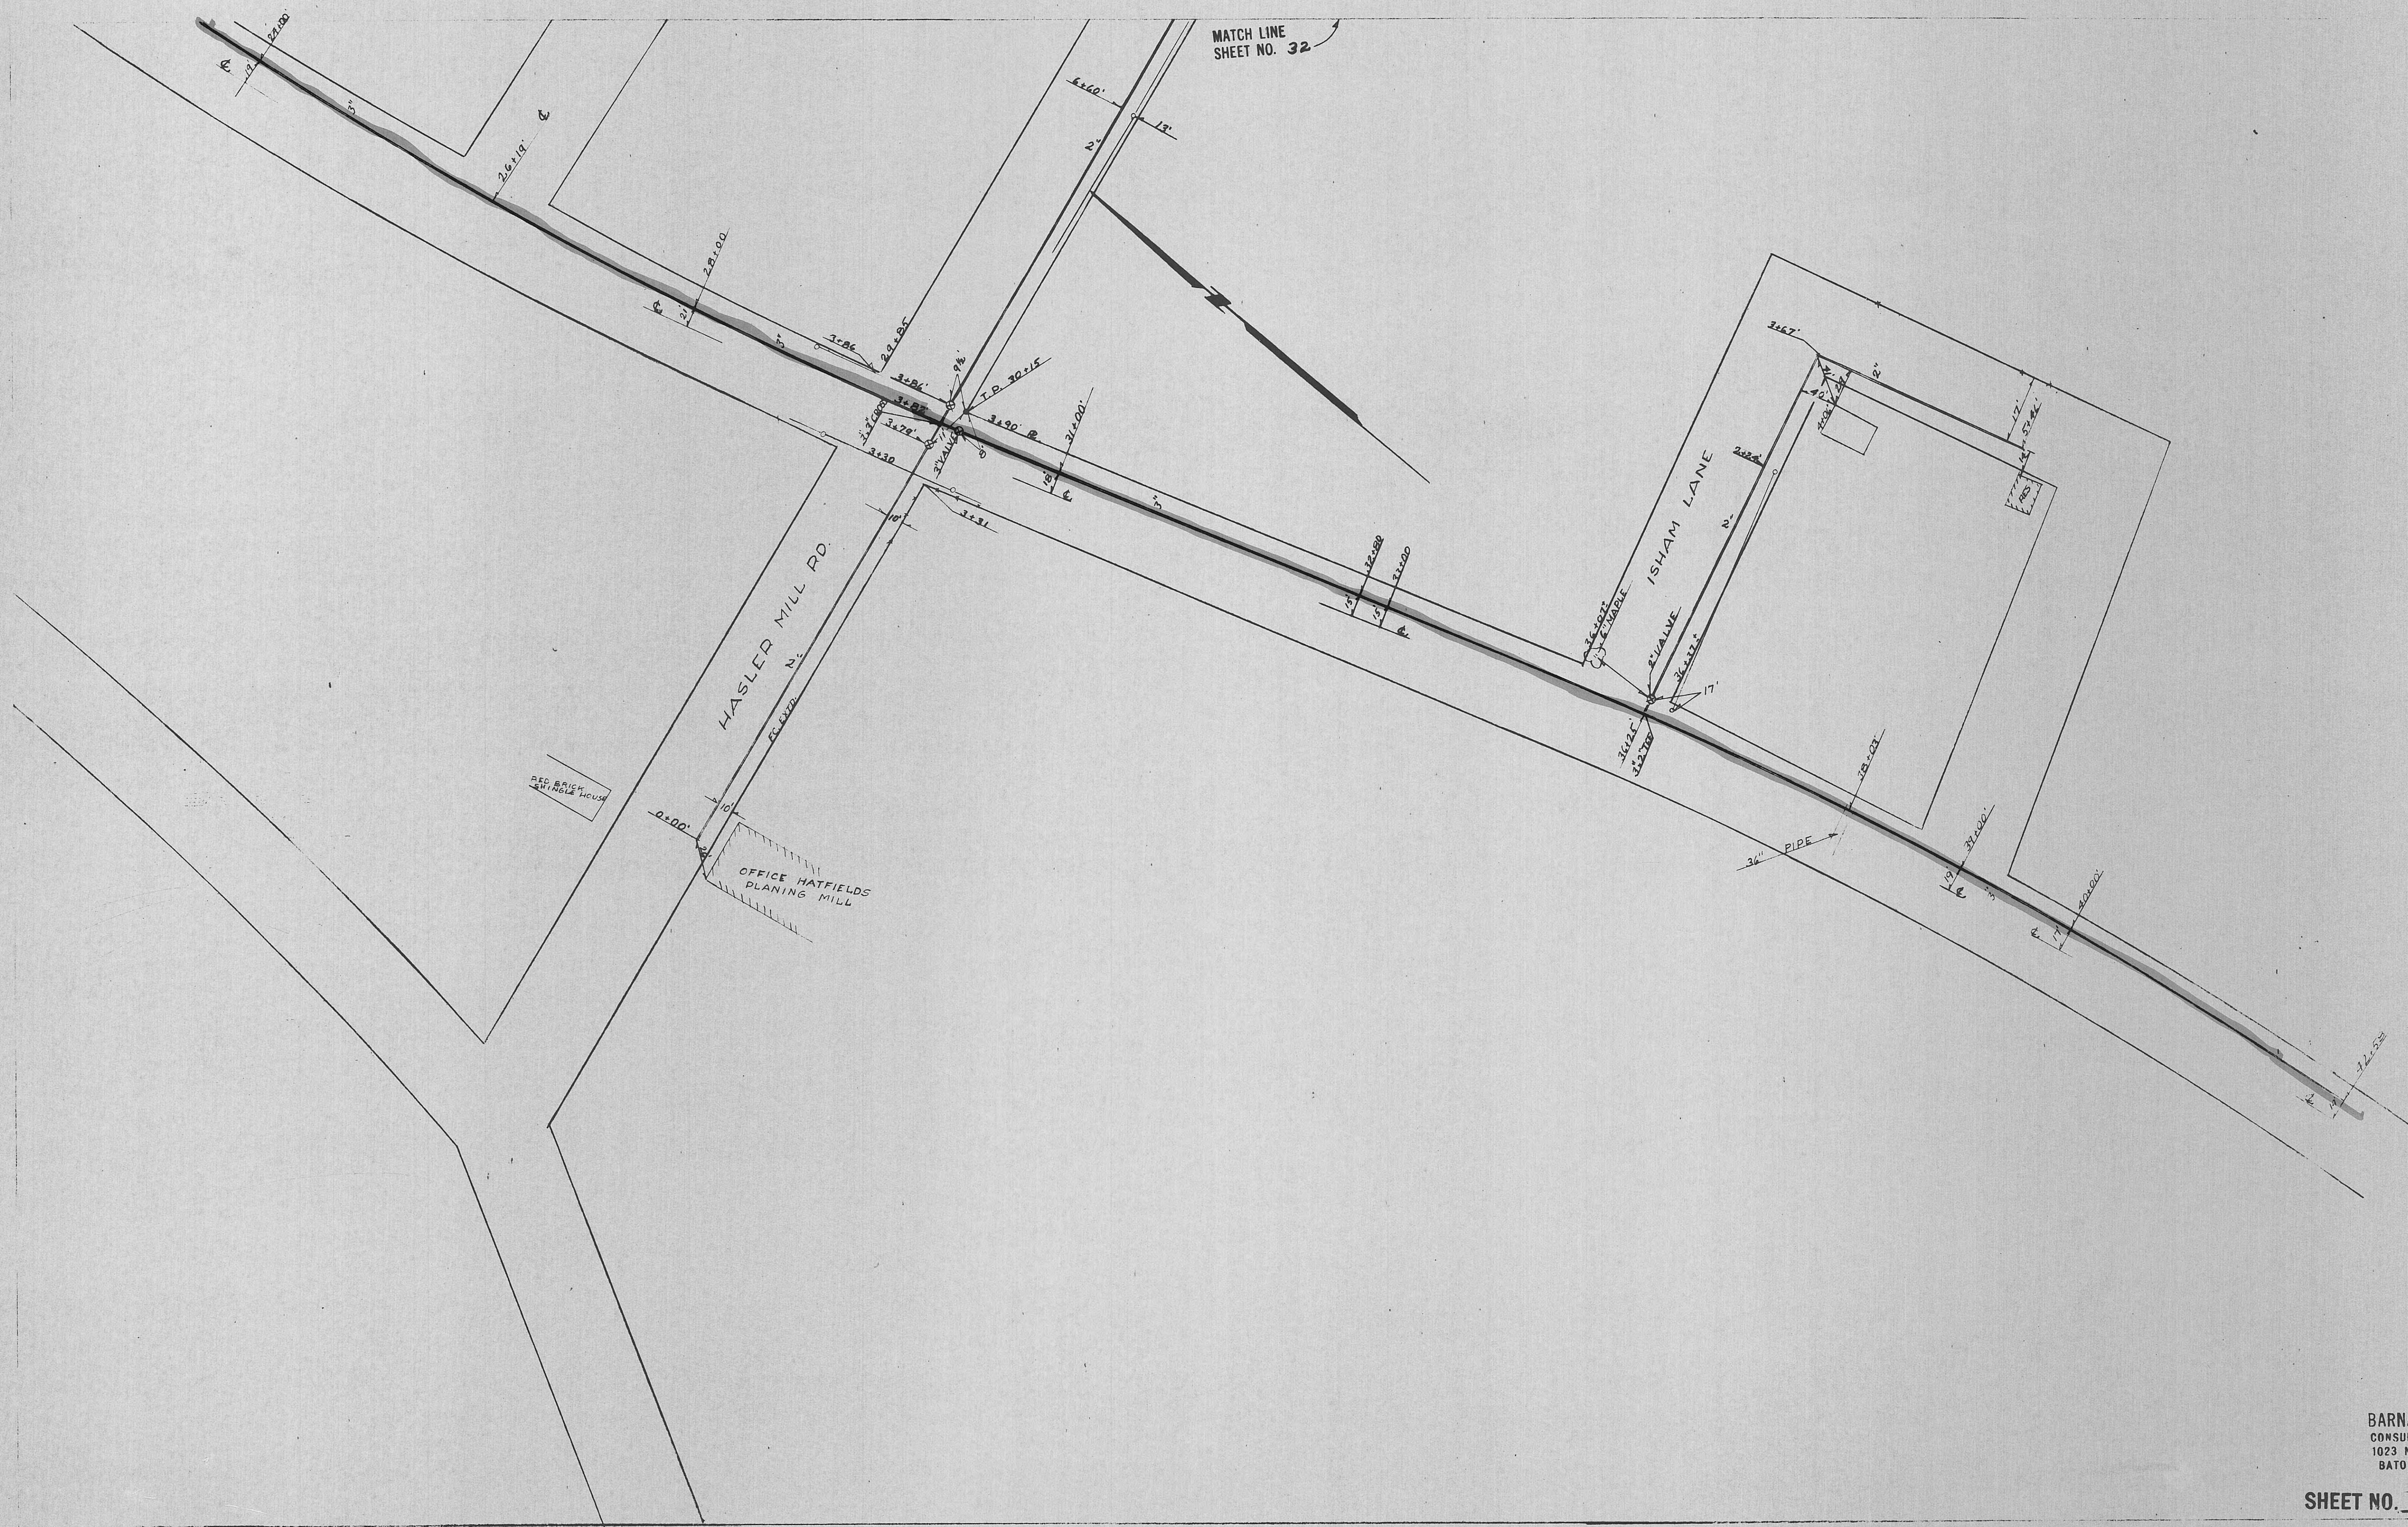

BARNARD & BURK
CONSULTING ENGINEERS
1023 NICHOLSON DRIVE
BATON ROUGE 2, LA.

SHEET NO. 34 OF 35

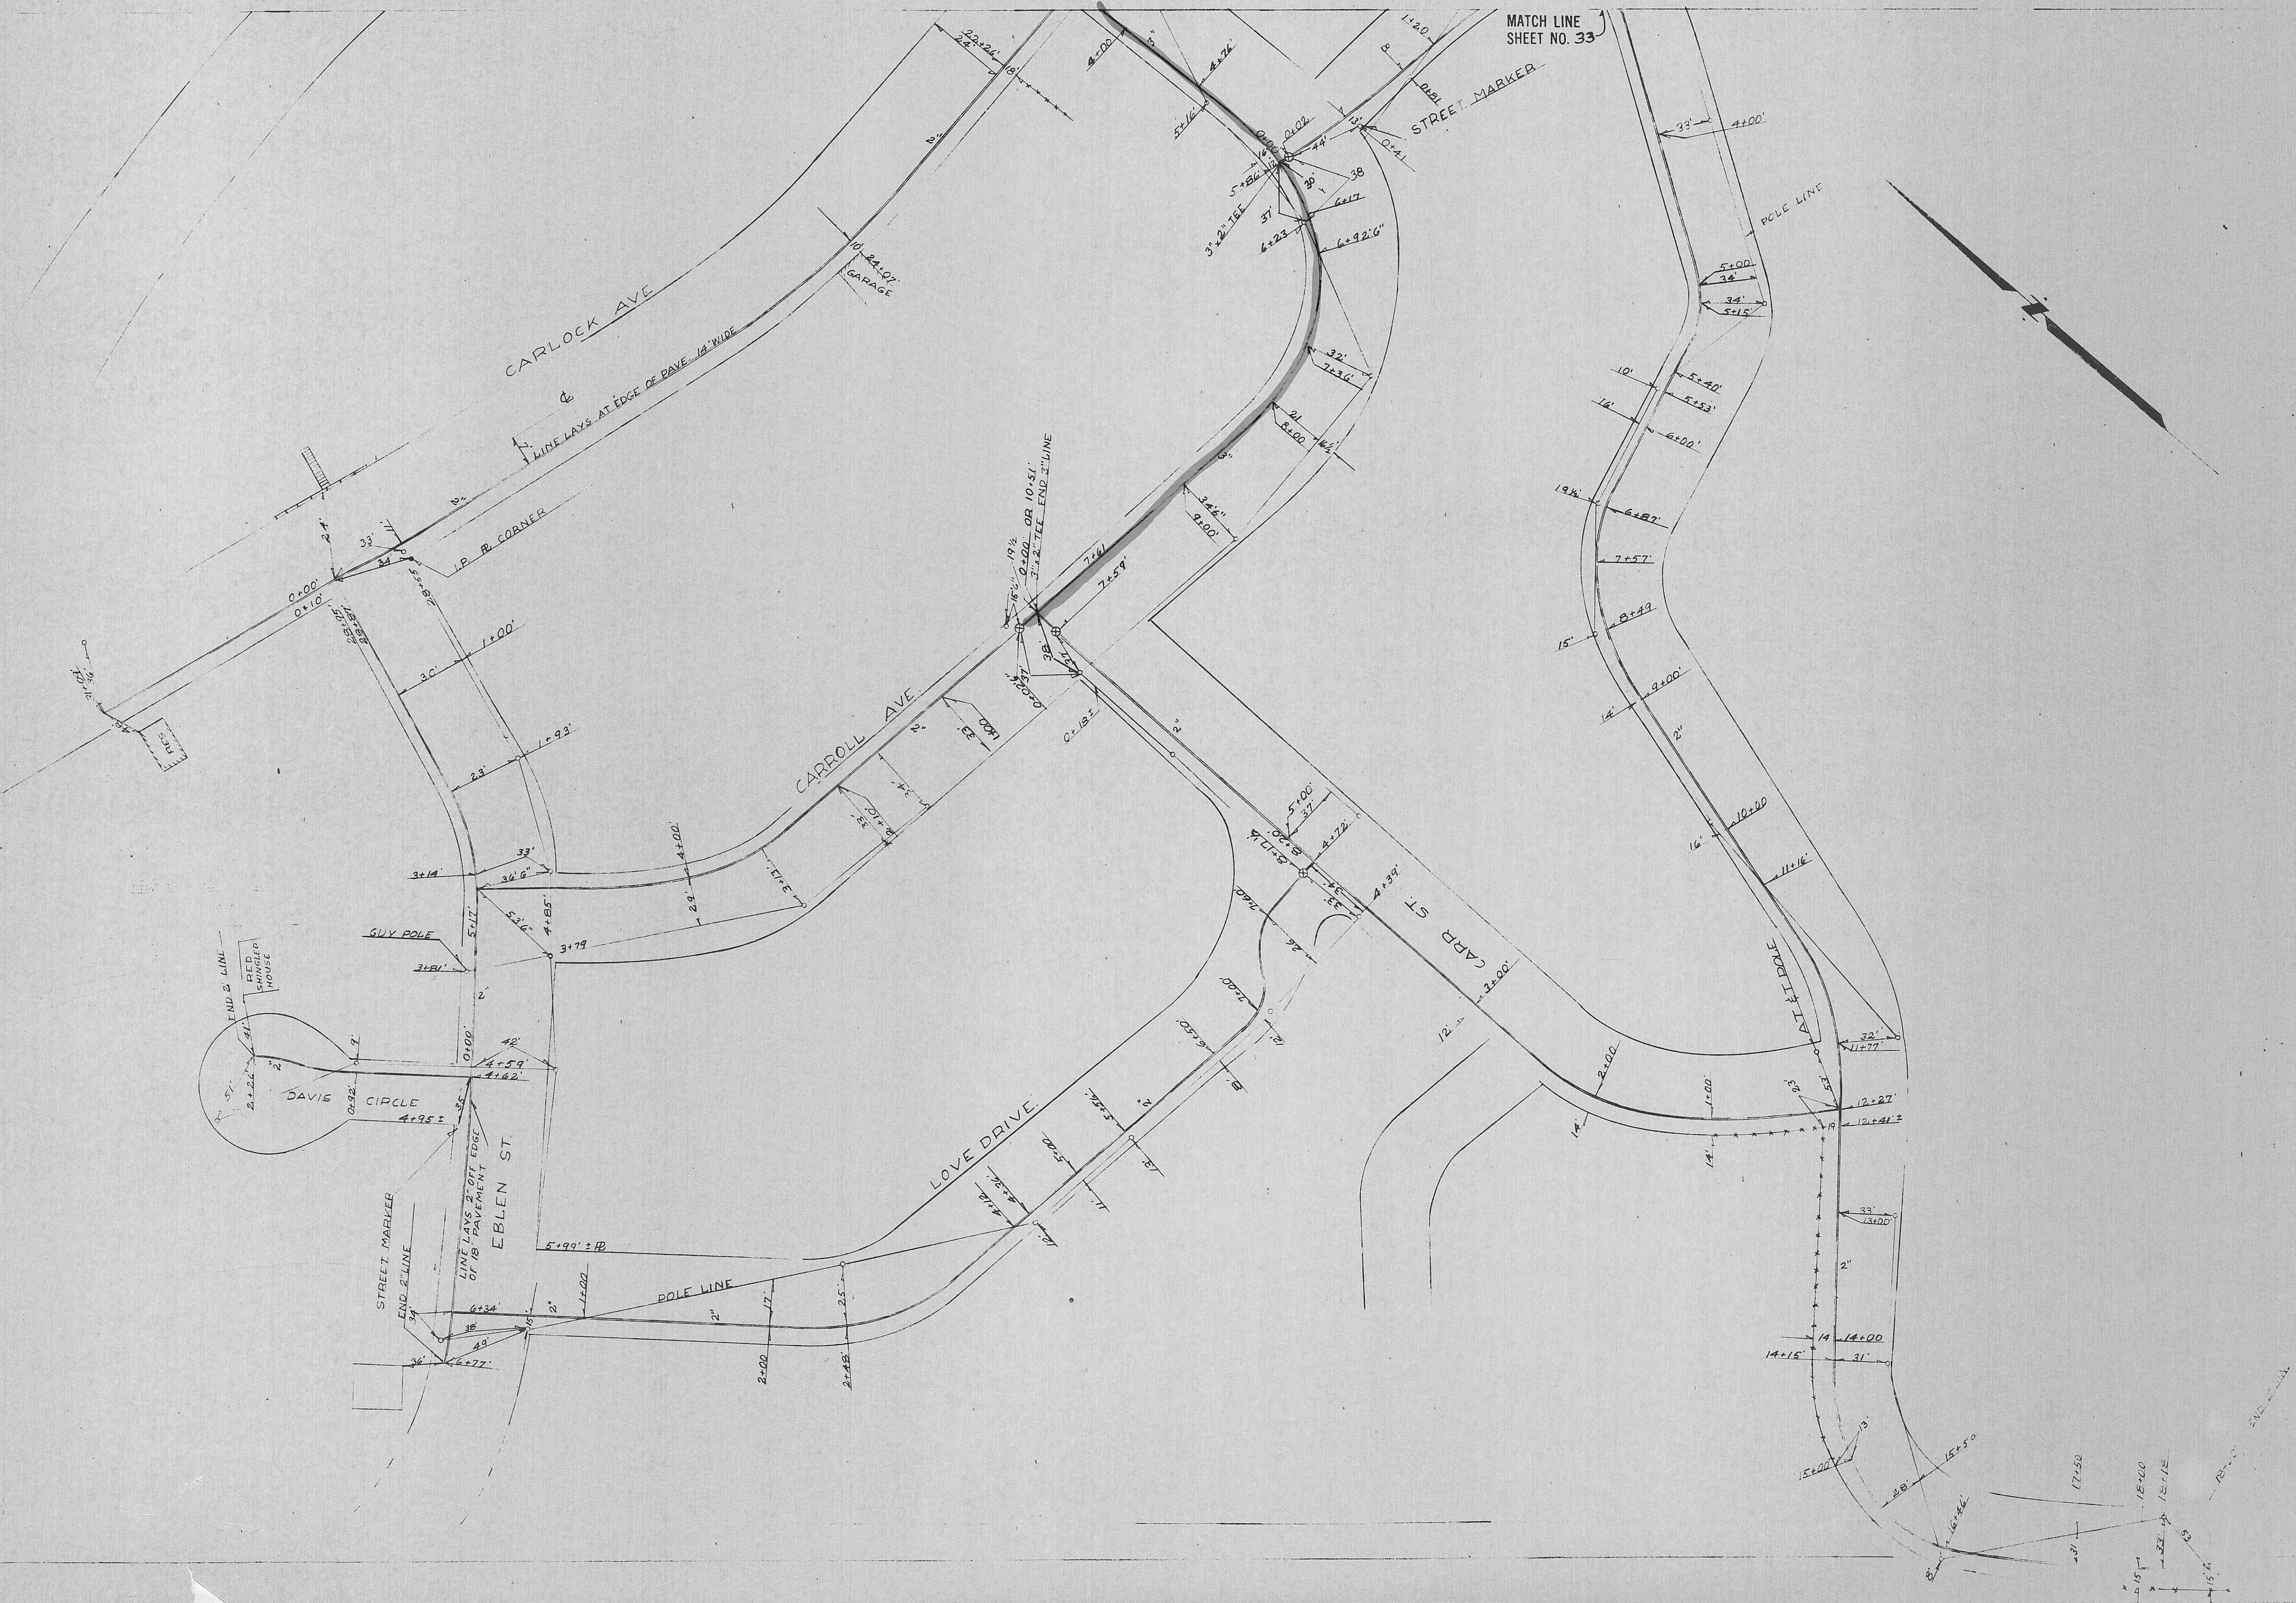

BARNARD & BURK
CONSULTING ENGINEERS
1023 NICHOLSON DRIVE
BATON ROUGE 2, LA.

SHEET NO. 35 OF 35



MATCH LINE

SHEET NO. 5


82 15' 20'
20' 20'
20' 20'

HOUSE

50'
15' 20'
20' 20'
HOUSE


BARNARD & BURK
CONSULTING ENGINEERS
1023 NICHOLSON DRIVE
BATON ROUGE 2, LA.

SHEET NO. 5 OF 35

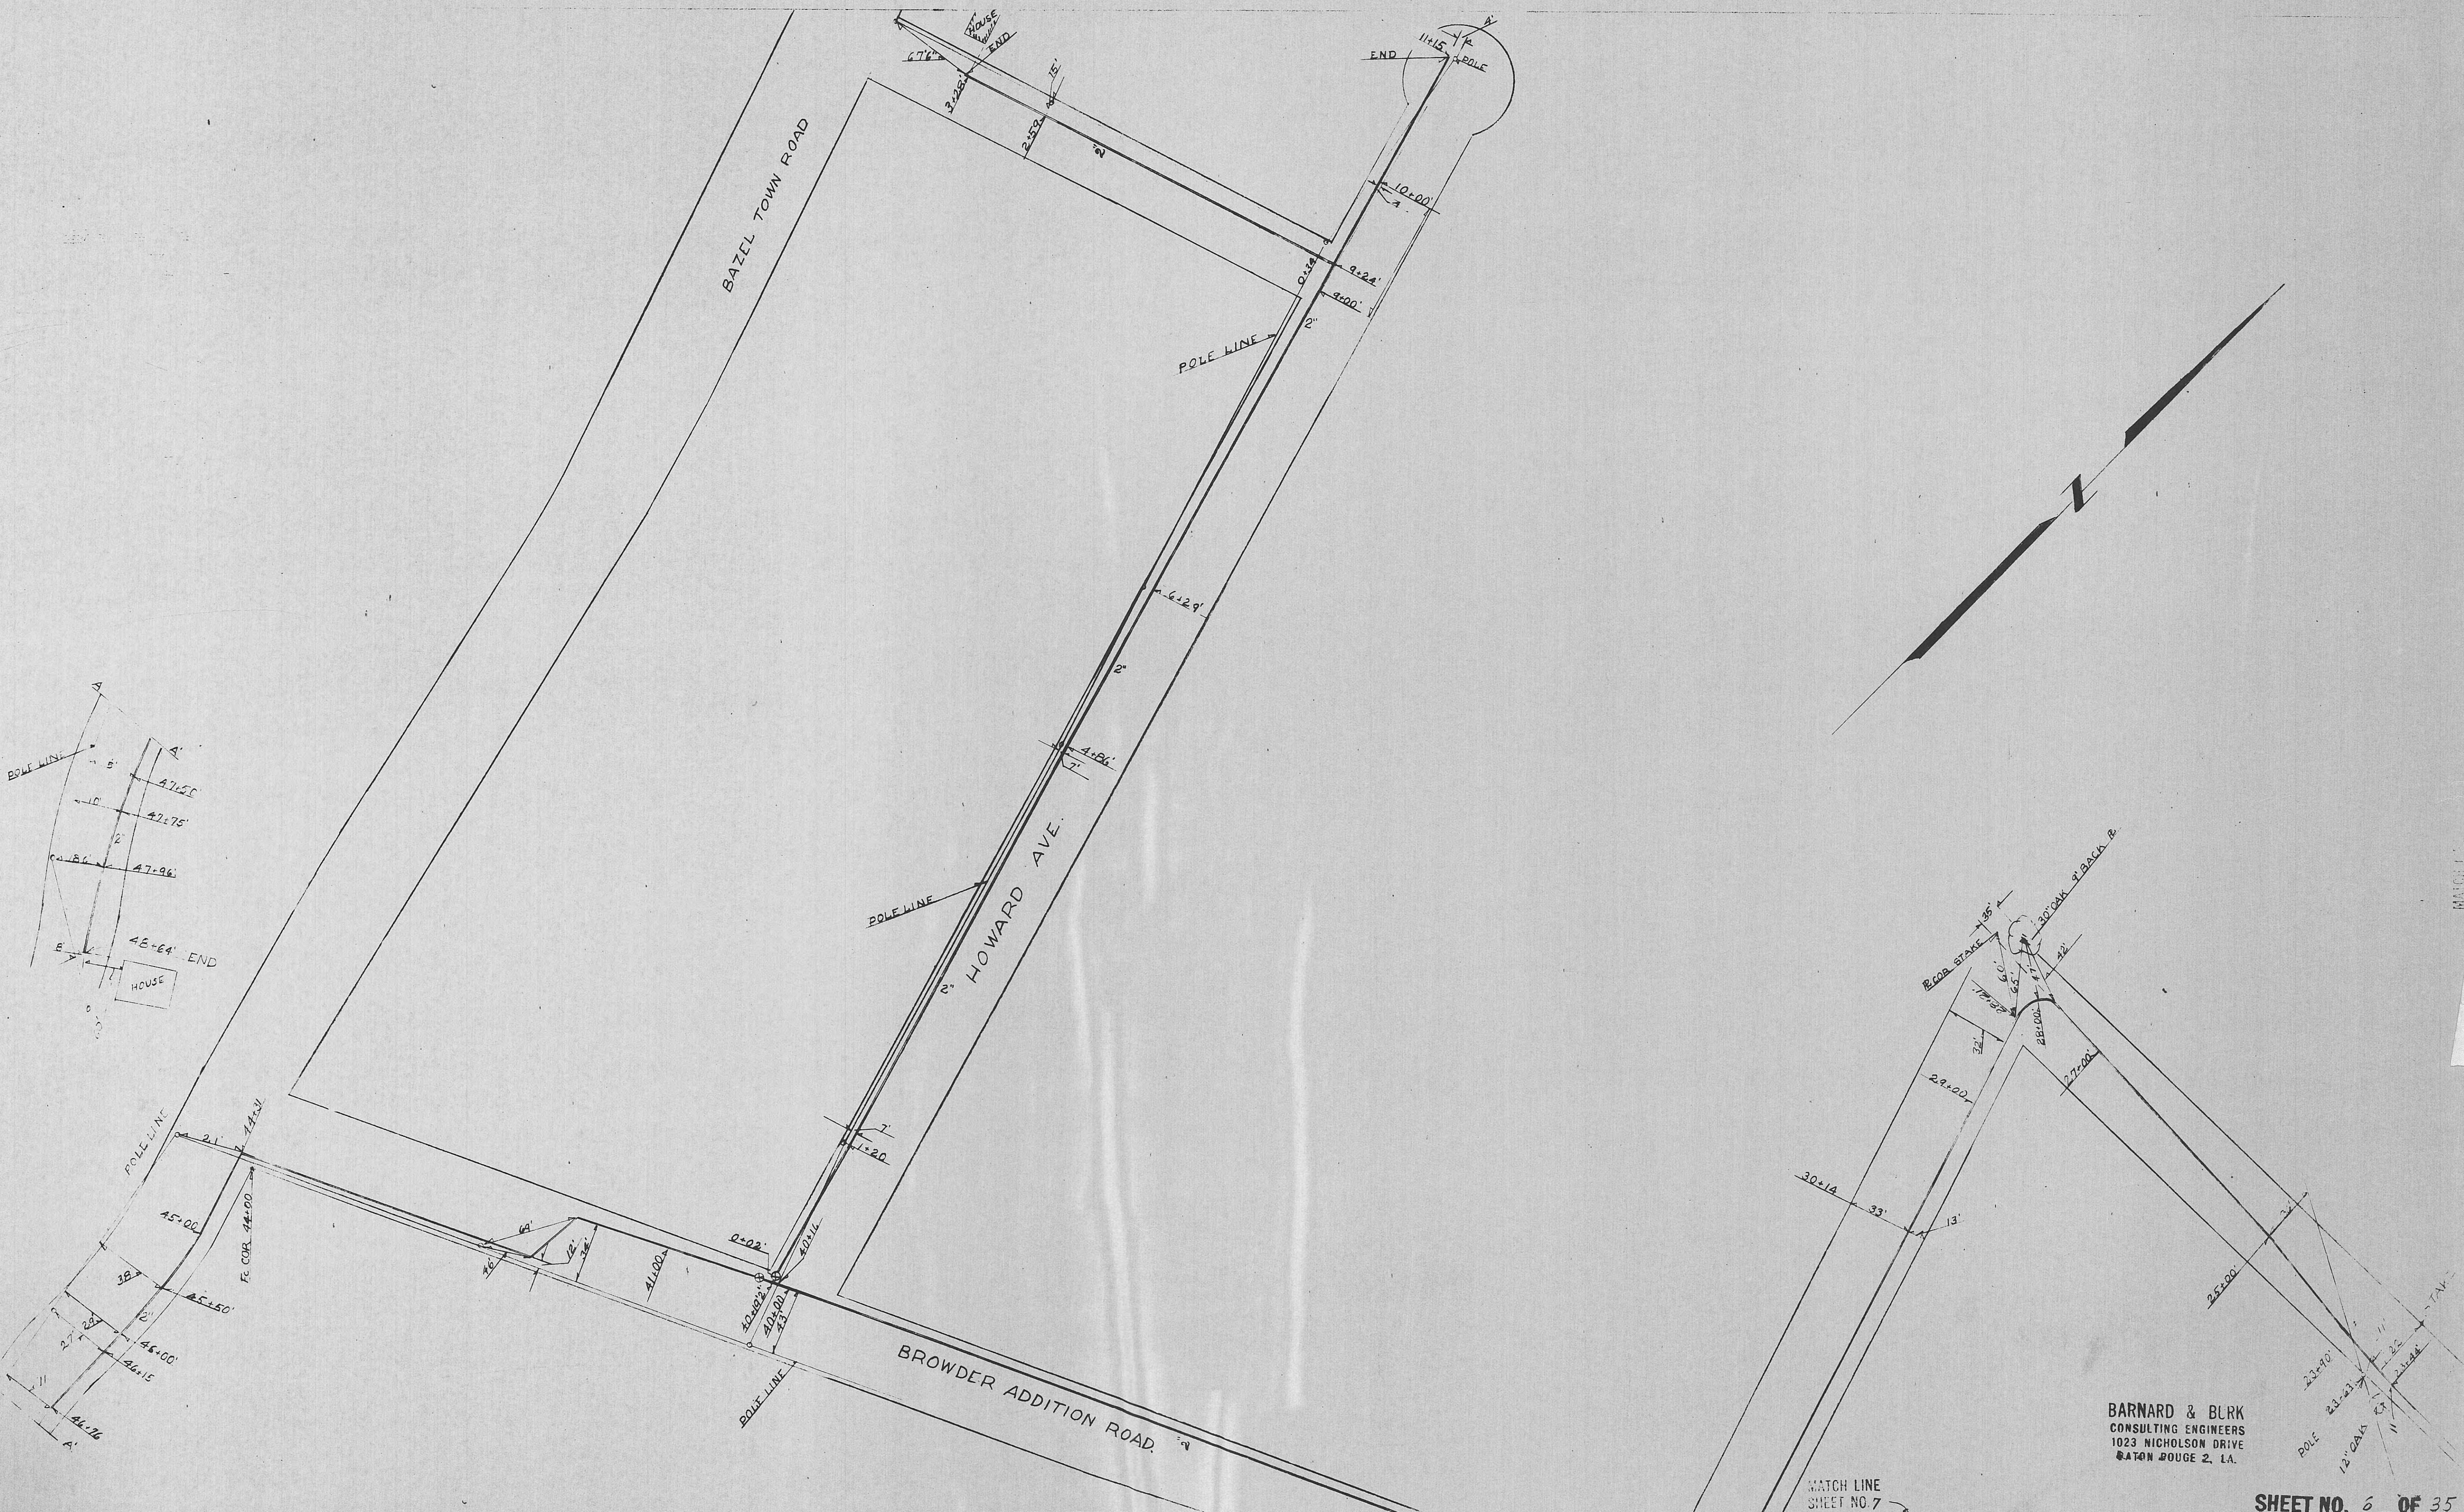


**BARNARD & BURK
CONSULTING ENGINEERS
1023 NICHOLSON DRIVE
BATON ROUGE 2, LA.**

SHEET NO. 6 OF 35

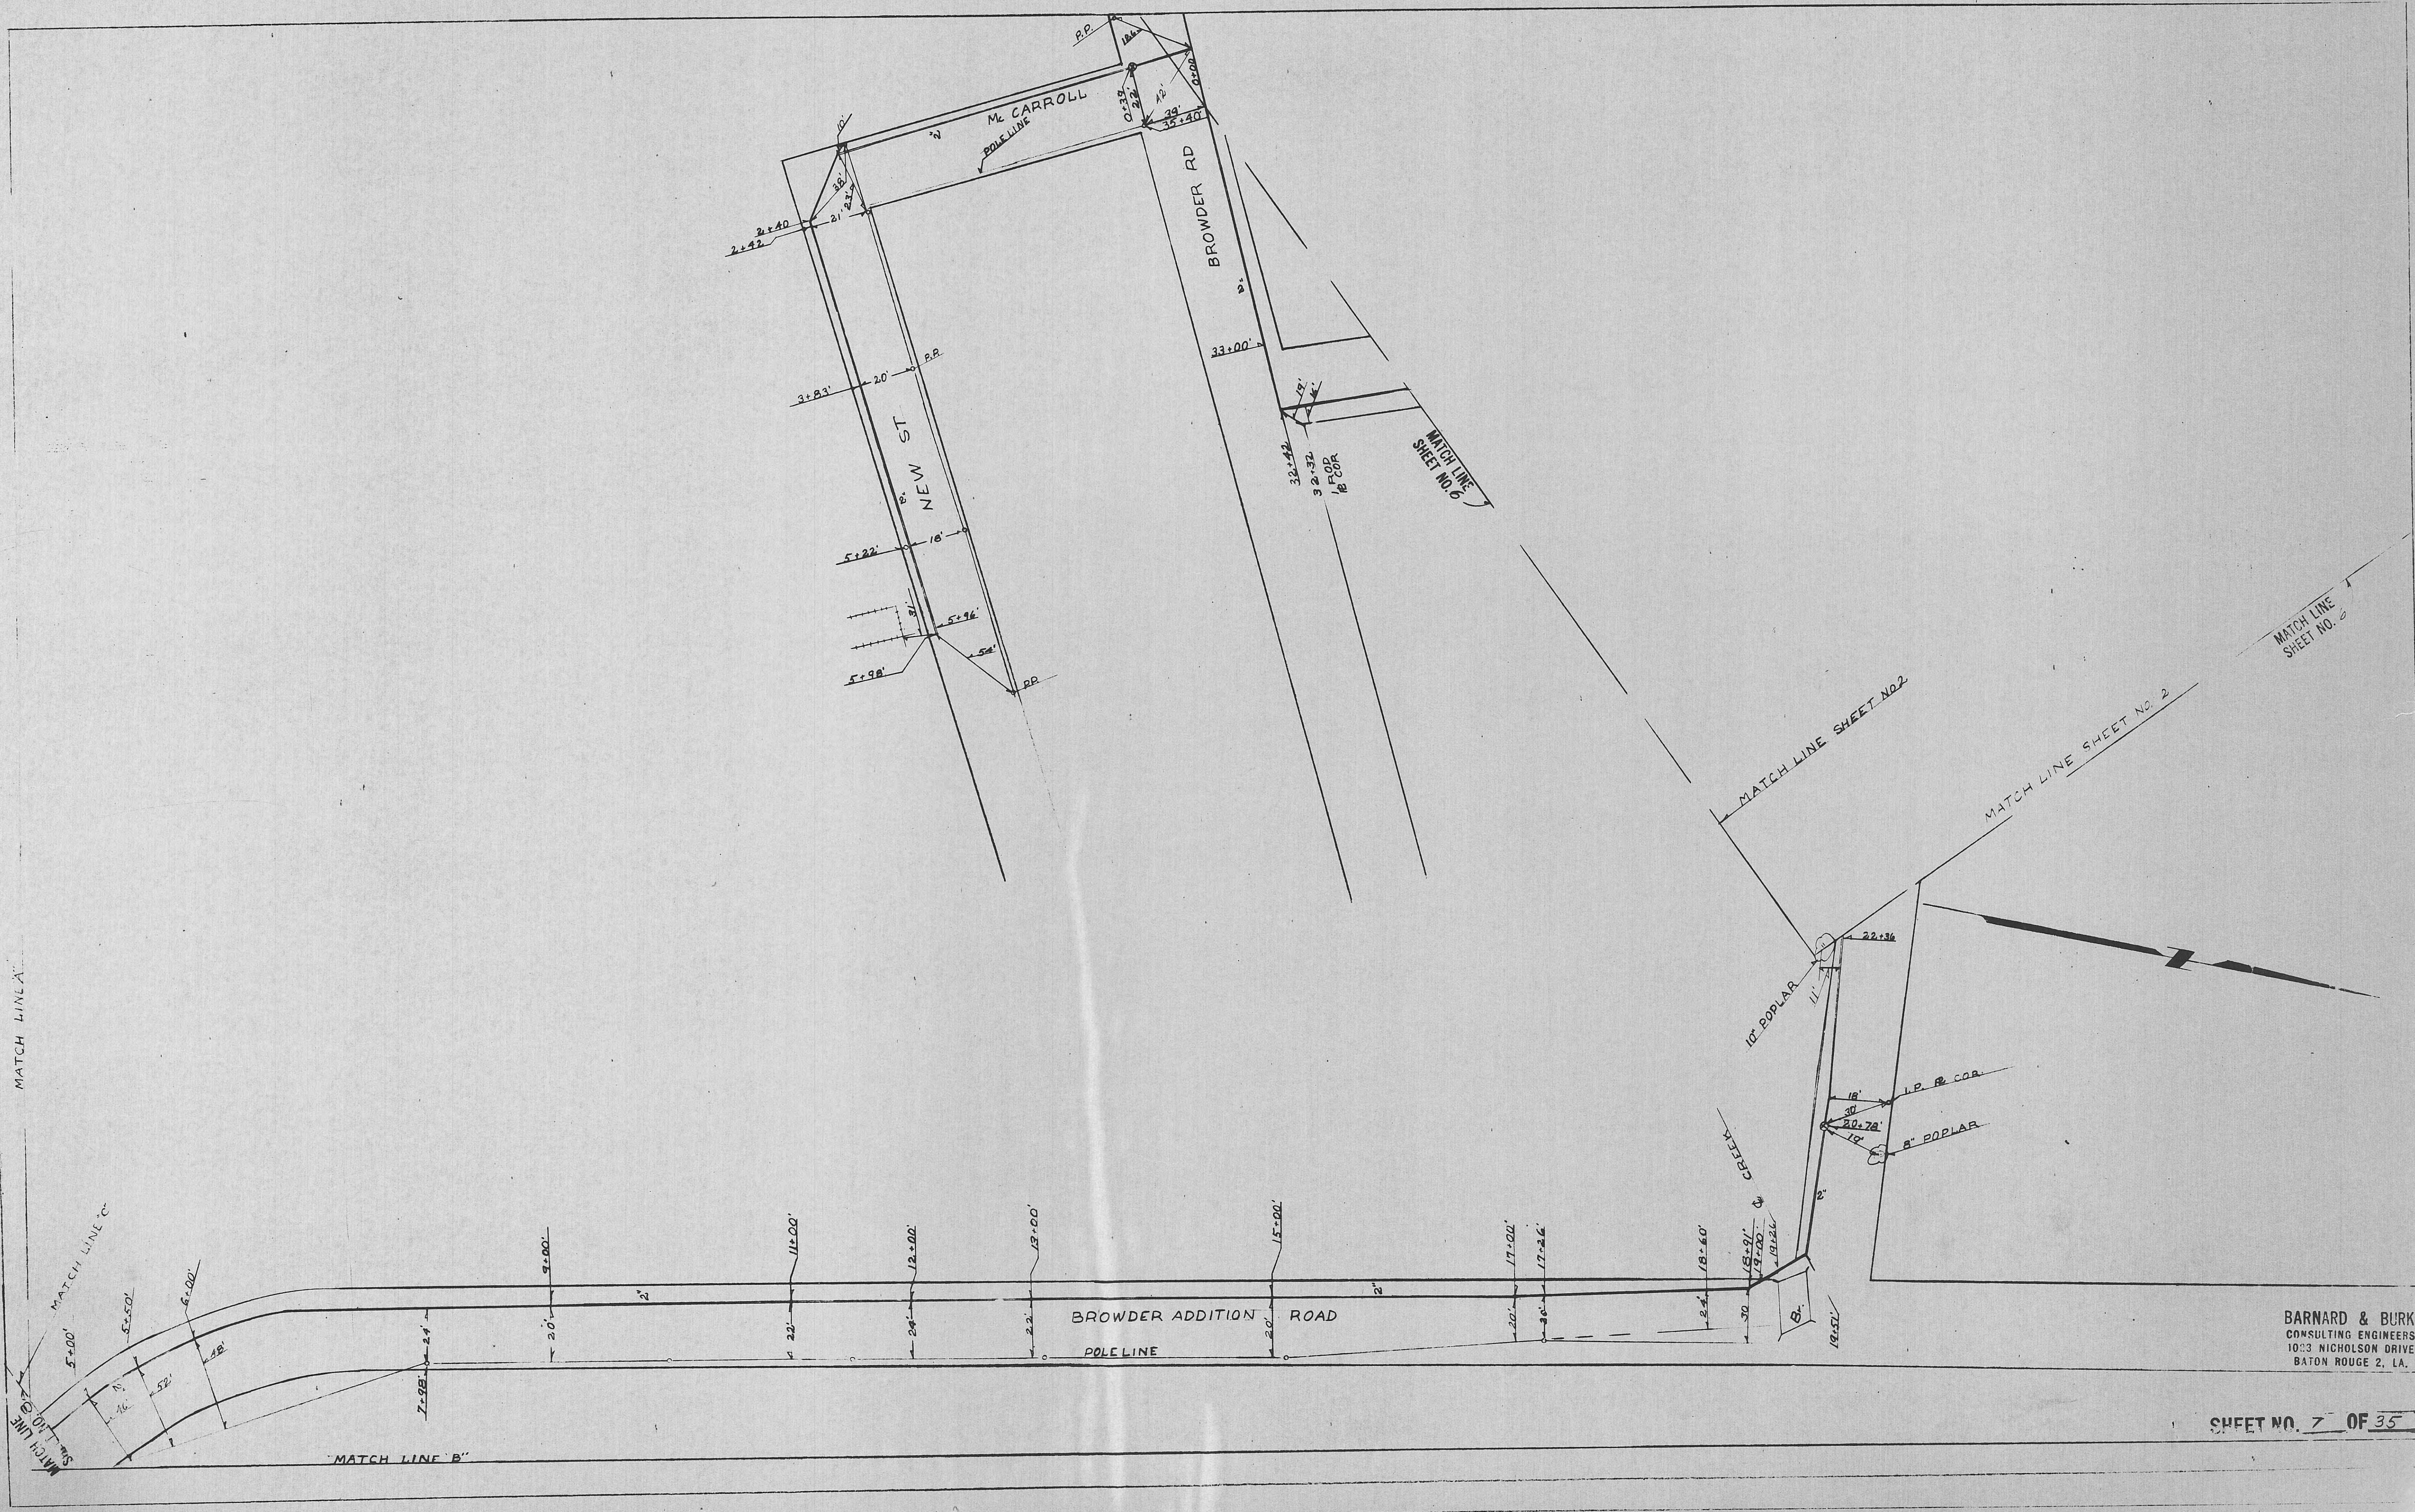


**BARNARD & BURK
CONSULTING ENGINEERS
1023 NICHOLSON DRIVE
BATON ROUGE 2, LA.**

SHEET NO. 7 OF 35

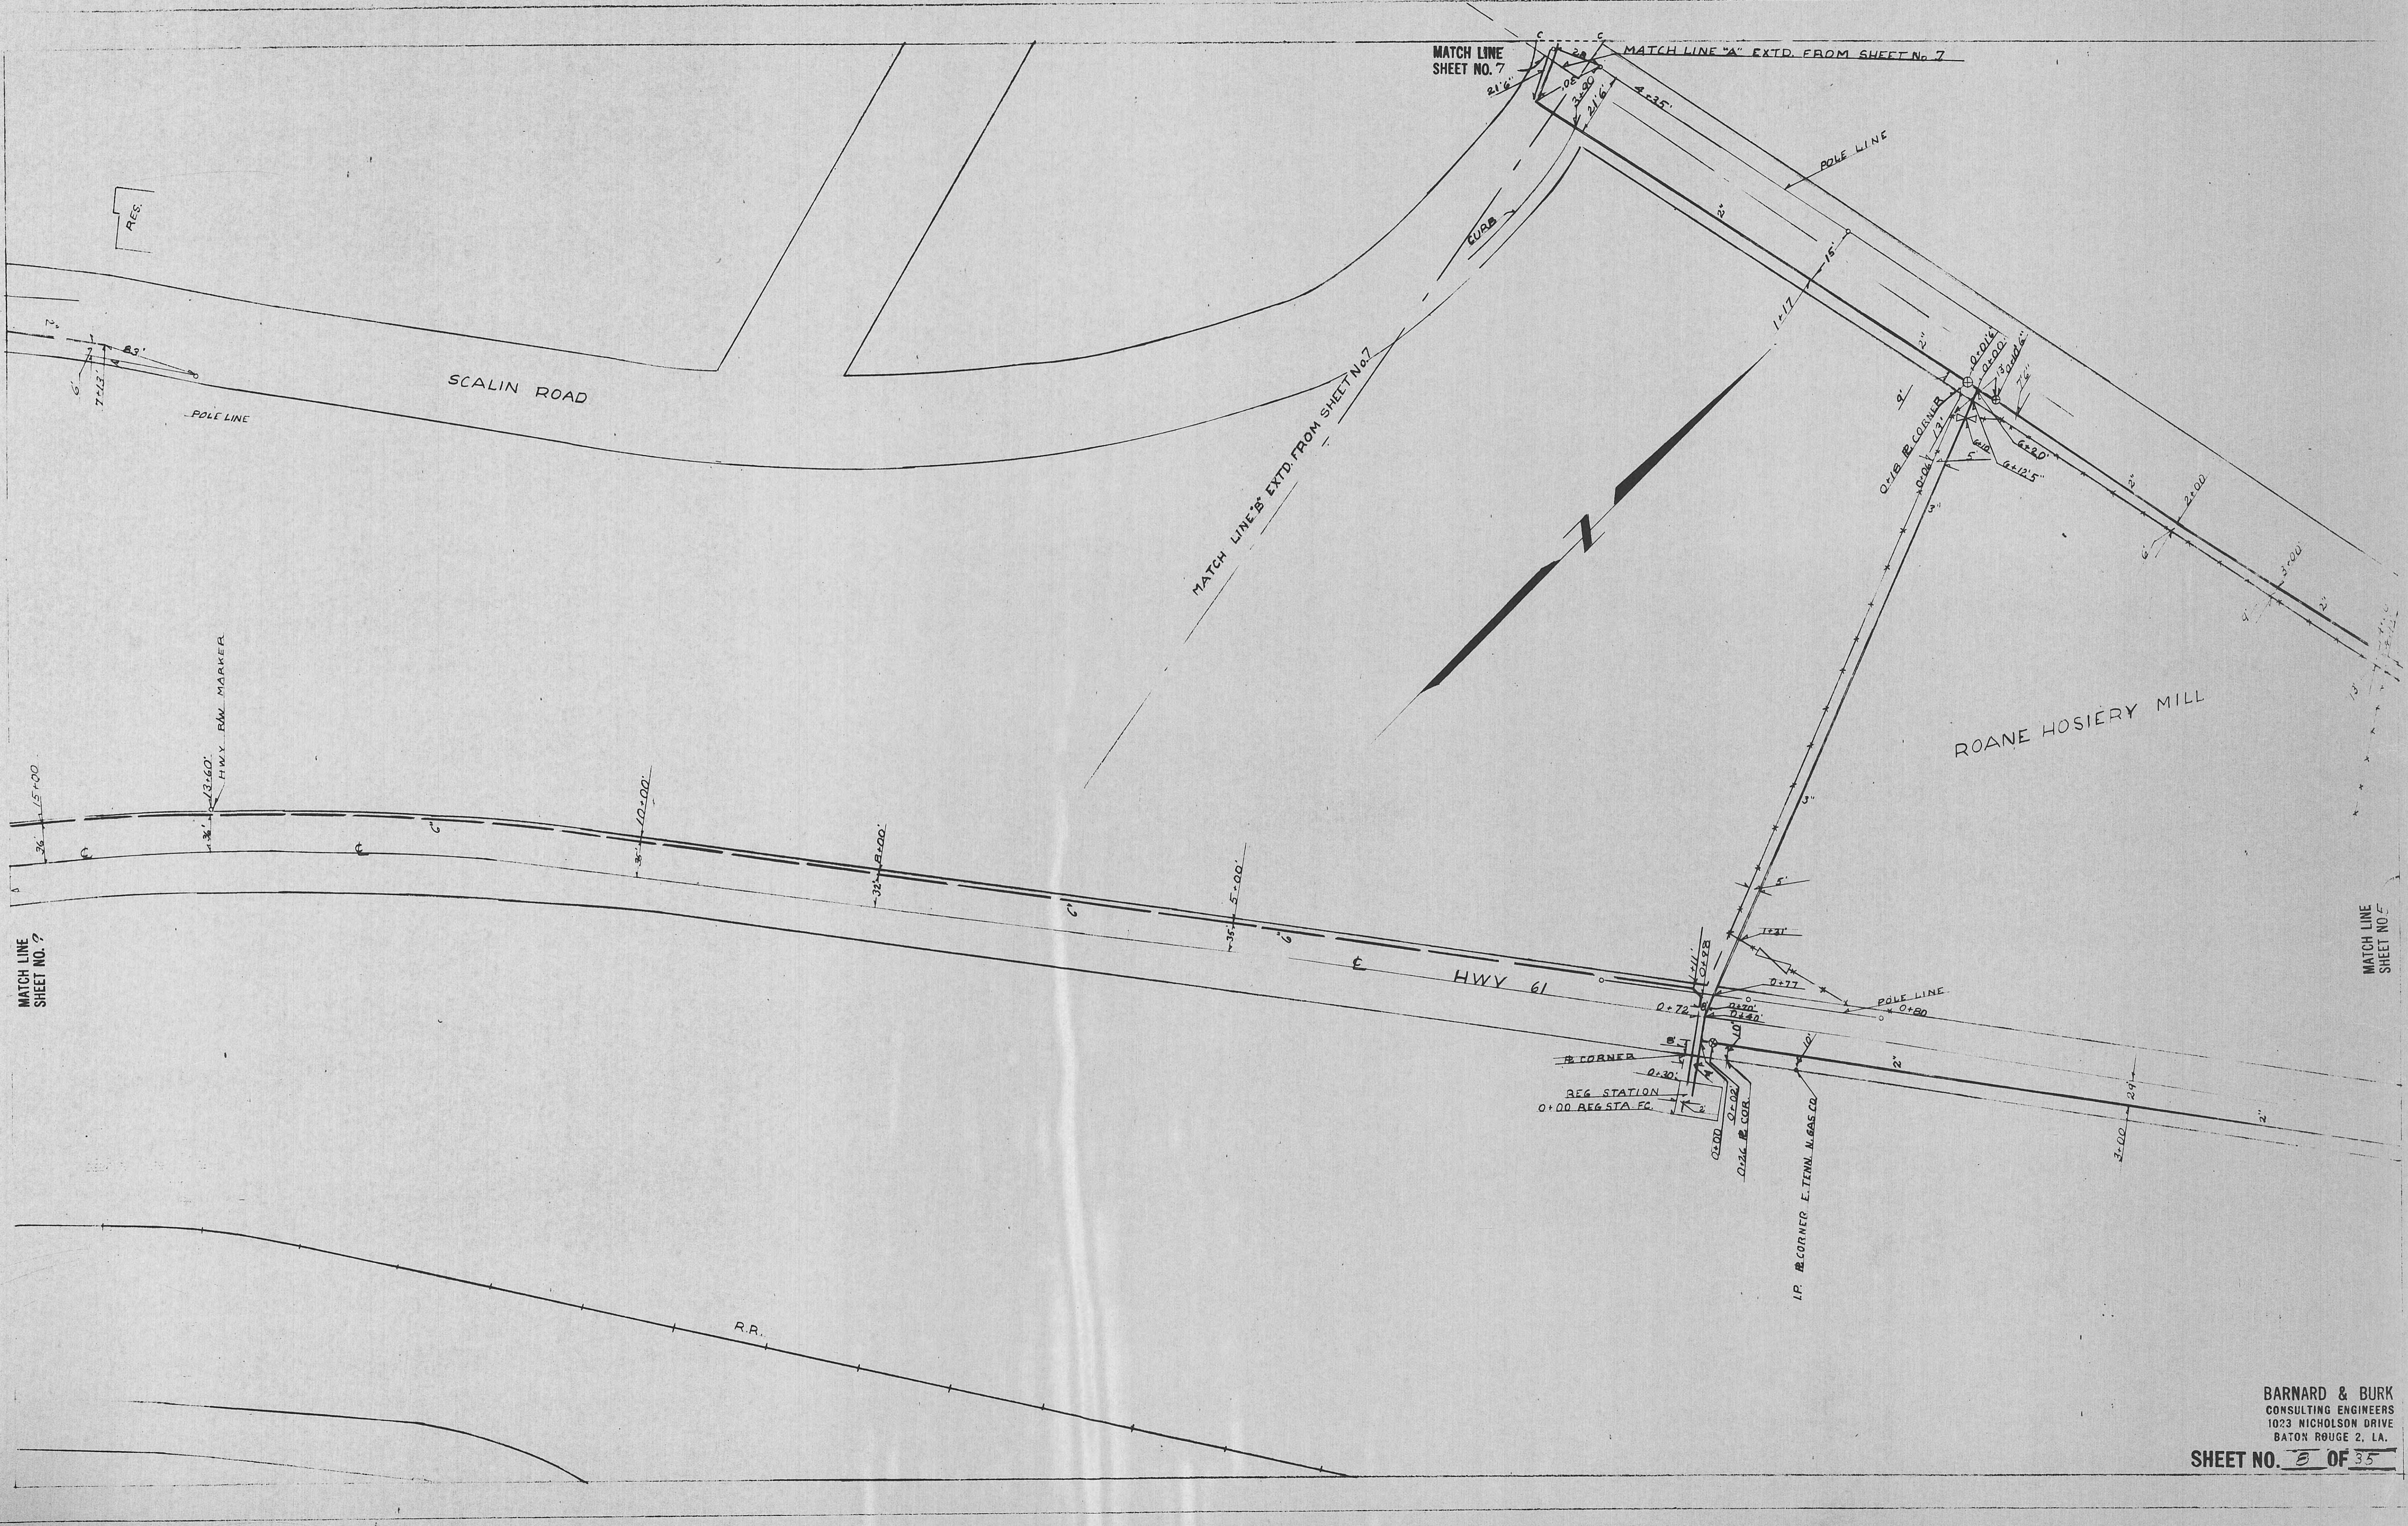

**MATCH LINE
SHEET NO. 10**

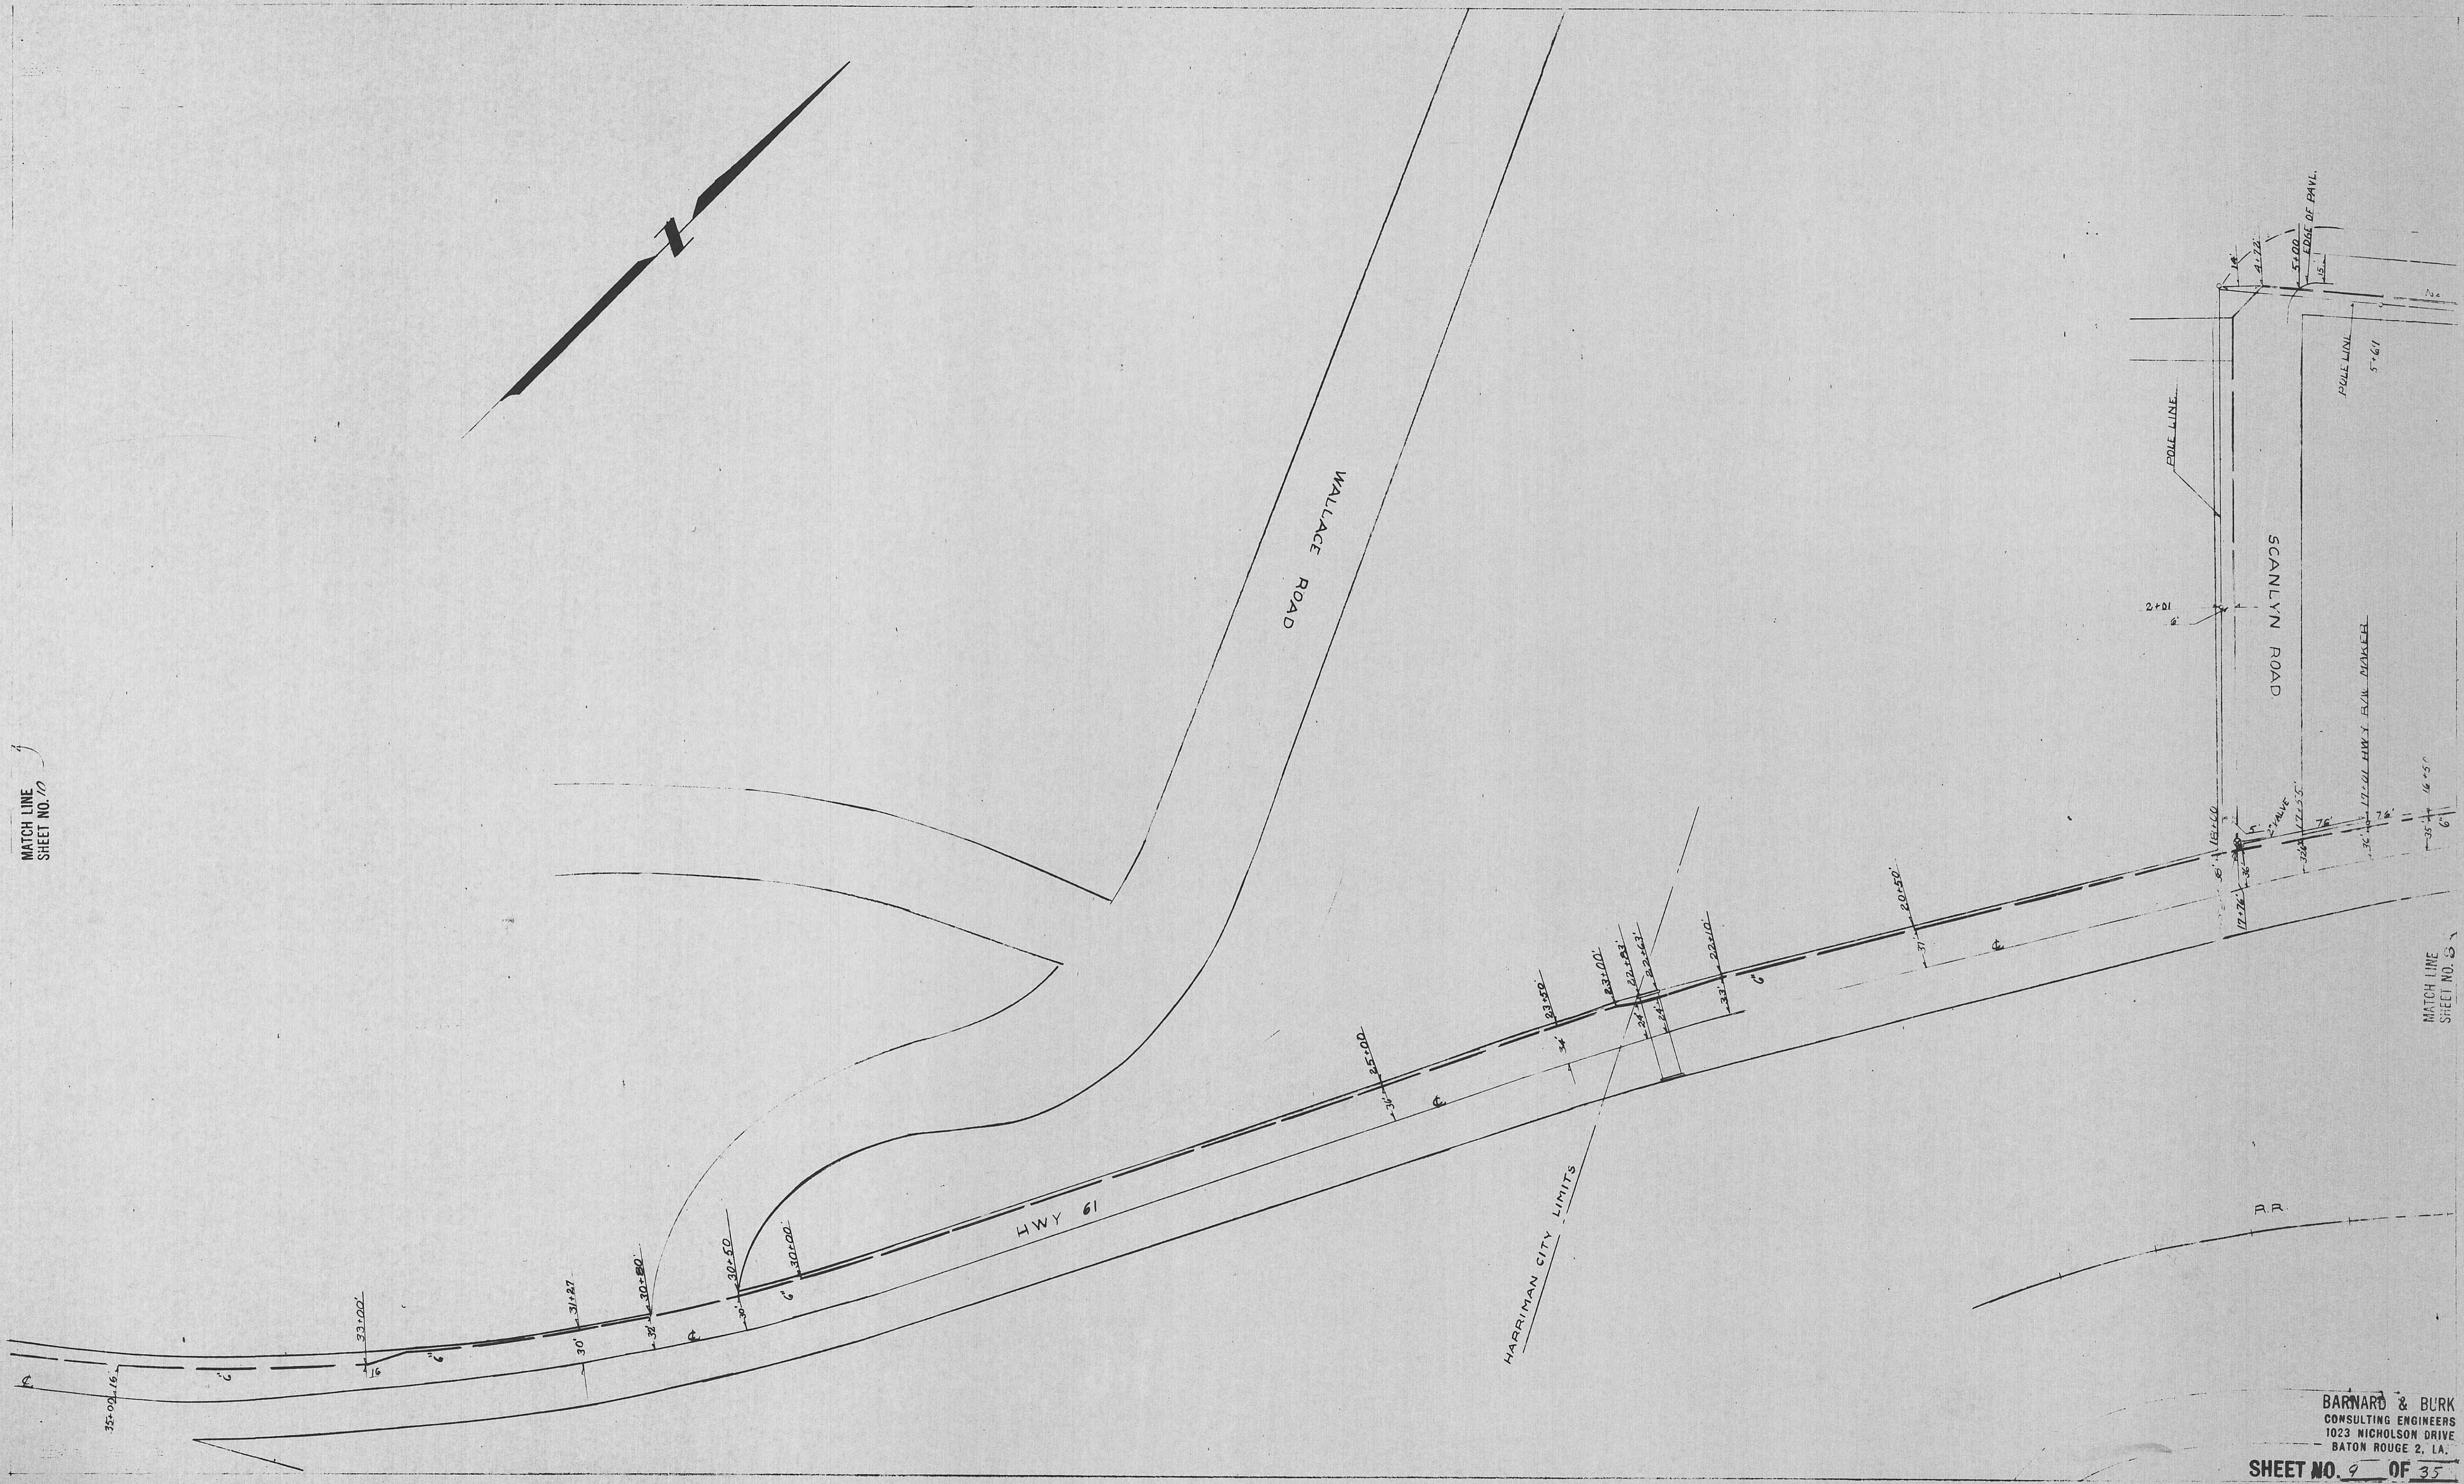

**BARNARD & BURK
CONSULTING ENGINEERS
1023 NICHOLSON DRIVE
BATON ROUGE 2, LA.**

SHEET NO. 9 OF 35