



REHABILITATION SCHEDULE

o See Sheet Nos. 14 and 15.


NOTE: The Following Manholes Raised To Grade:

1

RECORD DRAWINGS

Revisions Drawn by M. S. HALES Date 10-83

THESE RECORD DRAWINGS HAVE BEEN PREPARED, IN PART, ON THE BASIS OF INFORMATION COMPILED BY OTHERS. THEY ARE NOT INTENDED TO REPRESENT IN DETAIL THE EXACT LOCATION, TYPE OF COMPONENT NOR MANNER OF CONSTRUCTION. THE ENGINEER WILL NOT BE RESPONSIBLE FOR ANY ERRORS OR OMISSIONS WHICH HAVE BEEN INCORPORATED INTO THE RECORD DRAWINGS.

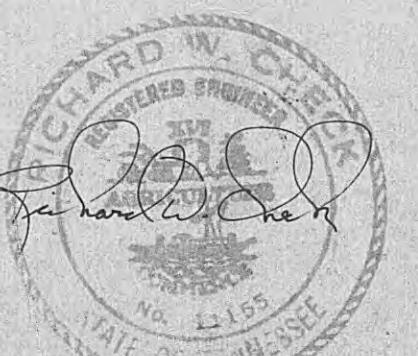

EXISTING WASTEWATER COLLECTION SYSTEM SEWER REHABILITATION

DRAWN BY: J.M.C. DATE: JAN 11
CHECKED BY: CCSE SW FILE NO.: 71

SCALE: 1" = 200'


PLAN AND SCHEDULE

HARRIMAN - TENNESSEE

[View all reviews](#) | [Write a review](#)

CH₂M
NO.

REHABILITATION SCHEDULE

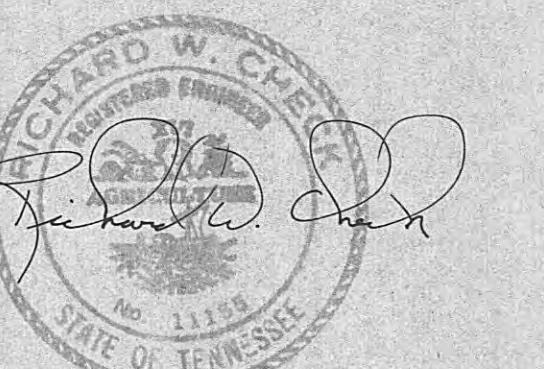

SMOKE TESTED ENTIRE MEADOWVIEW SYSTEM 4TH QTR '94

RECORD DRAWINGS

Revisions Drawn by M.S. HALES **Date** 10-83

THESE RECORD DRAWINGS HAVE BEEN PREPARED, IN PART, ON THE BASIS OF INFORMATION COMPILED BY OTHERS. THEY ARE NOT INTENDED TO REPRESENT IN DETAIL THE EXACT LOCATION, TYPE OF COMPONENT NOR MANNER OF CONSTRUCTION. THE ENGINEER WILL NOT BE RESPONSIBLE FOR ANY ERRORS OR OMISSIONS WHICH HAVE BEEN INCORPORATED INTO THE RECORD DRAWINGS.



EXISTING WASTEWATER COLLECTION SYSTEM SEWER REHABILITATION

DRAWN BY: J.M.C. DATE: JAN. 1
CHECKED BY: C.C.S. & R.W.C. FILE NO.: 489
SCALE: 1" = 200'


PLAN AND SCHEDULE

SMOKE TESTED ENTIRE FISK HGTS., MAYS SYSTEMS 4TH QTR '94

REVISIONS			
CORD.	DESCRIPTION	DATE	APPROVED




REHABILITATION SCHEDULE

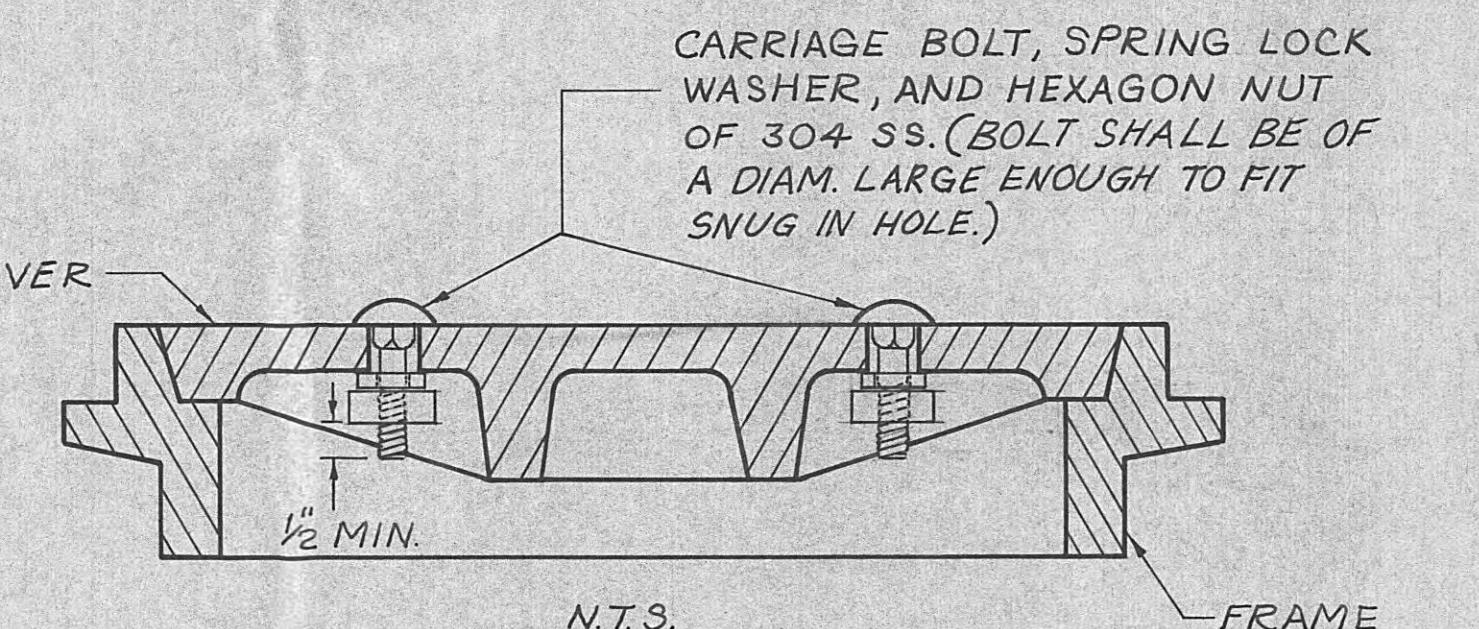

'OTE: MANHOLE COVERS WITH MORE THAN
8 HOLES SHALL BE REPLACED WITH
SOLID COVERS.

MANHOLE COVER SEALING DETAIL

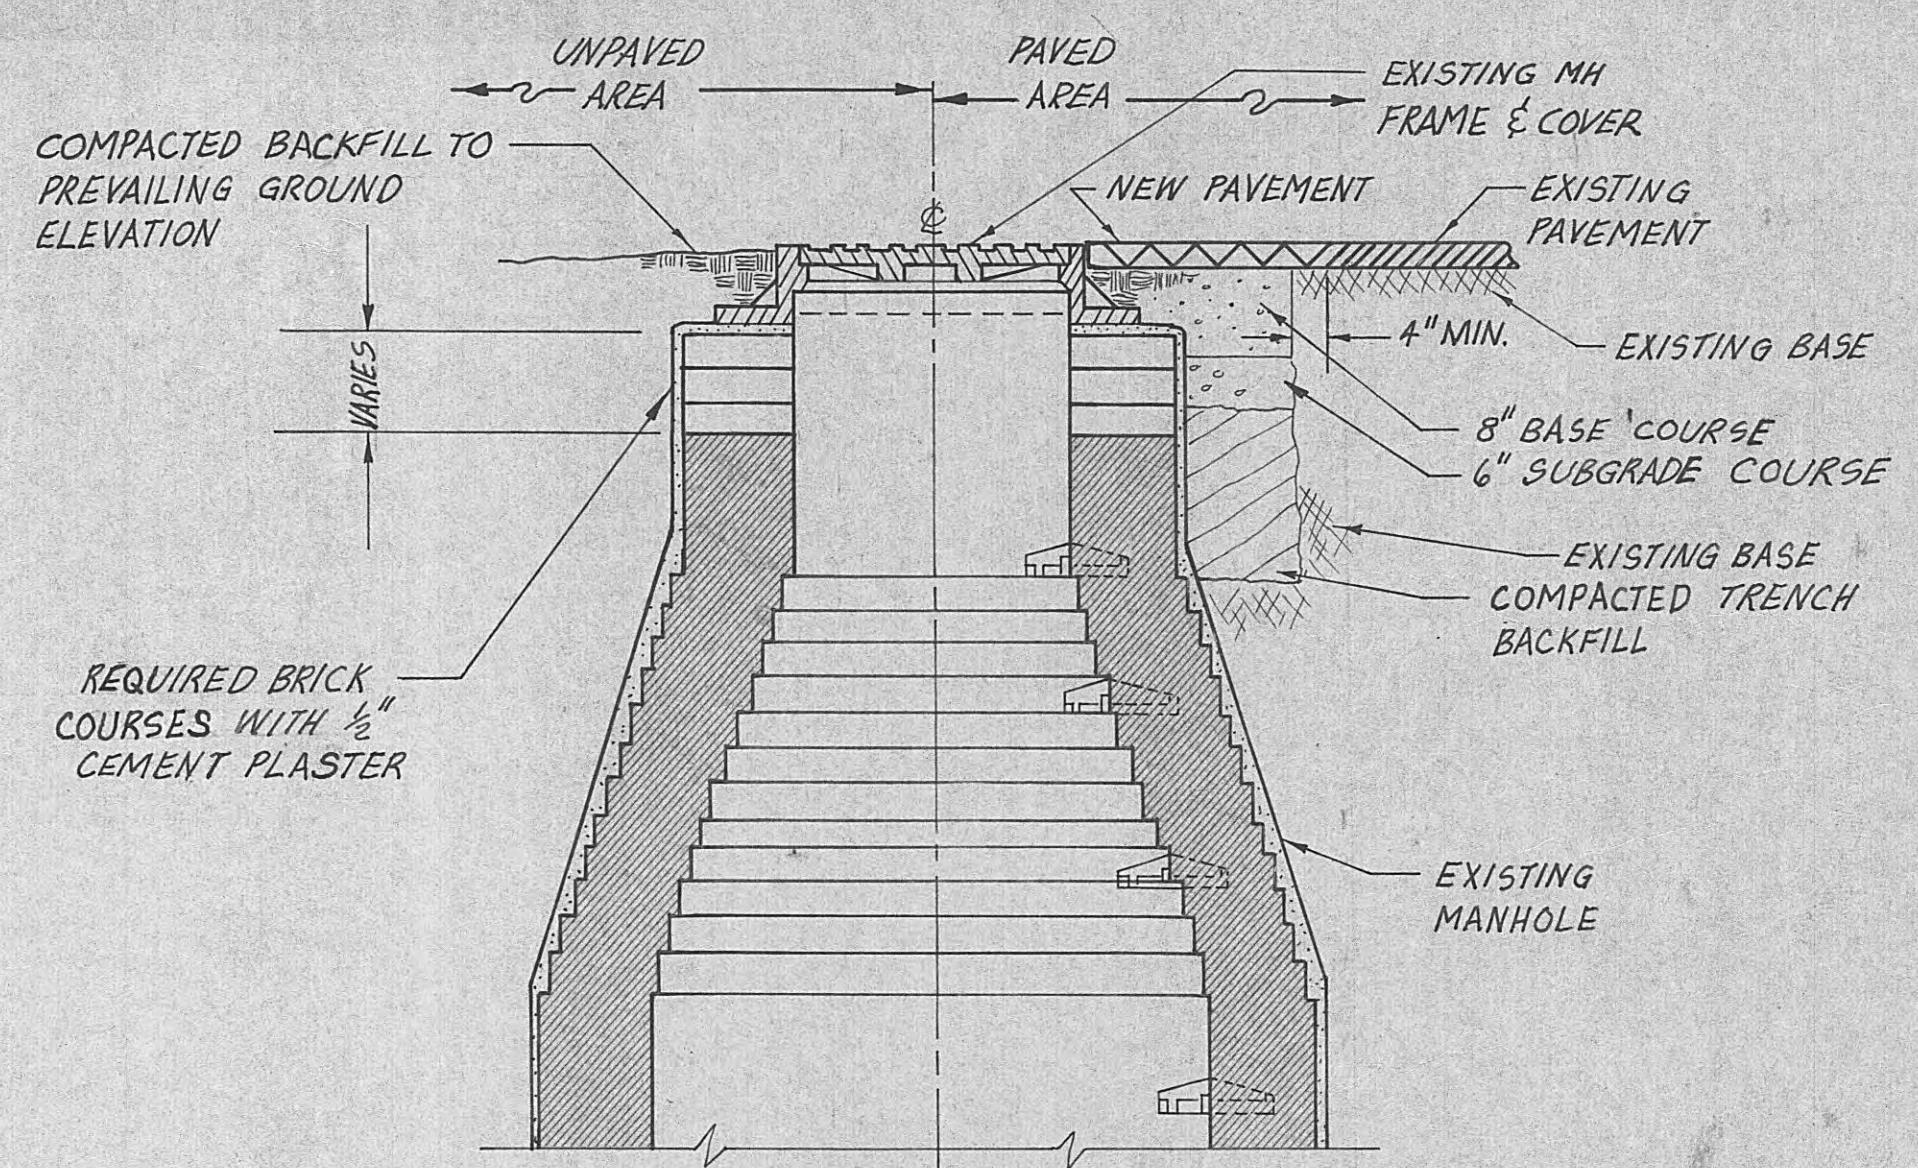

RAISING MANHOLE FRAME AND COVER

RECORD DRAWINGS

visions Drawn by M.S. HALES Date 10-83

THESE RECORD DRAWINGS HAVE BEEN PREPARED, IN PART, ON
THE BASIS OF INFORMATION COMPILED BY OTHERS. THEY ARE
NOT INTENDED TO REPRESENT IN DETAIL THE EXACT LOCATION,
TYPE OF COMPONENT NOR MANNER OF CONSTRUCTION. THE
ENGINEER WILL NOT BE RESPONSIBLE FOR ANY ERRORS OR
MISSIONS WHICH HAVE BEEN INCORPORATED INTO THE
COPIED DRAWINGS.



EXISTING WASTEWATER COLLECTION SYSTEM SEWER REHABILITATION

DRAWN BY: J. M. C. DATE: JAN. 1981
CHECKED BY: C.C.S. & R.W.C. FILE NO. 48402.71

PLAN AND SCHEDULE
STANDARD DETAILS
RRIMAN - TENNESSEE

SHEET
NO.
(12)




REHABILITATION SCHEDULE											
SEWER SECTION (Manhole) - (Manhole)	PIPE TYPE & DIAMETER (Inches)	LENGTH OF SECTION (Feet)	ESTIMATED NUMBER OF JOINTS	ESTIMATED CHEMICAL GROUTING (No. Joints)	ROOT TREATMENT (Feet)	EXCAVATE AND REPLACE (Feet)	MANHOLE SEALING (Manhole)	AVERAGE MANHOLE DEPTH (Feet)	MANHOLE COVER REPLACEMENT (Manhole)	MANHOLE COVER SEALING (Manhole)	TV INSPECTION (Feet)
X65 - X66	8 CP	280	67	2	278			5.0	X65		280
X70 - X71	8 VCP	230	56	4				8.0			230
X71 - X72	8 VCP	220	55	6				10.0			220
X44 - X45	8 VCP	236	54	11							236
									X68		
									X51,		
									X56, X67,		
									X69, X70,		
									X71, X72,		
									X73 X66		

RECORD DRAWINGS


Revisions Drawn by M.S. HALES Date 10/83

THESE RECORD DRAWINGS HAVE BEEN PREPARED IN PART ON THE BASIS OF INFORMATION COMPILED BY OTHERS. THEY ARE NOT INTENDED TO REPRESENT IN DETAIL THE EXACT LOCATION, TYPE OF COMPONENT NOR MANNER OF CONSTRUCTION. THE ENGINEER WILL NOT BE RESPONSIBLE FOR ANY ERRORS OR OMISSIONS WHICH HAVE BEEN INCORPORATED INTO THE RECORD DRAWINGS.

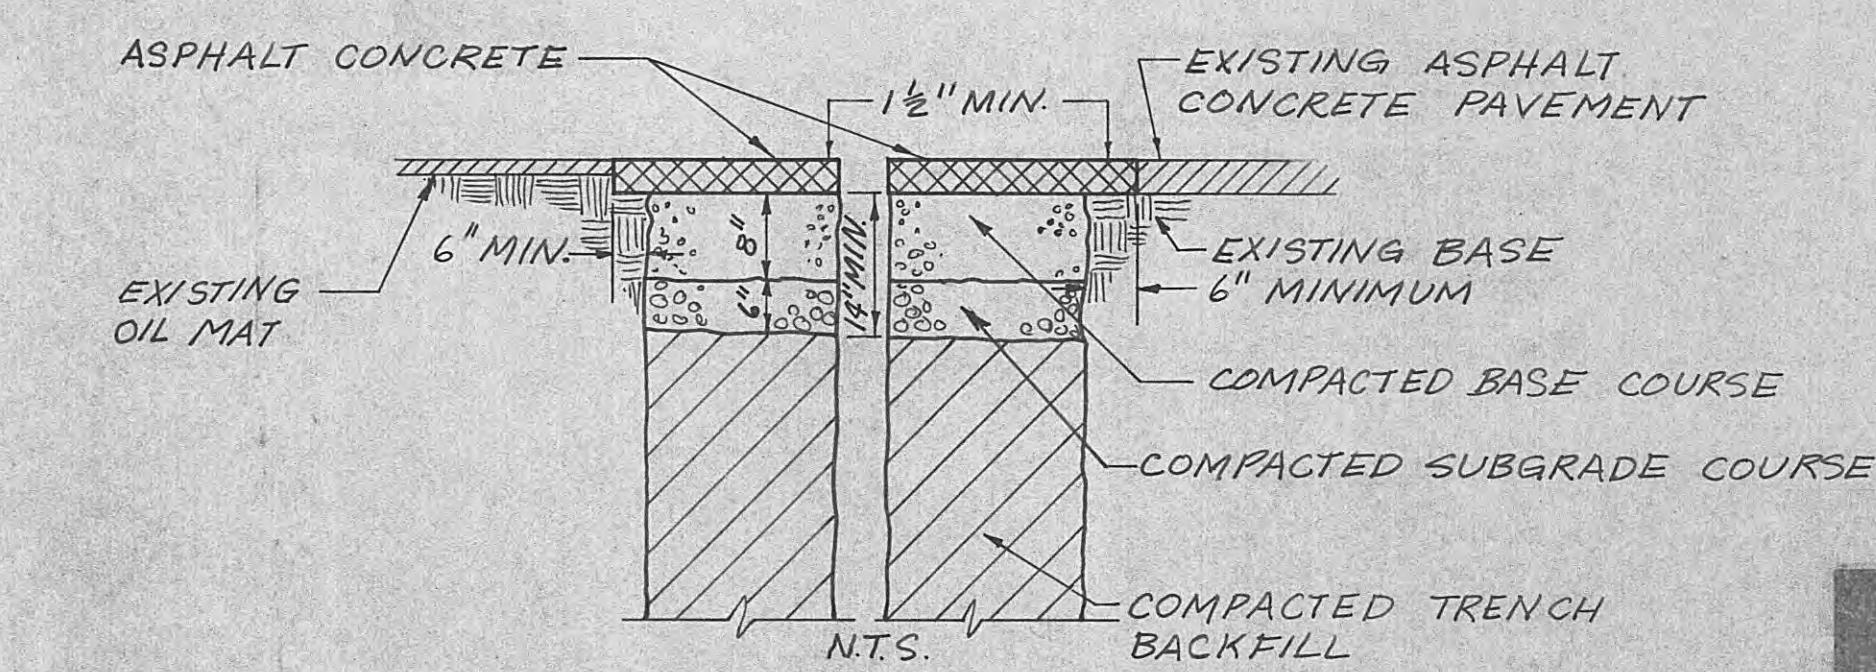

TYPICAL PAVEMENT RESTORATION
DETAIL


EXISTING WASTEWATER COLLECTION SYSTEM SEWER REHABILITATION	
DRAWING NO. 100-1000	DATE JAN. 1983
CHECKED BY CLIFFORD FILE NO. 1000211	SCALE 1:100
CHAMBERS	NO. DESCRIPTION DATE
	REVISIONS
PLAN AND SCHEDULE STANDARD DETAILS	
HARRIMAN - TENNESSEE	









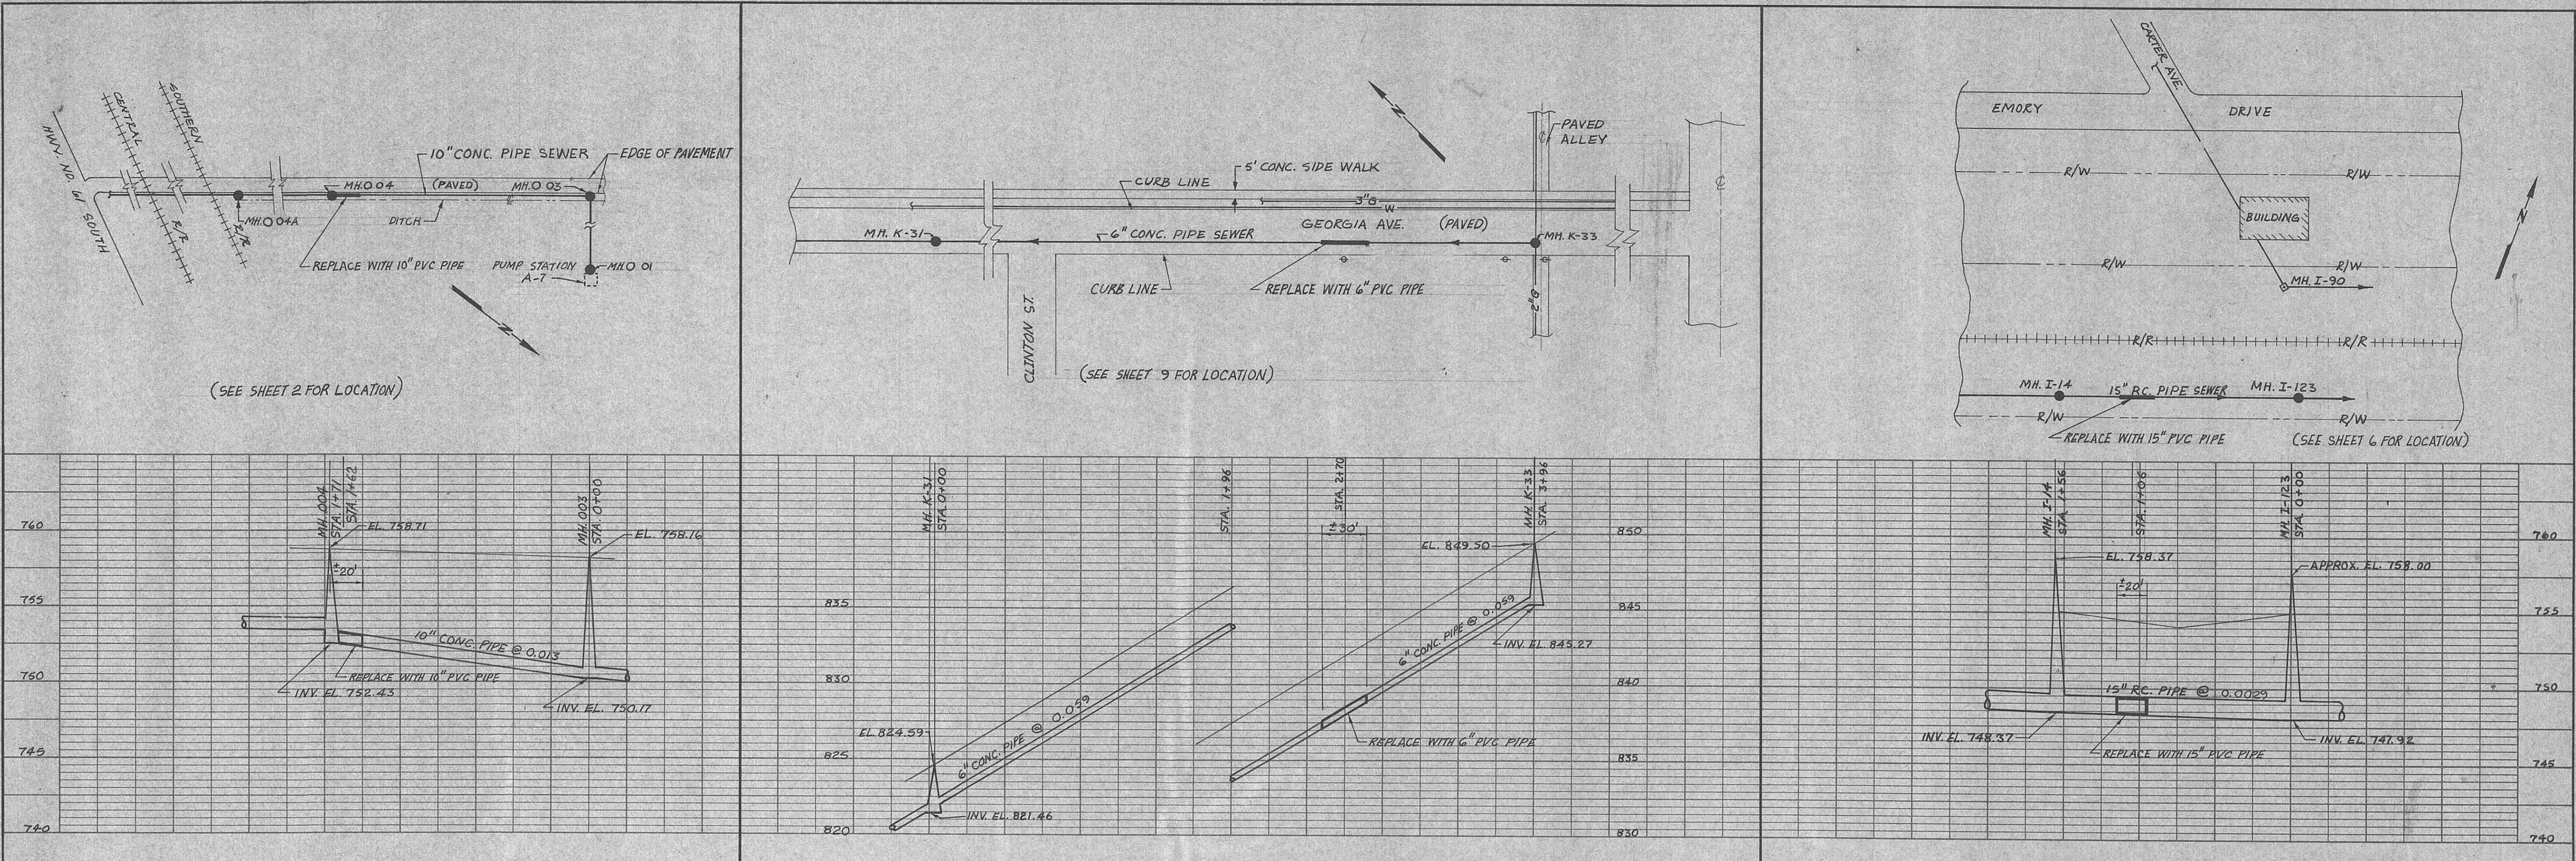


RECORD DRAWINGS

elations Drawn by M.S. HALES Date 10.83

SE RECORD DRAWINGS HAVE BEEN PREPARED, IN PART, ON BASIS OF INFORMATION COMPILED BY OTHERS. THEY ARE INTENDED TO REPRESENT IN DETAIL THE EXACT LOCATION, SIZE OF COMPONENT NOR MANNER OF CONSTRUCTION. THE ENGINEER WILL NOT BE RESPONSIBLE FOR ANY ERRORS OR OMISSIONS WHICH HAVE BEEN INCORPORATED INTO THE RECORD DRAWINGS.

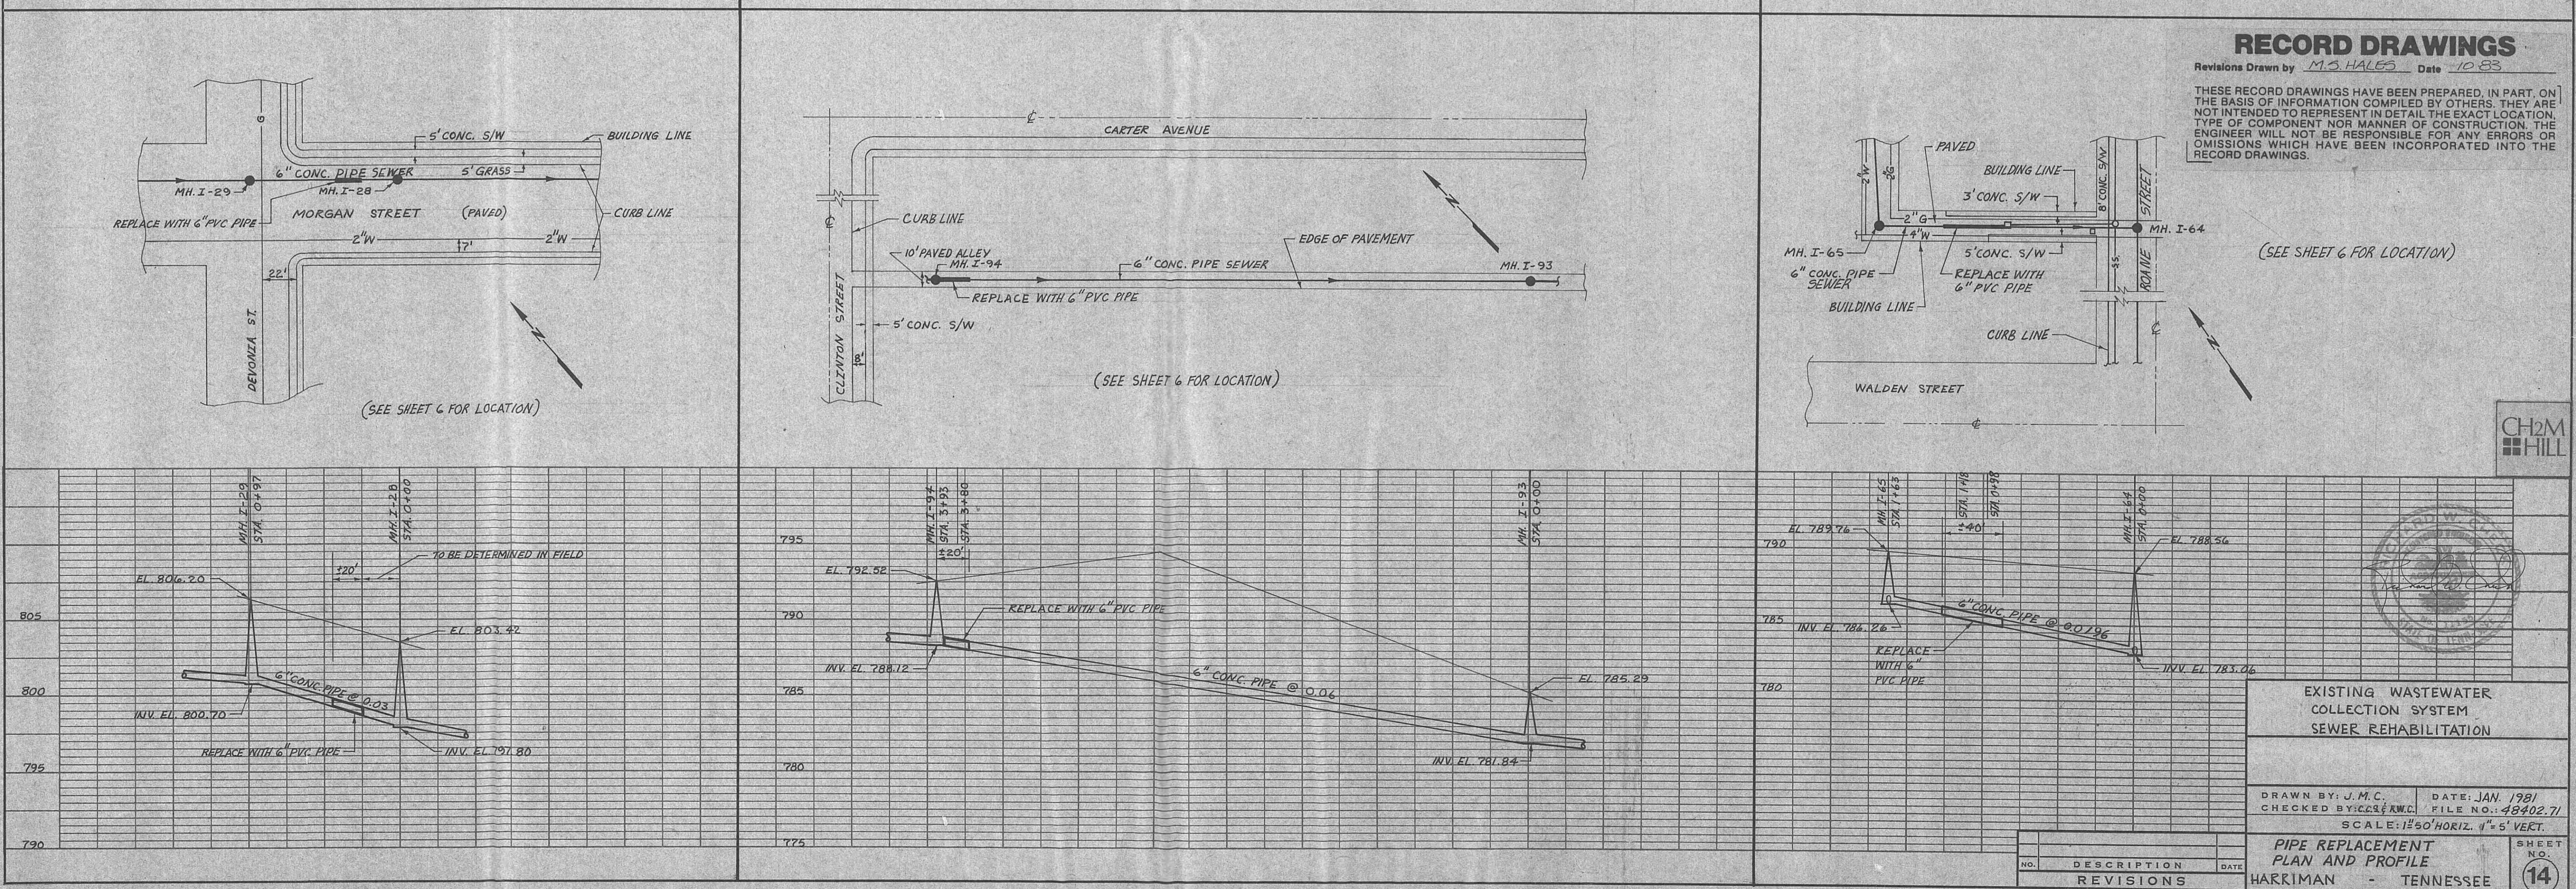

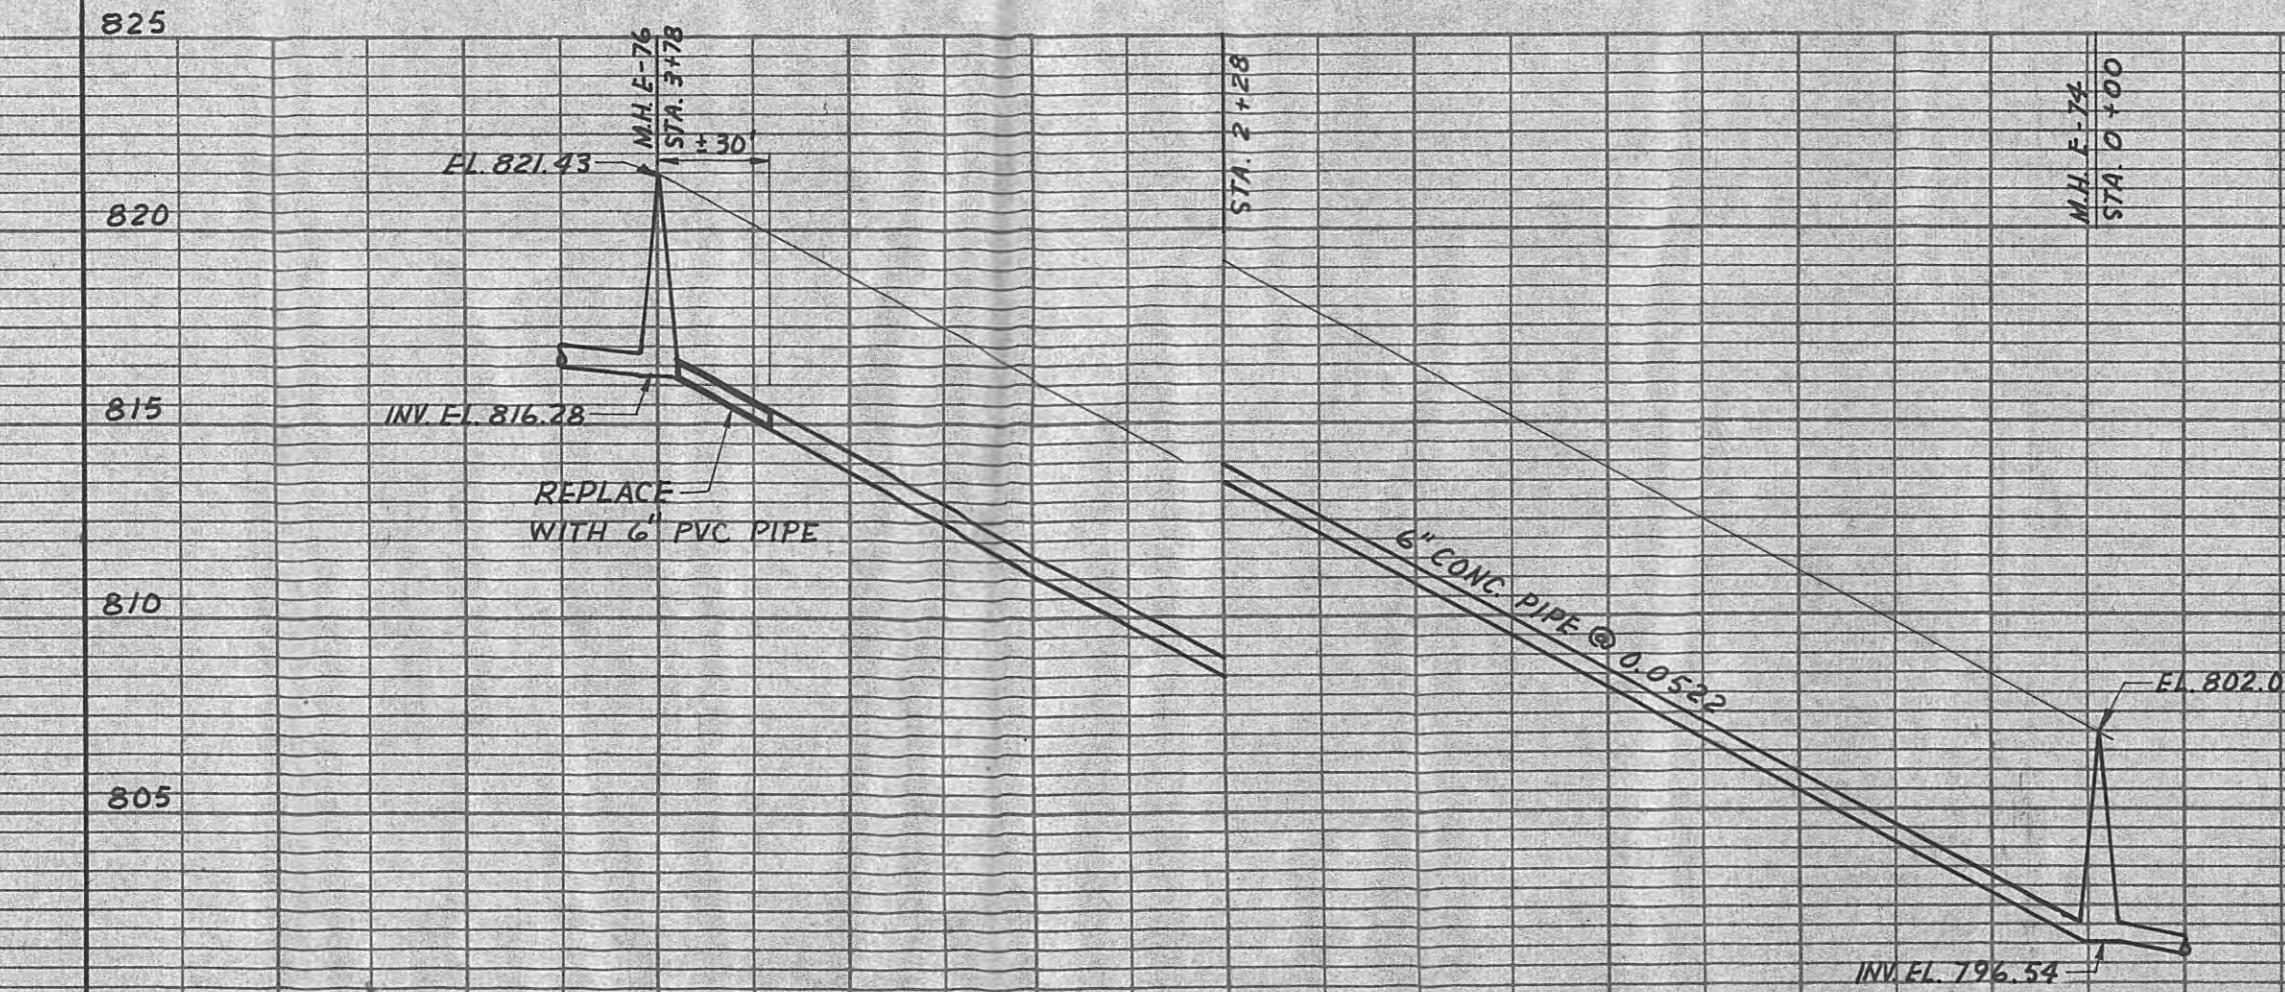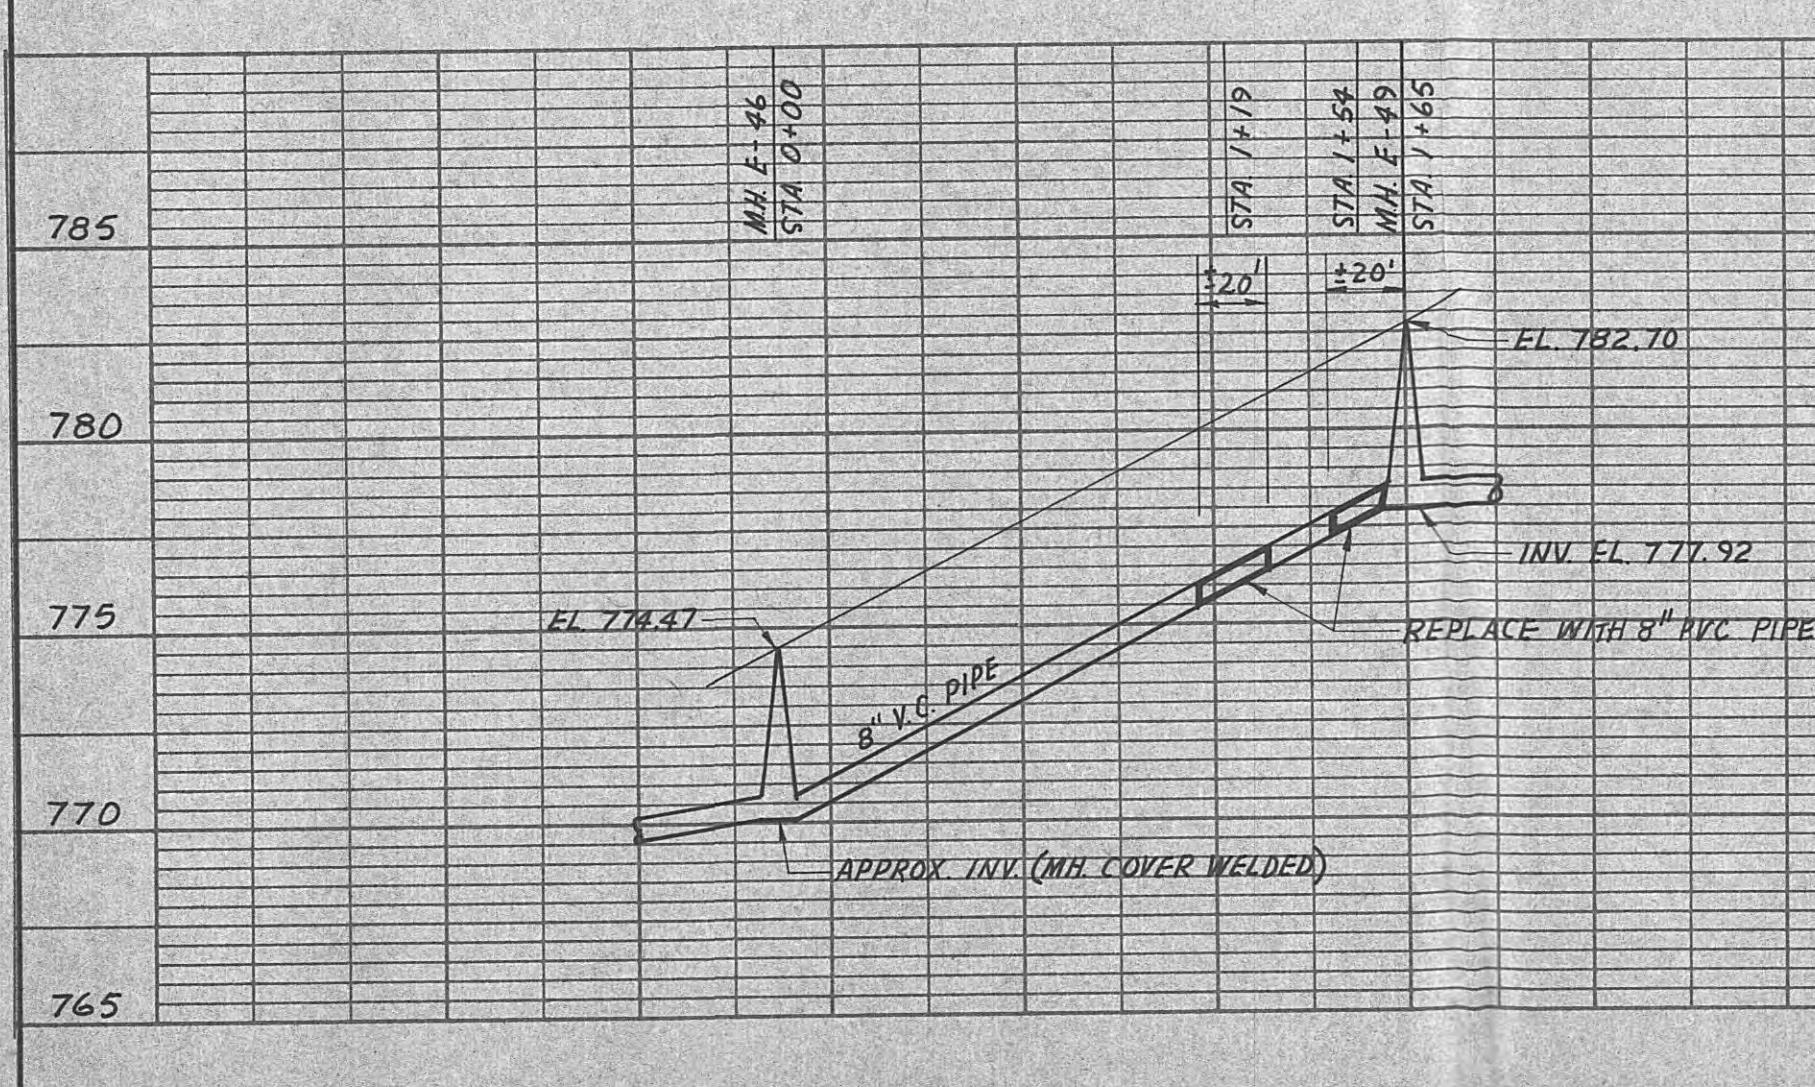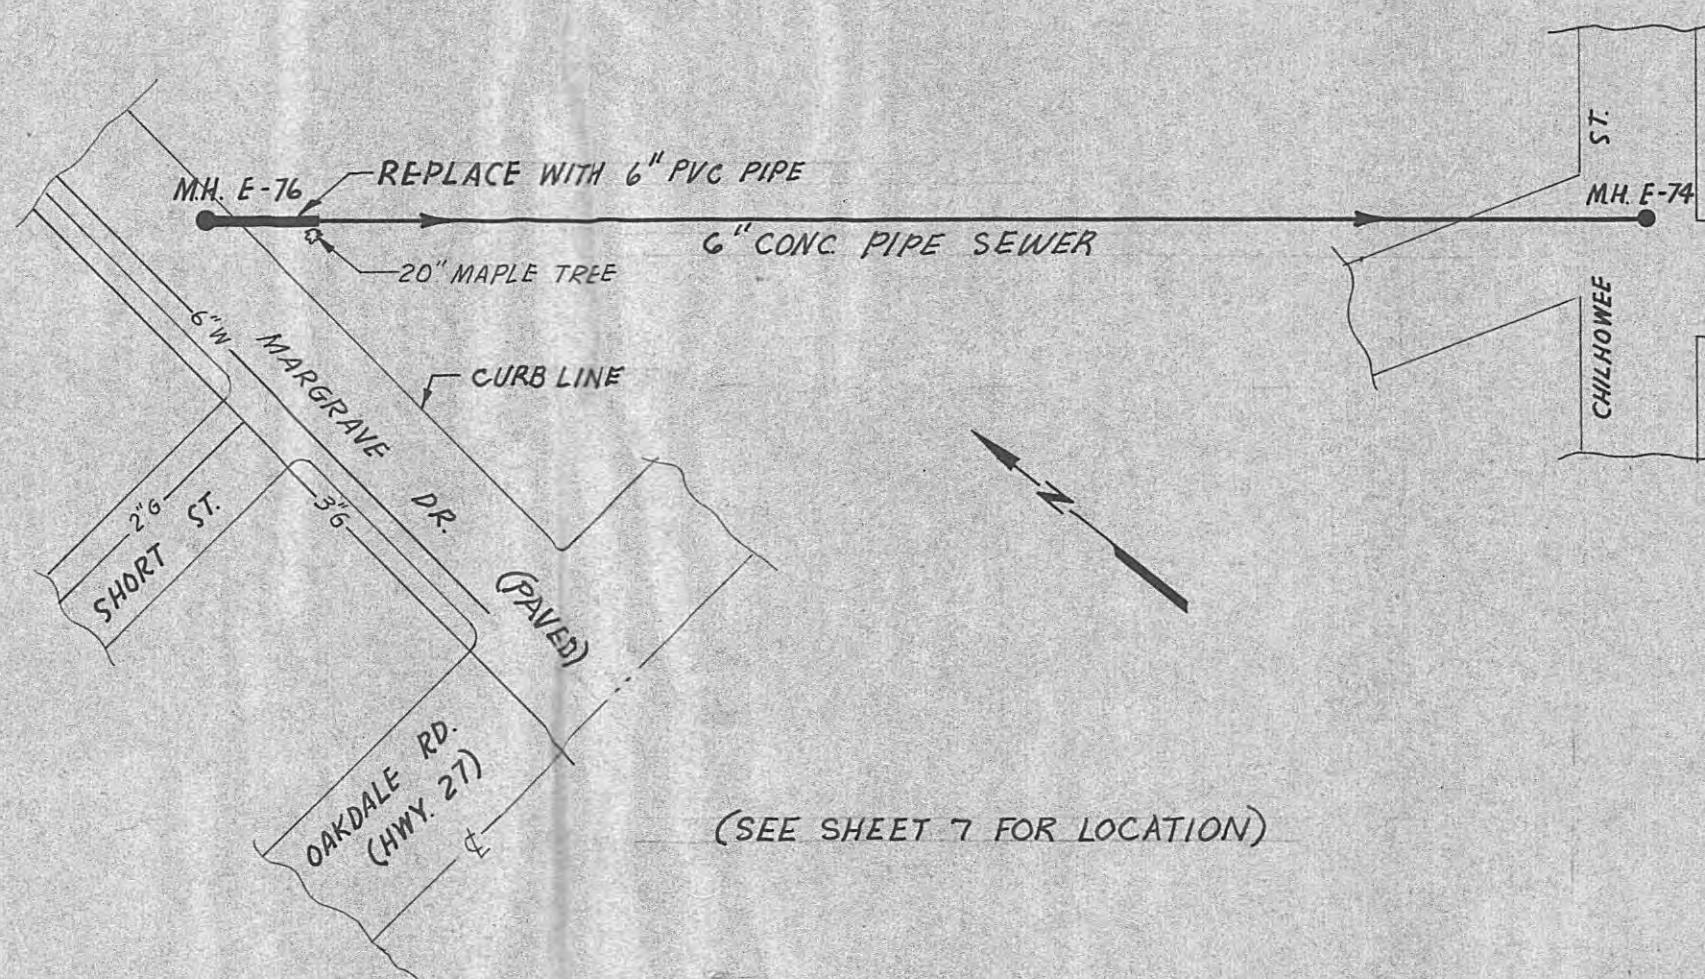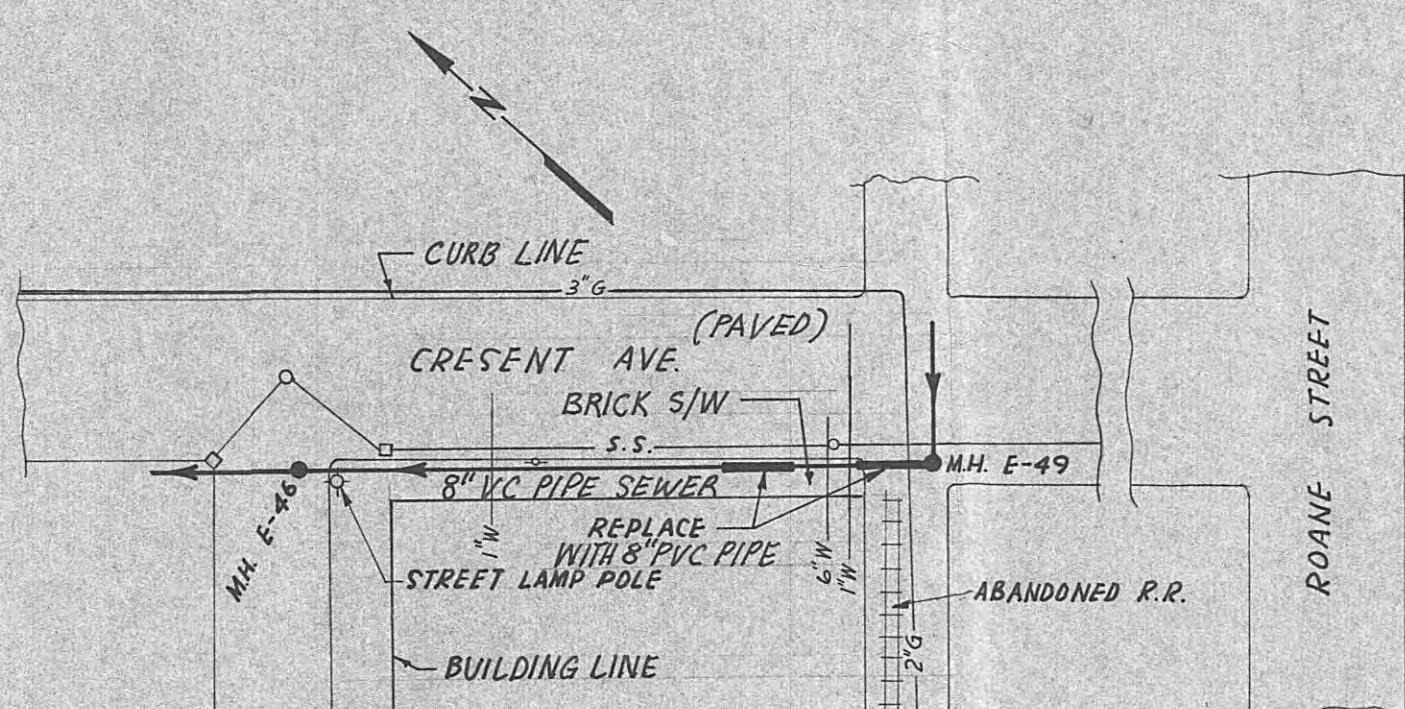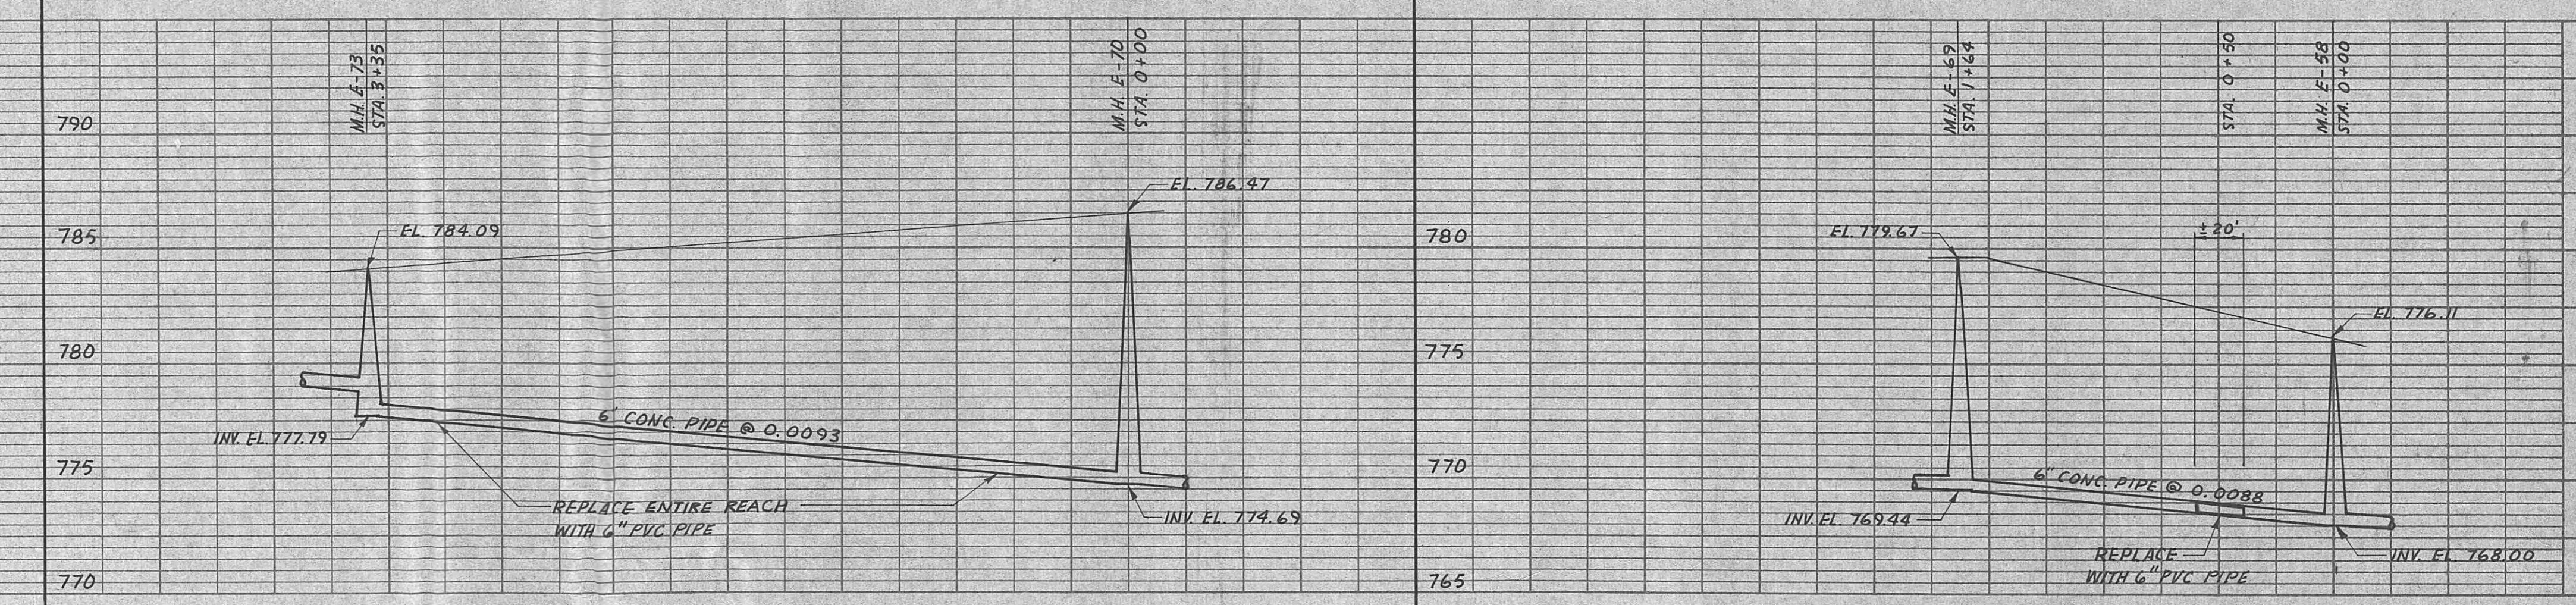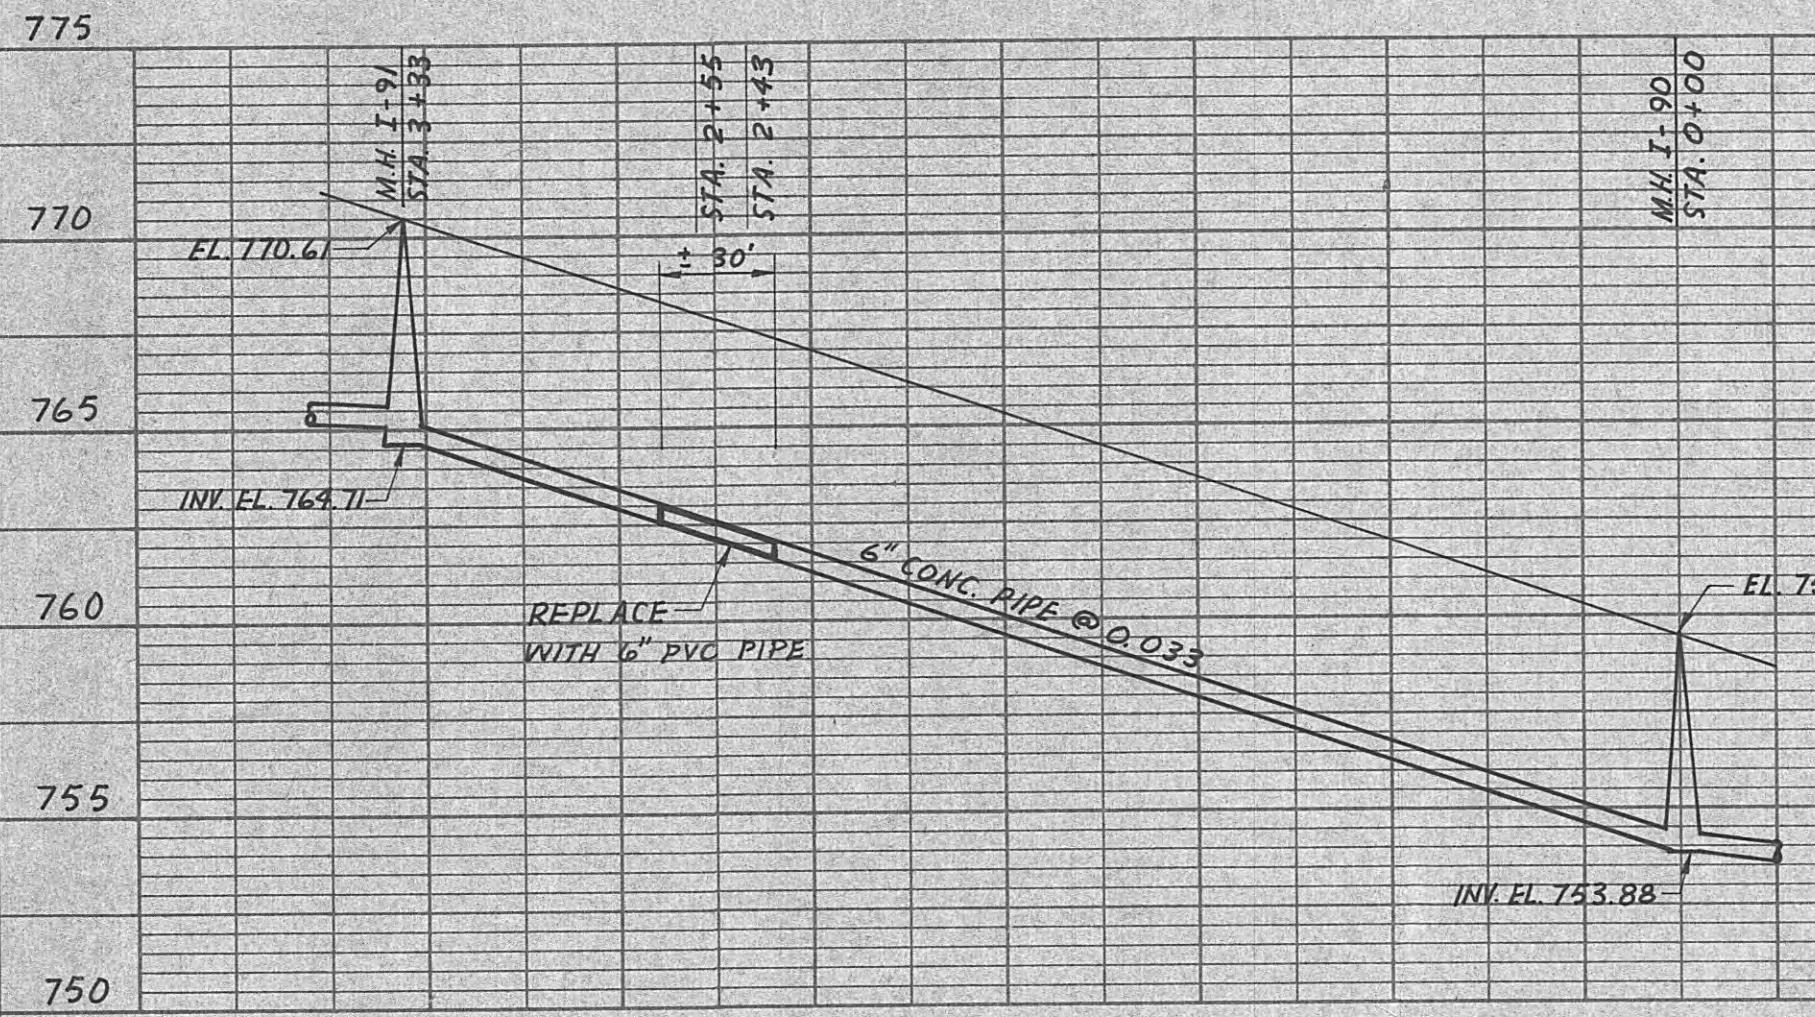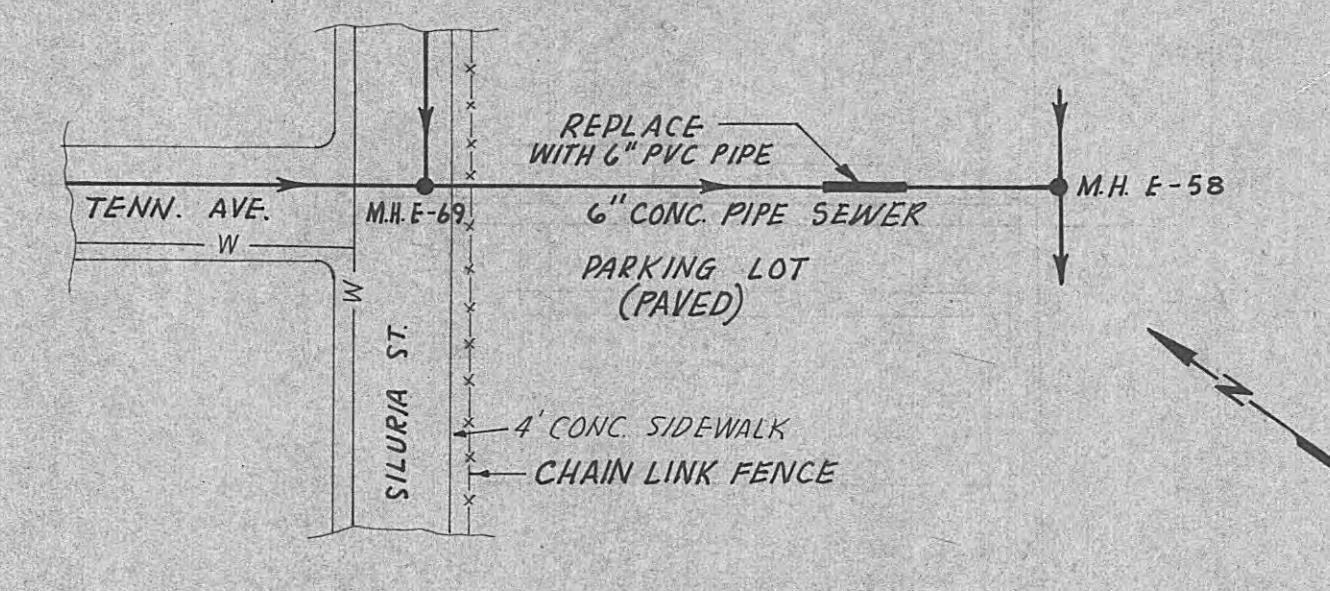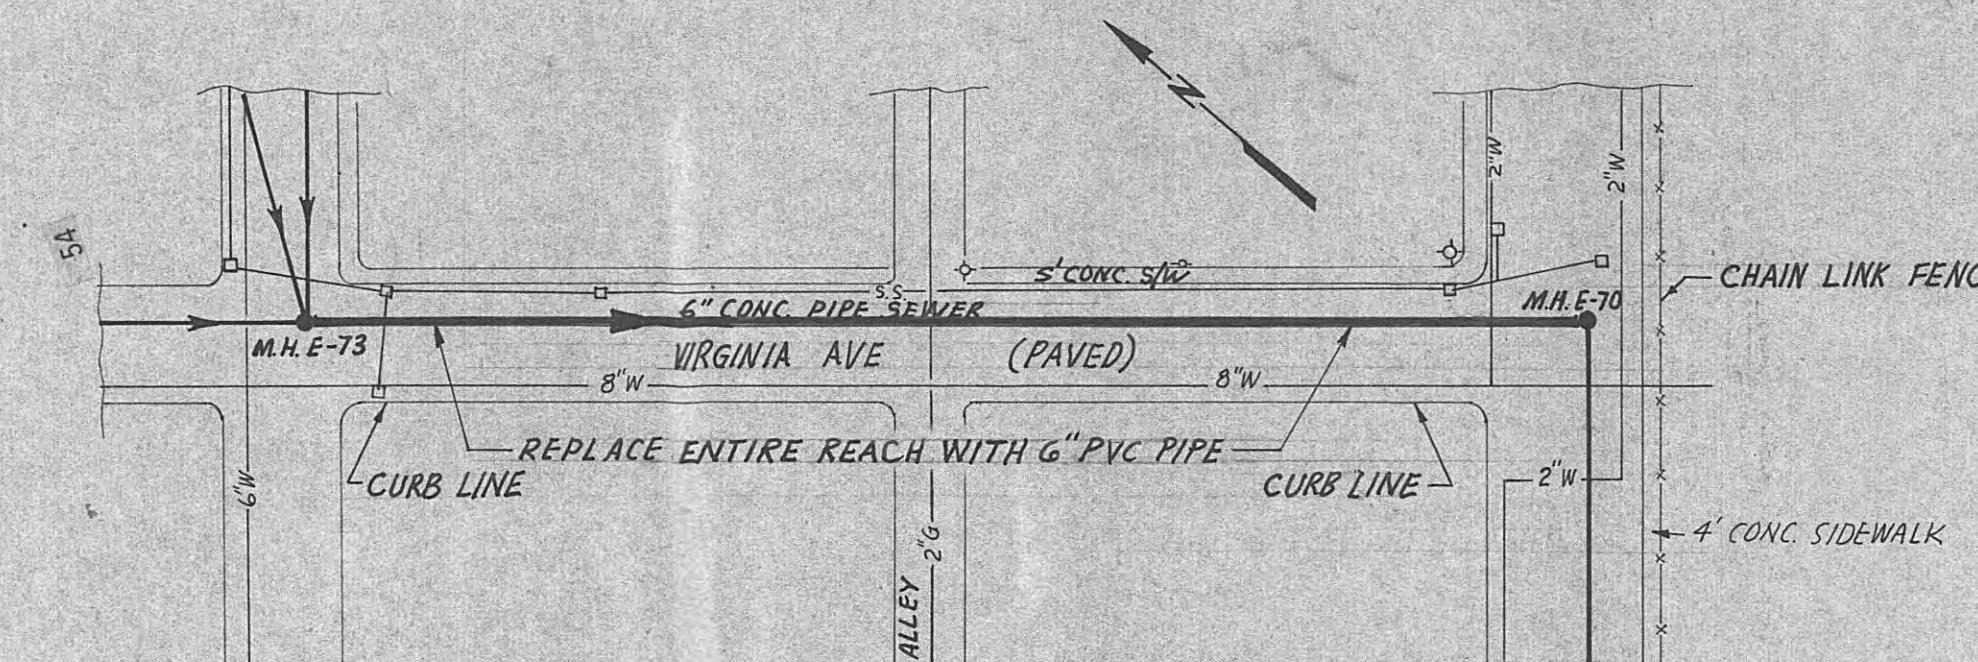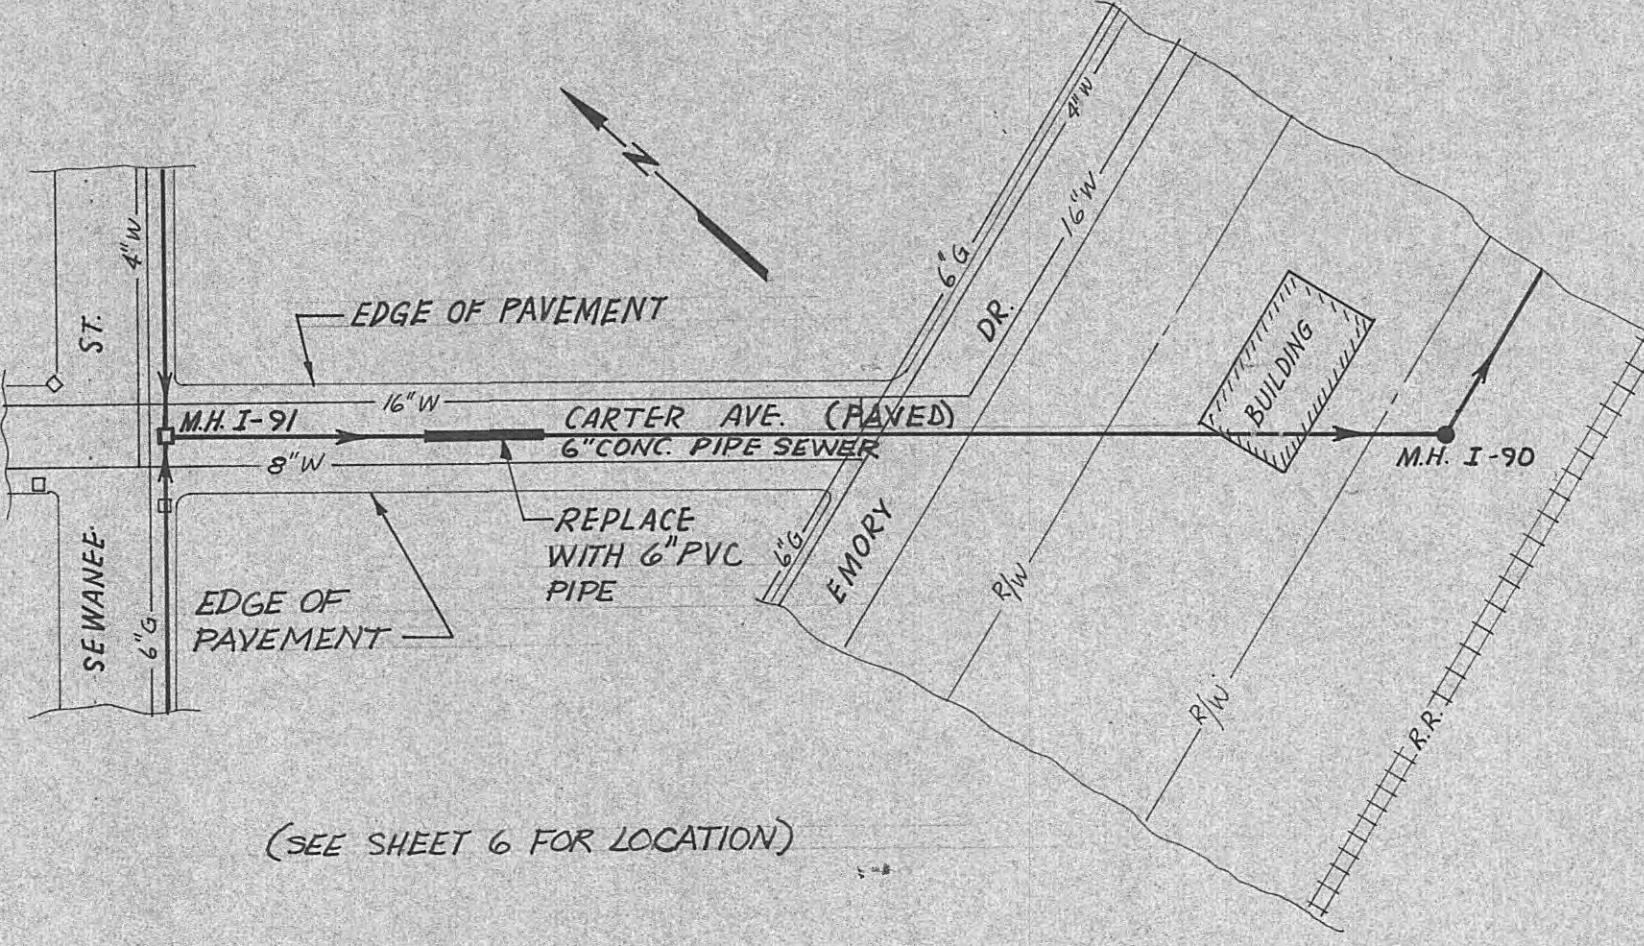

RECORD DRAWINGS

Revisions Drawn by M.S. HALES Date 10-83

THESE RECORD DRAWINGS HAVE BEEN PREPARED IN PART ON THE BASIS OF INFORMATION COMPILED BY OTHERS. THEY ARE NOT INTENDED TO REPRESENT IN DETAIL THE EXACT LOCATION, TYPE OF COMPONENT NOR MANNER OF CONSTRUCTION. THE ENGINEER WILL NOT BE RESPONSIBLE FOR ANY ERRORS OR OMISSIONS WHICH HAVE BEEN INCORPORATED INTO THE RECORD DRAWINGS.

CH2M
HILL

EXISTING WASTEWATER
COLLECTION SYSTEM
SEWER REHABILITATION

NO.	DESCRIPTION	DATE
	REVISIONS	

DRAWN BY: C.M.G. DATE: JAN. 1981
CHECKED BY: CCS ERMC FILE NO.: 1840271
SCALE: 1"=50' HORIZ. 1"=5' VERT.

PIPE REPLACEMENT
PLAN AND PROFILE
HARRIMAN - TENNESSEE

SHEET NO. 15



REHABILITATION SCHEDULE

REHABILITATION SCHEDULE

NOTE: The Following Manholes Raised To Grade:

— B —

B

RECORD DRAWINGS

Revisions Drawn by M.S

Revisions Drawn by _____

THESE RECORD DRAWINGS HAVE BEEN PREPARED, IN PART, ON THE BASIS OF INFORMATION COMPILED BY OTHERS. THEY ARE NOT INTENDED TO REPRESENT IN DETAIL THE EXACT LOCATION, TYPE OF COMPONENT NOR MANNER OF CONSTRUCTION. THE ENGINEER WILL NOT BE RESPONSIBLE FOR ANY ERRORS OR OMISSIONS WHICH HAVE BEEN INCORPORATED INTO THE RECORD DRAWINGS.



EXISTING WASTEWATER COLLECTION SYSTEM SEWER REHABILITATION	
DRAWN BY: J.M.C. CHECKED BY: C.C.S. & R.W.C.	DATE: JAN. 1981 FILE NO.: 48402.7
SCALE: 1" = 200'	
PLAN AND SCHEDULE	
DATE	SHEE NO. 4
HARRIMAN - TENNESSEE	

REHABILITATION SCHEDULE

PIPE TYPE & DIAMETER	SEWER SECTION (Manhole)-(Manhole)	LENGTH OF SECTION (Feet)	ESTIMATED NUMBER OF JOINTS	ESTIMATED CHEMICAL GROUTING (No. Joints)	ROOT TREATMENT (Feet)	MANHOLE AND REPLACE (Feet)	COVER REPLACEMENT (Manhole)	STRUCTURAL REHAB (Manhole)	TV INSPECTION (Manhole)
E3 - E4	12 CP	51	0	0	0	0	0	10.5	E15, E28
E4 - E5	10 CP	113	0	0	0	0	0	10.5	E103, E107
E33 - E43	12 VCP	341	83	5	0	0	0	17.0	E33, E43
E43 - E44	8 VCP	72	0	0	0	0	0	15.5	E44
E46 - E49	6 VCP	163	0	0	0	0	0	5.0	E49
E60 - E61	15 CIP	82	20	1	0	0	0	10.5	E115, E114
E109 - E110	6 VCP	156	69	10	0	0	0	6.5	E109
I14 - I123	15 VCP					22	0	10.0	I14, I92
I35 - I36	6 VCP	273	0	0	0	6	0	7.0	E32
I29 - I28	6 VCP					25	0	0	E65
I37 - I38	8 VCP	243	0	0	0	0	0	4.0	I156
I38 - I39	8 VCP	326	51	3	0	0	0	4.5	I160
I64 - I65	6 VCP	162	0	0	0	0	0	4.5	I165
I90 - I91	6 VCP	340	0	0	0	0	0	5.5	I167
I91 - I92	6 VCP	168	0	0	0	0	0	5.0	I168
I93 - I94	6 VCP	388	0	0	0	0	0	4.0	I97
I38 - I37	6 VCP	129	0	0	0	0	0	4.5	I72
I37 - I36	6 VCP	155	0	0	0	0	0	4.5	I45
I109 - I108	6 VCP	157	0	0	0	0	0	5.5	I157
I109 - I107	6 VCP	182	0	0	0	0	0	5.5	I182

Note: For additional manhole grouting, cover replacement and manhole cover sealing see schedule on sheet no. 4

Spec Sheet Nos 14 and 15

NOTE: The Following Manholes Raised To Grade:

RECORD DRAWINGS

Revisions Drawn by M.S. HALES Date 10 83

THESE RECORD DRAWINGS HAVE BEEN PREPARED, IN PART, ON
THE BASIS OF INFORMATION COMPILED BY OTHERS. THEY ARE
NOT INTENDED TO REPRESENT IN DETAIL THE EXACT LOCATION,
TYPE OF COMPONENT NOR MANNER OF CONSTRUCTION. THE
ENGINEER WILL NOT BE RESPONSIBLE FOR ANY ERRORS OR
OMISSIONS WHICH HAVE BEEN INCORPORATED INTO THE
RECORD DRAWINGS.

EXISTING WASTEWATER
COLLECTION SYSTEM
SEWER REHABILITATION

REHABILITATION SCHEDULE

o See Sheet Nos. 14 and 15.


NOTE: The Following Manholes Raised To Grade:


E69

RECORD DRAWINGS

Revisions Drawn by M. S. HALES Date 10-83

THESE RECORD DRAWINGS HAVE BEEN PREPARED, IN PART, ON
THE BASIS OF INFORMATION COMPILED BY OTHERS. THEY ARE
NOT INTENDED TO REPRESENT IN DETAIL THE EXACT LOCATION,
TYPE OF COMPONENT NOR MANNER OF CONSTRUCTION. THE
ENGINEER WILL NOT BE RESPONSIBLE FOR ANY ERRORS OR
OMISSIONS WHICH HAVE BEEN INCORPORATED INTO THE
RECORD DRAWINGS.

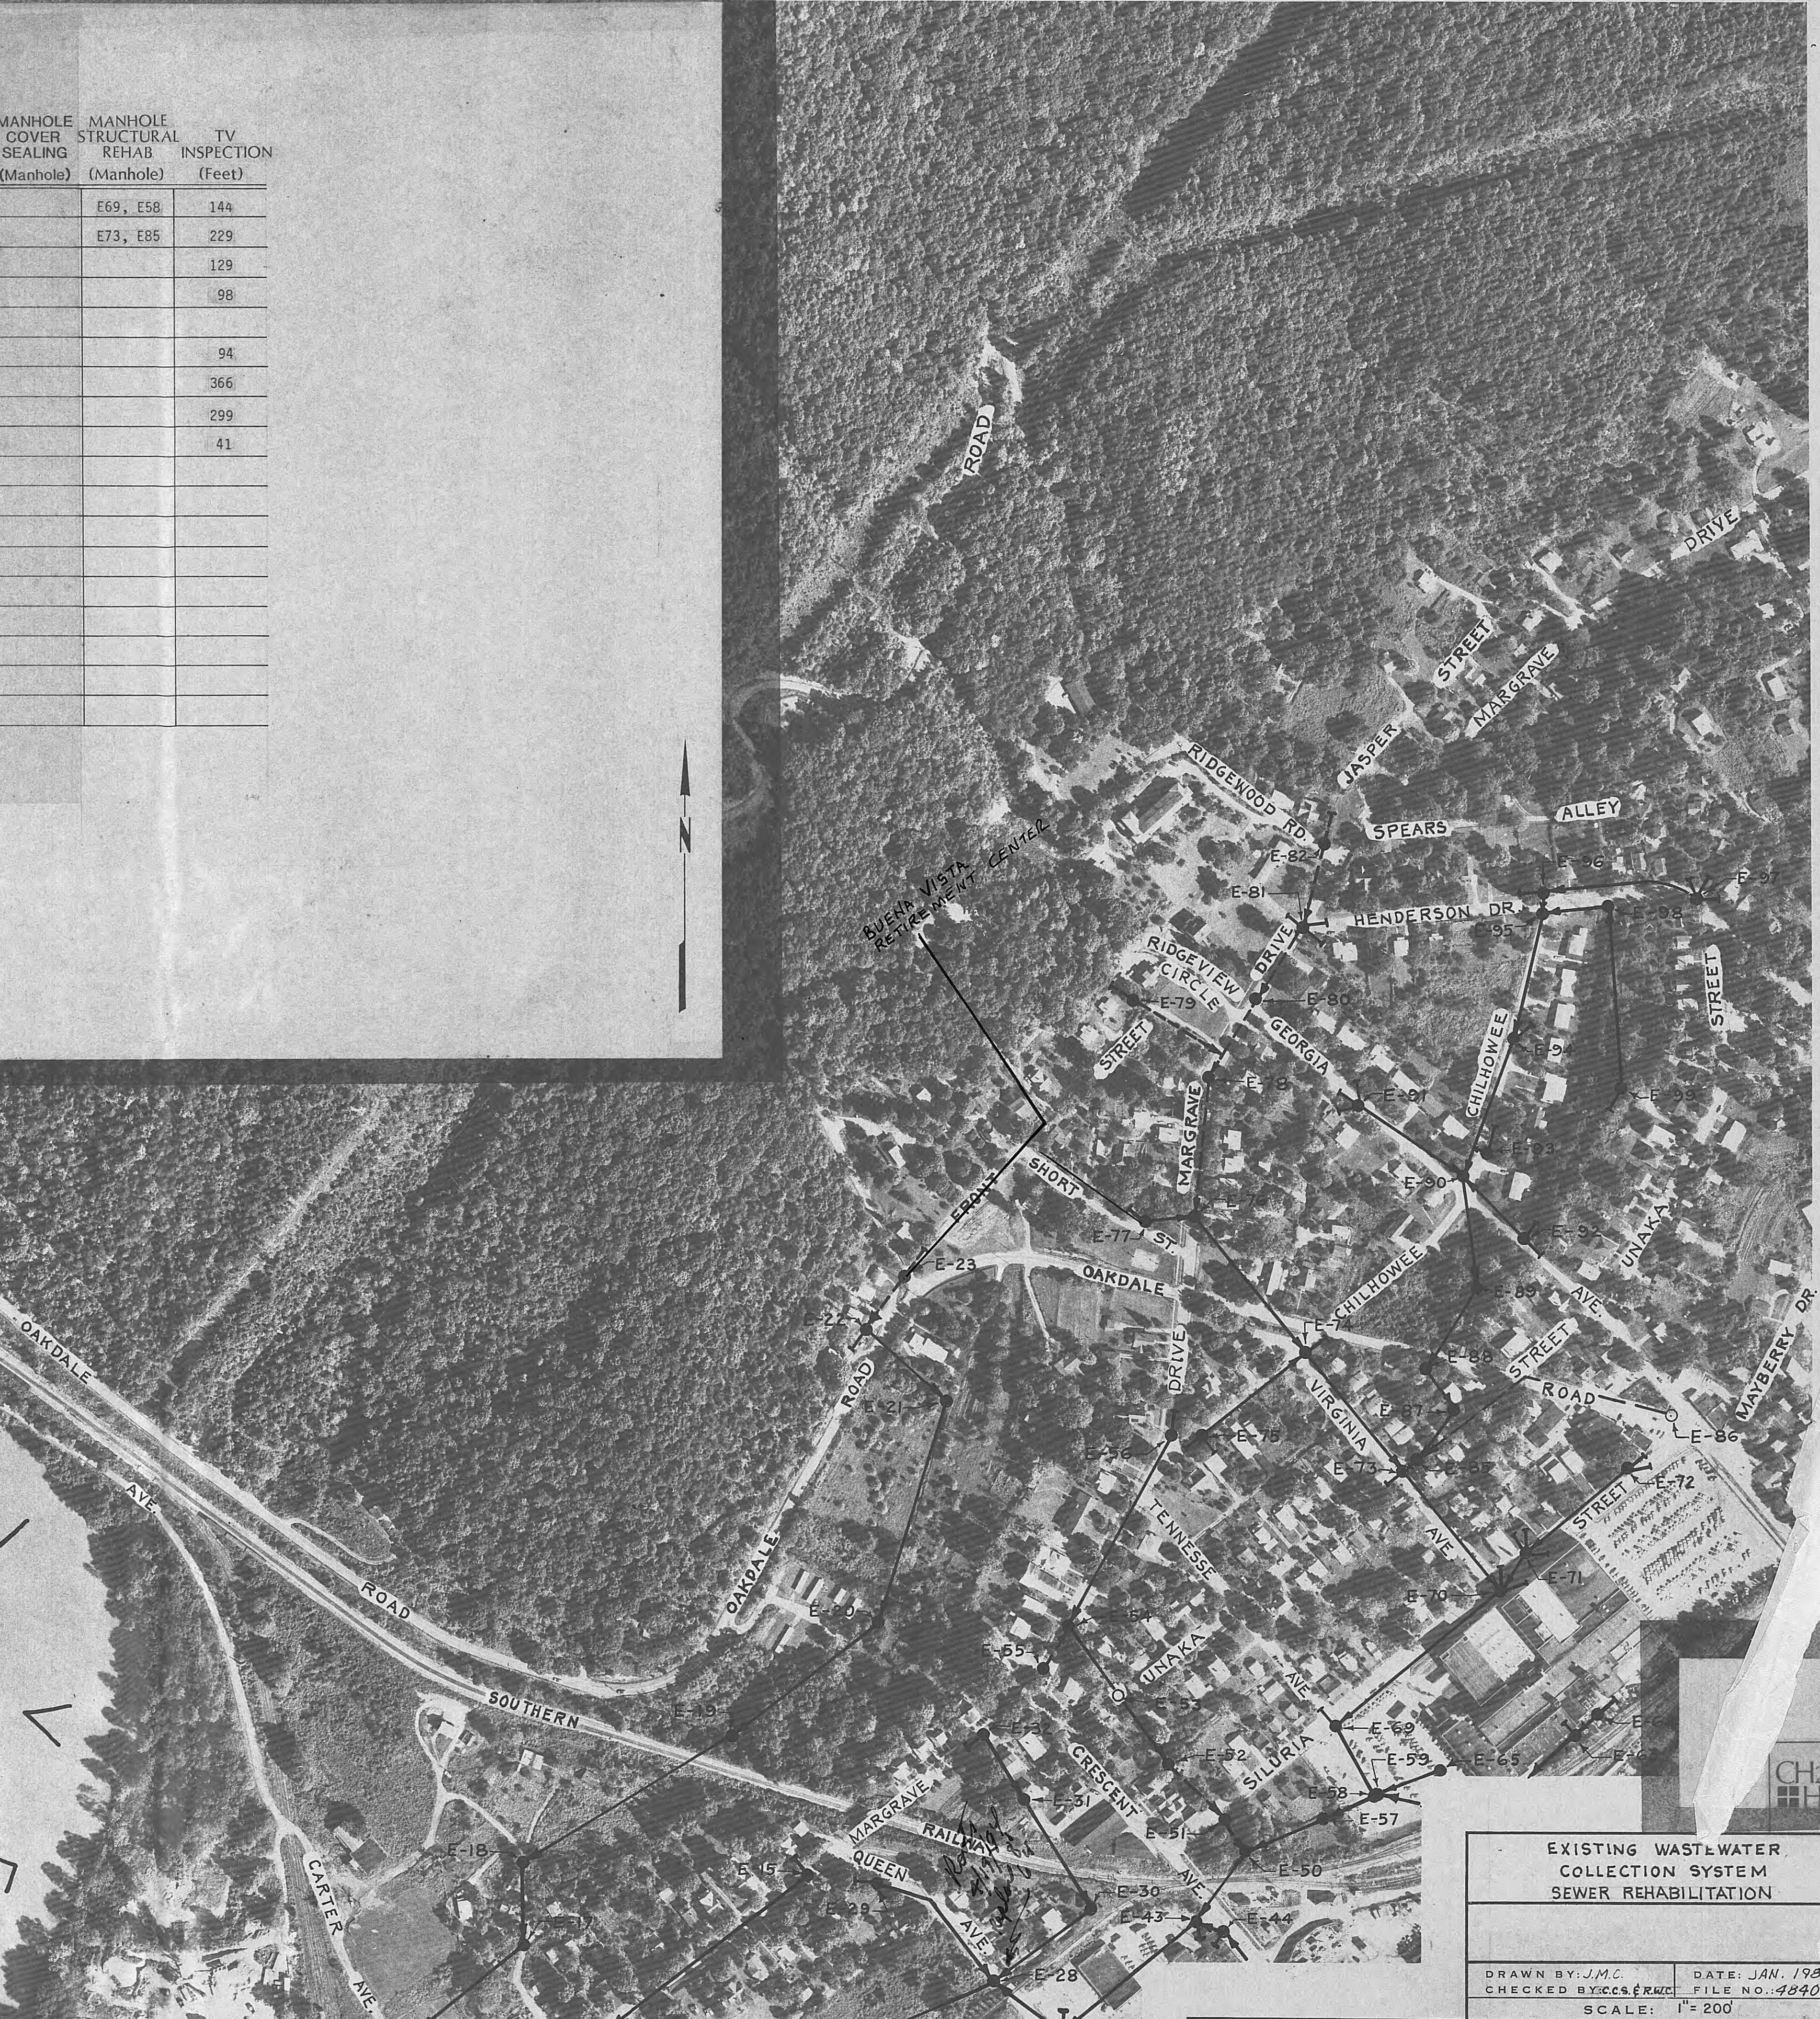

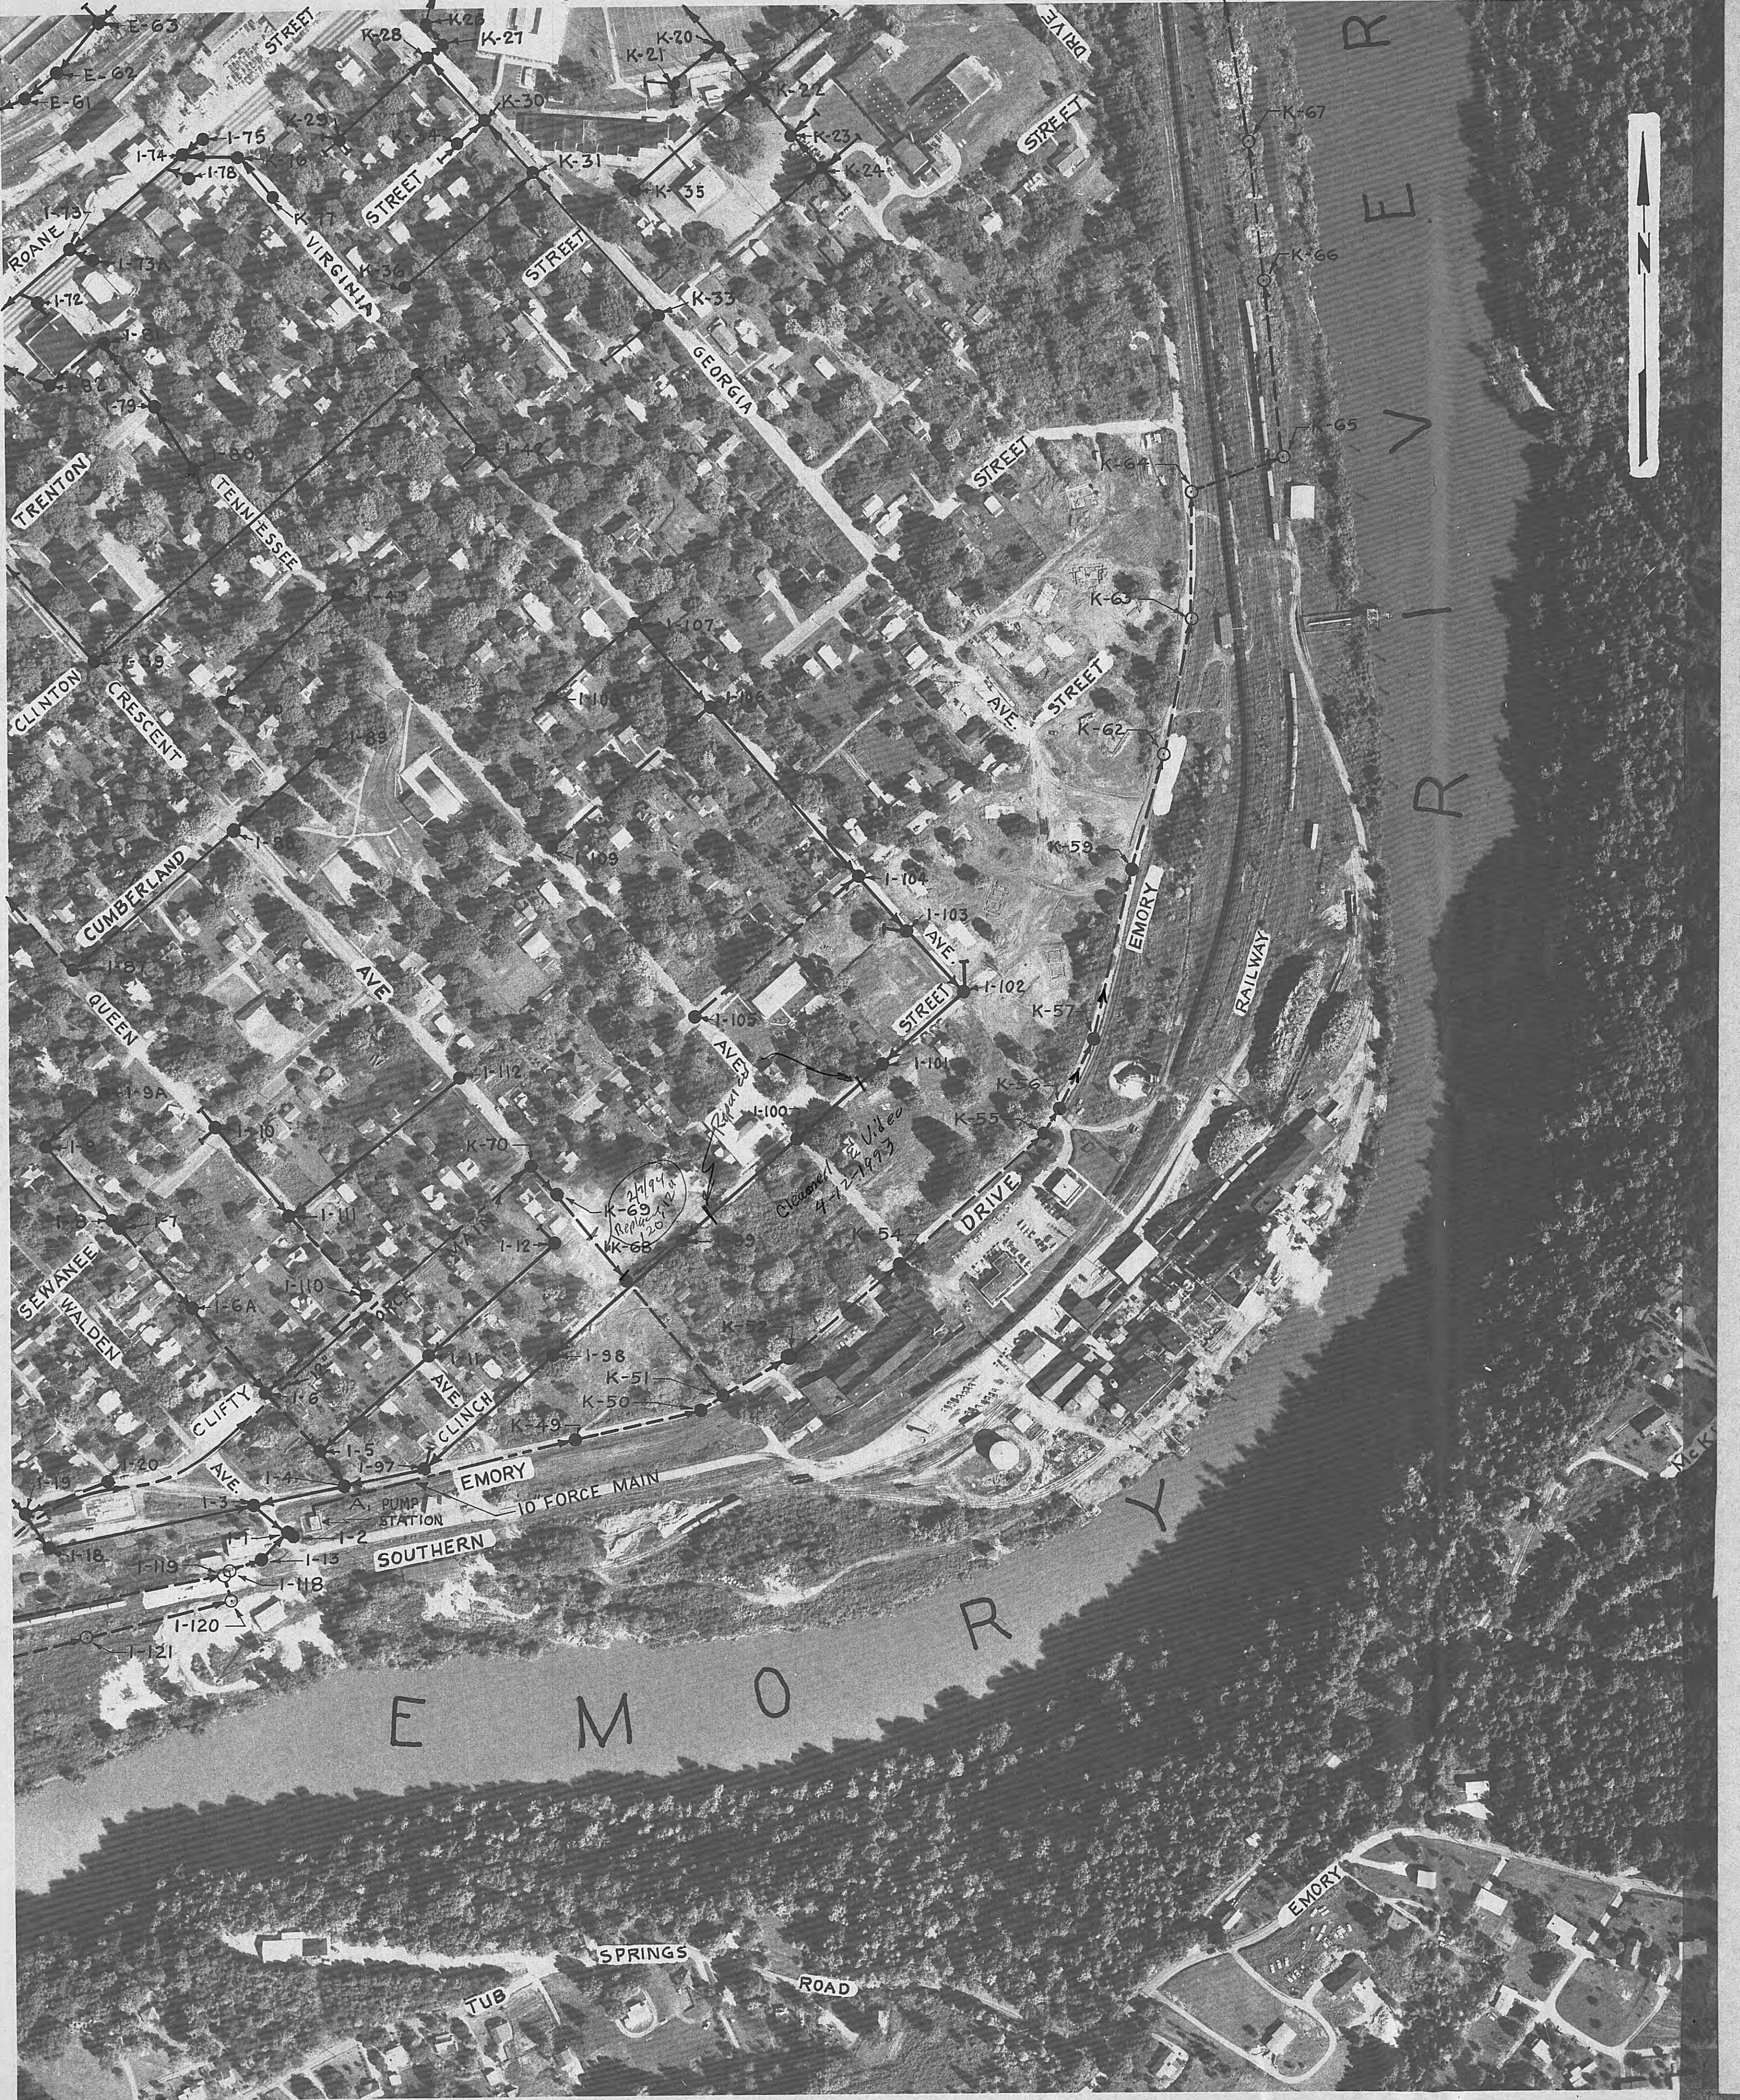

REHABILITATION SCHEDULE

NOTE: The Following Manholes Raised To Grade:

四

RECORD DRAWINGS

Revisions Drawn by M.S. HALES **Date** 10-83

THESE RECORD DRAWINGS HAVE BEEN PREPARED, IN PART, ON THE BASIS OF INFORMATION COMPILED BY OTHERS. THEY ARE NOT INTENDED TO REPRESENT IN DETAIL THE EXACT LOCATION, TYPE OF COMPONENT NOR MANNER OF CONSTRUCTION. THE ENGINEER WILL NOT BE RESPONSIBLE FOR ANY ERRORS OR OMISSIONS WHICH HAVE BEEN INCORPORATED INTO THE RECORD DRAWINGS.



EXISTING WASTEWATER COLLECTION SYSTEM SEWER REHABILITATION	
DRAWN BY: J.M.C. CHECKED BY: CCS/FRW/C	DATE: JAN. 1981 FILE NO.: 48402-71
SCALE: 1" = 200'	
PLAN AND SCHEDULE	
DATE: _____ HARRIMAN	SHEET NO.: TENNESSEE



REHABILITATION SCHEDULE


SMOKE TESTED ENTIRE WALNUT HILL, CHERRY ST, MEADOWVIEW SYSTEMS 4TH QTR '94



RECORD DRAWINGS

Revisions Drawn by M.S. HALES **Date** 10-8

THESE RECORD DRAWINGS HAVE BEEN PREPARED, IN PART, ON THE BASIS OF INFORMATION COMPILED BY OTHERS. THEY ARE NOT INTENDED TO REPRESENT IN DETAIL THE EXACT LOCATION, TYPE OF COMPONENT NOR MANNER OF CONSTRUCTION. THE ENGINEER WILL NOT BE RESPONSIBLE FOR ANY ERRORS OR OMISSIONS WHICH HAVE BEEN INCORPORATED INTO THE RECORD DRAWINGS.

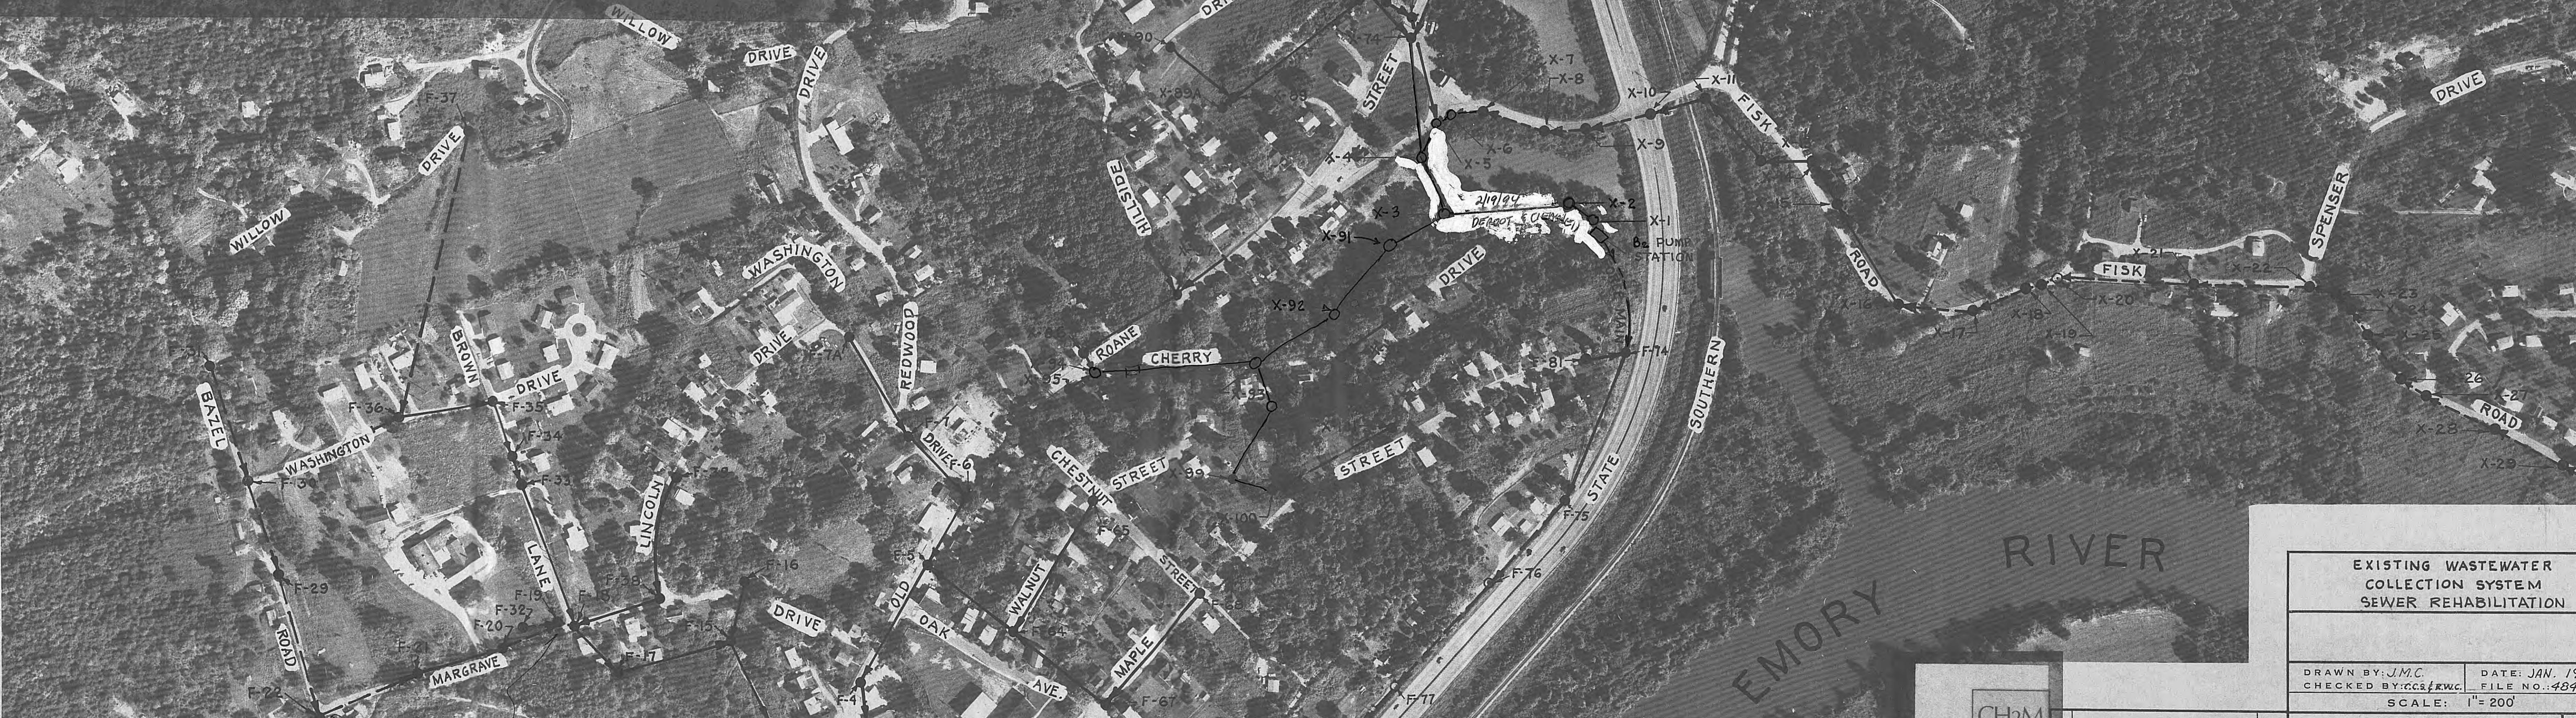

EXISTING WASTEWATER
COLLECTION SYSTEM
SEWER REHABILITATION