


GENERAL NOTES

1. EXACT LOCATION OF EXISTING WATER LINES IS NOT KNOWN. LOCATION AND SIZE SHOWN IS APPROXIMATE ONLY AND MAY VARY.
2. CONTRACTOR IS TO IMMEDIATELY REPAIR OR REPLACE ANY EXISTING WATER LINES WHICH ARE BROKEN OR DAMAGED DURING CONSTRUCTION. WATER TO CUSTOMERS WITH EXISTING WATER SERVICE IS TO REMAIN UNINTERRUPTED DURING CONSTRUCTION. NO ADDITIONAL COMPENSATION SHALL BE ALLOWED FOR ANY REPAIRS OR REPLACEMENT TO EXISTING WATER LINES.
3. CONTRACTOR WILL BE REQUIRED TO RUN SERVICE LINE FROM WATER MAIN TO WATER METER LOCATED AT THE PROPERTY LINE. METER TO BE IN A LOCATION SATISFACTORY TO THE PROPERTY OWNER. CONTRACTOR TO BE PAID UNDER UNIT PRICE BID FOR APPLICABLE TYPE PIPE BID IN THE BID SCHEDULE.
4. THE CONTRACTOR SHALL LOCATE ALL WATER, GAS, TELEPHONE, STORM DRAINAGE, AND OTHER UNDERGROUND UTILITIES, BEFORE PROCEEDING WITH ANY TRENCH EXCAVATION FOR PIPE LINES SO THAT WATER LINES TO BE INSTALLED MAY BE LOCATED WITH THE LEAST CONFLICT WITH EXISTING UTILITIES AS DETERMINED BY THE ENGINEER.
5. EXISTING WATER LINES TO REMAIN UNLESS OTHERWISE NOTED IN THE PLANS OR AS DIRECTED BY THE ENGINEER.
6. NO ADDITIONAL PAYMENT SHALL BE ALLOWED FOR WATER LINES REQUIRED TO BE BURIED DEEPER THAN THAT FOR NORMAL COVER PAYMENT TO BE INCLUDED IN UNIT PRICE BID FOR PIPE.
7. WHERE WATER LINES CROSS IMPROVED, GRASSED, OR LAWN AREAS, ETC., ALL SOD, SHRUBS, FLOWERS, PLANTINGS, ETC., SHALL BE REPLACED IN ORIGINAL CONDITION AT CONTRACTOR'S EXPENSE. GRASSED AREAS SHALL BE RESTORED TO PRIOR CONDITIONS IN THE FOLLOWING MANNER:
 AREAS LESS THAN 3:1 SLOPE SHALL BE RESEEDED AND MULCHED WITH GRASSES OR GROUND COVER AS OUTLINED IN THE SPECIFICATIONS. AREAS GREATER THAN 3:1 SLOPE SHALL BE RESEEDED AND MULCHED WITH A FABRIC MATERIAL AS OUTLINED IN THE SPECIFICATIONS. PAYMENT SHALL BE INCLUDED IN THE APPLICABLE UNIT PRICE BID FOR THE WATER LINE.
8. WHERE LINES CROSS UNDER CURBS, THEY SHALL BE TUNNELED UNDER THE CURB. NO SEPARATE PAYMENT WILL BE ALLOWED FOR REPAIRING CURBS DAMAGED OR DESTROYED DURING WATER LINE CONSTRUCTION.
9. PROMISCUOUS DESTRUCTION OF TREES ALONG WATER LINE RIGHT-OF-WAY WILL NOT BE PERMITTED. ALL REASONABLE EFFORTS WILL BE MADE BY THE CONTRACTOR TO PROTECT AND SAFEGUARD TREES.
10. ANY EXISTING FENCES, ROCK WALLS, GUARDRAILS, ETC., ALONG THE WATER LINE RIGHT-OF-WAY ARE TO BE REMOVED AND REINSTALLED IN THEIR ORIGINAL CONDITION (OR BETTER). NO SEPARATE PAYMENT WILL BE ALLOWED. PAYMENT TO BE INCLUDED IN THE APPLICABLE UNIT PRICE BID FOR THE WATER LINE.
11. ALL WATER LINES SHALL HAVE A MINIMUM COVER OF 30 INCHES, EXCEPT AS OTHERWISE NOTED.
12. THE COST FOR DIVERSION OF WATER IN DITCHES, CREEKS, OR RIVERS SHALL BE INCLUDED IN THE APPLICABLE UNIT PRICE BID FOR THE WATER LINE IN THE BID SCHEDULE. NO SEPARATE PAYMENT SHALL BE ALLOWED.
13. WHEN BLASTING FOR EXCAVATION OF WORK, ADEQUATE PRECAUTIONS SHALL BE USED TO PREVENT DAMAGE TO SURROUNDING PROPERTY.
14. NO SEPARATE PAYMENT SHALL BE ALLOWED FOR PIPE HANGERS AND SUPPORTS REQUIRED FOR BRIDGE CROSSING. PAYMENT TO BE INCLUDED IN THE APPLICABLE UNIT PRICE BID PER LINEAR FOOT OF PIPE IN THE BID SCHEDULE.
15. UNDER ITEM 15061A, COPPER TUBING SERVICE PIPE, IN THE BID SCHEDULE, NO SEPARATE PAYMENT SHALL BE MADE FOR CONNECTIONS TO EXISTING WATER METERS FOR EXISTING SERVICES. THE COST OF THIS WORK IS TO BE INCLUDED IN THE UNIT PRICE BID FOR OTHER ITEMS OF WORK.

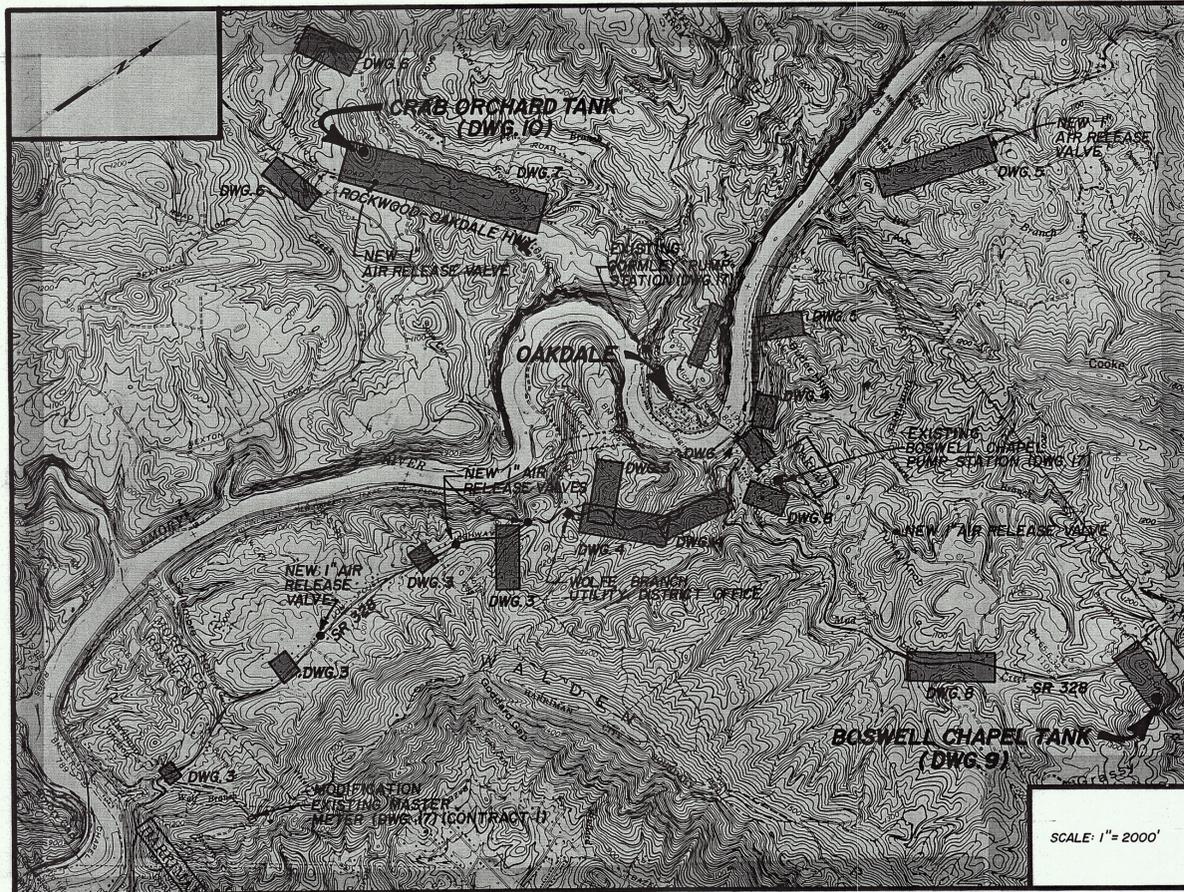

DRAWING LOCATION PLAN

REV.	BY	DATE	DESCRIPTION
WATER SYSTEM IMPROVEMENTS—PHASE II			
GENERAL PLAN			
WOLFE BRANCH UTILITY DISTRICT OAKDALE, TENNESSEE			
DESIGNED BY: <i>JDH</i>	HENSLEY-SCHMIDT, INC. Engineers and Managers		DRAWING NO.
DRAWN BY: <i>GAW</i>	ATLANTA-CHATTANOOGA-KNOXVILLE		7972-2
CHKD. <i>JDH</i> DATE:			
APPR. <i>GMC</i> DATE:			



STATE ROUTE 328
TO OAKDALE

SR 328 TO OAKDALE

STATE ROUTE 328
FROM HARRIMAN

BEN HENRY ROAD

FORREST HILLS ROAD






TO OAKDALE

SR 328 FROM HARRIMAN

SR 328 FROM HARRIMAN

LEGEND

- NEW WATER LINES 
- EXISTING WATER LINES 
- GATE VALVE 
- AIR RELEASE VALVE 
- PRESSURE REDUCING VALVE 
- REDUCER 

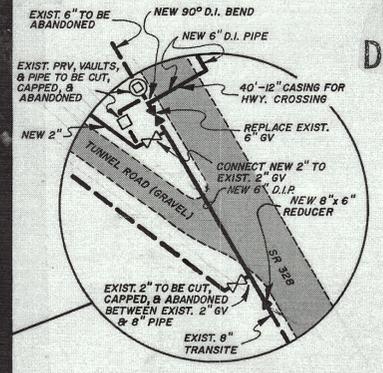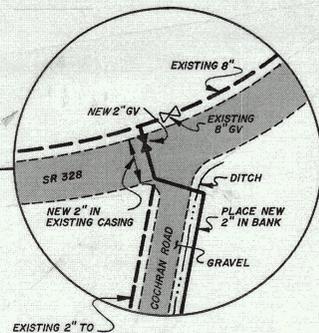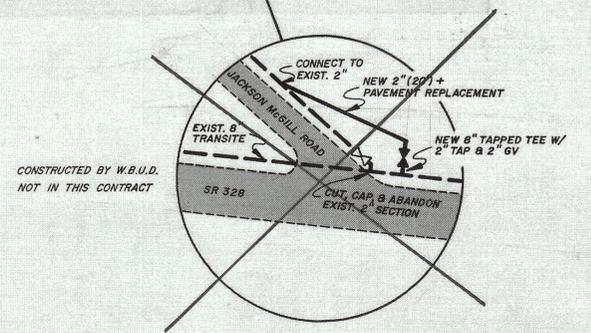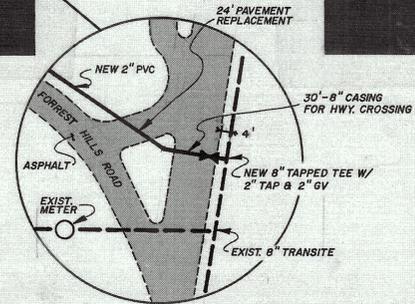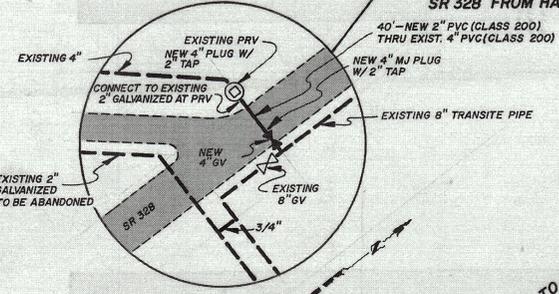

Record Drawing
Date March, 1987



REV RECORD DRAWING 3/87 JDH


REV.	BY	DATE	DESCRIPTION
WATER SYSTEM IMPROVEMENTS—PHASE II			
WATER LINE REPLACEMENT PLANS SHEET 1 OF 6			
WOLFE BRANCH UTILITY DISTRICT OAKDALE, TENNESSEE			
DESIGNED BY: <i>JDH</i>	HENSLEY-SCHMIDT, INC. Engineers and Managers		DRAWING NO.
DRAWN BY: <i>GAW</i>	ATLANTA · CHATTANOOGA · KNOXVILLE		7972-31
CHKD. <i>JDH</i>	DATE:		
APPR. <i>GMC</i>	DATE:		

SCALE: 1" = 200'

TUNNEL ROAD
(GRAVEL)

SR 328
FROM
HARRIMAN

STATE ROUTE 328

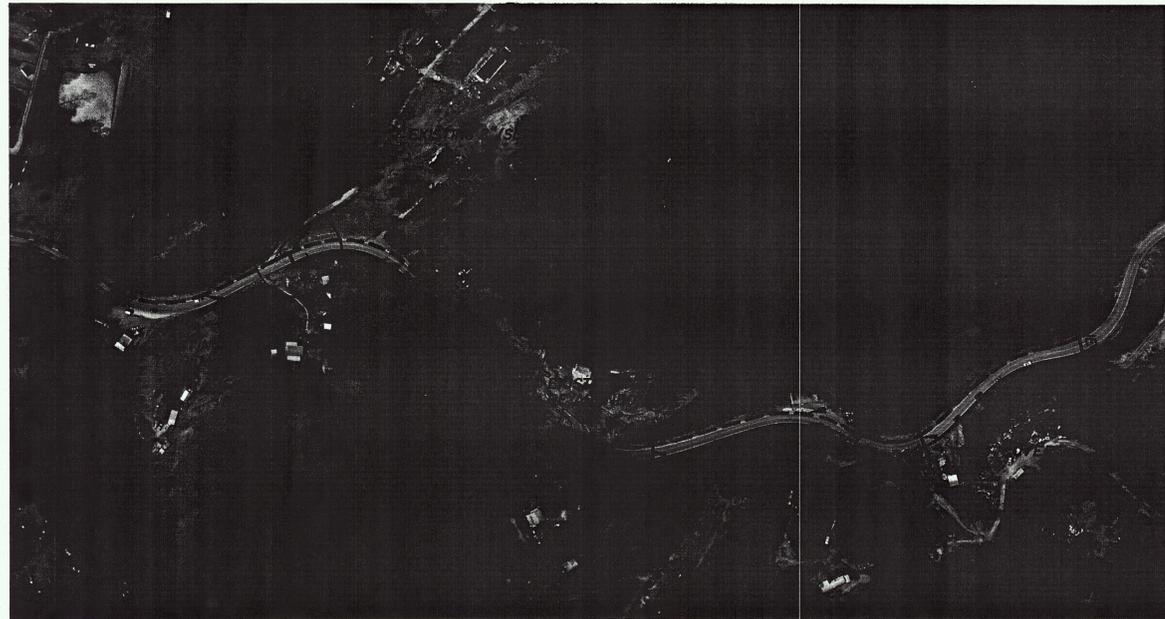







STATE ROUTE 328 TO OAKDALE

STATE ROUTE 328 CONTINUED




TO OAKDALE (TN HWY. 299)

TN HWY. 328

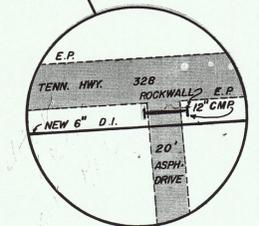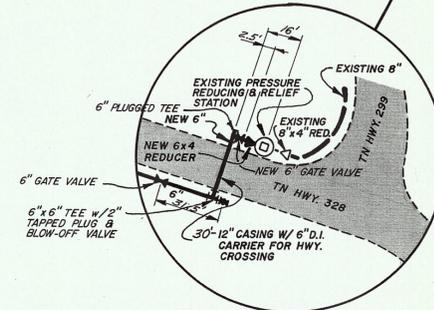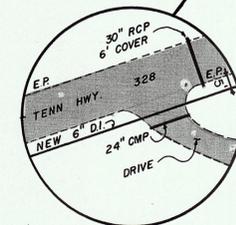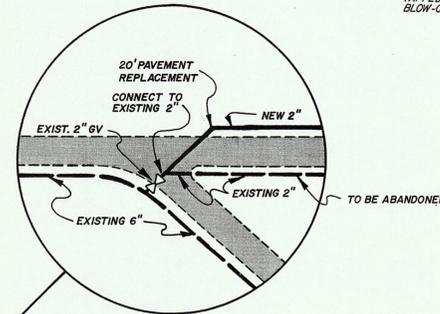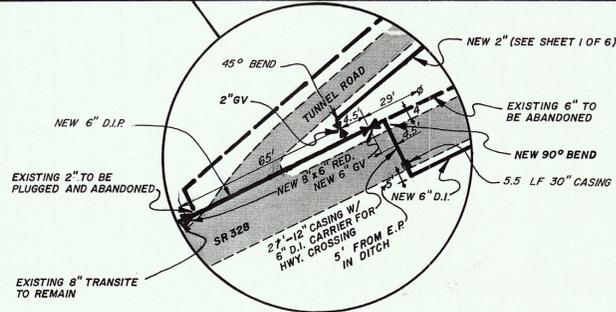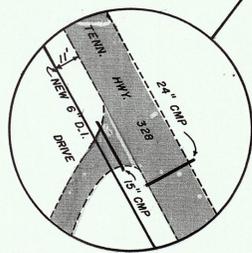

EMORY RIVER FROM OAKDALE

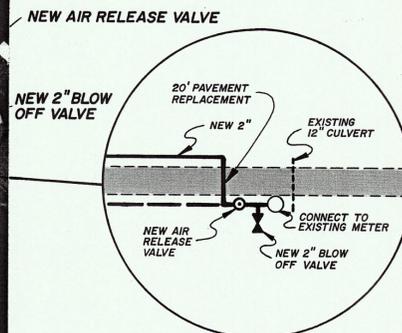




Record Drawing
Date *March, 1987*

LEGEND

- NEW WATER LINES
- EXISTING WATER LINES
- GATE VALVE
- AIR RELEASE VALVE
- PRESSURE REDUCING VALVE
- REDUCER







REV.	RECORD DRAWING	3/87	JDH
Dr.	1/86	GAW	CL
HENSLEY - SCHMIDT, INC. CONSULTING ENGINEERS ATLANTA, CHATTANOOGA, KNOXVILLE.			
PLAN SCALE	7972-4.1		
1" = 100'			

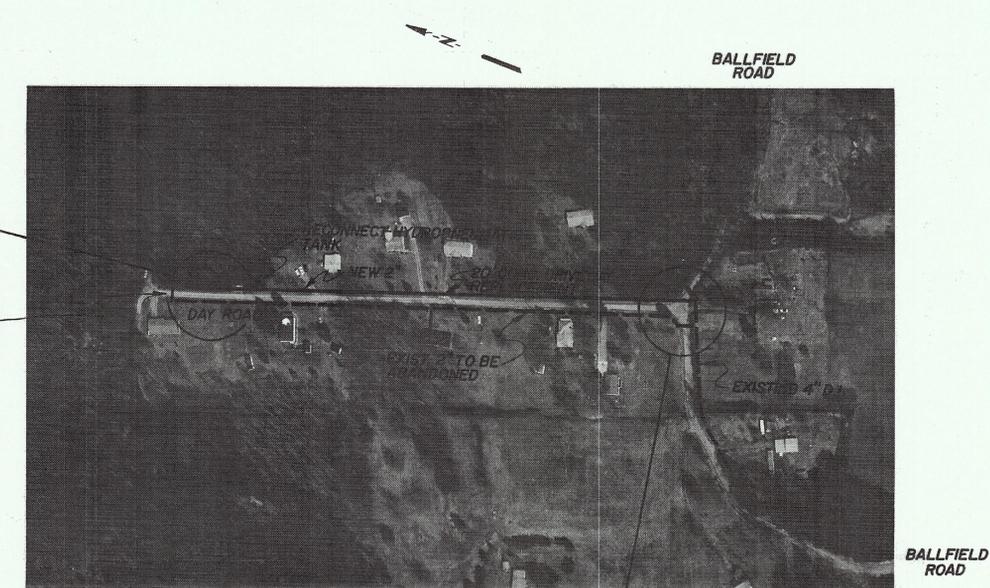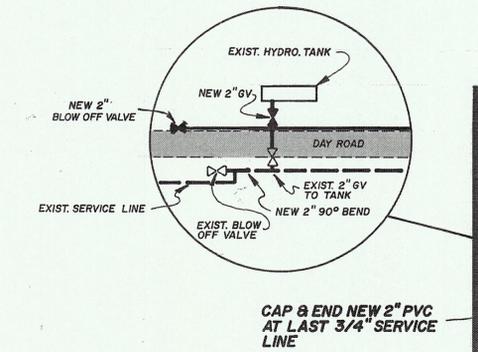
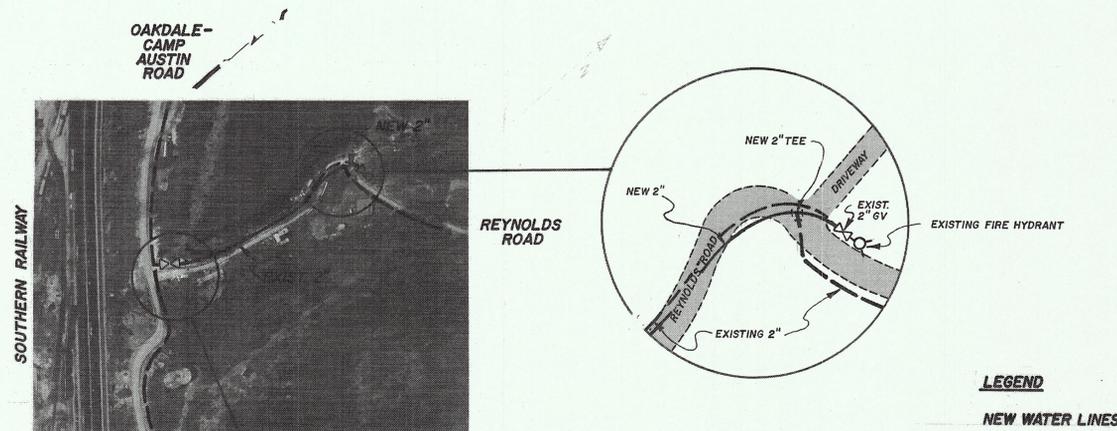


LEGEND

NEW WATER LINES	—————
EXISTING WATER LINES	—————
GATE VALVE	— — —
AIR RELEASE VALVE	○
PRESSURE REDUCING VALVE	⊖
REDUCER	— — —

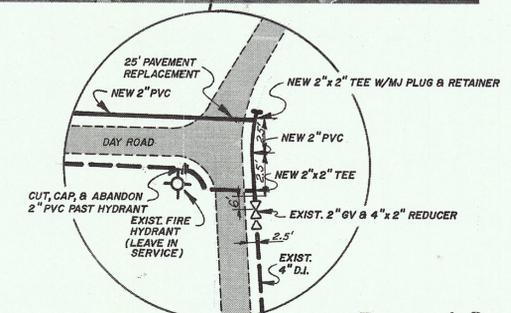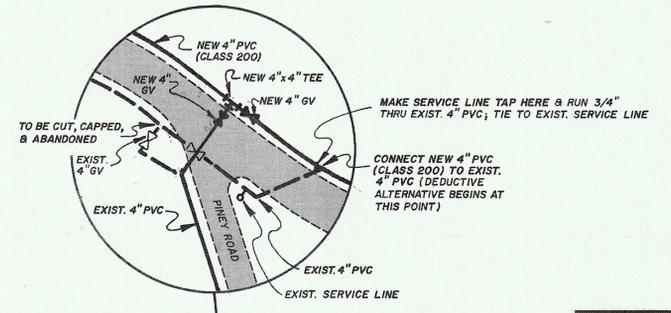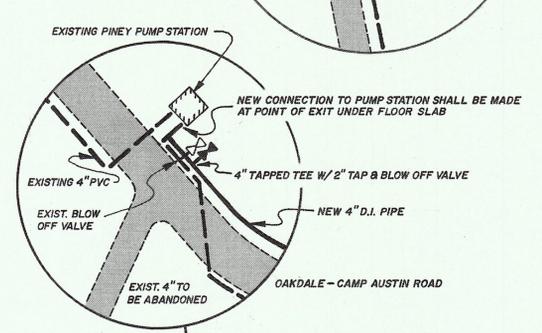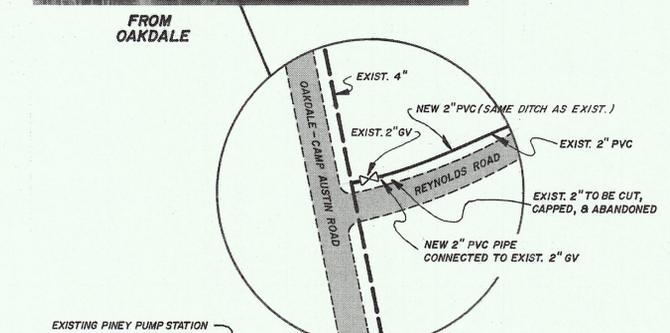

Record Drawing
Date March, 1987

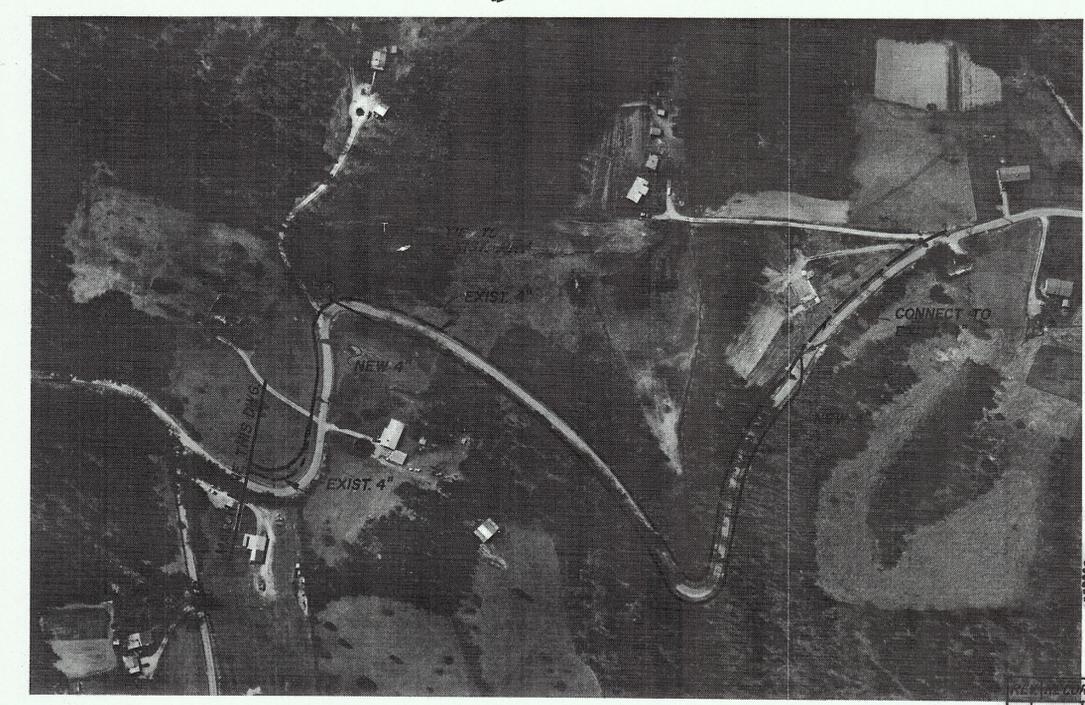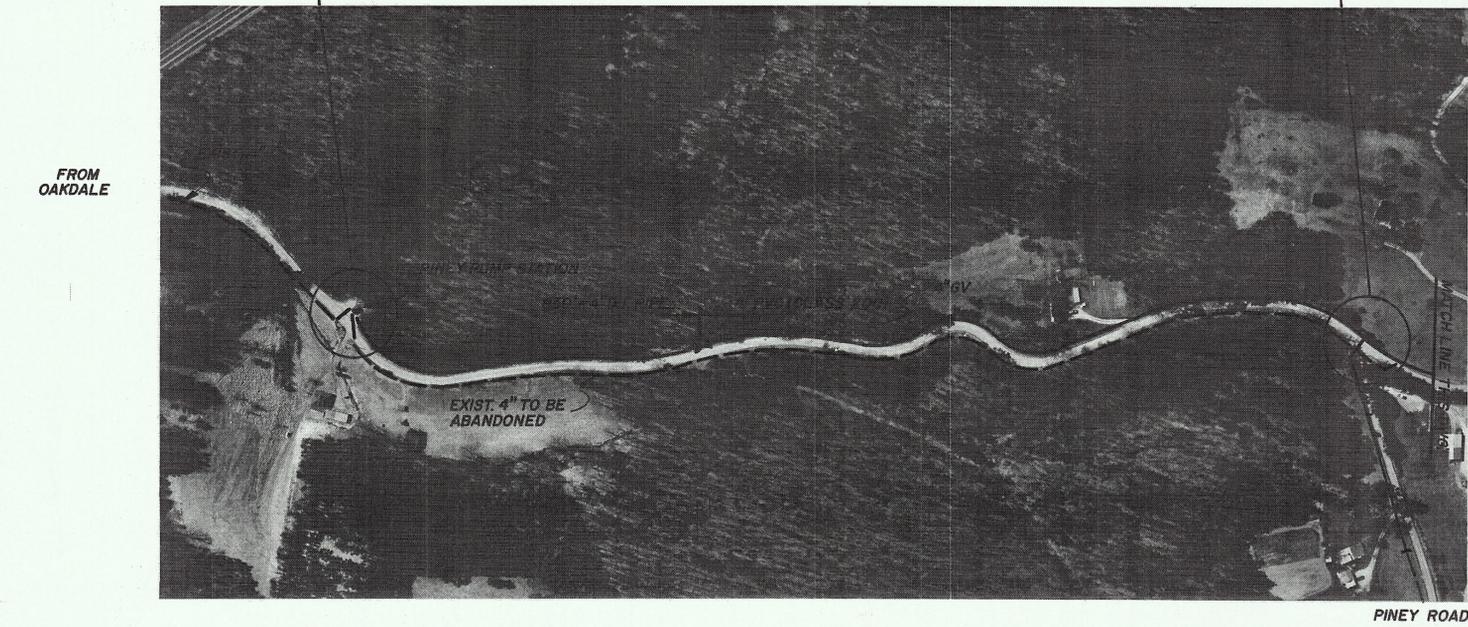


SCALE: 1"=200'

DEDUCTIVE ALTERNATE NO. 1

DRAWING 44-132-32756-4




Dr.	1/86	GAW	Cl.	JDH
Dr.	1/86	GAW	Cl.	JDH
HENLEY-SCHMIDT, INC. CONSULTING ENGINEERS ATLANTA, CHATTANOOGA, KNOXVILLE.				
PLAN SCALE	7972-5.1			
1"=100'				

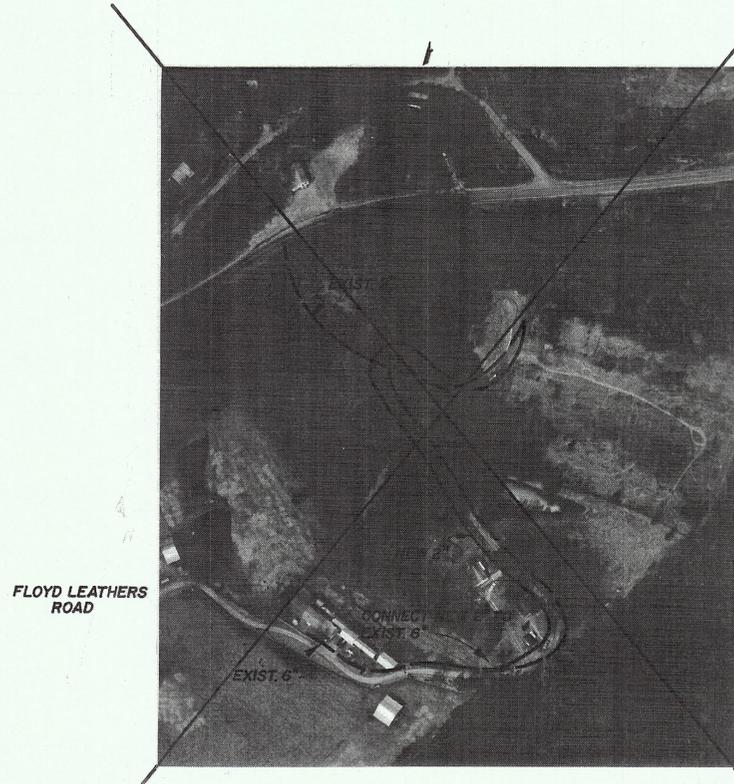


ROCKWOOD-OAKDALE HWY.

CONNECT 6 1/2" TAPPING TEE & VALVE TO EXIST. 6"

ROCKWOOD-OAKDALE HWY.

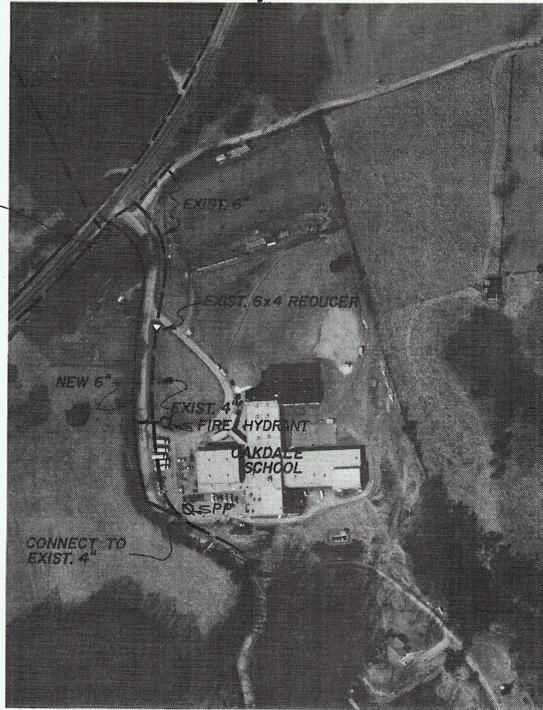


CONNECT TO EXIST. 4"

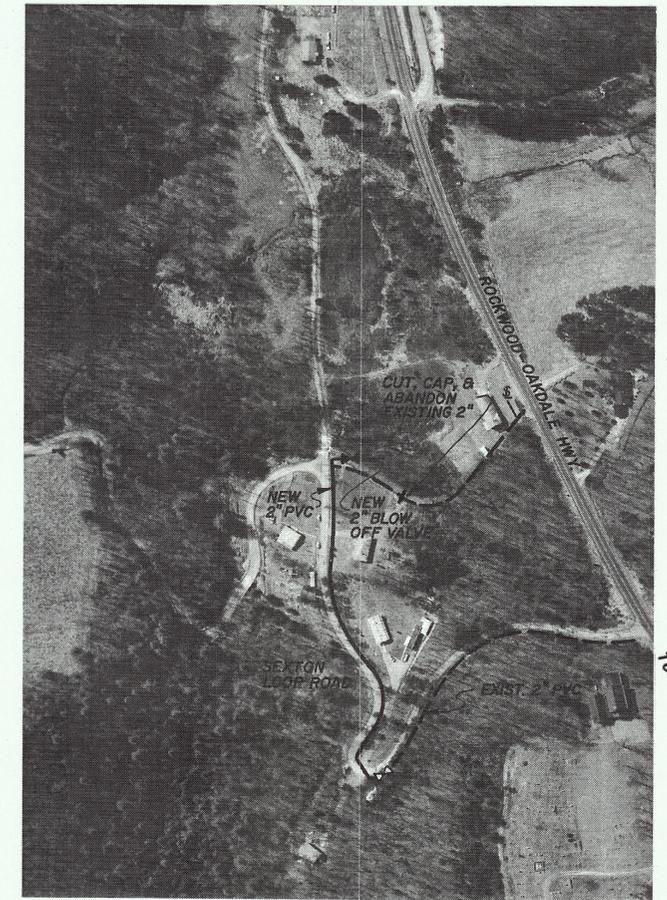


TO OAKDALE

NOT CONSTRUCTED
DEDUCTIVE ALTERNATE NO. 1

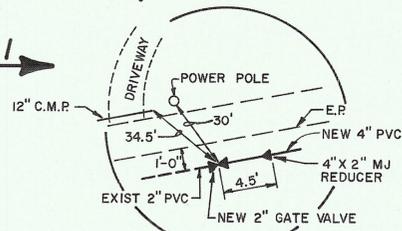

DEDUCTIVE ALTERNATE NO. 1

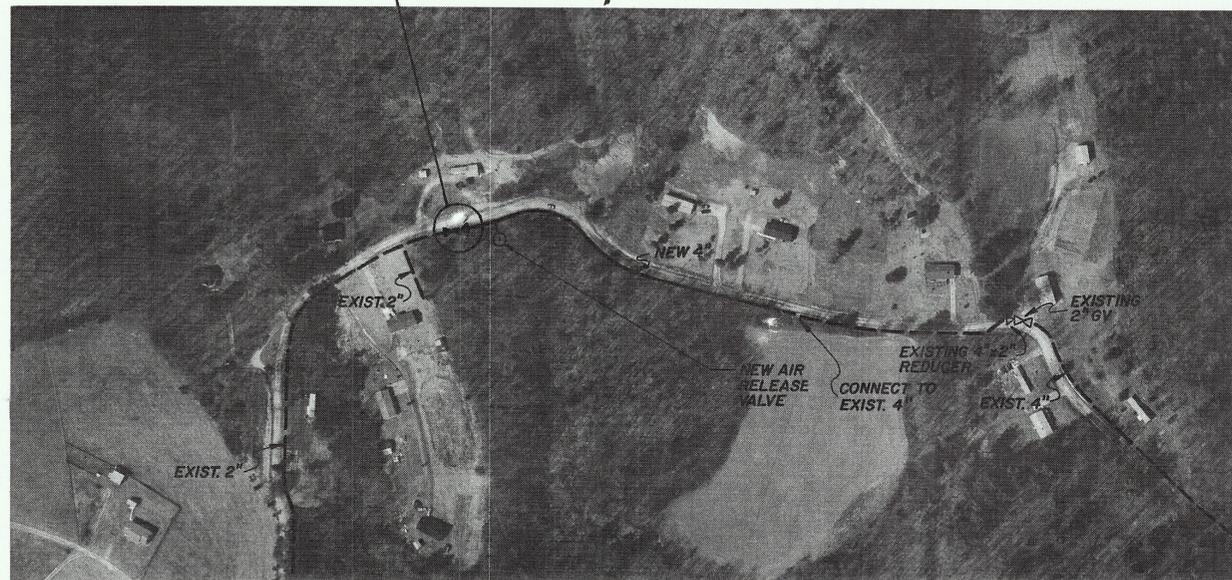

POWERS LOOP ROAD

POWERS LOOP ROAD

LEGEND



- NEW WATER LINES
- EXISTING WATER LINES
- GATE VALVE
- AIR RELEASE VALVE
- PRESSURE REDUCING VALVE
- REDUCER

Record Drawing
Date MARCH 1987





REV	RECORD DRAWING	3/87	JDH
Dr.	1/86	GAW	CL. JDH
HENSLEY - SCHMIDT, INC. CONSULTING ENGINEERS ATLANTA, CHATTANOOGA, KNOXVILLE			
PLAN SCALE	7972-6.1		
1" = 100'			


SCALE: 1" = 200'

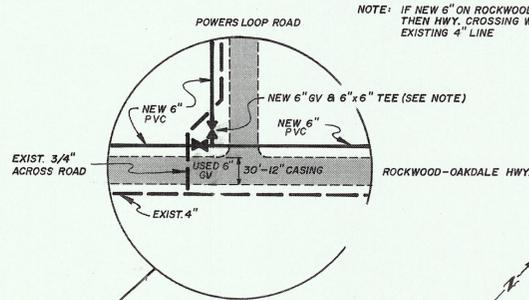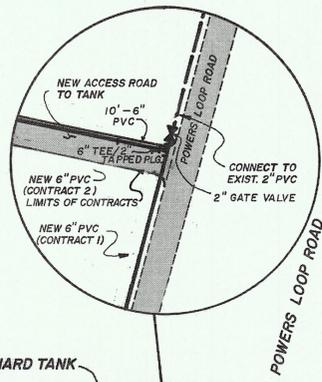

NOTE: IF NEW 6" ON ROCKWOOD-OAKDALE HWY. IS NOT CONSTRUCTED THEN HWY. CROSSING WILL BE NECESSARY FOR TIE-IN TO EXISTING 4" LINE

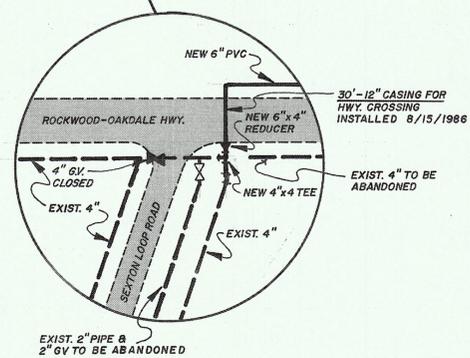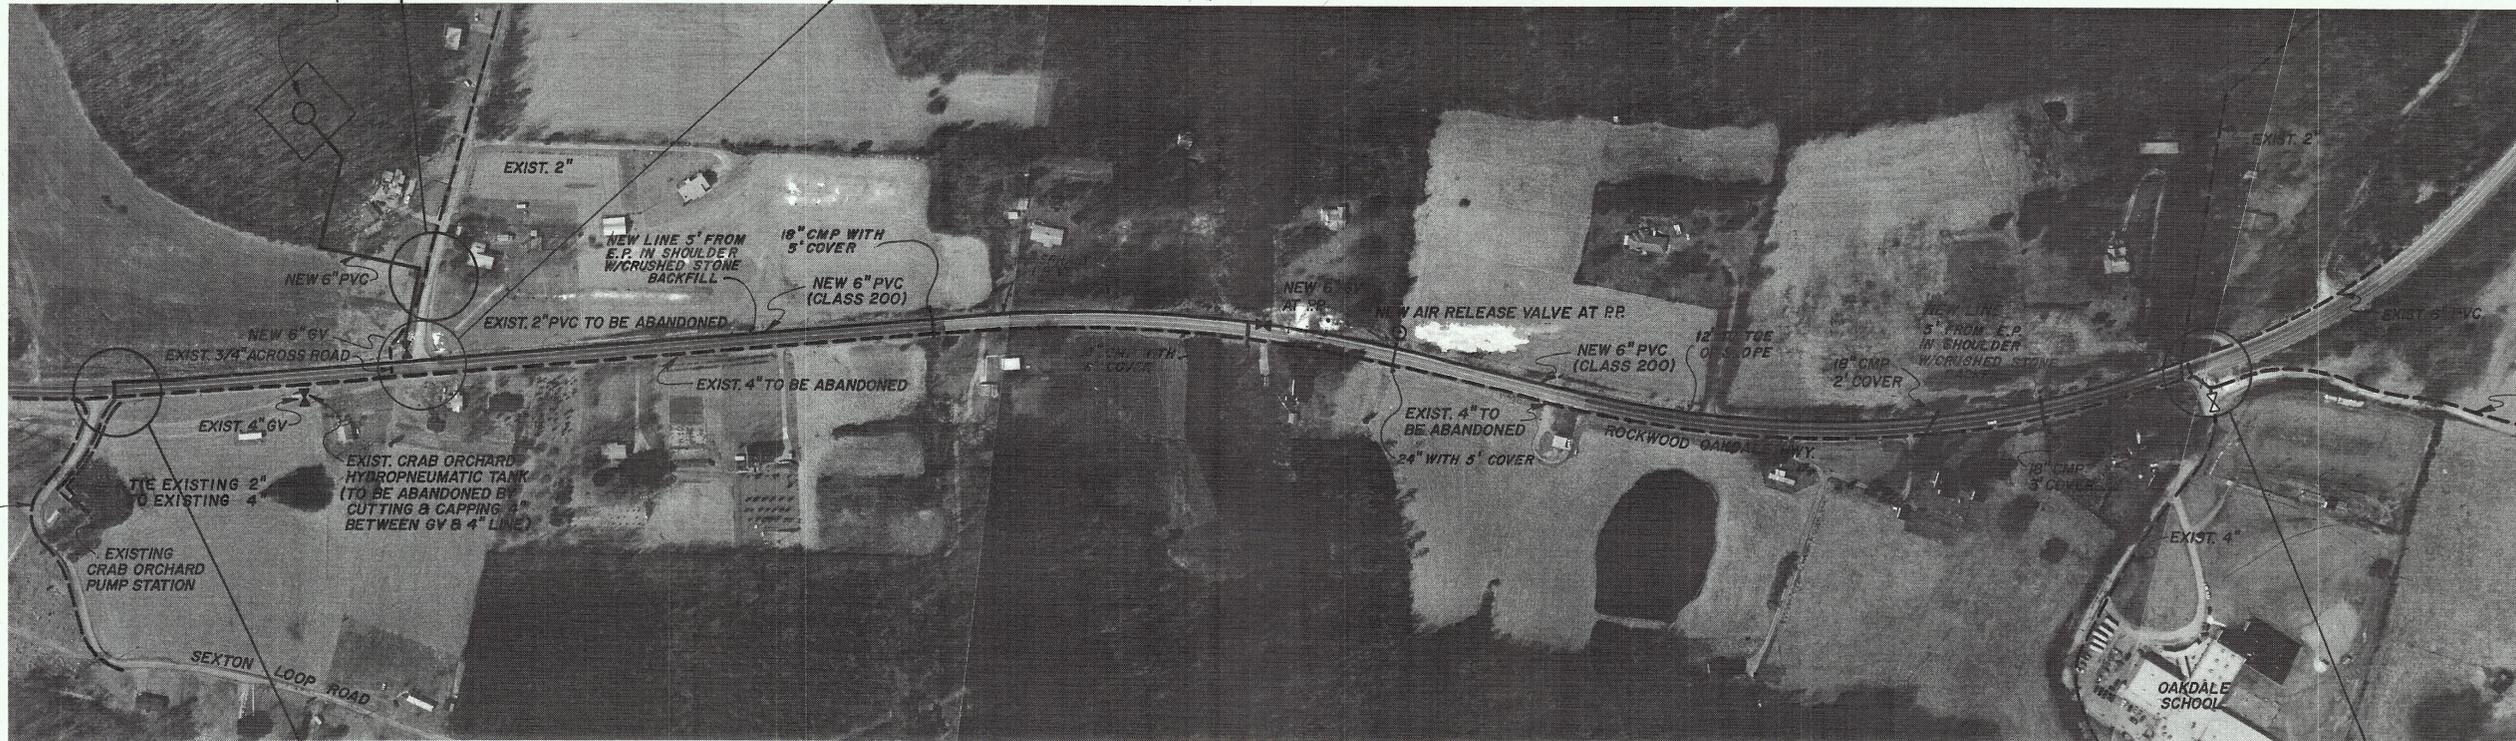

DEDUCTIVE ALTERNATE NO. 2
 (ALL WORK THIS DWG. EXCEPT 6" LINE ON POWERS LOOP ROAD TO NEW TANK)

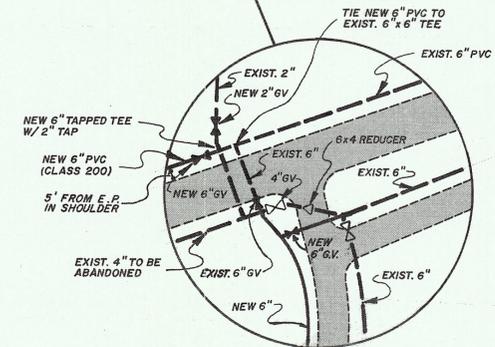


Record Drawing
 Date MARCH 1987

SCALE: 1"=200'



REV. RECORD DRAWING	3/87	JDH
Dr. 1/86	GAW	cl. JDH
HENSLEY - SCHMIDT, INC. CONSULTING ENGINEERS ATLANTA, CHATTANOOGA, KNOXVILLE.		
PLAN SCALE 1"=100'	7972-7.1	

FROM OAKDALE

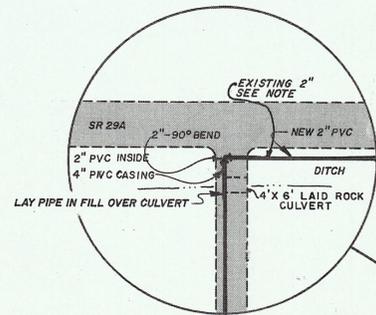

FROM OAKDALE

NEW 2" BLOW OFF VALVE AT E.O.L.


NEW AIR RELEASE VALVE

NEW 2"

NOTE 1:

REPLACE EXIST. 2" PVC W/ NEW 2" PVC (CLASS 200) (IN SAME TRENCH, IF TOTAL COST TO OWNER WOULD BE LESS THAN W/ NEW TRENCH)

EAST MAIN STREET

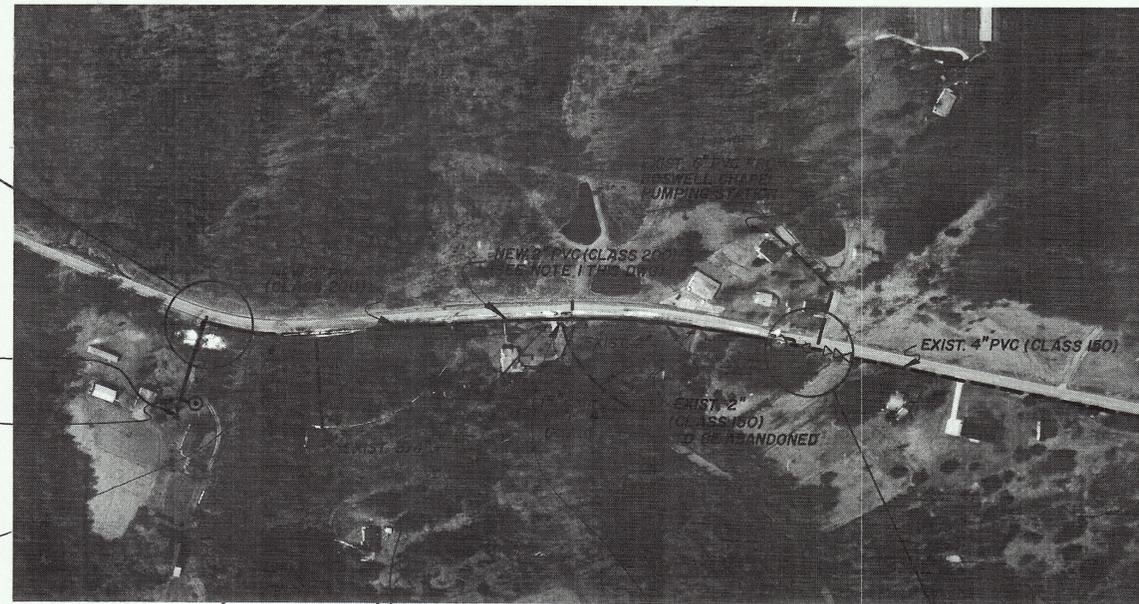


STATE ROUTE 328

12' TO NEW LINE

EXISTING LINE 2.5' FROM E.P.

RECONNECT EXIST. 2" LINE 25' ASPHALT

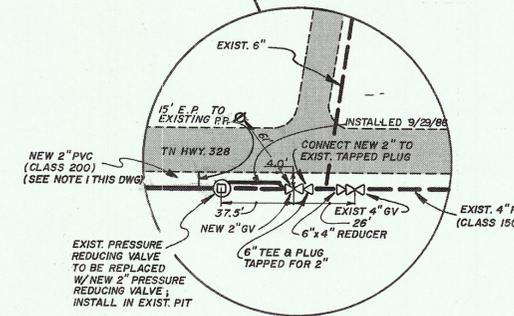

Record Drawing
Date March, 1987





LEGEND

NEW WATER LINES	—————
EXISTING WATER LINES	—————
GATE VALVE	— — —
AIR RELEASE VALVE	—○—
PRESSURE REDUCING VALVE	—□—
REDUCER	—▷—



SCALE: 1" = 200'

REV	RECORD DRAWING	3/87	JDH
Dr.	1/86	GAW	CL. JDH
HENSLEY - SCHMIDT, INC. CONSULTING ENGINEERS ATLANTA, CHATTANOOGA, KNOXVILLE			
PLAN SCALE	7972-8.1		
1" = 100'			

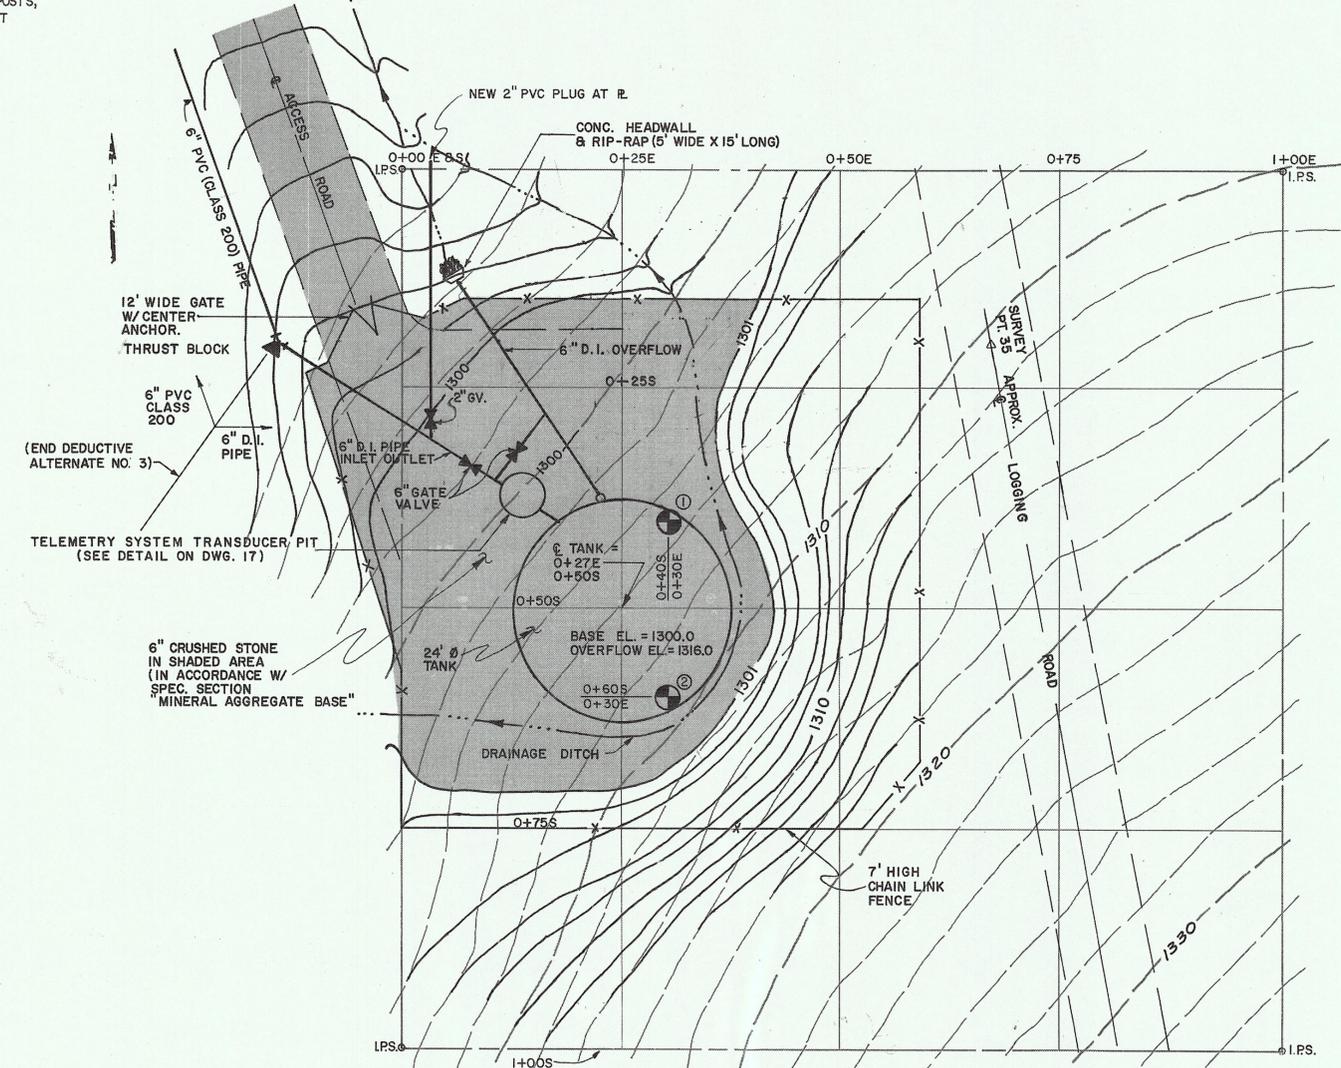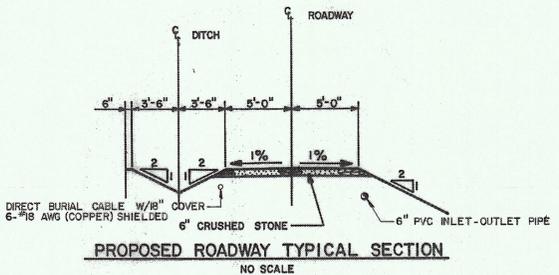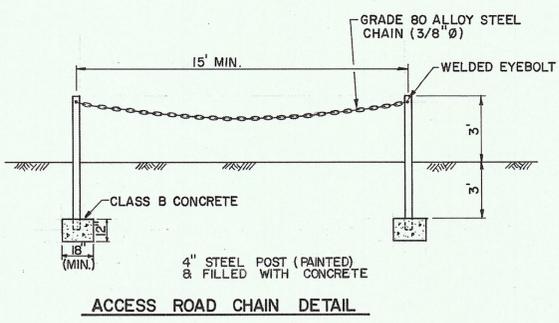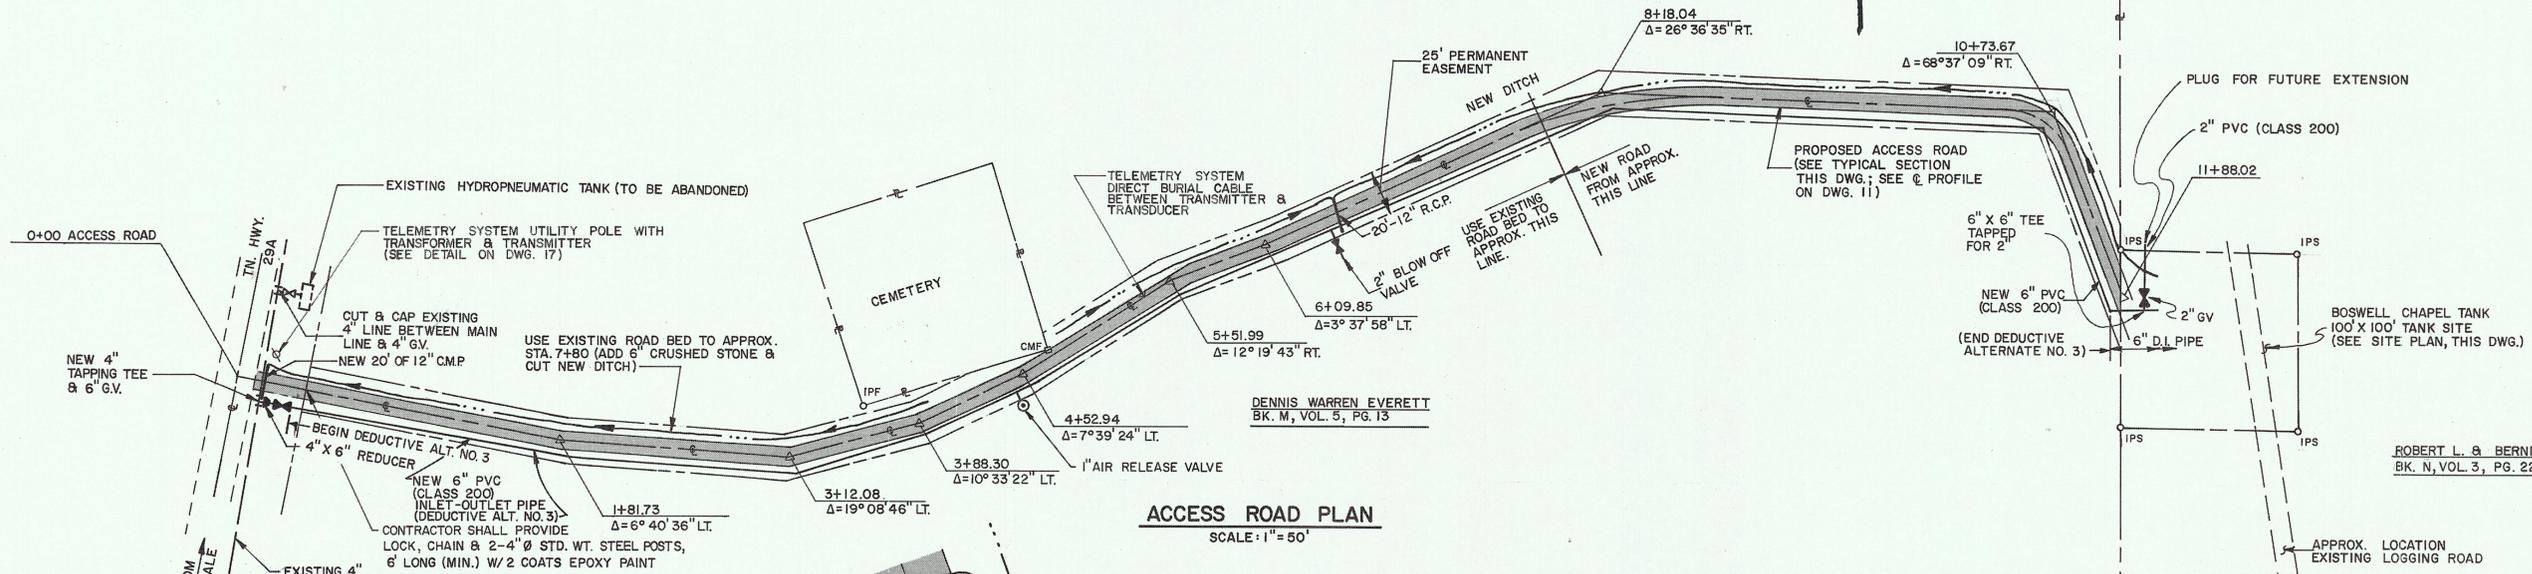

- NOTES:
1. ALL WORK ON THIS DRAWING SHALL BE INCLUDED IN CONTRACT 2, WATER STORAGE TANK.
 2. ALL AREAS DISTURBED DURING CONSTRUCTION SHALL BE SEEDED OR OTHERWISE TREATED AS SHOWN OR SPECIFIED.
 3. ALL NOTES LISTED ON DWG. 2 SHALL ALSO APPLY TO WORK UNDER CONTRACT 2.
 4. 6" PVC INLET-OUTLET PIPE BETWEEN LIMITS SHOWN SHALL BE DEDUCTIVE ALTERNATE NO. 3, AND MAY BE INSTALLED BY OWNER AS PART OF LOCAL SHARE OF PROJECT.

2	JDH	3/87	RECORD DRAWING
1	JDH	5/86	ADDED TELEMETRY SYSTEM
REV.	BY	DATE	DESCRIPTION




CONTRACT NO. 2 - WATER STORAGE TANKS

BOSWELL CHAPEL TANK - ACCESS ROAD AND SITE PLAN

WOLFE BRANCH UTILITY DISTRICT
OAKDALE, TENNESSEE



DESIGNED BY:	HENSLEY-SCHMIDT, INC.	DRAWING NO.
DRAWN BY:	Engineers and Managers	7972-9.2
CHKD. DATE:	ATLANTA-CHATTANOOGA-JACKSON	
APPR. DATE:	CHARLOTTE-KNOXVILLE-VALDOSTA	

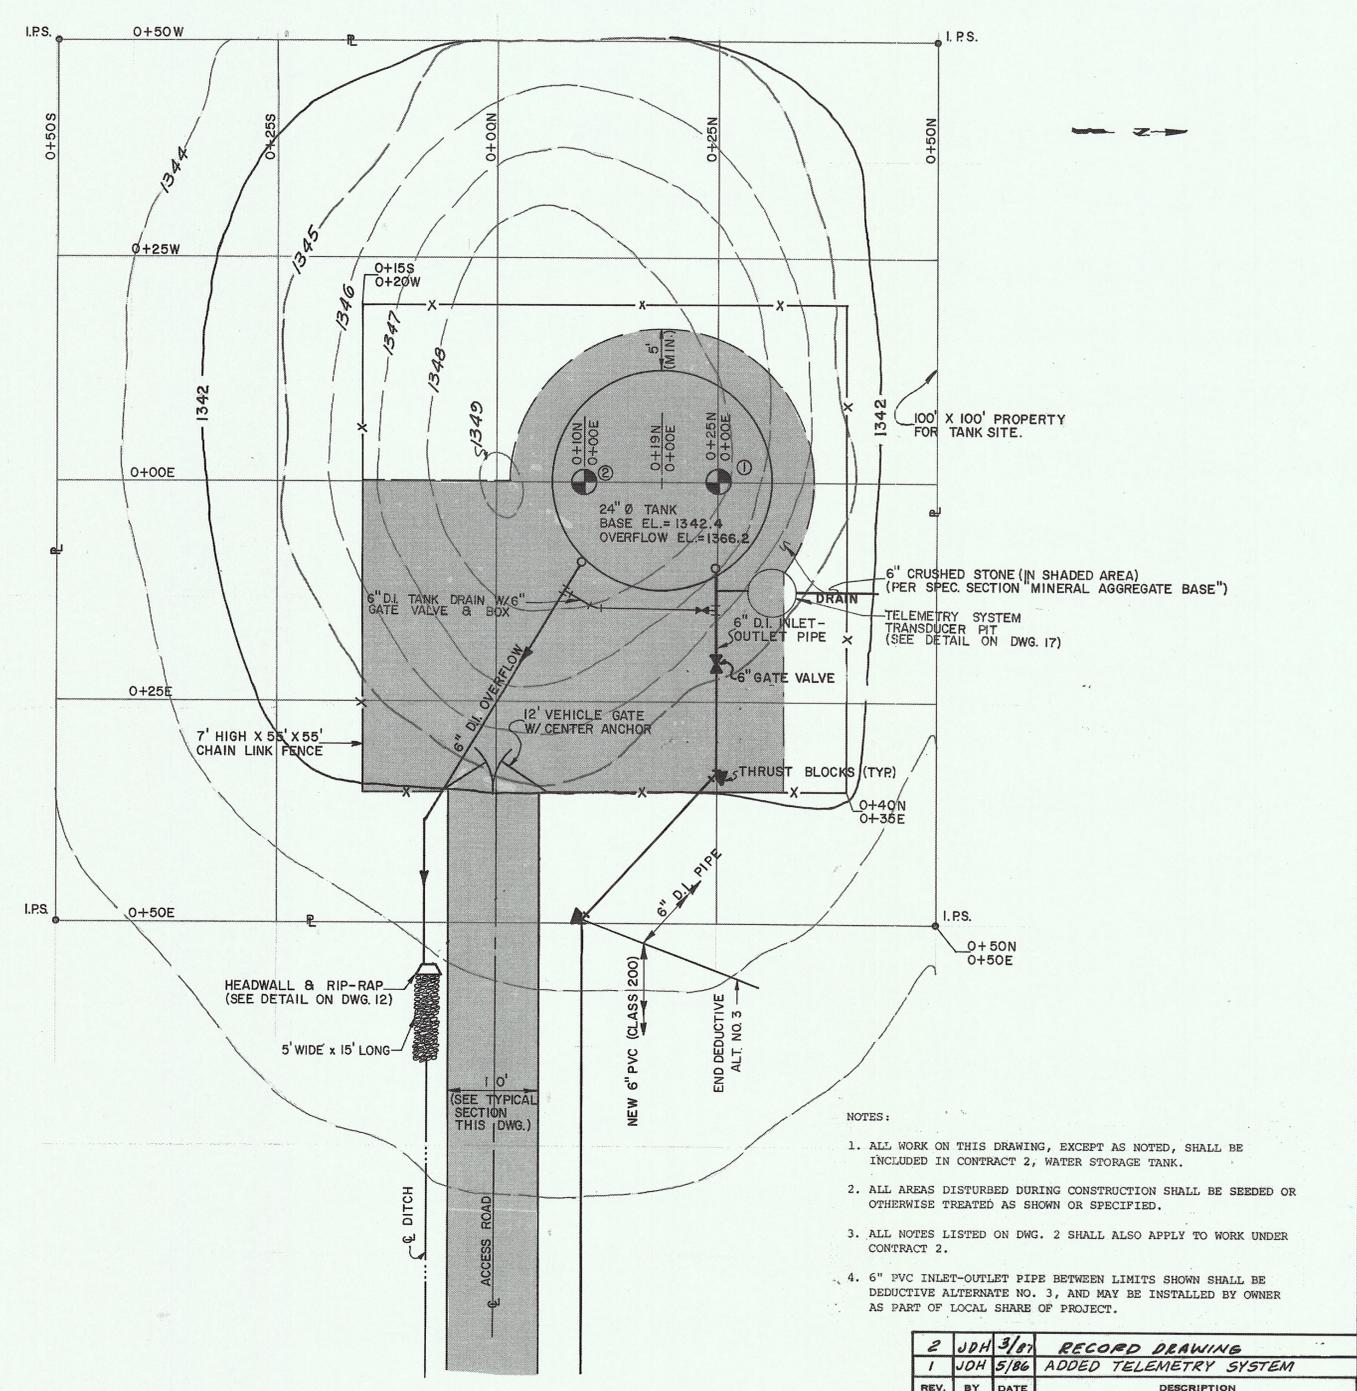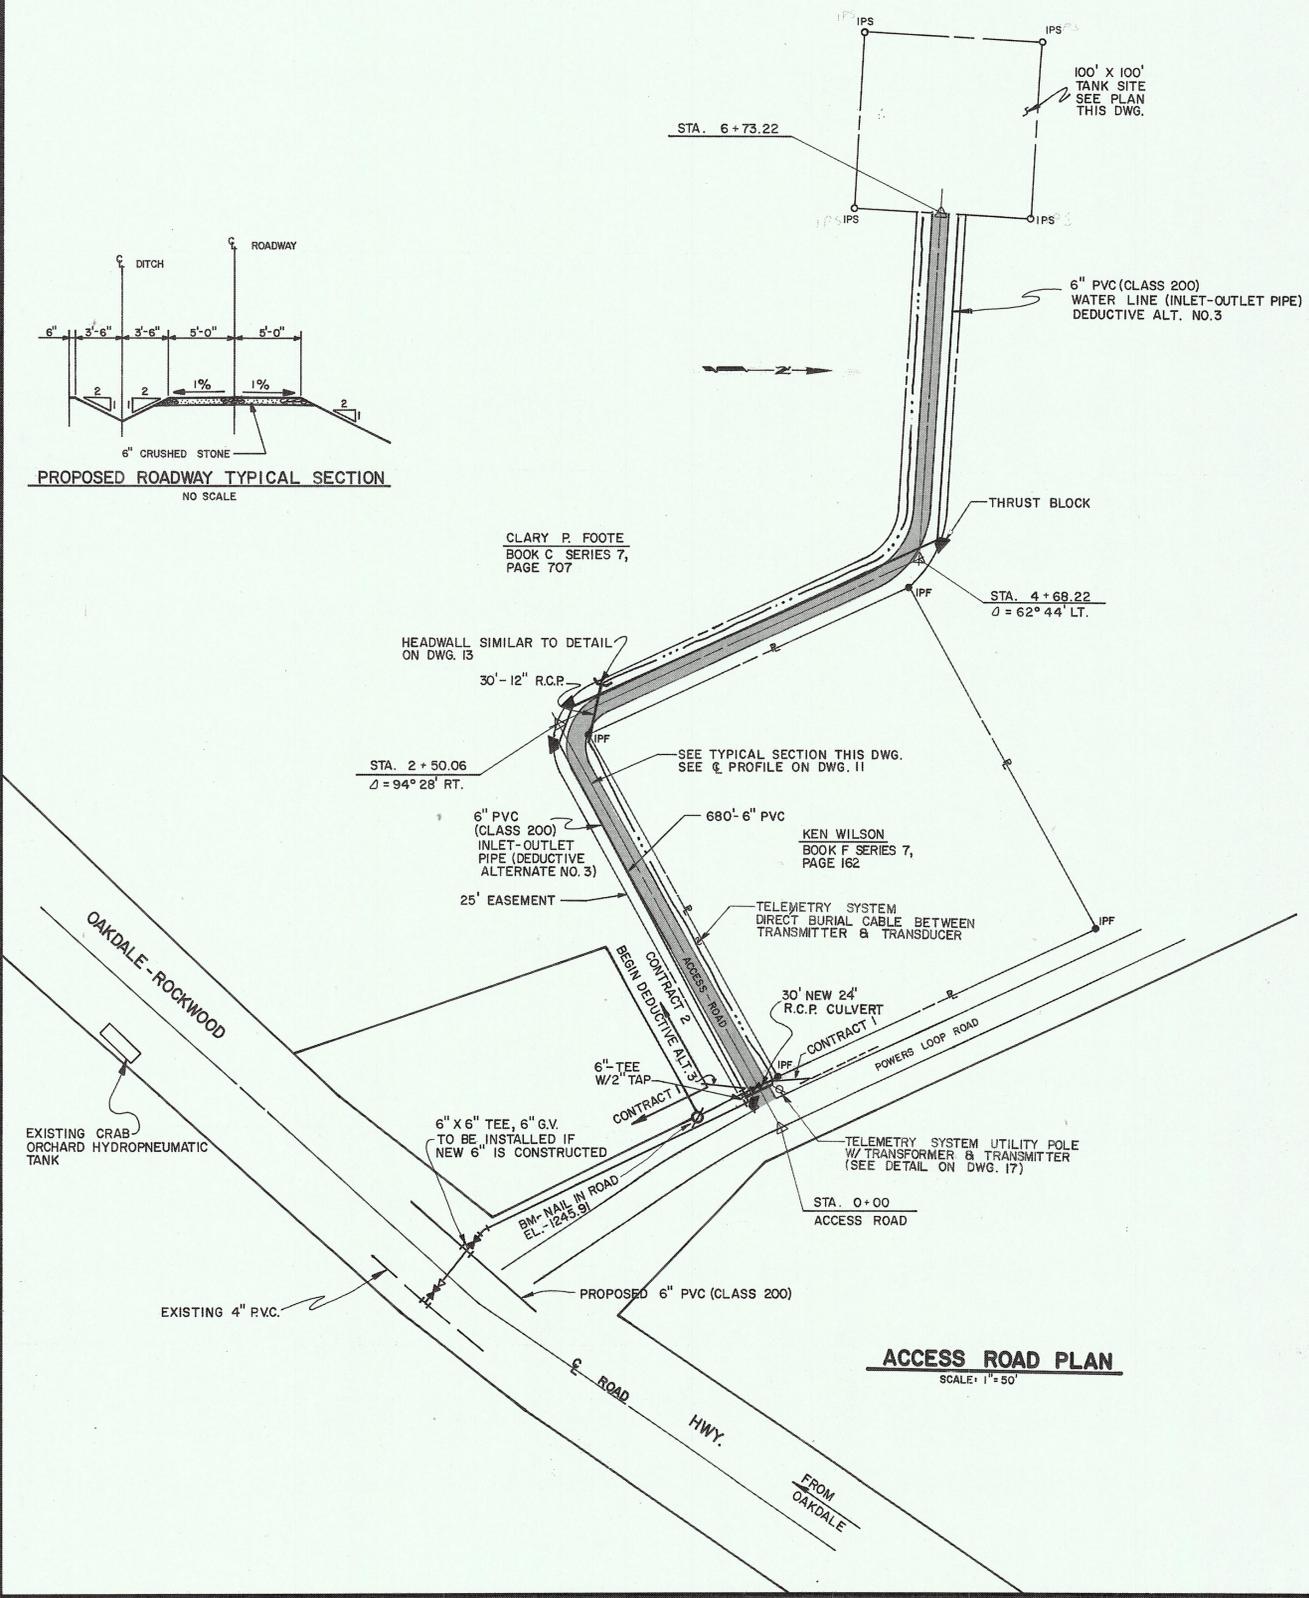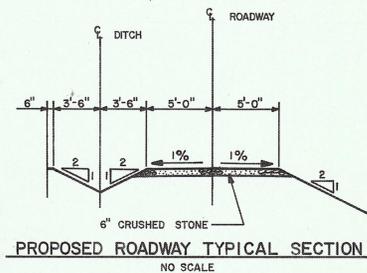

- NOTES:
1. ALL WORK ON THIS DRAWING, EXCEPT AS NOTED, SHALL BE INCLUDED IN CONTRACT 2, WATER STORAGE TANK.
 2. ALL AREAS DISTURBED DURING CONSTRUCTION SHALL BE SEEDED OR OTHERWISE TREATED AS SHOWN OR SPECIFIED.
 3. ALL NOTES LISTED ON DWG. 2 SHALL ALSO APPLY TO WORK UNDER CONTRACT 2.
 4. 6" PVC INLET-OUTLET PIPE BETWEEN LIMITS SHOWN SHALL BE DEDUCTIVE ALTERNATE NO. 3, AND MAY BE INSTALLED BY OWNER AS PART OF LOCAL SHARE OF PROJECT.

REV.	BY	DATE	DESCRIPTION
2	JDH	3/87	RECORD DRAWING
1	JDH	5/86	ADDED TELEMETRY SYSTEM

CONTRACT NO. 2 - WATER STORAGE TANKS

**CRAB ORCHARD TANK -
ACCESS ROAD AND
SITE PLAN**

WOLFE BRANCH UTILITY DISTRICT
OAKDALE, TENNESSEE





DESIGNED BY: J.D.H.	HENSLEY-SCHMIDT, INC.	DRAWING NO.
DRAWN BY: G. RAMEY		7972- 10.2
CHKD. DATE:		
APPR. DATE:		






BRUNING 44-132-32758-4

FINAL SURVEY
 CHECKED BY: []
 DATE: []
 PLOTTED BY: []
 DATE: []
 NOTE BOOK NO. []
 AREA: []
 AREA: []

DATE: 10/11/85
 BY: J. JONES
 NO. 3119
 ORIGINAL SURVEY NO. []
 CHECKED BY: []
 DATE: []
 AREA: []
 AREA: []

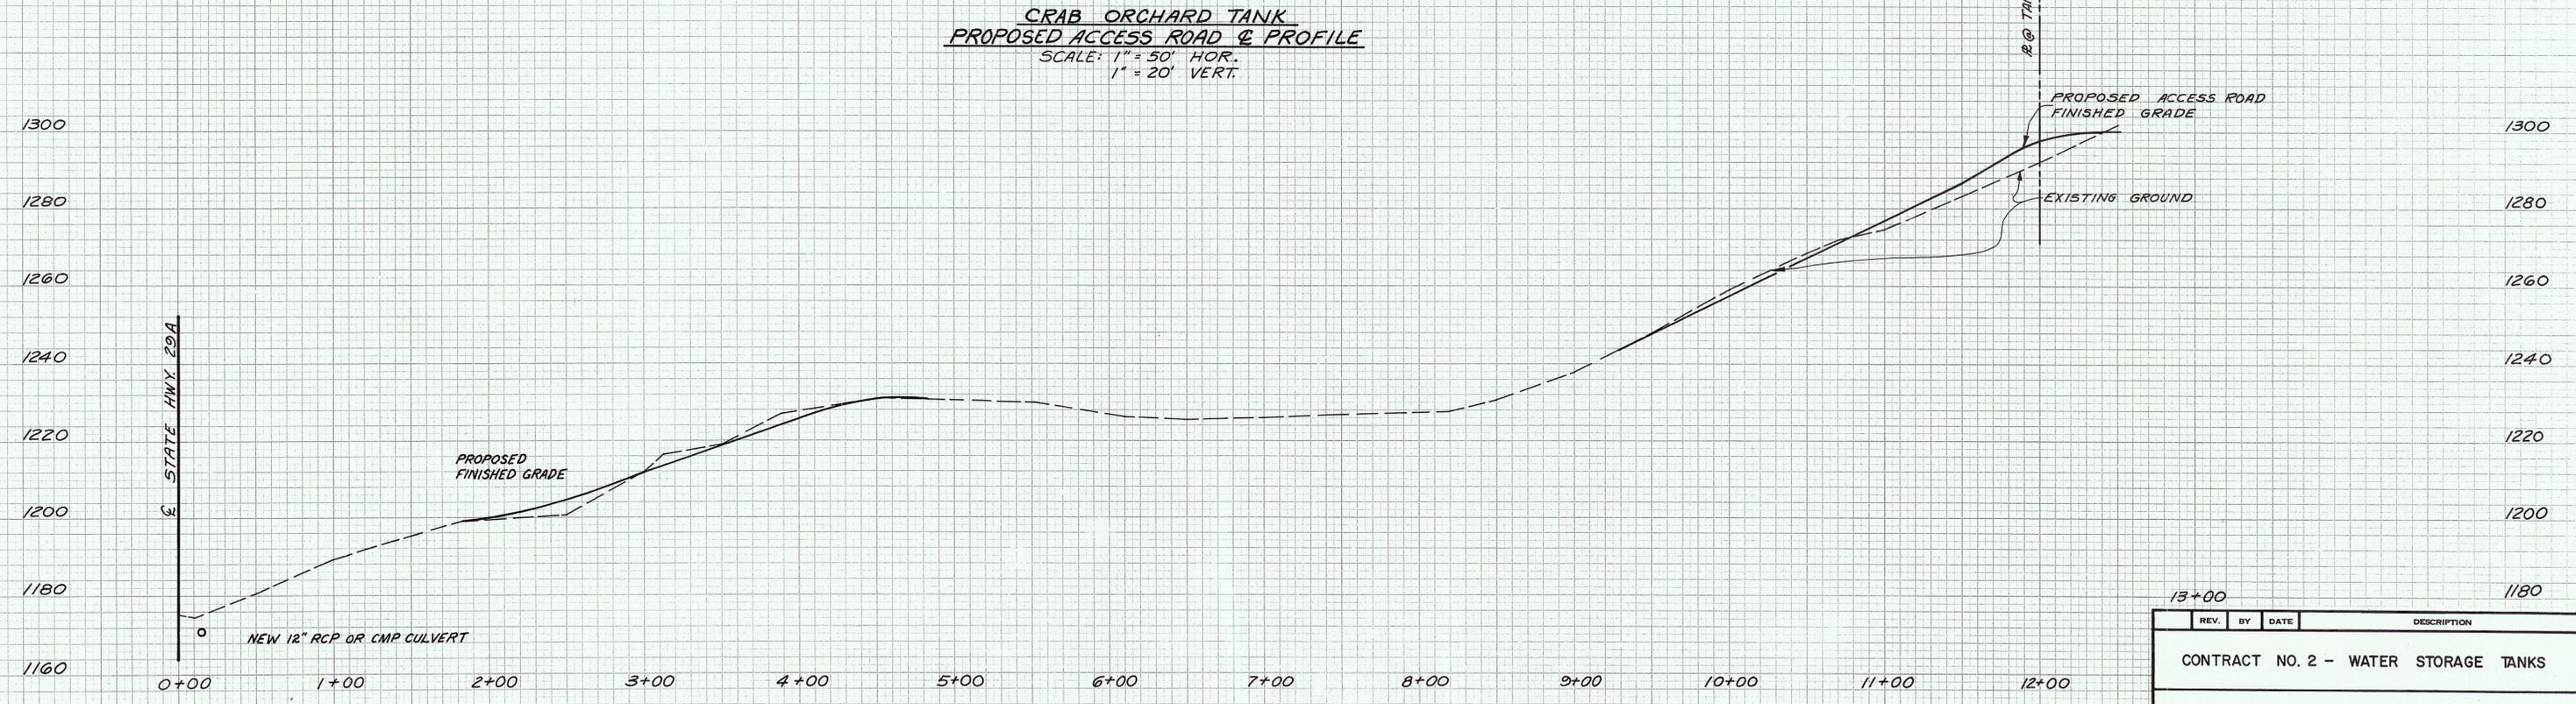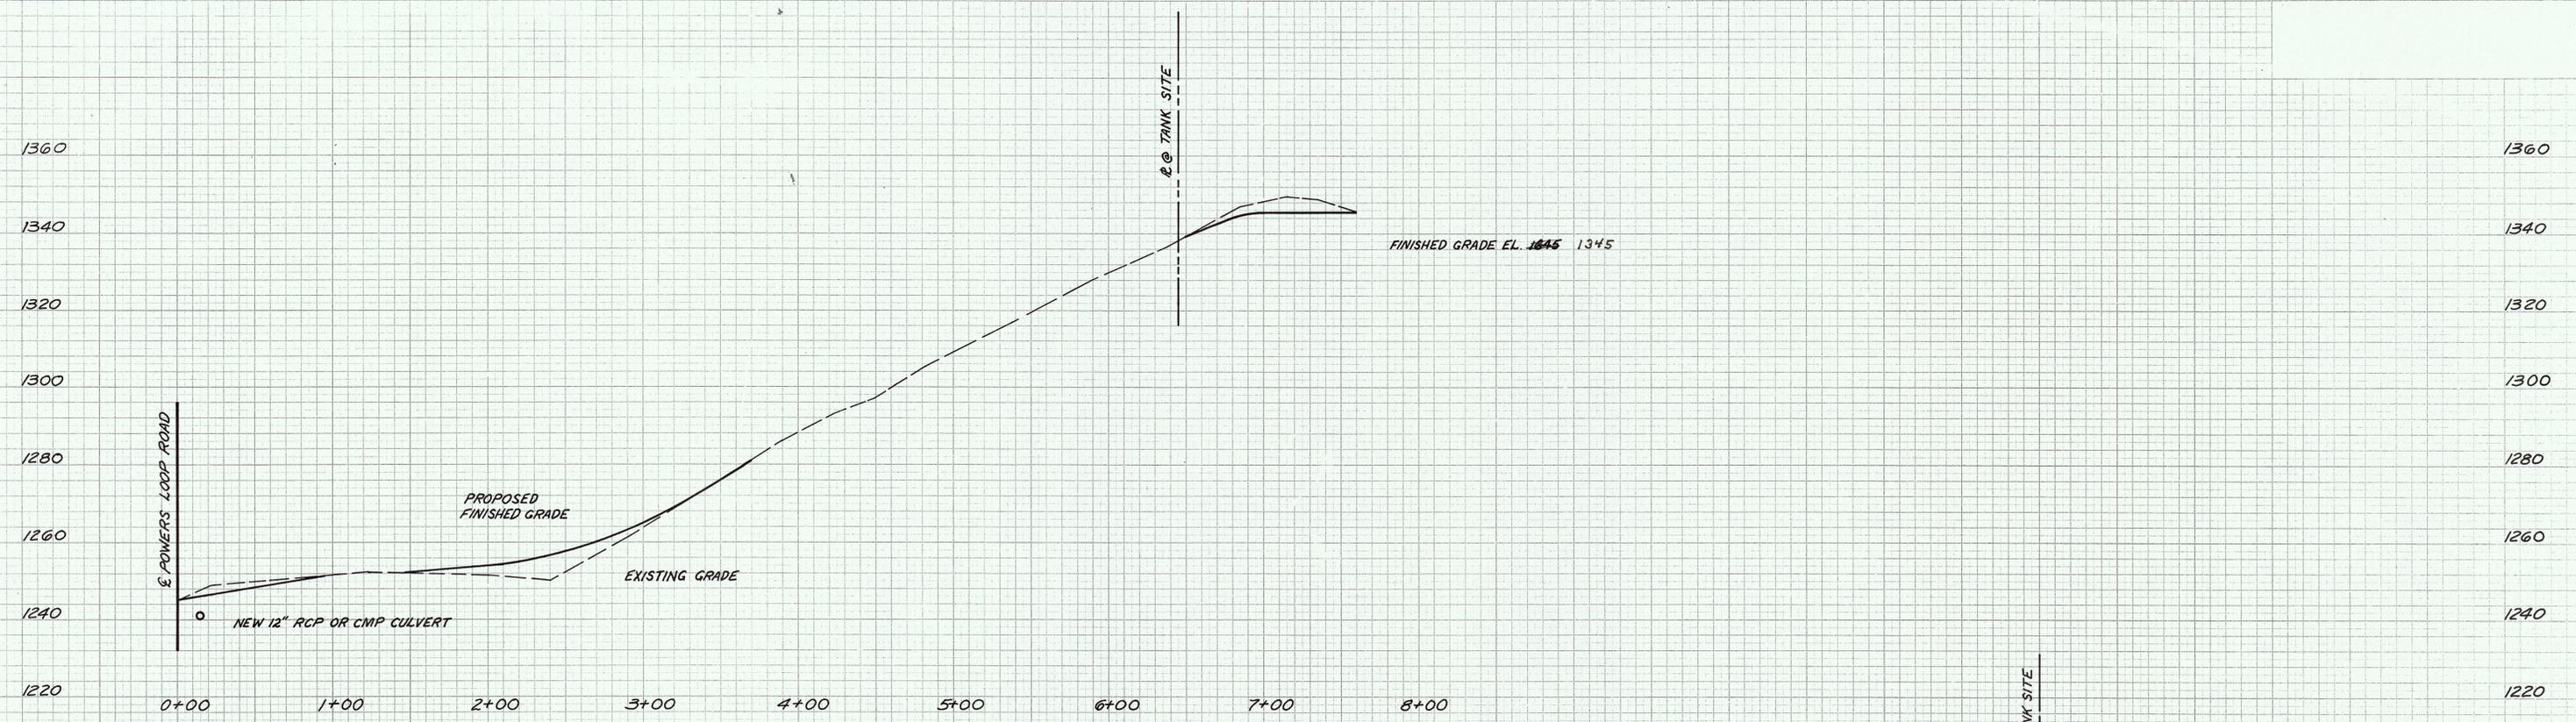

REV.	BY	DATE	DESCRIPTION
CONTRACT NO. 2 - WATER STORAGE TANKS			
TANK ACCESS ROADS - PROFILE			
WOLFE BRANCH UTILITY DISTRICT OAKDALE, TENNESSEE			
DESIGNED BY: JDH	HENSLEY - SCHMIDT, INC.		DRAWING NO.
DRAWN BY: JVD	CONSULTING ENGINEERS		7972- 11
CHKD. DATE:	ATLANTA - CHATTANOOGA - JACKSON		
APPR. DATE:	CHARLOTTE - KNOXVILLE - NASHVILLE		

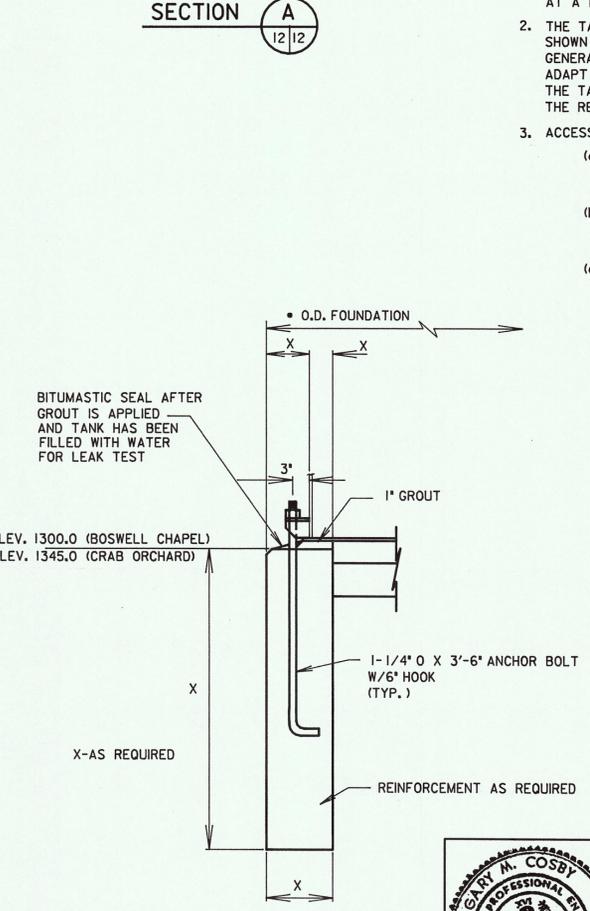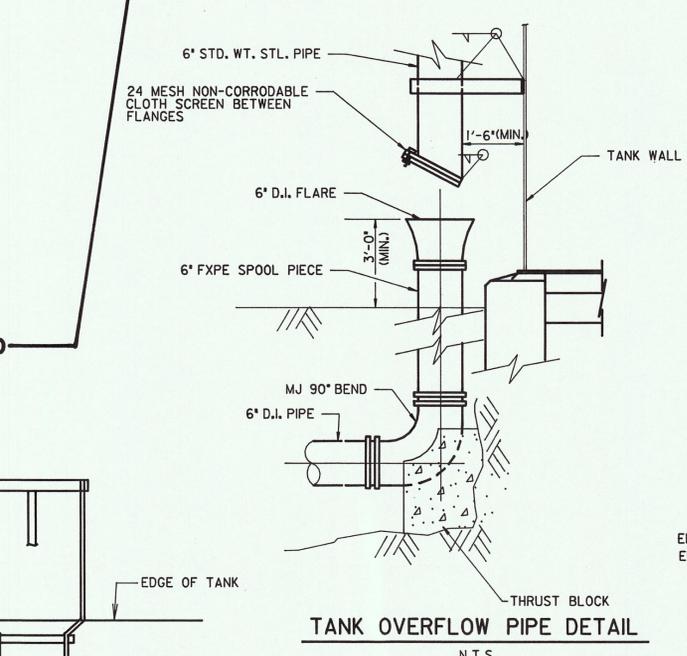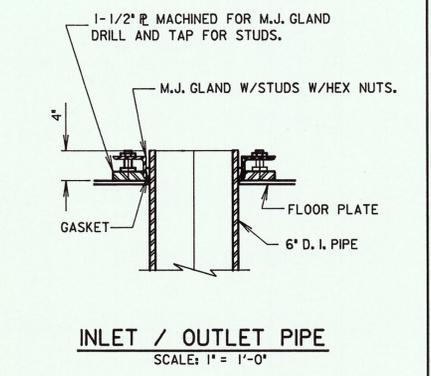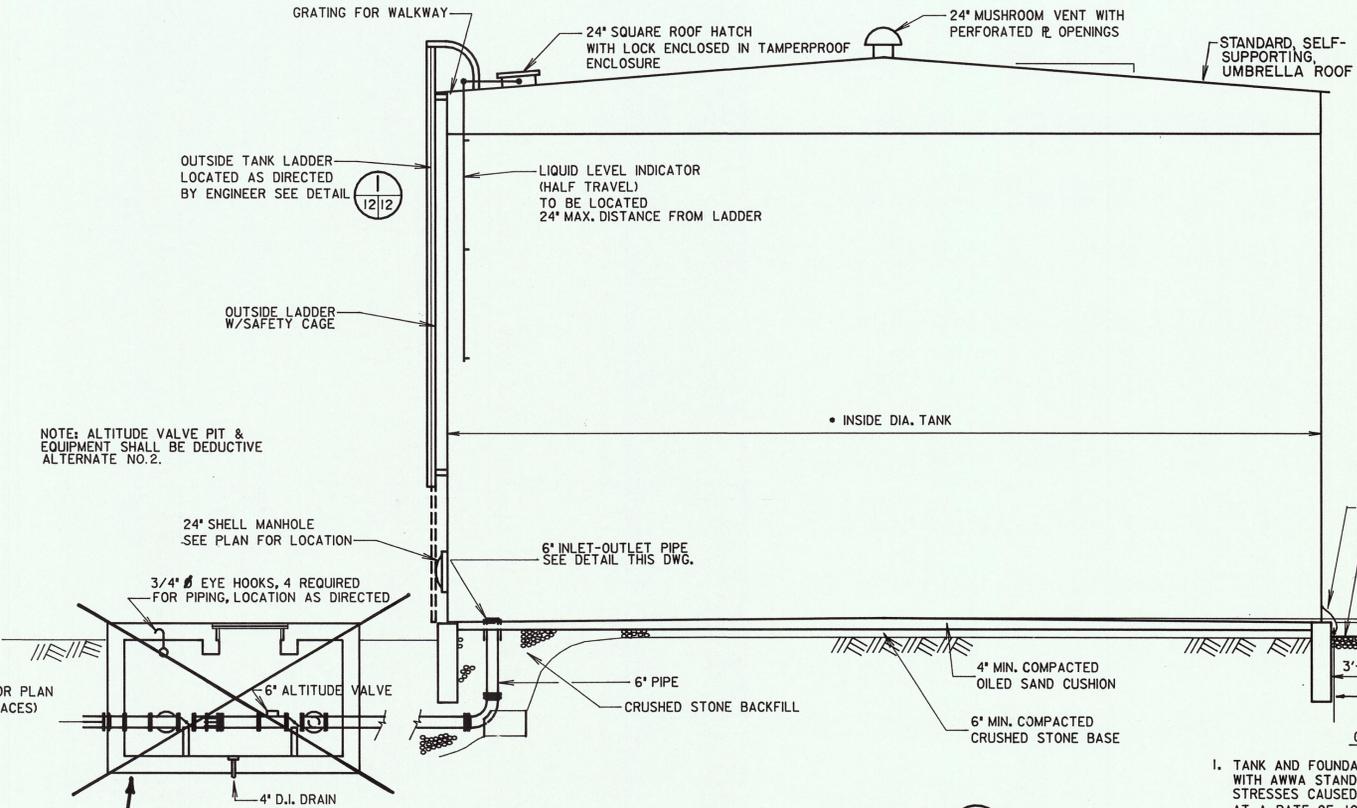
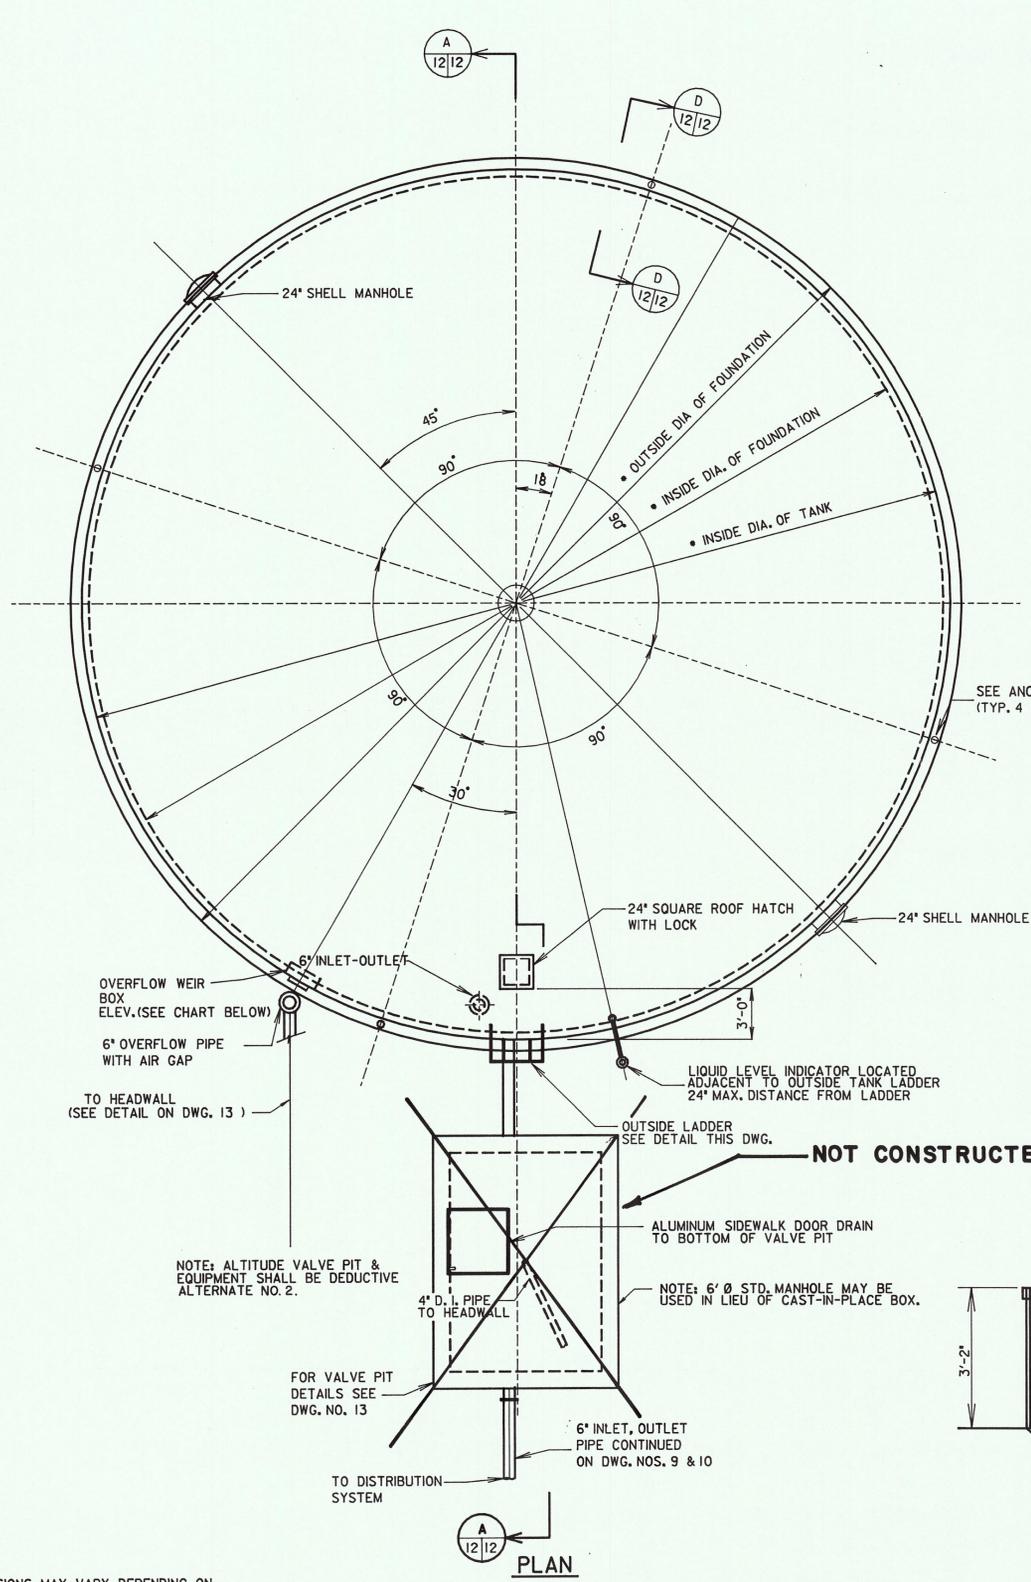


- GENERAL NOTES**
- TANK AND FOUNDATION SHALL BE DESIGNED IN ACCORDANCE WITH AWWA STANDARD SPECIFICATION D-100 INCLUDING STRESSES CAUSED BY A WIND FORCE BLOWING AT A RATE OF 100 MPH IN ANY DIRECTION.
 - THE TANK SHALL CONFORM TO THE DESIGN AND DIMENSIONS SHOWN ON THE DRAWINGS. THE CONTRACTOR MAY VARY THE GENERAL CONFIGURATION WITHIN REASONABLE LIMITS TO ADAPT THE TANK TO HIS STANDARD DESIGN PROCEDURES. THE TANK OVERFLOW AND TOP OF FOOTINGS SHALL BE AT THE RESPECTIVE ELEVATIONS SHOWN ON THE DRAWINGS.
 - ACCESSORIES:
 - TANK ACCESSORIES TO BE FURNISHED AND INSTALLED UNDER THIS CONTRACT ARE SHOWN AND/OR LISTED HEREINAFTER ON THE CONTRACT DRAWINGS OR SPECIFICATIONS.
 - THE TANK ACCESSORIES SHALL CONFORM TO ALL APPLICABLE PROVISIONS OF AWWA STANDARD SPECIFICATION D-100, LATEST EDITION.
 - THE ACCESSORIES TO BE FURNISHED AND INSTALLED ARE AS FOLLOWS:
 - OUTSIDE TANK LADDER W/SAFETY CAGE
 - TWO (2) 24-INCH-DIAMETER SHELL MANHOLES
 - ONE (1) 24-INCH-SQUARE WATERPROOF ROOF HATCH WITH LOCK
 - ONE (1) 24-INCH REMOVABLE MUSHROOM VENT
 - LIQUID LEVEL INDICATOR
 - 6-INCH OVERFLOW PIPING WITH WEIR BOX
 - PAINTER'S TROLLEY RAIL AT TOP OF TANK

• DIMENSIONS MAY VARY DEPENDING ON ACTUAL SIZE OF TANK FURNISHED

TANK DIMENSIONS	BOSWELL CHAPEL	CRAB ORCHARD
OUTSIDE DIAMETER OF FOUNDATION	AS REQUIRED	AS REQUIRED
INSIDE DIAMETER OF FOUNDATION	AS REQUIRED	AS REQUIRED
INSIDE DIAMETER OF TANK	24'	24'
OVERFLOW WEIR BOX ELEVATION	1323.8	1366.2
BASE OF TANK ELEVATION	1300.0	1342.4

NOTE: DIMENSIONS SHOWN ARE FOR 50,000 GAL. TANK. DIMENSIONS FOR 30,000 GAL. TANK ARE: 19' 0" x 16' 0" TO OVERFLOW. BASE ELEVATIONS WOULD BE SAME FOR EITHER SIZE TANK.

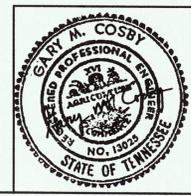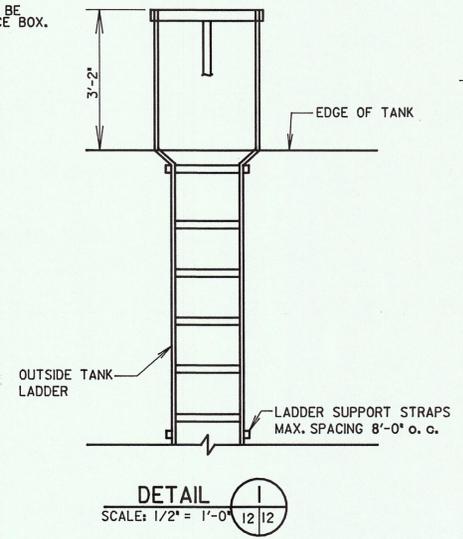


DESIGN	J.D.H.	1/86	HENSLEY - SCHMIDT, INC. ENGINEERS, MANAGERS AND SURVEYORS ATLANTA • CHATTANOOGA KNOXVILLE • RALEIGH	DRAWING NO.	7972-12.1
DRWN	CADD	1/86			
CHKD					
APPR					

RECORD DRAWING



WATER SYSTEM IMPROVEMENTS-PHASE II
CONTRACT 2

**ELEVATIONS & DETAILS
WATER STORAGE TANKS AT
BOSWELL CHAPEL & CRAB ORCHARD**

WOLFE BRANCH UTILITY DISTRICT
OAKDALE, TENNESSEE

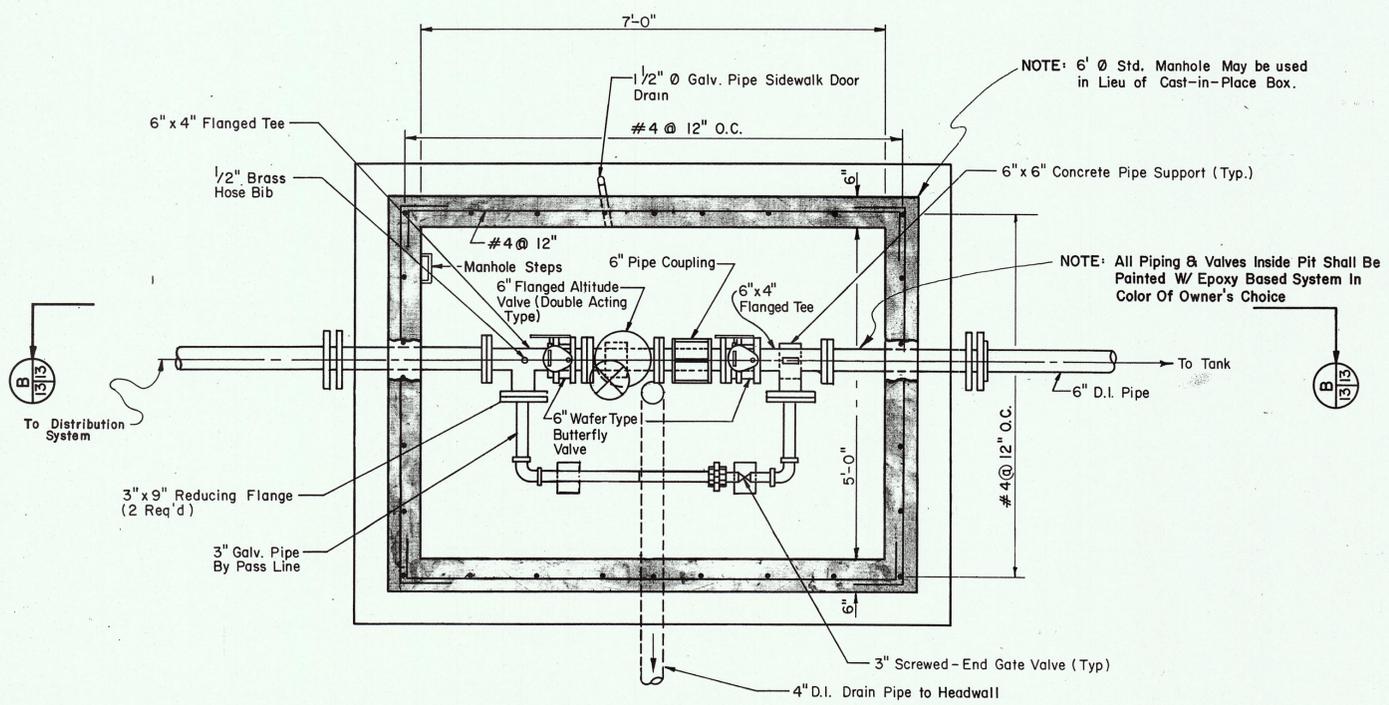

ALTITUDE VALVE PIT (DEDUCTIVE ALTERNATE, CONTRACT 2)
Scale: 3/4" = 1'-0"

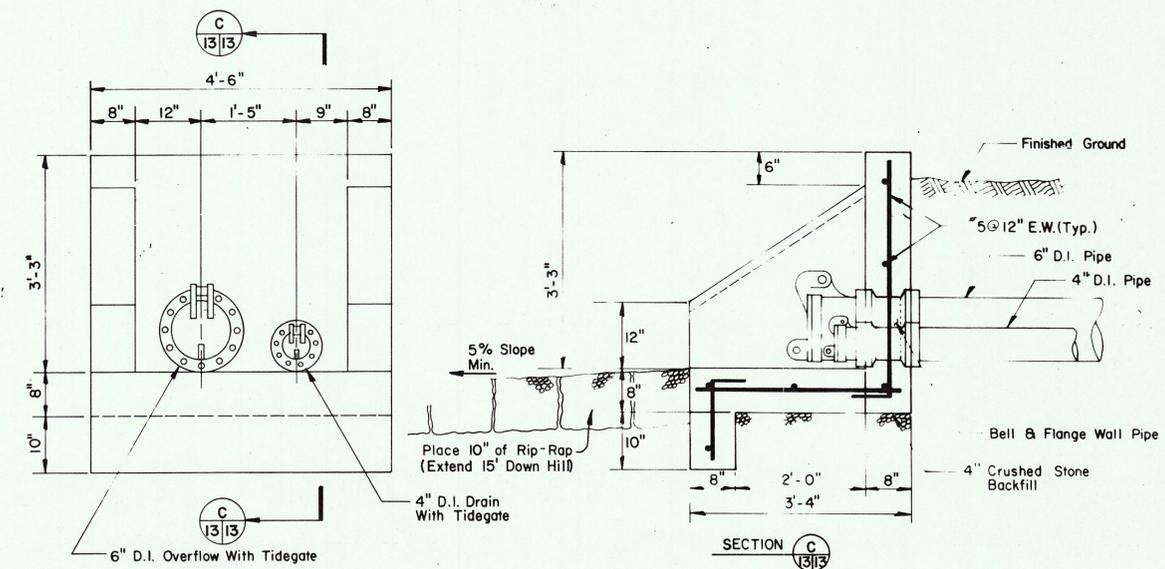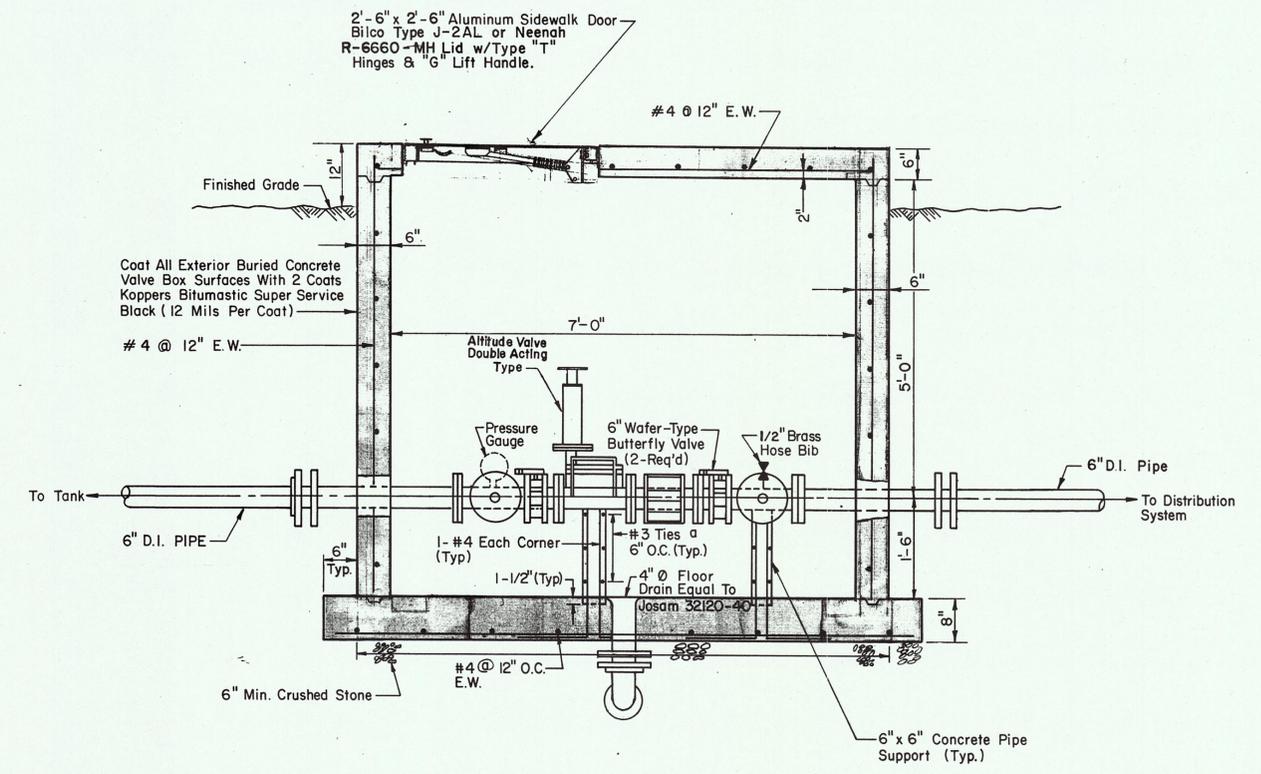

HEADWALL DETAIL
Scale: 3/4" = 1'-0"

NOT CONSTRUCTED
(TELEMETRY SYSTEMS UTILIZED TO CONTROL TANK ELEVATIONS)

REV.	BY	DATE	DESCRIPTION


CONTRACT NO. 2 — WATER STORAGE TANKS

ALTITUDE VALVE PIT SECTION AND DETAILS

WOLFE BRANCH UTILITY DISTRICT
OAKDALE, TENNESSEE





DESIGNED BY: D.B.R.	HENSLEY-SCHMIDT, INC.	DRAWING NO.
DRAWN BY: G. Ramsey	CONSULTANTS	7972 -13
CHKD. DATE:	ATLANTA - CHATTANOOGA - JACKSON	
APPR. DATE:	CHARLOTTE - KNOXVILLE - NASHVILLE	

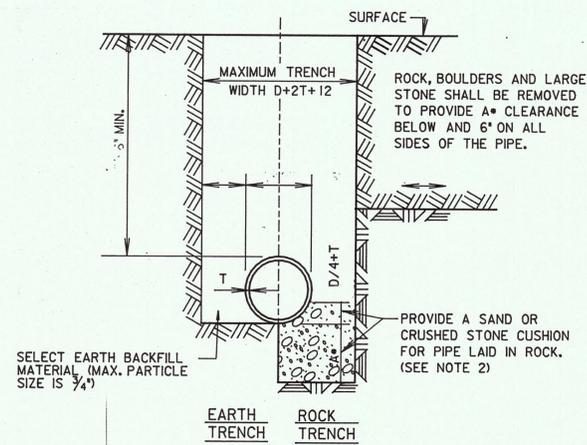

PIPE SIZE	A*
6" & LESS	6"
8" & LARGER	8"

PIPE LAYING DETAILS FOR DUCTILE IRON PIPE

NO SCALE

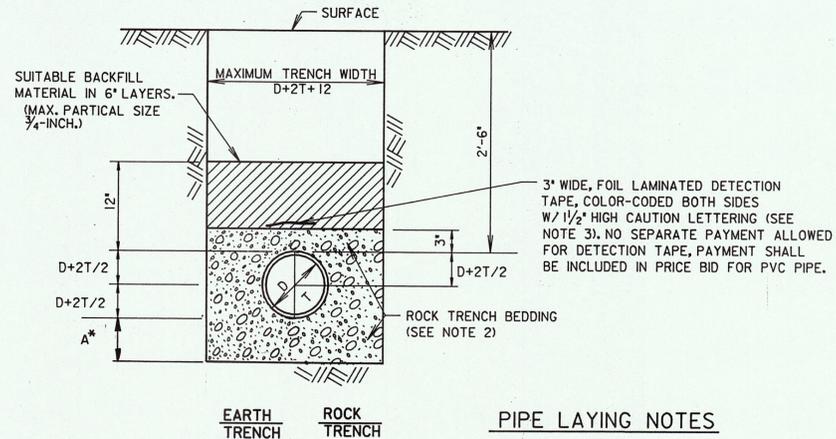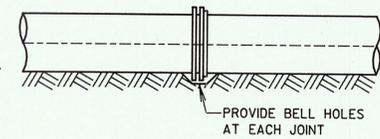


PIPE LAYING DETAIL
PVC PIPE

NO SCALE


PIPE LAYING NOTES

1. NO SEPARATE PAYMENT WILL BE MADE FOR CRUSHED STONE BEDDING PLACED IN EARTH TRENCH, PAYMENT SHALL BE INCLUDED IN THE UNIT PRICE BID FOR PVC PIPE.
2. QUANTITIES OF CRUSHED STONE FOR ROCK TRENCH SHALL BE THE AMOUNT IN EXCESS OF EARTH TRENCH BEDDING AND SHALL BE PAID FOR SEPARATELY UNDER "CRUSHED ROCK BEDDING MATERIAL" IN THE BID SCHEDULE.
3. 3" WIDE DETECTION TAPE SHALL ALSO BE PROVIDED ABOVE ALL NON-METALLIC SERVICE LINES INSTALLED BY THE CONTRACTOR. LOCATE 3" ABOVE AND CENTER OVER SERVICE LINES IN TRENCH, (NO SEPARATE PAYMENT, INCLUDED IN PRICE OF SERVICE LINE).

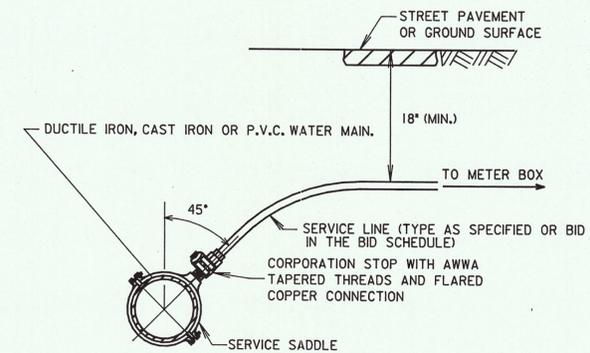


TYPICAL SERVICE INSTALLATION FOR
1" METERS & SMALLER

NO SCALE

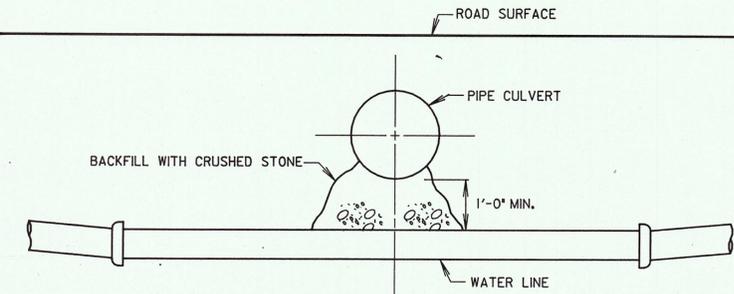

TYPICAL INSTALLATION
UNDER PIPE CULVERT


NO SCALE

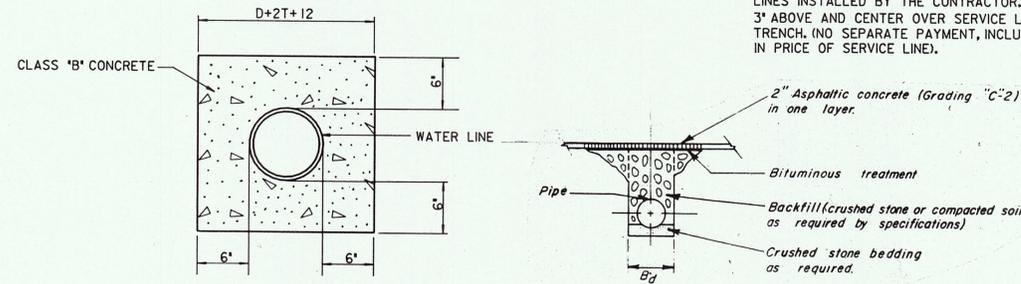

SECTION A-A


NO SCALE

TYPE 2
ASPHALTIC CONCRETE
FOR
LIGHT DUTY USE

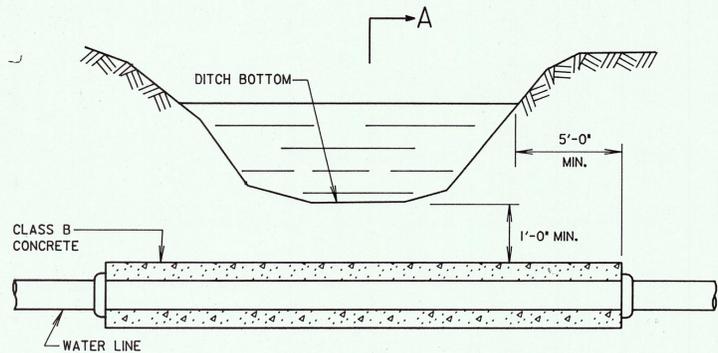

TYPICAL DITCH CROSSING

NO SCALE

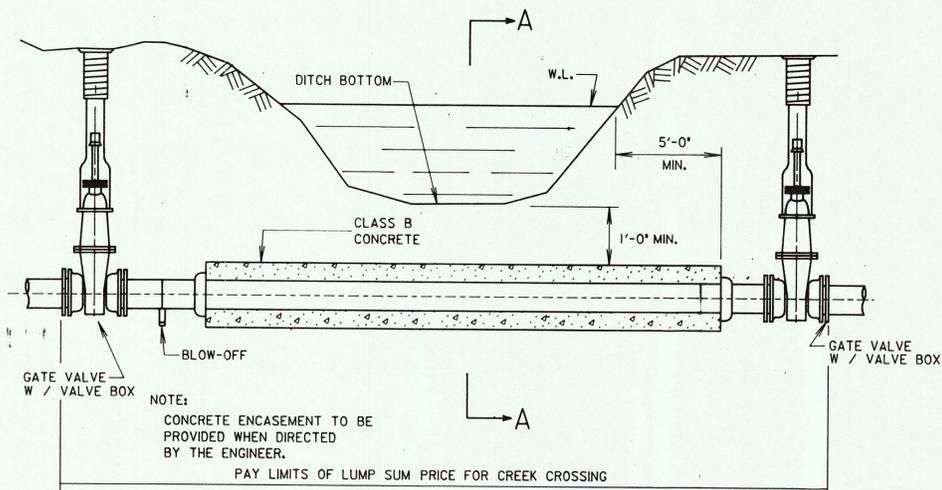


TYPICAL CREEK CROSSING

NO SCALE

NOTE:
CREEK CROSSING TO BE BID AS A SEPARATE ITEM IN THE BID SCHEDULE


NOTE:
NO SEPARATE PAYMENT ALLOWED FOR DITCH CROSSING CLASS "B" CONCRETE TO BE PAID FOR PER CUBIC YARD AS BID UNDER THE APPROPRIATE ITEM IN THE BID SCHEDULE

△			
△			
△			
REV. NO.	RELEASED BY	DESCRIPTION OF REVISION	
WATER SYSTEM IMPROVEMENTS PHASE II			
PIPING DETAILS SHEET 1 OF 2			
WOLFE BRANCH UTILITY DISTRICT OAKDALE, TENNESSEE			
J.D.H.	10/85	HENSLEY - SCHMIDT, INC. ENGINEERS, MANAGERS and SURVEYORS	
CADD	10/85	ATLANTA - CHATTANOOGA KNOXVILLE - RALEIGH	
JDH		7972-14	
GMC			

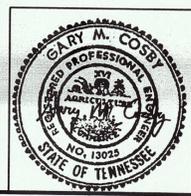


PIPE SIZE X	A	B	DEPTH C
90° BEND			
24"	2'-4"	4'-6"	5'-0"
20"	2'-4"	4'-0"	4'-6"
18"	2'-0"	3'-6"	4'-0"
16"	1'-9"	3'-4"	3'-6"
14"	1'-9"	2'-6"	3'-0"
12"	1'-6"	2'-0"	3'-0"
10"	1'-4"	2'-0"	2'-6"
8"	1'-0"	1'-6"	2'-0"
6"	1'-0"	1'-0"	2'-0"
4"	0'-9"	1'-0"	1'-0"
45° BEND			
24"	1'-4"	4'-6"	3'-0"
20"	1'-4"	3'-3"	3'-0"
18"	1'-0"	4'-0"	2'-0"
16"	1'-0"	4'-3"	1'-6"
14"	1'-0"	3'-6"	1'-4"
12"	1'-0"	3'-4"	1'-0"
10"	0'-9"	2'-6"	1'-0"
8"	0'-9"	1'-6"	1'-0"
6"	0'-9"	1'-0"	1'-0"
4"	0'-6"	1'-0"	1'-0"
22-1/2° BEND			
24"	1'-4"	3'-0"	2'-0"
20"	1'-4"	2'-6"	2'-0"
18"	1'-0"	2'-9"	1'-6"
16"	1'-0"	2'-4"	1'-4"
14"	1'-0"	2'-0"	1'-2"
12"	1'-0"	1'-9"	1'-0"
10"	0'-9"	1'-6"	0'-10"
8"	0'-9"	1'-0"	0'-8"
6"	0'-9"	1'-0"	0'-6"
4"	0'-6"	1'-0"	0'-4"
11-1/4° BEND			
24"	1'-4"	1'-6"	2'-0"
20"	1'-4"	1'-3"	2'-0"
18"	1'-0"	1'-4"	1'-6"
16"	1'-0"	1'-2"	1'-4"
14"	1'-0"	1'-0"	1'-2"
12"	1'-0"	1'-0"	1'-0"
10"	0'-9"	1'-0"	0'-10"
8"	0'-9"	1'-0"	0'-8"
6"	0'-9"	1'-0"	0'-6"
4"	0'-6"	1'-0"	0'-4"
UNBALANCED TEE & PLUG			
24"	3'-0"	7'-0"	5'-0"
20"	3'-0"	5'-0"	5'-0"
18"	2'-0"	5'-6"	3'-6"
16"	2'-0"	5'-6"	3'-0"
14"	2'-0"	4'-0"	3'-0"
12"	2'-0"	4'-6"	2'-0"
10"	1'-0"	3'-0"	2'-0"
8"	1'-0"	2'-9"	1'-6"
6"	1'-0"	1'-0"	1'-0"
4"	1'-0"	1'-0"	1'-0"
TEE			
24"	2'-6"	7'-0"	5'-0"
20"	2'-6"	5'-0"	5'-0"
18"	2'-6"	5'-6"	3'-6"
16"	2'-6"	5'-6"	3'-0"
14"	2'-4"	4'-0"	3'-0"
12"	2'-0"	4'-6"	2'-0"
10"	1'-9"	3'-0"	2'-0"
8"	1'-6"	2'-9"	1'-6"
6"	1'-0"	1'-0"	1'-0"
4"	1'-0"	1'-0"	1'-0"


TABLE OF DIMENSIONS FOR HORIZONTAL & VERTICAL SAG BENDS.

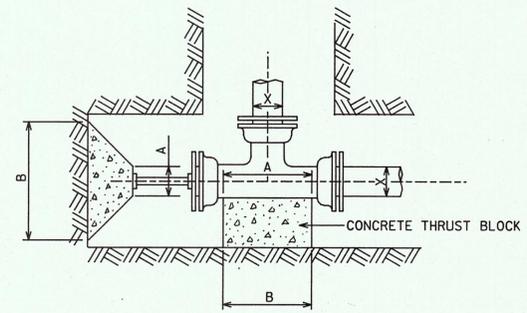


PLAN TYPICAL PLUG NO SCALE

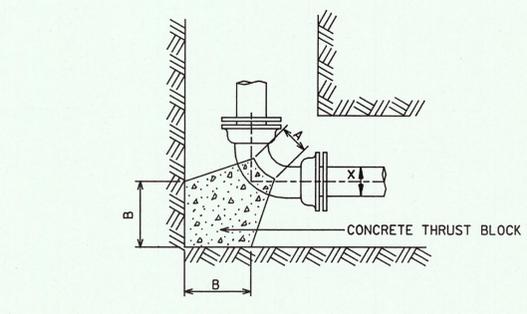


PLAN TYPICAL HORIZONTAL BEND NO SCALE

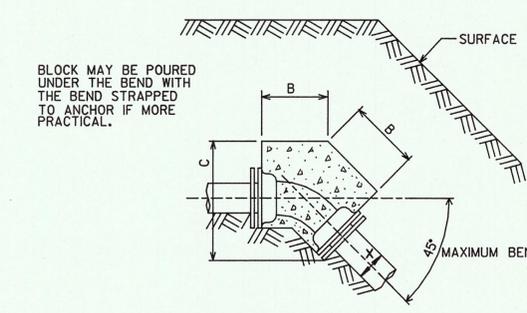


ELEVATION TYPICAL VERTICAL BEND NO SCALE

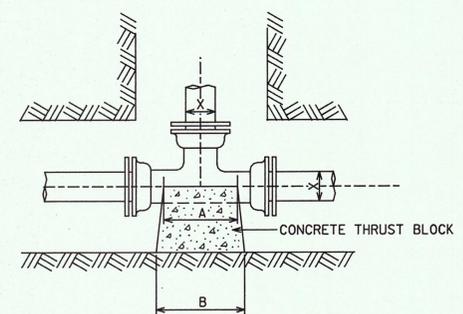


PLAN TYPICAL TEE NO SCALE

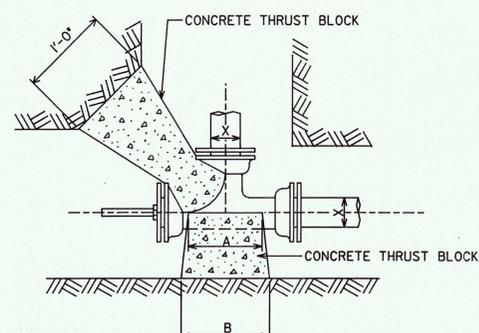


PLAN UNBALANCED TEE NO SCALE

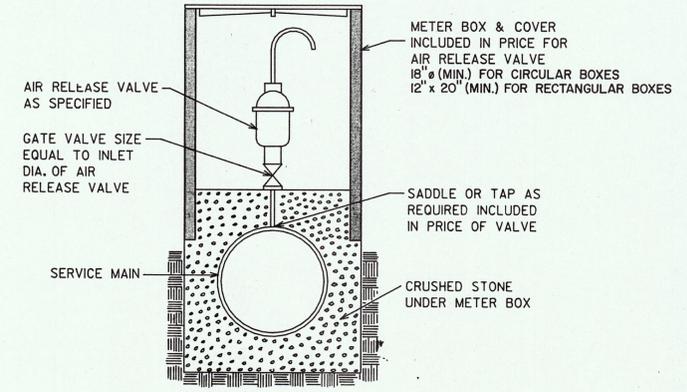


TYPICAL AIR RELEASE VALVE NO SCALE

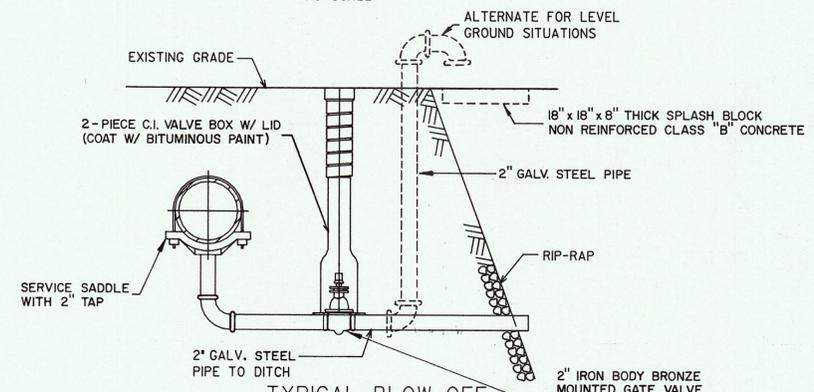


TYPICAL BLOW-OFF NO SCALE

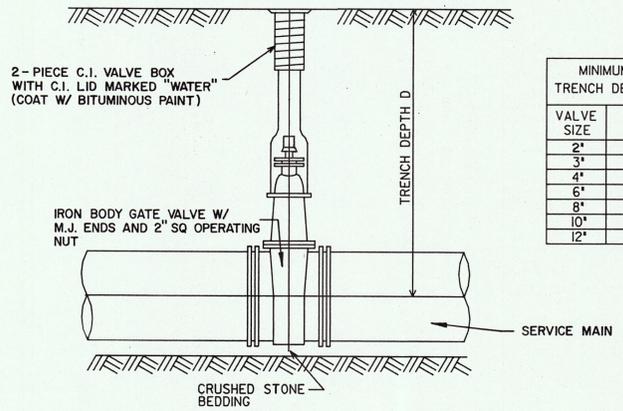


TYPICAL VALVE BOX GATE VALVE 12" & SMALLER NO SCALE

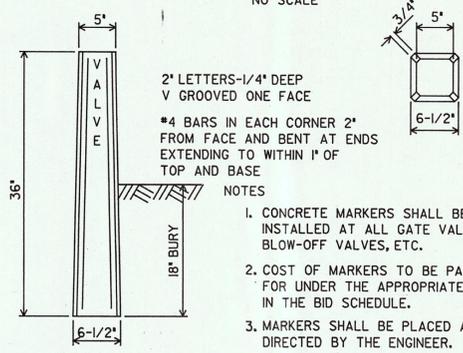

TYPICAL VALVE MARKER NO SCALE

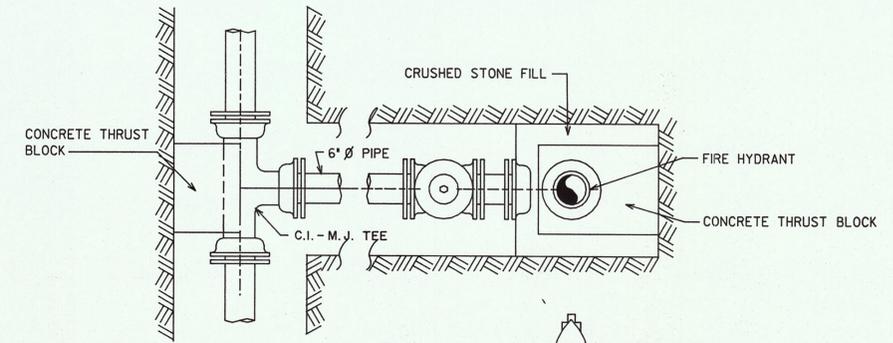

PLAN NO SCALE

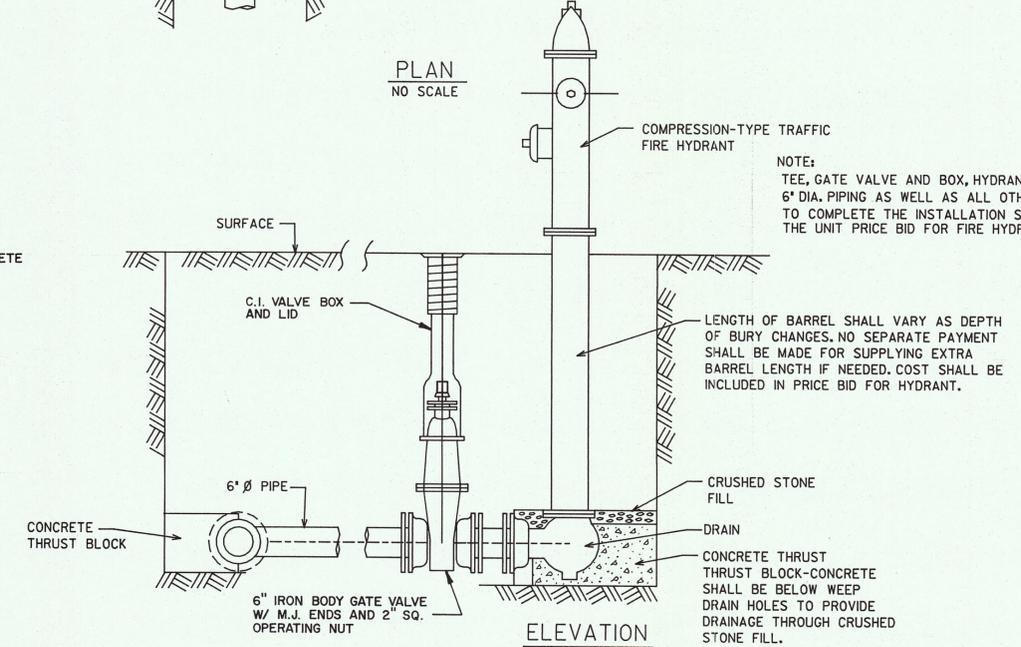


ELEVATION FIRE HYDRANT INSTALLATION NO SCALE

NOTE: TEE, GATE VALVE AND BOX, HYDRANT, THRUST BLOCKING, 6" DIA. PIPING AS WELL AS ALL OTHER WORK NECESSARY TO COMPLETE THE INSTALLATION SHALL BE INCLUDED IN THE UNIT PRICE BID FOR FIRE HYDRANTS.

LENGTH OF BARREL SHALL VARY AS DEPTH OF BURY CHANGES. NO SEPARATE PAYMENT SHALL BE MADE FOR SUPPLYING EXTRA BARREL LENGTH IF NEEDED. COST SHALL BE INCLUDED IN PRICE BID FOR HYDRANT.

VALVE SIZE	D
2"	36"
3"	37"
4"	39"
6"	41"
8"	44"
10"	52"
12"	56"

- GENERAL NOTES**
- WHERE WATER LINES CROSS IMPROVED, GRASSED, OR LAWN AREAS, ETC., ALL SOD, SHRUBS, FLOWERS, PLANTINGS, ETC., SHALL BE REPLACED IN ORIGINAL CONDITION AT CONTRACTOR'S EXPENSE. GRASSED AREAS SHALL BE RESTORED TO PRIOR CONDITIONS IN THE FOLLOWING MANNER:
AREAS LESS THAN 3:1 SLOPE SHALL BE RESEEDED AND MULCHED WITH GRASSES OR GROUND COVER AS OUTLINED IN THE SPECIFICATIONS. AREAS GREATER THAN 3:1 SLOPE SHALL BE RESEEDED AND MULCHED WITH A FABRIC MATERIAL AS OUTLINED IN THE SPECIFICATIONS. PAYMENT SHALL BE INCLUDED IN THE APPLICABLE UNIT PRICE BID FOR THE WATER LINE.
 - WHERE LINES CROSS UNDER CURBS, THEY SHALL BE TUNNELED UNDER THE CURB. NO SEPARATE PAYMENT WILL BE ALLOWED FOR REPAIRING CURBS DAMAGED OR DESTROYED DURING WATER LINE CONSTRUCTION.
 - PROMISCUOUS DESTRUCTION OF TREES ALONG WATER LINE RIGHT-OF-WAY WILL NOT BE PERMITTED. ALL REASONABLE EFFORTS WILL BE MADE BY THE CONTRACTOR TO PROTECT AND SAFEGUARD TREES.
 - ANY EXISTING FENCES, ROCK WALLS, GUARDRAILS, ETC., ALONG THE WATER LINE RIGHT-OF-WAY ARE TO BE REMOVED AND REINSTALLED IN THEIR ORIGINAL CONDITION (OR BETTER). NO SEPARATE PAYMENT WILL BE ALLOWED. PAYMENT TO BE INCLUDED IN THE APPLICABLE UNIT PRICE BID FOR THE WATER LINE.
 - ALL WATER LINES SHALL HAVE A MINIMUM COVER OF 30 INCHES, EXCEPT AS OTHERWISE NOTED.
 - THE COST FOR DIVERSION OF WATER IN DITCHES, CREEKS, OR RIVERS SHALL BE INCLUDED IN THE APPLICABLE UNIT PRICE BID FOR THE WATER LINE IN THE BID SCHEDULE. NO SEPARATE PAYMENT SHALL BE ALLOWED.
 - WHEN BLASTING FOR EXCAVATION OF WORK ADEQUATE PRECAUTIONS SHALL BE USED TO PREVENT DAMAGE TO SURROUNDING PROPERTY.

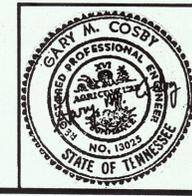

REV. NO.	RELEASED BY	DESCRIPTION OF REVISION


**WATER SYSTEM IMPROVEMENTS
PHASE II**

PIPING DETAILS

SHEET 2 OF 2

**WOLFE BRANCH UTILITY DISTRICT
OAKDALE, TENNESSEE**

DSGN	JDH	1/86	HENSLY-SCHMIDT, INC. ENGINEERS AND MANAGERS ATLANTA-CHATTANOOGA-KNOXVILLE VALDOSTA	DRAWING NO. 7972-15
DRWN	GAW	1/86		
CHKD	JDH			
APPR	GMC			

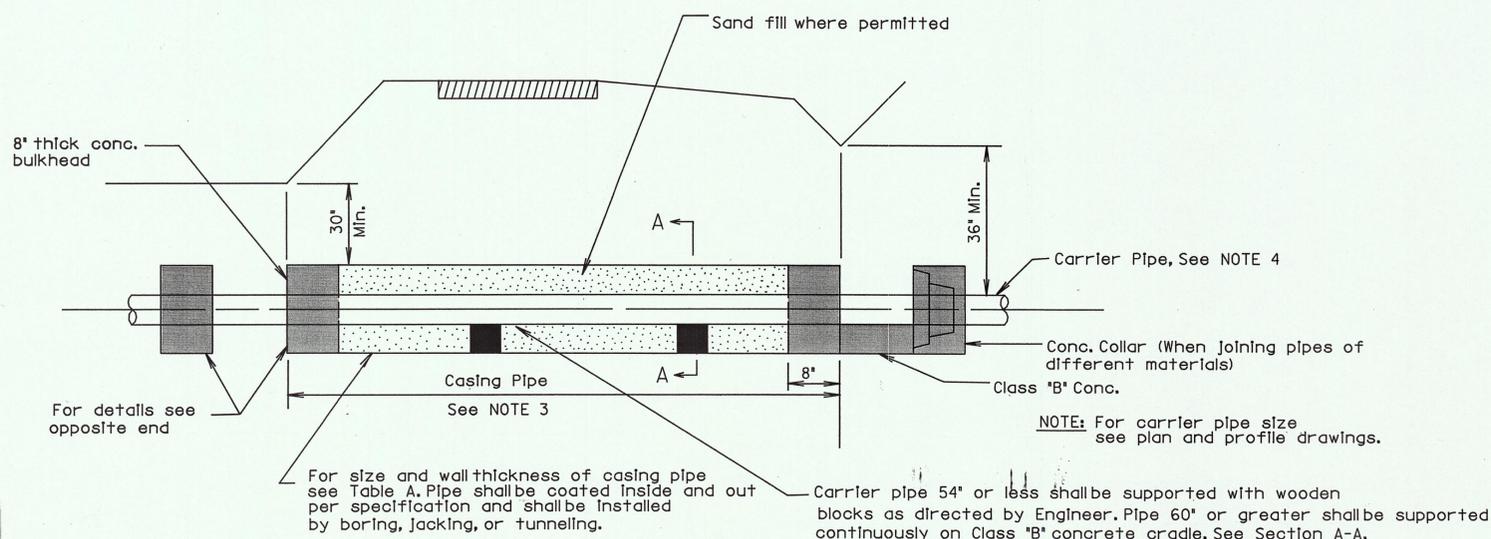

TYPICAL HIGHWAY CROSSING
For State & U.S. Highways and Designated City Streets
ALTERNATE BID ITEM

HIGHWAY CROSSING NOTES FOR PLACING UTILITY LINES WITHIN THE RIGHT-OF-WAY OR CROSSING STATE AND U. S. HIGHWAYS, AND DESIGNATED CITY STREETS


1. LINES CROSSING UNDER PAVED ROADS AND PAVED CROSSROADS WITHIN THE DESIGNATED CITY STREETS, STATE AND U. S. HIGHWAY RIGHT-OF-WAY SHALL BE ENCASED AND PLACED BY BORING, JACKING, OR TUNNELING. BORING, JACKING, OR TUNNELING SHALL EXTEND FROM TOE OF SHOULDER SLOPE TO TOE OF SHOULDER SLOPE. ON LINES CROSSING THE ENTIRE WIDTH OF RIGHT-OF-WAY, THE LENGTH OF CASING SHALL BE DETERMINED BY THE STATE HIGHWAY DIVISION ENGINEER AND/OR CITY ENGINEER. ALL WORK SHALL BE DONE AS SHOWN ON THIS DRAWING.
2. ALL LINES SHALL HAVE A MINIMUM COVER OF 30" EXCEPT WHERE DEEPER COVER IS INDICATED ON THE DRAWINGS. ALL TRENCH EXCAVATION WITHIN THE RIGHT-OF-WAY AND NOT UNDER PAVING SHALL BE BACKFILLED BY TAMPING IN 6" LAYERS. ALL SURPLUS MATERIAL SHALL BE REMOVED FROM THE RIGHT-OF-WAY, AND THE EXCAVATION FINISHED FLUSH WITH SURROUNDING GROUND.
3. CASING PIPE SHALL BE EITHER SPIRAL WELDED STEEL PIPE OR STEEL LINER PLATE, APPLICABLE AND SUITABLE TO METHOD OF INSTALLATION EMPLOYED (SEE TABLE "A"). ALL CASING PIPE SHALL BE COATED INSIDE AND OUT PER SPECIFICATIONS.
4. CARRIER PIPE FOR ALL LINES 6" TO 54" IN DIAMETER SHALL BE CAST OR DUCTILE IRON PIPE WITH "PUSH-ON" TYPE JOINTS. CARRIER PIPE 60" IN DIAMETER AND LARGER SHALL BE REINFORCED CONCRETE WITH "BELL & SPIGOT" JOINTS. FOR SIZE, SEE PLAN AND PROFILE DRAWINGS.
5. ALL INSTALLATIONS SHALL BE DONE TO LEAVE FREE FLOWS IN DRAINAGE DITCHES, PIPES, CULVERTS, OR OTHER SURFACE WATER DRAINAGE FACILITIES OF THE HIGHWAY, STREET, OR ITS CONNECTIONS.

TABLE "A"		
PIPE SIZE		
Carrier Pipe (Inches)	Casing Pipe	
	Dia. (Inches)	Steel Pipe Wall Thick
6 & 8	16	1/4"
10	20	5/16"
12	24	3/8"
14 & 16	30	1/2"
18	36	1/2"
24	36	1/2"
30	54	See TABLE "B"
36	54	
42	66	
48	72	
54	78	
60	84	
66	96	
72	108	
84	120	
96	144	


RAILROAD CROSSING NOTES FOR PLACING UTILITY PIPELINES WITHIN OR CROSSING A RAILROAD RIGHT-OF-WAY

1. CASING PIPE SHALL EXTEND THE DISTANCES SHOWN IN THE ABOVE TYPICAL CROSSING DETAILS, BUT IN NO CASE LESS THAN 25 FEET FROM CENTER LINE OF OUTSIDE TRACK TO END OF PIPE. THE CASING PIPE SHALL EXTEND BEYOND THE LIMITS OF RAILWAY RIGHT-OF-WAY, IF NECESSARY, TO OBTAIN THIS DISTANCE.
2. UNDER TRACKS AND RIGHT-OF-WAY, CARRIER PIPES 54" OR LESS IN DIAMETER SHALL BE DUCTILE IRON WITH "PUSH-ON" TYPE JOINTS; CARRIER PIPE 60" OR GREATER IN DIAMETER SHALL BE REINFORCED CONCRETE PIPE WITH "BELL & SPIGOT" JOINTS OF THE SAME TYPE REQUIRED FOR LINE INSTALLED IN TRENCH.
3. ANY REPLACEMENT OF A CARRIER PIPE SHALL BE CONSIDERED A NEW INSTALLATION.
4. ALL WORK ON RAILWAY RIGHT-OF-WAY INCLUDING NECESSARY SUPPORTING OF TRACKS, SAFETY OF OPERATIONS, AND OTHER STANDARD AND INCIDENTAL OPERATION PROCEDURES SHALL BE UNDER THE SUPERVISION OF THE APPROPRIATE AUTHORIZED REPRESENTATIVE OF THE RAILWAY SYSTEM AFFECTED, AND ANY DECISIONS OF THIS REPRESENTATIVE PERTAINING TO CONSTRUCTION SHALL GOVERN.
5. IF, IN THE OPINION OF THE RAILWAY COMPANY, IT BECOMES NECESSARY TO PROVIDE FLAGGING PROTECTION, WATCHMEN, REMOVAL OR REPLACEMENT OF TRACKS, OR THE PERFORMANCE OF ANY OTHER WORK IN ORDER TO KEEP THE TRACKS SAFE FOR TRAFFIC, THE CONTRACTOR SHALL REIMBURSE THE RAILROAD IN CASH FOR SUCH SERVICES IN ACCORDANCE WITH ACCOUNTING PROCEDURES AGREED ON BY THE CONTRACTOR AND AFFECTED RAILWAY COMPANY BEFORE CONSTRUCTION IS STARTED.
6. THE CONTRACTOR SHALL, AT HIS EXPENSE AND BEFORE ENTERING UPON RAILWAY PROPERTY, SECURE AND MAINTAIN THROUGHOUT THE CONSTRUCTION PERIOD INSURANCE OF THE KINDS AND AMOUNTS REQUIRED BY THE AFFECTED RAILWAY COMPANY.
7. WHERE SODDING IS DISTURBED BY EXCAVATION OR BACKFILLING OPERATIONS, SUCH AREAS SHALL BE REPLACED BY SEEDING AND MULCHING ON ALL SIDE SLOPES OF 5% OR LESS. ALL DRAINAGE DITCHES AND SWALES AND ALL SLOPES OVER 5% SHALL BE REGRASSED WITH BLOCK SODDING. NO SEPARATE PAYMENT SHALL BE MADE FOR SEEDING AND MULCHING OR SODDING. SAID COST SHALL BE INCLUDED IN THE BID PRICES FOR INSTALLATION OF PIPE.
8. THE INSTALLATION OF SAID FACILITY SHALL BE DONE UNDER THE SUPERVISION AND CONTROL OF THE STATE HIGHWAY DIVISION ENGINEER AND/OR CITY ENGINEER, AND THE METHOD OF CROSSING SHALL BE DIRECTED BY THE STATE HIGHWAY DIVISION ENGINEER AND/OR CITY ENGINEER.
9. THE CONTRACTOR SHALL MAKE NECESSARY ARRANGEMENTS FOR HIGHWAY TRAFFIC OVER SAID POINT DURING SUCH WORK AND SHALL PLACE NECESSARY BARRICADES, WARNING SIGNS, SIGNALS, LIGHTS, AND, IF NECESSARY, WATCHMEN FOR THE TRAVELING PUBLIC.

TABLE "B"									
Gages of Liner Plate for Continuous Load-Carrying Structures									
Nominal Dia. (Inches)	Height of Cover (Feet)								
	2-5	6-10	11-15	16-20	21-25	26-30	31-35	36-40	40-45
48	12	12	12	12	12	12	12	12	10
54	12	12	12	12	12	12	12	10	8
60	12	12	12	12	12	12	10	8	7
66	12	12	12	12	12	10	8	8	5
72	12	12	12	12	10	8	7	5	5
78	12	12	12	10	8	7	5	5	5
84	12	12	10	10	8	5	5	5	5
96	12	10	10	10	8	5	5	5	5
108	10	10	10	8	7	5	5	5	5
120	10	10	8	8	7	5	5	5	3
144	8	8	8	8	5	5	3	1	1

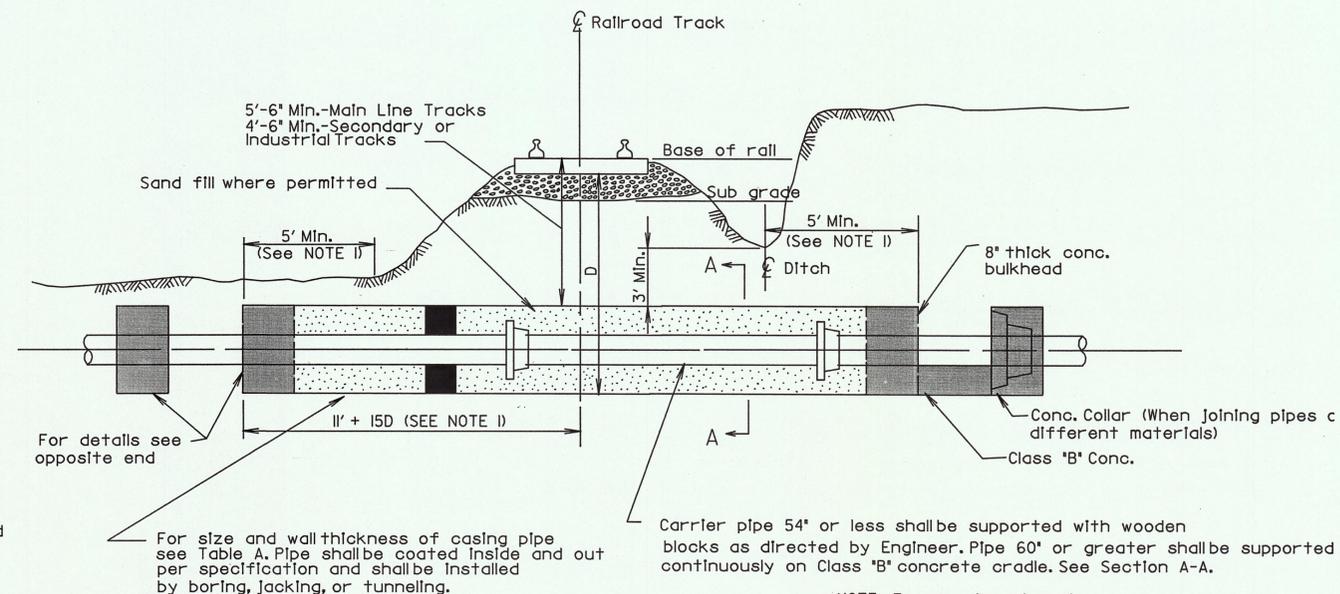


TYPICAL RAILROAD CROSSING

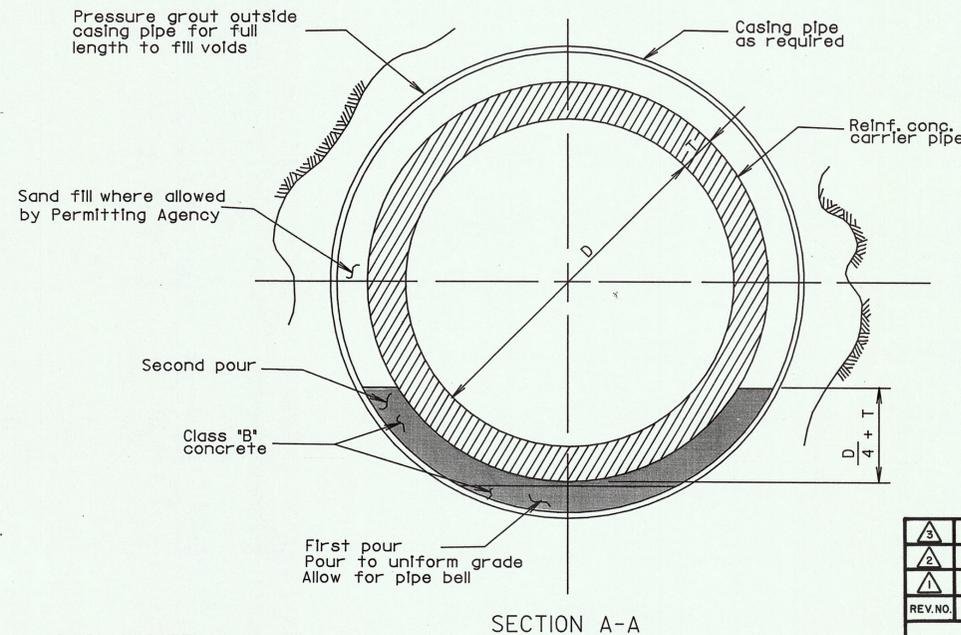


CASING PIPE
Size & Thickness of pipe for Railroad & Highway Crossing.
(Min. thickness for liner plate casing) in railroad crossing 10 gage.

3		
2		
1		
REV. NO.	RELEASED BY	DESCRIPTION OF REVISION
WATER SYSTEM IMPROVEMENTS—PHASE II		
HIGHWAY AND RAILROAD CROSSING DETAILS		
WOLFE BRANCH UTILITY DISTRICT OAKDALE, TENNESSEE		
DSGN	JDH	1/66
DRWN	GAW	1/66
CHKD	JDH	
APPR	GMC	
HENSLEY-SCHMIDT, INC. ENGINEERS AND MANAGERS ATLANTA-CHATTANOOGA-KNOXVILLE VALDOSTA		DRAWING NO. 7972-16




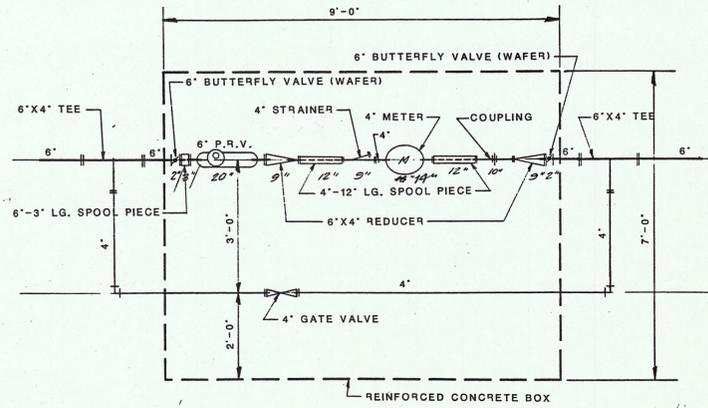


**MASTER METER
PRESSURE REGULATING BOX DETAIL
NO SCALE**

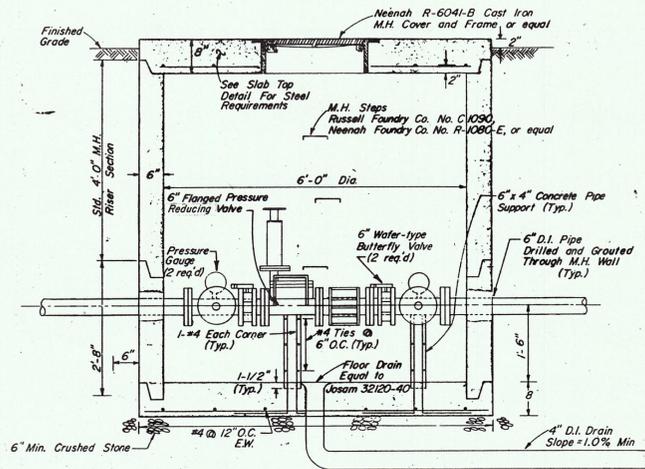

**PRESSURE REDUCING VALVE-SECTION A-A (CONTRACT 1)
N.T.S.**

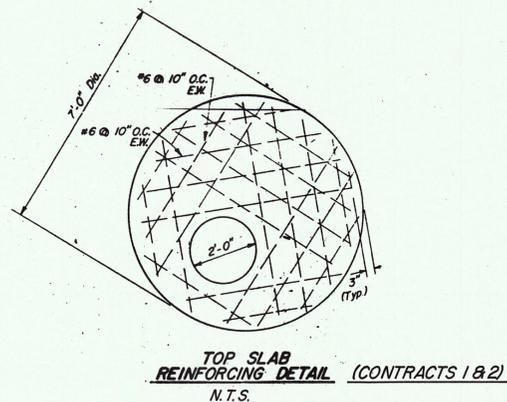


**TOP SLAB
REINFORCING DETAIL (CONTRACTS 1 & 2)
N.T.S.**

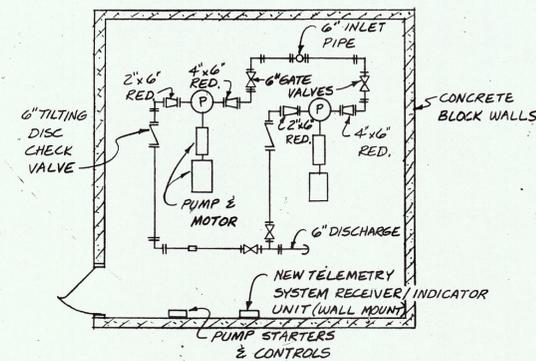


**PLAN-EXISTING GORMLEY PUMP STATION
MODIFICATIONS (CONTRACT 2)**

N.T.S.
NOTE: ALL EQUIPMENT SHOWN IS EXISTING
UNLESS OTHERWISE NOTED

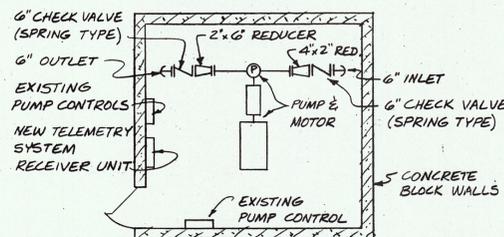



**PLAN-EXISTING BOSWELL CHAPEL PUMP STATION
MODIFICATIONS (CONTRACT 2)**

N.T.S.
NOTE: ALL EQUIPMENT SHOWN IS EXISTING
UNLESS NOTED OTHERWISE

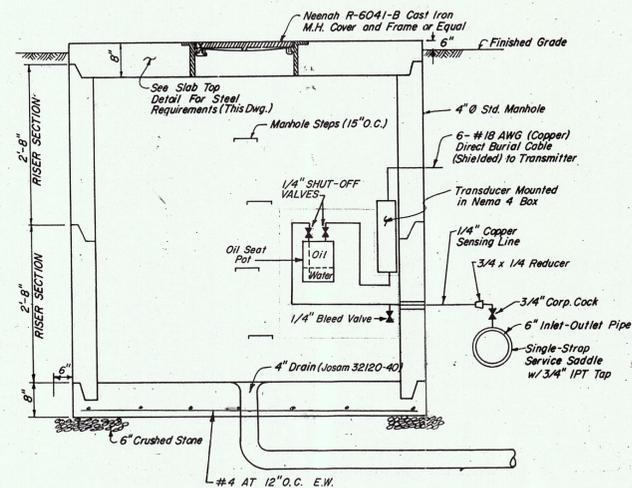


**TELEMETRY SYSTEM
TRANSDUCER PIT DETAIL (CONTRACT 2)
N.T.S.**


TELEMETRY SYSTEM ELECTRICAL DETAILS (CONTRACT 2)

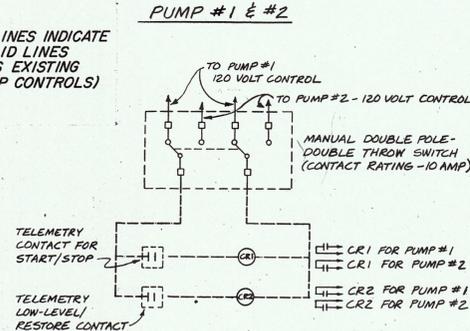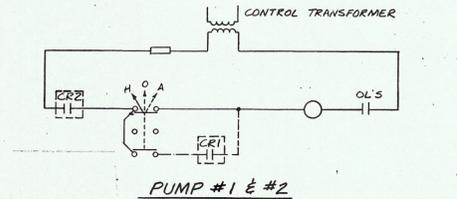


**CONTROL SCHEME FOR
GORMLEY PUMP STATION
(TWO BOOSTER PUMPS) OPERATION**

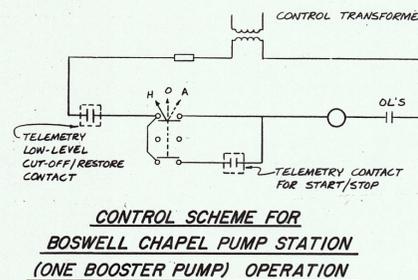

**CONTROL SCHEME FOR
BOSWELL CHAPEL PUMP STATION
(ONE BOOSTER PUMP) OPERATION**

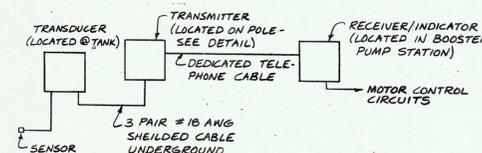

**TELEMETRY SYSTEM (CONTRACT 2)
(TYPICAL FOR BOTH
BOOSTER PUMP STATIONS)**

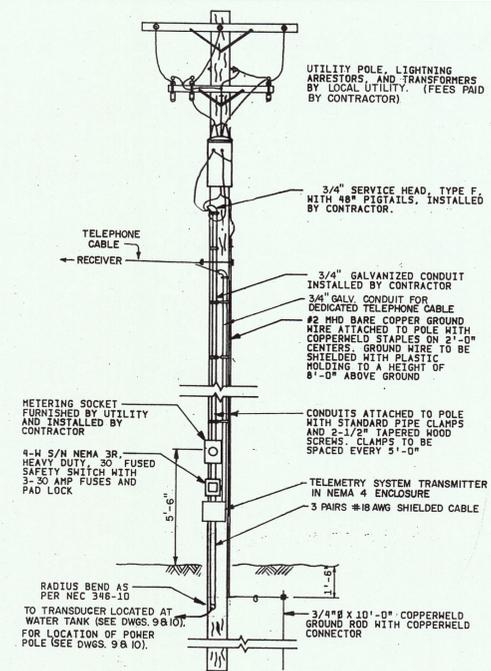

**POWER POLE DETAIL (CONTRACT 2)
NO SCALE**

TELEMETRY SYSTEM NOTES (CONTRACT 2)

- Existing pump controls shall be modified and wired for telemetry.
- Manual switch shall be labeled to indicate Pump No. 1 or Pump No. 2 operation via telemetry.
- Between the transmitter and receiver, a dedicated DC metallic phone line pair or No. 3002 voice-grade phone line pair shall be supplied and installed on existing poles for each Booster Pump Station.
- 120-volt AC single phase, two wire, 60 cycle shall be installed for the transmitter and receiver at each end (Pole/Pump Station).
- A lightning arrester shall be installed to each line of the incoming side of the 120-volt AC power input terminals at the transmitter and receiver.
- A heater element (± 100 watt) shall be installed in the enclosure with thermo switch.
- Transmitter enclosure (NEMA 4) shall have a padlock.
- Receiver/indicator shall be installed in the Booster Pump Building and No. 14 AWG conductors in 3/4-inch IMC conduit to motor control circuit. (See control scheme for each Booster Pump Station.)
- The transducer (telemetry signal) shall be installed in the concrete manhole at each tank.


REV. NO.	RELEASED BY	DATE	DESCRIPTION OF REVISION
3	JDH	3/87	RECORD DRAWING
2	JDH	5/86	ADDED ENTIRE DRAWING

**WATER SYSTEM IMPROVEMENTS
PHASE II**

**MISCELLANEOUS MODIFICATIONS
TO EXISTING FACILITIES**

**WOLFE BRANCH UTILITY DISTRICT
OAKDALE, TENNESSEE**

DSGN	DRWN	CHKD	APPR	DATE	COMPANY	DRAWING NO.
	JRC			5/86	HENSLEY-SCHMIDT, INC. ENGINEERS AND SURVEYORS ATLANTA-CHATTANOOGA-KNOXVILLE VALDOSTA	7972-17.2




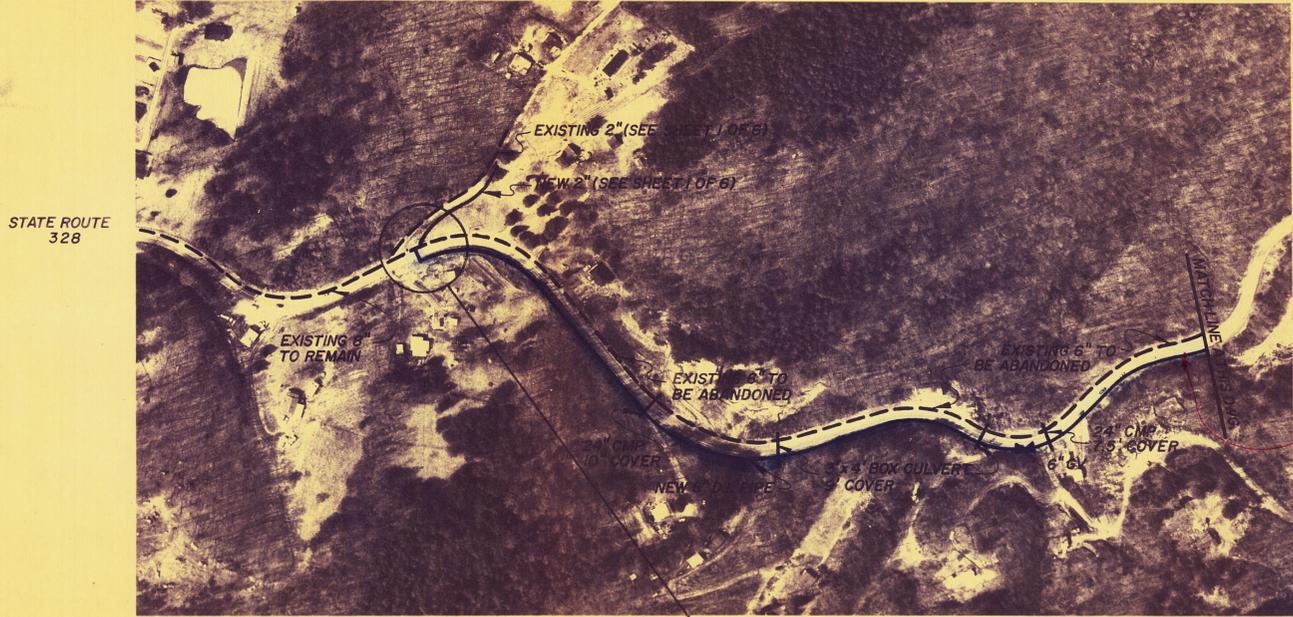


STATE ROUTE 328 TO OAKDALE




TN HWY 328

LINE TO BE LAID IN DITCH OR BEHIND DITCH WHERE POSSIBLE

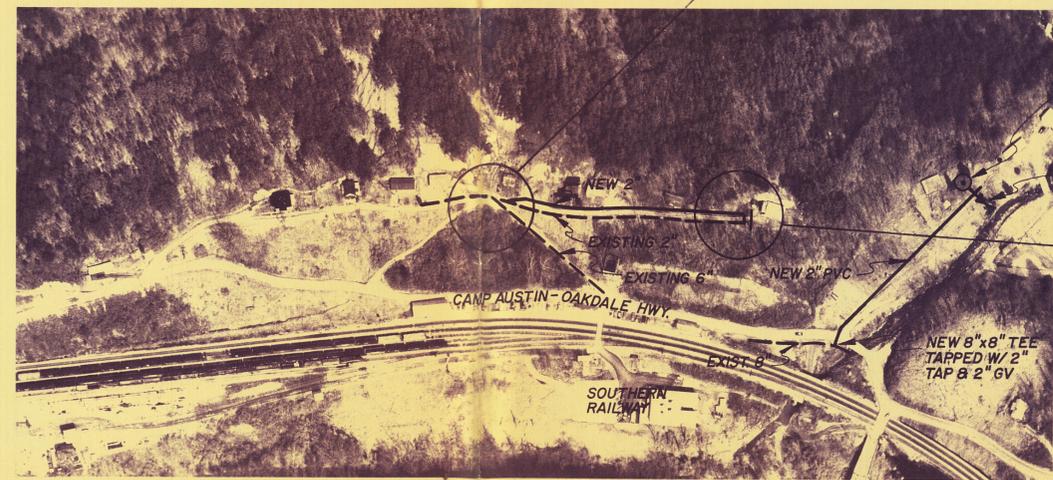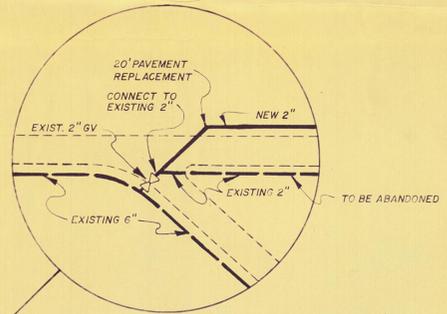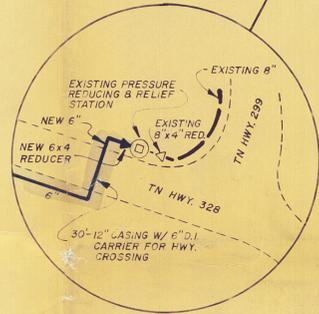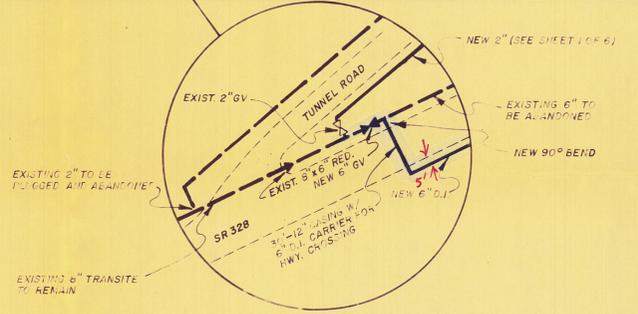

EMORY RIVER FROM OAKDALE

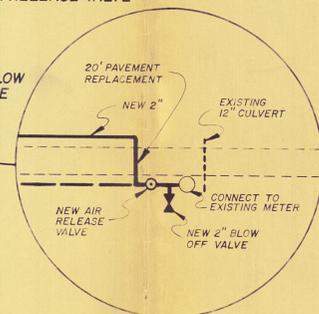

LEGEND



- NEW WATER LINES
- EXISTING WATER LINES
- GATE VALVE
- AIR RELEASE VALVE
- PRESSURE REDUCING VALVE
- REDUCER

CHECKED & APPROVED
Halsley
 ENGINEER - 4
 Date APR 21 1986





Dr.	1/86	GAW	ca.	JDH
HENSLY - SCHMIDT, INC. CONSULTING ENGINEERS ATLANTA, CHATTANOOGA, KNOXVILLE				
PLAN SCALE	7972-4			
1" = 100'				

SCALE: 1" = 200'

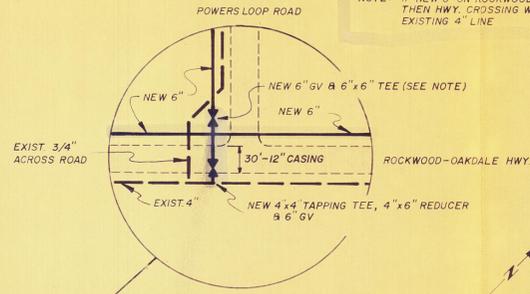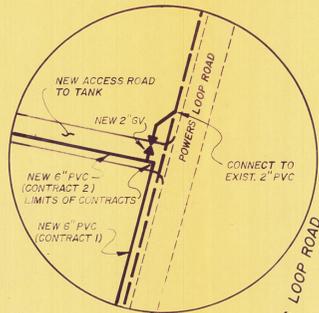


NOTE: IF NEW 6" ON ROCKWOOD-OAKDALE HWY IS NOT CONSTRUCTED THEN HWY. CROSSING WILL BE NECESSARY FOR TIE-IN TO EXISTING 4" LINE

NOTE: LINE TO BE LAID BEHIND DITCH WHERE POSSIBLE

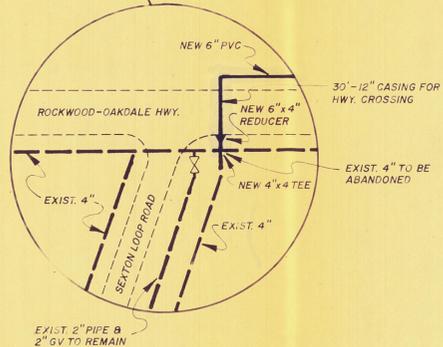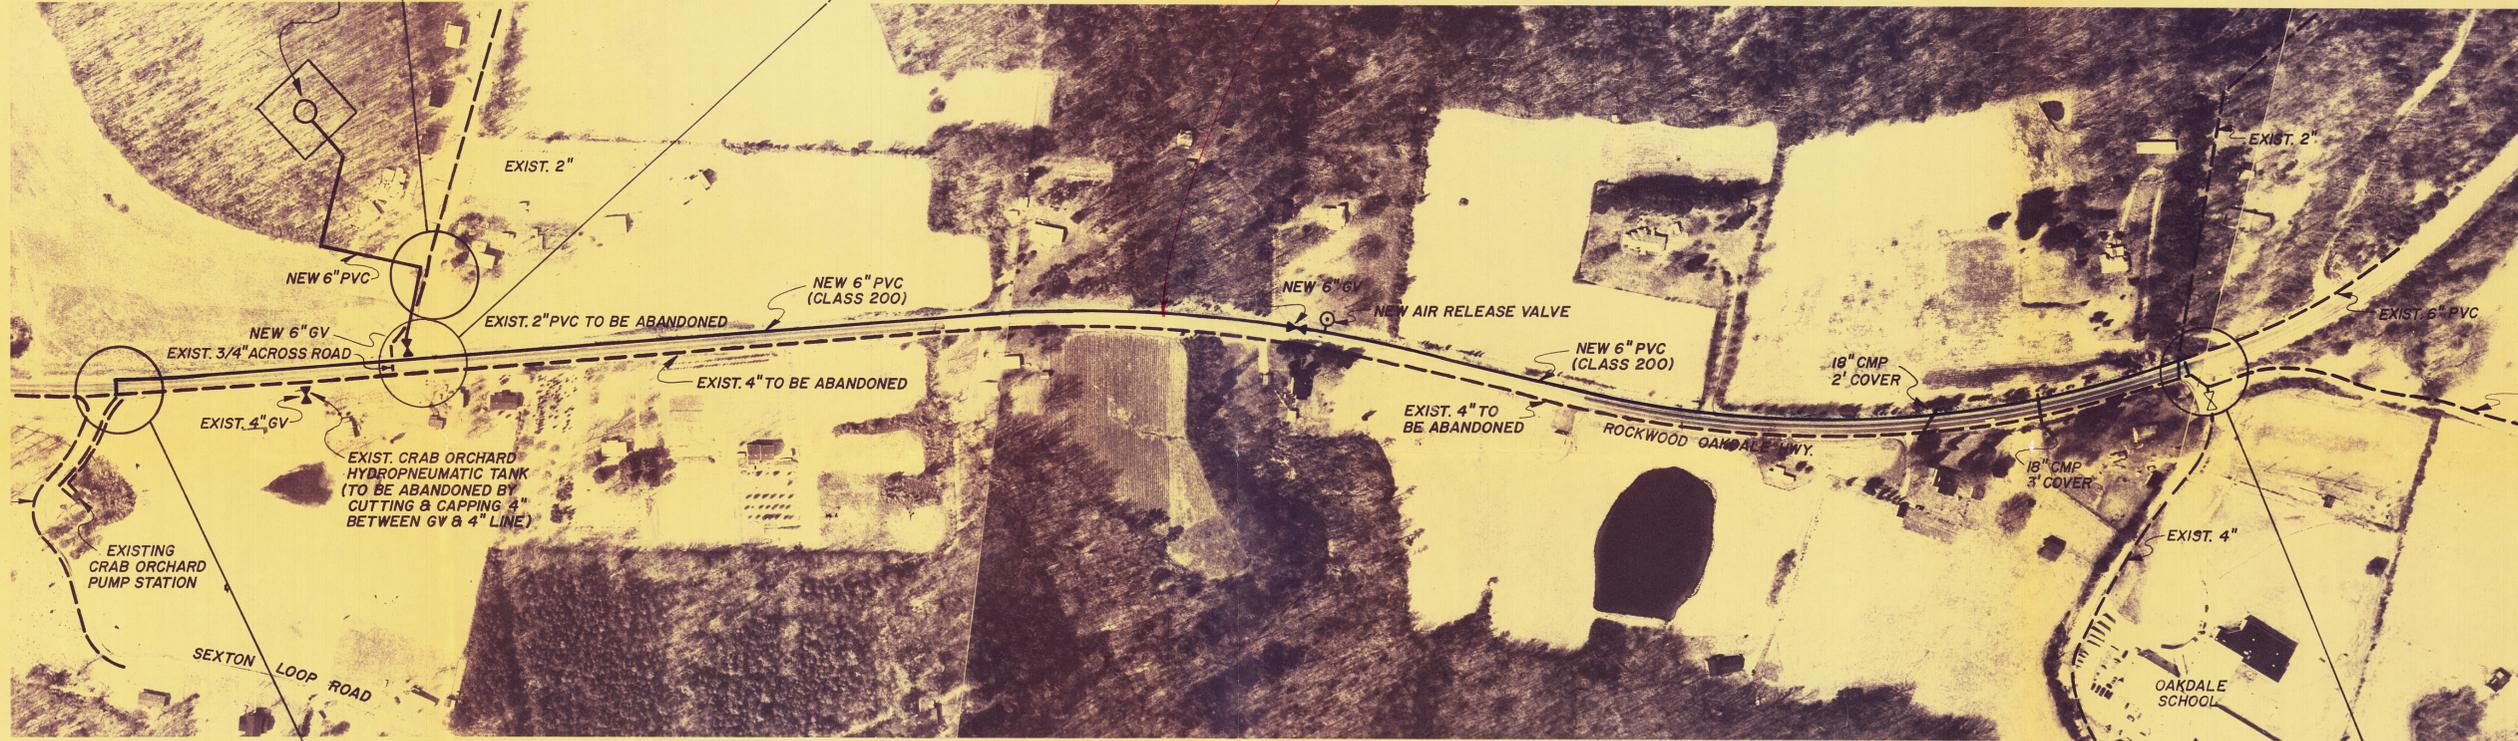

DEDUCTIVE ALTERNATE NO. 2
 (ALL WORK THIS DWG. EXCEPT 6" LINE ON POWERS LOOP ROAD TO NEW TANK)

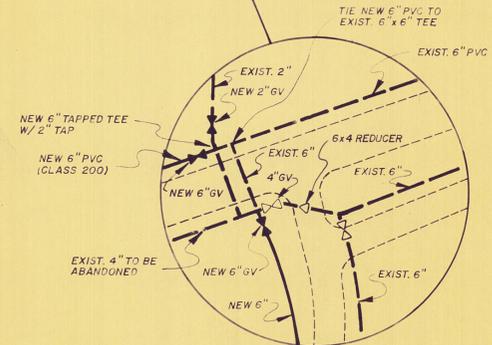

BRUNING 441 132 32756 4

SCALE: 1" = 200'



Dr.	1/86	GAW	ck.	JDH
HENSLEY - SCHMIDT, INC. CONSULTING ENGINEERS ATLANTA, CHATTANOOGA, KNOXVILLE				
PLAN SCALE 1" = 100'				7972-7