


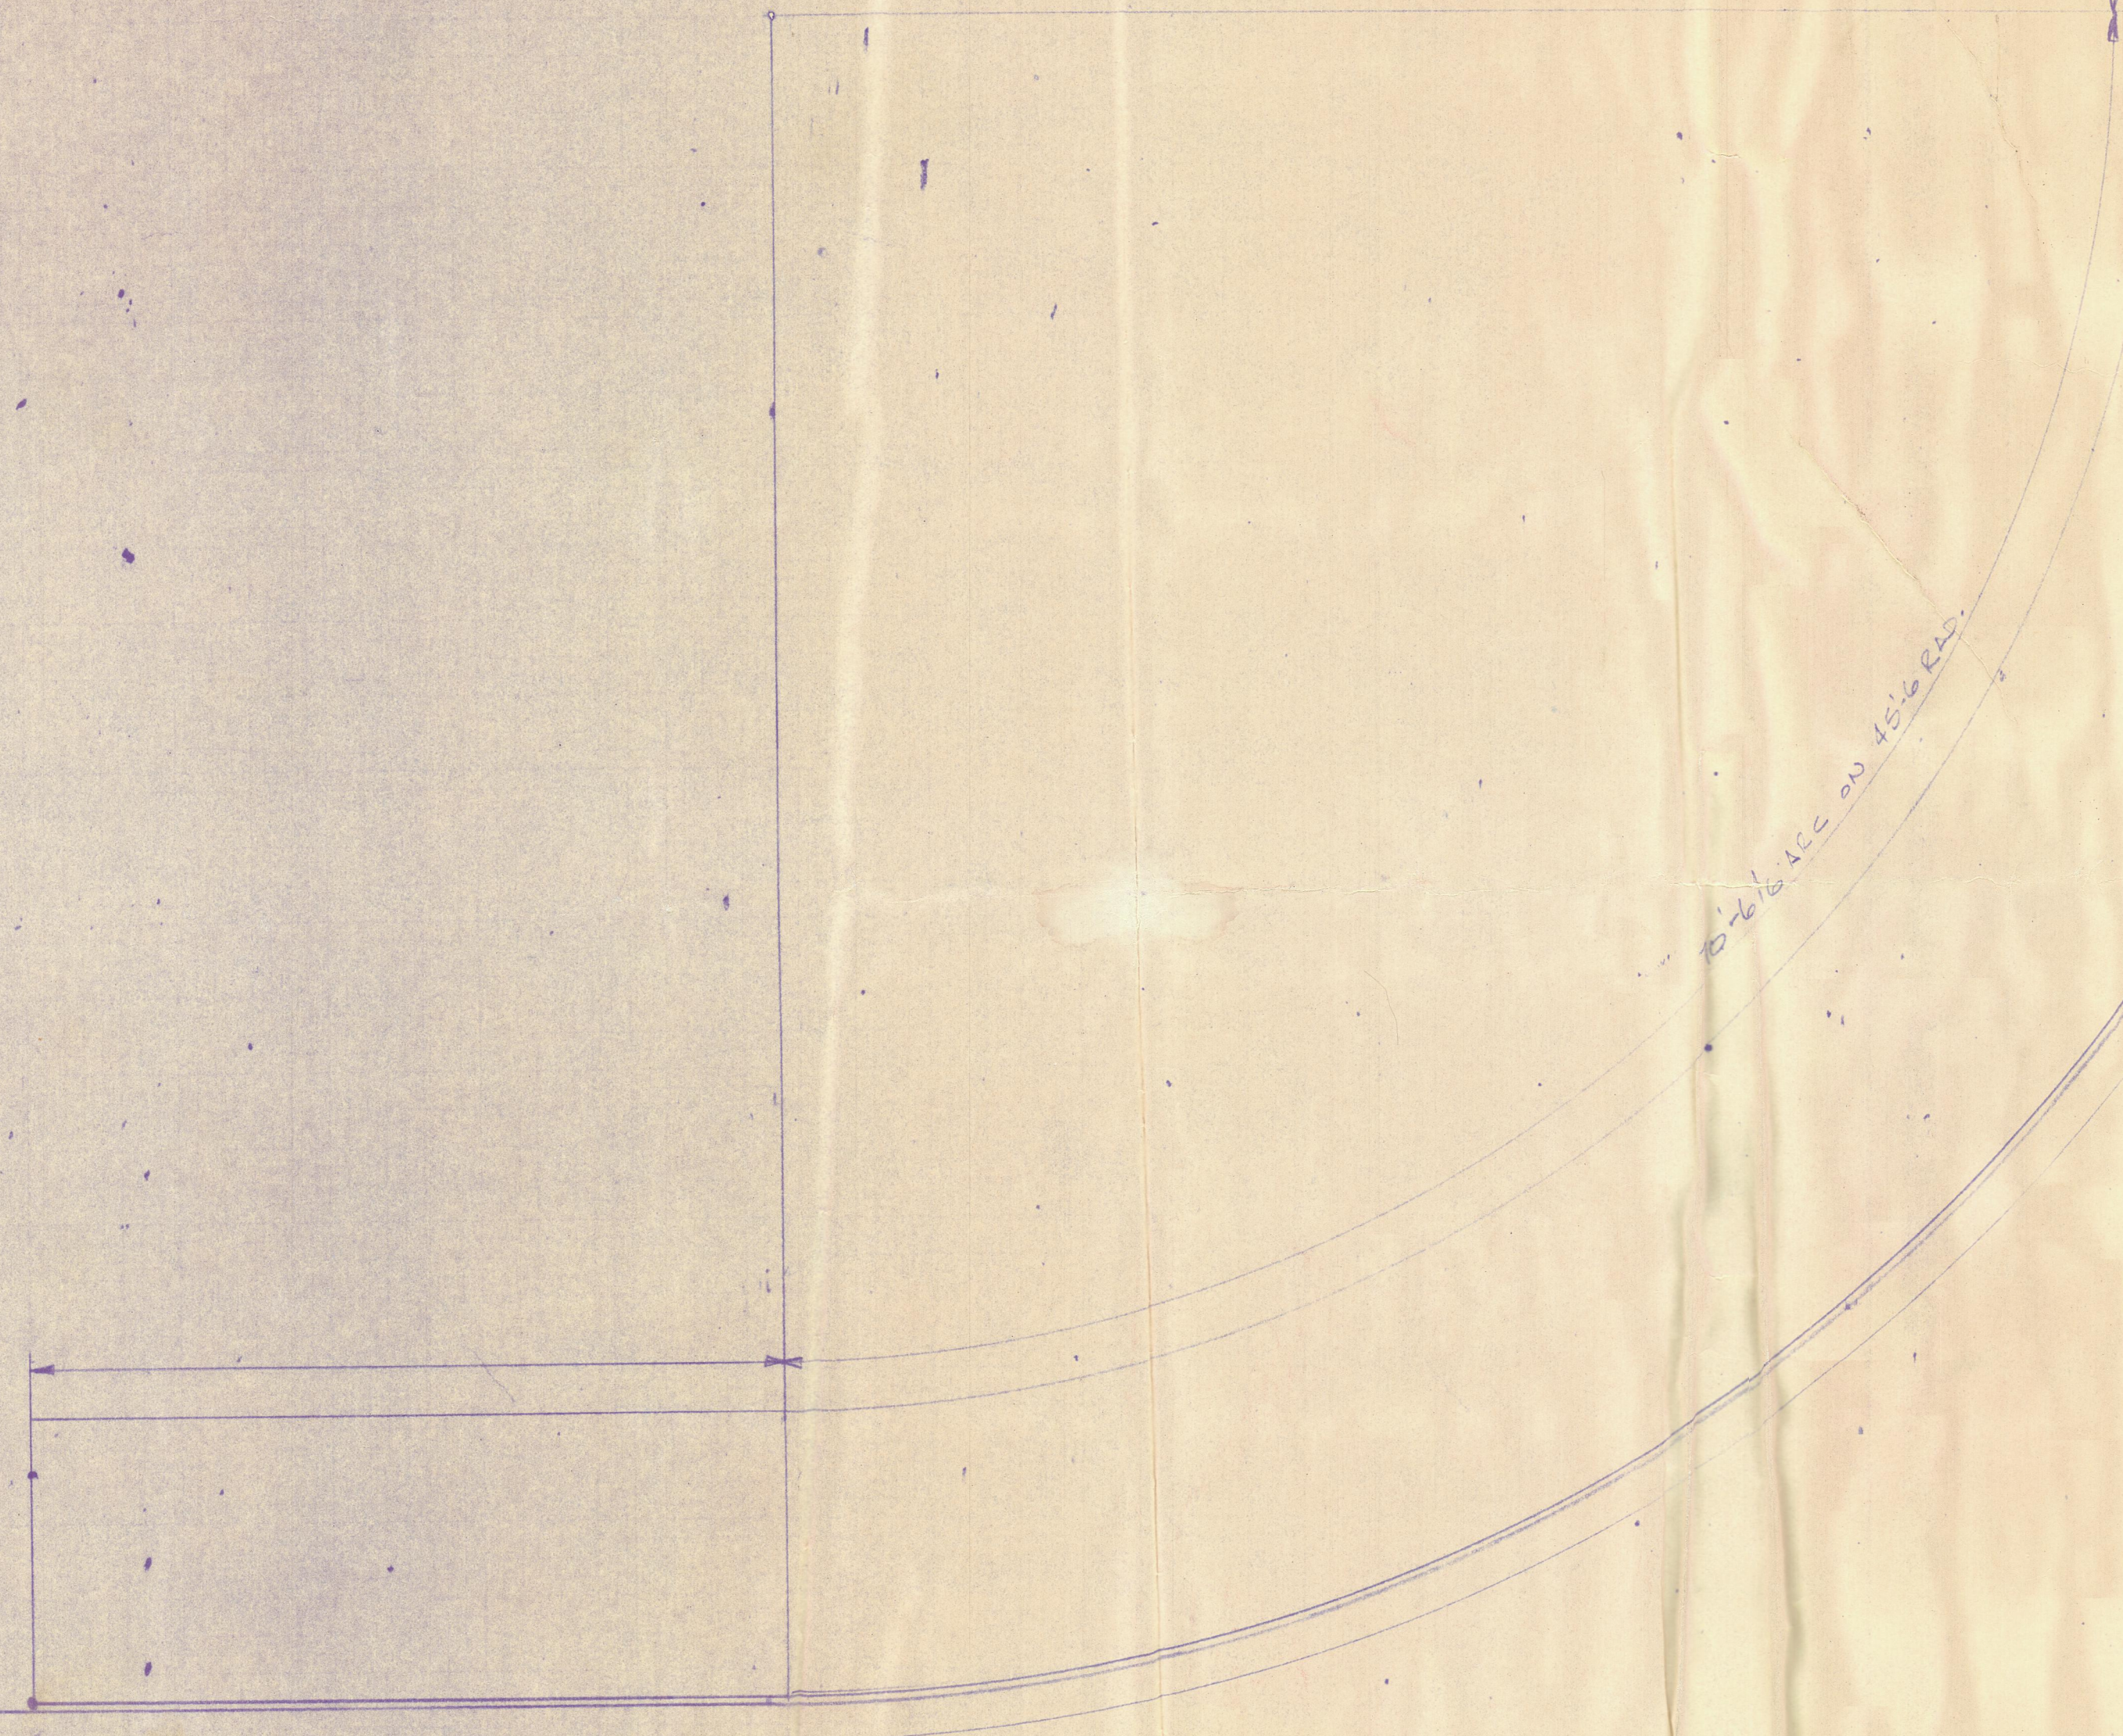


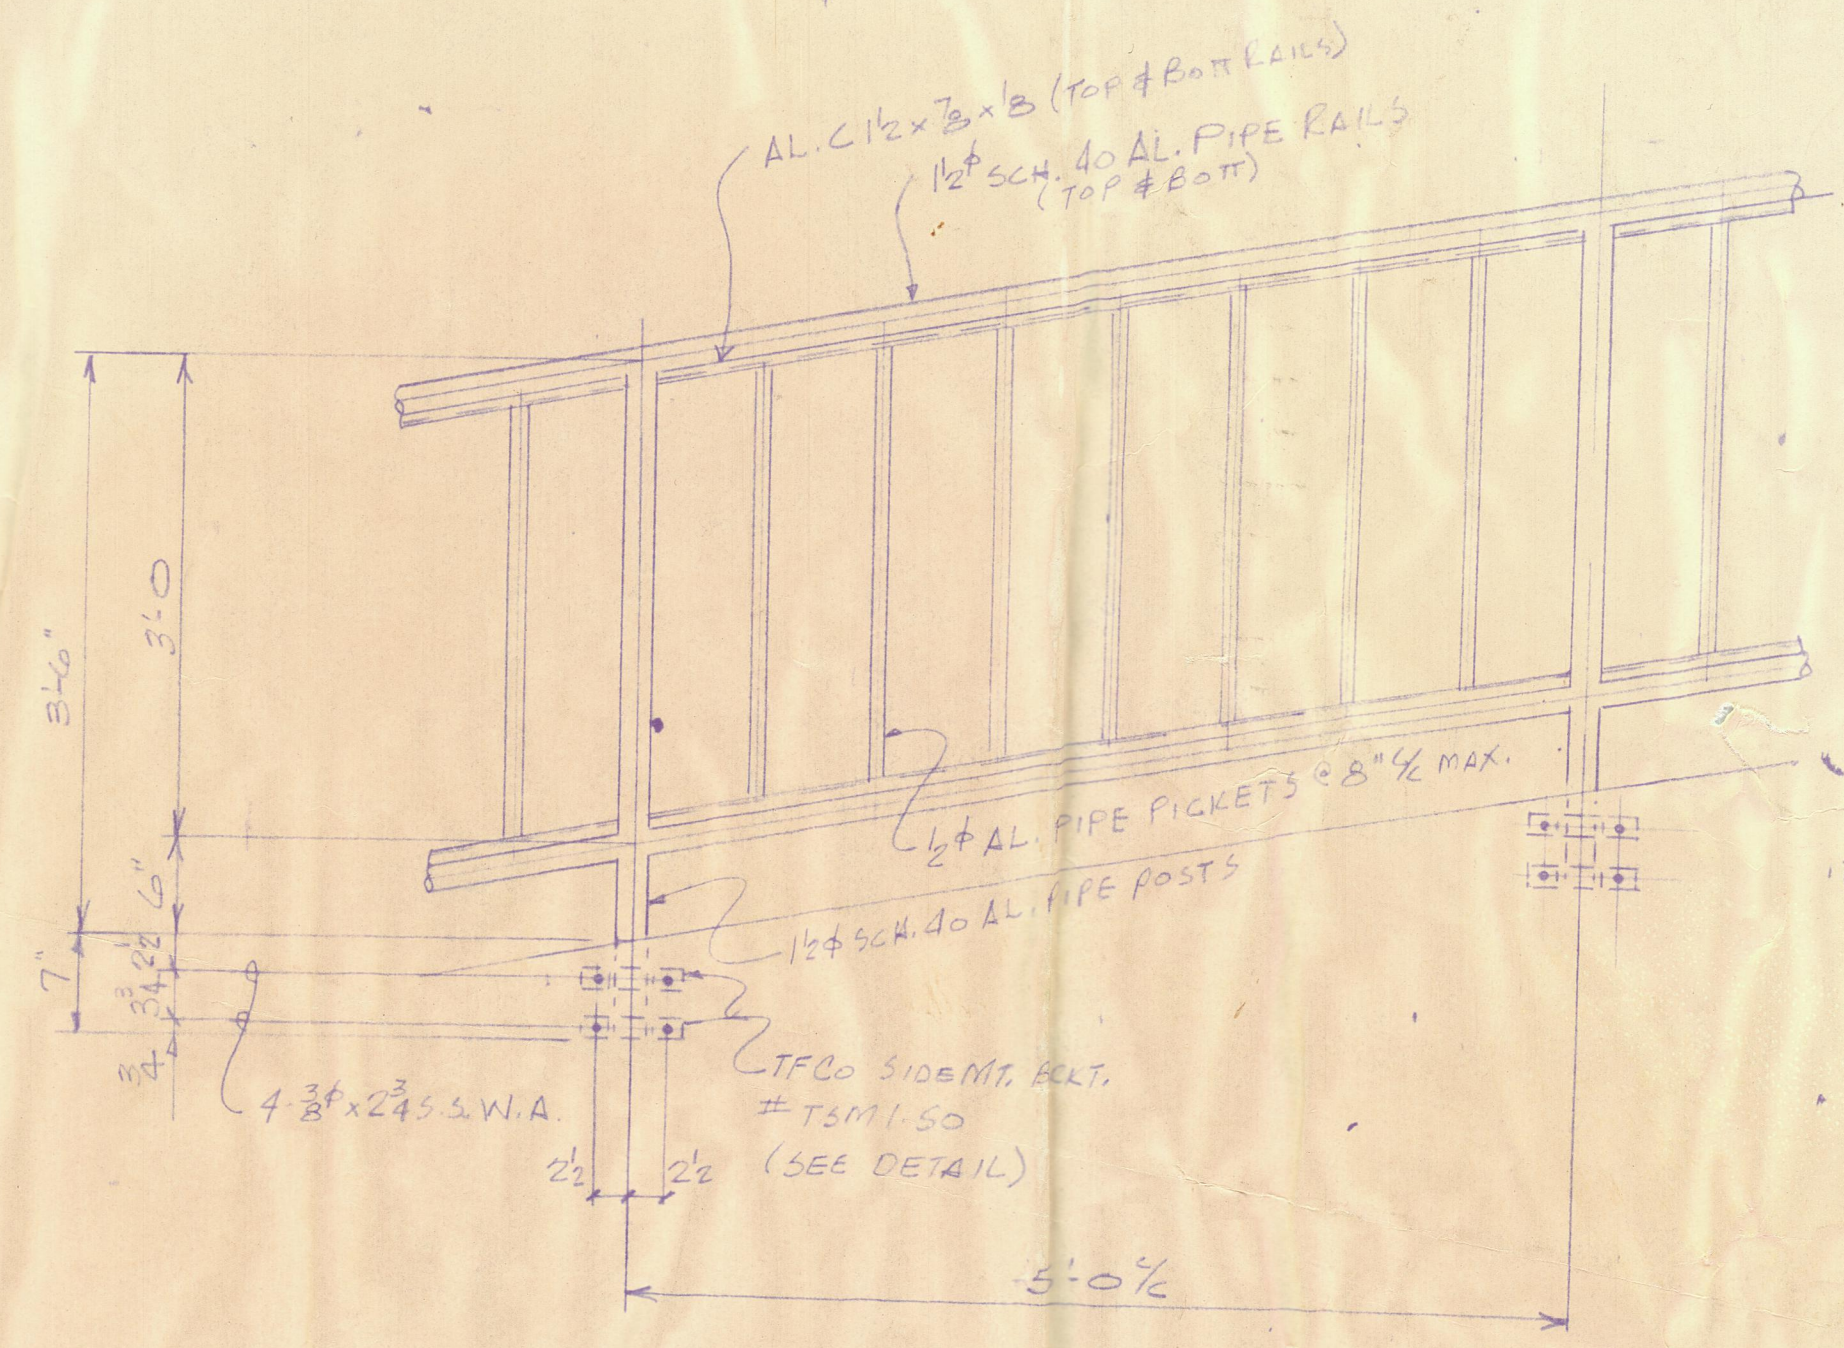

PLAN OF ALUM. PICKET RAIL AT RETAINING WALL

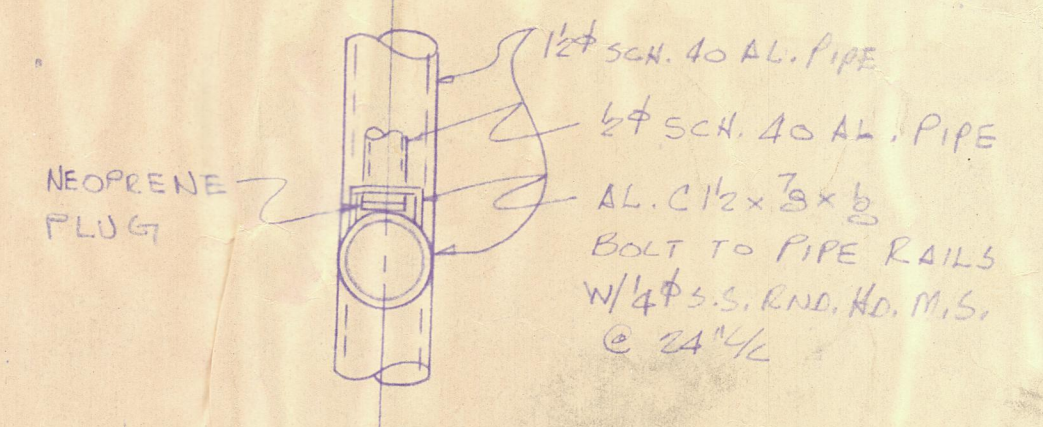


TYPICAL RAIL DETAIL

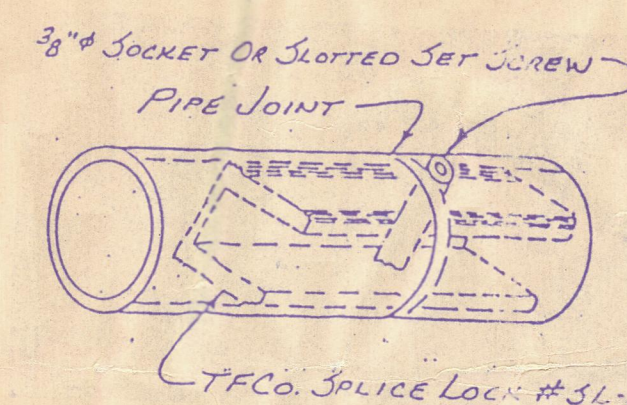

TYPICAL PICKET DETAIL

CONTR. NOTE
PLEASE PROVIDE:
1. ELEVATIONS
2. HORIZONTAL DIMS.
3. VERIFY RADII

HOLD HANDRAIL FOR FIELD
DIMENSIONS.

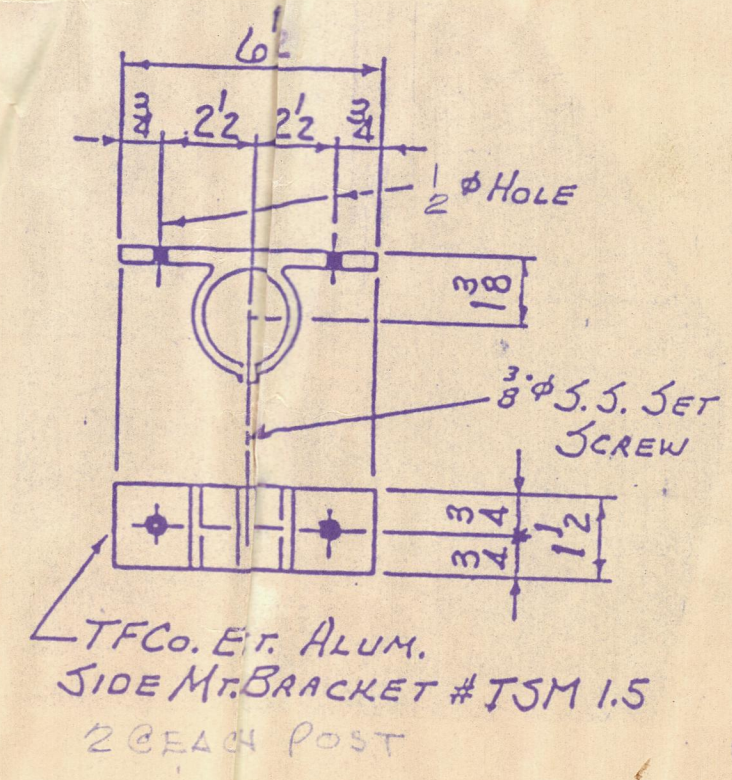

☒ NO EXCEPTION TAKEN ☒ MAKE CORRECTIONS NOTED
☐ REJECTED ☐ REVISE AND RESUBMIT

Checking is only for general conformance with the design concept of the project and internal compliance with the information given in the contract documents. Any system shown is subject to the requirements of the plans and specifications. Contractor is responsible for dimensions which shall be confirmed and corrected at the job site by selecting installation process and equipment of construction, coordination of his work with that of all other trades and the satisfactory performance of his work.

Date by A.M. 3-2-94
Elrod & Dunson, Inc.

FOR APPROVAL

HANDRAIL TO BE 1 1/2" DIA. SCH. 40 ALUMINUM PIPE (ALLOY 6105-T5) WITH INTERNAL FITTINGS.

AL. C 1 1/2 ALLOY 6063-T6
5" AL. PIPE ALLOY 6063-T6
BOLTS - TYPE 316 S.S.

Judy Construction Co.
BY 3-2-94 DATE: 3-2-94
☒ Reviewed
☒ Reviewed As Noted

BID ITEM 1

a DATE: 11-94 BY: D.H. CHKD:		b DATE: BY: CHKD:		FINISH MEDIUM BRONZE ANODIZE		FIELD BOLTS ON 01- A-BOLTS ON 21-		TF THOMPSON FABRICATING COMPANY "ENGINEERING FROM THE OUTSIDE IN"		S.O. 93512 SHEET No. _____ OF _____	
c DATE: BY: CHKD:		d DATE: BY: CHKD:		PAINT AL. IN CONTACT WITH CONC. 1/2" ELECTROLYTIC		REF. DWGS. 219		STRUCTURE WATER T&T, FAC. LOCATION HARBORMAN, TO.		DWG. No. _____	
						DRAWN BY D. HOWELL CHECKED BY _____		CUSTOMER JUDY CONST. ENGINEER ELROD-DUNSON, INC. DETAIL OF AL. PICKET RAIL		E55-2	