

EXHAUST FAN SCHEDULE									
MARK	LOCATION	TYPE FAN	CFM	S.P. IN W.C.	RPM	DRIVE	HP	VOLTS/ PHASE	REMARKS
EF-1	HARDEES P.S.	FRP B.C. CENTRIFUGAL UTILITY FAN	1626	0.5	2506	BELT	.75	115/1	HARTZELL, OR EQUAL, SERIES 410 FRP UTILITY FAN, SIZE 12".
EF-2	WEBB P.S.	FRP B.C. CENTRIFUGAL UTILITY FAN	1,470	0.5	2303	BELT	.50	115/1	HARTZELL, OR EQUAL, SERIES 410 FRP UTILITY FAN, SIZE 12".
EF-3	WOODY P.S.	FRP B.C. CENTRIFUGAL UTILITY FAN	4,910	1.0	983	BELT	1.5	115/1	HARTZELL, OR EQUAL, SERIES 410 FRP UTILITY FAN, SIZE 24".

LOUVER SCHEDULE							
MARK	LOCATION	SIZE-INCHES WxHxD	FREE AREA SQ. FT.	CFM	VELOCITY FPM	HEAD LOSS IN W.G.	REMARKS
L-1	HARDEES P.S.	24x24x6	1.89	933	494	0.037	RUSKIN, OR EQUAL, MODEL ELF6375DXH DRAINABLE STATIONARY LOUVER W/KYNAR COATING, MOUNT 6"-8" A.F.F.
L-2	HARDEES P.S.	24x24x6	1.89	933	494	0.029	RUSKIN, OR EQUAL, MODEL ELF6375DXH DRAINABLE STATIONARY LOUVER W/KYNAR COATING, MOUNT 6"-8" A.F.F.
L-3	HARDEES P.S.	24x27x6*	1.38	1626	1178	0.17	RUSKIN, OR EQUAL, MODEL ELC6375DAF, DRAINABLE COMBINATION LOUVER W/MOTOR OPERATOR & KYNAR COATING. INTERLOCK W/EF-1. MOUNT IN EXISTING OPENING.
L-4	WEBB P.S.	24x24x6	1.89	712	377	0.021	RUSKIN, OR EQUAL, MODEL ELF6375DXH DRAINABLE STATIONARY LOUVER W/KYNAR COATING, MOUNT 6"-8" A.F.F.
L-5	WEBB P.S.	24x24x6	1.89	712	377	0.016	RUSKIN, OR EQUAL, MODEL ELF6375DXH DRAINABLE STATIONARY LOUVER W/KYNAR COATING, MOUNT 6"-8" A.F.F.
L-6	WEBB P.S.	24x27x6*	1.38	1470	1065	0.14	RUSKIN, OR EQUAL, MODEL ELC6375DAF, DRAINABLE COMBINATION LOUVER W/MOTOR OPERATOR & KYNAR COATING. INTERLOCK W/EF-2. MOUNT IN EXISTING OPENING.
L-7	WOODY P.S.	24x24x6	1.89	744	394	0.023	RUSKIN, OR EQUAL, MODEL ELF6375DXH DRAINABLE STATIONARY LOUVER W/KYNAR COATING, MOUNT 6"-8" A.F.F.
L-8	WOODY P.S.	24x24x6	1.89	744	394	0.018	RUSKIN, OR EQUAL, MODEL ELC6375DAF, DRAINABLE COMBINATION LOUVER W/MOTOR OPERATOR & KYNAR COATING. INTERLOCK W/EF-3. MOUNT IN EXISTING OPENING.
L-9	WOODY P.S.	36x34x6*	3.68	3570	970	0.12	RUSKIN, OR EQUAL, MODEL ELC6375DAF, DRAINABLE COMBINATION LOUVER W/MOTOR OPERATOR & KYNAR COATING. INTERLOCK W/EF-3. MOUNT IN EXISTING OPENING.
L-10	WOODY P.S.	24x27x6*	1.38	1340	970	0.12	RUSKIN, OR EQUAL, MODEL ELC6375DAF, DRAINABLE COMBINATION LOUVER W/MOTOR OPERATOR & KYNAR COATING. INTERLOCK W/EF-3. MOUNT IN EXISTING OPENING.

* APPROXIMATE DIMENSIONS. CONTRACTOR TO FIELD MEASURE EXACT WIDTH AND HEIGHT.










ELECTRIC HEATER SCHEDULE									
MARK	LOCATION	UNIT TYPE	MIN. BTUH.	CFM	KW	THROW FT.	*F TEMP. RISE	VOLTS/ PHASE	REMARKS
EUH-1	HARDEES P.S.	HORIZ DISCHARGE UNIT HEATER	51,200	1,100	15	32	43	480/3	TRANE, OR EQUAL, MODEL UHEC-153DACA W/ UNIT MOUNTED THERMOSTAT, DISCONNECT & SUMMER FAN SWITCH. MOUNT 7" A.F.F.
EUH-2	WEBB P.S.	HORIZ DISCHARGE UNIT HEATER	51,200	1,100	15	32	43	480/3	TRANE, OR EQUAL, MODEL UHEC-153DACA W/ UNIT MOUNTED THERMOSTAT, DISCONNECT & SUMMER FAN SWITCH. MOUNT 7" A.F.F.
EUH-3	WOODY P.S.	HORIZ DISCHARGE UNIT HEATER	51,200	1,100	15	32	43	480/3	TRANE, OR EQUAL, MODEL UHEC-153DACA W/ UNIT MOUNTED THERMOSTAT, DISCONNECT & SUMMER FAN SWITCH. MOUNT 7" A.F.F.

ENERGY RECOVERY VENTILATOR SCHEDULE											
MARK	LOCATION	E.S.P. IN. WG.	CFM	DUCT SIZE	WHEEL % EFF.	NO. & TYPE BLOWERS	DRIVE	MOTOR H.P. EA.	VOLTS/ PHASE	MIN. CIRC. AMPS	REMARKS
ERV-1	HARDEES P.S.	.50	933	18"x18" IN 8-3/8"x11-1/2" OUT	80	2, F.C. CENTRIFUGAL	BELT	1/2	230/1	12	GREENHECK, OR EQUAL, MODEL ERV-361S-A W/ FRESH AIR FILTER.
ERV-2	WEBB P.S.	.375	712	18"x18" IN 8-3/8"x11-1/2" OUT	82	2, F.C. CENTRIFUGAL	BELT	1/3	230/1	9	GREENHECK, OR EQUAL, MODEL ERV-361S-A W/ FRESH AIR FILTER.
ERV-3	WOODY P.S.	.375	744	18"x18" IN 8-3/8"x11-1/2" OUT	82	2, F.C. CENTRIFUGAL	BELT	1/3	230/1	9	GREENHECK, OR EQUAL, MODEL ERV-361S-A W/ FRESH AIR FILTER.

RECORD DRAWINGS

ALL RIGHTS RESERVED.
THIS DOCUMENT IS THE PROPERTY OF GRW ELDRO DUNSON, INC. AND SHALL NOT BE REPRODUCED IN WHOLE OR IN PART OR USED FOR CONSTRUCTION OF OTHER THAN THIS SPECIFIC PROJECT WITHOUT WRITTEN PERMISSION OF GRW ELDRO DUNSON, INC.

RECHECKED BY: *[Signature]* DATE: *16/2007*

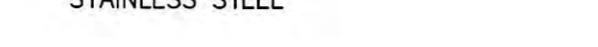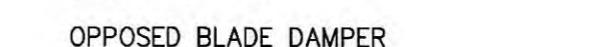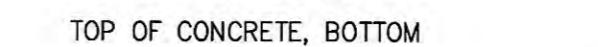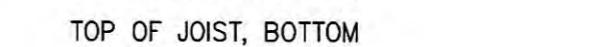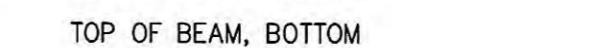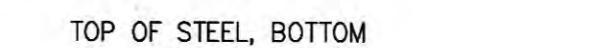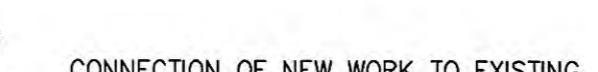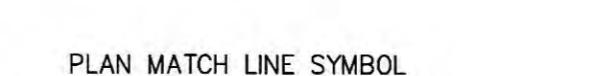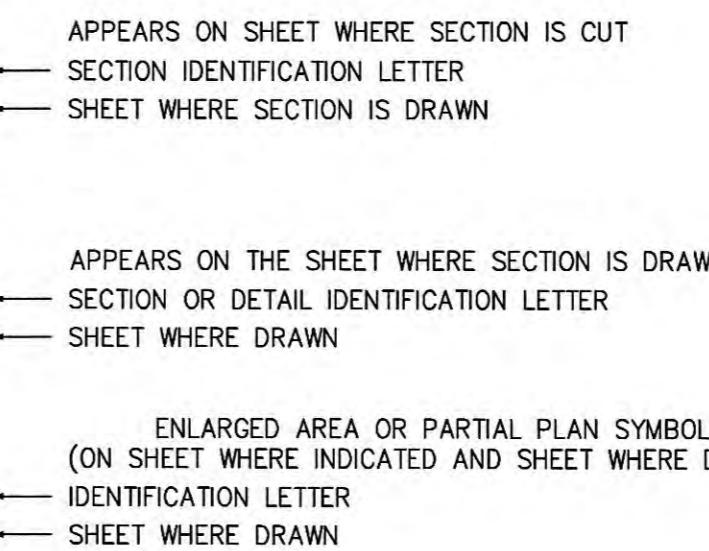GENERAL LEGEND**GENERAL NOTES**


- GENERAL NOTES, WHEREVER THEY ARE FOUND, APPLY TO ALL WORK IN THE PROJECT, UNLESS OTHERWISE INDICATED. SHEET NOTES, UTILIZING NOTE SYMBOLS, APPLY ONLY TO THE SHEET ON WHICH THEY ARE FOUND, UNLESS OTHERWISE STATED. THE MEANING OF NOTE SYMBOLS AND NUMBERS VARIES FROM SHEET TO SHEET.
- CONTRACTOR SHALL UTILIZE ALL INFORMATION IN THE CONTRACT DOCUMENTS FOR PROVIDING THE WORK. CONTRACTOR SHALL UTILIZE DETAILS AND FLOW DIAGRAMS FOR THE WORK WHERE APPROPRIATE, WHETHER OR NOT THEY ARE SPECIFICALLY REFERENCED ON THE PLANS OR SUPPORTING DRAWINGS.
- CONTRACTOR SHALL FIELD VERIFY ALL EXISTING CONDITIONS. ANY DISCREPANCIES BETWEEN EXISTING CONDITIONS AND CONTRACT DOCUMENTS ARE TO BE BROUGHT TO THE ATTENTION OF THE ENGINEER BEFORE ANY WORK RELATING TO THOSE CONDITIONS IS PERFORMED.
- LEGENDS OR LISTS OF SYMBOLS AND ABBREVIATIONS ARE GENERAL IN NATURE AND MAY CONTAIN ITEMS NOT USED IN THE CONTRACT DOCUMENTS. IF ANY SUCH ITEMS ARE FOUND WHICH ARE NOT DEFINED ON THE PLANS OR IN THE SPECIFICATIONS, THE ENGINEER SHALL BE CONTACTED FOR CLARIFICATION BEFORE THE BID.
- CONTRACTOR SHALL MAINTAIN A SET OF PROJECT RECORD DRAWINGS AT THE JOB SITE AND SHALL BE RESPONSIBLE FOR MAKING CLEAR, NEAT CHANGES TO THE DRAWINGS, REFLECTING CHANGES TO THE WORK AND VARIANCE IN EXISTING CONDITIONS.
- PROVIDE ALL MISCELLANEOUS STEEL, AS REQUIRED, TO SUPPORT ALL MECHANICAL DUCT AND PIPING SYSTEMS AND EQUIPMENT. HANG ALL EQUIPMENT FROM STRUCTURE WITH MINIMUM OF TWO TRAPEZE ASSEMBLIES OR FOUR INTEGRAL MOUNTING POINTS WITH VIBRATION ISOLATORS ON ALL FOUR SUPPORTS. DO NOT HANG ANYTHING FROM STEEL, COMPOSITION OR WOODEN DECKS. NON-ROOF CONCRETE DECKS MAY BE USED ONLY WITH PERMISSION OF THE ENGINEER. DO NOT HANG ANYTHING FROM MECHANICAL OR ELECTRICAL ITEMS.
- NO CONCRETE RIBS OR JOISTS SHALL BE CUT WITHOUT SPECIFIC PERMISSION FROM THE ENGINEER. ALL ROOF OR FLOOR DECK PENETRATIONS IN WAFFLE STRUCTURE SHALL BE IN THE THIN-SLAB DEPRESSIONS IN THE STRUCTURE UNLESS OTHERWISE SHOWN.
- NO STEEL STRUCTURAL MEMBERS SHALL BE CUT, BURNED, WELDED OR DRILLED WITHOUT SPECIFIC PERMISSION OF THE ENGINEER.
- NO WOODEN STRUCTURAL MEMBERS SHALL BE CUT OR DRILLED EXCEPT AS INDICATED IN THE CONTRACT DOCUMENTS OR AS APPROVED BY THE ENGINEER.
- CONSULT ROOF PLAN AND STRUCTURAL DRAWINGS FOR PLACEMENT OF ROOF MOUNTED EQUIPMENT. PROVIDE ALL NECESSARY ROOF CURBS, EQUIPMENT RAILS AND BASES AND ANY ADDITIONAL REQUIRED FRAMING IN COORDINATION WITH STRUCTURAL AND ROOFING WORK.
- ALL EQUIPMENT, DUCT, PIPING AND ACCESSORIES INSTALLED OUTSIDE OR OTHERWISE EXPOSED TO THE ELEMENTS SHALL BE ADEQUATELY WEATHERPROOFED, IN KEEPING WITH THE SPECIFICATIONS. ALL FERROUS METAL FRAMING COMPONENTS SHALL BE STAINLESS STEEL OR HOT-DIP GALVANIZED.
- DO NOT CHANGE PATH OF PIPING OR DUCT RUNS, ADD TURNS OR OFFSETS OR CHANGE DUCT DIMENSIONS OR PIPE SIZE WITHOUT FIRST CONSULTING THE ENGINEER. PIPE SIZES SHOWN ON DRAWINGS ARE NOMINAL UNLESS OTHERWISE INDICATED. ALL DUCT SIZES SHOWN ON PLANS ARE CLEAR INSIDE DIMENSIONS FOR SHOP OR FIELD-FABRICATED DUCT AND NOMINAL SIZES FOR FACTORY FABRICATED DUCT.
- CONTRACTOR SHALL CERTIFY AT THE TIME OF OWNER OCCUPANCY THAT ALL BELT-DRIVEN EQUIPMENT HAS BEEN CHECKED FOR BELT TIGHTNESS AFTER WEAR-IN PERIOD.
- ALL EXISTING EQUIPMENT SHUTDOWNS OR INTERRUPTIONS OF UTILITY SERVICE REQUIRED FOR COMPLETION OF THE WORK SHALL BE SCHEDULED IN ADVANCE, AS REQUIRED BY THE OWNER.
- COORDINATE ALL PIPING AND DUCTWORK WITH BOTH NEW AND EXISTING MECHANICAL AND ELECTRICAL WORK, INCLUDING HVAC, PLUMBING, ELECTRICAL, FIRE ALARM AND COMMUNICATIONS.
- CONTRACTOR IS RESPONSIBLE FOR MAKING ALL REQUIRED CONNECTIONS FOR A COMPLETE SYSTEM. CONNECTIONS OF NEW WORK TO EXISTING IS USUALLY INDICATED BY SPECIAL SYMBOL (SEE LEGEND). SYMBOLS MISSING FROM THE DRAWINGS DO NOT EXCUSE THE CONTRACTOR FROM PROVIDING THE WORK.
- ALL DUCTWORK AND SHEET METAL SHALL BE PROVIDED AS INDICATED AND SHALL BE MANUFACTURED AND SHOP- OR FIELD-FABRICATED, AS A MINIMUM, IN ACCORDANCE WITH THE RECOMMENDATIONS AND DETAILS OF SMACNA, UNLESS SPECIFICALLY INDICATED OTHERWISE.
- FANS SHALL BE PROVIDED AS INDICATED BY GREENHECK, CARNES, COOK OR APPROVED EQUAL. GRILLE, RESTRICTOR AND FUSER SHALL BE PROVIDED AS INDICATED BY TITUS, TUTTLE AND BAILEY, CARNES OR APPROVED EQUAL. LOUVRES, HOODS AND PENTHOUSES SHALL BE PROVIDED AS INDICATED BY GREENHECK, AIRSTREAM, LOUVRES AND DAMPERS, CARNES, RUSKIN OR APPROVED EQUAL. PROVIDE FIRE AND SMOKE DAMPERS IN ACCORDANCE WITH THE REQUIREMENTS OF NFPA AND THE TENNESSEE BUILDING CODE.
- USE TURNING VENES, PER SMACNA CONSTRUCTION GUIDELINES, FOR ALL MITERED RECTANGULAR TURNS OF 45 DEGREES OR MORE.
- PROVIDE ALL CONTROLS NECESSARY TO OPERATE EQUIPMENT AS SHOWN OR DESCRIBED, INCLUDING VALVES, ACTUATORS, THERMOSTATS, DAMPERS, ALL ACCESSORY DEVICES, POWER AND/OR PNEUMATIC SERVICE.
- PROVIDE DISCONNECTS AND MAGNETIC STARTERS (OR RELAYS WITH OVERLOAD PROTECTION FOR SINGLE PHASE) FOR ALL EQUIPMENT SUPPLIED UNDER DIVISION 15 WHICH IS SPECIFIED TO HAVE FACTORY CONTROL PANEL, POWER WIRING AND CONDUIT TO THESE DEVICES AND BETWEEN THESE DEVICES AND MECHANICAL EQUIPMENT, IF REQUIRED, SHALL BE PROVIDED UNDER DIVISION 16.
- ANY AND ALL DAMAGE DUE TO DEMOLITION OR CONSTRUCTION IS TO BE REPAIRED OR REPLACED AS APPROPRIATE, SUBJECT TO ENGINEERS APPROVAL, AND AT NO ADDITIONAL COST TO THE OWNER.

GRW PROJECT NO. 7601-30 CONTRACT NO. S02-03

**MECHANICAL LEGEND
GENERAL NOTES, AND SCHEDULES
HARRIMAN UTILITY BOARD
HARRIMAN, TENNESSEE**


REVIEWED: RGE	DESIGNED: RGE	DATE: JUNE, 2004
DRAWN: JMG	SCALE:	AS NOTED
APPROVED: RGE	SHEET NO. M-4	
REVISIONS		

LEXINGTON LOUISVILLE INDIANAPOLIS
NASHVILLE KNOXVILLE

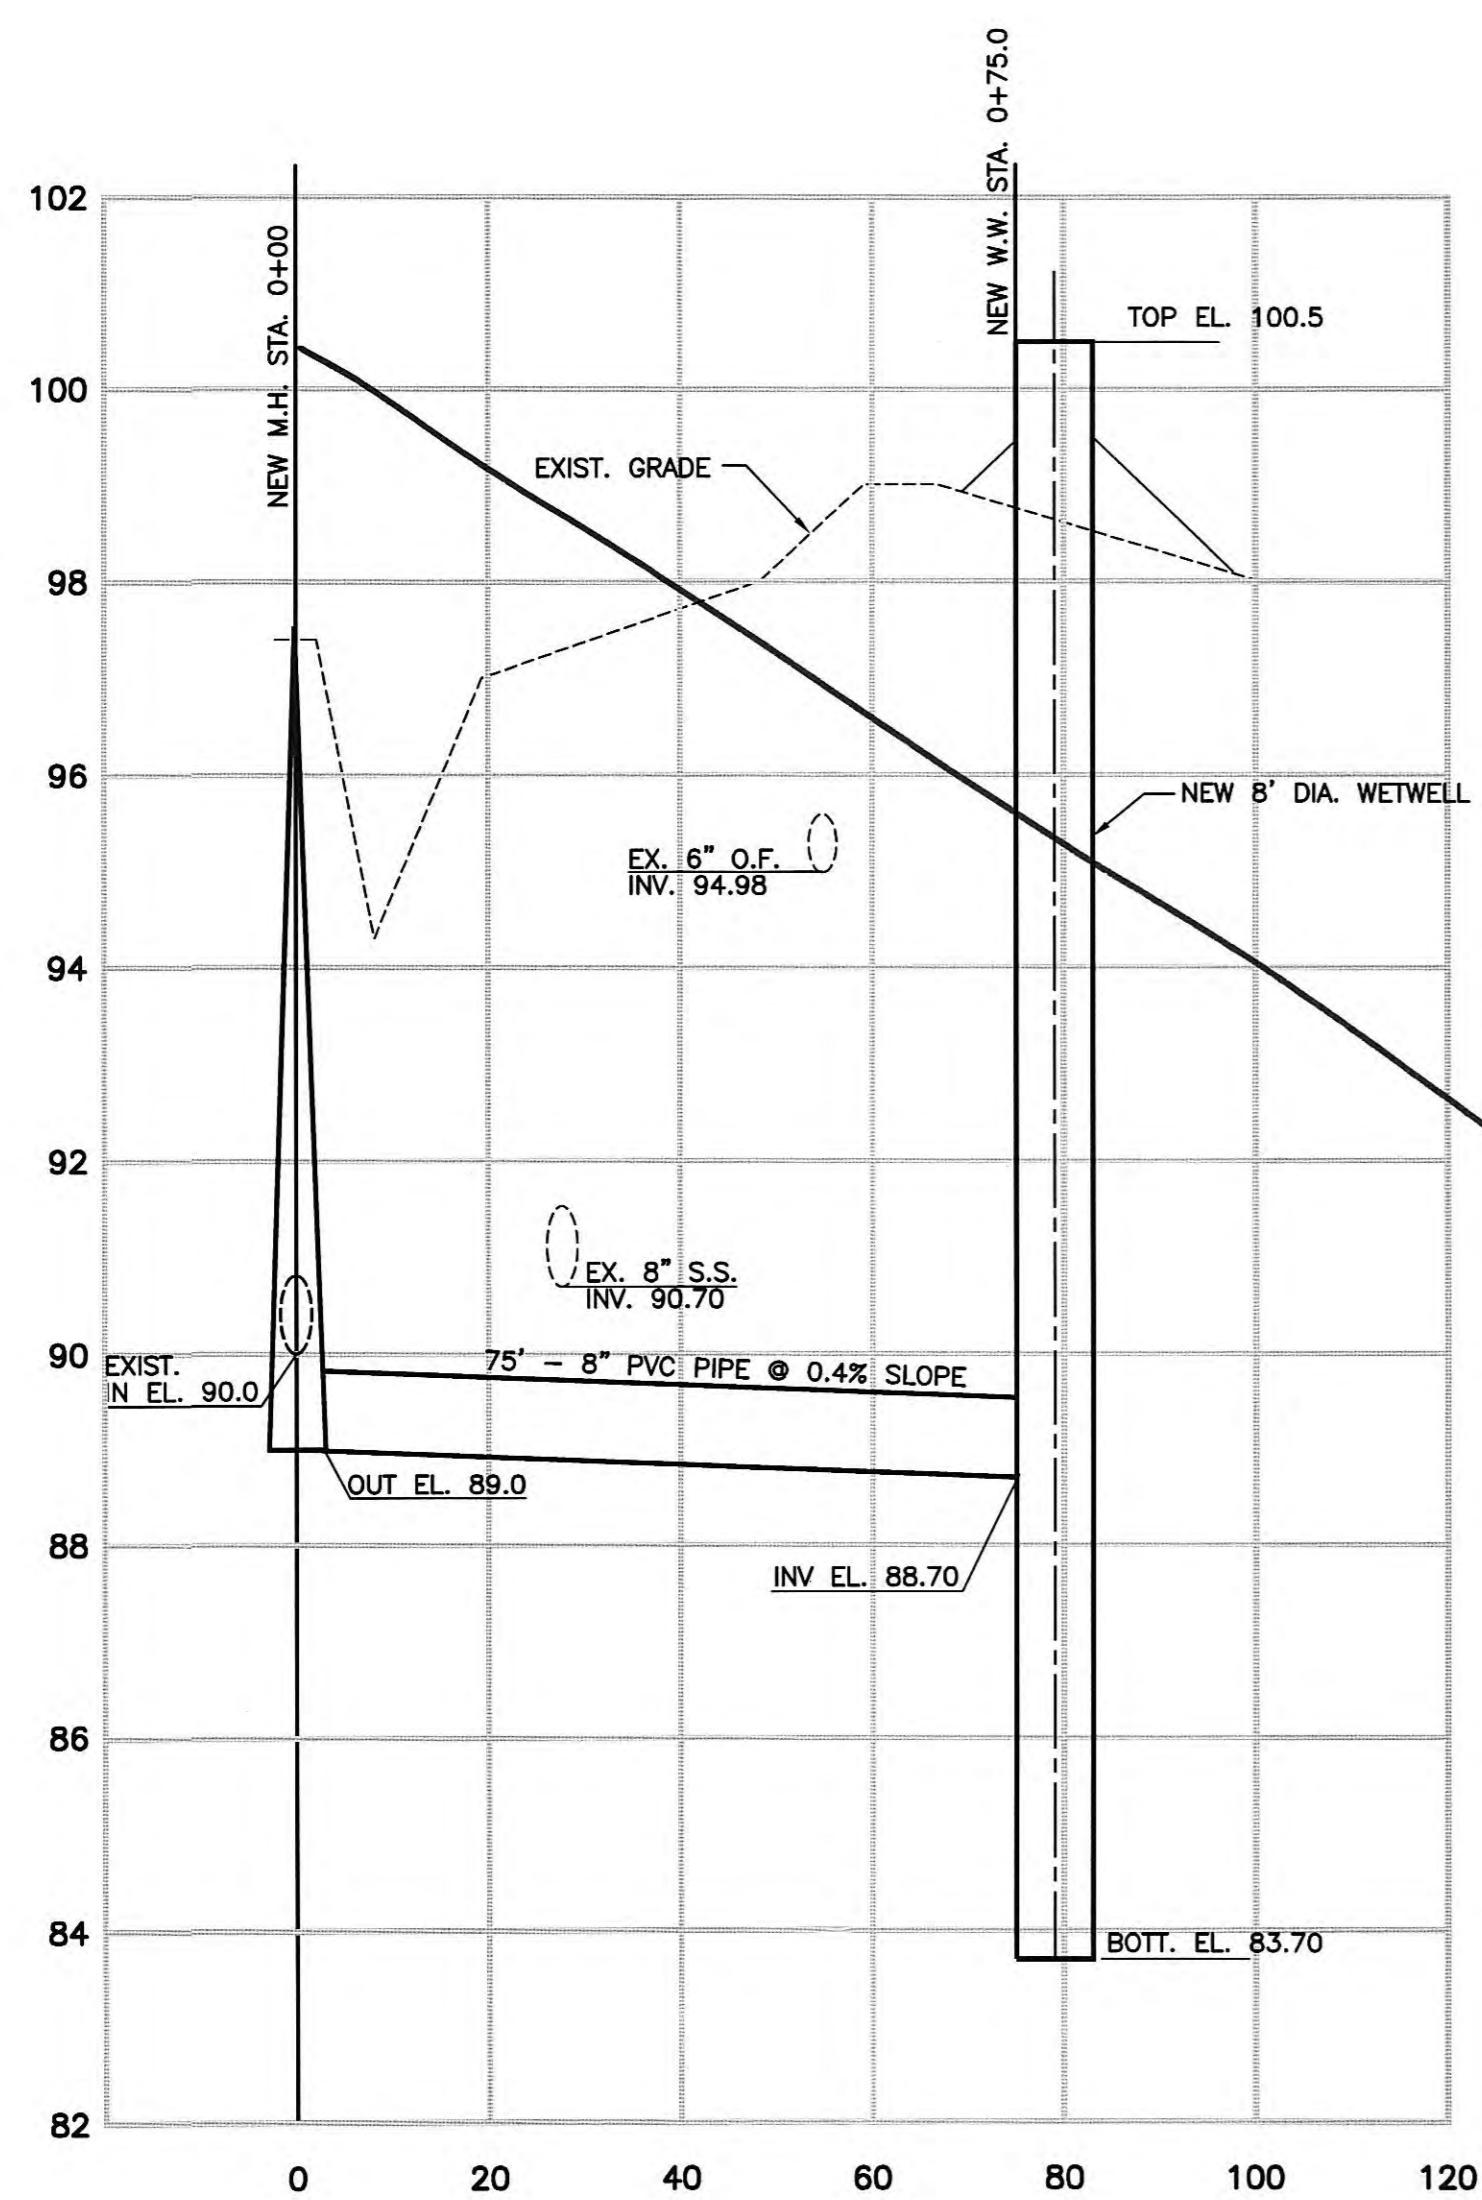

PROFILE—GRAVITY SEWER

SCALE: 1" = 20' H
2' V

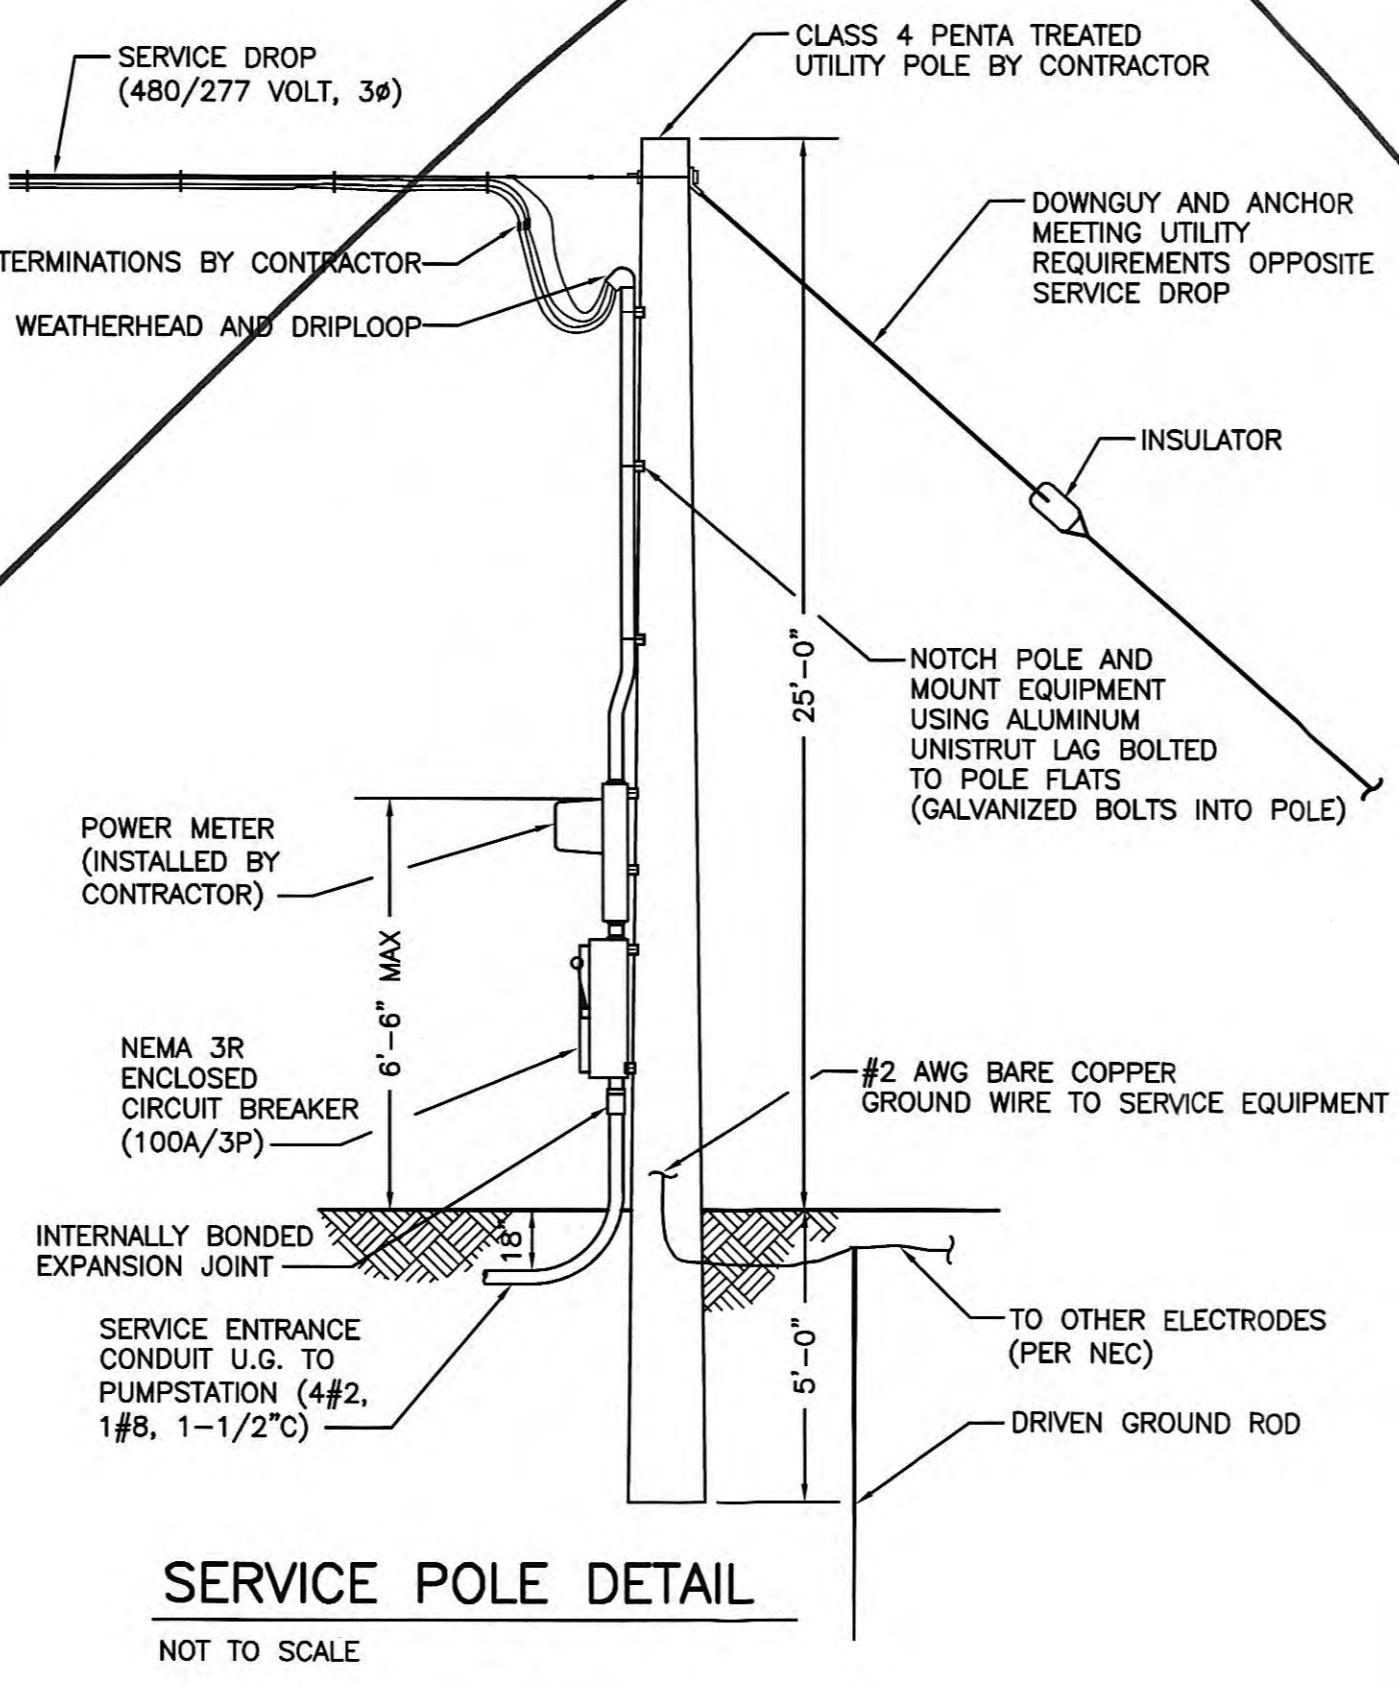

SERVICE POLE DETAIL

NOT TO SCALE

GRAPHIC SCALE
0 10 20 40
1 Inch = 20' feet

BURIED TELEPHONE CABLES AND UTILITIES
CALL: TENNESSEE ONE CALL (1-800-351-1111)

ALL RIGHTS RESERVED.
THIS DOCUMENT IS THE PROPERTY OF GRW ELROD DUNSON, INC. AND SHALL NOT BE REPRODUCED IN WHOLE OR IN PART OR
USED FOR CONSTRUCTION OF OTHER THAN THIS SPECIFIC PROJECT WITHOUT WRITTEN PERMISSION OF GRW ELROD DUNSON, INC.

RECORD DRAWINGS


THESE RECORD DRAWINGS REPRESENT THE "AS-BUILT"
PROJECT TO THE BEST OF THE ENGINEER'S KNOWLEDGE.
ALTHOUGH PREPARED FROM THE CONSTRUCTION RECORD,
THEY CANNOT BE GUARANTEED TO BE EXACT IN EVERY
DETAIL.



CHECKED BY:
[Signature]
ENGINEER'S REPRESENTATIVE
4/2007
DATE

GRW PROJECT NO. 7601-30		CONTRACT NO. S02-03	
CARDIFF SEWAGE LIFT STATION SITE GRADING AND PIPING PLAN HARRIMAN UTILITY BOARD HARRIMAN, TENNESSEE			
DESIGNED:	RGT	DATE:	FEBRUARY, 2004
DRAWN:	DGR	SCALE:	AS NOTED
REVIEWED:	RGT	SHEET NO.	
APPROVED:	RGT		


GRW Elrod Dunson, Inc.
Engineers, Architects, Planners
LEXINGTON LOUISVILLE NASHVILLE KNOXVILLE
INDIANAPOLIS PORT MITCHELL ARLINGTON

C-8

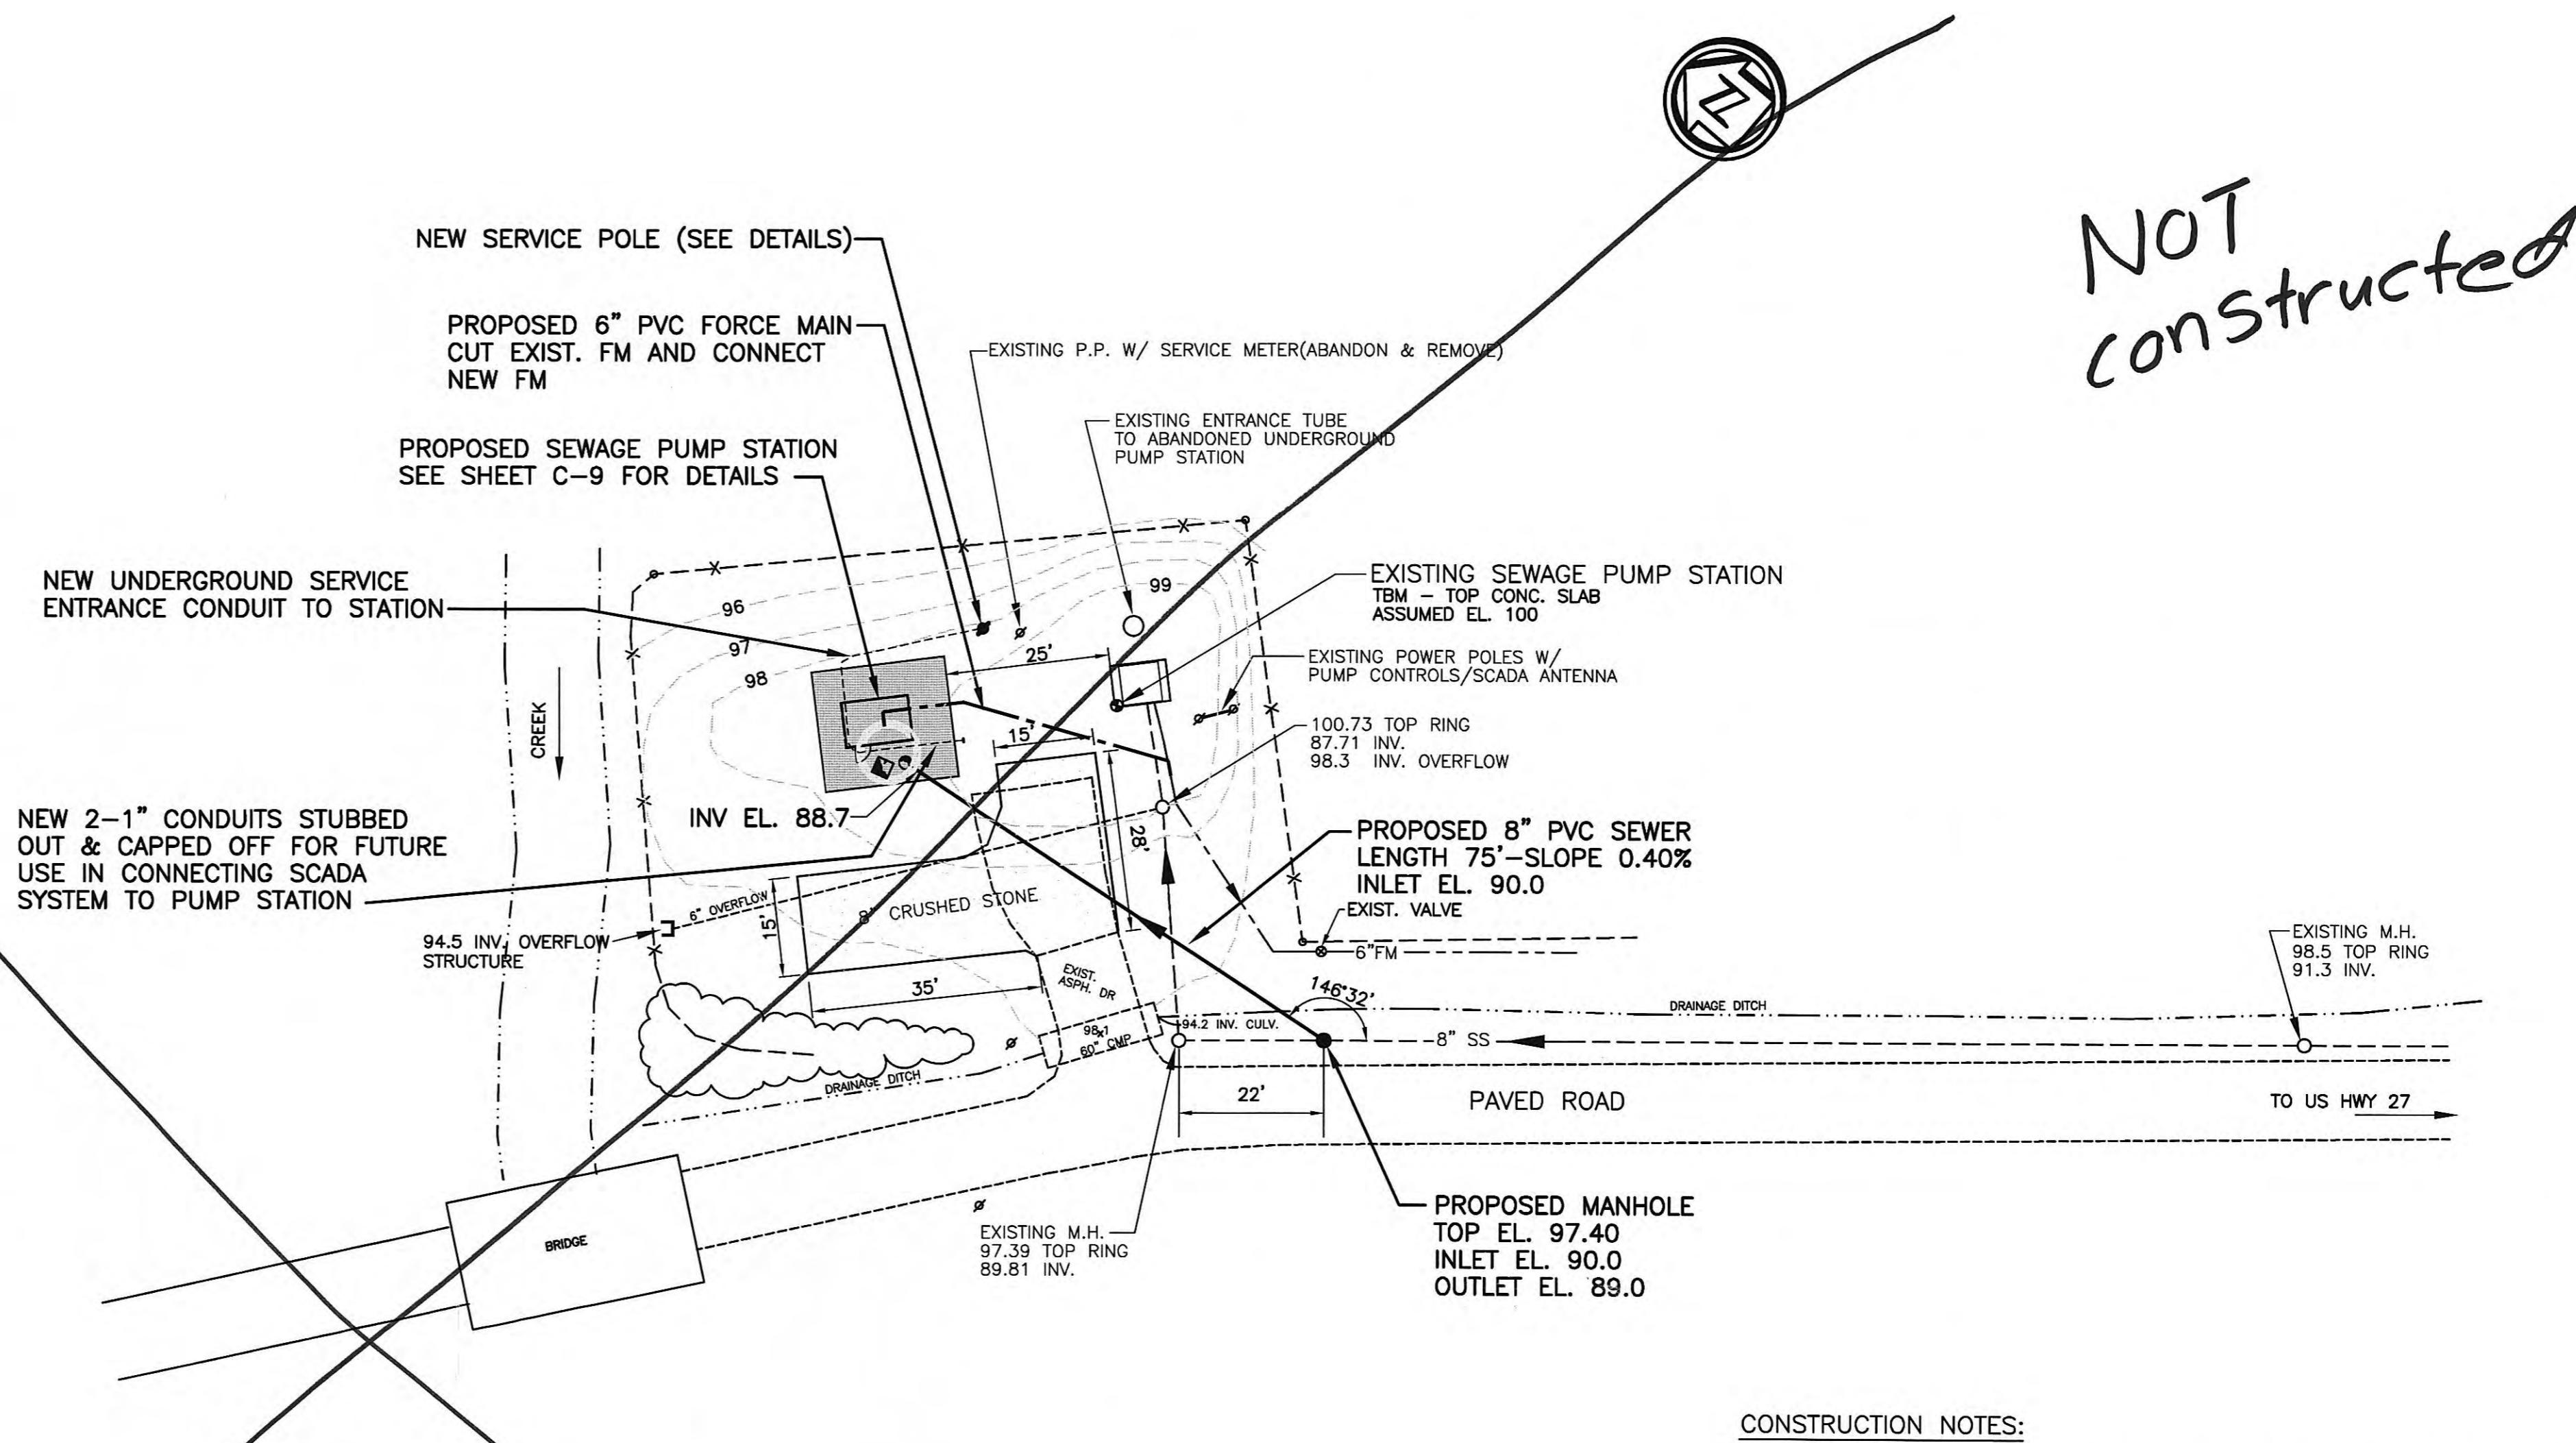

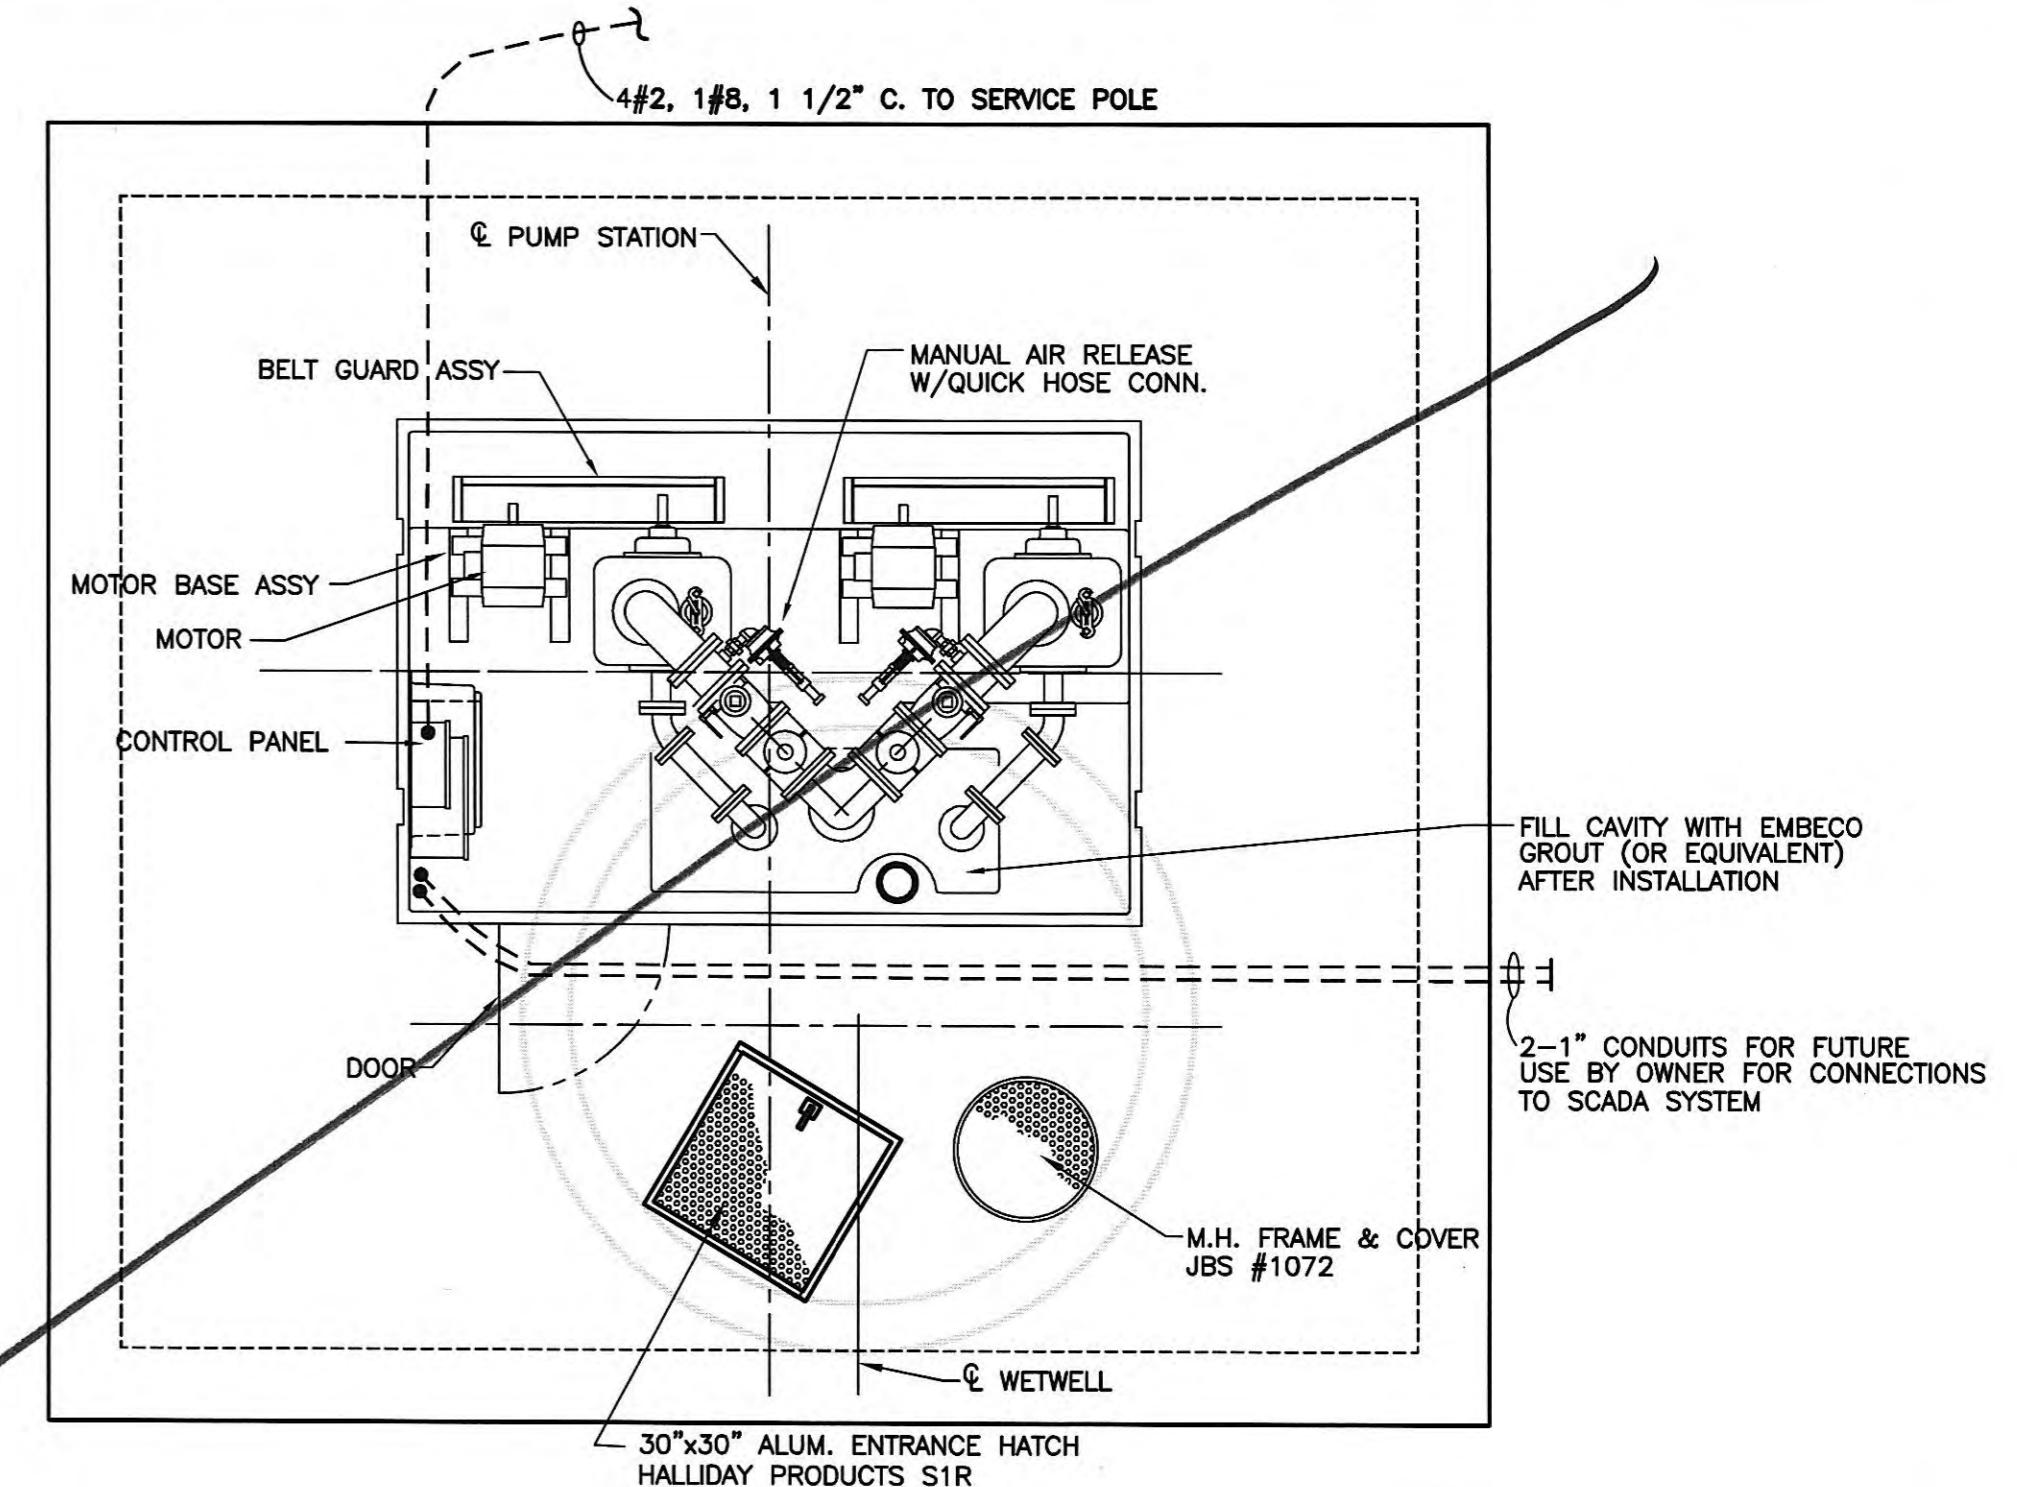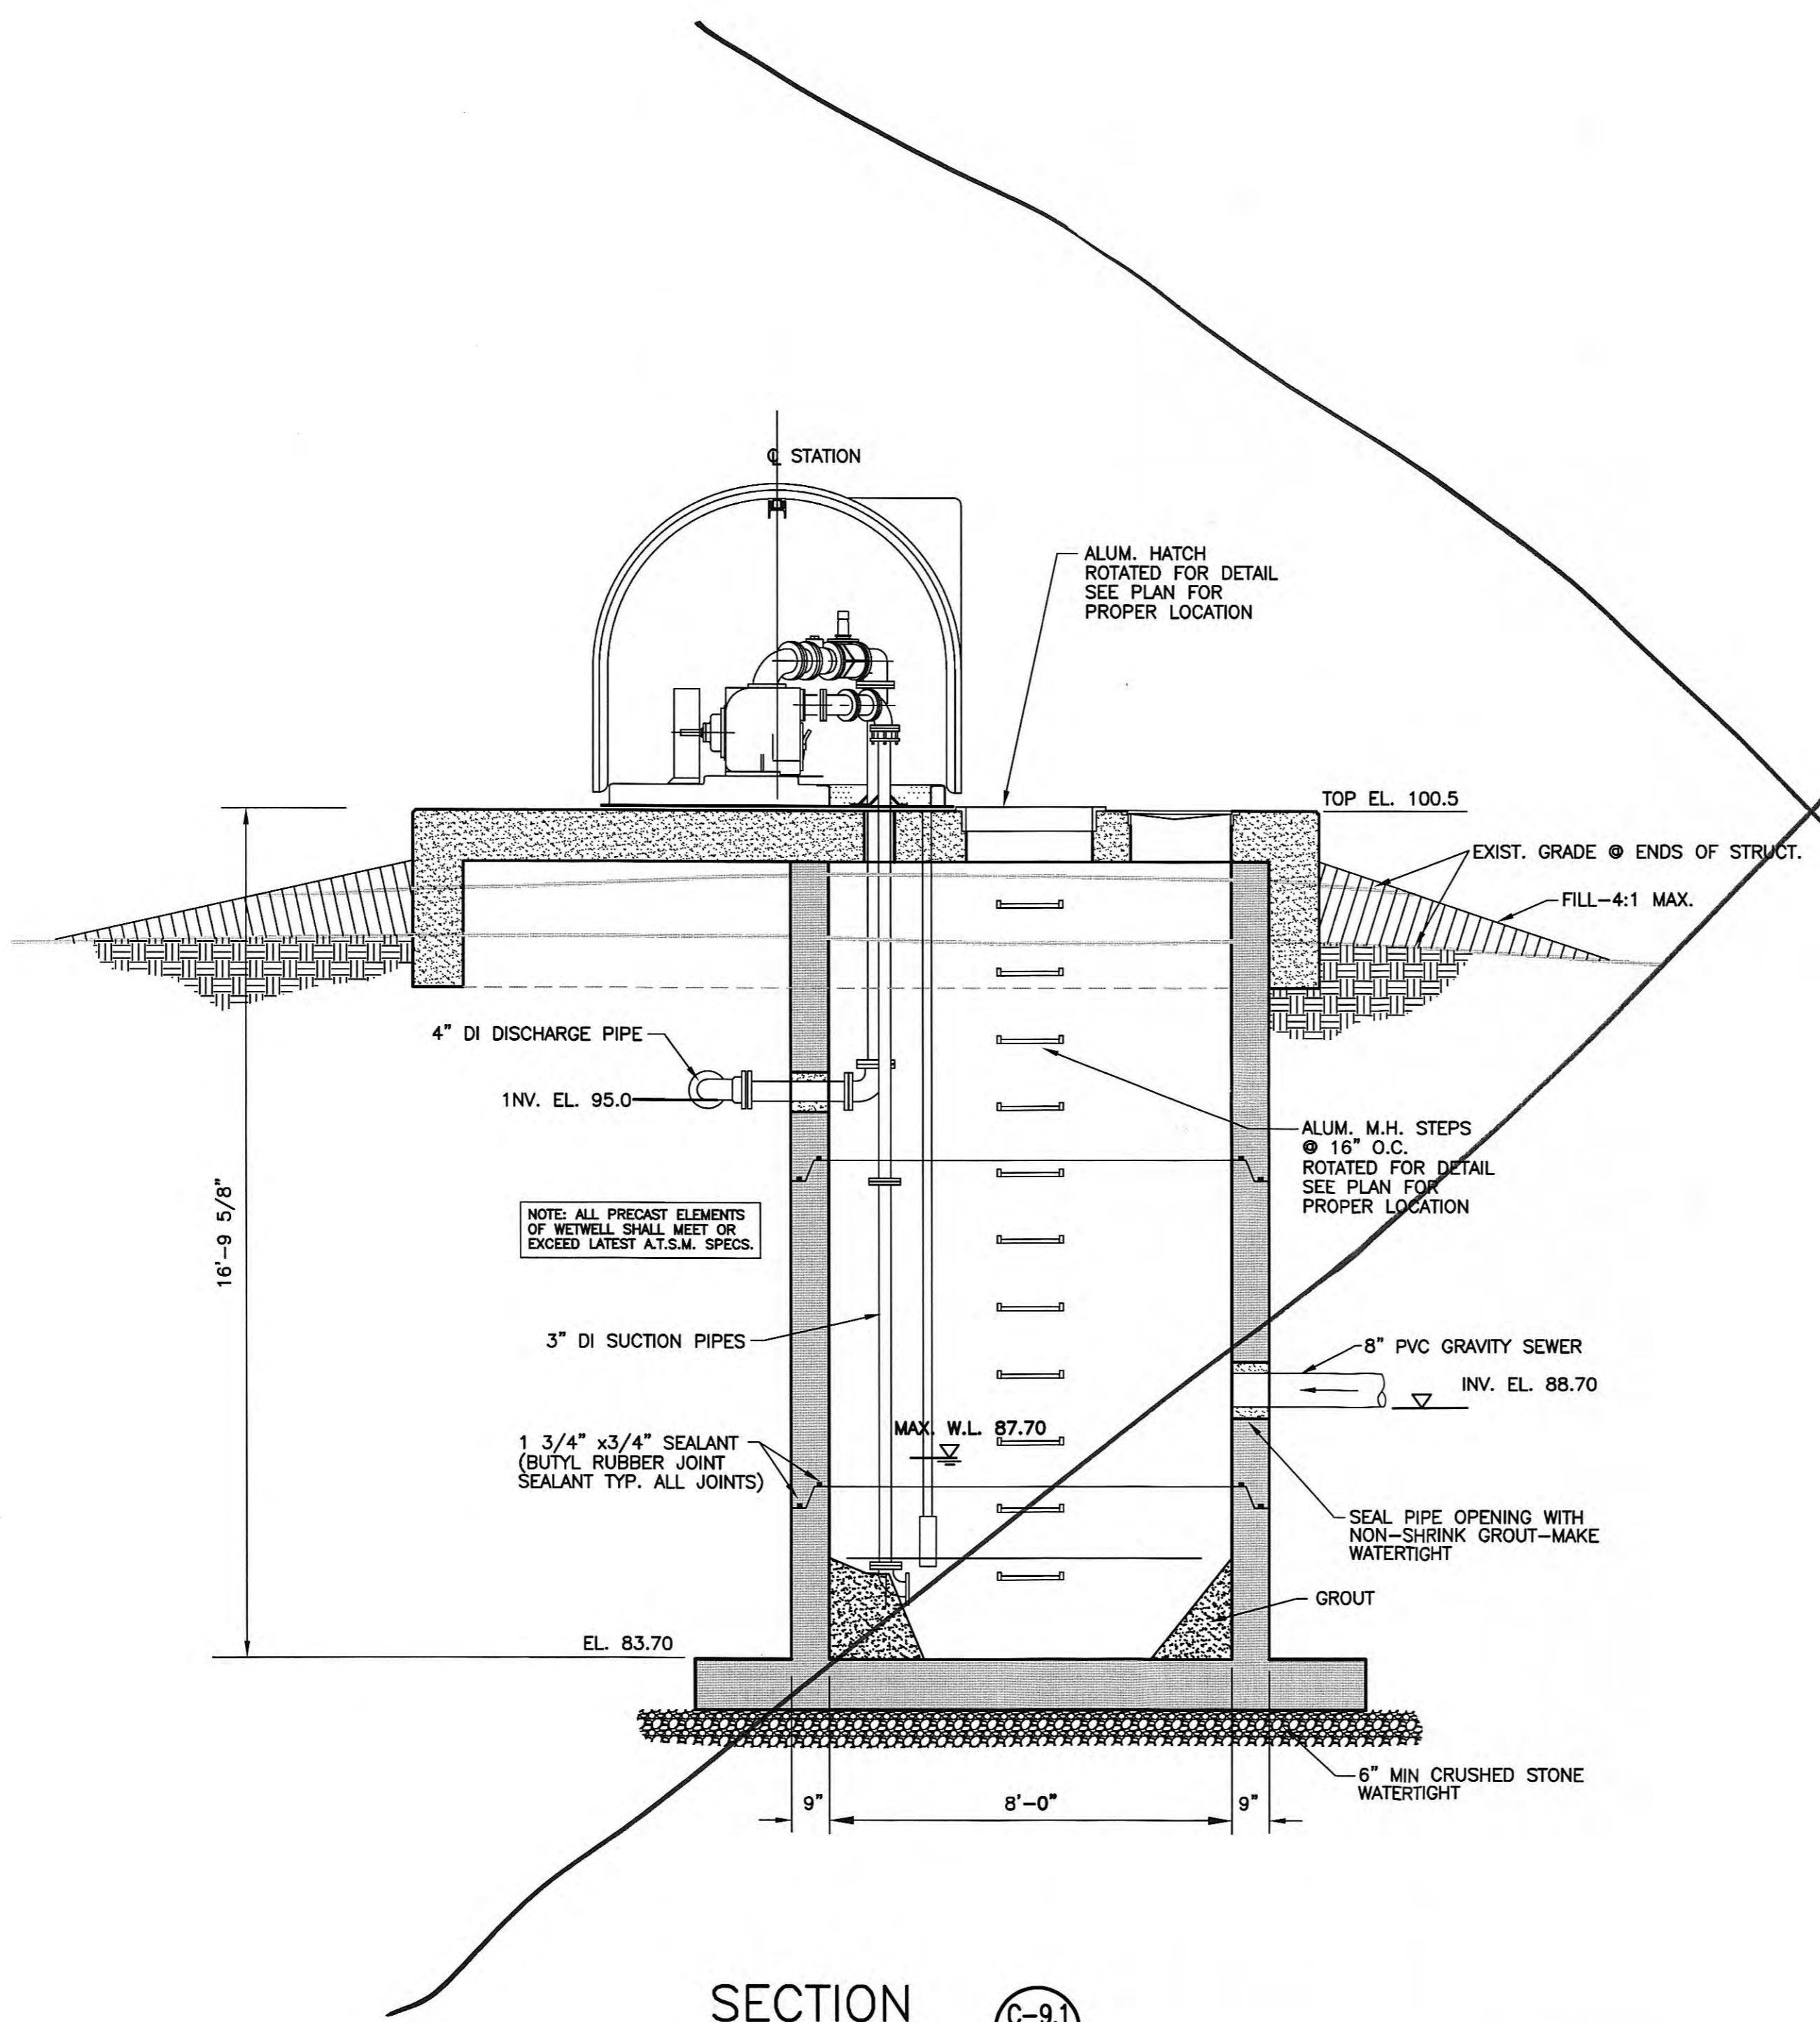

CARDIFF SEWAGE LIFT STATION - TOP VIEW


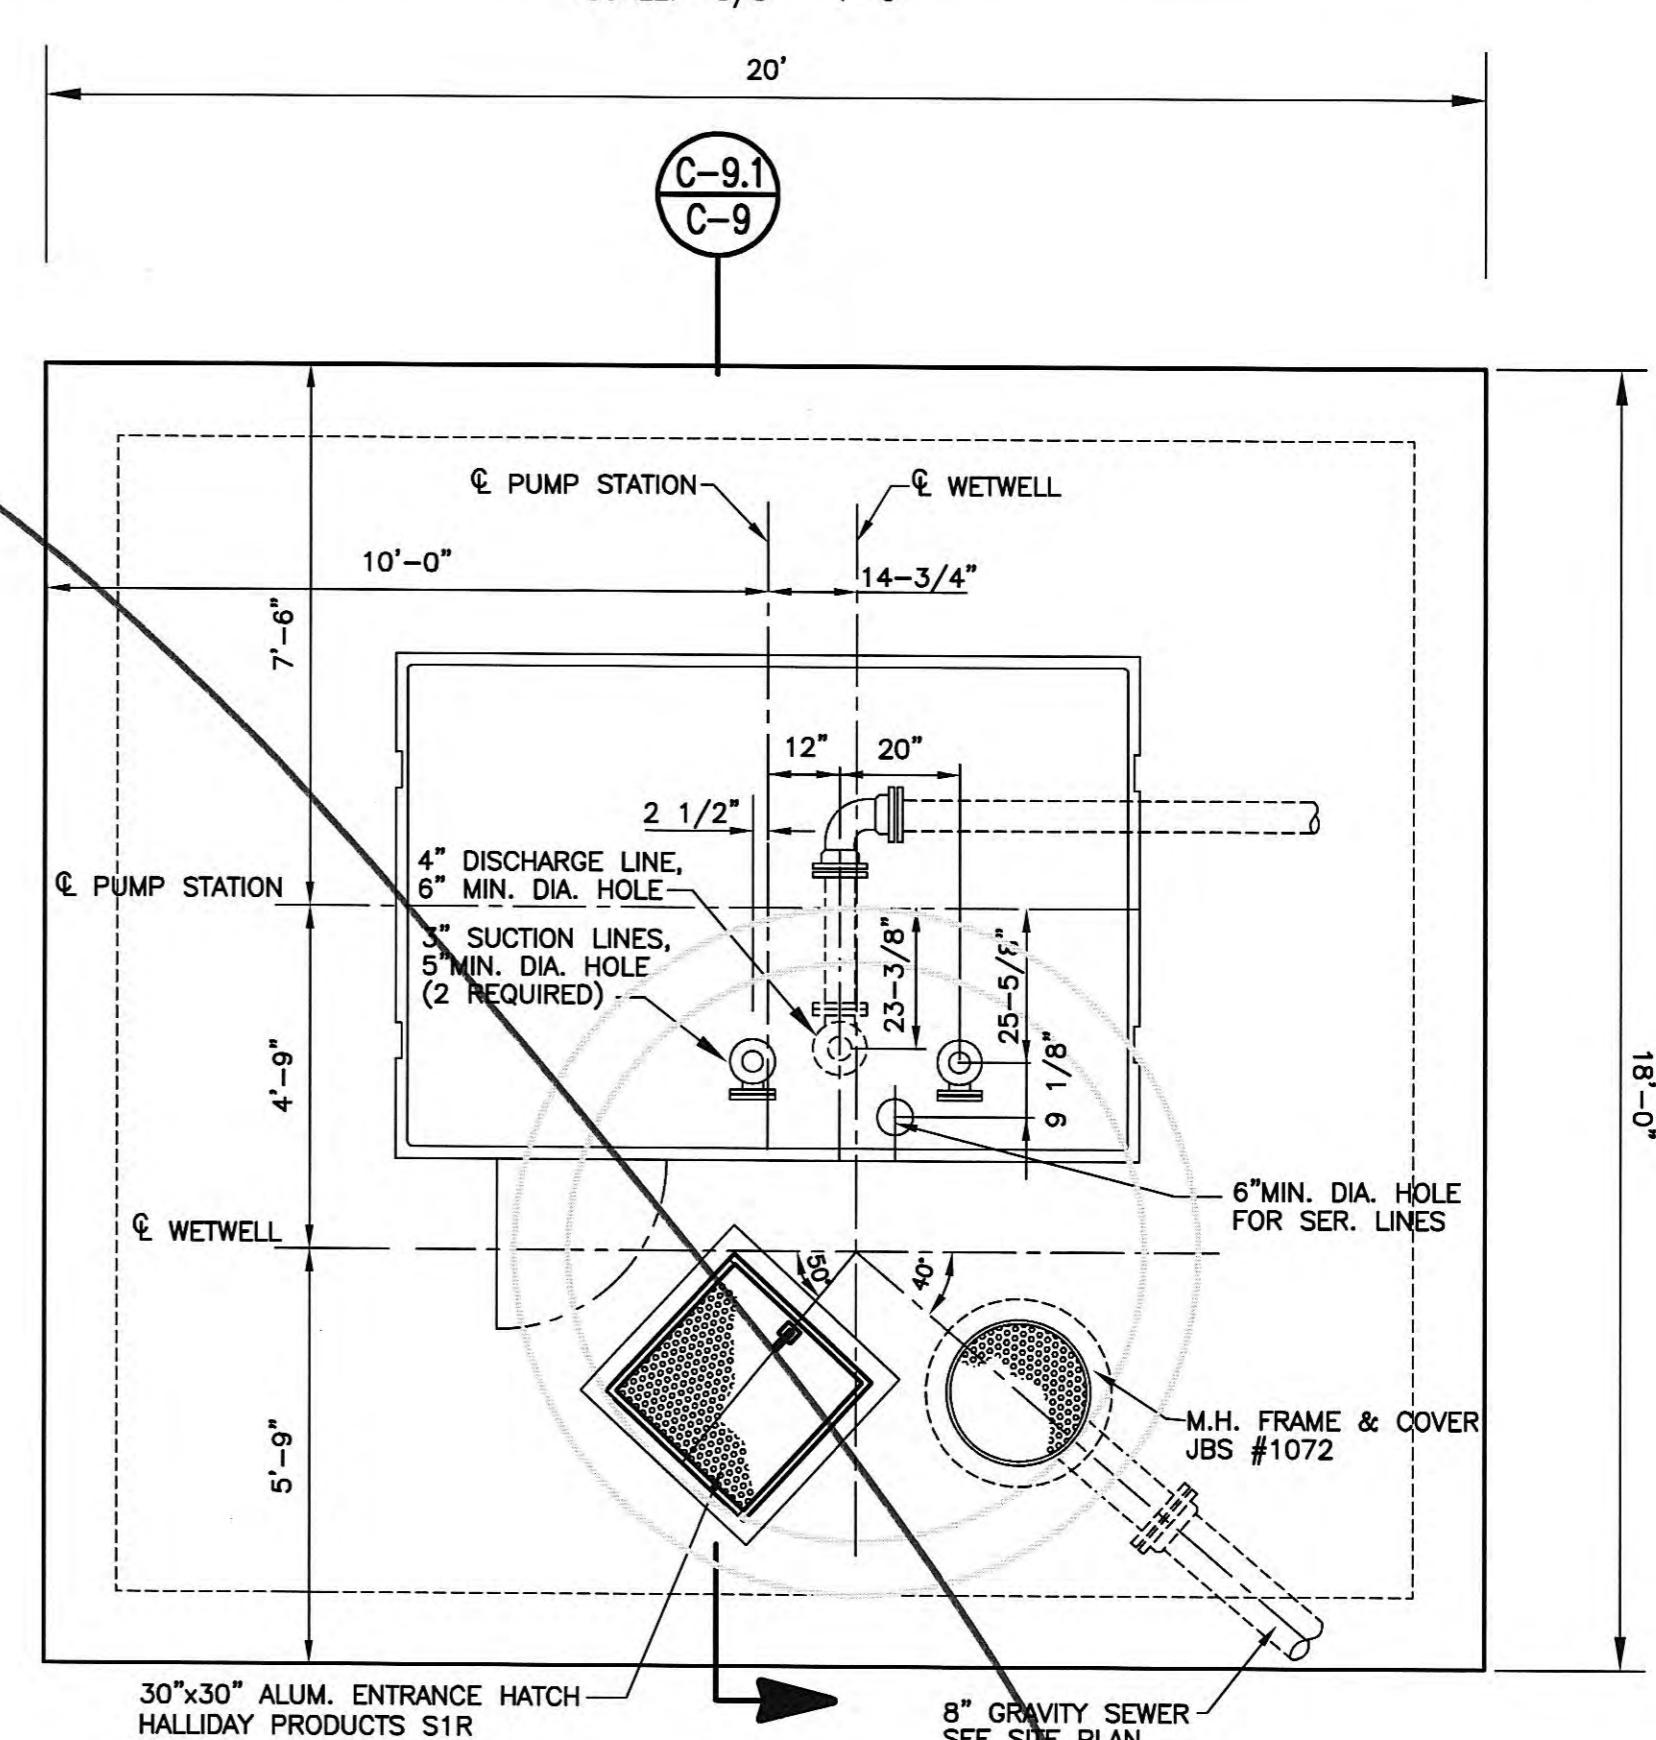


PIPING AND EQUIPMENT LAYOUT - PLAN VIEW

SCALE: 3/8" = 1'-0"

GRW PROJECT NO. 7601-30		CONTRACT NO. S02-03			
CARDIFF SEWAGE LIFT STATION PLAN AND SECTIONS HARRIMAN UTILITY BOARD HARRIMAN, TENNESSEE					
BURIED TELEPHONE CABLES AND UTILITIES CALL: TENNESSEE ONE CALL (1-800-351-1111)					
RECORD DRAWINGS	DESIGNED: RGT	DATE: FEBRUARY, 2004			
THESE RECORD DRAWINGS REPRESENT THE "AS-BUILT" PROJECT TO THE BEST OF THE ENGINEER'S KNOWLEDGE. ALTHOUGH PREPARED FROM THE CONSTRUCTION RECORD, THEY CANNOT BE GUARANTEED TO BE EXACT IN EVERY DETAIL.	DRAWN: DGR	SCALE: AS NOTED			
CHECKED BY: Signature ENGINEER'S REPRESENTATIVE	REVIEWED: RGT	SHEET NO. C-9			
DATE: 6/2002	APPROVED: RGT				
THIS DOCUMENT IS THE PROPERTY OF GRW ELROD DUNSON, INC. AND SHALL NOT BE REPRODUCED IN WHOLE OR IN PART OR USED FOR CONSTRUCTION OF OTHER THAN THIS SPECIFIC PROJECT WITHOUT WRITTEN PERMISSION OF GRW ELROD DUNSON, INC.					
GRW Elrod Dunson, Inc. Engineers, Architects, Planners LEXINGTON LOUISVILLE NASHVILLE KNOXVILLE INDIANAPOLIS FORT MITCHELL ARLINGTON					

RECORD DRAWINGS	
THESE RECORD DRAWINGS REPRESENT THE "AS-BUILT" PROJECT TO THE BEST OF THE ENGINEER'S KNOWLEDGE. ALTHOUGH PREPARED FROM THE CONSTRUCTION RECORD, THEY CANNOT BE GUARANTEED TO BE EXACT IN EVERY DETAIL.	
CHECKED BY:	DATE:
<i>[Signature]</i> Signature ENGINEER'S REPRESENTATIVE	6/2002
REVISIONS	DATE
REVISIONS	BY

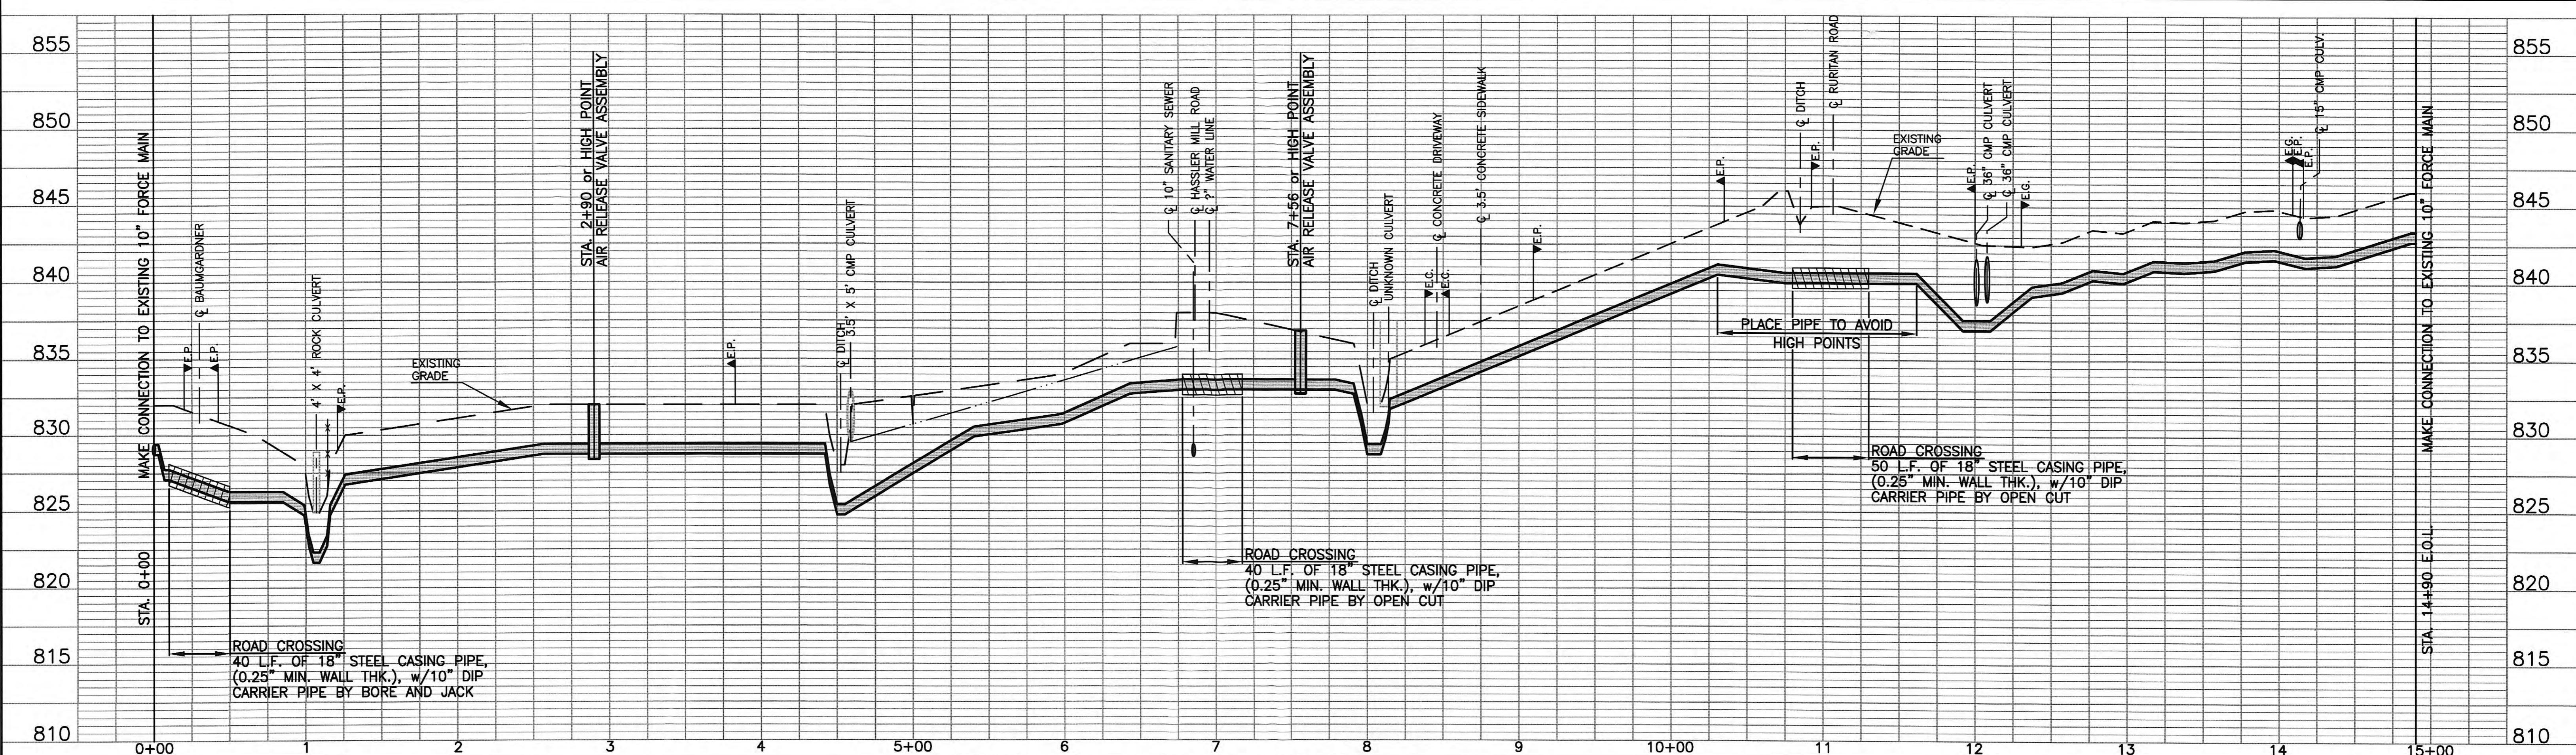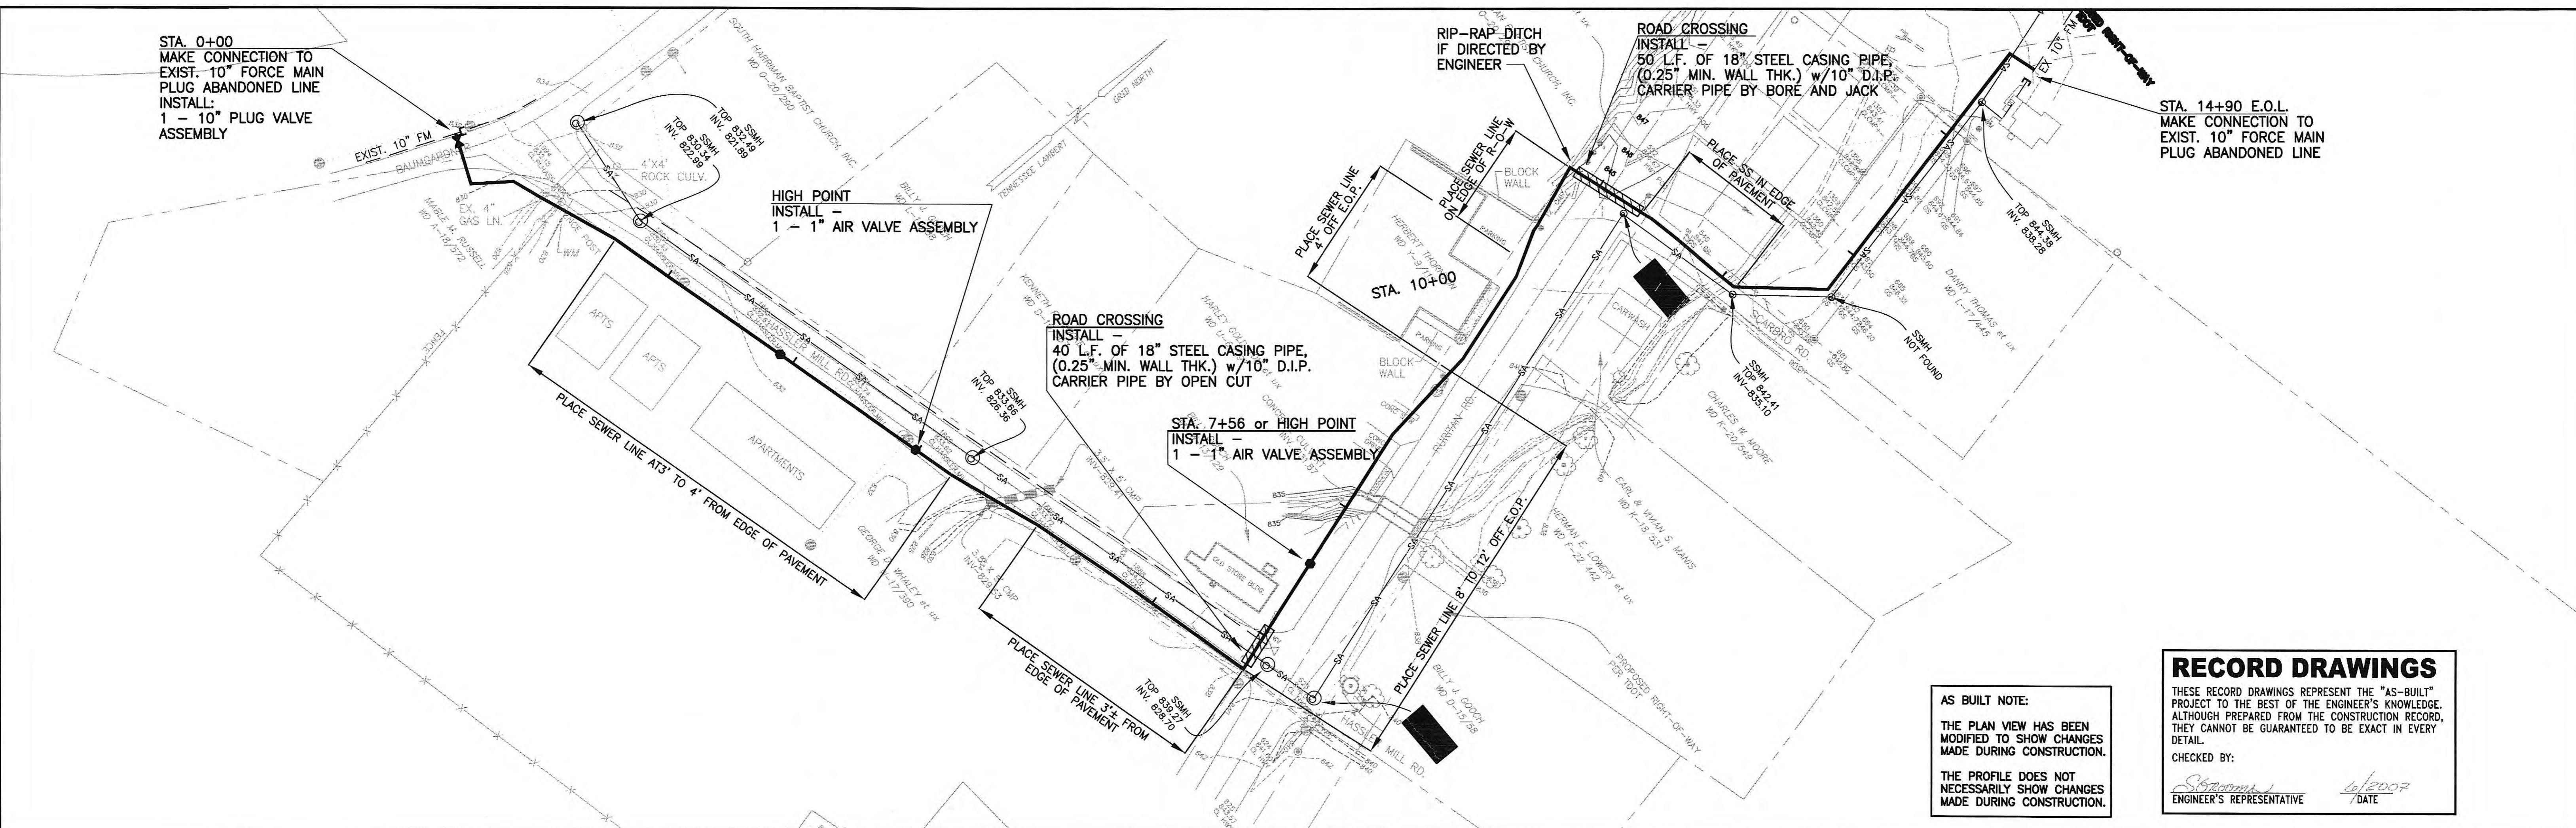

CALL BEFORE YOU DIG
800-892-0112 • www.digbydig.org



IN
TENNESSEE
CALL
1 - 800 - 351-1111
Y'S BEFORE YOU DIG

NOTES:
1. FORCE MAIN BASE DRAWING PROVIDED BY CITY OF HARRISBURG.
DRAWING BY WILLIAM B. STEELMAN, TN LIC. # 1831. DRAWING NO. 835ASBLT.

PLAN VIEW GRAPHIC SCALE
0 25 50 1
1 inch = 50 feet H
Profile: 1 inch = 5 feet

1	REVISED FORCE MAIN ROUTE MOVED GRAVITY SEWER TO SHEET 11	9/04	D
NO.	DESCRIPTION	DATE	B
	REVISIONS		

**WOODY STREET FORCE MAIN
STA. 0+00 TO STA. 14+90 E.O.L.
HARRIMAN UTILITY BOARD
HARRIMAN, TENNESSEE**

The logo consists of the letters "GRW." in a bold, black, stylized font. The "G" is a large circle with a horizontal bar through it, the "R" is a vertical rectangle with a diagonal cut, and the "W" has a curved top and a vertical bottom.


GRW Elrod Dunson, Inc.

Engineers, Architects, Planners



LEXINGTON LOUISVILLE NASHVILLE KNOXVILLE

INDIANAPOLIS FORT MITCHELL ARLINGTON

AUGUST, 2004
SCALE:
AS NOTED
SHEET NO.
C-10

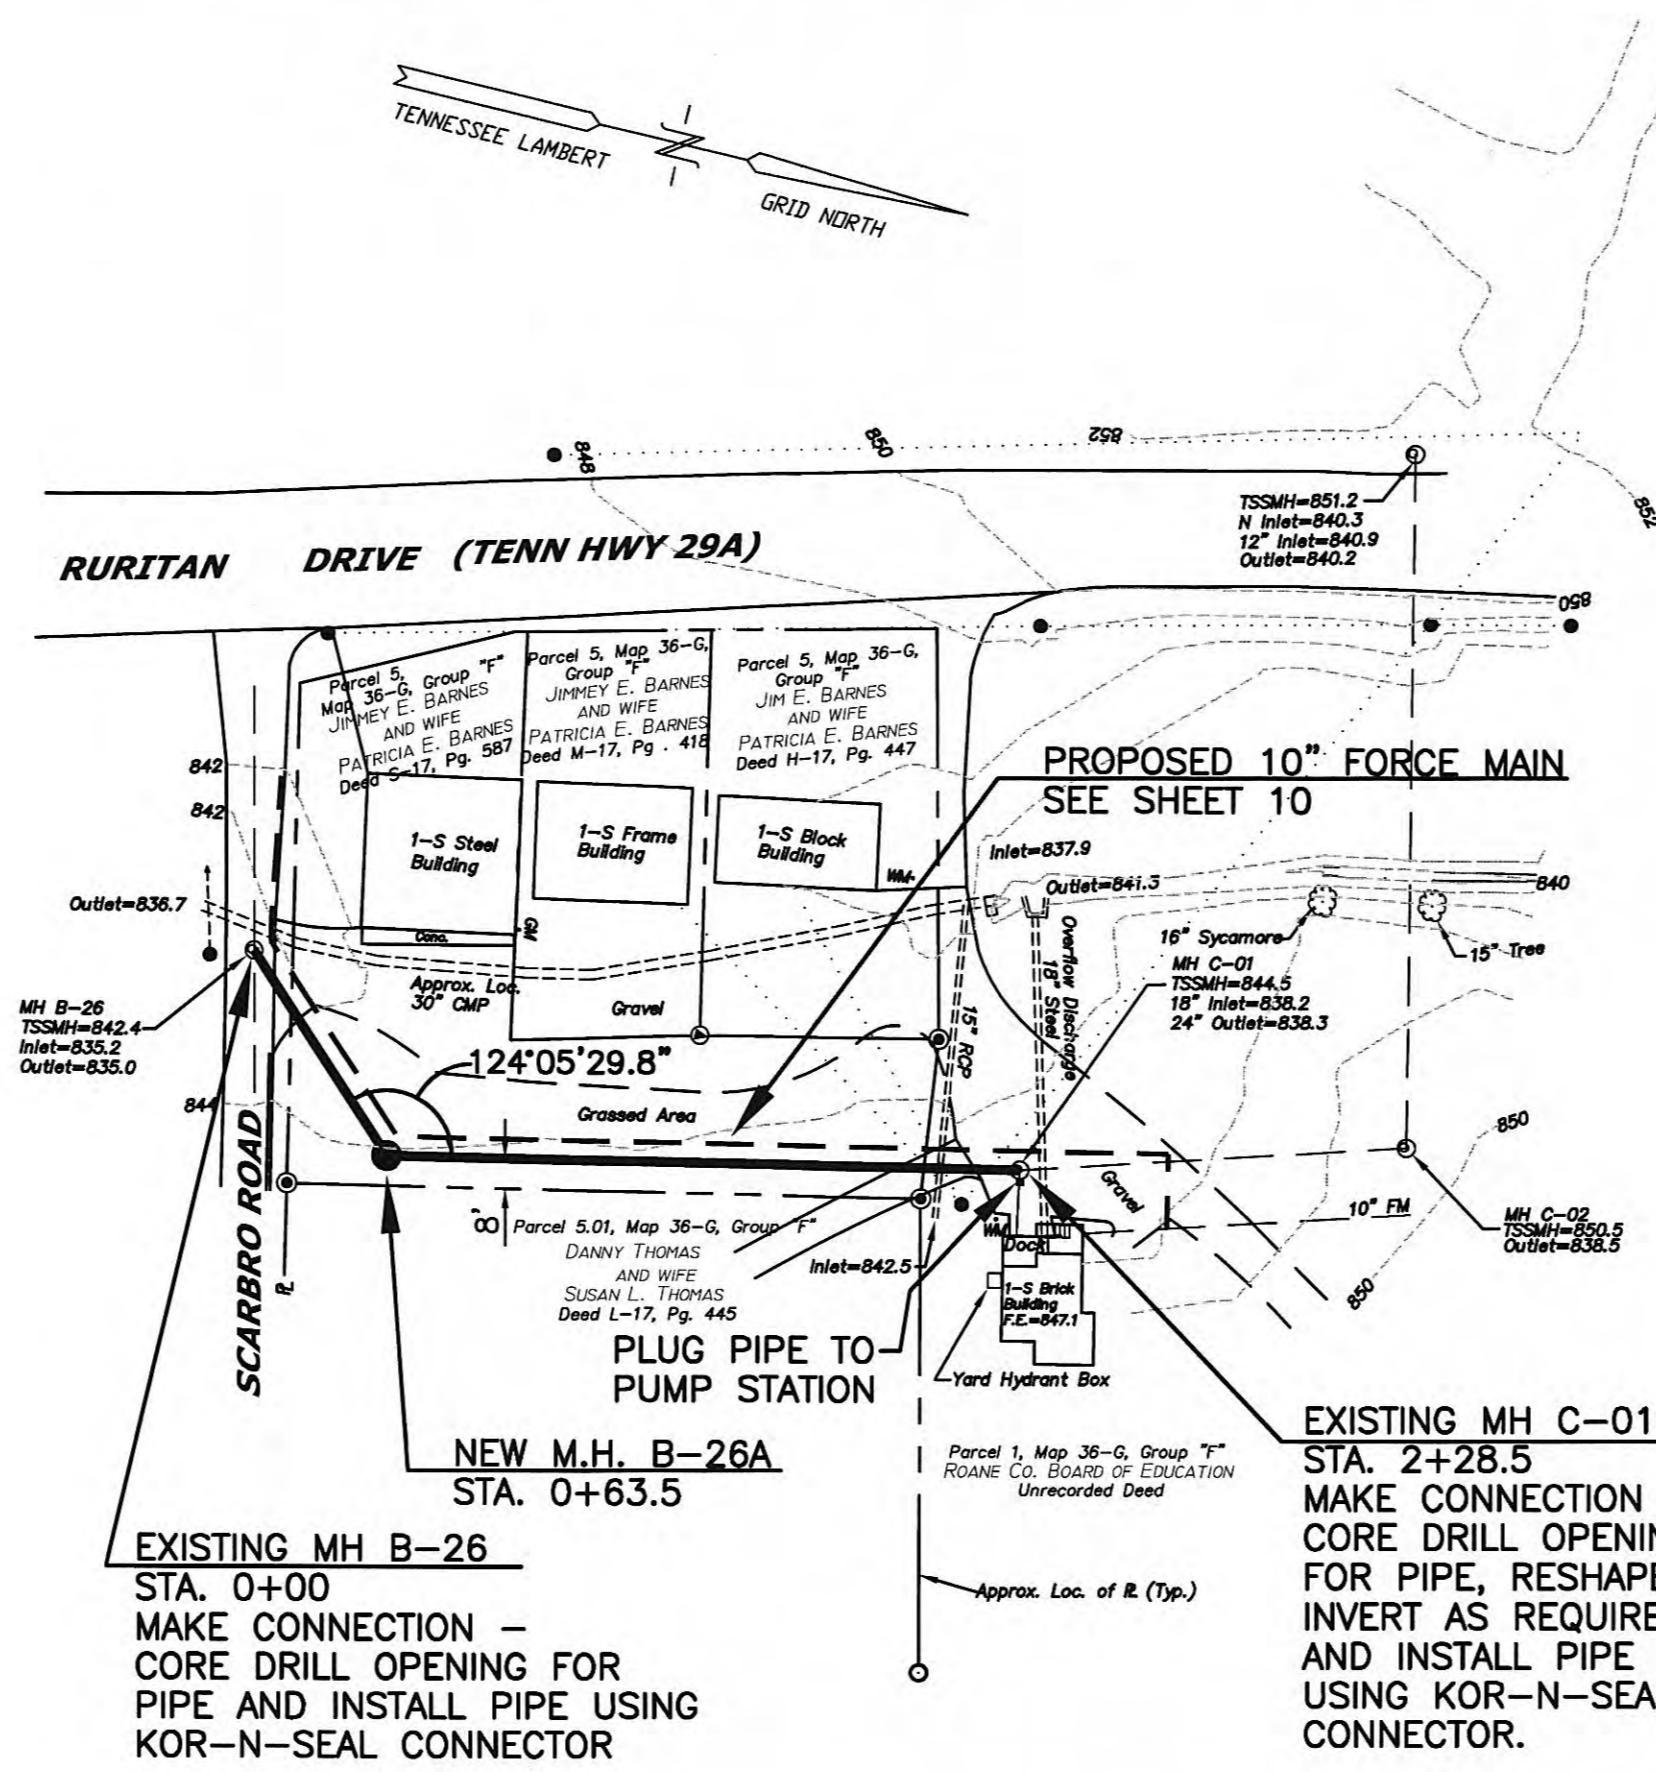

RECORD DRAWINGS
 THESE RECORD DRAWINGS REPRESENT THE "AS-BUILT" PROJECT TO THE BEST OF THE ENGINEER'S KNOWLEDGE. ALTHOUGH PREPARED FROM THE CONSTRUCTION RECORD, THEY CANNOT BE GUARANTEED TO BE EXACT IN EVERY DETAIL.
 CHECKED BY:
 [Signature] 6/2002
 ENGINEER'S REPRESENTATIVE
 DATE

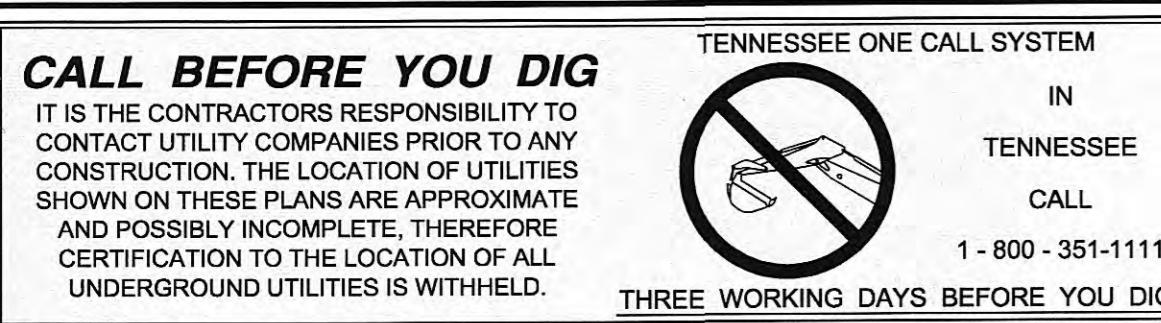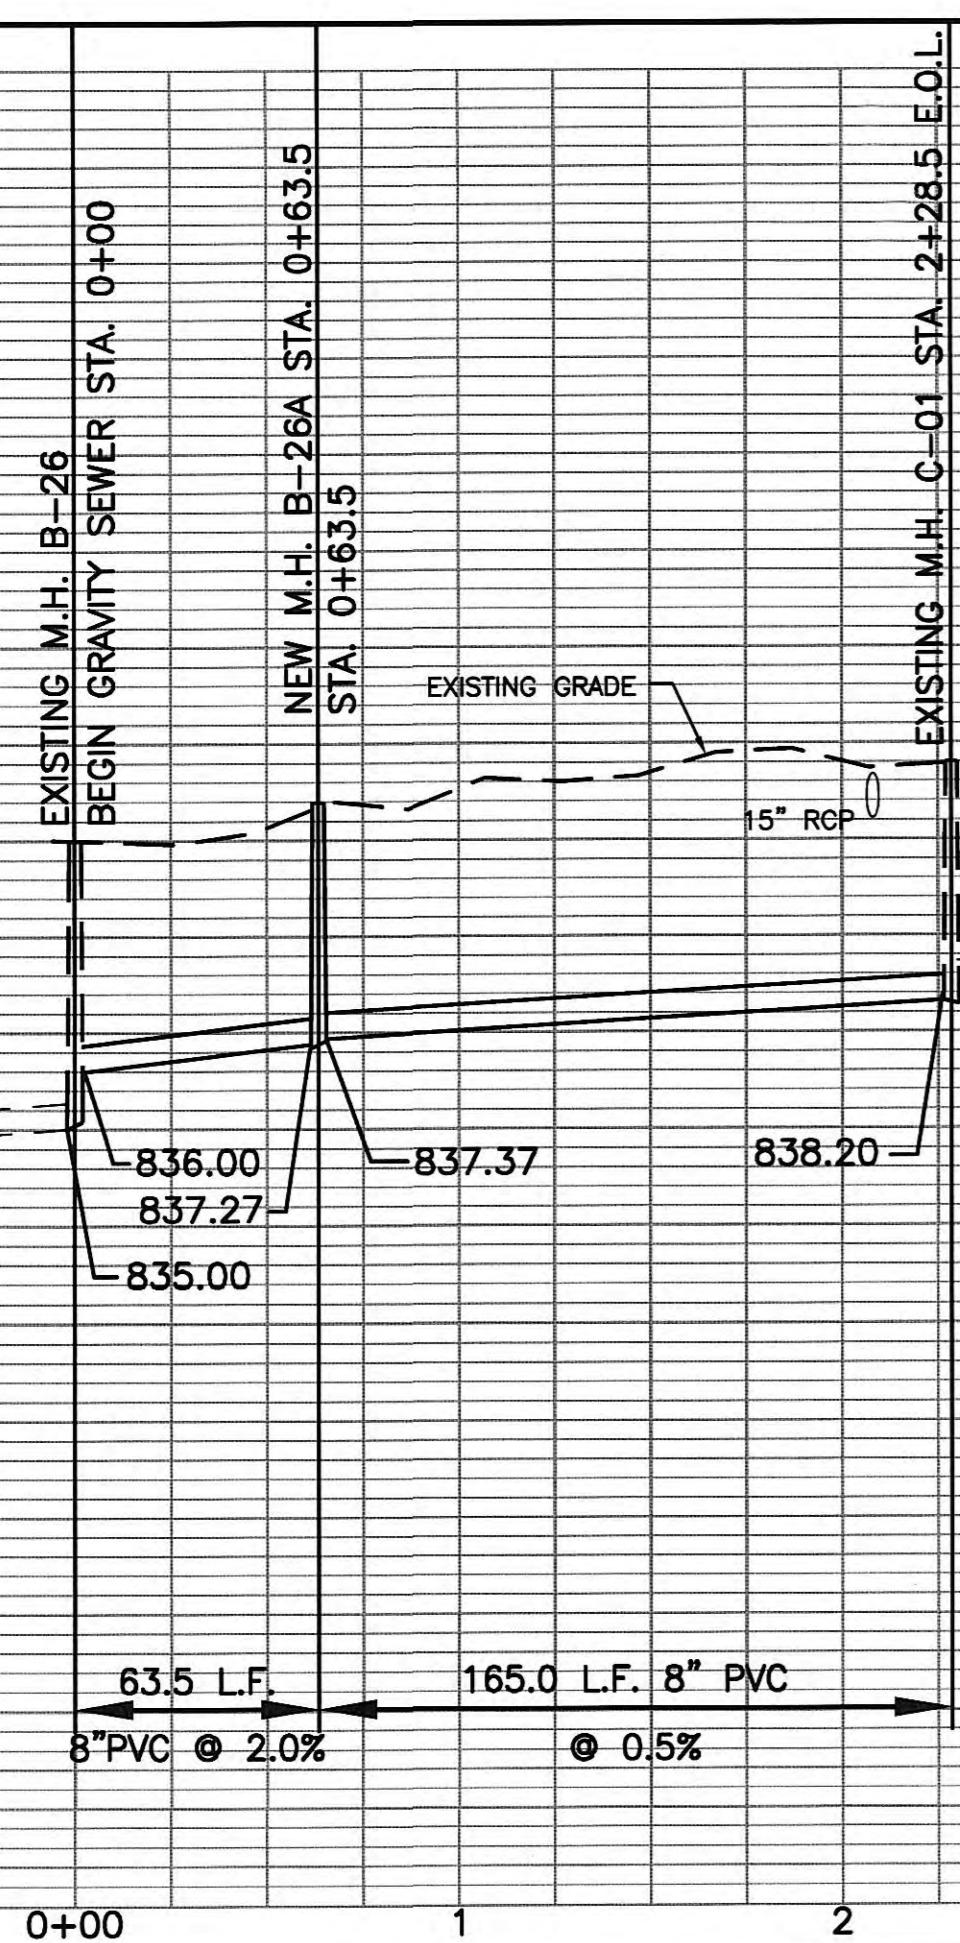

NOTES:
 1. GRAVITY SEWER BASE, DWG BY LACKEY AND ASSOC.
 DRAWING NO. 01-724.

PLAN VIEW GRAPHIC SCALE
 0 25 50 100
 1 inch = 50 feet Horz.
 Profile: 1 inch = 5 feet Vert.
























ALL RIGHTS RESERVED.
 THIS DOCUMENT IS THE PROPERTY OF GRW ELROD DUNSON, INC.
 AND SHALL NOT BE REPRODUCED IN WHOLE OR IN PART OR
 USED FOR CONSTRUCTION OF OTHER THAN THIS SPECIFIC PROJECT
 WITHOUT WRITTEN PERMISSION OF GRW ELROD DUNSON, INC.


1	MOVED GRAVITY SEWER TO SHEET 11	9/04	DM
NO.	DESCRIPTION	DATE	BY
	REVISIONS		

SCARBRO ROAD GRAVITY SEWER -
 STA. 0+0 TO STA. 2+28.5 E.O.L.
 HARRIMAN UTILITY BOARD
 HARRIMAN, TENNESSEE

GRW PROJECT NO. 7601-30 CONTRACT S02-03

DESIGNED: AUGUST, 2004
 DRAWN: SCALE: AS NOTED
 DM
 REVIEWED: SHEET NO.
 RGT
 APPROVED: C-11
 RGT
 GRW Elrod Dunson, Inc.
 Engineers, Architects, Planners
 LEXINGTON LOUISVILLE NASHVILLE KNOXVILLE
 INDIANAPOLIS PORT MITCHELL ARLINGTON

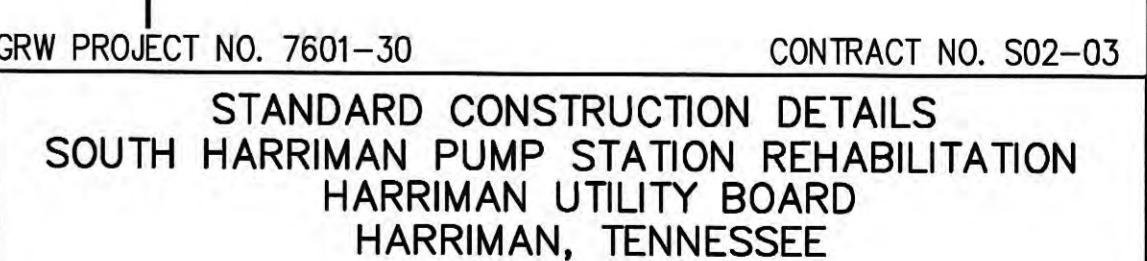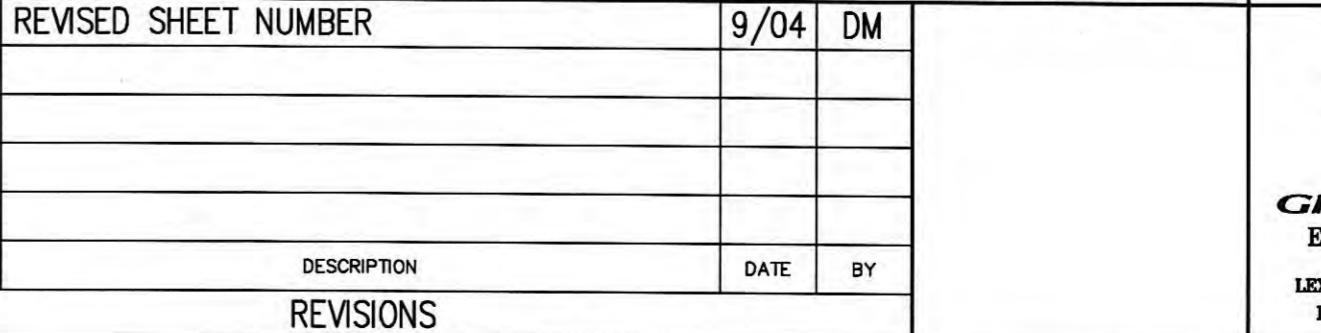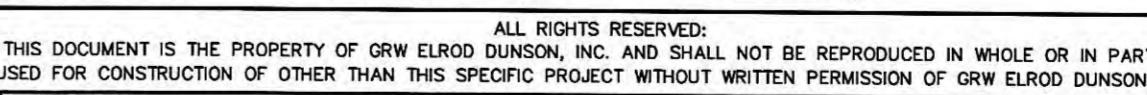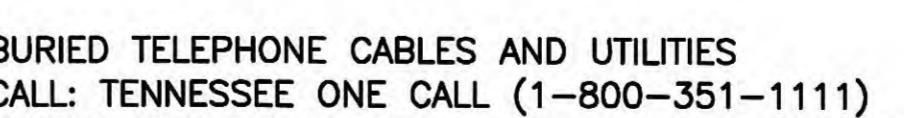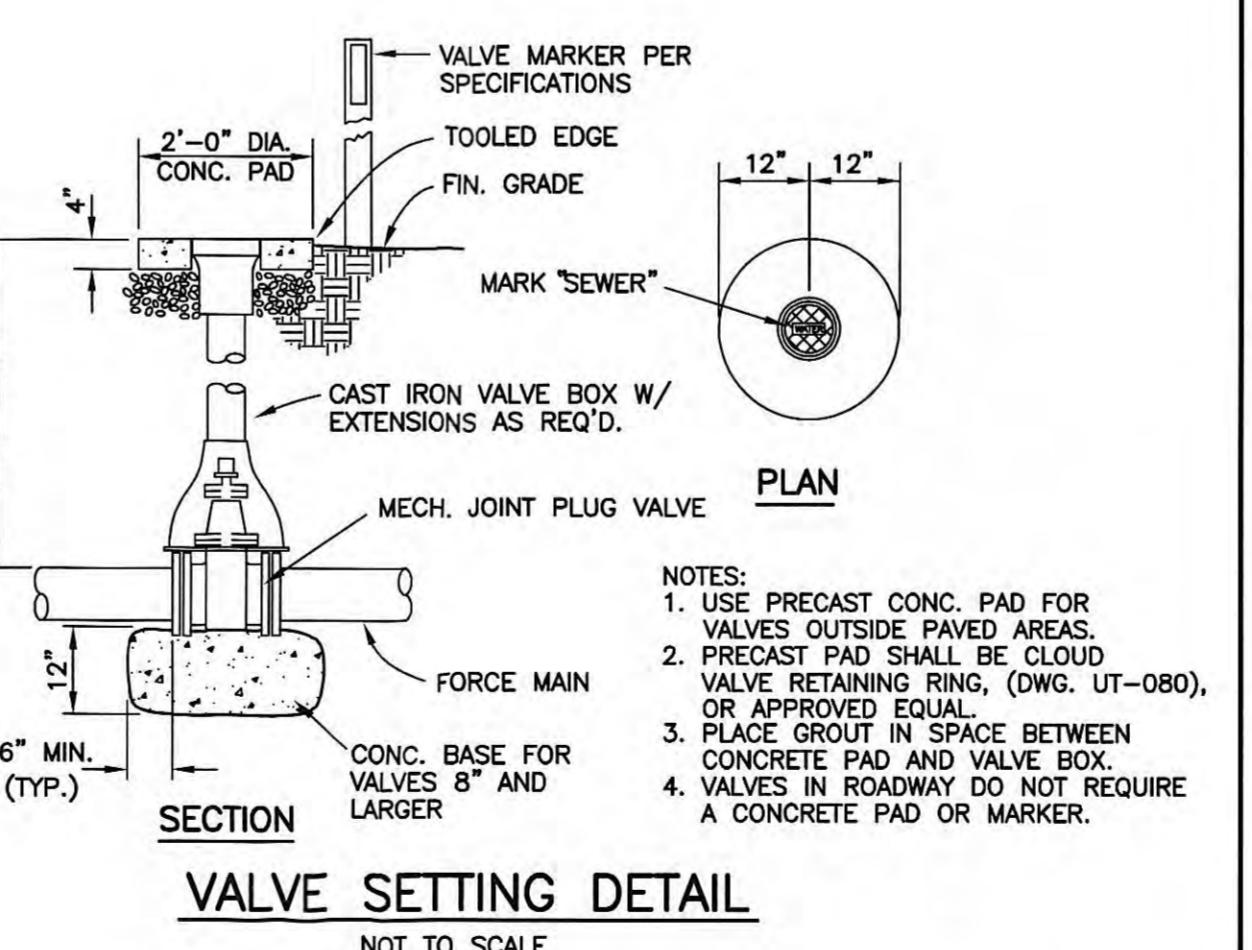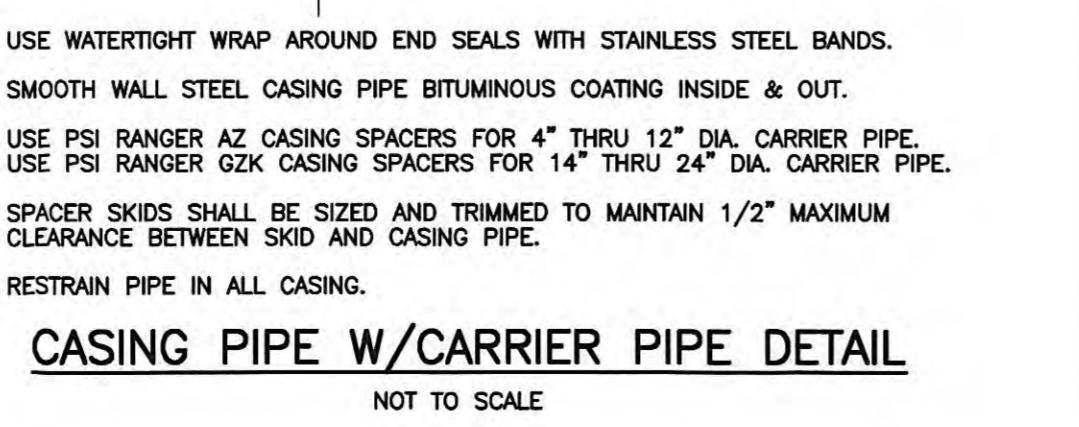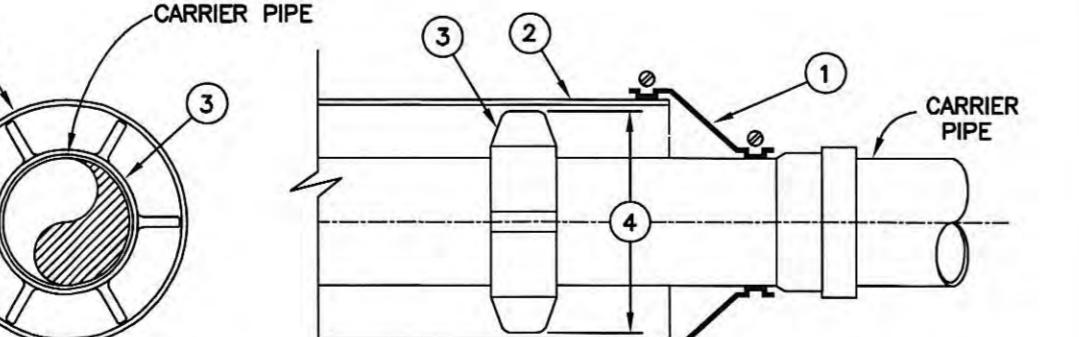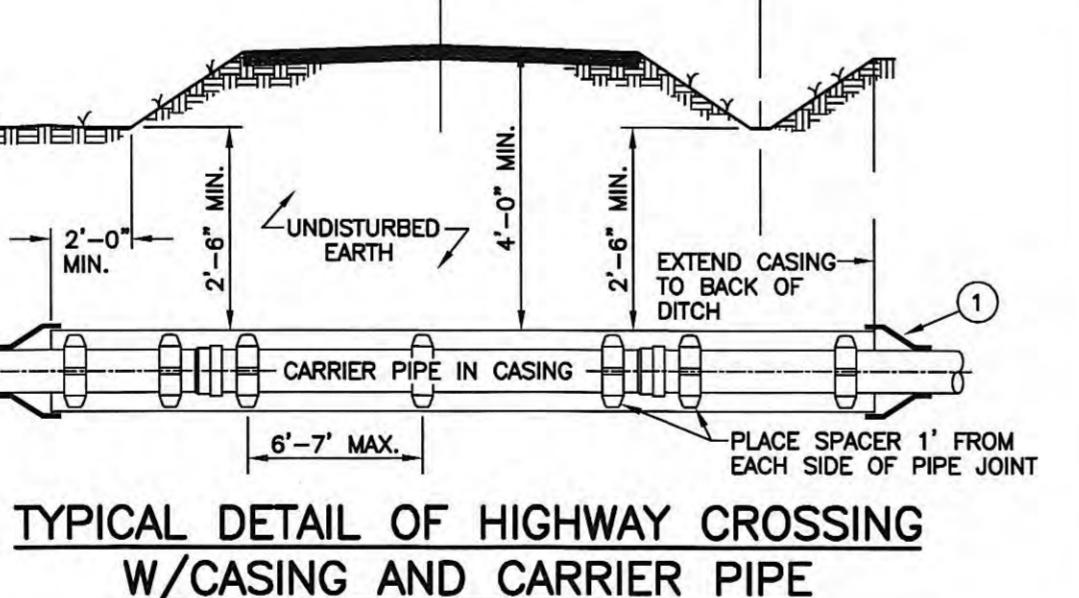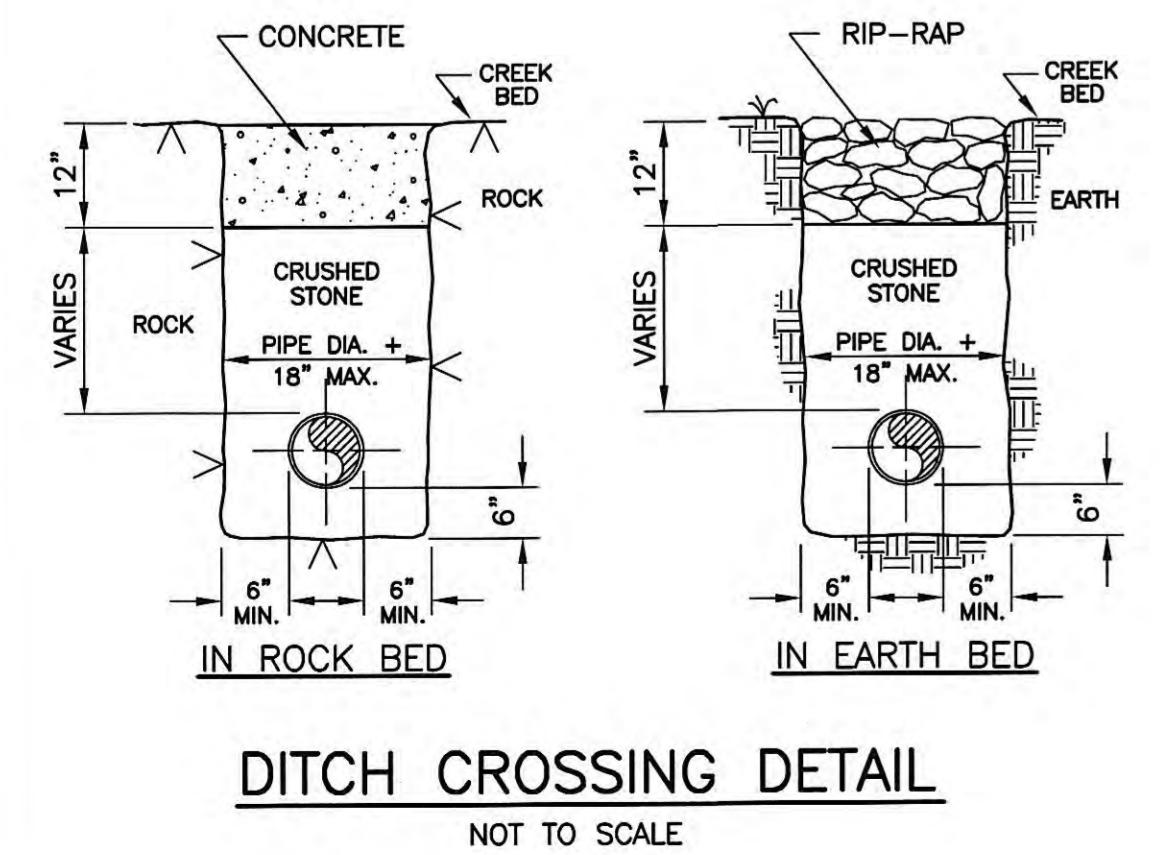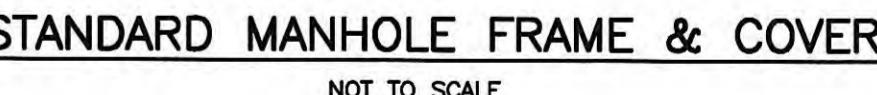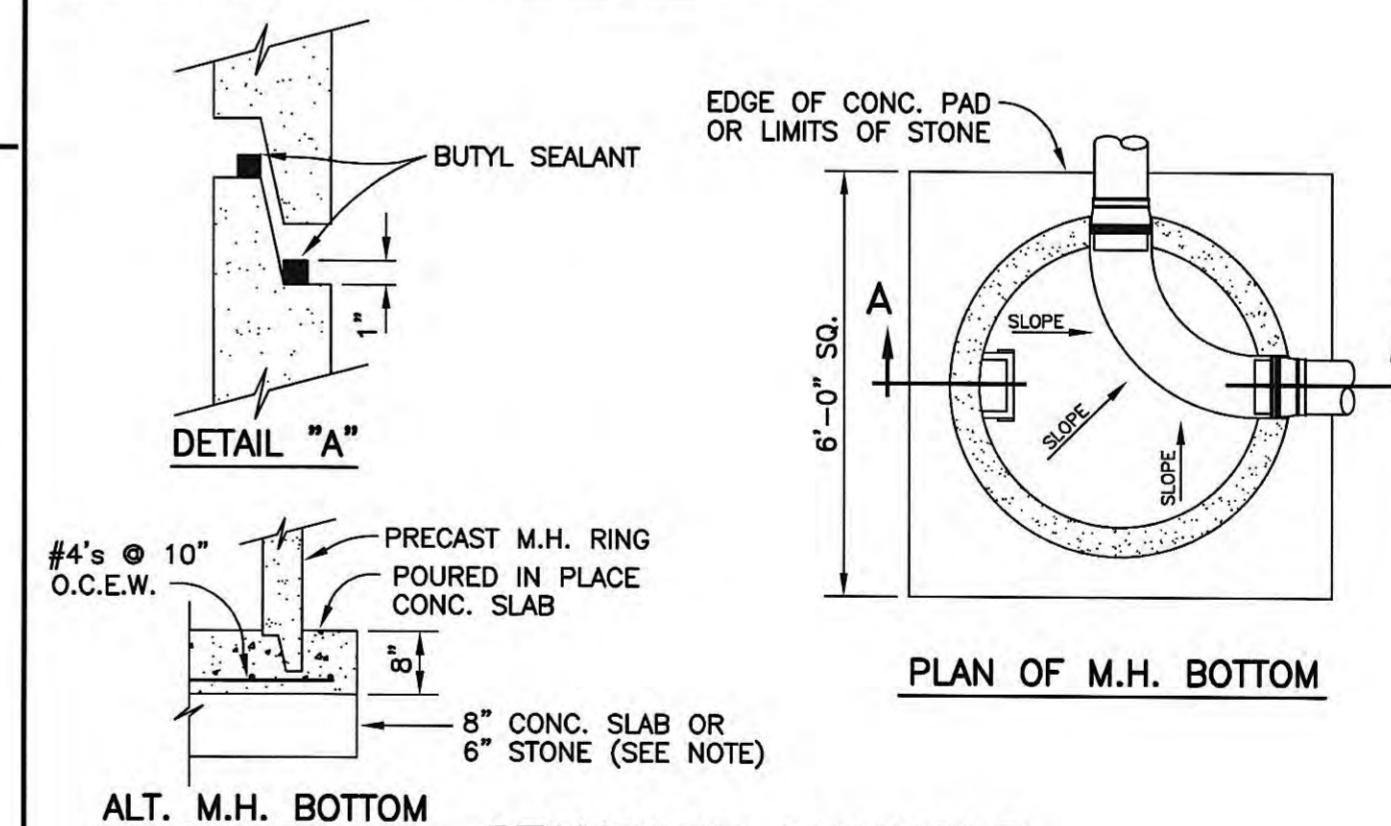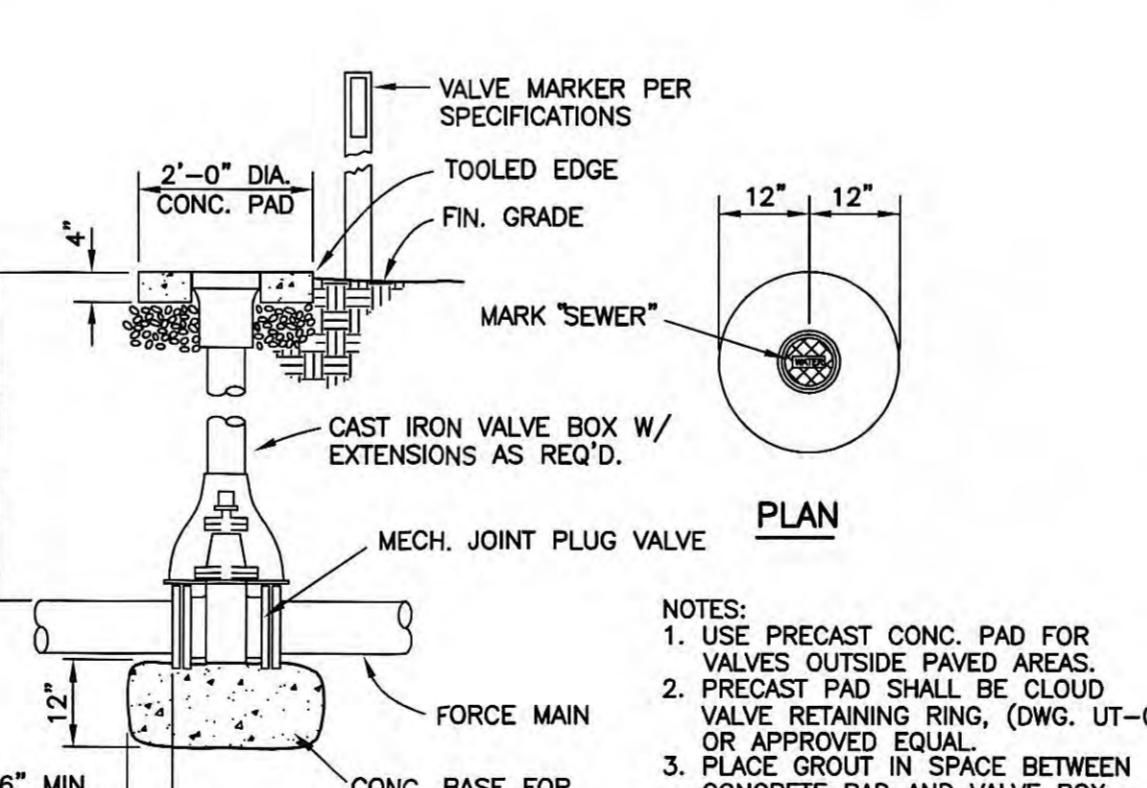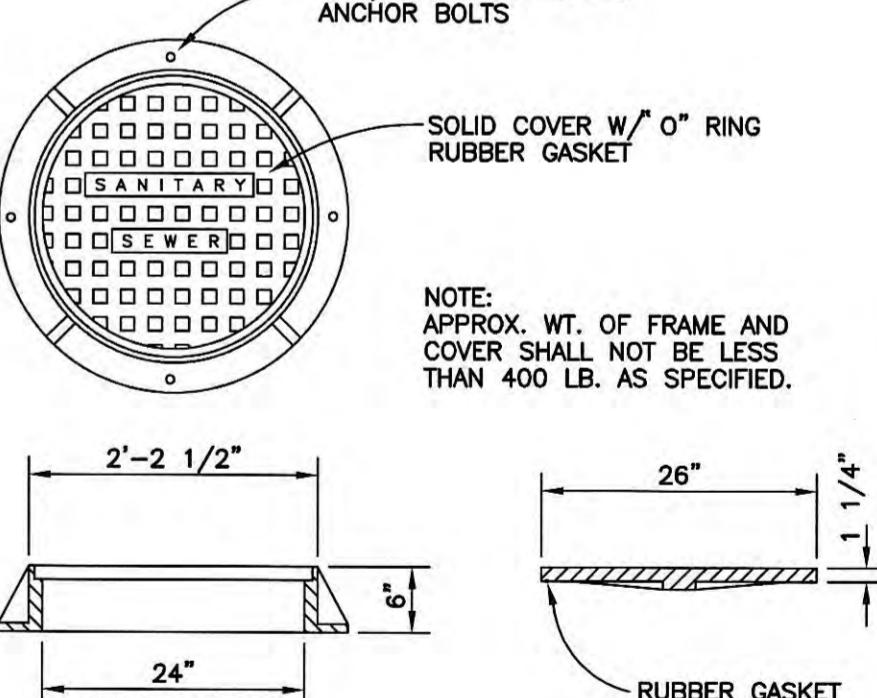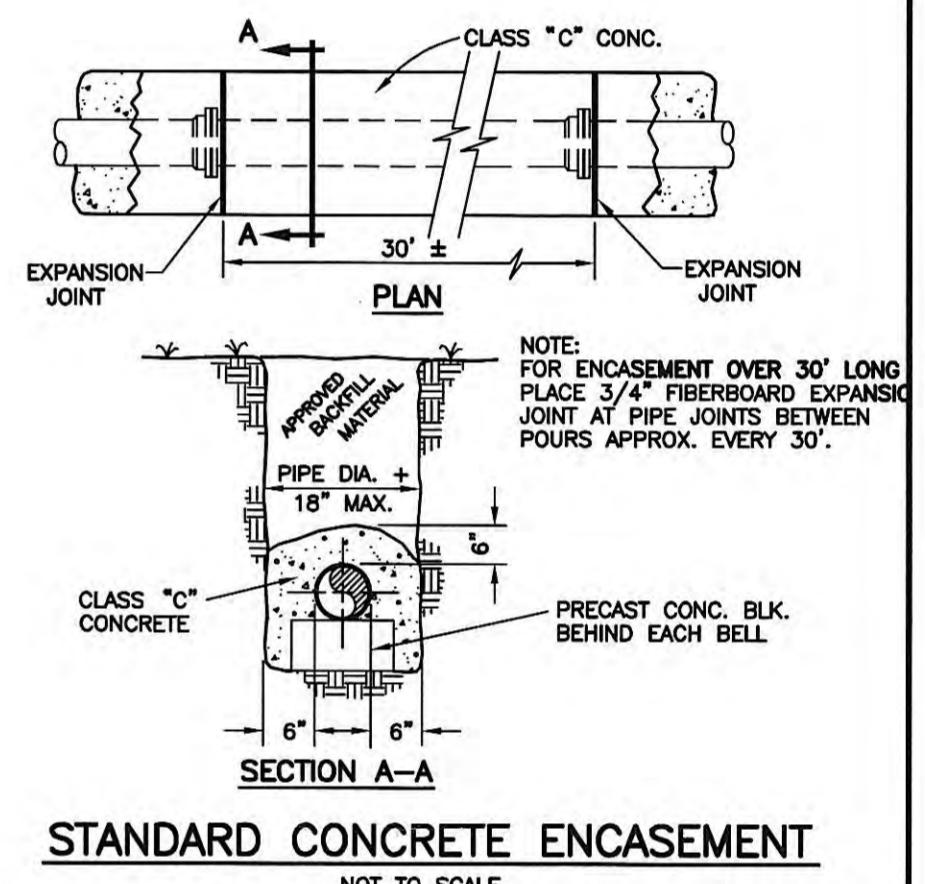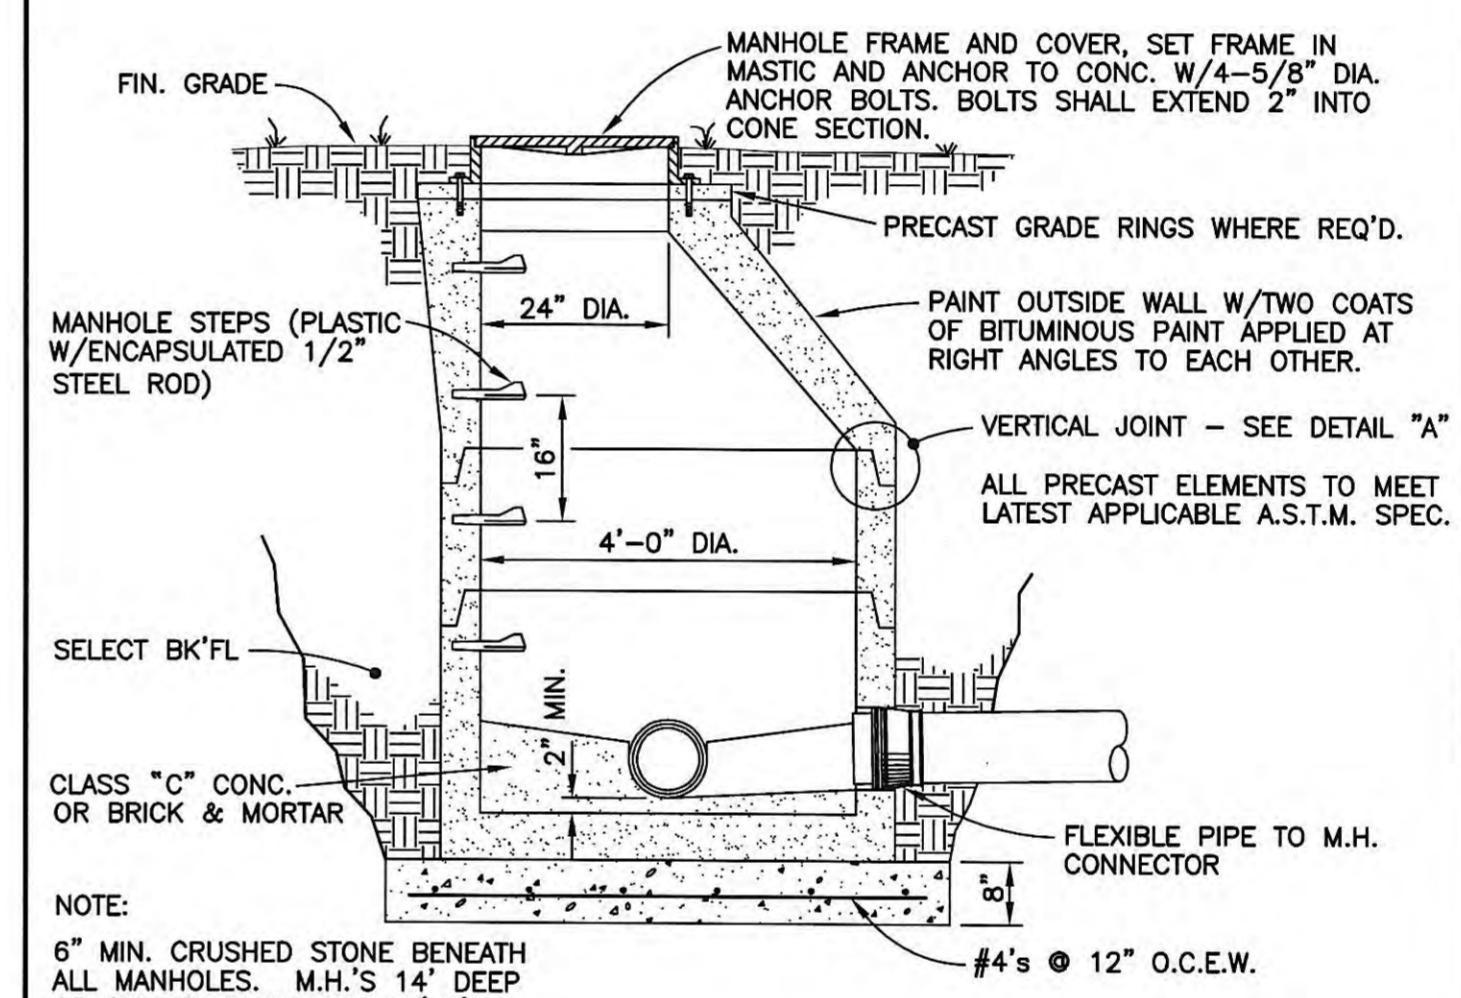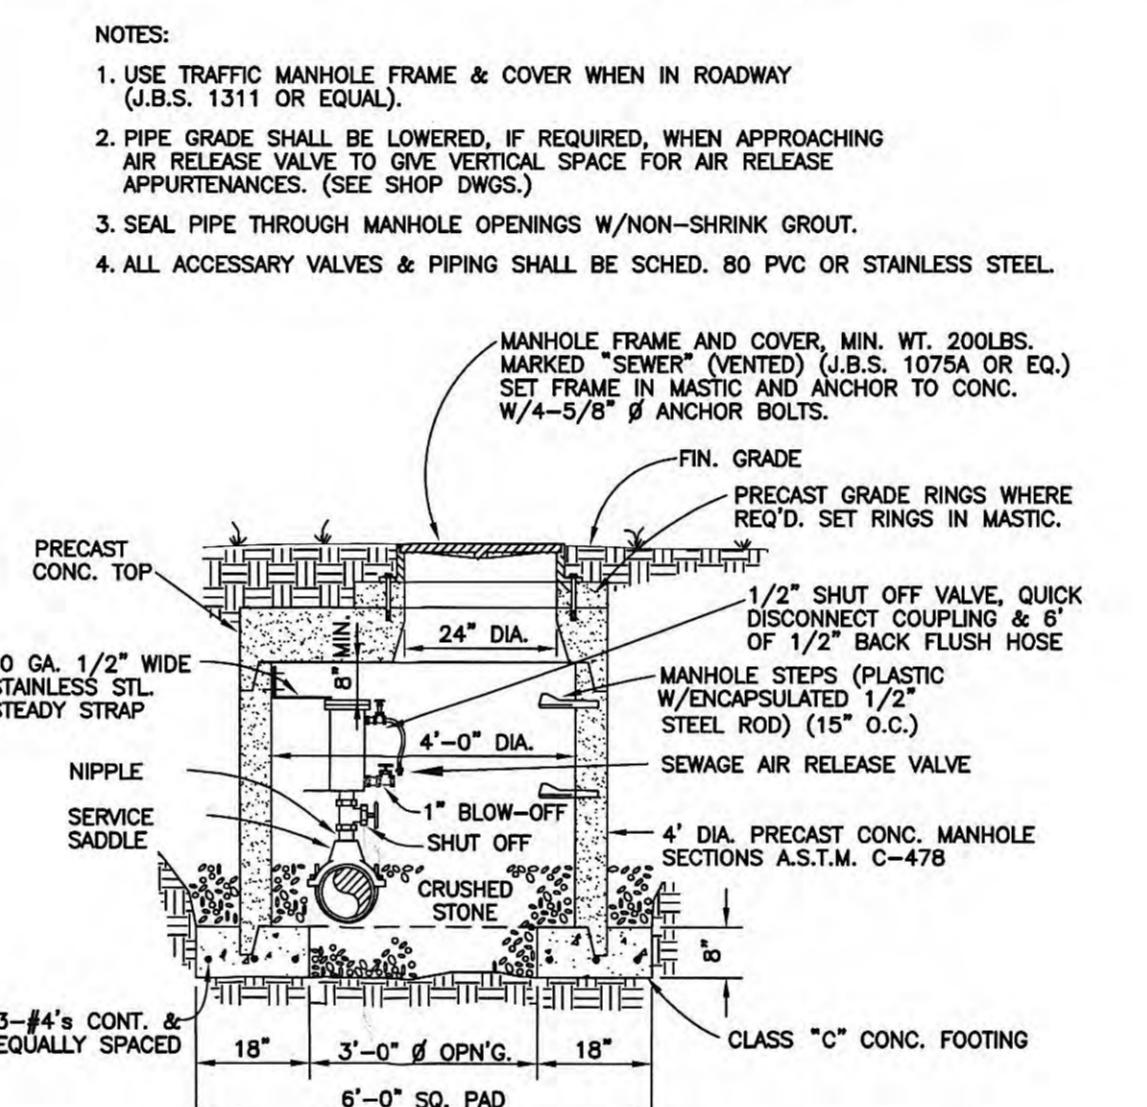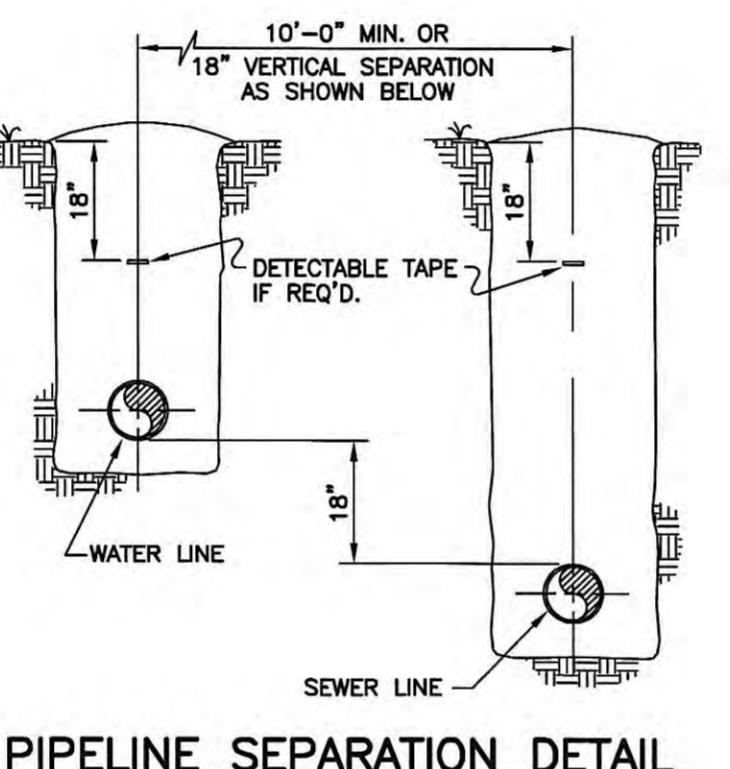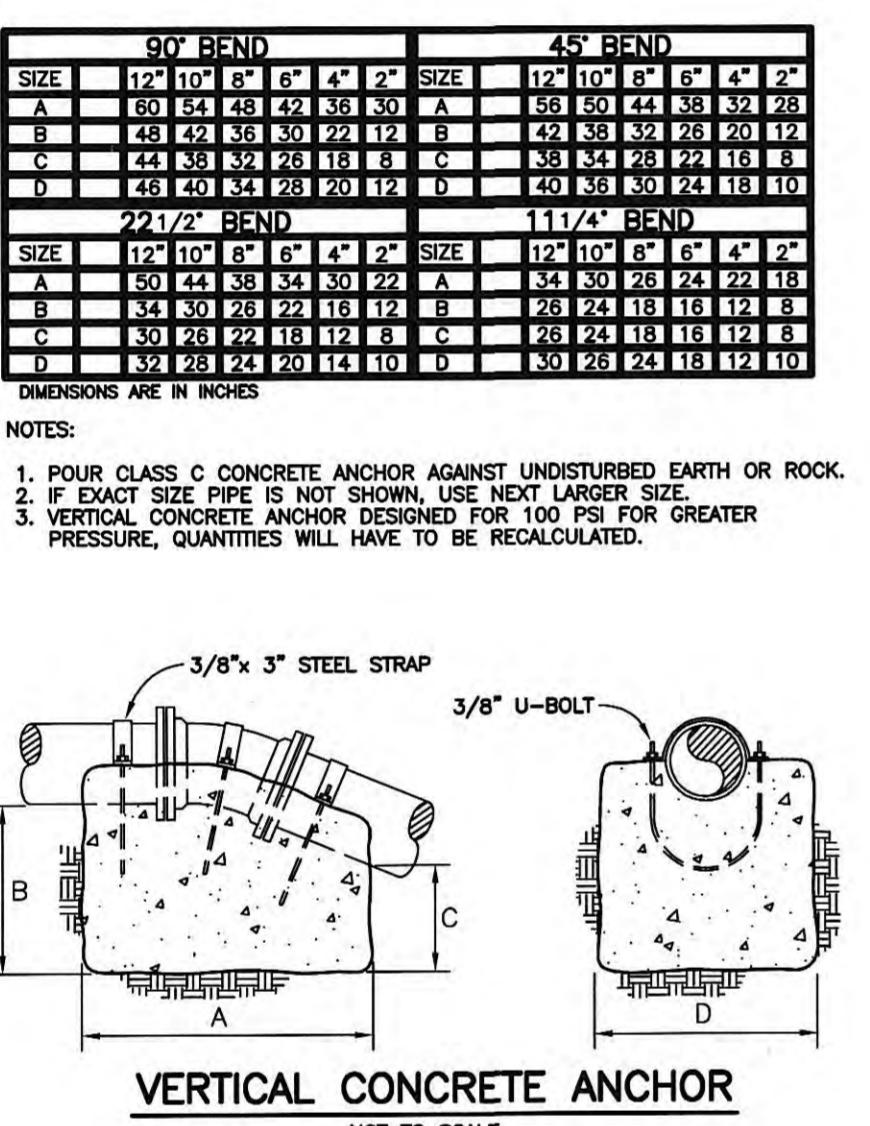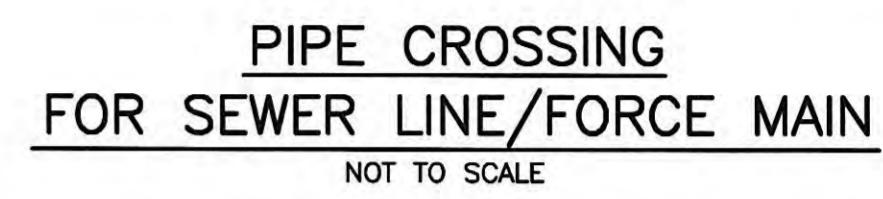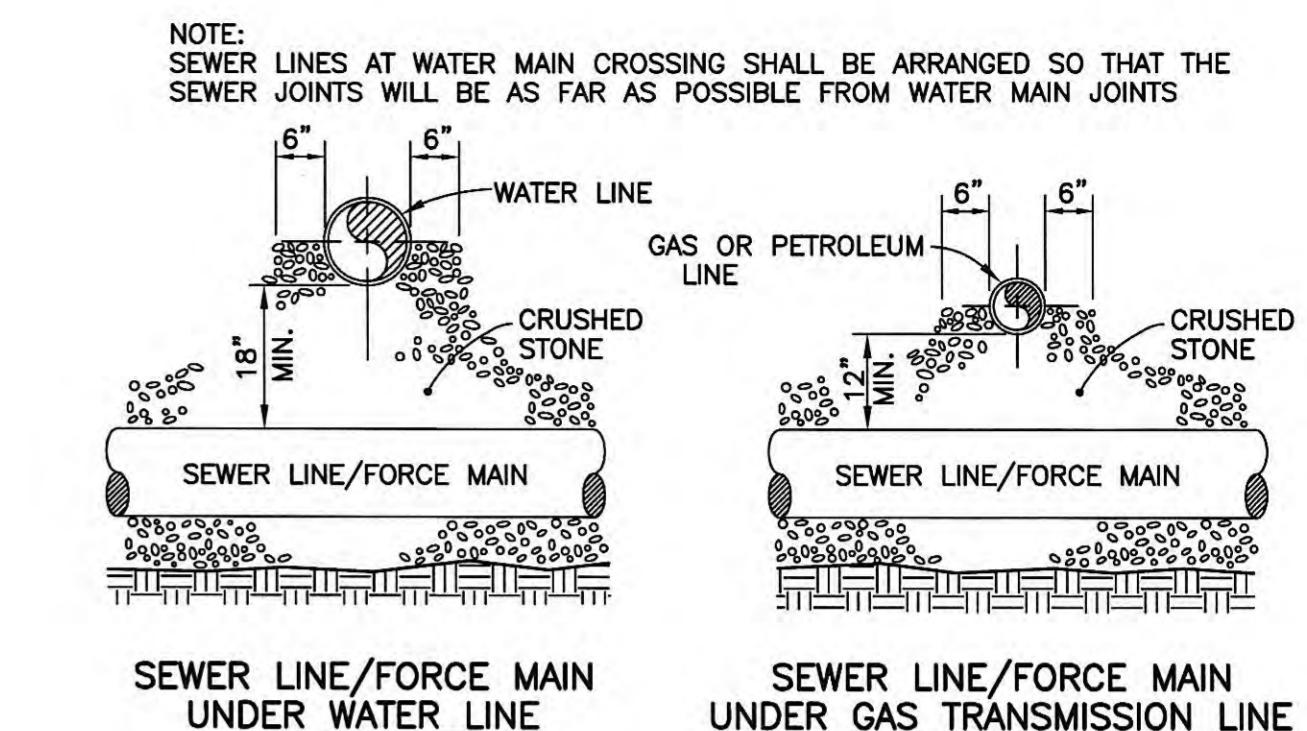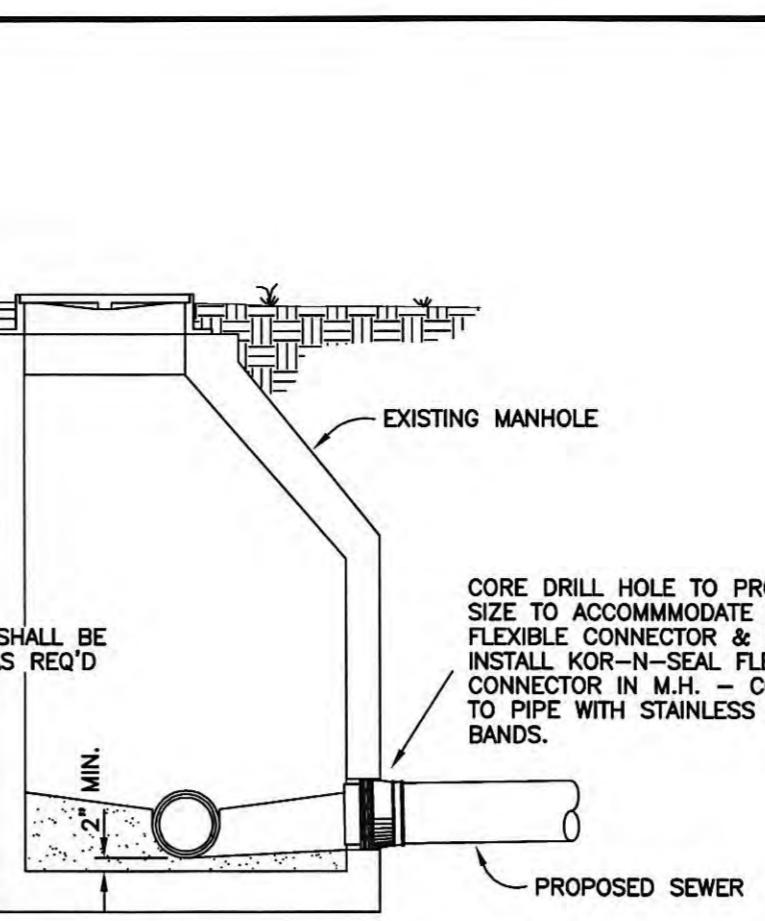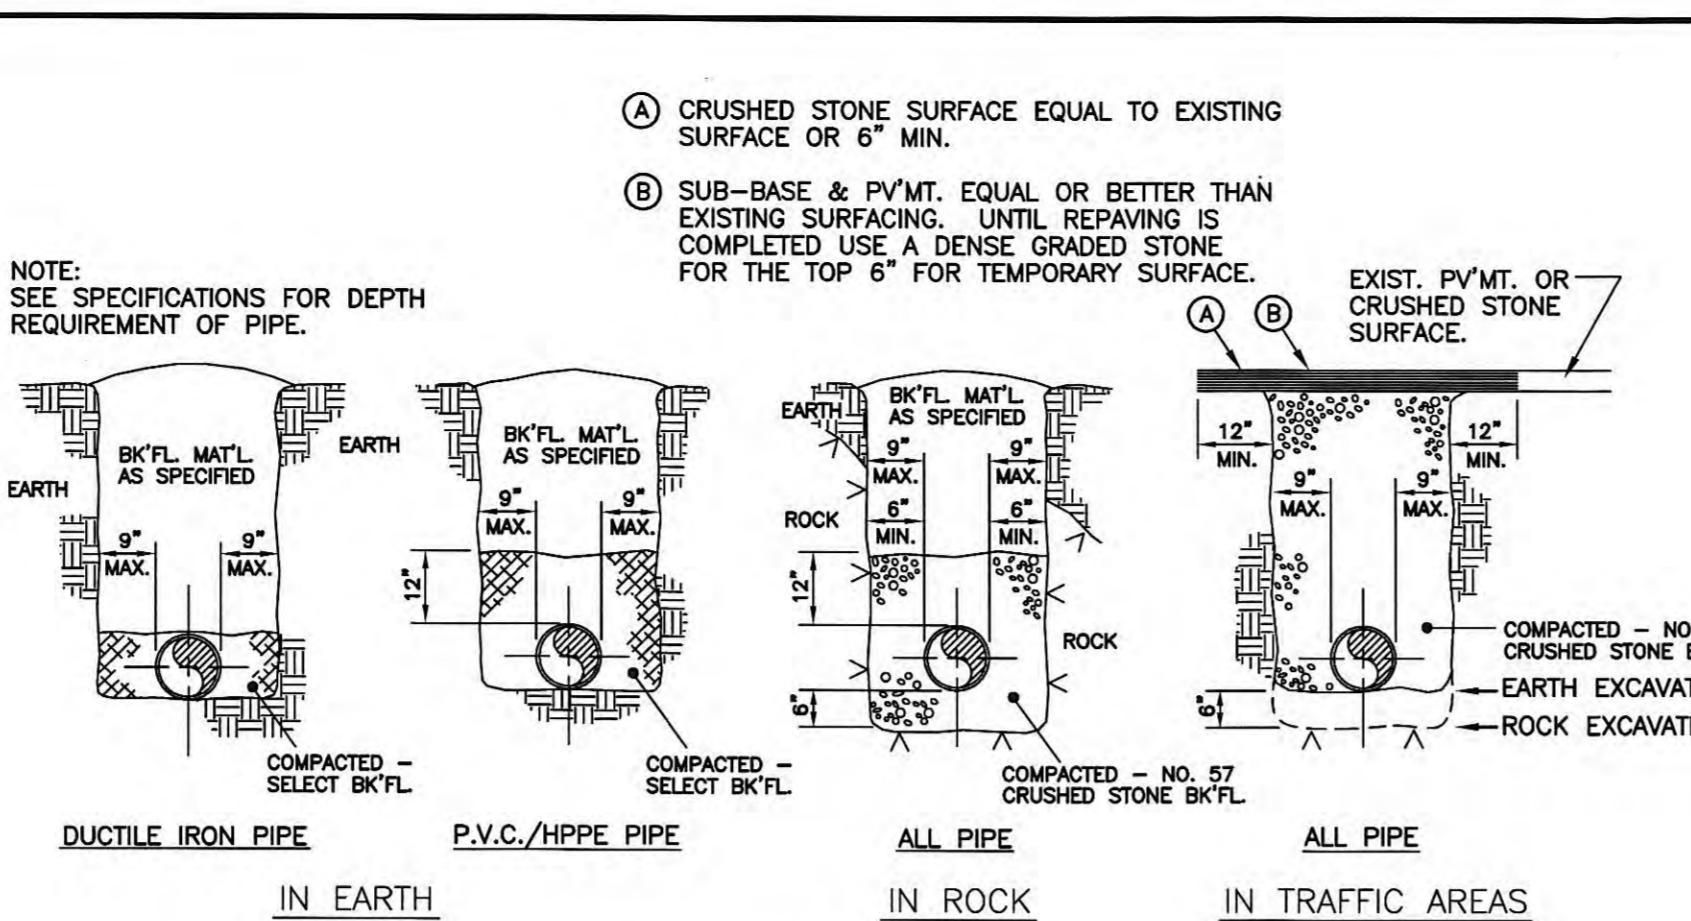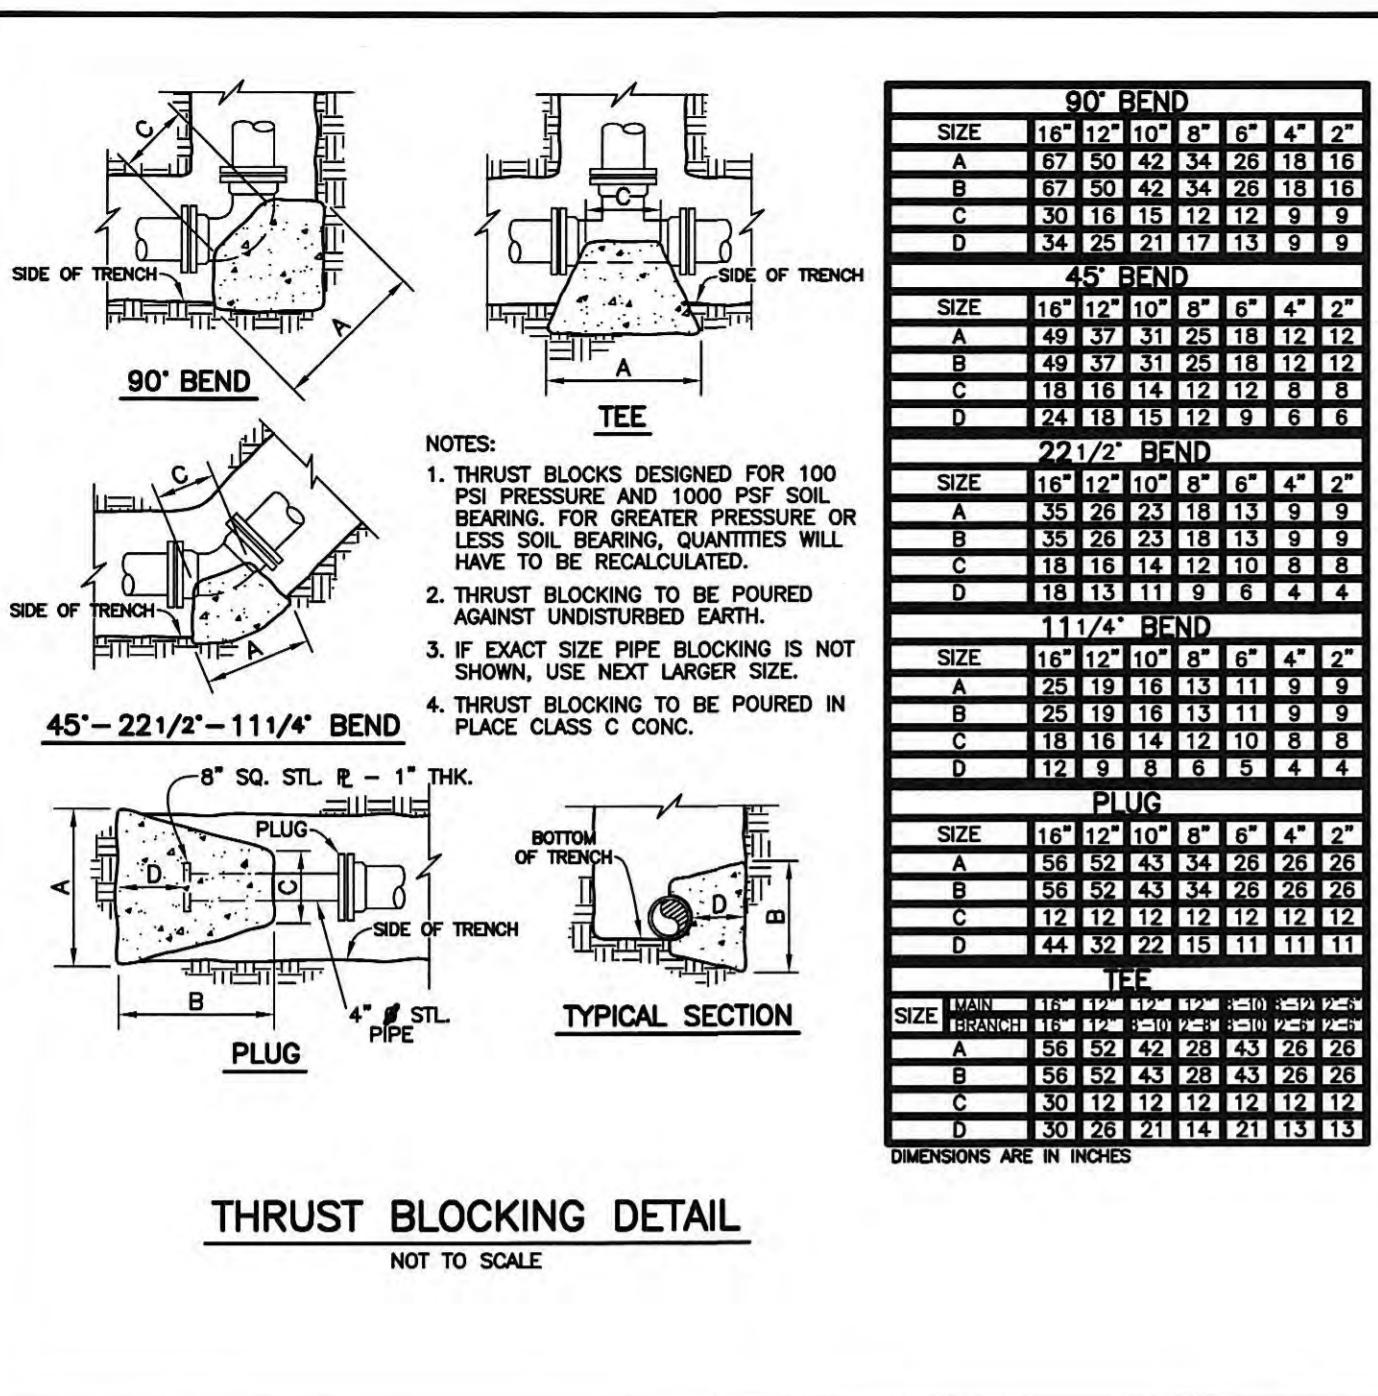

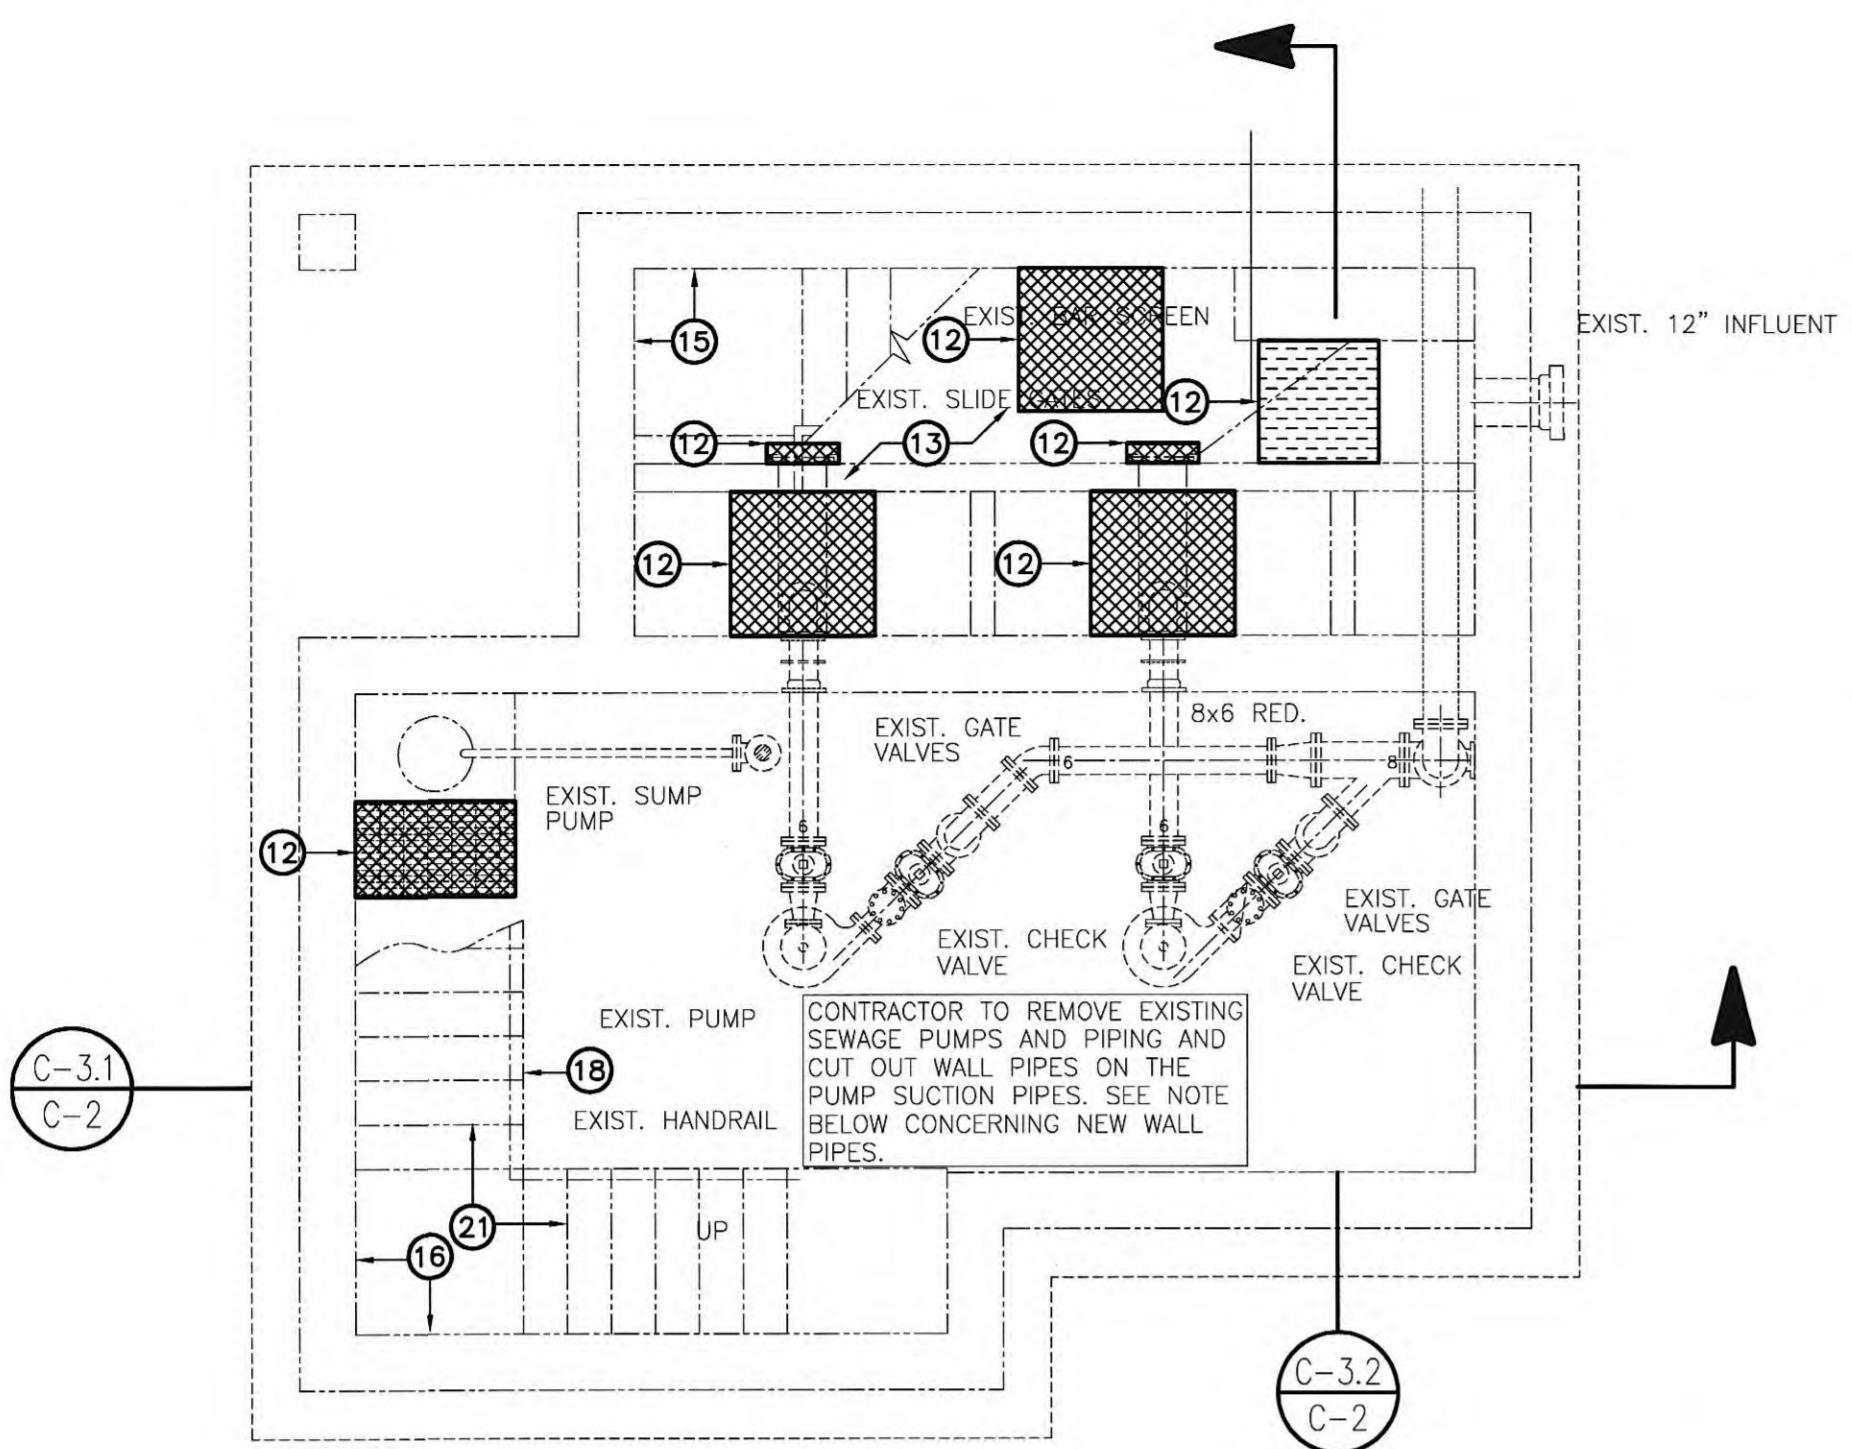


FLOOR PLAN – PUMP LEVEL

SCALE: 1/4" = 1'-0"

- ## **CONTRACTOR NOTES:**
1. CONTRACTOR SHALL BE RESPONSIBLE FOR BYPASS PUMPING WHILE REHABILITATING PUMP STATION. THIS INCLUDES ANY REQUIRED CONNECTIONS TO INFLUENT AND DISCHARGE LINES. HUB WILL PROVIDE THE REQUIRED ELECTRICAL SERVICE FOR BYPASS PUMPING.
 2. THE OWNER SHALL HAVE FIRST SALVAGE RIGHTS TO ALL EXISTING VALVES, PIPING AND EQUIPMENT. IF THE OWNER REJECTS SALVAGED MATERIALS, THE CONTRACTOR SHALL PROVIDE FINAL DISPOSAL OF ALL ITEMS.
 3. CONTRACTOR TO CLEAN AND PAINT PIPING AND WALLS. WALLS INCLUDE ENTRANCE LEVEL: ELECTRICAL AREA AND PUMP LEVEL: PUMP AND PIPING AREA.
- ## **KEYNOTES:**
- ① REMOVE EXISTING DOOR AND FRAME. PROVIDE NEW OUT SWINGING DOOR WITH NEW FRAME. VERIFY MASONRY OPENING.
 - ② REMOVE EXISTING ROOF MATERIAL DOWN TO CONC. DECK. PROVIDE NEW EPDM ROOFING, INSULATION, AND FLASHING.
 - ③ ROOF LINE ABOVE.
 - ④ EXISTING GUTTER TO BE REPLACED.
 - ⑤ INSTALL NEW 4"x4" MTL. DOWNSPOUT.
 - ⑥ EXISTING EQUIPMENT TO BE REMOVED- SEE MECHANICAL.
 - ⑦ NEW MECHANICAL DUCT. FLASH AS REQ'D.
 - ⑧ EXISTING ROOF HATCH TO BE REMOVED
 - ⑨ WALL BELOW
 - ⑩ EXISTING LADDER TO BE REMOVED.
 - ⑪ EXISTING HANDRAIL TO BE REPLACED.
 - ⑫ EXISTING GRATING TO BE REPLACED.
 - ⑬ NEW TOPPING SLAB.
 - ⑭ EXISTING WINDOW TO BE REPLACED.


KEYNOTES

- (1) REMOVE EXISTING DOOR AND FRAME. PROVIDE NEW OUT SWINGING DOOR WITH NEW FRAME. VERIFY MASONRY OPENING.
 - (2) REMOVE EXISTING ROOF MATERIAL DOWN TO CONCRETE DECK. PROVIDE NEW EPDM ROOFING, INSULATION AND FLASHING.
 - (3) ROOF LINE ABOVE.
 - (4) EXISTING GUTTER TO BE REPLACED.
 - (5) INSTALL NEW 4"x4" MTL. DOWNSPOUT.
 - (6) EXISTING EQUIPMENT TO BE REMOVED- SEE MECHANICAL.
 - (7) NEW MECHANICAL DUCT. FLASH AS REQ'D.
 - (8) EXISTING ROOF HATCH TO BE REMOVED
 - (9) WALL BELOW
 - (10) EXISTING LADDER TO BE REMOVED.
 - (11) EXISTING HANDRAIL TO BE REPLACED.
 - (12) EXISTING GRATING TO BE REPLACED.
 - (13) NEW TOPPING SLAB.
 - (14) EXISTING WINDOW TO BE REPLACED.
 - (15) EXIST. WALLS TO BE PRESSURE WASHED AND SEALER APPLIED
 - (16) EXIST. WALLS TO BE PRESSURE WASHED AND PAINTED
 - (17) PATCH EXPOSED EXT. CONC. AS REQUIRED
 - (18) EXIST. HANDRAIL TO BE RE-ANCHORED AS REQUIRED WHERE LOOSE -PAINT
 - (19) NEW DOOR AND FRAME TO BE HOLLOW METAL, PAINT TO MATCH FRP DOORS
 - (20) NEW DOOR AND FRAME TO BE FRP
 - (21) REPLACE STAIR NOSINGS

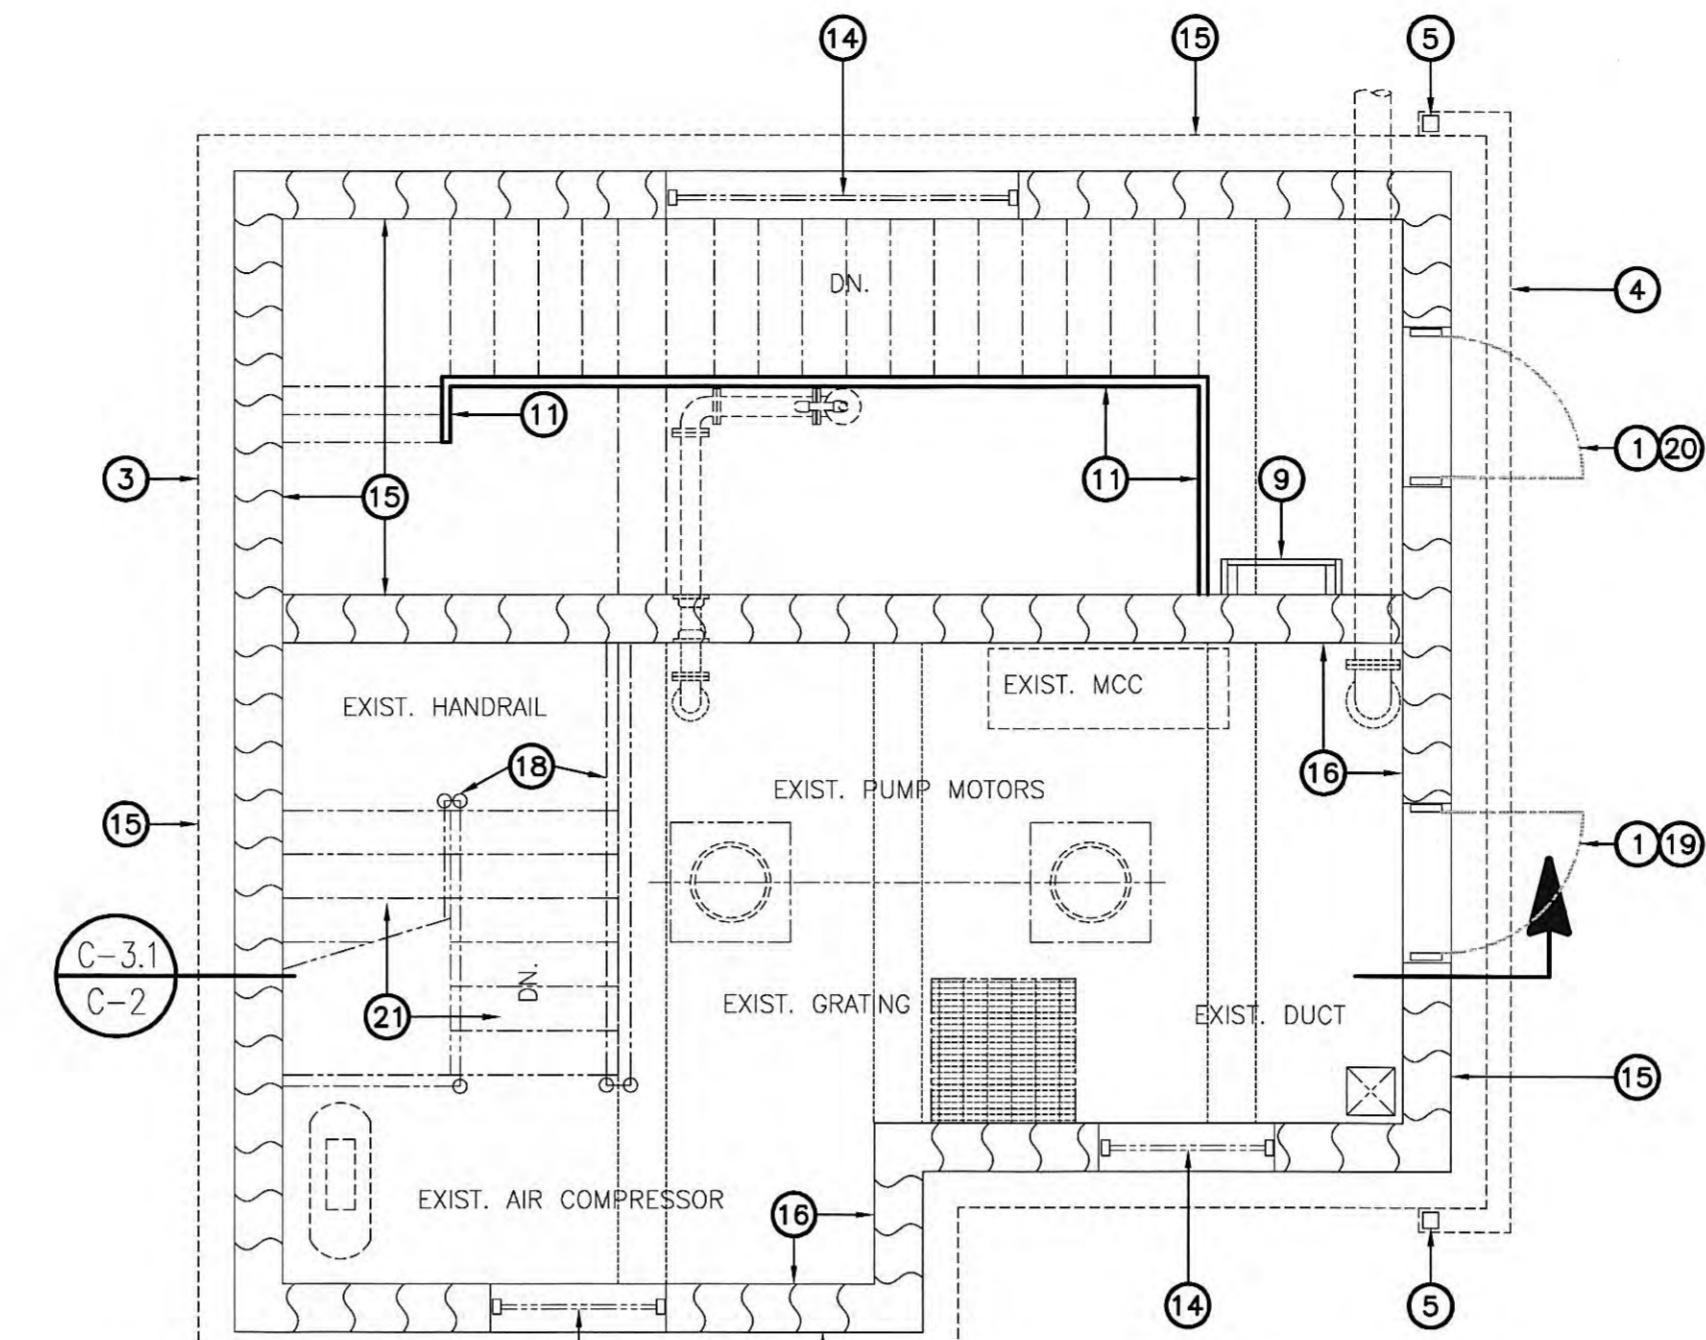


FLOOR PLAN – ENTRANCE LEVEL

SCALE: 1/4" = 1'-0"

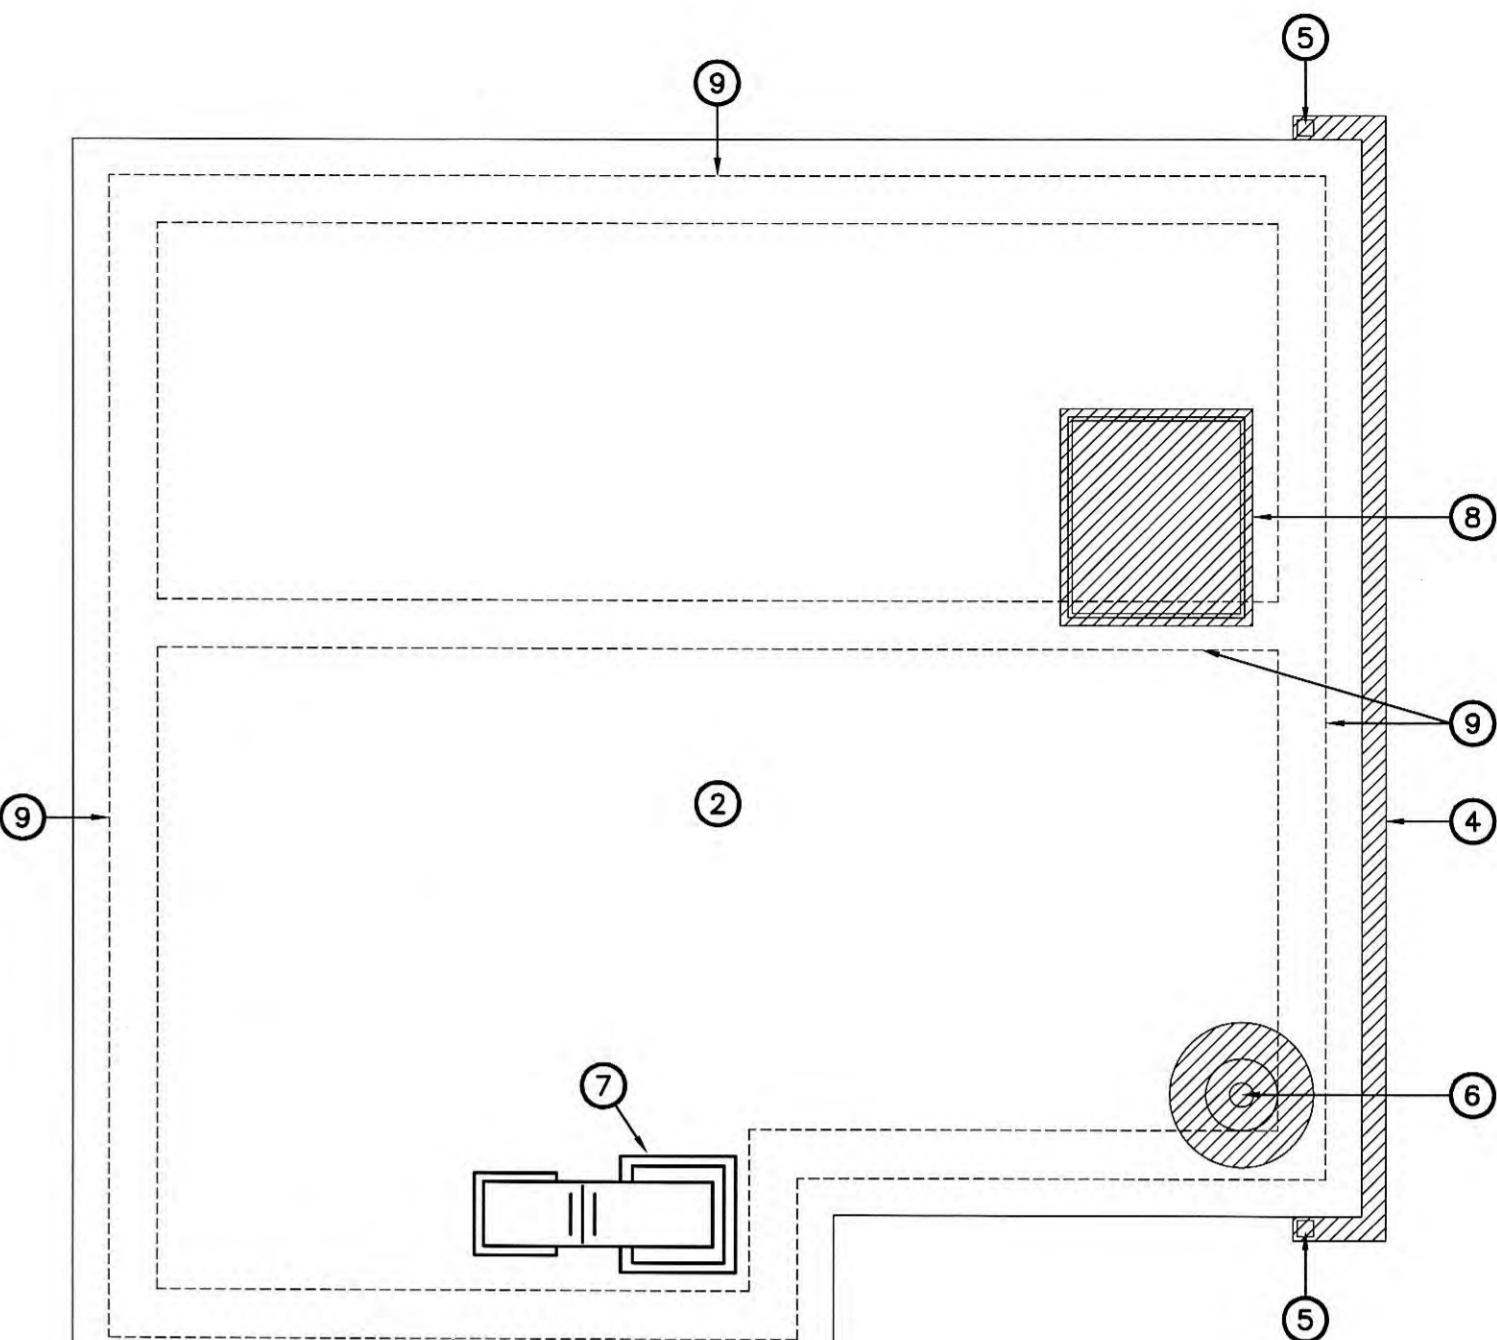


ROOF PLAN

SCALE: 1/4" = 1'-0"

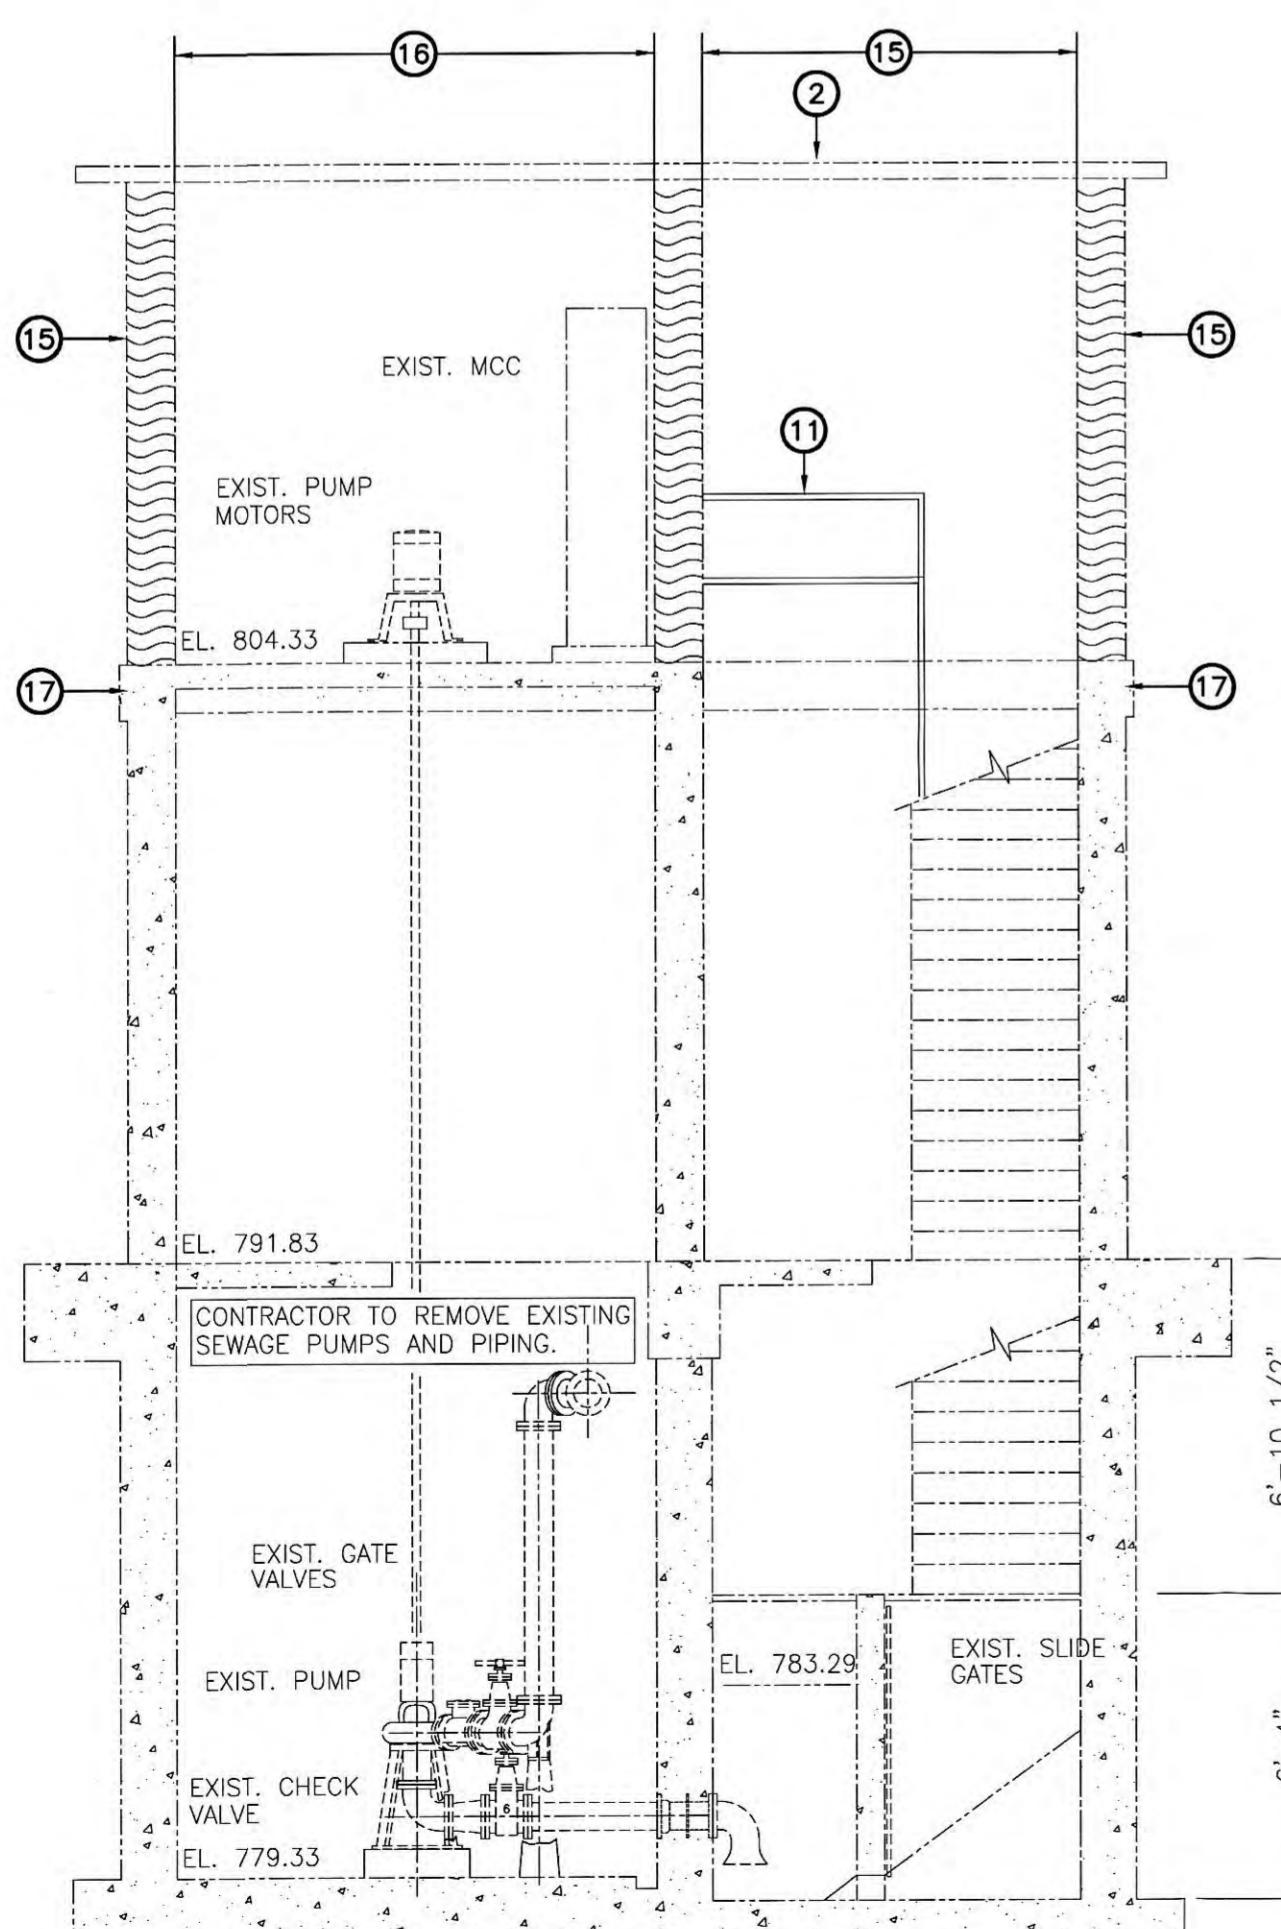

BUILDING—SECTION

SCALE: 1/4" = 1'-0"

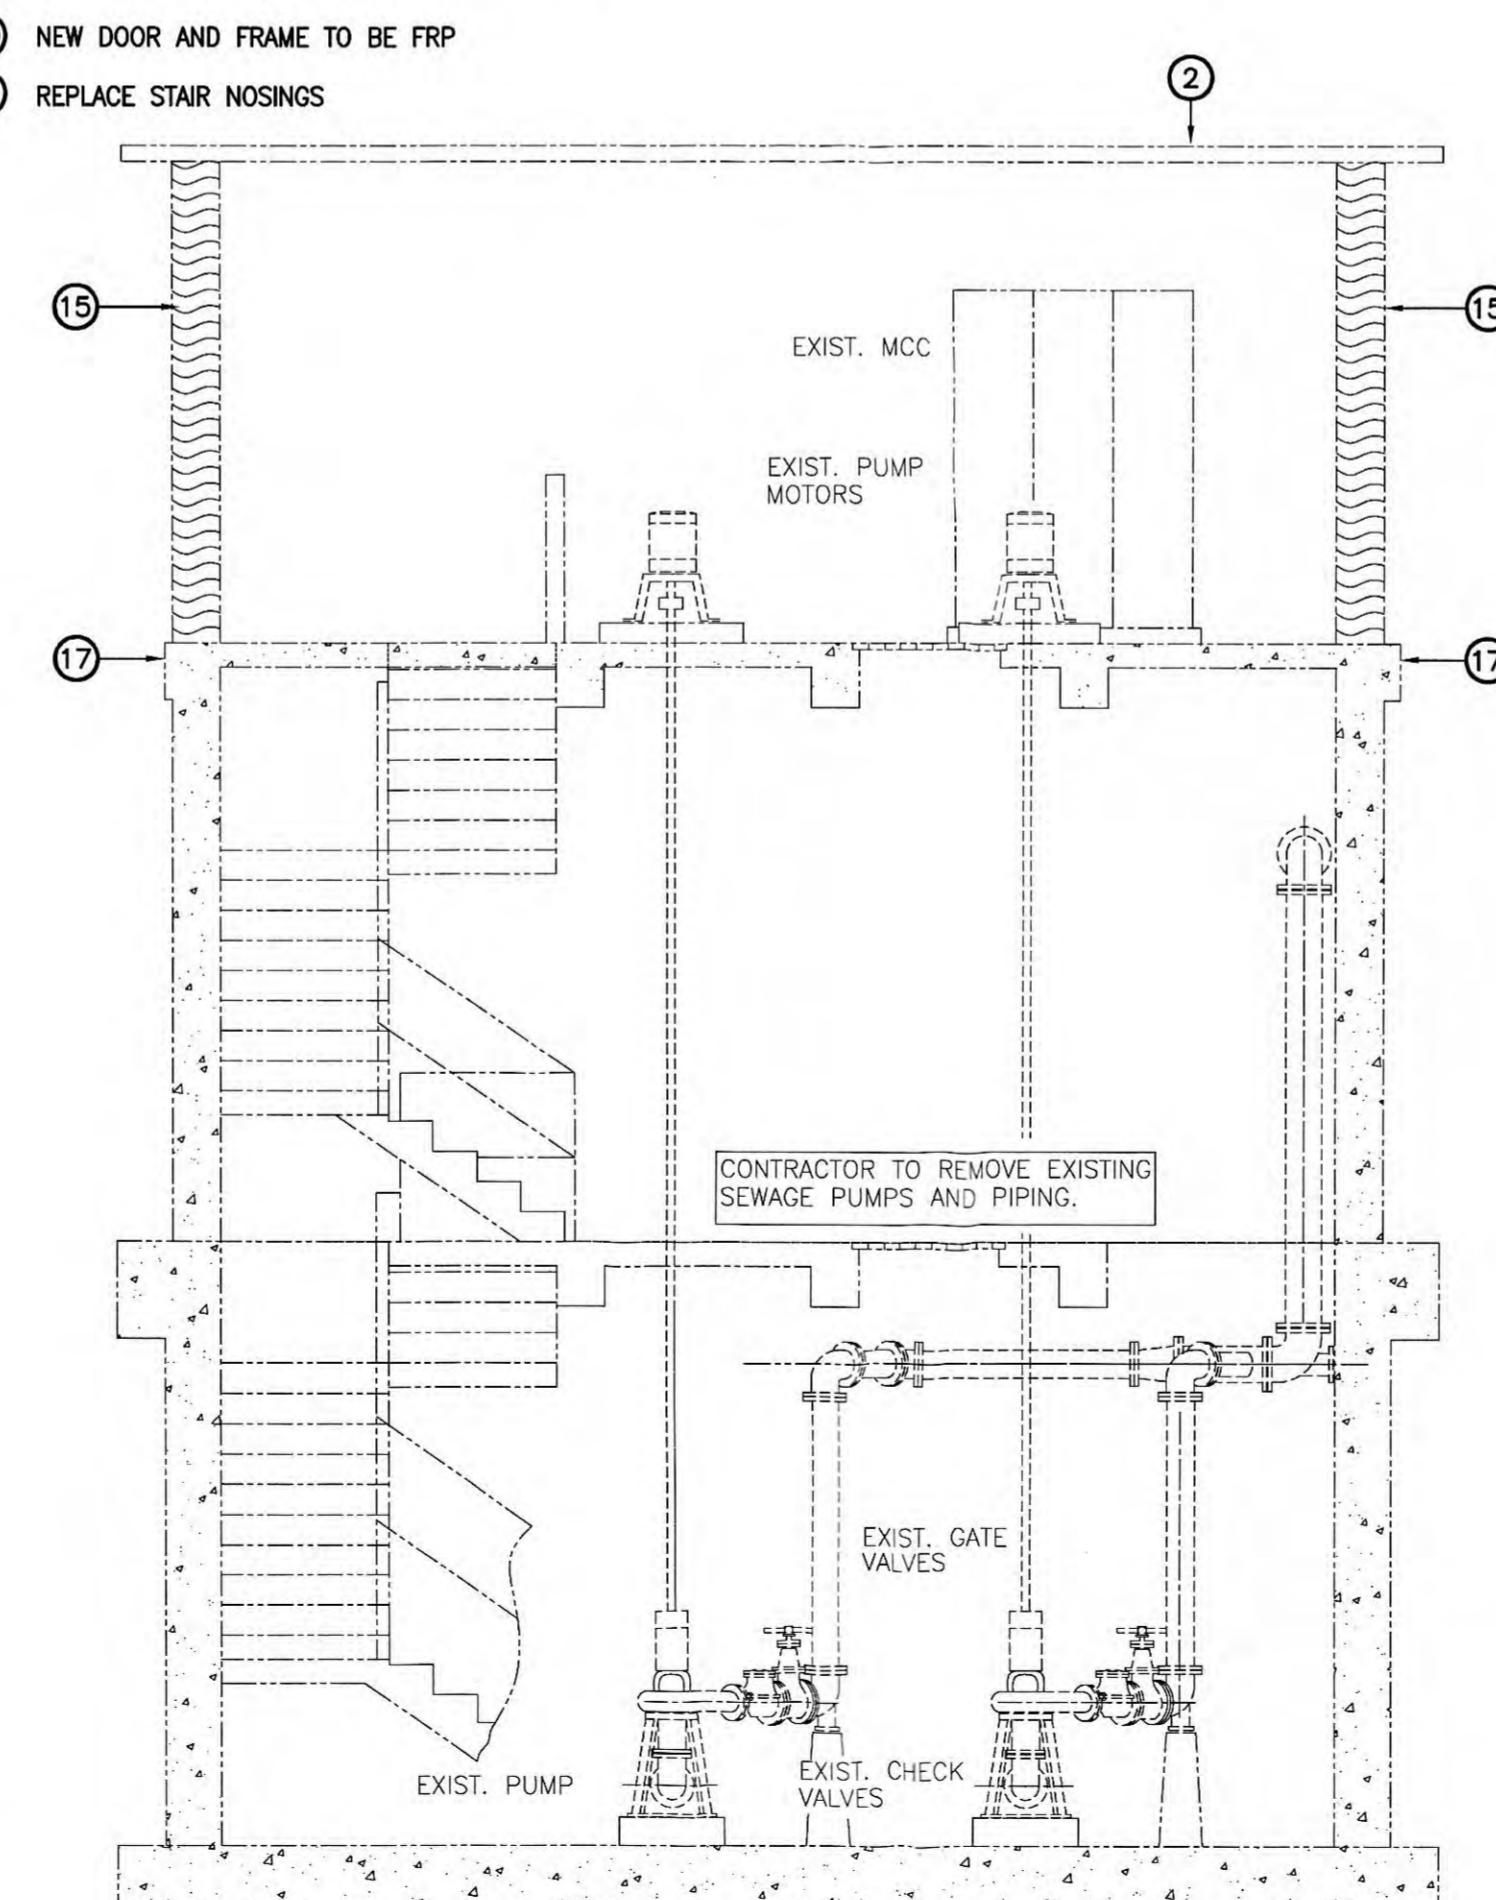

BUILDING—SECTION

SCALE: 1/4" = 1'-0"

Tue, 05 Jun 2007 - 9:09am
FILE NAME: L:\Harriman UB - 7601 (WWTP. PS & lines)\7601-30 - Sewer System Rehab\CADD\S Harriman PS Rehab\Record Dwg\3041-A1.dwg

RECORD DRAWINGS

THESE RECORD DRAWINGS REPRESENT THE "AS-BUILT" PROJECT TO THE BEST OF THE ENGINEER'S KNOWLEDGE. ALTHOUGH PREPARED FROM THE CONSTRUCTION RECORD, THEY CANNOT BE GUARANTEED TO BE EXACT IN EVERY DETAIL.

DETAIL.
CHECKED BY:

CHECKED BY: S. S. S. S. 6/2007
ENGINEER'S REPRESENTATIVE DATE

T NO. 7601-30

CONTRACT NO. S02-03


**EXISTING HARDEES SEWAGE PUMP STATION
ARCHITECTURAL PLANS AND SECTIONS
HARRIMAN UTILITY BOARD
HARRIMAN, TENNESSEE**

ALL RIGHTS RESERVED:
THIS DOCUMENT IS THE PROPERTY OF GRW ELROD DUNSON, INC. AND SHALL NOT BE REPRODUCED IN WHOLE OR IN PART OR
USED FOR CONSTRUCTION OF OTHER THAN THIS SPECIFIC PROJECT WITHOUT WRITTEN PERMISSION OF GRW ELROD DUNSON, INC.

NO.	DESCRIPTION	DATE	BY	
	REVISIONS			This document, originally issued, sealed, and signed by John C. Potts, Kentucky Professional Architect, No. 101185, on June 4, 2004, shall not be used in lieu of a certified document.



DESIGNED: JCP	DATE: JUNE, 2004
DRAWN: STAFF	SCALE: AS NOTED
REVIEWED: JCP	SHEET NO.
APPROVED: JCP	A-1

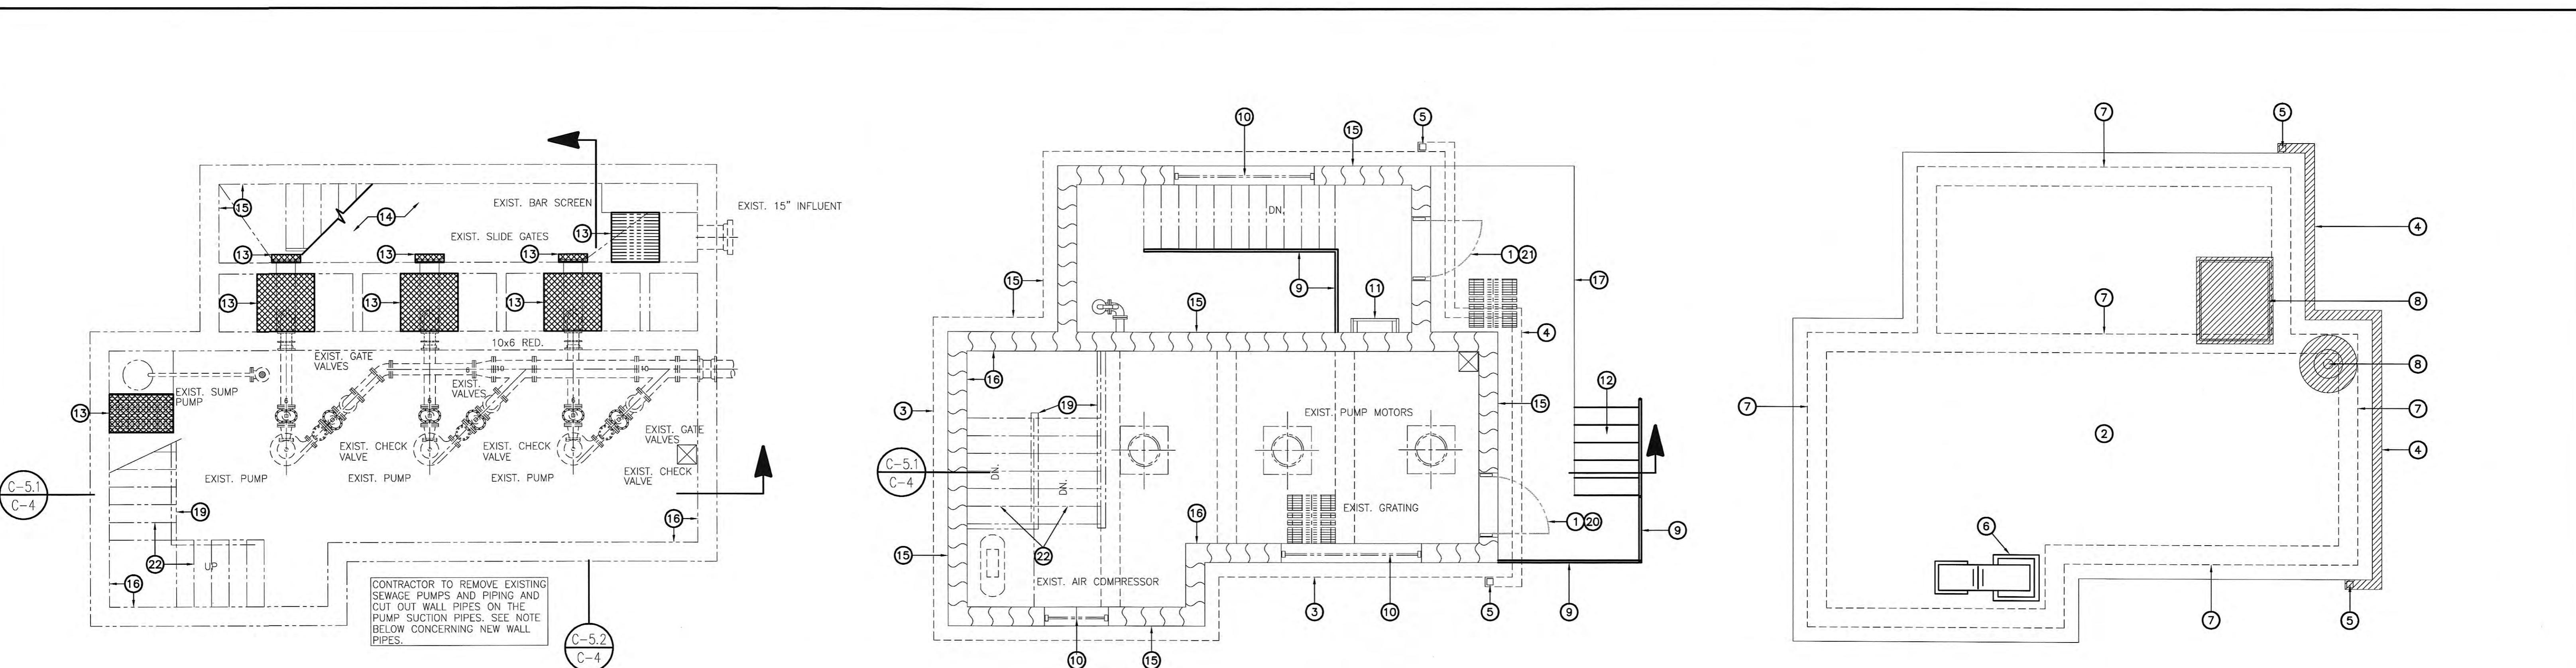

FLOOR PLAN – PUMP LEVEL


SCALE: 1/4" = 1'-0"

FLOOR PLAN – ENTRANCE LEVEL

SCALE: 1/4" = 1'-0"


ROOF PLAN

SCALE: 1/4" = 1'-0"

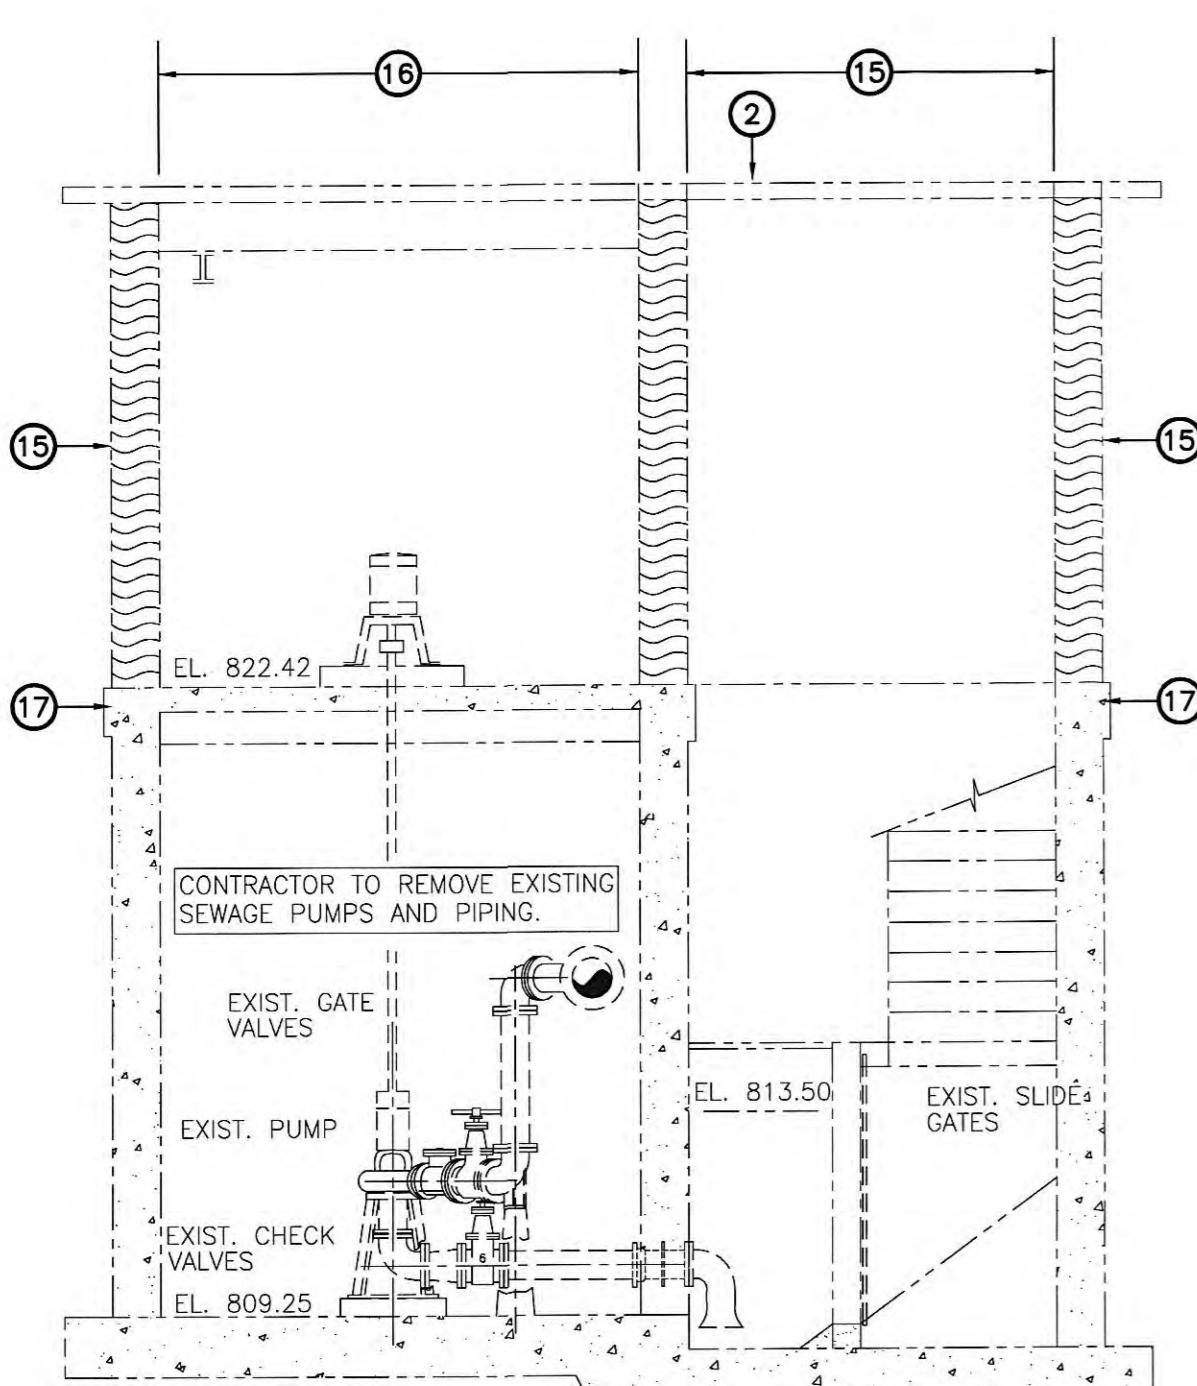

BUILDING – SECTION

SCALE: 1/4" = 1'-0"

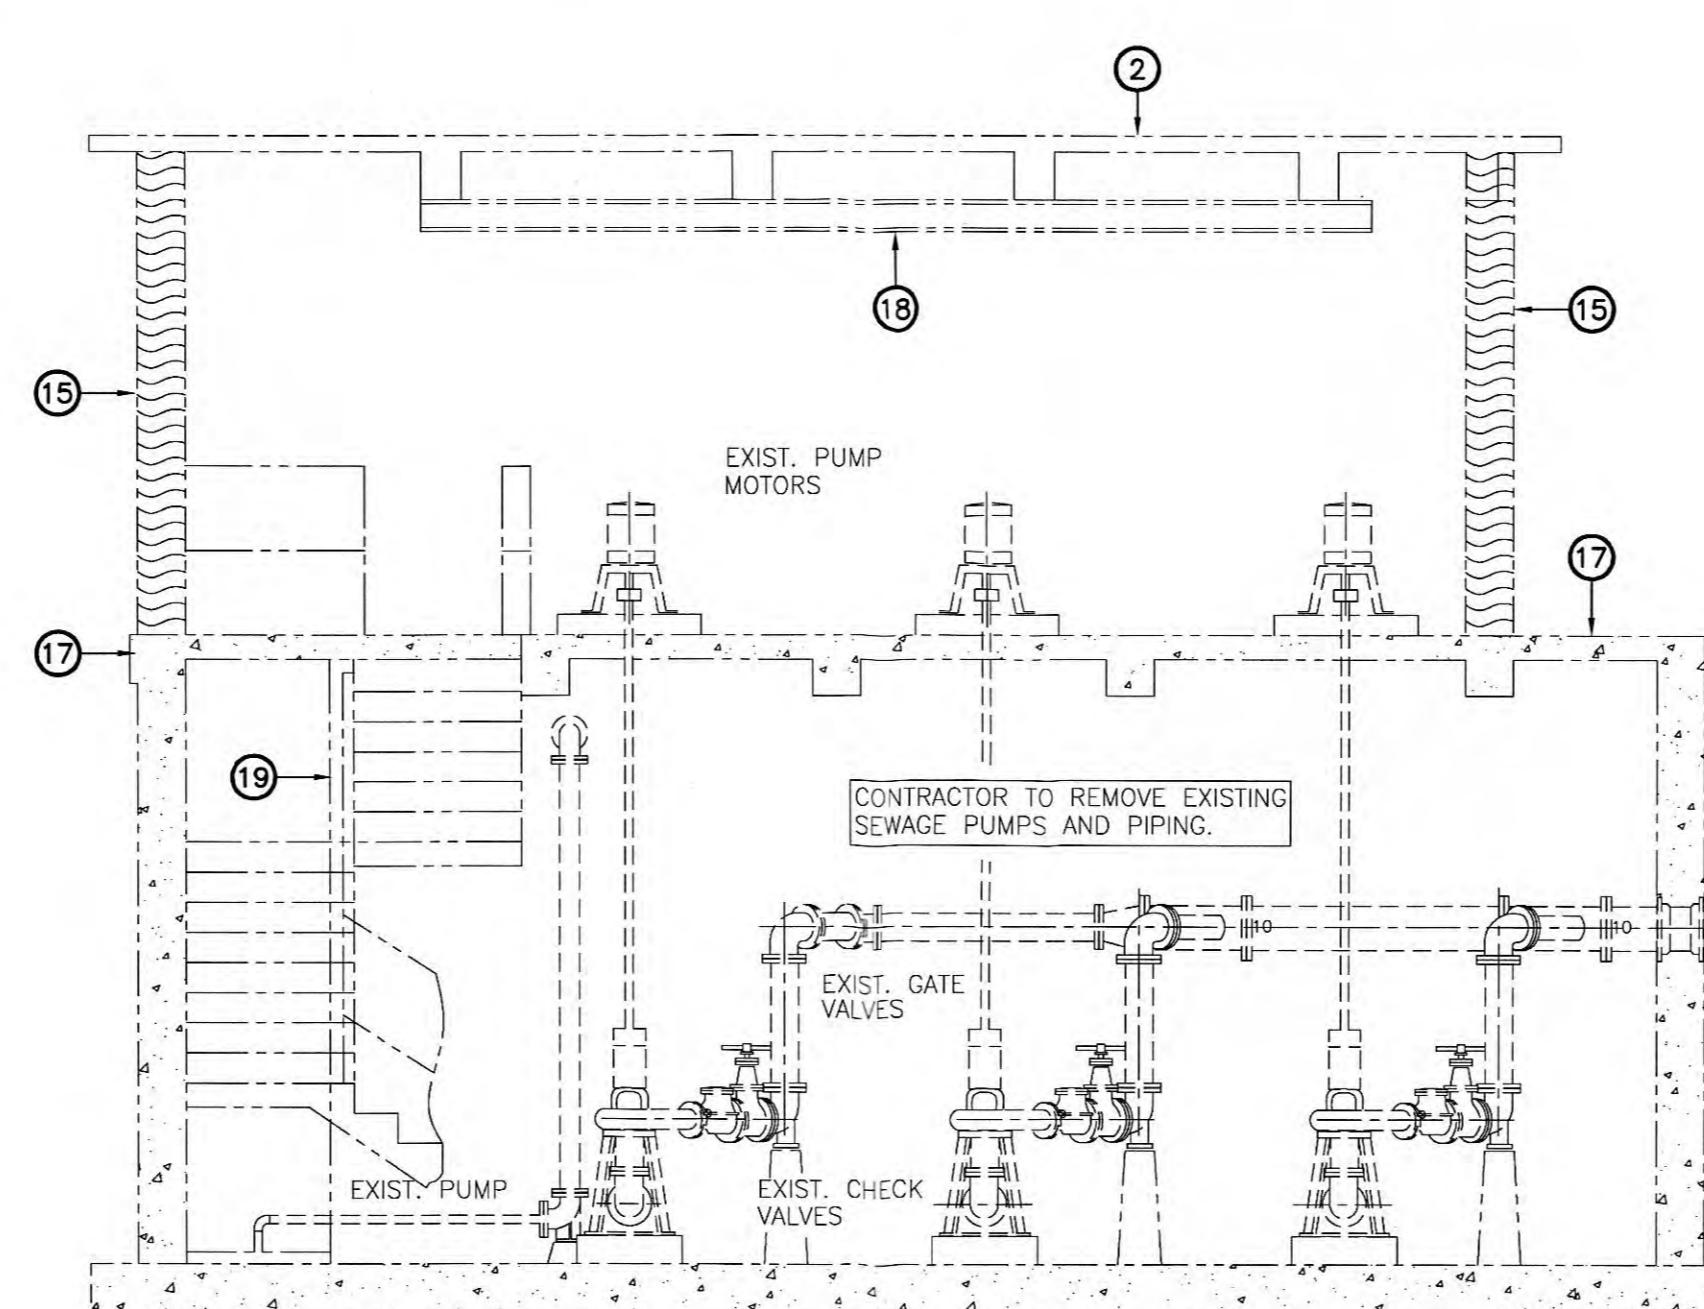

BUILDING – SECTION

SCALE: $1/4'' = 1'-0''$


RECORD DRAWINGS

THESE RECORD DRAWINGS REPRESENT THE "AS-BUILT" PROJECT TO THE BEST OF THE ENGINEER'S KNOWLEDGE. ALTHOUGH PREPARED FROM THE CONSTRUCTION RECORD, THEY CANNOT BE GUARANTEED TO BE EXACT IN EVERY DETAIL.

CHECKED BY:


S. Somay 6/2007
ENGINEER'S REPRESENTATIVE DATE

<p>ALL RIGHTS RESERVED: THIS DOCUMENT IS THE PROPERTY OF GRW ELROD DUNSON, INC. AND SHALL NOT BE REPRODUCED IN WHOLE OR IN PART OR USED FOR CONSTRUCTION OF OTHER THAN THIS SPECIFIC PROJECT WITHOUT WRITTEN PERMISSION OF GRW ELROD DUNSON, INC.</p>			
NO.	DESCRIPTION	DATE	BY
<p>REVISIONS</p>			

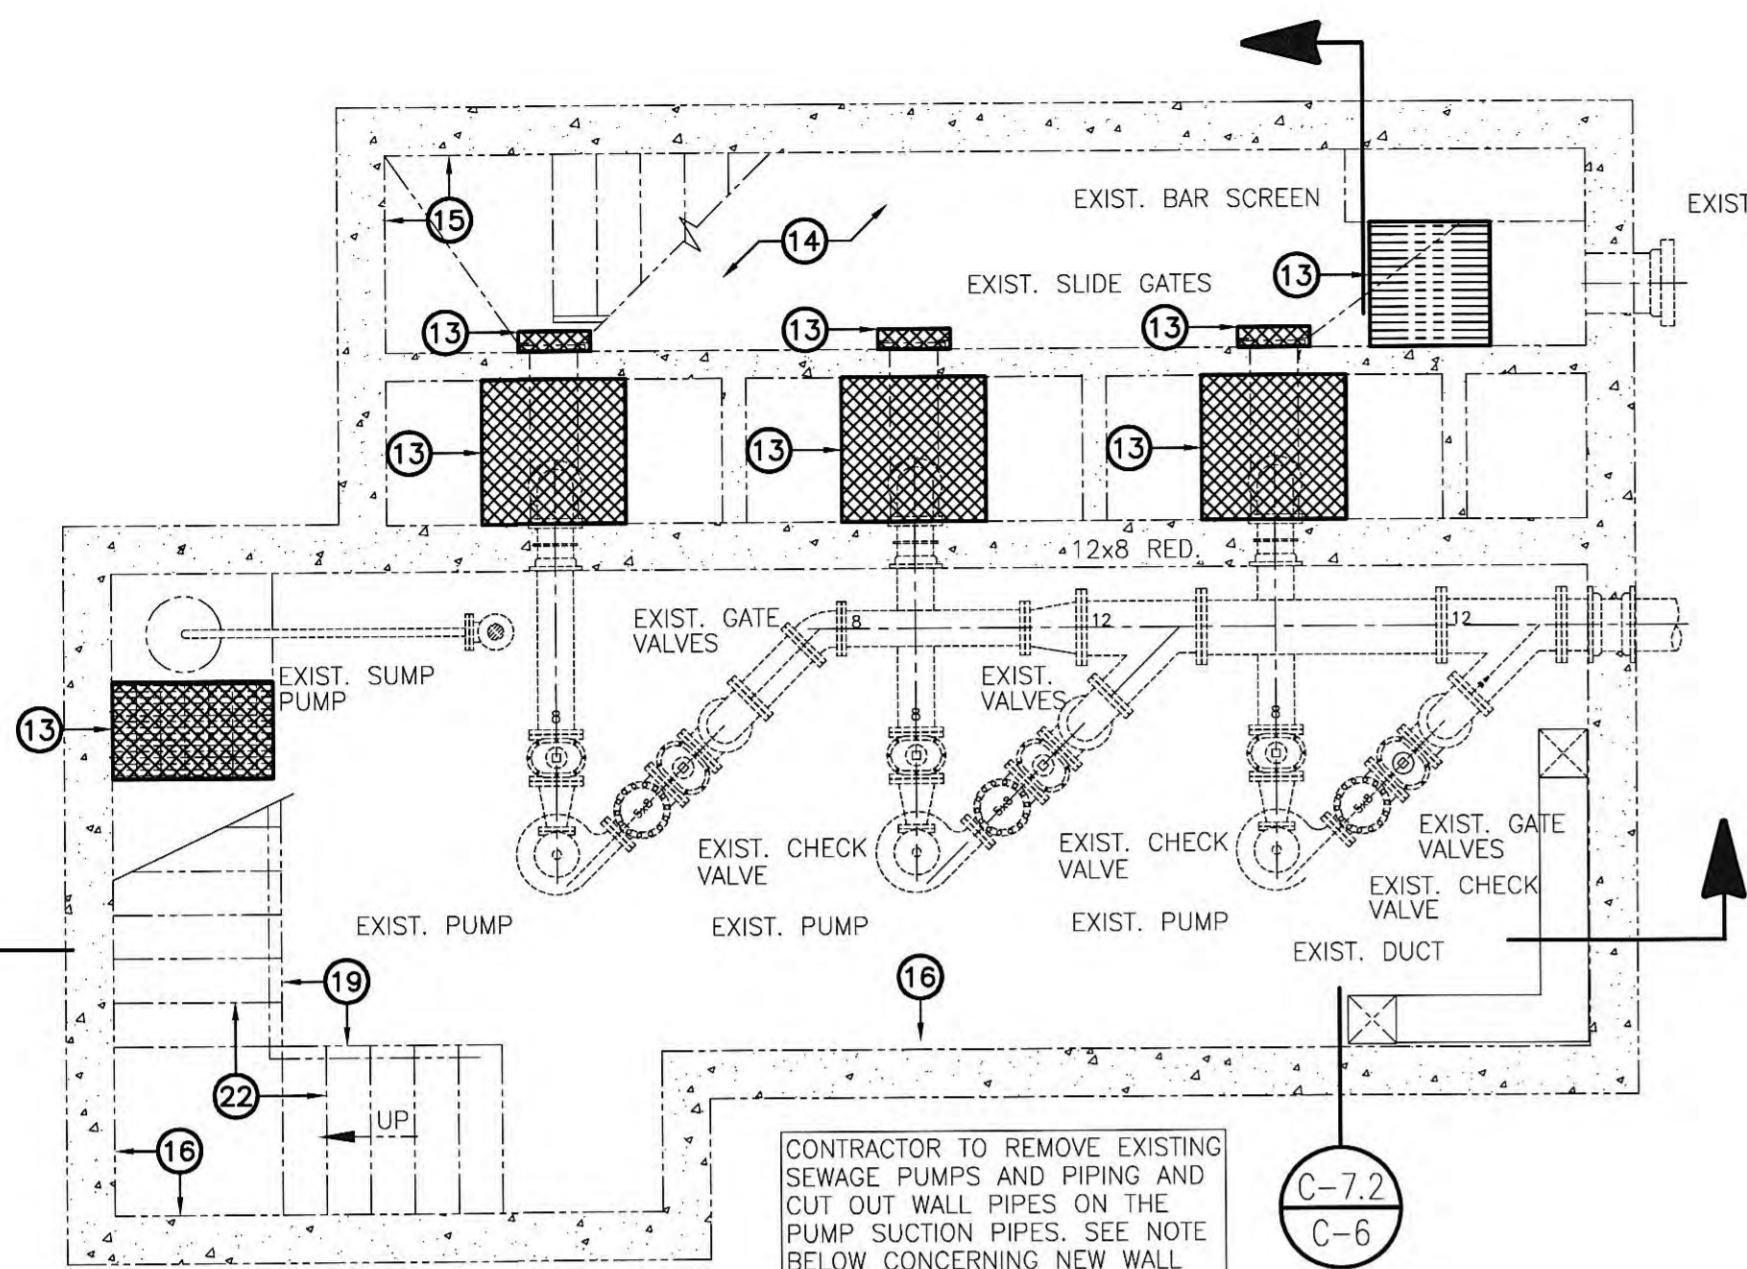


FLOOR PLAN – PUMP LEVEL

SCALE: $1/4'' = 1'-0''$

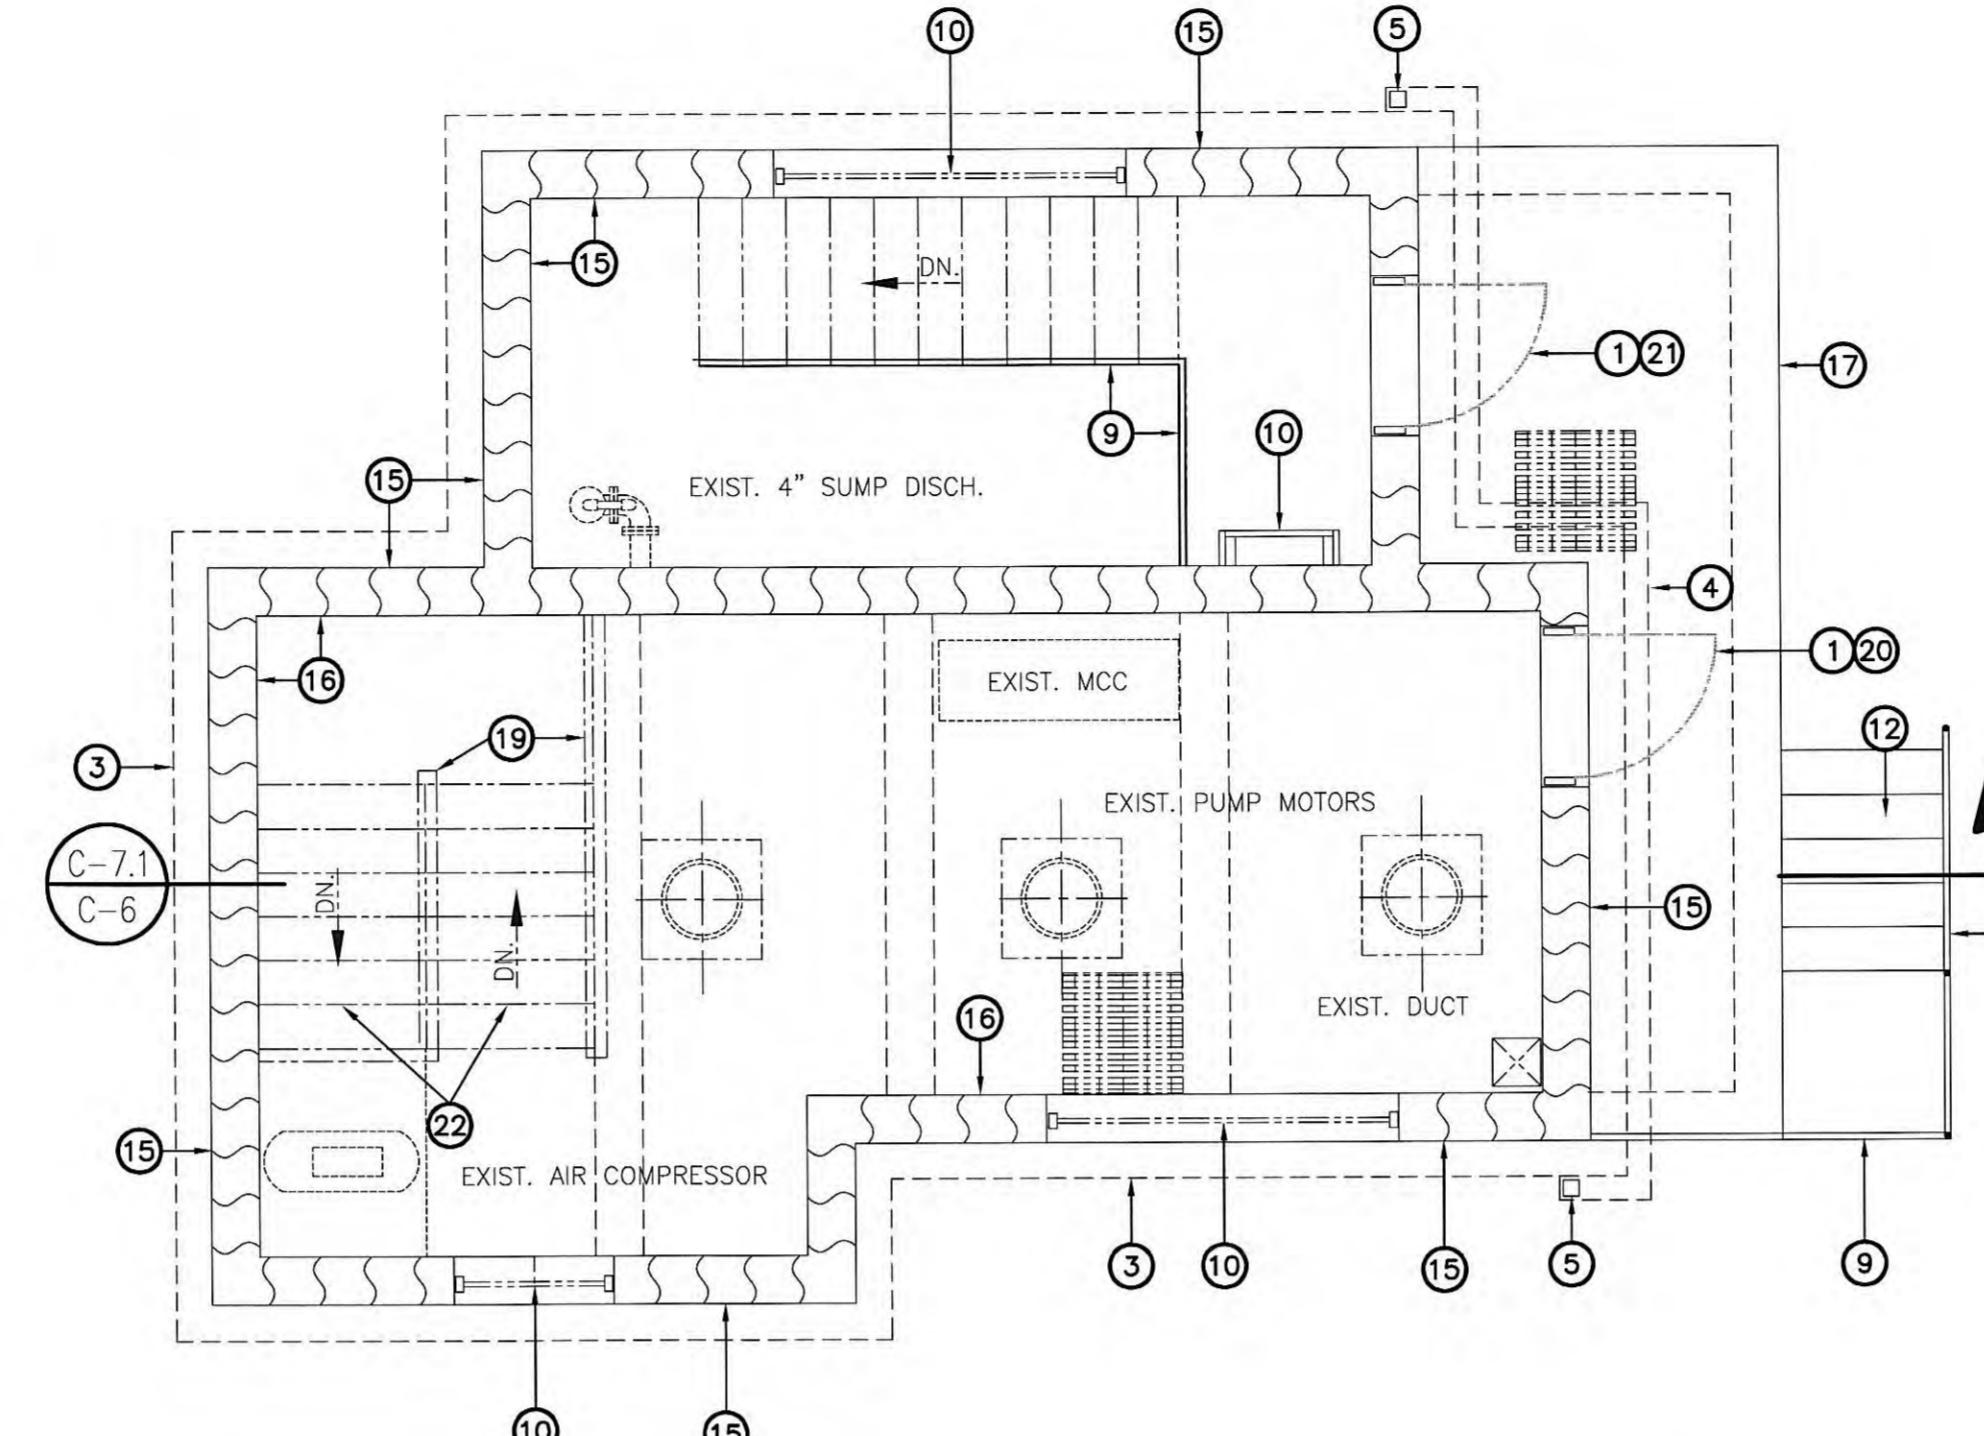

FLOOR PLAN – ENTRANCE LEVEL

SCALE: 1/4" = 1'-0"

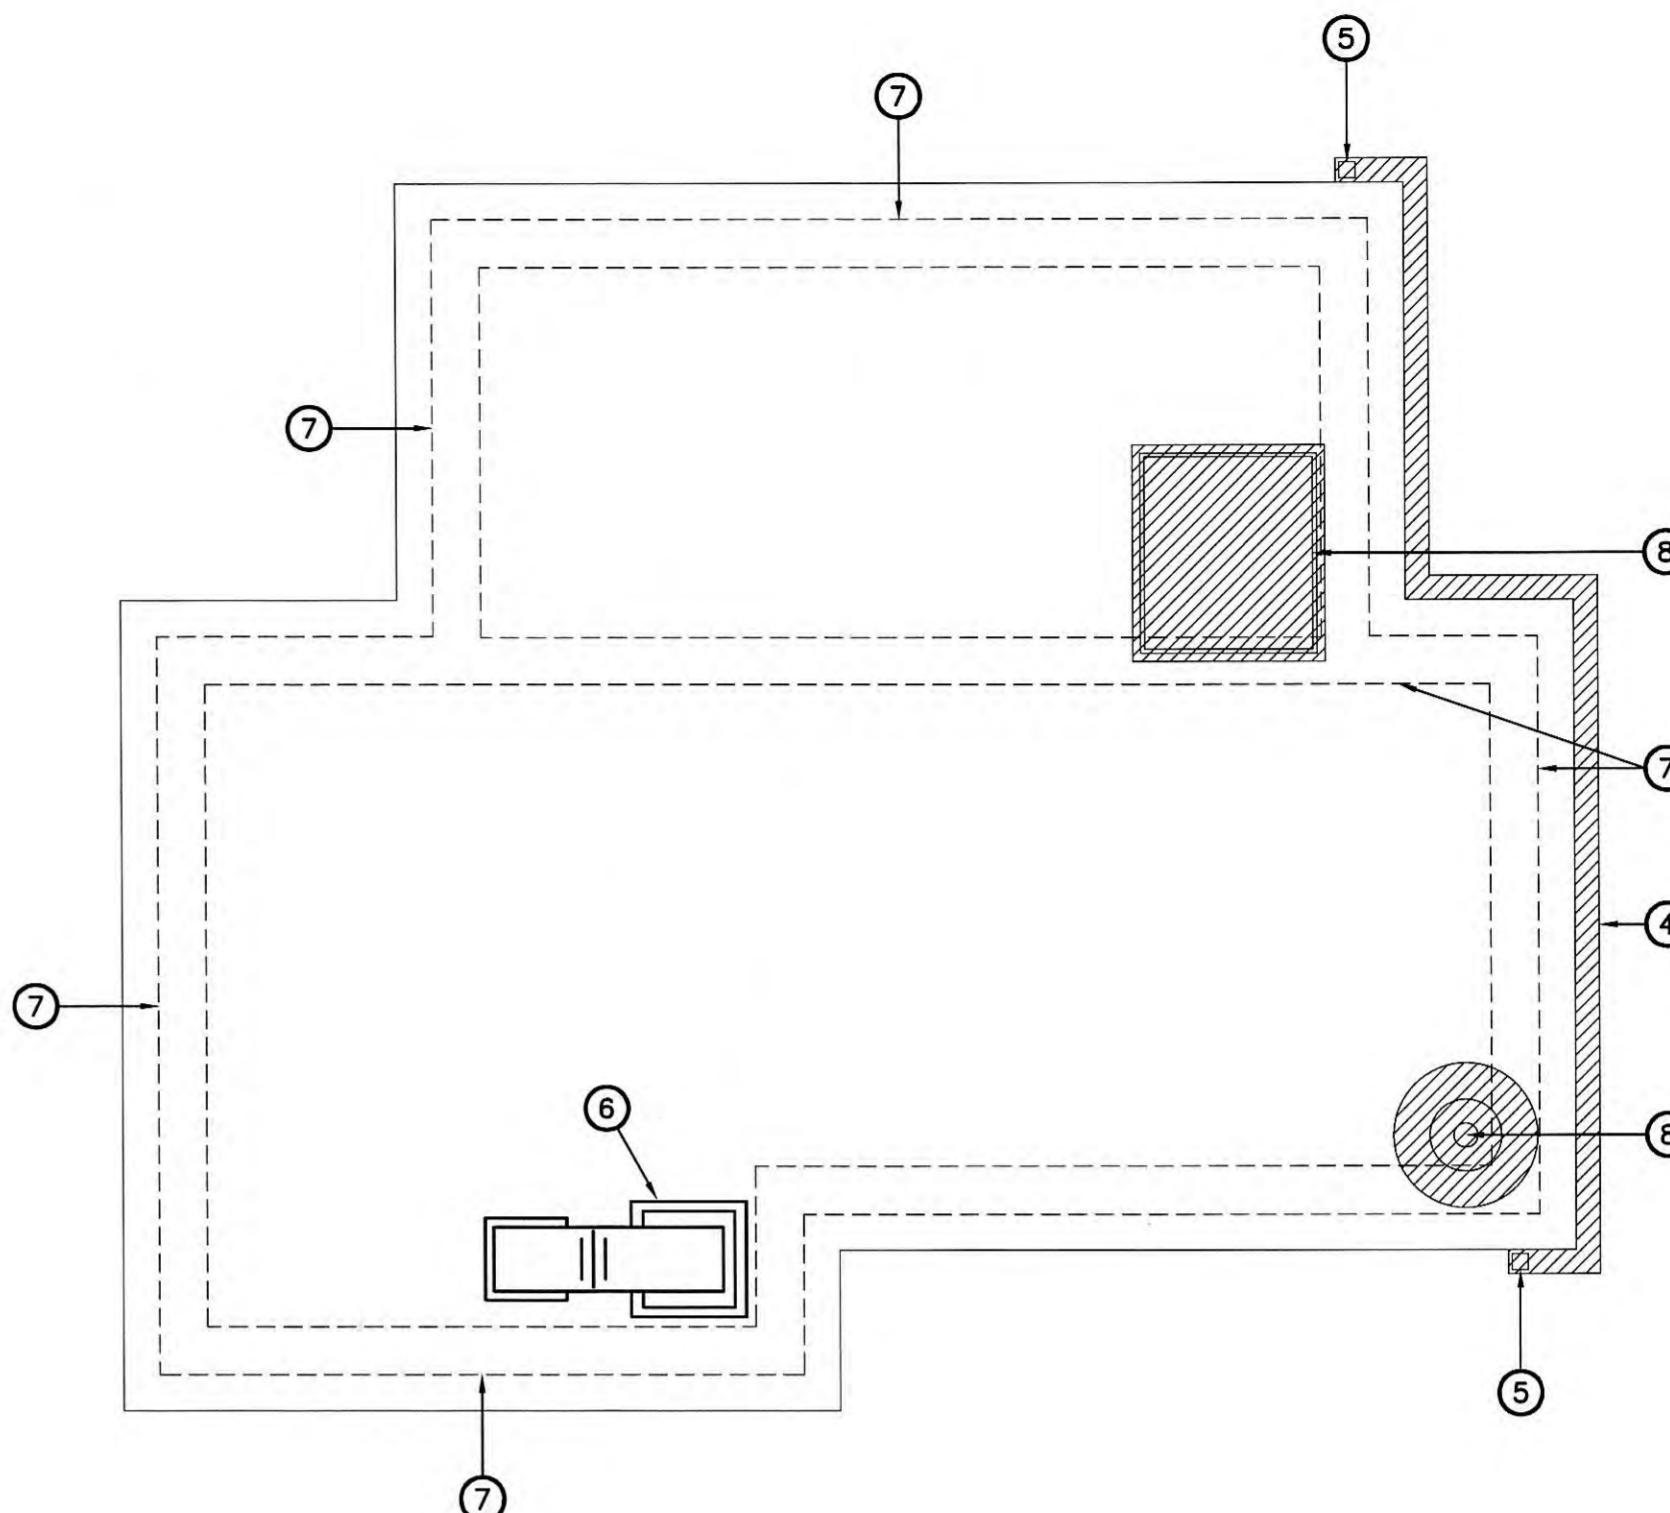

ROOF PLAN


SCALE: 1/4" = 1'-0"

CONTRACTOR NOTES

1. CONTRACTOR SHALL BE RESPONSIBLE FOR BYPASS PUMPING WHILE REHABILITATING PUMP STATION. THIS INCLUDES ANY REQUIRED CONNECTIONS TO INFLUENT AND DISCHARGE LINES. HUB WILL PROVIDE THE REQUIRED ELECTRICAL SERVICE FOR BYPASS PUMPING.
 2. THE OWNER SHALL HAVE FIRST SALVAGE RIGHTS TO ALL EXISTING VALVES, PIPING AND EQUIPMENT. IF THE OWNER REJECTS SALVAGED MATERIALS, THE CONTRACTOR SHALL PROVIDE FINAL DISPOSAL OF ALL ITEMS.
 3. CONTRACTOR TO CLEAN AND PAINT PIPING AND WALLS. WALLS INCLUDE ENTRANCE LEVEL: ELECTRICAL AREA AND PUMP LEVEL: PUMP AND PIPING AREA.


KEYNOTES

- (1) REMOVE EXISTING DOOR AND FRAME. PROVIDE NEW OUT SWINGING DOOR WITH NEW FRAME. PAINT. VERIFY MASONRY OPENING.
 - (2) REMOVE EXISTING ROOF MATERIAL DOWN TO CONC. DECK. PROVIDE NEW EPDM ROOFING, INSULATION, AND FLASHING.
 - (3) ROOF LINE ABOVE.
 - (4) EXISTING GUTTER TO BE REPLACED.
 - (5) INSTALL NEW 4"x4" MTL. DOWNSPOUT.
 - (6) EXISTING EQUIPMENT TO BE REMOVED— SEE MECHANICAL.
 - (7) WALL BELOW.
 - (8) EXISTING EQUIPMENT TO BE REMOVED.
 - (9) REPLACE EXISTING HANDRAILS
 - (10) REPLACE EXISTING WINDOW— SEE WINDOW DETAILS SHEET A-4
 - (11) REMOVE EXISTING LADDER.
 - (12) EXISTING CONC. STAIRS TO BE REPAIRED AND NEW METAL TREADS TO BE INSTALLED, MATCH EXISTING SIZE.
 - (13) EXISTING GRATING TO BE REPLACED.
 - (14) NEW CONC. TOPPING SLAB.
 - (15) EXIST. WALLS TO BE PRESSURE WASHED AND SEALER APPLIED
 - (16) EXIST. WALLS TO BE PRESSURE WASHED AND PAINTED
 - (17) PATCH EXPOSED EXT. CONC. AS REQUIRED
 - (18) PAINT STL. BEAM
 - (19) EXIST HANDRAIL TO BE REPLACED
 - (20) NEW DOOR AND FRAME TO BE HOLLOW METAL, PAINT TO MATCH FRP DOOR.
 - (21) NEW DOOR AND FRAME TO BE FRP
 - (22) REPLACE STAIR NOSINGS

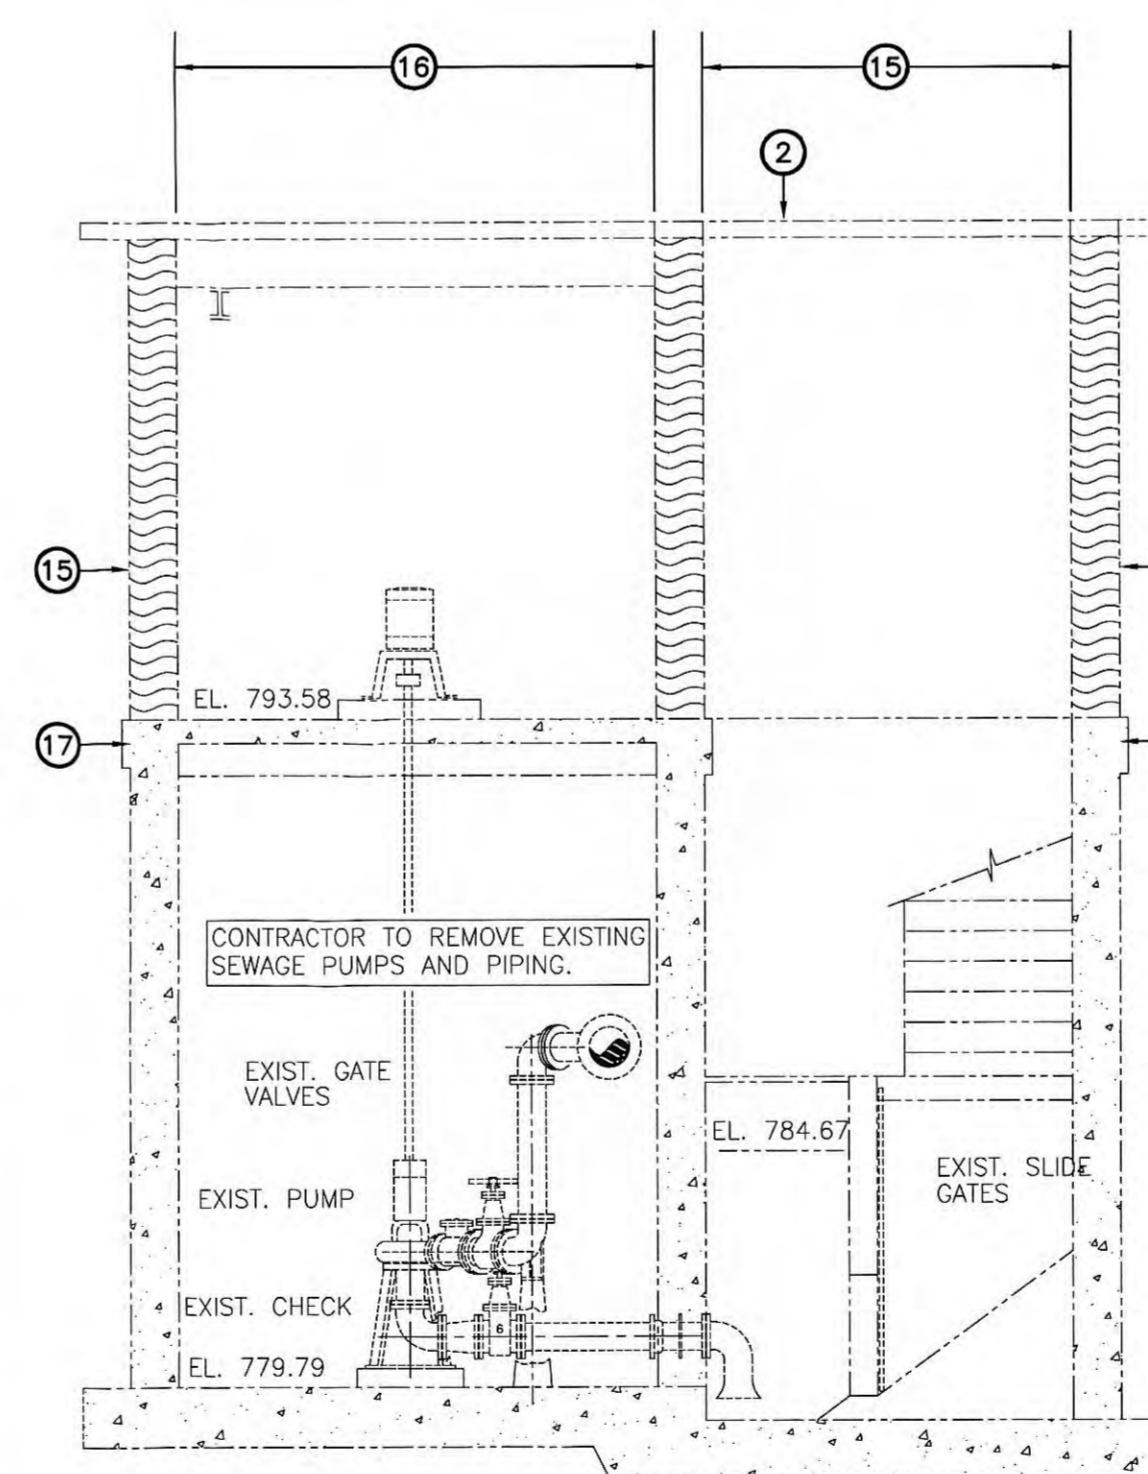

BUILDING – SECTION

SCALE: 1/4" = 1'-0"

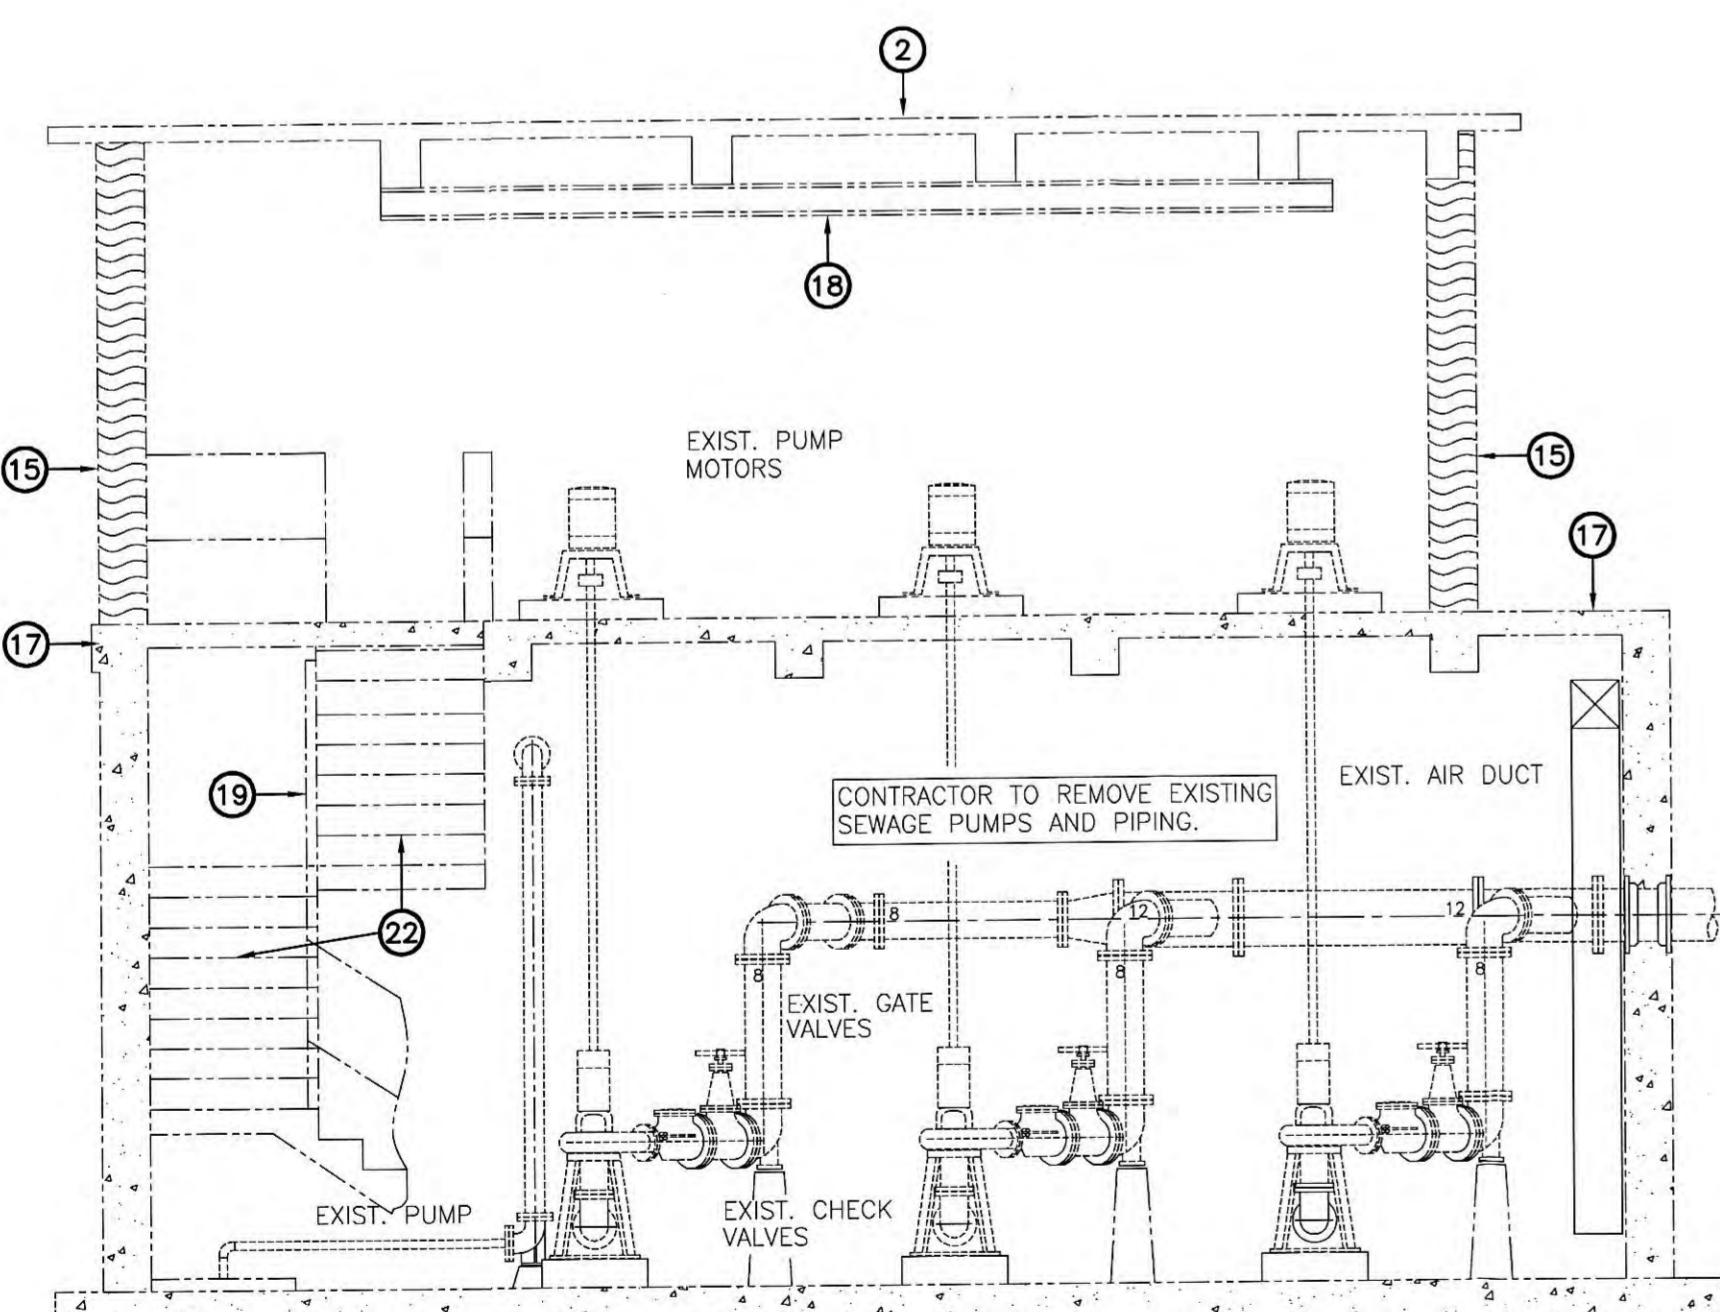

BUILDING – SECTION

SCALE: $1/4'' = 1'-0''$



SCALE: 1/4 = 1-0

RECORD DRAWINGS

THESE RECORD DRAWINGS REPRESENT THE "AS-BUILT" PROJECT TO THE BEST OF THE ENGINEER'S KNOWLEDGE. ALTHOUGH PREPARED FROM THE CONSTRUCTION RECORD, THEY CANNOT BE GUARANTEED TO BE EXACT IN EVERY DETAIL.

CHECKED BY:


Stroms)
ENGINEER'S REPRESENTATIVE

6/2002
DATE

ALL RIGHTS RESERVED:
THIS DOCUMENT IS THE PROPERTY OF GRW ELROD DUNSON, INC. AND SHALL NOT BE REPRODUCED IN WHOLE OR IN PART OR
USED FOR CONSTRUCTION OF OTHER THAN THIS SPECIFIC PROJECT WITHOUT WRITTEN PERMISSION OF GRW ELROD DUNSON, INC.

NO.	DESCRIPTION	DATE	BY
REVISIONS			

	DATE:	JUNE, 2004
	SCALE:	AS NOTED
	SHEET NO.	A-3

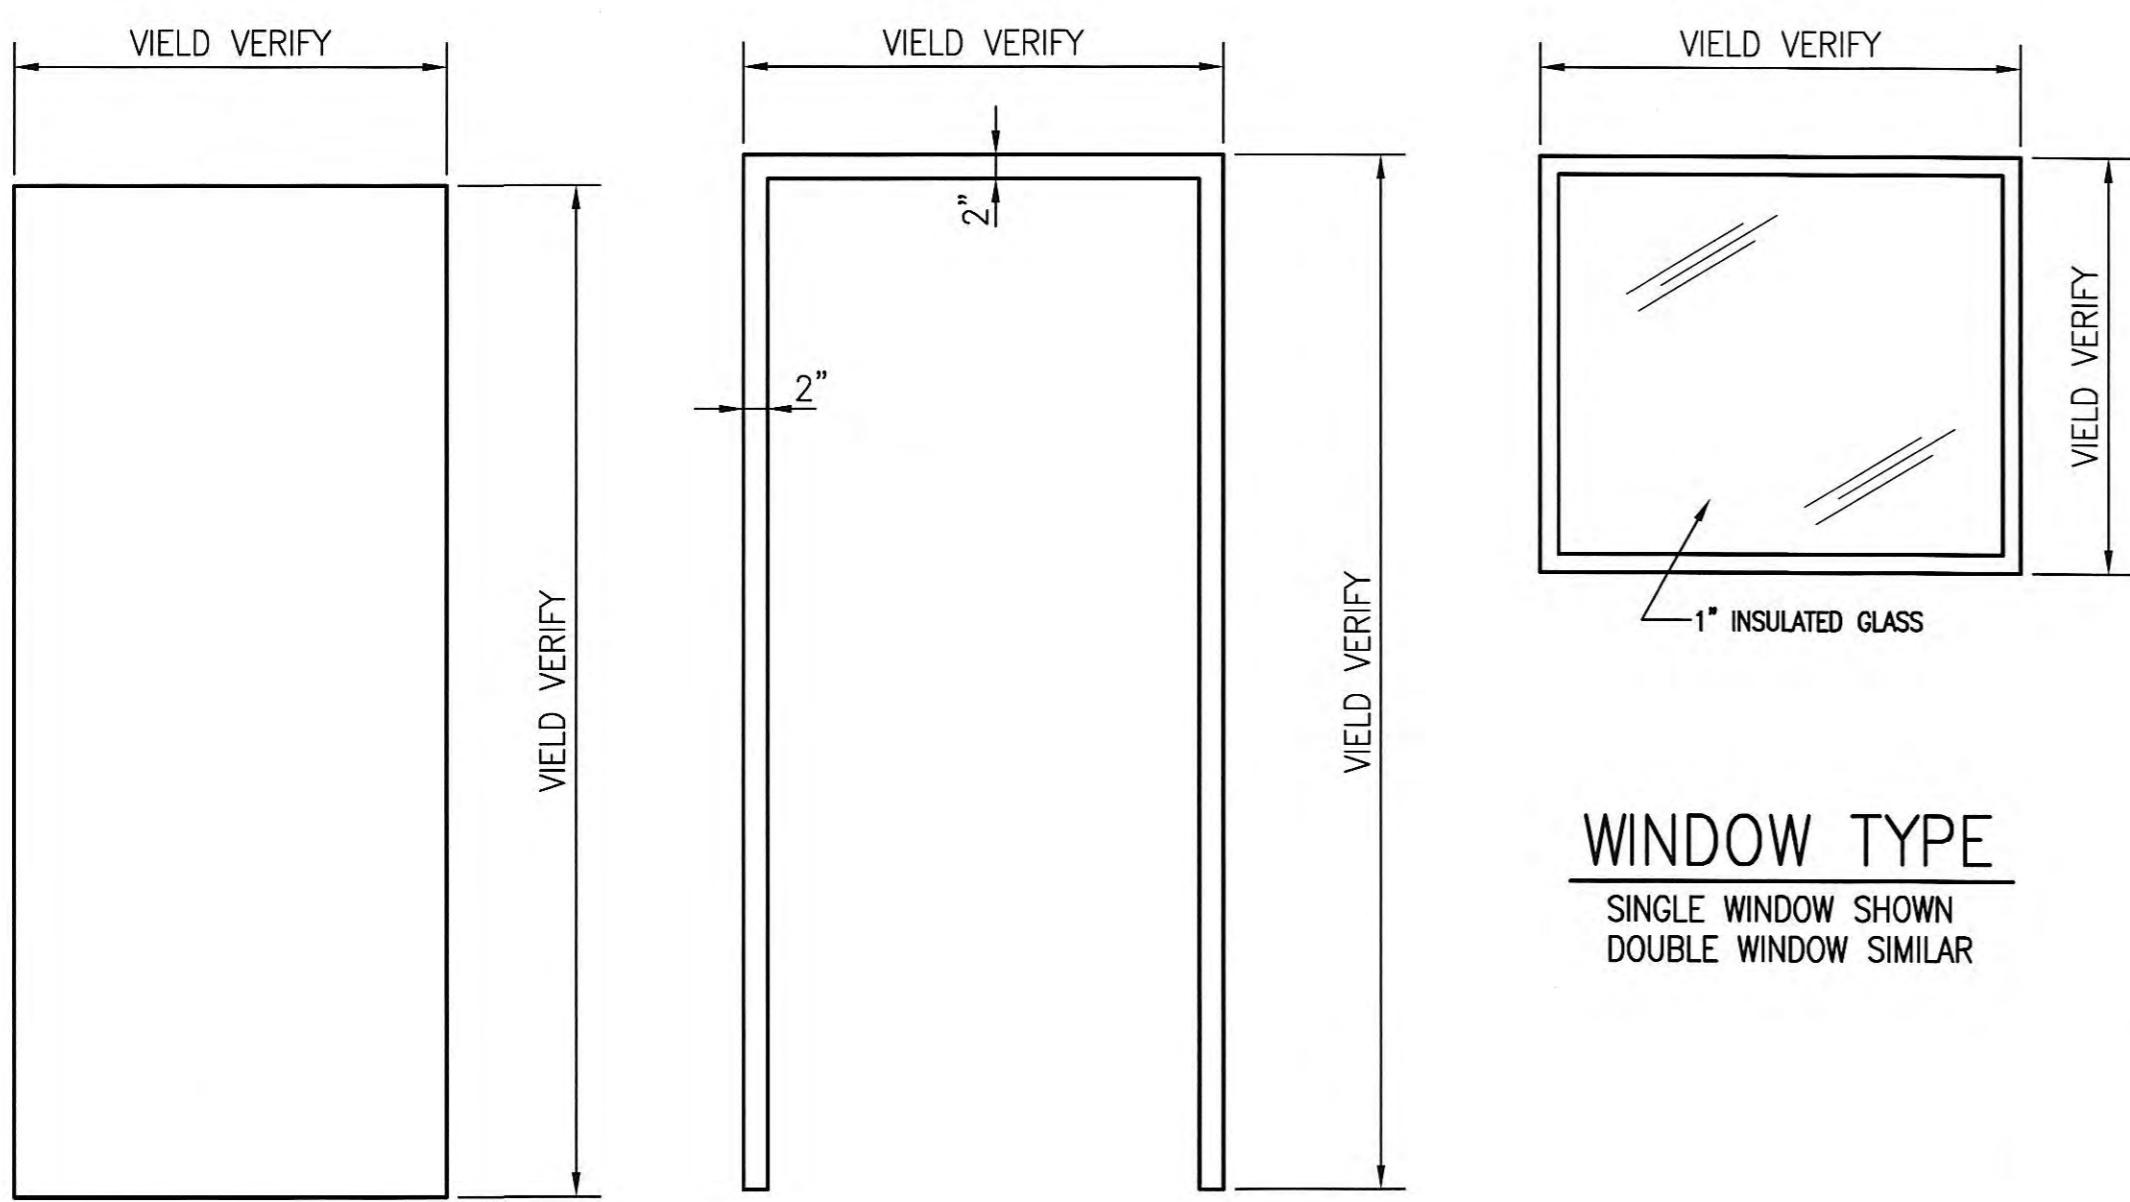


A DOOR TYPE

1


WINDOW TYPE

SINGLE WINDOW SHOWN
DOUBLE WINDOW SIMILAR

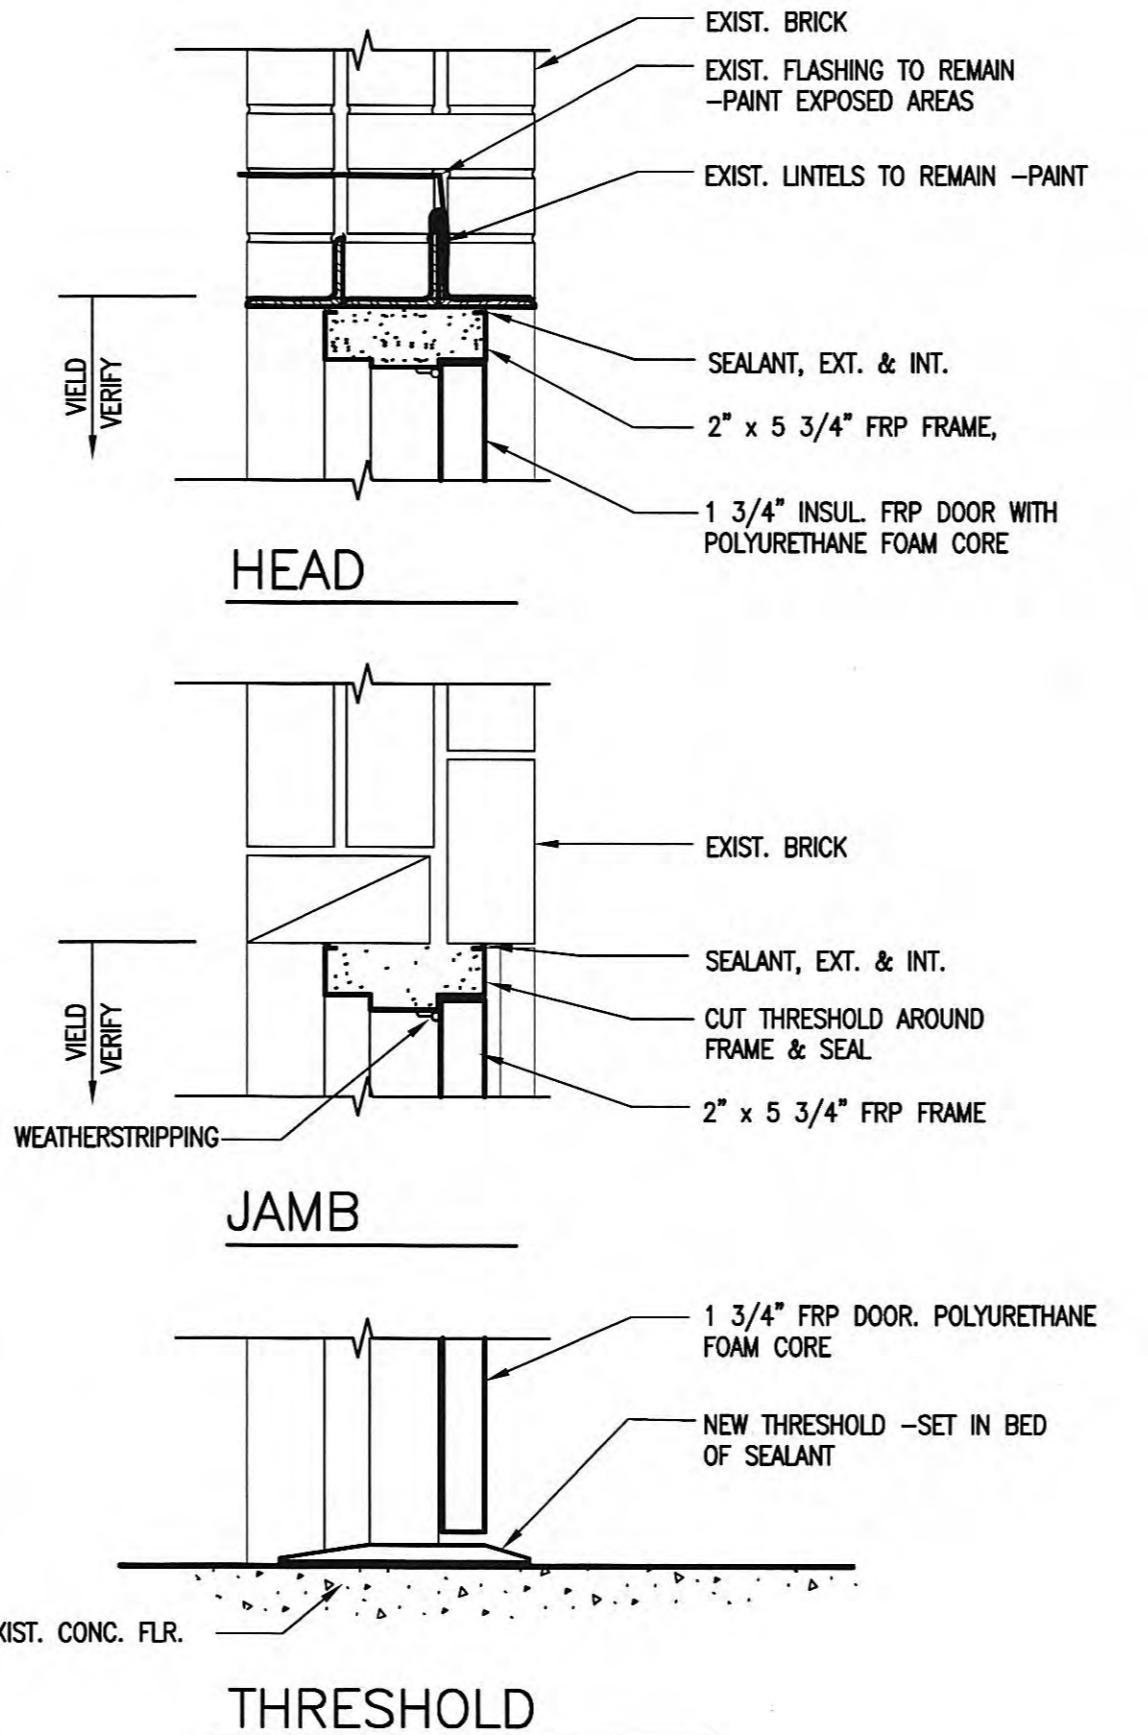


DOOR DETAILS (FRP)

SCALE: 1 1/2" = 1'-0"

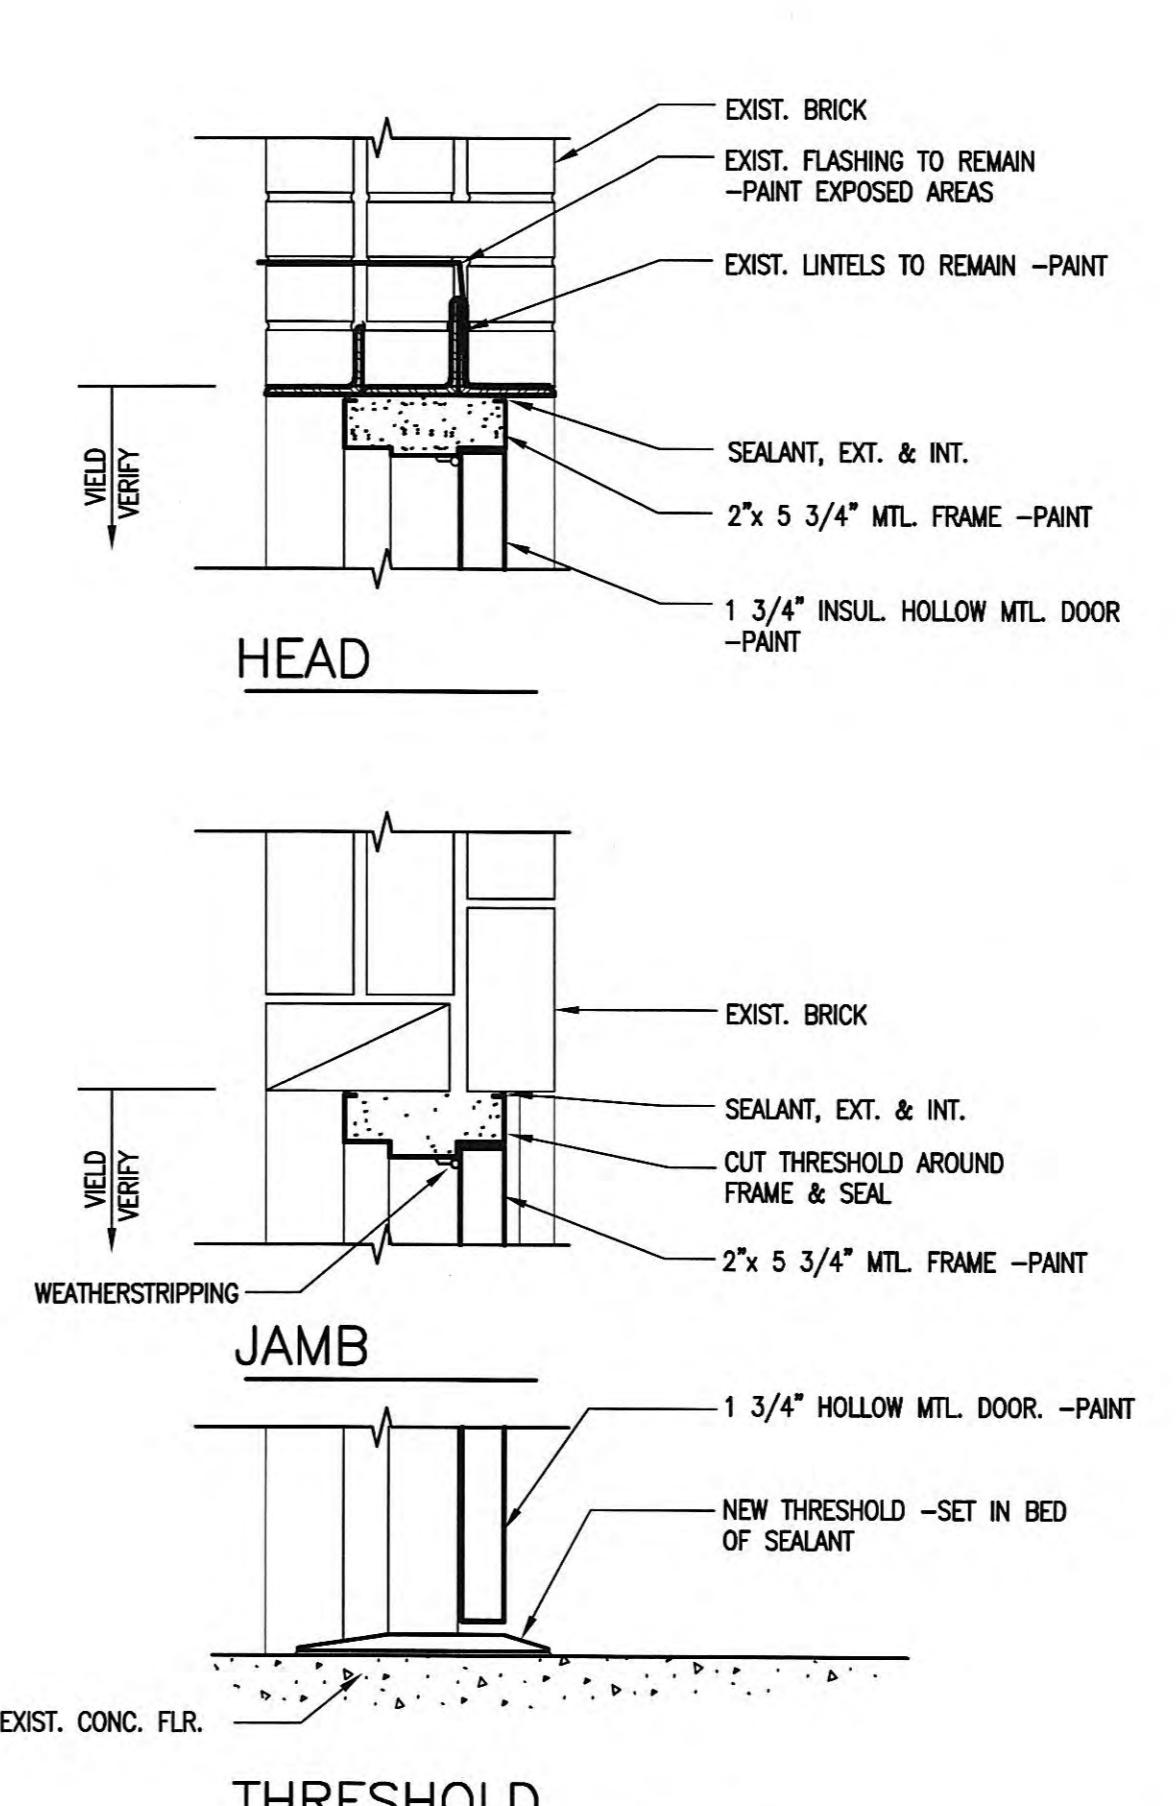


DOOR DETAILS (METAL)

SCALE: 1 1/2" = 1'-0"

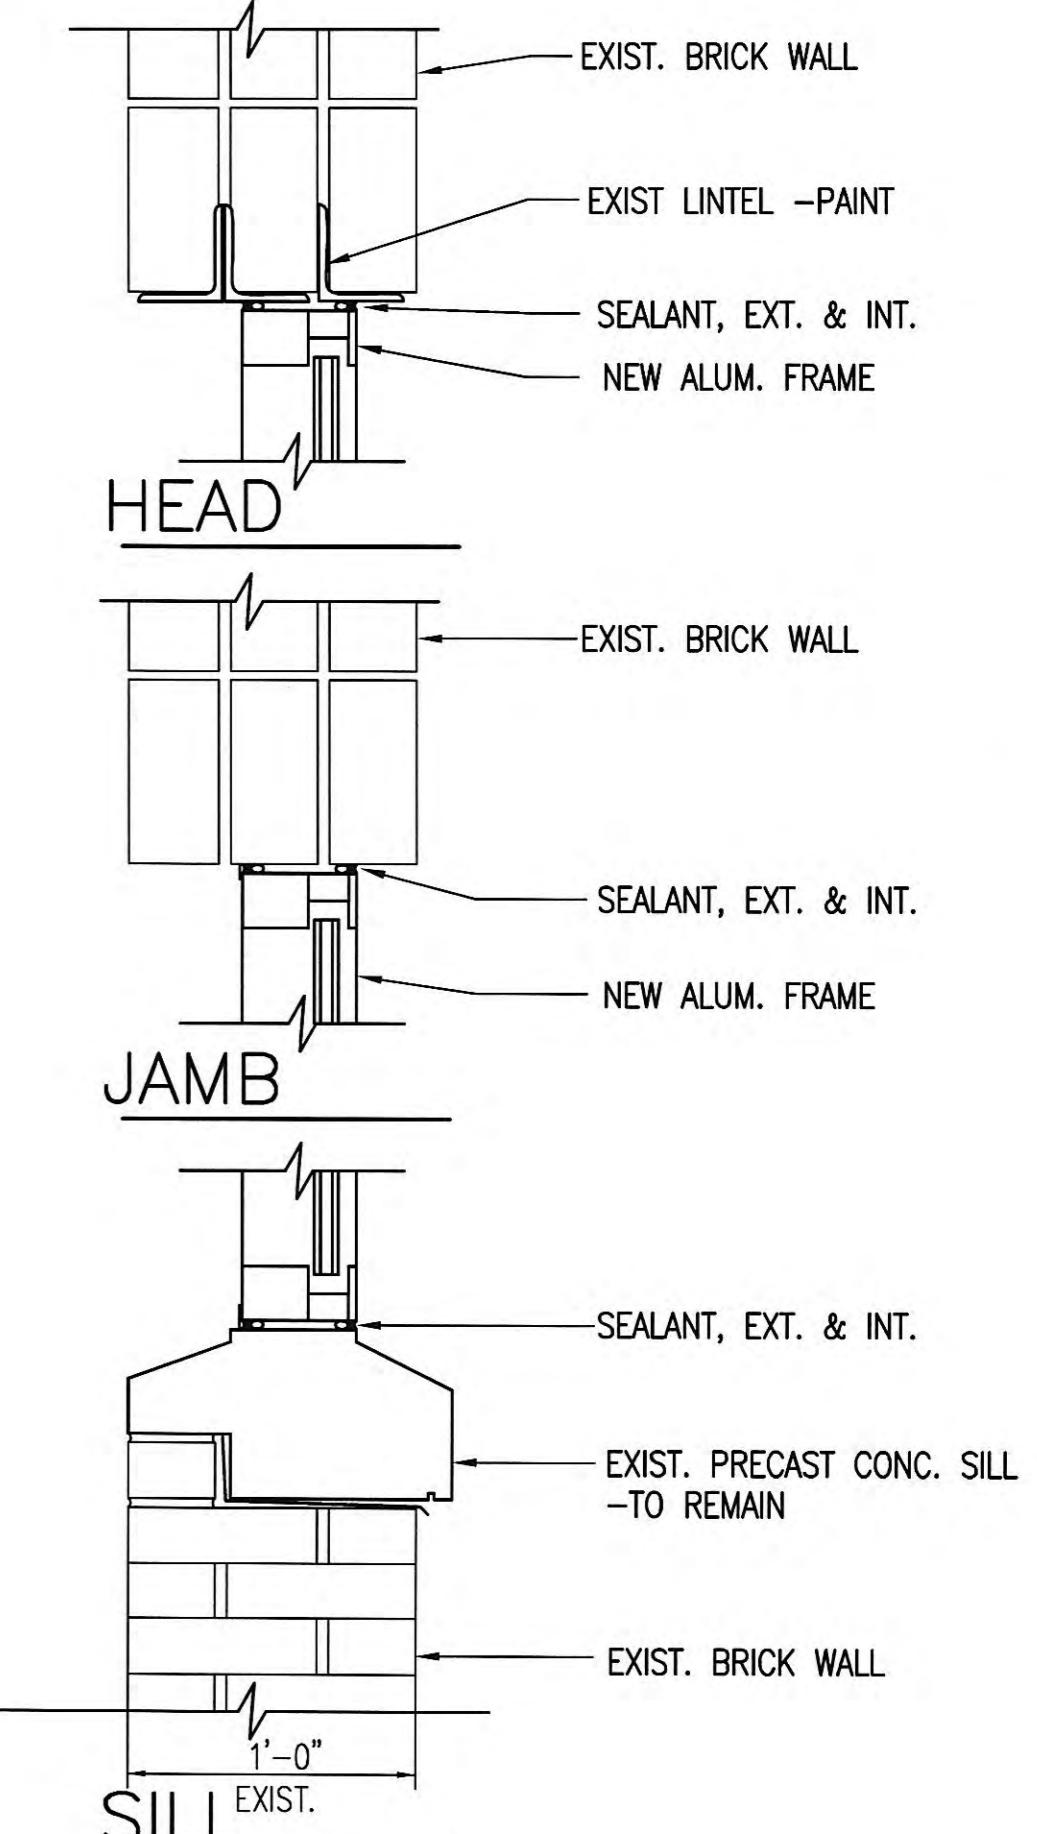


WINDOW DETAILS

SCALE: 1 1/2" = 1'-0"

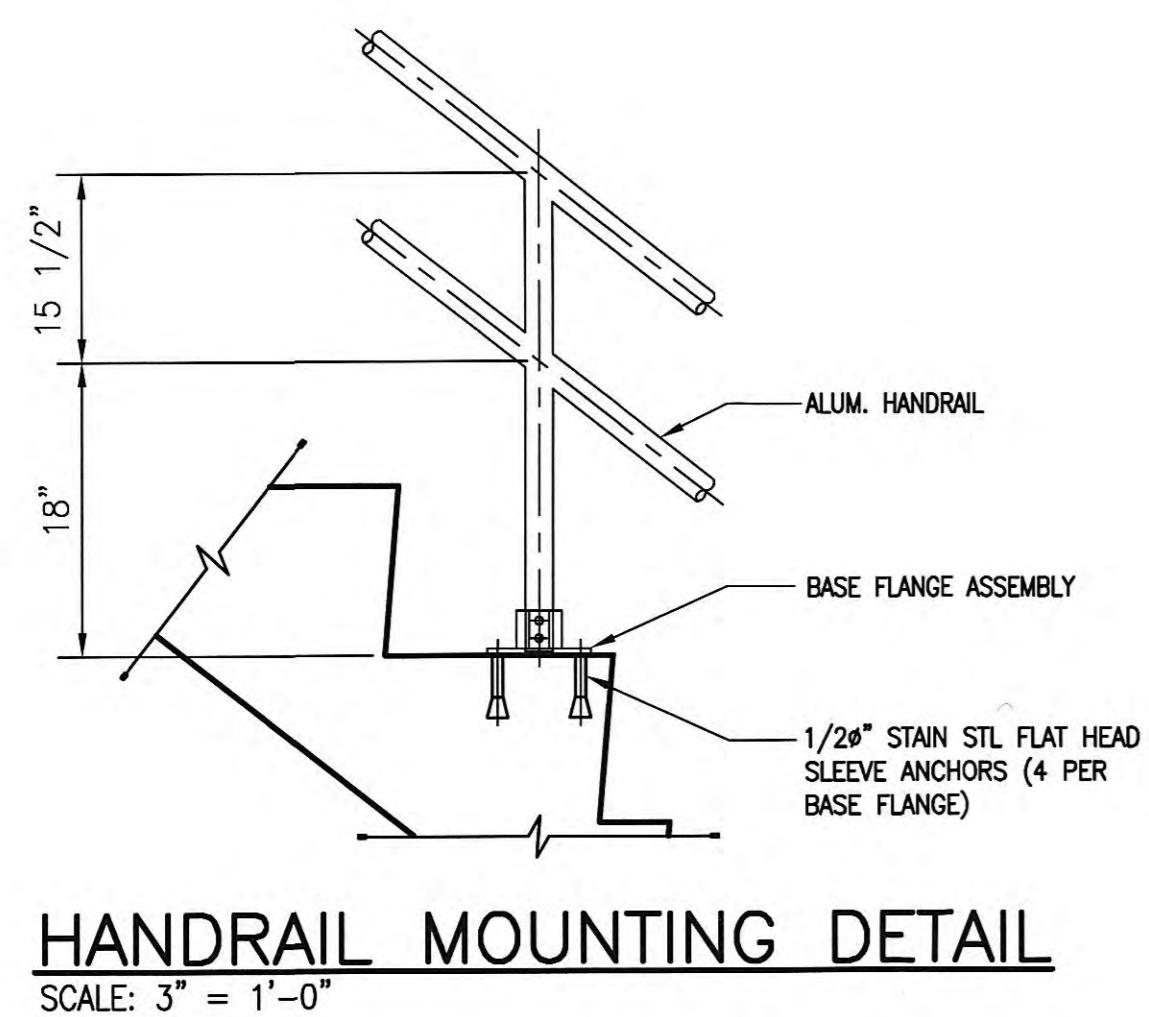


HANDRAIL MOUNTING DETAIL

SCALE: 3" = 1'-0"

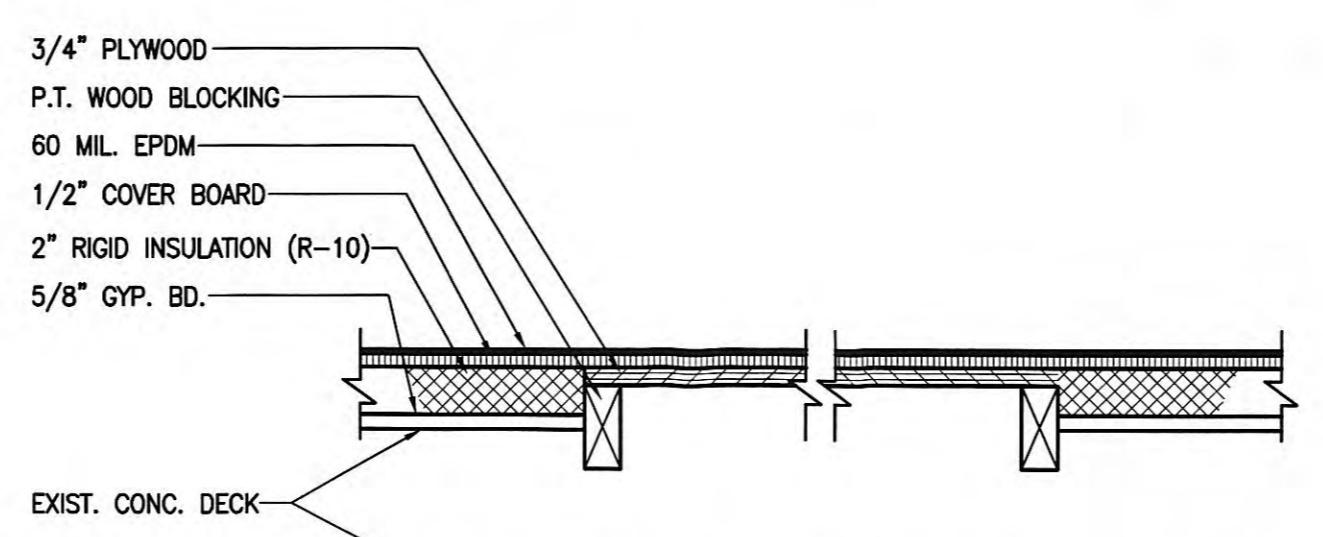


ROOF DETAIL AT OPENINGS

SCALE: 1 1/2" = 1'-0"

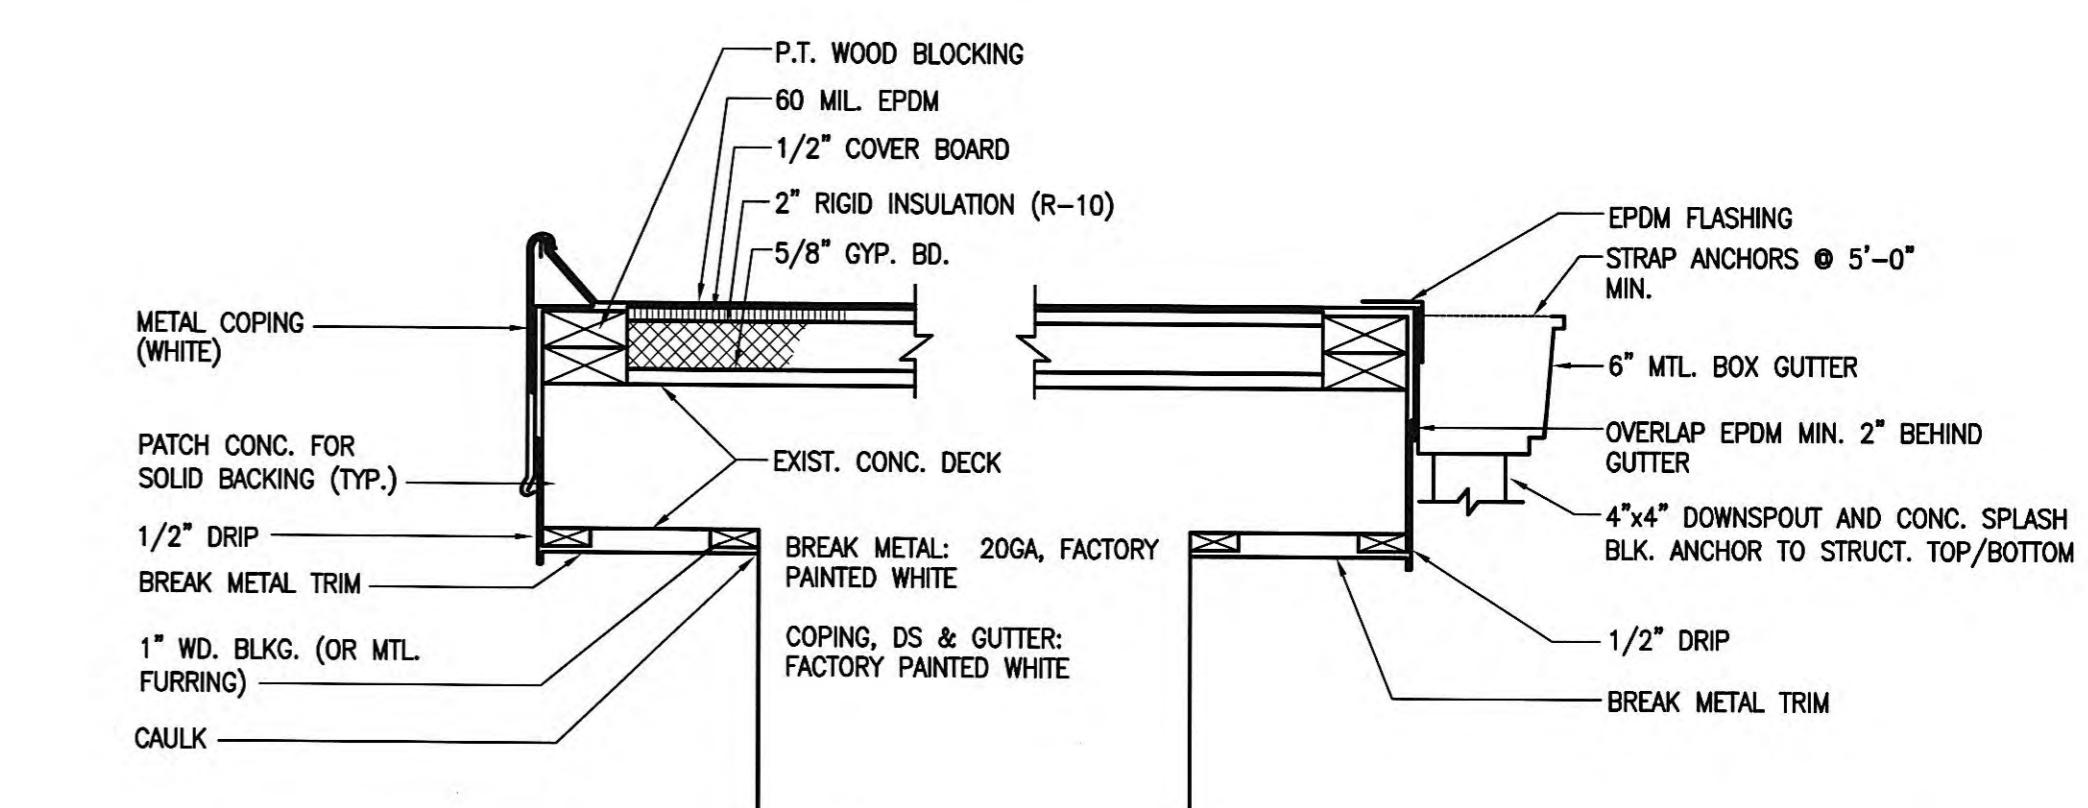

ROOF DETAIL

SCALE 1 1/2" = 1'-0"

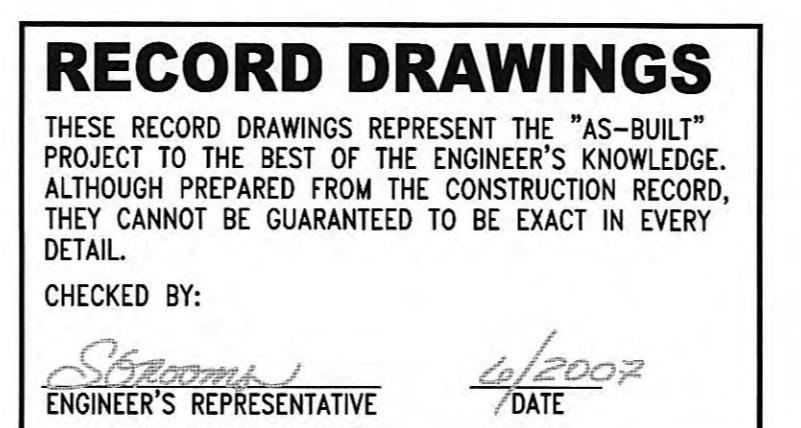

THESE RECORD DRAWINGS REPRESENT THE "AS-BUILT" PROJECT TO THE BEST OF THE ENGINEER'S KNOWLEDGE. ALTHOUGH PREPARED FROM THE CONSTRUCTION RECORD, THEY CANNOT BE GUARANTEED TO BE EXACT IN EVERY DETAIL.

DETAIL.
CHECKED BY:

SEARCHED BY:
S. Groom

Streams 6/2007

PROJECT NO. 7601-30


CONTRACT NO. S02-03

**EXISTING HARDEES SEWAGE PUMP STATION
ARCHITECTURAL PLANS AND SECTIONS
HARRIMAN UTILITY BOARD
HARRIMAN, TENNESSEE**


 <p>RW Elrod Dunson, Inc. Engineers, Architects, Planners</p> <p>LEXINGTON LOUISVILLE INDIANAPOLIS NASHVILLE KNOXVILLE</p>	DESIGNED:	DATE:
	JCP	JUNE, 2004
	DRAWN:	SCALE:
	STAFF	AS NOTED
REVIEWED:	SHEET NO.	
JCP		
APPROVED:		
JCP		

A-4


INTERIOR LIGHTING

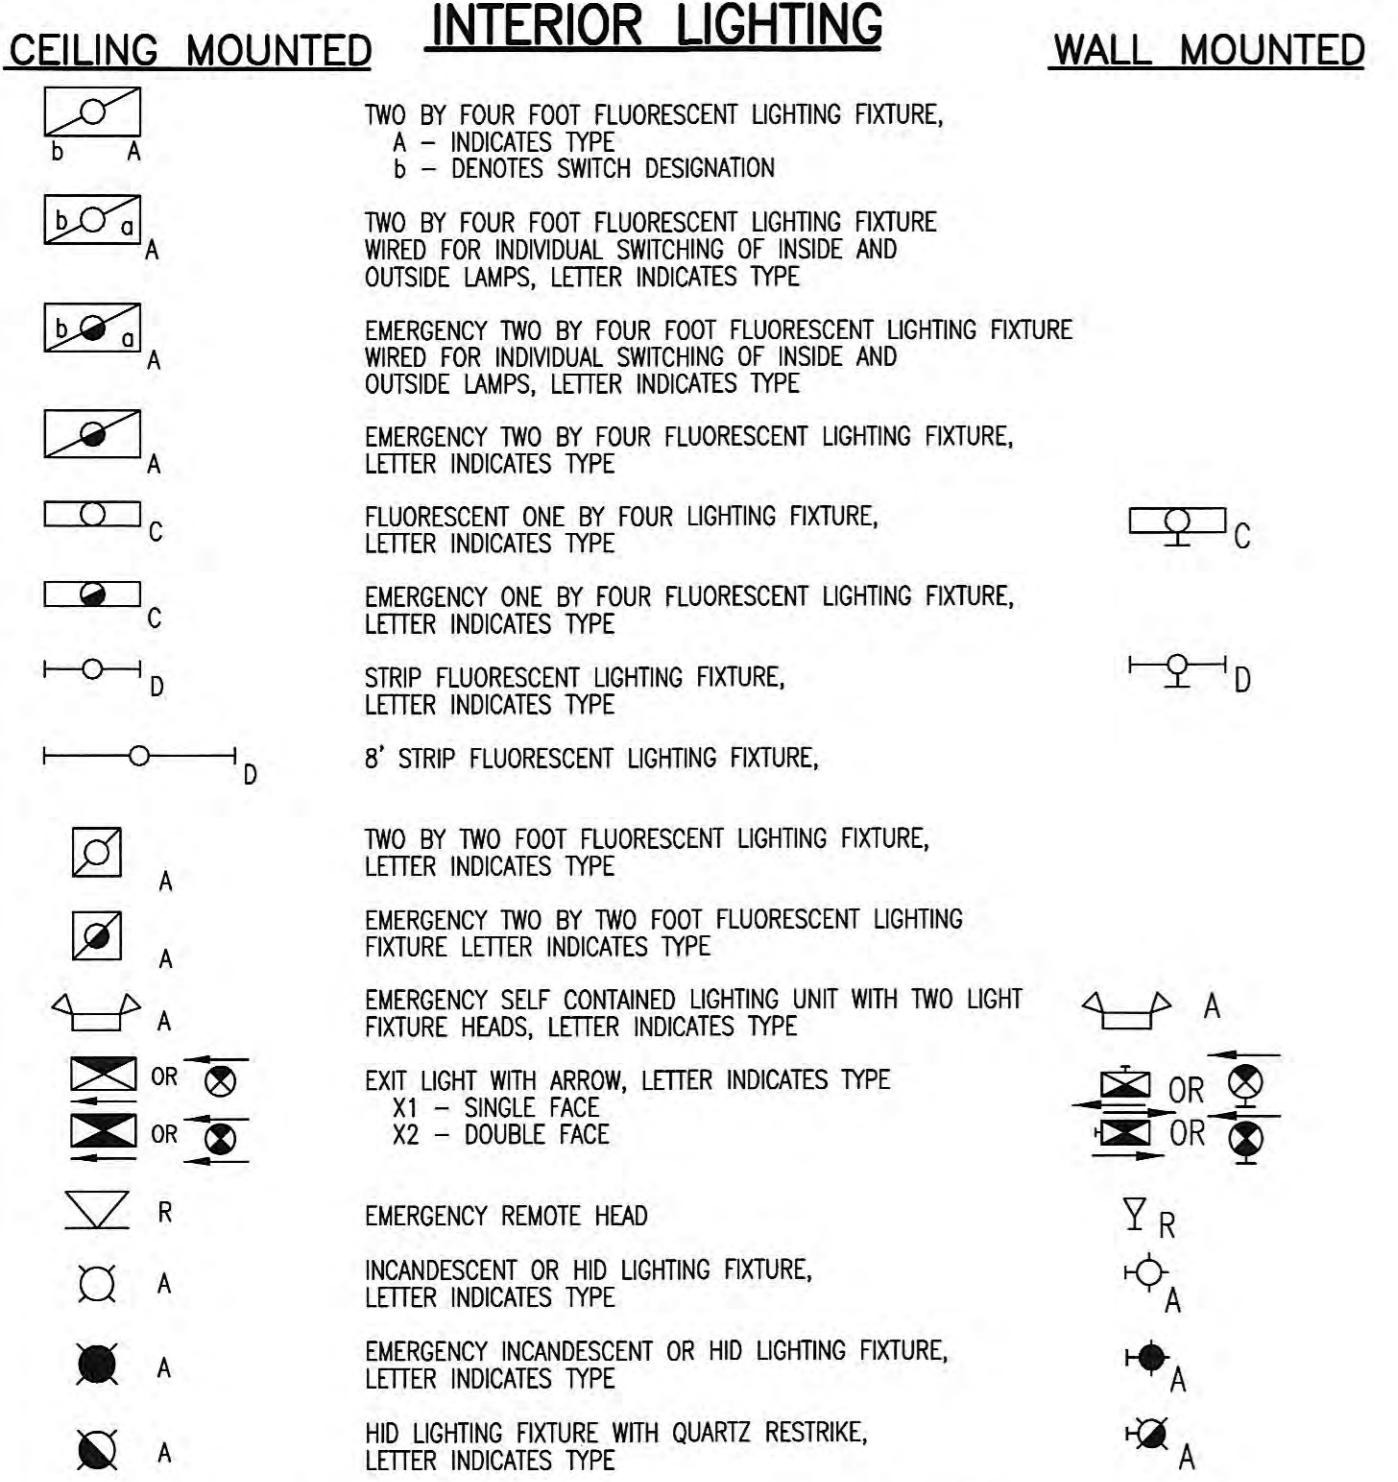



INTERIOR CONDUIT AND WIRE

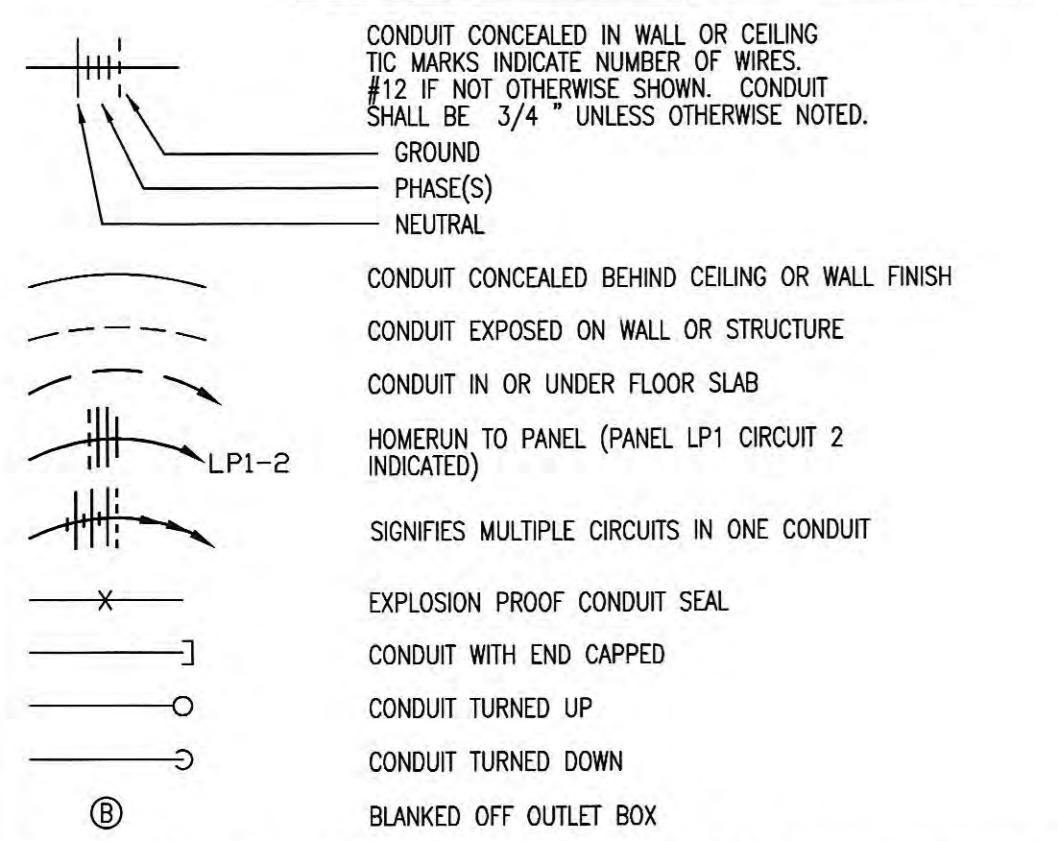


FIRE ALARM/SUPPRESSION SYSTEM DEVICES

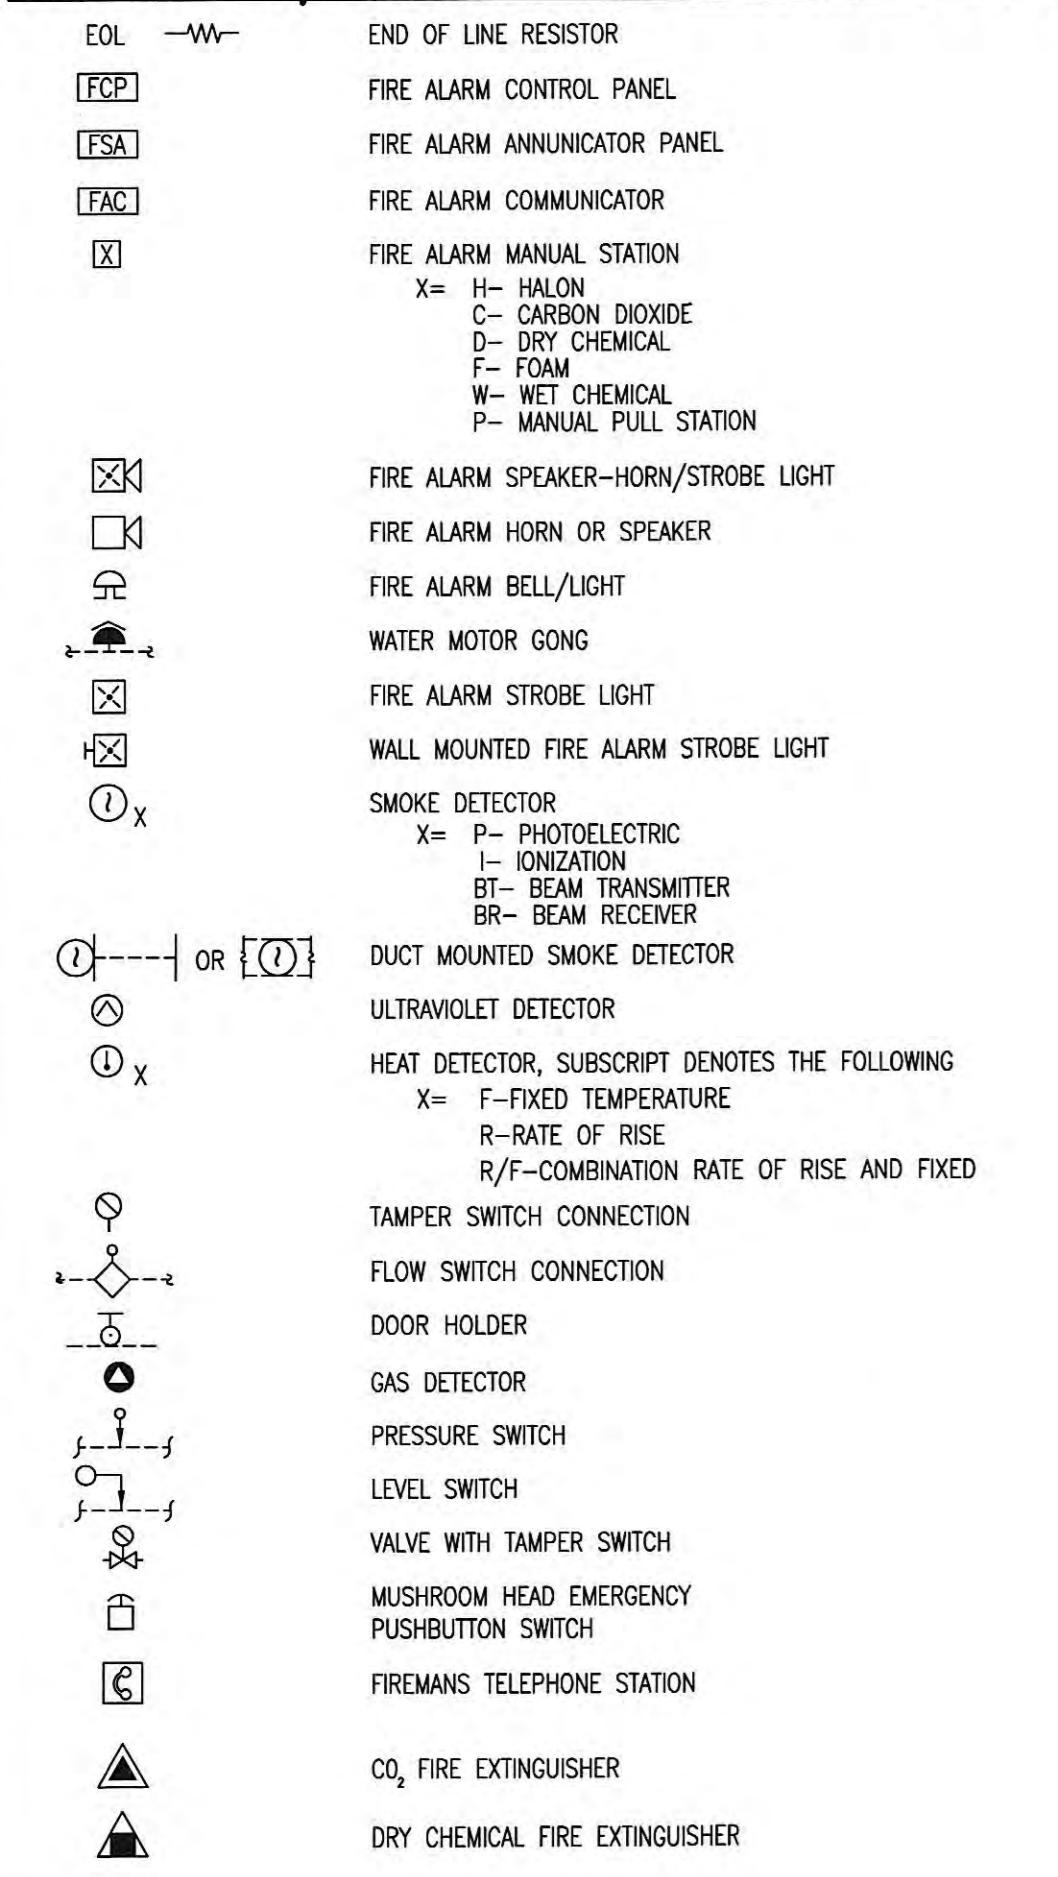


INTERIOR POWER EQUIPMENT AND DEVICES

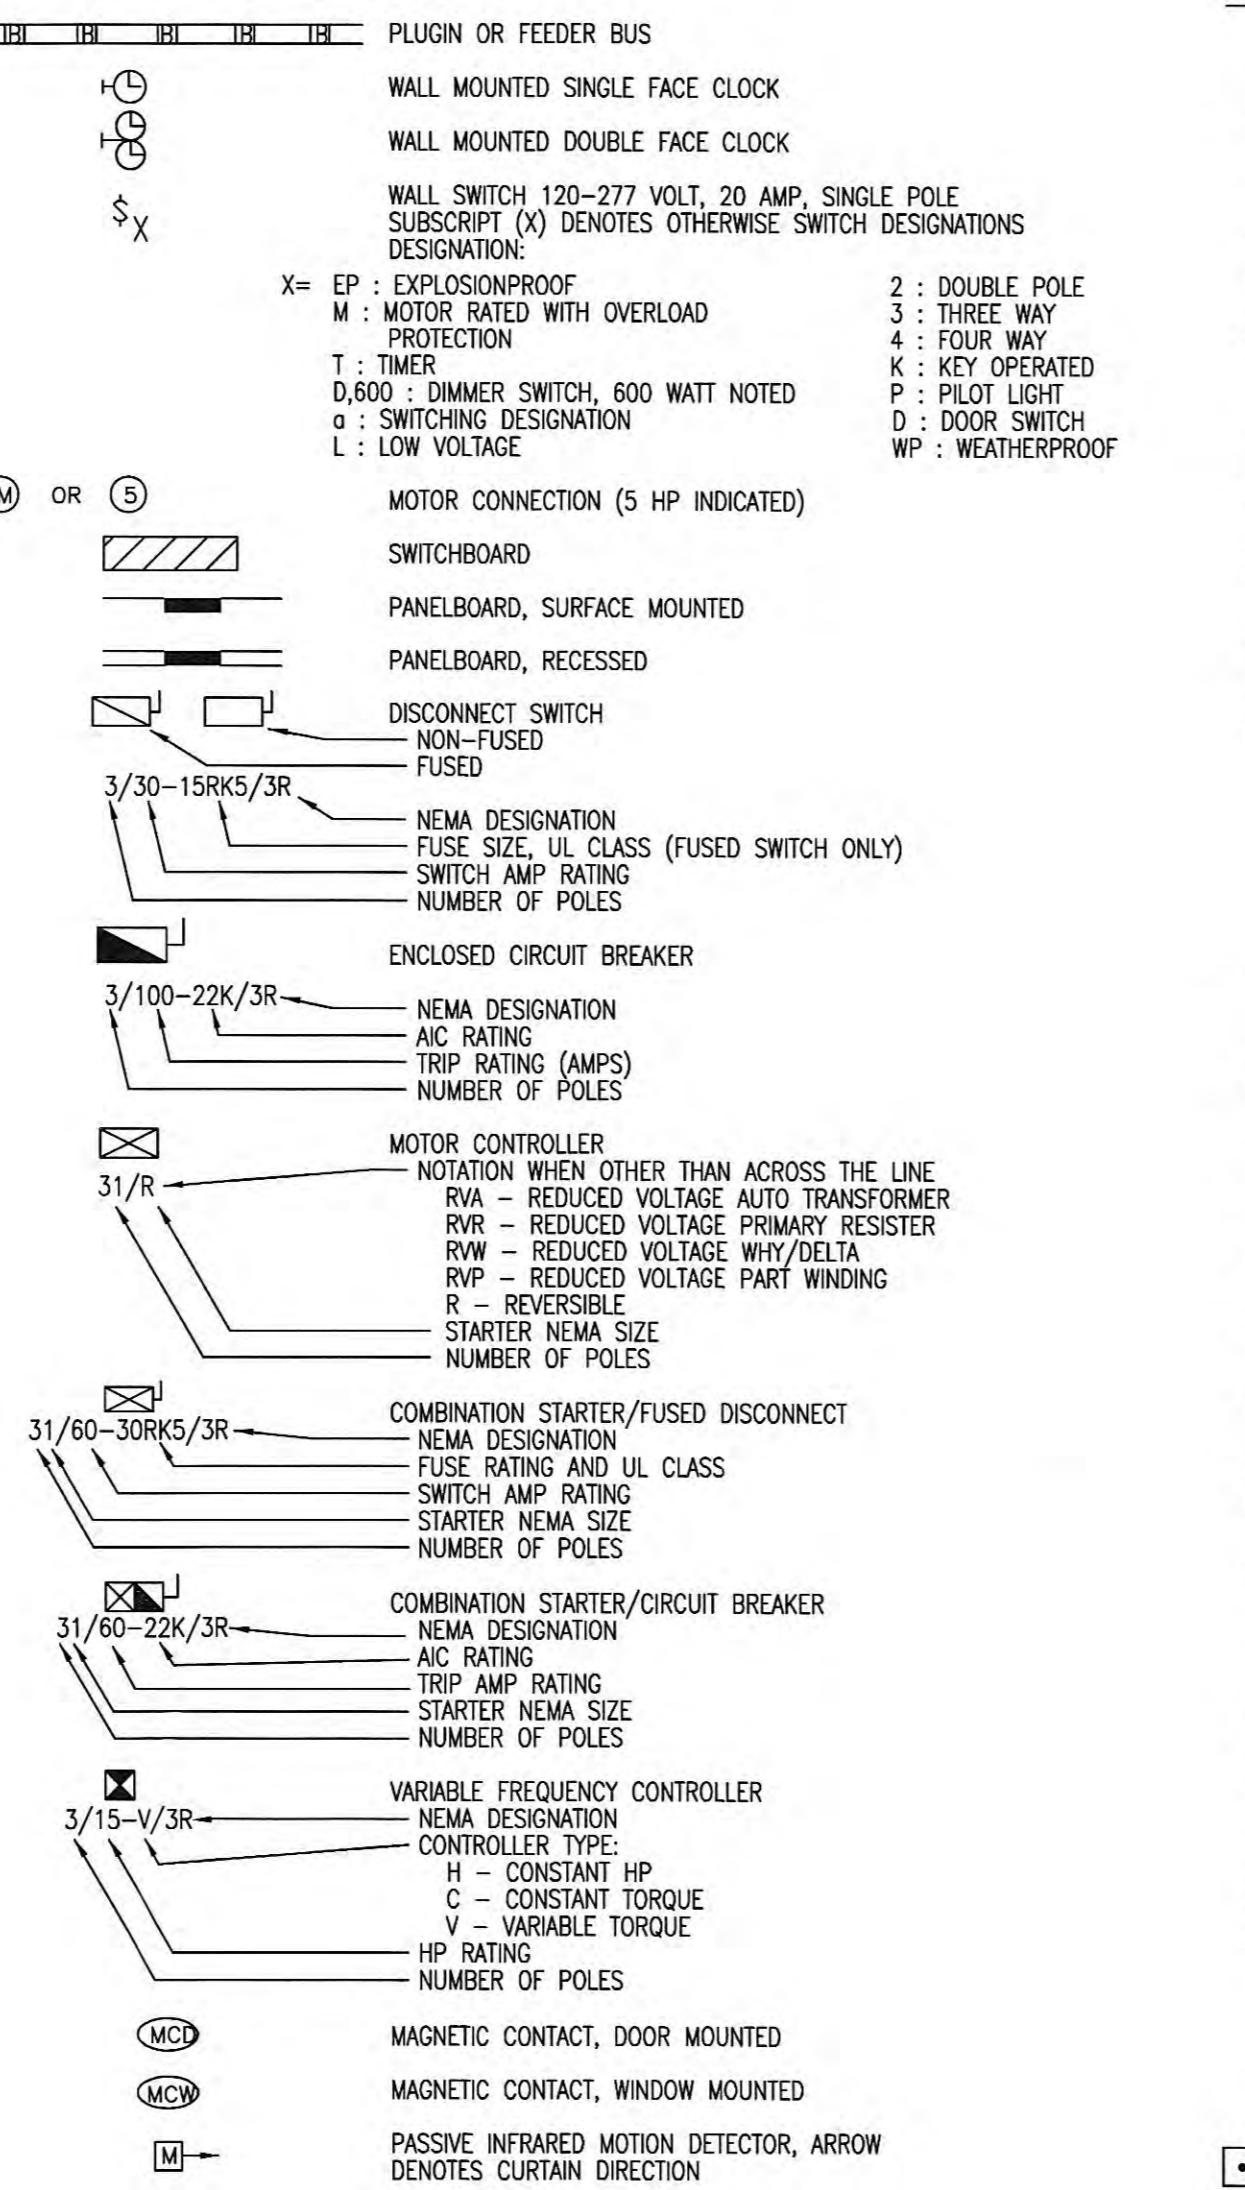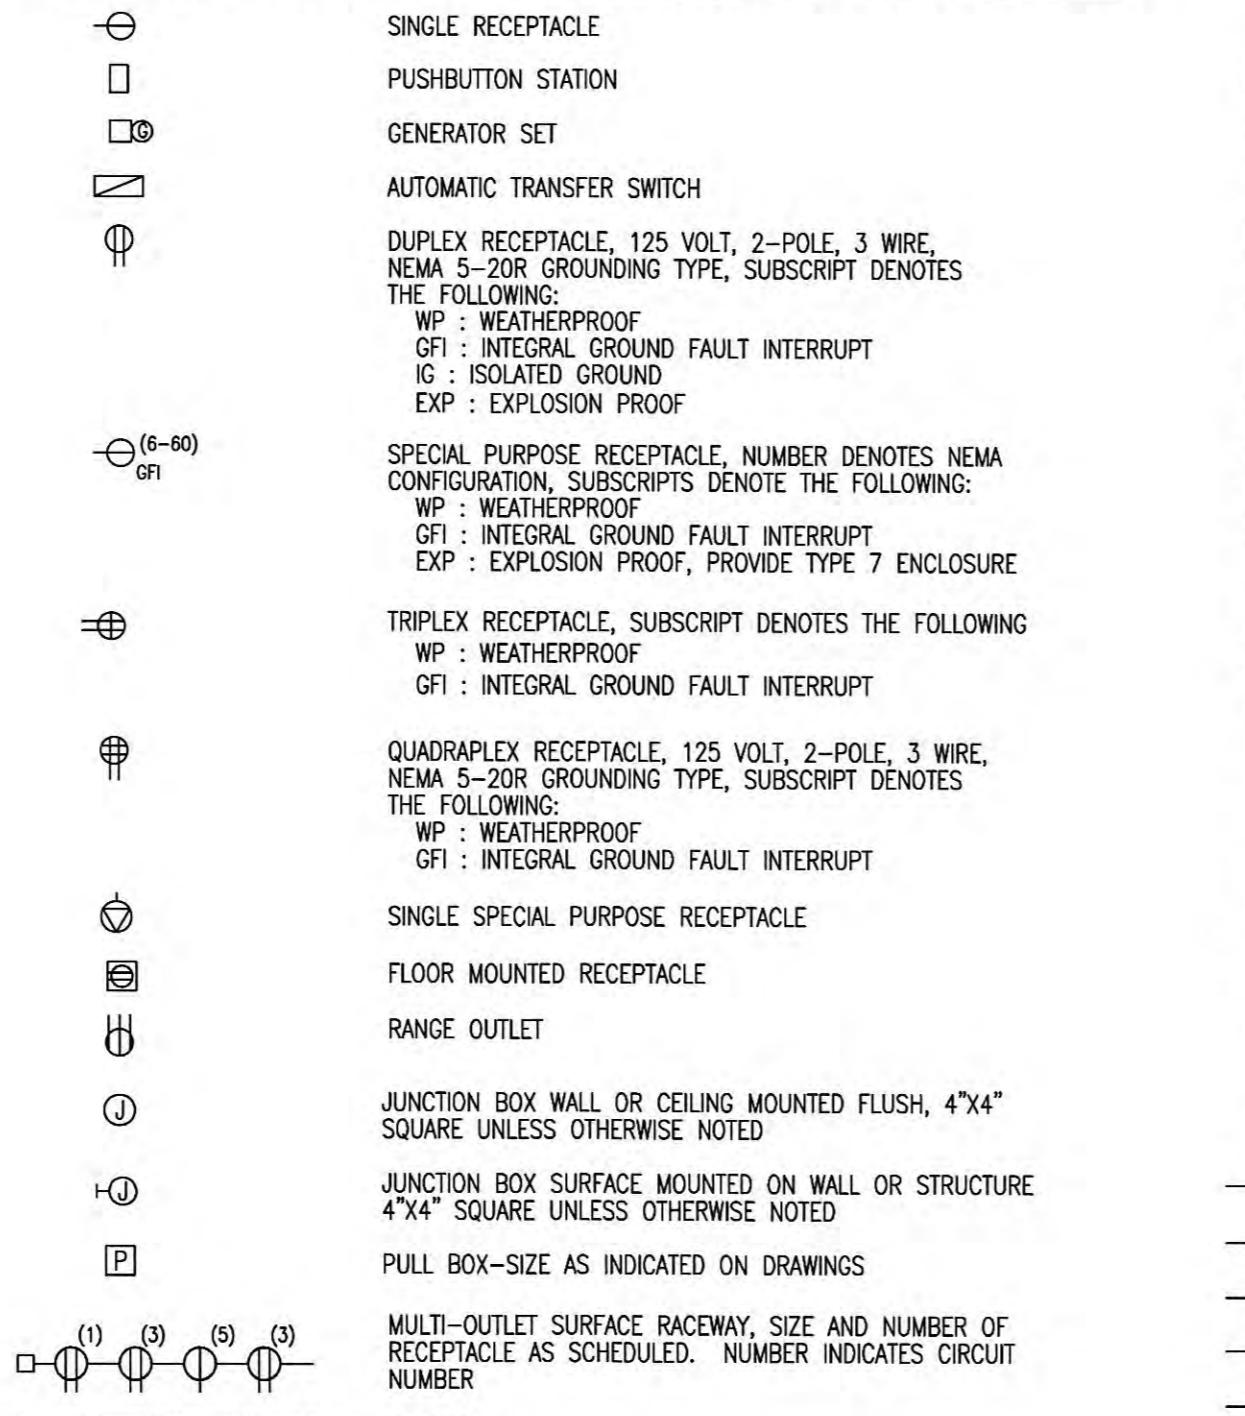

EXTERIOR

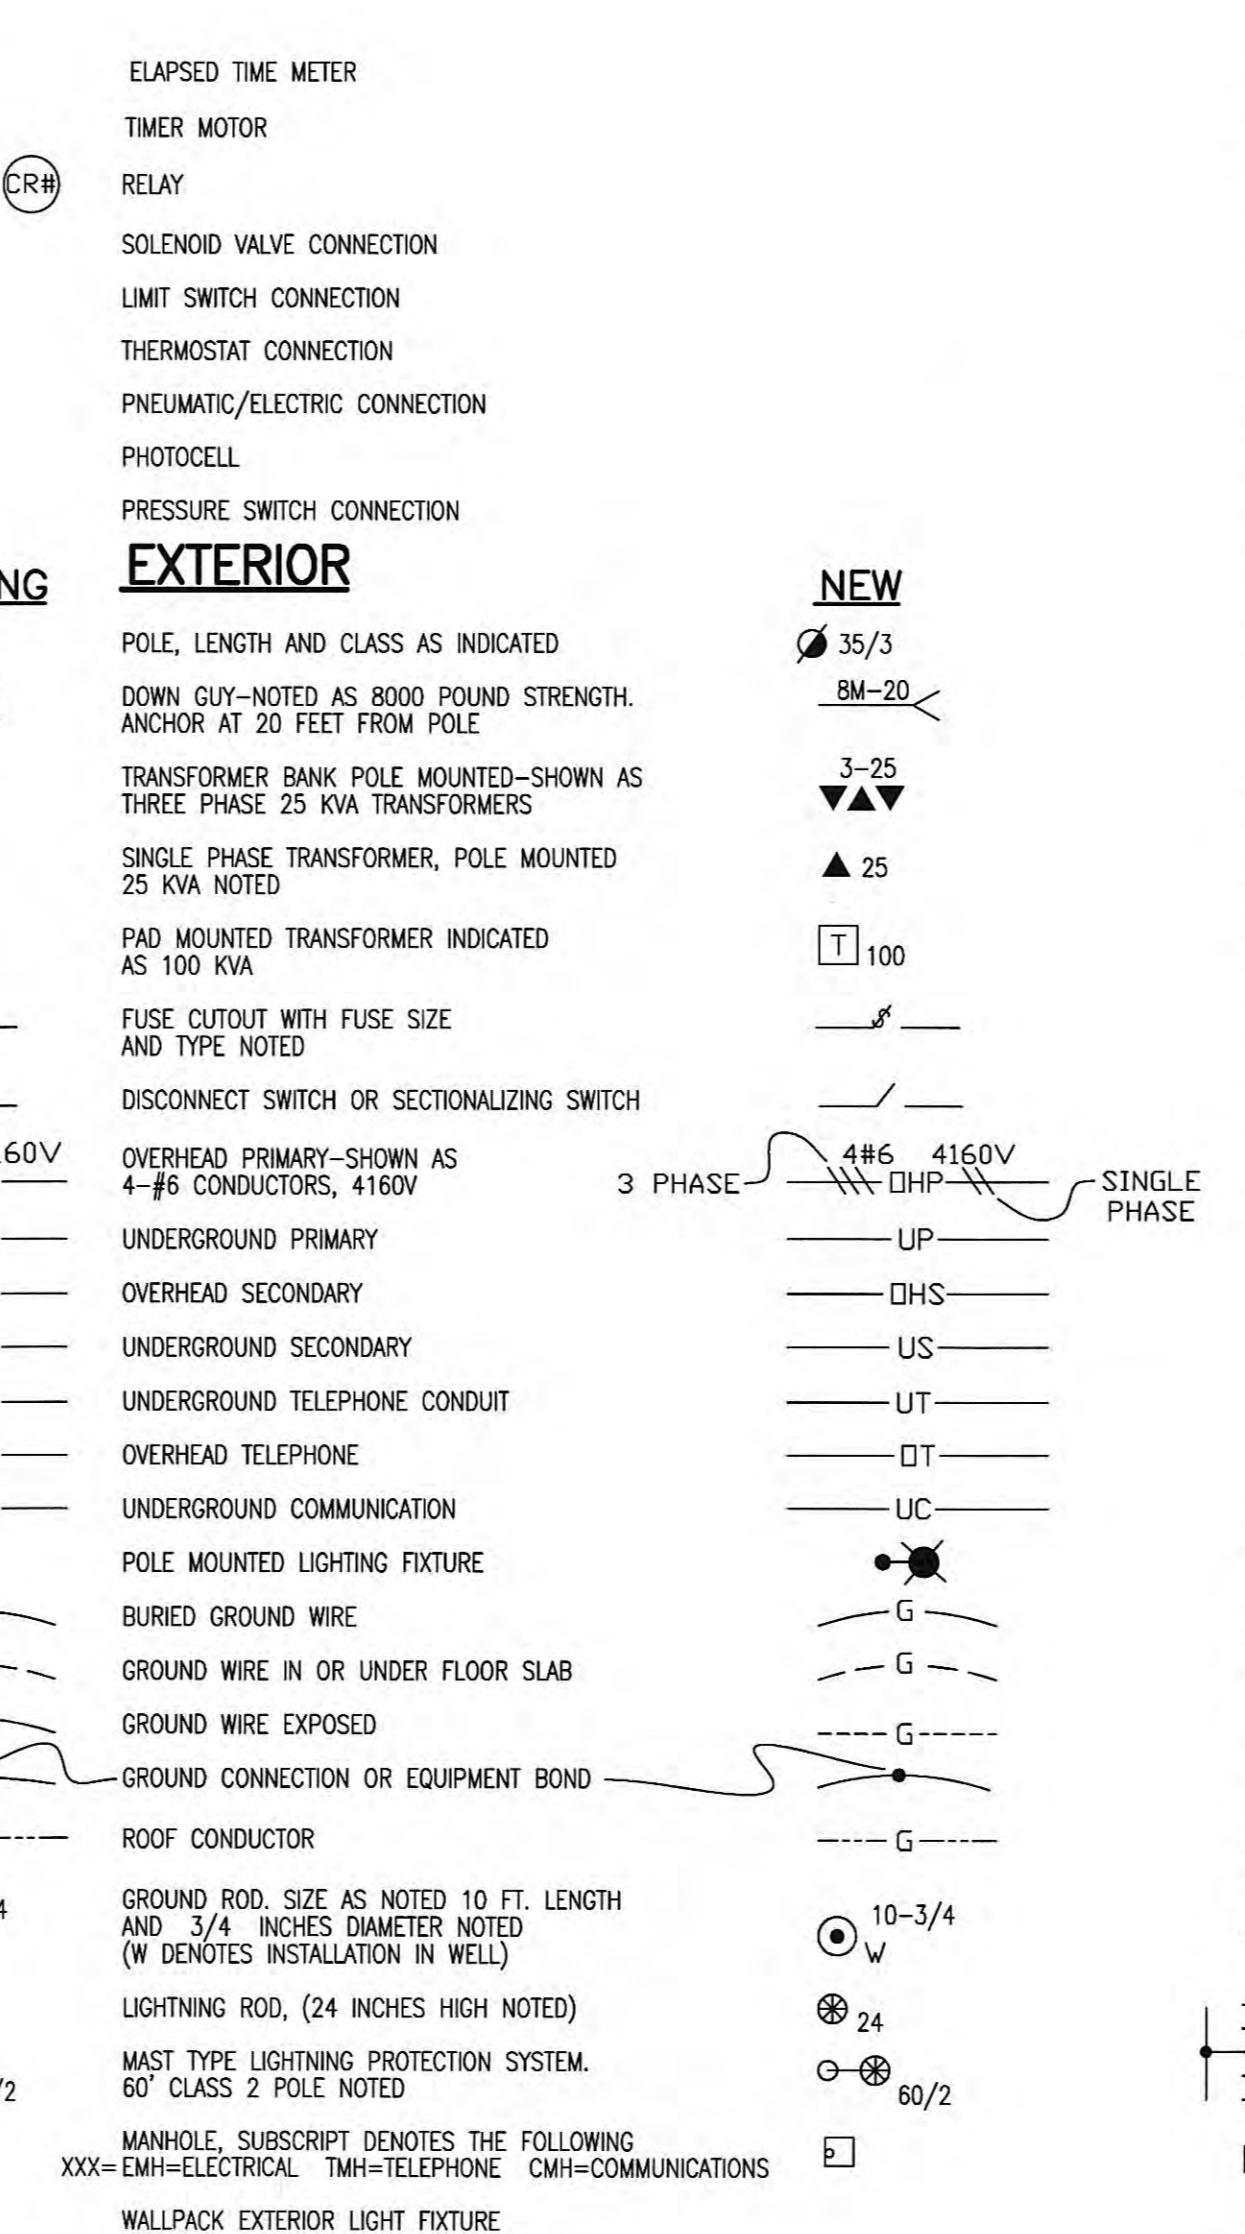

COMMUNICATION

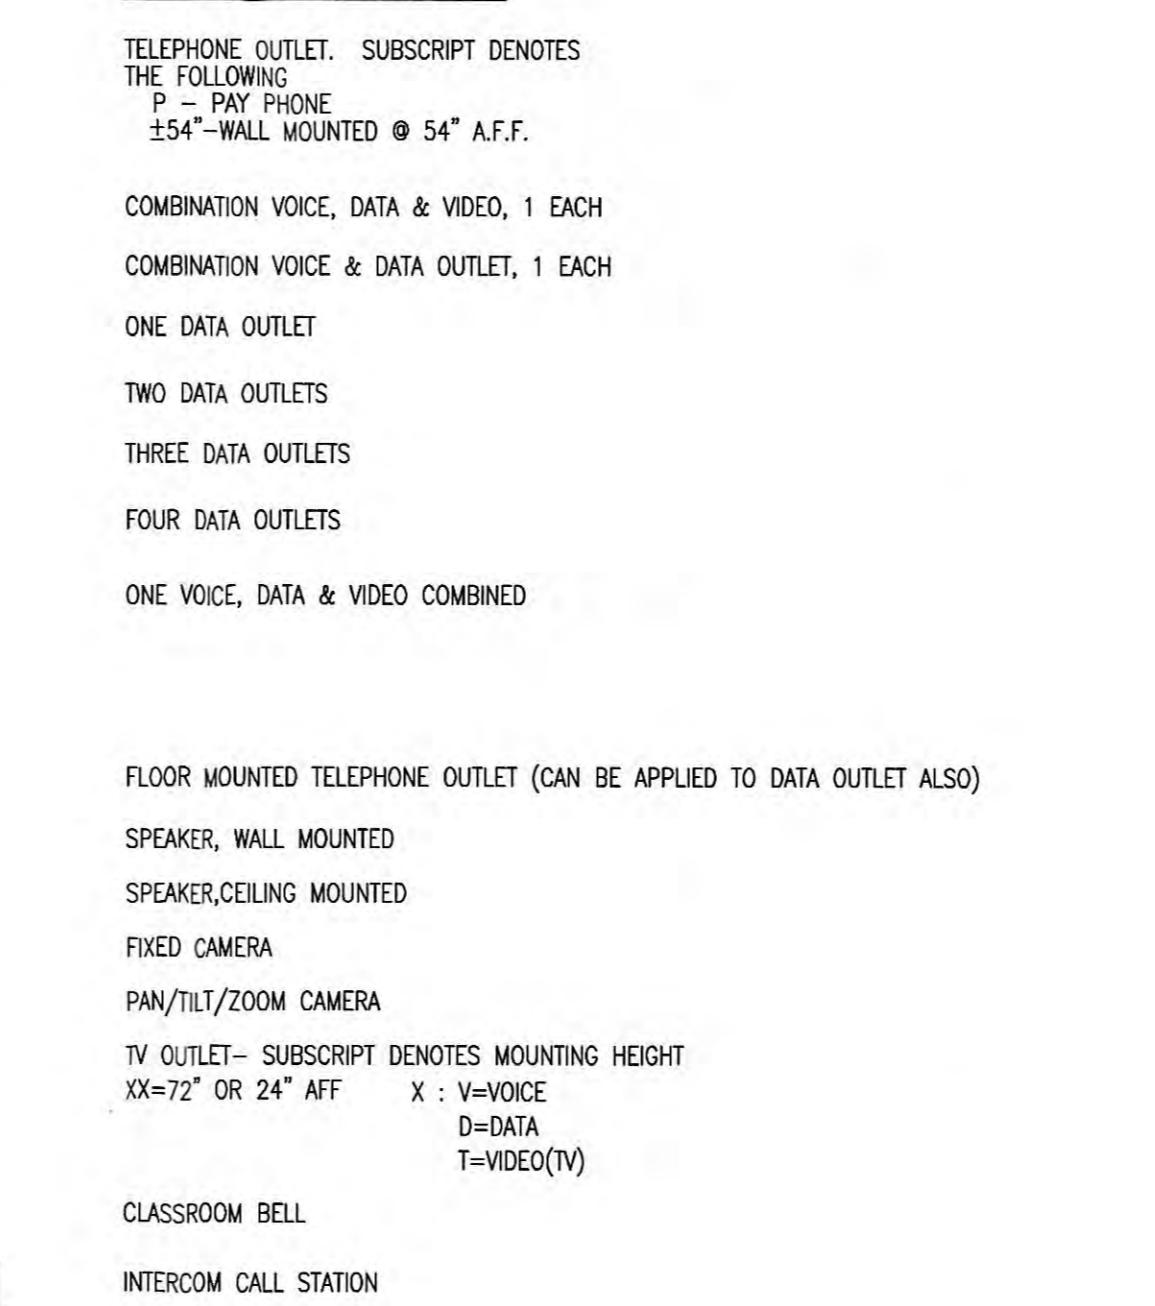

ABBREVIATIONS


A, AMP	- AMPERES	LA	- LIGHTNING ARRESTOR
AF	- AMPERE FRAME	LTC	- LIGHTING
AFF	- ABOVE FINISHED FLOOR	EM	- EMERGENCY
AGF	- ABOVE FINISHED GRADE	EMT	- ELECTRICAL METALLIC TUBING
AHU	- AIR HANDLING UNIT	ELD	- END OF LINE
AL	- ALUMINUM	EUD	- ELECTRIC UNIT HEATER
AT	- AUTOMATIC TRIP	MAU	- MAKEUP AIR UNIT
ATRV	- AUTOTRANSFORMER REDUCED VOLTAGE	MAX	- MAXIMUM
ATS	- AUTOMATIC TRANSFER SWITCH	MCB	- MAIN CIRCUIT BREAKER
AWG	- AMERICAN WIRE GAUGE	MCC	- MOTOR CONTROL CENTER
BLDG	- BUILDING	MCP	- MOTOR CIRCUIT PROTECTOR
CB	- CIRCUIT BREAKER	MDP	- MAIN DISTRIBUTION PANEL
CCTV	- CLOSED CIRCUIT TELEVISION	MFR	- MANUFACTURER
CKT	- CIRCUIT	MG	- MOTOR GENERATOR
C/L	- CENTERLINE	MH	- MANHOLE, METAL HALIDE, MOUNTING HEIGHT
CLG	- CEILING	MIC	- MICROPHONE
COND	- CONDUCTOR	SW	- SWITCH
CONN	- CONNECTION	SYS	- SYSTEM
CTL	- CONTROL	TEL	- TELEPHONE
CU	- COPPER	TM	- THERMAL MAGNETIC
DACT	- DIGITAL ALARM COMMUNICATING TRANSMITTER	TVSS	- TRANSIENT VOLTAGE SURGE SUPPRESSOR
DB	- DIRECT BURIAL	TYP	- TYPICAL
DET	- DETAIL	UGC	- UNDERGROUND
DP	- DISTRIBUTION PANEL	V	- VOLTAGE
DISC	- DISCONNECT	VFD	- VARIABLE FREQUENCY DRIVE
DN	- DOWN	W	- WIRE
DP	- DISTRIBUTION PANEL	W/WITH	- WITH
DPS	- DOUBLE POLE SINGLE THROW	W/OUT	- WITHOUT
EA	- EACH	WP	- WEATHERPROOF
EC	- EMPTY CONDUIT	WT	- WEIGHT
ELEC	- ELECTRICAL	X'FMR, XFMR	- TRANSFORMER

• LIST OF ABBREVIATIONS, ACRONYMS, AND SYMBOLS IS A STANDARD LIST.
NOT ALL SYMBOLS ARE USED ON THIS PROJECT.

• SYMBOLS USED BUT NOT LISTED HERE SHALL BE DEFINED ELSEWHERE IN THE BID DOCUMENTS. IF NOT, CONTACT THE ENGINEER FOR CLARIFICATION PRIOR TO BID OPENING.

(A) KEY NOTE CALL OUT

CONTROLS

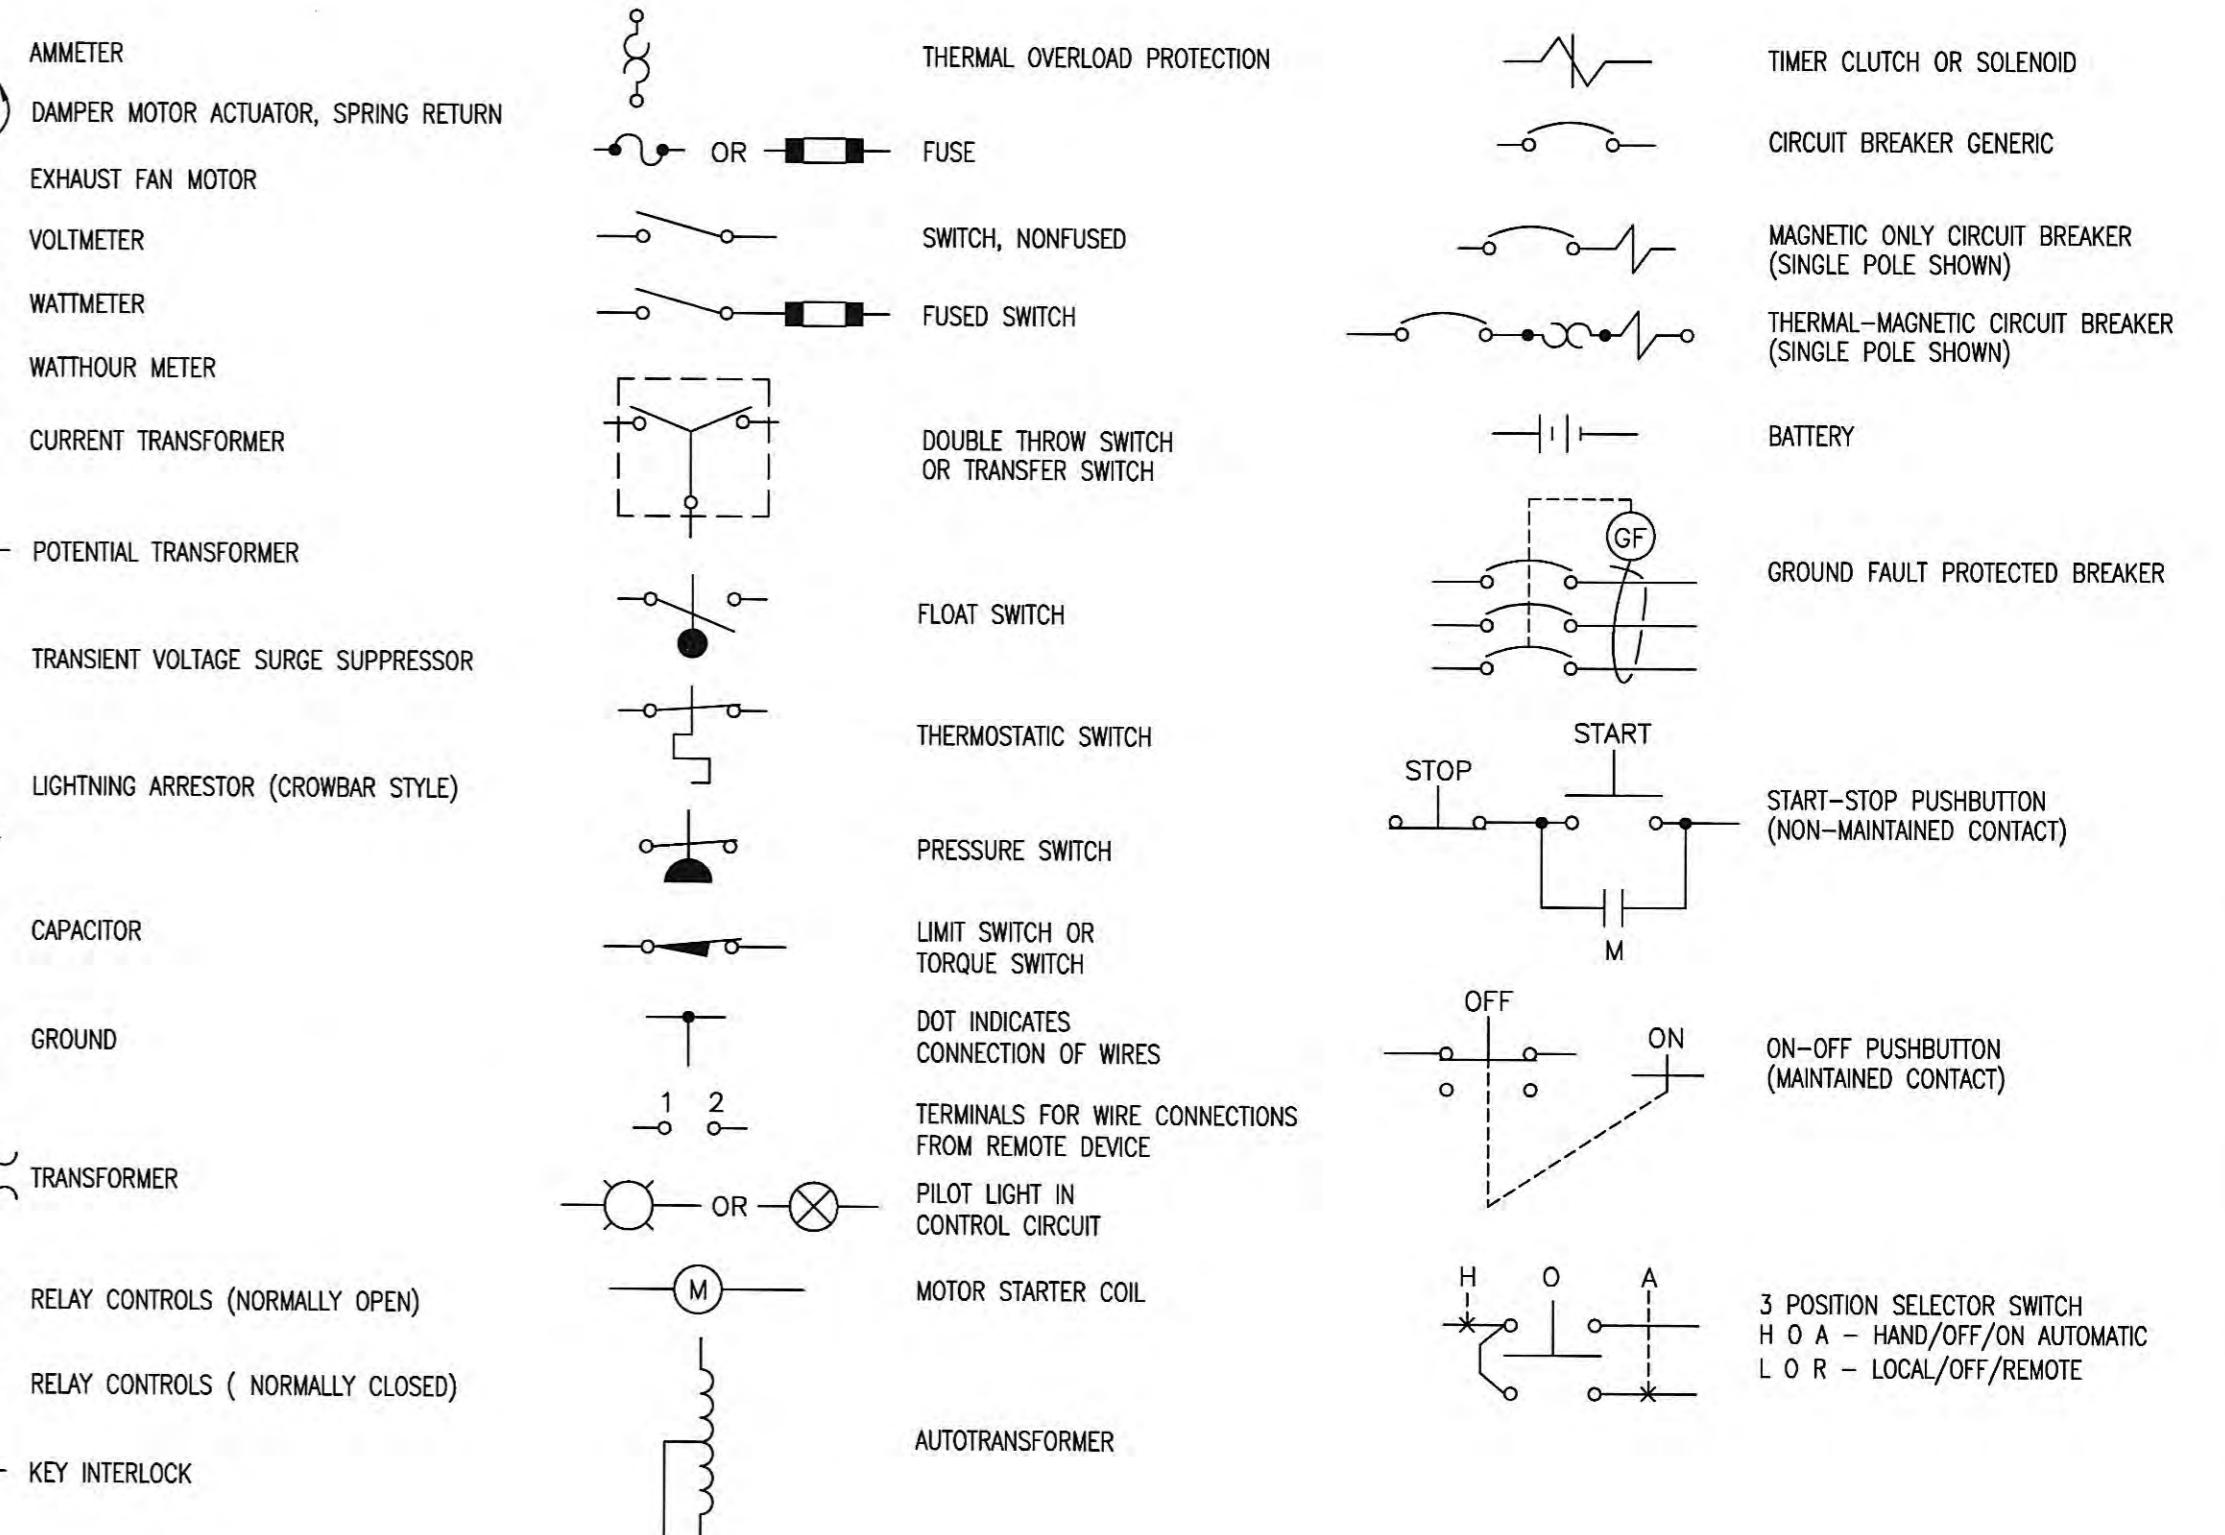

RECORD DRAWINGS

THESE RECORD DRAWINGS REPRESENT THE "AS-BUILT" PROJECT TO THE BEST OF THE ENGINEER'S KNOWLEDGE. ALTHOUGH PREPARED FROM THE CONSTRUCTION RECORD, THEY CANNOT BE GUARANTEED TO BE EXACT IN EVERY DETAIL.

CHECKED BY:
Shannon
ENGINEER'S REPRESENTATIVE
DATE: *6/2007*

ELECTRICAL SYMBOL SHEET		CONTRACT NO. S02-03	
HARRIMAN UTILITY BOARD			
HARRIMAN, TENNESSEE			
ALL RIGHTS RESERVED: THIS DOCUMENT IS THE PROPERTY OF GRW ELROD DUNSON, INC. AND SHALL NOT BE REPRODUCED IN WHOLE OR IN PART OR USED FOR CONSTRUCTION OF OTHER THAN THIS SPECIFIC PROJECT WITHOUT WRITTEN PERMISSION OF GRW ELROD DUNSON, INC.			
NO.	DESCRIPTION	DATE	BY
REVISIONS			
DESIGNED:	WLM	DATE:	JUNE, 2004
DRAWN:	JMG	SCALE:	AS NOTED
REVIEWED:	WLM	SHEET NO.	
APPROVED:	WLM		E-1



CONSTRUCTION PLANS
FOR
WASTEWATER SYSTEM IMPROVEMENTS

**HARRIMAN UTILITY BOARD
HARRIMAN, TENNESSEE**

**SOUTH HARRIMAN
PUMP STATIONS REHABILITATION**

**CONTRACT S02-03
NOVEMBER, 2002**

RECORD DRAWINGS
THESE RECORD DRAWINGS REPRESENT THE "AS-BUILT"
PROJECT TO THE BEST OF THE ENGINEER'S KNOWLEDGE.
ALTHOUGH PREPARED FROM THE CONSTRUCTION RECORD,
THEY CANNOT BE GUARANTEED TO BE EXACT IN EVERY
DETAIL.
CHECKED BY:
S. Groom *10/2002*
ENGINEER'S REPRESENTATIVE */DATE*



GRW Elrod Dunson, Inc.

Engineers, Architects, Planners



404 BNA Drive, Suite 201 NASHVILLE, TN 37217
PH. (615)366-1600 FAX (615)366-0406

LEXINGTON LOUISVILLE NASHVILLE KNOXVILLE INDIANAPOLIS

Accepted By: _____
Title: _____ MANAGER
For: _____ HARRIMAN UTILITY BOARD
Date: _____


PROJECT NO. 7601-30

SET NO.

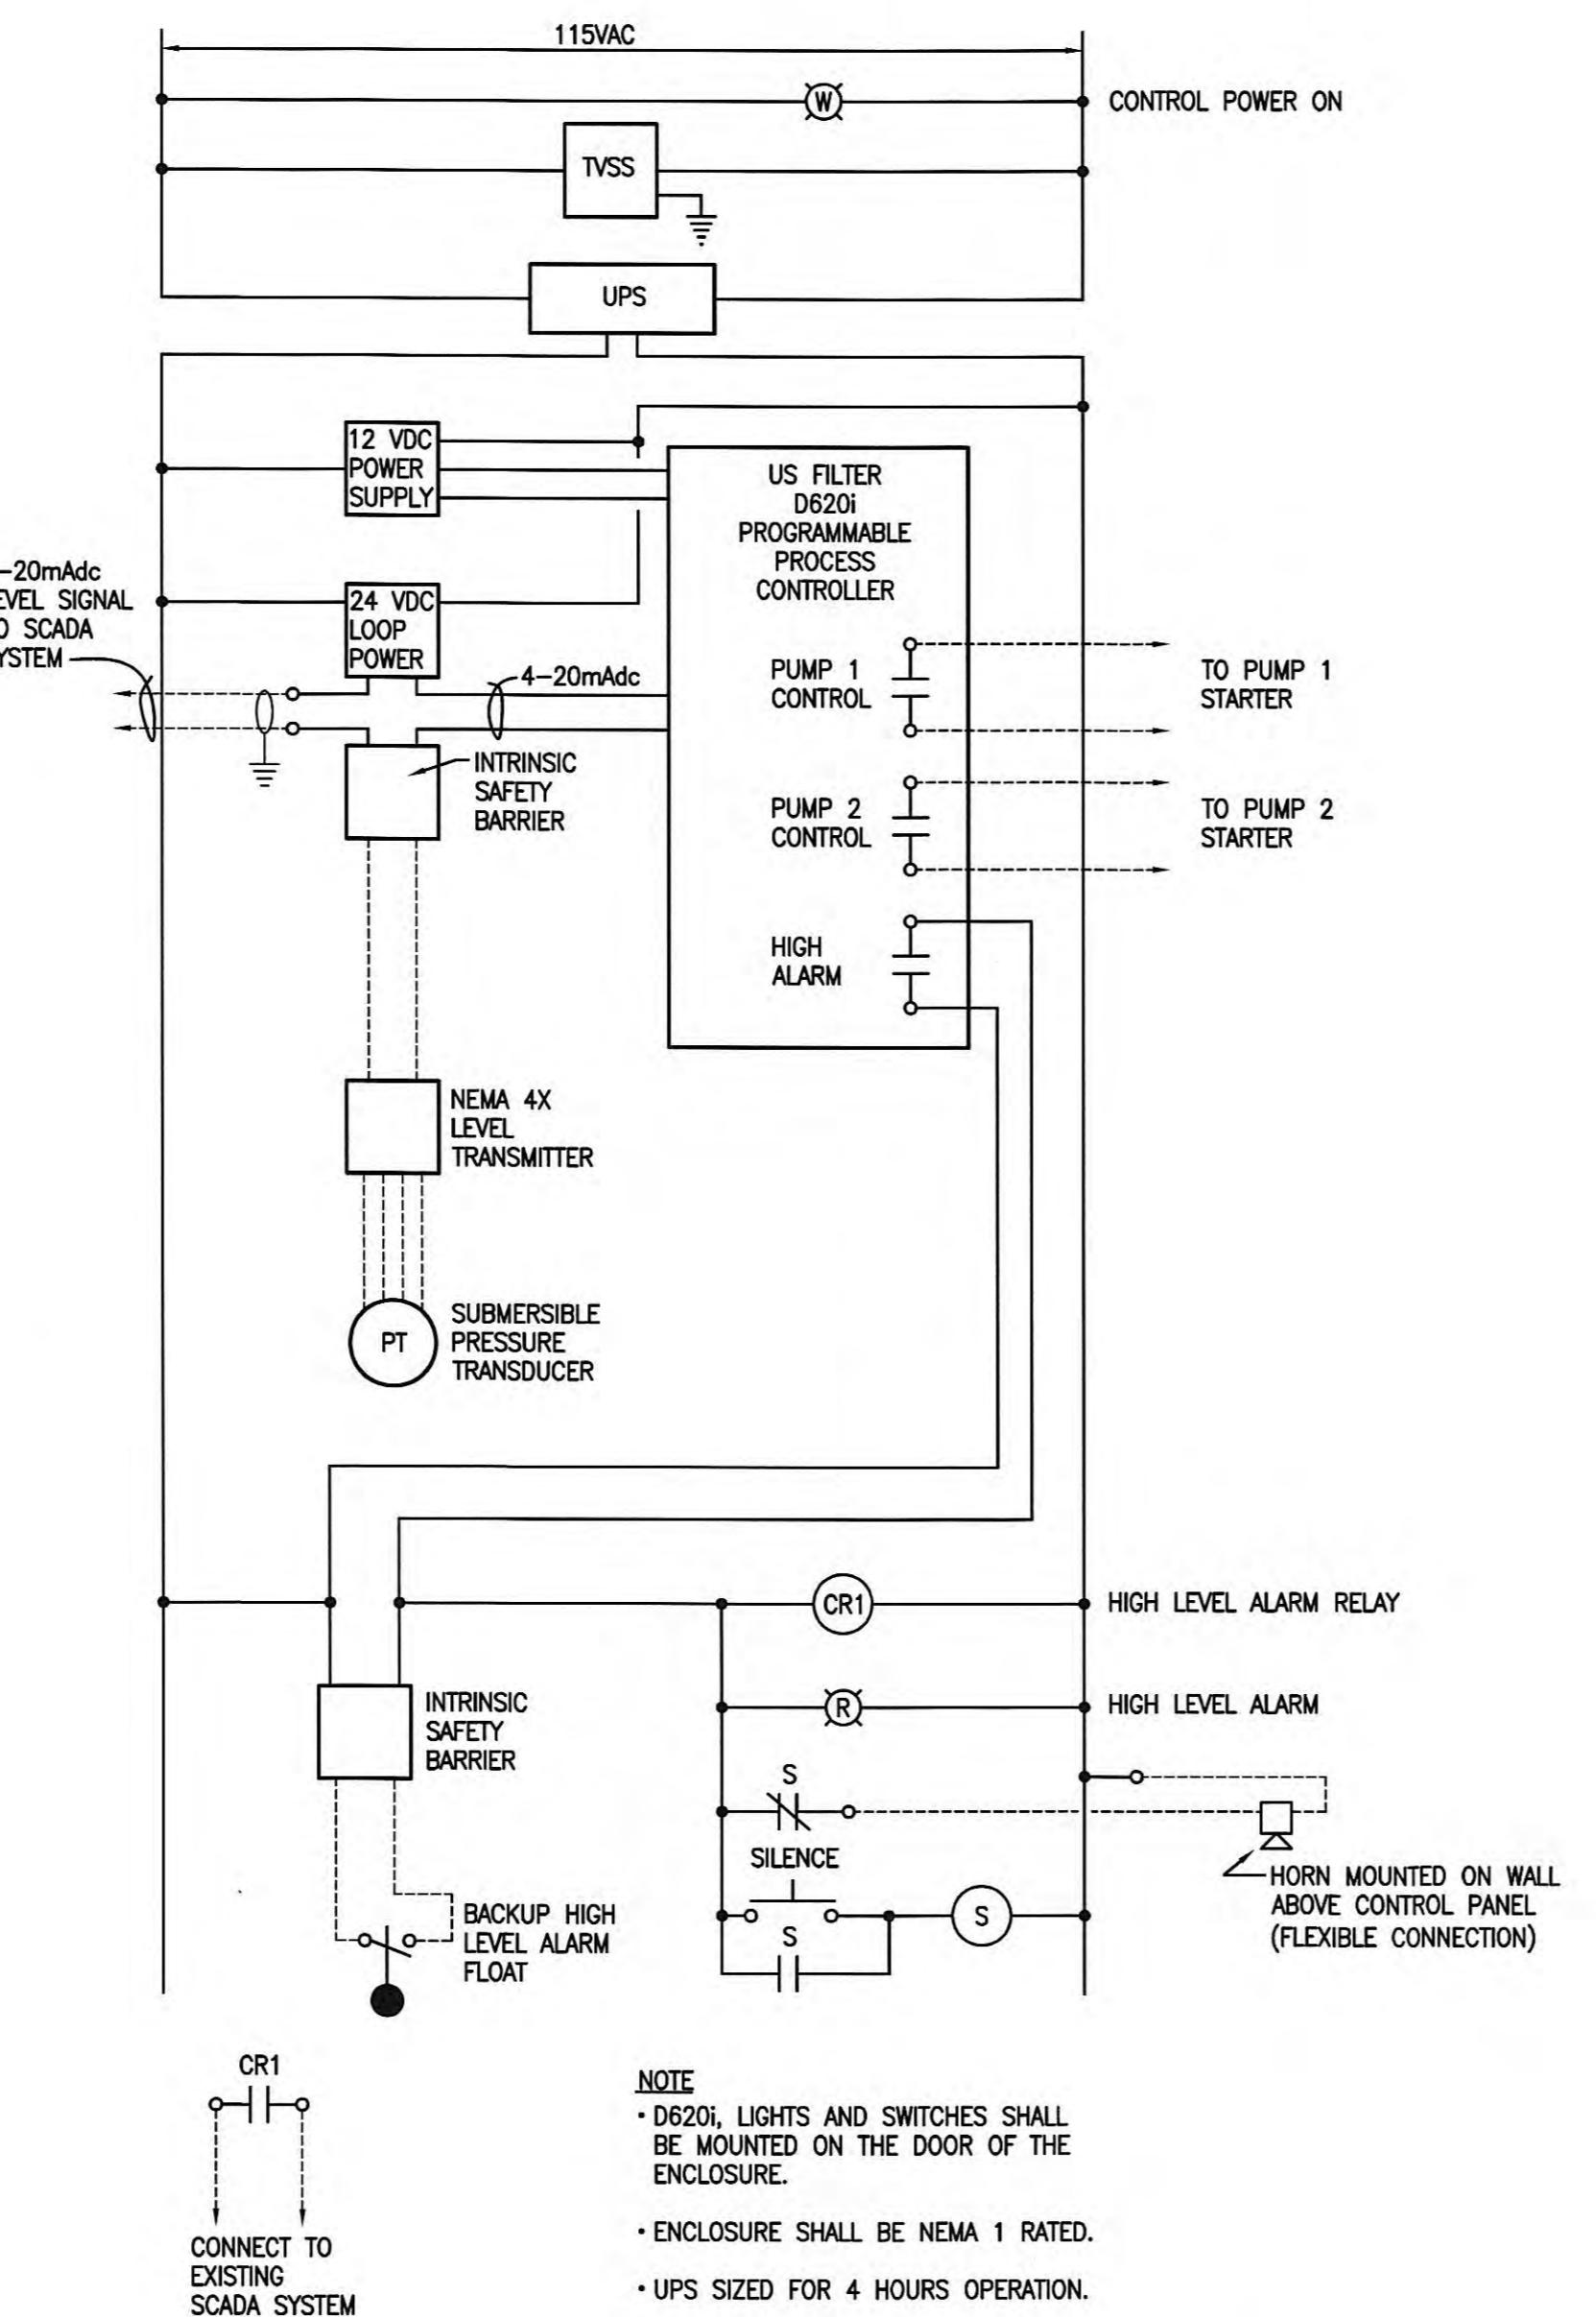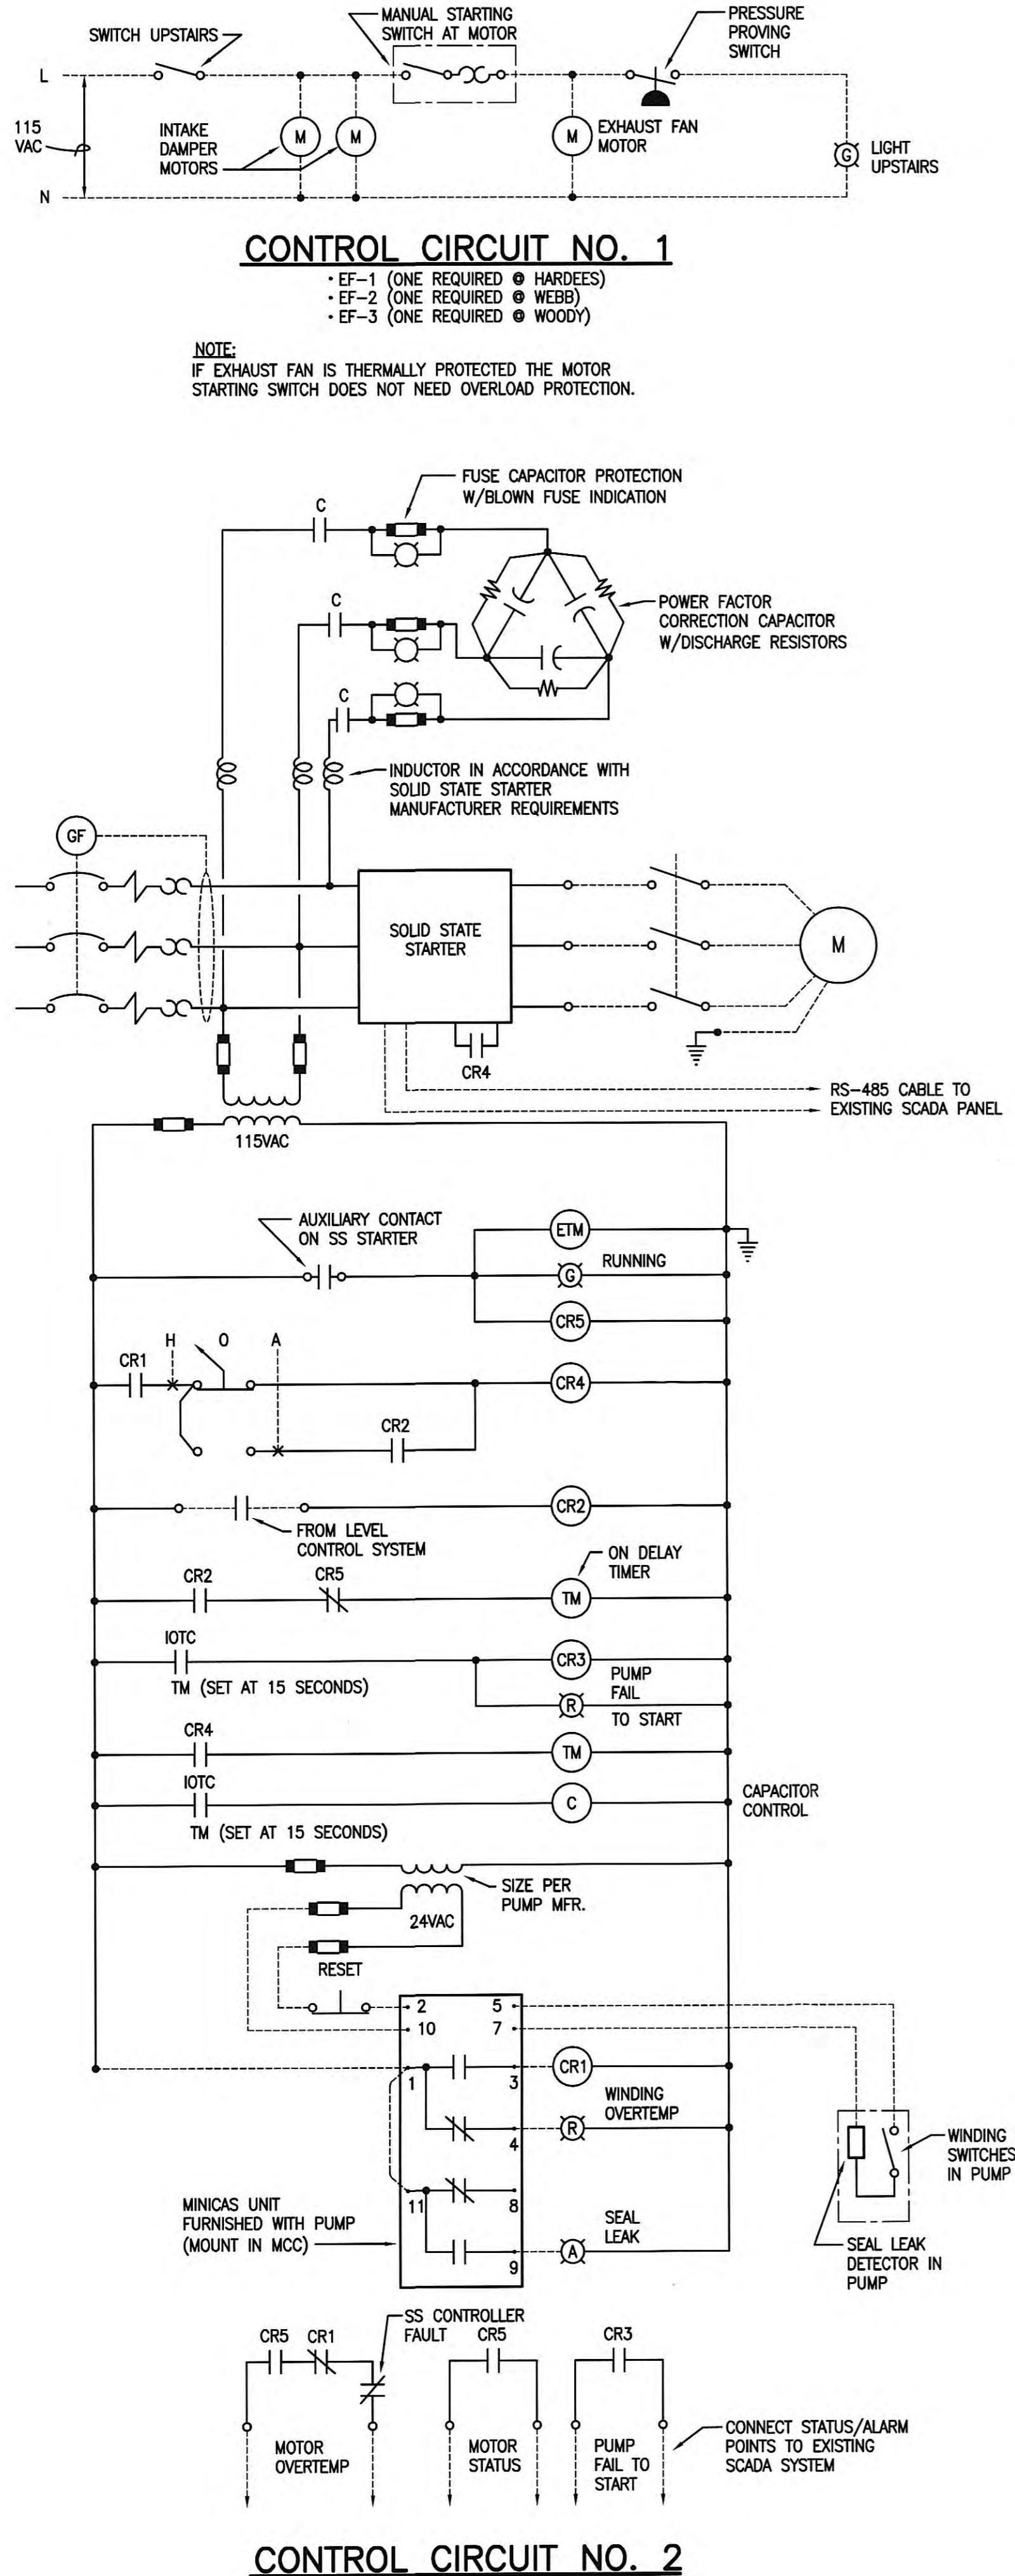

CONTROL CIRCUIT NO. 3

• HARDEES LEVEL CONTROL PANEL (1 REQUIRED)

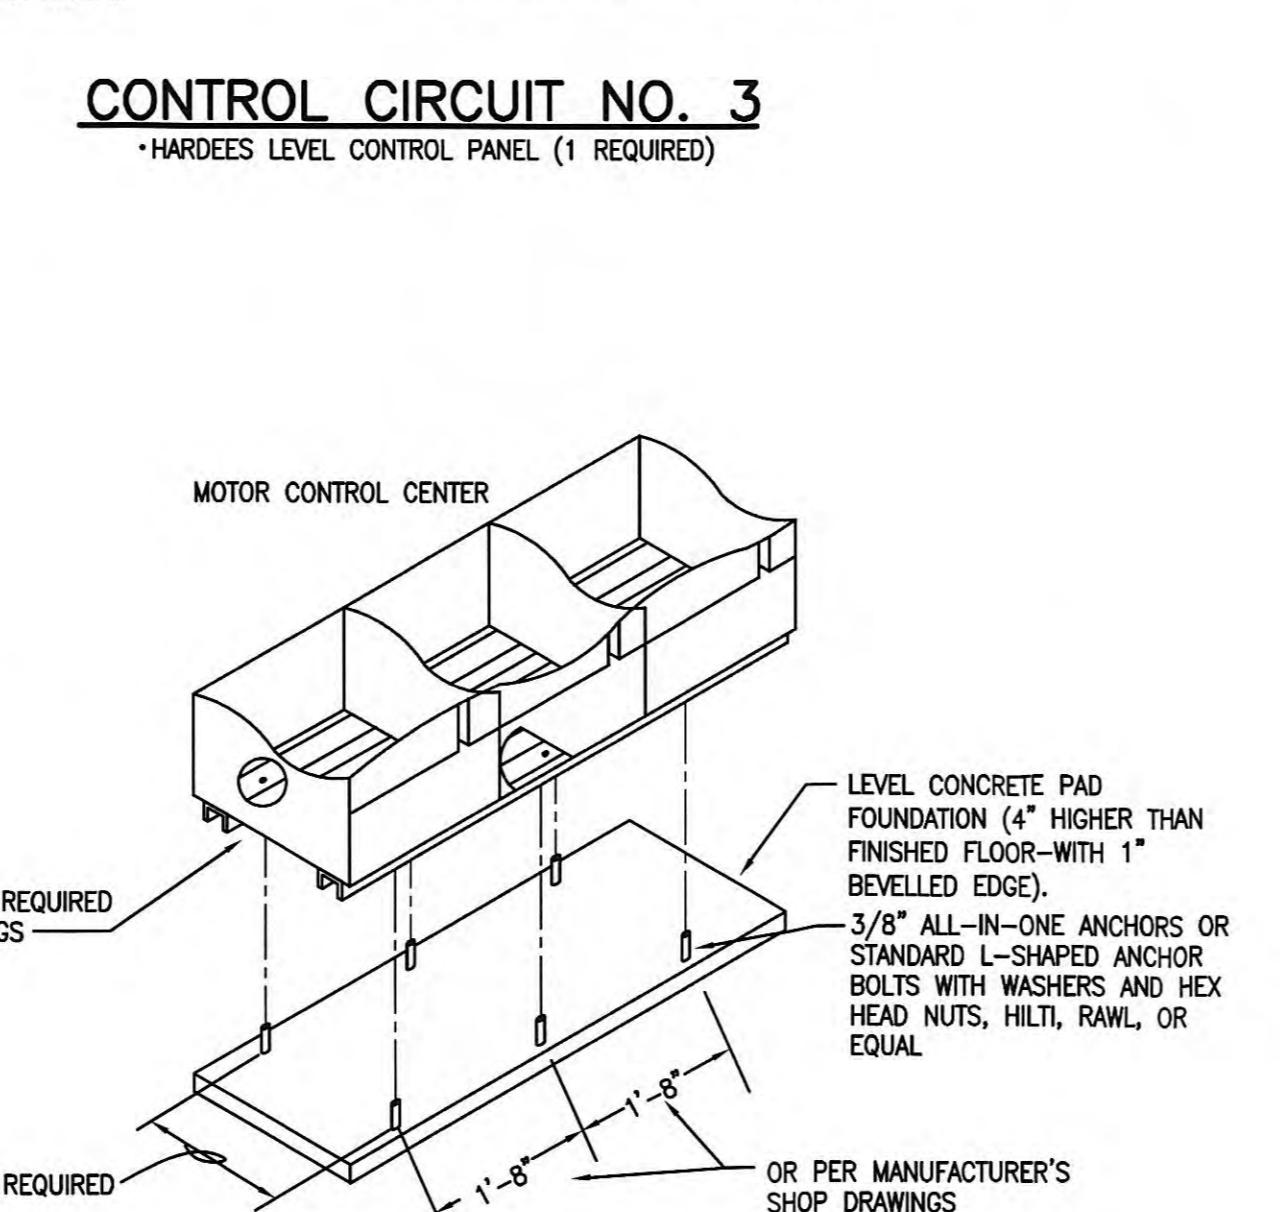

TYPICAL STRUCTURE ANCHORING DETAIL


- NOT TO SCALE
- FOR ALL MOTOR CONTROL CENTERS AND FREE STANDING ELECTRICAL CABINETS
- USE EPOXY SET ANCHORS WHERE REQUIRED TO PREVENT SPALLING OF CONCRETE.

CONTROL CIRCUIT NO. 4


- HARDEES MCC INCOMING PHASE A CURRENT MONITOR (1 REQUIRED)
- WEBB MCC INCOMING PHASE A CURRENT MONITOR (1 REQUIRED)
- WOODY MCC INCOMING PHASE A CURRENT MONITOR (1 REQUIRED)

HARDEES PUMP STATION D620i CONTROL SETTINGS

ITEM	ELEVATION
PUMP OFF	781.35
LEAD PUMP ON	782.80
LAG PUMP ON	N/A (ALTERNATE ONLY)
HIGH LEVEL ALARM	783.30

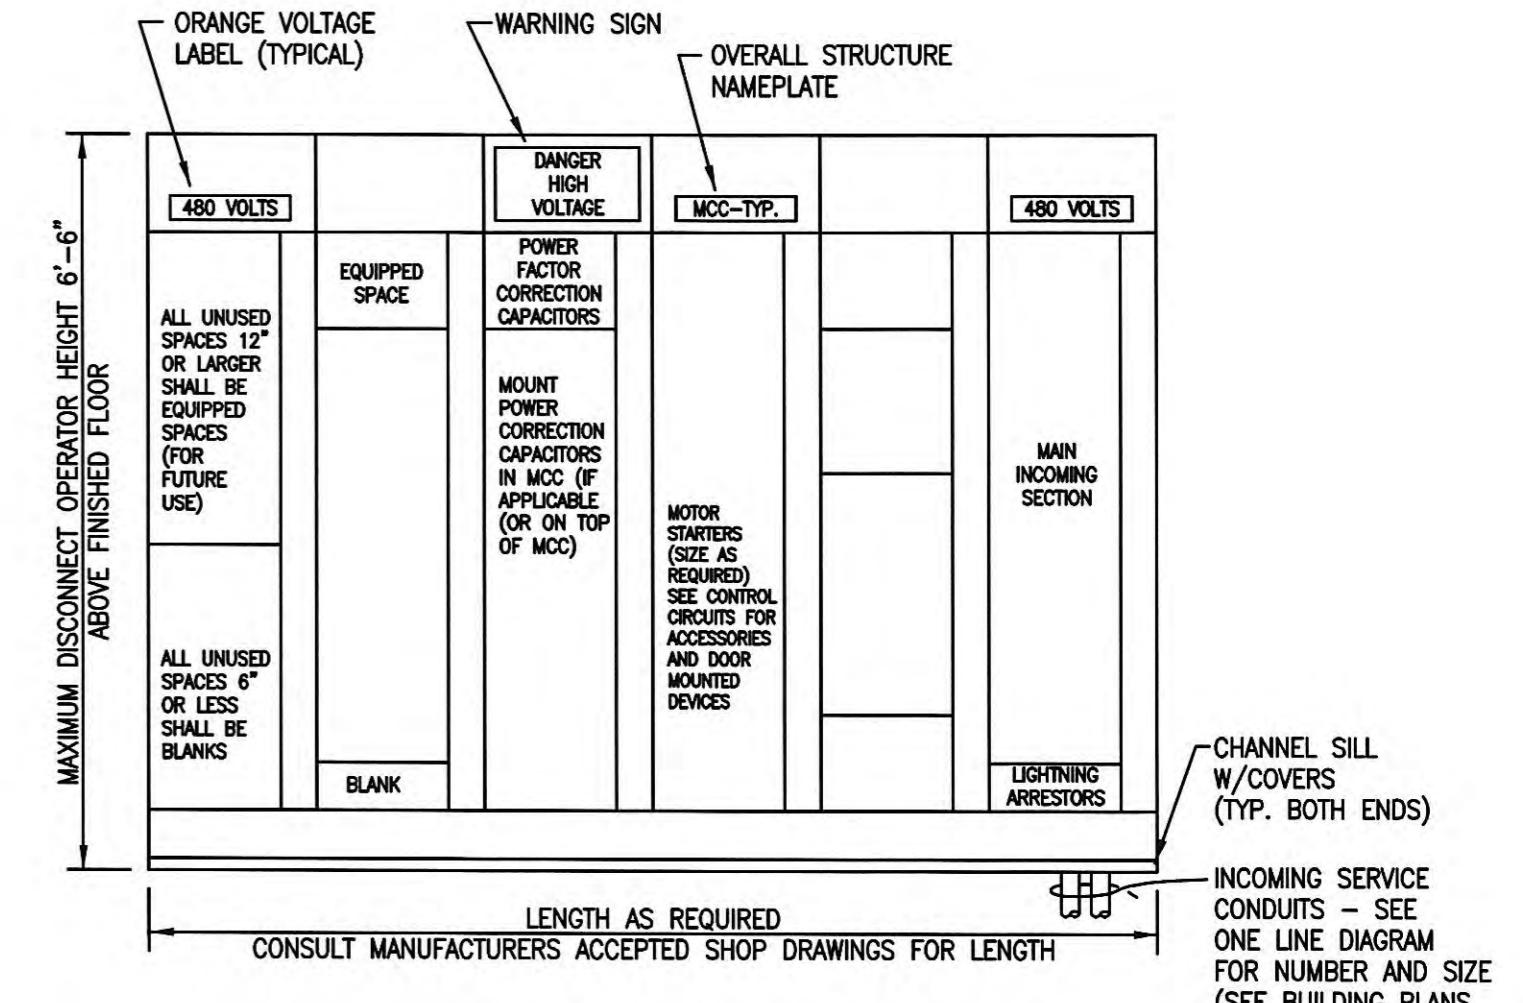

TYPICAL MOTOR CONTROL CENTER FRONT ELEVATION

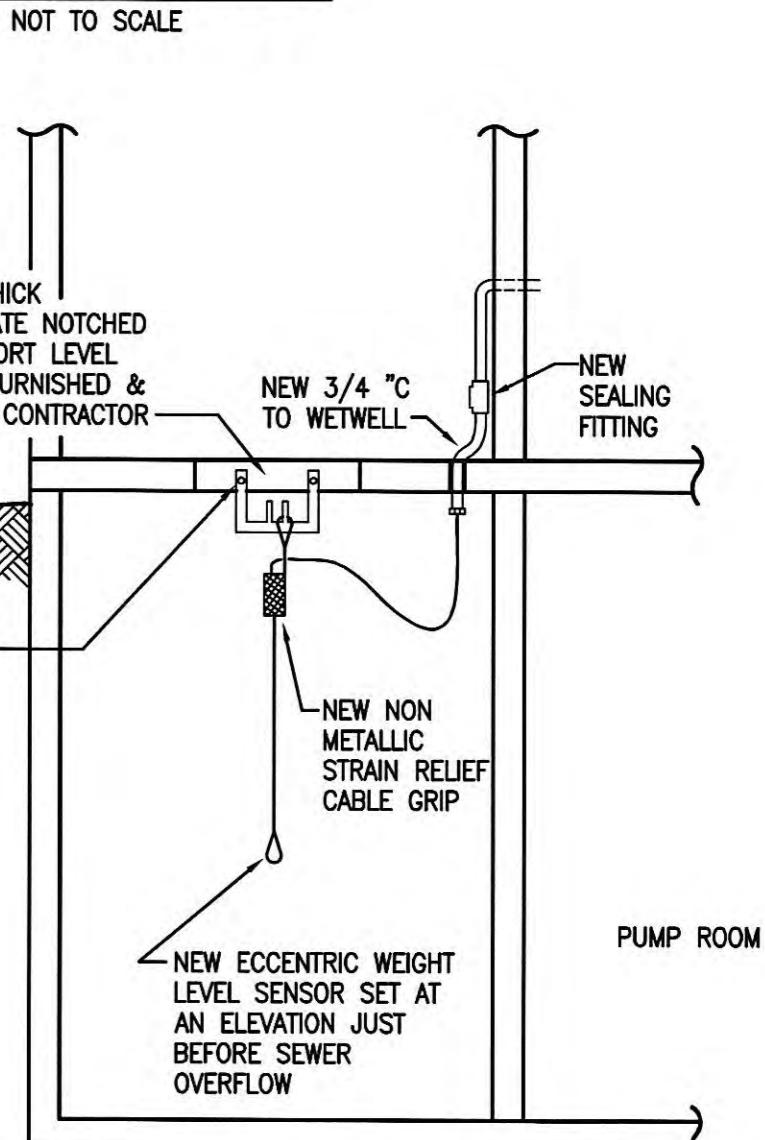


MATERIAL LIST

- ① GROUND ROD
- ② EXOTHERMIC WELD
- ③ GROUNDING CONDUCTOR #1/0 COPPER (VARIES)
- ④ POLYMER CONCRETE FIBERGLASS REINFORCED BOX
- ⑤ COVER FOR ABOVE BOX
- ⑥ GRAVEL OR CRUSHED STONE

TYPICAL GROUND ROD TEST WELL INSTALLATION

NO SCALE

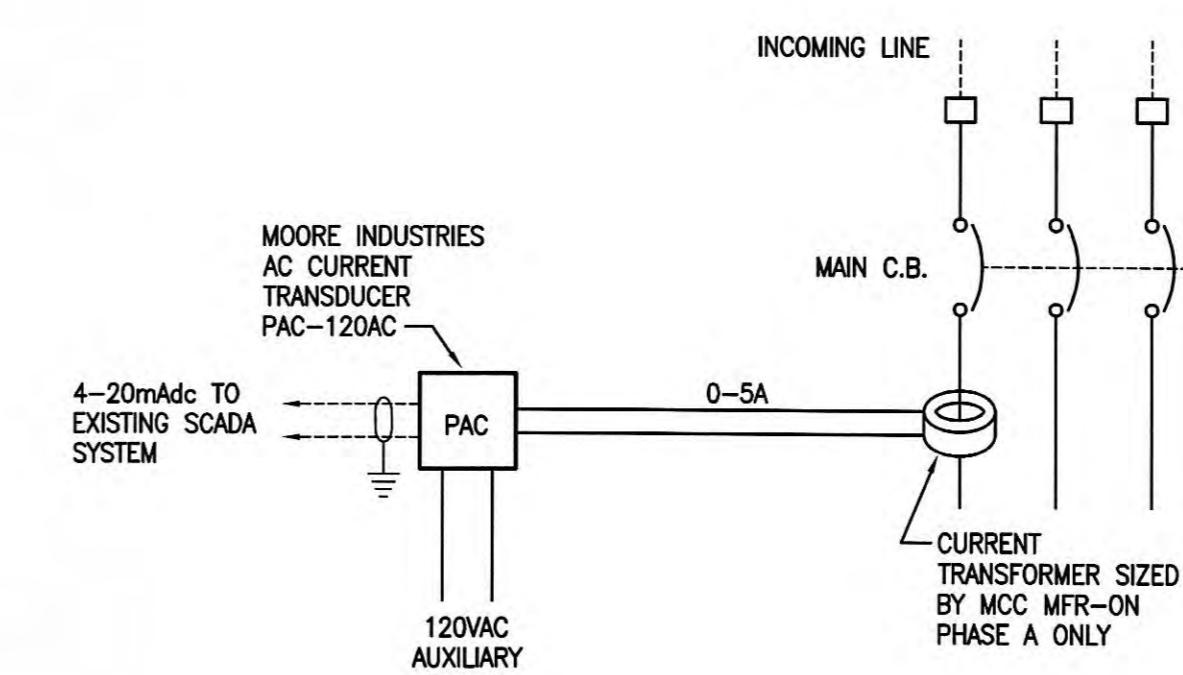

CONTROL CIRCUIT NO. 4

- HARDEES MCC INCOMING PHASE A CURRENT MONITOR (1 REQUIRED)
- WEBB MCC INCOMING PHASE A CURRENT MONITOR (1 REQUIRED)
- WOODY MCC INCOMING PHASE A CURRENT MONITOR (1 REQUIRED)

ALL RIGHTS RESERVED:
THIS DOCUMENT IS THE PROPERTY OF GRW ELROD DUNSON, INC. AND SHALL NOT BE REPRODUCED IN WHOLE OR IN PART OR USED FOR CONSTRUCTION OF OTHER THAN THIS SPECIFIC PROJECT WITHOUT WRITTEN PERMISSION OF GRW ELROD DUNSON, INC.

This document, originally issued, sealed, and signed by William Lamont Maynard, Kentucky Professional Engineer, No. 103277, on June 4, 2004, shall not be used in lieu of a certified document.
NO. DESCRIPTION DATE BY
REVISIONS
WLM

GRW PROJECT NO. 7601-30 CONTRACT NO. S02-03

HARDEE'S PUMP STATION ELECTRICAL CONTROLS & DETAILS

HARRIMAN UTILITY BOARD
HARRIMAN, TENNESSEE

DESIGNED:	DATE:
WLM	JUNE, 2004
DRAWN:	SCALE:
JMG	AS NOTED
REVIEWED:	SHEET NO.
WLM	
APPROVED:	
WLM	



E-2

RECORD DRAWINGS

THESE RECORD DRAWINGS REPRESENT THE "AS-BUILT" PROJECT TO THE BEST OF THE ENGINEER'S KNOWLEDGE. ALTHOUGH PREPARED FROM THE CONSTRUCTION RECORD, THEY CANNOT BE GUARANTEED TO BE EXACT IN EVERY DETAIL.

CHECKED BY:

[Signature] 6/2007 DATE

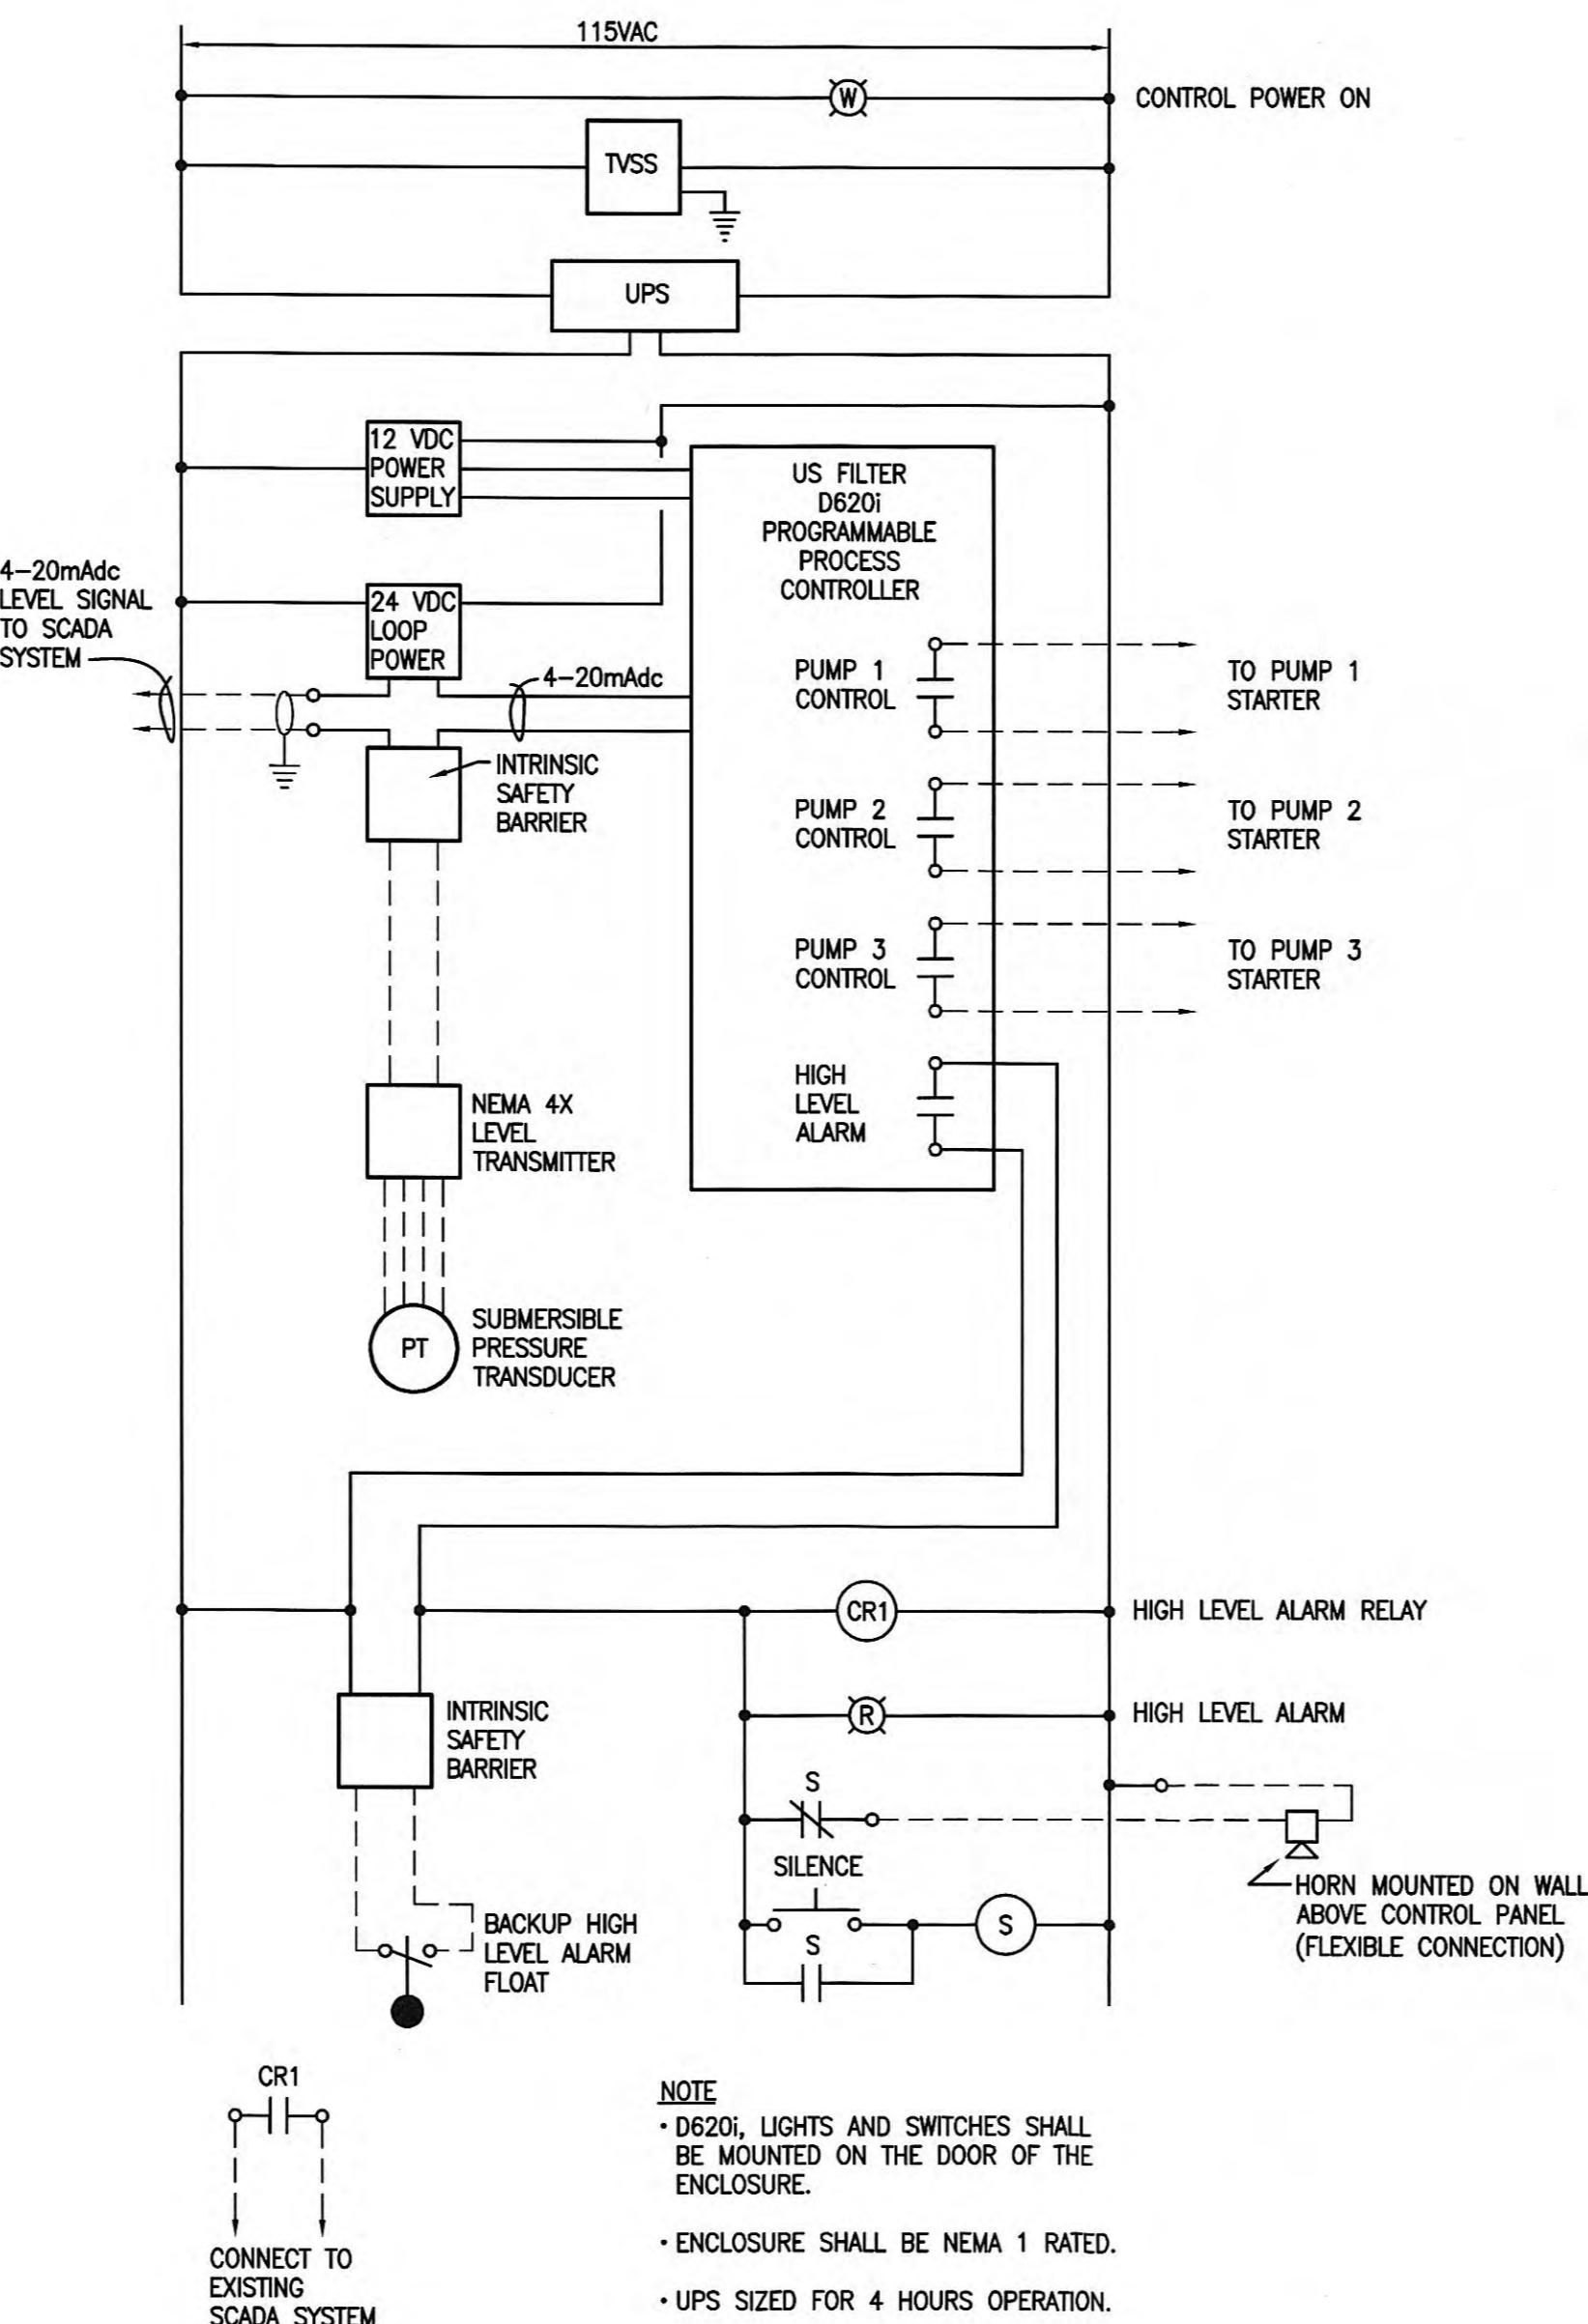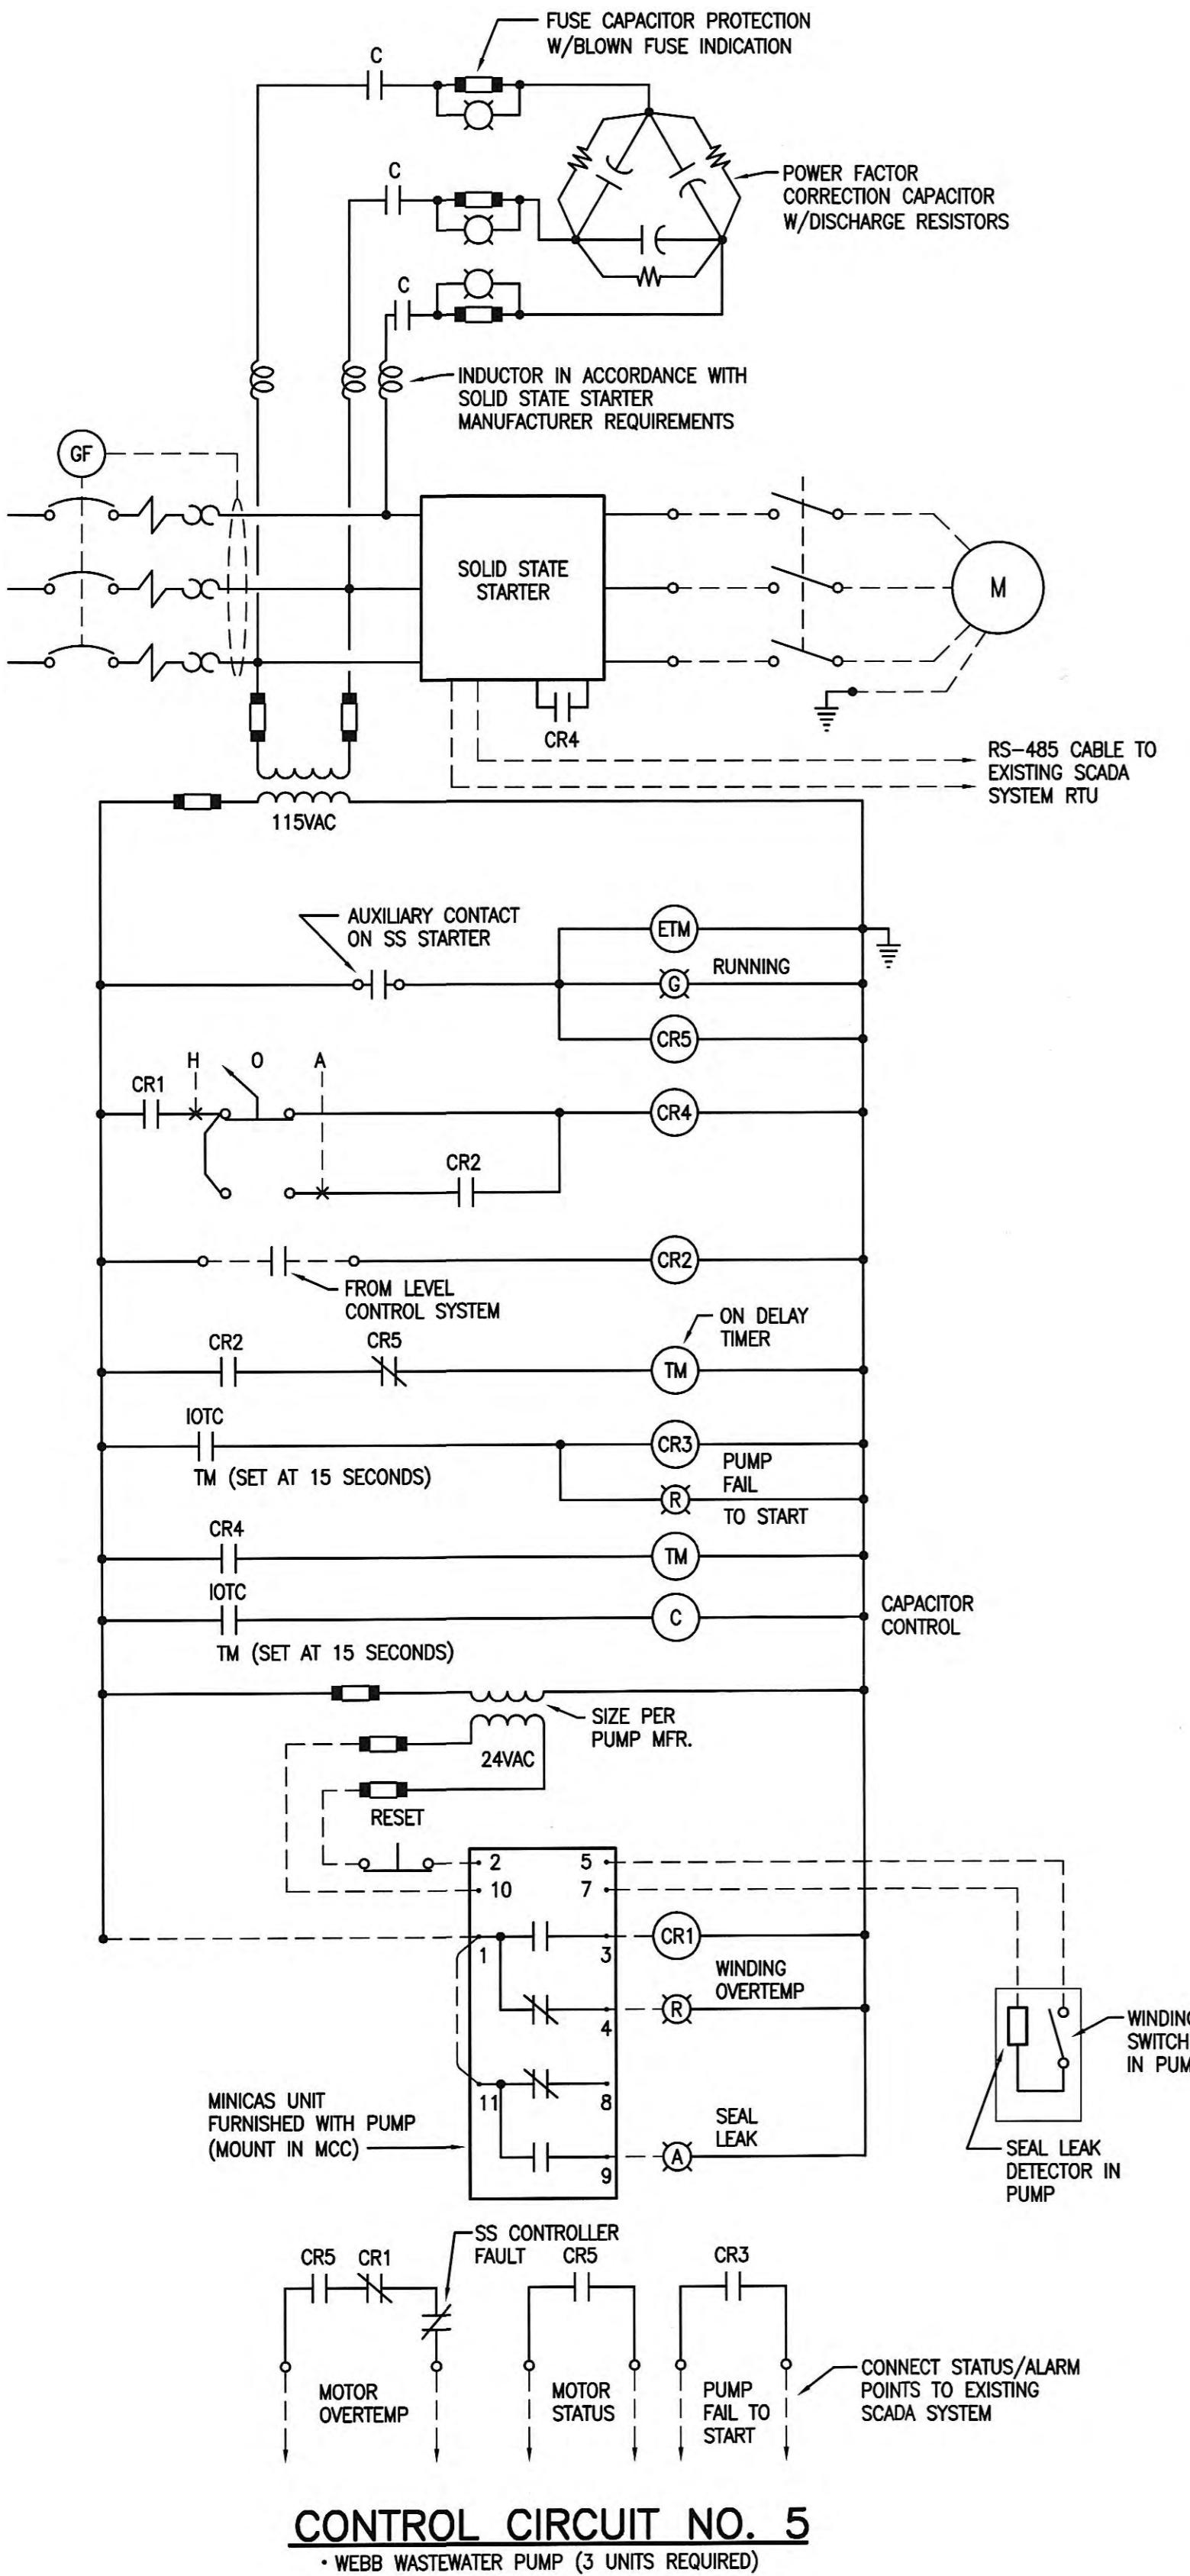

WEBB PUMP STATION D6201 CONTROL SETTINGS

ITEM	ELEVATION
PUMPS OFF	782.00
LEAD PUMP ON	783.75
LAG PUMP ON	784.50
SECOND LAG PUMP ON	N/A (ALTERNATE ONLY)
HIGH LEVEL ALARM	784.70

RECORD DRAWINGS
THESE RECORD DRAWINGS REPRESENT THE "AS-BUILT" PROJECT TO THE BEST OF THE ENGINEER'S KNOWLEDGE, ALTHOUGH PREPARED FROM THE CONSTRUCTION RECORD, THEY CANNOT BE GUARANTEED TO BE EXACT IN EVERY DETAIL.
CHECKED BY:
S. Lamont
ENGINEER'S REPRESENTATIVE
6/2007
DATE

GRW PROJECT NO. 7601-30			CONTRACT NO. S02-03														
WEBB PUMP STATION ELECTRICAL CONTROLS HARRIMAN UTILITY BOARD HARRIMAN, TENNESSEE																	
ALL RIGHTS RESERVED. THIS DOCUMENT IS THE PROPERTY OF GRW ELROD DUNSON, INC. AND SHALL NOT BE REPRODUCED IN WHOLE OR IN PART OR USED FOR CONSTRUCTION OF OTHER THAN THIS SPECIFIC PROJECT WITHOUT WRITTEN PERMISSION OF GRW ELROD DUNSON, INC.																	
<table border="1" style="width: 100%; border-collapse: collapse;"> <tr> <td style="width: 10%;">NO.</td> <td style="width: 20%;">DESCRIPTION</td> <td style="width: 10%;">DATE</td> <td style="width: 10%;">BY</td> <td style="width: 30%;"></td> <td style="width: 20%;"></td> </tr> <tr> <td colspan="6" style="text-align: center;">REVISIONS</td> </tr> </table>						NO.	DESCRIPTION	DATE	BY			REVISIONS					
NO.	DESCRIPTION	DATE	BY														
REVISIONS																	
DESIGNED:	WLM	DATE:	JUNE, 2004														
DRAWN:	JMG	SCALE:	AS NOTED														
REVIEWED:	WLM	SHEET NO.															
APPROVED:	WLM																



E-4

PANEL SCHEDULE	A
LOCATION	WEBB
ENCLOSURE	NEMA 1
SURFACE, FLUSH, OR MCC	MCC
AIC RATING	22,000
DESCRIPTION	VA
ENERGY RECOVERY VENT - 2	1380
	1380
WETWELL LIGHTING CIRCUIT	100
RECEPTACLE CIRCUIT	360
OUTSIDE LIGHT	300
RECONNECT EXISTING CIRCUIT	800
RECONNECT EXISTING CIRCUIT	800
RECEPTACLE CIRCUIT	360
SPARE	500
SPARE	500
TOTAL VOLT-AMPERES PER PHASE	
TOTAL AMPERES PER PHASE	

VOLTAGE	240/120, 3W				
MAINS AMPACITY	100				
MAIN C.B. SIZE	100				
TOTAL SPACES	20				
NO.	FEEDER	BKR	#P	VA	DESCRIPTION
2	3#12, 3/4"C	20A	1	1587	EXHAUST FAN EF-2
4	3#12, 3/4"C	20A	1	250	PUMP CONTROL SYSTEM
6	3#12, 3/4"C	20A	1	400	UPSTAIRS LIGHTS
8	3#12, 3/4"C	20A	1	1000	DOWNSTAIRS LIGHTS
10	AS REQUIRED	20A	1	1500	RECONNECT EXISTING CIRCUIT
12	2#12	20A	1	50	PHASE A AMPERAGE MONITOR
14		20A	1	500	SPARE
16	4#12, 3/4"C	20A	2	920	SUMP PUMP
18		—	—	920	
20		20A	1	500	SPARE


NOTE:
ONLY POWER CONDUCTORS
SHOWN. FOR COMPLETE FILLS,
SEE FLOOR PLANS AND
CONTROL CIRCUITS AS WELL.



UTILITY METER

480 VOLT, 3 PHASE, A 4 WIRE SERVICE FROM UTILITY

3#3/0, 1#4 NEUTRAL, 2" CONDUIT

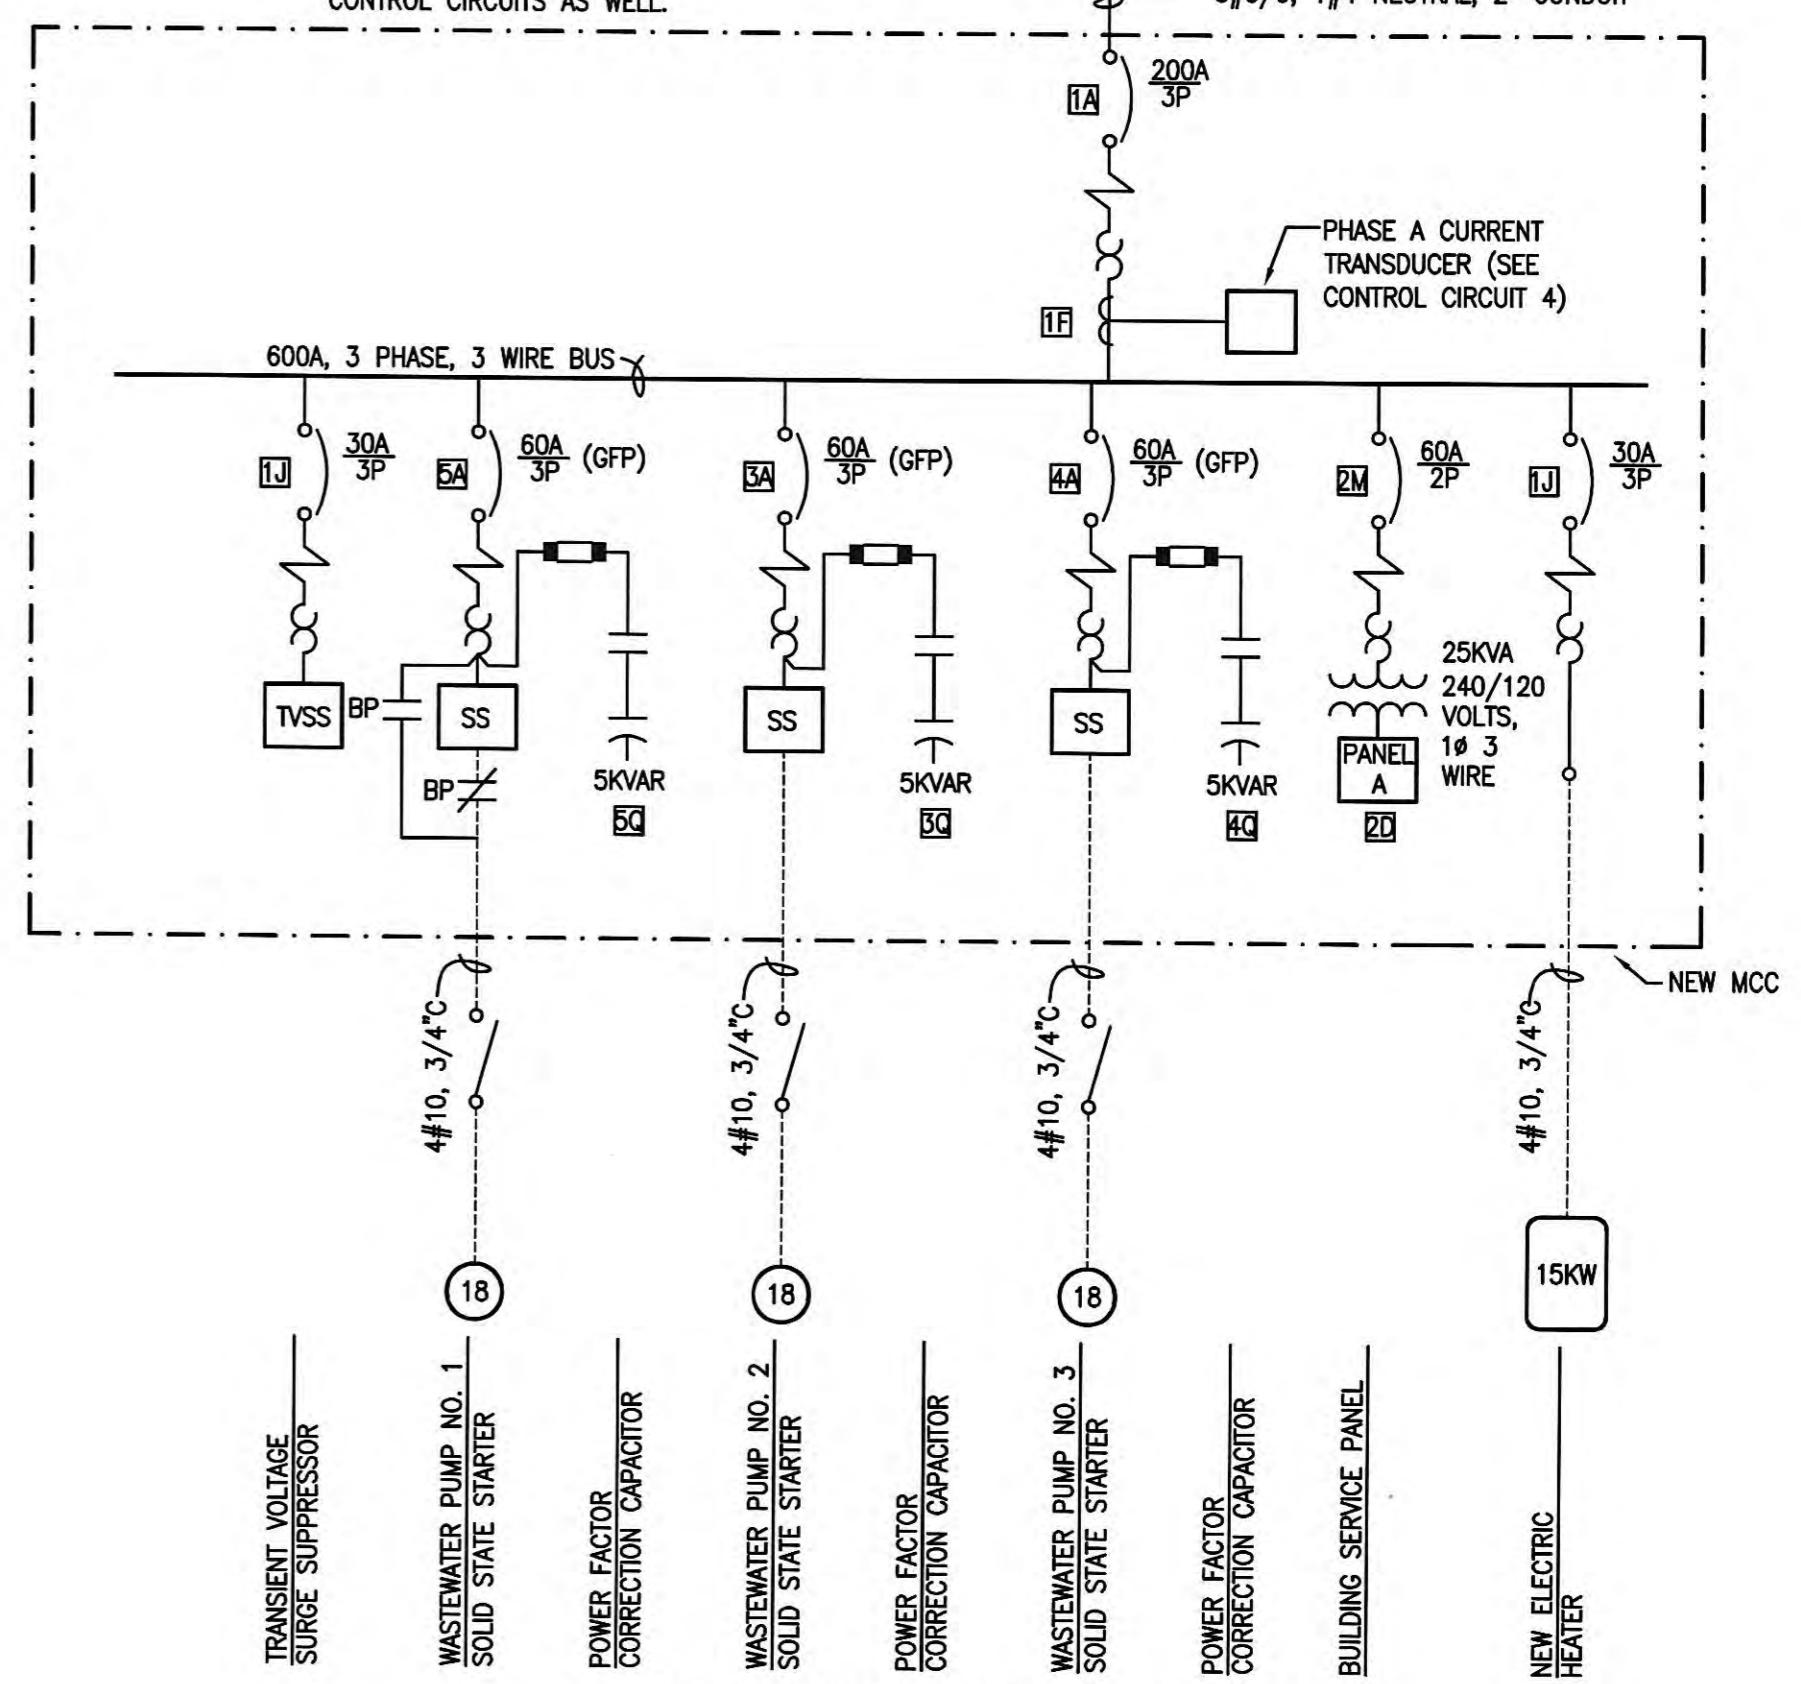

KEYNOTES:


- ① REMOVE EXISTING LATCHOUT STATION FOR ABANDONED PUMP.
 - ② NEW LEVEL TRANSDUCER AND CABLE SUPPORT FOR CONTROL OF NEW PUMPS.
 - ③ NEW NEMA 4X ENCLOSED SAFETY SWITCH WITHIN SIGHT OF NEW PUMP.
 - ④ NEW DRY PIT SUBMERSIBLE PUMP.
 - ⑤ NEW EXHAUST FAN SHALL RUN CONTINUOUSLY TO PROVIDE 6 AIR CHANGES/HOUR.
 - ⑥ FURNISH AND INSTALL NEW HAZLUX HAZLITE M5 (OR EQUAL) EXPLOSION PROOF COMPACT FLUORESCENT LIGHT FIXTURES IN WETWELL SIDE OF STRUCTURE AS SHOWN. FIXTURE JUST INSIDE DOOR TO BE CEILING MOUNTED; ALL OTHERS WALL MOUNTED WITH BRACKET FURNISHED WITH FIXTURE. FIXTURE SHALL ALSO BE NEMA 4X RATED AND HAVE 26 WATTS OF PL LAMP EACH.
 - ⑦ FURNISH AND INSTALL CROUSE HINDS VXHBF25GP, OR EQUAL WITH G55 GREEN GLASS GLOBE AND 60 WATT LAMP. PROVIDE SIGN BELOW FIXTURE STATING "DO NOT GO DOWNSTAIRS UNLESS GREEN LAMP IS ILLUMINATED INDICATING LOWER LEVEL VENTILATION FAN IS RUNNING".
 - ⑧ NEW ENERGY RECOVERY VENTILATOR.
 - ⑨ EXISTING 6KW ELECTRIC HEATER TO BE ABANDONED & REMOVED THIS CONTRACT.
 - ⑩ NEW MOTOR CONTROL CENTER WITH SERVICE ENTRANCE CONDUIT THROUGH ROOF TO WEATHERHEAD. EXISTING MCC AND THROUGH ROOF SERVICE TO BE ABANDONED AND REMOVED.
 - ⑪ EXISTING METER BASE AND SERVICE POLE. MODIFY AS REQUIRED FOR NEW SERVICE.
 - ⑫ NEW LEVEL CONTROL PANEL.
 - ⑬ EXISTING SINGLE PHASE PANEL TO BE ABANDONED AND REMOVED THIS CONTRACT. INTERCEPT CONDUITS FROM LOADS AT A CONVENIENT POINT AND RECONNECT CIRCUITS TO NEW PANEL A IN NEW MCC.
 - ⑭ EXISTING SCADA RTU TO REMAIN. WIRE NEW SIGNALS FROM PUMP STARTERS & CONTROLS TO EXISTING RTU. COORDINATE EXACT REQUIREMENTS FOR MONITORING WITH THE OWNER.
 - ⑮ EXISTING COAXIAL CABLE AND ANTENNA FOR SCADA RTU. DO NOT DISTURB.

KEYNOTES (CONTINUED):

- 6 NEW #6 AWG GROUNDED CONDUCTOR TO RTU FOR LIGHTNING ARRESTOR GROUND.
 - 7 FURNISH AND INSTALL A 1KW BULKHEAD LIGHTNING ARRESTOR ON COAXIAL CABLE BEFORE IT ATTACHES TO RADIO.
 - 8 NEW #2 BARE COPPER GROUNDING ELECTRODE CONDUCTOR SLEEVED IN A 3/4" CONDUIT TO OUTSIDE. BOND TO ANY EXISTING GROUNDING ELECTRODE SYSTEM AT OLD MCC LOCATION.
 - 9 NEW GROUNDING ELECTRODE ARRAY.
 - 10 SEAL CONDUIT AGAINST GROUNDWATER ENTRY.
 - 11 ALL CONDUITS FROM WETWELL TO PUMP STATION SHALL BE FITTED WITH SEALING FITTINGS.
 - 2 NEW ELECTRIC HEATER - SEE MECHANICAL PLAN FOR THERMOSTAT LOCATION (PROVIDE WIRING).
 - 3 PROVING SWITCH FOR EF-1.
 - 4 2#16, SHIELDED AND TWISTED PAIR, 3/4"C
 - 5 19#12, 1"C
 - 6 NEW COMBUSTIBLE GAS ALARM PANEL. SCOTT GAS PLUS OR EQUAL.
 - 7 NEW COMBUSTIBLE GAS DETECTOR SET UP FOR METHANE AND MOUNTED 6'-6" A.F.F.
 - 8 NEW BACKUP HIGH LEVEL ALARM FLOAT.
 - 9 3#12, 3/4"C FOR HIGH LEVEL ALARM TO RTU.
 - 10 7#12, 3/4"C FROM LEVEL CONTROLS TO MCC FOR PUMP START/STOP CONTROL.
 - 11 ABANDON & REMOVE EXISTING LIGHT FIXTURE-BLANKOFF BOX.
 - 12 REMOVE AND REPLACE WETWELL VENTILATOR MOTOR ON ROOF WITH A NEW MOTOR RATED FOR CLASS 1, DIVISION 1 GROUP C & D ATMOSPHERES. EXISTING MOTOR 1/3HP, 115 VOLT, 725 RPM.
 - 13 NEW SUMP PUMP CONTROL AND DISCONNECT SWITCH (NEMA 4X) BY CONTRACTOR.


KEYNOTES (CONTINUED):

- 34** NEW SWITCH(ES).
 - 35** NEW HOLOPHANE 7200-4-12-J-F OR EQUAL 2 LAMP FLUORESCENT LUMINAIRE.
 - 36** NEW HOLOPHANE WL2K-150HP-12-BZ OR EQUAL WALLPACK.
 - 37** NEW HOLOPHANE DM5-C-36-T-NN-2-DL OR EQUAL EMERGENCY FIXTURE.
 - 38** NEW MOTORIZED AIR INTAKE DAMPER FOR EF-2.
 - 39** NEW RS-485 CABLE, 3/4" CONDUIT TO EXISTING SCADA RTU.

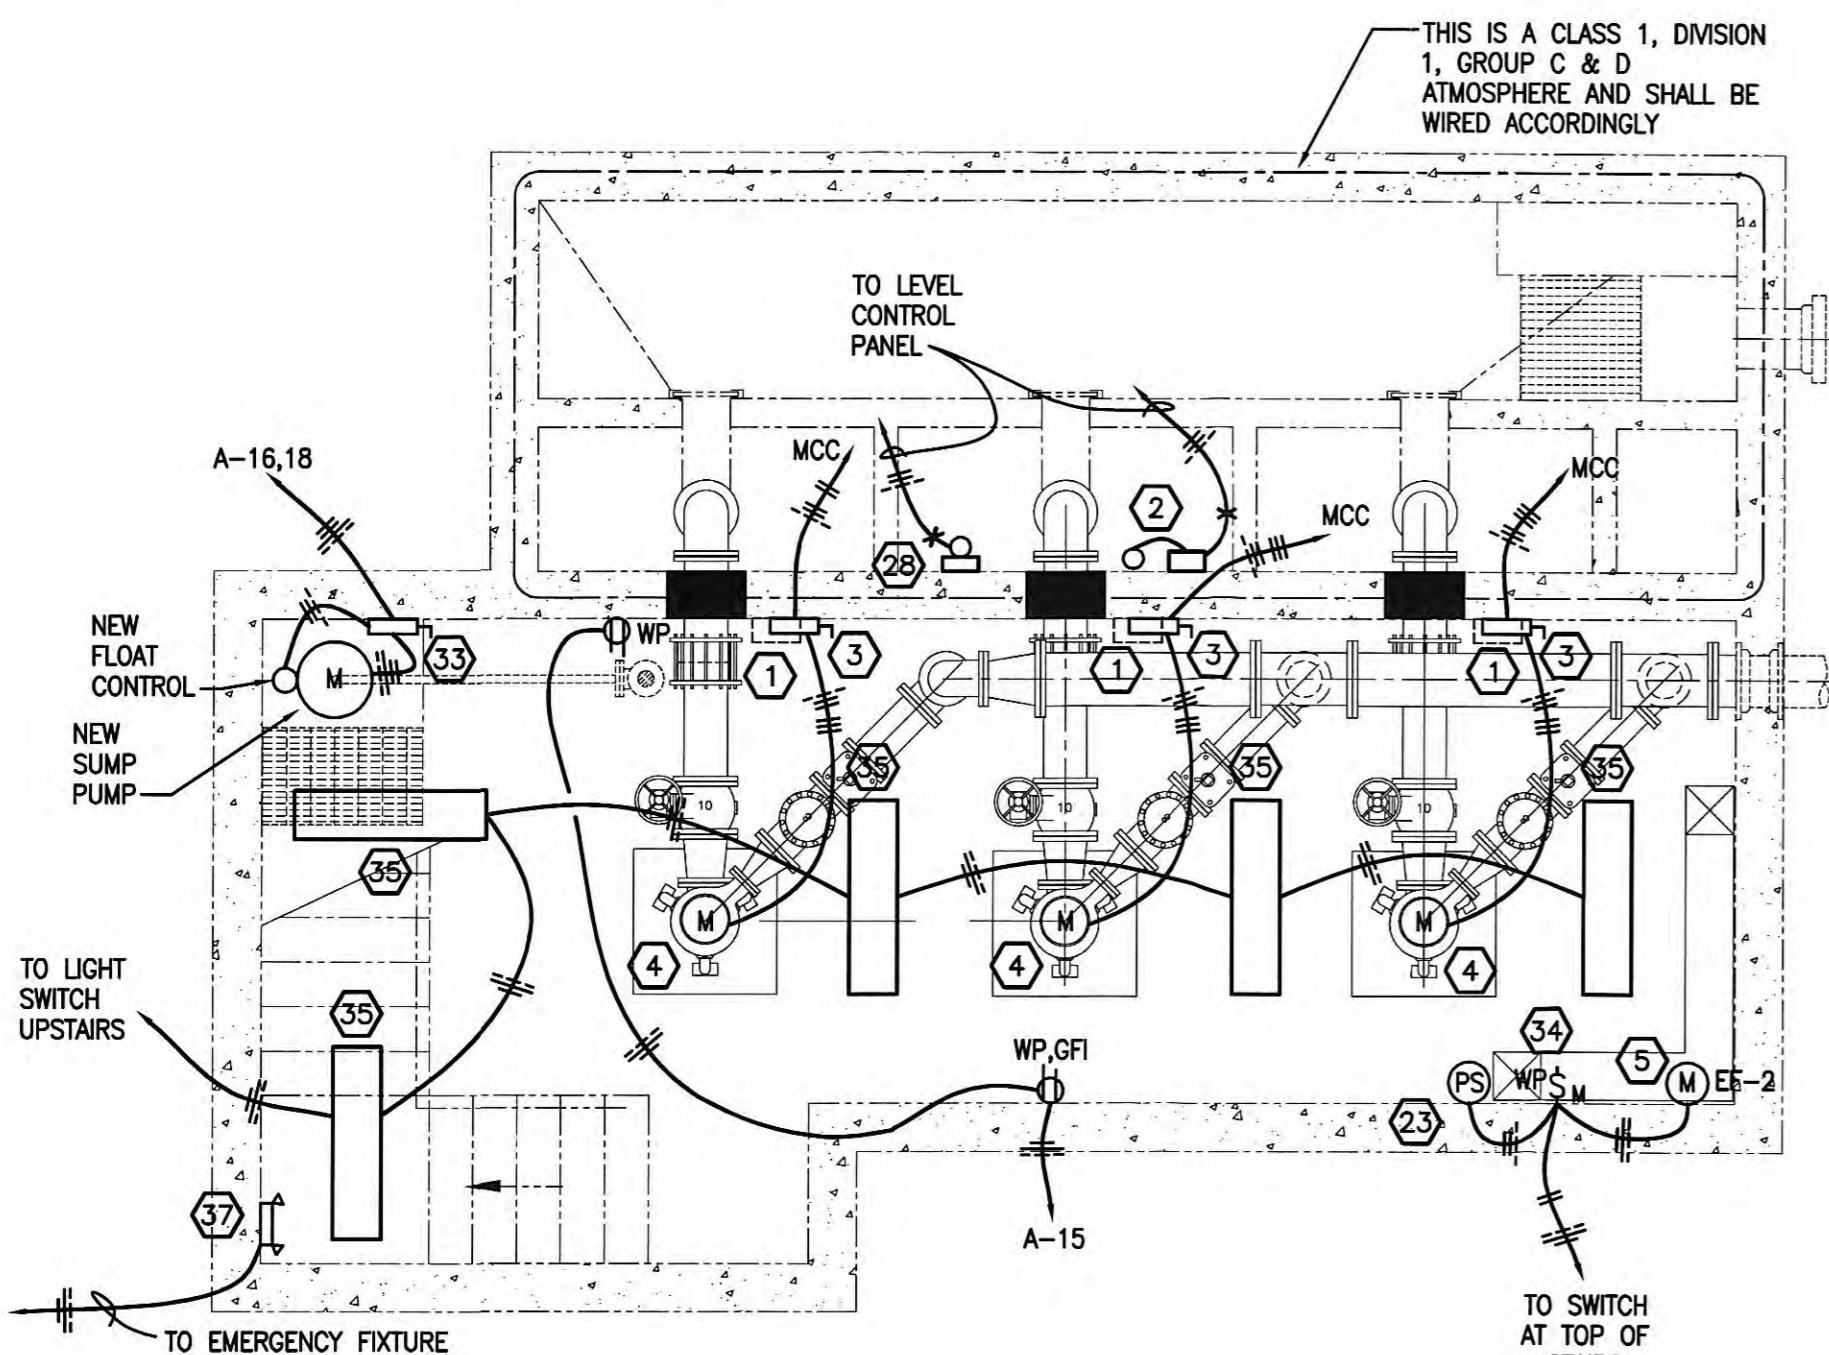

MODIFIED FLOOR PLAN – PUMP LEVEL

SCALE: 1/4" = 1'-0"

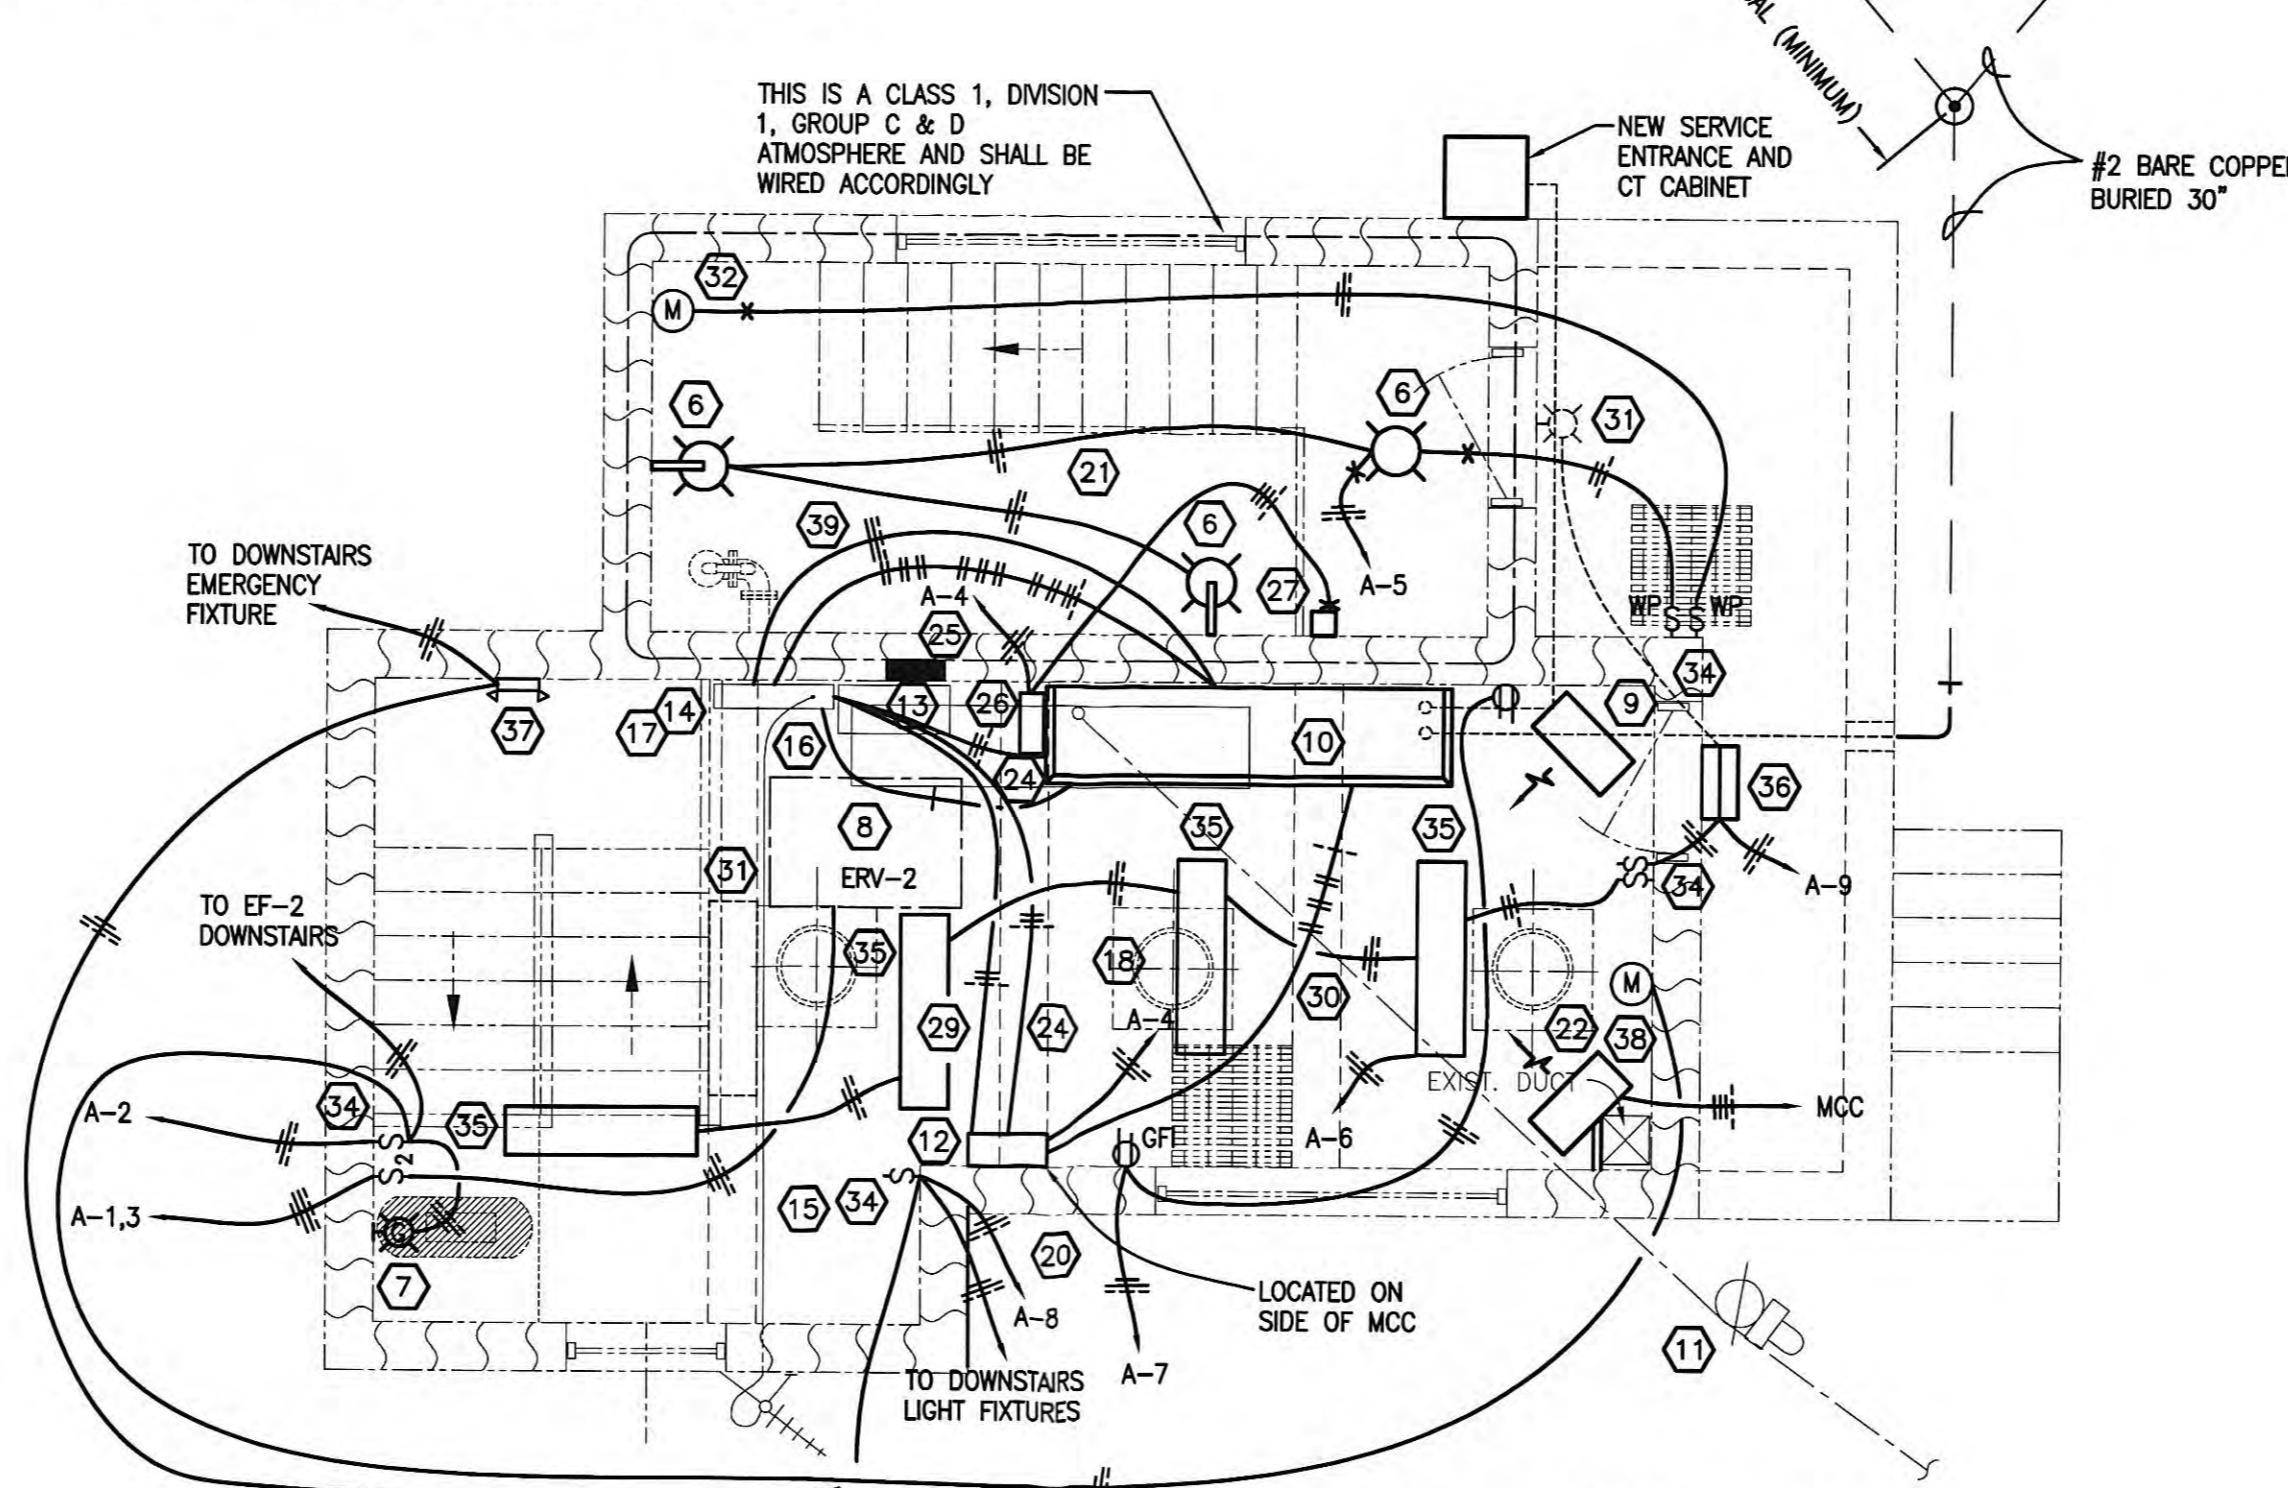

MODIFIED FLOOR PLAN - ENTRANCE LEVEL

MODIFIED

NOTE.

- SEE GENERAL PROJECT NOTES ON DRAWING E-3.
 - SEE TYPICAL DETAILS ON DRAWING E-2

PROJECT NO. 7601-30 CONTRACT NO. S02-03

**EXISTING WEBB SEWAGE PUMP STATION
ELECTRICAL
HARRIMAN UTILITY BOARD
HARRIMAN TENNESSEE**

 RW Elrod Dunson, Inc. Engineers, Architects, Planners	DESIGNED: WLM	DATE: JUNE, 2004
	DRAWN: JMG	SCALE: AS NOTED
	REVIEWED: WLM	SHEET NO.
	APPROVED: WLM	
		E-5

PANEL SCHEDULE		A		VOLTAGE		240/120, 3W						
LOCATION	WOODY	ENCLOSURE	NEMA 1	MAIN C.B. SIZE	100	TOTAL SPACES	20					
SURFACE, FLUSH, OR MCC	MCC	AIC RATING	22,000	-A-	VA	-B-	VA					
DESCRIPTION	VA	#P	BKR	FEEDER	NO.	NO.	FEEDER	BKR	#P	VA	DESCRIPTION	
ENERGY RECOVERY VENT - 3	1380	2	20A	4 #12, 3/4°C	1	2967	2	3#12, 3/4°C	20A	1	1587	EXHAUST FAN EF-3
	1380				3		1630	4 #12, 3/4°C	20A	1	250	PUMP CONTROL SYSTEM
WETWELL LIGHTING CIRCUIT	100	1	20A	3#12, 3/4°C	5	500	6	3#12, 3/4°C	20A	1	400	UPSTAIRS LIGHTS
RECEPTACLE CIRCUIT	360	1	20A	3#12, 3/4°C	7		1360	8 #12, 3/4°C	20A	1	1000	DOWNTAIRS LIGHTS
OUTSIDE LIGHT	300	1	20A	3#12, 3/4°C	9	1800	10	AS REQUIRED	20A	1	1500	RECONNECT EXISTING CIRCUIT
RECONNECT EXISTING CIRCUIT	800	1	20A	AS REQUIRED	11		850	12 AS REQUIRED	20A	1	50	PHASE A AMPERAGE MONITOR
RECONNECT EXISTING CIRCUIT	800	1	20A	AS REQUIRED	13	1300	14		20A	1	500	SPARE
RECEPTACLE CIRCUIT	360	1	20A	3#12, 3/4°C	15		1280	16 #12, 3/4°C	20A	2	920	SUMP PUMP
SPARE	500	1	20A		17	1420	18		-	-	920	
SPARE	500	1	20A		19	1000	20		20A	1	500	SPARE
TOTAL VOLT-AMPERES PER PHASE						7987	6120					
TOTAL AMPERES PER PHASE						66.6	51					

KEYNOTES:


- ① REMOVE EXISTING LATCHOUT STATION FOR ABANDONED PUMP.
- ② NEW LEVEL TRANSDUCER AND CABLE SUPPORT FOR CONTROL OF NEW PUMPS.
- ③ NEW NEMA 4X ENCLOSED SAFETY SWITCH WITHIN SIGHT OF NEW PUMP.
- ④ NEW DRY PIT SUBMERSIBLE PUMP.
- ⑤ NEW EXHAUST FAN SHALL RUN CONTINUOUSLY TO PROVIDE 6 AIR CHANGES/HOUR.
- ⑥ FURNISH AND INSTALL NEW HAZLUX HAZLITE M5 (OR EQUAL) EXPLOSION PROOF COMPACT FLUORESCENT LIGHT FIXTURES IN WETWELL SIDE OF STRUCTURE AS SHOWN. FIXTURE JUST INSIDE DOOR TO BE CEILING MOUNTED; ALL OTHERS WALL MOUNTED WITH BRACKET FURNISHED WITH FIXTURE. FIXTURE SHALL ALSO BE NEMA 4X RATED AND HAVE 24 WATTS OF PL LAMP EACH.
- ⑦ FURNISH AND INSTALL CROUSE HINDS VXHBF25GP, OR EQUAL WITH G55 GREEN GLASS GLOBE AND 60 WATT LAMP. PROVIDE SIGN BELOW FIXTURE STATING "DO NOT GO DOWNSTAIRS UNLESS GREEN LAMP IS ILLUMINATED INDICATING LOWER LEVEL VENTILATION FAN IS RUNNING".
- ⑧ NEW ENERGY RECOVERY VENTILATOR.
- ⑨ EXISTING 6KW ELECTRIC HEATER TO BE ABANDONED & REMOVED THIS CONTRACT.
- ⑩ NEW MOTOR CONTROL CENTER WITH SERVICE ENTRANCE CONDUIT THROUGH ROOF TO WEATHERHEAD. EXISTING MCC AND THROUGH ROOF SERVICE TO BE ABANDONED AND REMOVED.
- ⑪ EXISTING OVERHEAD SERVICE THROUGH ROOF. MODIFY AS REQUIRED FOR NEW SERVICE.
- ⑫ NEW LEVEL CONTROL PANEL (IN M.C.C.).
- ⑬ EXISTING SINGLE PHASE PANEL TO BE ABANDONED AND REMOVED THIS CONTRACT. INTERCEPT CONDUITS FROM LOADS AT A CONVENIENT POINT AND RECONNECT CIRCUITS TO NEW PANEL A IN NEW MCC.
- ⑭ EXISTING SCADA RTU TO REMAIN. WIRE NEW SIGNALS FROM PUMP STARTERS & CONTROLS TO EXISTING RTU. COORDINATE EXACT REQUIREMENTS FOR MONITORING WITH THE OWNER.
- ⑮ EXISTING COAXIAL CABLE AND ANTENNA FOR SCADA RTU. DO NOT DISTURB.

KEYNOTES (CONTINUED):


- ⑯ NEW #6 AWG GROUNDED CONDUCTOR TO RTU FOR LIGHTNING ARRESTOR GROUND.
- ⑰ FURNISH AND INSTALL A 1KW BULKHEAD LIGHTNING ARRESTOR ON COAXIAL CABLE BEFORE IT ATTACHES TO RADIO.
- ⑱ NEW #1/0 BARE COPPER GROUNDING ELECTRODE CONDUCTOR SLEEVED IN A 3/4" CONDUIT TO OUTSIDE. BOND TO ANY EXISTING GROUNDING ELECTRODE SYSTEM AT OLD MCC LOCATION.
- ⑲ NEW GROUNDING ELECTRODE ARRAY.
- ⑳ SEAL CONDUIT AGAINST GROUNDWATER ENTRY.
- ㉑ ALL CONDUITS FROM WETWELL TO PUMP STATION SHALL BE FITTED WITH SEALING FITTINGS.
- ㉒ NEW ELECTRIC HEATER - SEE MECHANICAL PLAN FOR THERMOSTAT LOCATION (PROVIDE WIRING).
- ㉓ PROVING SWITCH FOR EF-1.
- ㉔ 2#16, SHIELDED AND TWISTED PAIR, 3/4"
- ㉕ 19#12, 1°C
- ㉖ COMBUSTIBLE GAS ALARM PANEL. SCOTT GAS PLUS OR EQUAL.
- ㉗ NEW COMBUSTIBLE GAS DETECTOR SET UP FOR METHANE AND MOUNTED 6'-6" A.F.F.
- ㉘ NEW BACKUP HIGH LEVEL ALARM FLOAT.
- ㉙ 3#12, 3/4°C FOR HIGH LEVEL ALARM TO RTU.
- ㉚ 7#12, 3/4°C FROM LEVEL CONTROLS TO MCC FOR PUMP START/STOP CONTROL.
- ㉛ 31 ABANDON & REMOVE EXISTING LIGHT FIXTURE BLACKOFF BOX.
- ㉜ REMOVE AND REPLACE WETWELL VENTILATOR MOTOR ON ROOF WITH A NEW MOTOR RATED FOR CLASS 1, DIVISION 1 GROUP C & D ATMOSPHERES. EXISTING MOTOR 1/3HP, 115 VOLT, 725 RPM.

KEYNOTES (CONTINUED):

- ㉝ REWIRE EXISTING SUMP PUMP TO NEW MOTOR STARTER.
- ㉞ NEW SWITCH(ES).
- ㉟ NEW HOLOPHANE 7200-4-12-J-F OR EQUAL 2 LAMP FLUORESCENT LUMINAIRE.
- ㉟ NEW HOLOPHANE WL2K-150HP-12-BZ OR EQUAL WALLPACK.
- ㉟ NEW HOLOPHANE DM5-C-36-S-NN-2-DL OR EQUAL EMERGENCY FIXTURE.
- ㉟ NEW MOTORIZED AIR INTAKE DAMPER FOR EF-2.
- ㉟ RS-485 CABLE 3/4°C FROM MCC TO EXISTING SCADA FOR VFD MONITORING.

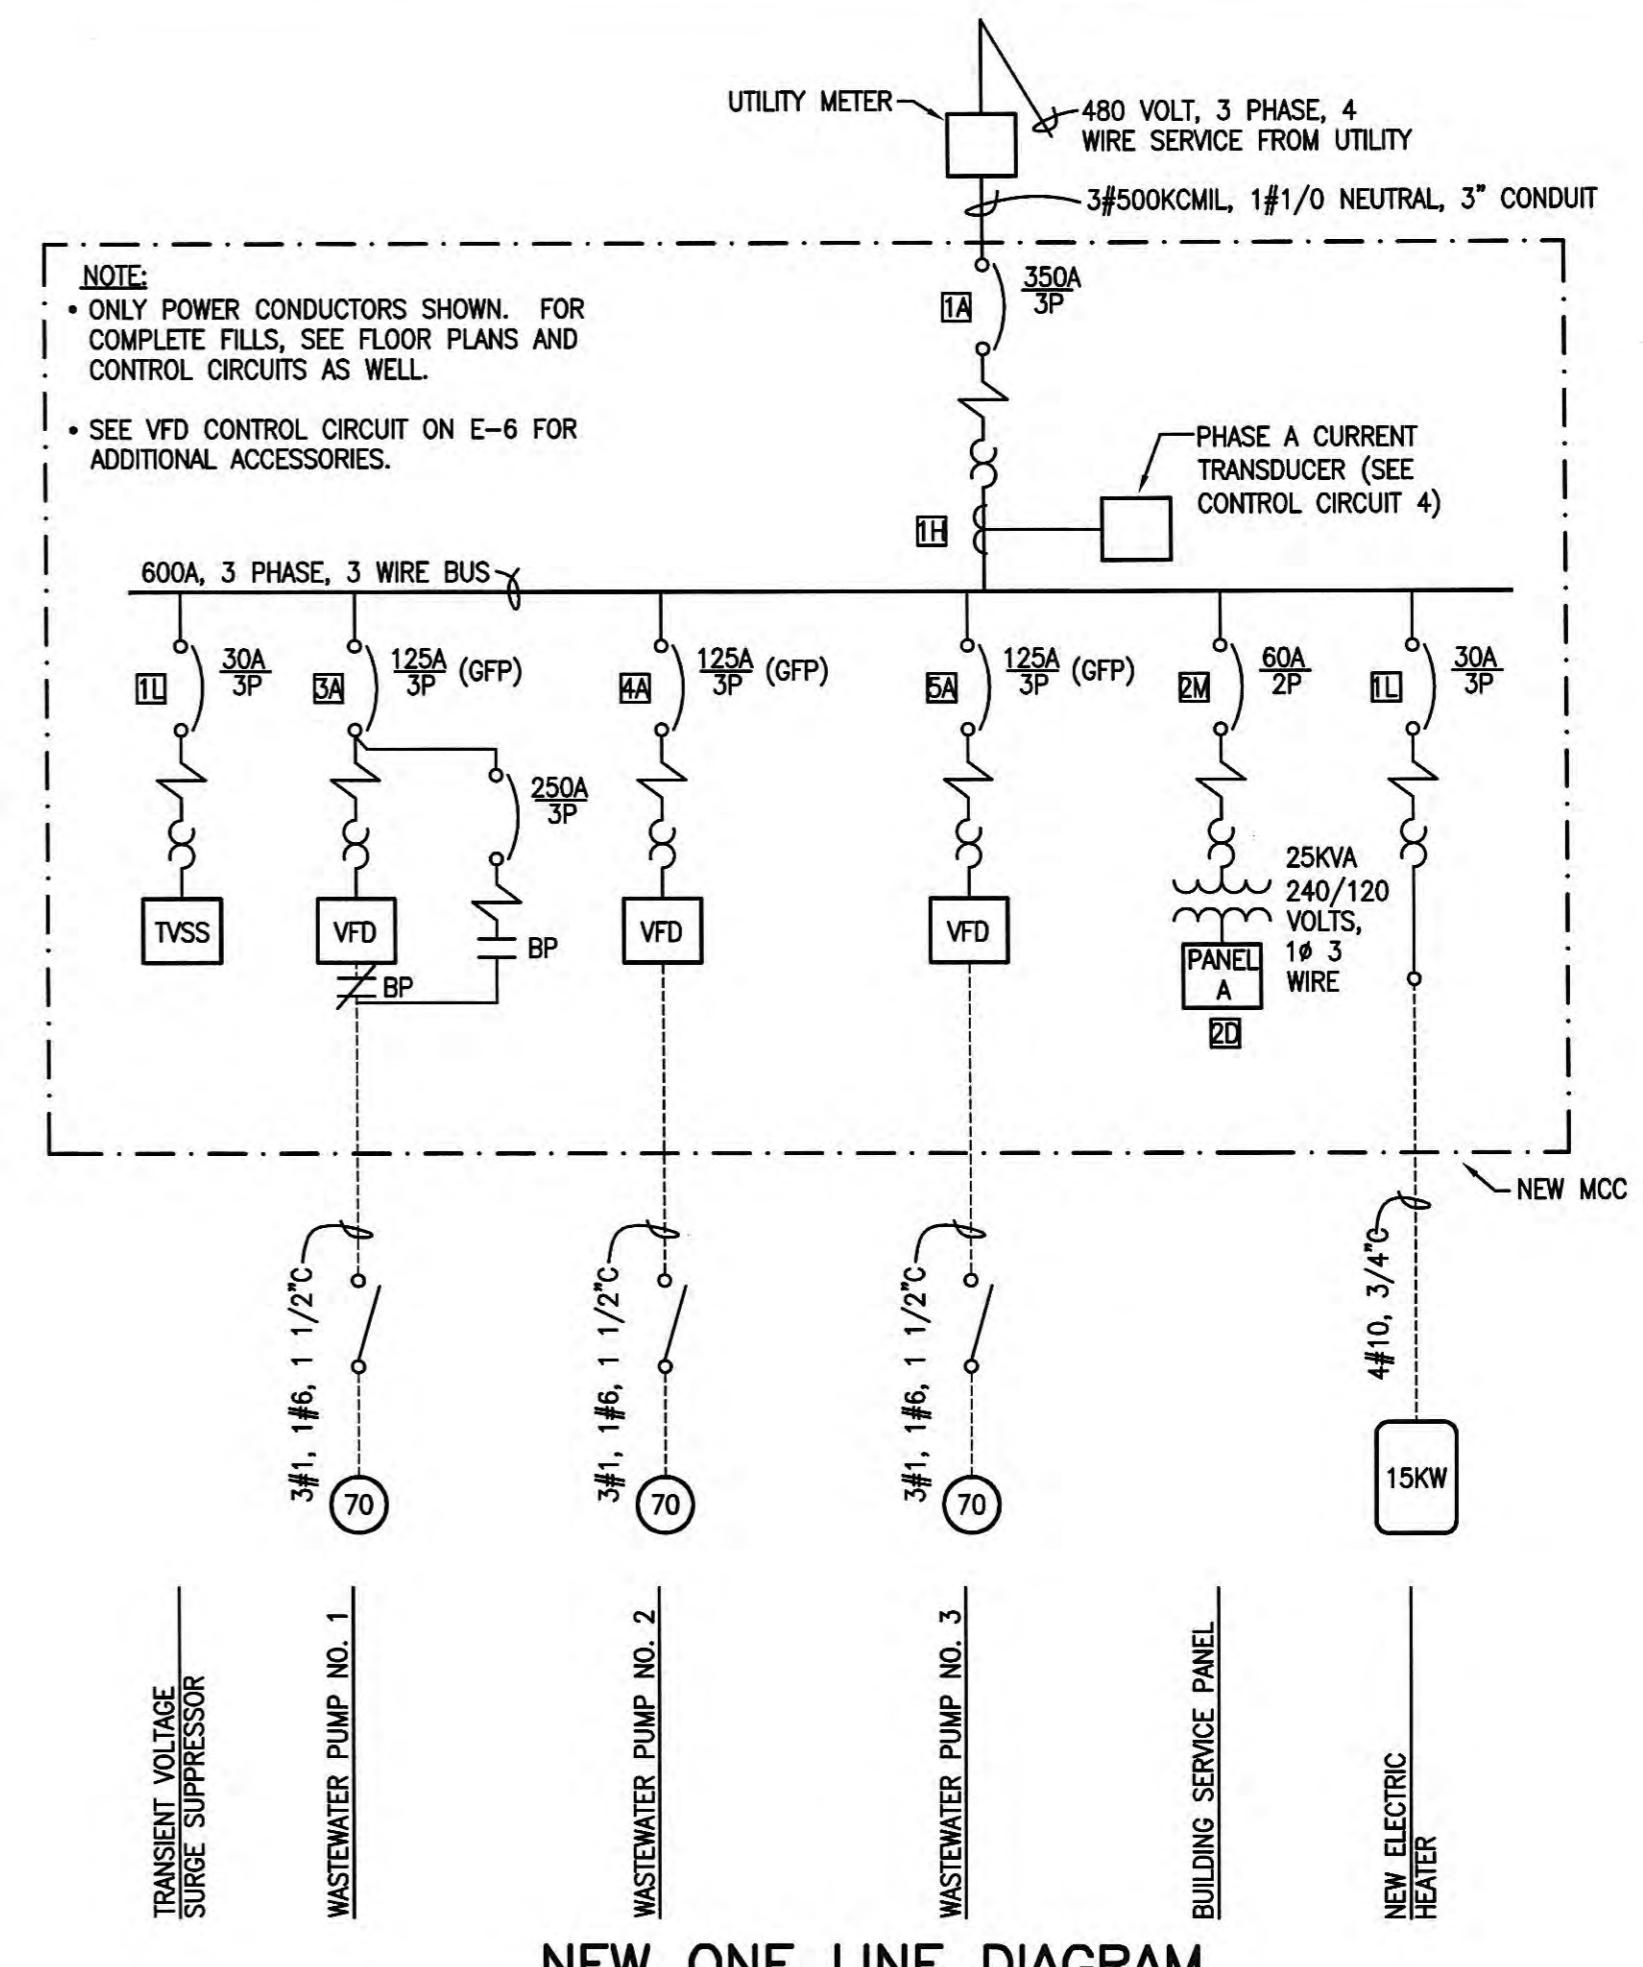


NEW ONE LINE DIAGRAM
NO SCALE

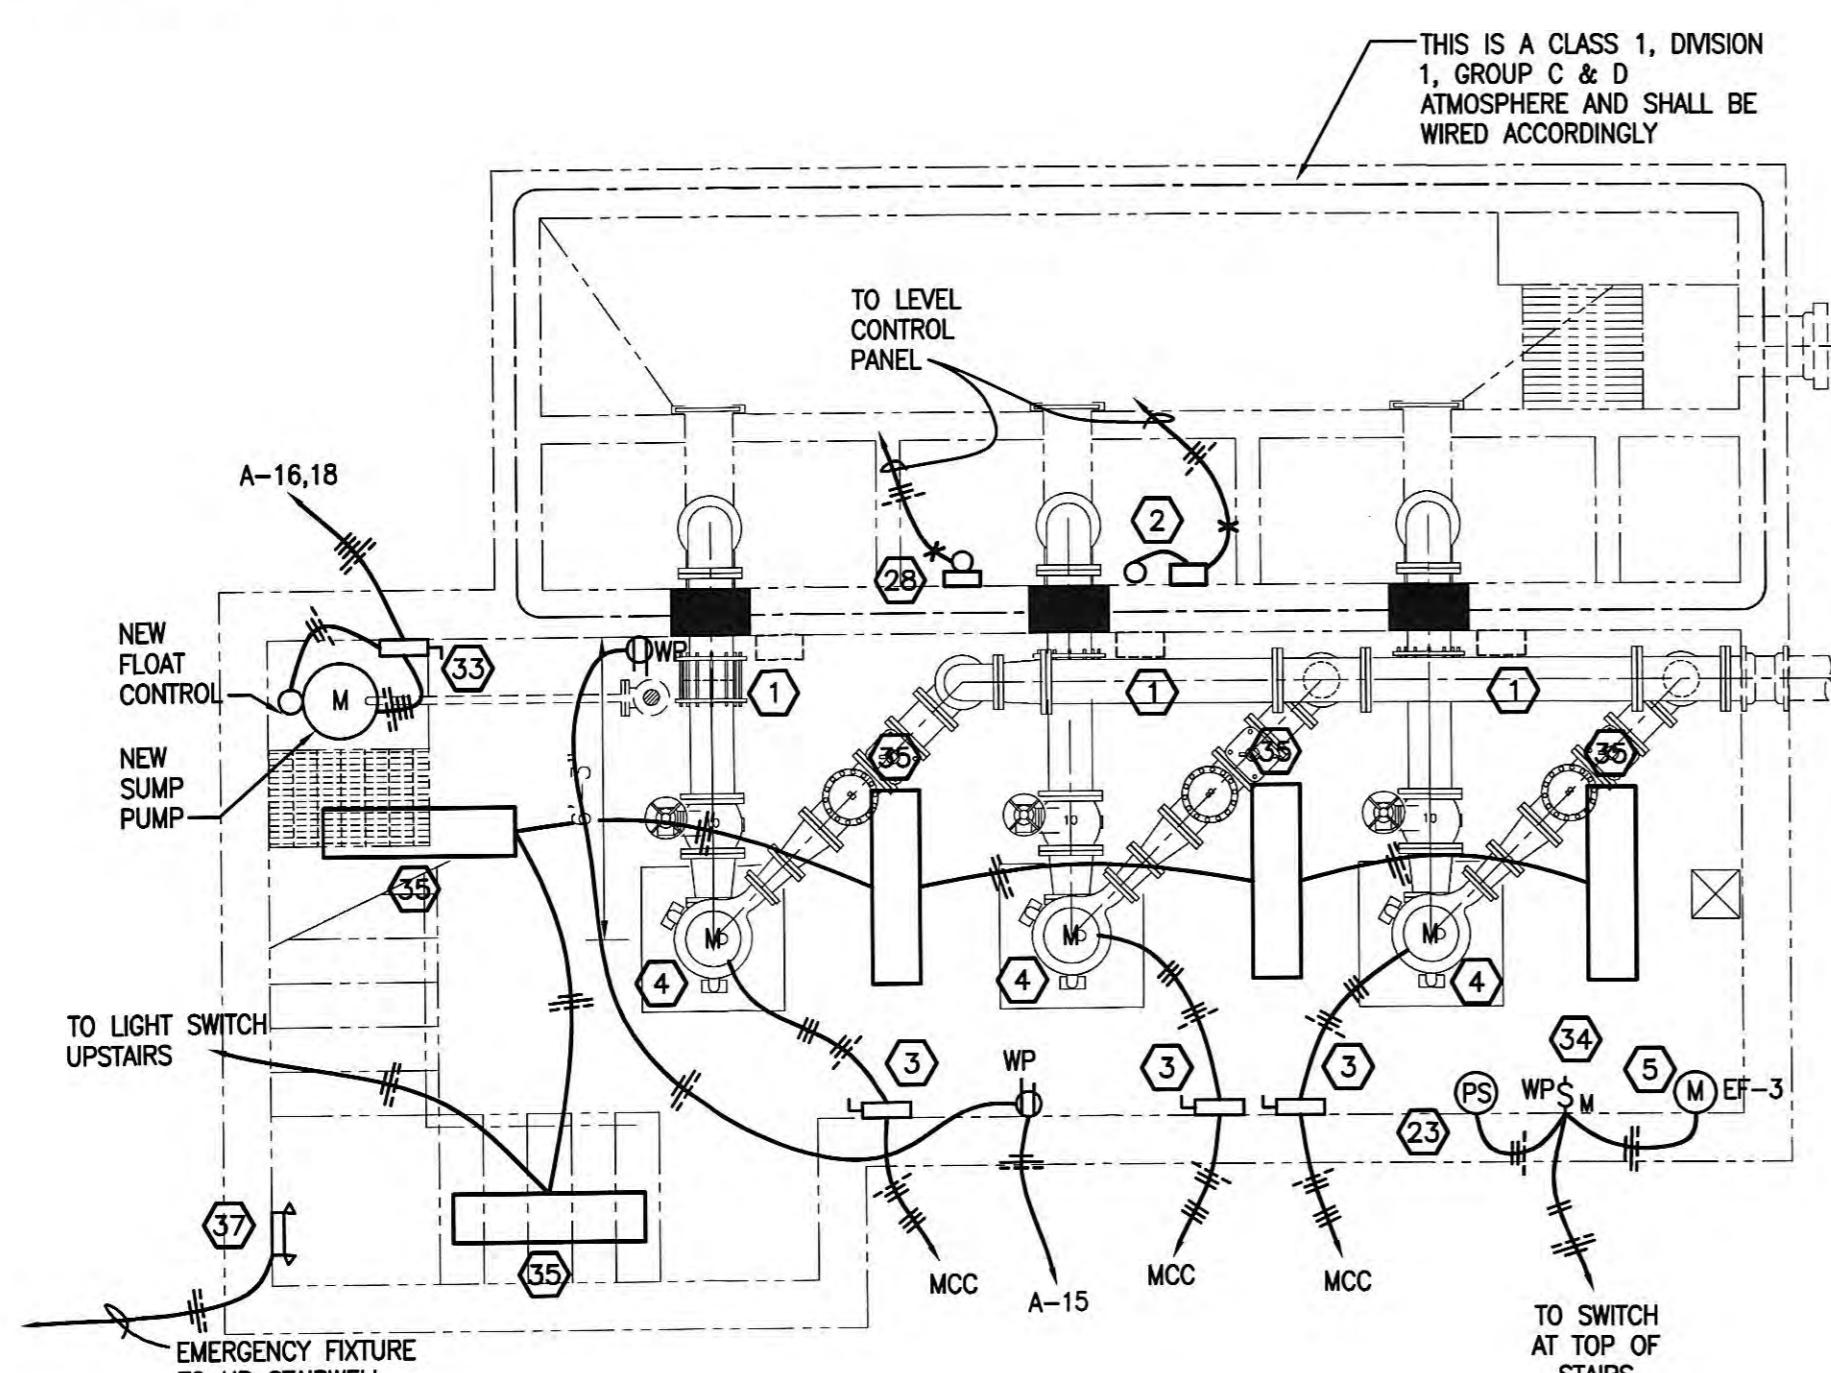

MODIFIED FLOOR PLAN - PUMP LEVEL

SCALE: 1/4" = 1'-0"

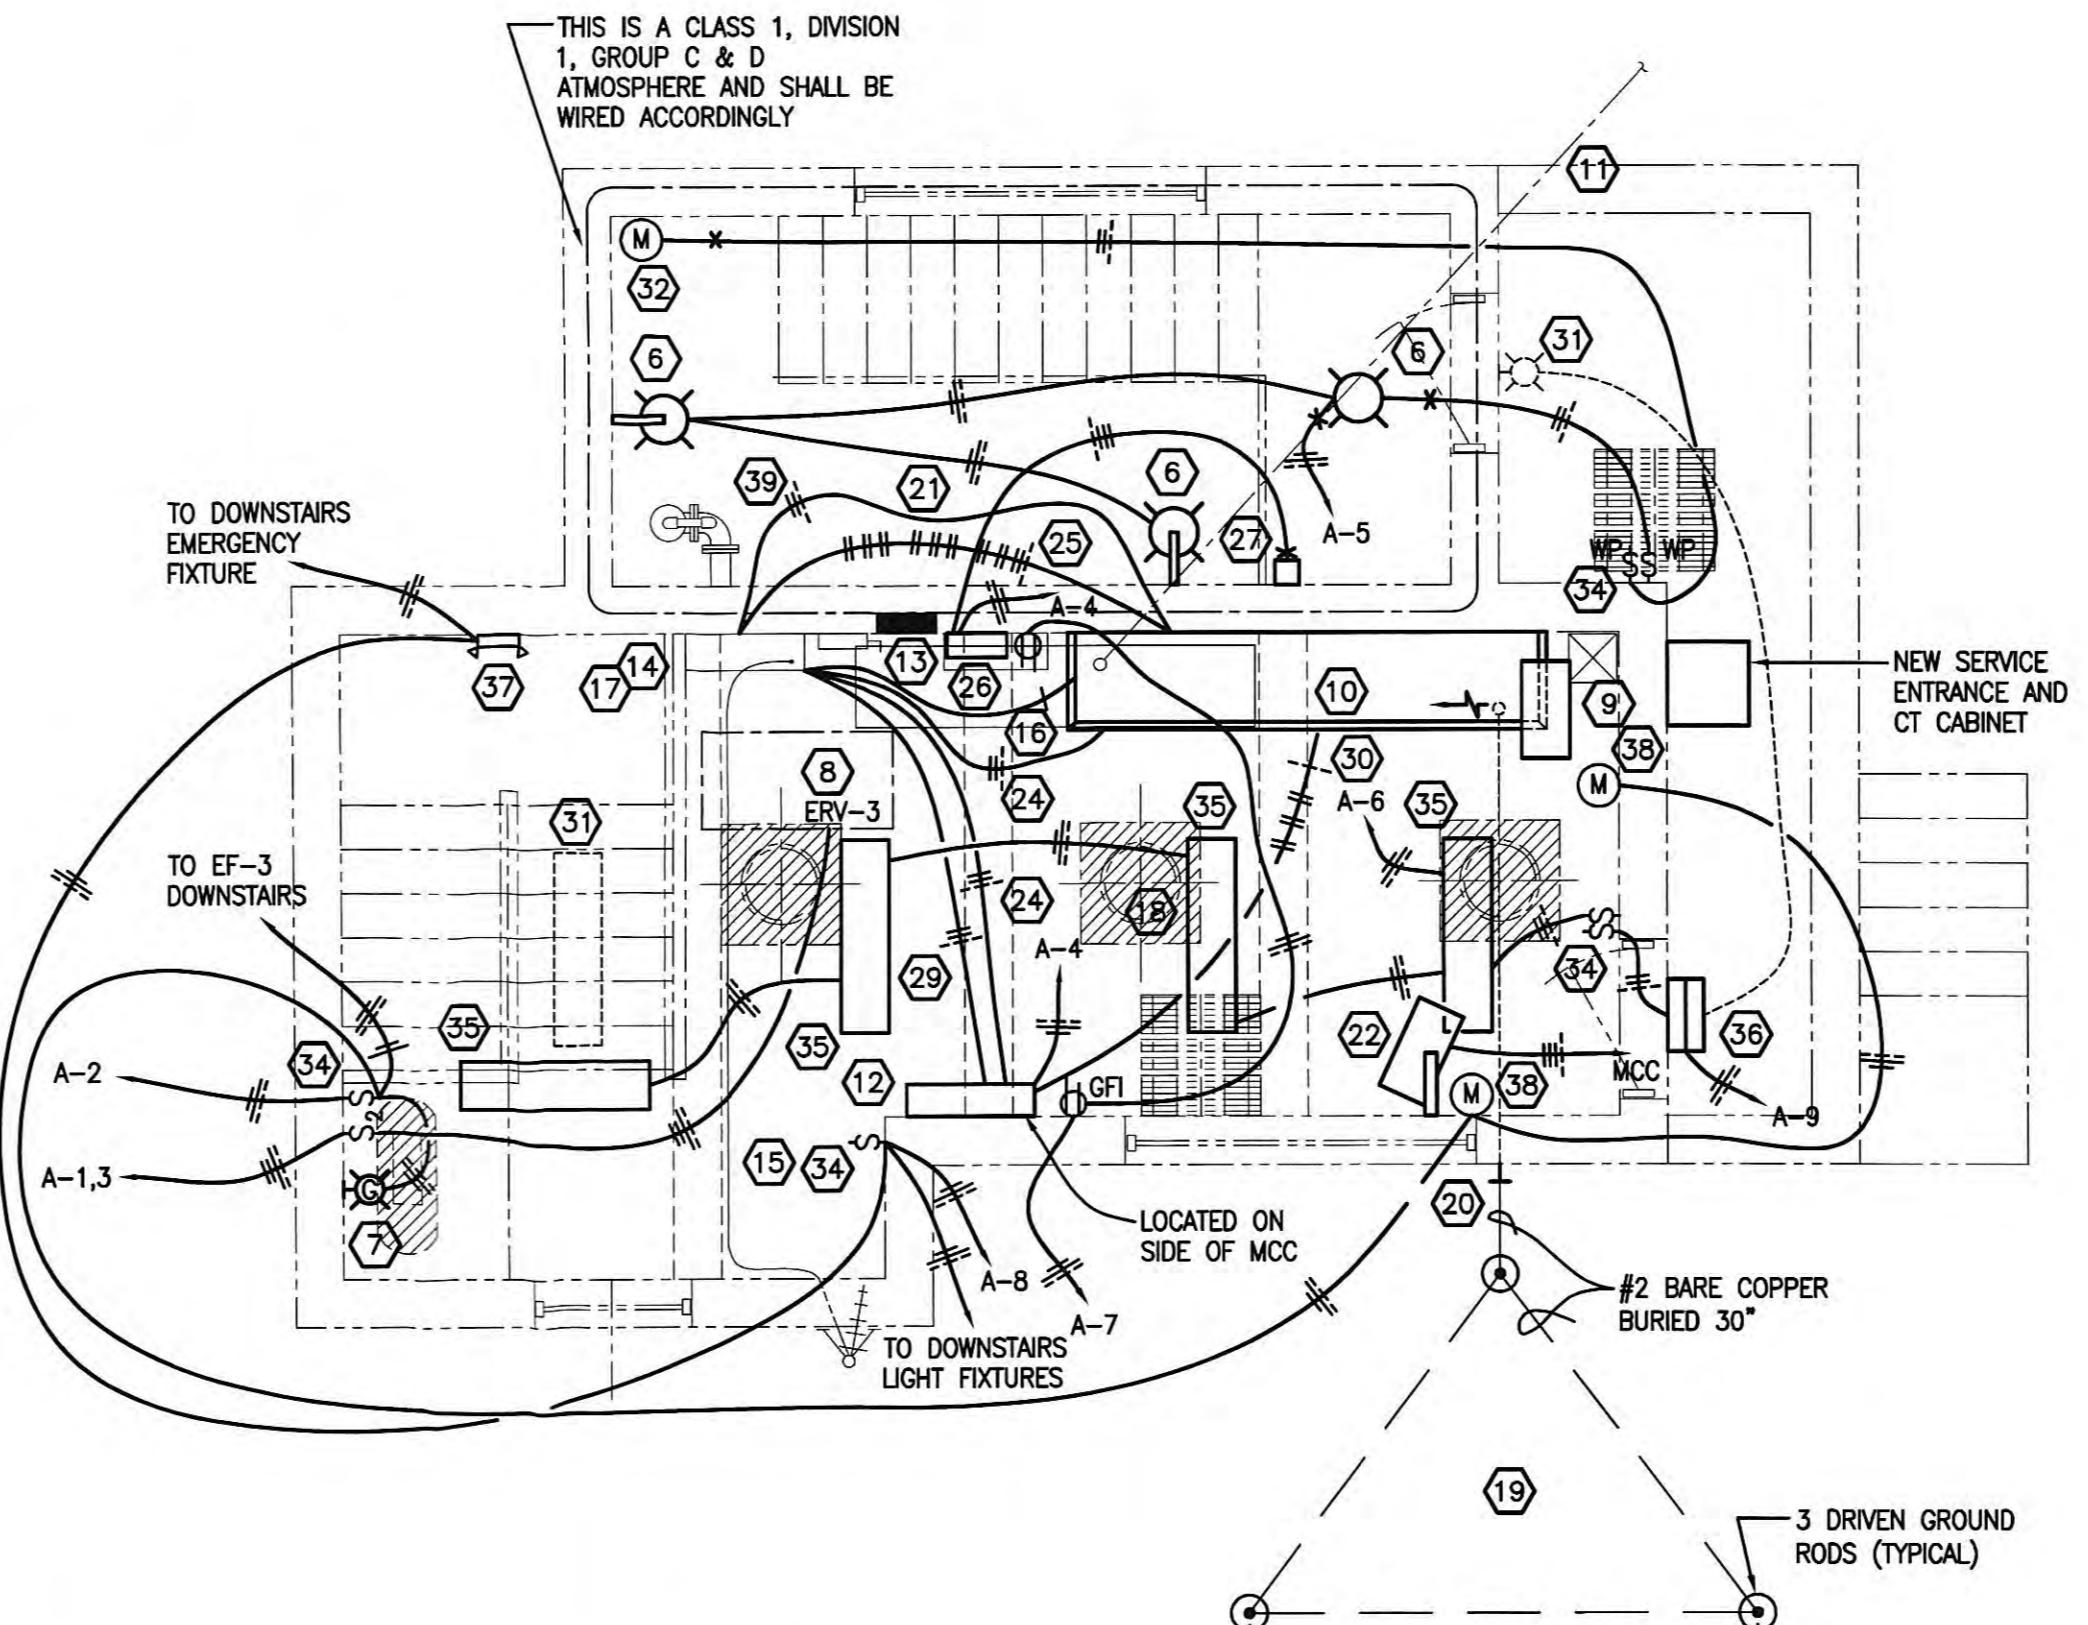

MODIFIED FLOOR PLAN - ENTRANCE LEVEL

SCALE: 1/4" = 1'-0"

NOTE:

- SEE GENERAL PROJECT NOTES ON DRAWING E-3.
- SEE TYPICAL DETAILS ON DRAWING E-2.

ALL RIGHTS RESERVED.
THIS DOCUMENT IS THE PROPERTY OF GRW ELROD DUNSON, INC. AND SHALL NOT BE REPRODUCED IN WHOLE OR IN PART OR USED FOR CONSTRUCTION OF OTHER THAN THIS SPECIFIC PROJECT WITHOUT WRITTEN PERMISSION OF GRW ELROD DUNSON, INC.

NO.	DESCRIPTION	DATE	BY

RECORD DRAWINGS

THESE RECORD DRAWINGS REPRESENT THE "AS-BUILT" PROJECT TO THE BEST OF THE ENGINEER'S KNOWLEDGE. ALTHOUGH PREPARED FROM THE CONSTRUCTION RECORD, THEY CANNOT BE GUARANTEED TO BE EXACT IN EVERY DETAIL.

CHECKED BY:
S. Brown
ENGINEER'S REPRESENTATIVE
DATE: 6/2007




DESIGNED:	DATE:
WLM	JUNE, 2004
DRAWN:	SCALE:
JMG	AS NOTED
REVIEWED:	SHEET NO.:
WLM	
APPROVED:	
WLM	

GRW PROJECT NO. 7601-30 CONTRACT NO. S02-03

EXISTING WOODY SEWAGE PUMP STATION
ELECTRICAL
HARRIMAN UTILITY BOARD
HARRIMAN, TENNESSEE


GRW Elrod Dunson, Inc.
Engineers, Architects, Planners
LEXINGTON LOUISVILLE INDIANAPOLIS
NASHVILLE KNOXVILLE

E-7

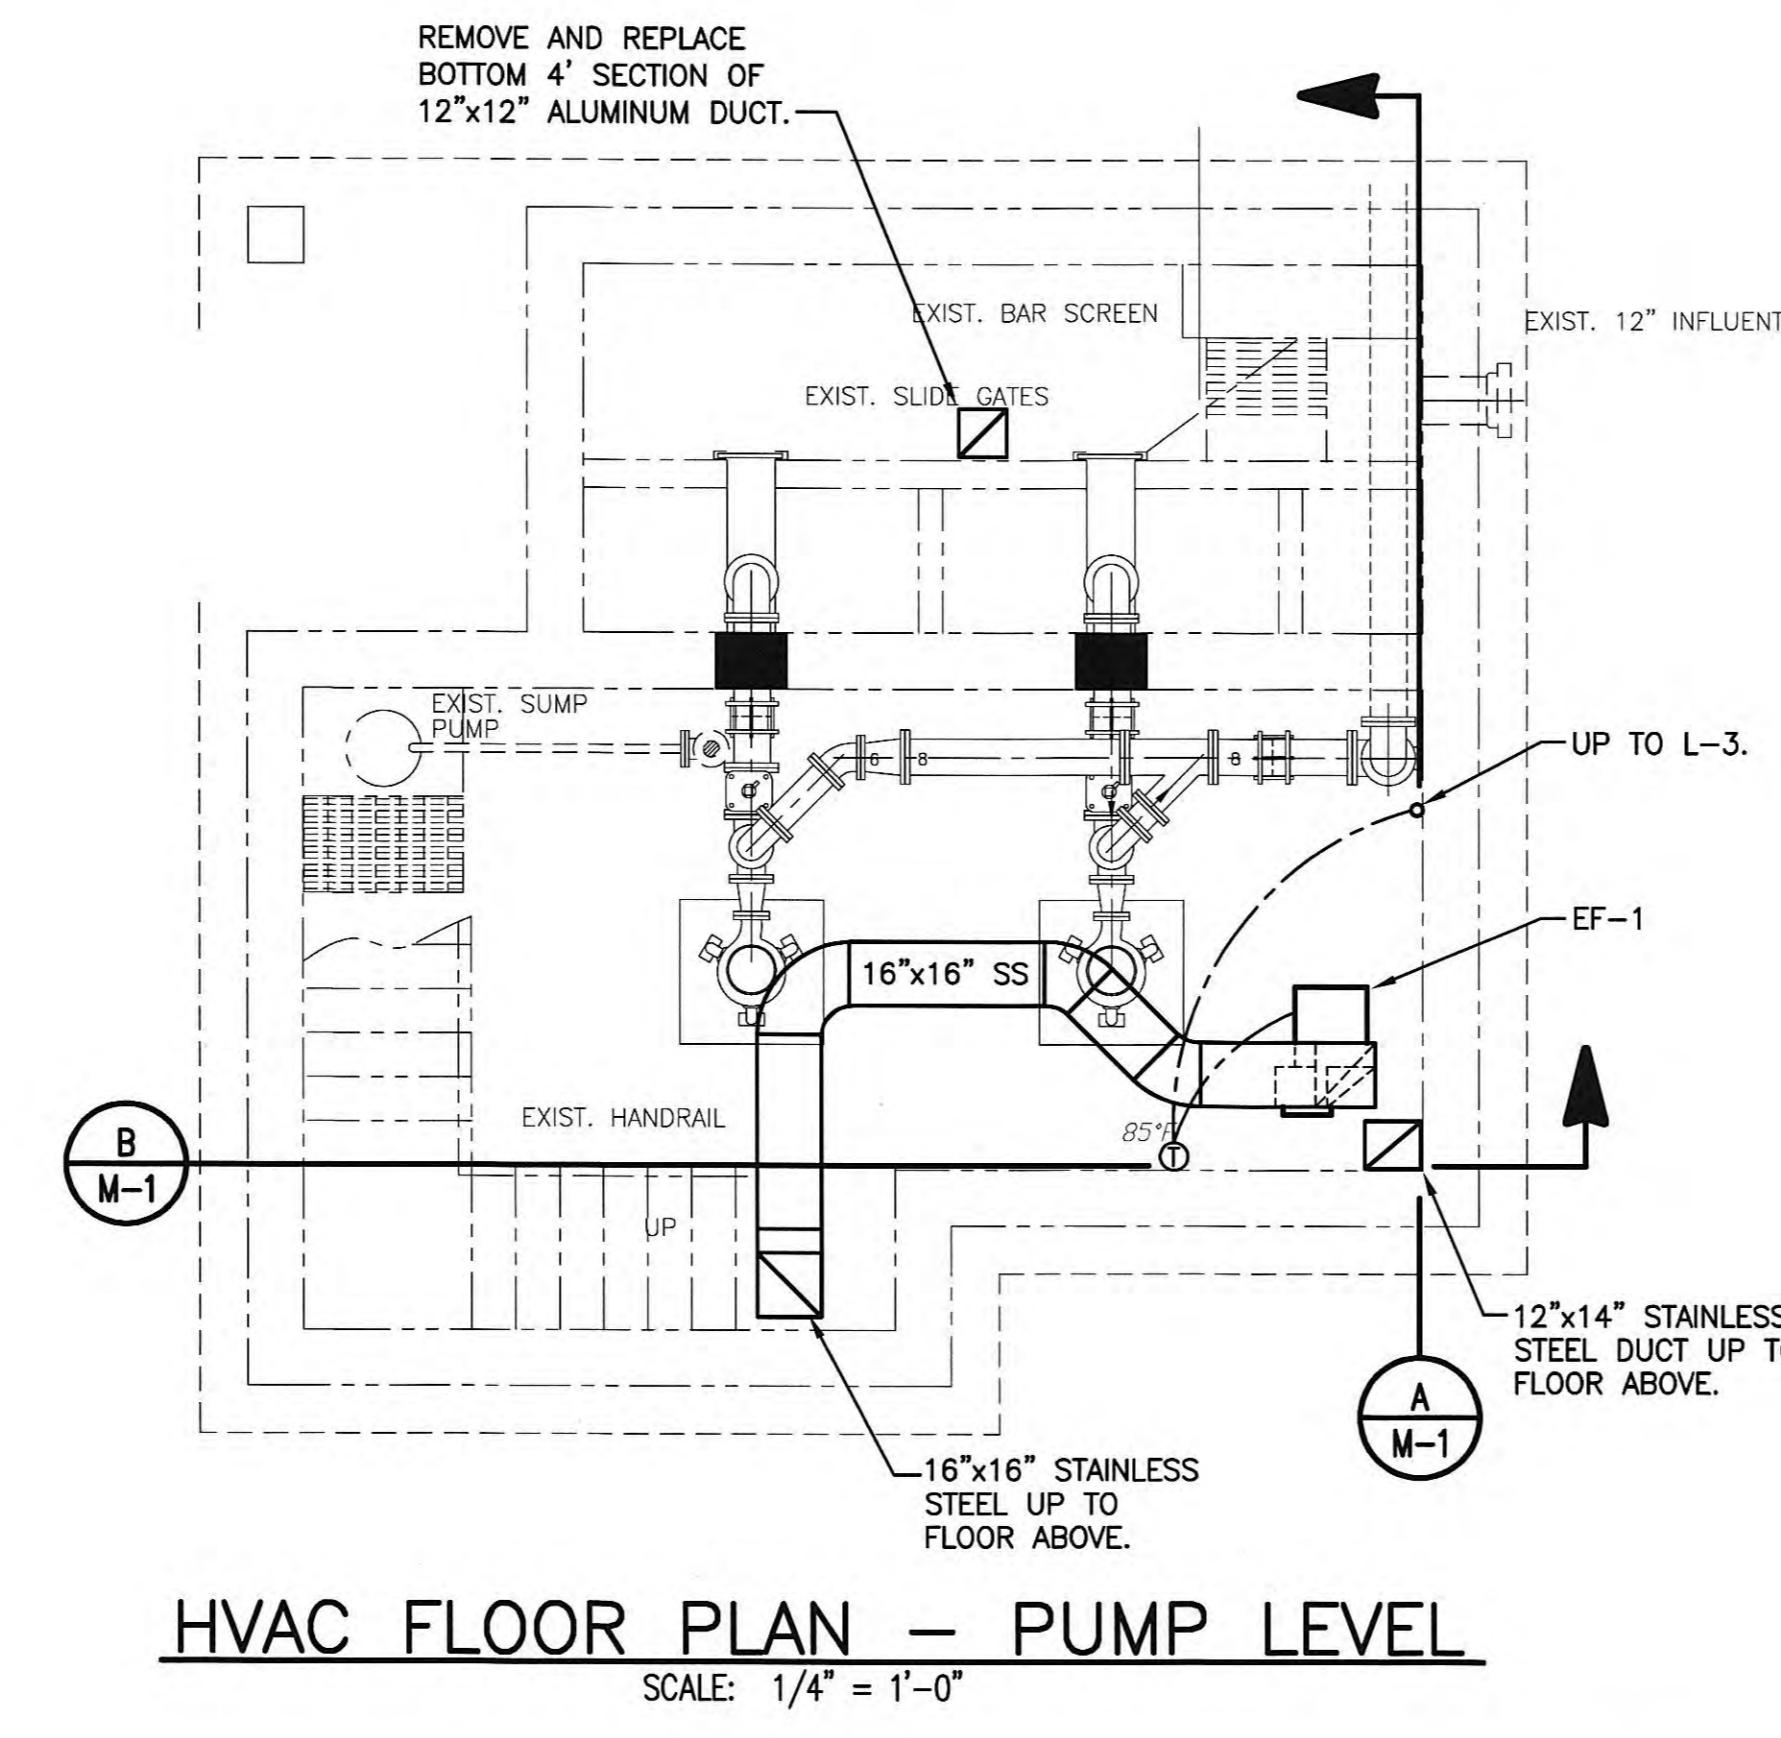


HVAC FLOOR PLAN – PUMP LEVEL

SCALE: 1/4" = 1'-0"

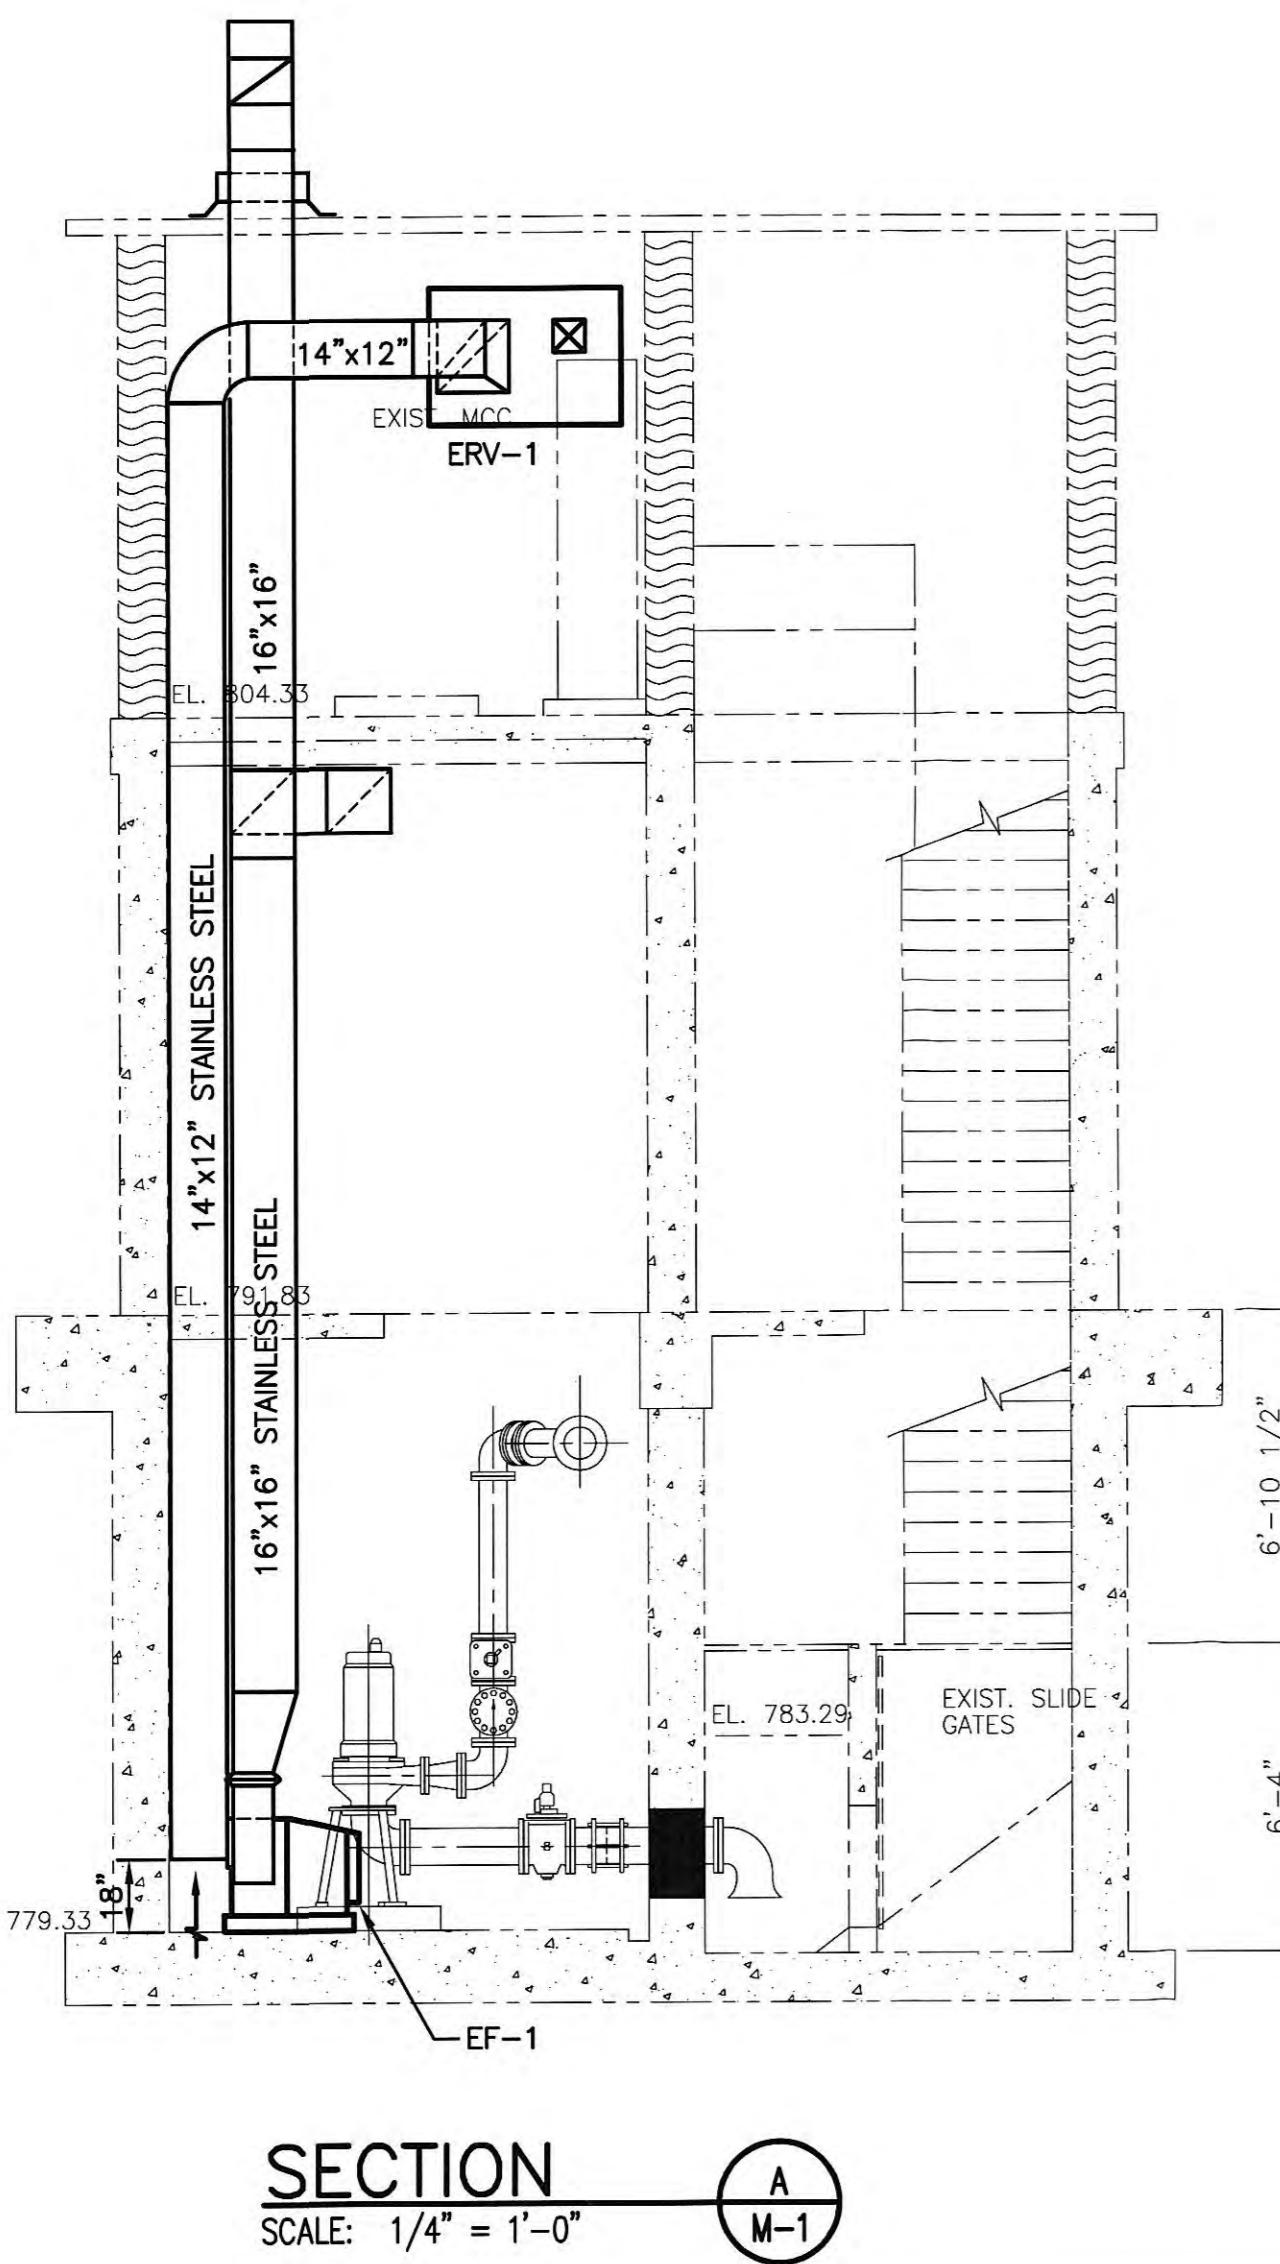


SECTION

Tue, 05 Jun 2007 - 9:42am
FILE NAME: I:\Harriman UB - 7601 (WWTP, PS & lines)\7601-30 - Sewer System Rehab\CADD\S Harriman PS Rehab\Record Dwg\3041-M1.dwg

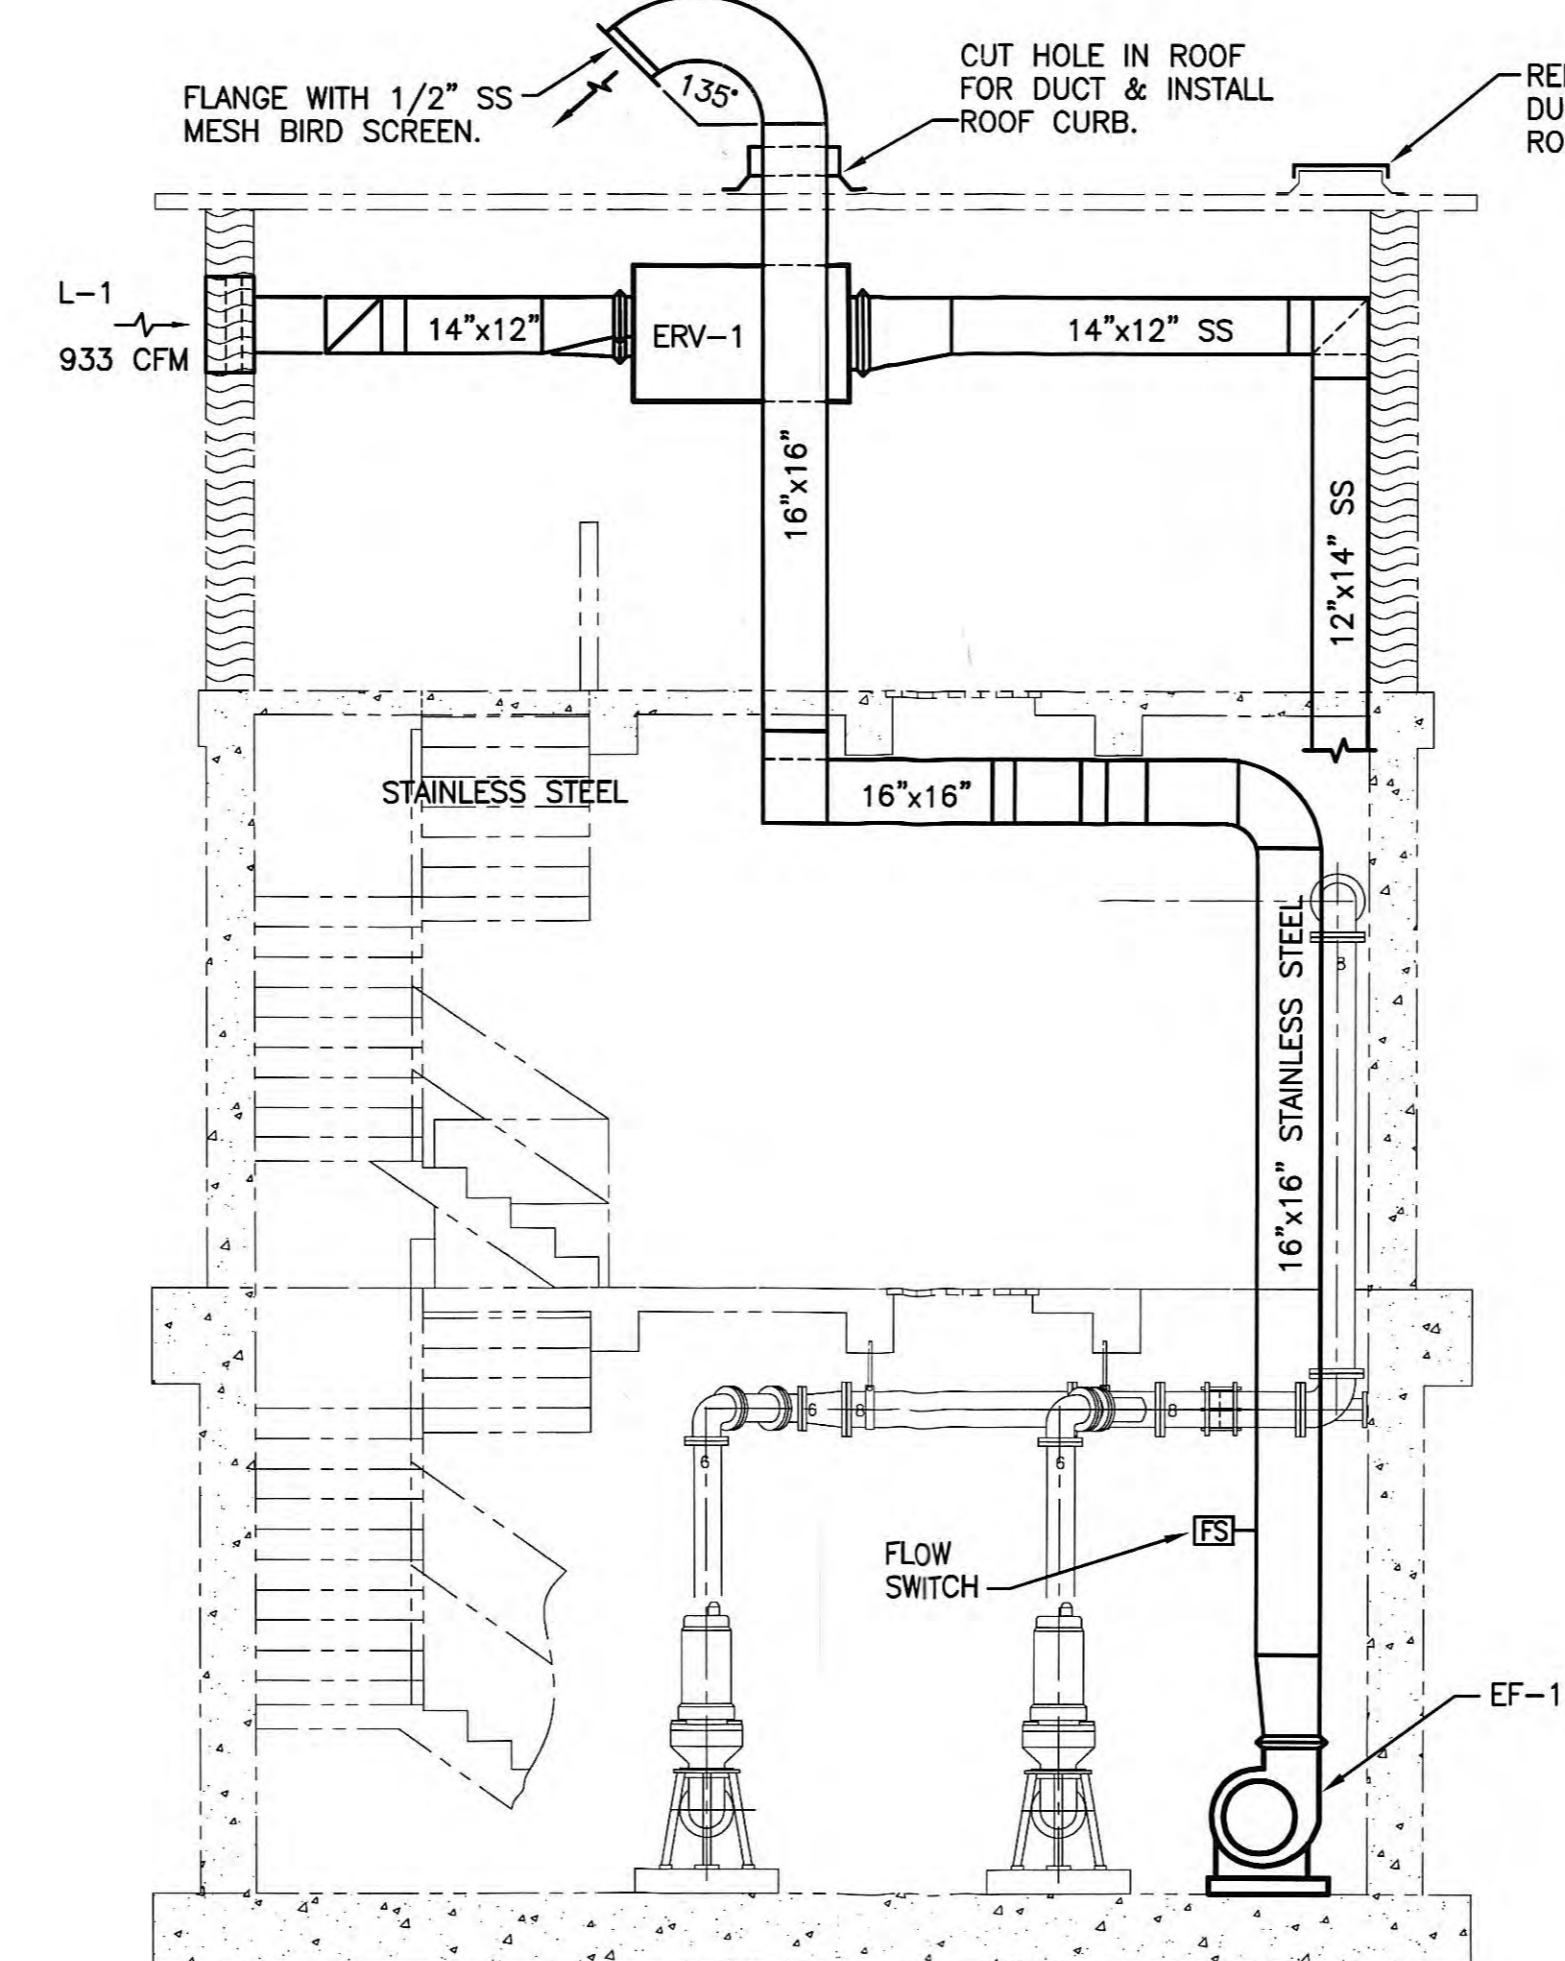


SECTION
SCALE: 1/4"

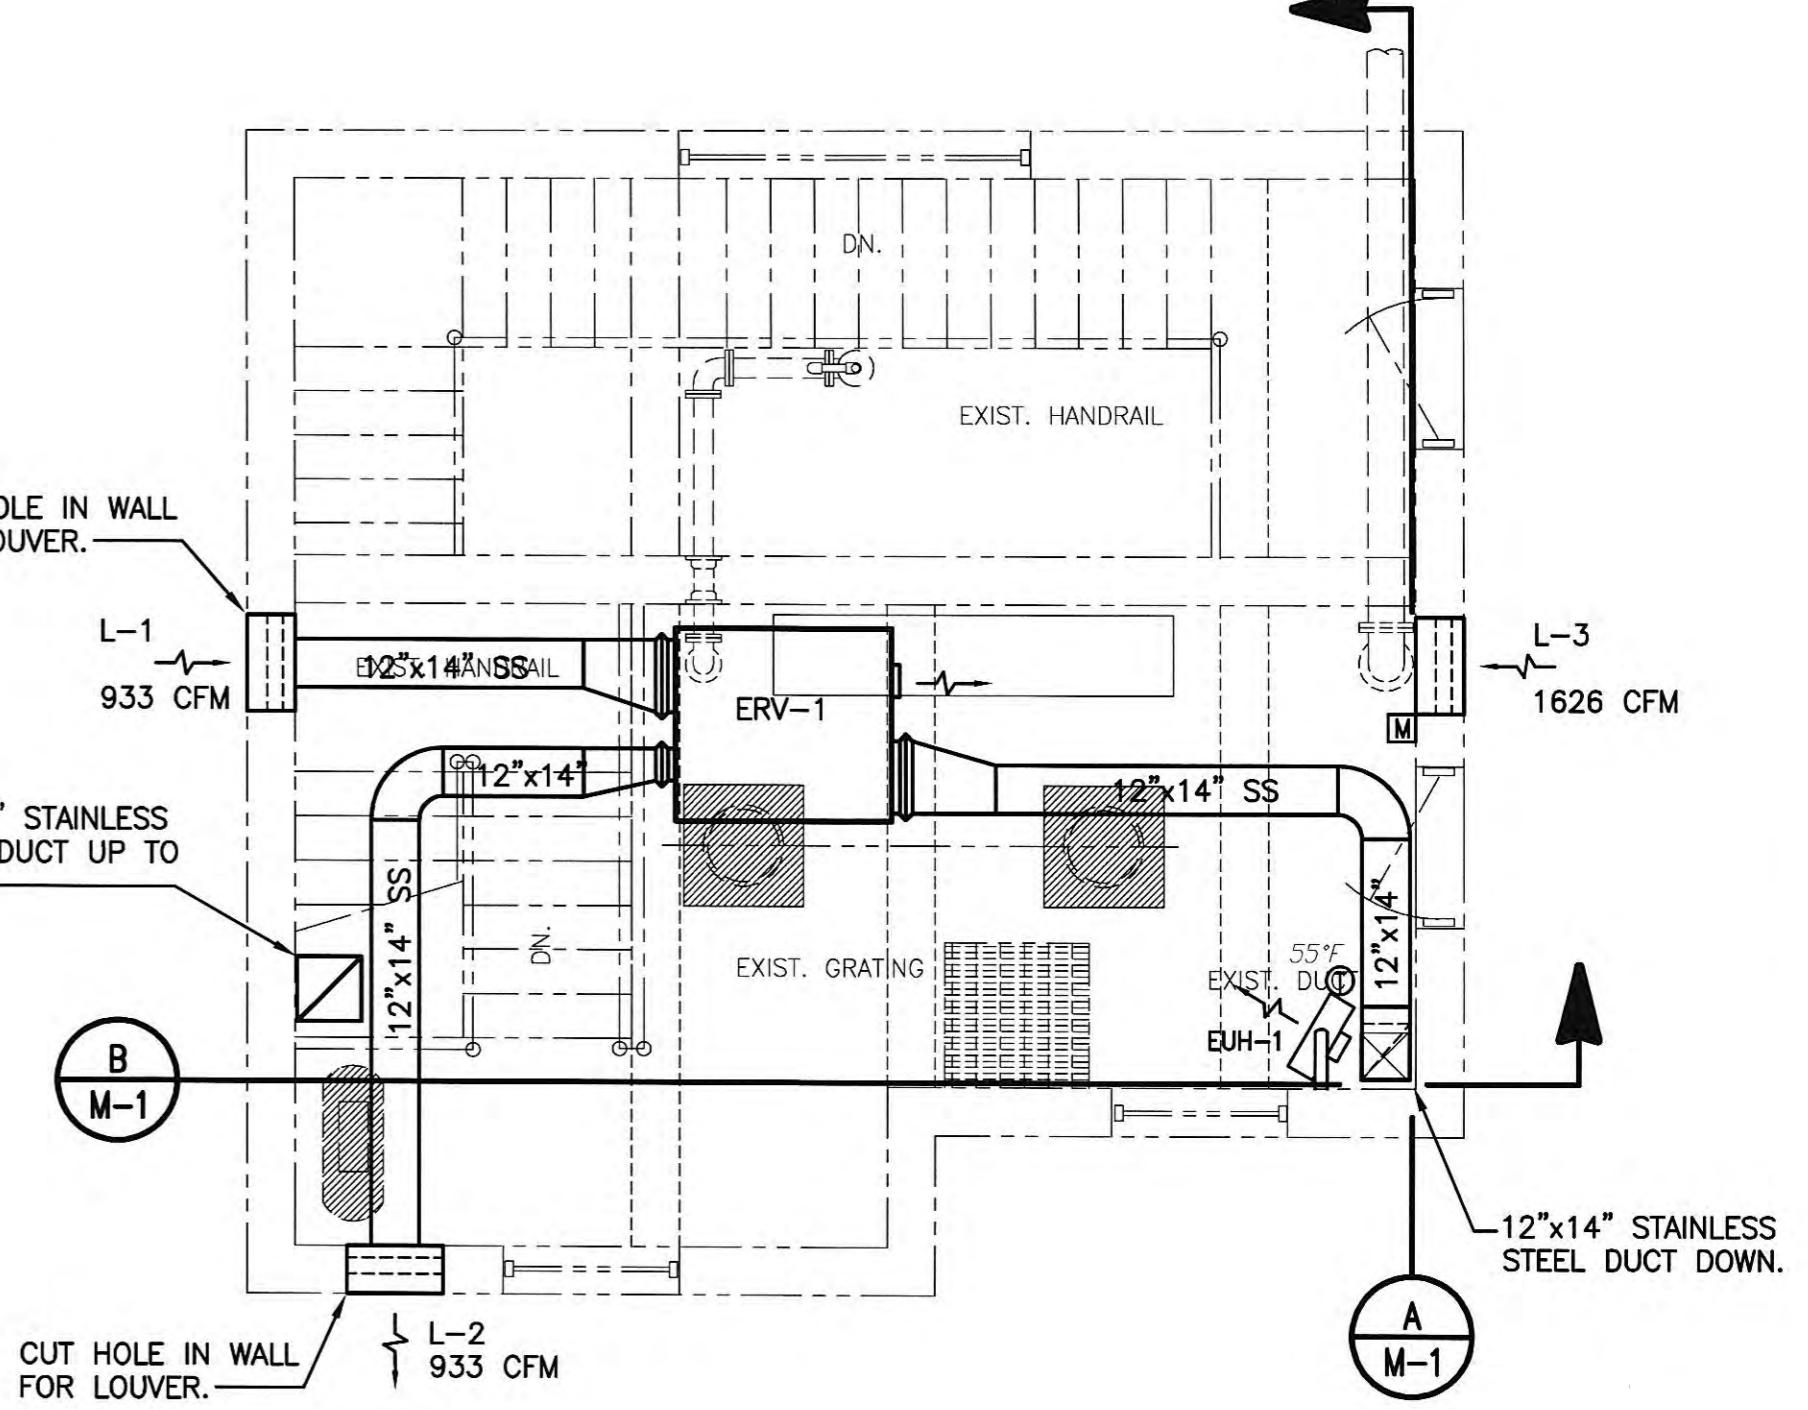

HVAC FLOOR PLAN – ENTRANCE LEVEL

SCALE: 1/4" = 1'-0"

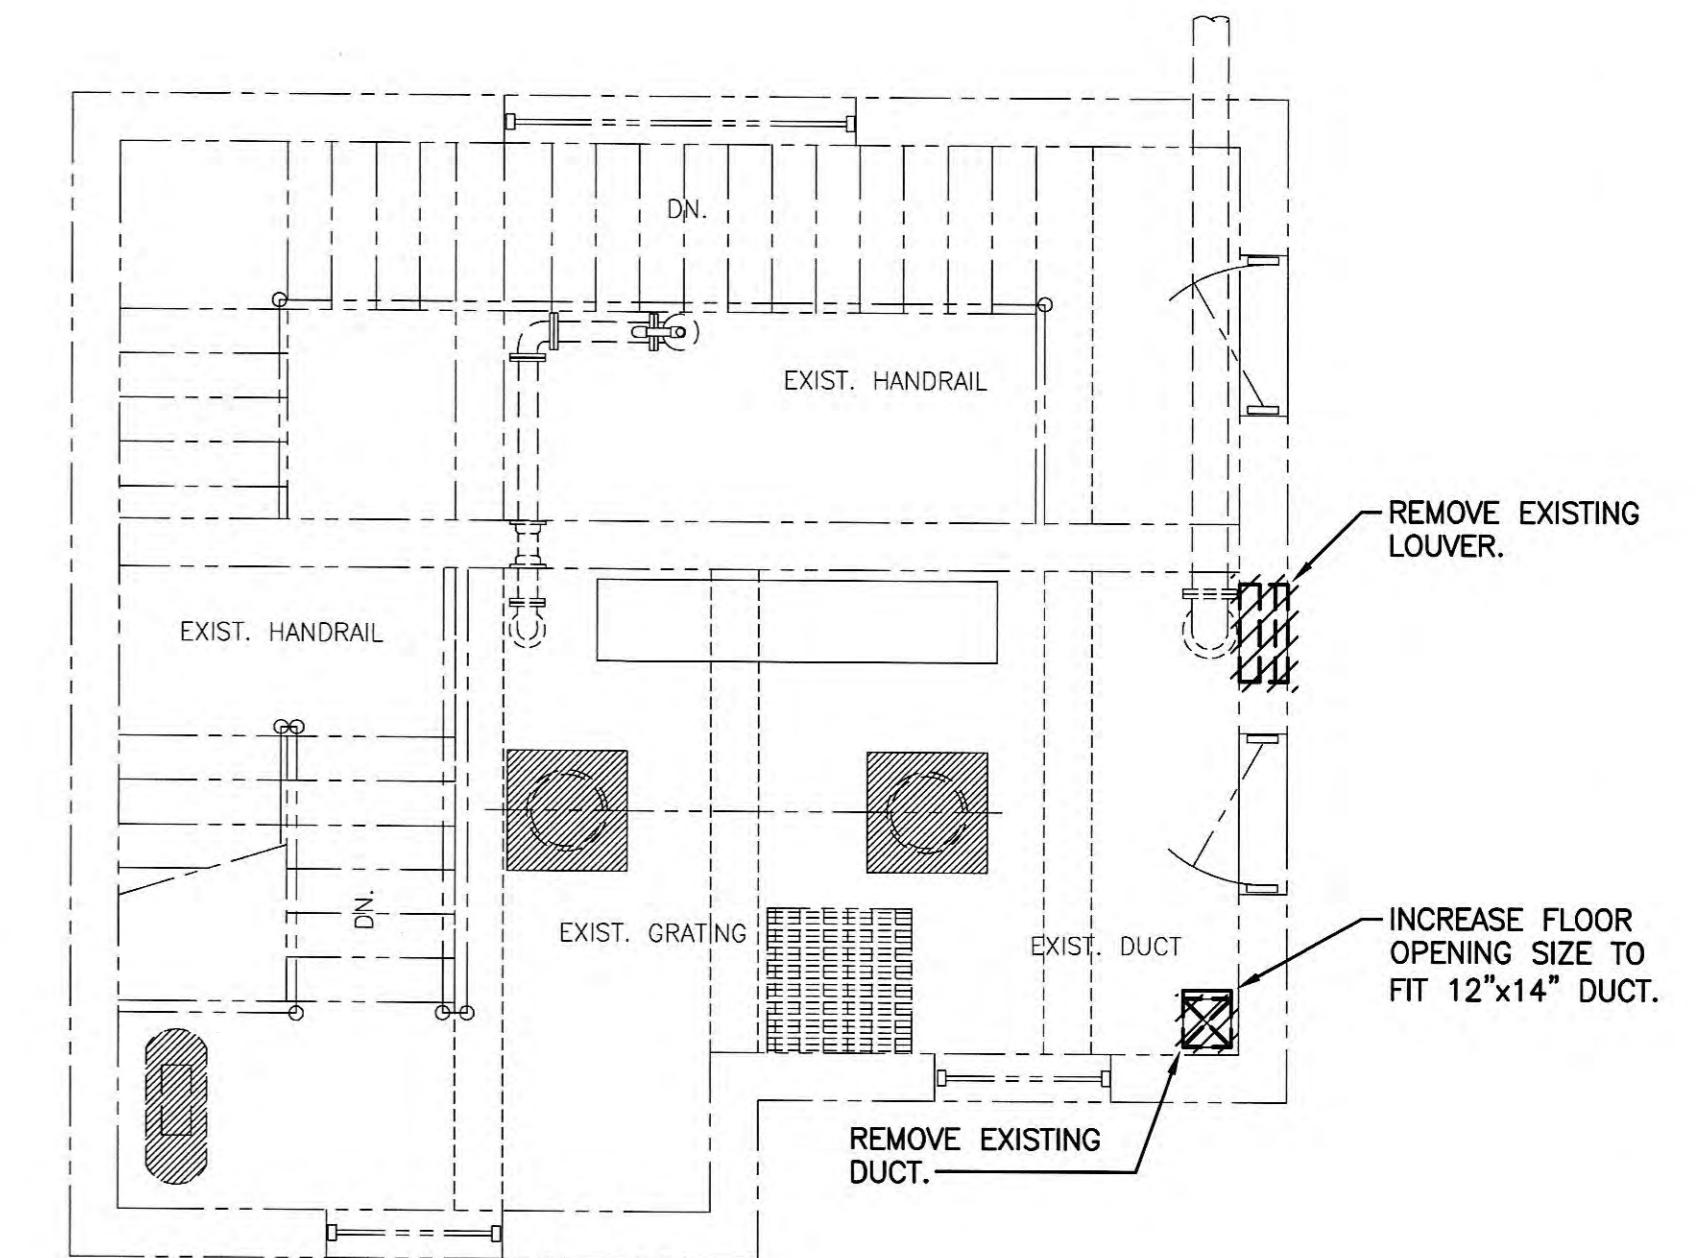


HVAC DEMOLITION PLAN – ENTRANCE LEVEL

SCALE: 1/4" = 1'-0"

<p>ALL RIGHTS RESERVED:</p> <p>THIS DOCUMENT IS THE PROPERTY OF GRW ELROD DUNSON, INC. AND SHALL NOT BE REPRODUCED IN WHOLE OR IN PART OR USED FOR CONSTRUCTION OF OTHER THAN THIS SPECIFIC PROJECT WITHOUT WRITTEN PERMISSION OF GRW ELROD DUNSON, INC.</p>				
NO.	DESCRIPTION	DATE	BY	<p>This document, originally issued, sealed, and signed by Robert G. Ely, Kentucky Professional Engineer, No. 00102520, on June 4, 2004, shall not be used in lieu of a certified document.</p>  <p>GRW EI Engineers LEXINGTON</p>
REVISIONS				




P STATION	
S	
D	
	DATE:
	JUNE, 2004
	SCALE:
	AS NOTED
	SHEET NO.
	M-1

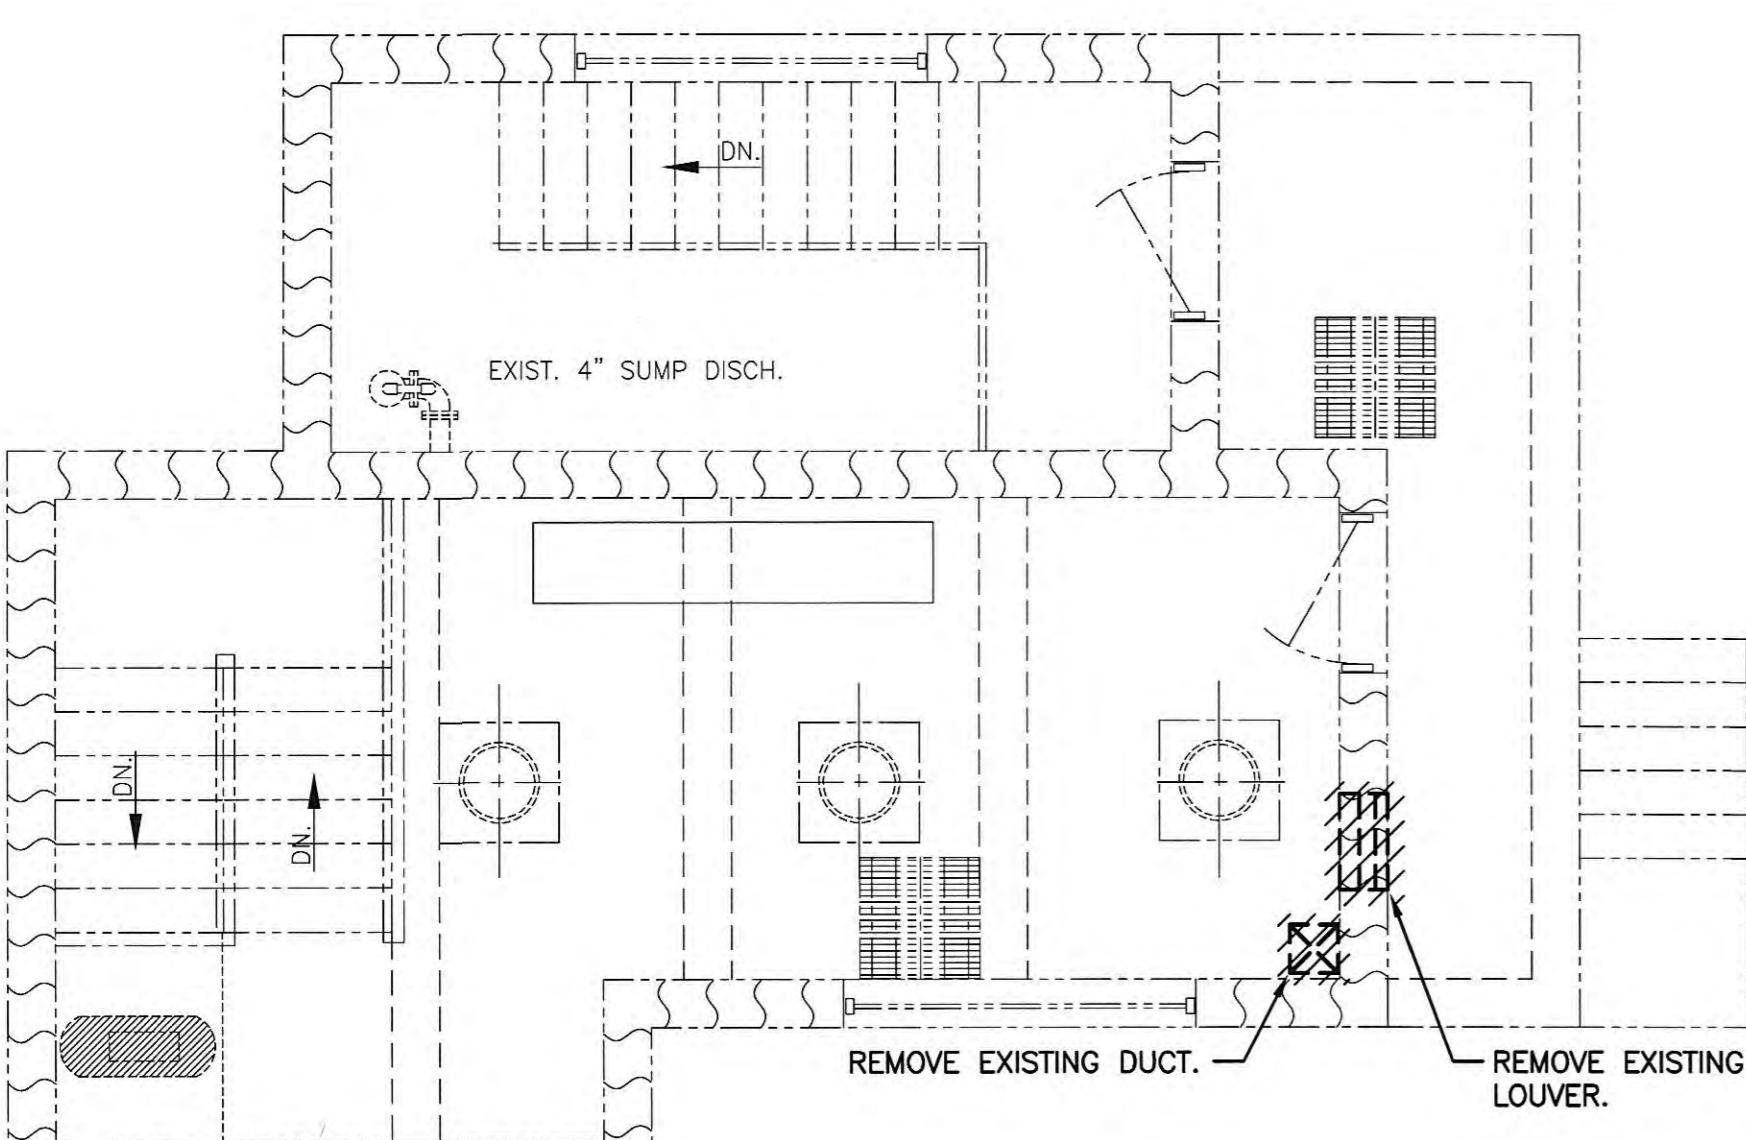


HVAC DEMOLITION PLAN – ENTRANCE LEVEL

SCALE: 1/4" = 1'-0"

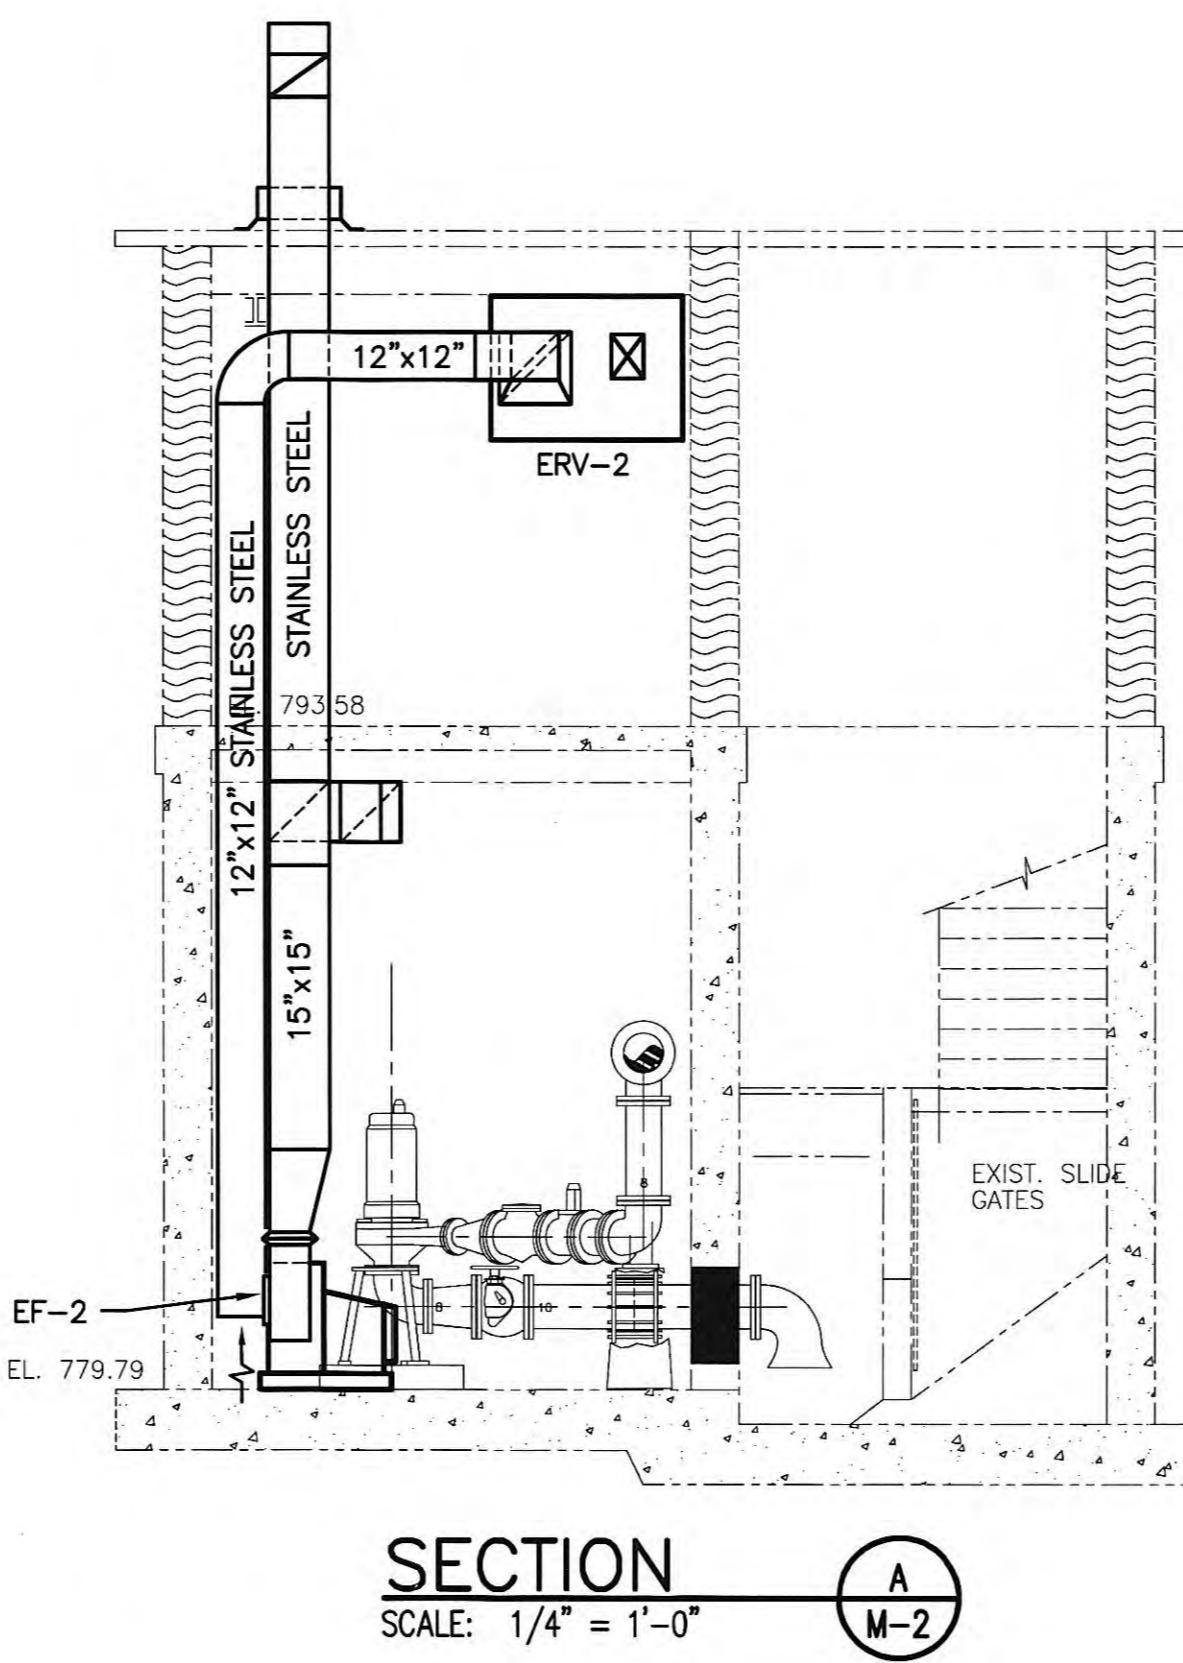


SECTION A-A

SCALE: 1/4" = 1'-0"

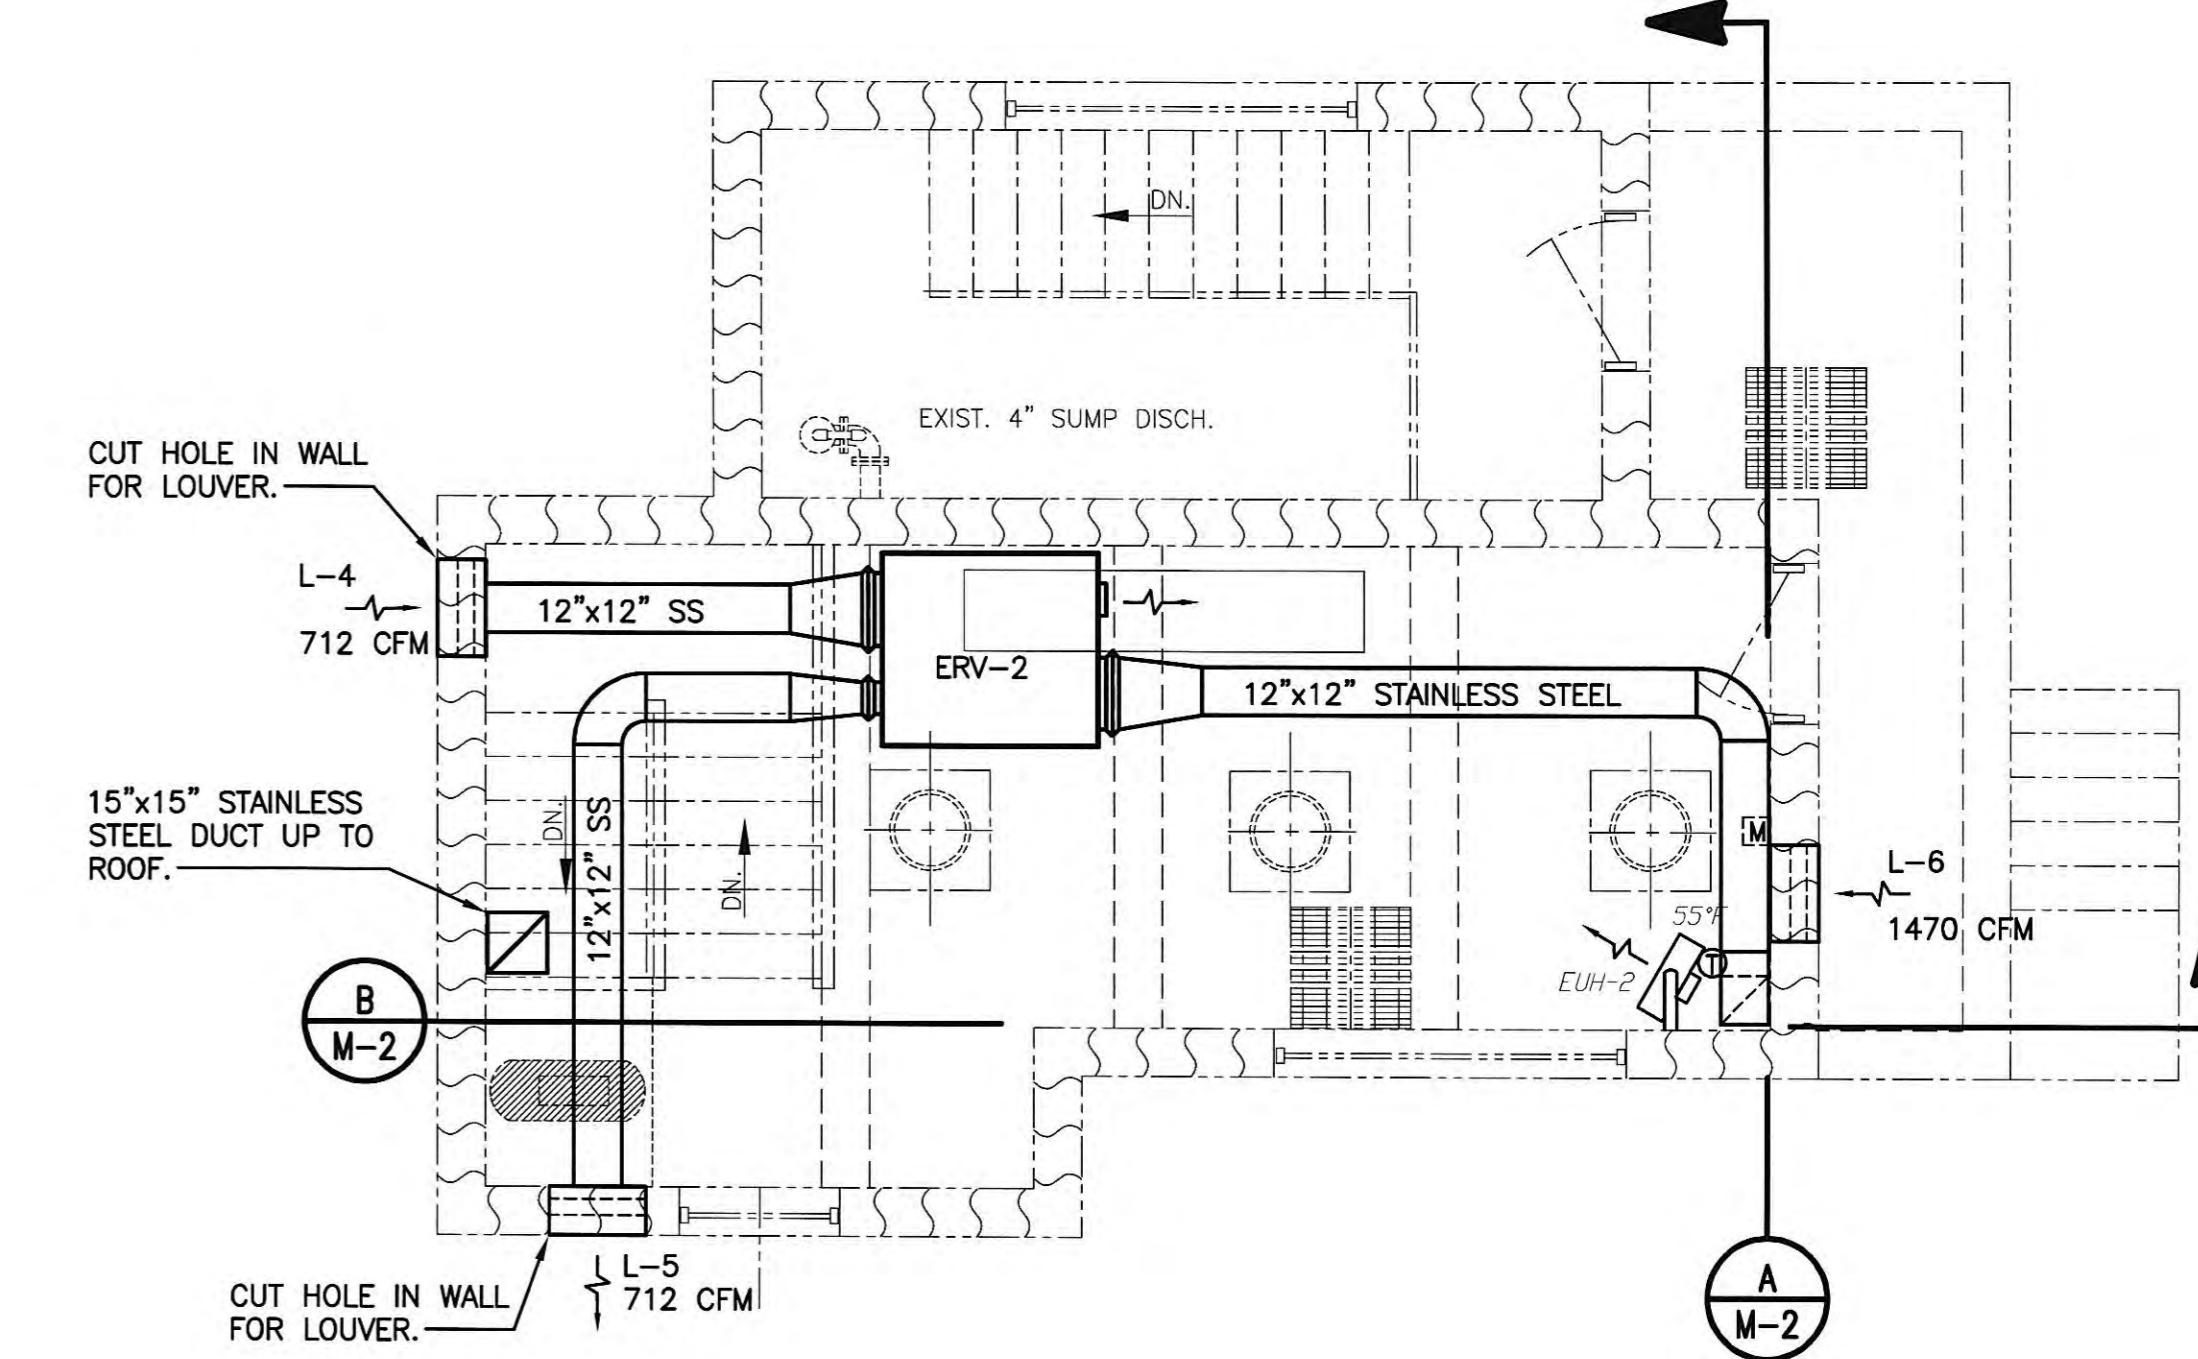


HVAC NEW WORK PLAN – ENTRANCE LEVEL

SCALE: 1/4" = 1'-0"

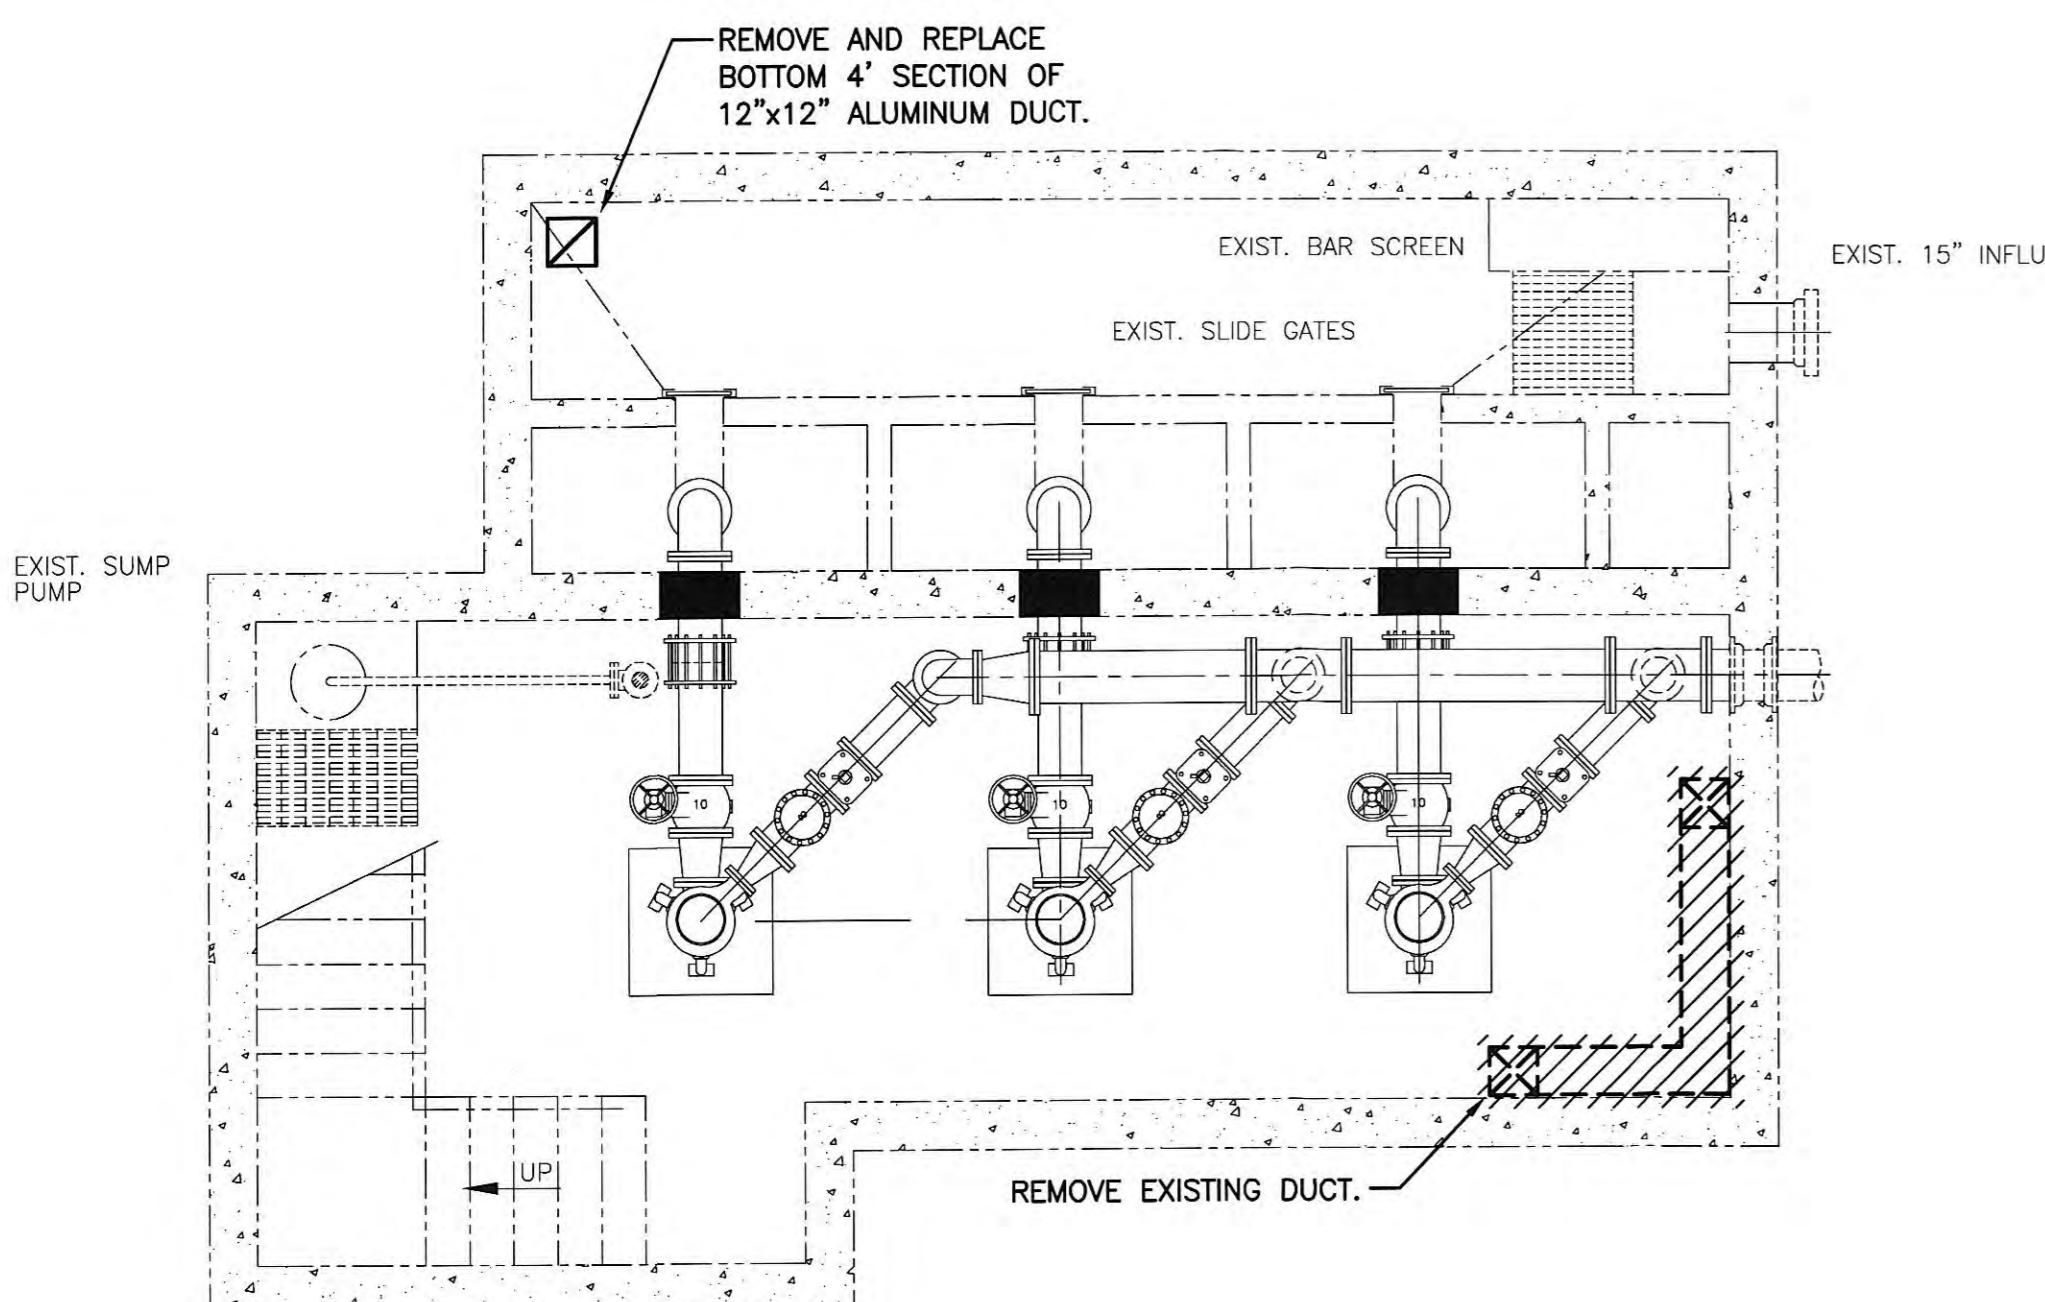


HVAC DEMOLITION PLAN – PUMP LEVEL

SCALE: 1/4" = 1'-0"

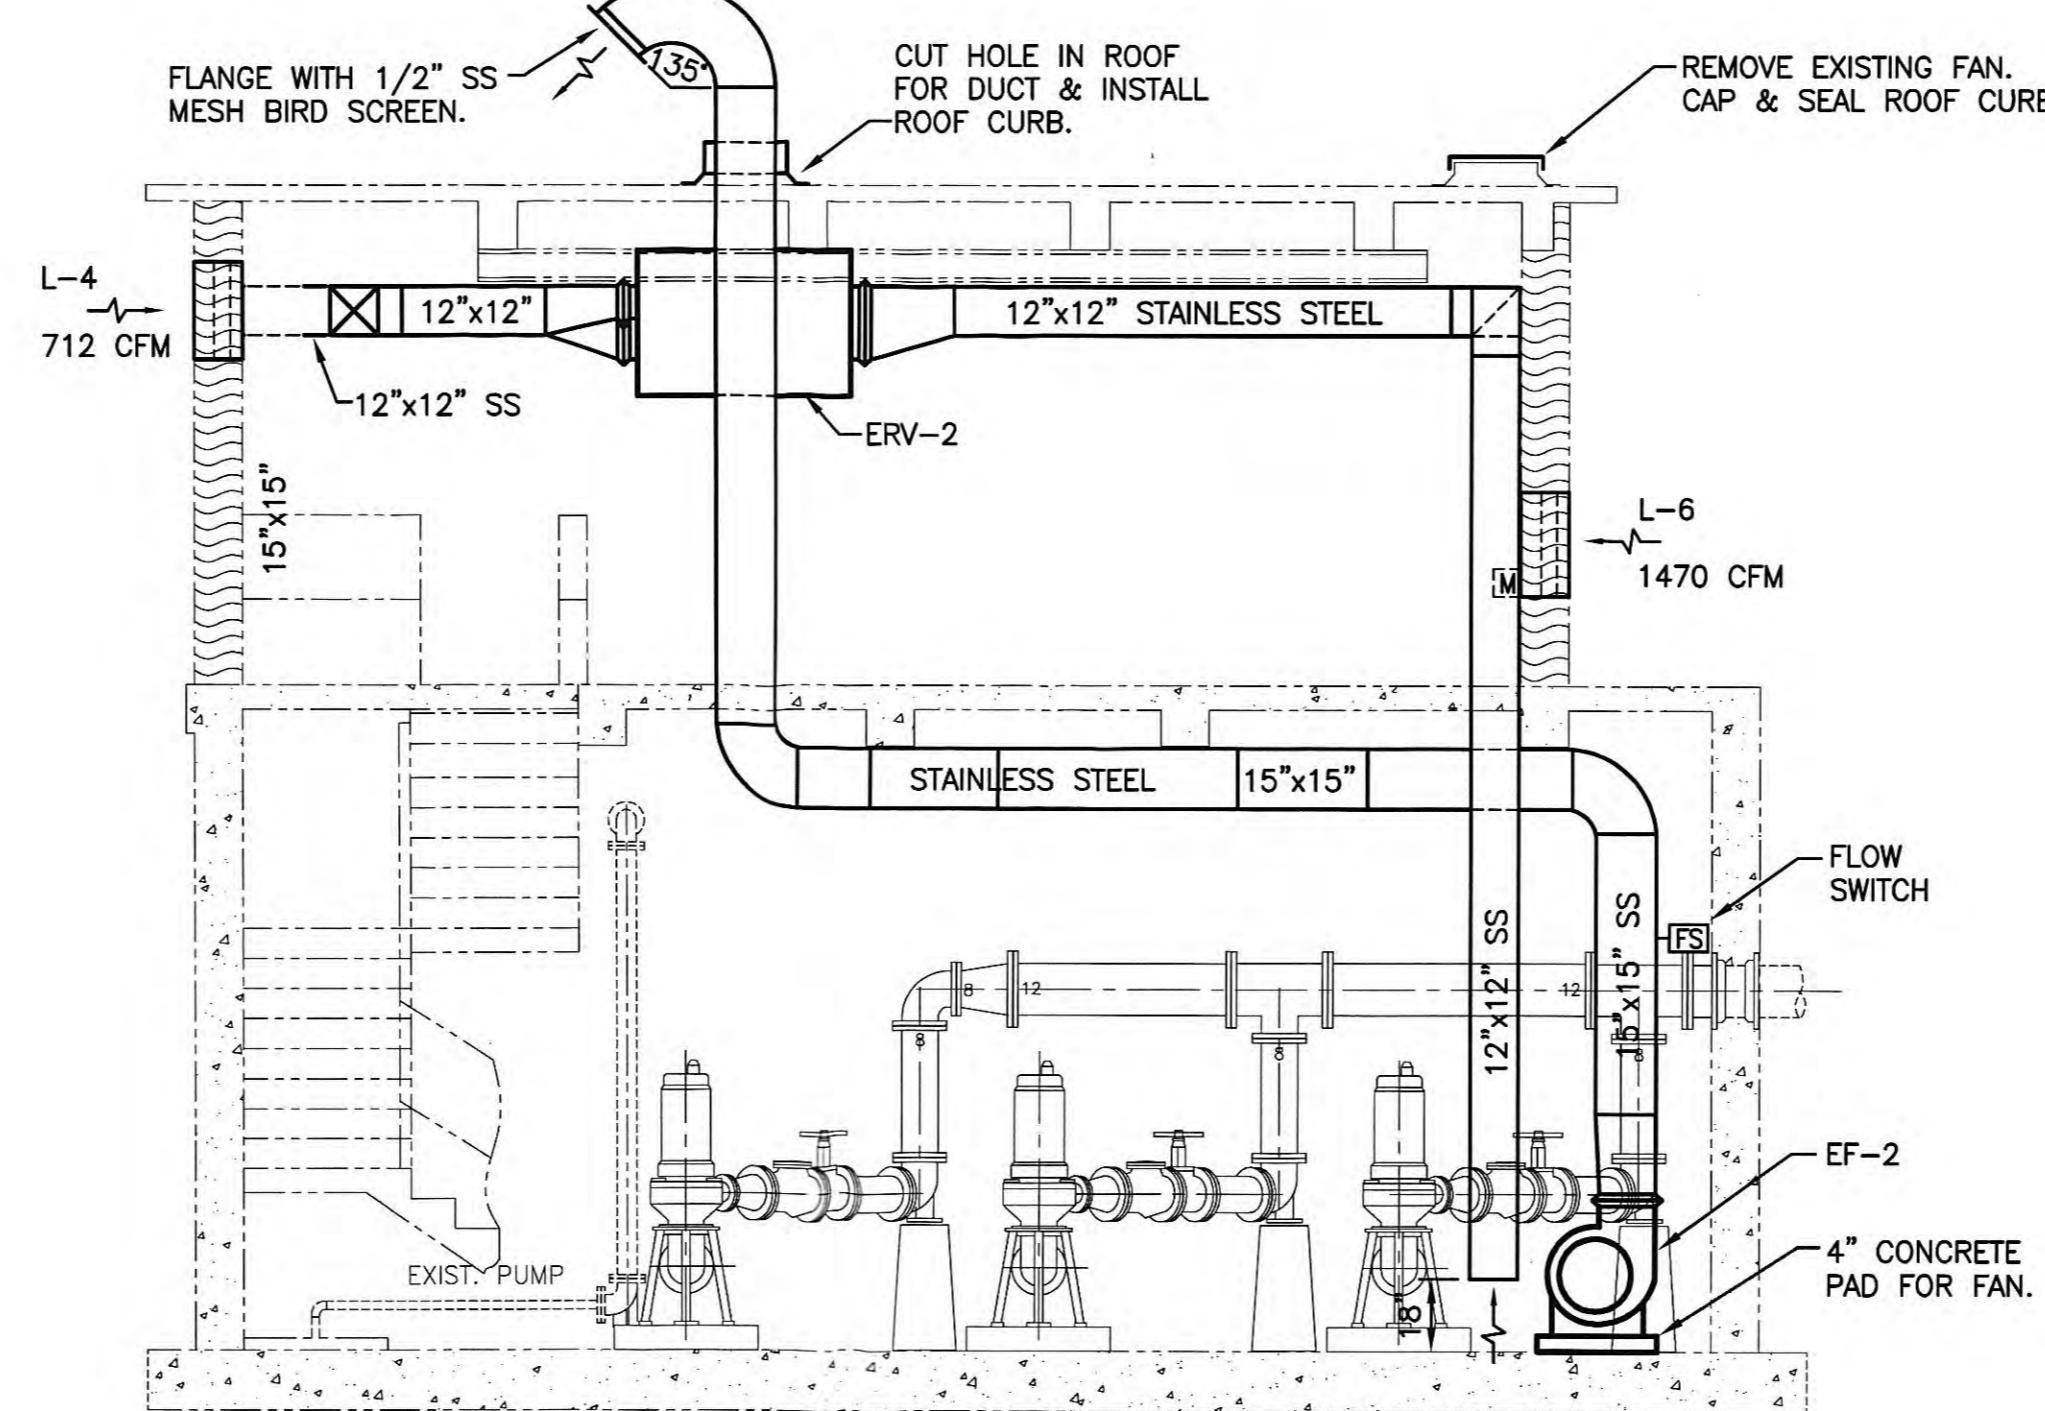

SECTION B-B

SCALE: 1/4" = 1'-0"

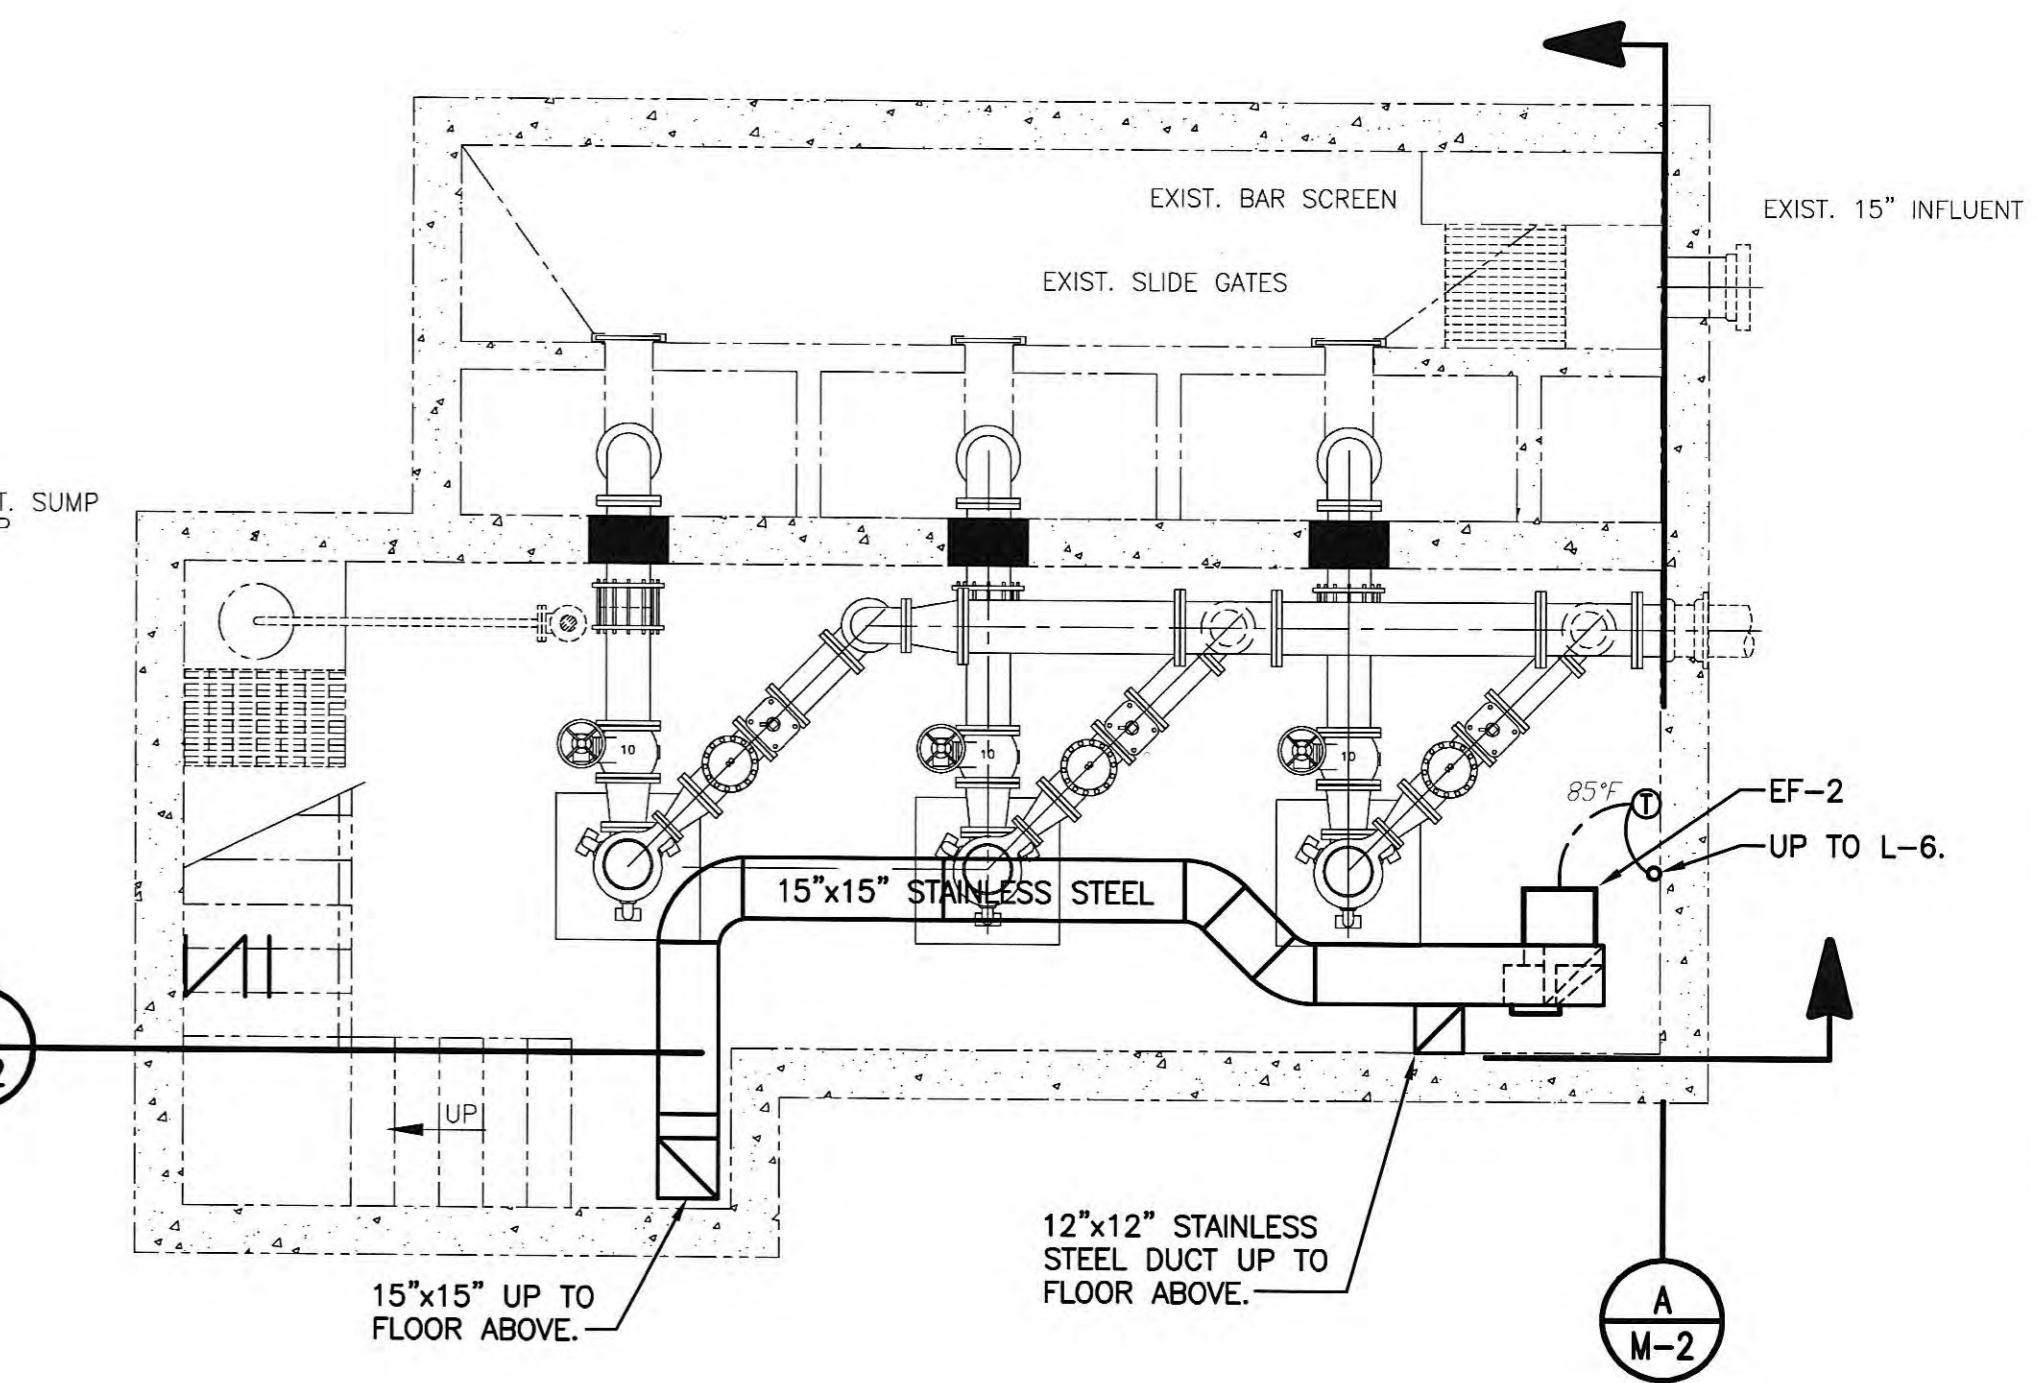

HVAC NEW WORK PLAN – PUMP LEVEL

SCALE: 1/4" = 1'-0"


RECORD DRAWINGS

ALL RIGHTS RESERVED.
THIS DOCUMENT IS THE PROPERTY OF GRW ELROD DUNSON, INC. AND SHALL NOT BE REPRODUCED IN WHOLE OR IN PART OR USED FOR CONSTRUCTION OF OTHER THAN THIS SPECIFIC PROJECT WITHOUT WRITTEN PERMISSION OF GRW ELROD DUNSON, INC.
THESE RECORD DRAWINGS REPRESENT THE "AS-BUILT" PROJECT TO THE BEST OF THE ENGINEER'S KNOWLEDGE, ALTHOUGH PREPARED FROM THE CONSTRUCTION RECORD, THEY CANNOT BE GUARANTEED TO BE EXACT IN EVERY DETAIL.
CHECKED BY:
[Signature]
ENGINEER'S REPRESENTATIVE
DATE: *16/2007*

NO.	DESCRIPTION	DATE	BY


This document, originally issued, sealed, and signed by Robert G. Fly, Kentucky Professional Engineer, No. 00102520, on June 4, 2004, shall not be used in lieu of a certified document.
REVIEWED:
RGE
APPROVED:
RGE

GRW	DESIGNED: JK	DATE: JUNE, 2004
ELROD DUNSON, INC.	DRAWN: EGR	SCALE: AS NOTED
Engineers, Architects, Planners	REVIEWED: RGE	SHEET NO.: M-2
LEXINGTON LOUISVILLE INDIANAPOLIS NASHVILLE KNOXVILLE	APPROVED: RGE	

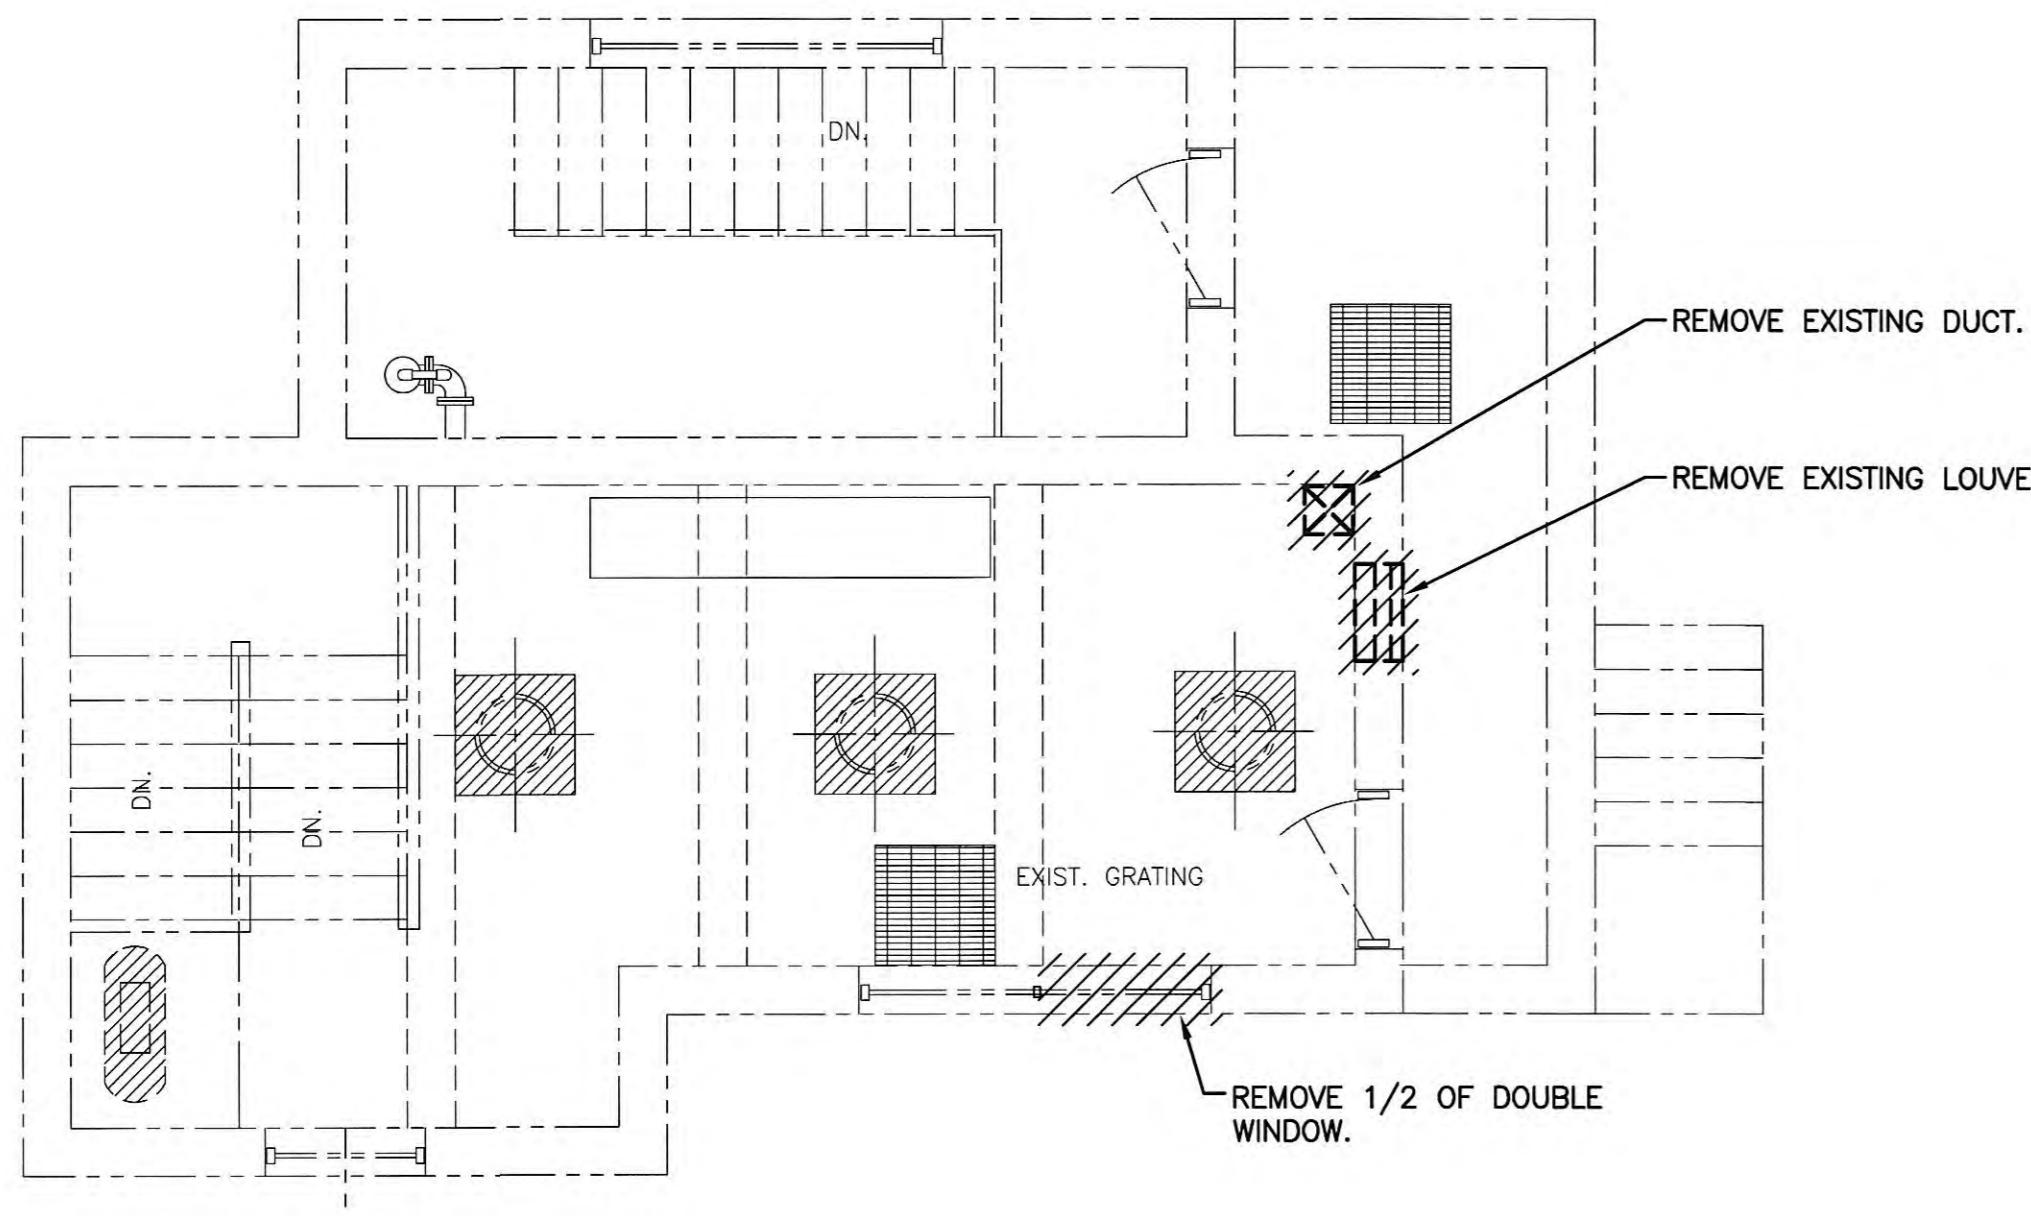


HVAC DEMOLITION PLAN – ENTRANCE LEVEL

SCALE: 1/4" = 1'-0"

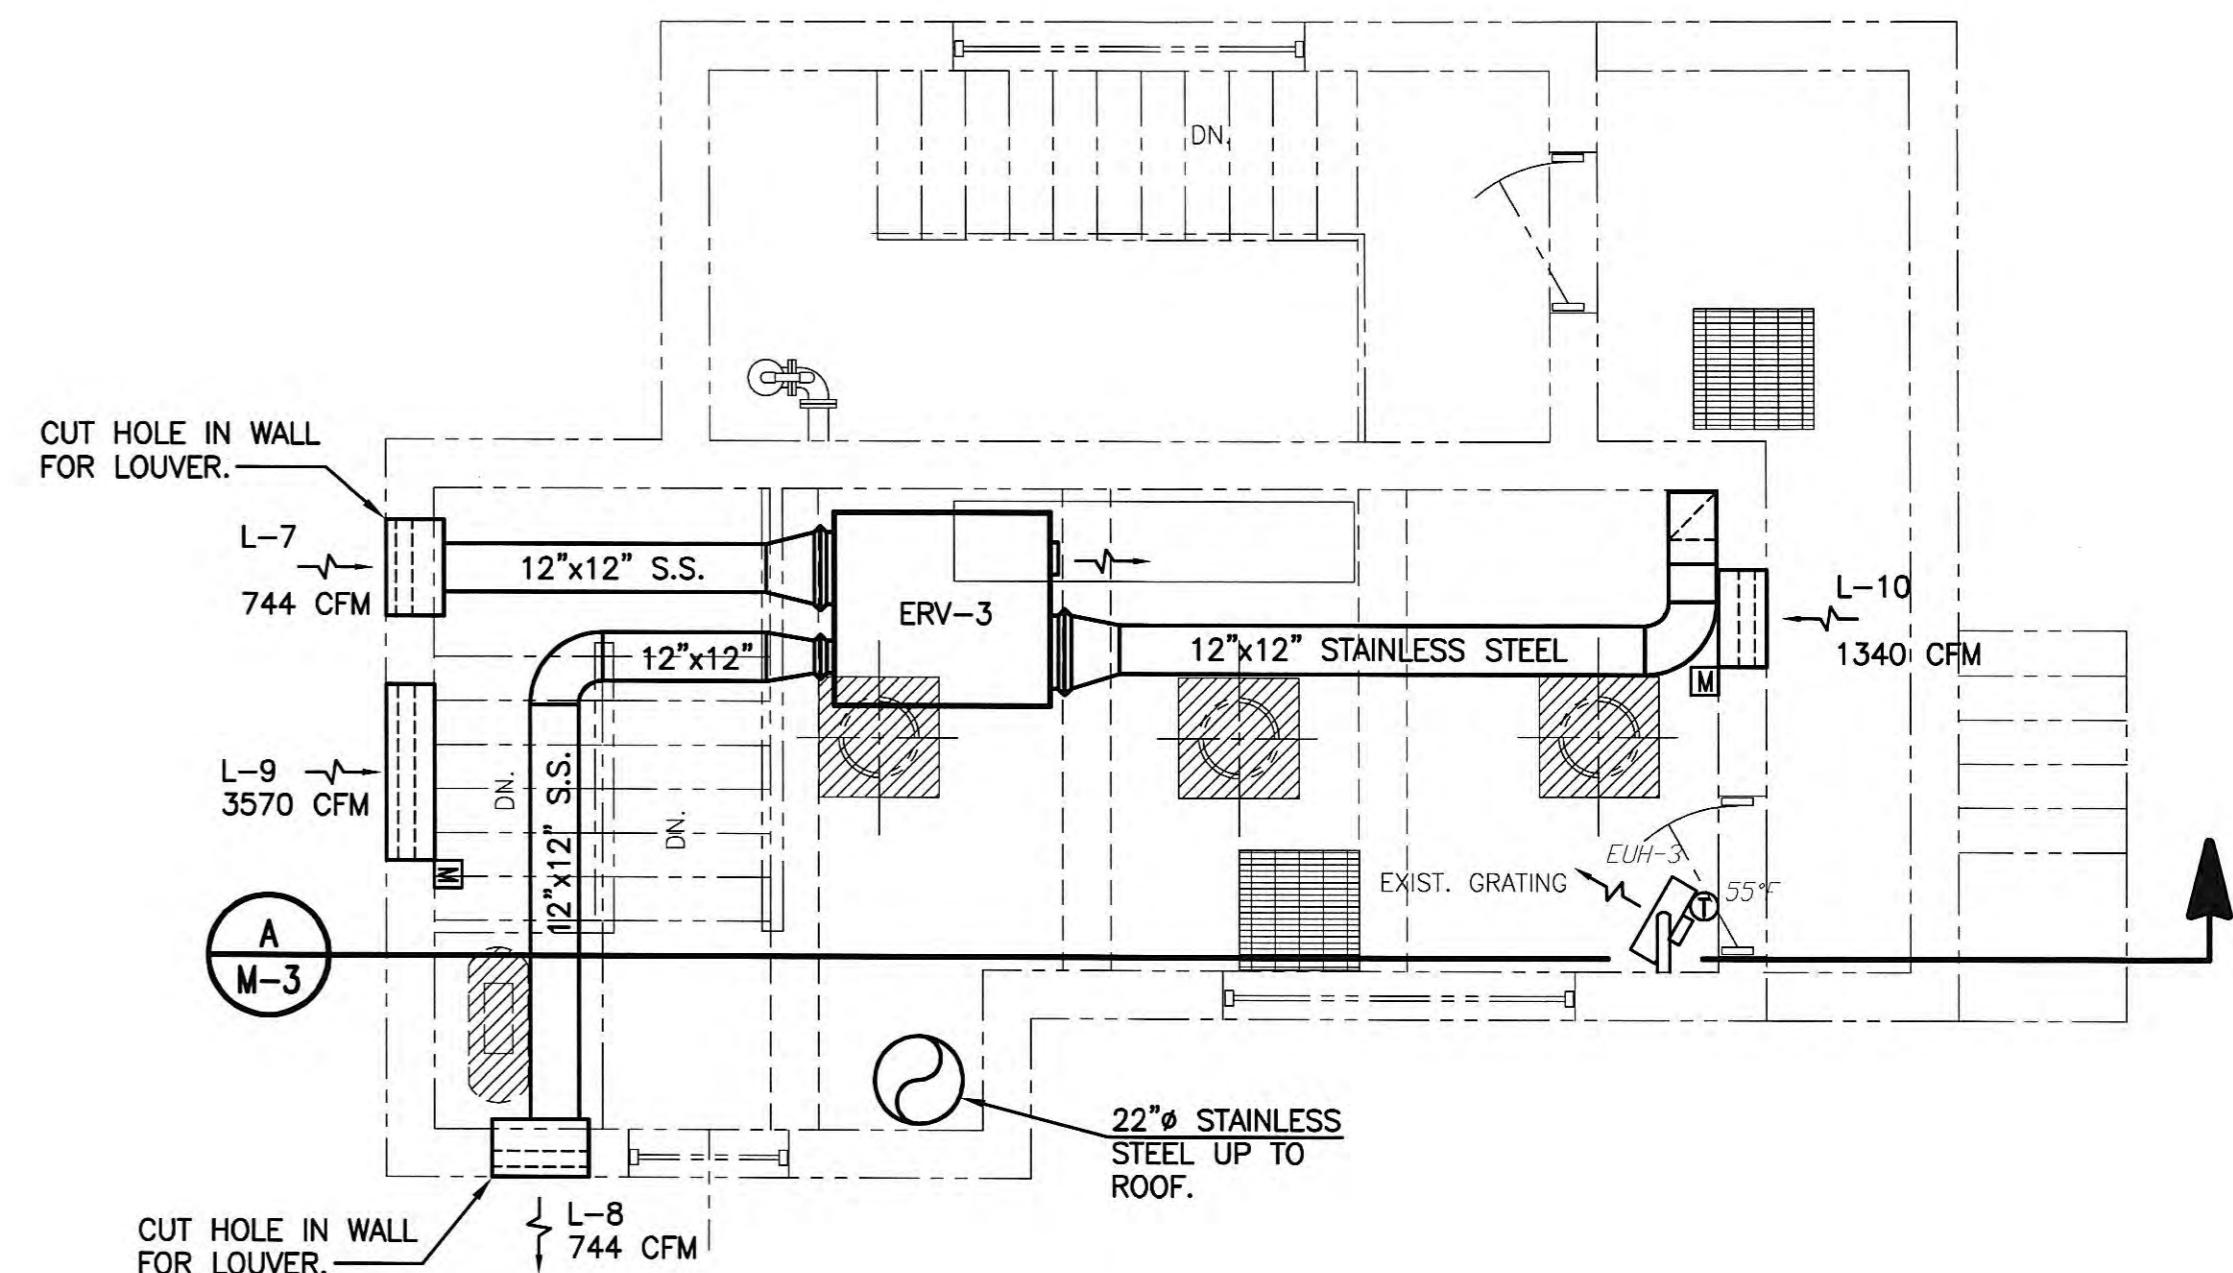



HVAC NEW WORK PLAN – ENTRANCE LEVEL

SCALE: 1/4" = 1'-0"

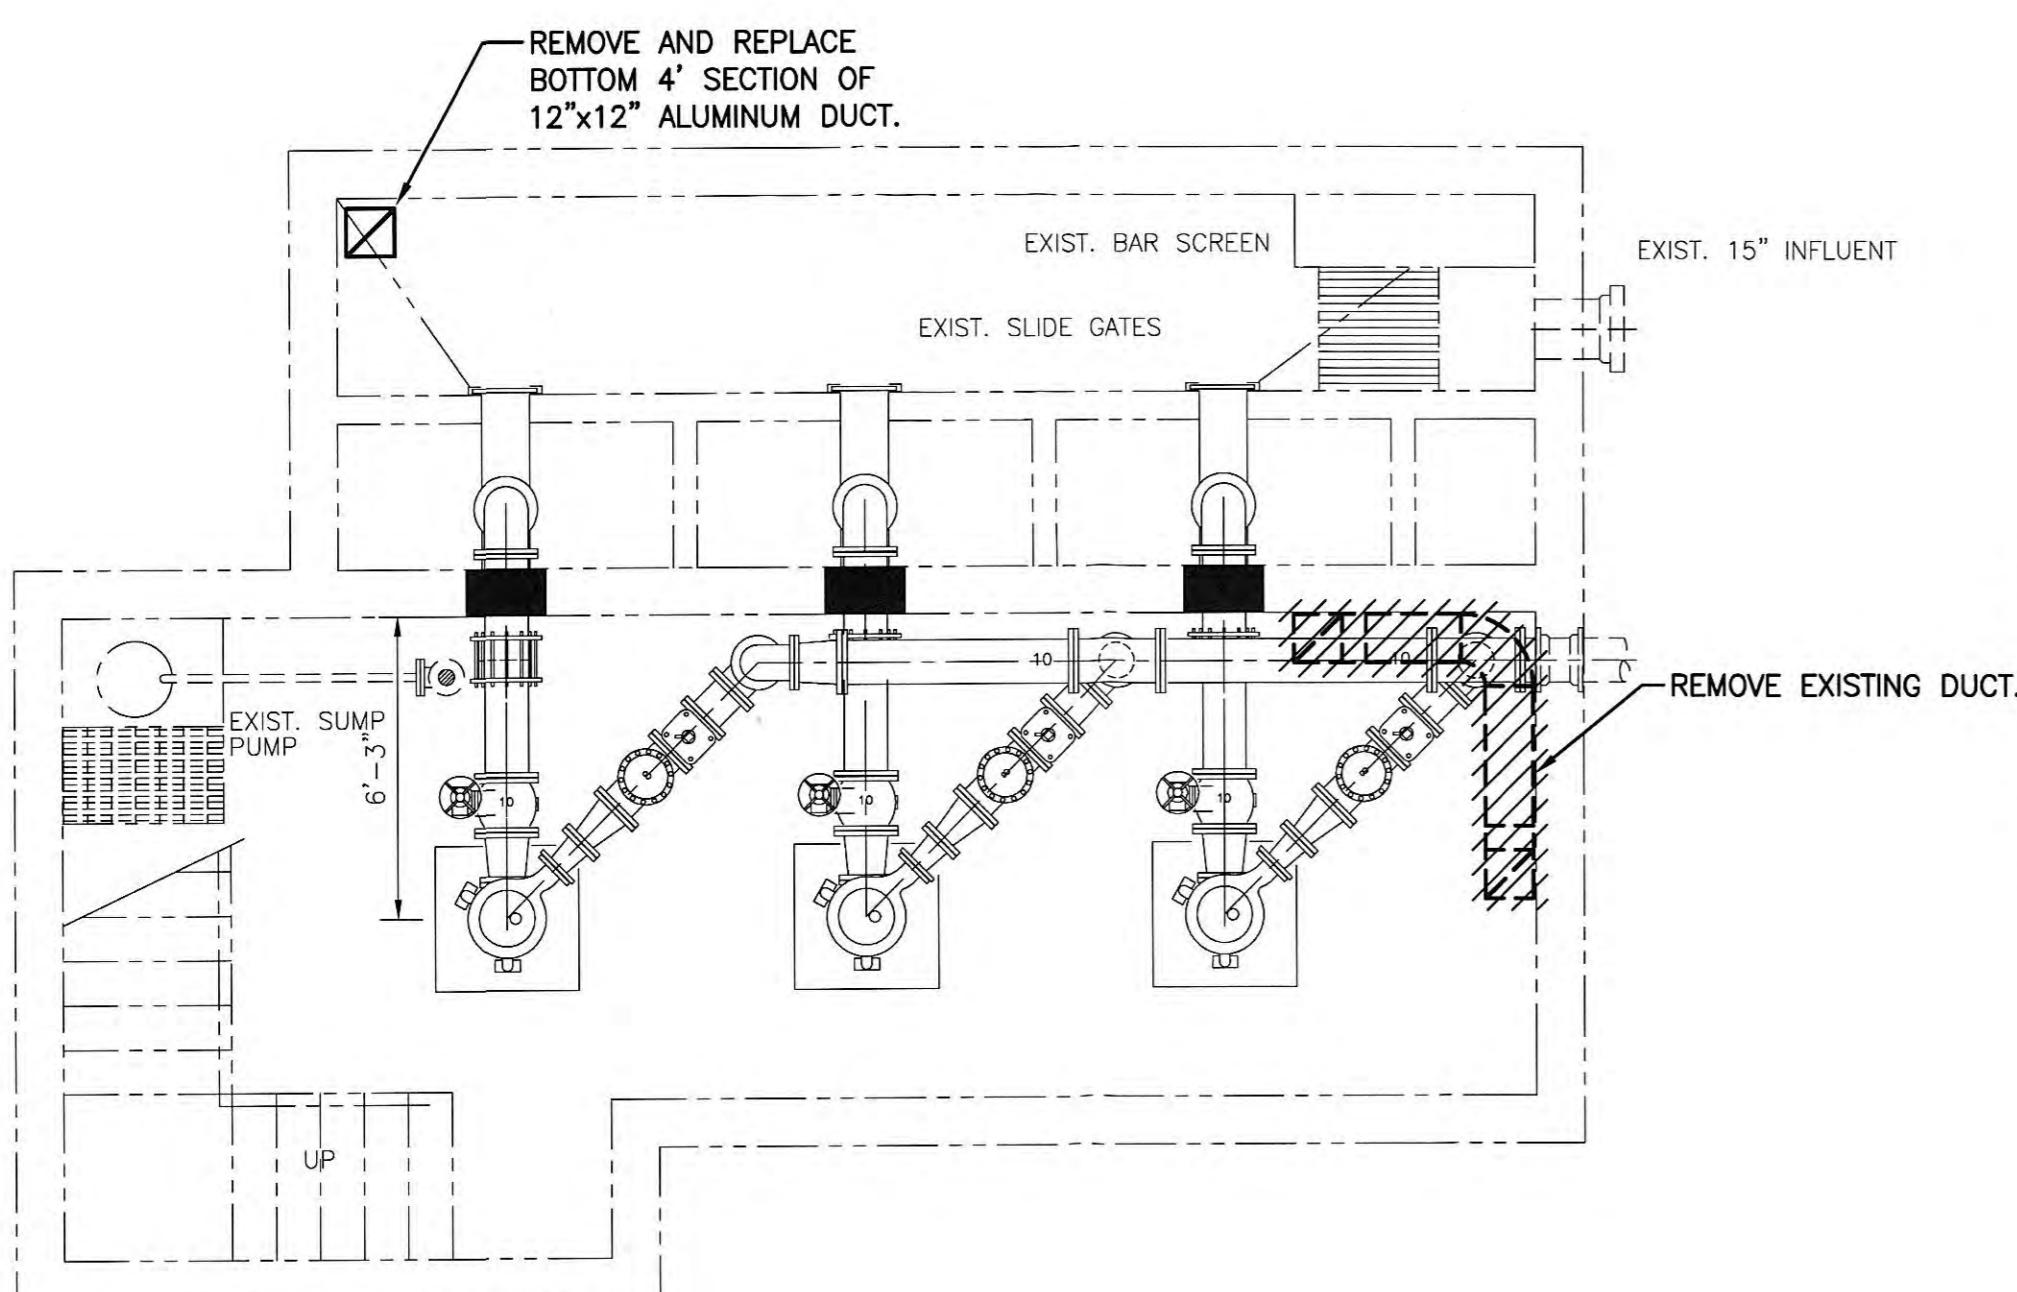

HVAC DEMOLITION PLAN – PUMP LEVEL

SCALE: 1/4" = 1'-0"

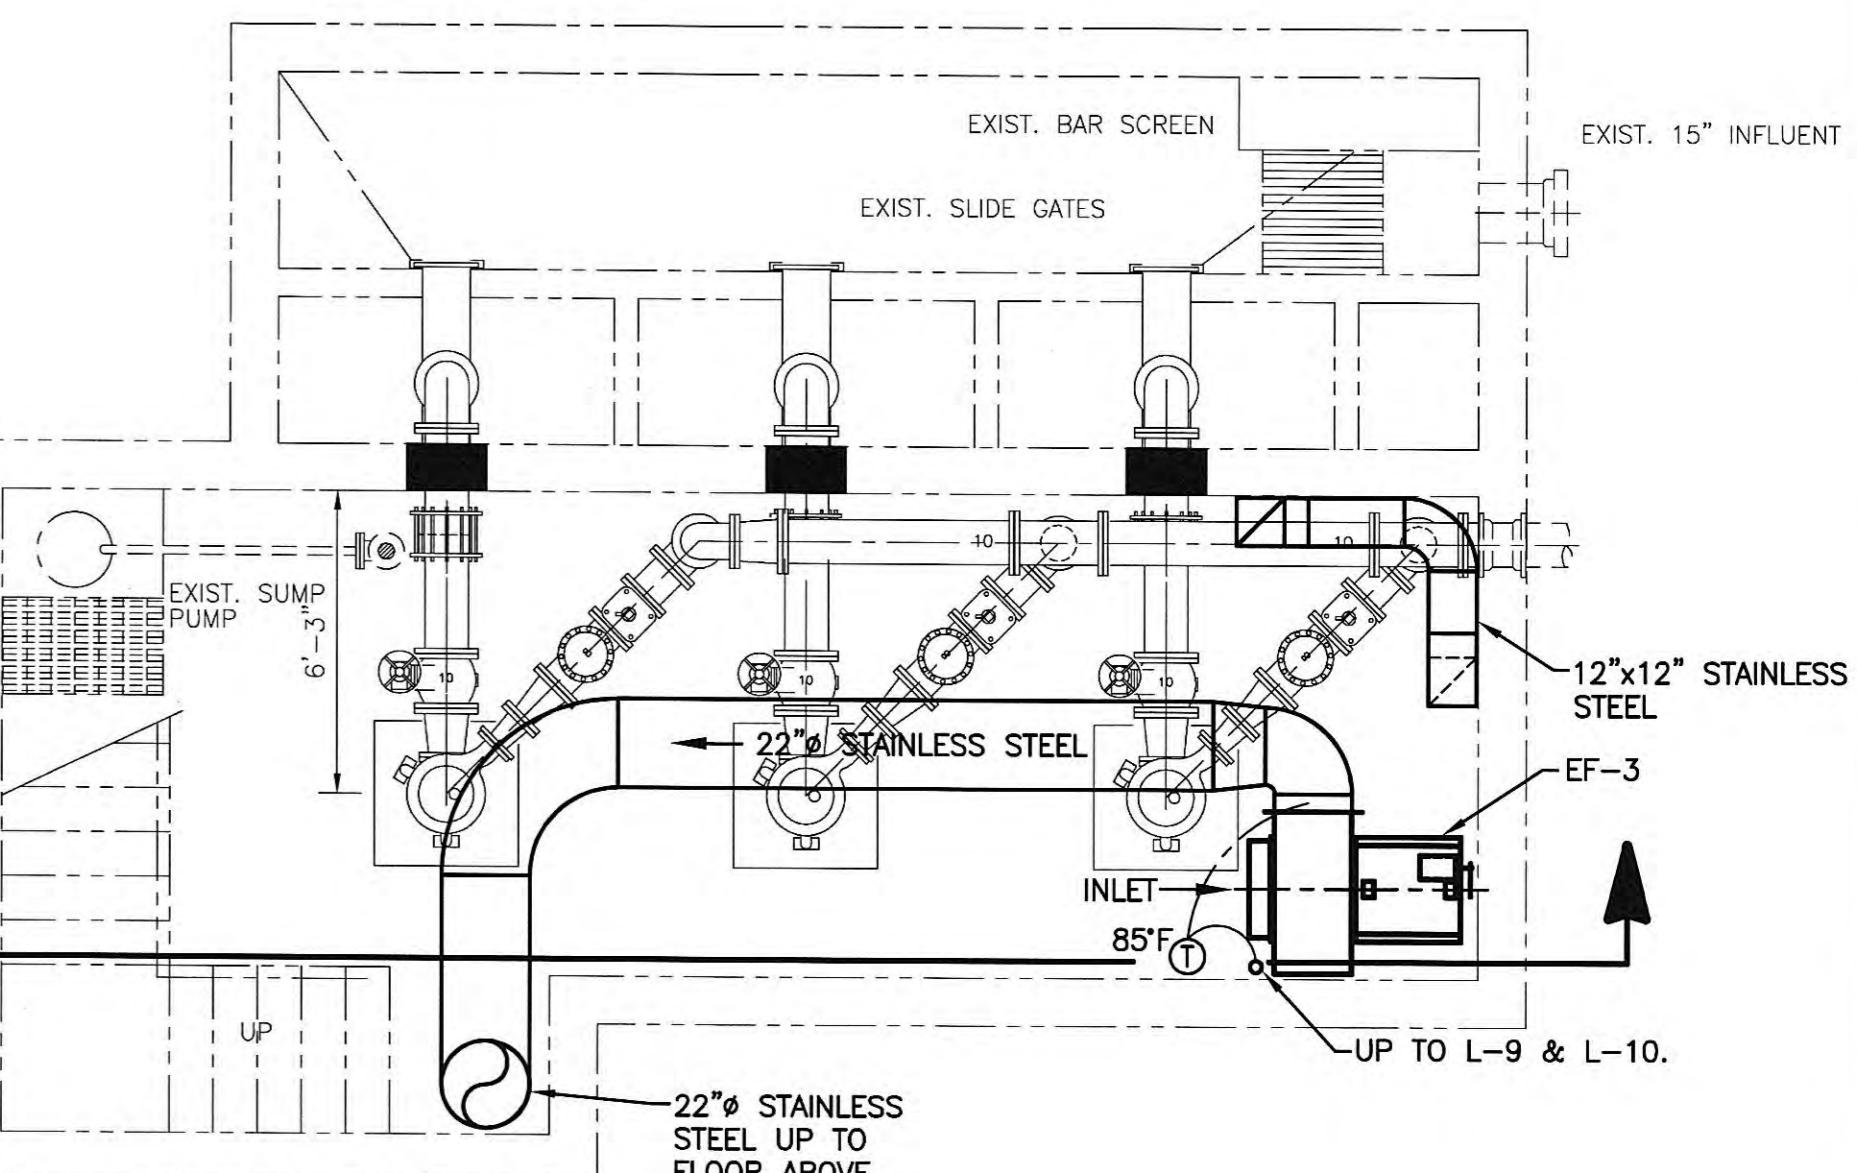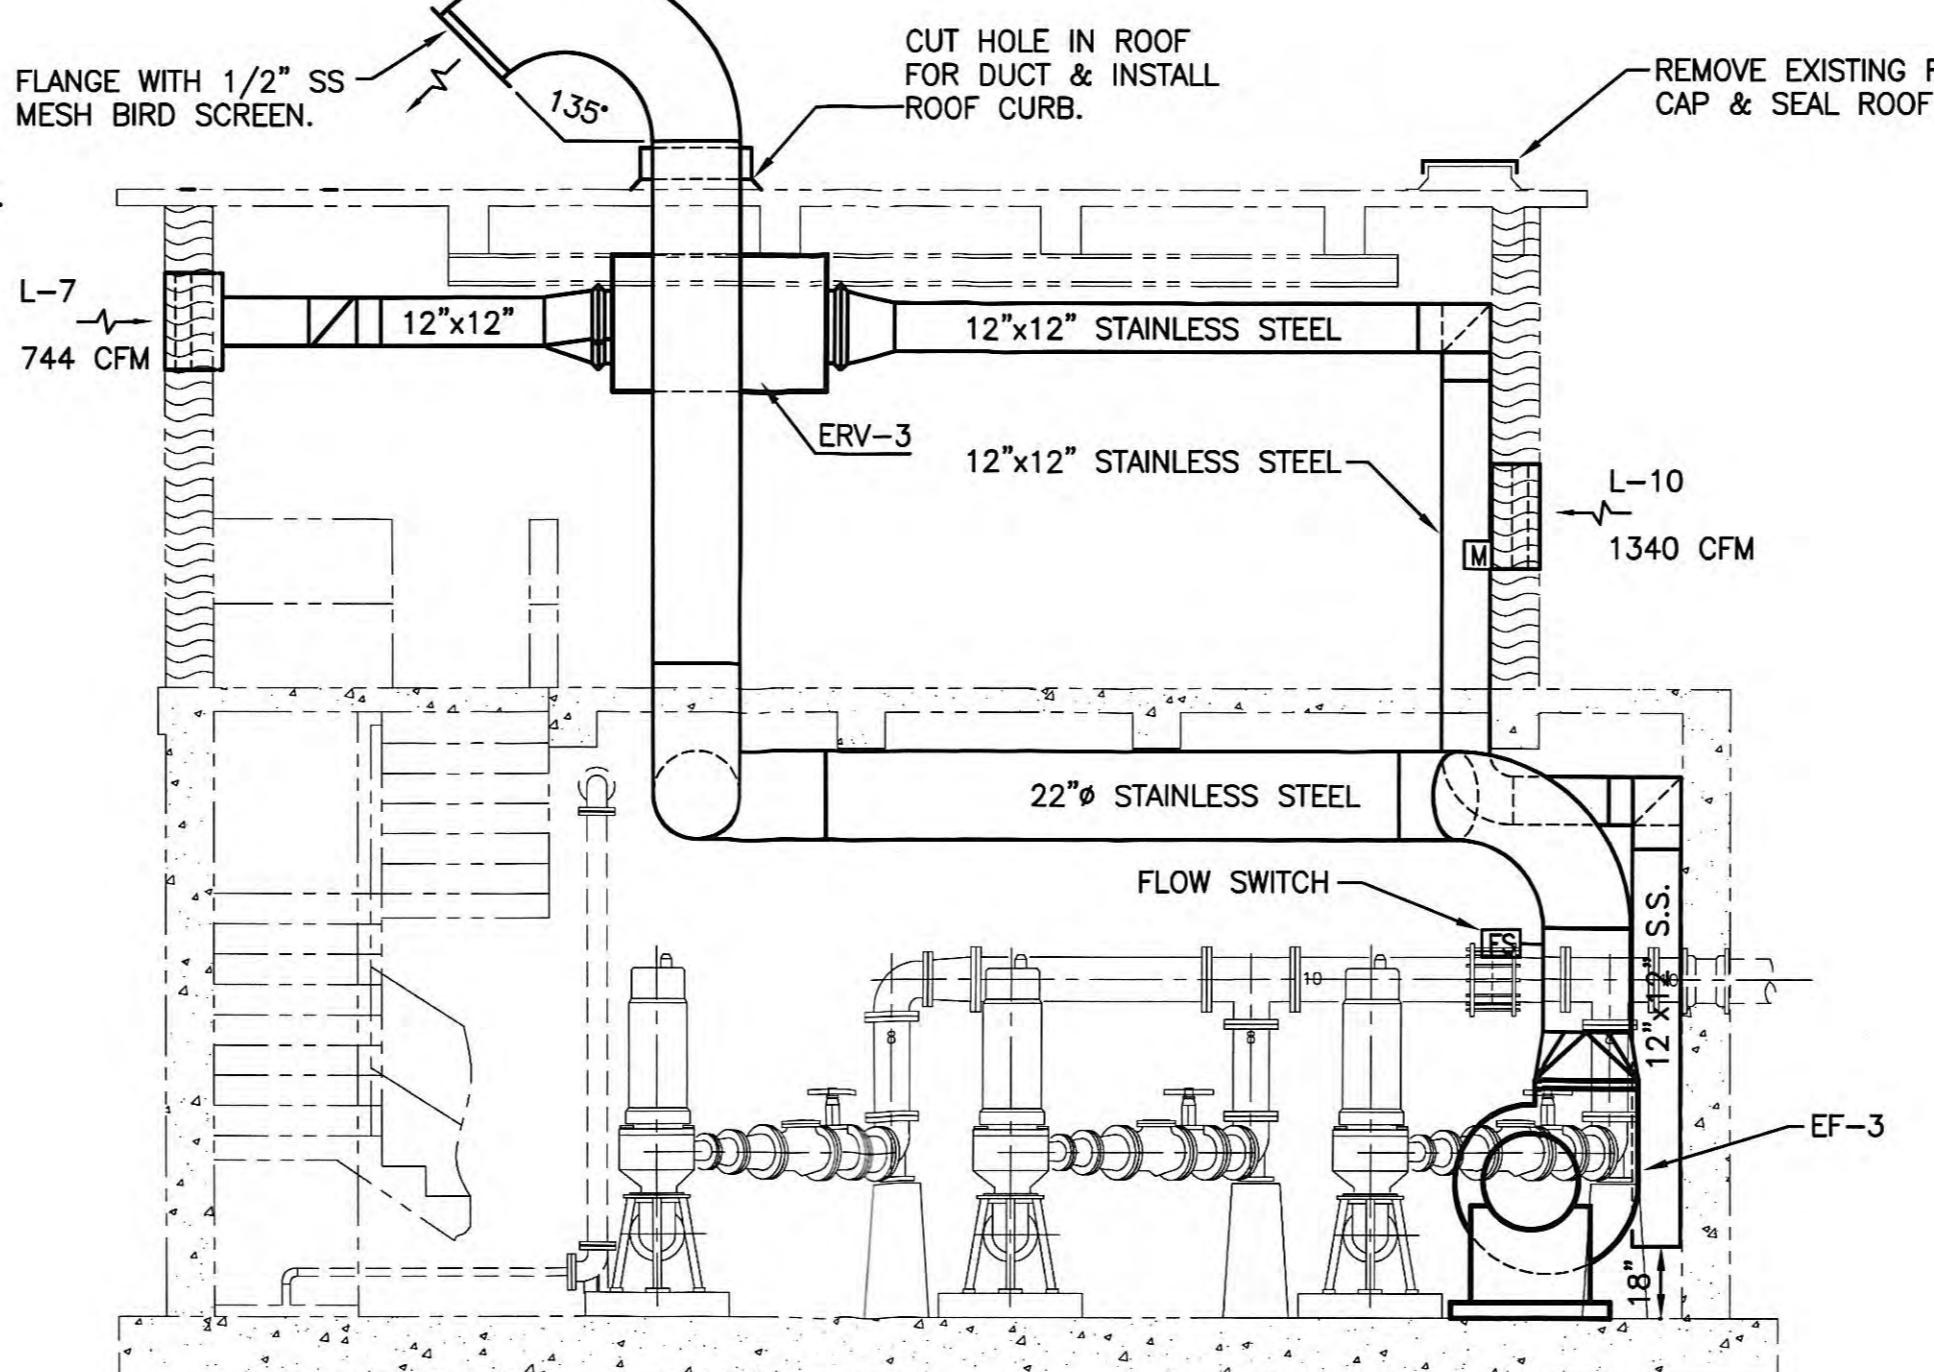

HVAC NEW WORK PLAN – PUMP LEVEL


SCALE: 1/4" = 1'-0"

RECORD DRAWINGS	
THESE RECORD DRAWINGS REPRESENT THE "AS-BUILT" PROJECT TO THE BEST OF THE ENGINEER'S KNOWLEDGE. ALTHOUGH PREPARED FROM THE CONSTRUCTION RECORD, THEY CANNOT BE GUARANTEED TO BE EXACT IN EVERY DETAIL.	
CHECKED BY: <i>S. Ely</i> ENGINEER'S REPRESENTATIVE	
DATE: <i>6/2007</i>	

SECTION
SCALE: 1/4" = 1'-0"

ALL RIGHTS RESERVED: THIS DOCUMENT IS THE PROPERTY OF GRW ELROD DUNSON, INC. AND SHALL NOT BE REPRODUCED IN WHOLE OR IN PART OR USED FOR CONSTRUCTION OF OTHER THAN THIS SPECIFIC PROJECT WITHOUT WRITTEN PERMISSION OF GRW ELROD DUNSON, INC.					
NO.	DESCRIPTION	DATE	BY	REVISIONS	

GRW PROJECT NO. 7601-30 CONTRACT NO. S02-03					
EXISTING WOODY ST. SEWAGE PUMP STATION HVAC PLAN AND SECTIONS HARRIMAN UTILITY BOARD HARRIMAN, TENNESSEE					
DESIGNED:	RGE	DATE:	JUNE, 2004		
DRAWN:	EGR	SCALE:	AS NOTED		
REVIEWED:	RGE	SHEET NO.			
APPROVED:	RGE	M-3			

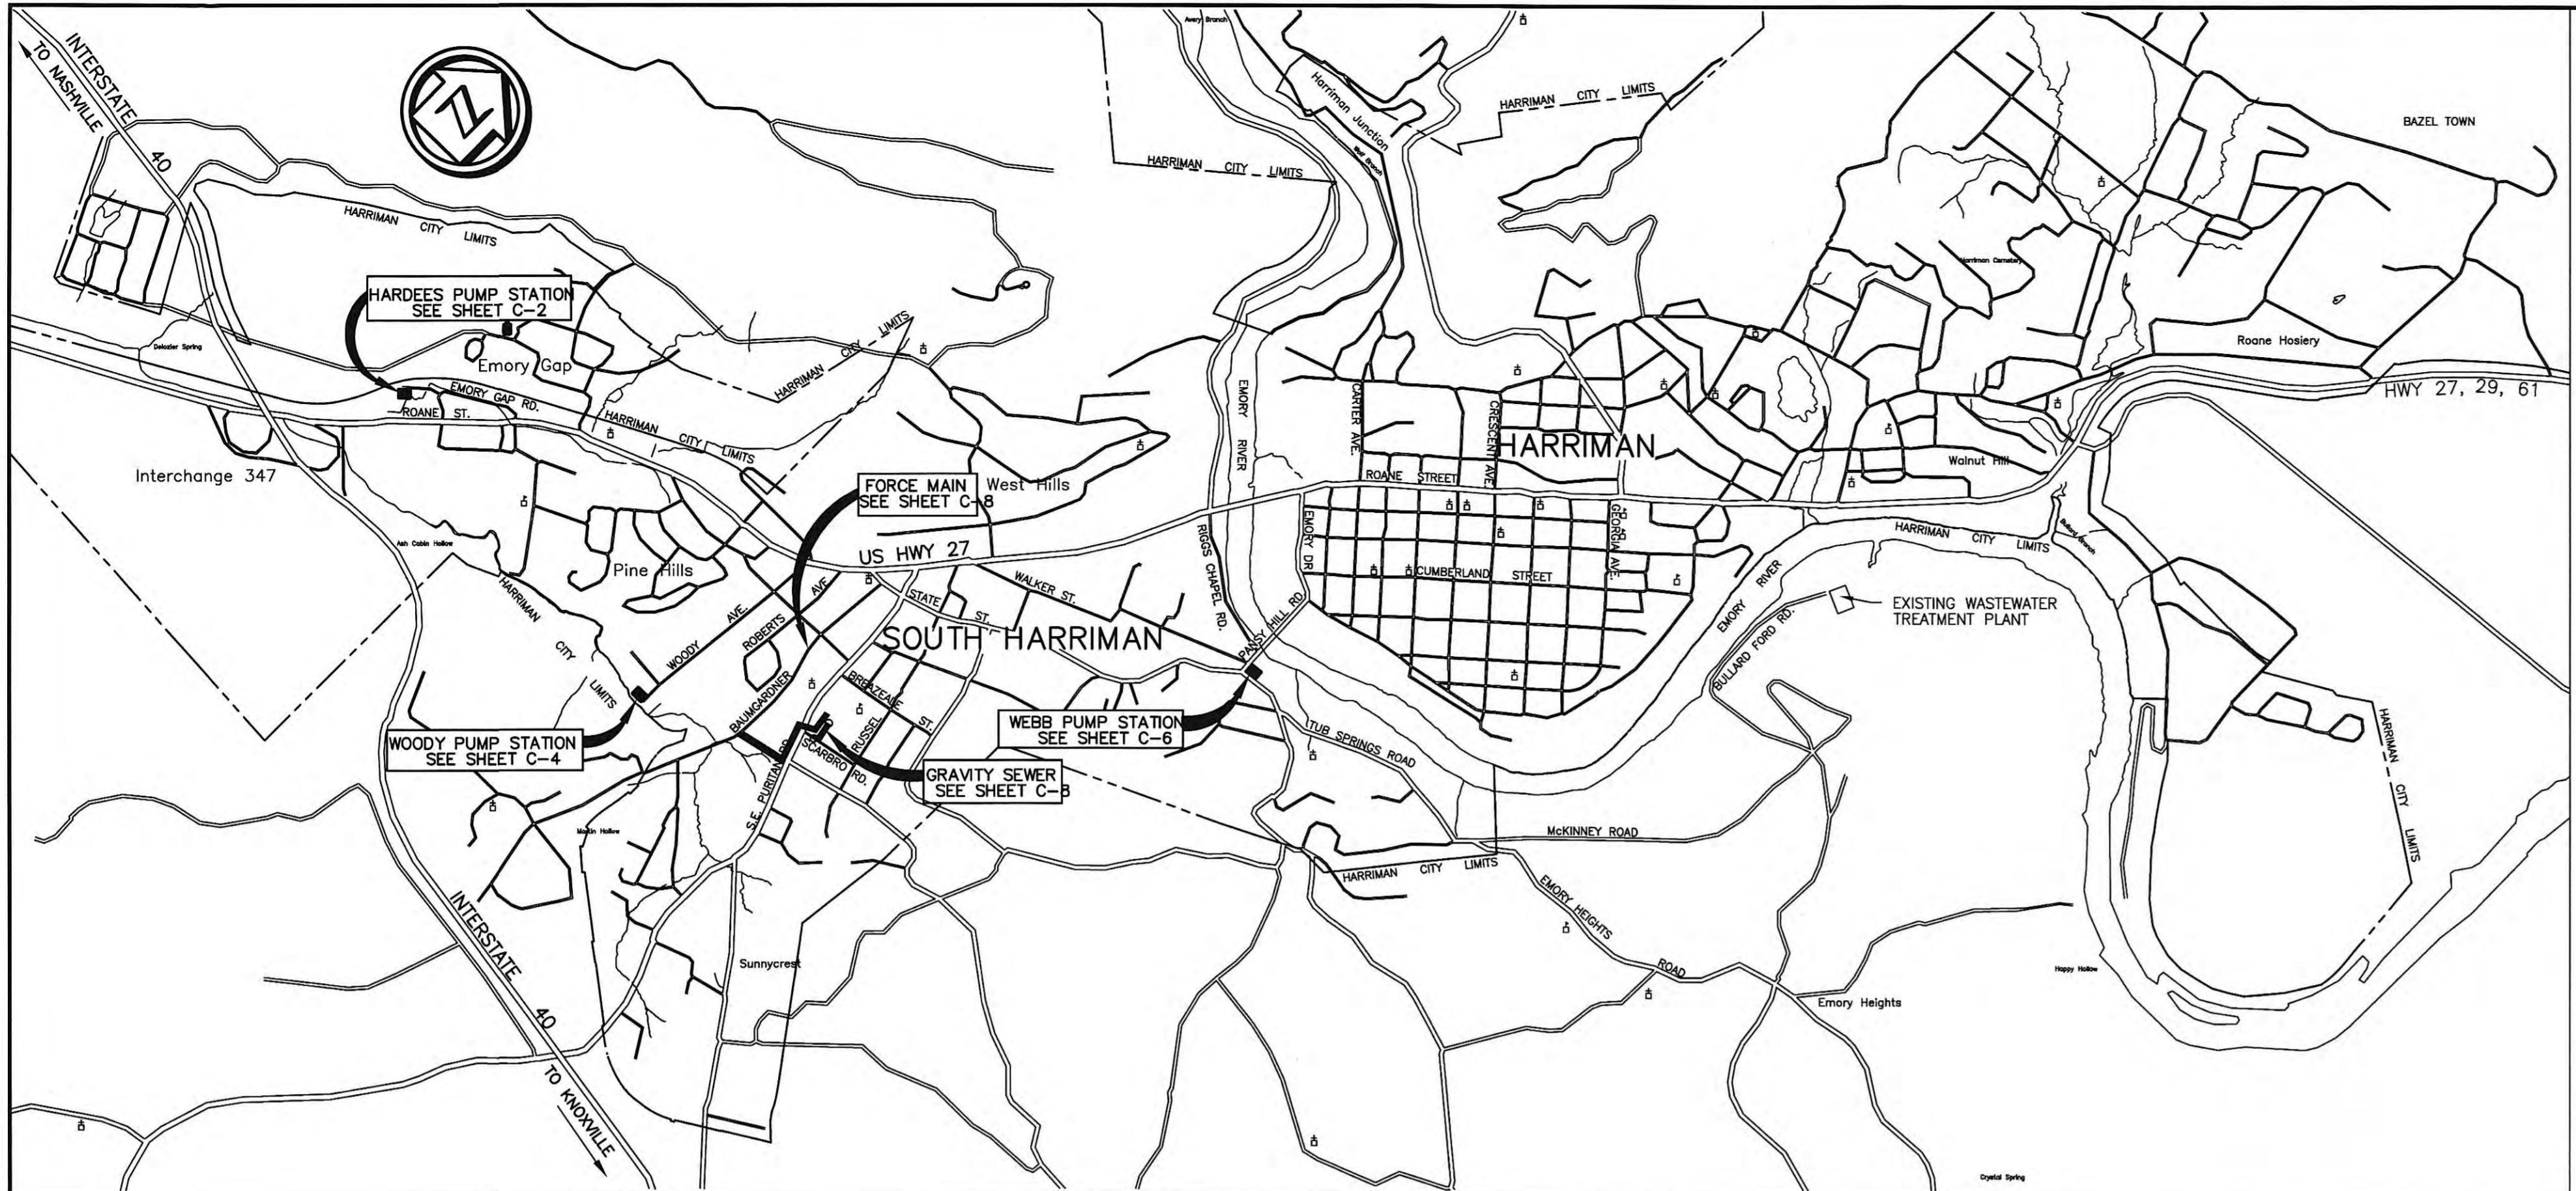

LOCATION MAP

SCALE: 1" = 1500'

INDEX OF SHEETS

- C-1 LOCATION MAP, VICINITY MAP AND INDEX OF SHEETS
- C-2 EXISTING HARDEES SEWAGE PUMP STATION-PLAN VIEWS
- C-3 EXISTING HARDEES SEWAGE PUMP STATION-SECTIONS
- C-4 EXISTING WOODY ST. SEWAGE PUMP STATION-PLAN VIEWS
- C-5 EXISTING WOODY ST. SEWAGE PUMP STATION-SECTIONS
- C-6 EXISTING WEBB SEWAGE PUMP STATION-PLAN VIEWS
- C-7 EXISTING WEBB SEWAGE PUMP STATION-SECTIONS
- C-8 CARDIFF SEWAGE PUMP STATION - SITE GRADING & PIPING PLAN
- C-9 CARDIFF SEWAGE PUMP STATION - PLAN & SECTIONS
- C-10 WOODY STREET FORCE MAIN - STA. 0+00 TO STA. 14+90 E.O.L.
- C-11 SCARBRO ROAD GRAVITY SEWER - STA. 0+00 TO STA. 2+28.5
- C-12 STANDARD CONSTRUCTION DETAILS

- A-1 ARCHITECTURAL- EXISTING HARDEES SEWAGE PUMP STATION
- A-2 ARCHITECTURAL- EXISTING WOODY ST. SEWAGE PUMP STATION
- A-3 ARCHITECTURAL-EXISTING WEBB SEWAGE PUMP STATION
- A-4 ARCHITECTURAL-EXISTING HARDEES SEWAGE PUMP STATION

- E-1 ELECTRICAL SYMBOLS
- E-2 CONTROL CIRCUIT - HARDEES PUMP STATION
- E-3 HARDEES PUMP STATION ELECTRICAL PLAN & DETAILS
- E-4 CONTROL CIRCUIT - WEBB PUMP STATION
- E-5 WEBB PUMP STATION ELECTRICAL PLAN & DETAILS
- E-6 CONTROL CIRCUIT - WOODY ST. PUMP STATION
- E-7 WOODY ST. PUMP STATION ELECTRICAL PLAN & DETAILS

- M-1 MECHANICAL-EXISTING HARDEES SEWAGE PUMP STATION
- M-2 MECHANICAL-EXISTING WEBB SEWAGE PUMP STATION
- M-3 MECHANICAL-EXISTING WOODY ST. SEWAGE PUMP STATION
- M-4 MECHANICAL LEGEND



VICINITY MAP

NOT TO SCALE

RECORD DRAWINGS


THESE RECORD DRAWINGS REPRESENT THE "AS-BUILT" PROJECT TO THE BEST OF THE ENGINEER'S KNOWLEDGE. ALTHOUGH PREPARED FROM THE CONSTRUCTION RECORD, THEY CANNOT BE GUARANTEED TO BE EXACT IN EVERY DETAIL.

CHECKED BY:

S. Strohmeier
ENGINEER'S REPRESENTATIVE

10/2007
DATE

GRW PROJECT NO. 7601-30				CONTRACT NO. S02-03											
LOCATION PLAN, VICINITY MAP INDEX OF DRAWINGS SOUTH HARRIMAN PUMP STATIONS REHABILITATION HARRIMAN UTILITY BOARD - HARRIMAN, TENNESSEE															
<small>ALL RIGHTS RESERVED. THIS DOCUMENT IS THE PROPERTY OF GRW ELROD DUNSON, INC. AND SHALL NOT BE REPRODUCED IN WHOLE OR IN PART OR USED FOR CONSTRUCTION OF OTHER THAN THIS SPECIFIC PROJECT WITHOUT WRITTEN PERMISSION OF GRW ELROD DUNSON, INC.</small>															
<table border="1"> <tr> <td>NO.</td> <td>DESCRIPTION</td> <td>DATE</td> <td>BY</td> </tr> <tr> <td colspan="4">REVISIONS</td> </tr> </table>								NO.	DESCRIPTION	DATE	BY	REVISIONS			
NO.	DESCRIPTION	DATE	BY												
REVISIONS															
				<small>DESIGNED: DRAWN: DRAILED: REVIEWED: APPROVED: RGT AS NOTED RGO RGT</small>											
				<small>DATE: SCALE: SHEET NO. C-1</small>											

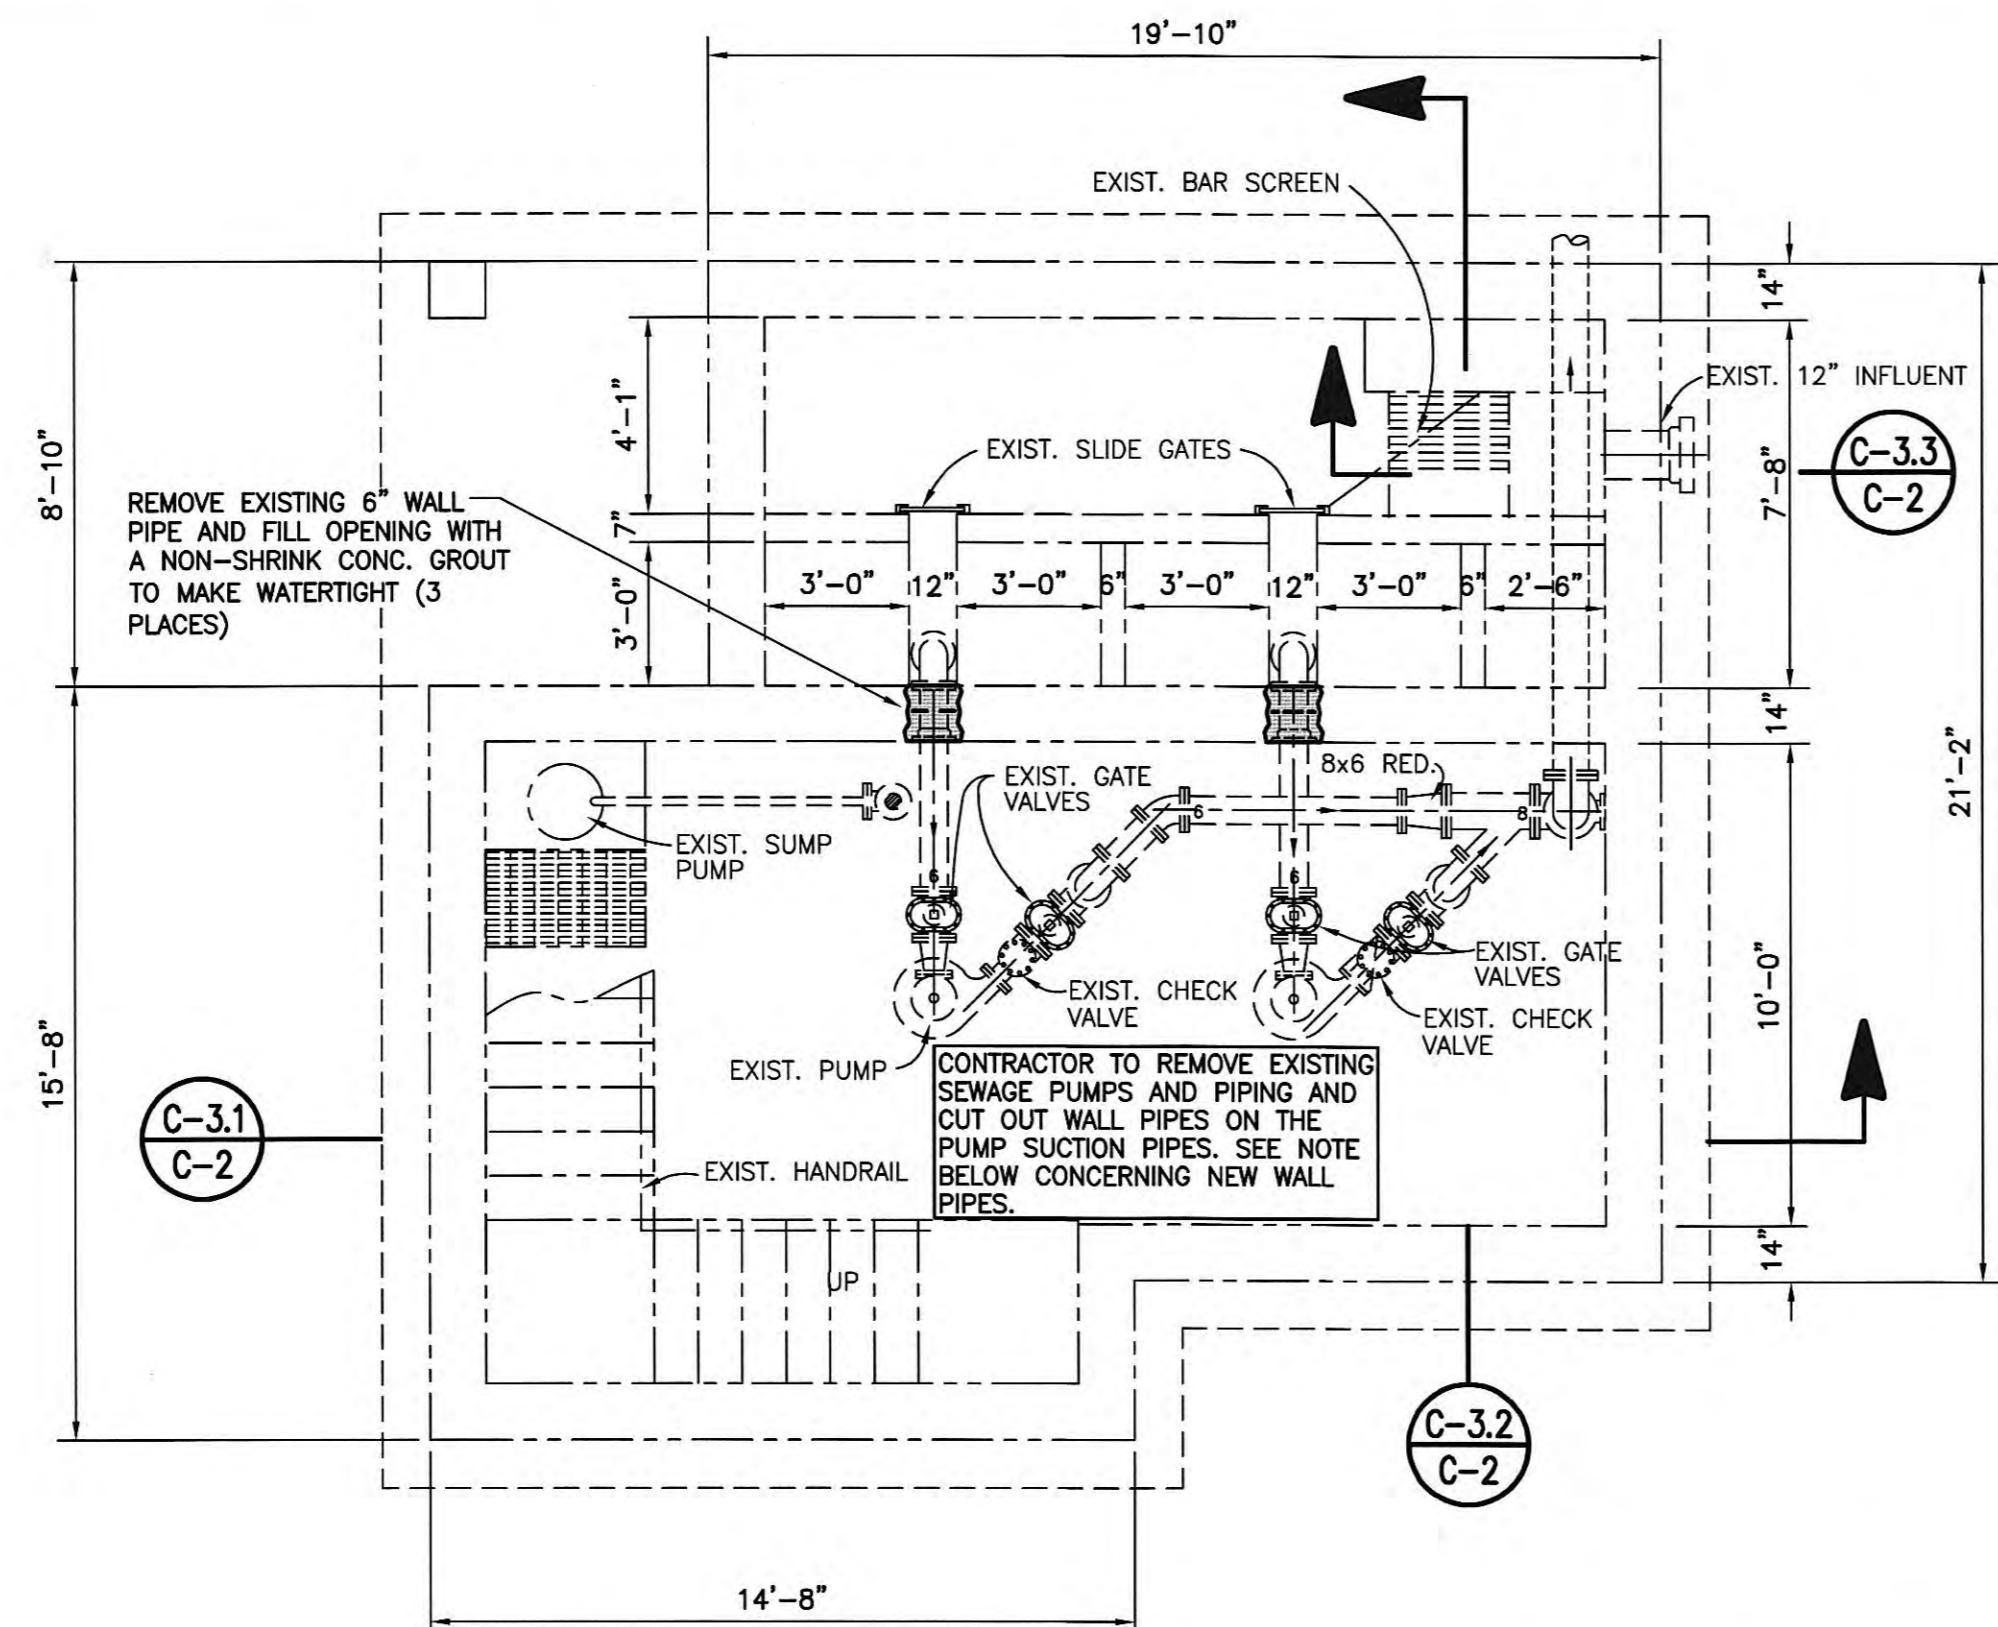


EXISTING FLOOR PLAN - PUMP LEVEL

SCALE: 1/4" = 1'-0"


CONTRACTOR NOTES:

1. CONTRACTOR SHALL BE RESPONSIBLE FOR BYPASS PUMPING WHILE REHABILITATING PUMP STATION. THIS INCLUDES ANY REQUIRED CONNECTIONS TO INFLUENT AND DISCHARGE LINES. HUB WILL PROVIDE THE REQUIRED ELECTRICAL SERVICE FOR BYPASS PUMPING.
2. THE OWNER SHALL HAVE FIRST SALVAGE RIGHTS TO ALL EXISTING VALVES, PIPING AND EQUIPMENT. IF THE OWNER REJECTS SALVAGED MATERIALS, THE CONTRACTOR SHALL PROVIDE FINAL DISPOSAL OF ALL ITEMS.
3. CONTRACTOR TO CLEAN AND PAINT PIPING AND WALLS. WALLS INCLUDE ENTRANCE LEVEL, ELECTRICAL AREA AND PUMP LEVEL: PUMP AND PIPING AREA.
4. CONTRACTOR TO PRESSURE WASH AND CLEAN WETWELL AND SUMP OF EACH PUMP.

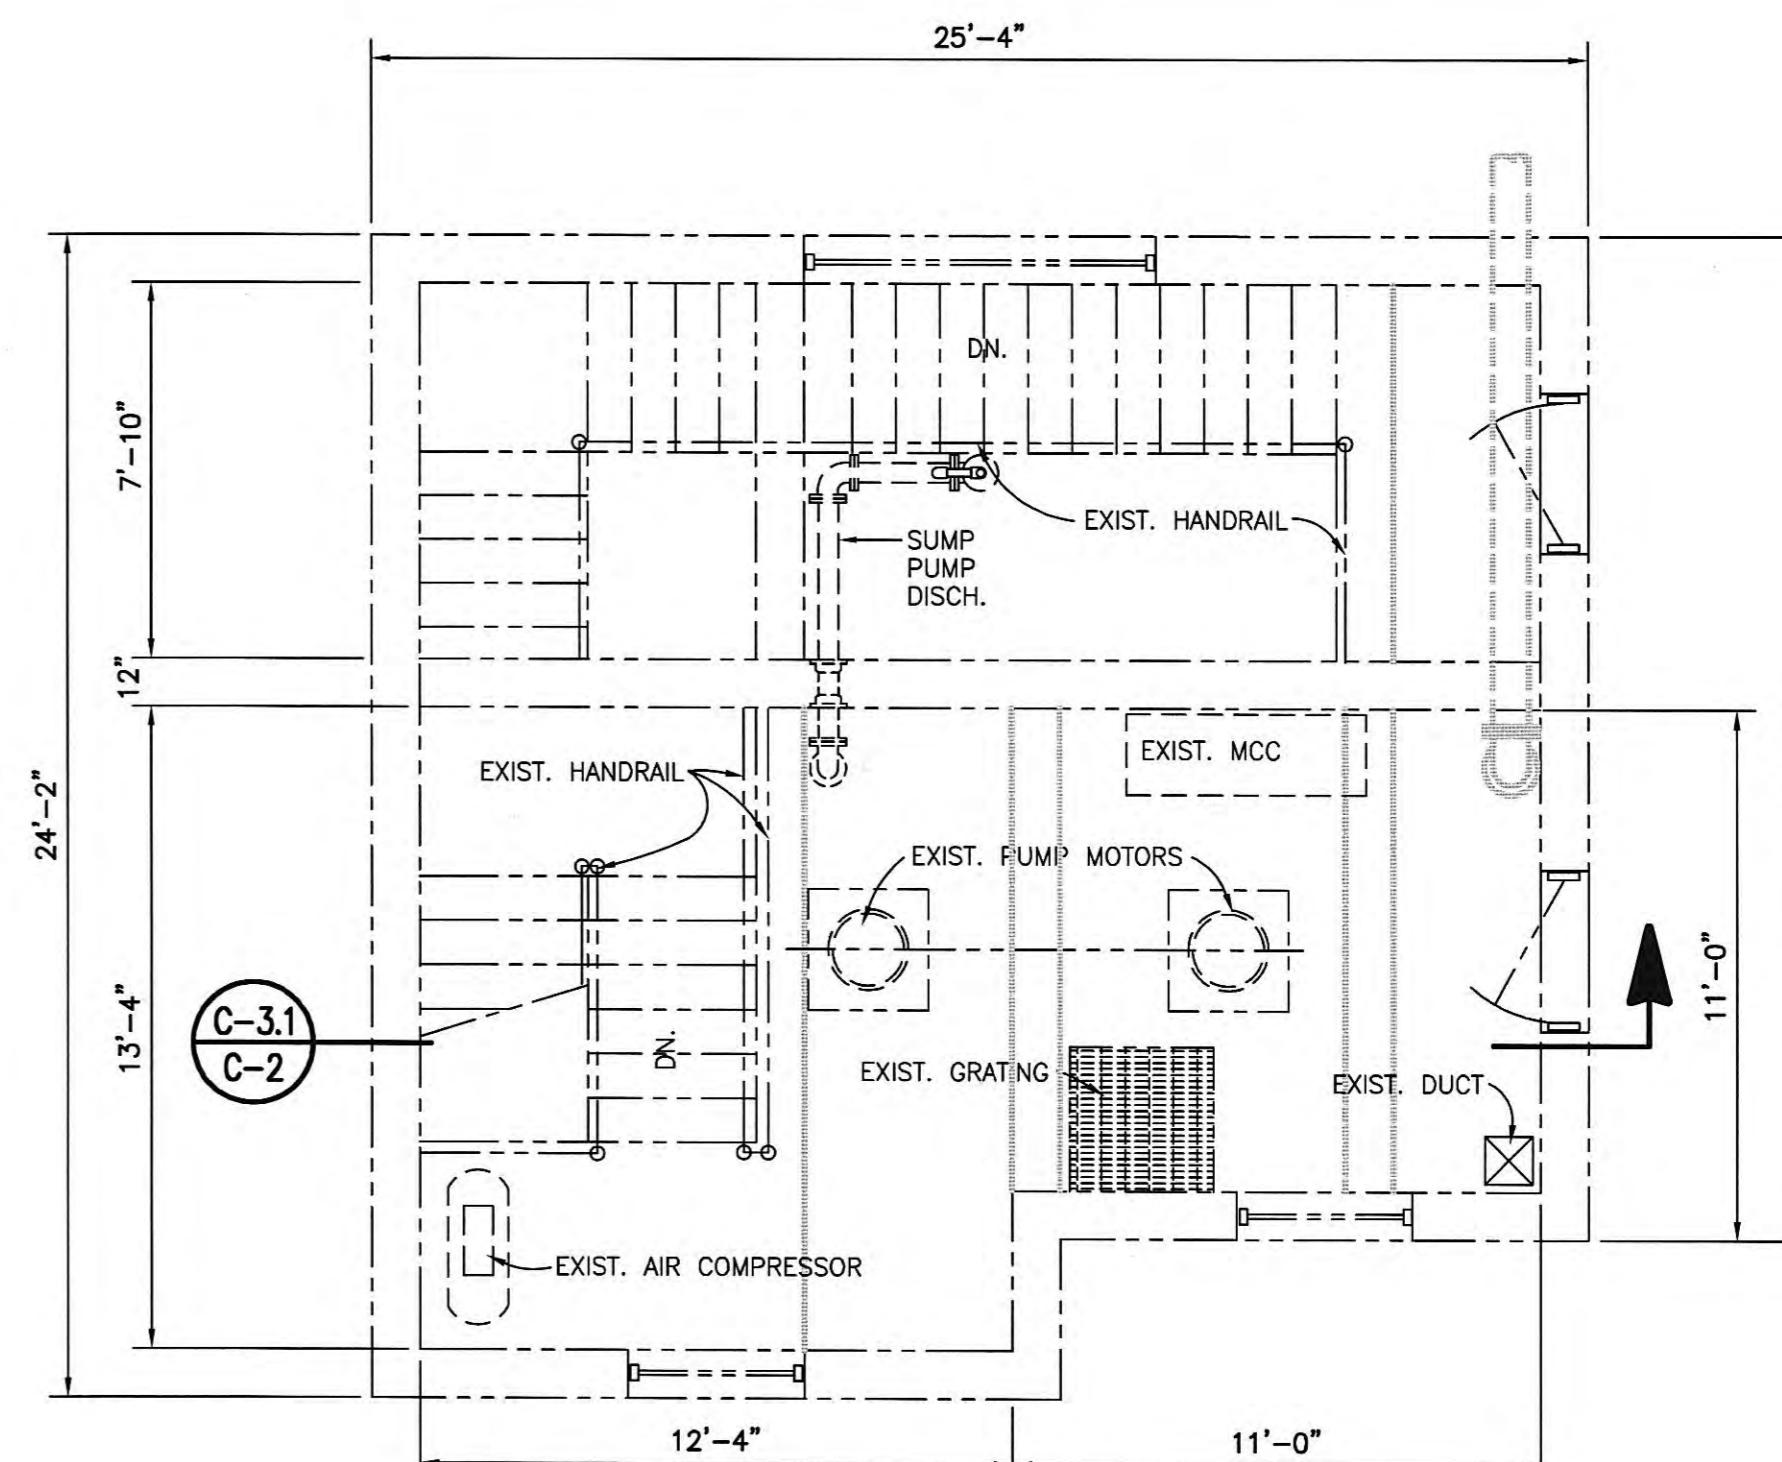


EXISTING FLOOR PLAN - ENTRANCE LEVEL

SCALE: 1/4" = 1'-0"

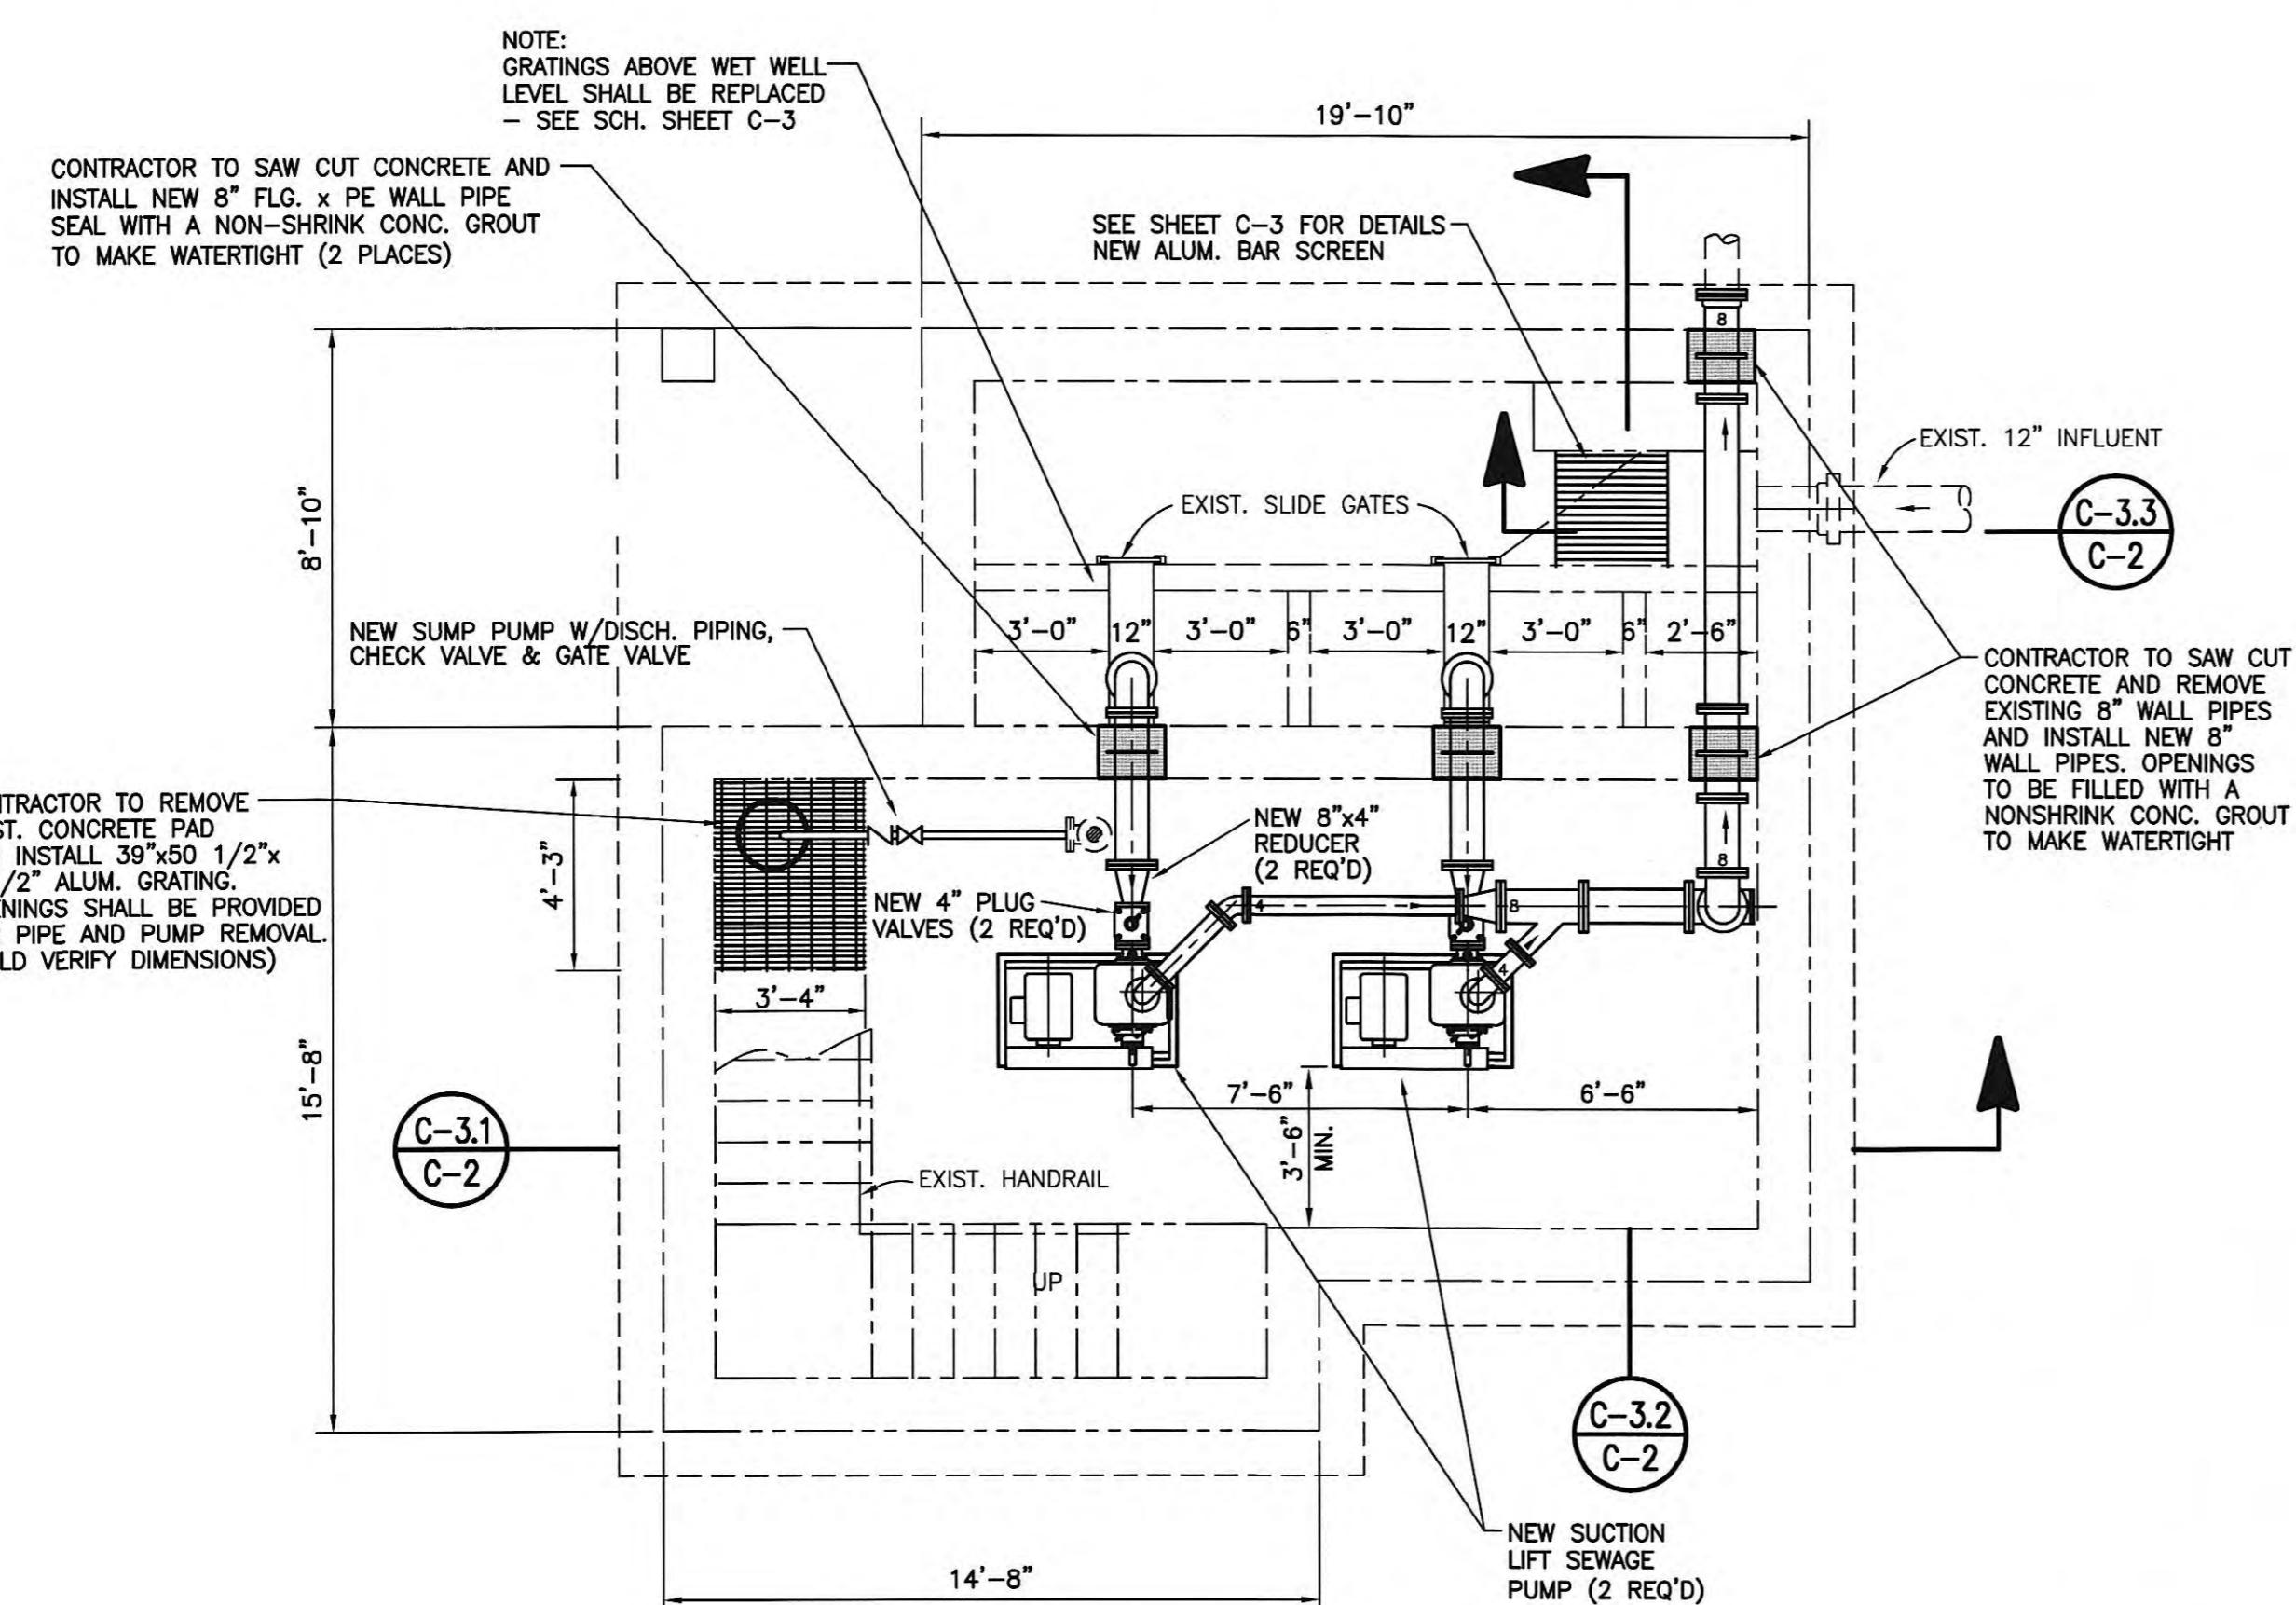

MODIFIED FLOOR PLAN - PUMP LEVEL

SCALE: 1/4" = 1'-0"

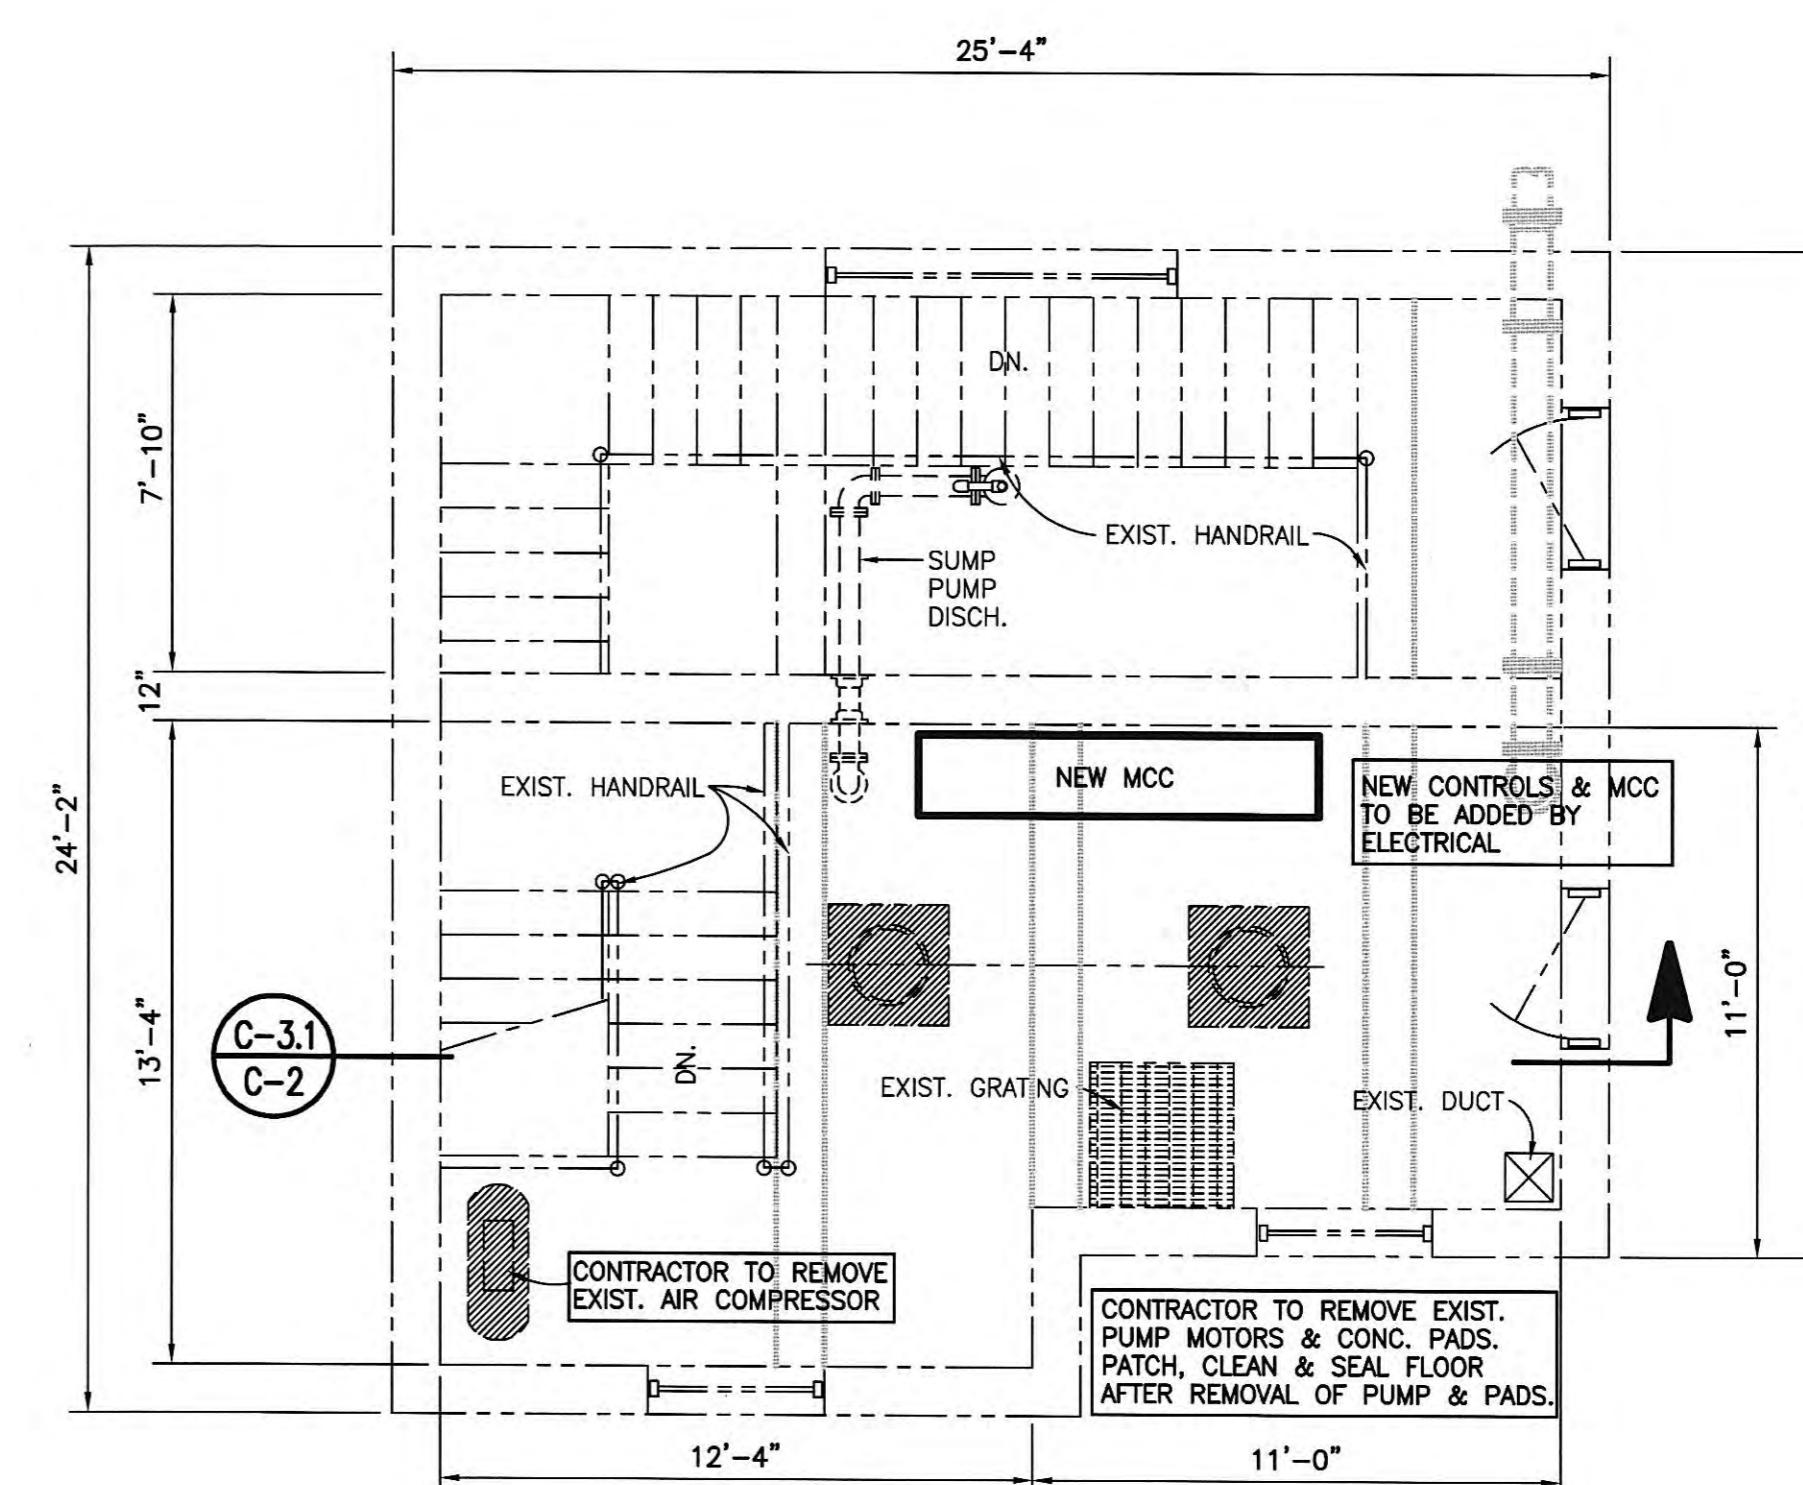

MODIFIED FLOOR PLAN - ENTRANCE LEVEL

SCALE: 1/4" = 1'-0"

GRW PROJECT NO. 7601-30
CONTRACT NO. S02-03
**EXISTING HARDEES SEWAGE PUMP STATION
PLAN VIEWS
HARRIMAN UTILITY BOARD
HARRIMAN, TENNESSEE**




RECORD DRAWINGS	
THESE RECORD DRAWINGS REPRESENT THE "AS-BUILT" PROJECT TO THE BEST OF THE ENGINEER'S KNOWLEDGE, ALTHOUGH PREPARED FROM THE CONSTRUCTION RECORD, THEY CANNOT BE GUARANTEED TO BE EXACT IN EVERY DETAIL.	
CHECKED BY: <i>[Signature]</i> DATE: <i>6/1/2007</i>	
ENGINEER'S REPRESENTATIVE	

ALL RIGHTS RESERVED: THIS DOCUMENT IS THE PROPERTY OF GRW ELROD DUNSON, INC. AND SHALL NOT BE REPRODUCED IN WHOLE OR IN PART OR USED FOR CONSTRUCTION OF OTHER THAN THIS SPECIFIC PROJECT WITHOUT WRITTEN PERMISSION OF GRW ELROD DUNSON, INC.					
NO.	ADDENDUM NO. 1	DATE	RGT	BY	REVISIONS
1					
	DESCRIPTION				


GRW Elrod Dunson, Inc.
Engineers, Architects, Planners
LEXINGTON LOUISVILLE INDIANAPOLIS
NASHVILLE KNOXVILLE

DESIGNED: RGT/NDW DATE: NOVEMBER, 2002
DRAWN: DGR SCALE: AS NOTED
REVIEWED: NDW SHEET NO.
APPROVED: RGT



C-2

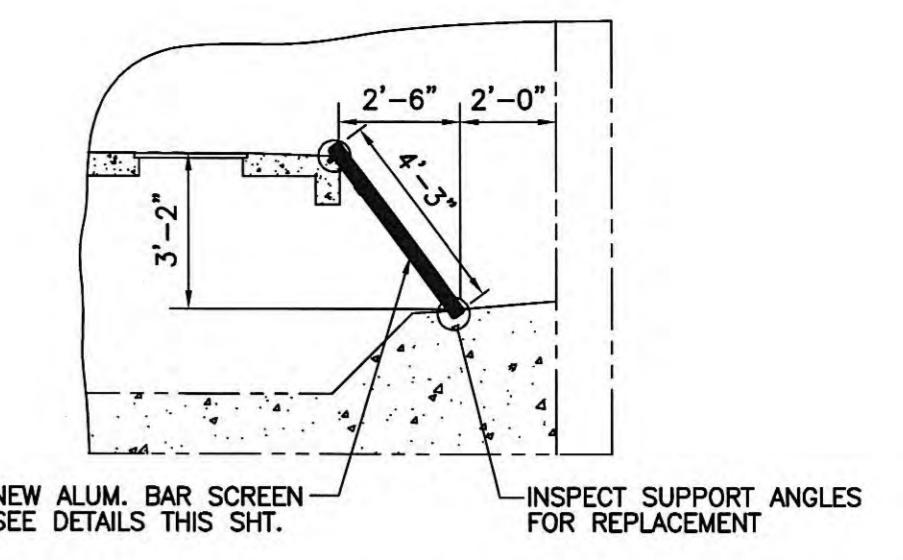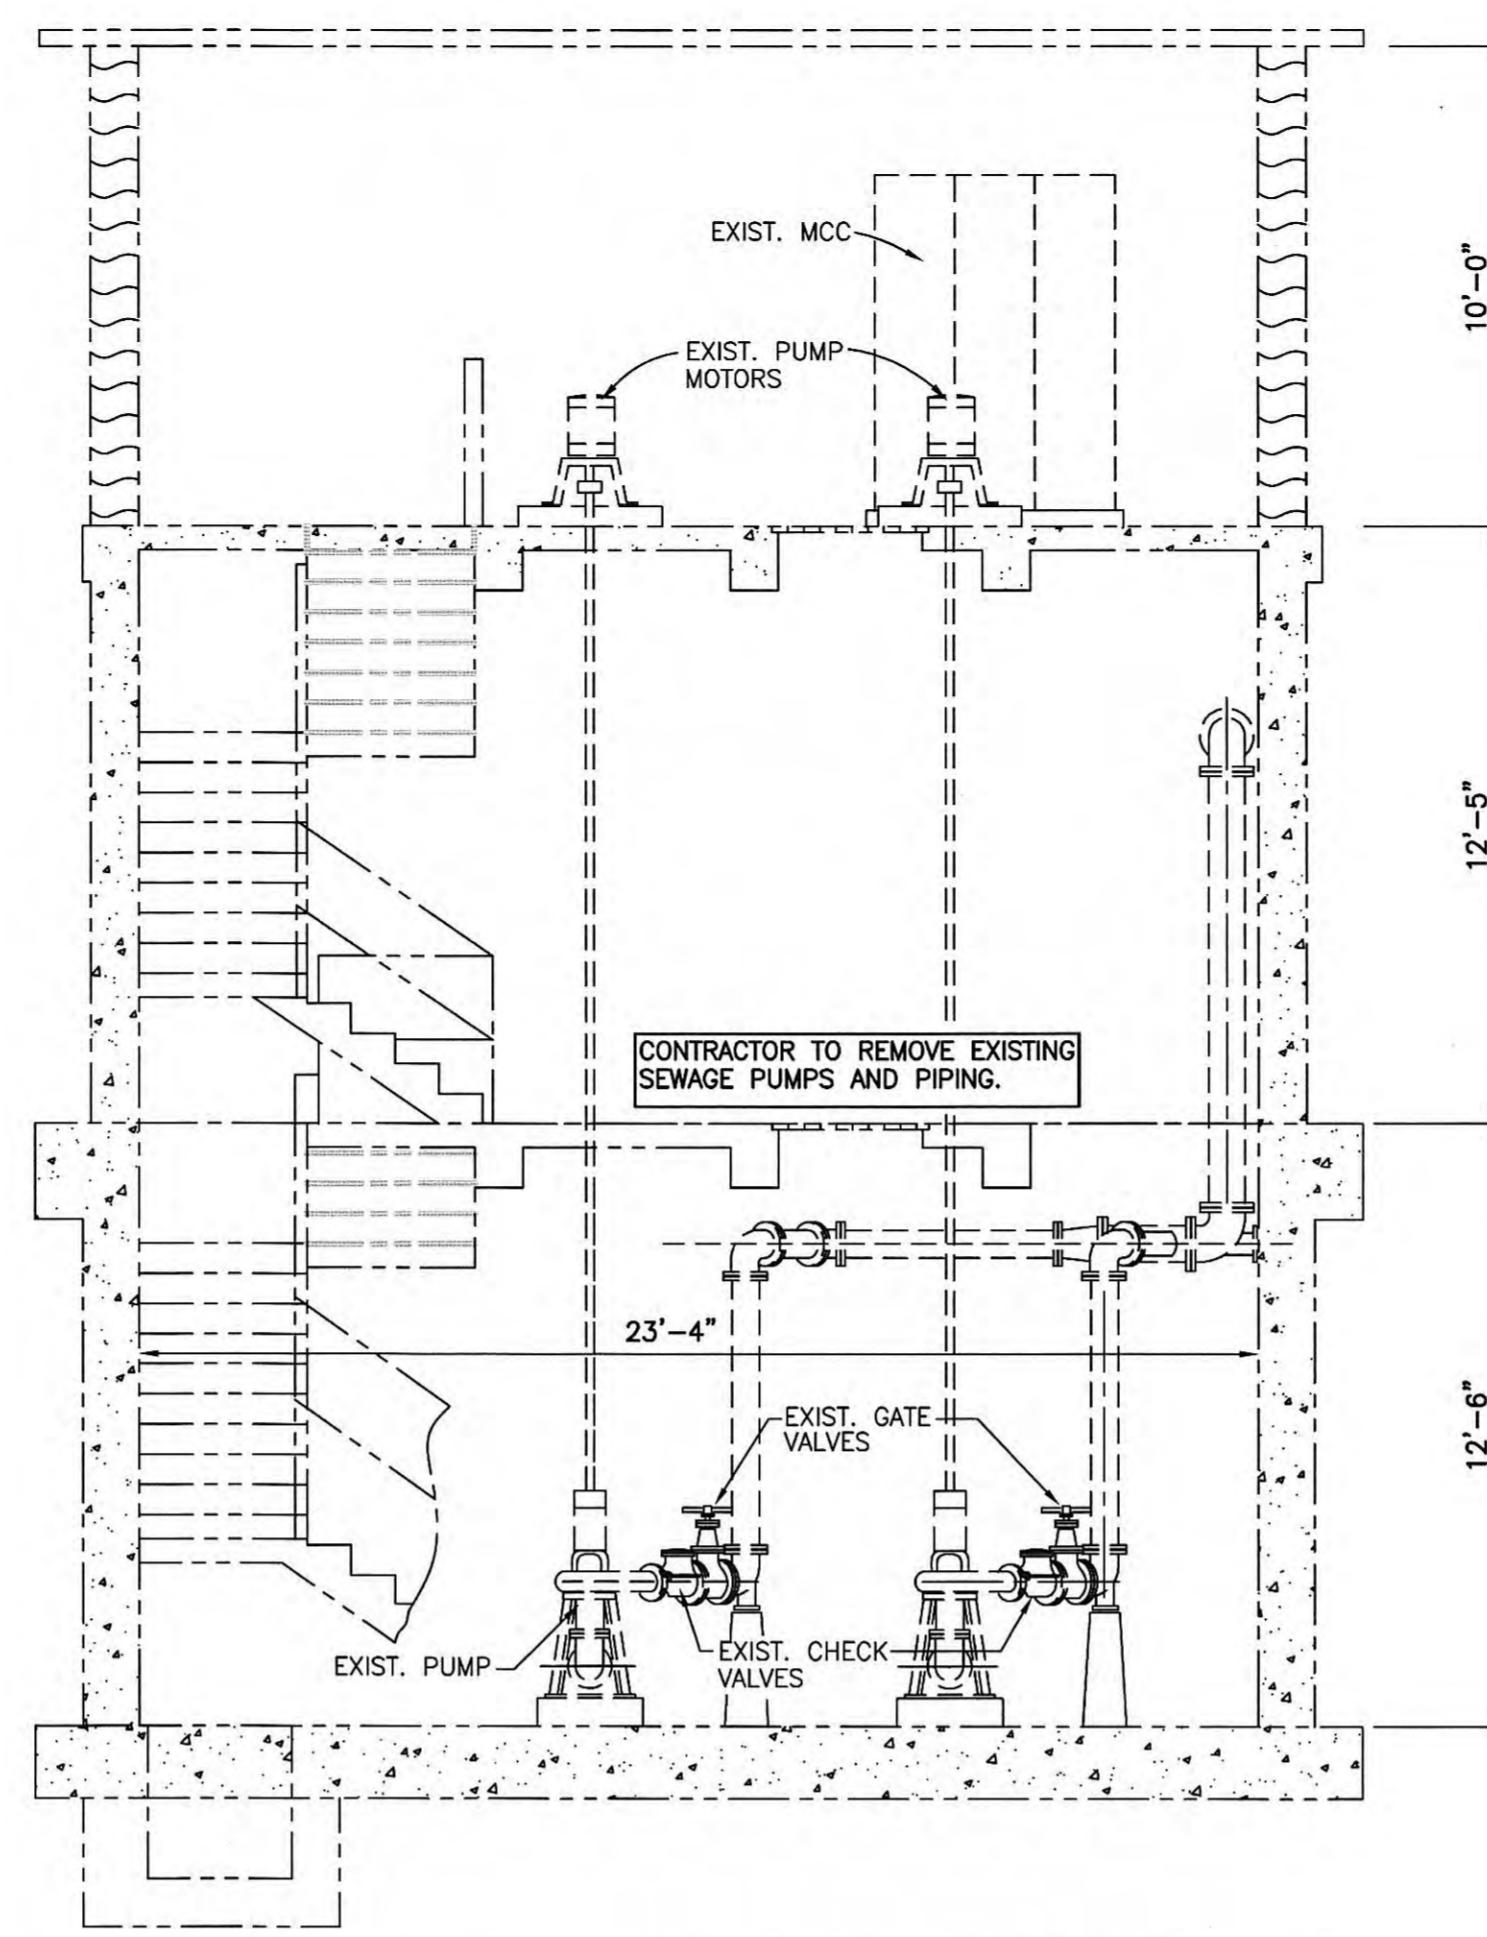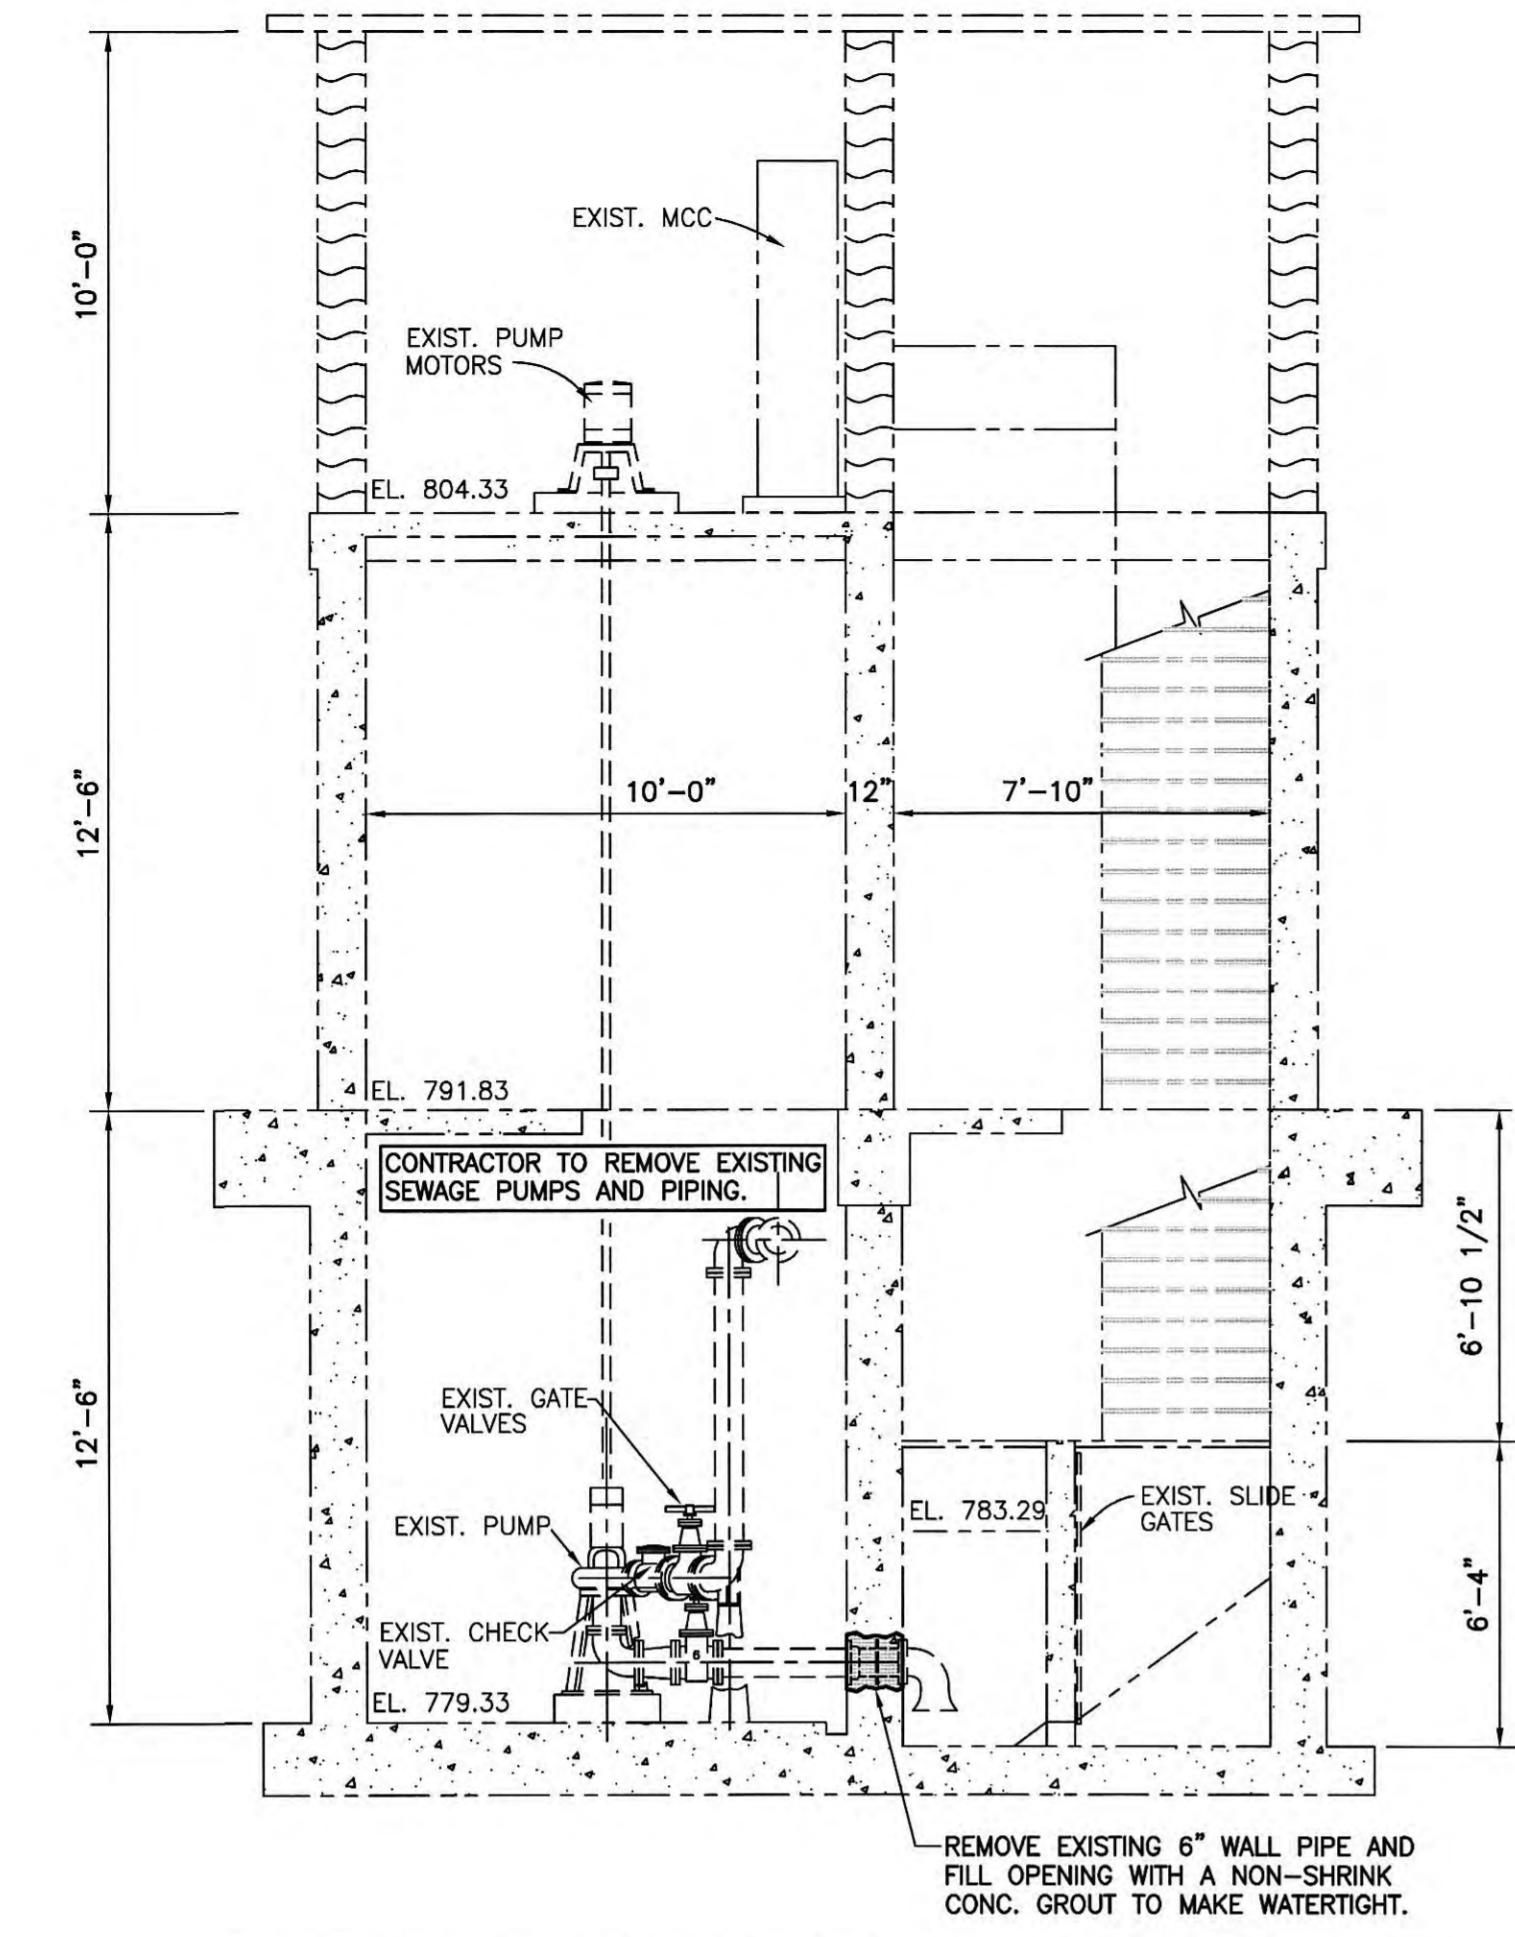

NOTES:
1. CONTRACTOR TO FIELD VERIFY BAR SCREEN DIMENSIONS BEFORE FABRICATION. SUPPORT ANGLES SHALL BE REPLACED IF DETERIORATED.
2. CONTRACTOR TO FURNISH ALUM. BAR SCREEN RAKE W/TINES SPACED TO MATCH BAR SPACING ON SCREEN.

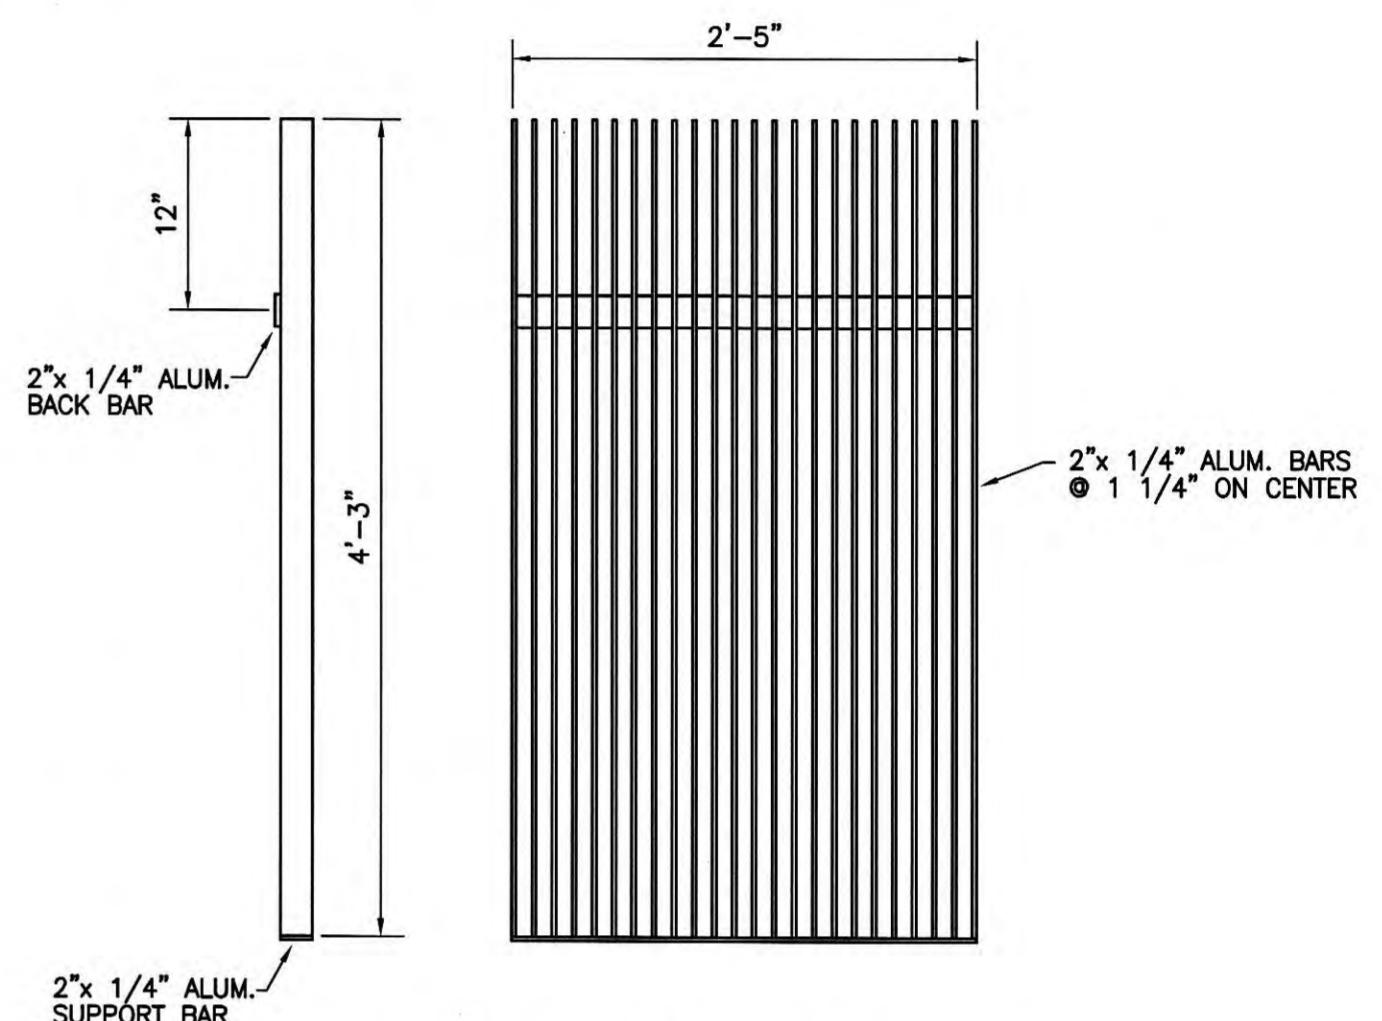

MANUAL BAR SCREEN DETAIL
SCALE: NONE

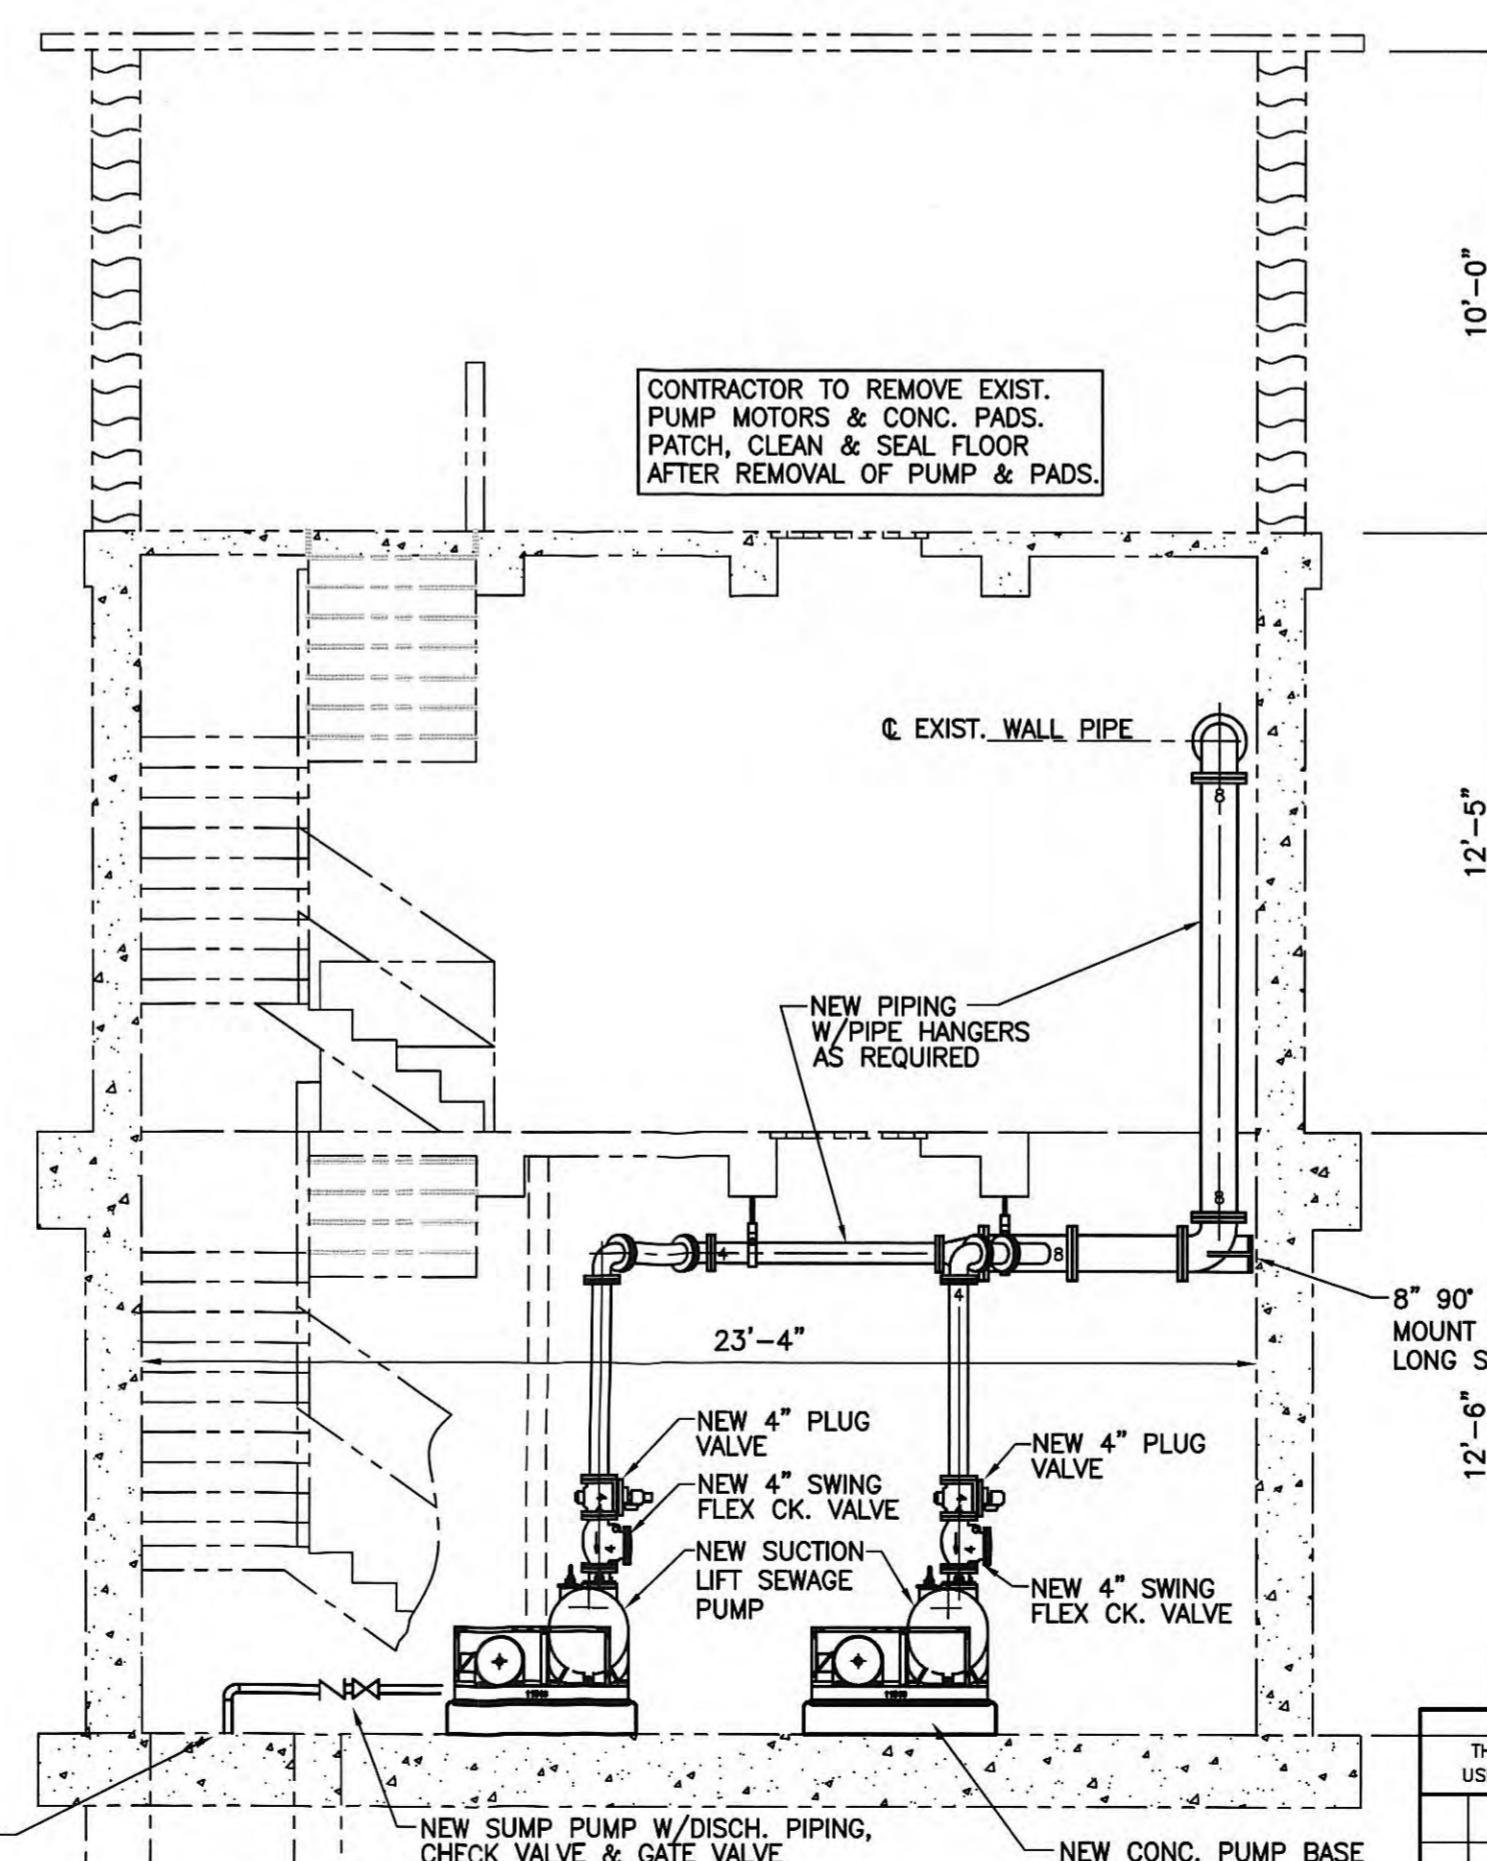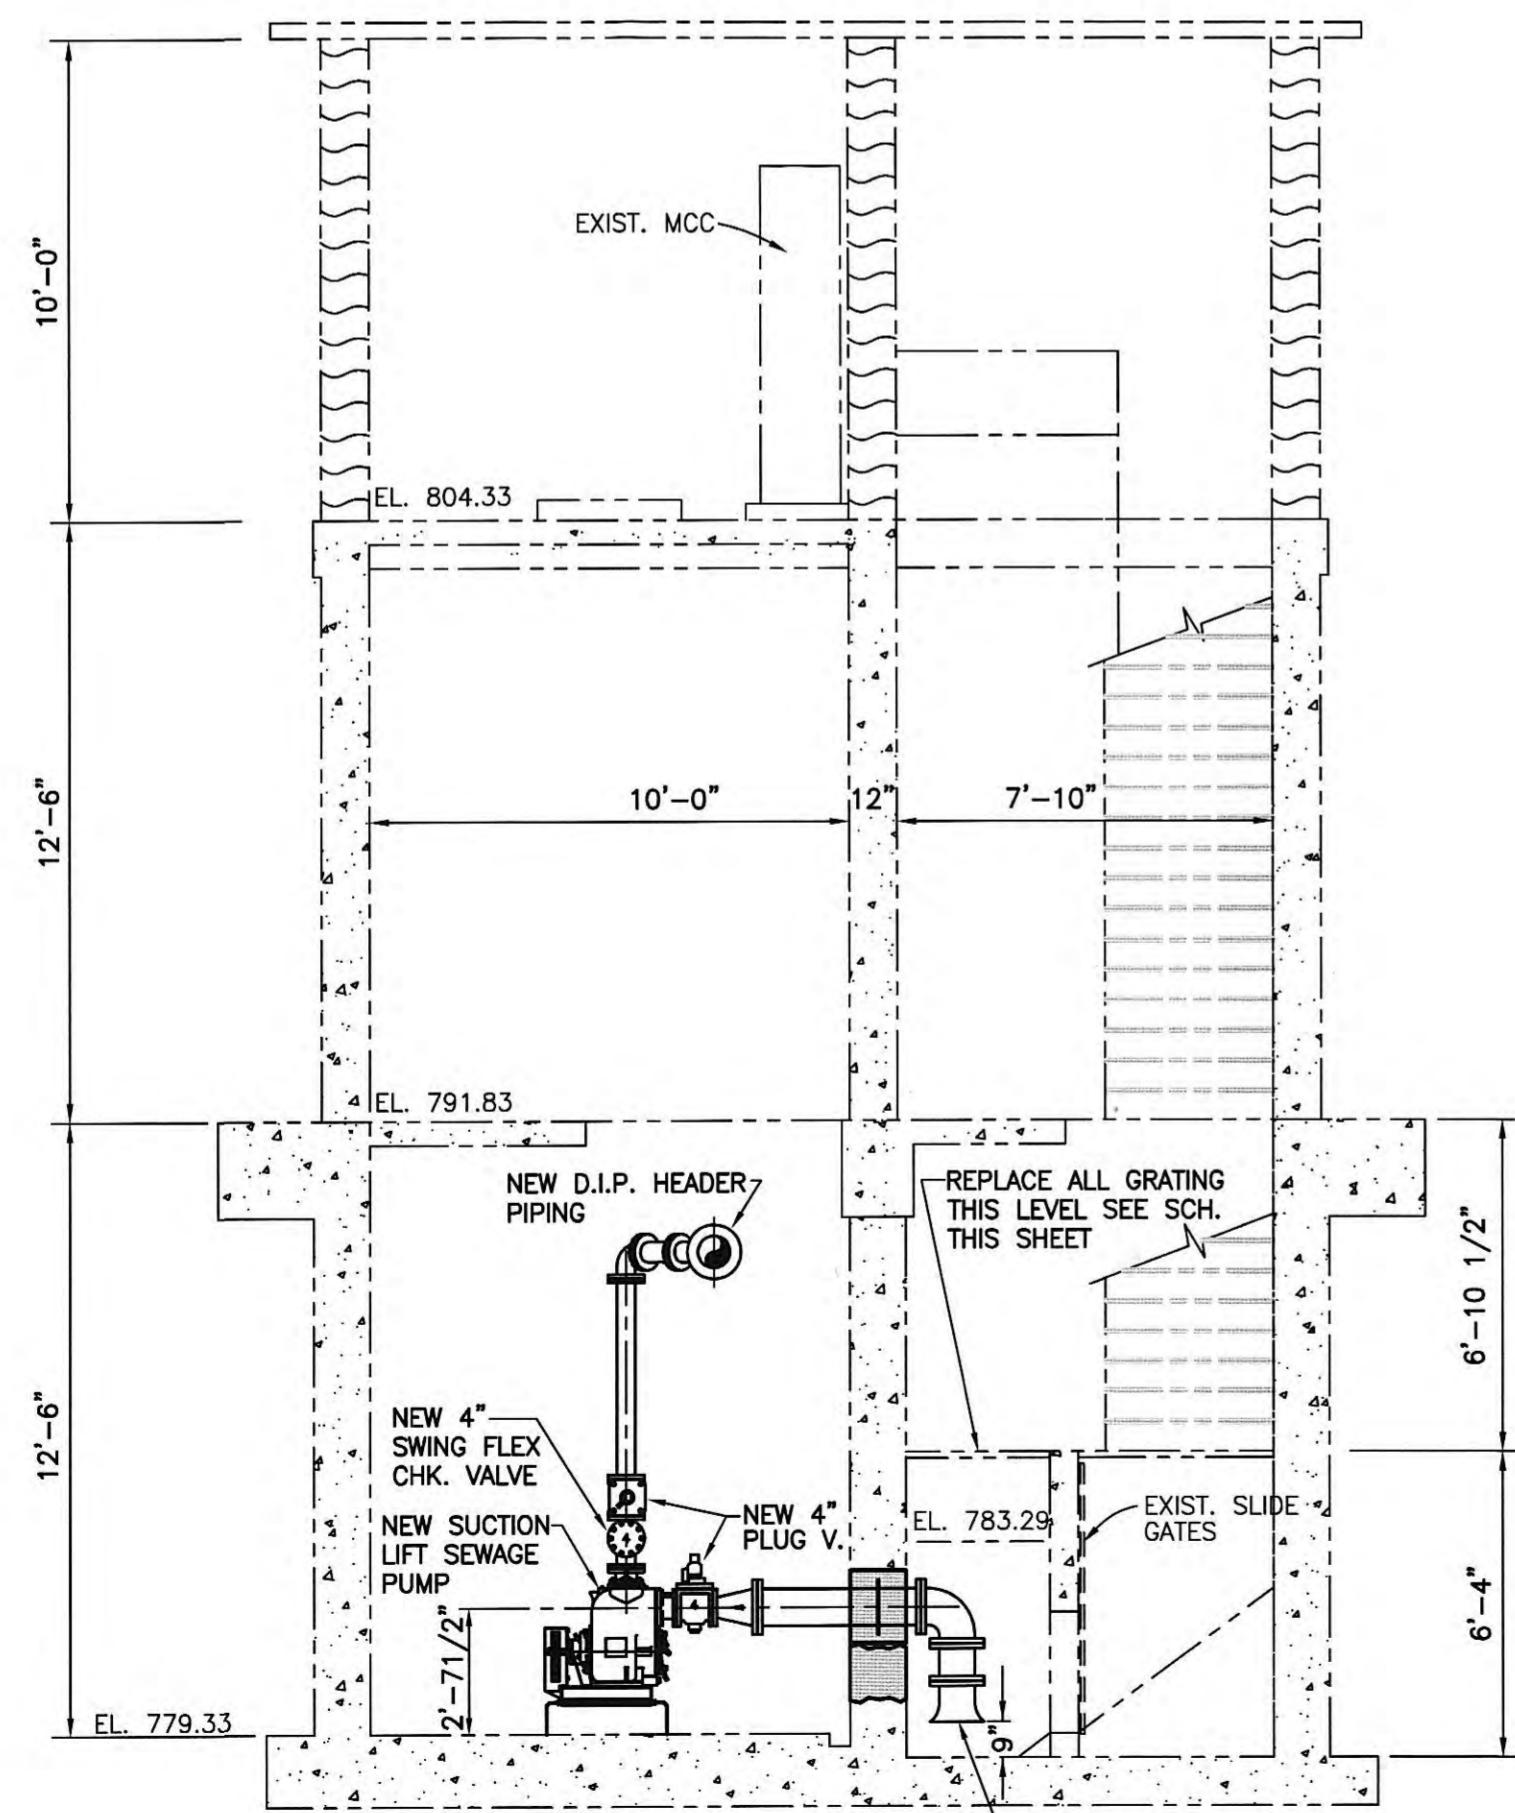

SCHEDULE FOR ALUMINUM GRATING REPLACEMENT	
3 EACH - 35 1/2" x 38 1/2" x 1 1/2"	
2 EACH - 20 1/2" x 5" x 1 1/2"	


CONTRACTOR TO FIELD VERIFY ALL GRATING OPENINGS FOR PROPER FIT.

ALL RIGHTS RESERVED:
THIS DOCUMENT IS THE PROPERTY OF GRW ELROD DUNSON, INC. AND SHALL NOT BE REPRODUCED IN WHOLE OR IN PART OR USED FOR CONSTRUCTION OF OTHER THAN THIS SPECIFIC PROJECT WITHOUT WRITTEN PERMISSION OF GRW ELROD DUNSON, INC.

GRW PROJECT NO. 7601-30
CONTRACT NO. S02-03
EXISTING HARDEES SEWAGE PUMP STATION SECTIONS
HARRIMAN UTILITY BOARD
HARRIMAN, TENNESSEE

DESIGNED:	RGT/NDW	DATE:	NOVEMBER, 2002
DRAWN:		SCALE:	
DRA:		AS NOTED	
REVIEWED:		SHEET NO.	
APPROVED:		C-3	


GRW
GRW Elrod Dunson, Inc.
Engineers, Architects, Planners
LEXINGTON LOUISVILLE INDIANAPOLIS
NASHVILLE KNOXVILLE

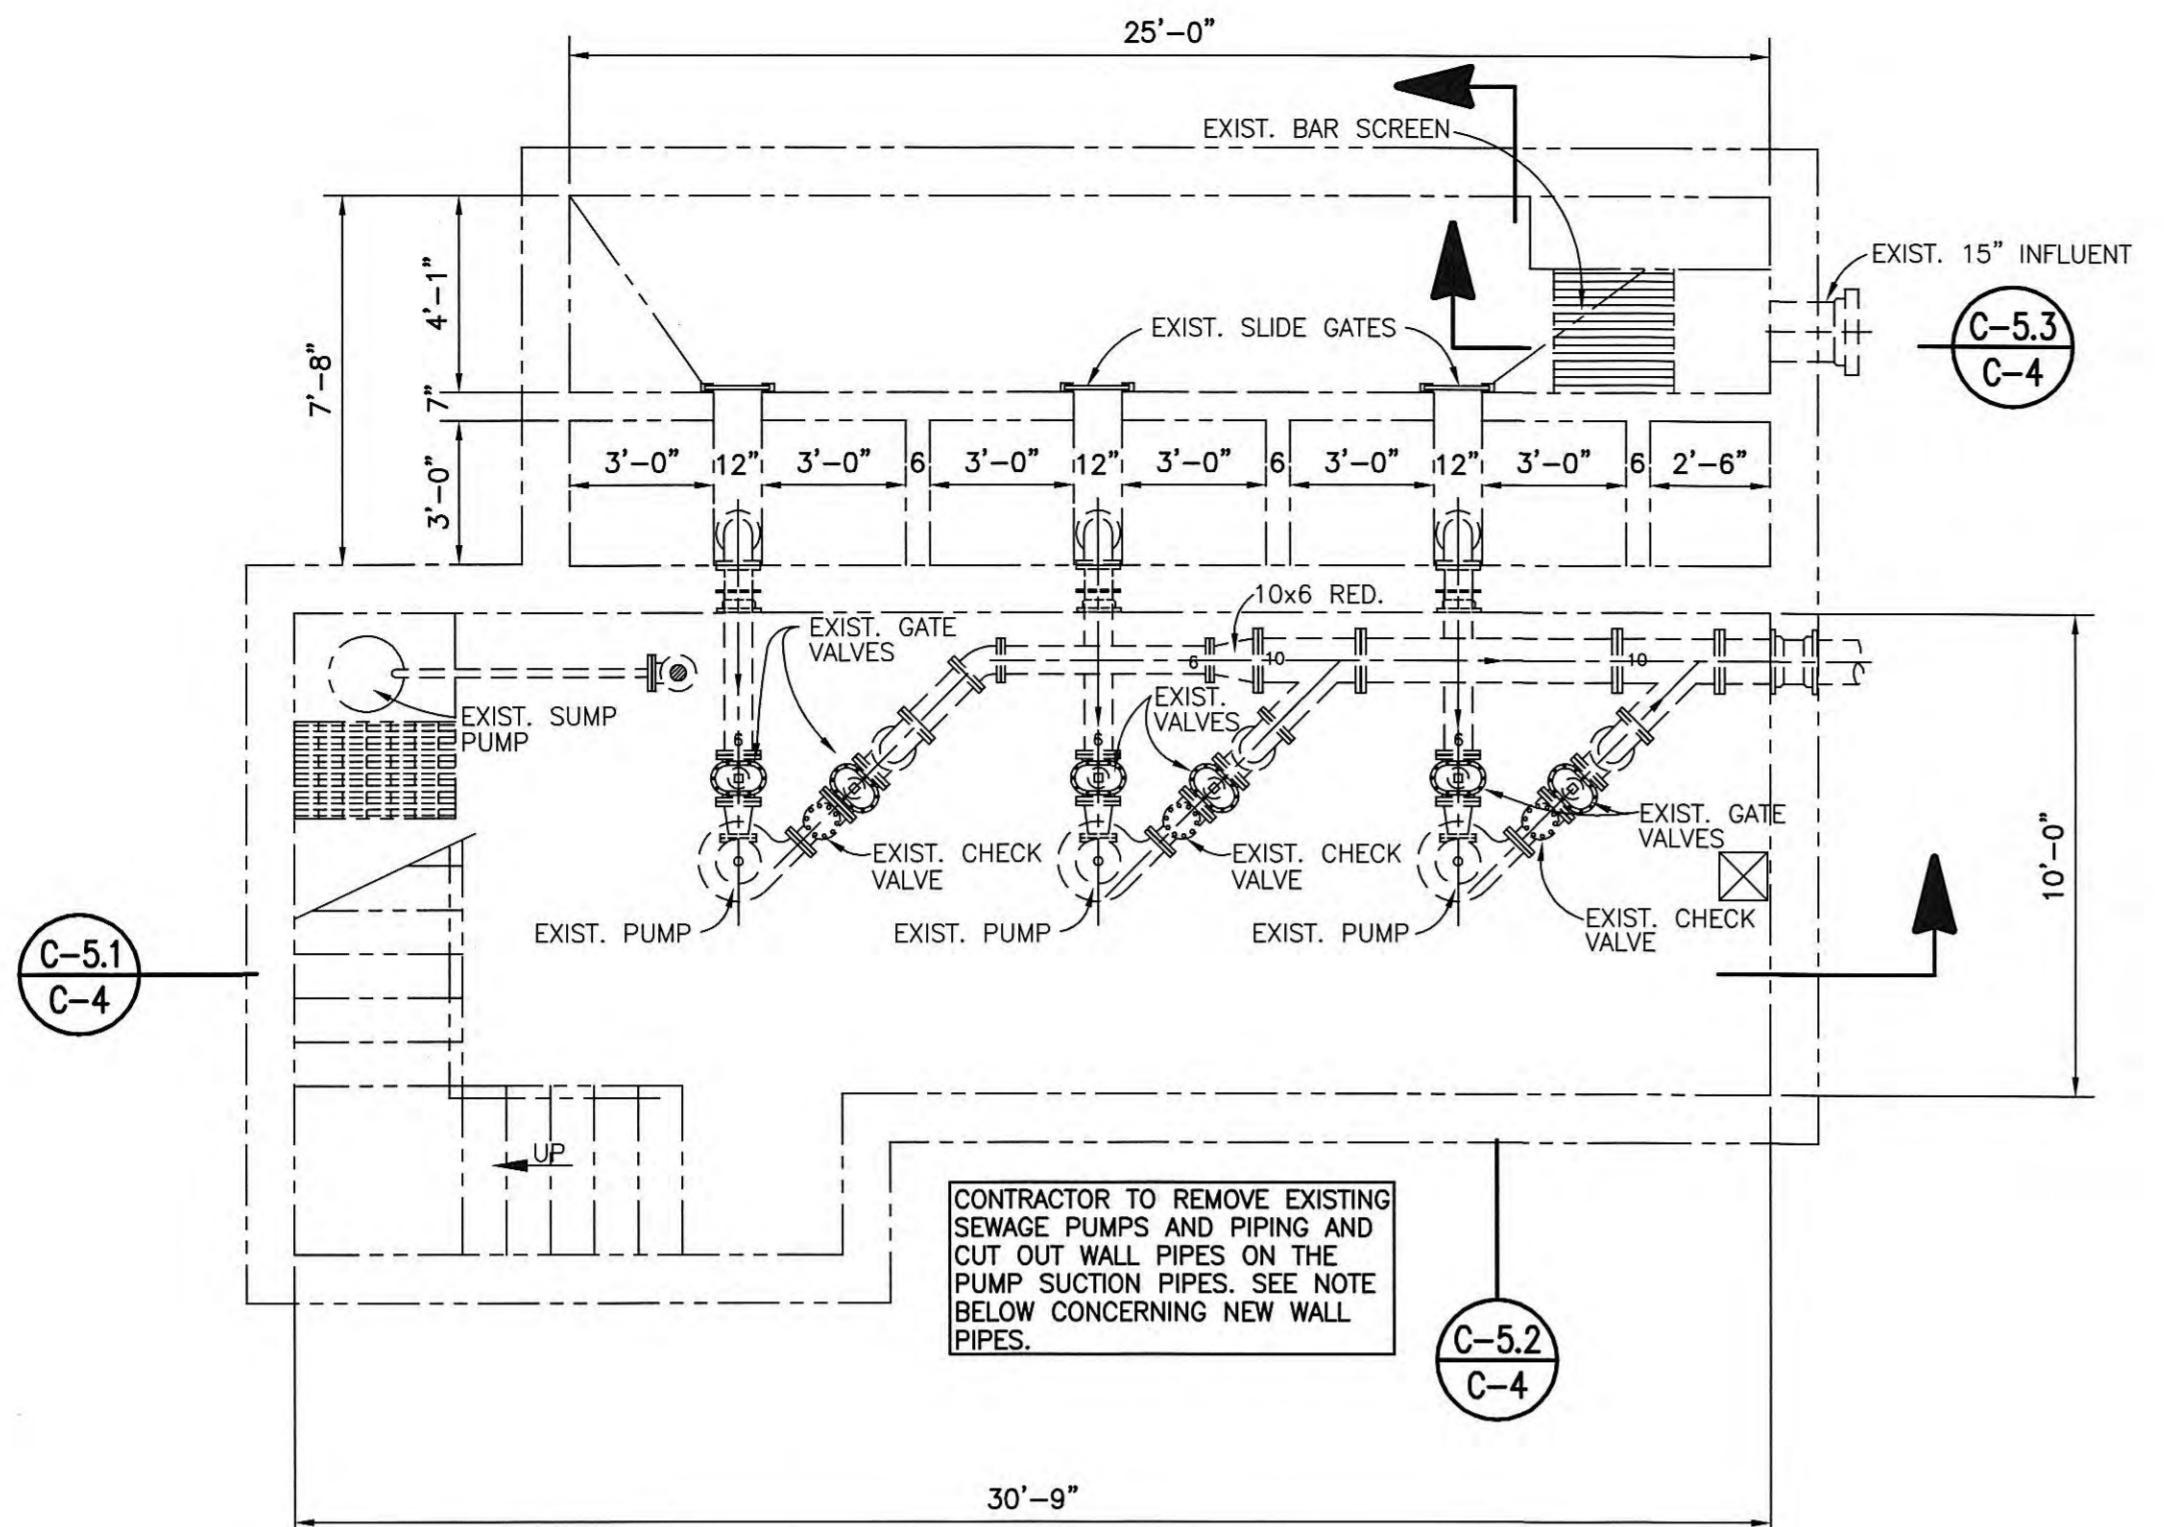

EXISTING FLOOR PLAN – PUMP LEVEL


SCALE: 1/4" = 1'-0"

- CONTRACTOR NOTES:**
1. CONTRACTOR SHALL BE RESPONSIBLE FOR BYPASS PUMPING WHILE REHABILITATING PUMP STATION. THIS INCLUDES ANY REQUIRED CONNECTIONS TO INFLUENT AND DISCHARGE LINES. HUB WILL PROVIDE THE REQUIRED ELECTRICAL SERVICE FOR BYPASS PUMPING.
 2. THE OWNER SHALL HAVE FIRST SALVAGE RIGHTS TO ALL EXISTING VALVES, PIPING AND EQUIPMENT. IF THE OWNER REJECTS SALVAGED MATERIALS, THE CONTRACTOR SHALL PROVIDE FINAL DISPOSAL OF ALL ITEMS.
 3. CONTRACTOR TO CLEAN AND PAINT PIPING AND WALLS. WALLS INCLUDE ENTRANCE LEVEL: ELECTRICAL AREA AND PUMP LEVEL: PUMP AND PIPING AREA.

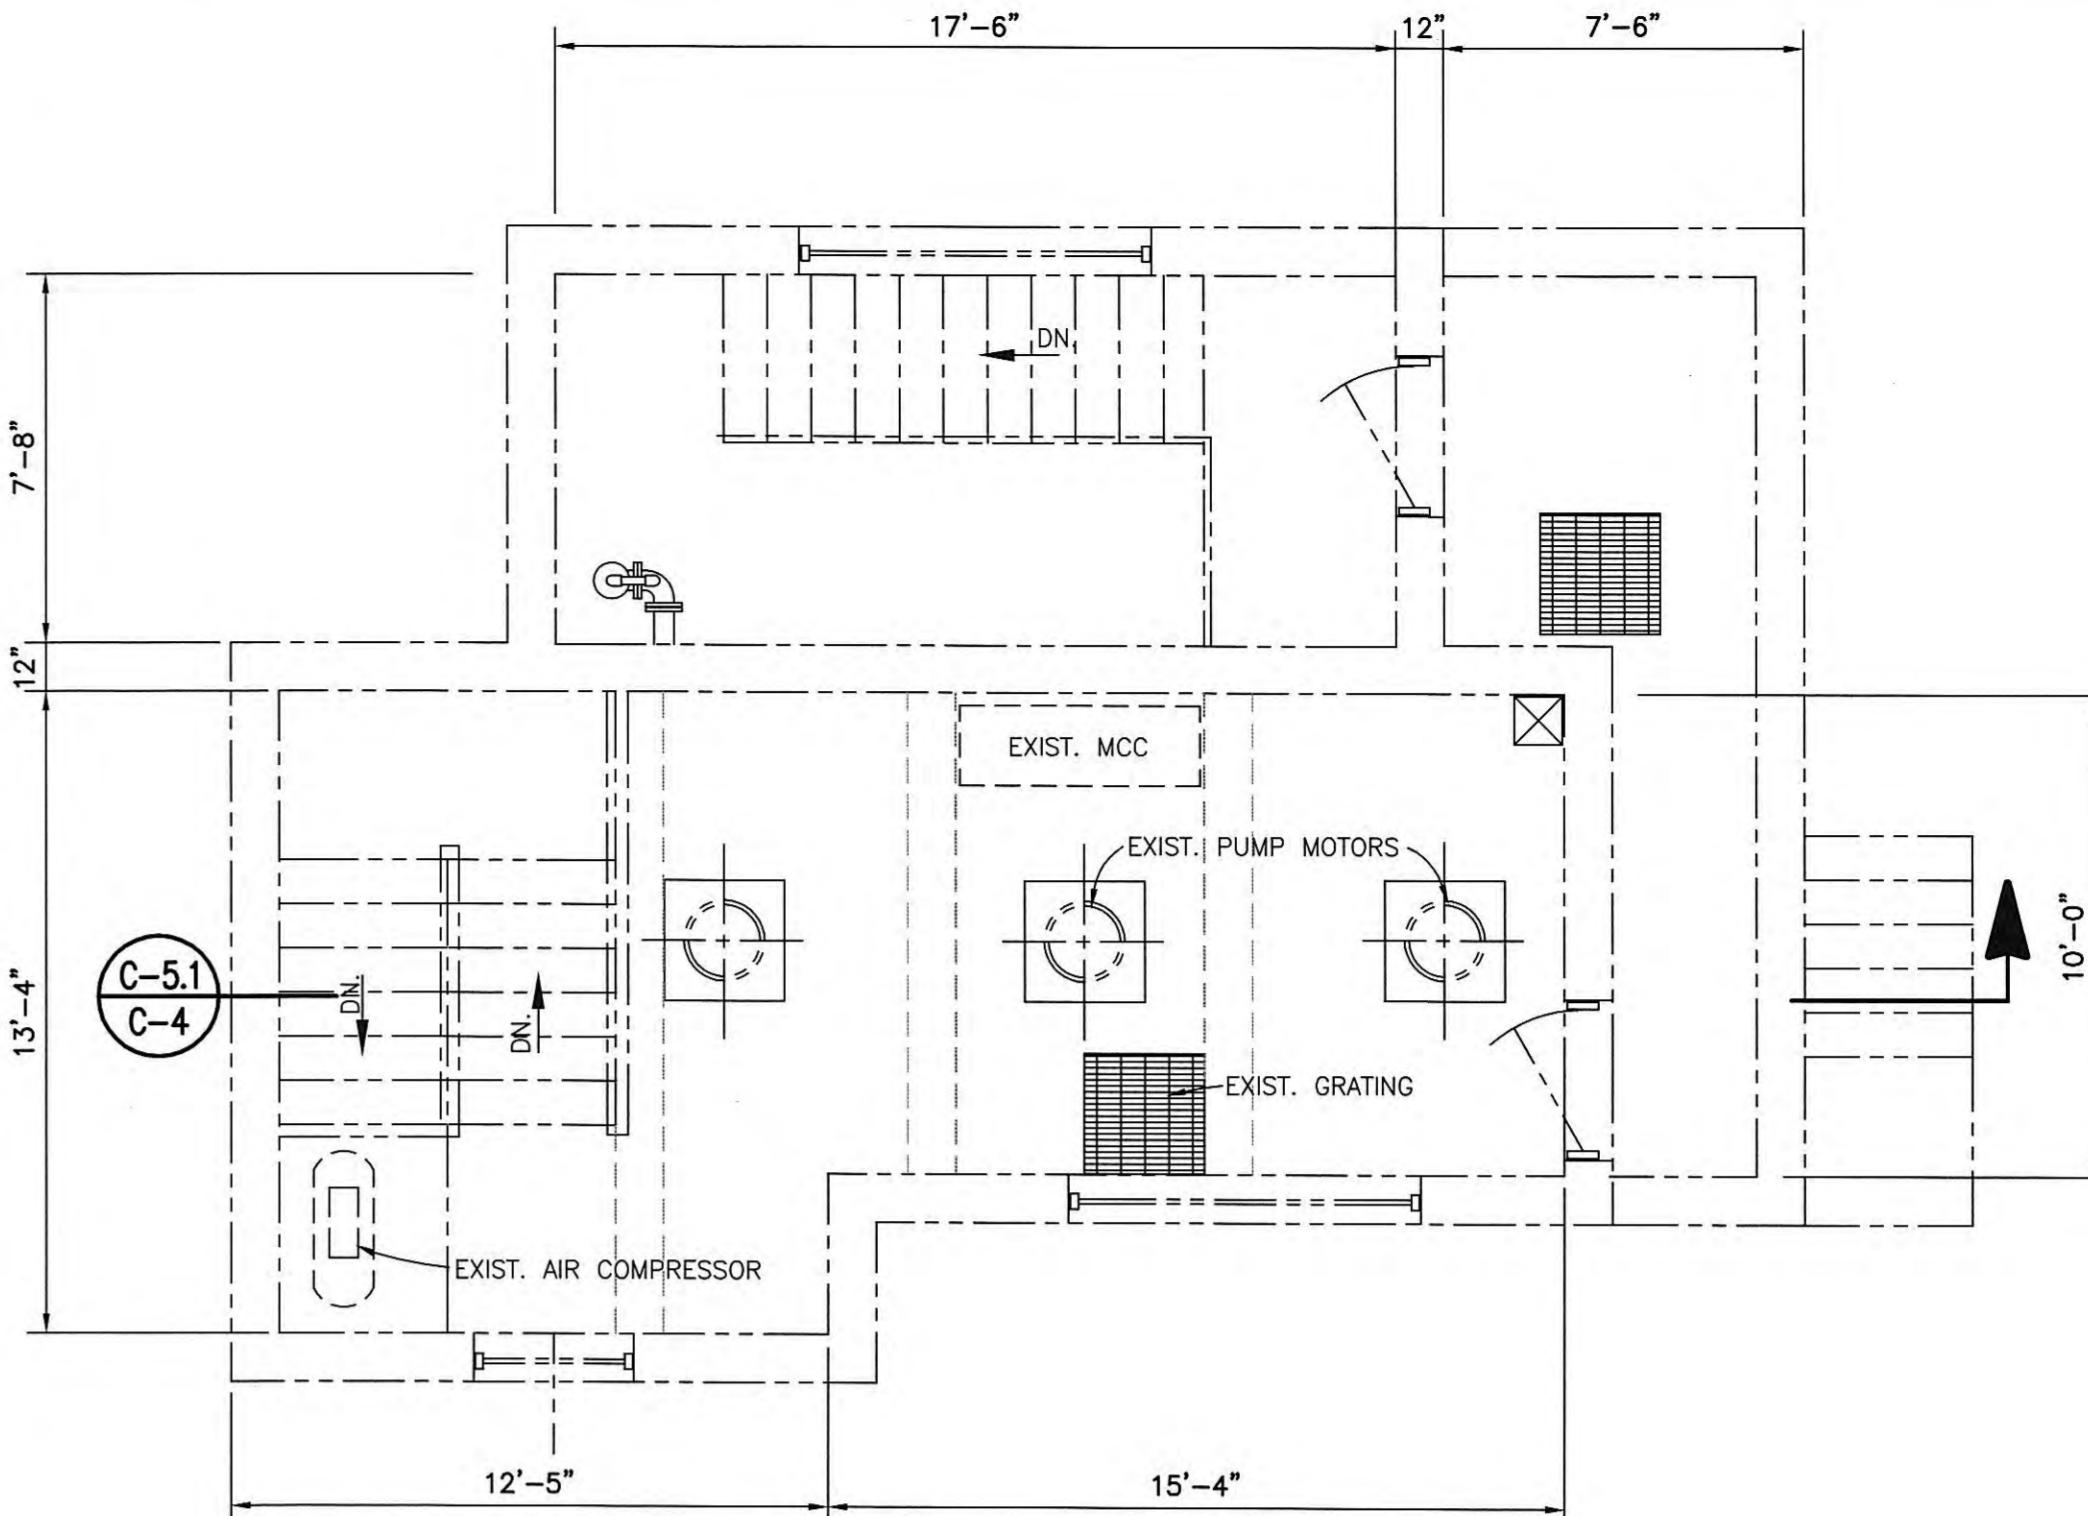


EXISTING FLOOR PLAN – ENTRANCE LEVEL

SCALE: 1/4" = 1'-0"

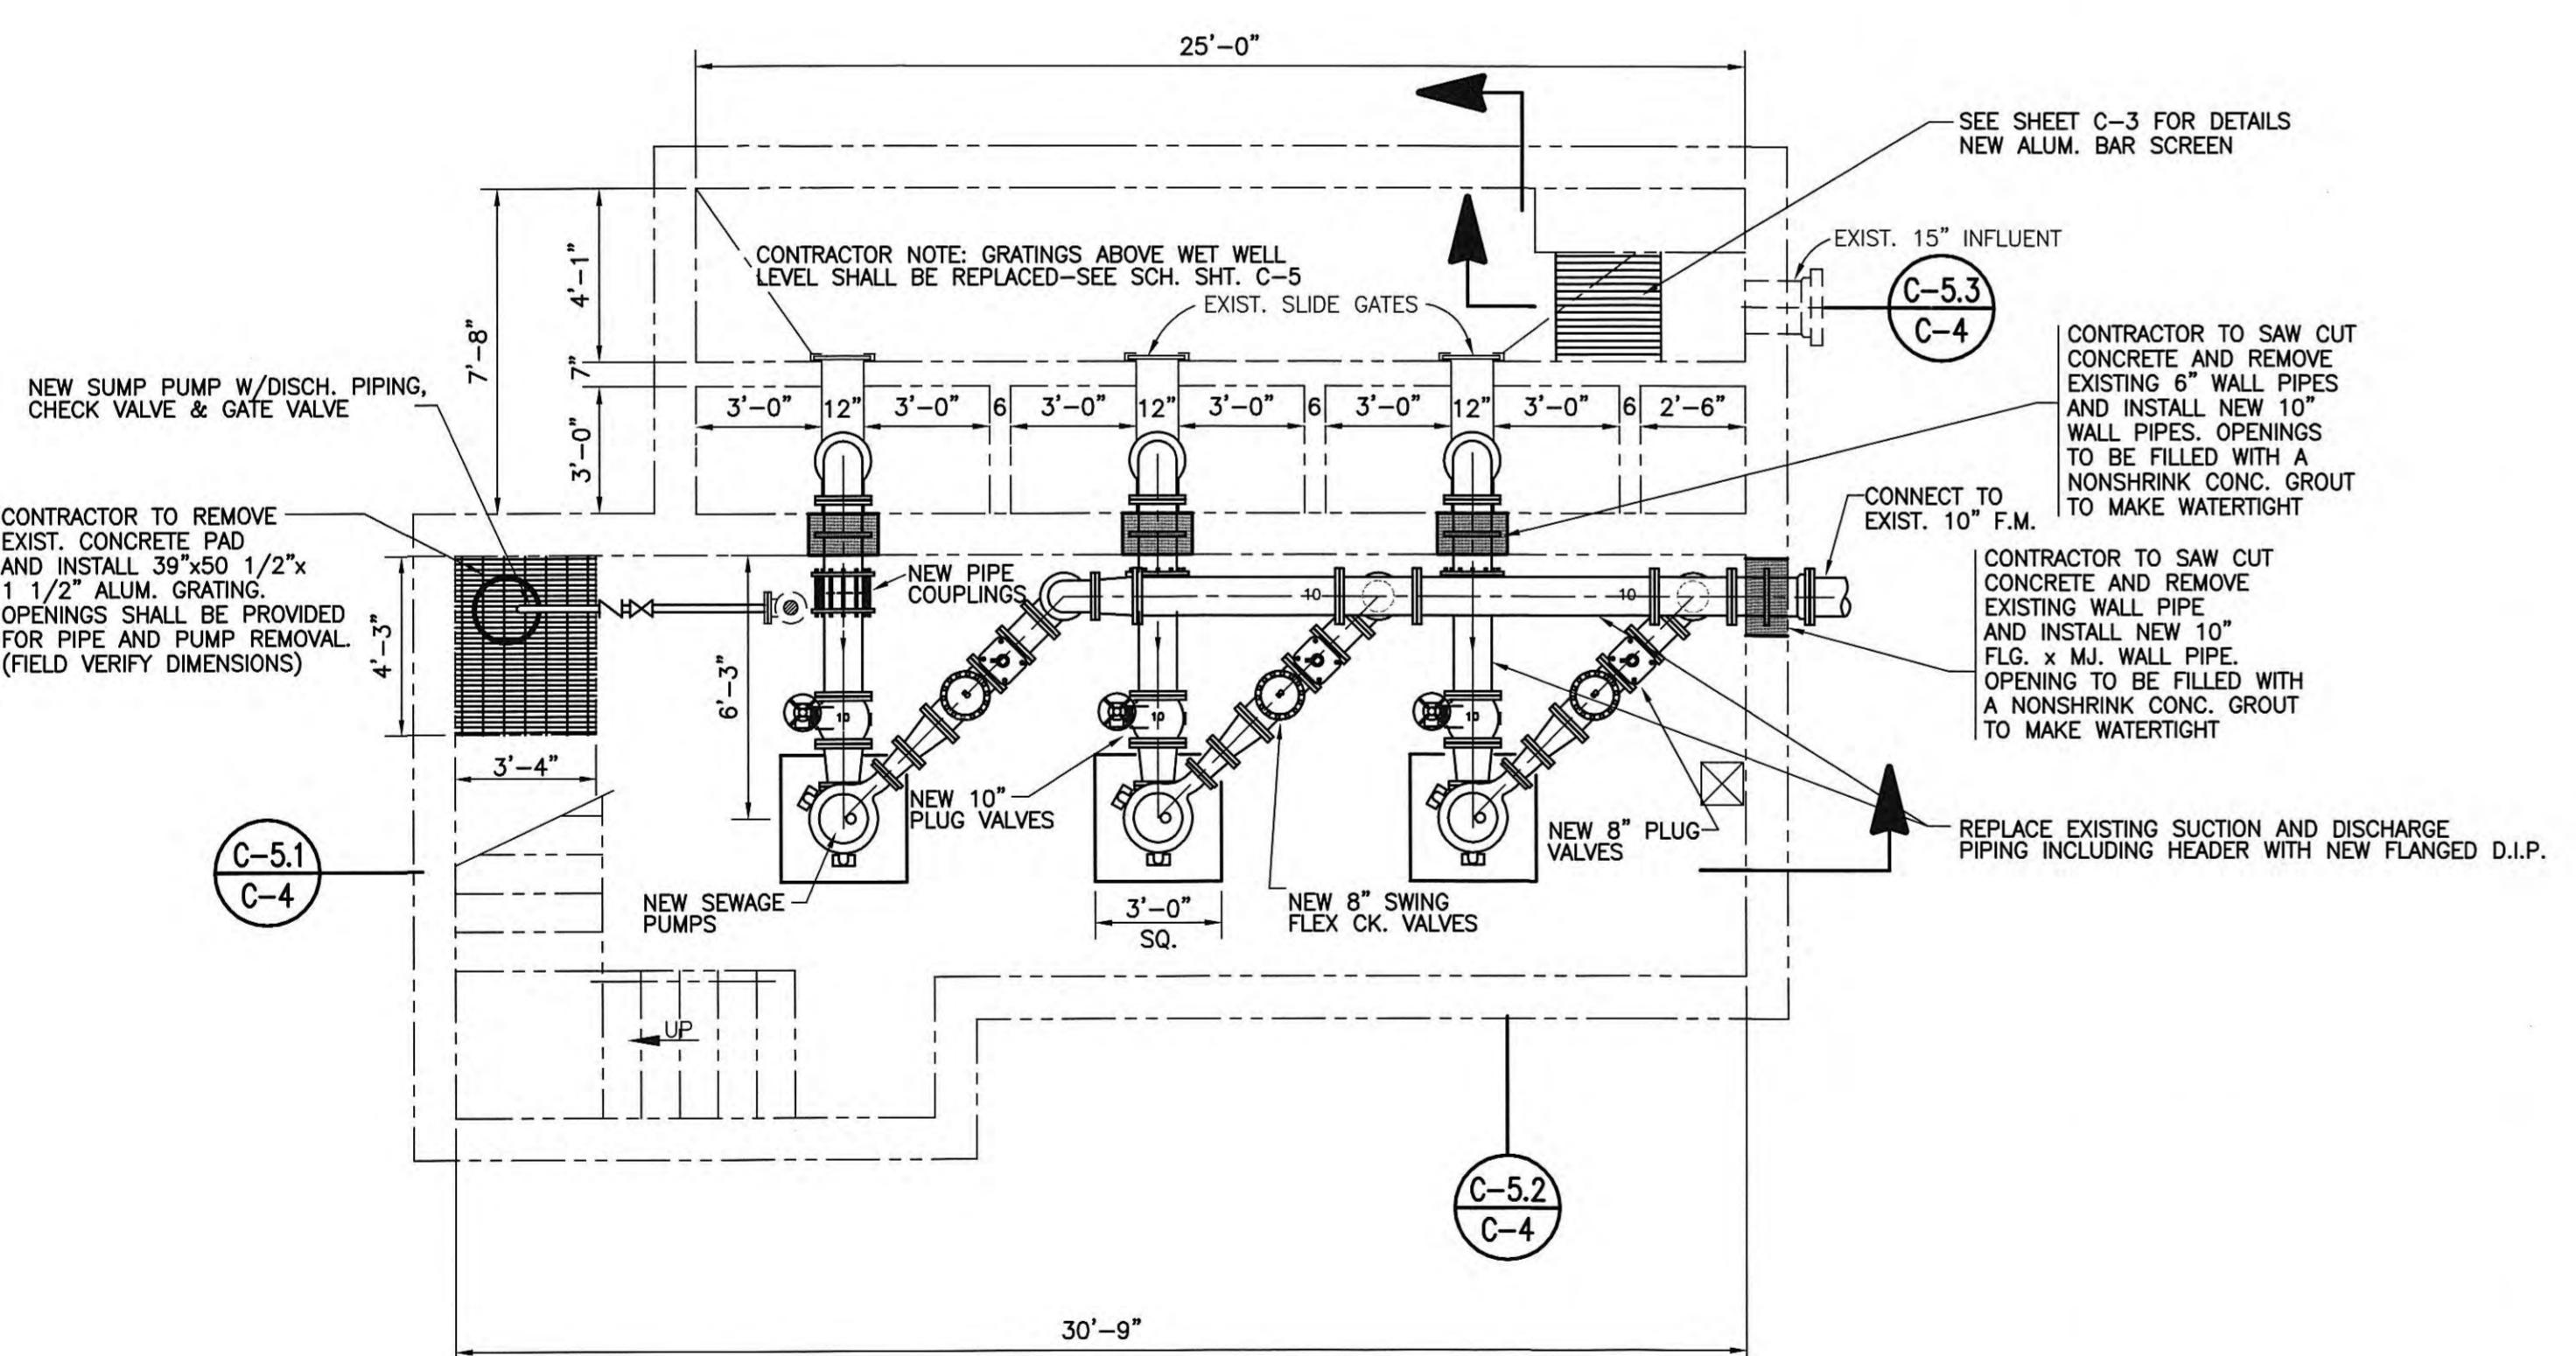

MODIFIED FLOOR PLAN – PUMP LEVEL

SCALE: 1/4" = 1'-0"

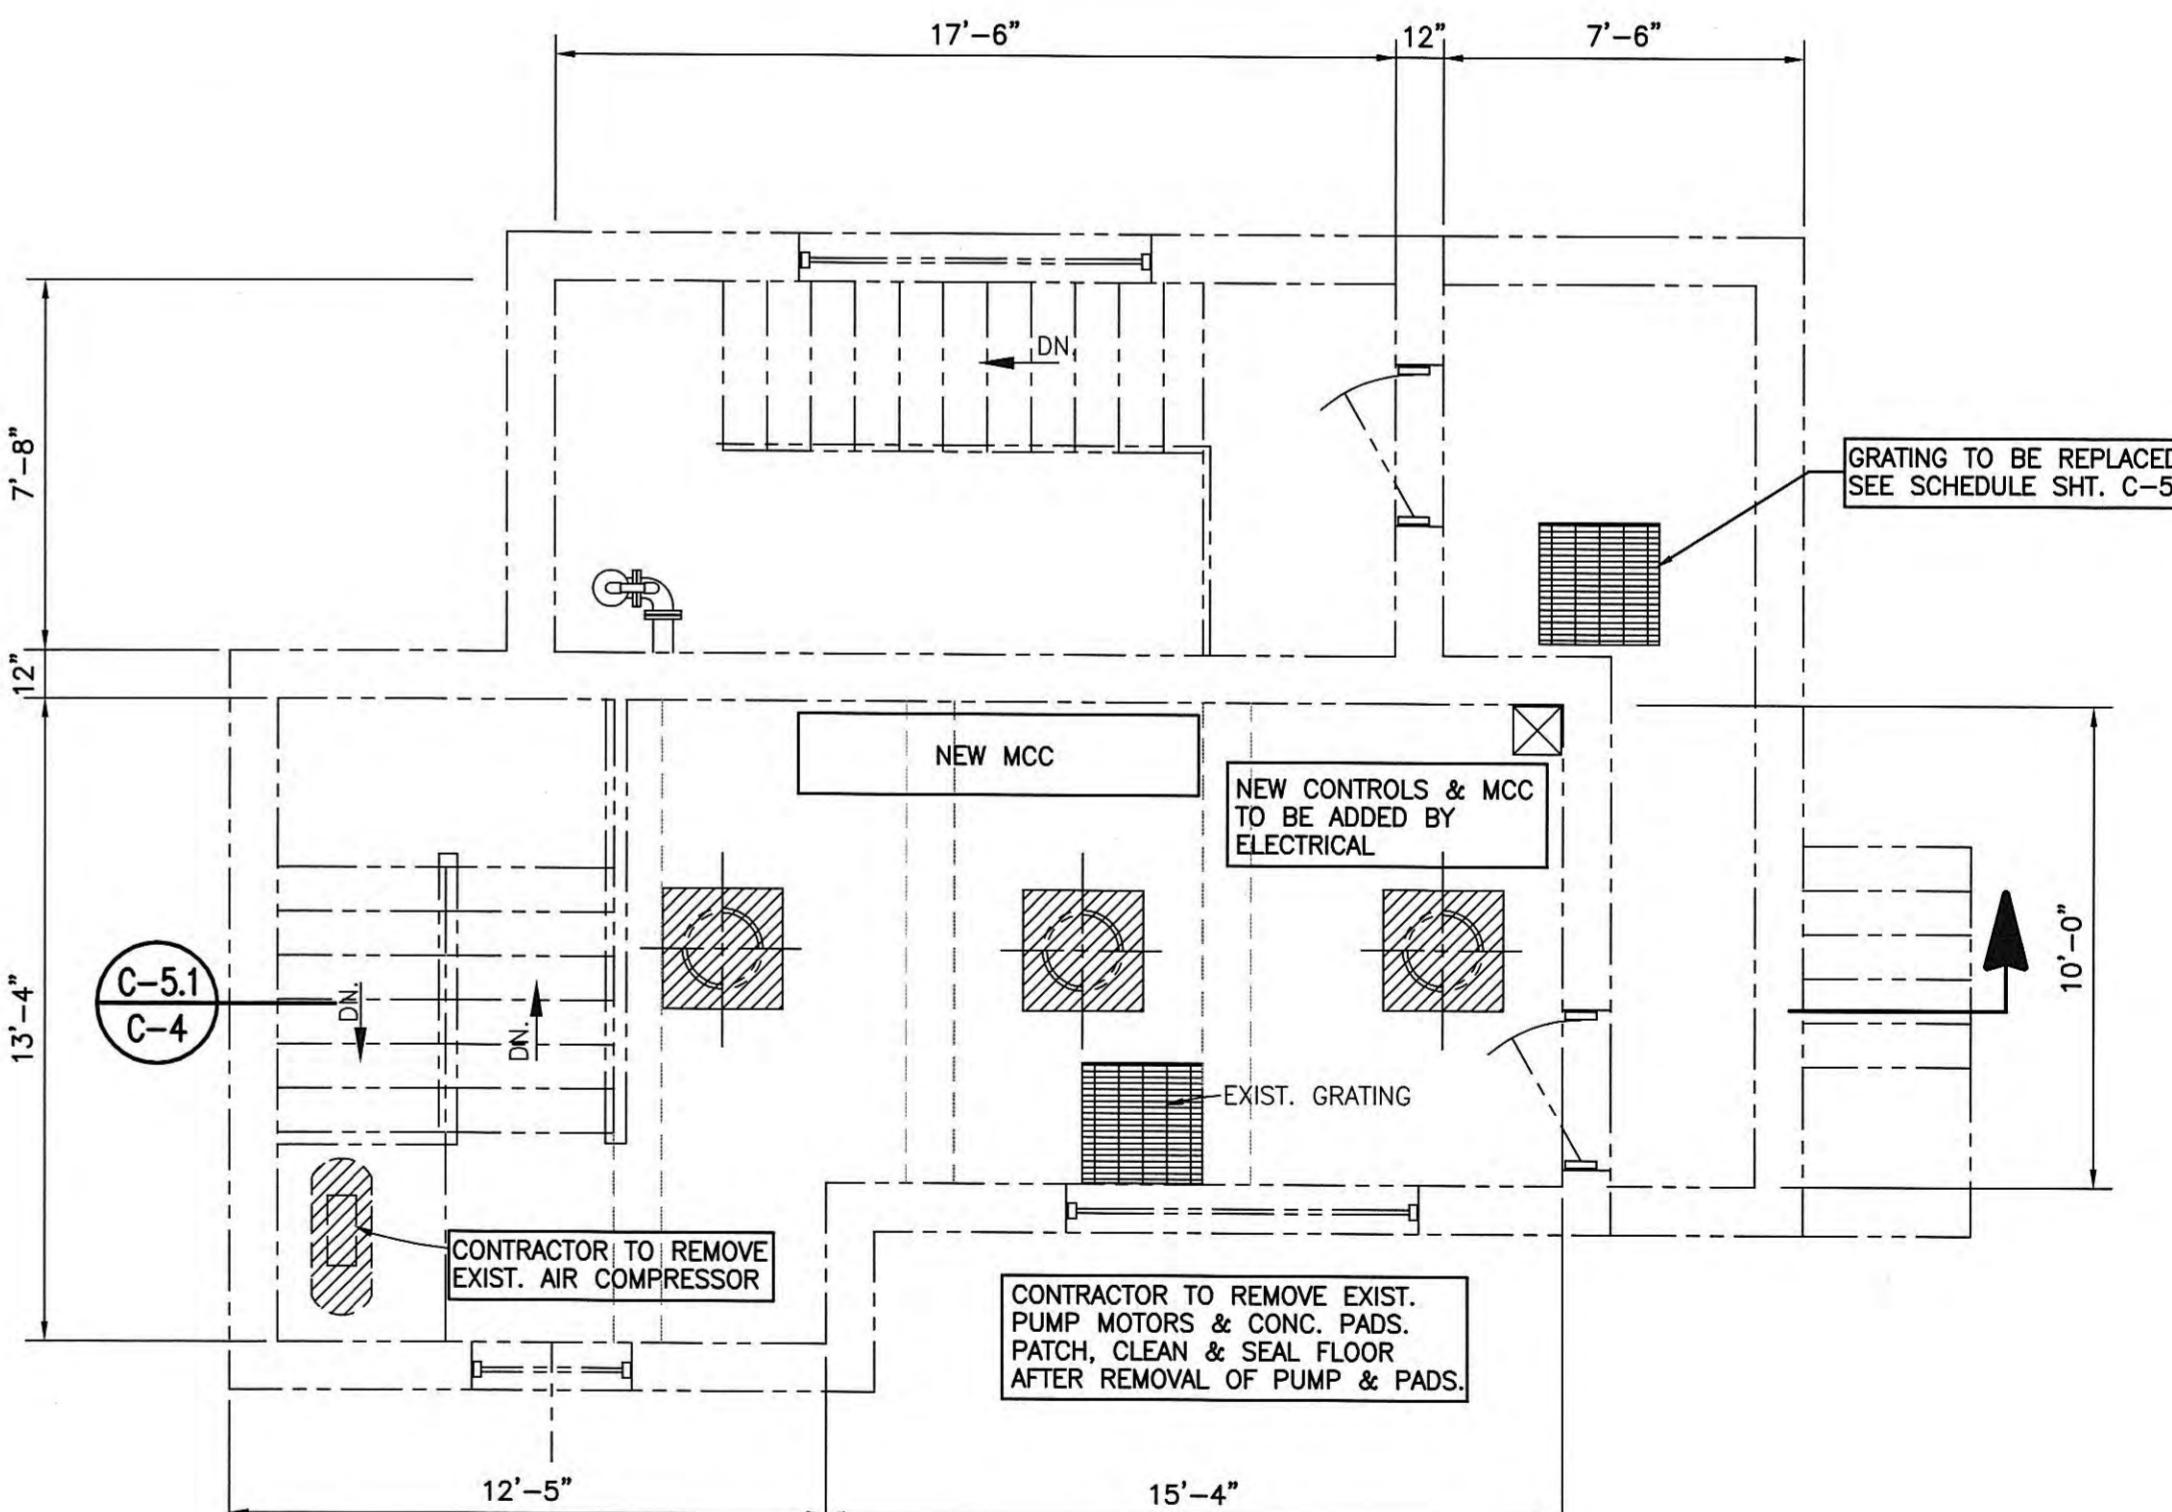

MODIFIED FLOOR PLAN – ENTRANCE LEVEL

SCALE: 1/4" = 1'-0"

RECORD DRAWINGS

ALL RIGHTS RESERVED.
THIS DOCUMENT IS THE PROPERTY OF GRW ERLOD DUNSON, INC. AND SHALL NOT BE REPRODUCED IN WHOLE OR IN PART OR USED FOR CONSTRUCTION OF OTHER THAN THIS SPECIFIC PROJECT WITHOUT WRITTEN PERMISSION OF GRW ERLOD DUNSON, INC.

NO.	DESCRIPTION	DATE	BY
REVISIONS			

Engineer's Representative: *S. Brooks* / Date: *6/2002*


NO.	DESCRIPTION	DATE	BY
REVISIONS			

GRW PROJECT NO. 7601-30 CONTRACT NO. S02-03

EXISTING WOODY ST. SEWAGE PUMP STATION PLAN VIEWS
HARRIMAN UTILITY BOARD
HARRIMAN, TENNESSEE

GRW ERLOD DUNSON, INC.
Engineers, Architects, Planners
LEXINGTON LOUISVILLE INDIANAPOLIS
NASHVILLE KNOXVILLE


DESIGNED: RGT/NDW	DATE: NOVEMBER, 2002
DRAWN: DGR	SCALE: AS NOTED
REVIEWED: NDW	SHEET NO.:
APPROVED: RGT	C-4

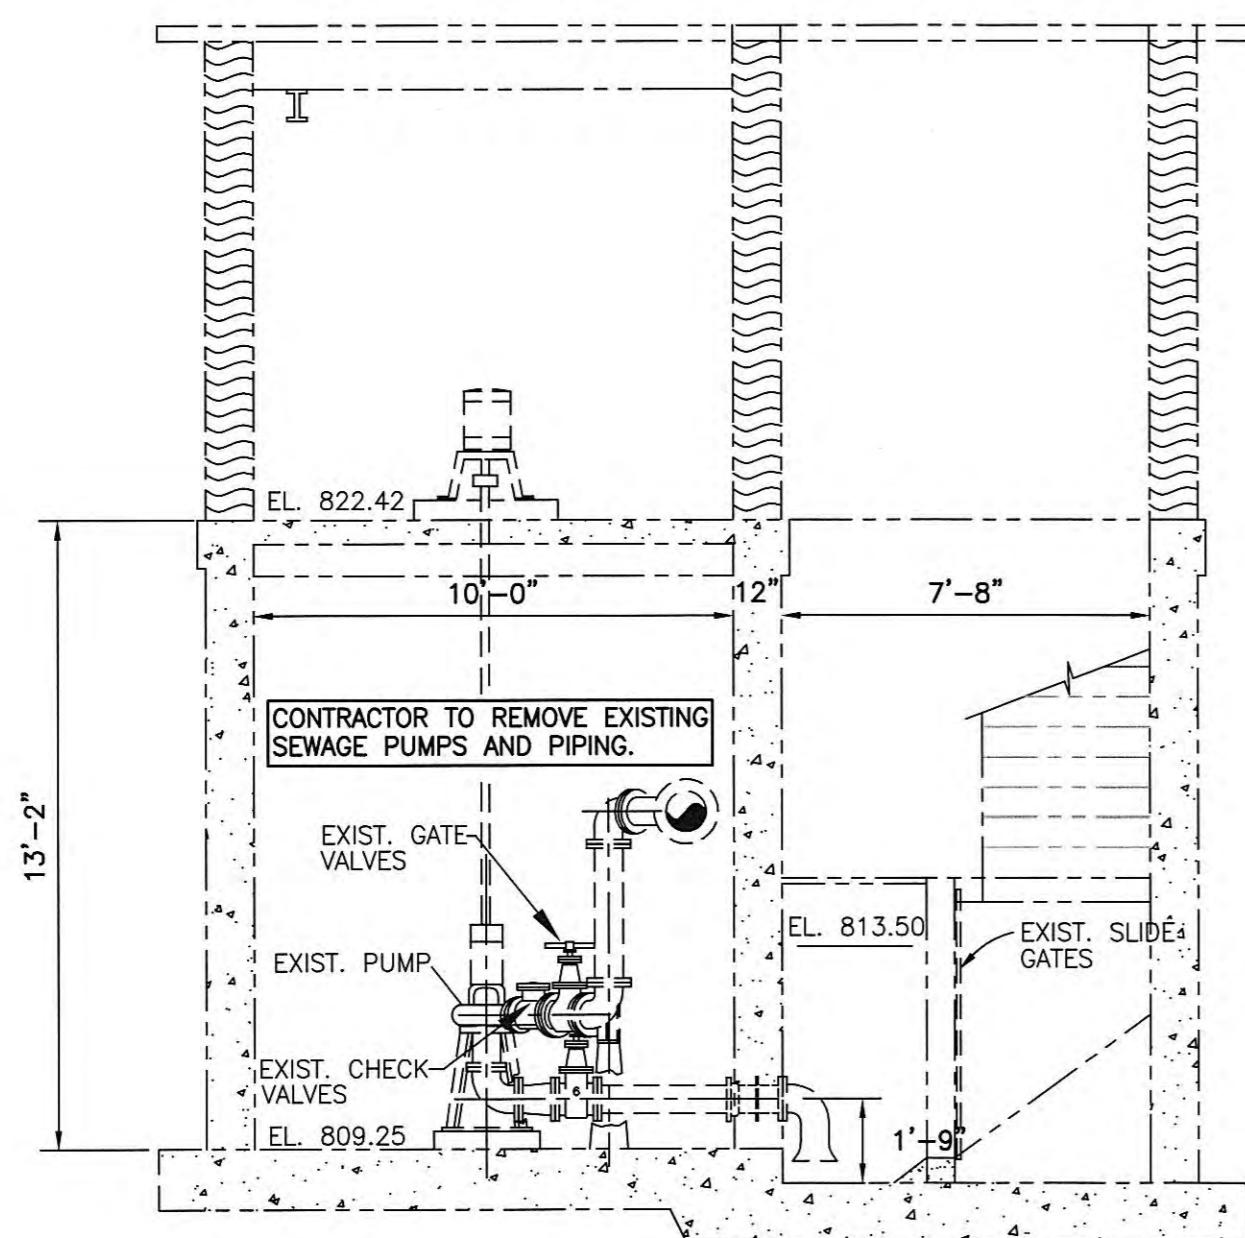


EXISTING CONDITIONS—SECTION

SCALE: $1/4"$ = $1'-0"$

C-5.2
C-4

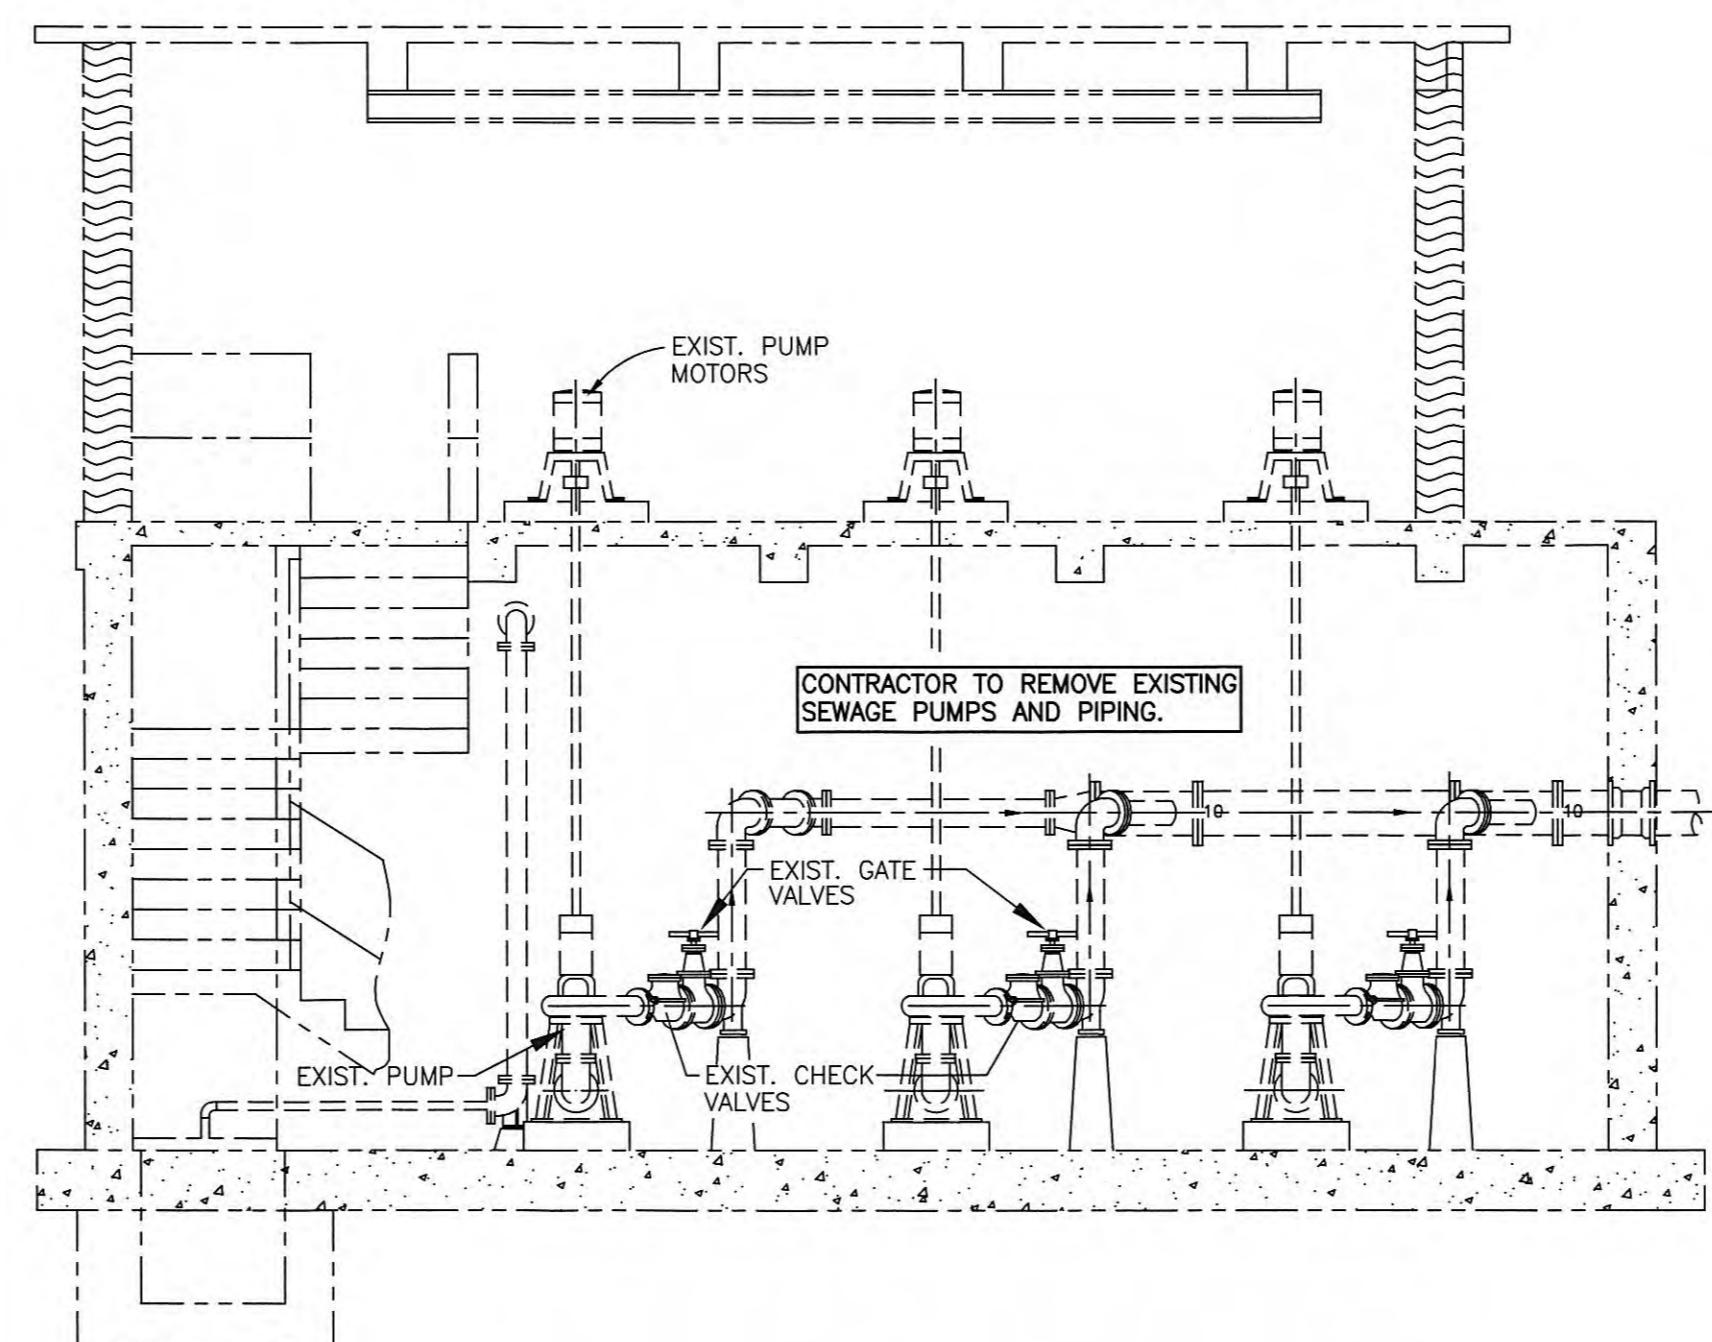

EXISTING CONDITIONS–SECTION

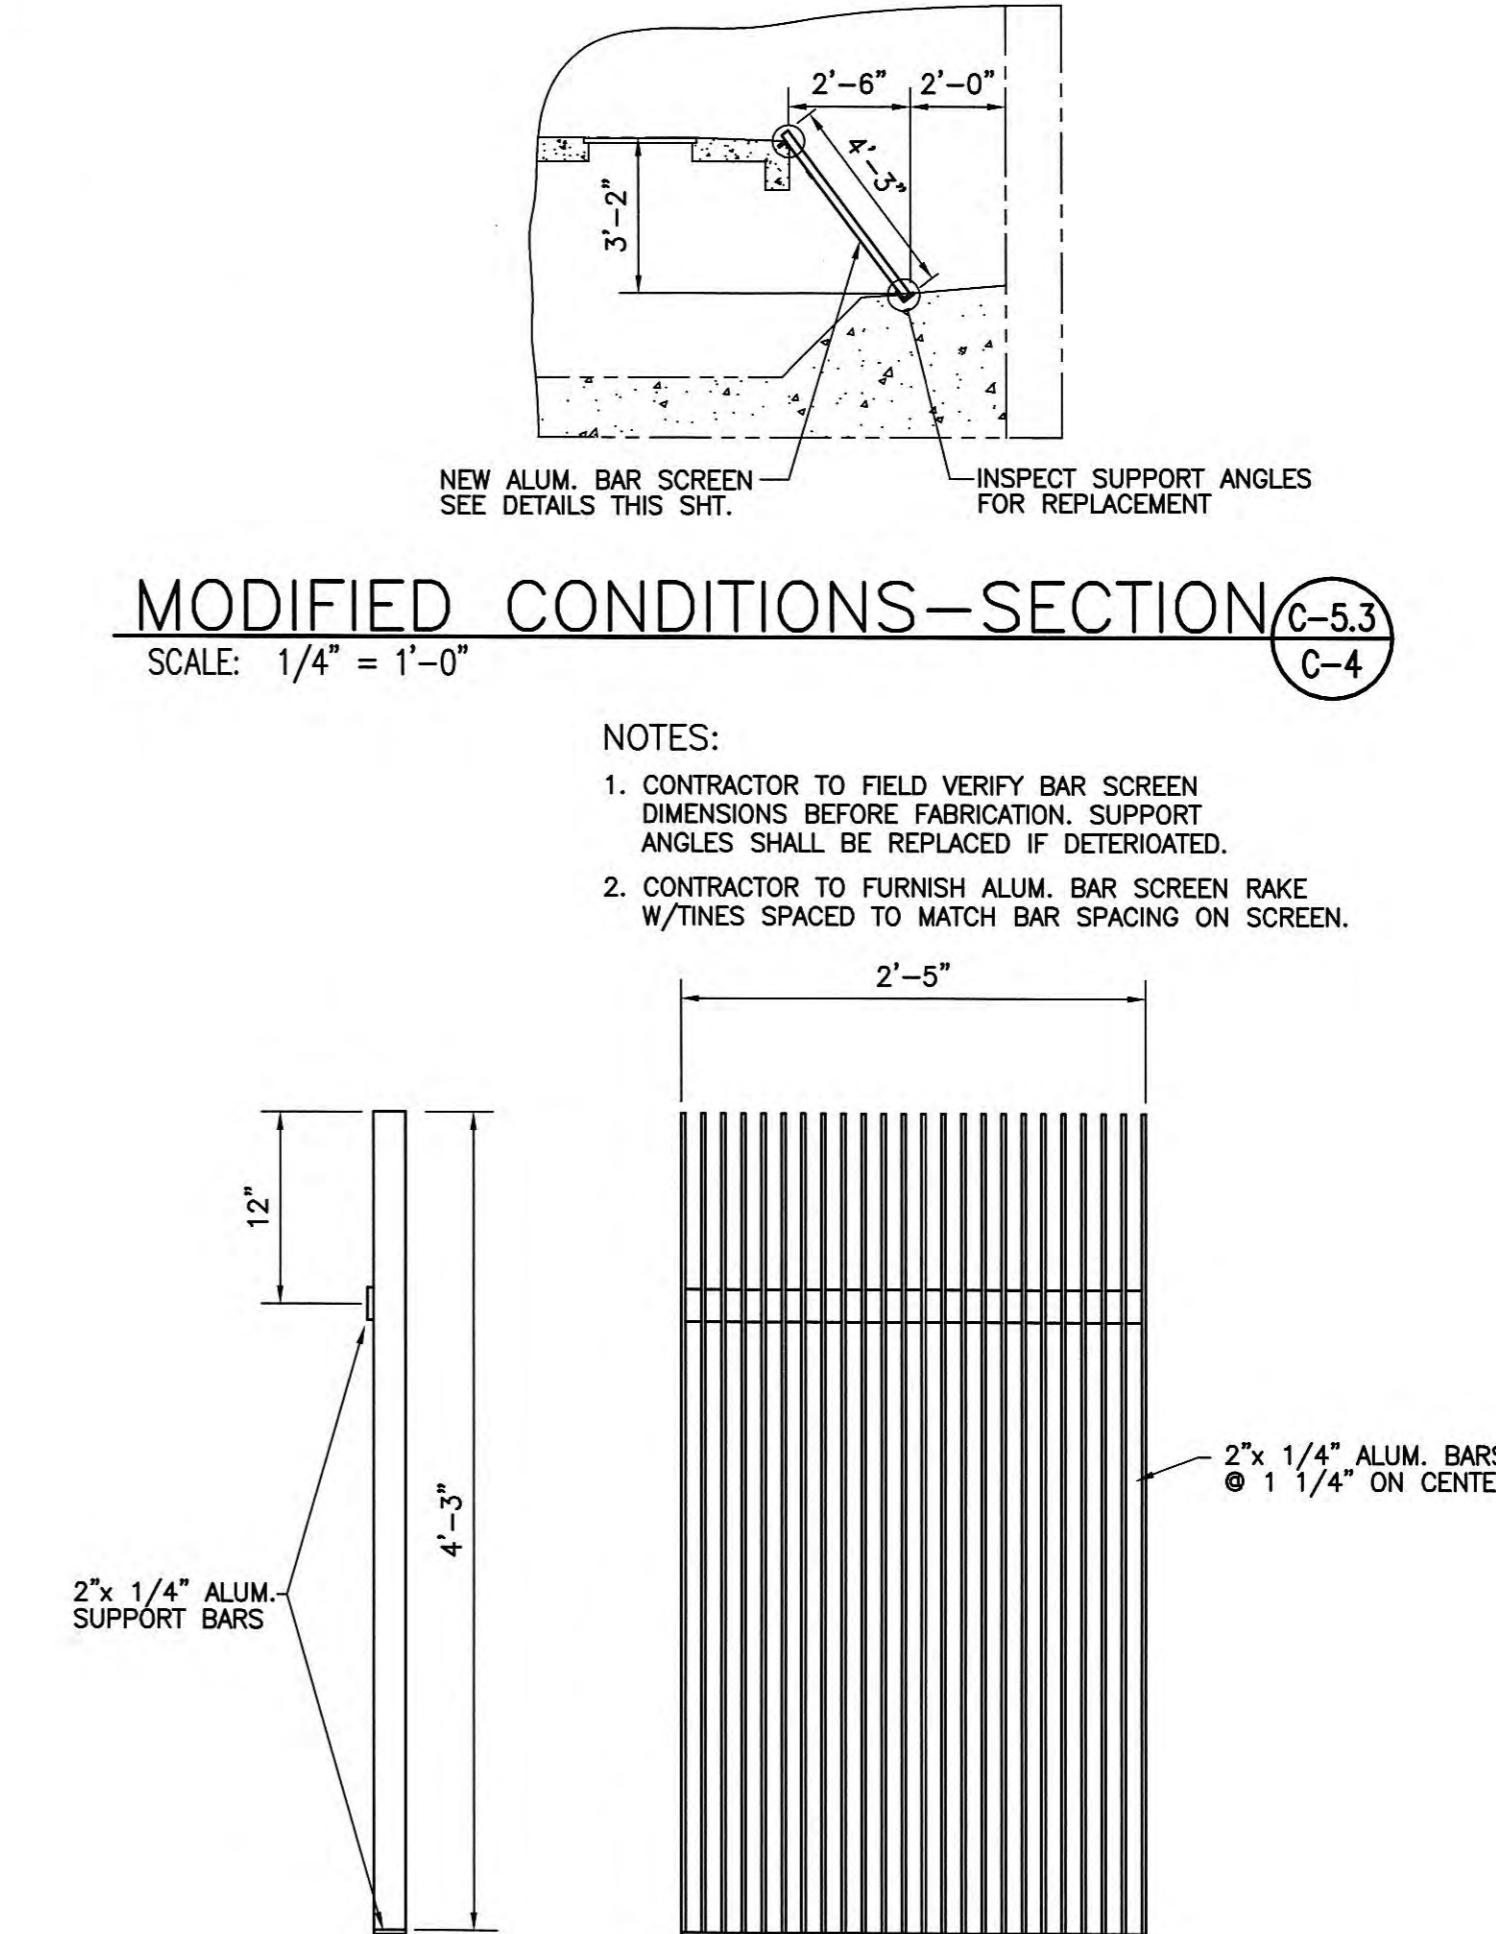


MODIFIED CONDITIONS—SECTION


NEW ALUM. BAR SCREEN — SEE DETAILS THIS SHT. INSPECT SUPPORT ANGLES FOR REPLACEMENT

NOTES:


1. CONTRACTOR TO FIELD VERIFY BAR SCREEN DIMENSIONS BEFORE FABRICATION. SUPPORT ANGLES SHALL BE REPLACED IF DETERIORATED.
2. CONTRACTOR TO FURNISH ALUM. BAR SCREEN RAKE W/TINES SPACED TO MATCH BAR SPACING ON SCREEN.

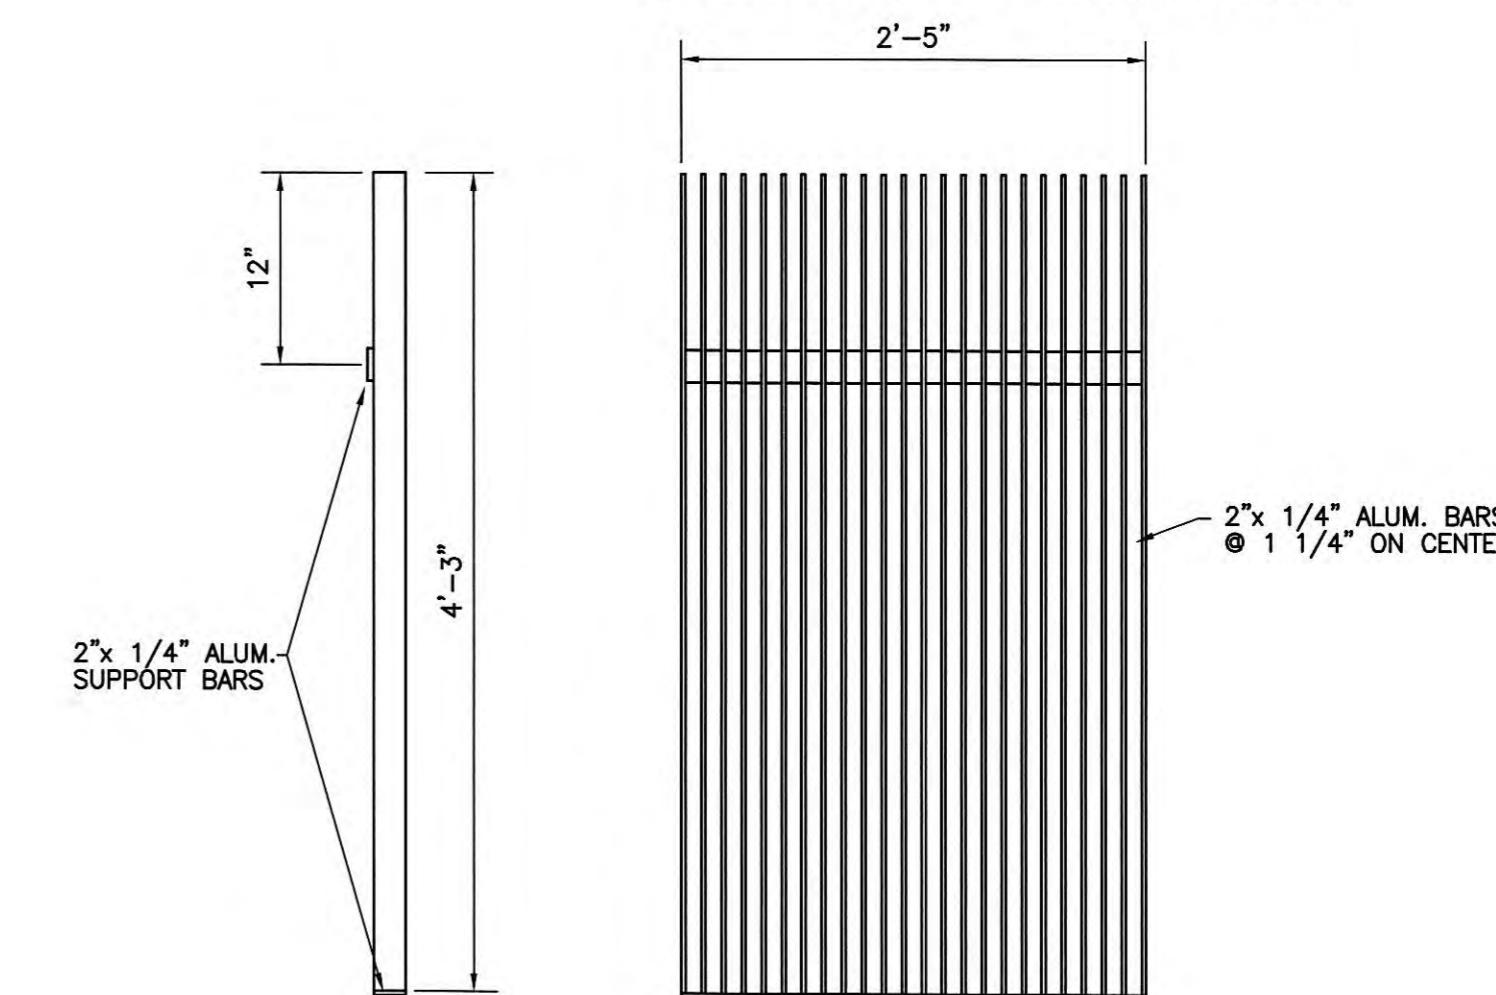


MANUAL BAR SCREEN DETAIL

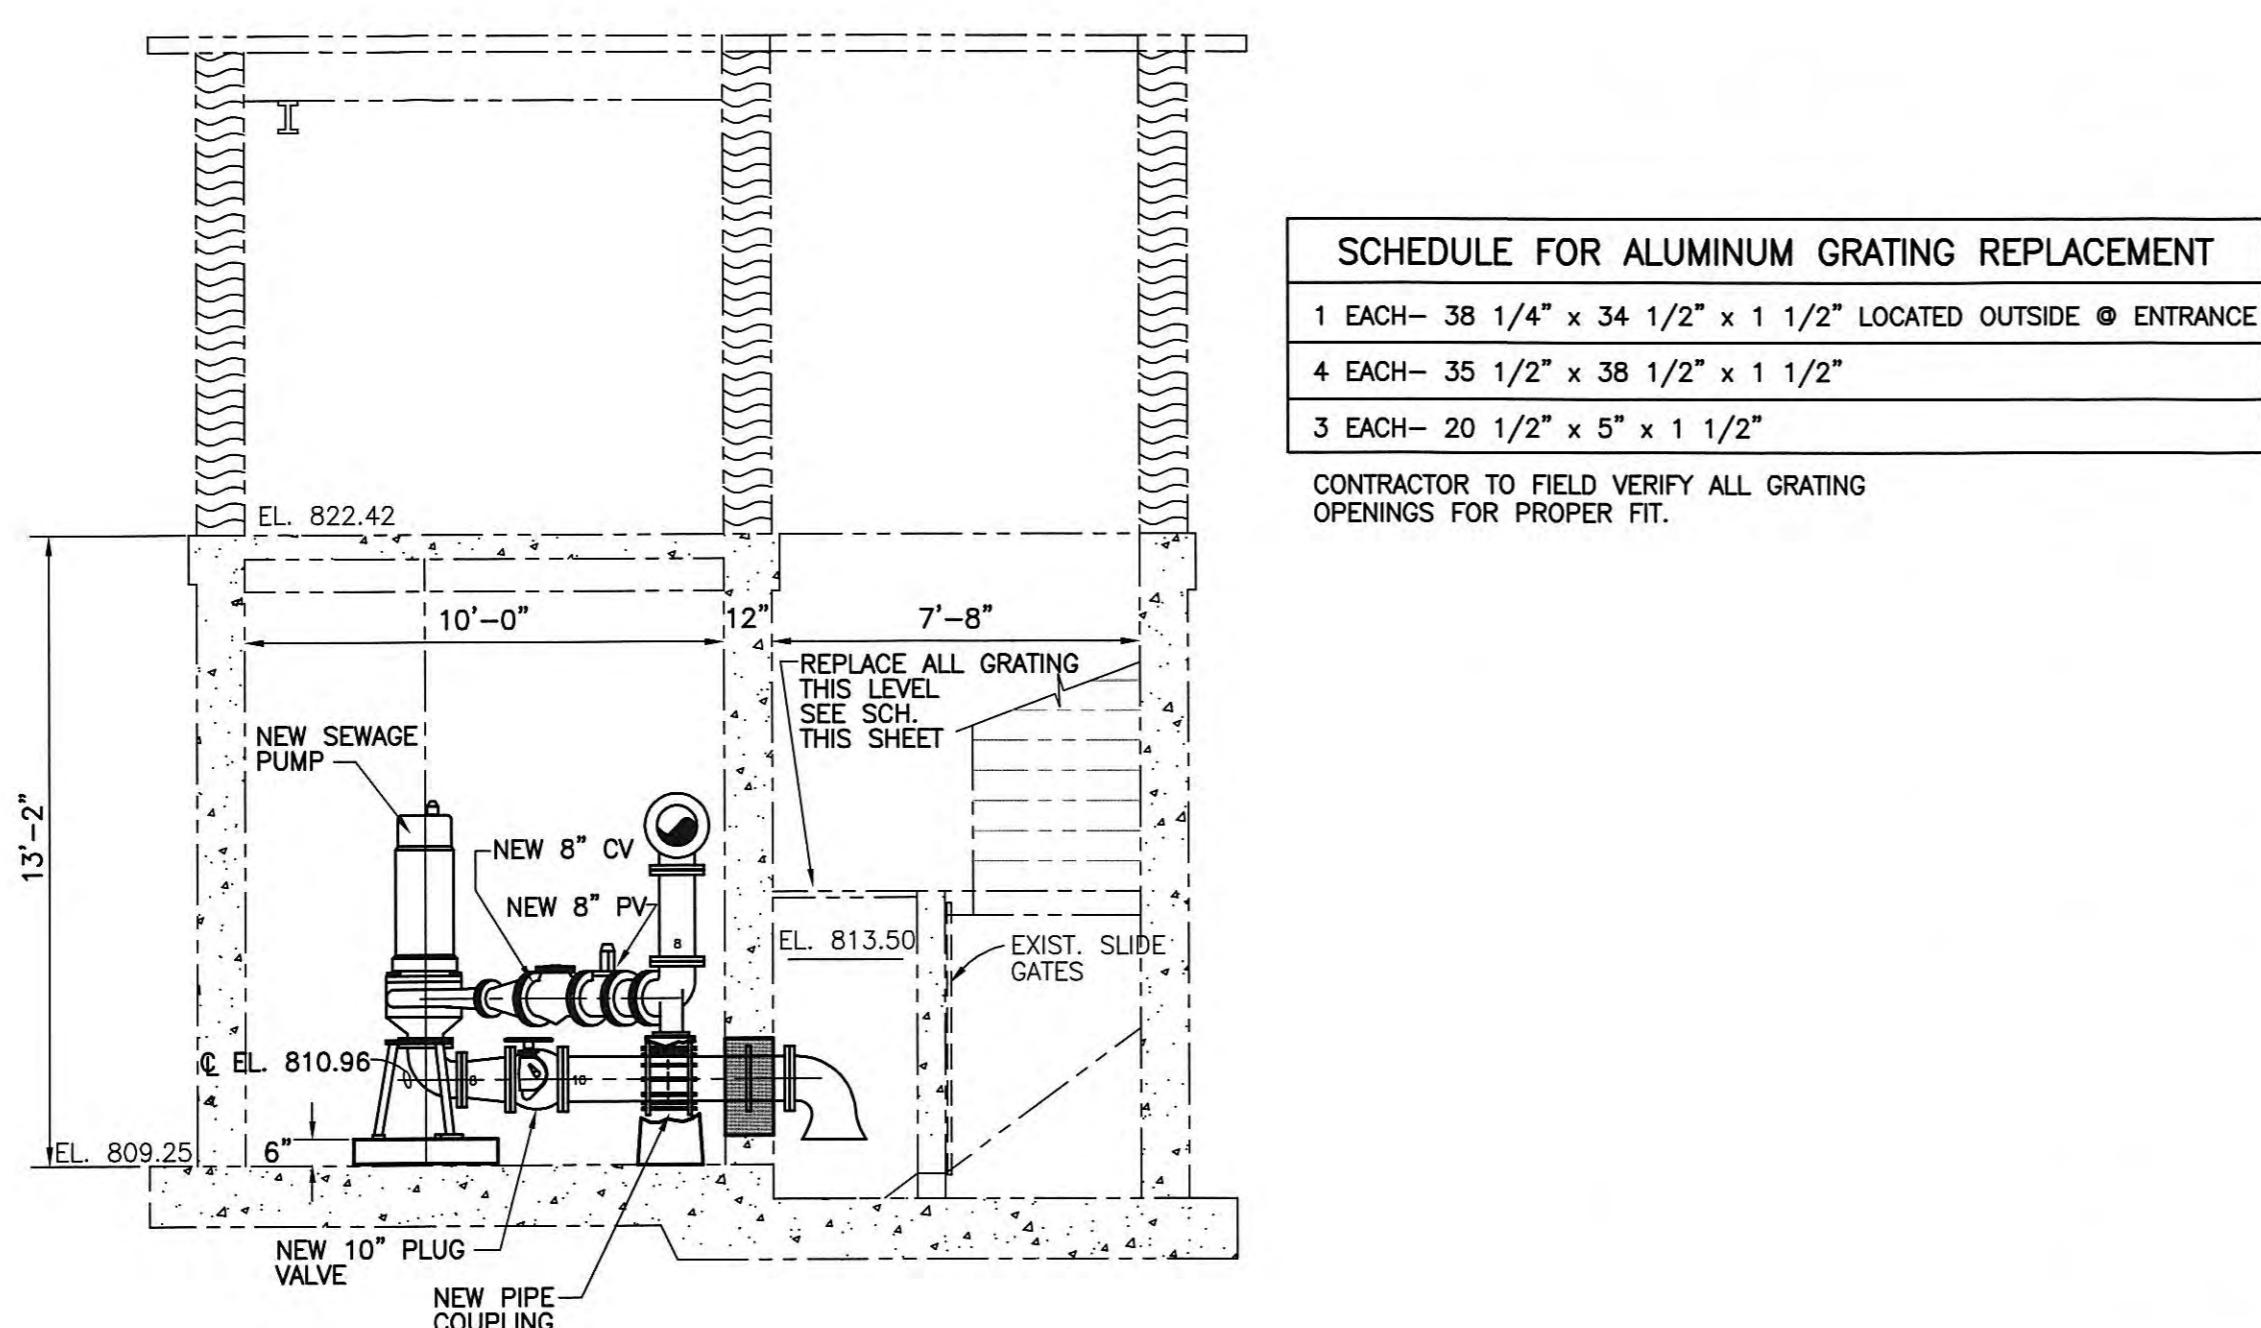

MODIFIED CONDITIONS—SECTION

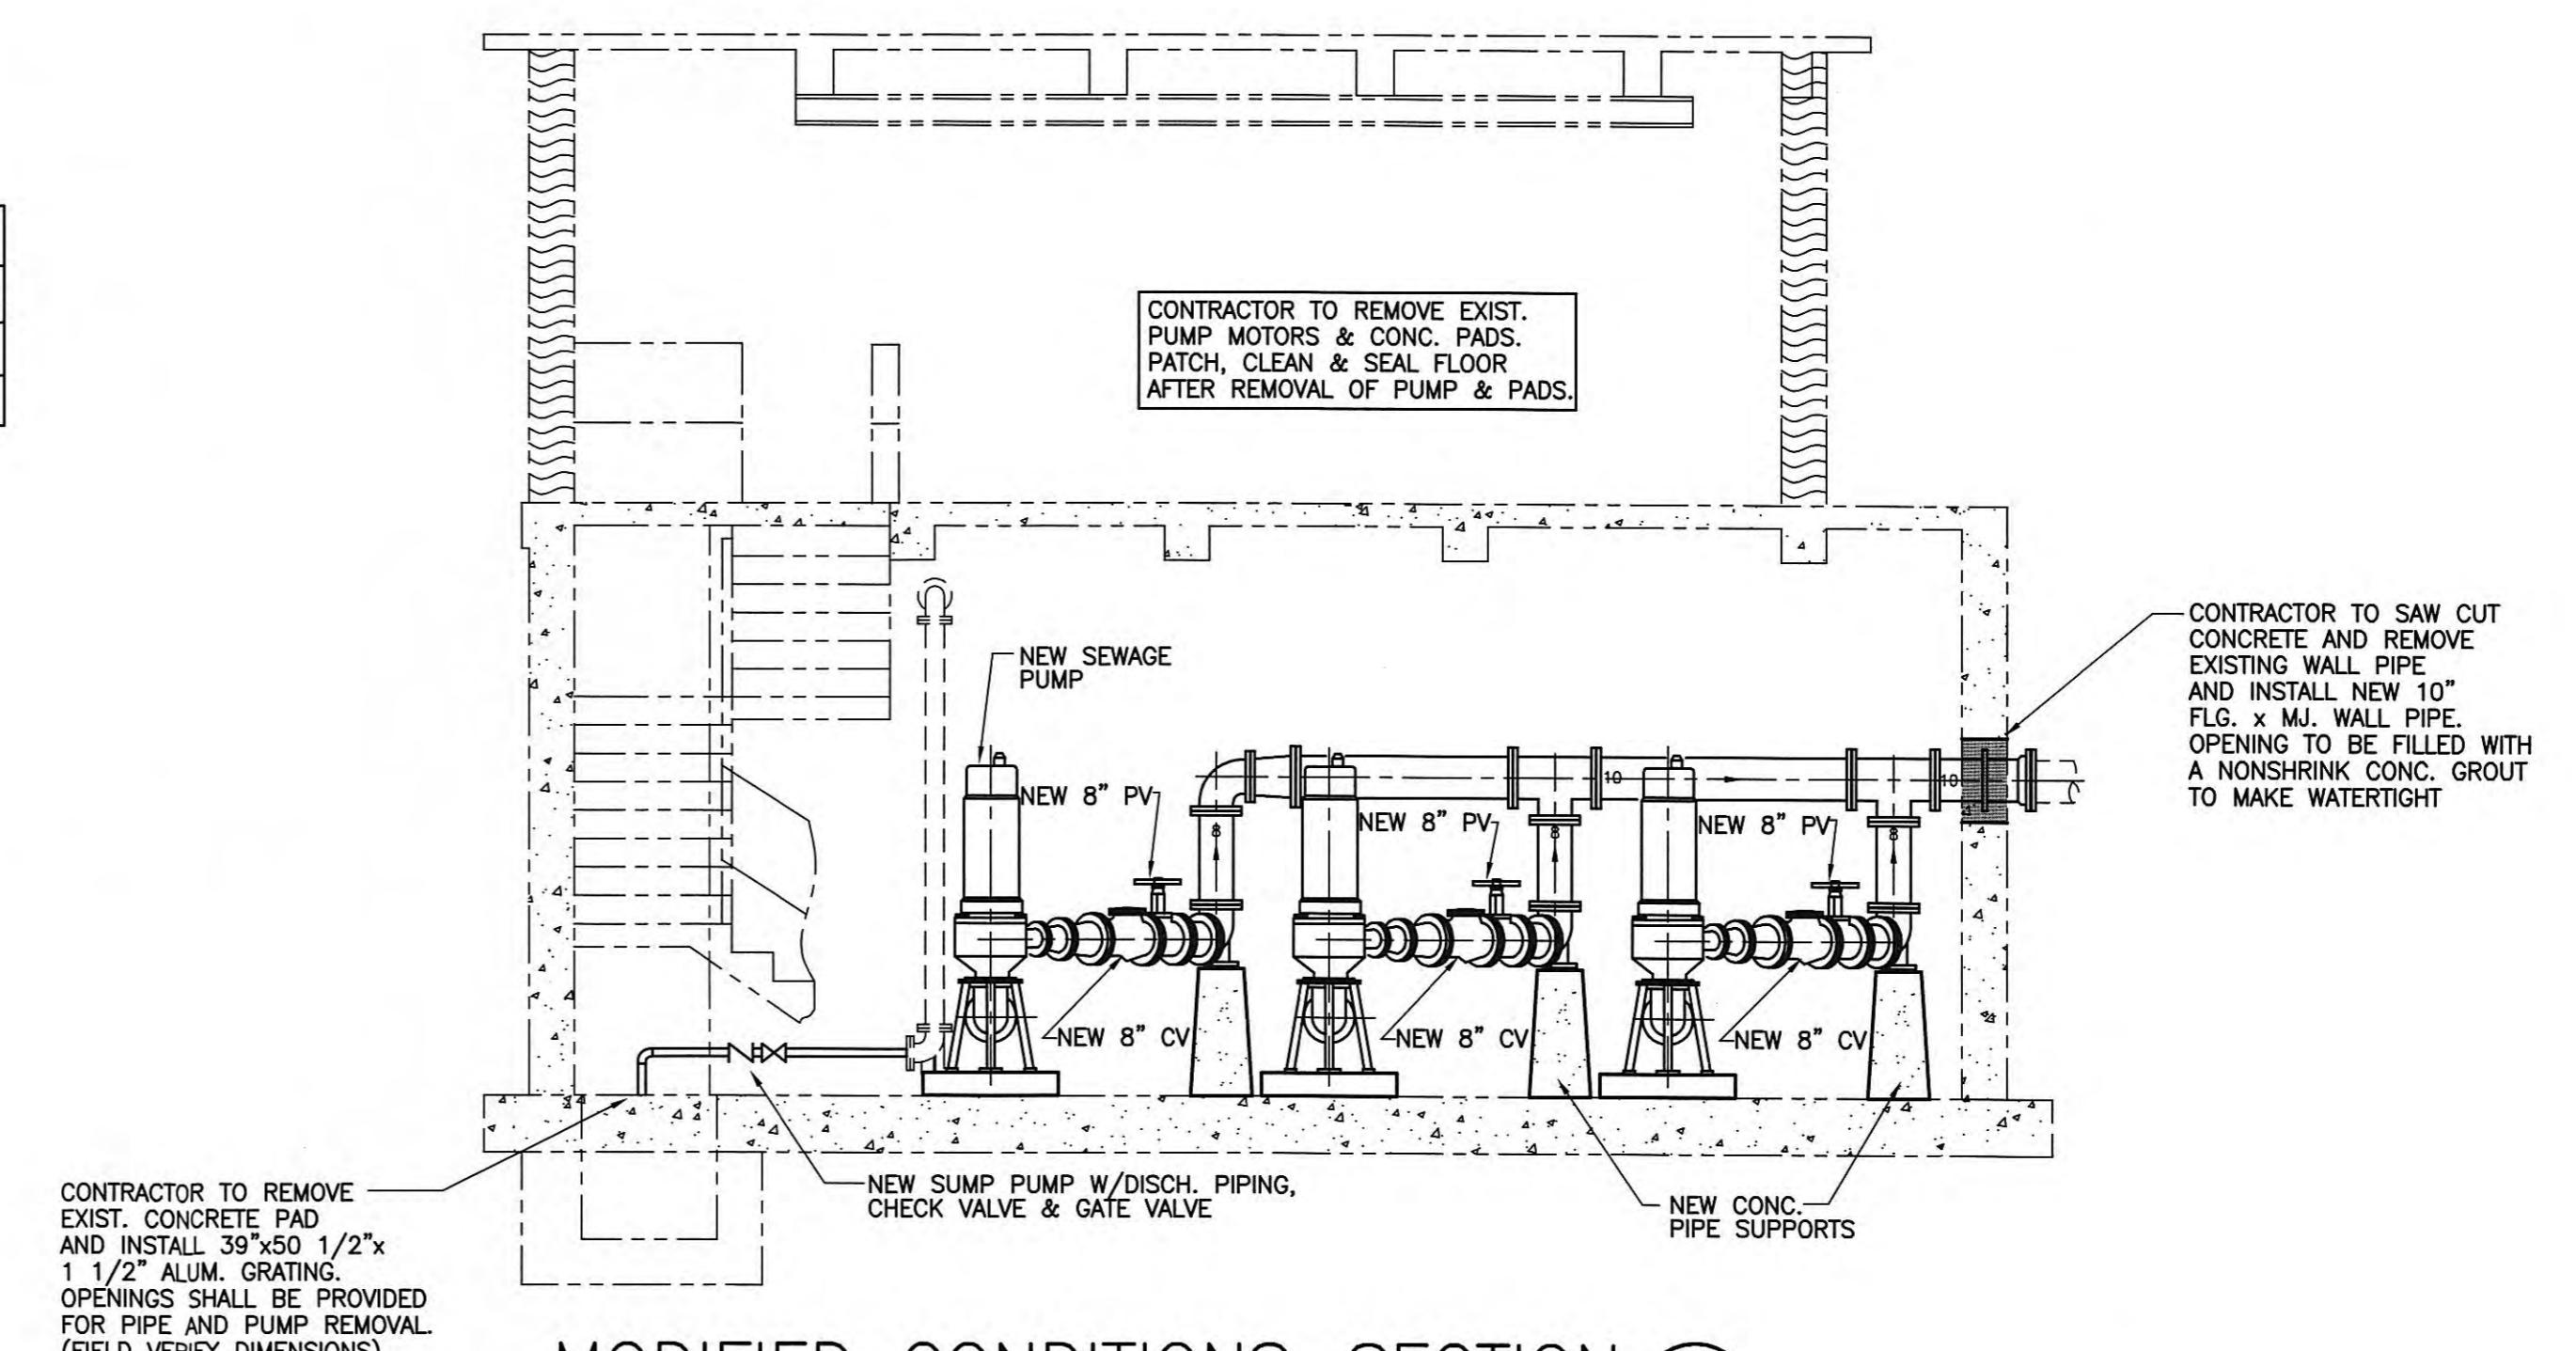

MODIFIED CONDITIONS–SECTION

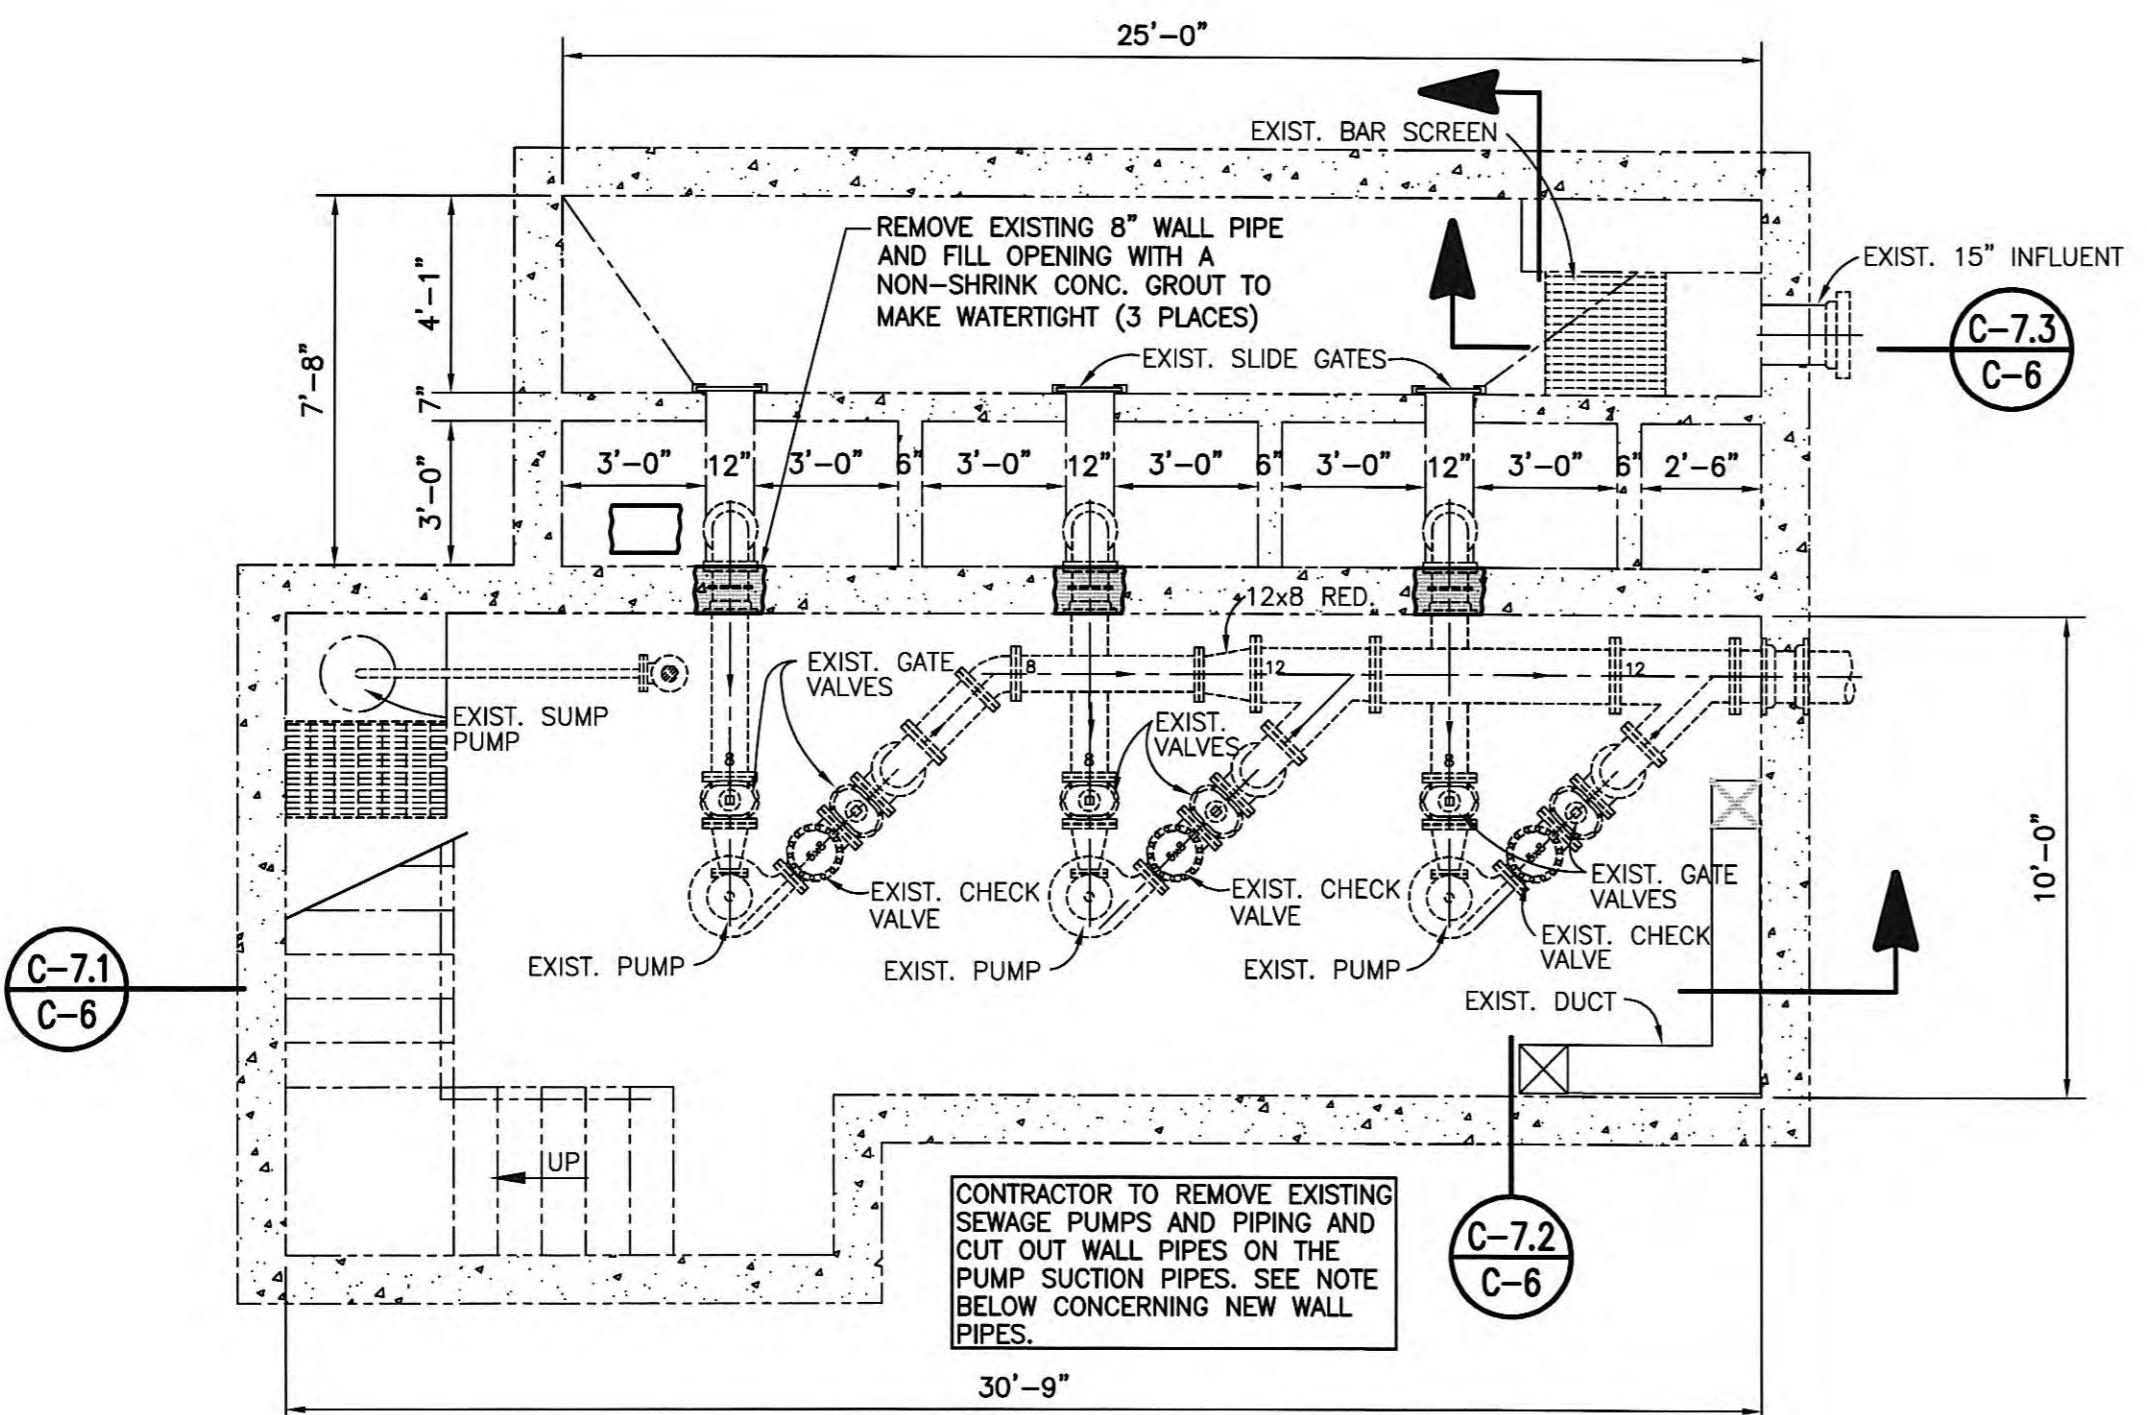


EXISTING FLOOR PLAN – PUMP LEVEL

SCALE: 1/4" = 1'-0"


CONTRACTOR NOTES:

1. CONTRACTOR SHALL BE RESPONSIBLE FOR BYPASS PUMPING WHILE REHABILITATING PUMP STATION. THIS INCLUDES ANY REQUIRED CONNECTIONS TO INFLUENT AND DISCHARGE LINES. HUB WILL PROVIDE THE REQUIRED ELECTRICAL SERVICE FOR BYPASS PUMPING.
2. THE OWNER SHALL HAVE FIRST SALVAGE RIGHTS TO ALL EXISTING VALVES, PIPING AND EQUIPMENT. IF THE OWNER REJECTS SALVAGED MATERIALS, THE CONTRACTOR SHALL PROVIDE FINAL DISPOSAL OF ALL ITEMS.
3. CONTRACTOR TO CLEAN AND PAINT PIPING AND WALLS. WALLS INCLUDE ENTRANCE LEVEL: ELECTRICAL AREA AND PUMP LEVEL: PUMP AND PIPING AREA.
4. CONTRACTOR TO PRESSURE WASH AND CLEAN WETWELL AND SUMP OF EACH PUMP.

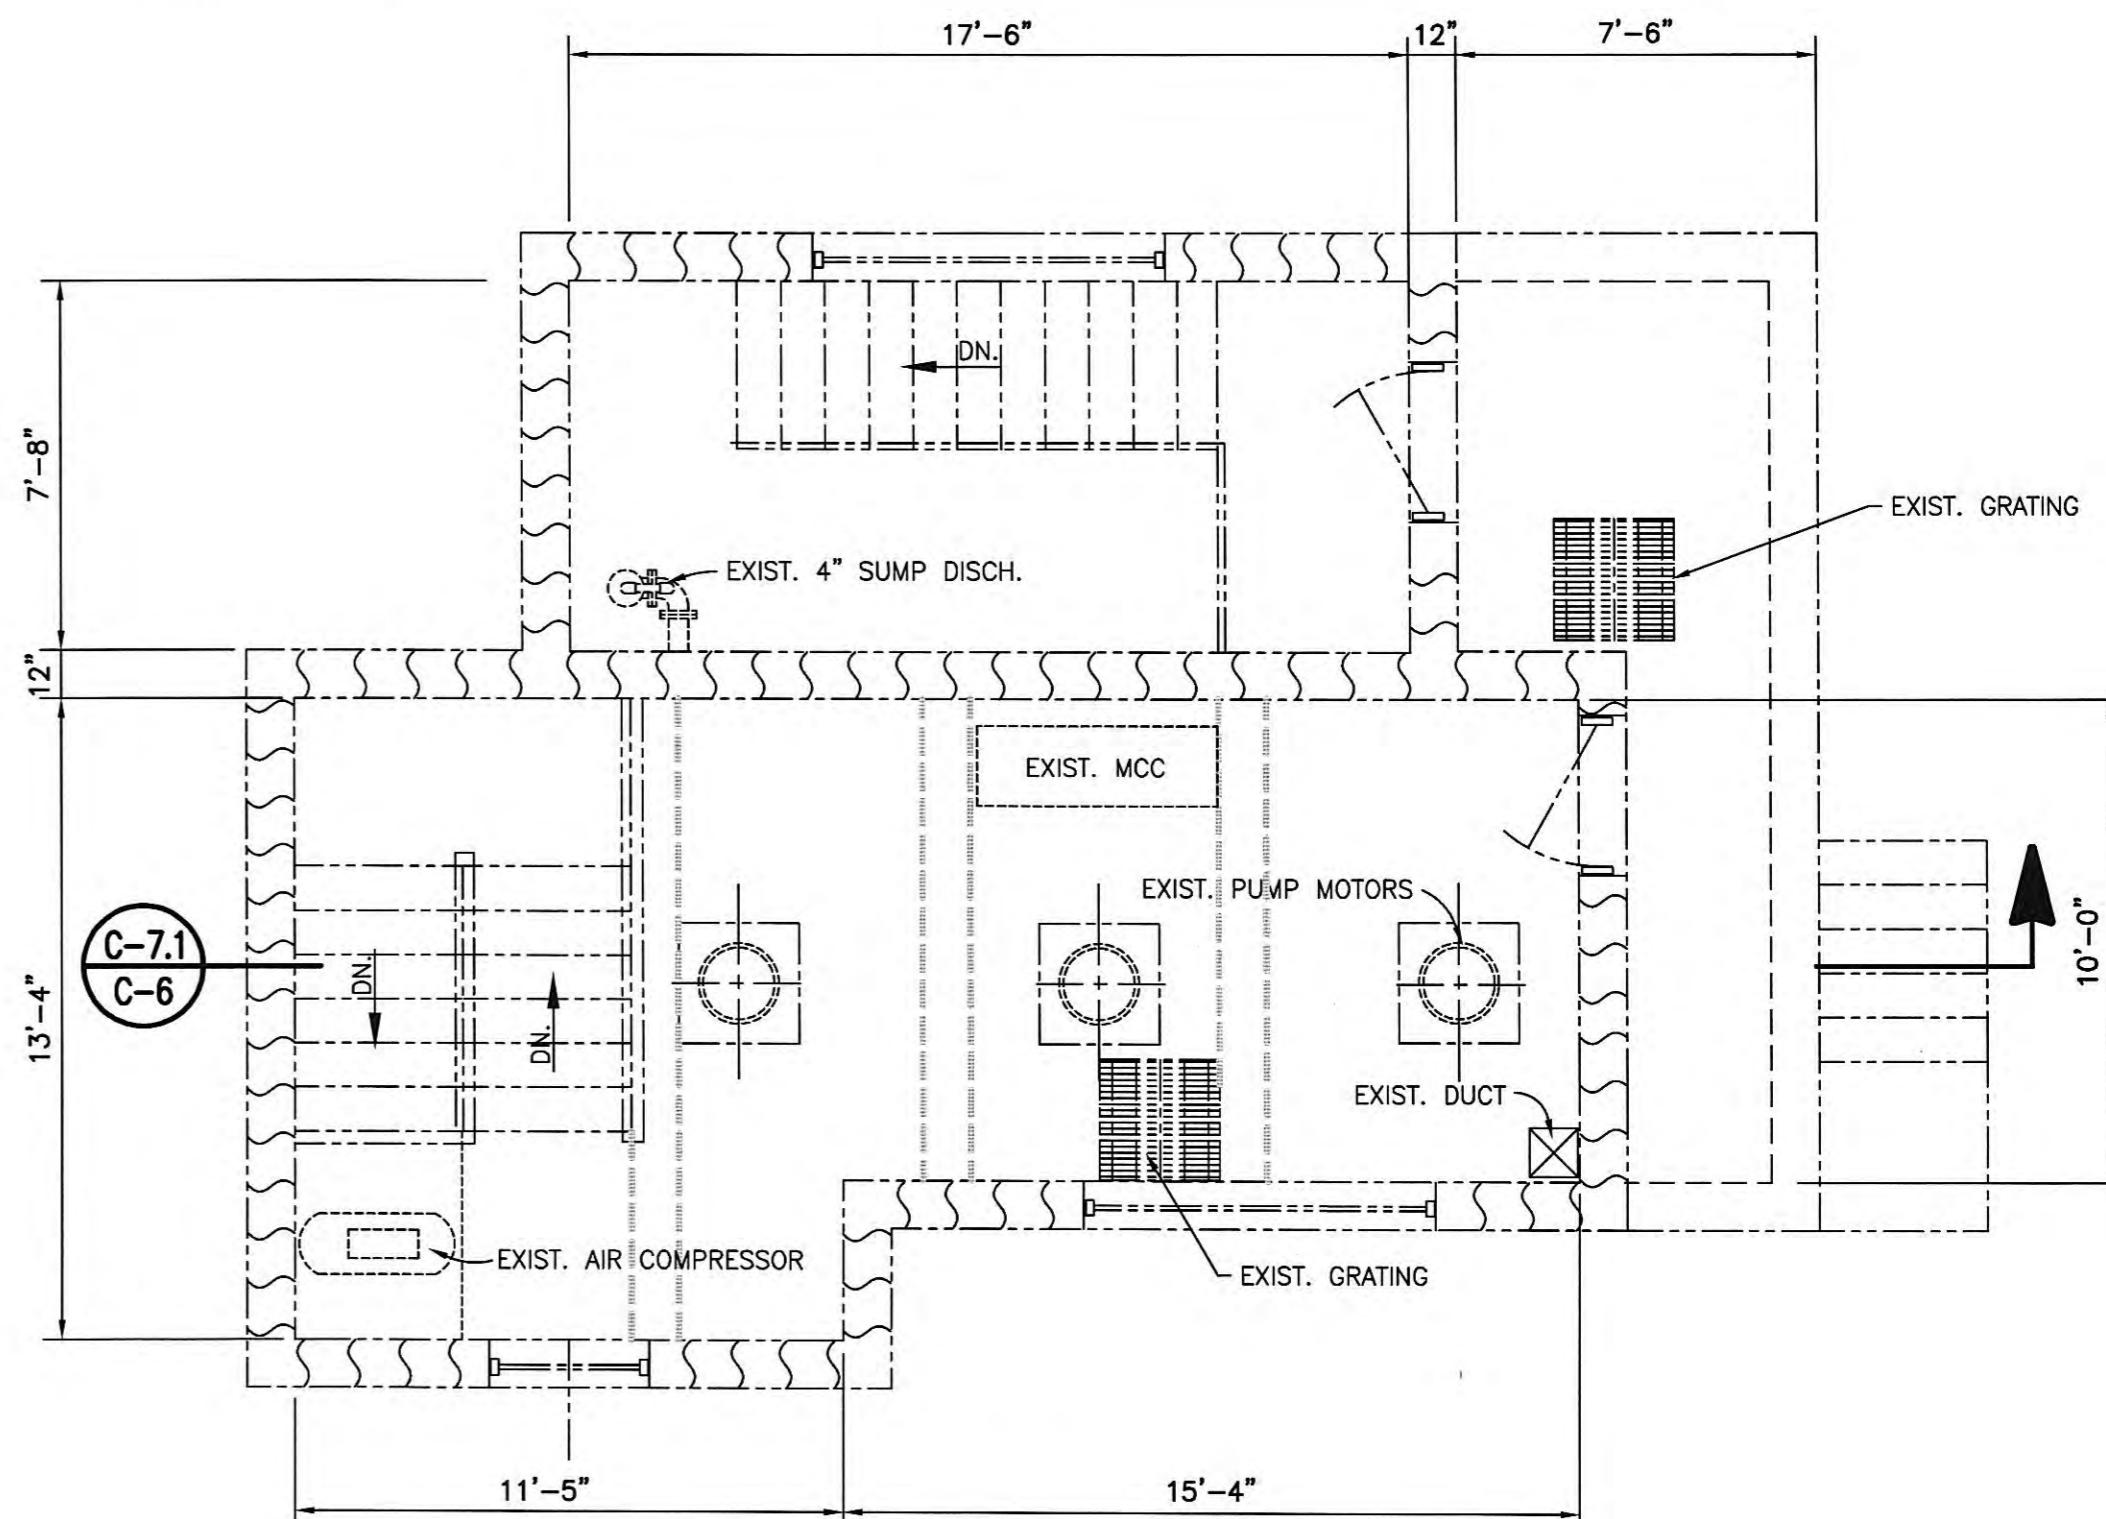


EXISTING FLOOR PLAN – ENTRANCE LEVEL

SCALE: 1/4" = 1'-0"

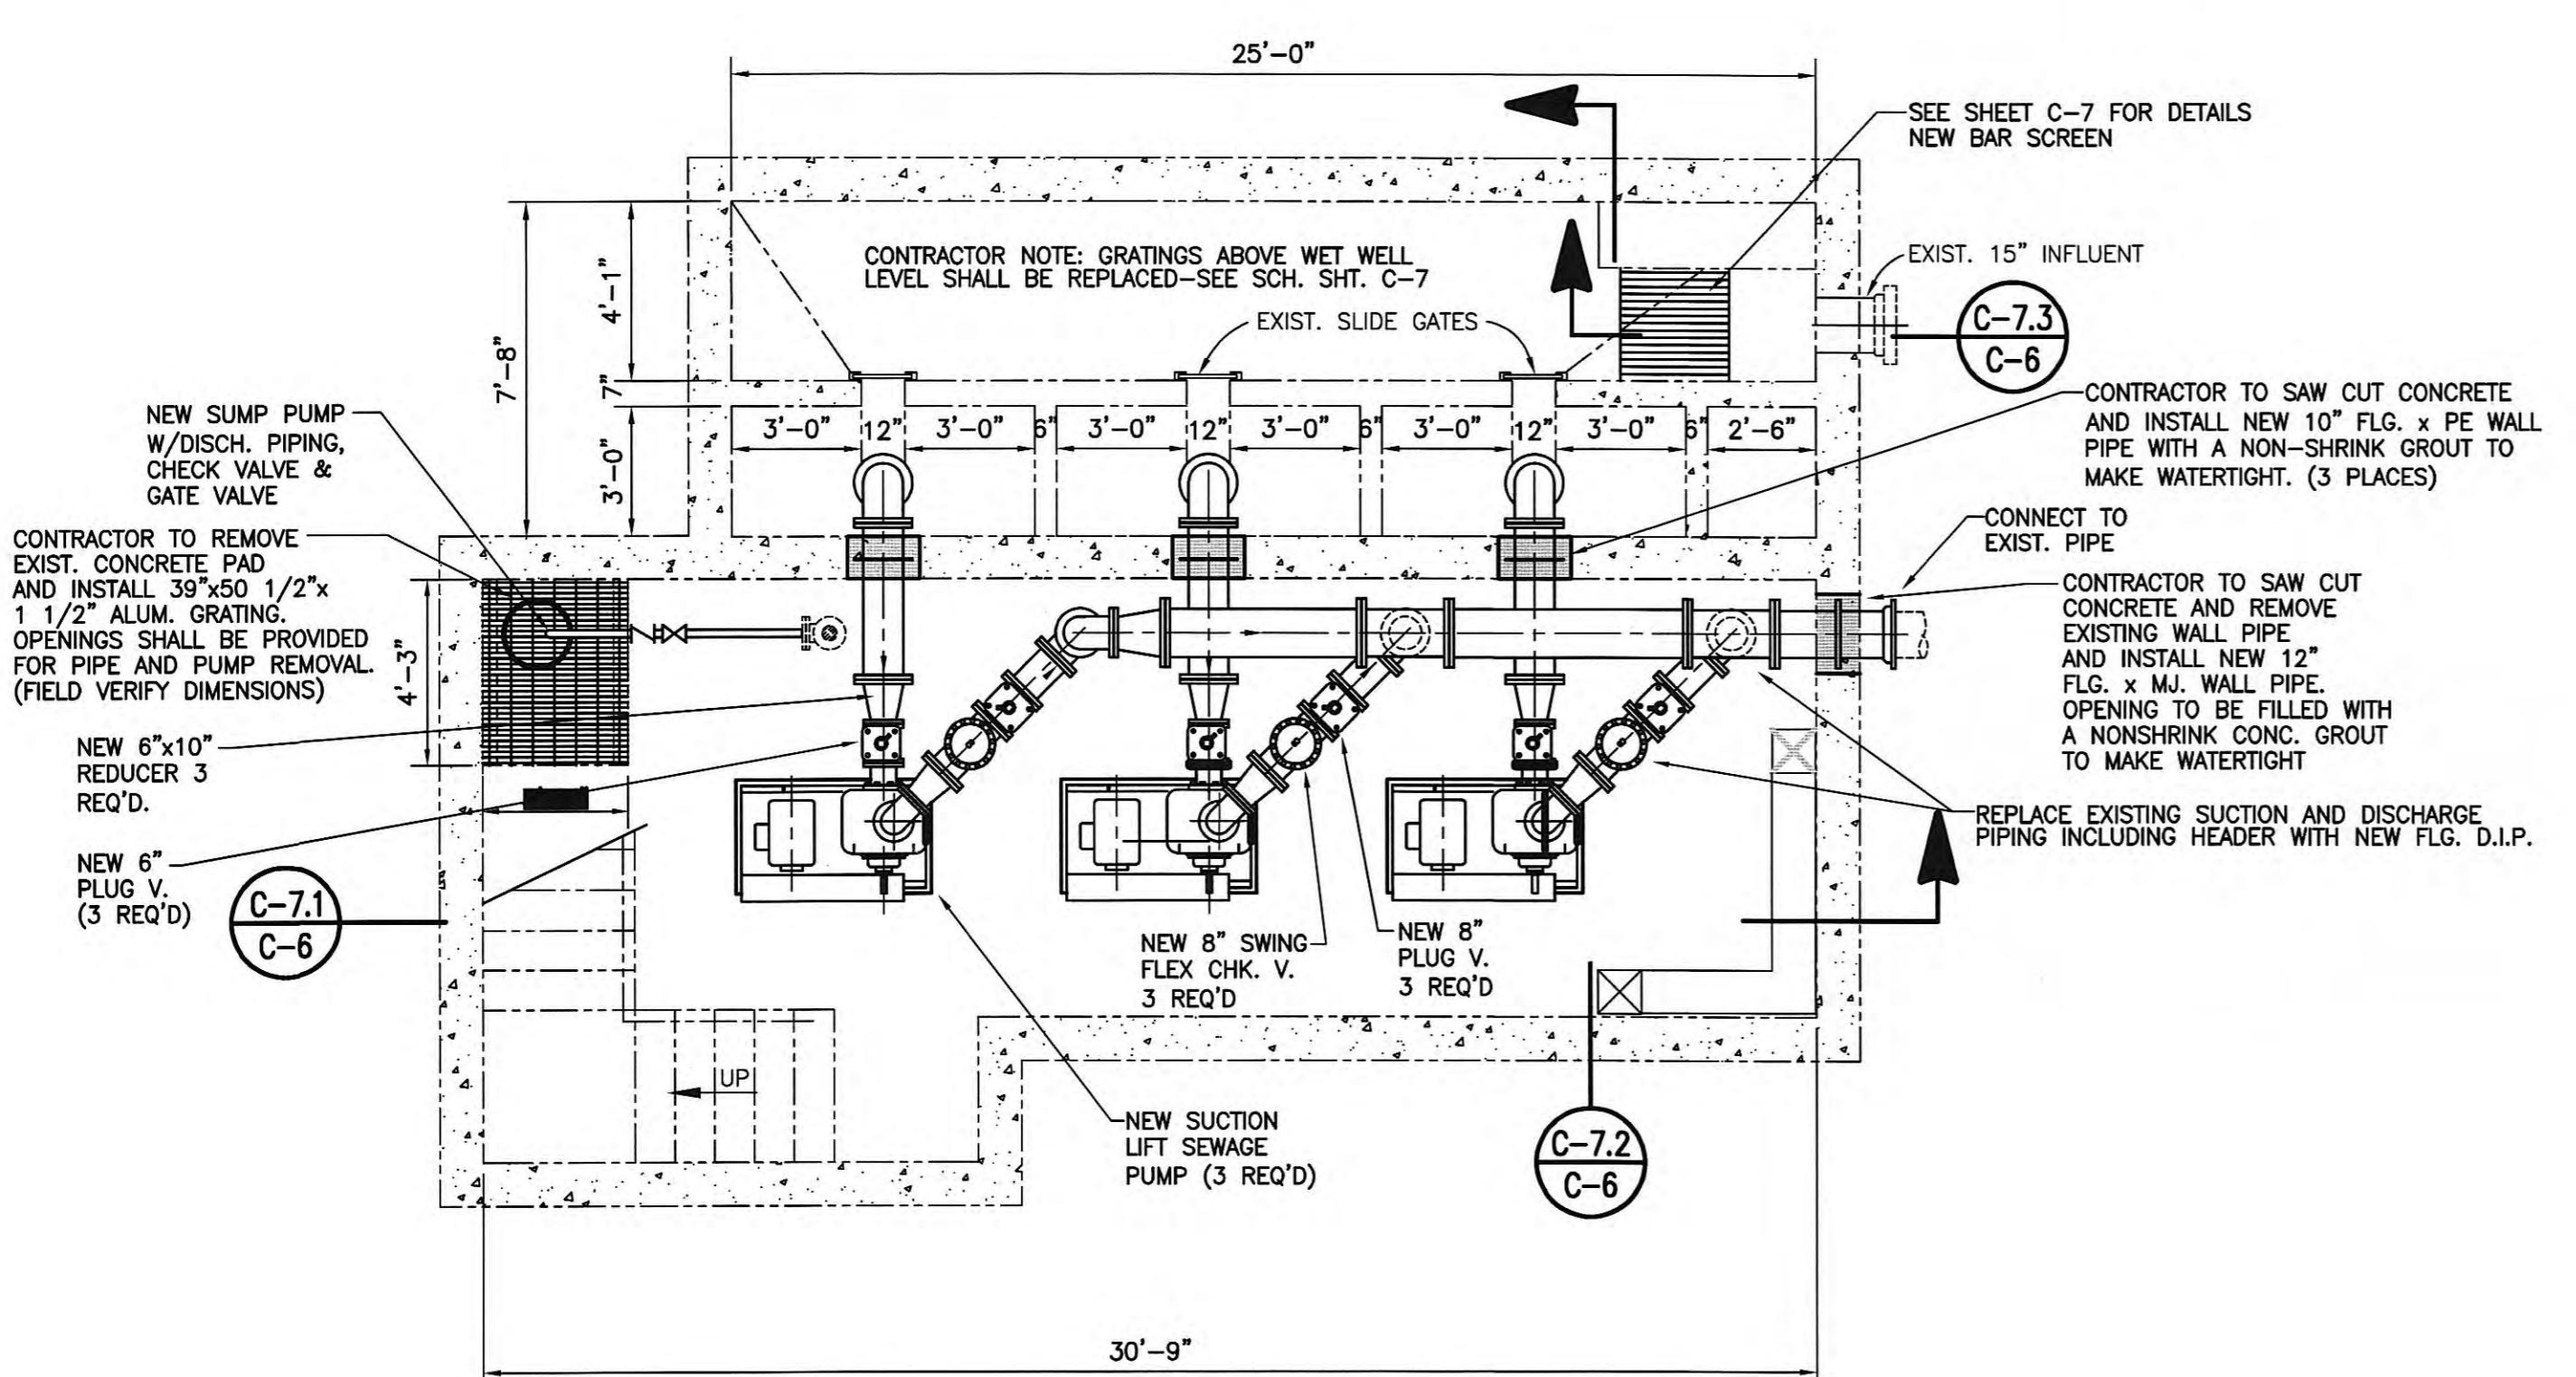

MODIFIED FLOOR PLAN – PUMP LEVEL

SCALE: 1/4" = 1'-0"

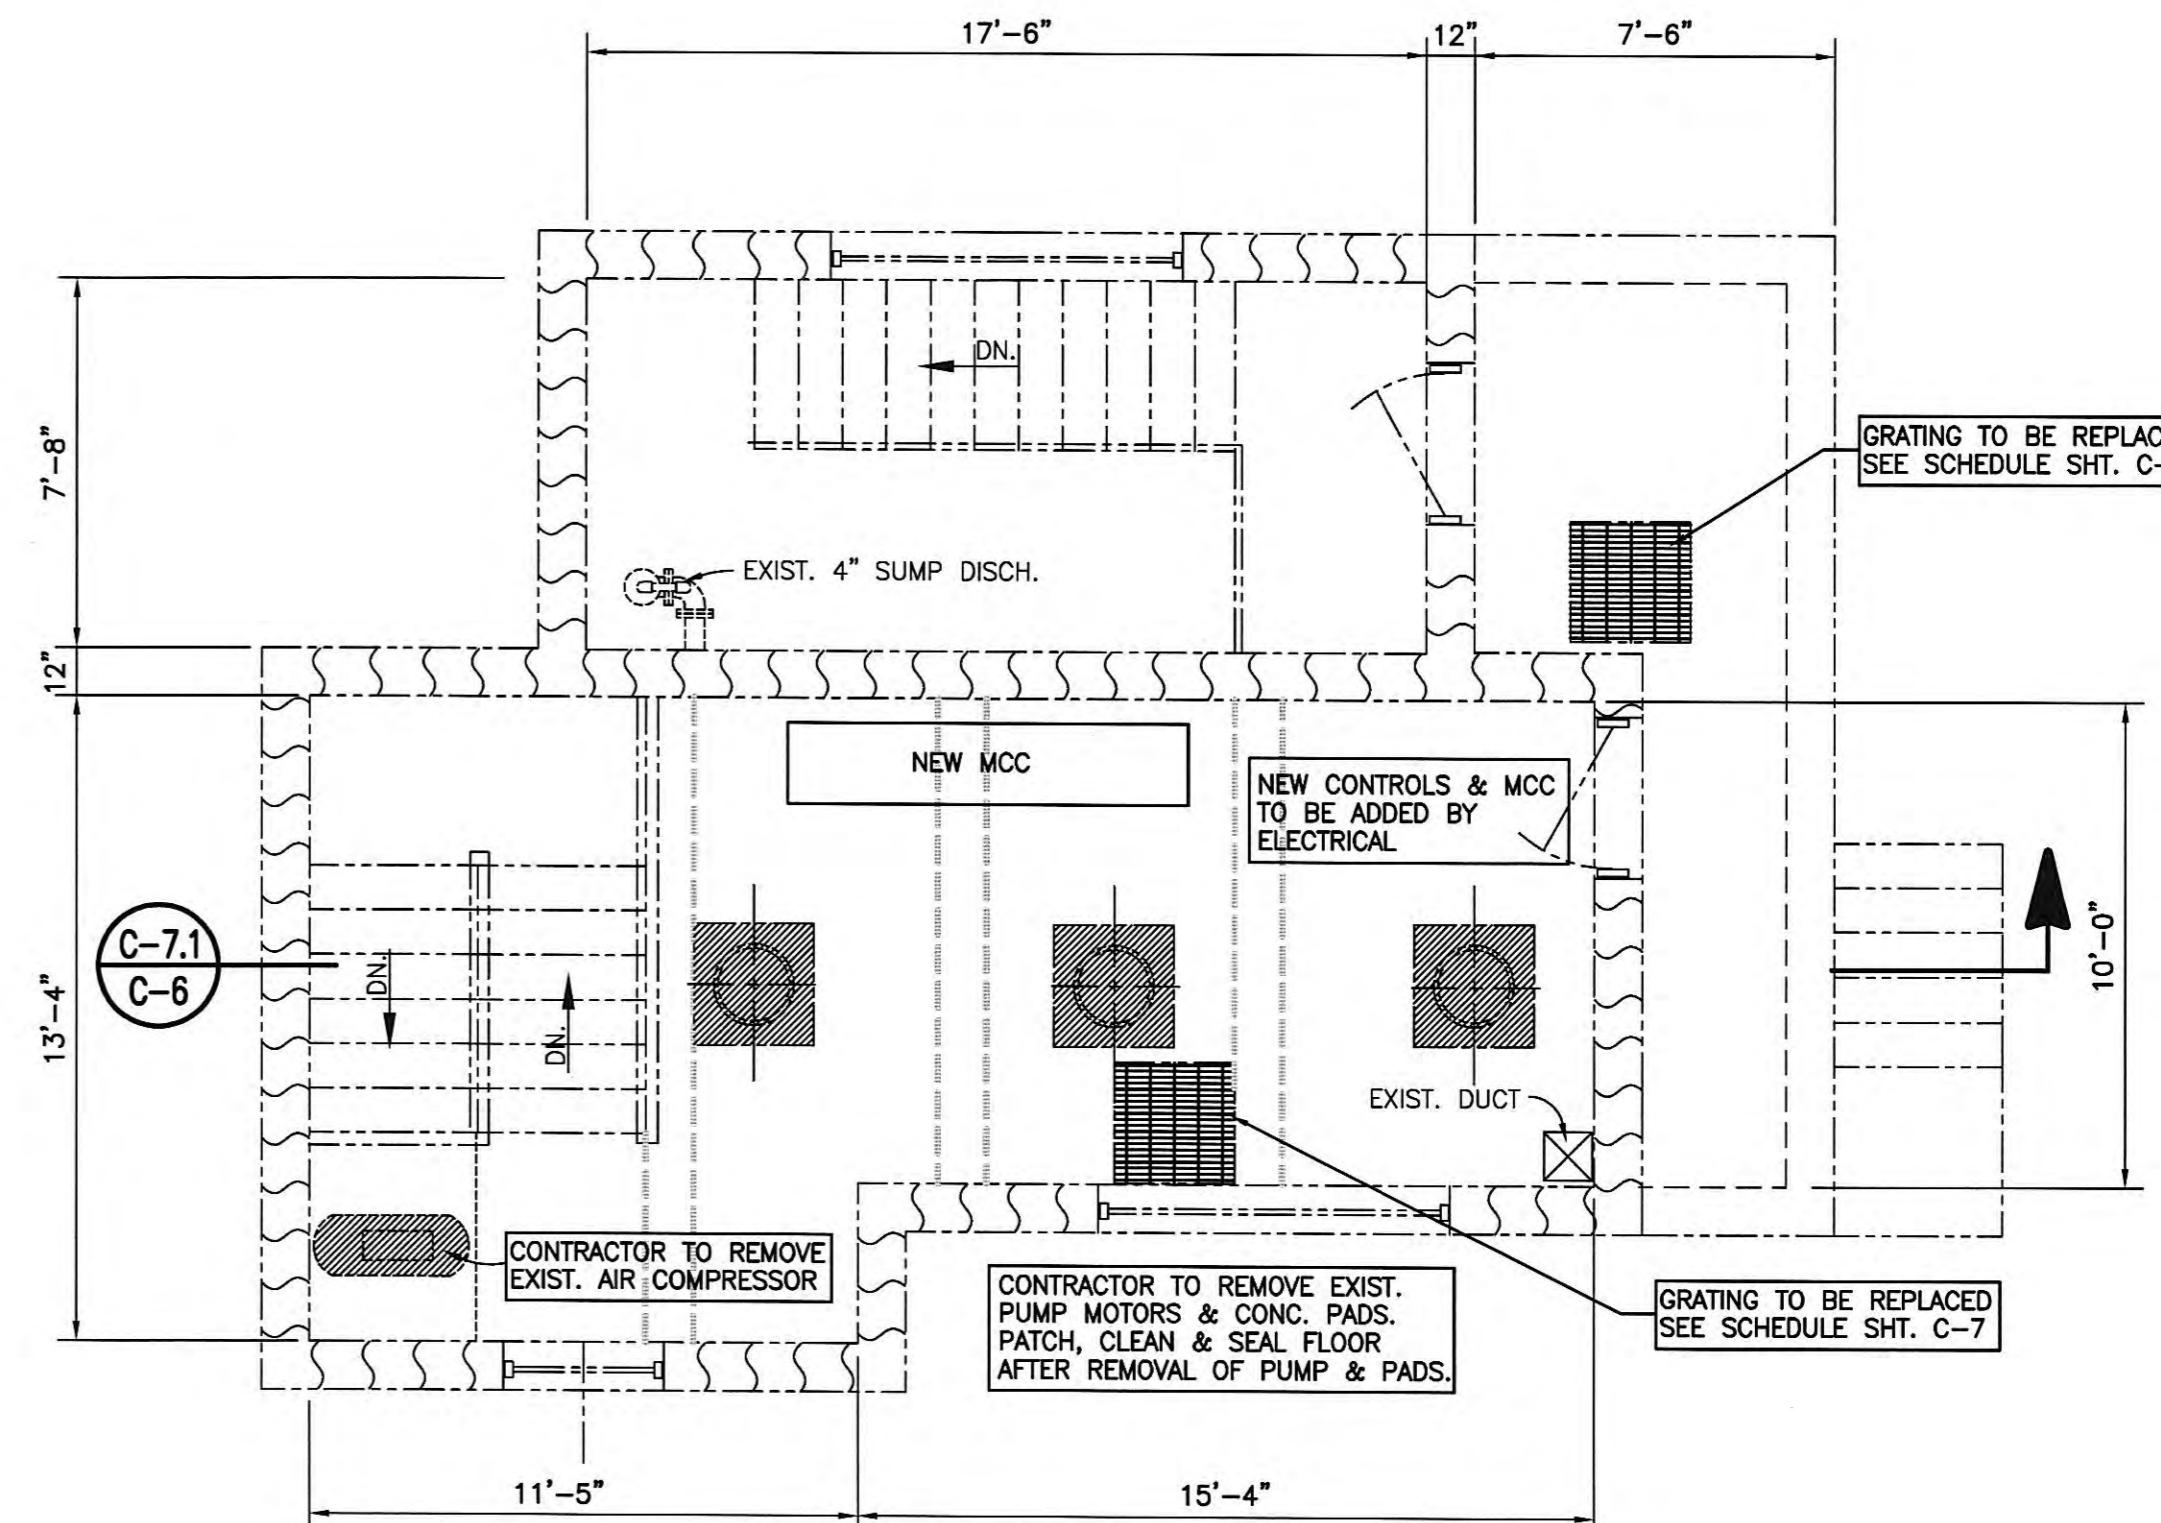

MODIFIED FLOOR PLAN – ENTRANCE LEVEL

SCALE: 1/4" = 1'-0"

RECORD DRAWINGS


THESE RECORD DRAWINGS REPRESENT THE "AS-BUILT" PROJECT TO THE BEST OF THE ENGINEER'S KNOWLEDGE. ALTHOUGH PREPARED FROM THE CONSTRUCTION RECORD, THEY CANNOT BE GUARANTEED TO BE EXACT IN EVERY DETAIL.
CHECKED BY:
S. Groom
ENGINEER'S REPRESENTATIVE
6/12/2002
DATE

ALL RIGHTS RESERVED:
THIS DOCUMENT IS THE PROPERTY OF GRW ELROD DUNSON, INC. AND SHALL NOT BE REPRODUCED IN WHOLE OR IN PART OR USED FOR CONSTRUCTION OF OTHER THAN THIS SPECIFIC PROJECT WITHOUT WRITTEN PERMISSION OF GRW ELROD DUNSON, INC.


NO.	ADDENDUM NO. 1	DATE	BY
1	DESCRIPTION	8/11/05	RGT

REVISIONS


 GRW Elrod Dunson, Inc. <small>Engineers, Architects, Planners</small> <small>LEXINGTON LOUISVILLE INDIANAPOLIS NASHVILLE KNOXVILLE</small>	DESIGNED:	RGT/NDW	DATE:	NOVEMBER, 2002
	DRAWN:	AS NOTED	SCALE:	
	DGR:		REVIEWED:	NDW
	APPROVED:		SHEET NO.	C-6

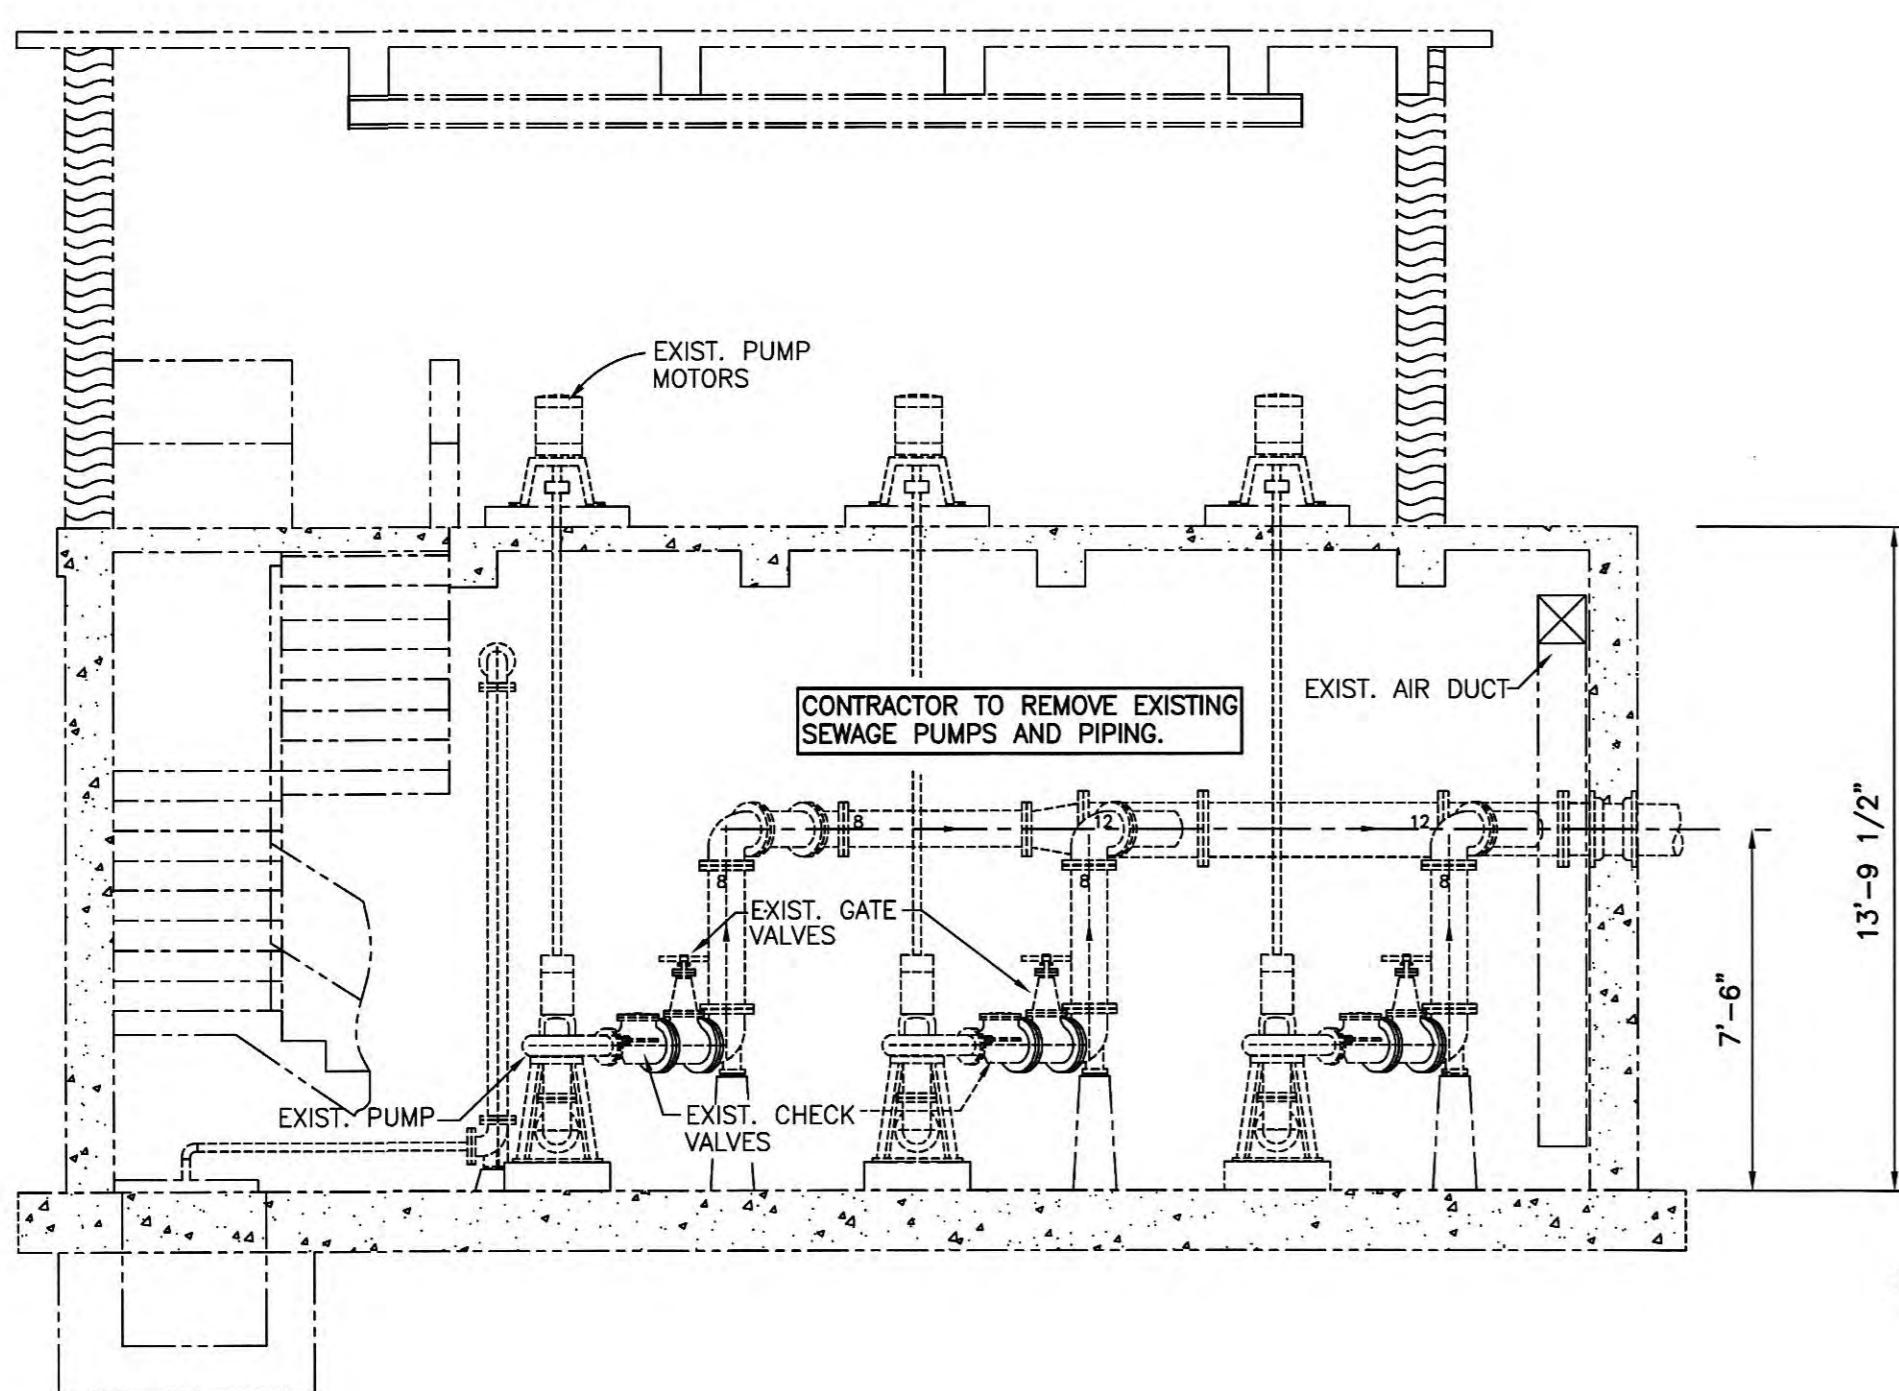


EXISTING CONDITIONS-SECTION (C-7.2)
SCALE: 1/4" = 1'-0"

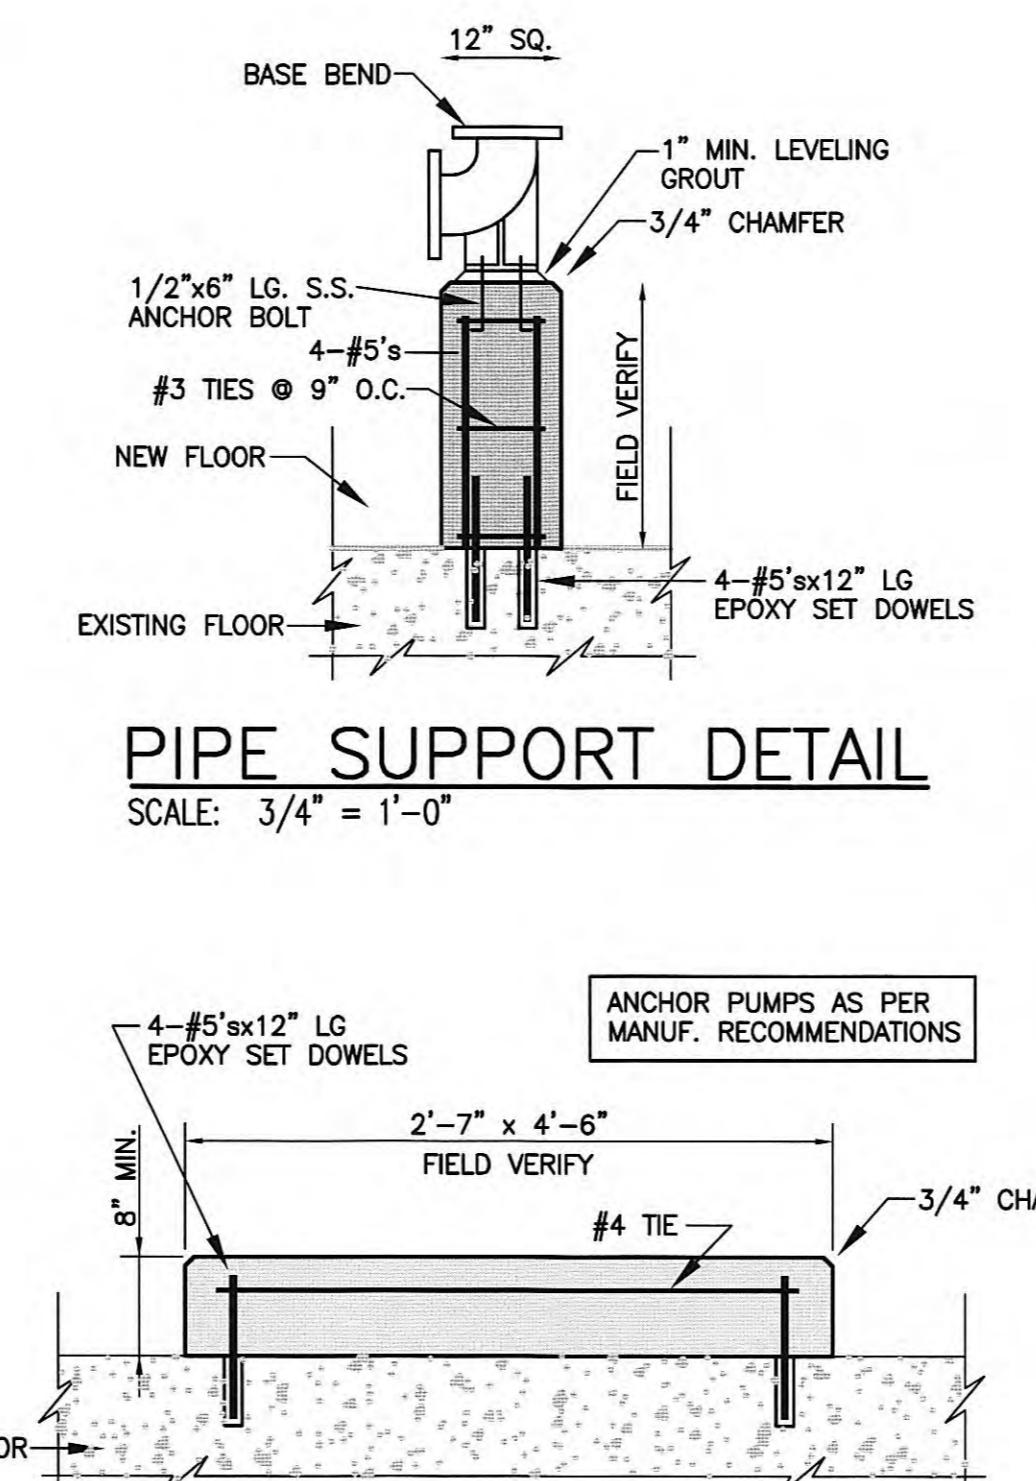


PIPE SUPPORT DETAIL
SCALE: 3/4" = 1'-0"

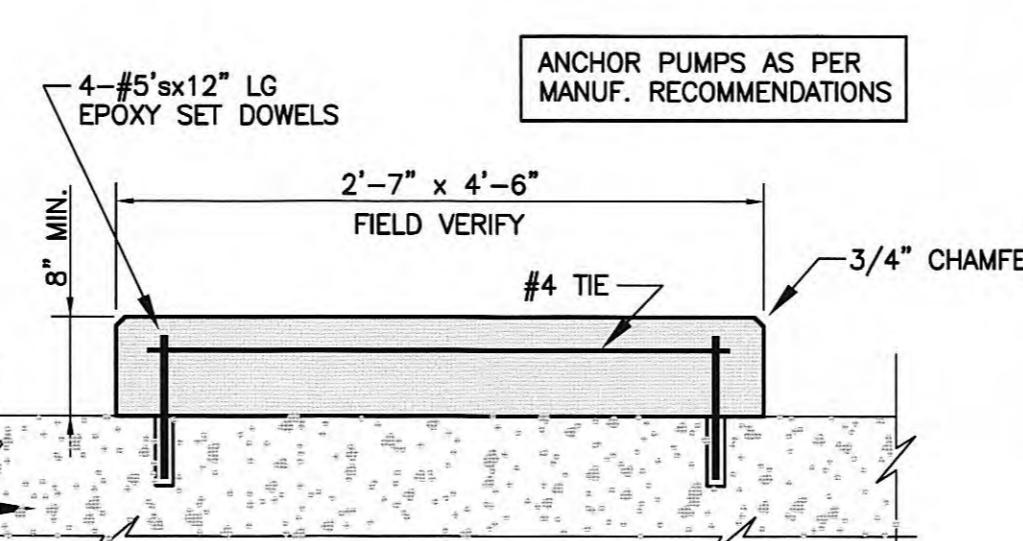

PUMP BASE DETAIL
SCALE: 3/4" = 1'-0"

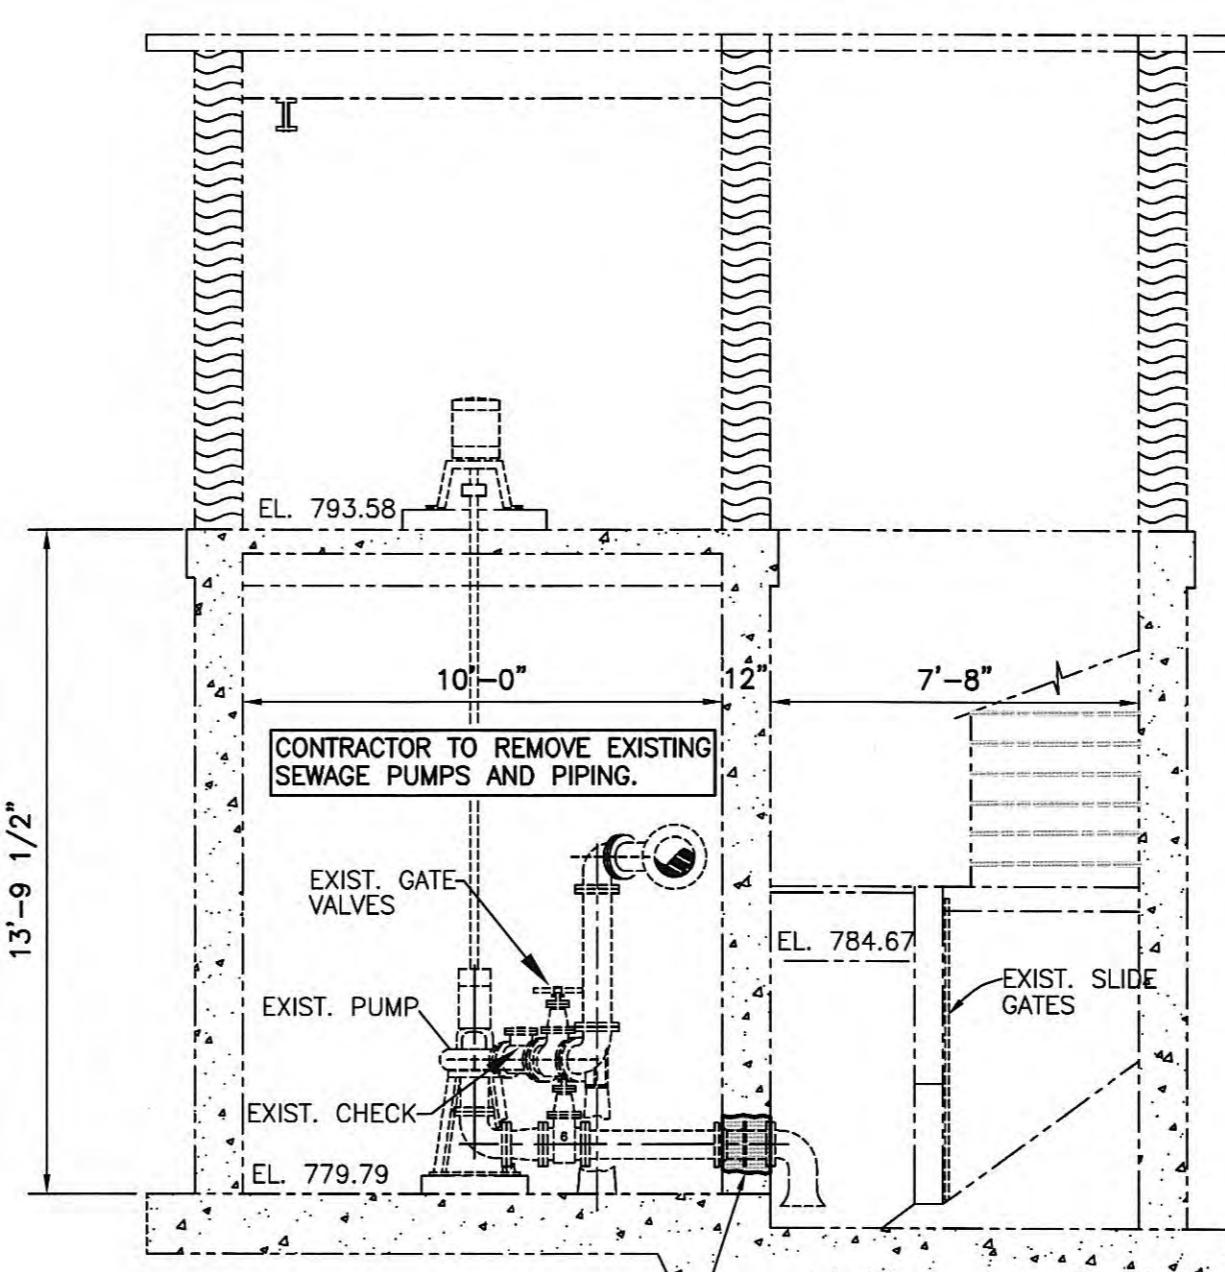


EXISTING CONDITIONS-SECTION (C-7.1)
SCALE: 1/4" = 1'-0"

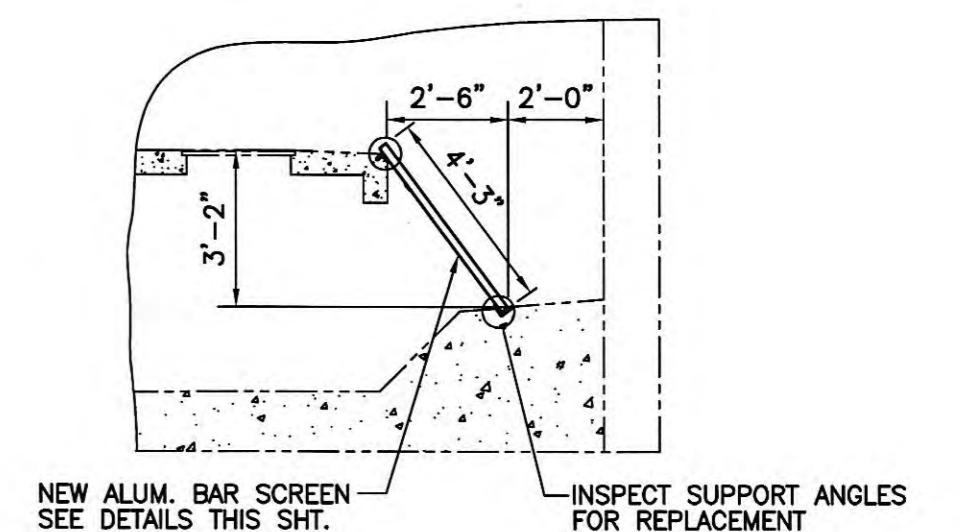


MODIFIED CONDITIONS-SECTION (C-6)
SCALE: 1/4" = 1'-0"


- NOTES:
1. CONTRACTOR TO FIELD VERIFY BAR SCREEN DIMENSIONS BEFORE FABRICATION. SUPPORT ANGLES SHALL BE REPLACED IF DETERIORATED.
 2. CONTRACTOR TO FURNISH ALUM. BAR SCREEN RAKE W/TINES SPACED TO MATCH BAR SPACING ON SCREEN.

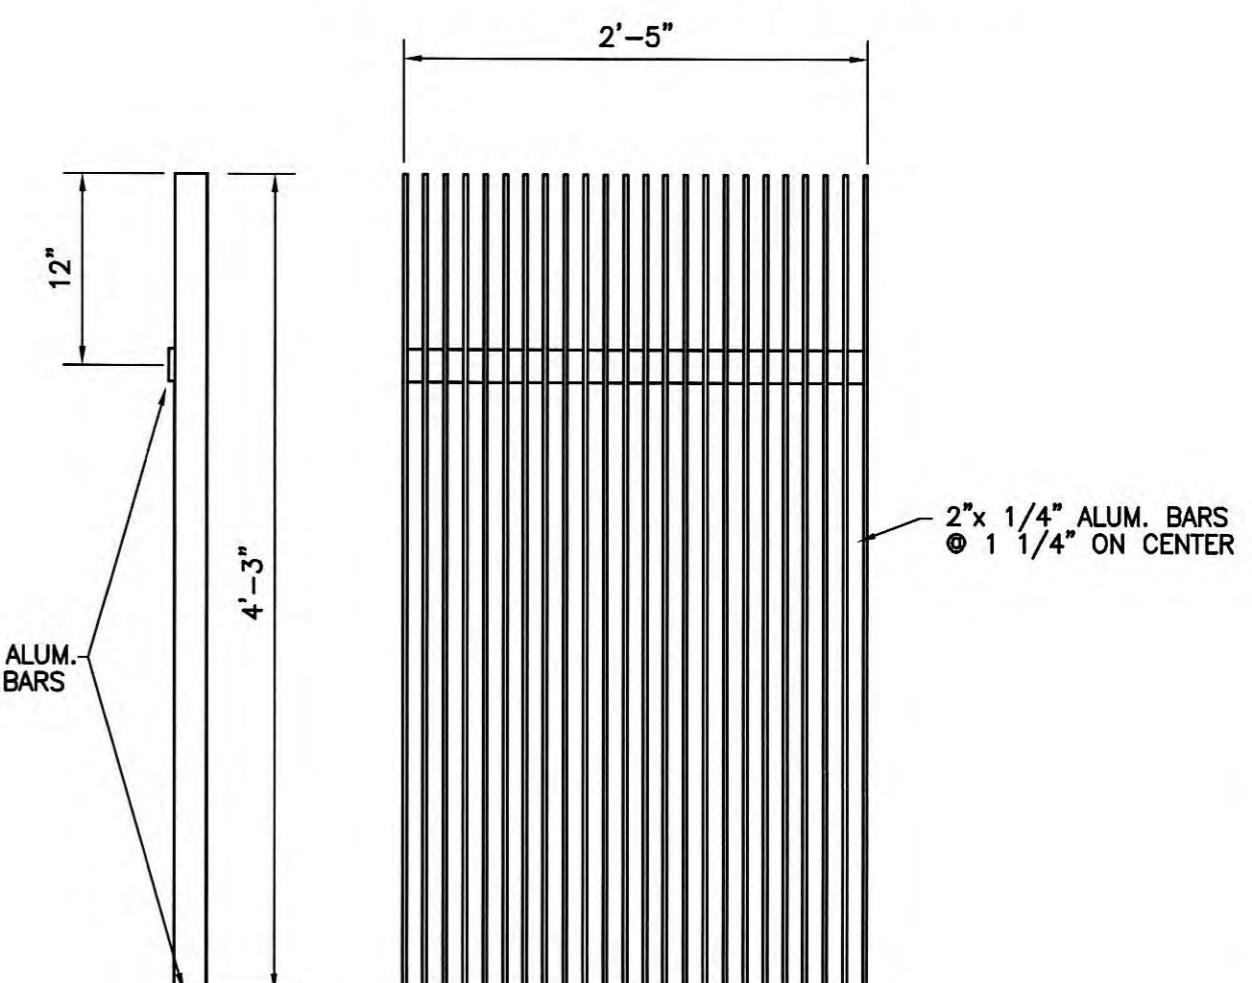

MANUAL BAR SCREEN DETAIL
SCALE: NONE

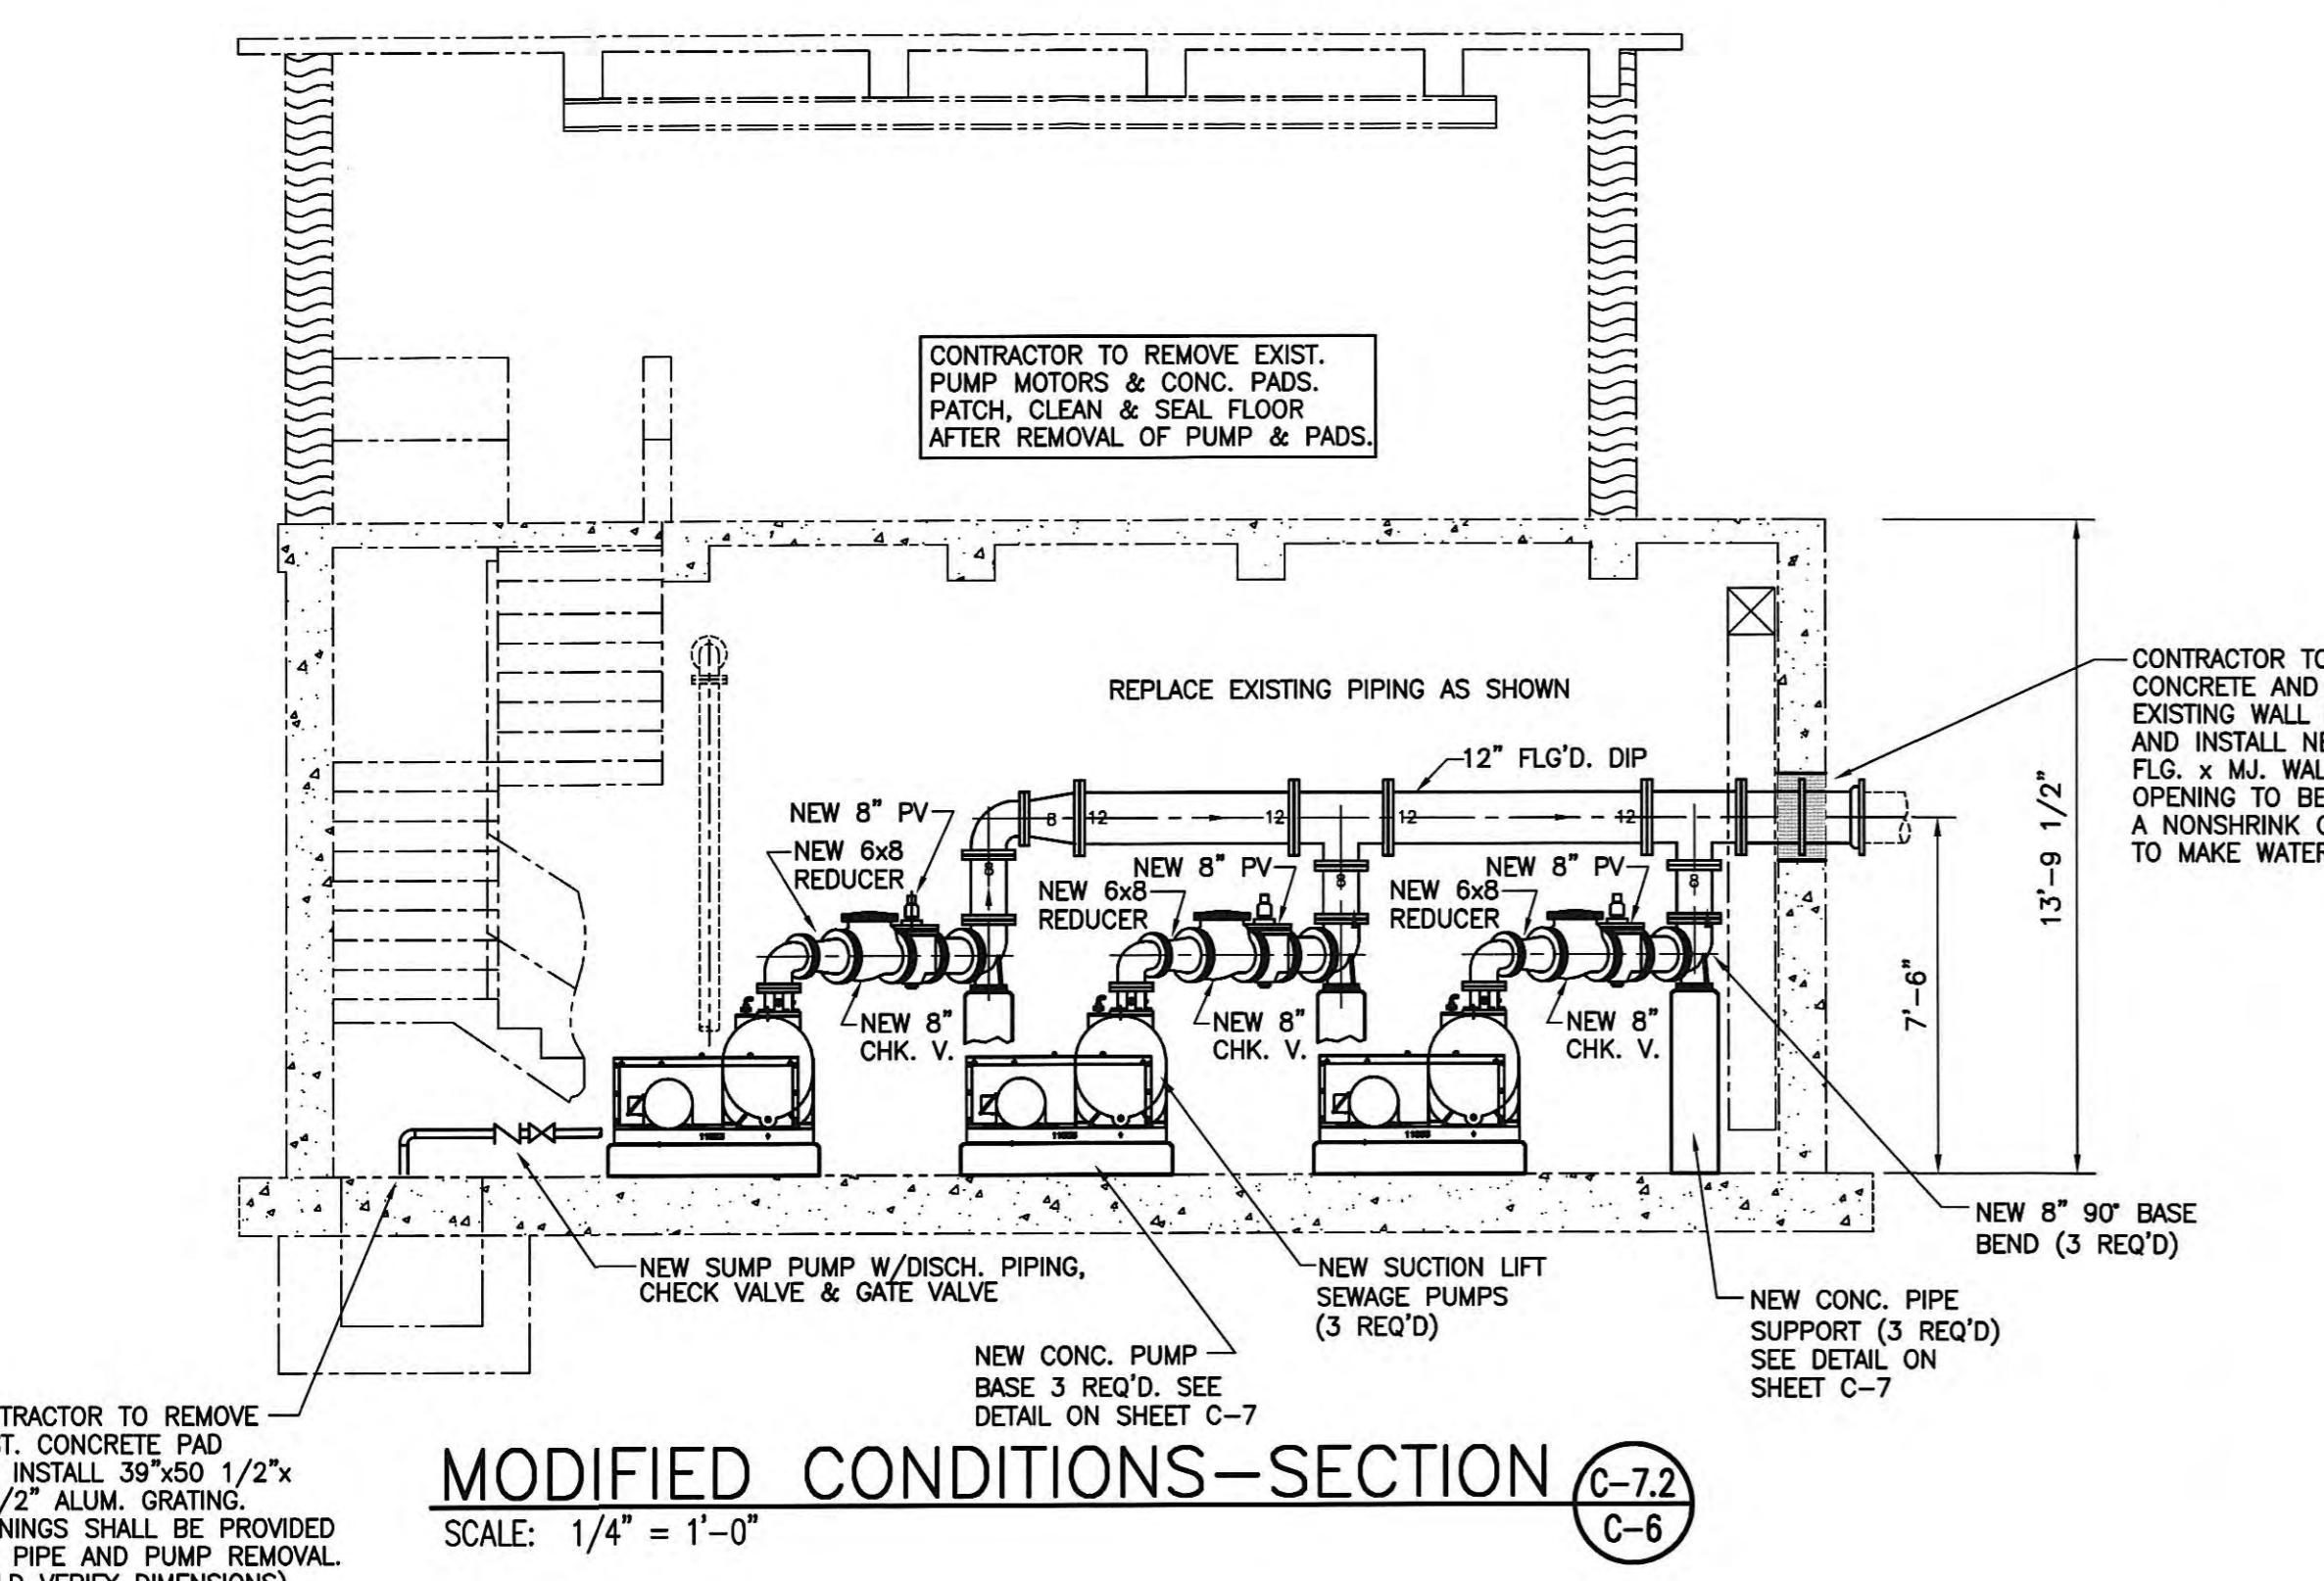

MODIFIED CONDITIONS-SECTION (C-7.2)
SCALE: 1/4" = 1'-0"

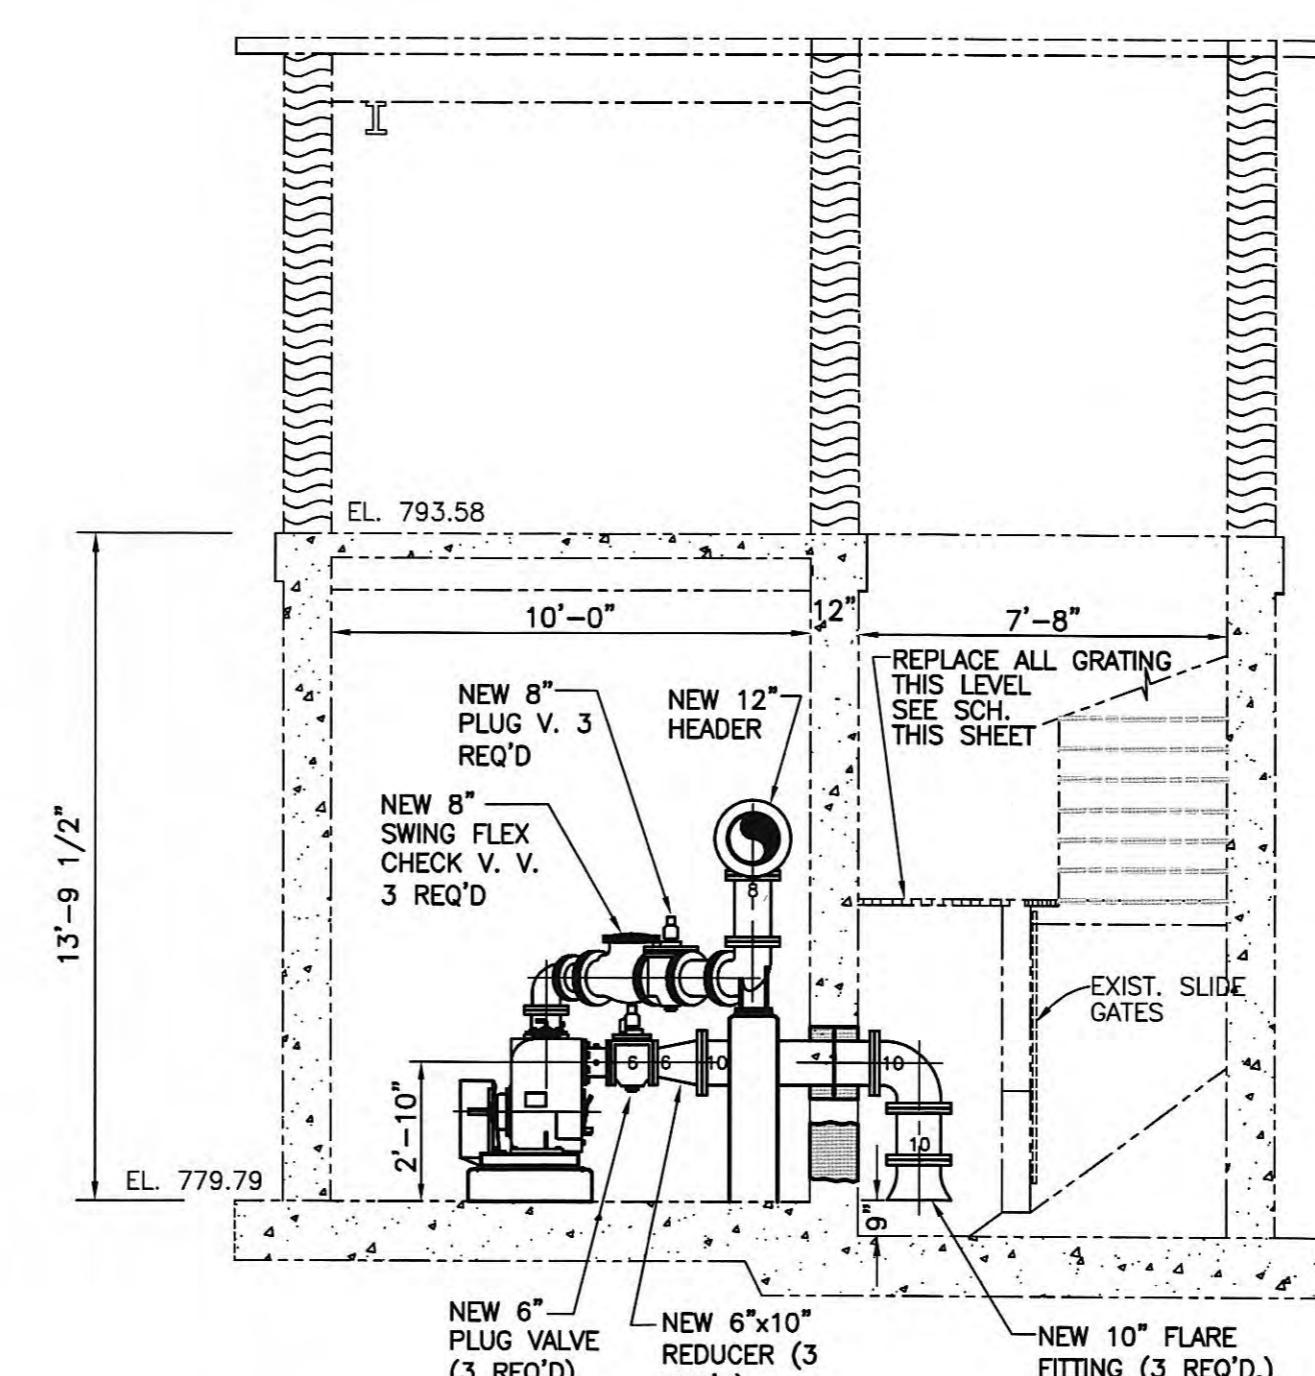

MODIFIED CONDITIONS-SECTION (C-7.1)
SCALE: 1/4" = 1'-0"

SCHEDULE FOR ALUMINUM GRATING REPLACEMENT	
1 EACH-	36 1/4" x 34 1/2" x 1 1/2" LOCATED OUTSIDE @ ENTRANCE
1 EACH-	38 1/2" x 34 1/2" x 1 1/2" LOCATED @ PUMP MOTOR LEVEL
4 EACH-	35 1/2" x 38 1/2" x 1 1/2"
3 EACH-	20 1/2" x 5" x 1 1/2"

CONTRACTOR TO FIELD VERIFY ALL GRATING OPENINGS FOR PROPER FIT.

GRW PROJECT NO. 7601-30 CONTRACT NO. S02-03

EXISTING WEBB SEWAGE PUMP STATION SECTIONS

HARRIMAN UTILITY BOARD
HARRIMAN, TENNESSEE

RECORD DRAWINGS

ALL RIGHTS RESERVED:
THIS DOCUMENT IS THE PROPERTY OF GRW ELROD DUNSON, INC. AND SHALL NOT BE REPRODUCED IN WHOLE OR IN PART OR
USED FOR CONSTRUCTION OF OTHER THAN THIS SPECIFIC PROJECT WITHOUT WRITTEN PERMISSION OF GRW ELROD DUNSON, INC.
CHECKED BY:
S. Brown
ENGINEER'S REPRESENTATIVE
DATE: 6/2007

NO.	ADDENDUM NO. 1	DATE	BY
1	DESCRIPTION	DATE	BY

DESIGNED: RGT/NDW	DATE: NOVEMBER, 2002
DRAWN: DGT	SCALE: AS NOTED
REVIEWED: NDW	SHEET NO.: C-7
APPROVED: RGT	

GRW Elrod Dunson, Inc.
Engineers, Architects, Planners
LEXINGTON LOUISVILLE INDIANAPOLIS
NASHVILLE KNOXVILLE

C-7