


KIF - UTILITY RESTORATION

HARRIMAN UTILITY BOARD - WATER



SITE MAP

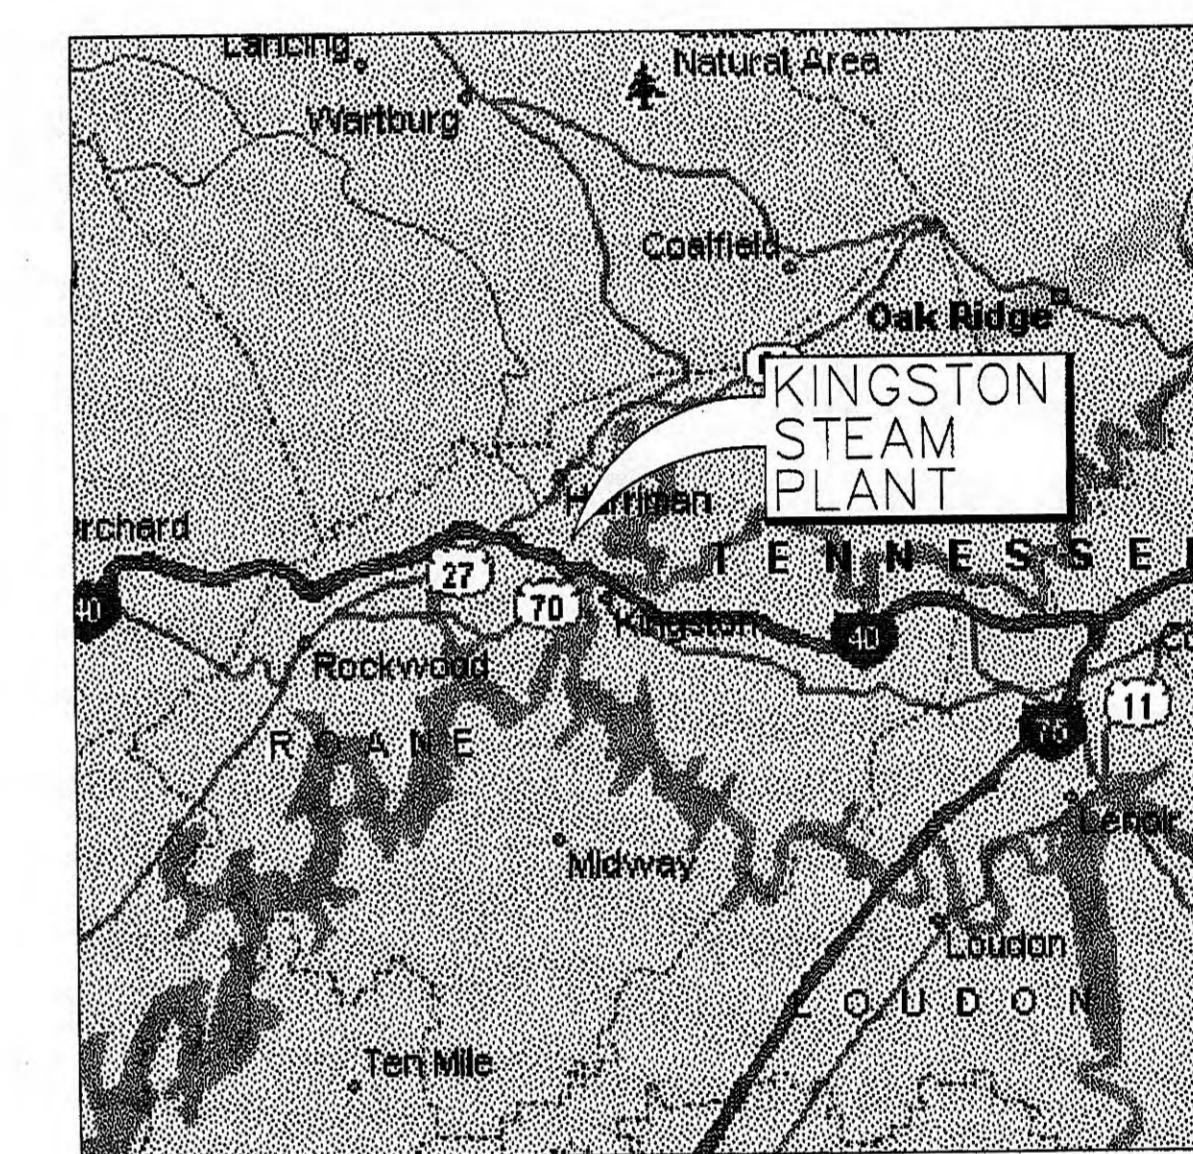


VICINITY MAP

DRAWING INDEX

ALL-HW001	TITLE SHEET
ALL-HW002	GENERAL PLAN
765-HW003	PLAN SHEET 1 OF 12
765-HW004	PLAN SHEET 2 OF 12
765-HW005	PLAN SHEET 3 OF 12
765-HW006	PLAN SHEET 4 OF 12
766-HW007	PLAN SHEET 5 OF 12
766-HW008	PLAN SHEET 6 OF 12
766-HW009	PLAN SHEET 7 OF 12
767-HW010	PLAN SHEET 8 OF 12
767-HW011	PLAN SHEET 9 OF 12
767-HW012	PLAN SHEET 10 OF 12
767-HW013	PLAN SHEET 11 OF 12
767-HW014	PLAN SHEET 12 OF 12
ALL-HW015	DETAIL SHEET
ALL-HW016	EROSION CONTROL DETAIL SHEET

PREPARED BY:

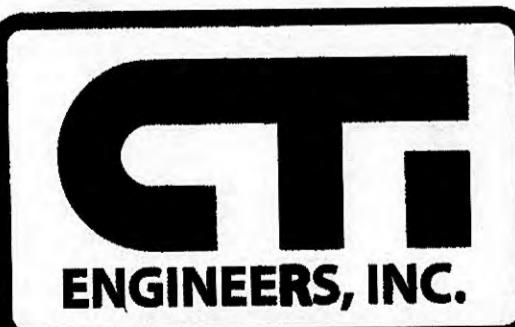

CTI ENGINEERS, INC.
112 DURWOOD ROAD SUITE A
KNOXVILLE, TN 37922
865-245-2750

JOHN L. KING, PE
TENNESSEE LICENSE NO. 103702

7/31/09


NOTE:
THESE RECORD DRAWINGS PREPARED BY CTI ARE BASED UPON THE
REPRESENTATIONS OF OTHERS (MAYSE CONSTRUCTION COMPANY, OF
CHATTANOOGA, TENNESSEE) AND ARE NOT FOR BIDDING, PERMIT OR
CONSTRUCTION PURPOSES. THESE DRAWINGS HAVE BEEN REVIEWED BY CTI AND
ARE BELIEVED TO REFLECT, TO THE BEST OF OUR KNOWLEDGE, AN ACCURATE
RECORD OF THE WORK AS CONSTRUCTED. THE INFORMATION CONTAINED HEREIN
SHOULD BE FIELD-VERIFIED PRIOR TO BEING USED FOR FUTURE DESIGN
AND/OR CONSTRUCTION.

RECORD DRAWING
12-14-2010


I CERTIFY THAT THESE PLANS HAVE BEEN REVIEWED
AND APPROVED BY THE HARRIMAN UTILITY BOARD

CHUCK FLORA, GENERAL MANAGER DATE

R	1	2	3	4	5	6	7	8	9	10	11	12
R 1	12/14/10	JLK	JMG	JLK	-	-	JLK	-	-	-	-	D
RECORD DRAWING	DATE	DESIGN	DRAW	OKD	SUPPLY	RYWD	APPRO	ISSUED	PROJECT ID	AS CONSTR	CO	
NO.	RECD	NO.	NO.	NO.	NO.	NO.	NO.	NO.	NO.	NO.	NO.	
SCALE: NOT TO SCALE												
EXCEPT AS NOTED												
YARD CIVIL												
KIF - UTILITY EXTENSIONS												
HARRIMAN UTILITY BOARD - WATER												
TITLE SHEET												
DESIGNED BY:	DRAWN BY:	CHECKED BY:	SUPERVISED BY:	REVIEWED BY:	APPROVED BY:	ISSUED BY:						
J.L.K.	J.M.G.	D.L.J.										
KINGSTON FOSSIL PLANT												
TENNESSEE VALLEY AUTHORITY												
FOSSIL AND HYDRO ENGINEERING												
AUTOCAD R07	DATE	3/17/09	36	c	ALL-HW001.1	R 1						
PLOT FACTOR:1:1												
C.A.D. DRAWING												
DO NOT ALTER MANUALLY												

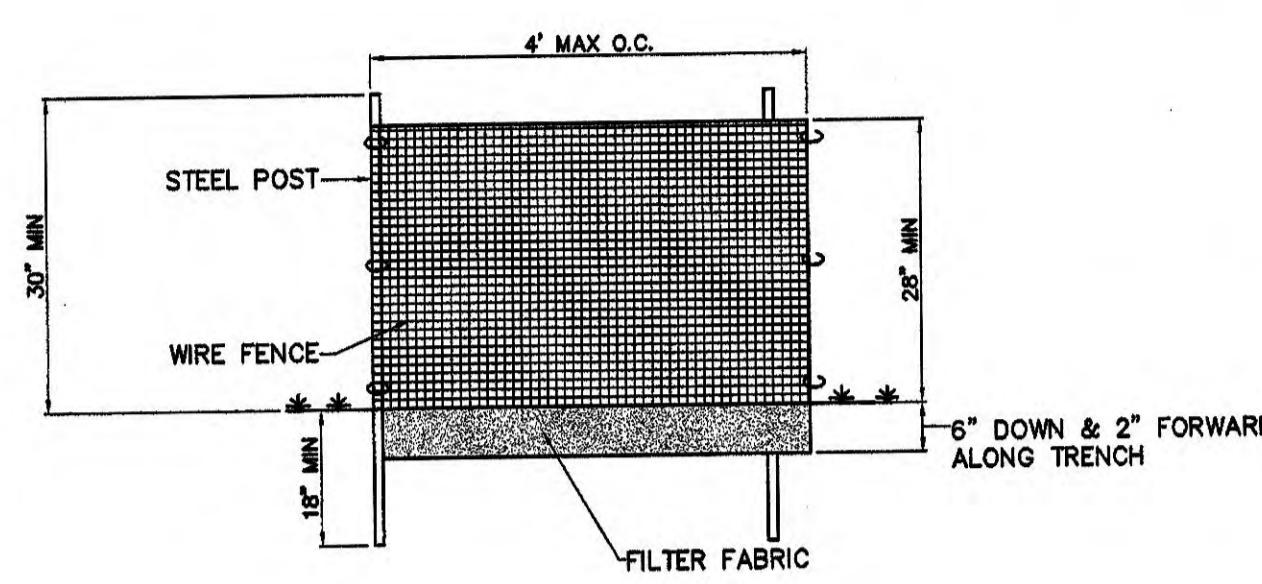

TYPICAL SILT FENCE TYPE C SF
(TYPE C TO BE USED FOR THIS PROJECT)

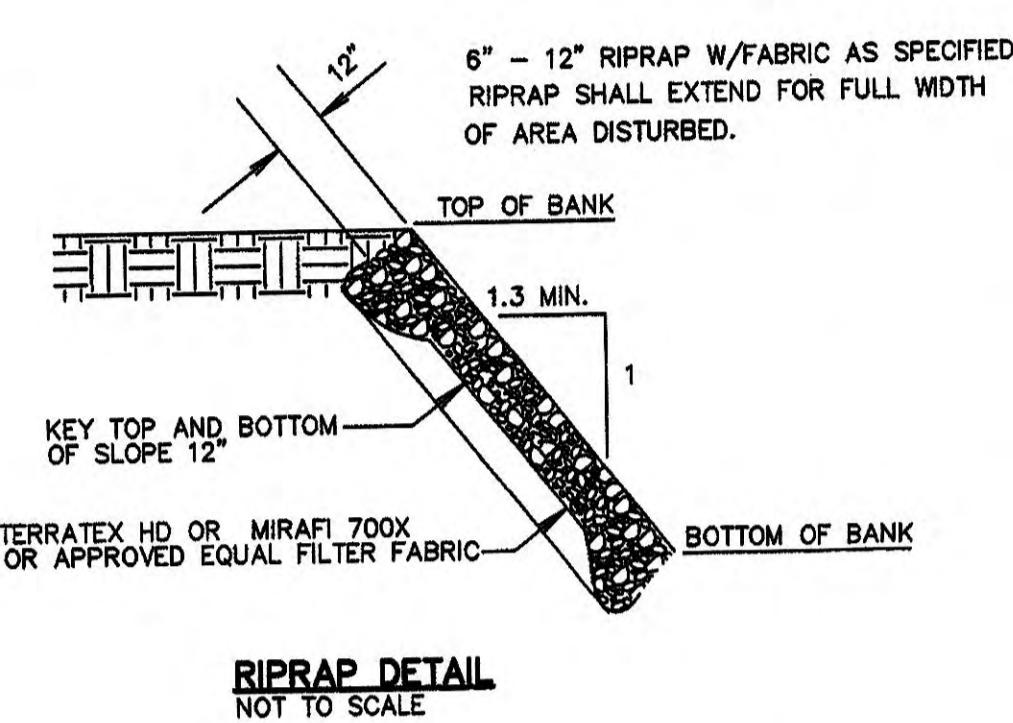

RIPRAP DETAIL
NOT TO SCALE

GENERAL NOTES:
THE FOLLOWING GENERAL EARTHWORK PROCEDURE SHALL BE FOLLOWED FOR CONSTRUCTION OF ROADWAYS, EMBANKMENTS, AND OTHER GENERAL GRADING ACTIVITIES.

1) INSTALL EROSION AND SEDIMENT CONTROL MEASURES IN ACCORDANCE WITH TENNESSEE DEPARTMENT OF ENVIRONMENT AND CONSERVATION (TDEC) REQUIREMENTS.

2) CONTRACTOR IS TO REFER TO THE TENNESSEE DEPARTMENT OF ENVIRONMENT AND CONSERVATION DIVISION OF WATER POLLUTION CONTROL FOR DETAILS ON INSTALLING AND MAINTAINING THE EROSION CONTROL DEVICES CALLED FOR IN THIS PLAN.

3) SEEDING: CONTRACTOR IS TO APPLY TEMPORARY OR PERMANENT SEEDING TO ANY COMPLETED SECTION OF WORK. THE CONTRACTOR SHALL SEED AND MULCH THESE AREAS TO MINIMIZE THE AMOUNT OF DISTURBED AREA PER SPECIFICATION.

B. APPLY TEMPORARY SEEDING WHENEVER GRADING OPERATIONS ARE TEMPORARILY STOPPED FOR OVER 14 DAYS. THE GRADED AND EXPOSED SURFACES IS TO BE COMPLETED WITHIN ONE YEAR. APPLY TEMPORARY SEEDING TO SOIL STOCKPILES PER SPECIFICATIONS.




C. APPLY PERMANENT SEEDING WHETHER GRADING OPERATIONS ARE COMPLETED AND ALL CONSTRUCTION ACTIVITIES HAVE NOT IMPACTED THE DISTURBED AREA. APPLY PERMANENT SEEDING TO ALL NON-CONSTRUCTION AREAS WHICH SHOW SIGNS OF EXCESSIVE EROSION PER SPECIFICATIONS.

4) ALL SILT FENCE SHOULD BE INSTALLED ALONG THE CONTOUR, NEVER UP OR DOWN A SLOPE. THE DRAINAGE AREA SHOULD NOT EXCEED 1/4 ACRE FOR EVERY 100 FEET OF SILT FENCE.


5) IN AREAS WHERE THE SLOPE IS GREATER THAN 20%, A FLAT AREA LENGTH OF 10 FEET BETWEEN THE SLOPE AND THE FENCE SHOULD BE PROVIDED.

6) DETAILS FOR STRUCTURAL PRACTICES SHOWN IN: "TENNESSEE EROSION AND SEDIMENT CONTROL HANDBOOK", DATED MARCH 2002.

LAND SLOPE(%)	MATERIAL SLOPE LENGTH ABOVE FENCE(S) 2 TO 5 100 6 TO 10 75 10 TO 20 25 >20 15
---------------	--

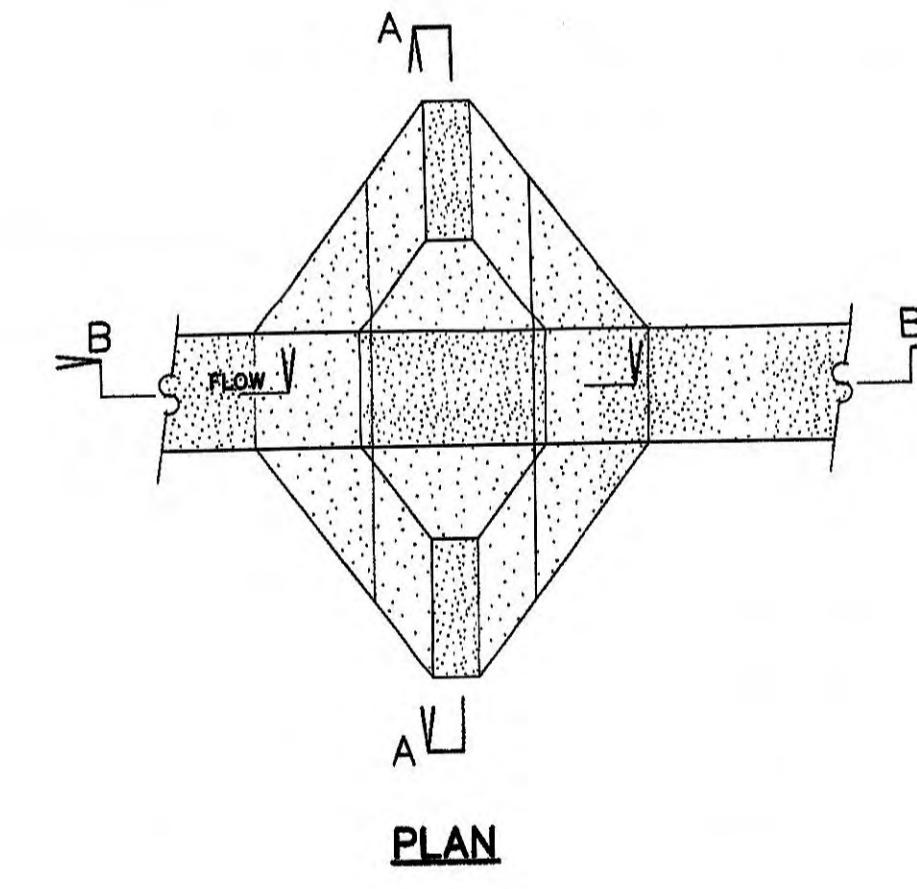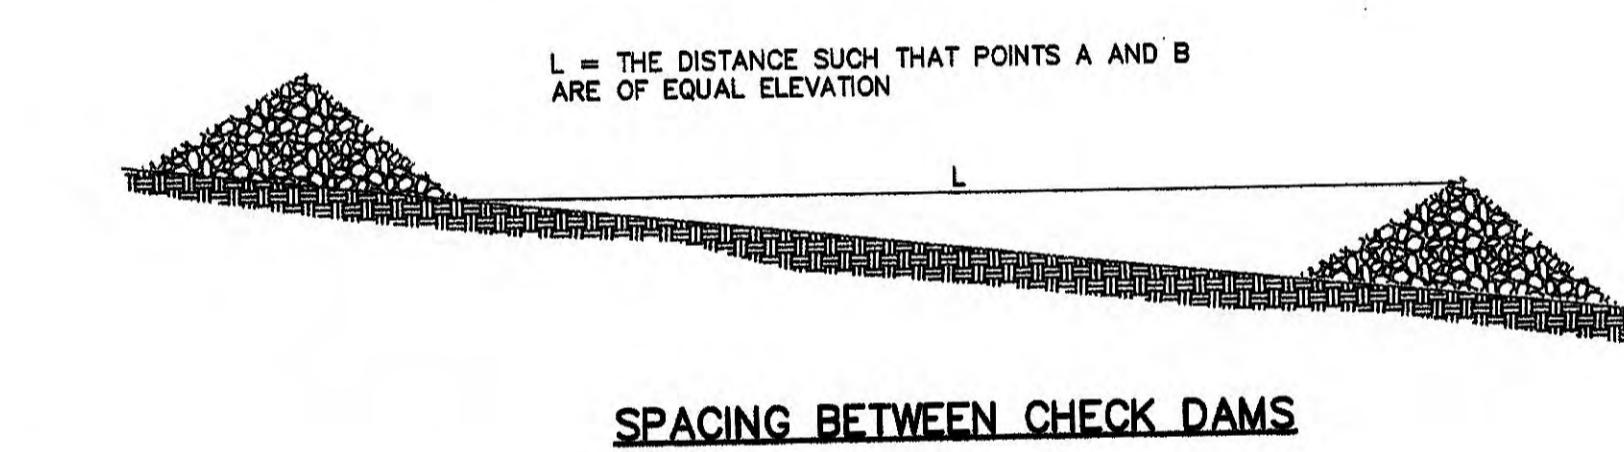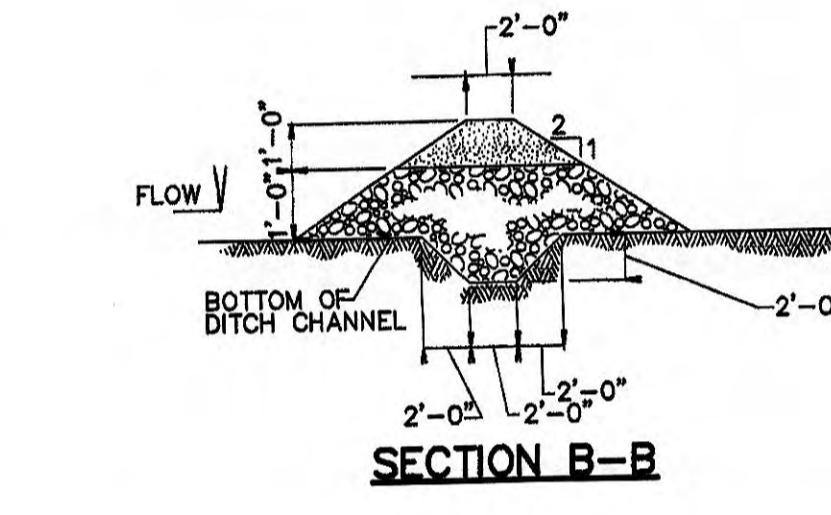

STONE CHECK DAM
NOT TO SCALE

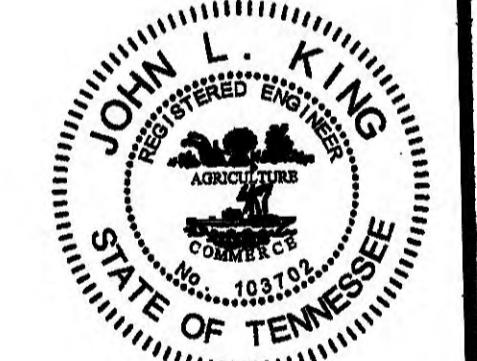


R 1	12/14/10	JLK	JMG	JLK	-	-	-	-	-	-	D
RECORD DRAWING	REV. NO.	DATE	DESIGN	DRAW.	CHNO.	SUPV.	RVWD.	APPR.	ISSD.	PROJECT	AS CONST.
SCALE: AS SHOWN	EXCEPT AS NOTED										
YARD	CIVIL										
KIF - UTILITY EXTENSIONS											
HARRIMAN UTILITY BOARD - WATER											
EROSION CONTROL DETAIL SHEET											
DESIGNED BY: J.L.K.	DRAWN BY: J.M.G.	CHECKED BY: D.L.L.	SUPERVISED BY: D.L.L.	REV'D BY: J.L.K.	APPROVED BY: J.L.K.	ISSUED BY: J.L.K.	PLOT FACTOR:1:1				
KINGSTON FOSSIL PLANT											
TENNESSEE VALLEY AUTHORITY											
FOSSIL AND HYDRO ENGINEERING											
AUTOCAD R07	DATE	3/17/09	36	C	ALL-HW016.1	R 1					

RECORD DRAWING
12-14-2010


CTI ENGINEERS, INC.
TASK COMPLETED BY:
REV. NO.
REV'D BY:
APPROVED BY:
ISSUED BY:

C.A.D. DRAWING
DO NOT ALTER MANUALLY

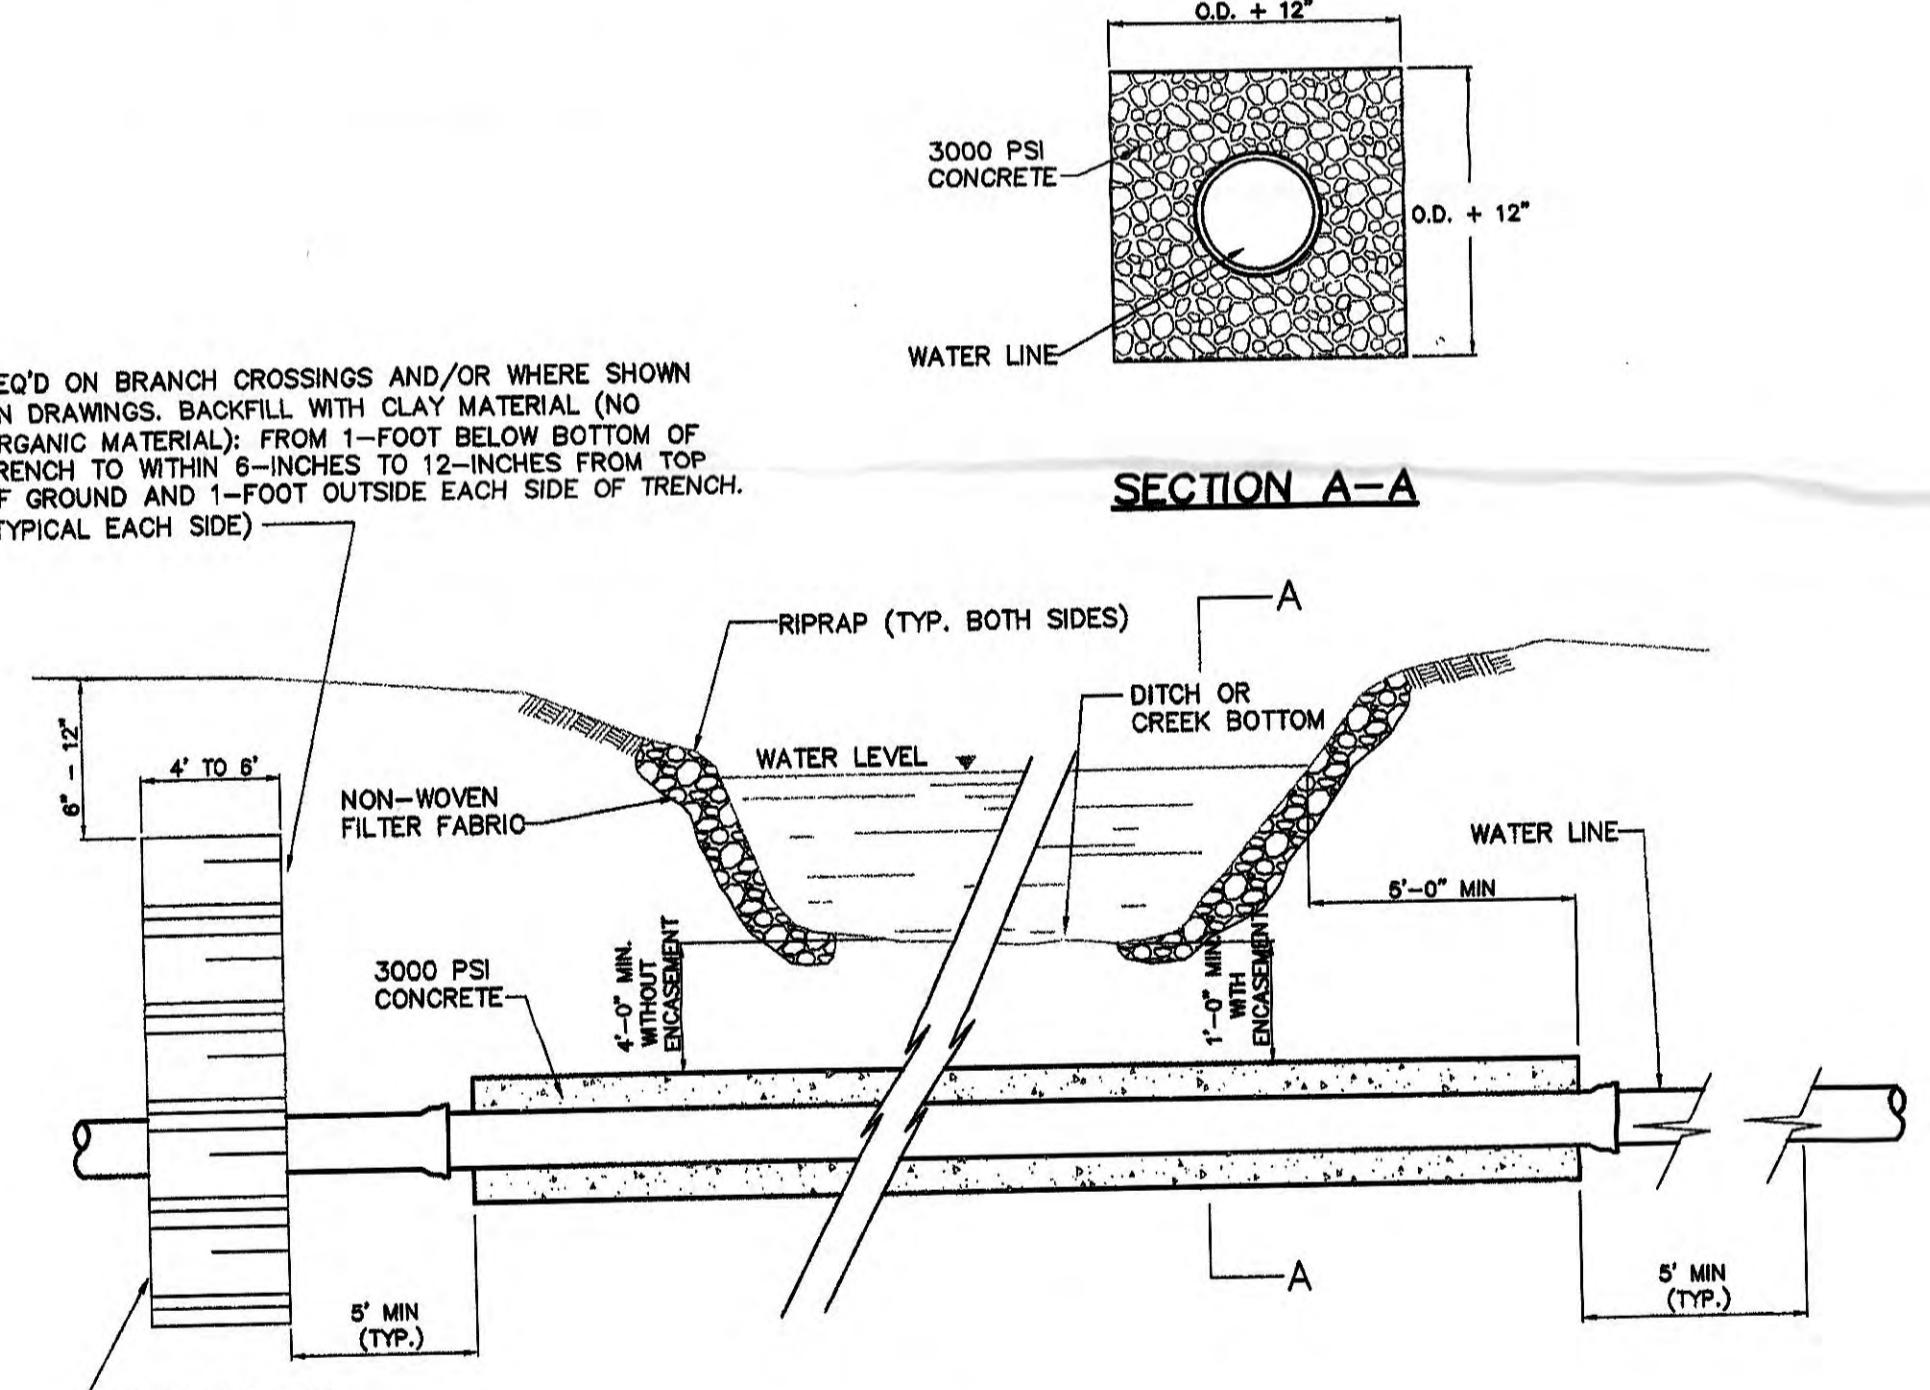

BRANCH OR DITCH CROSSING DETAIL
NOT TO SCALE

NOTE:
PIPELINE MIN. 4 FEET OF COVER UNLESS IN ROCK. IF ROCK IS ENCOUNTERED TOP OF PIPE SHALL BE 1 FOOT BELOW
ROCK ENCASED IN CONCRETE. PIPING MATERIAL SHALL BE DUCTILE IRON UNLESS OTHERWISE SPECIFIED IN DRAWINGS.

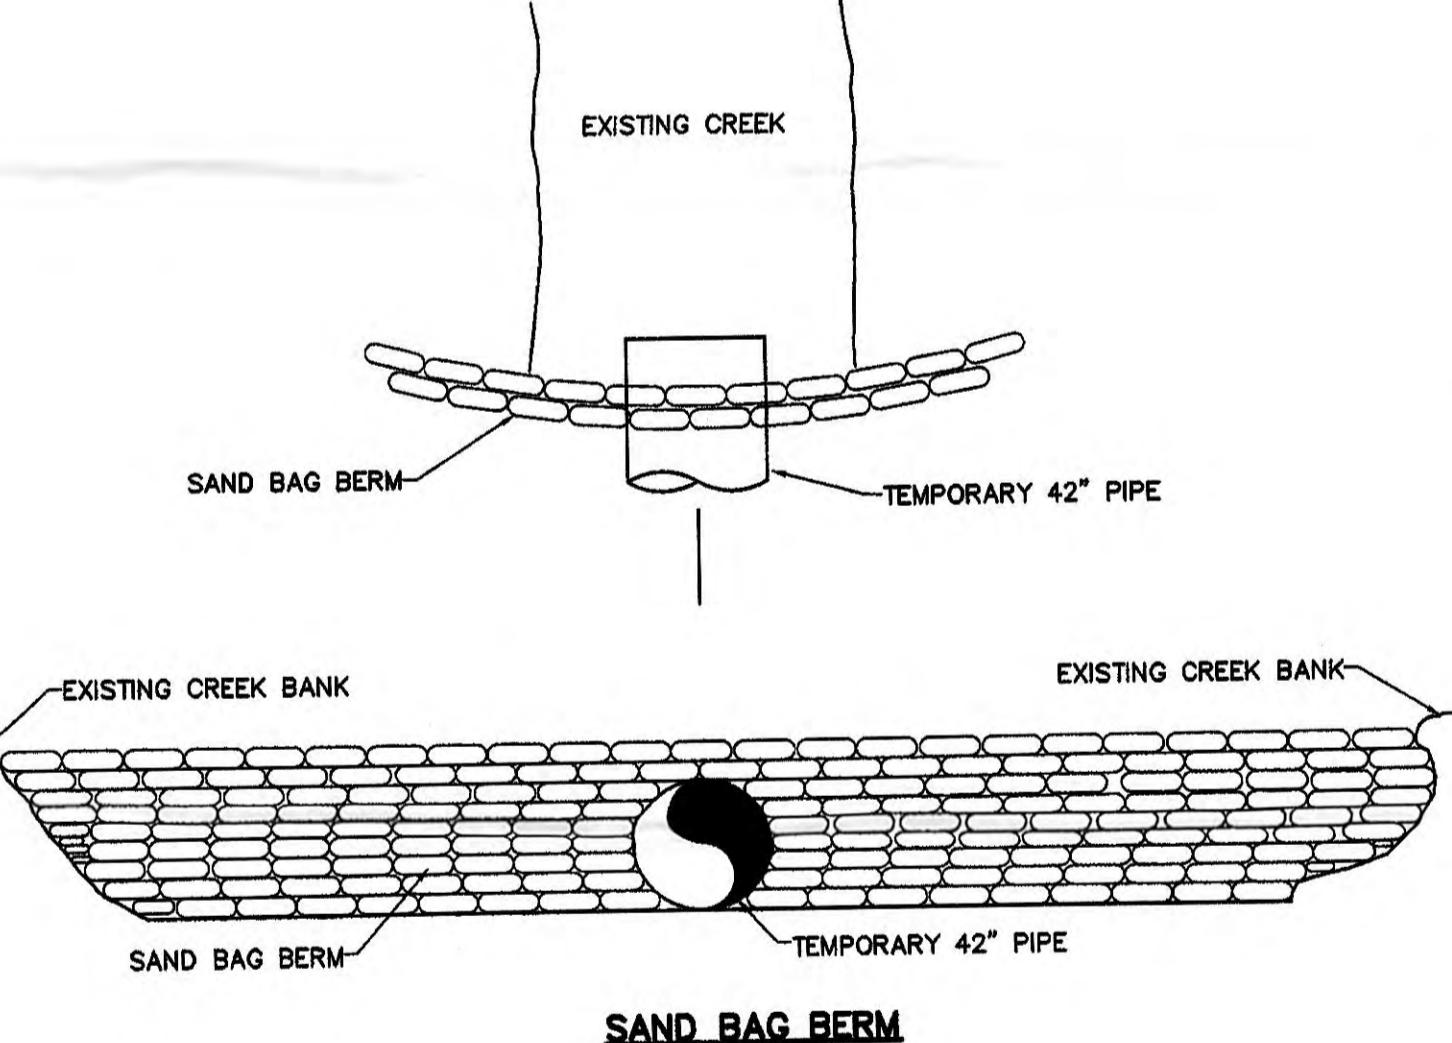

1 2 3 4 5 6 7 8 9 10 11 12

36

C

10W

2

3

4

5

6

7

8

9

10

11

12

A

B

C

D

E

F

G

H

A

B

C


D

E

F

G

H

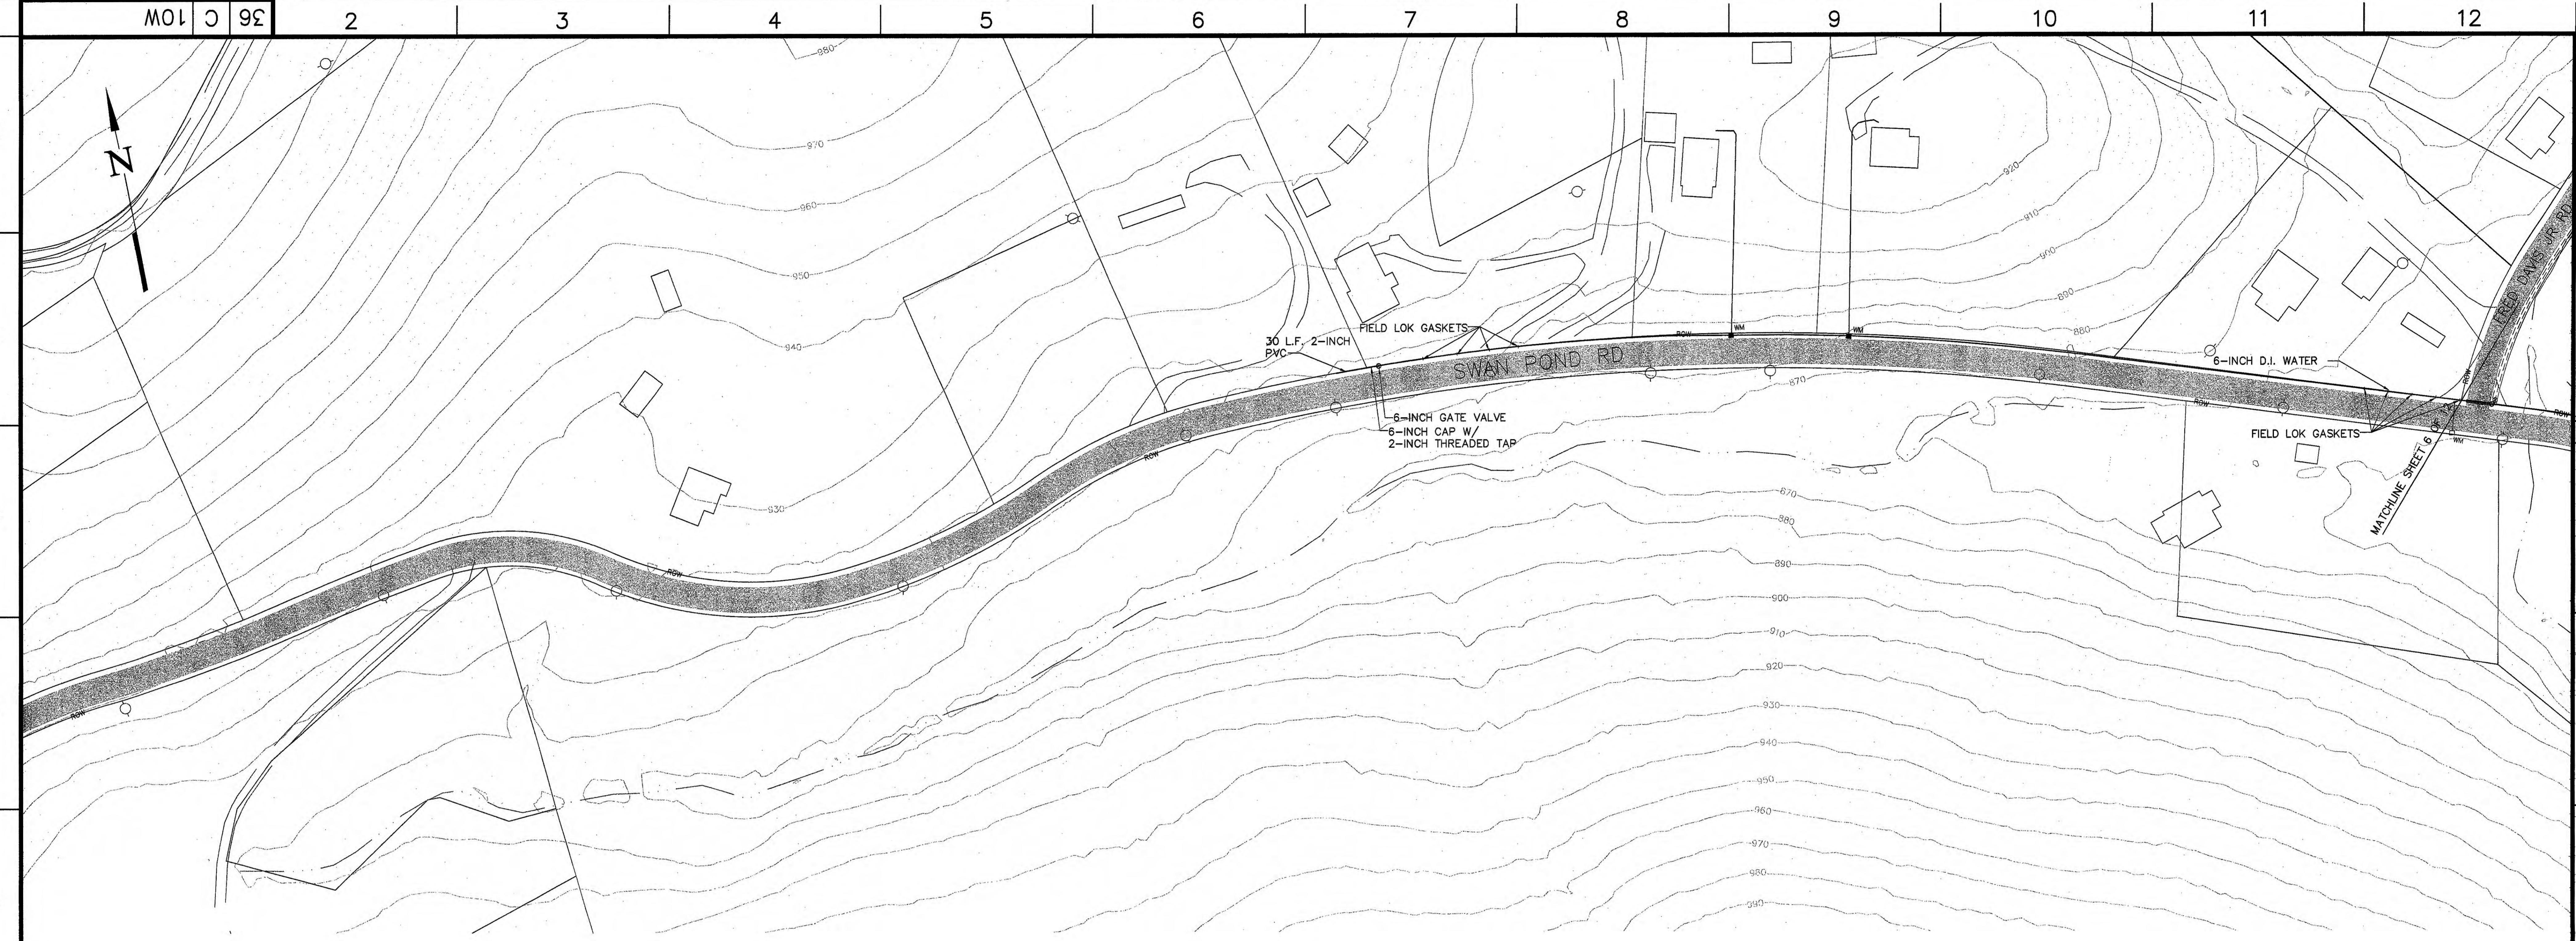

PLAN
SCALE: 1"=50'



R											DISPUB INTERFA	
R 1	12/14/10	JLK	JMG	JLK	-	-	JLK	-	-	-	-	1D
RECORD DRAWING												
REV. NO.	DATE	DESIGN	DRAW.	CHKO	SUPV	RWD	APPD	ISSD	PROJECT	AS CONST	PER	
SCALE: 1"=50' EXCEPT AS NOTED												
CIVIL YARD												
KIF - UTILITY EXTENSIONS HARRIMAN UTILITY BOARD - WATER PLAN SHEET 7 OF 12												
DESIGNED BY: J.L.K.	DRAWN BY: J.M.G.	CHECKED BY: D.L.W.	SUPERVISED BY: J.M.G.	REVIEWED BY: D.L.W.	APPROVED BY: J.M.G.	ISSUED BY: D.L.W.						
HASSLER MILL ROAD WEST ON SWAN POND ROAD												
TVA ESR NO. 766 CTI NO. C07070-13												
KINGSTON FOSSIL PLANT TENNESSEE VALLEY AUTHORITY FOSSIL AND HYDRO ENGINEERING												
AUTOCAD R07 DATE 3/17/09 36 C 766-HW009.1 R 1												

RECORD DRAWING
12-14-2010

HASSLER MILL ROAD WEST
ON SWAN POND ROAD
TVA ESR NO. 766
CTI NO. C07070-13

CTI ENGINEERS, INC.
TASK COMPLETED BY: REV NO.

PLOT FACTOR:1:1
W-TVA
C.A.D. DRAWING
DO NOT ALTER MANUALLY

1

2

3

4

5

6

7

8

9

10

11

12

36

C

10W

2

3

4

5

6

7

8

9

10

11

12

A

B

C

D

E

F

G

H

A

B

C


D

E


F

G

H

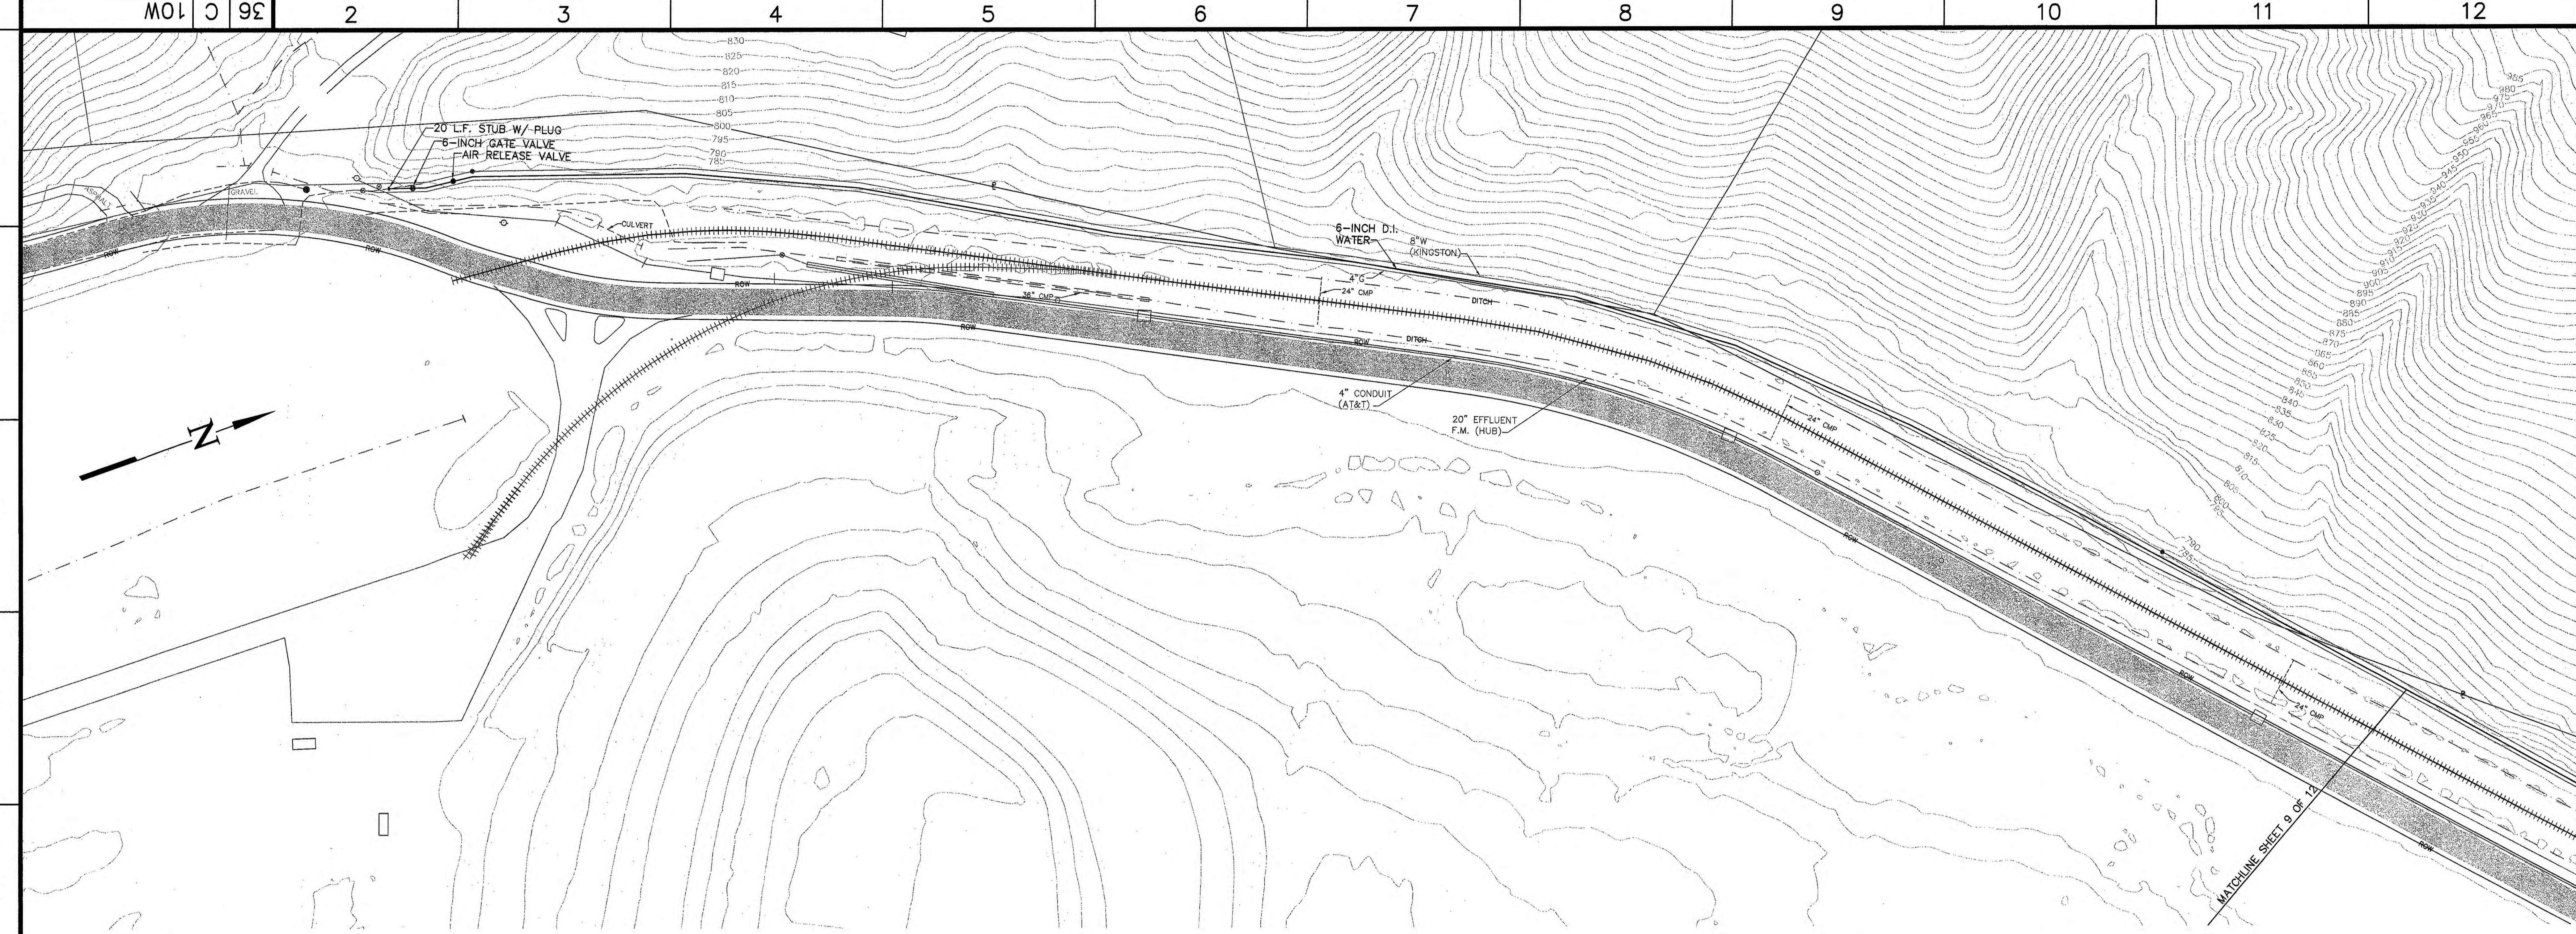

PLAN
SCALE: 1"=50'

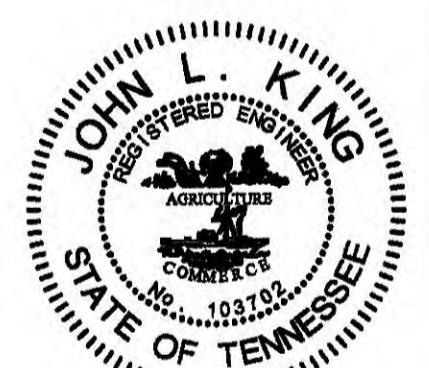

R2	12/14/10	JLK	JMG	JLK	-	-	JLK	-	-	-	-
RECORD DRAWING											
R.D.	8/14/10	JLK	JMG	JLK	-	-	JLK	-	-	-	-
ADDED SWPF INFORMATION, ARV AND NOTE											
REV. NO.	DATE	DRW	DRW	CHD	SUPV	RWD	APPD	ISSD	PROJECT	AS CONST	DISP/REF
SCALE: 1"=50' EXCEPT AS NOTED											
CIVIL YARD											
KIF - UTILITY EXTENSIONS											
HARRIMAN UTILITY BOARD - WATER											
PLAN SHEET 8 OF 12											
DESIGNED BY:	DRAWN BY:	CHEKED BY:	SUPERVISED BY:	REVIEWED BY:	APPROVED BY:	ISSUED BY:					
JLK	JMG	D.L.J.									
KINGSTON FOSSIL PLANT TENNESSEE VALLEY AUTHORITY FOSSIL AND HYDRO ENGINEERING											
AUTOCAD R07 DATE 3/17/09 36 C 767-HW010.2 R 2											

RECORD DRAWING
12-14-2010

LAKE SHORE DRIVE
TO RAIL ROAD TRACKS
TVA ESR NO. 767
CTI NO. C07070-14

CTI ENGINEERS, INC.
TASK COMPLETED BY: REV NO.

PLOT FACTOR:1:1
C.A.D. DRAWING
W-TVA
DO NOT ALTER MANUALLY

1

2

3

4

5

6

7

 
8

 
9

 
10

11

12







36

C

10W

2

3

4

5

6

7

8

9

10

11

12

A

B

C

D

E

F

G

H

A

B

C

D

E

F

G

H

1

2

3

4

5

6

7


8

9

10

11

12

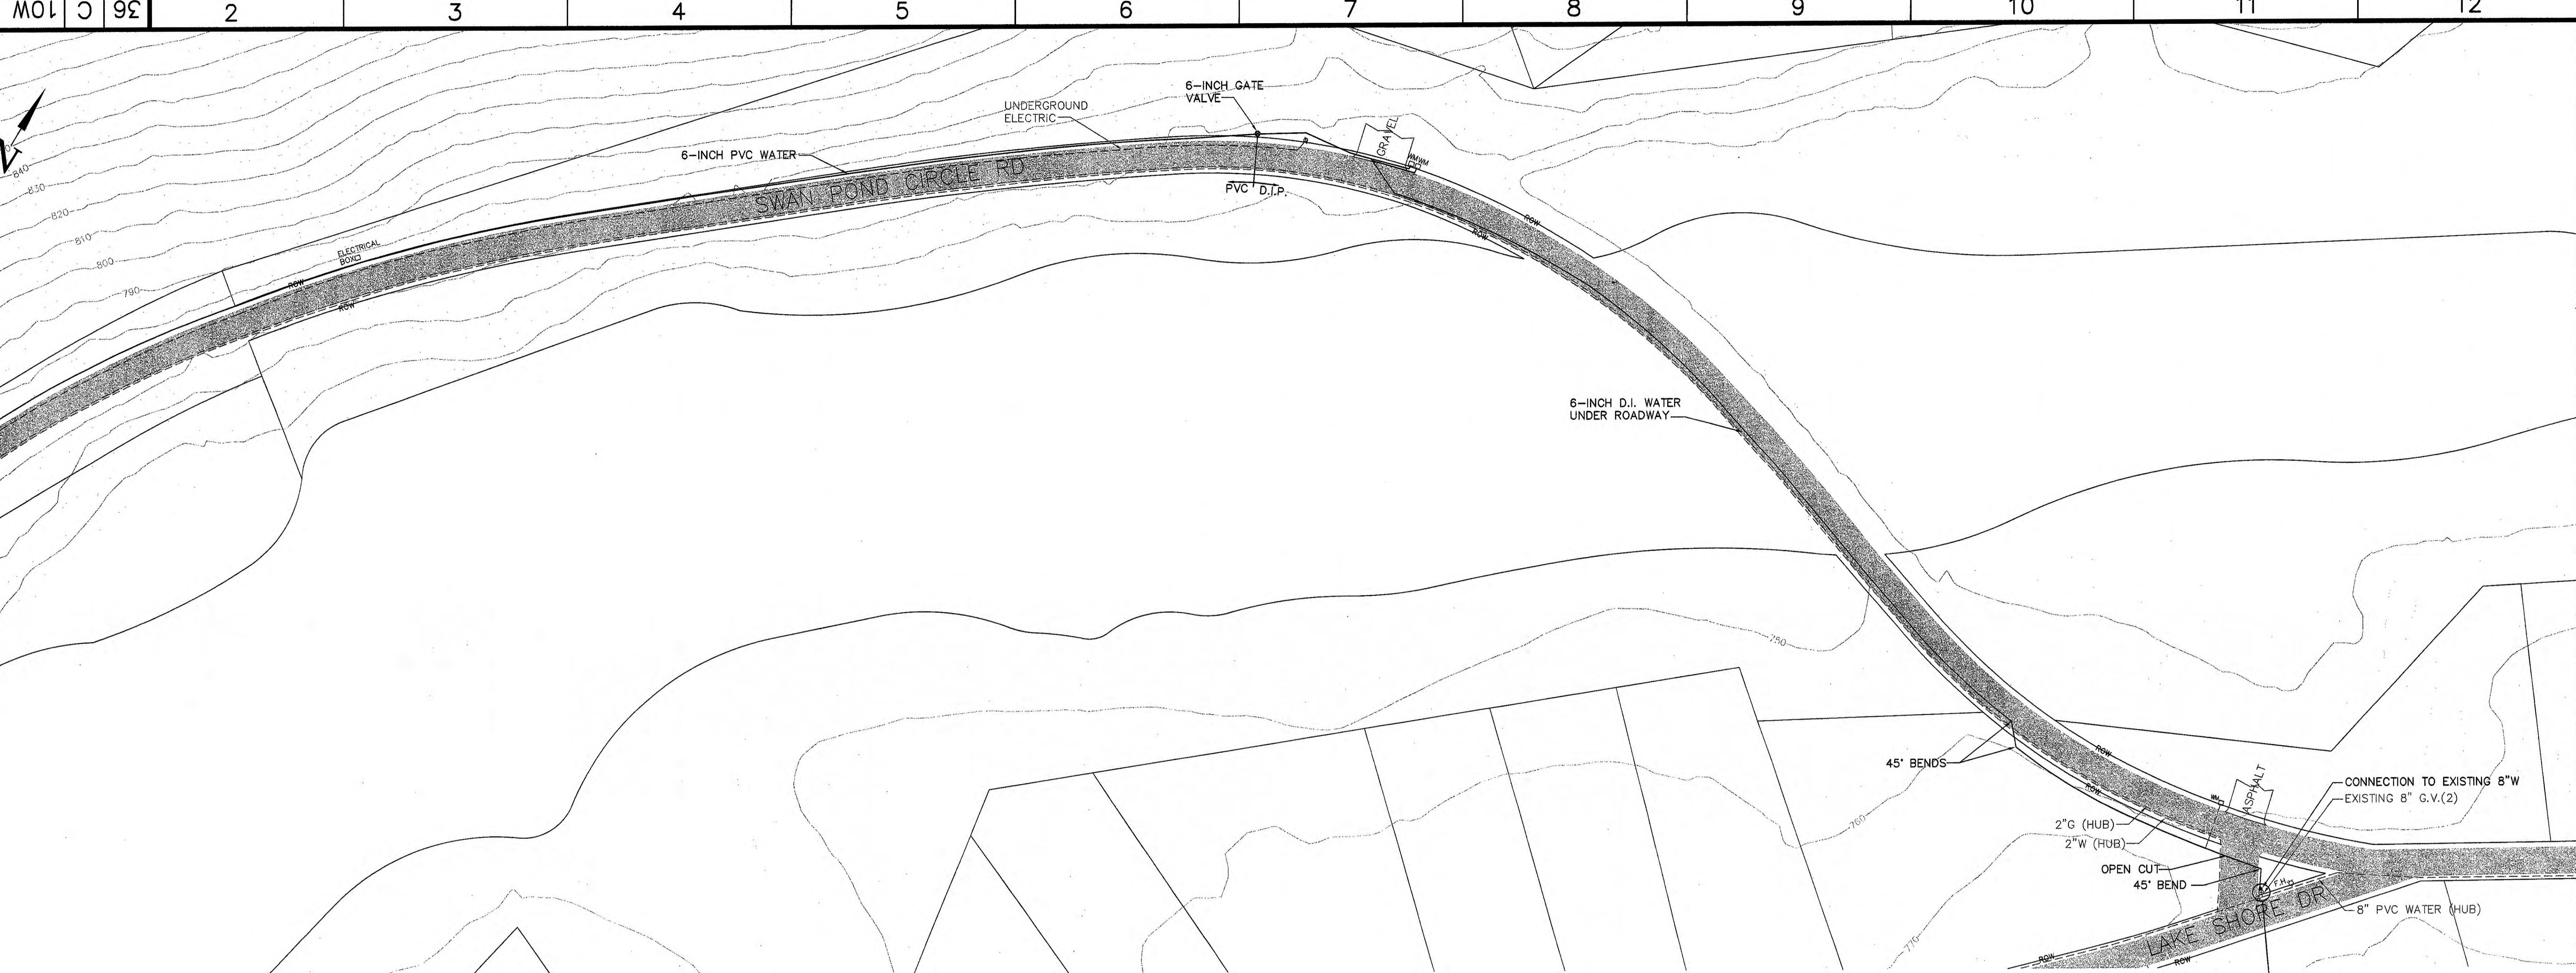


RECORD DRAWING
12-14-2010


LAKE SHORE DRIVE
TO RAIL ROAD TRACKS
TVA ESR NO. 767
CTI NO. C07070-14

CTI ENGINEERS, INC.
TASK COMPLETED BY: REV NO.

R 3	12/14/10	JLK	JMG	JLK	-	-	JLK	-	-	
RECORD DRAWING										
R 1	12/14/10	JLK	JMG	JLK	-	-	JLK	-	-	
RELOCATED AT DIP										
R 1	8/17/09	JLK	JMG	JLK	-	-	JLK	-	-	D
ADDED SWPPP INFORMATION										
REF. NO.	DATE	DESIGN	DRAW.	DKD	SUPV.	RWD.	APPD.	ISSD.	PROJECT ID	PER CO.
SCALE: 1"=50'										EXCEPT AS NOTED
CIVIL YARD										
KIF - UTILITY EXTENSIONS										
HARRIMAN UTILITY BOARD - WATER										
PLAN SHEET 12 OF 12										

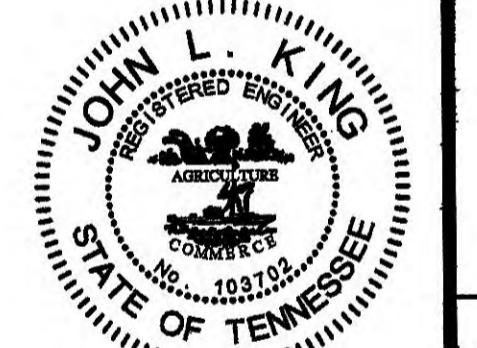

 PLOT FACTOR:1:1
W.L.TVA
C.A.D. DRAWING
DO NOT ALTER MANUALLY



36 C 10W

2

3

4

5

6

7

8

9

10

11

12

A

B



C

D


E

F

G

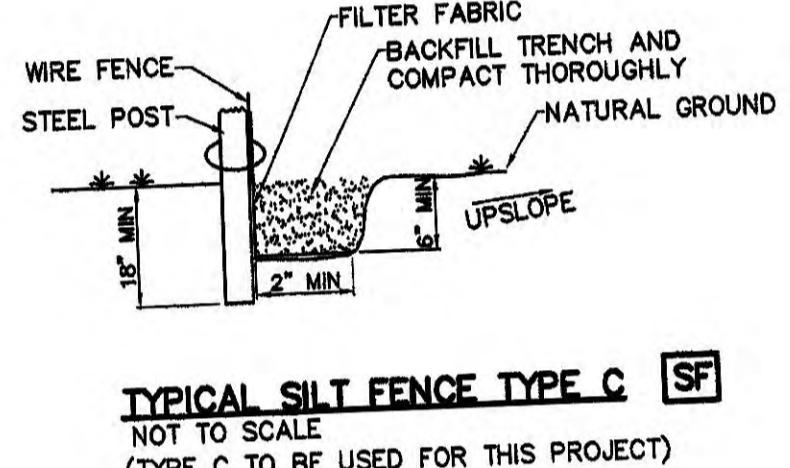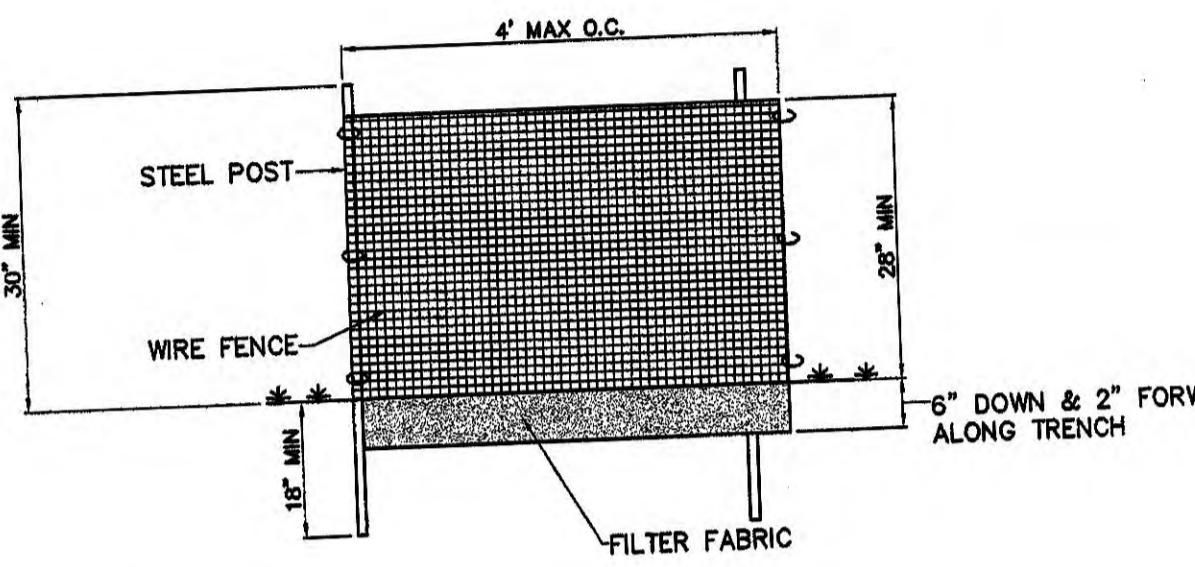

TYPICAL SILT FENCE TYPE C (SF)
NOT TO SCALE
(TYPE C TO BE USED FOR THIS PROJECT)

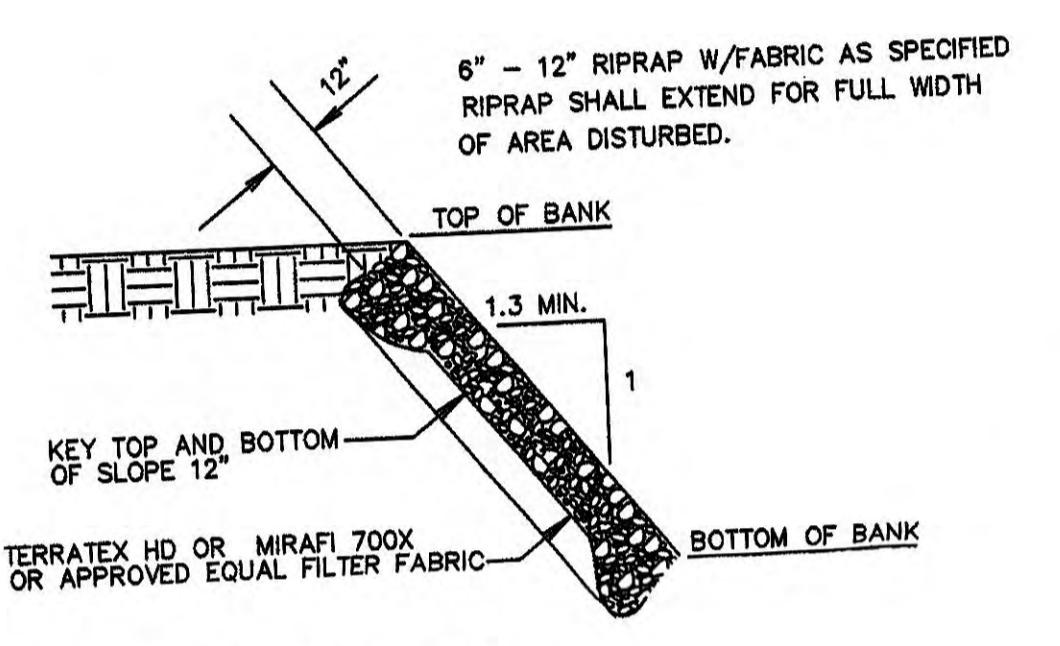

RIPRAP DETAIL
NOT TO SCALE

GENERAL NOTES:

THE FOLLOWING GENERAL EARTHWORK PROCEDURE SHALL BE FOLLOWED FOR CONSTRUCTION OF ROADWAYS, EMBANKMENTS, AND OTHER GENERAL GRADING ACTIVITIES.

- 1) INSTALL EROSION AND SEDIMENT CONTROL MEASURES IN ACCORDANCE WITH TENNESSEE DEPARTMENT OF ENVIRONMENT AND CONSERVATION (TDEC) REQUIREMENTS.
- 2) CONTRACTOR IS TO REFER TO THE TENNESSEE DEPARTMENT OF ENVIRONMENT AND CONSERVATION DIVISION OF WATER POLLUTION CONTROL FOR DETAILS ON INSTALLING AND MAINTAINING THE EROSION CONTROL DEVICES CALLED FOR IN THIS PLAN.

3) SEEDING:
A. THE CONTRACTOR IS TO APPLY TEMPORARY OR PERMANENT SEEDING TO ANY COMPLETED ACTIONS OF WORK. THE CONTRACTOR SHALL SEED AND MAINTAIN THESE AREAS TO MINIMIZE THE AMOUNT OF DISTURBED AREA PER SPECIFICATIONS.

B. APPLY TEMPORARY SEEDING WHENEVER GRADING OPERATIONS ARE TEMPORARILY HALTED FOR OVER 14 DAYS AND FINAL GRADE OF EXPOSED SURFACES IS TO BE COMPLETED WITHIN ONE YEAR. APPLY TEMPORARY SEEDING TO SOIL STOCKPILES PER SPECIFICATIONS.

C. APPLY PERMANENT SEEDING WHENEVER GRADING OPERATIONS ARE COMPLETED AND ALL CONSTRUCTION OPERATIONS WILL NOT IMPACT THE DISTURBED AREA. APPLY PERMANENT SEEDING TO ALL NON-CONSTRUCTION AREAS WHICH SHOW SIGNS OF EXCESSIVE EROSION PER SPECIFICATIONS.

D) ALL SILT FENCE SHOULD BE INSTALLED ALONG THE CONTOUR, NEVER UP OR DOWN A SLOPE. THE DRAINAGE AREA SHOULD NOT EXCEED 1/4 ACRE FOR EVERY 100 FEET OF SILT FENCE.


CRITERIA FOR SILT FENCE PLACEMENT:

LAND SLOPE(%)	MAXIMUM SLOPE LENGTH ABOVE FENCE(FT.)
<2	100
2-5	75
5 TO 10	50
10 TO 20	25
>20	15


*IN AREAS WHERE THE SLOPE IS GREATER THAN 20%, A FLAT AREA LENGTH OF 10 FEET BETWEEN THE SLOPE AND THE FENCE SHOULD BE PROVIDED.

5) IN AREAS WHERE THE PROPOSED WATERLINE IS UNDER THE EXISTING ROADSIDE DITCH, ROCK CHECK DAMS ARE TO BE NO GREATER THAN 1 FOOT IN HEIGHT AND NO DEEPER THAN 2 FEET. THE EXISTING ROADSIDE DITCHES ARE ON AVERAGE 10 FEET DEEP. THE ROCK CHECK DAMS ARE TO BE 1 FOOT IN HEIGHT TO ENSURE THAT WATER WILL NOT BE PUSHED OUT IN TO THE ROADWAY BY THE CHECK DAM DURING HEAVY RAIN EVENTS.

6) DETAILS FOR STRUCTURAL PRACTICES SHOWN IN: "TENNESSEE EROSION AND SEDIMENT CONTROL HANDBOOK", DATED MARCH 2002.

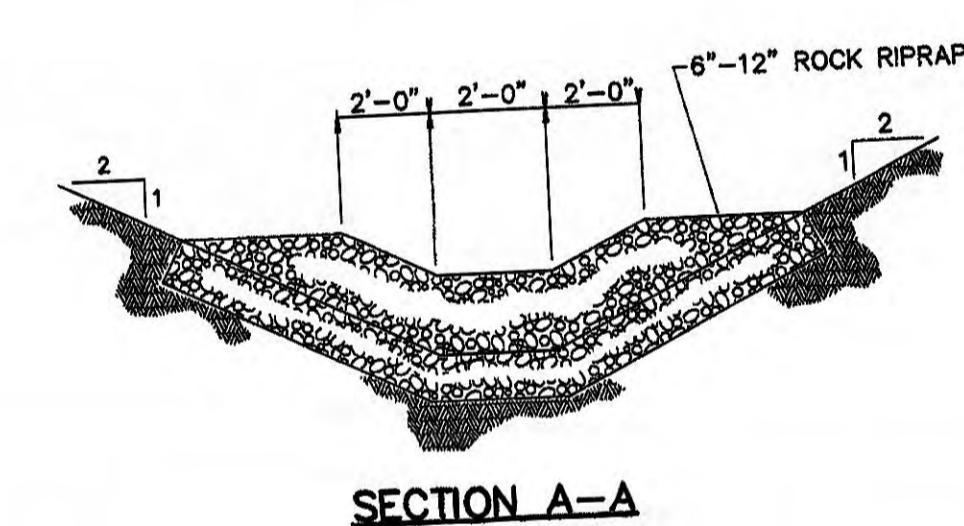


SECTION A-A

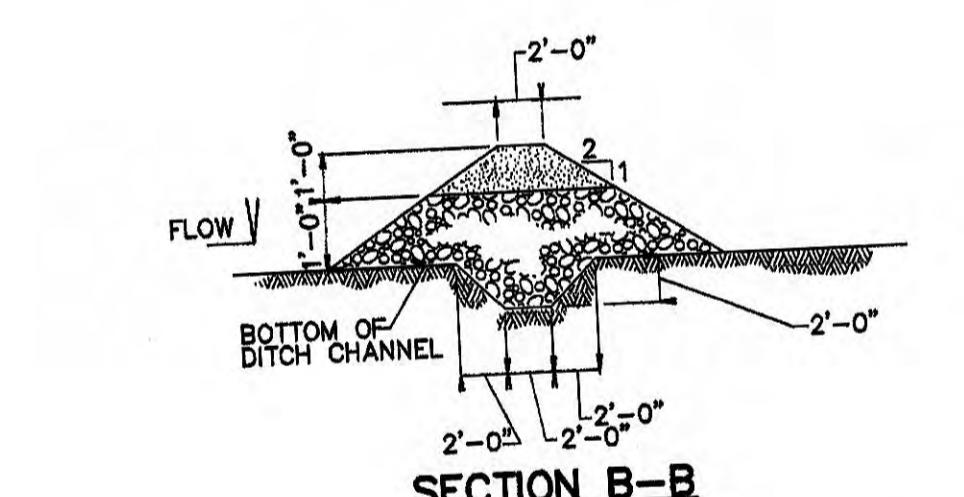


L = THE DISTANCE SUCH THAT POINTS A AND B ARE OF EQUAL ELEVATION

SPACING BETWEEN CHECK DAMS

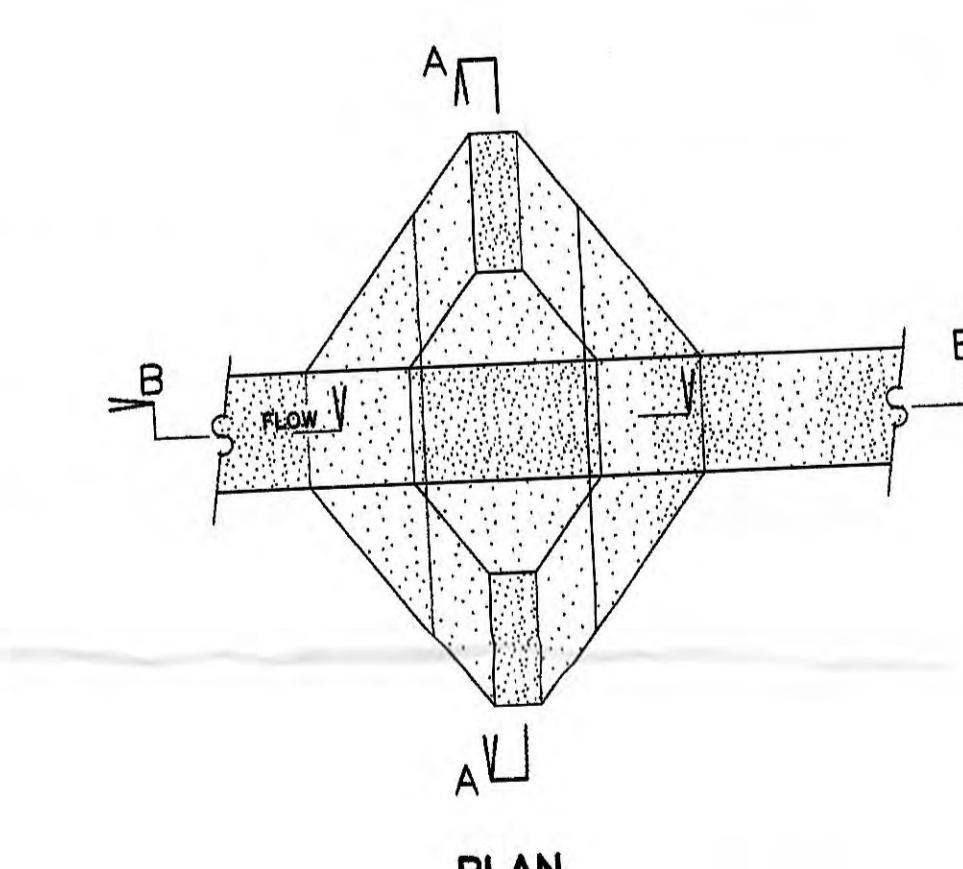


STONE CHECK DAM
NOT TO SCALE

REQ'D ON BRANCH CROSSINGS AND/OR WHERE SHOWN
ON DRAWINGS. BACKFILLED WITH CLAY MATERIAL (NO
ORGANIC MATERIAL). FROM 1-FOOT BELOW BOTTOM OF
TRENCH TO 6-INCHES TO 12-INCHES FROM TOP
OF GROUND AND 1-FOOT OUTSIDE EACH SIDE OF TRENCH.
(TYPICAL EACH SIDE)

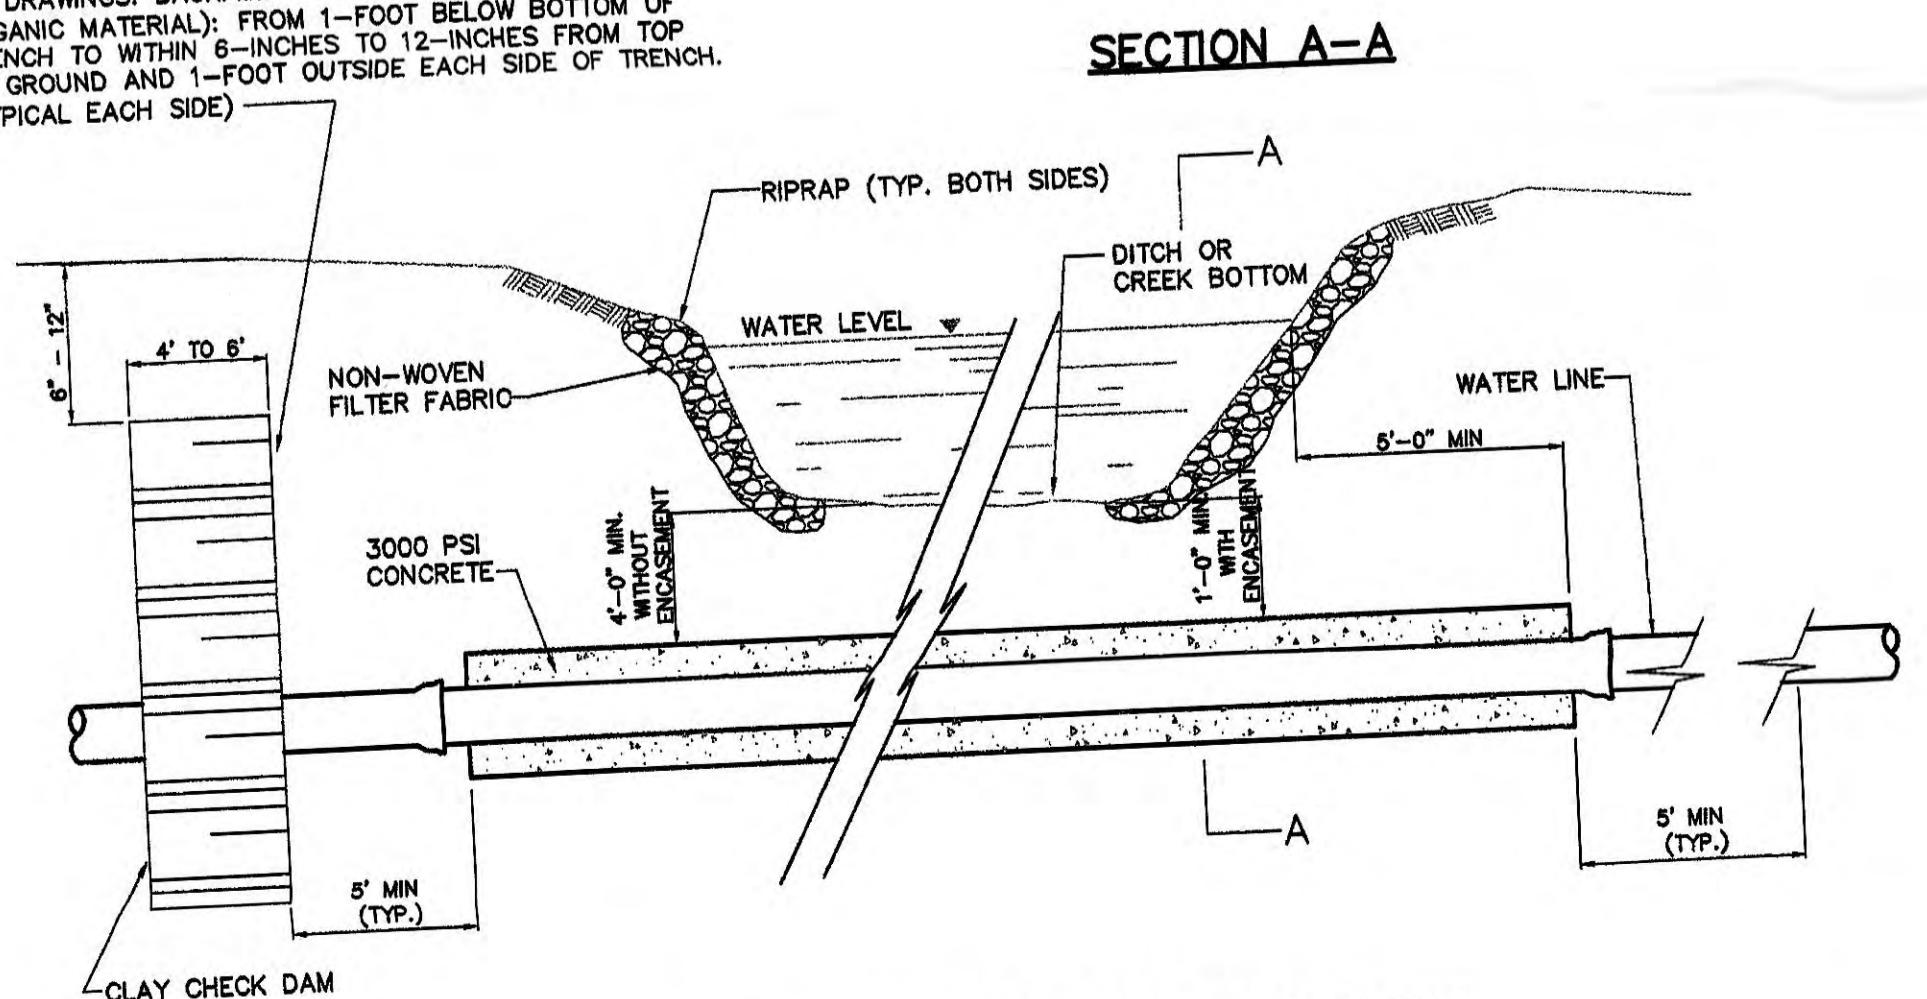

BRANCH OR DITCH CROSSING DETAIL
NOT TO SCALE

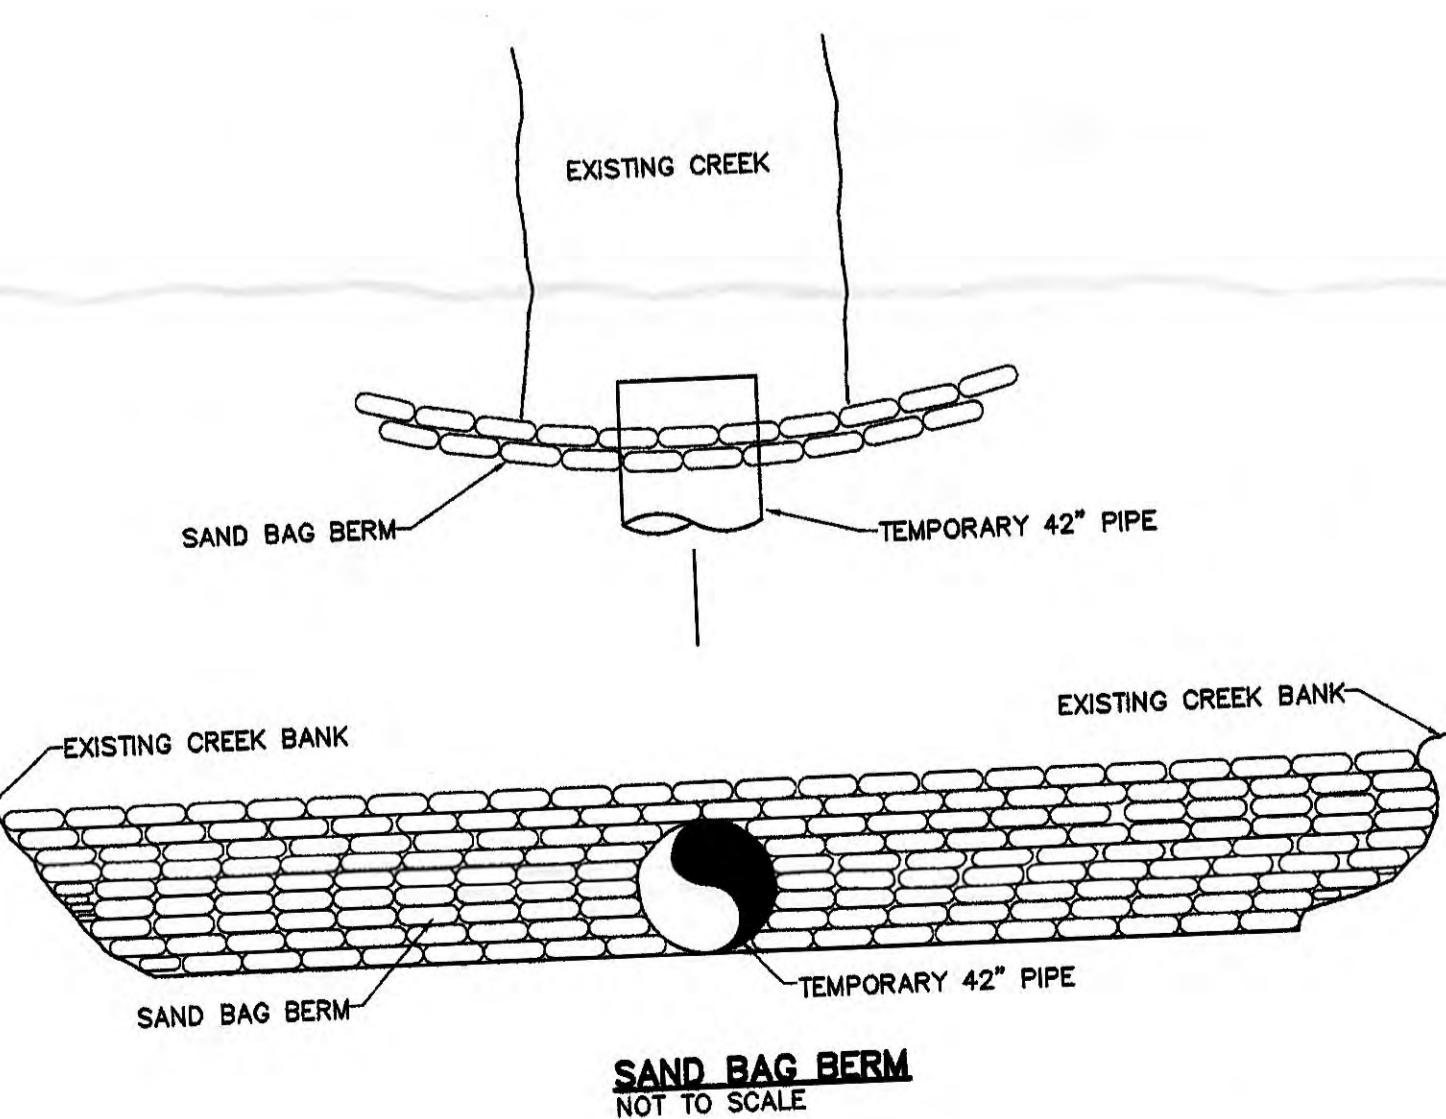

R	JLK	JMG	JLK	-	-	-	-	-	-	-	-	-
R 1	12/14/10	JLK	JMG	JLK	-	-	-	-	-	-	-	-
RECORD DRAWING												
REV. NO.	DATE	DSGN	DRW	CHG	SUPV	RVWD	APPO	ISSD	PROJECT	AS CONST	CD	DISP/INTERFA
EXCEPT AS NOTED												
SCALE: AS SHOWN												
YARD CIVIL												
KIF - UTILITY EXTENSIONS												
HARRIMAN UTILITY BOARD - WATER												

36

C

10W

2

3

4

5

6

7

8

9

10

11

12

A

B

C

D

E

F

G

H



**RECORD DRAWING
12-14-2010**


**PLAN
SCALE: 1"=500'**

LEGEND

- PROPOSED UTILITY
- PROPOSED UTILITY
- - - EXISTING UTILITY OR OTHER


TVA ESR NO. 765, 766, 767
CTI NO. C07070-12, 13, 14

CTI ENGINEERS, INC.
TASK COMPLETED BY: REV NO.

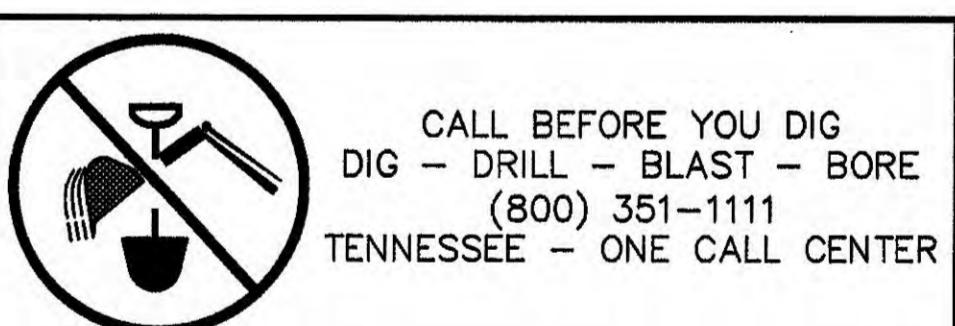

R 1	12/14/10	JLK	JMG	JLK	—	—	JLK	—	—	D				
RECORD DRAWING										DRILLS INTERFA				
REV. NO.	DATE	DESIGN	DRILL	CHECK	SUPPLY	PWD	APPRO	ISSUED	PROJECT ID	AS CONST				
									SB					
SCALE: 1"=500'										EXCEPT AS NOTED				
CIVIL YARD														
KIF - UTILITY EXTENSIONS														
HARRIMAN UTILITY BOARD - WATER														
GENERAL PLAN														
DESIGNED BY:	DRAWN BY:	CHECKED BY:	SUPERVISED BY:	REVIEWED BY:	APPROVED BY:	ISSUED BY:								
J.L.K.	J.M.G.	D.L.J.												
KINGSTON FOSSIL PLANT TENNESSEE VALLEY AUTHORITY FOSSIL AND HYDRO ENGINEERING											R 1			
AUTOCAD R07											3/17/09	36	C	ALL-HW002.1
											PLOT FACTOR:1:1 W-TVA			

C.A.D. DRAWING
DO NOT ALTER MANUALLY

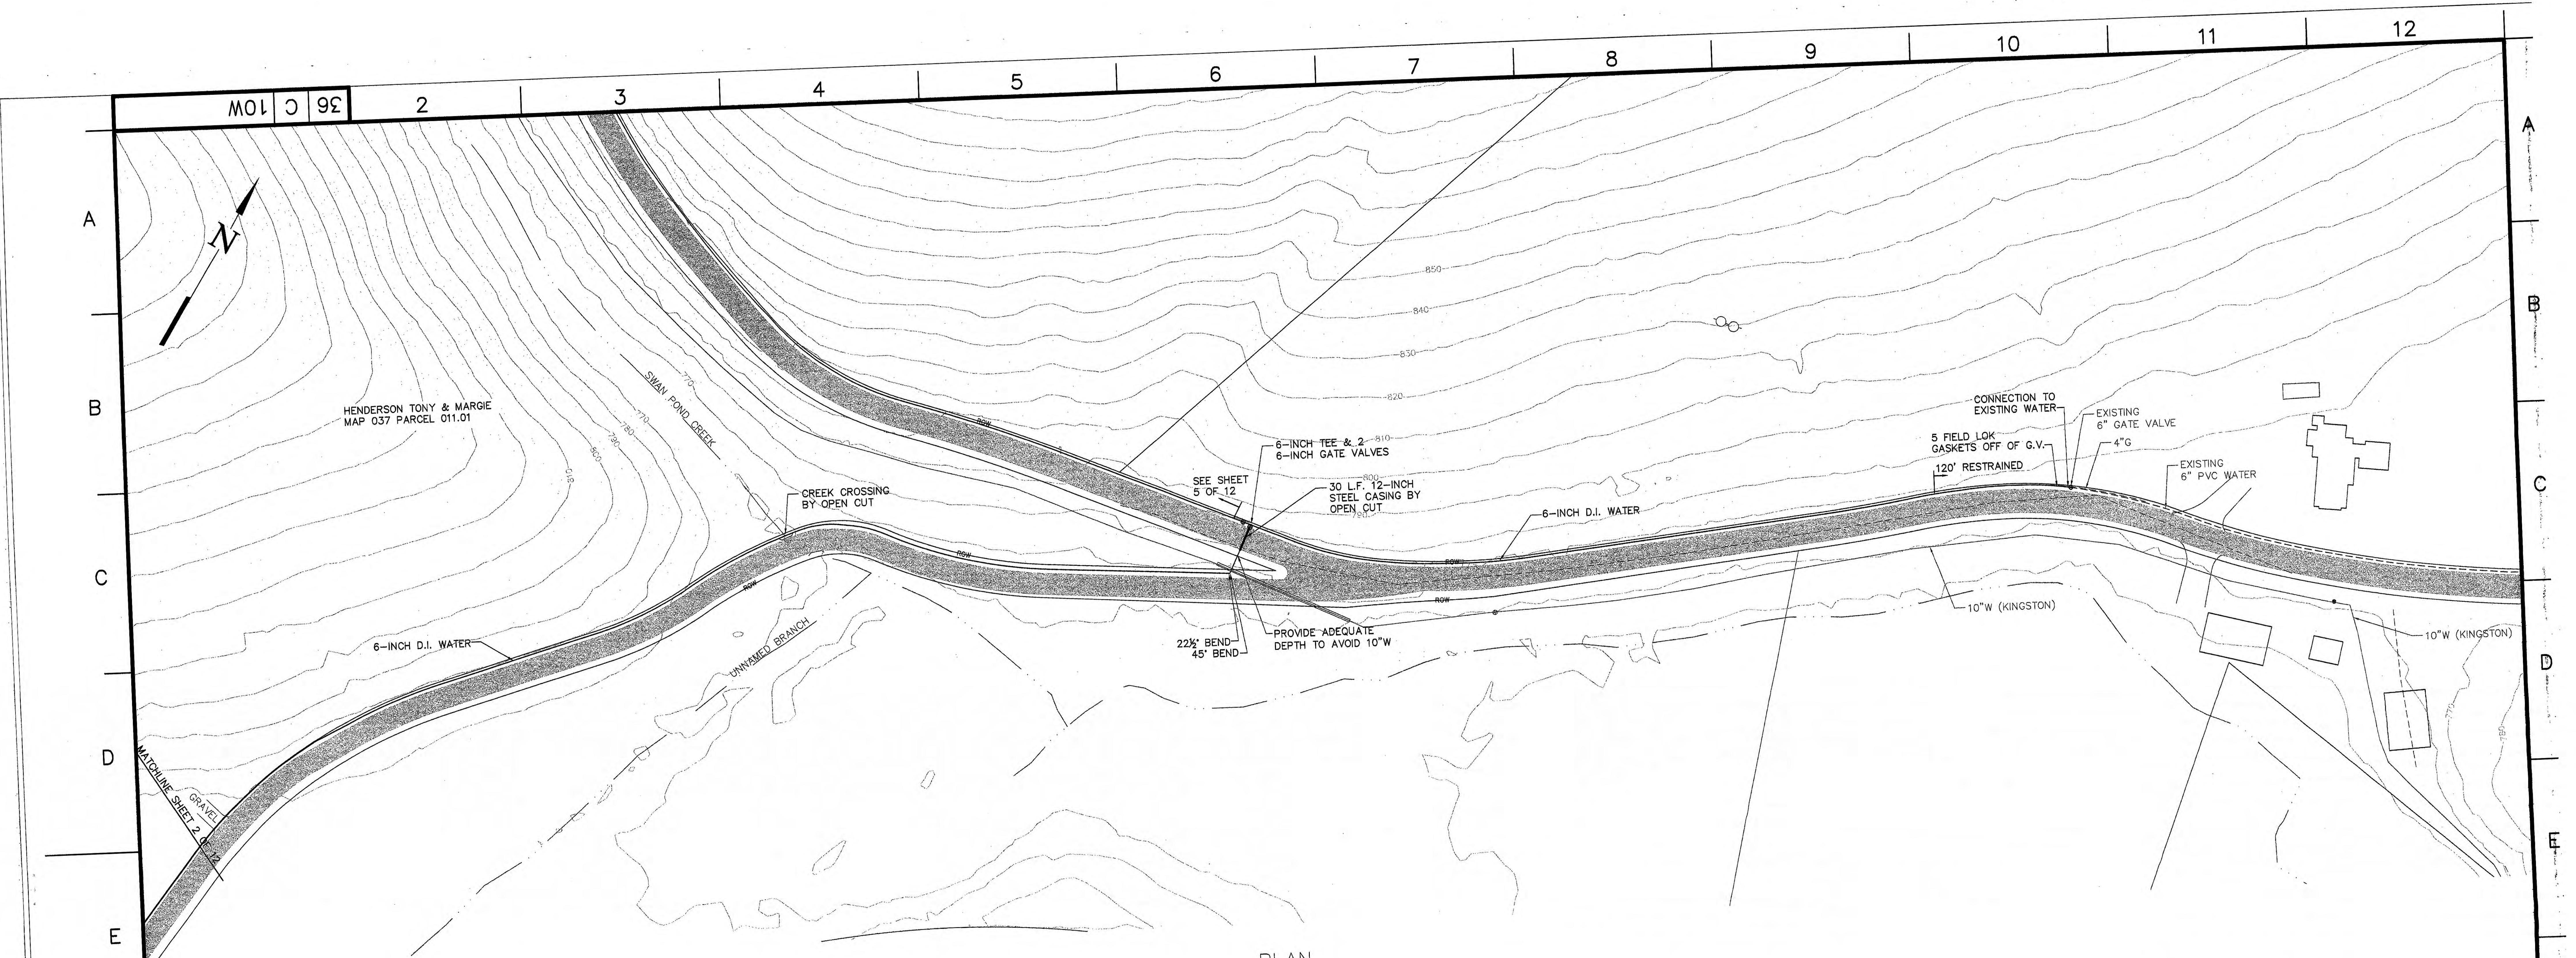


PLAN

CIVIL
YARD

KIF - UTILITY EXTENSIONS
HARRIMAN UTILITY BOARD - WATER
PLAN SHEET 1 OF 12

PLAN SHEET NO. 1						
FARM TO HASSSLER MILL ROAD	DESIGNED BY: J.L.K.	DRAWN BY: J.M.G.	CHECKED BY: D.L.J.	SUPERVISED BY:	REVIEWED BY:	APPROVED BY:
KINGSTON FOSSIL PLANT TENNESSEE VALLEY AUTHORITY FOSSIL AND HYDRO ENGINEERING						
TVA ESR NO. 765 CTI NO. C07070-12	AUTOCAD R07	DATE 3/17/09	36	C	765-HW003.2	R 2
PLOT FACTOR:1:1						
C.A.D. DRAWING						

 RECORD DRAWING
12-14-2010



36 C 10W

2

3

4

5

6

7

8

9

10

11

12

A

B

C

D

E

F

G

H

A


B

C

D

E

F

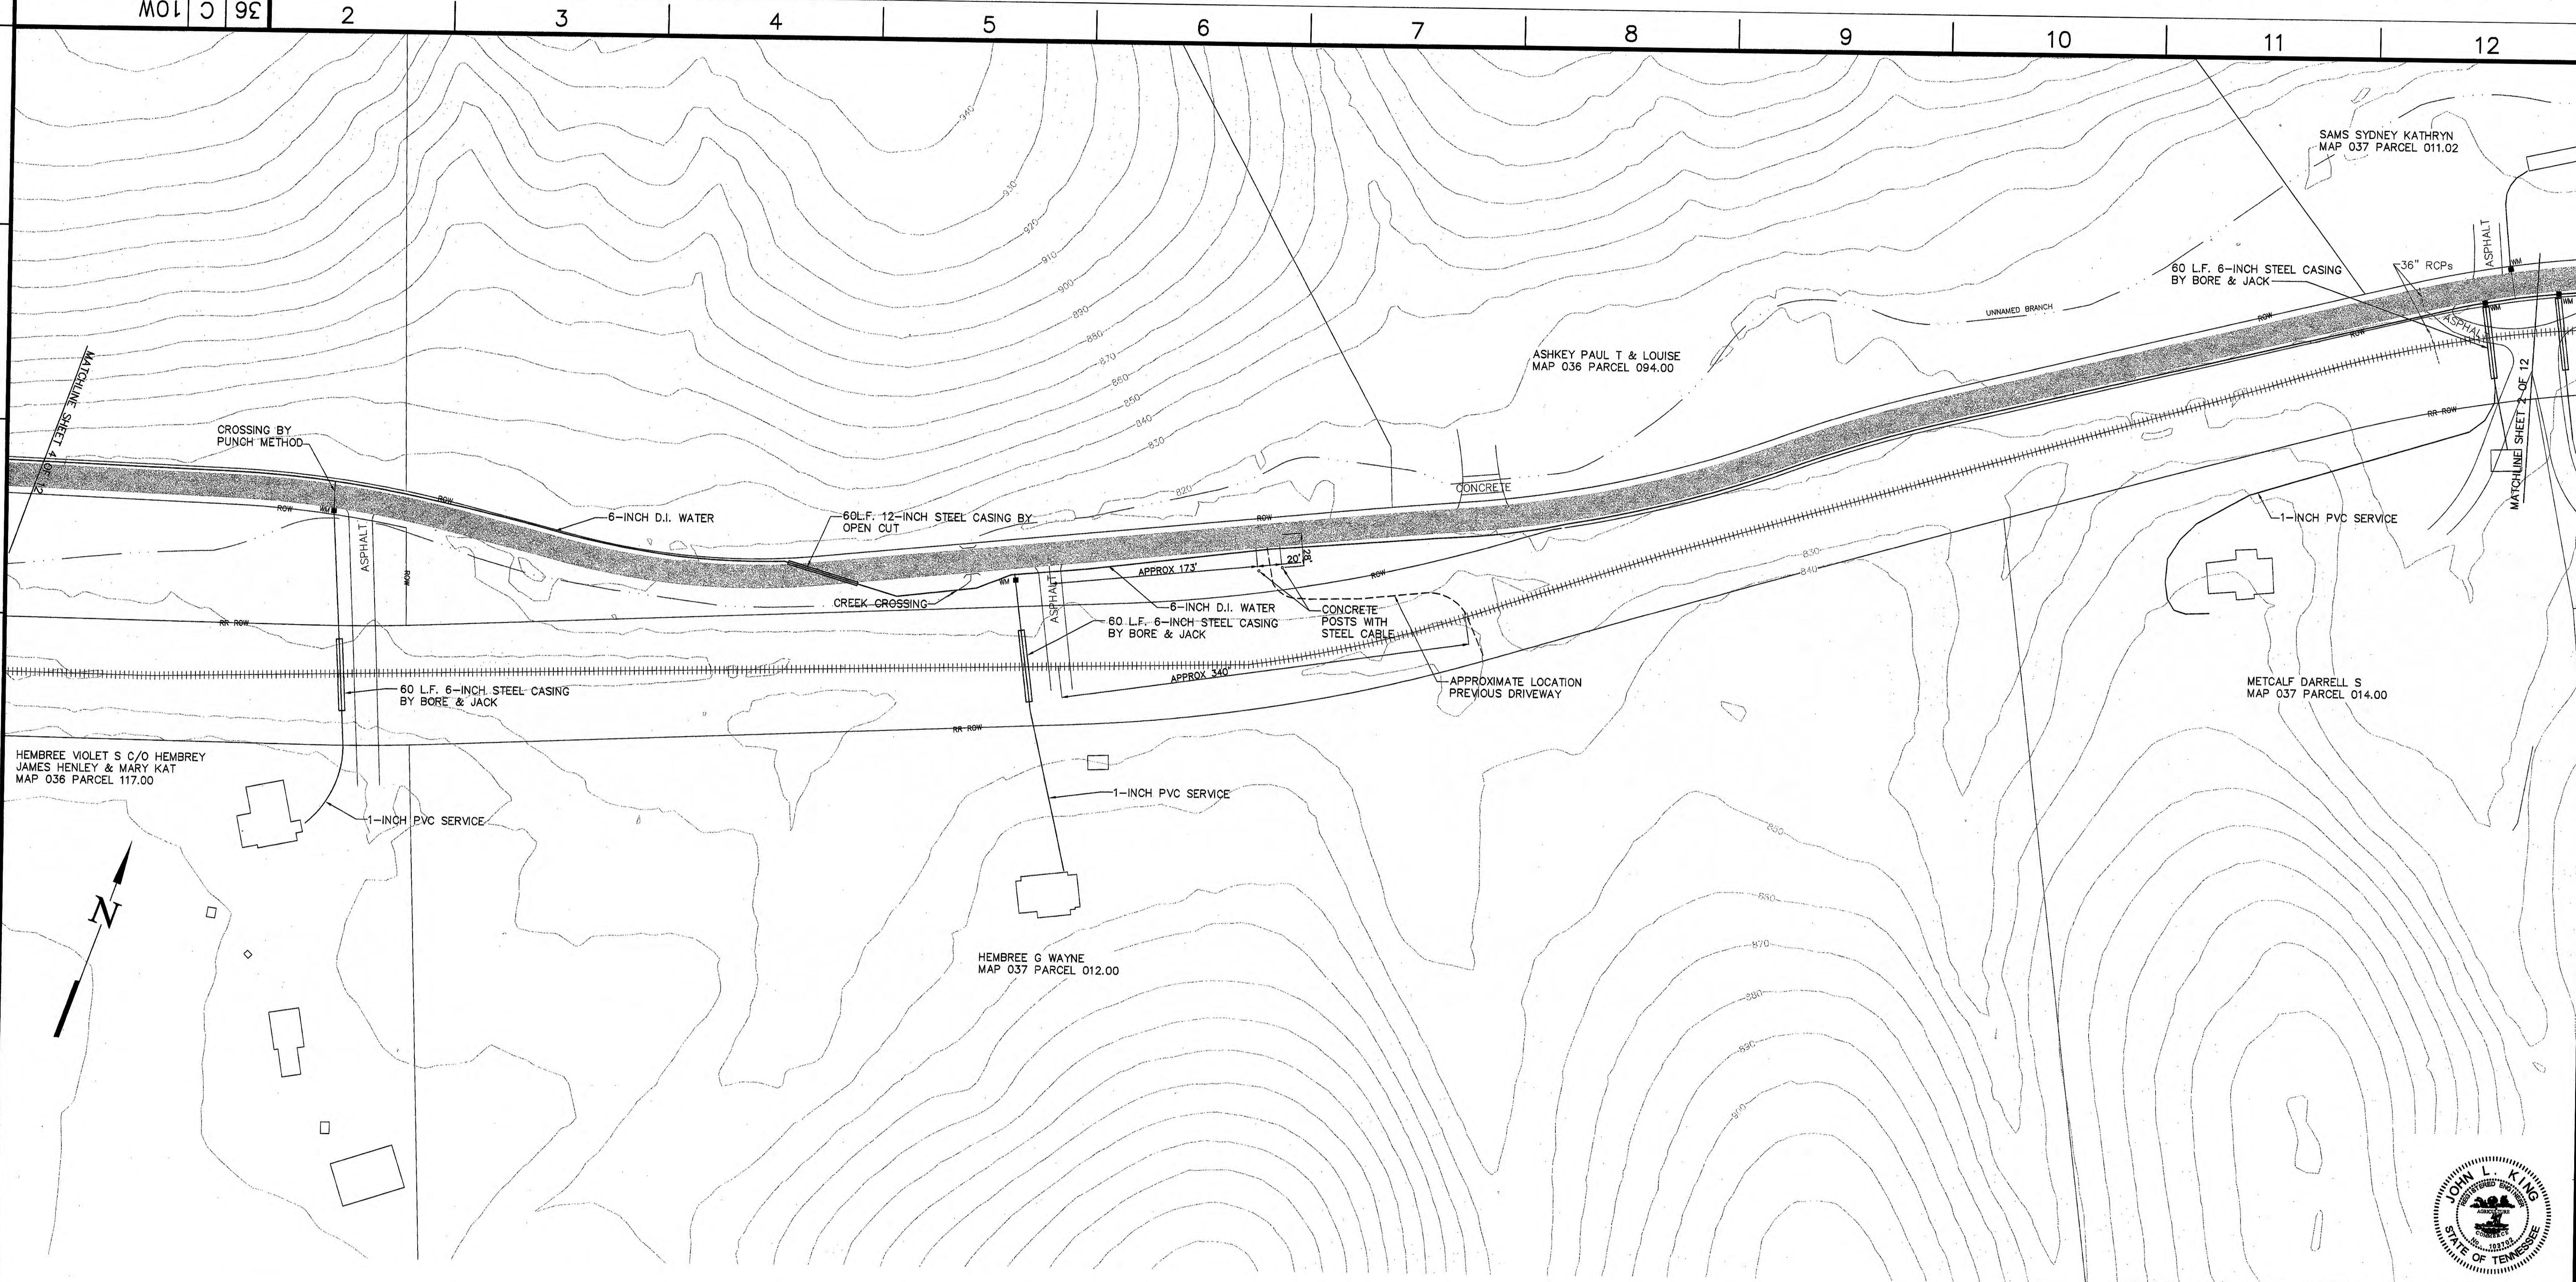

RECORD DRAWING
12-14-2010

FARM TO HASSSLER
MILL ROAD

TVA ESR NO. 765
CTI NO. C07070-12

CONSOLIDATED TECH., INC.
TASK COMPLETED BY: REV NO.



R 2 12/14/10 JLK JMG JLK - - JLK - -
RECORD DRAWING JLK JMG JLK - - JLK - -
R 1 8/17/09 JLK JMG JLK - - JLK - -
CHANGED CASING MATERIAL AND ADDED SWPPP INFORMATION
RE. DATE DESN DRIN CHDO SUPV RWD APPD ISSD PROJECT AS CONST
SCALE: 1"=50'
EXCEPT AS NOTED

CIVIL
YARD

KIF - UTILITY EXTENSIONS
HARRIMAN UTILITY BOARD - WATER
PLAN SHEET 3 OF 12

DESIGNED BY: JLK.	DRAWN BY: JMG.	CHECKED BY: DLJ.	SUPERVISED BY: -	REVVED BY: -	APPROVED BY: -	ISSUED BY: -
KINGSTON FOSSIL PLANT TENNESSEE POWER & LIGHT COMPANY FOSSIL AND HYDRO ENGINEERING						
AUTOCAD R07	DATE 3/17/08	36	C	765-HW005.2	R 2	PLOT FACTOR:1:1 W-TVA C.A.D. DRAWING DO NOT ALTER MANUALLY

