


Line Blanked Out under the 1st we HAD To Pull
500 feet Roll of Poly under - 190 This is a Solid Piece
with No Fuses. See PHOTOS - WE came on the way to
The valley on each side. This line was broke
About the middle of the West Bound Cave,
The way I know This is when we pulled the
old out, it didn't come from Jet valley side
Then we measured off the old piece. HAD
To Push the 2nd By Hand from Jet valley side
Toward Nat. v. Hollow.




10/19/60
Bayer's Band I-40 and instructed a
6" plastic casing with a 3" gate
UNTER LINE UNDER THE INTERMEDIATE
AND THEN THEY TRID BACK INTO 2" PLASTIC
ON EACH SIDE OF THE INTERSTATE.
HUB RAN A 2" PLASTIC LINE UP ASH CROWNED
TO SCOTTE AND WENT UP THE HILL TO MR SCOTTS
THEN WE WENT UNDER THE ROAD WITH A 1" PLASTIC
LINE. WE USED THE 2" TRANSITE LINE AS A
SLEEVE AND TRID BACK INTO A 2" PLASTIC LINE

11/20/60 SEE NOTE BOTTOM LEFT.

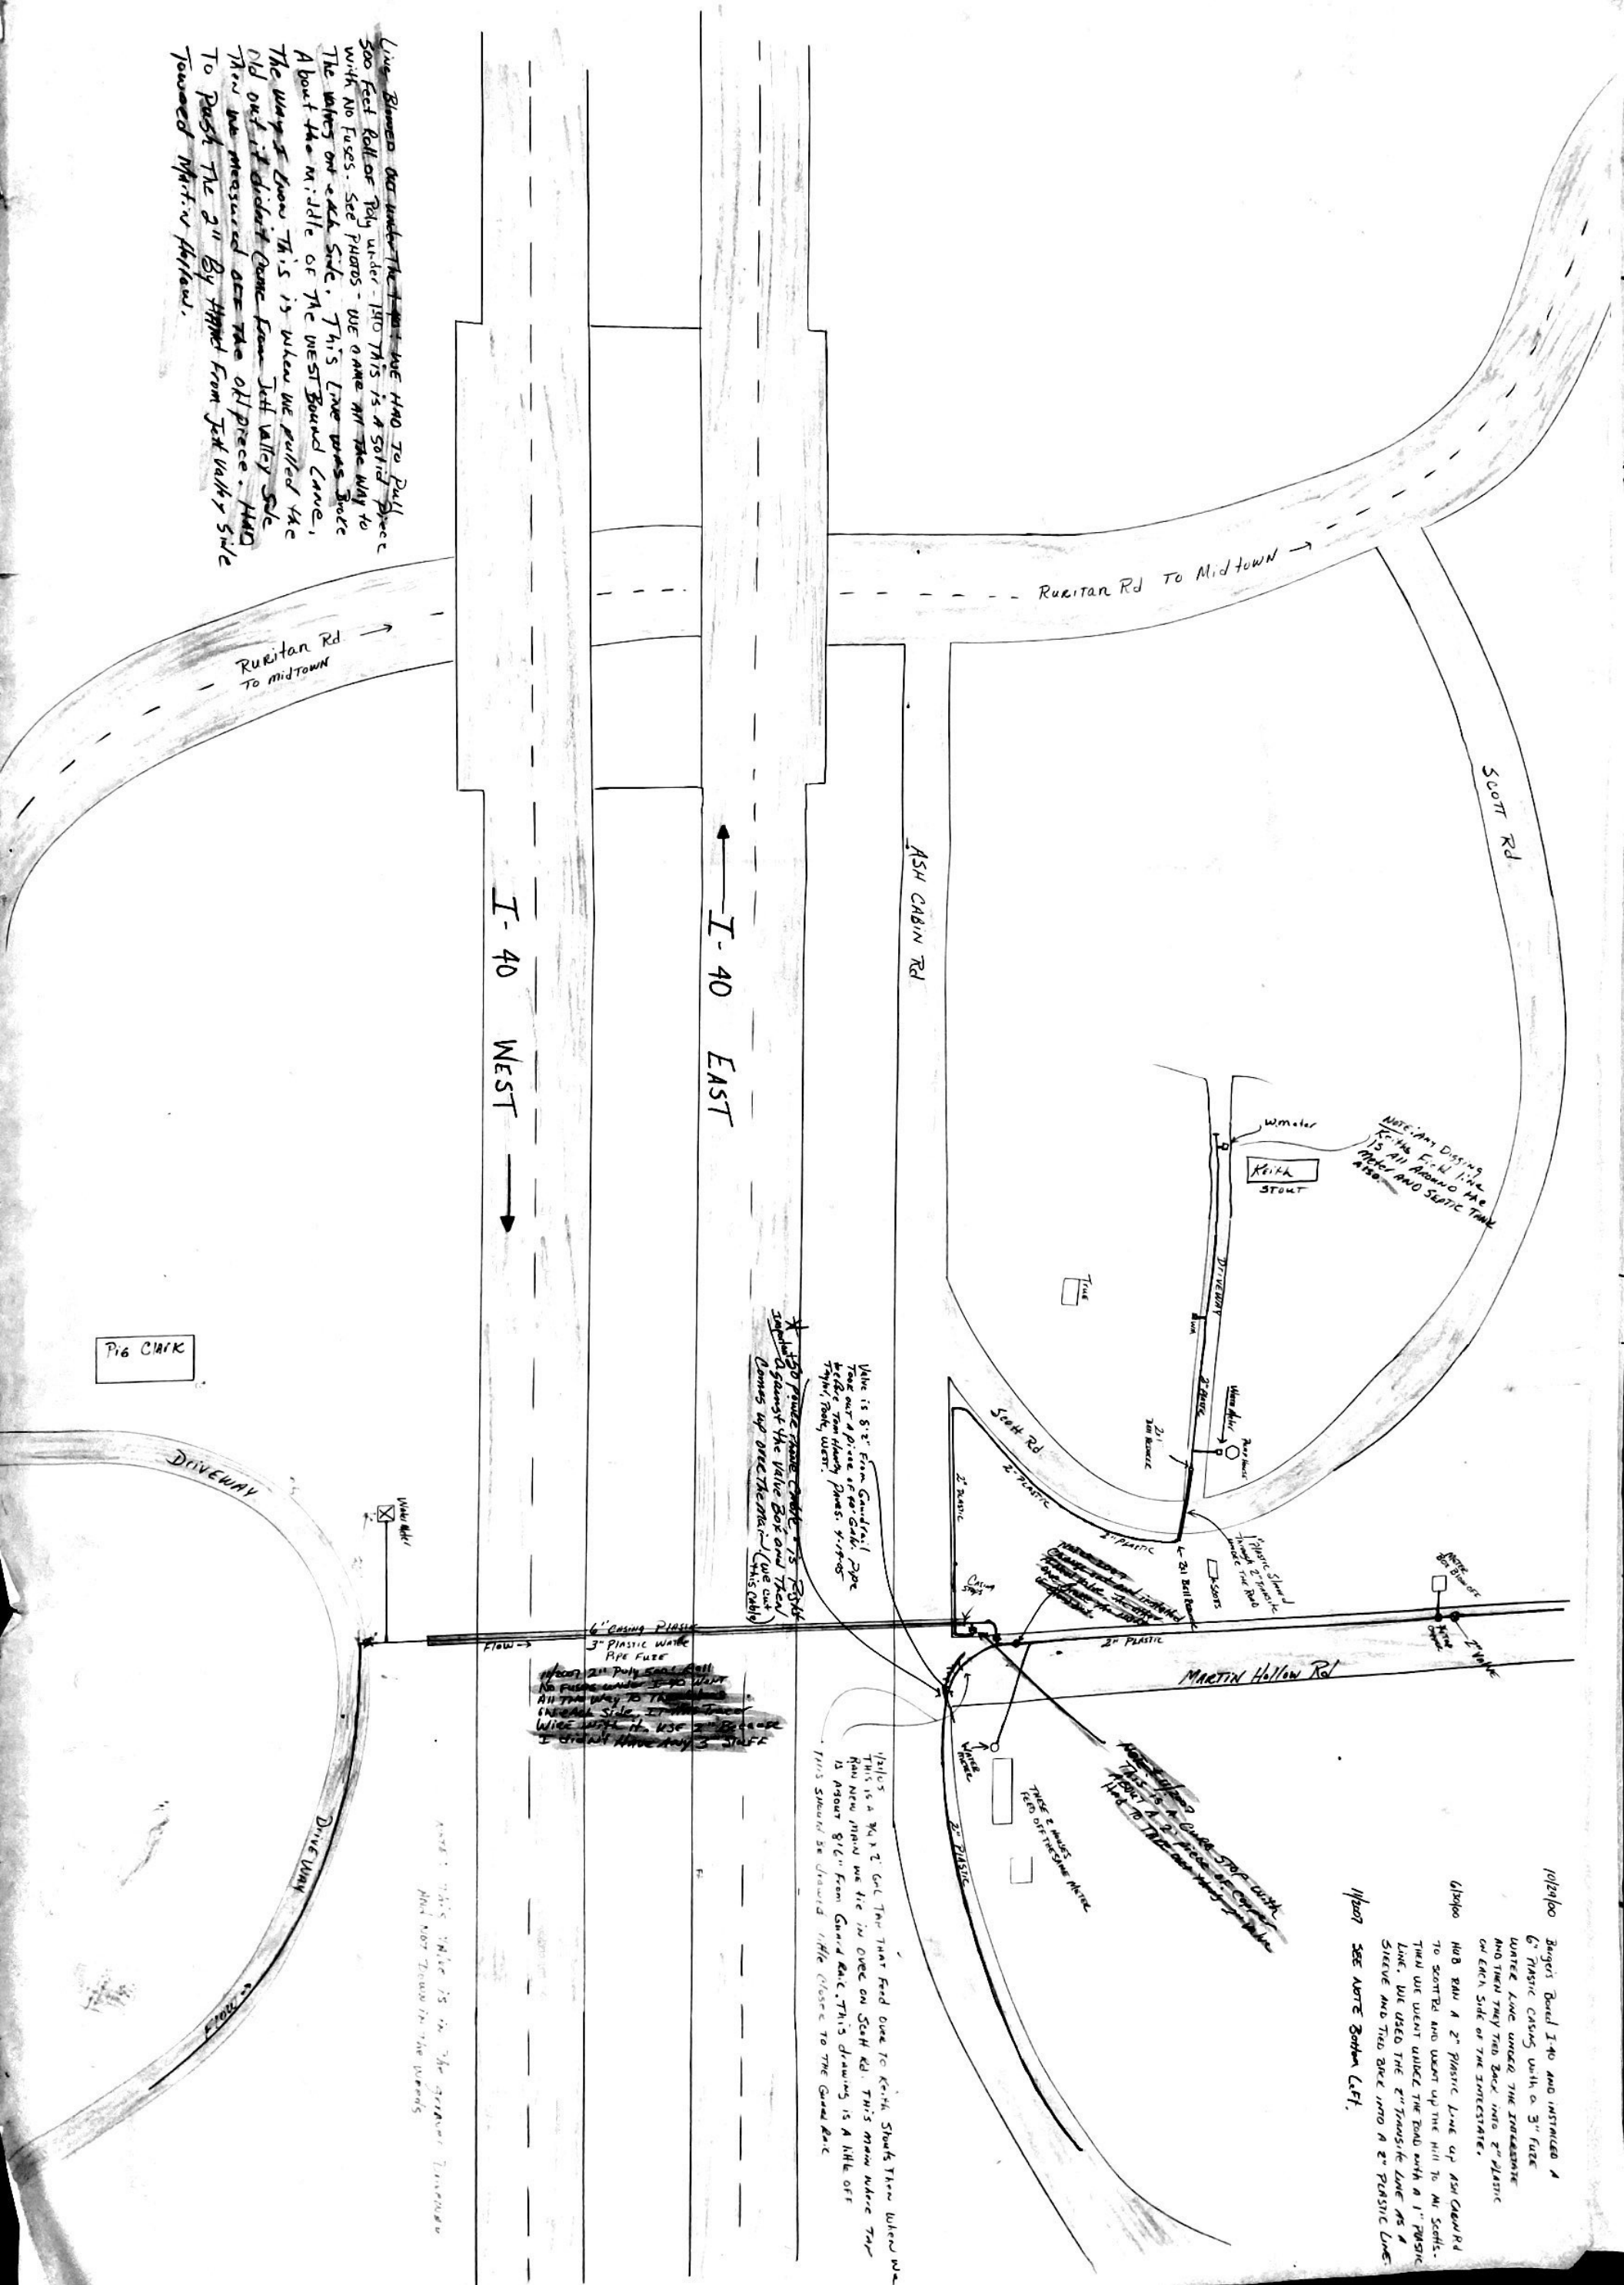

DEVONIA STREET, HARRIMAN, TENNESSEE


DEVONIA STREET, HARRIMAN, TENNESSEE

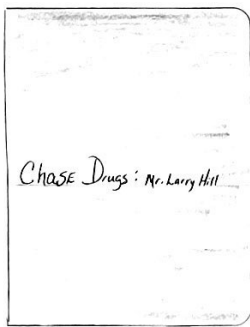

Parking lot

Value kills
Lost Power
Ground Potential
Value

WELDEN STREET
HARRIMAN, TENNESSEE

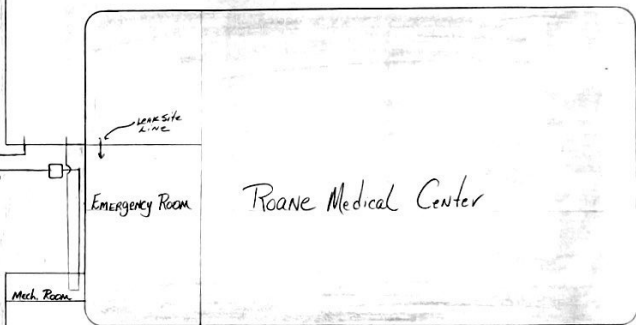

Roane Medical Center Parking Lot

Roane Street, Harriman, Tennessee

Roane Street, Harriman, Tennessee

Lease under E.R. Floor, Had a Company to use ground structure!
May 2008
Roane Medical: Mr. Tim Gault / City of Harriman: Mayor Chris Mason / HHS Mr. Chuck Fava
HVB: Gas Water Source Superintendent: FRANKIE DAVIS

Run
Fall 2004

NOTE *

2" Poly Pipe Run The Edge of Woods.
Only 1 Poly Valve Where it Starts down The
Runway

Revised


This is the
New line that
was installed so they
could add onto the runway

2" Poly Valve
Gore

Pump Station

NOTE
#309 under
299

NOTE
This Part is in
A 4" GAS Pipe
Sleeve for ABOUT
100 Feet, because
of Rock.

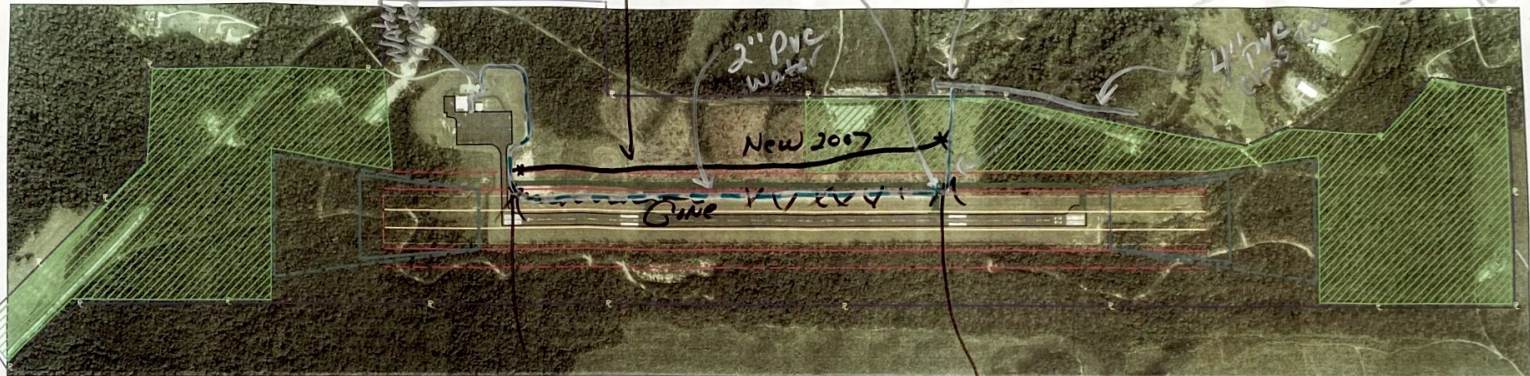

LEGEND		
ITEM	EXISTING	FUTURE
RUNWAY & TAXIWAY		
RUNWAY & TAXIWAY MARKINGS		
AIRPORT PROPERTY LINE		SAME
RUNWAY SAFETY AREA		
RUNWAY OBJECT FREE AREA		
RUNWAY PROTECTION ZONE		
NON AVIATION LAND USE	N/A	

← 2" Poly Valve
↑ 2" Fuse Cap

NOTE
When the New
Runway Comes this
line gets moved down into
the woods as of 10/06 it has not
been moved. JEL

2" Cap
Poly Valve

TENNESSEE DEPARTMENT OF TRANSPORTATION AERONAUTICS DIVISION			
LAND USE MAP			
ROCKWOOD MUNICIPAL AIRPORT ROCKWOOD, TN			
HMB PROFESSIONAL ENGINEERS, INC. NASHVILLE, TENNESSEE	SCALE	1"=500'	SHEET NO. 7 OF 7
	DATE	1/2005	
	DRAWN BY:	JEL	

