


CONSTRUCTION PLANS  
FOR  
WATER SYSTEM IMPROVEMENTS  
FOR  
**HARRIMAN UTILITIES BOARD**  
**HARRIMAN, TENNESSEE**  
CONTRACT W93-04  
**WATER TREATMENT FACILITIES**

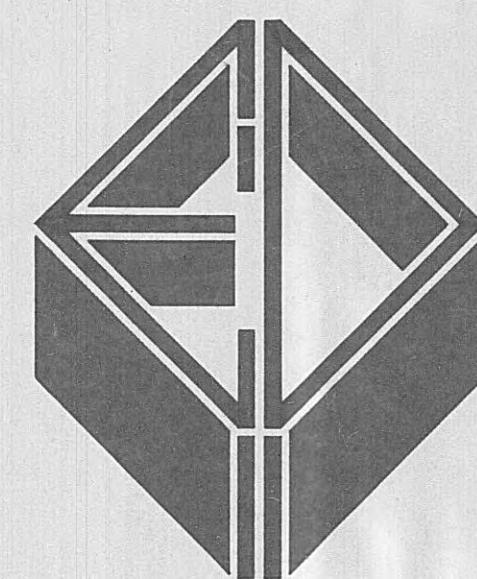


**ELROD · DUNSON, INC.**  
CONSULTING ENGINEERS

Nashville · Knoxville  
Lexington, KY

**AS BUILT**

DATE: 3-20-95  
APPROVED: D.M.

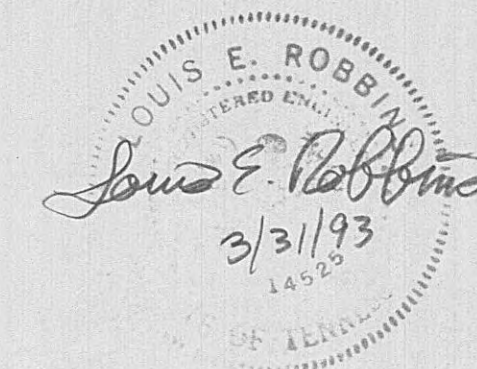


Accepted By: Alvin B. Poole  
Title: Chairman  
For: Harriman Utility Board  
Date: 3-29-93

PROJECT NO. 0592

SET NO.




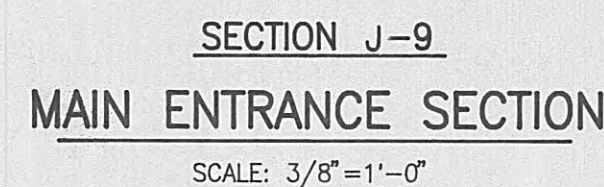


SCALE: 1/8"=1'-0"

# AS BUILT

DATE: 3-20-95  
APPROVED: D.M.

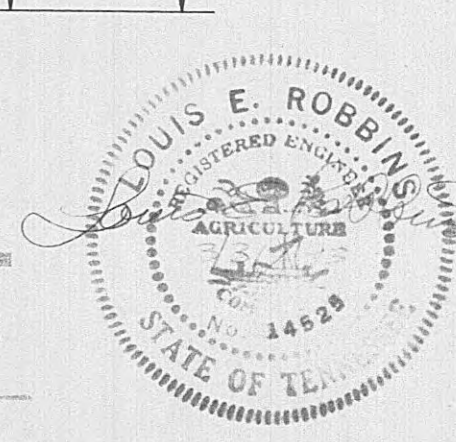




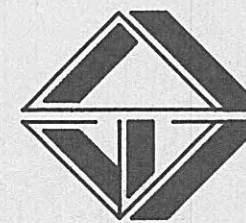


REVISIONS

DESIGNED: L. E. R.  
DRAWN: S. C. G.  
CHECKED: L. E. R.  
DATE: MARCH, 1993  
SCALE: AS NOTED  
PROJ. NO. 0592


SHEET 10  
OF 36

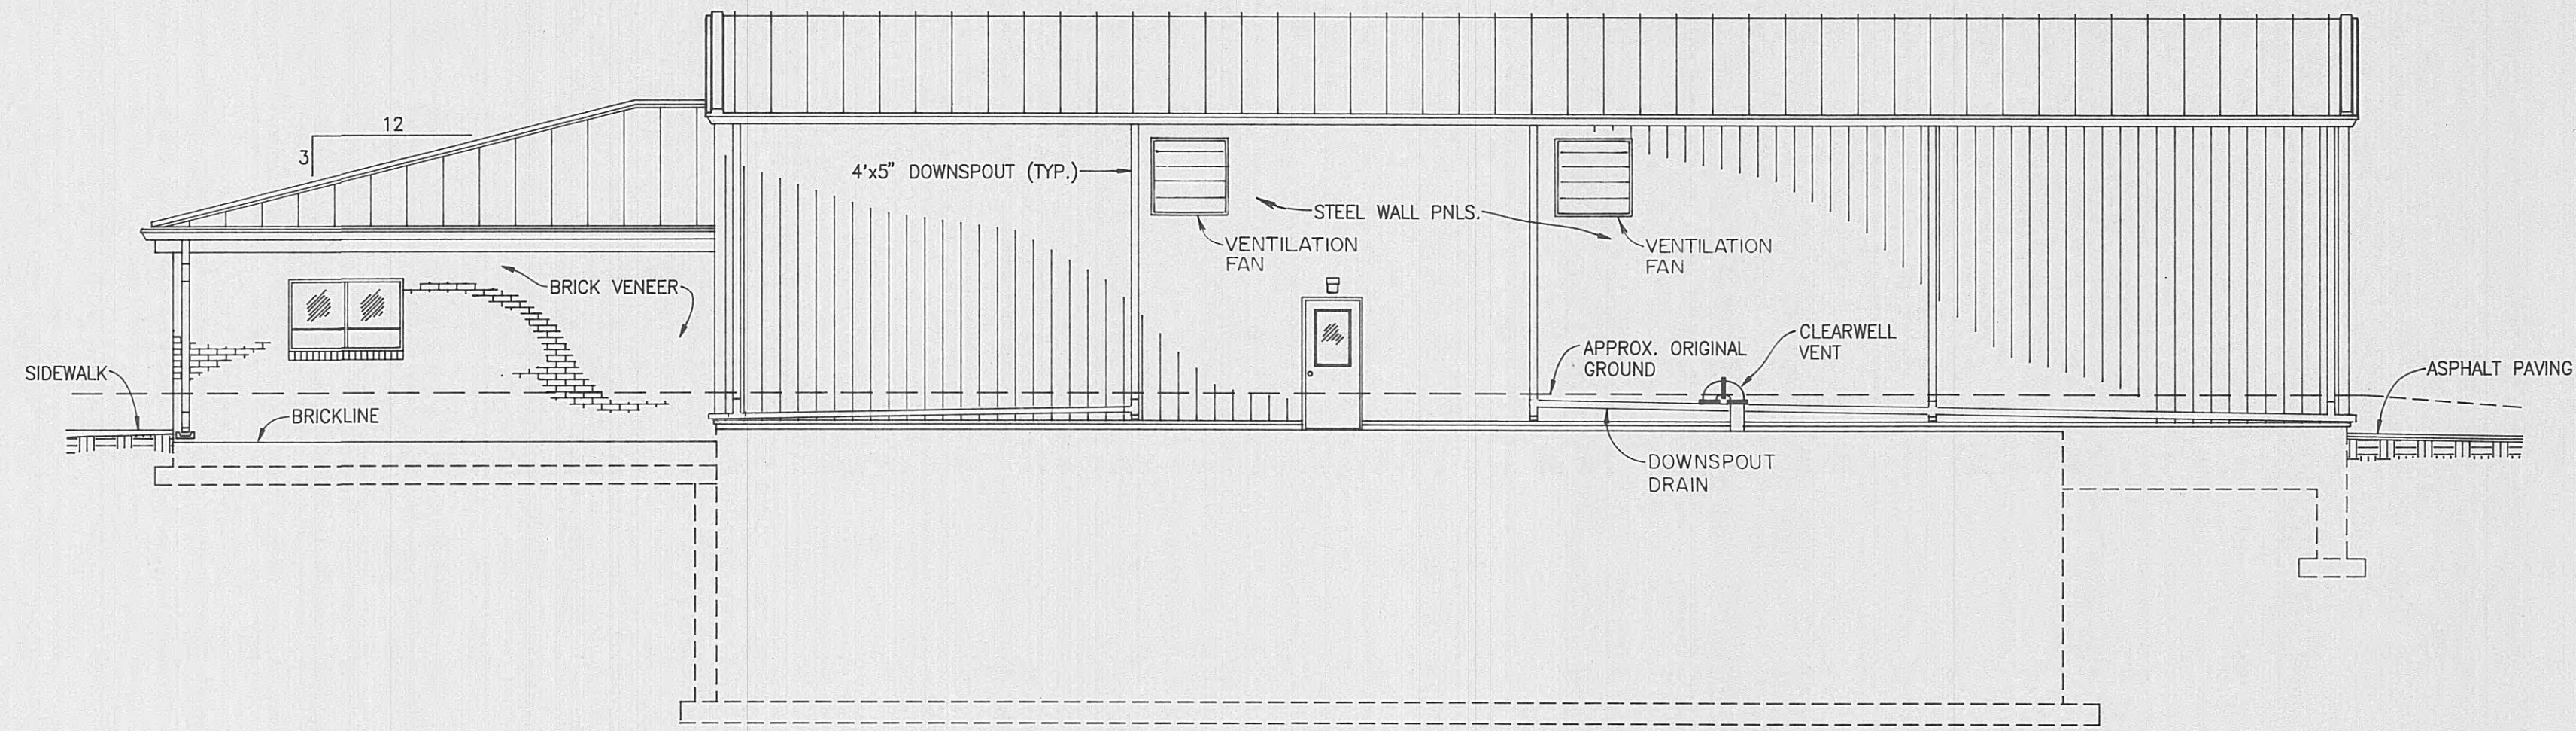


**WEST ELEVATION**  
SCALE: 1/8" = 1'-0"

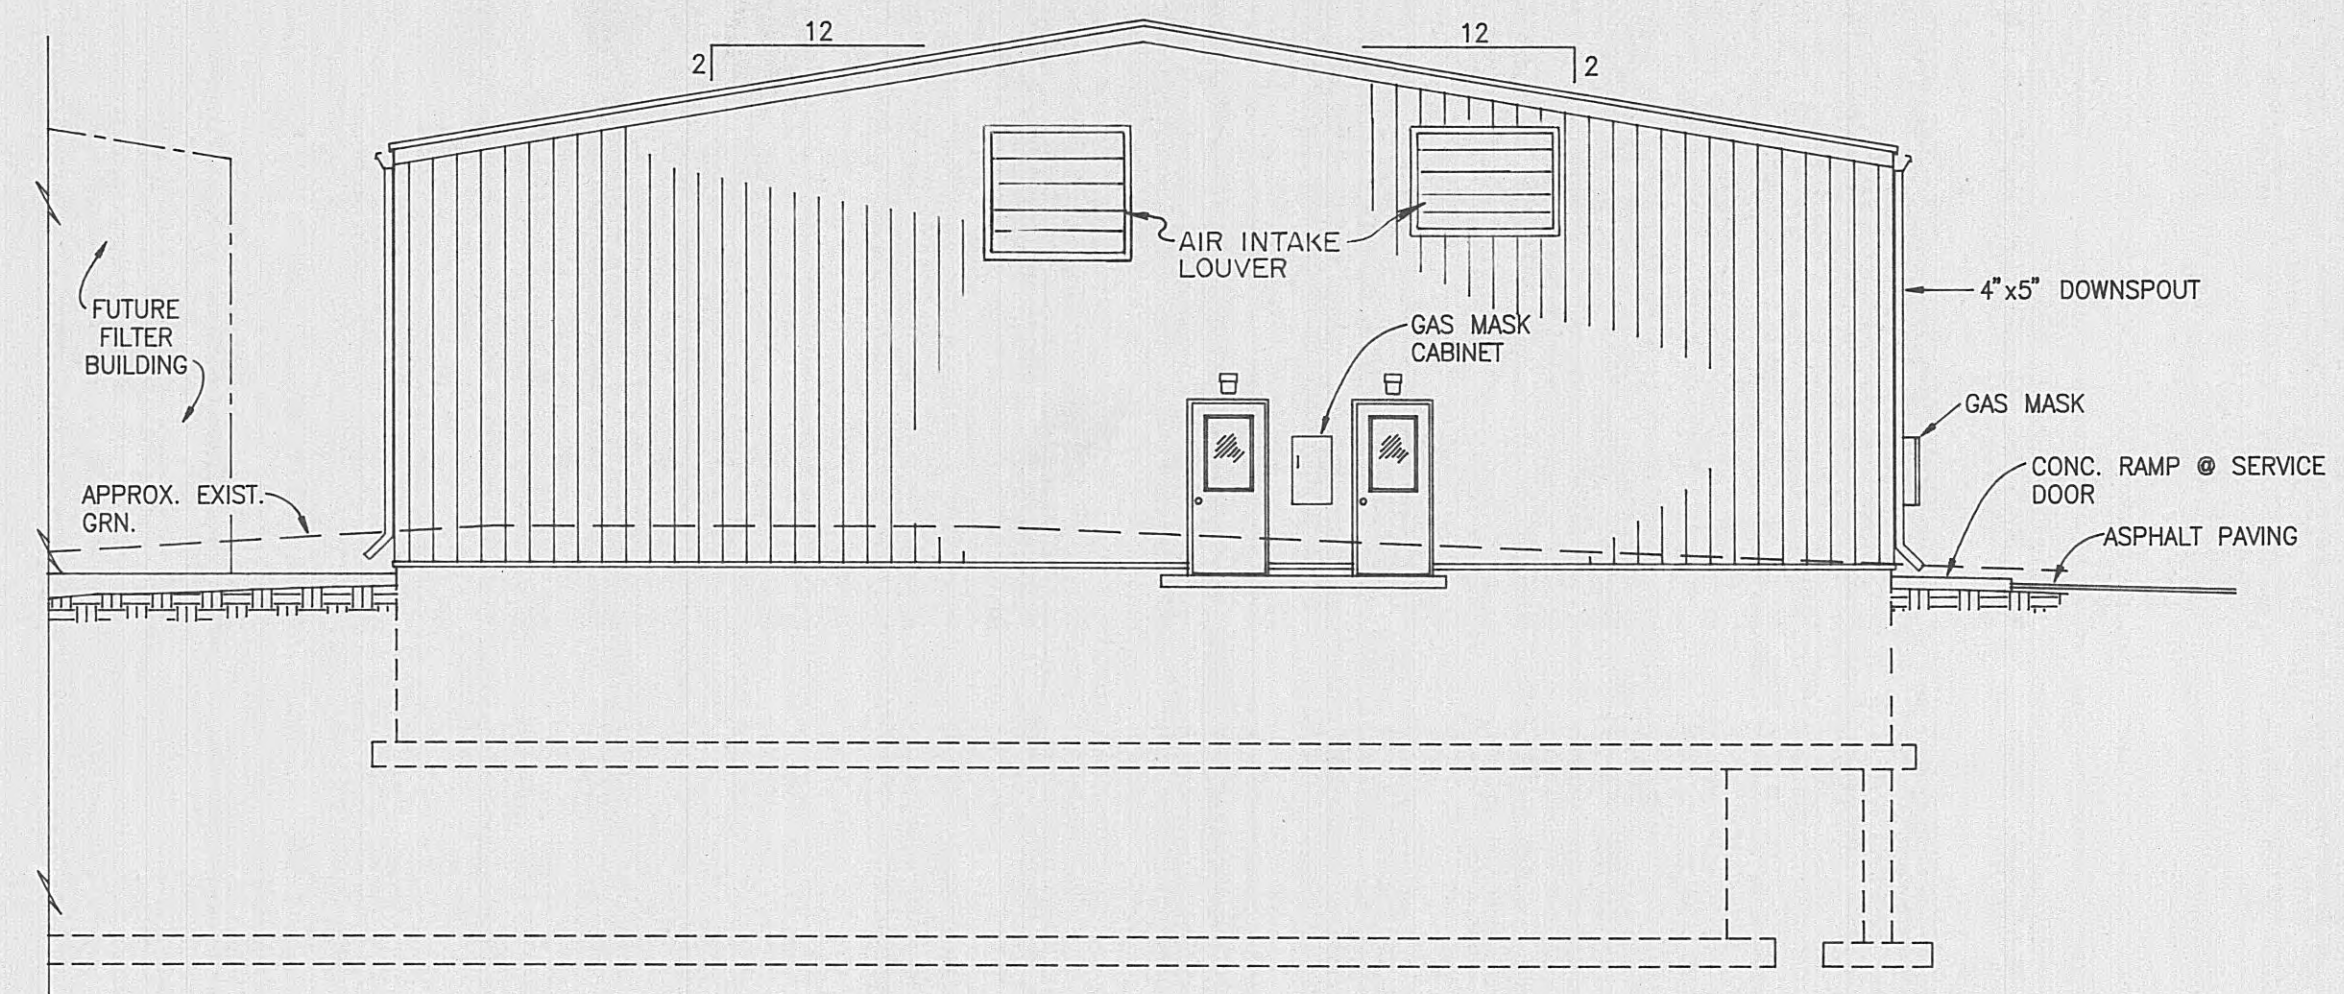


**SOUTH ELEVATION**  
SCALE: 1/8" = 1'-0"

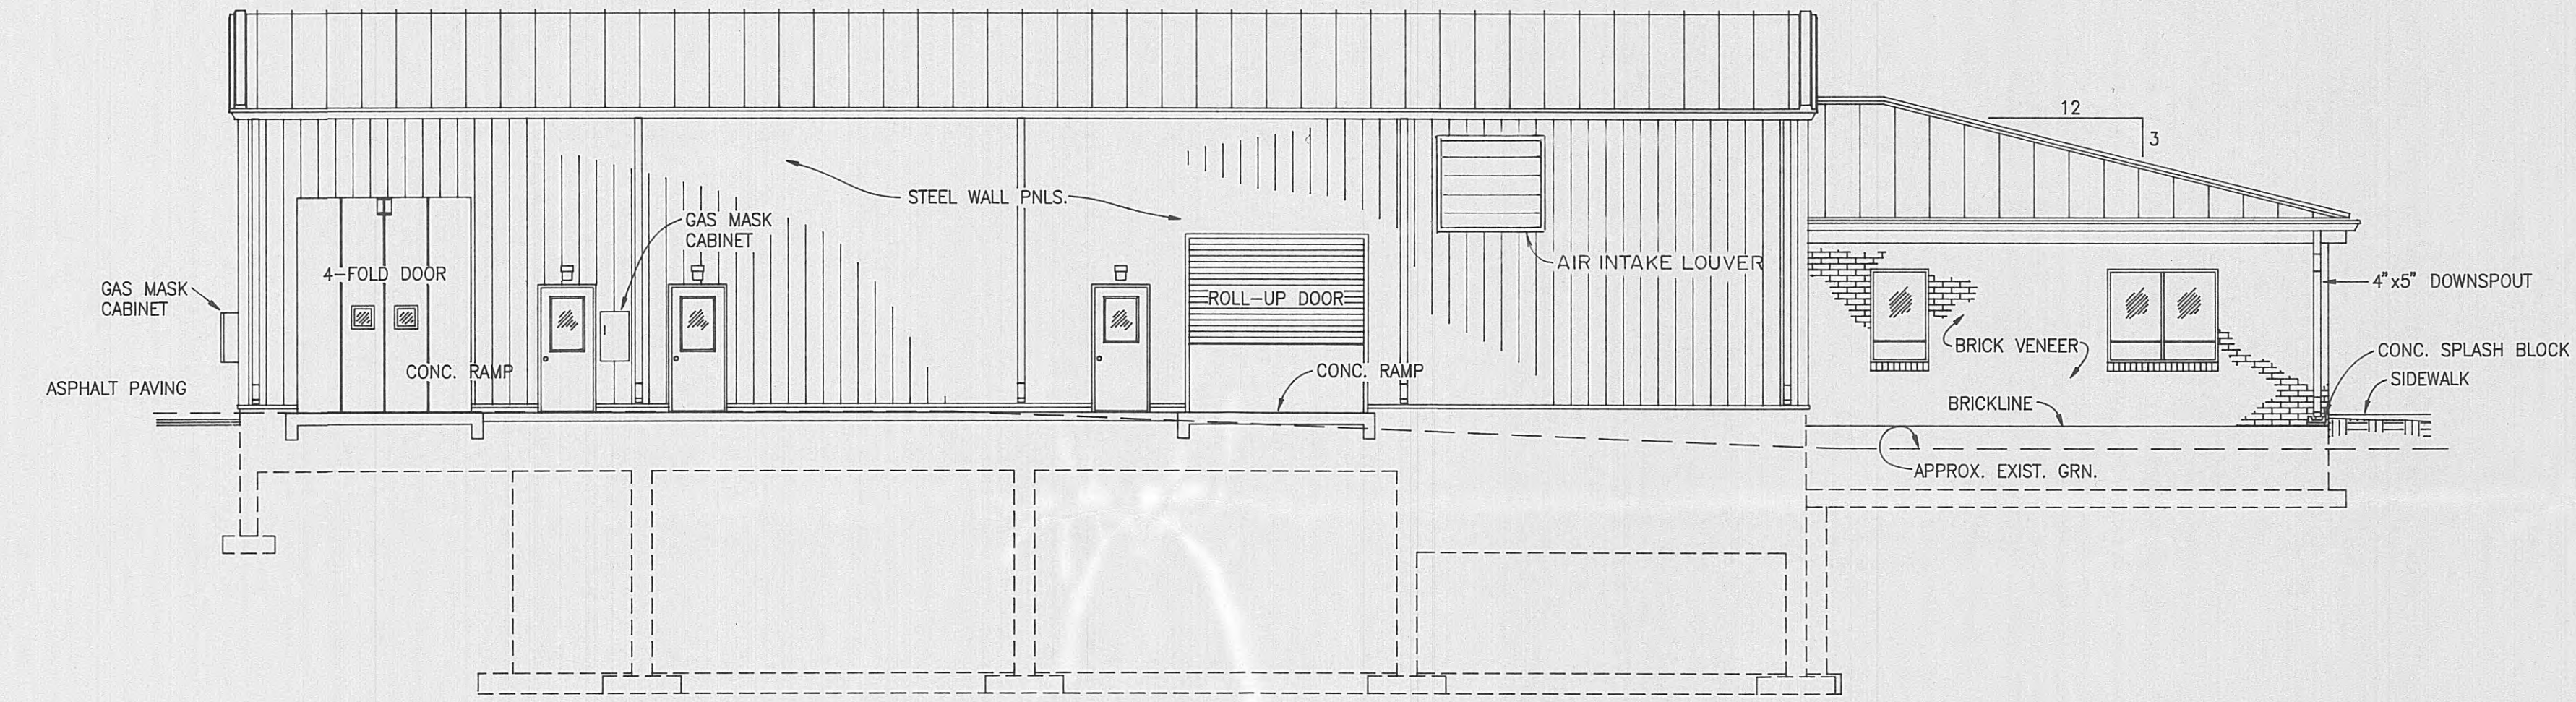


**EAST ELEVATION**  
SCALE: 1/8" = 1'-0"

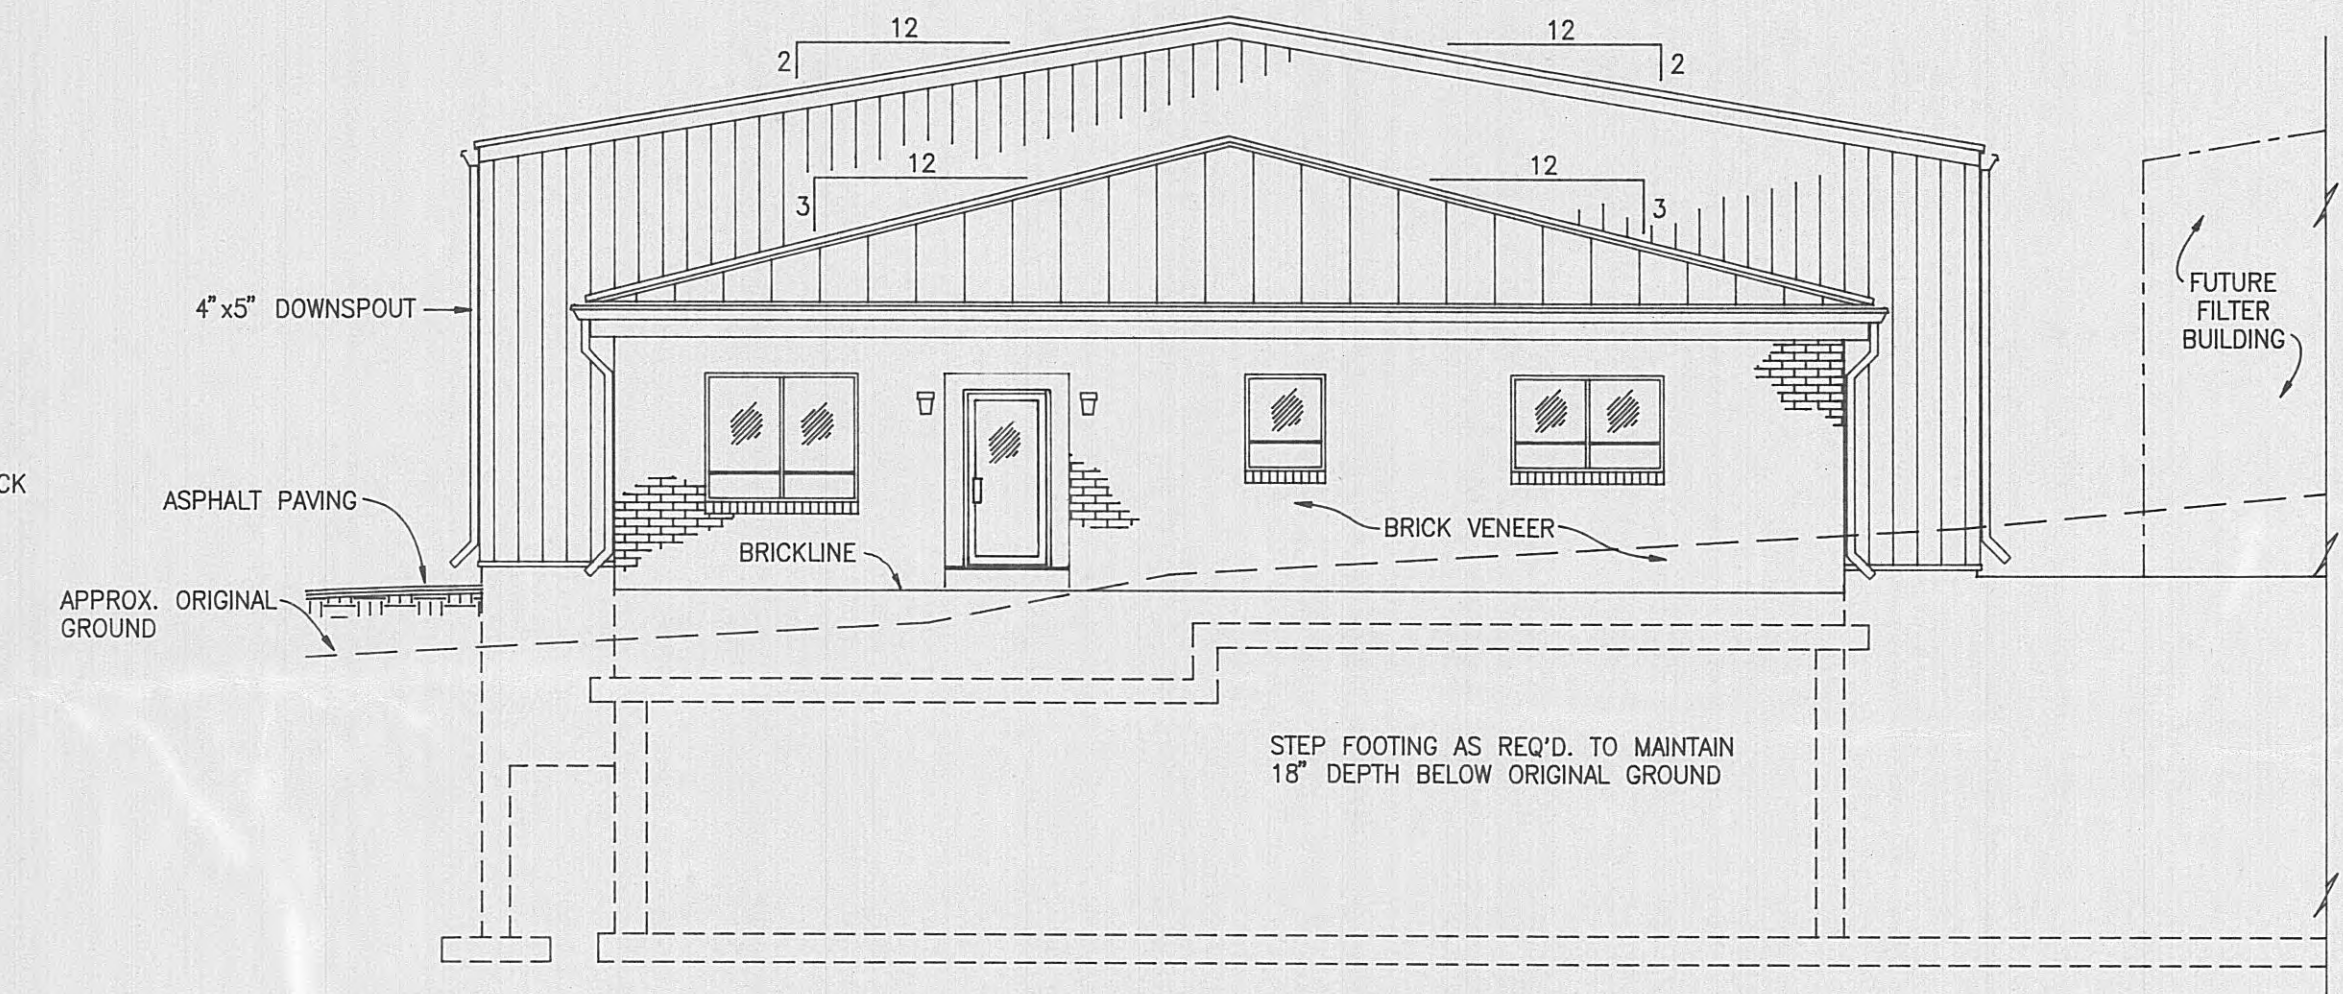

**NORTH ELEVATION**  
SCALE: 1/8" = 1'-0"

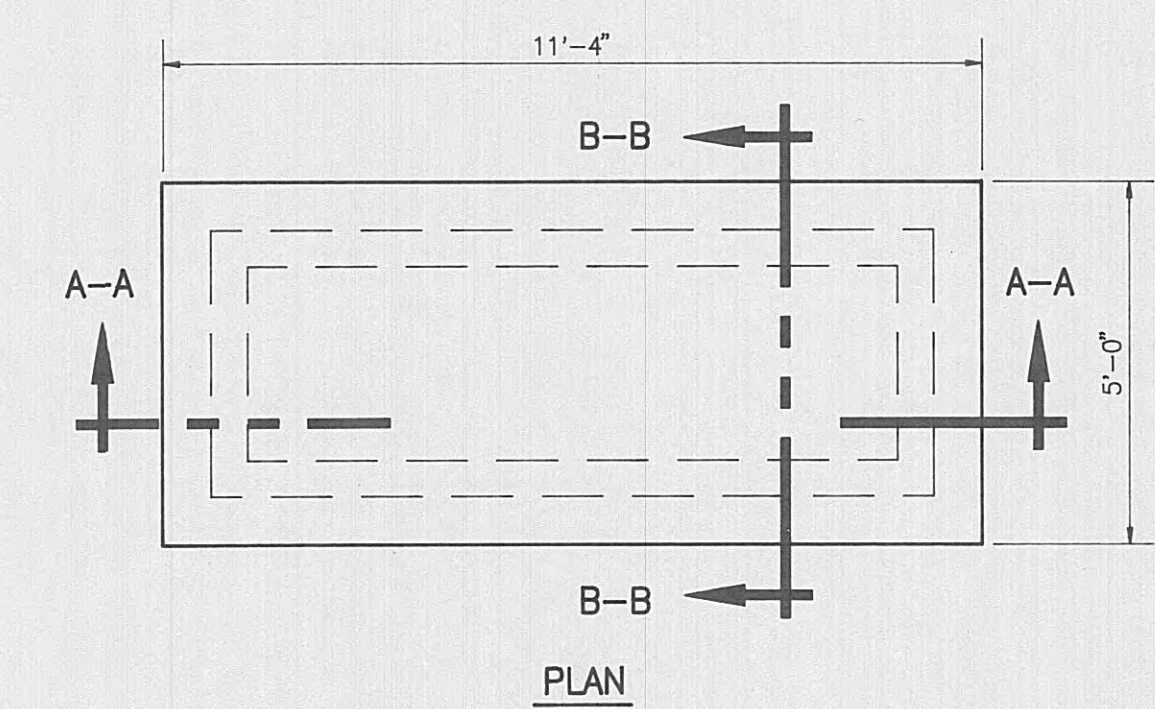


**PLAN**

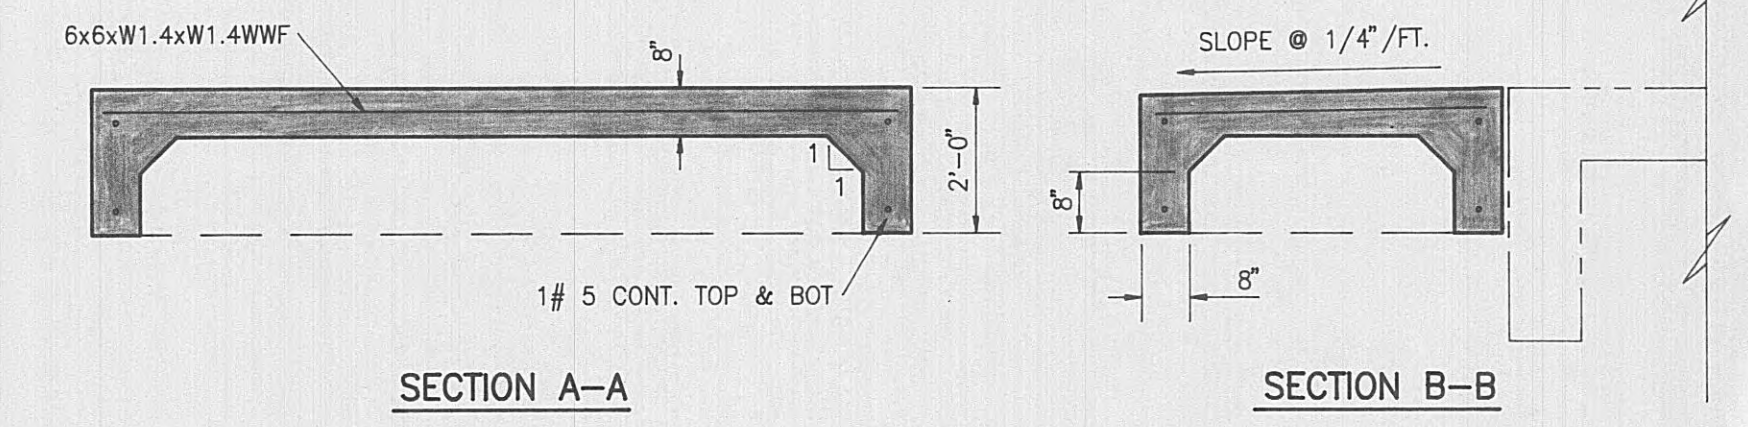

**SECTION A-A**

**SECTION B-B**

**CONCRETE RAMP DETAIL**  
SCALE: 3/8" = 1'-0"

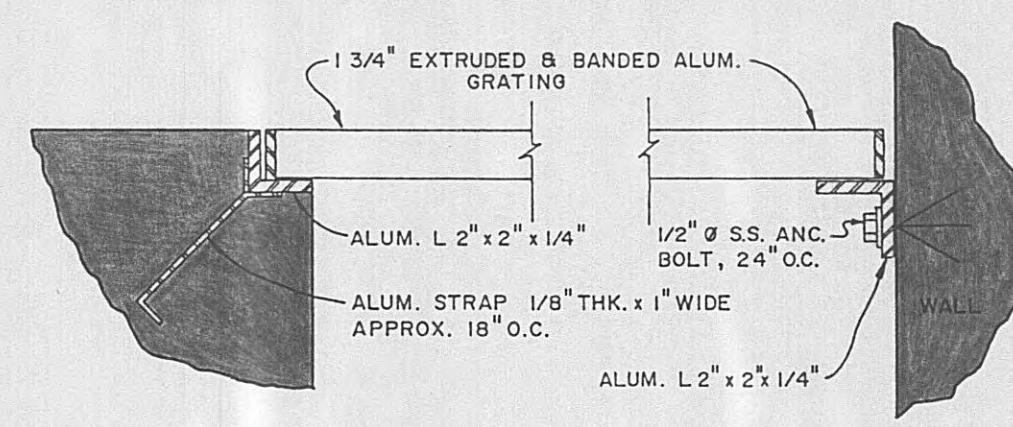

**TYPICAL GRATING DETAIL**  
NOT TO SCALE

**DESIGN LOADS**


1. WIND DESIGN DATA: BASIC WIND VELOCITY = 80 M.P.H., I = 1.0, SITE EXPOSURE FACTOR = C.
2. ROOF LIVE LOADS 25 PSF - NO REDUCTION IN LIVE LOAD PERMITTED FOR COLUMNS, RAFTERS, FRAMES & PURLINS. COLLATERAL LOAD 3 PSF.
3. SEISMIC DESIGN DATA: ZONE = 2, K = 1.0, I = 1.0.
4. DESIGN LIVE LOADS: SUPPORTED FLOORS - 200 P.S.F.

**MISCELLANEOUS AND SUBMITTALS**











1. METAL BUILDING TO BE DESIGNED IN ACCORDANCE WITH STANDARD BUILDING CODE AND ANSI A58.1 - 1982 STANDING SEAM ROOF SHALL BE 24 GAUGE.
2. PRE-ENGINEERED SYSTEMS

THE DESIGN OF PRE-ENGINEERED SYSTEMS SPECIFIED IN THE CONTRACT DOCUMENTS WHICH ARE DESIGNED/ENGINEERED BY OTHERS, IS THE SOLE RESPONSIBILITY OF THE SUPPLIER AND IT'S DESIGN ENGINEER LICENSED IN THE STATE OF THE PROJECT. SUBMITTALS OF SUCH SYSTEMS TO THE STRUCTURAL ENGINEER OF RECORD SHALL BE REVIEWED FOR CONFORMANCE WITH THE CONTRACT DOCUMENTS WITH REGARD TO THE ARRANGEMENT AND/OR SIZES OF MEMBERS SHOWN ON THE STRUCTURAL CONTRACT DOCUMENTS AND THE SUPPLIERS INTERPRETATION OF THE DESIGN INFORMATION INCLUDED IN THE CONTRACT DOCUMENTS. SUCH REVIEW BY THE STRUCTURAL ENGINEER OF RECORD SHALL NOT IMPLY ANY RESPONSIBILITY FOR THE ACTUAL DESIGN OF SUCH SYSTEMS. THE CONTRACTOR SHALL BE RESPONSIBLE FOR THE DIMENSIONAL ACCURACY AND CONFORMANCE WITH THE INFORMATION CONTAINED IN THE CONTRACT DOCUMENTS. SUBMIT 4 COPIES OF ENGINEERING CALCULATIONS.

**AS BUILT**  
DATE: 3-20-95  
APPROVED: D.M.

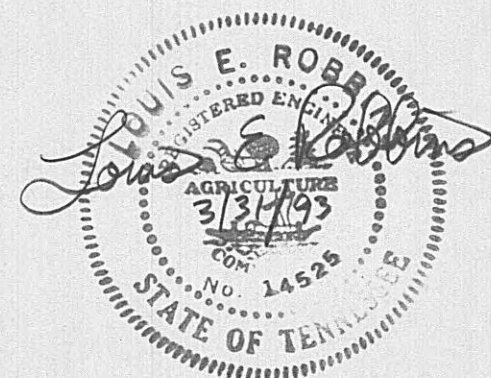



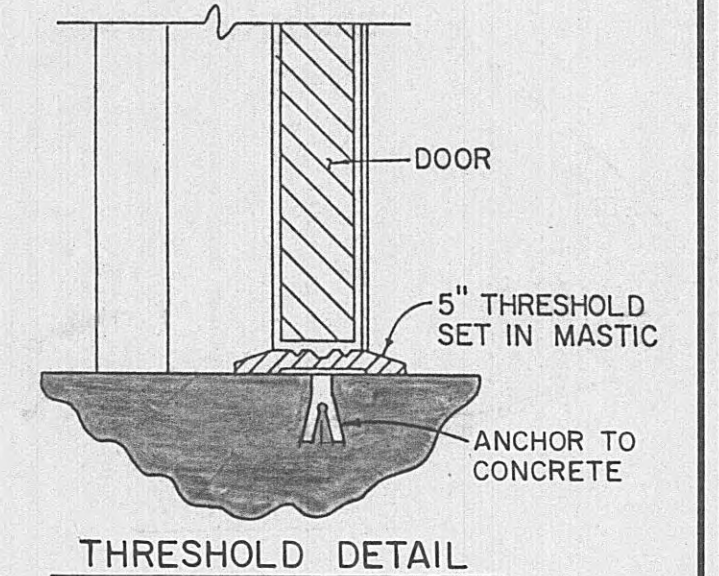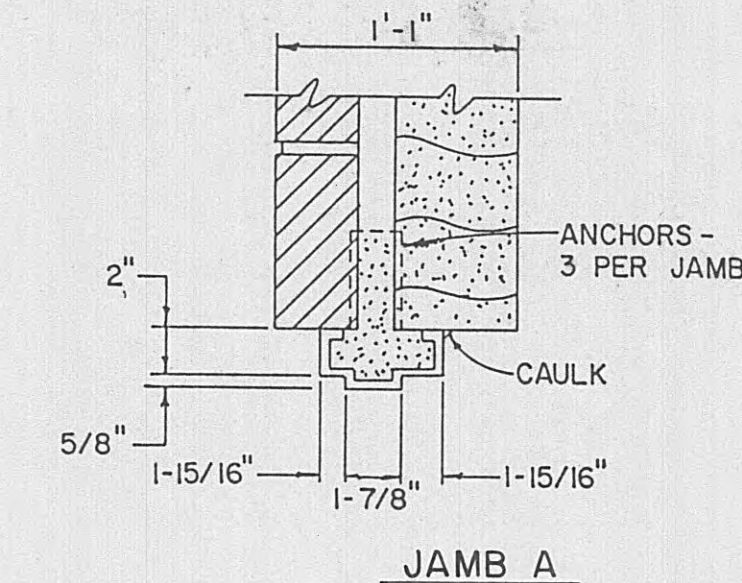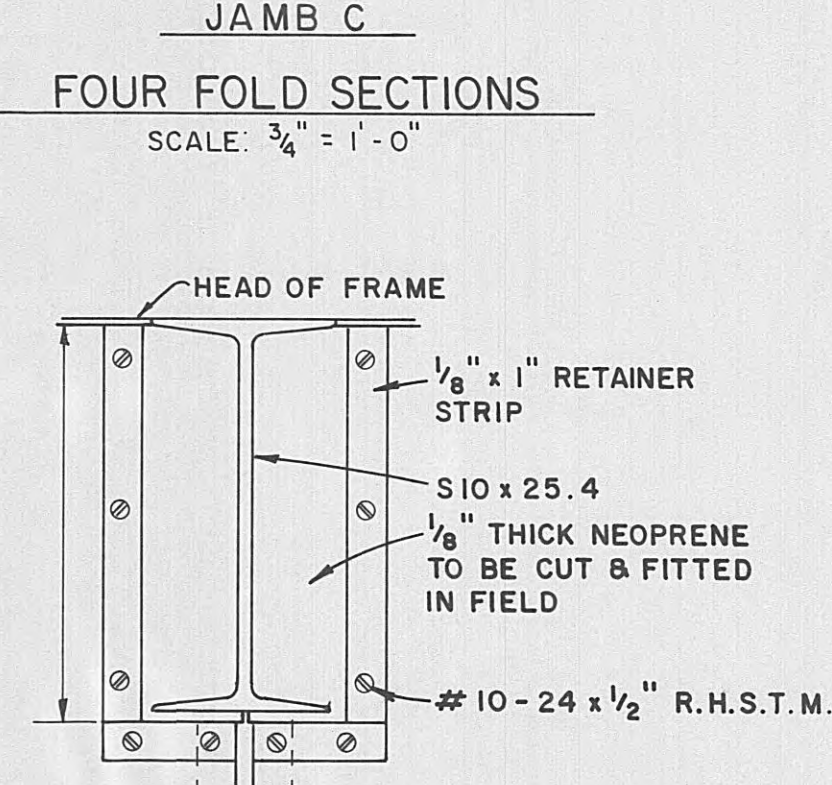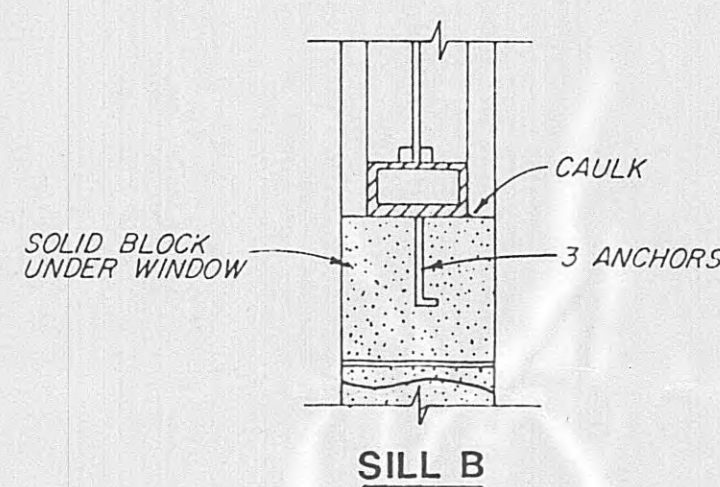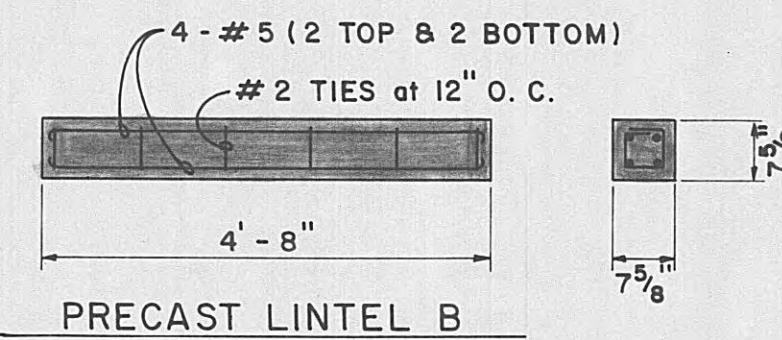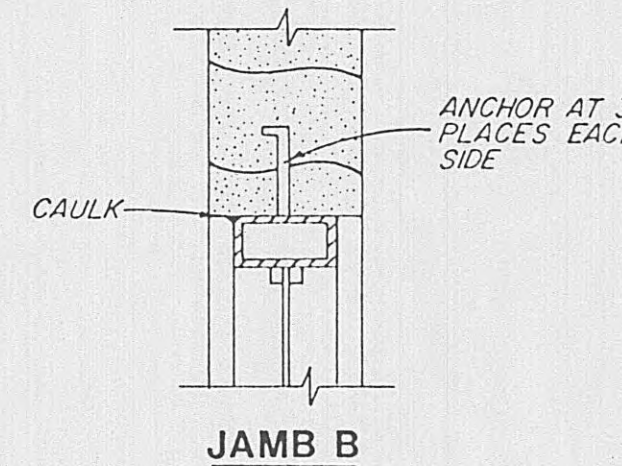
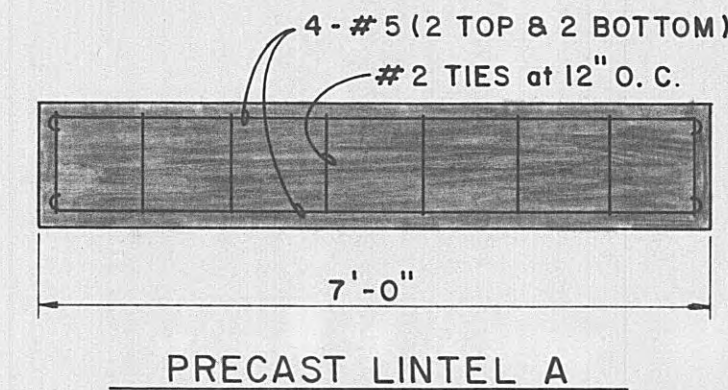
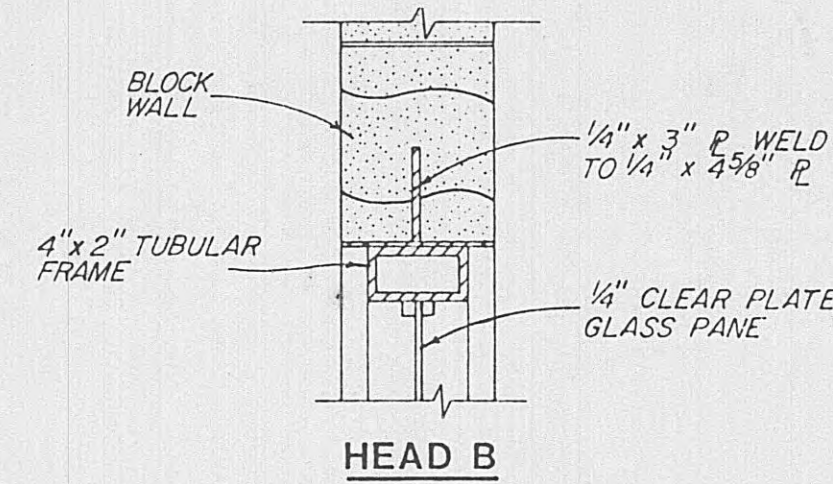
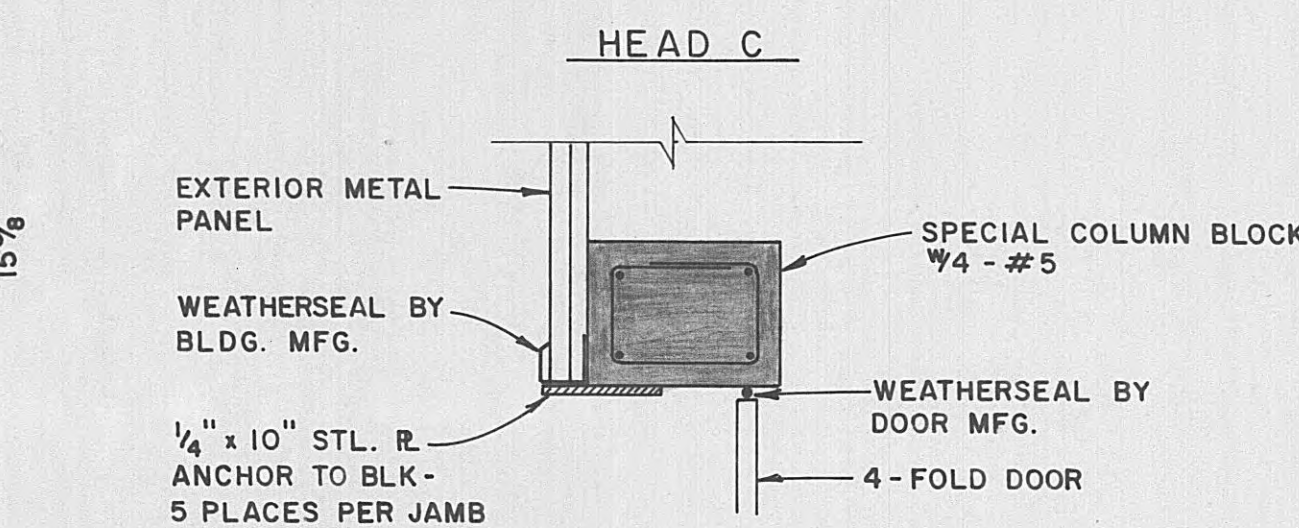
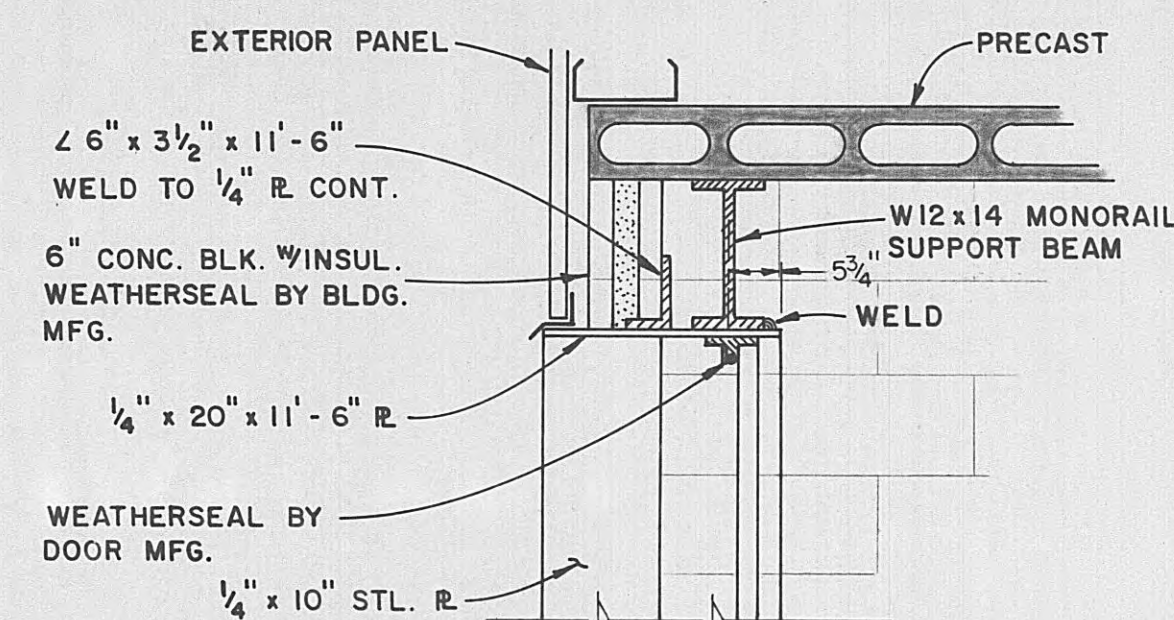


DOOR SECTIONS  
N. T. S.

DOOR SCHEDULE								
MARK	LOCATION	HAND	DOOR SIZE	HDW	THRES- HOLD	JAMB	HEAD	REMARKS
A-1	OUTSIDE/MAIN ENTRANCE	RHR	3'-0" X 7'-2"	1	YES	--	--	ALUM. DOOR & FRAME
B-1	OUTSIDE/FILTER ROOM	ROLL-UP	10'-0" X 10'-0"	*	NO	--	--	**
B-2	OUTSIDE/STORAGE BLDG.	ROLL-UP	10'-0" X 10'-0"	*	NO	--	--	**
C-1	BACT.LAB/ENTRANCE HALL	RH	3'-0" X 7'-2"	2	NO	B	B	
C-2	ENTRANCE HALL/OFFICE	LH	3'-0" X 7'-2"	2	NO	B	B	NO LOUVER REQ'D.
C-3	ENTRANCE HALL/BREAK RM.	RH	3'-0" X 7'-2"	5	NO	B	B	NO LOUVER REQ'D.
C-4	ENTRANCE HALL/STORAGE	RHR	3'-0" X 7'-2"	2	NO	B	B	NO WINDOW REQ'D.
C-5	HALL/RESTROOM	LH	3'-0" X 7'-2"	4	NO	B	B	NO WINDOW/LOUVER REQ'D.
C-6	HALL/LAB ROOM	LHR	3'-0" X 7'-2"	2	NO	B	B	NO LOUVER REQ'D.
C-7	HALL/ELEC.ROOM	RHR	3'-0" X 7'-2"	6	NO	B	B	NO WINDOW REQ'D.
C-8	LAB ROOM/BACT.LAB	RH	3'-0" X 7'-2"	5	NO	B	B	
C-8	FILTER ROOM/POLYMER RM.	LHR	3'-0" X 7'-2"	5	NO	B	B	NO LOUVER REQ'D.
D-1	FILTER ROOM/HALL	LH	3'-0" X 7'-2"	2	YES	B	B	
D-2	OUTSIDE/FLOUIDE	LHR	3'-0" X 7'-2"	2	YES	B	B	
D-3	OUTSIDE/CARBON ROOM	LHR	3'-0" X 7'-2"	2	YES	B	B	
D-4	OUTSIDE/CL <sub>2</sub> FEED RM.	LHR	3'-0" X 7'-2"	3	YES	B	B	
D-5	OUTSIDE/CHLORINE STORAGE	LHR	3'-0" X 7'-2"	3	YES	B	B	
D-6	OUTSIDE/FILTER RM.	LHR	3'-0" X 7'-2"	2	YES	B	B	
D-7	OUTSIDE/FILTER RM	RHR	3'-0" X 7'-2"	2	YES	B	B	
D-8	OUTSIDE/STORAGE BLDG.	LHR	3'-0" X 7'-2"	2	YES	B	B	
D-9	OUTSIDE/INTAKE PUMP BLDG.	RHR	3'-0" X 7'-2"	2	YES	B	B	
D-10	OUTSIDE/INTAKE PUMP BLDG.	LH	3'-0" X 7'-2"	2	YES	A	A	
D-11	INSIDE/STORAGE BLDG.	RH	2'-8" X 6'-8"	3	YES	B	B	
E-1	OUTSIDE/CHLORINE STORAGE	FOUR-FOLD	10'-0" X 12'-4"	*	YES	C	C	

\*DOOR HDW. FURNISHED BY DOOR MANUFACTURER  
\*\*STL. FRAME FOR ROLL-UP DOOR FURNISHED BY BLDG. MANUFACTURER

HARDWARE SCHEDULE					
NO.	BUTTS	DOOR STOPS & HOLDERS	LOCKSET	LATCHSET	CLOSER
1	1-1/2 PAIR	YES	KEY-KEY	PULL & BAR	YES
2	1-1/2 PAIR	YES	KEY-BUTTON	KNOB-KNOB	YES
3	1-1/2 PAIR	YES	KEY-BUTTON	KNOB-PANIC BAR	YES
4	1-1/2 PAIR	STOP ONLY	KEY-TURN LEVER	PLATE HANDLE	YES
5	1-1/2 PAIR	YES	NONE	KNOB-KNOB	NO
6	1-1/2 PAIR	YES	NONE	KNOB-PANIC BAR	NO

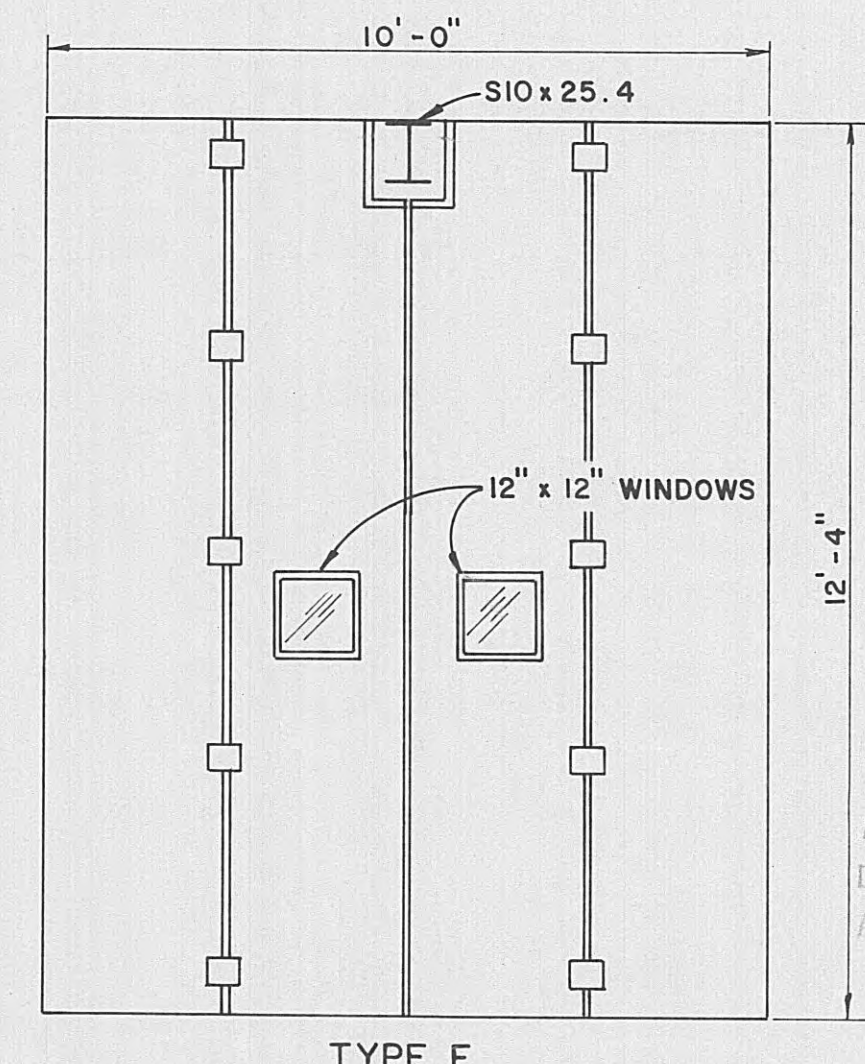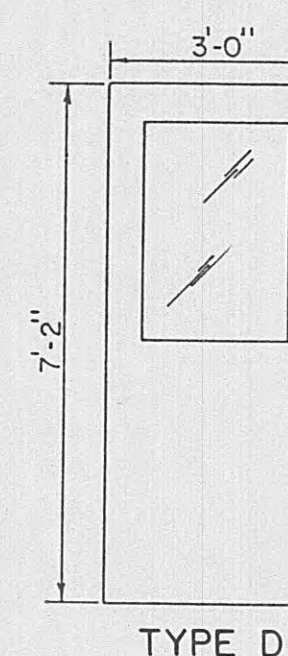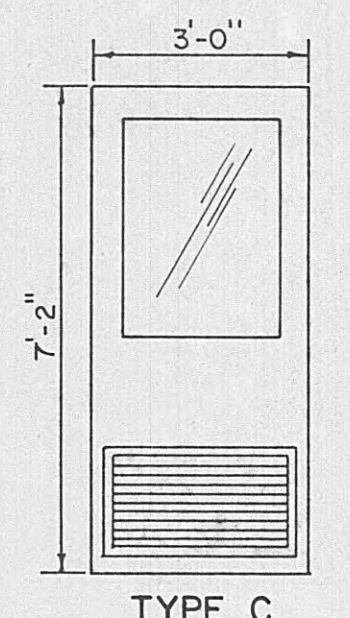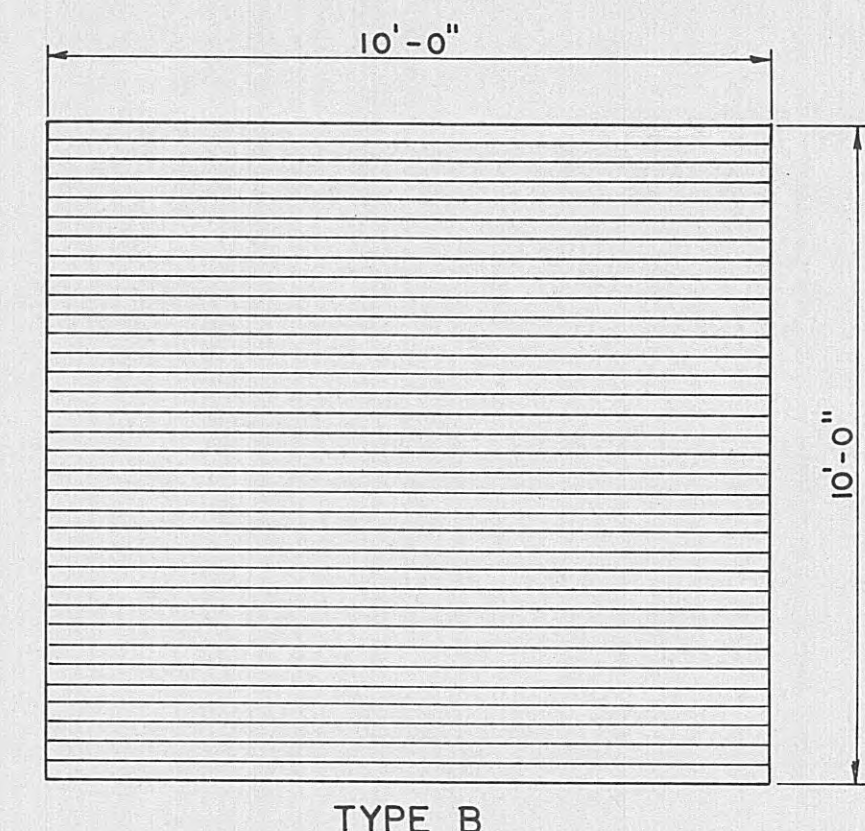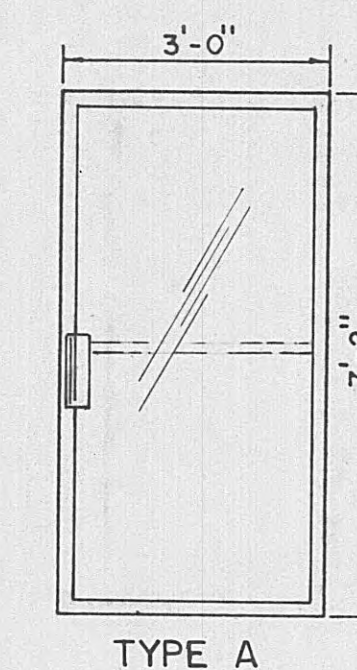

**AS BUILT**  
DATE: 3-20-95  
APPROVED: D.M.



**ELRUD • DUNSON, INC.**  
CONSULTING ENGINEERS  
NASHVILLE • KNOXVILLE  
LEXINGTON, KY

## DOOR AND WINDOW SCHEDULES AND DETAILS

## REVISIONS

SIGNED: L. E. R.  
AWN: D. M.  
ECKED: L. E. R.  
E: MARCH, 1993  
LE: AS NOTED  
J. NO. 0592

SHEET 11  
OF 36







# FOUNDATION NOTES

1. INDIVIDUAL FOOTINGS ARE DESIGNED TO BEAR ON SOIL CAPABLE OF SUPPORTING 2500 P.S.F.
2. THE SOIL BEARING CAPACITY SHALL BE VERIFIED WHEN FOUNDATION EXCAVATIONS HAVE BEEN CARRIED DOWN TO THE PROPOSED ELEVATIONS OR PROPER BEARING STRATUM.
3. ANCHOR BOLTS SHALL BE ASTM A307. BOLT SIZE TO BE DETERMINED BY METAL BUILDING CONTRACTOR.


# REINFORCED CONCRETE

1. ALL CONCRETE WORK SHALL CONFORM TO THE BUILDING CODE REQUIREMENTS FOR REINFORCED CONCRETE: (ACI 318-89).
2. REINFORCING STEEL SHALL BE DEFORMED BARS ASTM A615 (GRADE 60).
3. THE COMPRESSIVE STRENGTH AT 28 DAYS OF ALL CAST IN PLACE CONCRETE SHALL BE: 4000 PSI AS SPECIFIED.
4. LAP SPLICES FOR REINFORCING BARS SHALL BE 30 BAR DIAMETERS, UNLESS NOTED OTHERWISE.
5. THE LONGITUDINAL REINFORCING STEEL IN WALLS AND FOOTINGS SHALL BE CONTINUOUS & SHALL BE CONTINUOUS AROUND CORNERS.
6. ALL DOWELS TO BE SAME SIZE AS WALL STEEL UNLESS NOTED OTHERWISE.

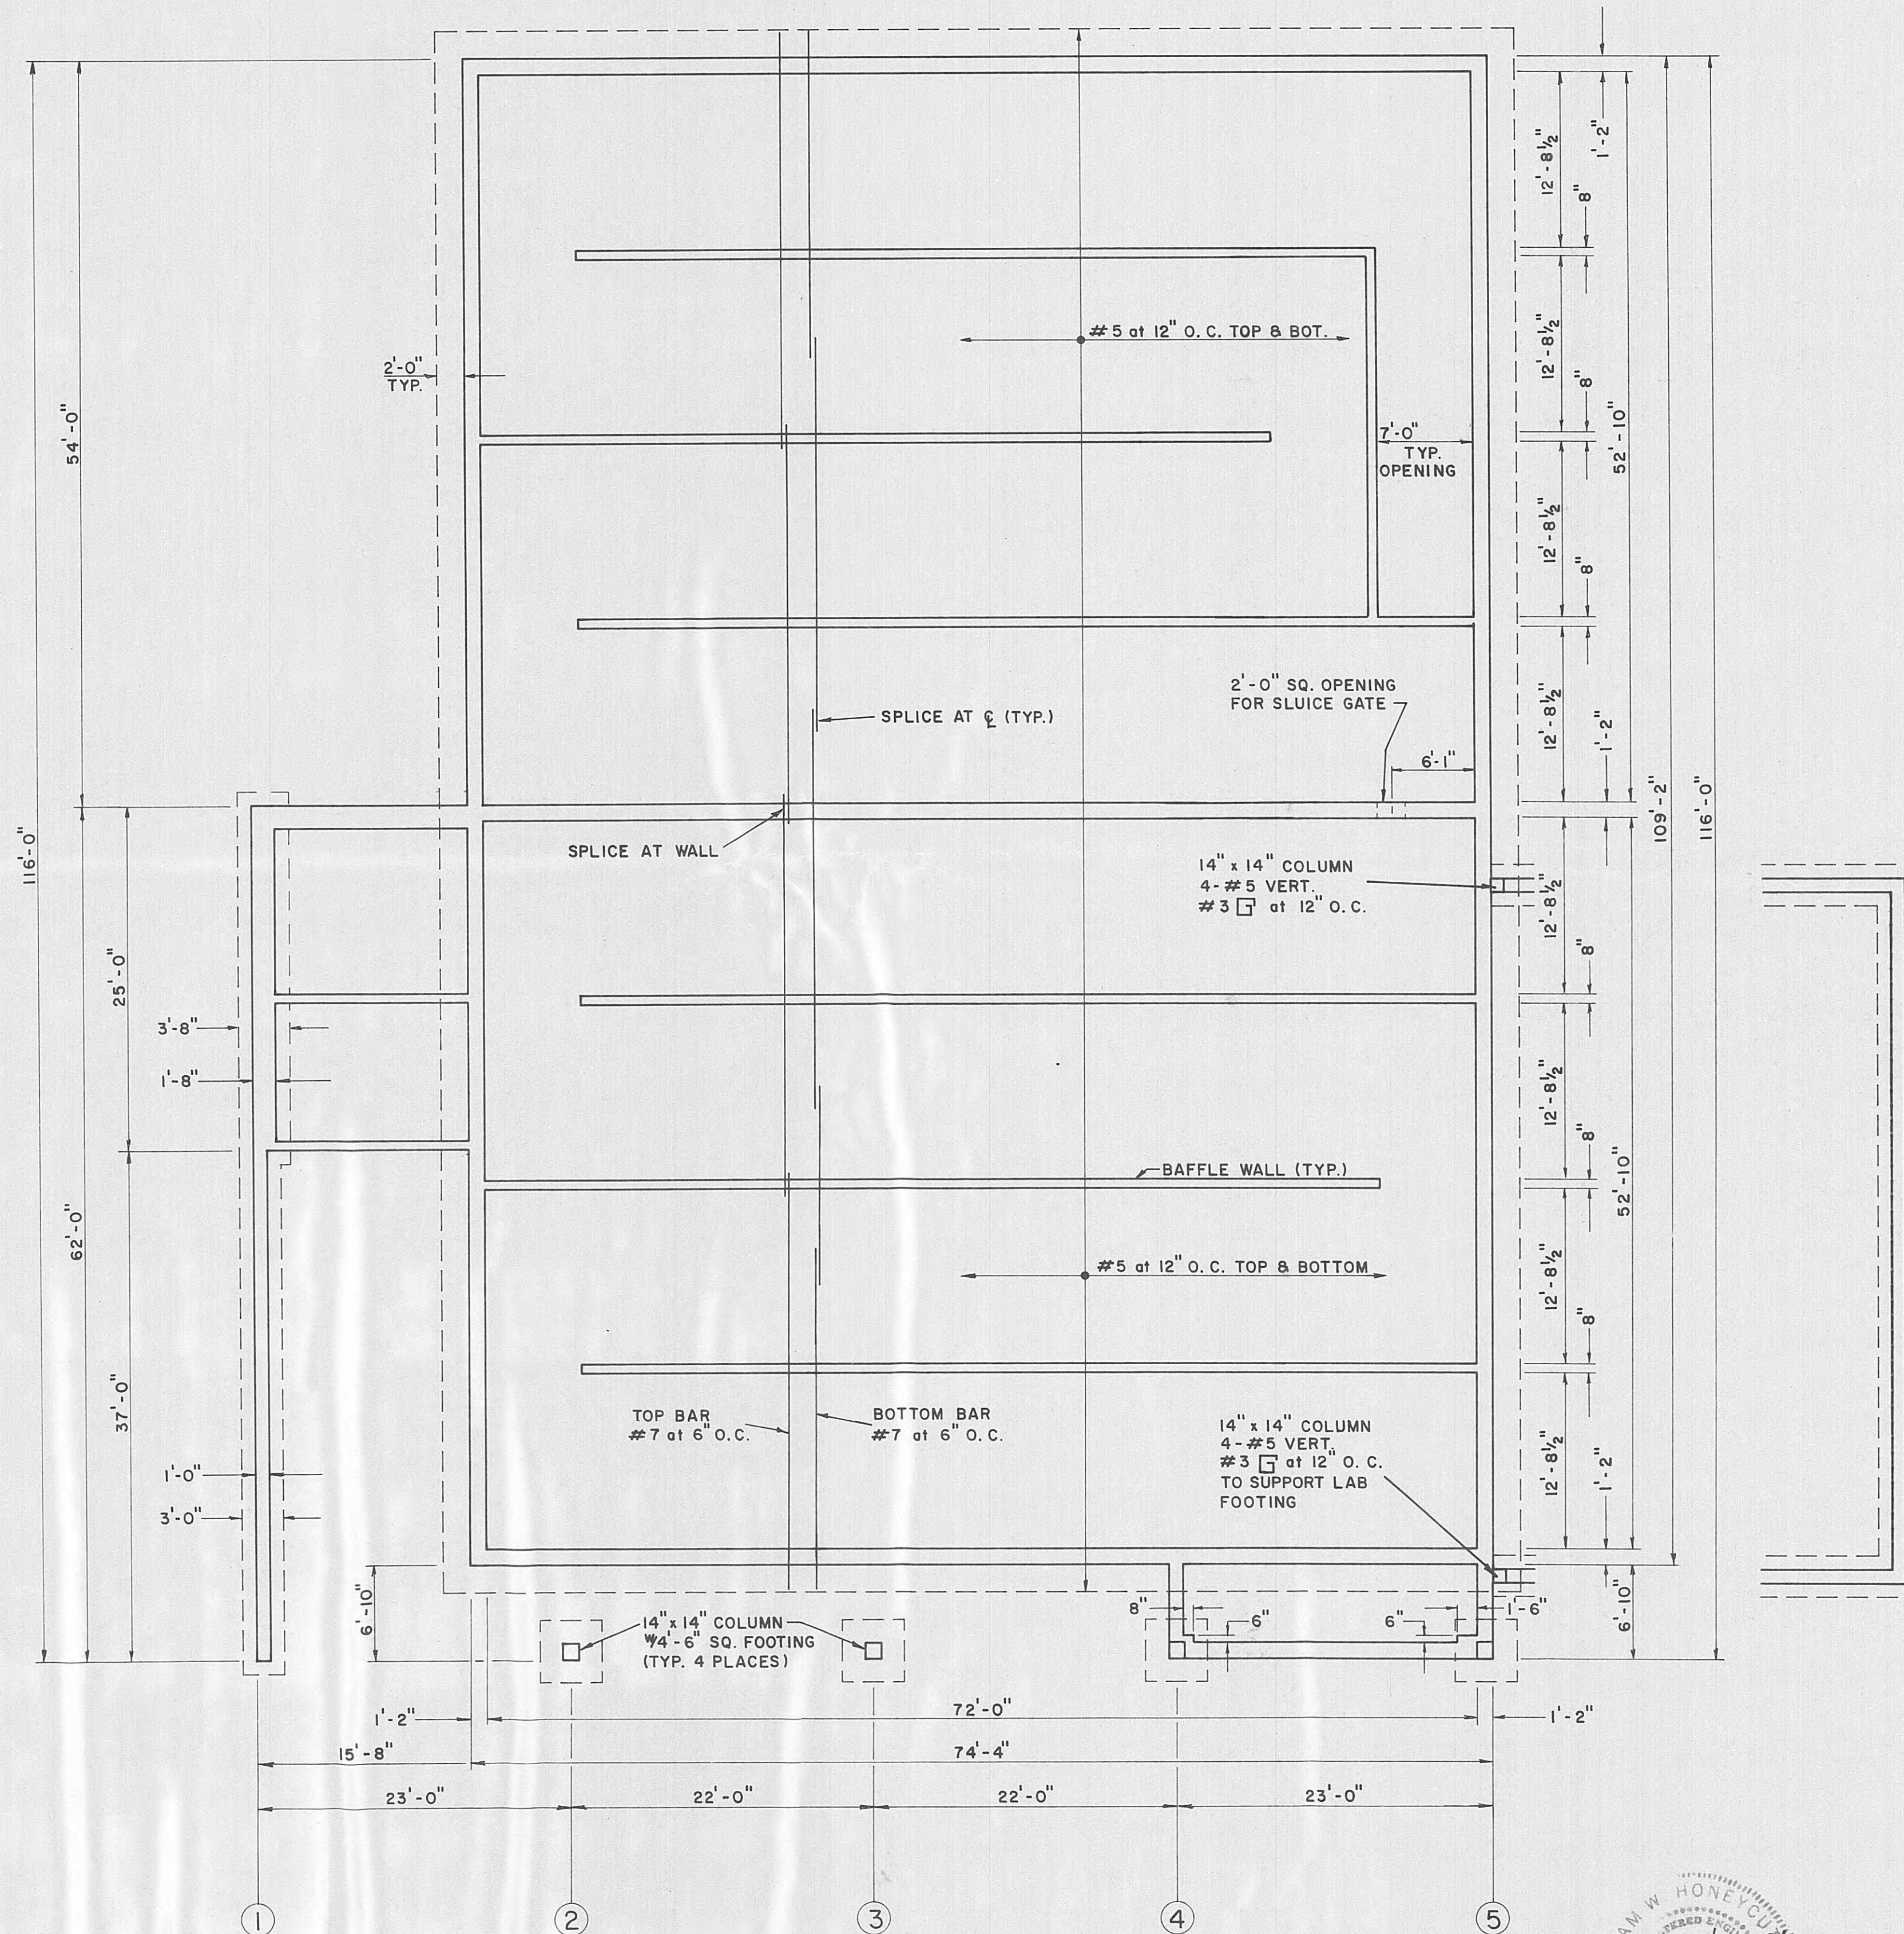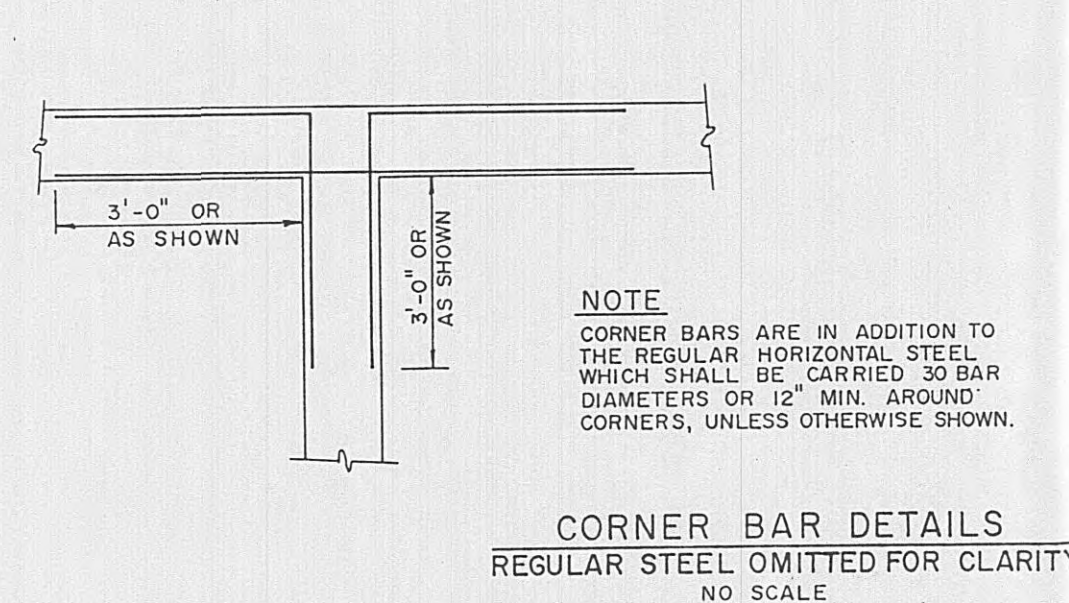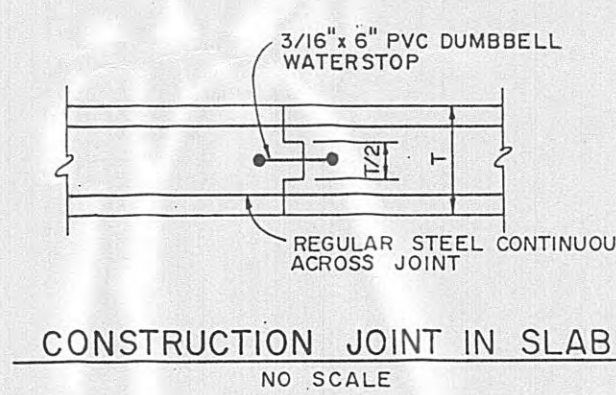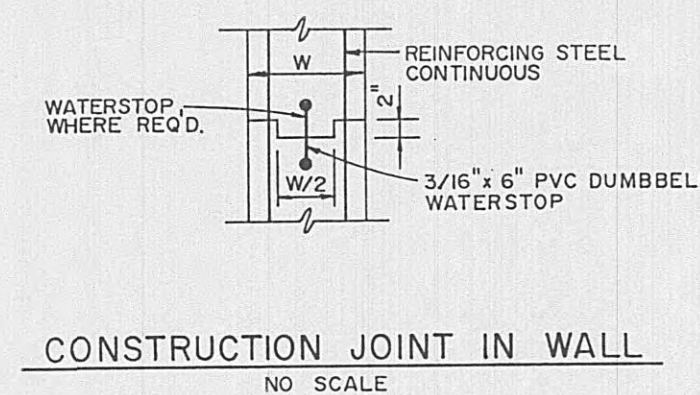



STRUCTURAL - FLOOR SLAB ELEVATION 767.00

SCALE: 1/8" = 1'-0"


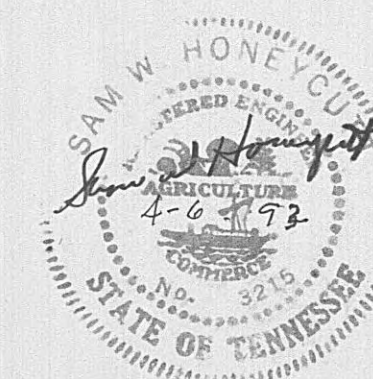


AS BUILT  
DATE: 3-20-95  
APPROVED: [Signature]




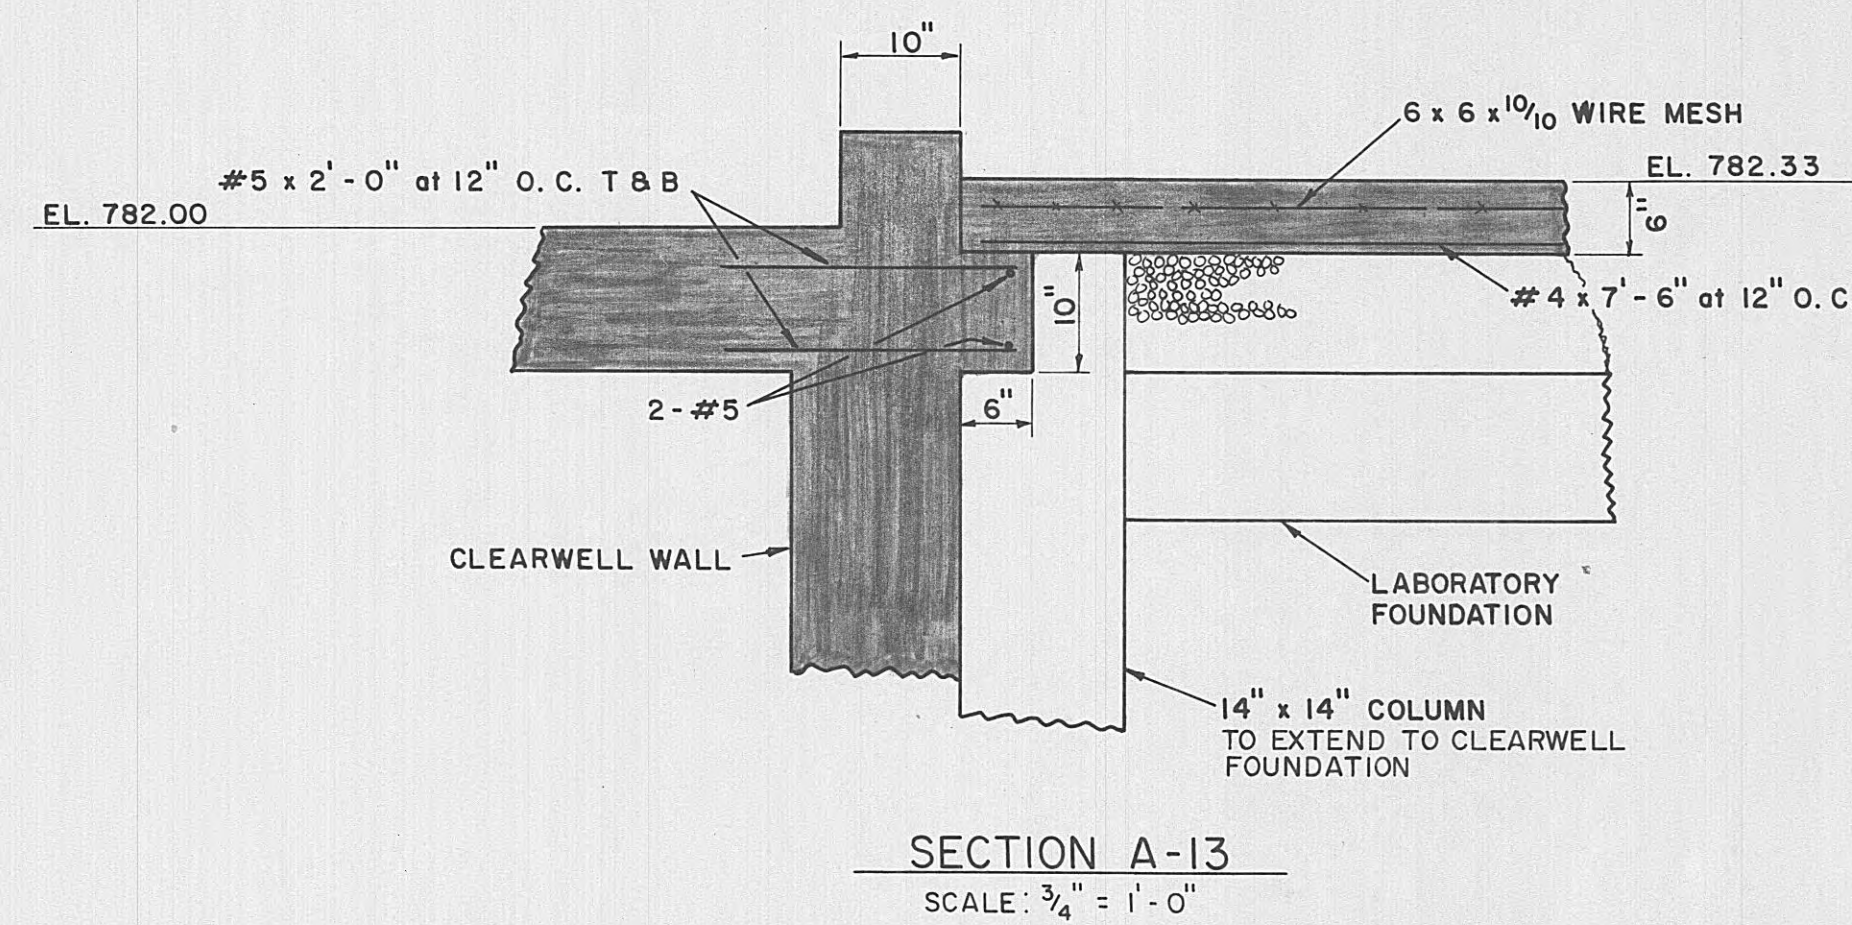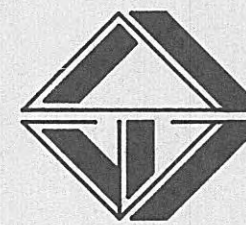


FLOOR SLAB SCHEDULE				
MARK	TYPE	REINFORCING		REMARKS
		BOTTOM	TOP	
FS1	12" SOLID	#5 @ 12"	#7 @ 7"	
FS2	12" SOLID	FROM FS1	FROM FS1	
FS3	12" SOLID	#7 @ 7"	#7 @ 7"	
FS4	12" SOLID	FROM FS3	FROM FS3	
FS5	12" SOLID	#7 @ 7"	#7 @ 7"	
FS6	12" SOLID	#6 @ 12"	FROM FS5	
FS7	12" SOLID	#7 @ 7"	#7 @ 7"	
FS8	12" SOLID	#7 @ 7"	FROM FS7	
FS9	12" SOLID	FROM FS8	FROM FS8	
FS10	12" SOLID	#5 @ 12"	#6 @ 12"	
FS11	12" SOLID	#5 @ 12"	#6 @ 12"	
FS11A	12" SOLID	FROM FS10	FROM FS10	
FS12	12" SOLID	#5 @ 12"	#6 @ 12"	
FS13	12" SOLID	FROM FS12	FROM FS12	
FS14	12" SOLID	#5 @ 12"	#6 @ 12"	
FS15	12" SOLID	#5 @ 12"	FROM FS14	
FS16	12" SOLID	#5 @ 12"	#6 @ 12"	
FS17	12" SOLID	#5 @ 12"	FROM FS16	
FS18	12" SOLID	FROM FS17	FROM FS16	
FS18	12" SOLID	#7 @ 12"	#5 @ 12" O.C.	
FS20	14" SOLID	#7 @ 6"	#5 @ 12 O.C.	

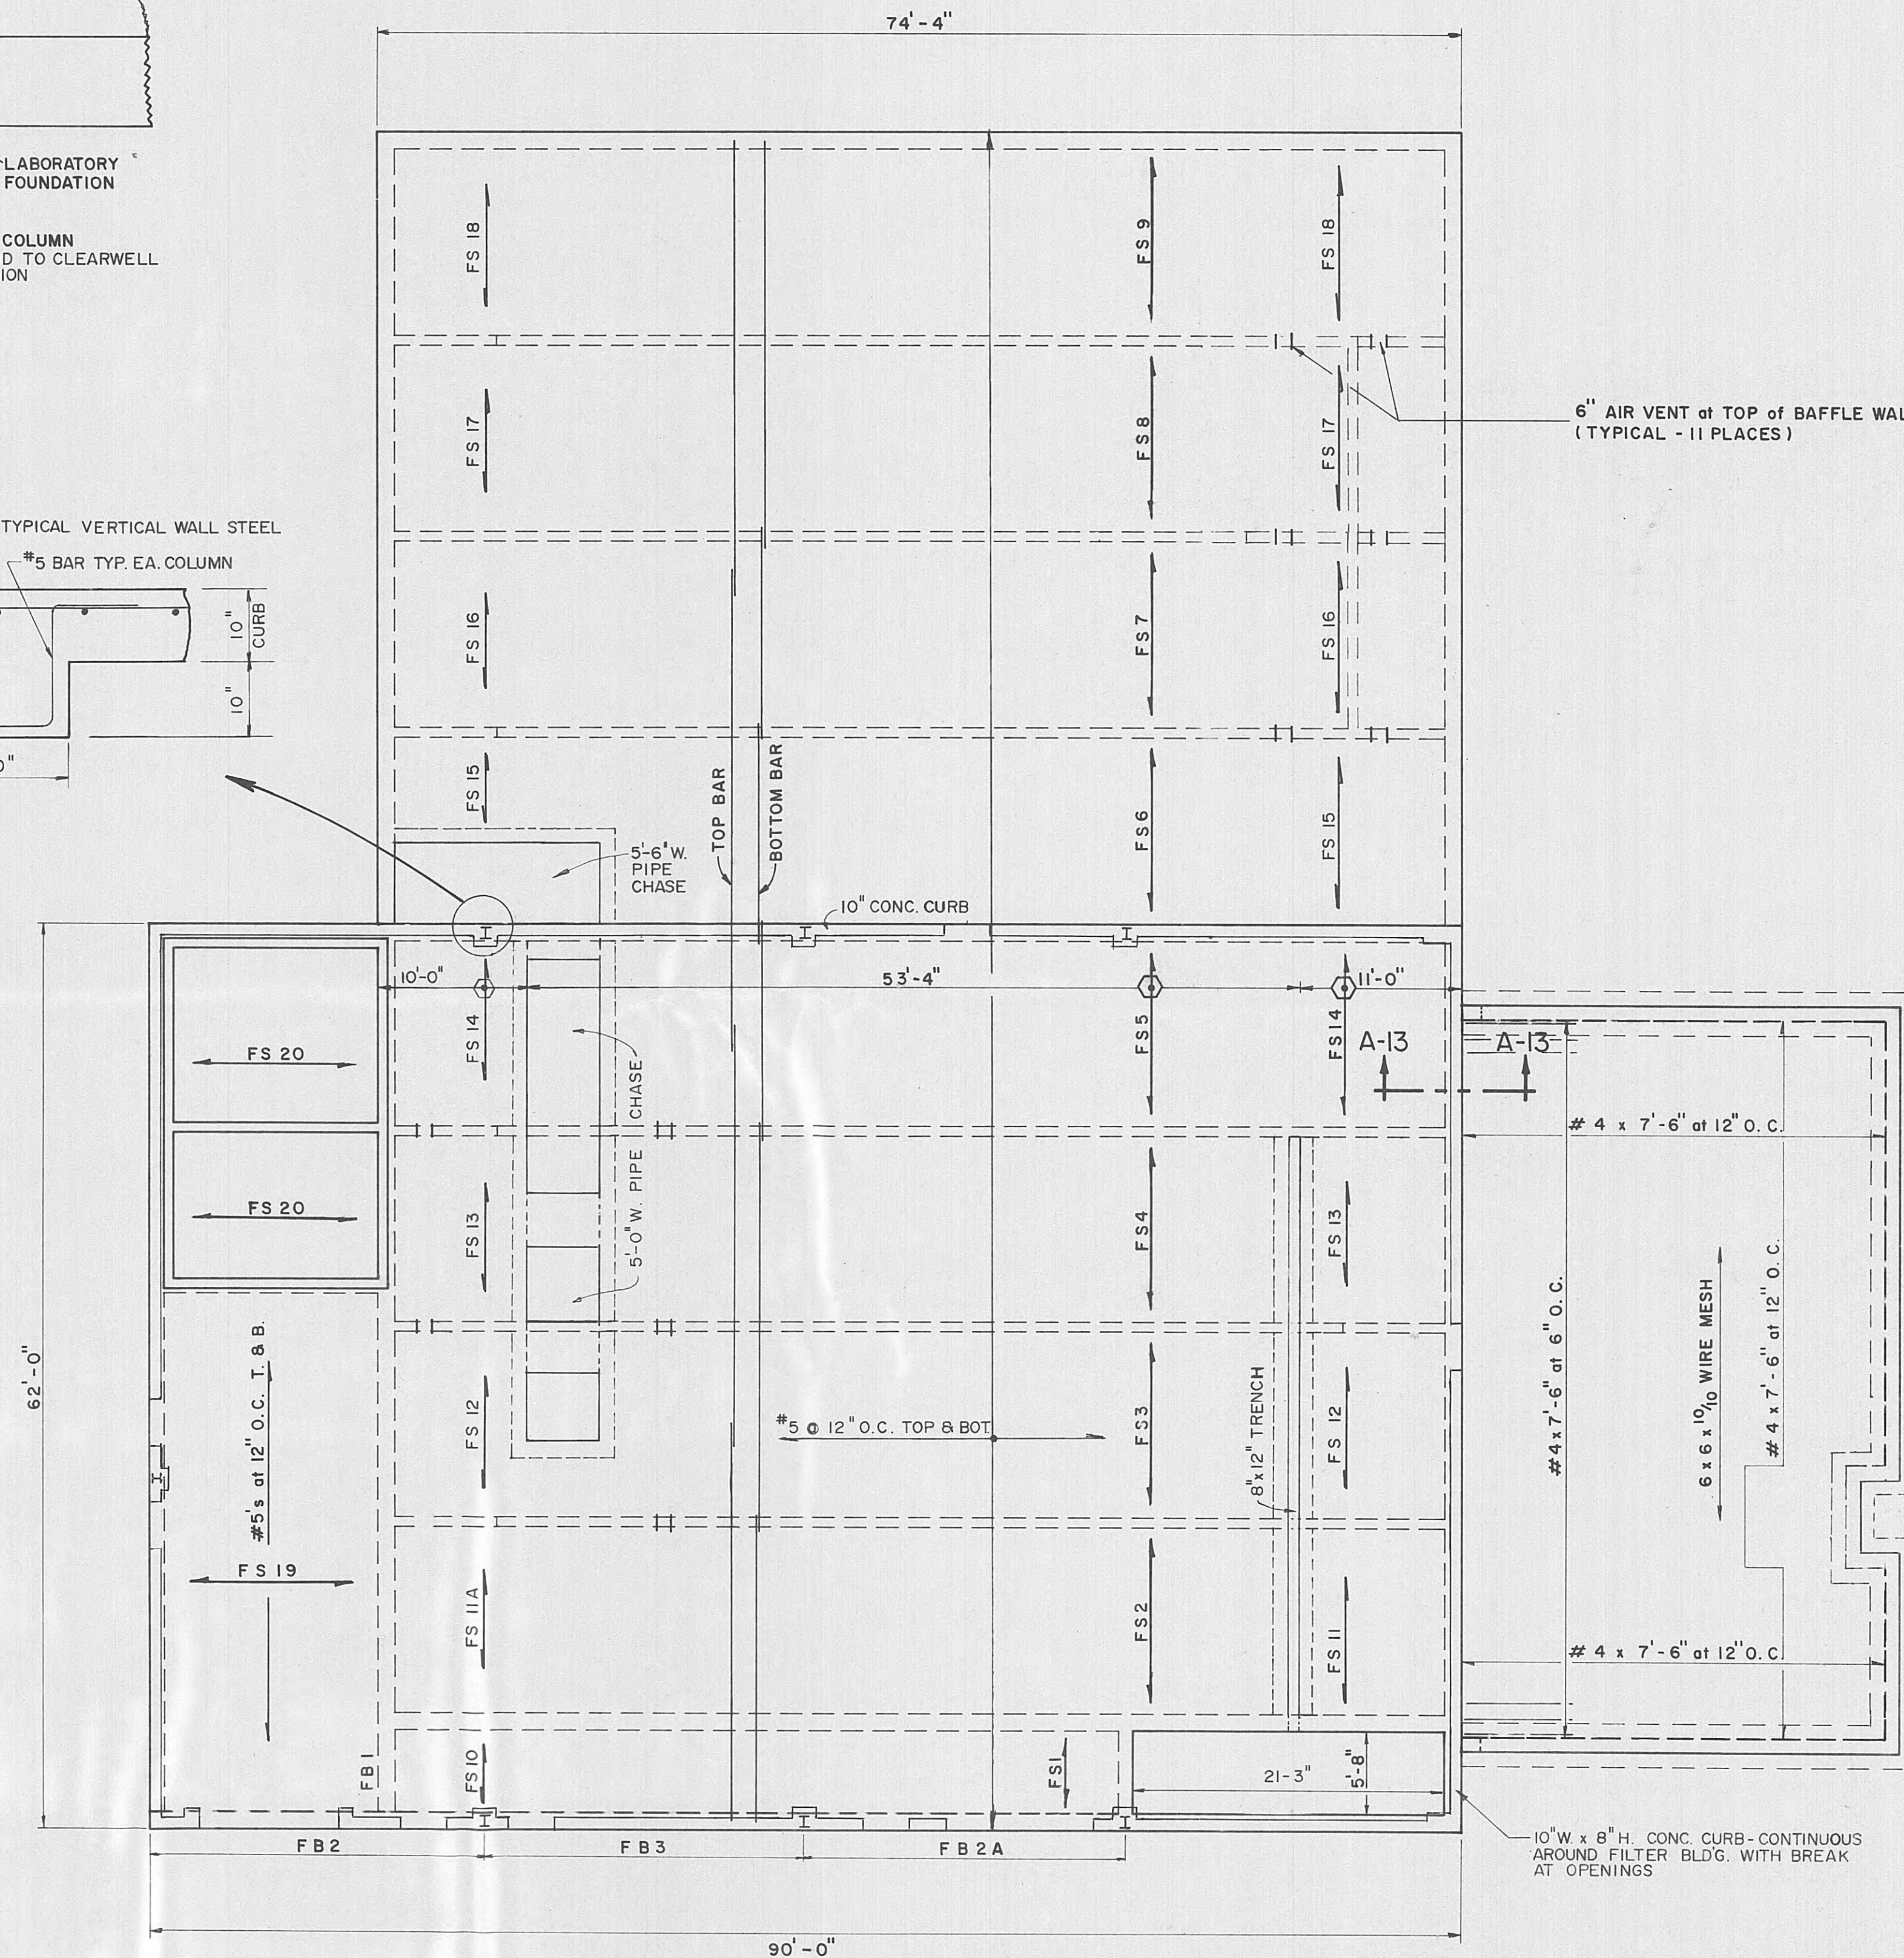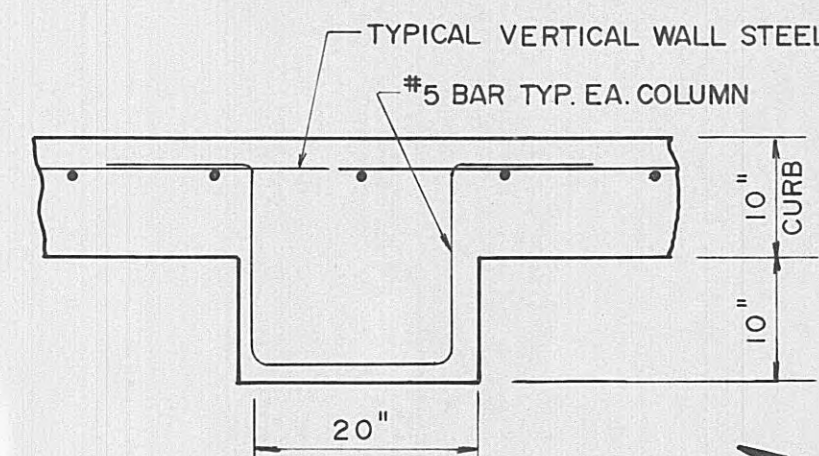

BEAM SCHEDULE						
MARK	SIZE B X D	REINFORCING		STIRRUPS		REMARKS
		BOTTOM	TOP	SIZE	SPACING	
FB1	14 X 18	3 # 6	2 # 6	#3 □	2" - 12" O.C. CONT.	SEE DETAIL
FB2	14 X 30	3 # 8	3 # 8	#3 □	2" - 12" O.C. CONT.	SPLICE TOP BARS @ FB3
FB3	14 X 30	3 # 8	FROM FB2	#3 □	2" - 12" O.C. CONT.	

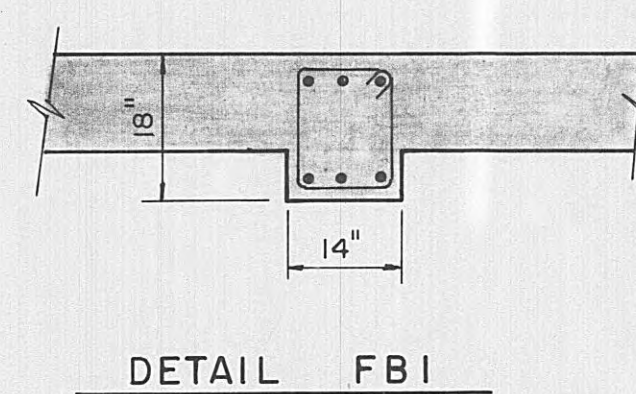

STRUCTURAL - FLOOR SLAB ELEVATION 782.0  
SCALE: 1/8" = 1'-0"

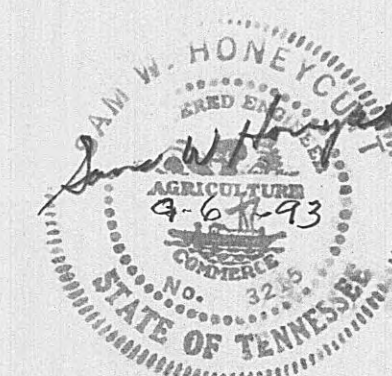


AS BUILT  
DATE: 3-20-95  
APPROVED: D.M.




LEGEND


---	PROCESS FLOW
---	BACKWASH FLOW & SURFACE WASH
---	60-80 PSI AIR
---	20 PSI AIR
---	3-15 PSI PNEUMATIC SIGNAL LINE
---	LOW PRESSURE AIR
---	ELECTRICAL LINE
---	CHEMICAL FEED LINE
PRV	PRESSURE RELIEF VALVE
FI	FLOW INDICATOR
PR	PRESSURE REGULATOR
CV	CONTROL VALVE
PI	PRESSURE INDICATOR
VRV	VACUUM RELEASE VALVE
ARV	AIR RELEASE VALVE
PI	PRESSURE INDICATOR
PS	PRESSURE SWITCH
LC	LEVEL CONTROLLER
POS	VALVE POSITIONER
M	MOTOR
SCD	STREAMING CURRENT DETECTOR
SV	SOLENOID VALVE
AS	AIR SUPPLY 65-80 PSI CLEAN & DRY

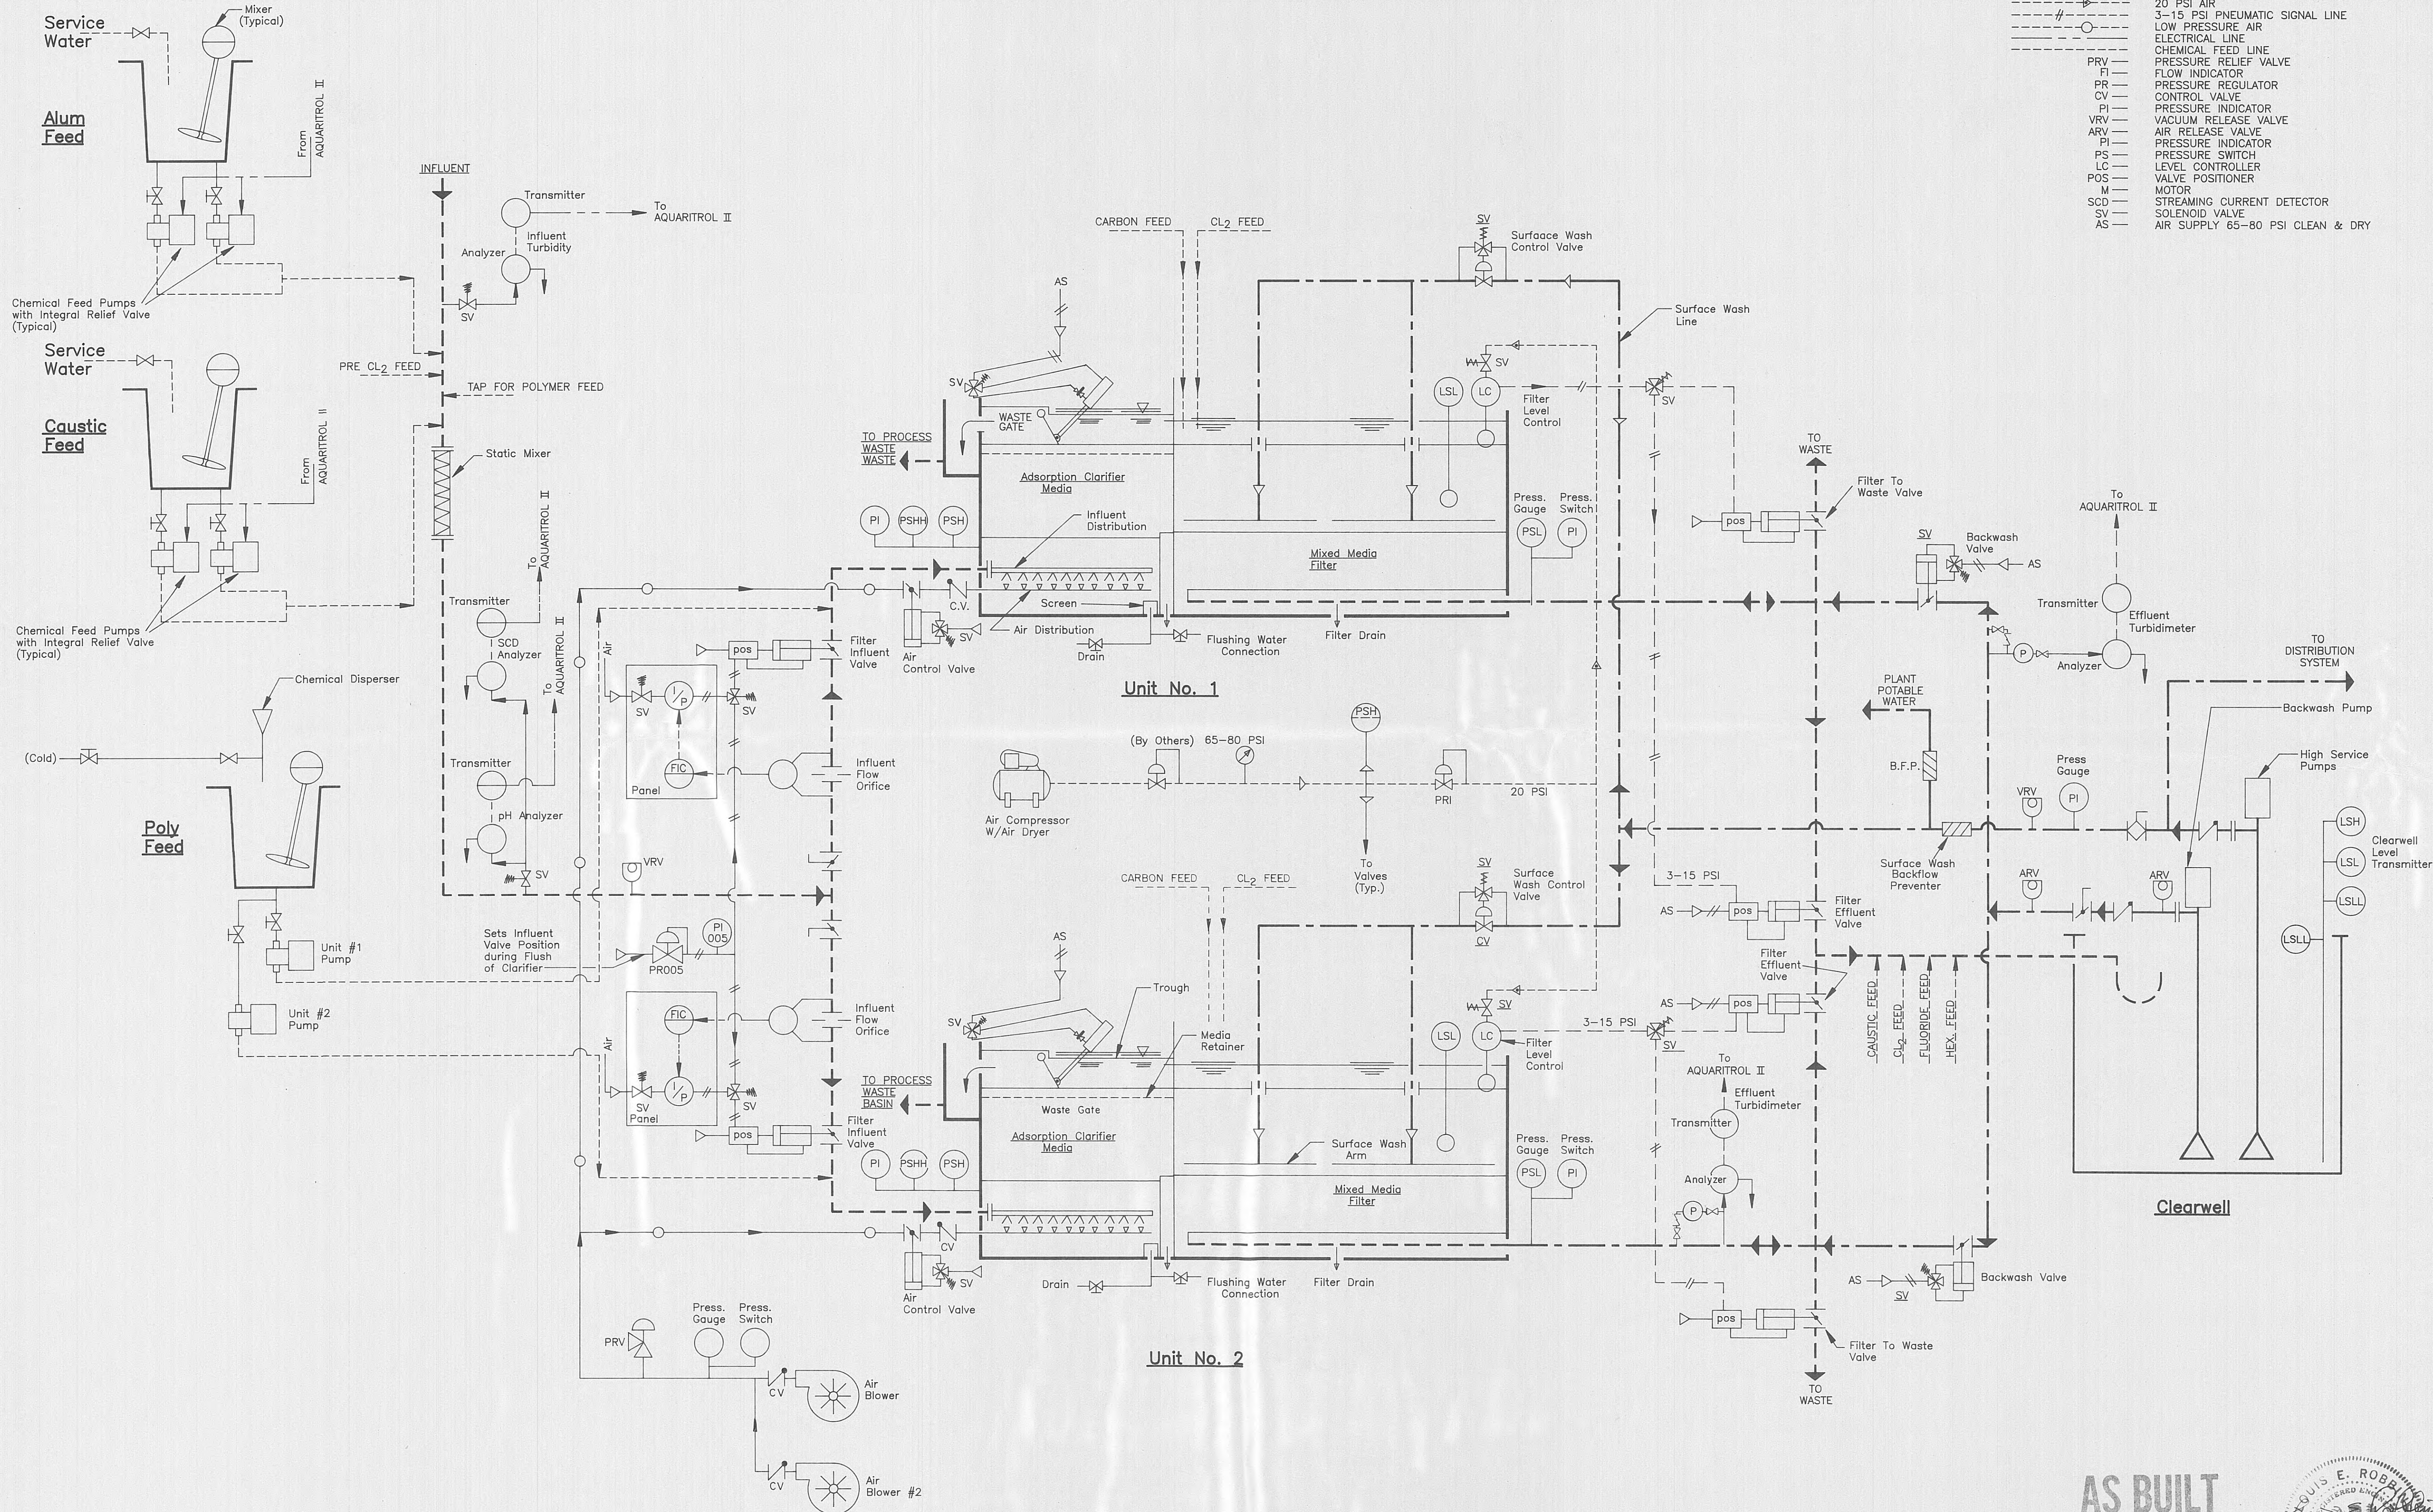


AS BUILT  
DATE: 3-20-95  
APPROVED: D.M.

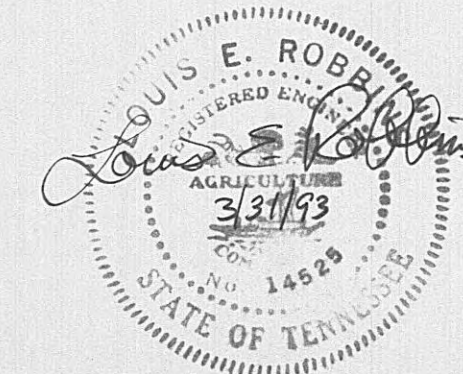



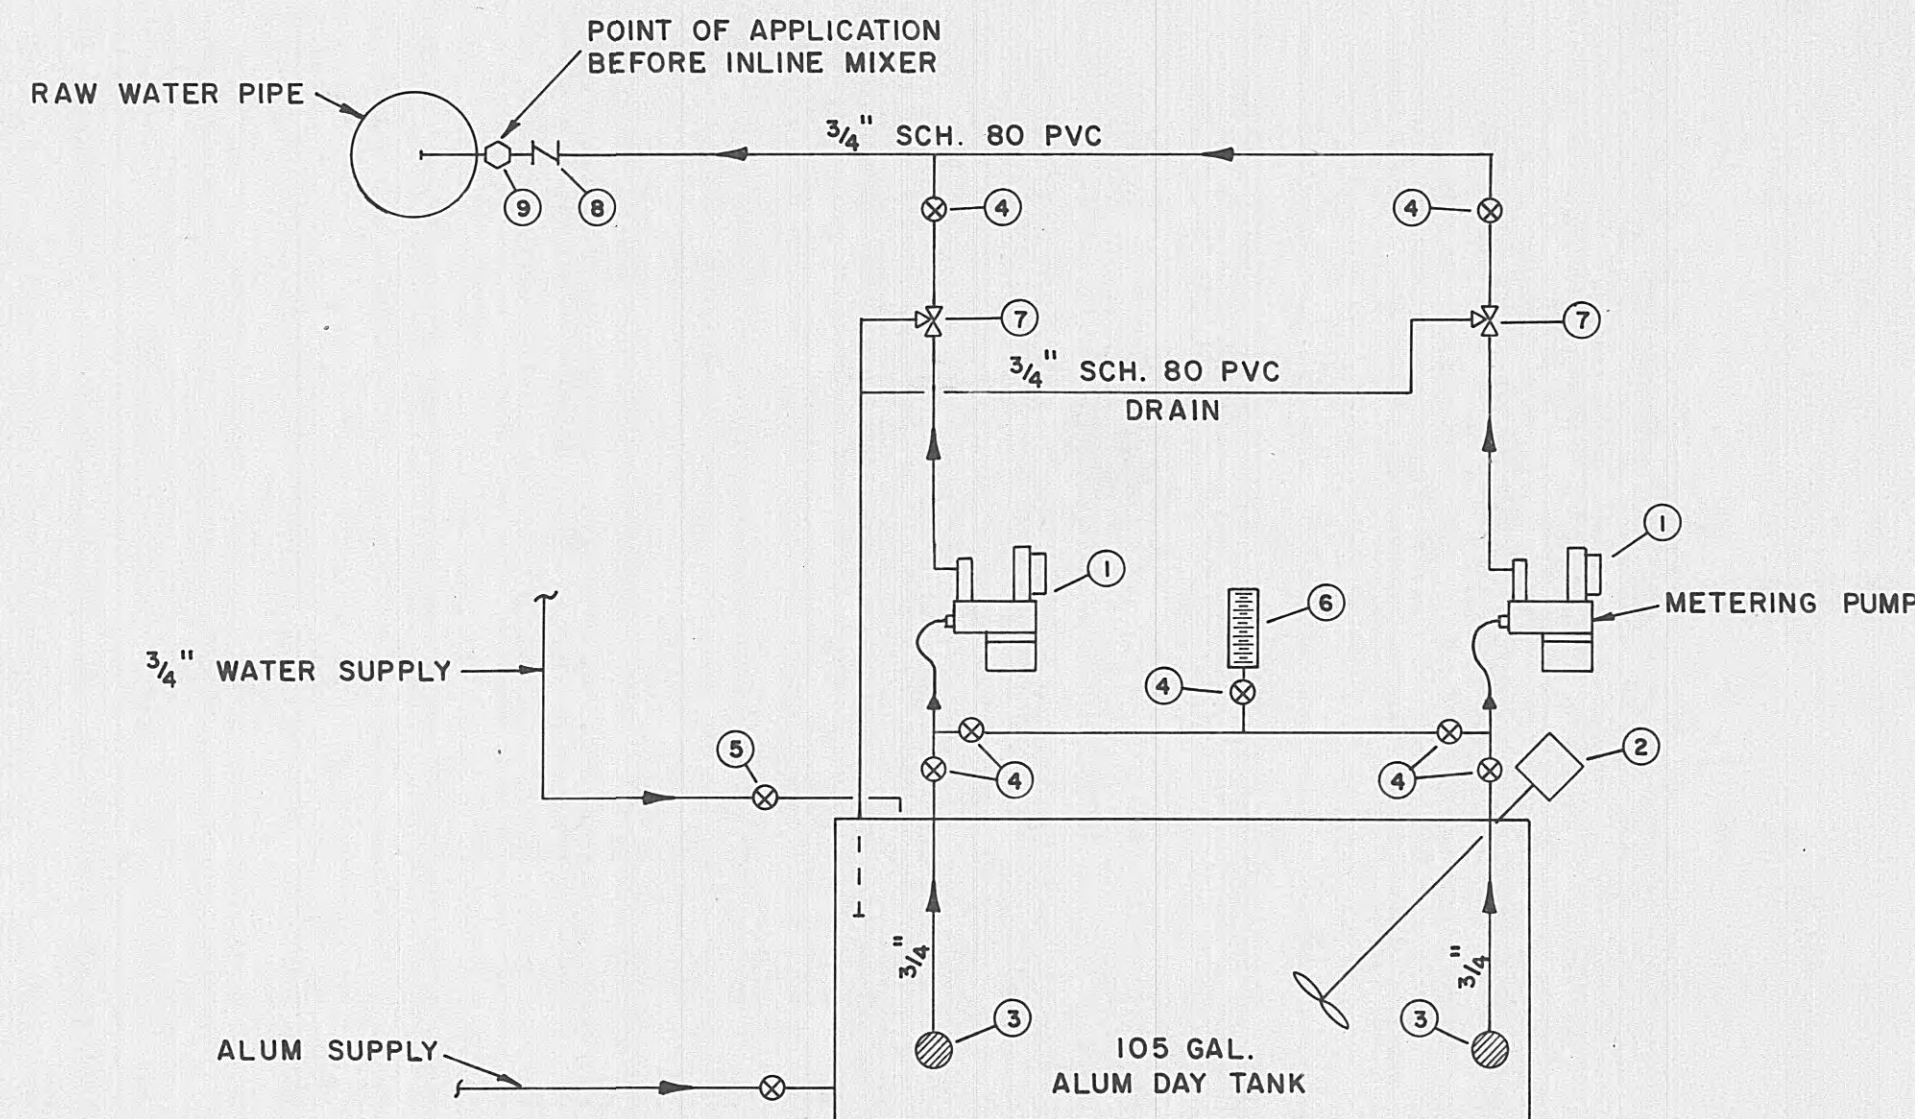


LIQUID ALUM FEED SCHEMATIC

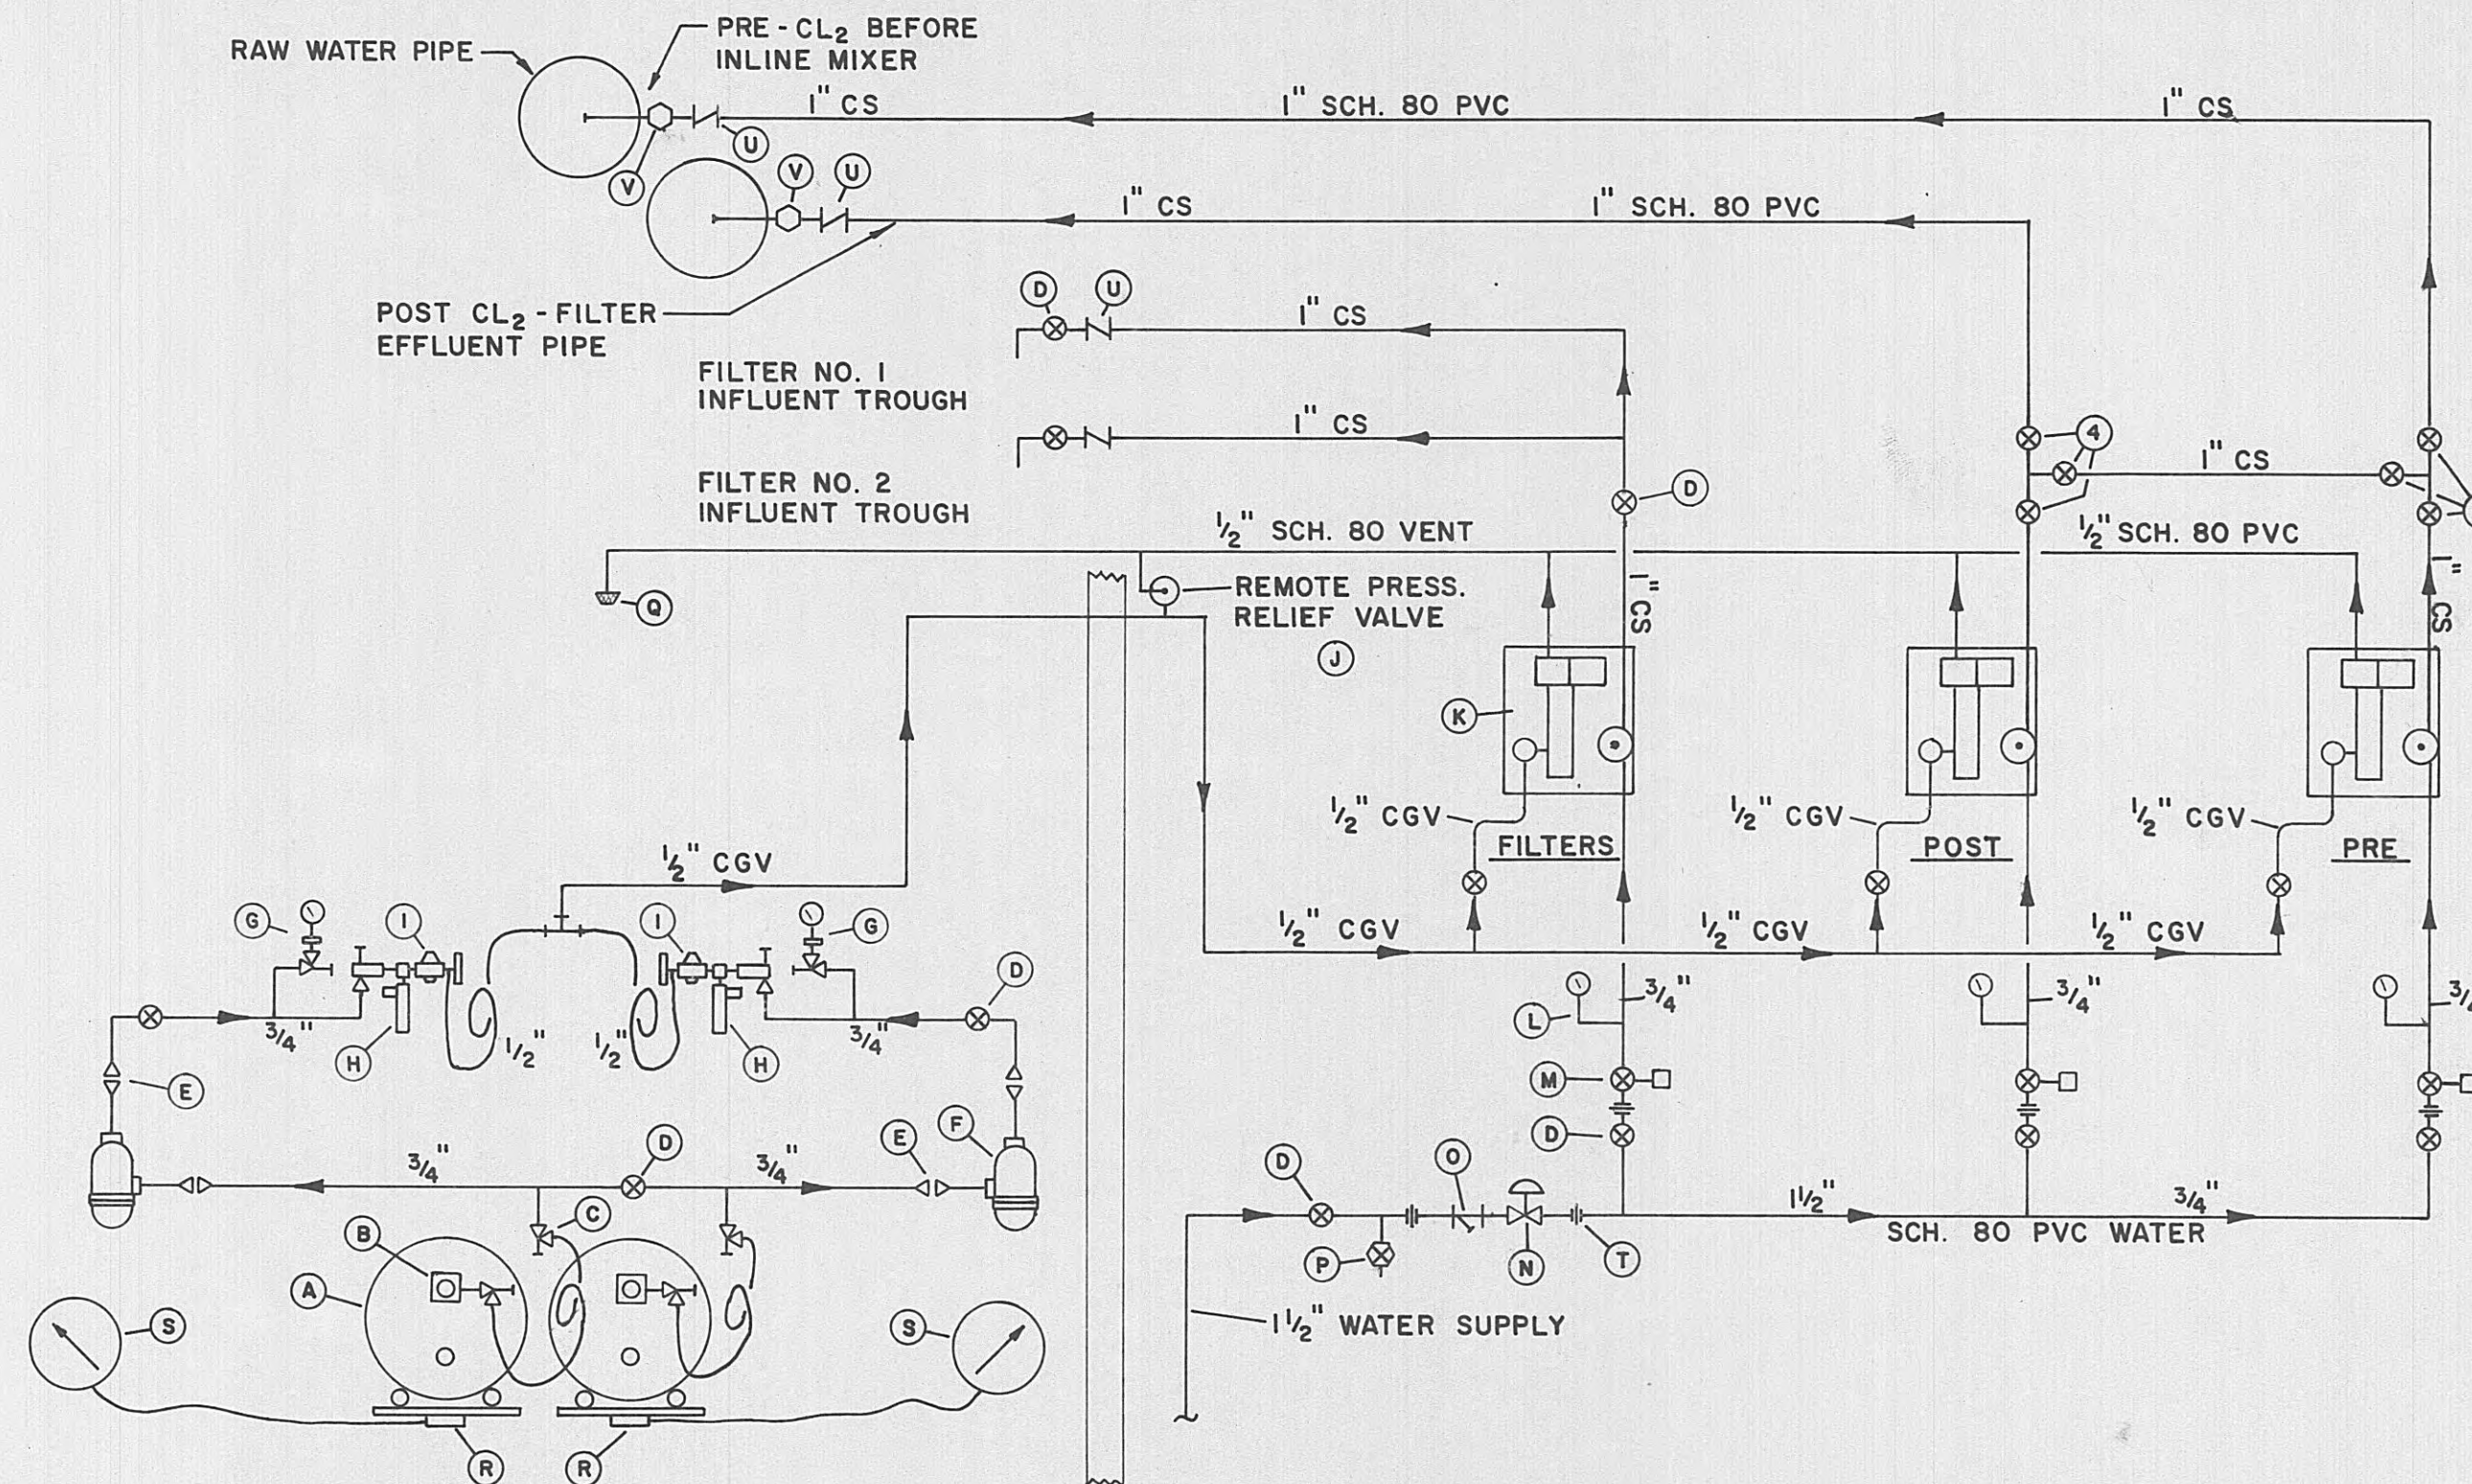


CHLORINATION SCHEMATIC


- CHLORINATION LEGEND
- A. TON CYLINDERS
  - B. CAPTIVE YOLK TYPE TON CYLINDER VALVE
  - C. HEADER VALVE
  - D. BALL VALVE
  - E. AMMONIA UNION
  - F. FILTER
  - G. CHLORINE GAS PRESSURE GAUGE W/HEADER VALVE
  - H. HEATER - DRIP LEG
  - I. VACUUM REGULATOR
  - J. REMOTE PRESSURE RELIEF VALVE
  - K. CHLORINATOR
  - L. WATER PRESSURE GAUGE
  - M. SOLENOID VALVE
  - N. PRESSURE REGULATING VALVE
  - O. Y-STRAINER
  - P. HOSE BIBB
  - Q. VENT SCREEN
  - R. TON CYLINDER SCALES
  - S. SCALES DIAL INDICATOR (REMOTE LOCATION)
  - T. UNION
  - U. CHECK VALVE
  - V. CORPORATION COCK MAIN CONNECTION

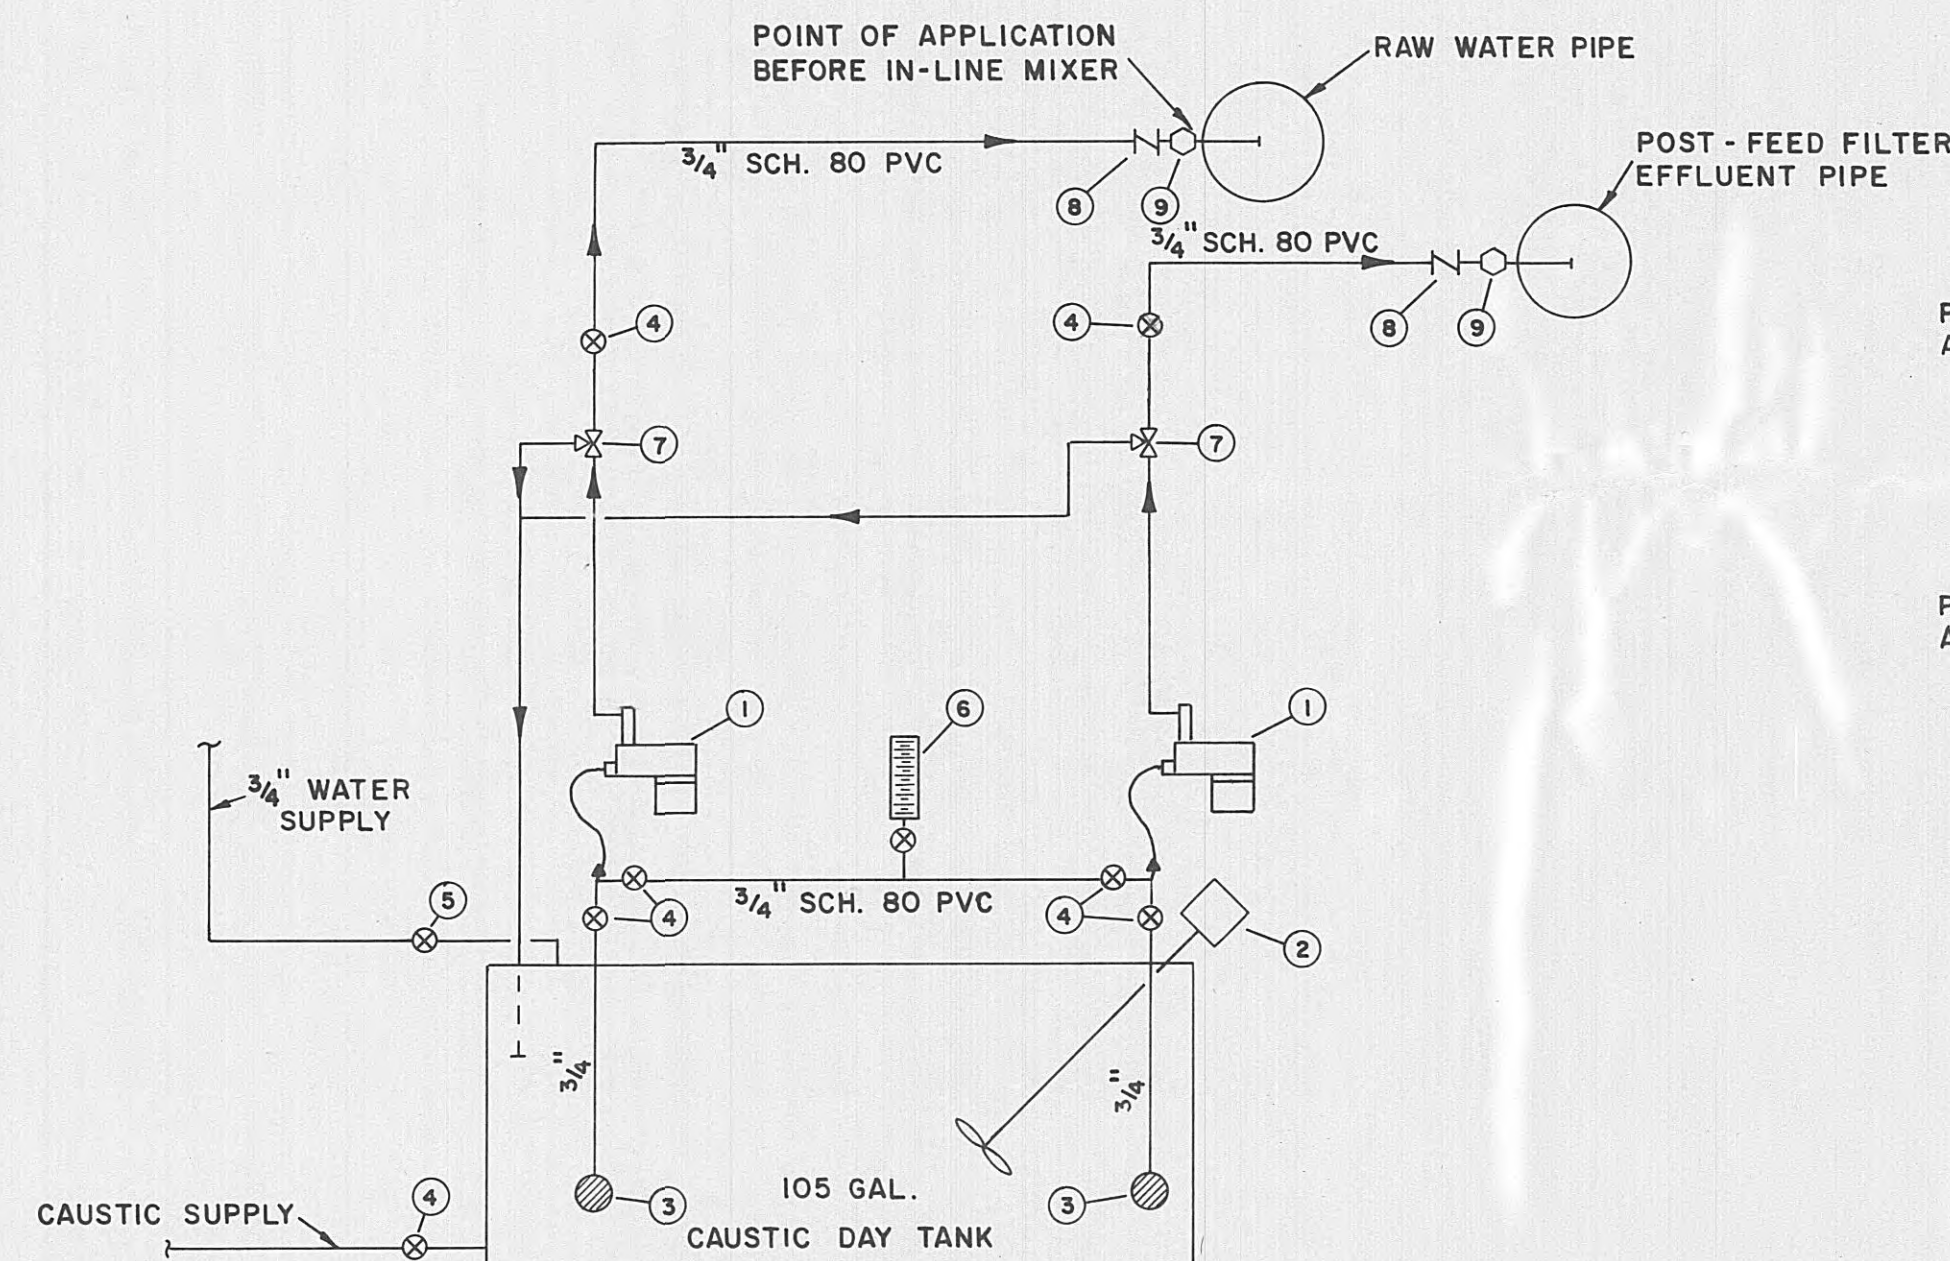

LIQUID CAUSTIC FEED SCHEMATIC

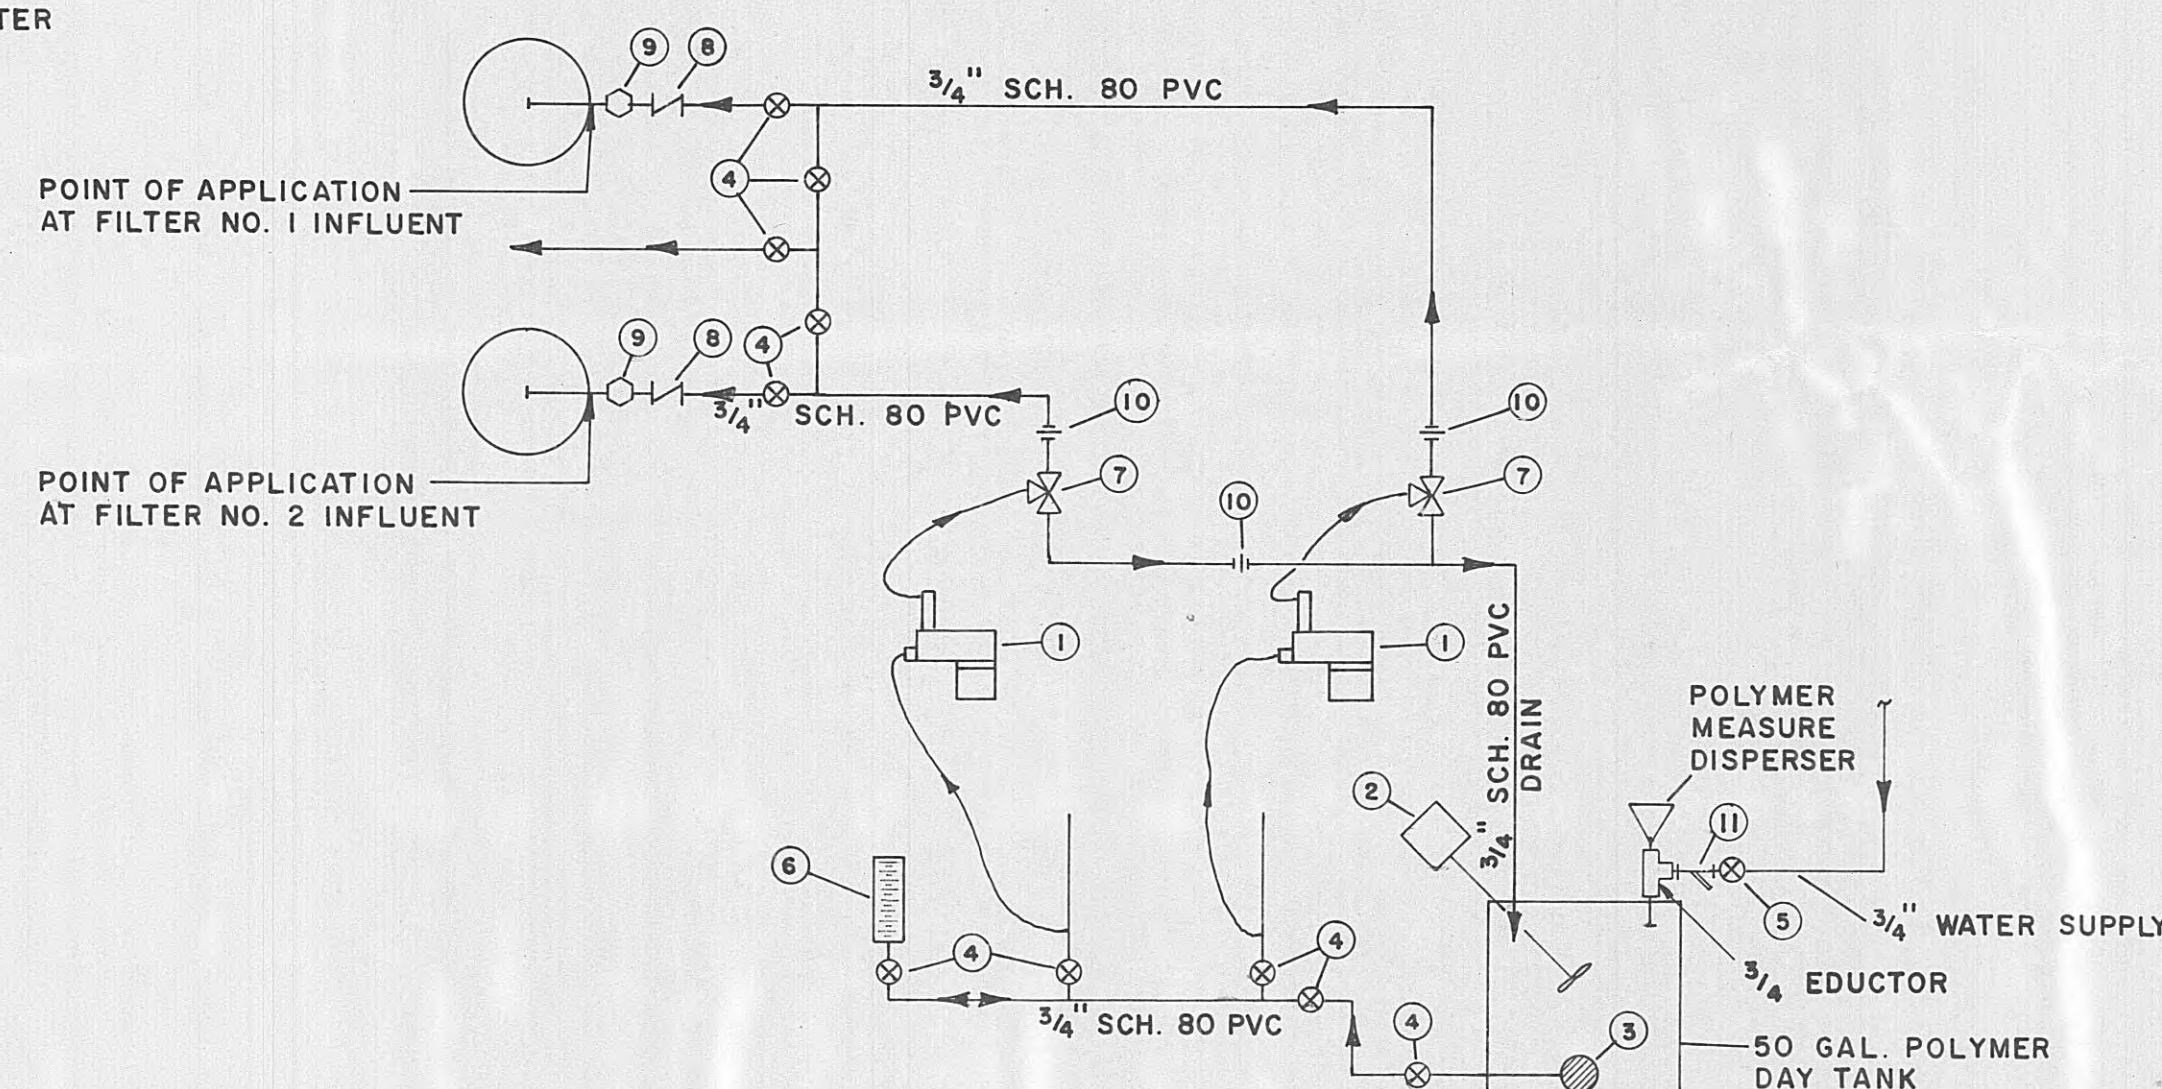


LIQUID POLYMER FEED SCHEMATIC

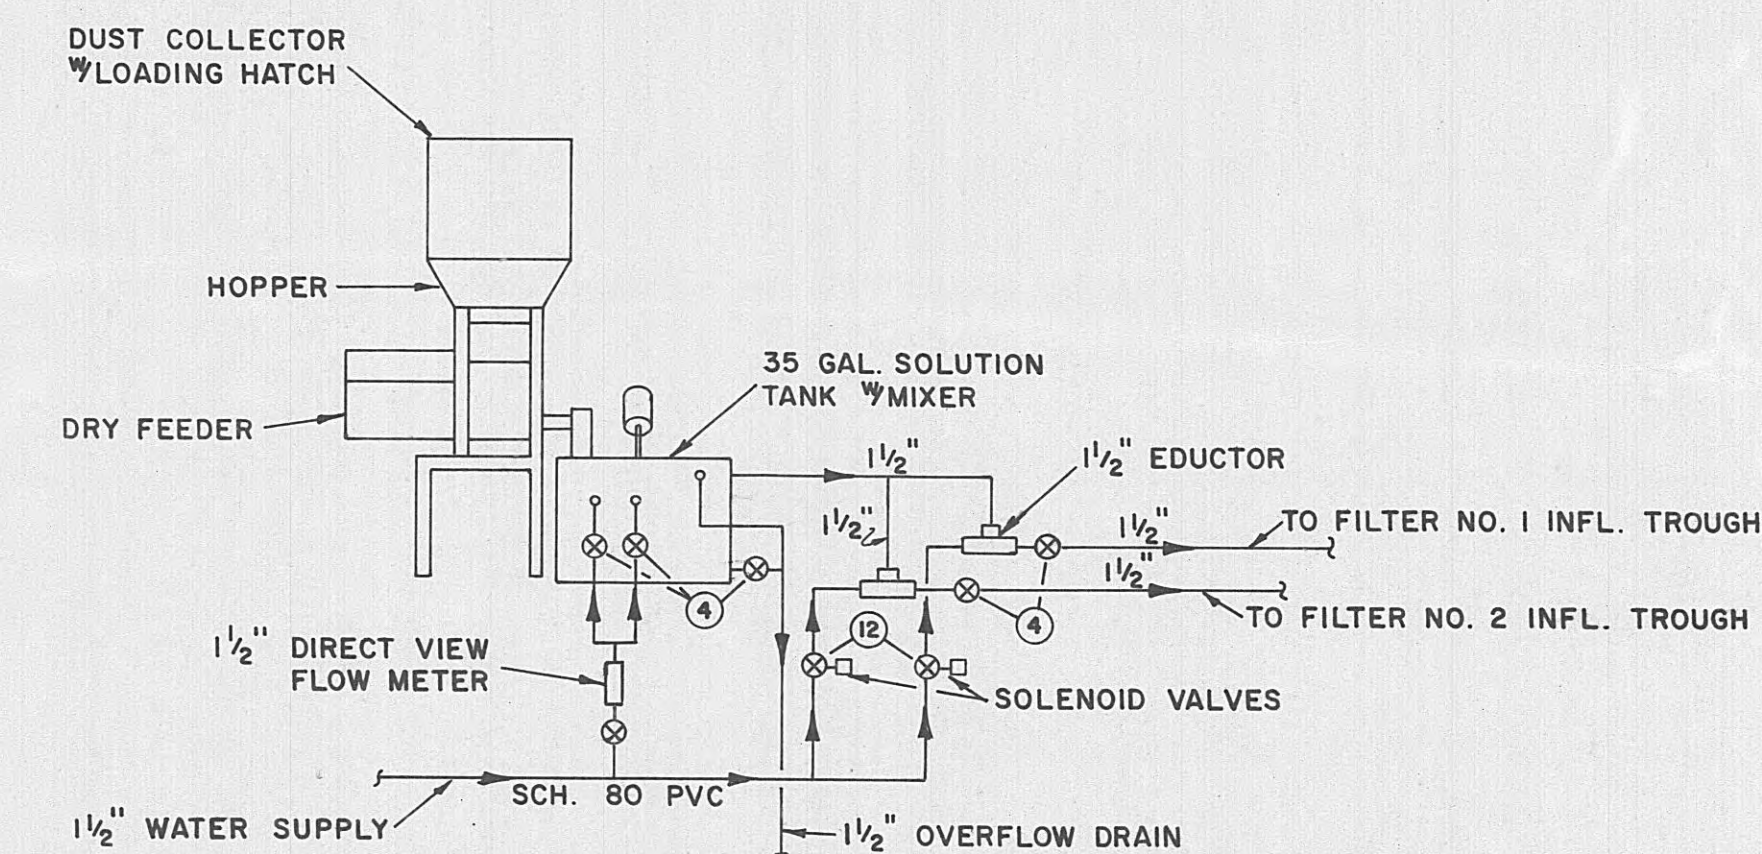


CARBON (DRY) FEED SCHEMATIC


- CHEMICAL FEED LEGEND
- 1. CHEMICAL METERING PUMP
  - 2. CHEMICAL MIXER
  - 3. FOOT VALVE/STRAINER
  - 4. BALL VALVES
  - 5. HOSE BIBB
  - 6. CALIBRATION CHAMBER
  - 7. PRESSURE RELIEF VALVE
  - 8. CHECK VALVE
  - 9. CORPORATION COCK MAIN CONNECTION
  - 10. UNION
  - 11. STRAINER
  - 12. SOLENOID VALVES

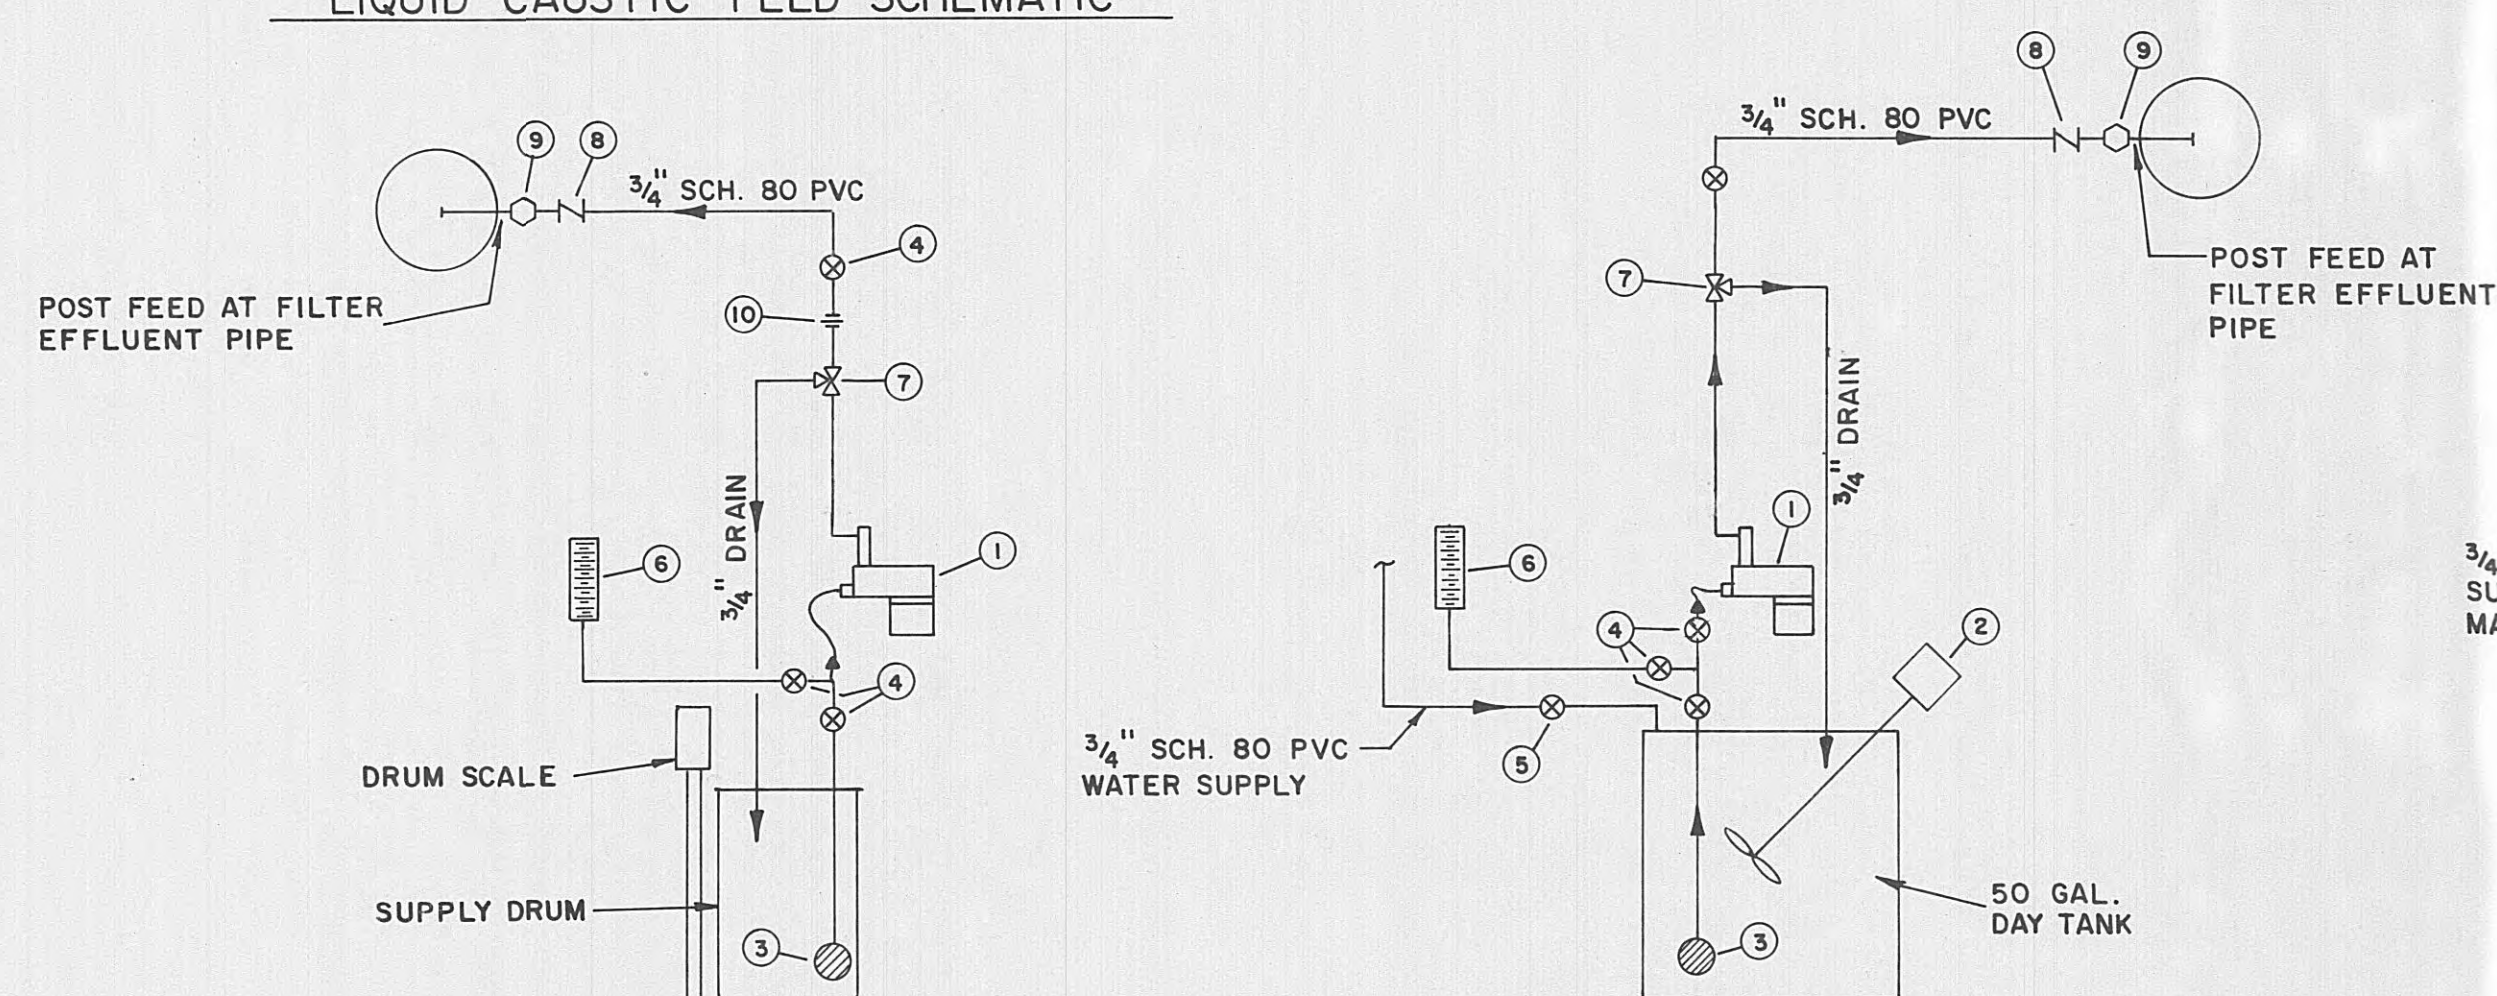

LIQUID FLUORIDE FEED SCHEMATIC

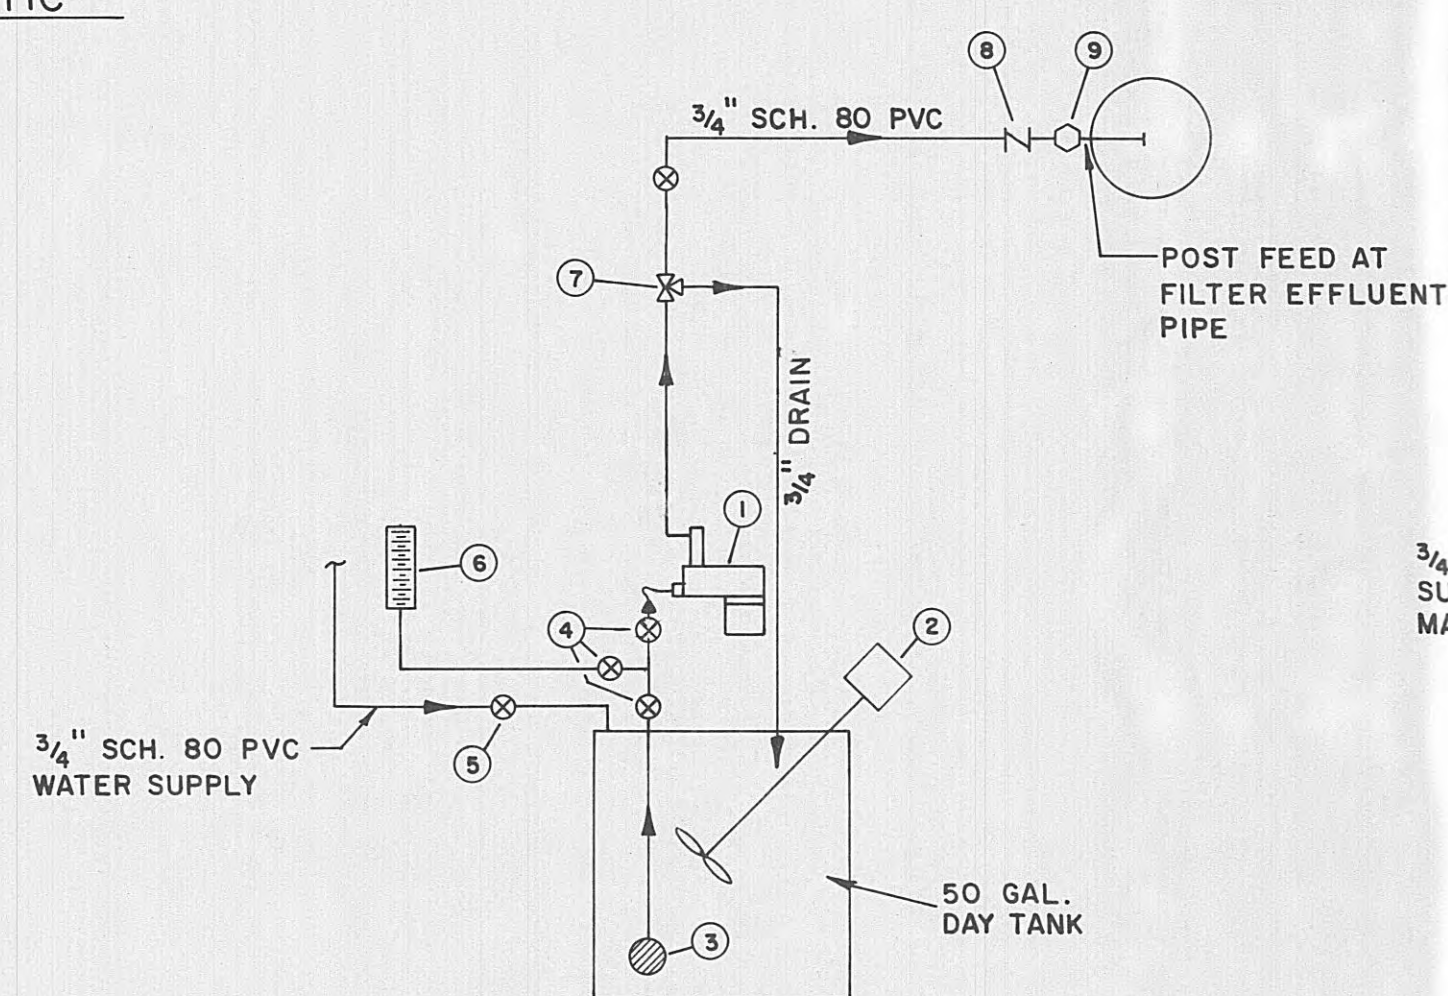


LIQUID PHOSPHATE FEED SCHEMATIC

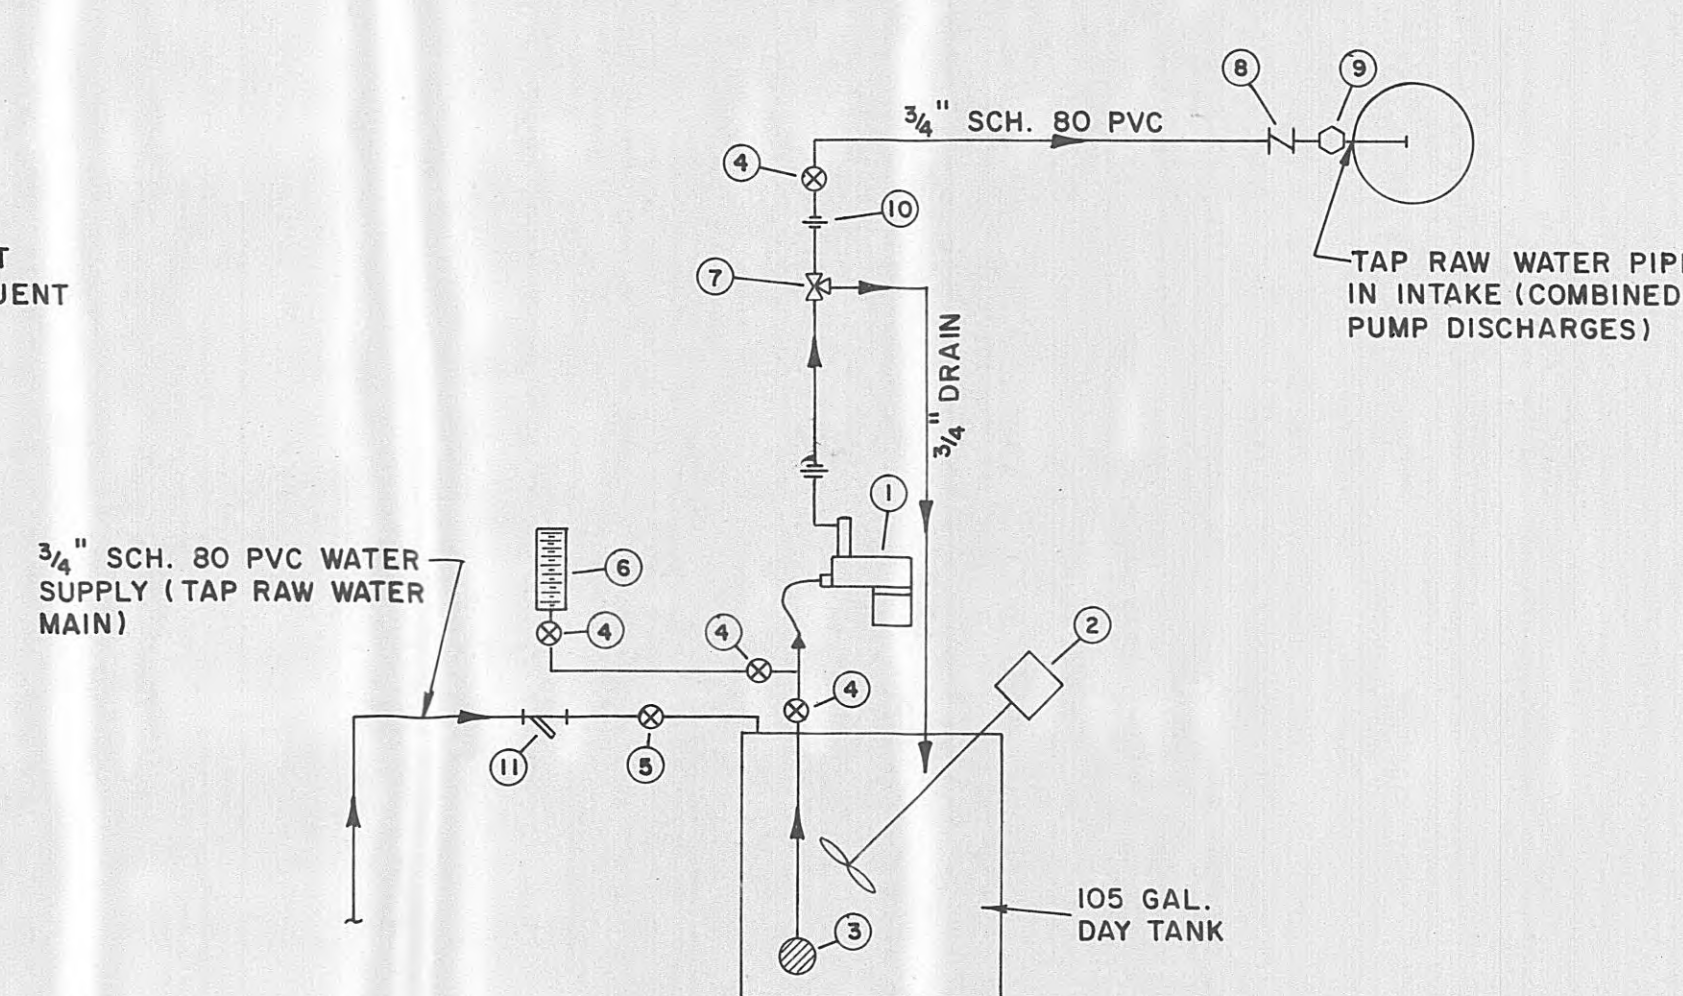

POTASSIUM PERMANGANATE FEED SCHEMATIC  
(LOCATED IN INTAKE PUMP BUILDING)

AS BUILT  
DATE: 3-20-95  
APPROVED: D.M.

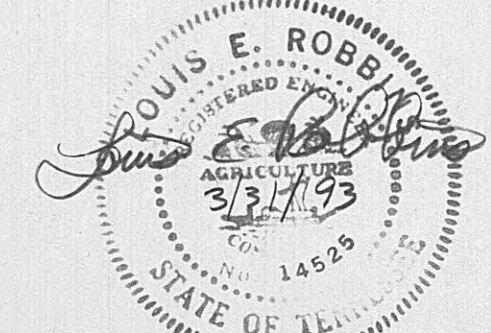

ELROD • DUNSON, INC.  
CONSULTING ENGINEERS  
NASHVILLE • KNOXVILLE  
LEXINGTON, KY

HARRIMAN, TENNESSEE  
CHLORINATION AND CHEMICAL FEED SCHEMATICS  
CONTRACT W93-04


REVISIONS

DESIGNED: L. E. R.  
DRAWN: D. G. R., D. M.  
CHECKED: L. E. R.  
DATE: MARCH, 1993  
SCALE: NONE  
PROJ. NO. 0592


SHEET 15

OF 36




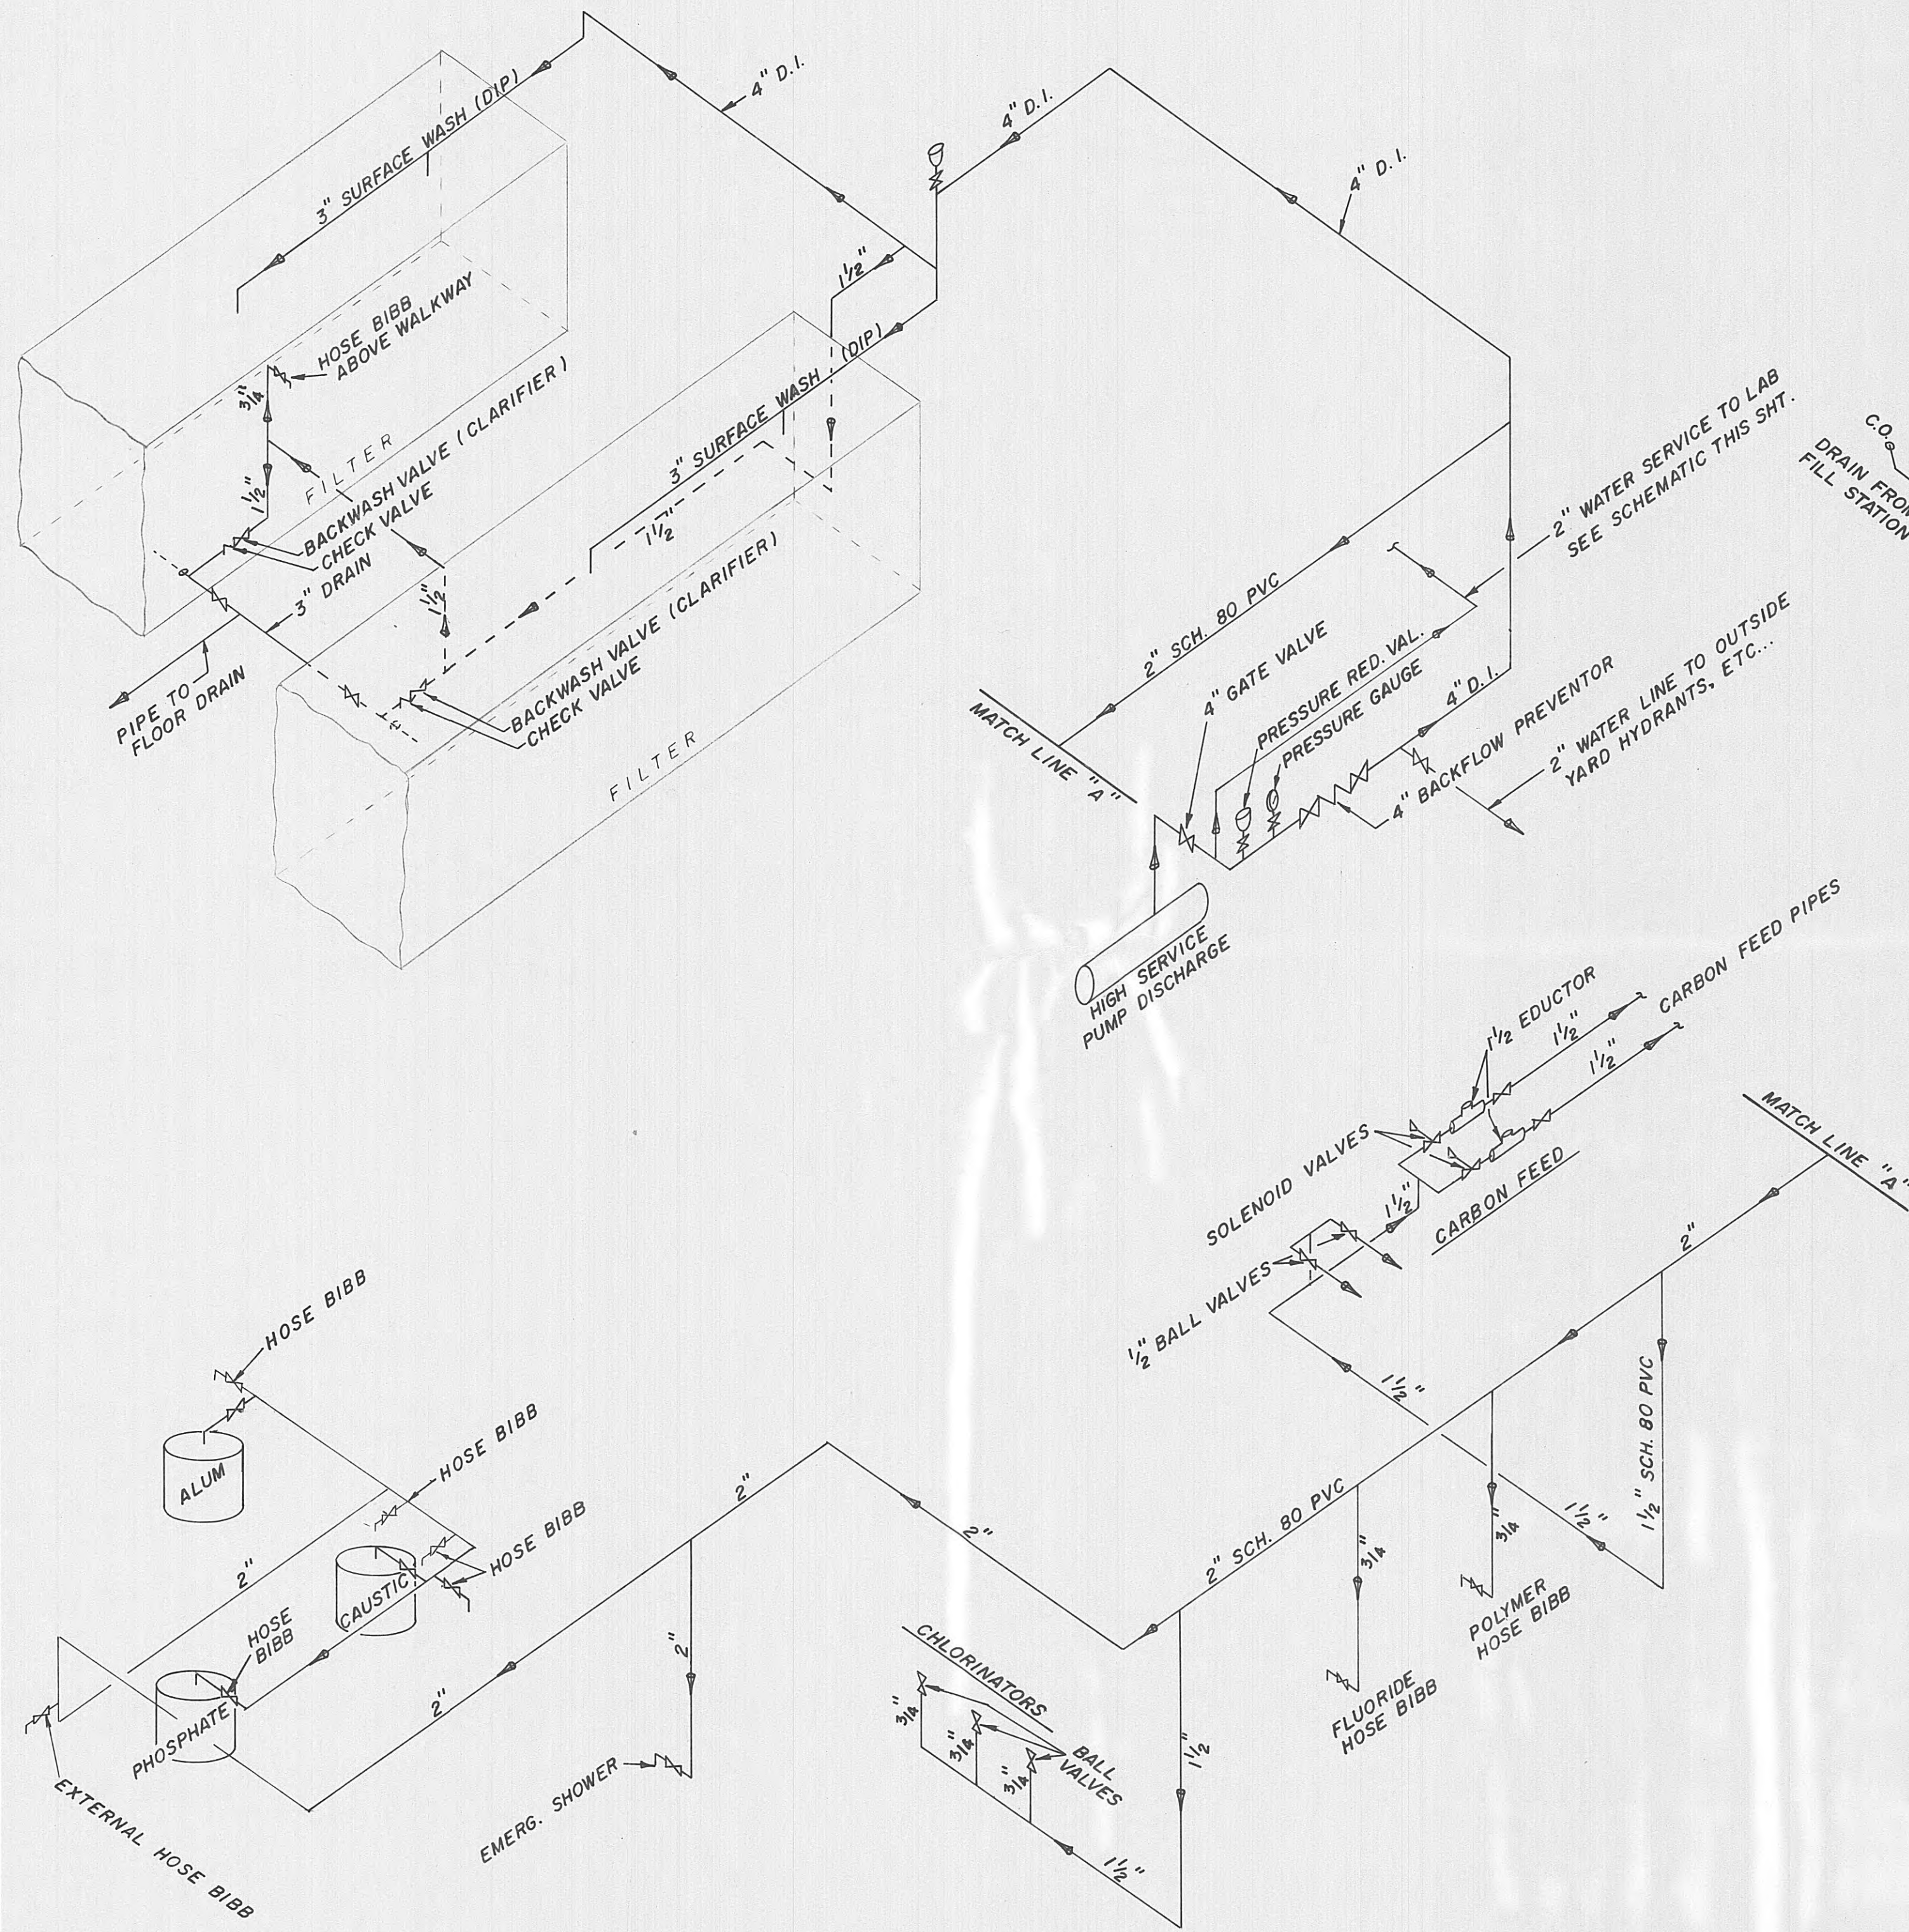

SURFACE WASH/CHEMICAL FEED WATER SCHEMATIC

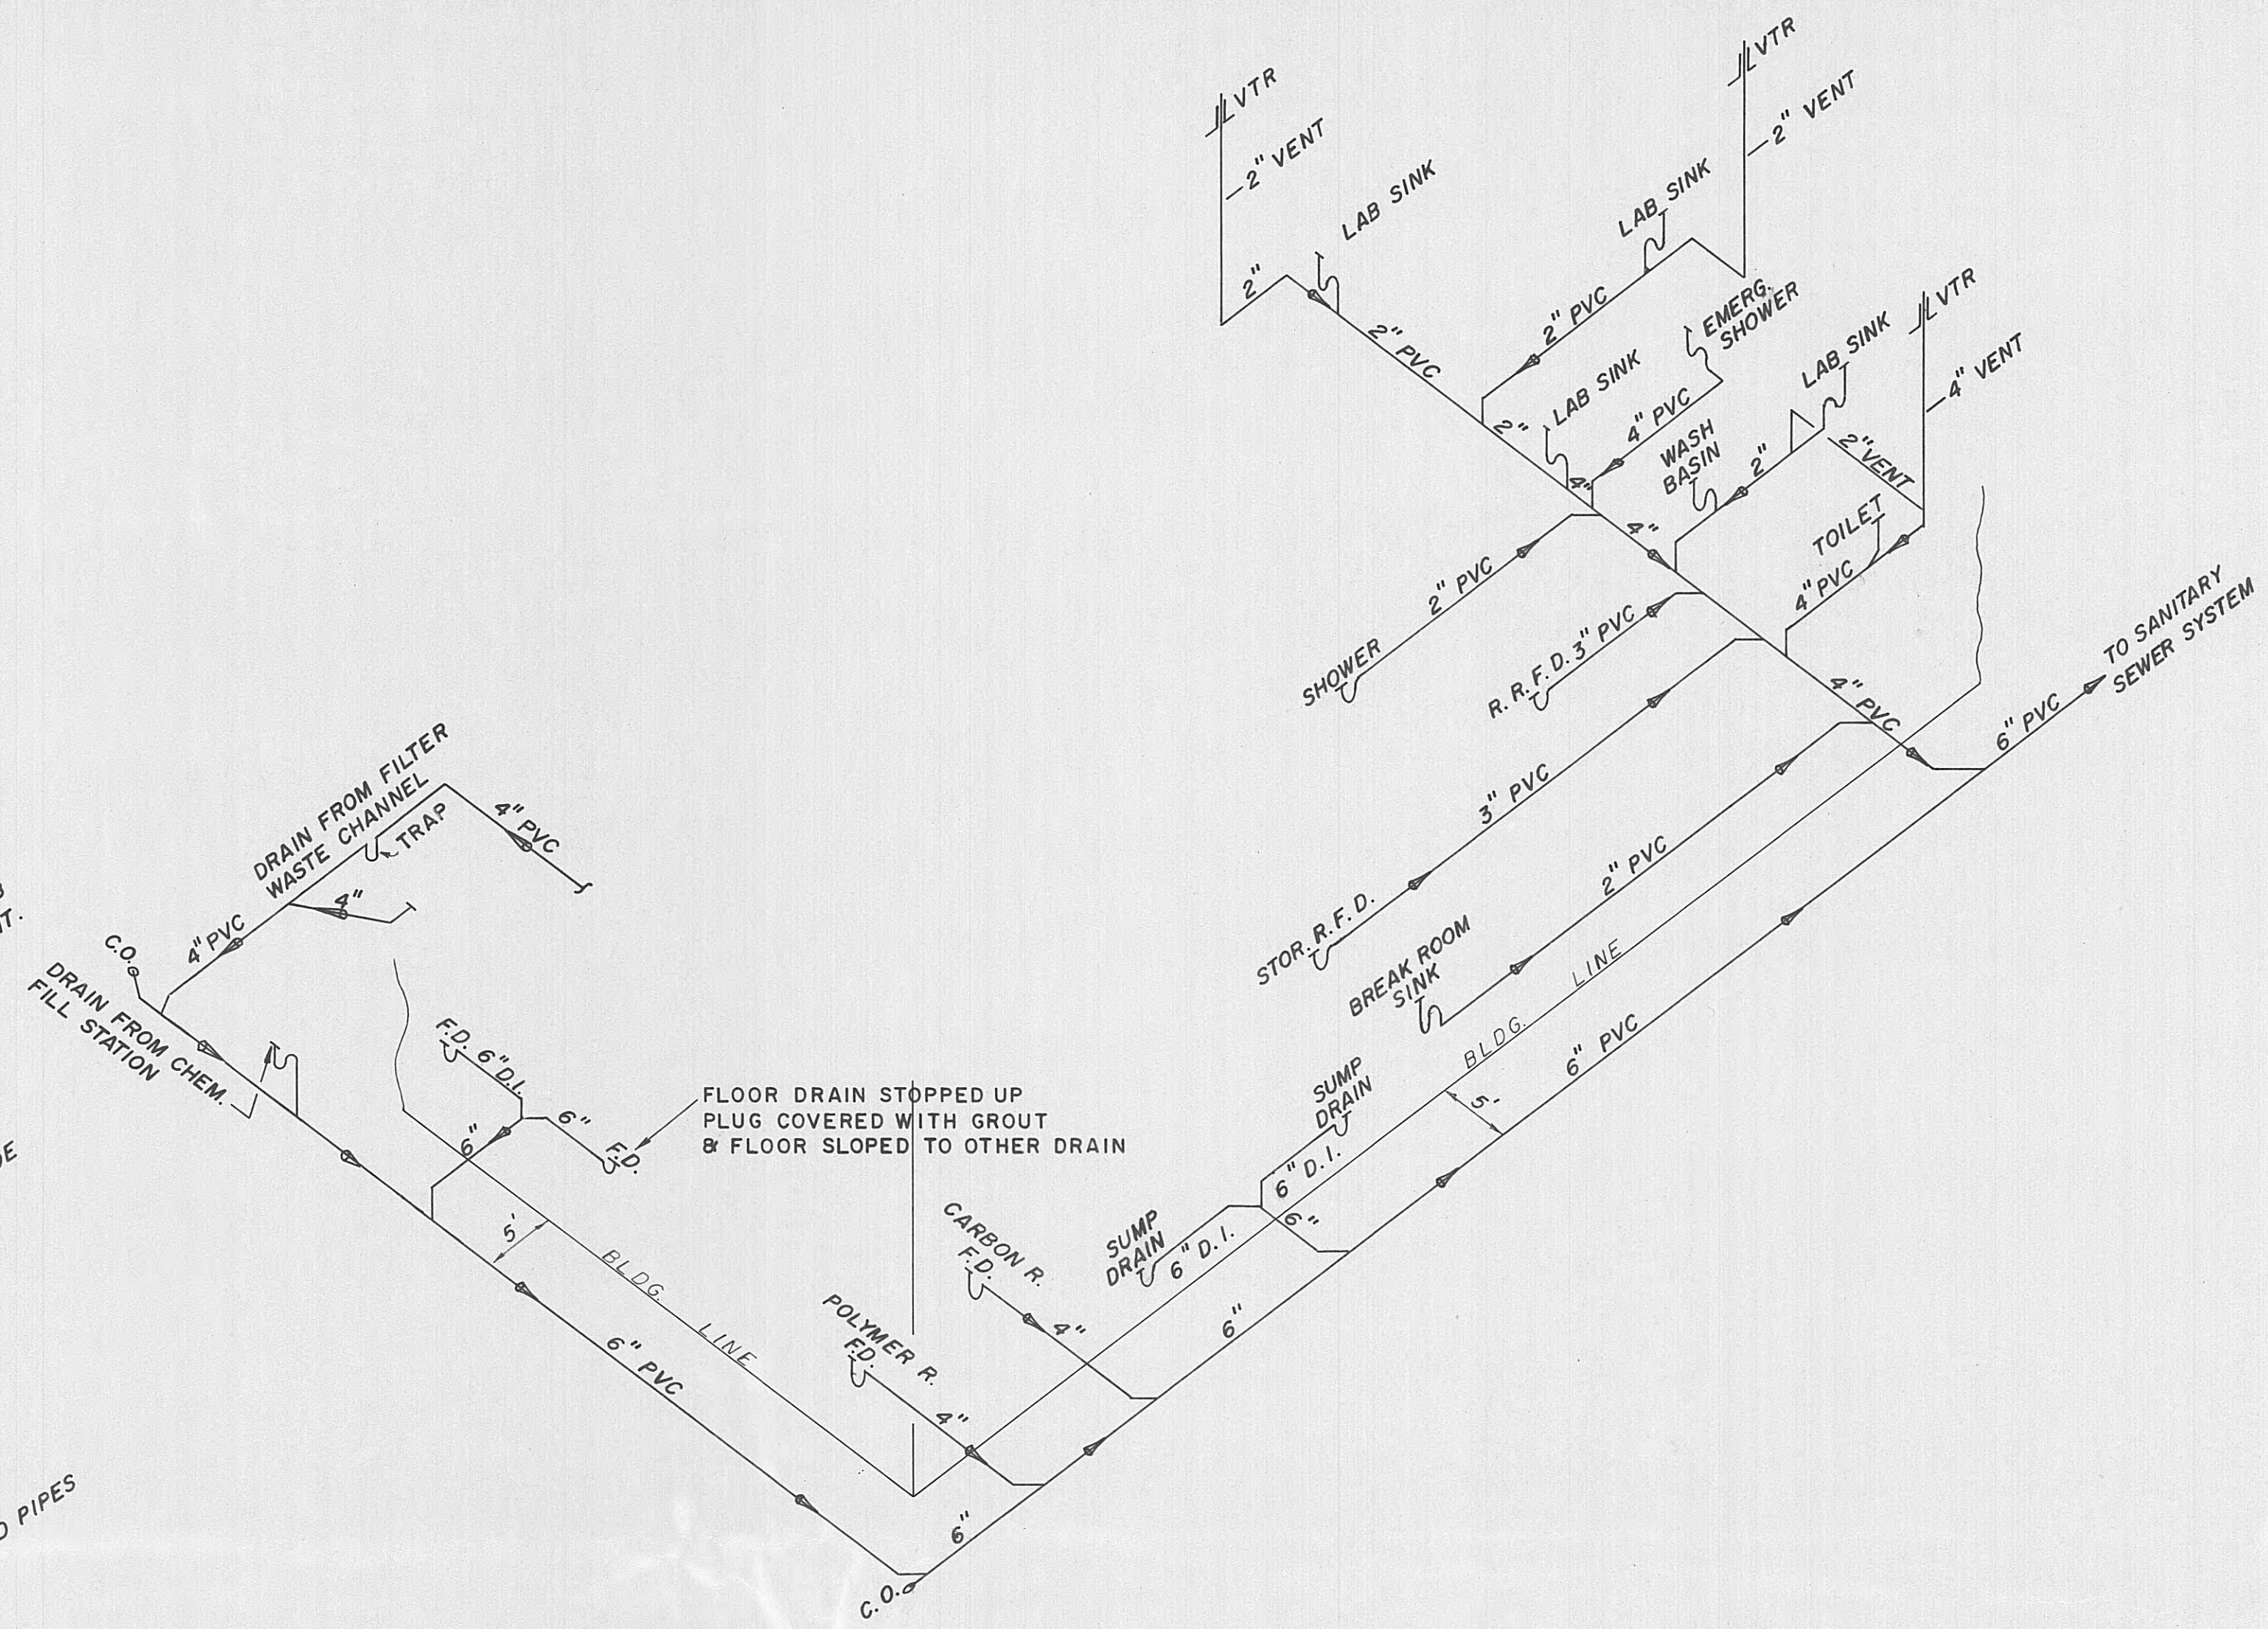


PLUMBING SCHEMATIC

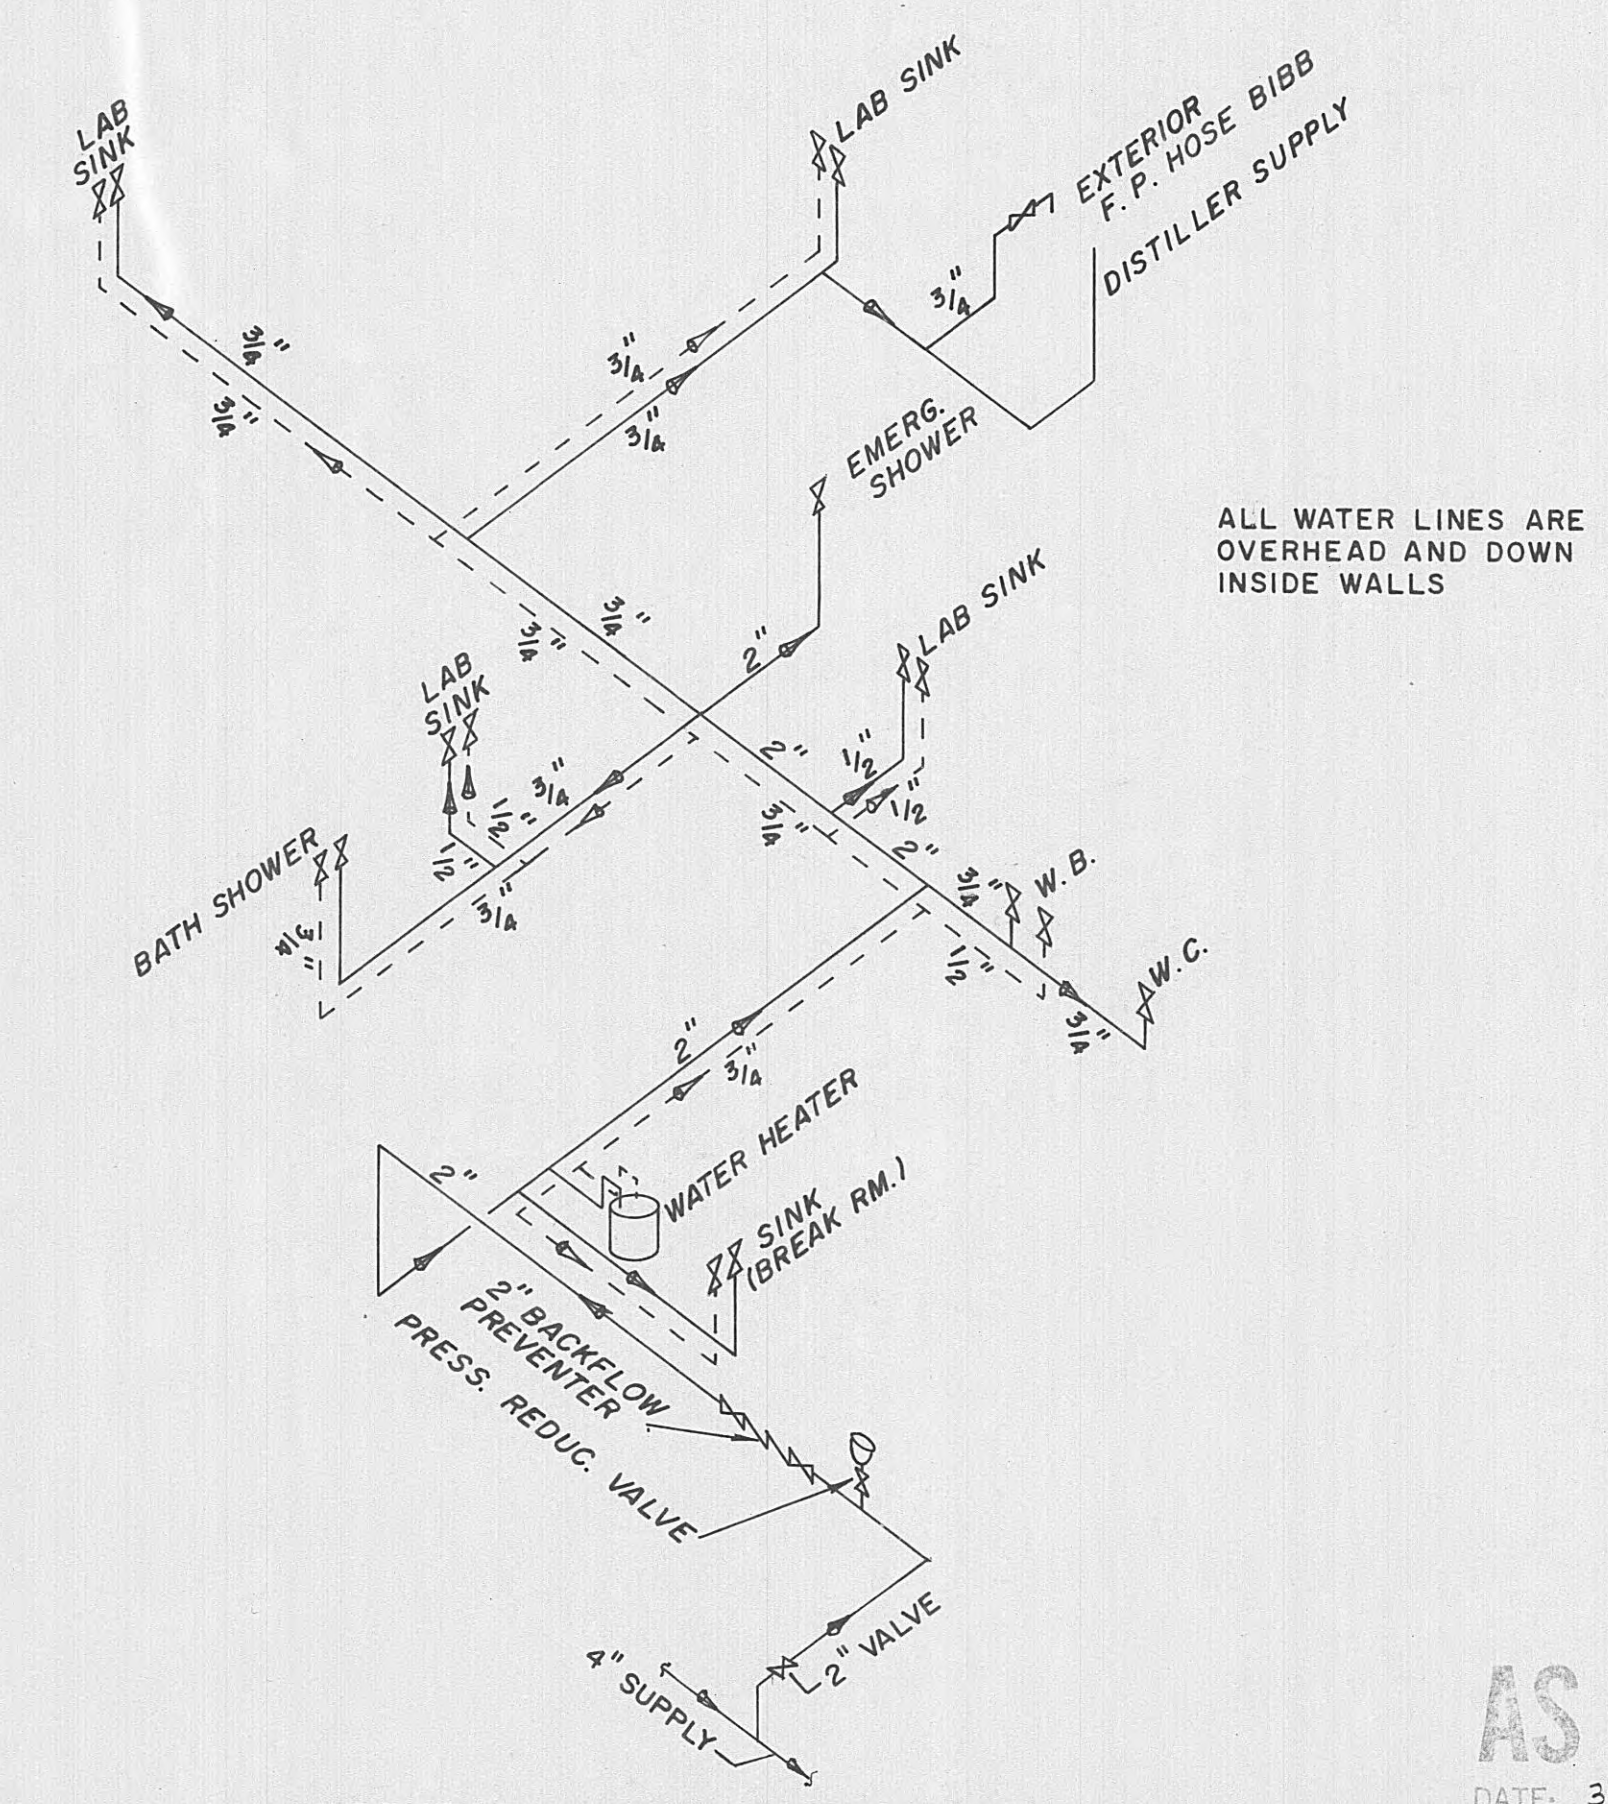

LABORATORY WATER SCHEMATIC

AS BUILT  
DATE: 3-20-95  
APPROVED: *D.M.*

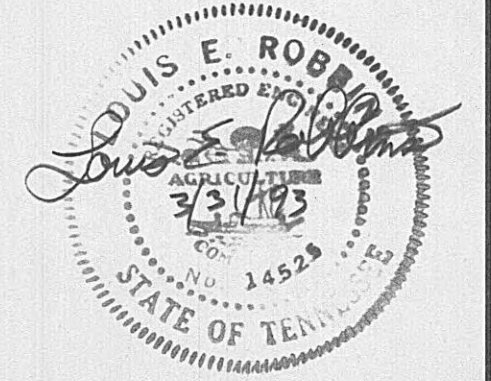

ELROD · DUNSON, INC.  
CONSULTING ENGINEERS  
NASHVILLE · KNOXVILLE  
LEXINGTON, KY


CONTRACT W93-04  
HARRIMAN, TENNESSEE  
SURFACE WASH / CHEMICAL FEED WATER, LABORATORY WATER  
AND PLUMBING SCHEMATICS

REVISIONS  
4/19/93  
ADD DRAIN FOR  
FILTER WASTE  
CHANNEL


DESIGNED: L. E. R.  
DRAWN: D. G. R., D. M.  
CHECKED: L. E. R.  
DATE: MARCH, 1993  
SCALE: NONE  
PROJ. NO. 0592

SHEET 16  
OF 36





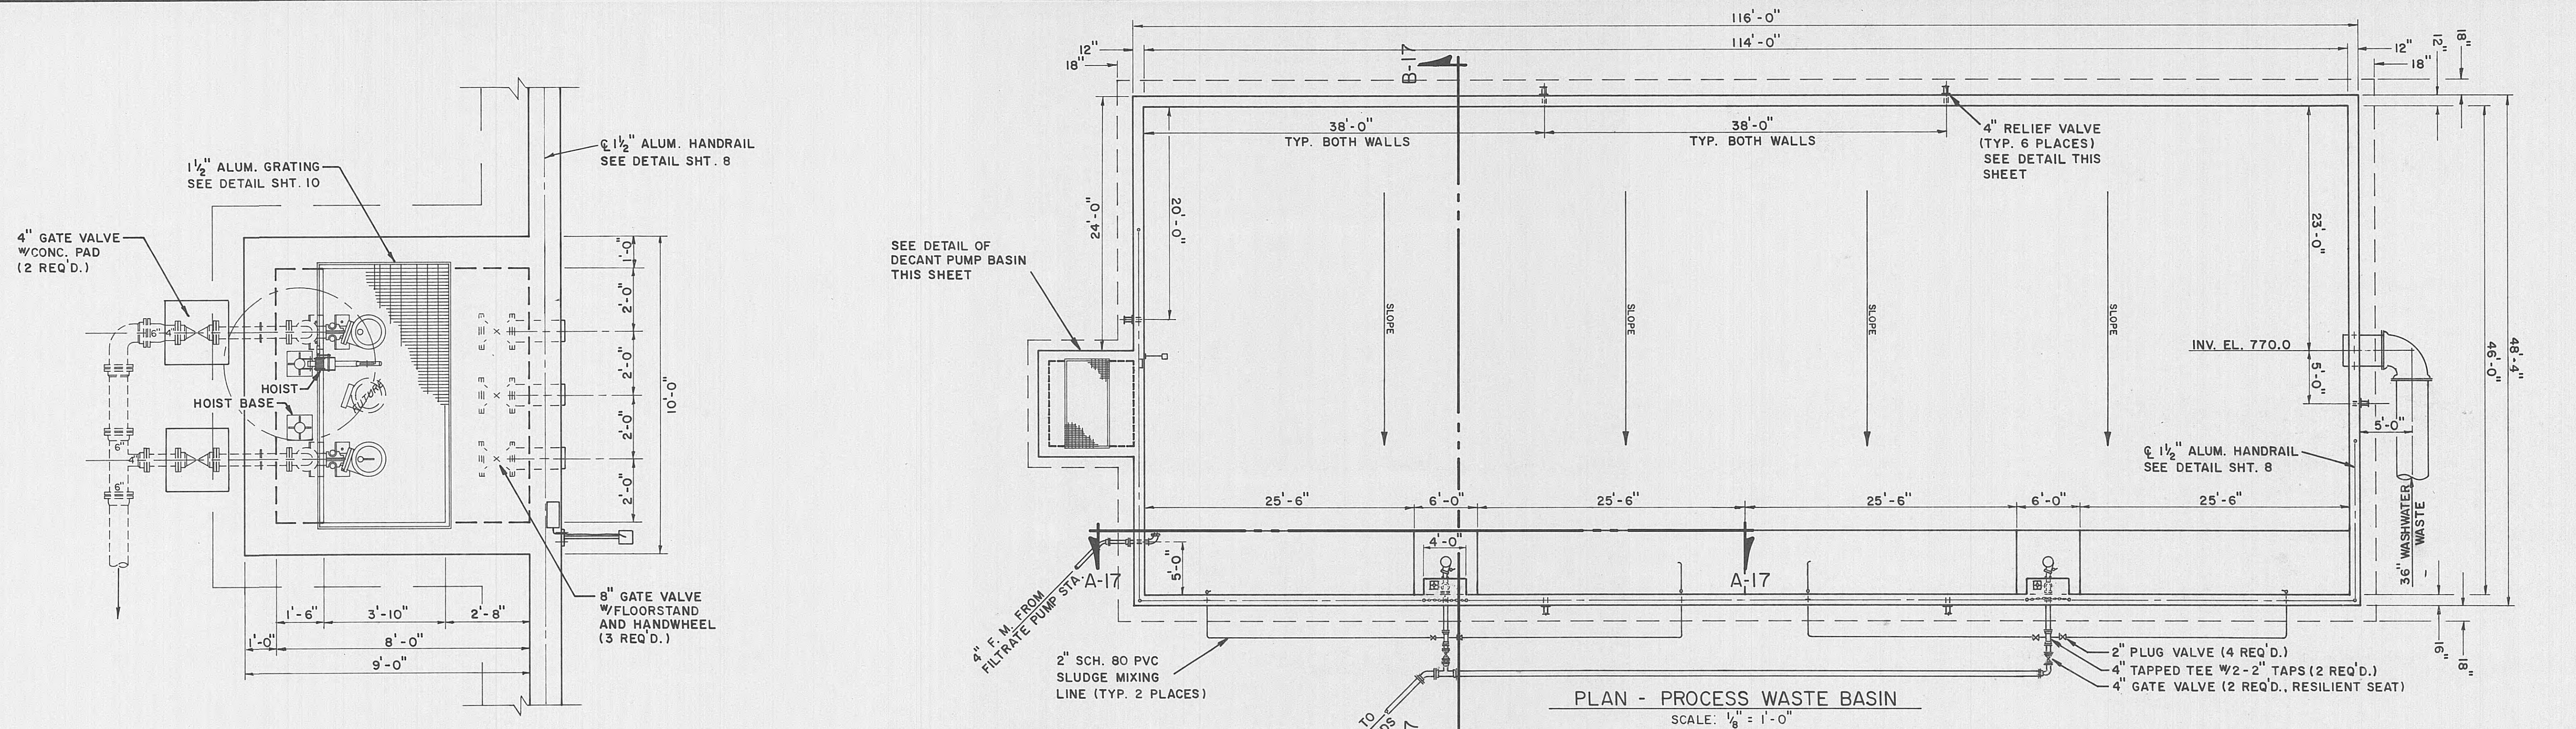


PLAN - DECANT PUMP BASIN DETAIL  
SCALE: 3/8" = 1'-0"

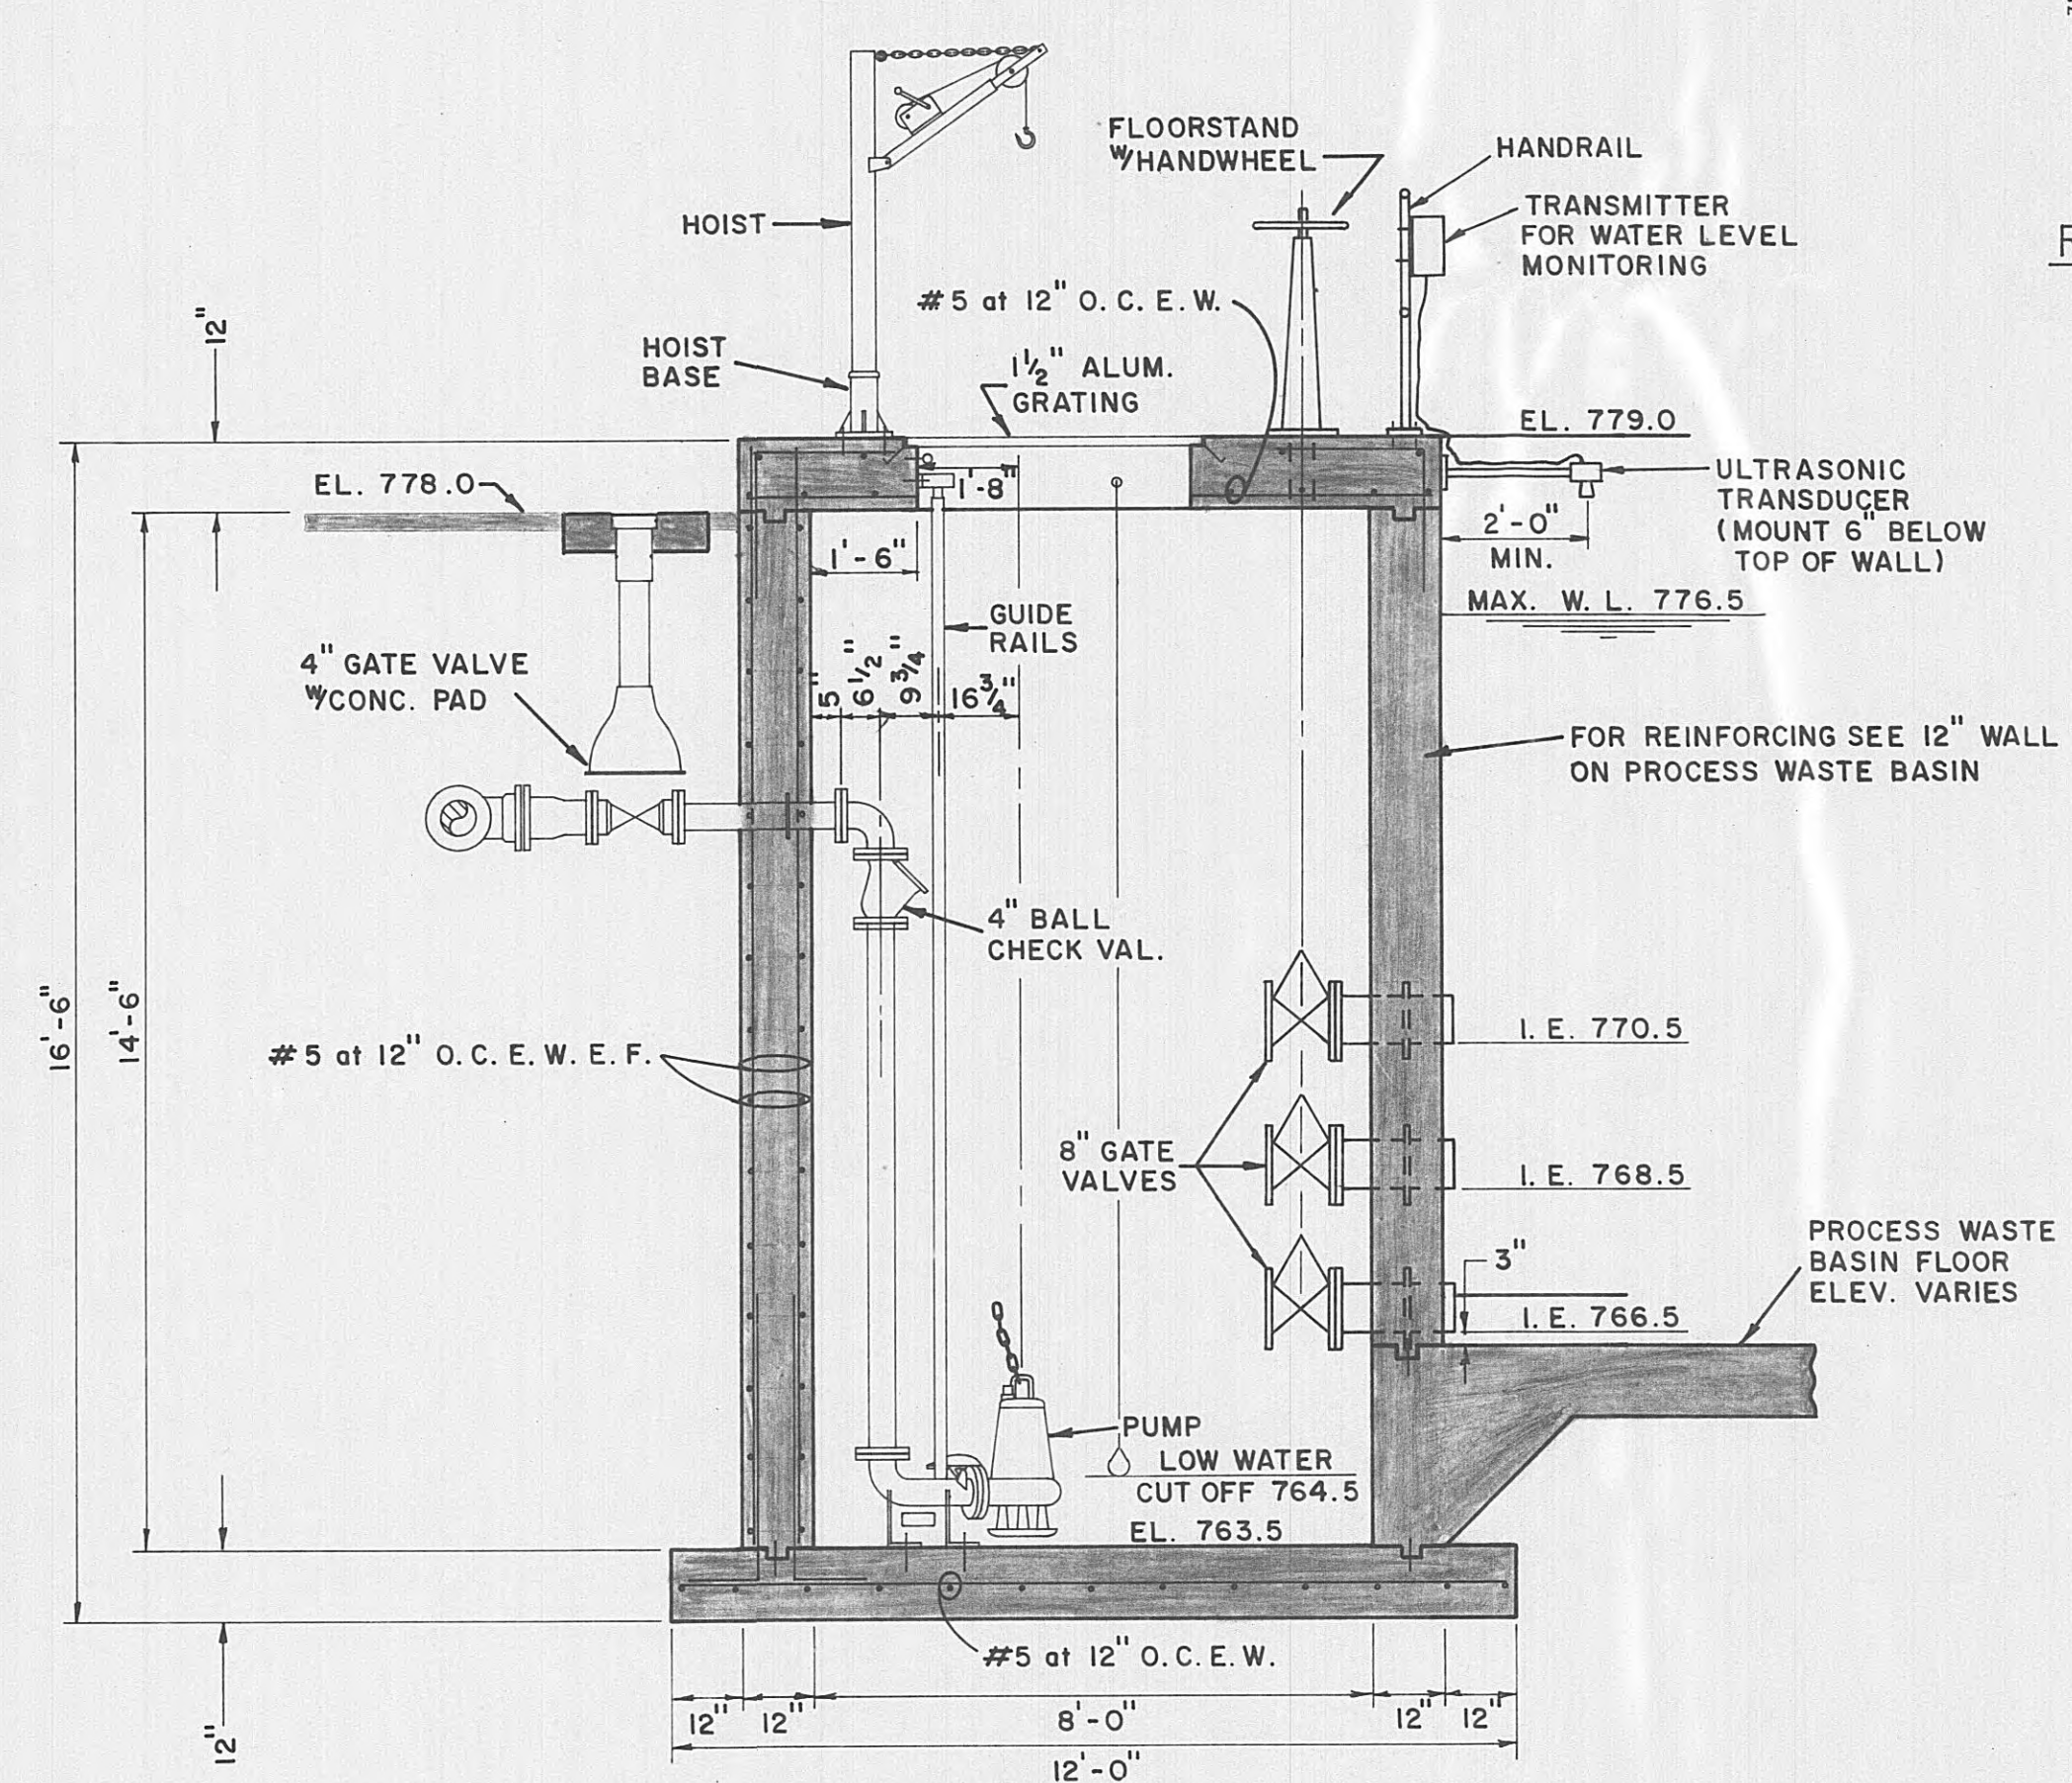



SECTION - DECANT PUMP BASIN DETAIL  
SCALE: 3/8" = 1'-0"

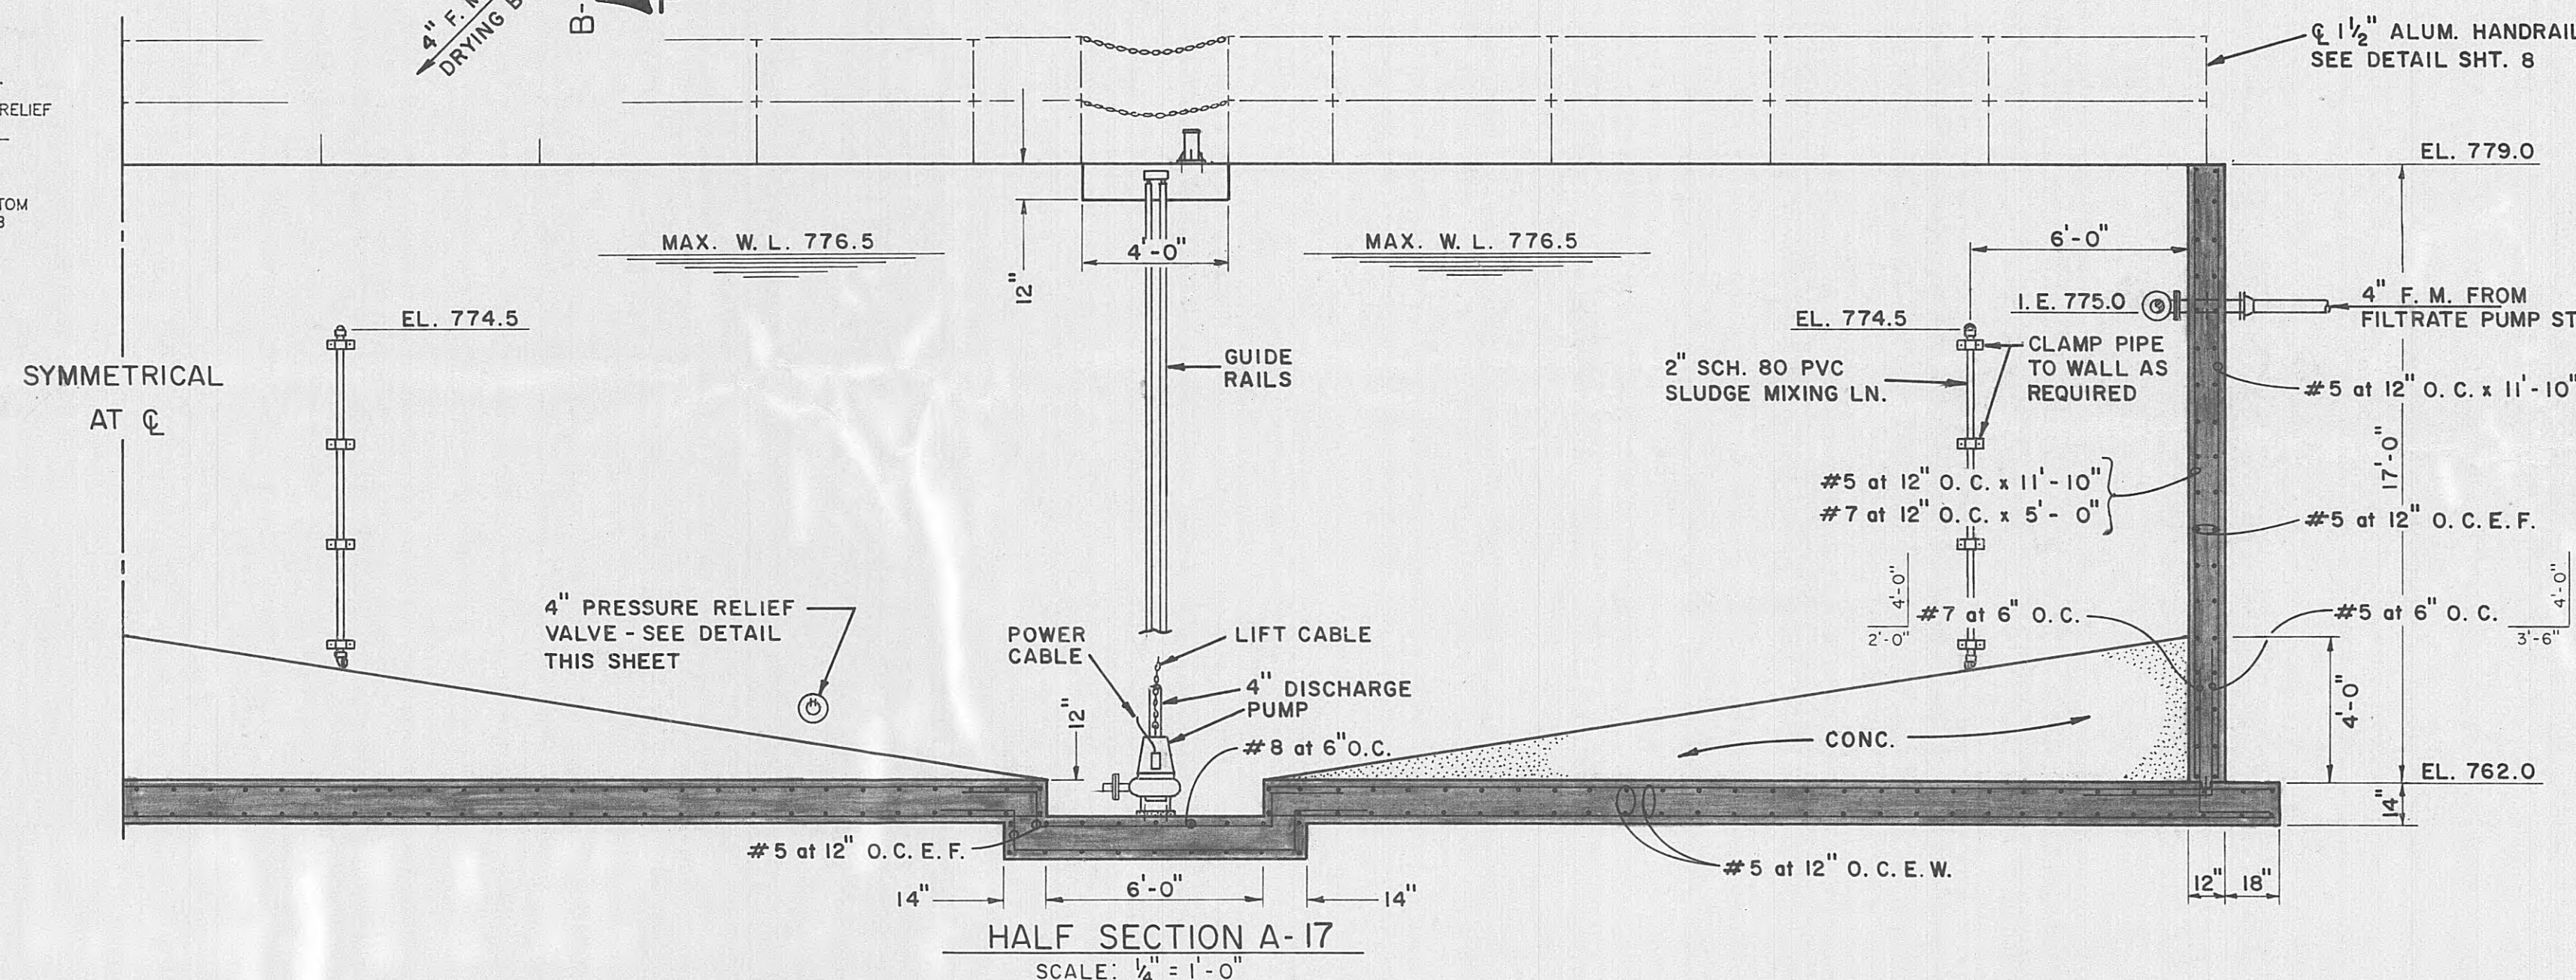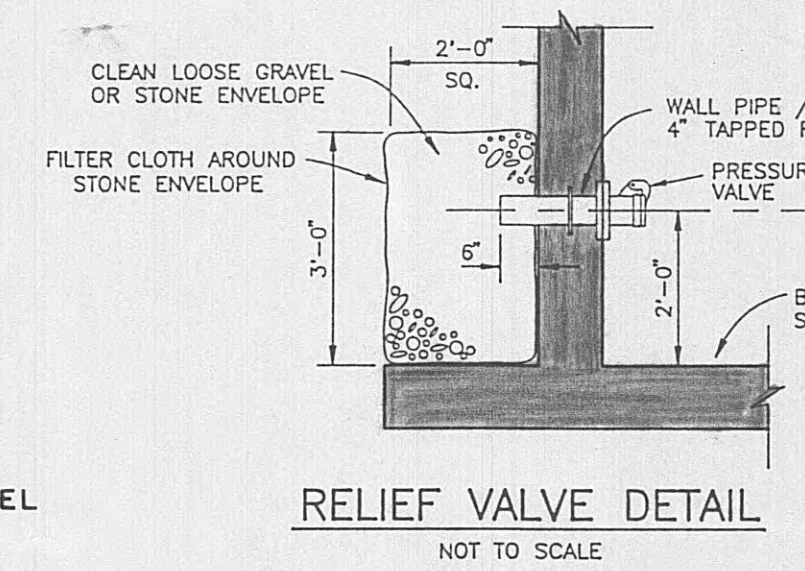


HALF SECTION A-17  
SCALE: 1/4" = 1'-0"

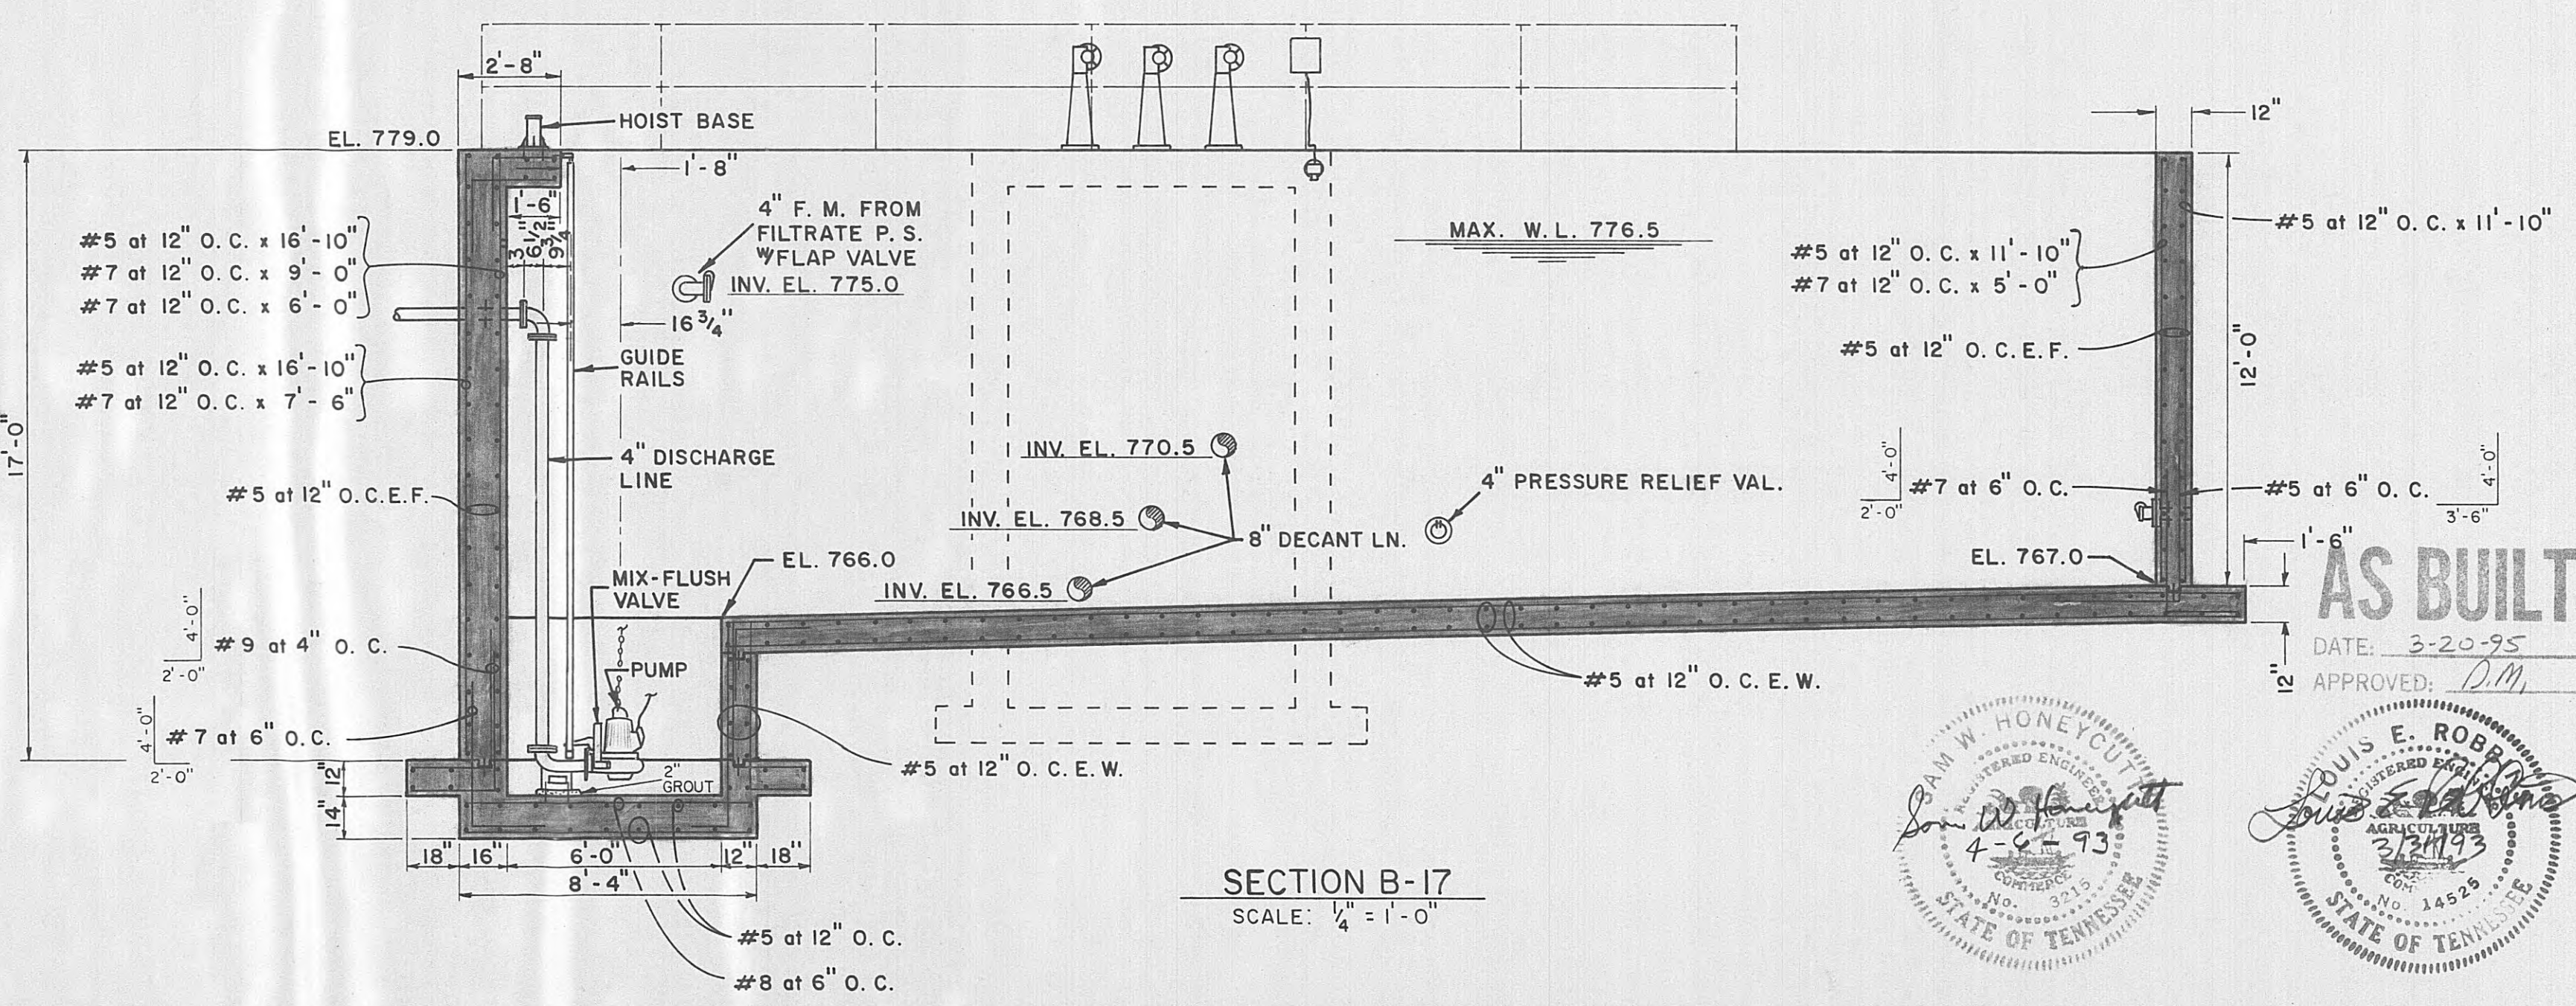


SECTION B-17  
SCALE: 1/4" = 1'-0"

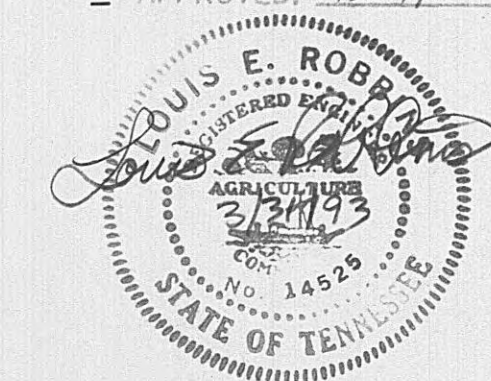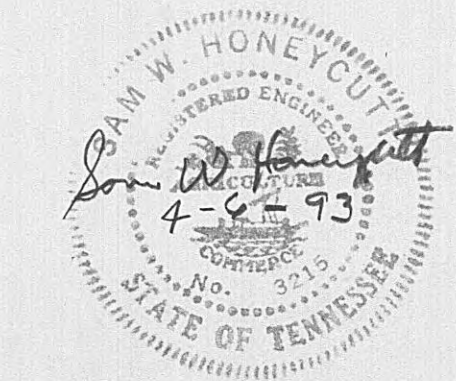




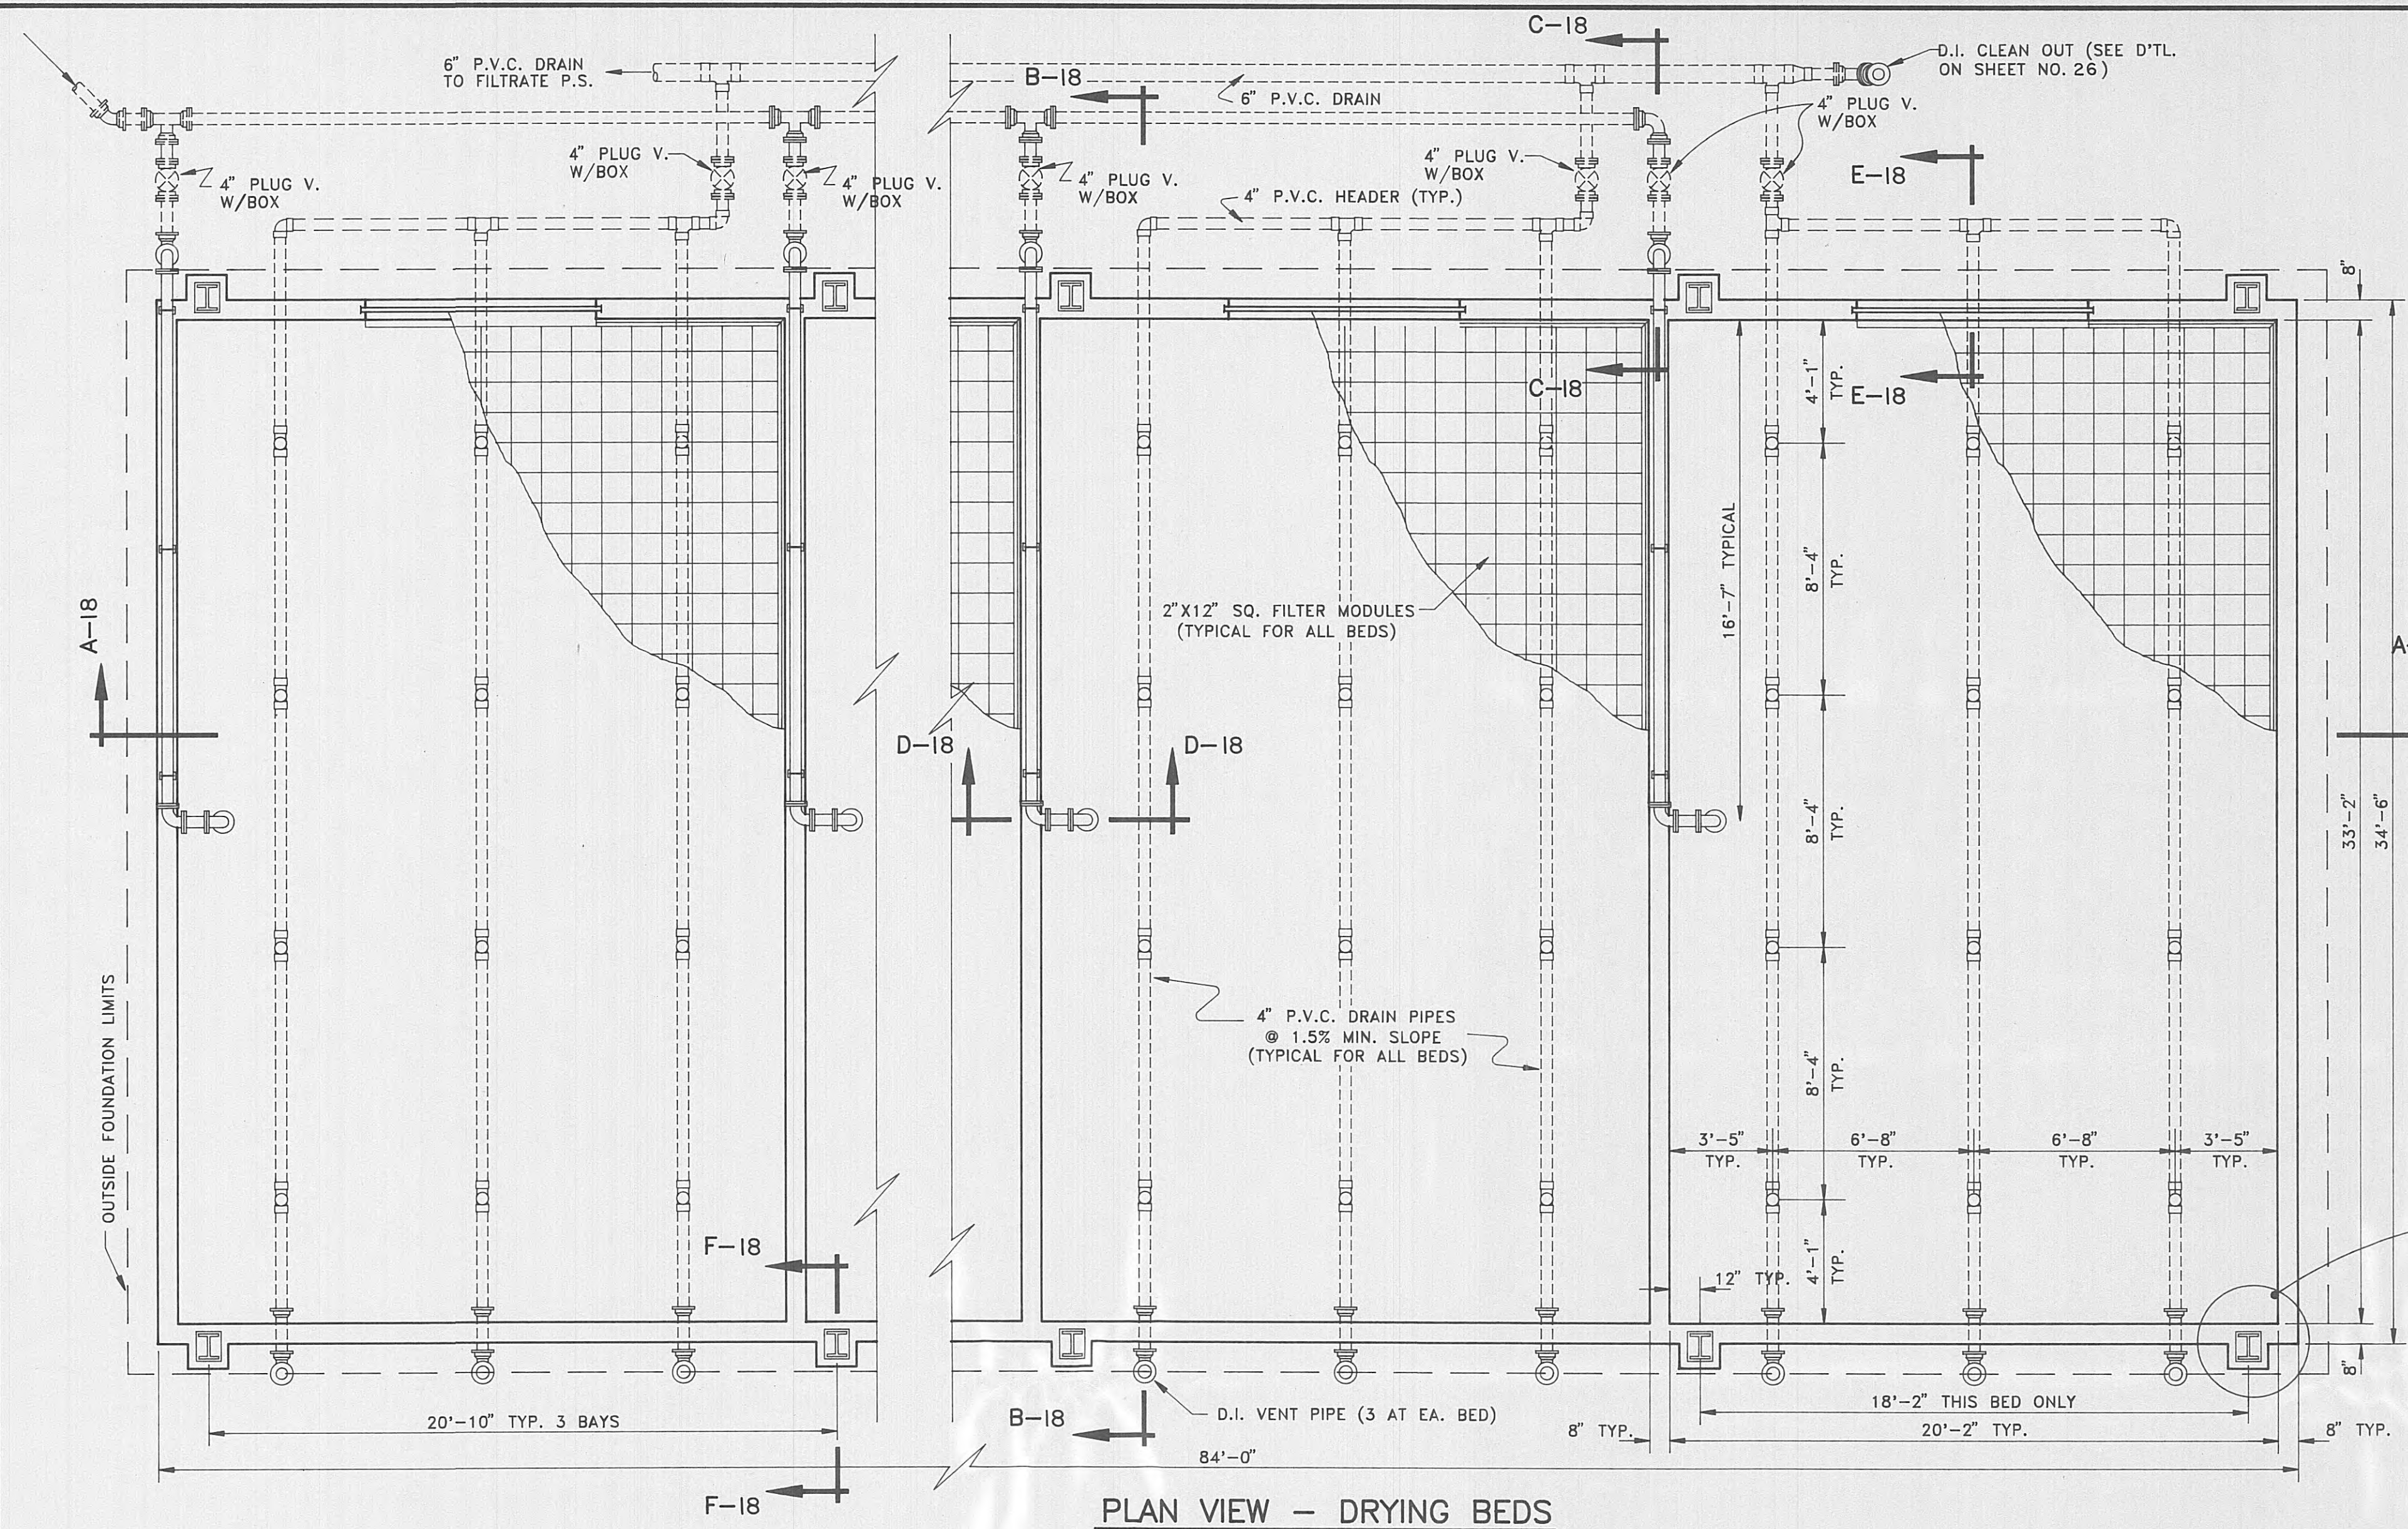


PLAN VIEW - DRYING BEDS  
SCALE: 1/4"=1'-0"

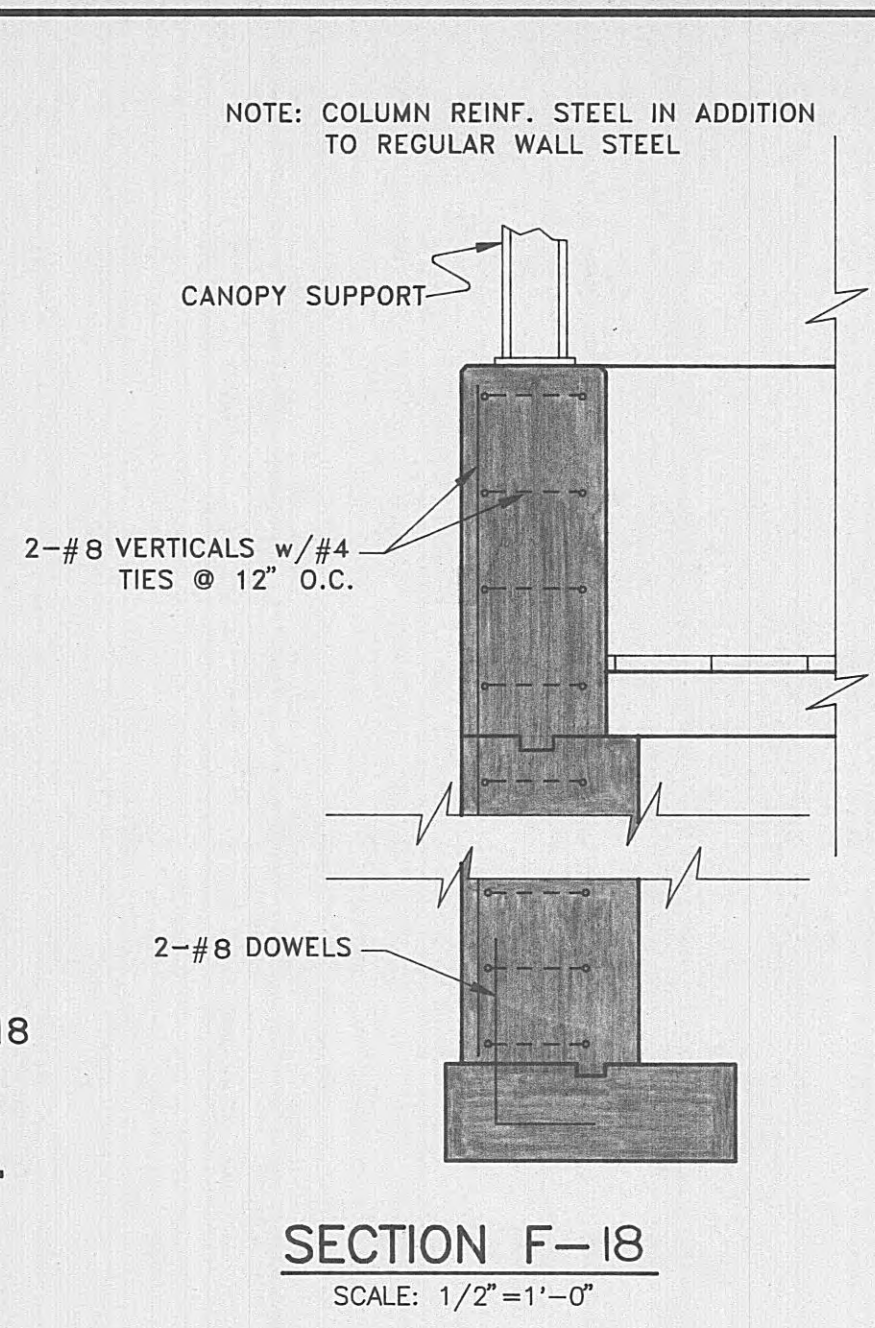


SECTION F-18  
SCALE: 1/2"=1'-0"

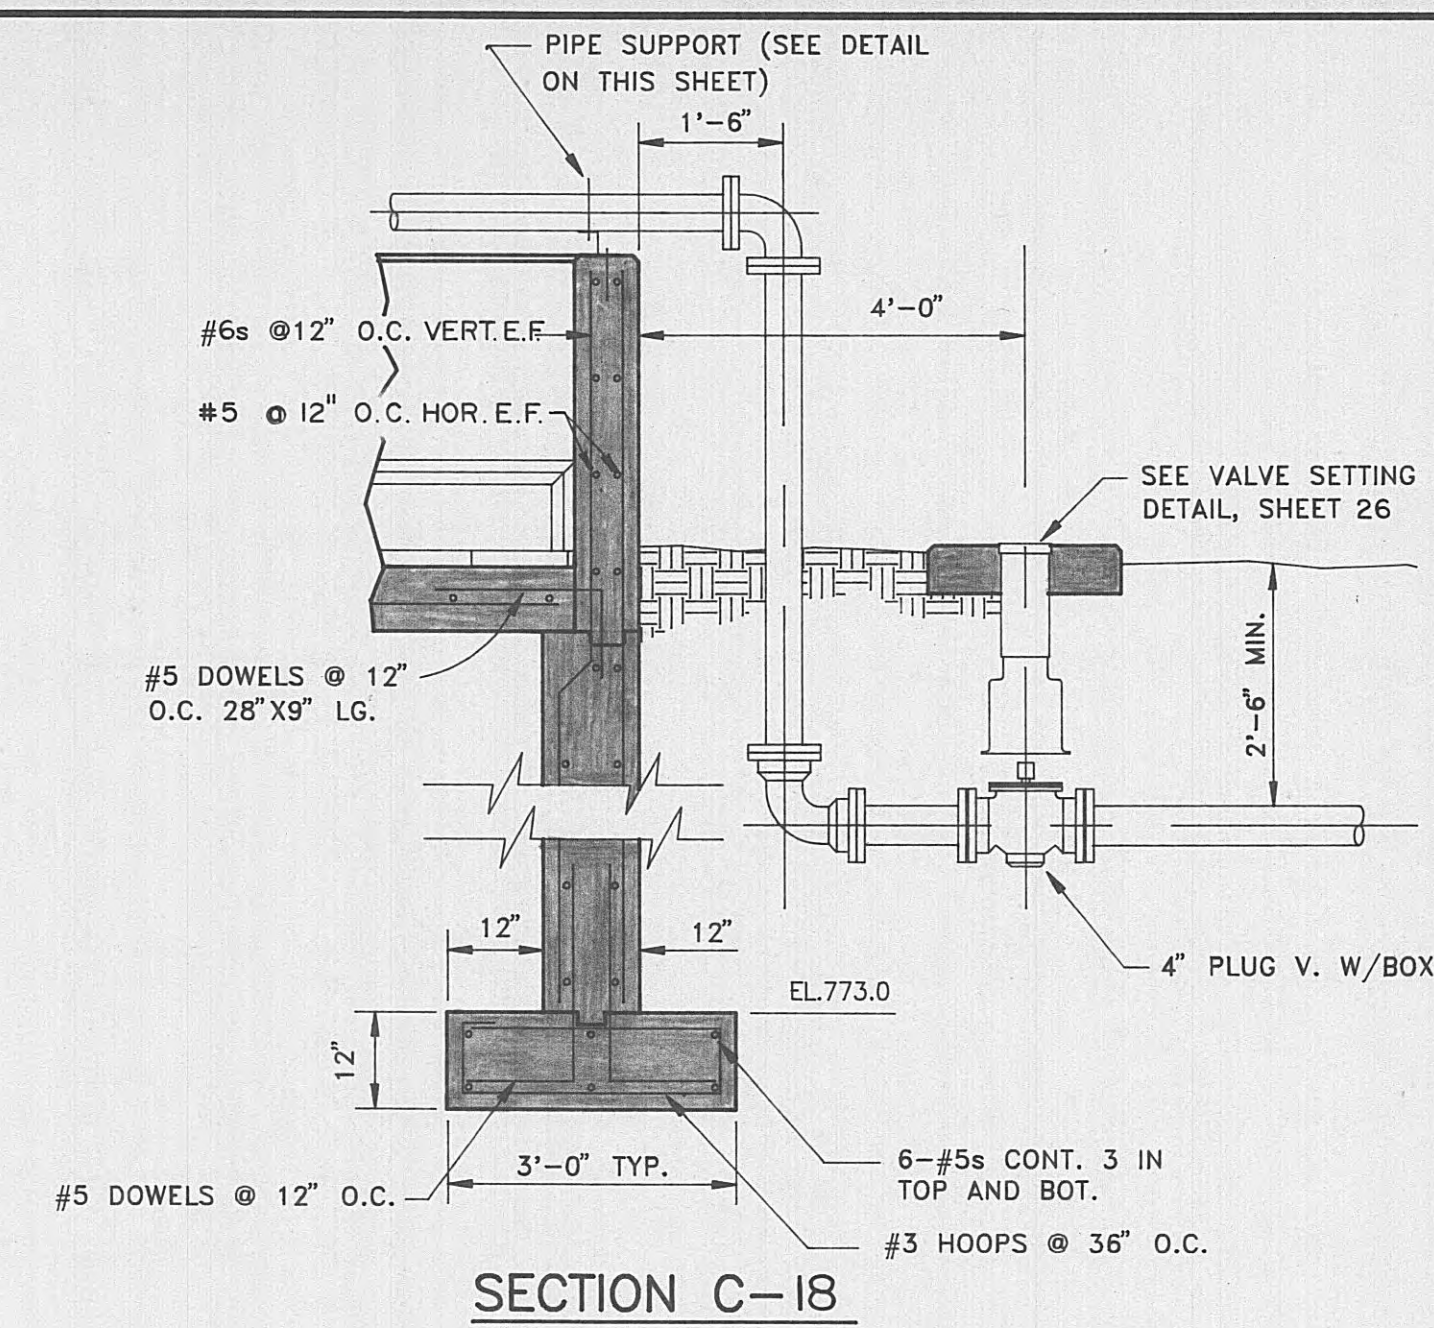


SECTION C-18  
SCALE: 1/2"=1'-0"

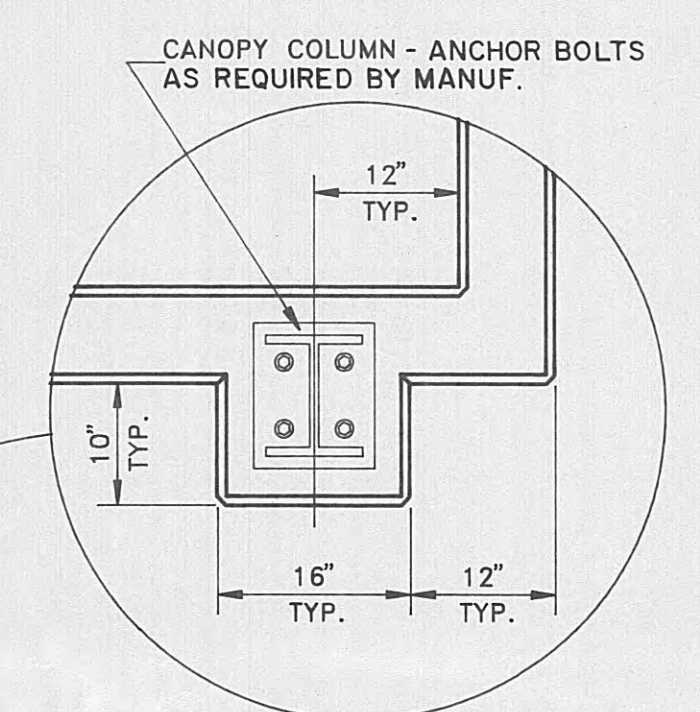


NOTES:  
CONCRETE FLOOR OF DRYING BEDS SHALL BE STEEL TROWEL FINISHED (1/4" IN 10" MAXIMUM SURFACE VARIATION).  
CHAMFER ALL EXPOSED EDGES 3/4"x45°

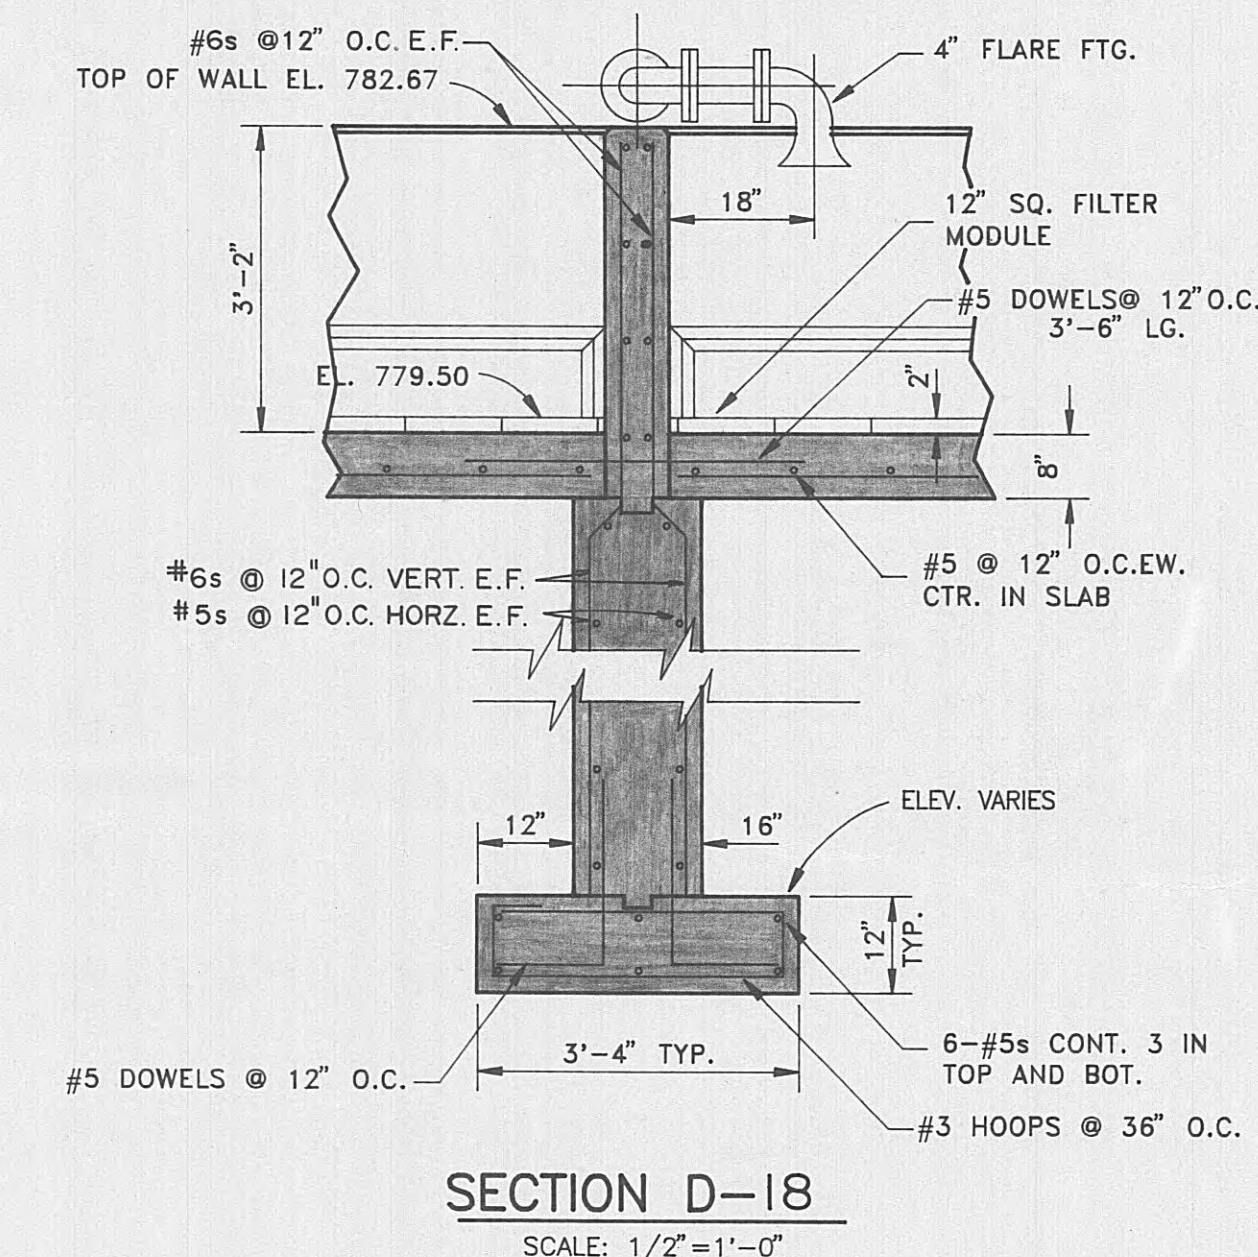


SECTION D-18  
SCALE: 1/2"=1'-0"

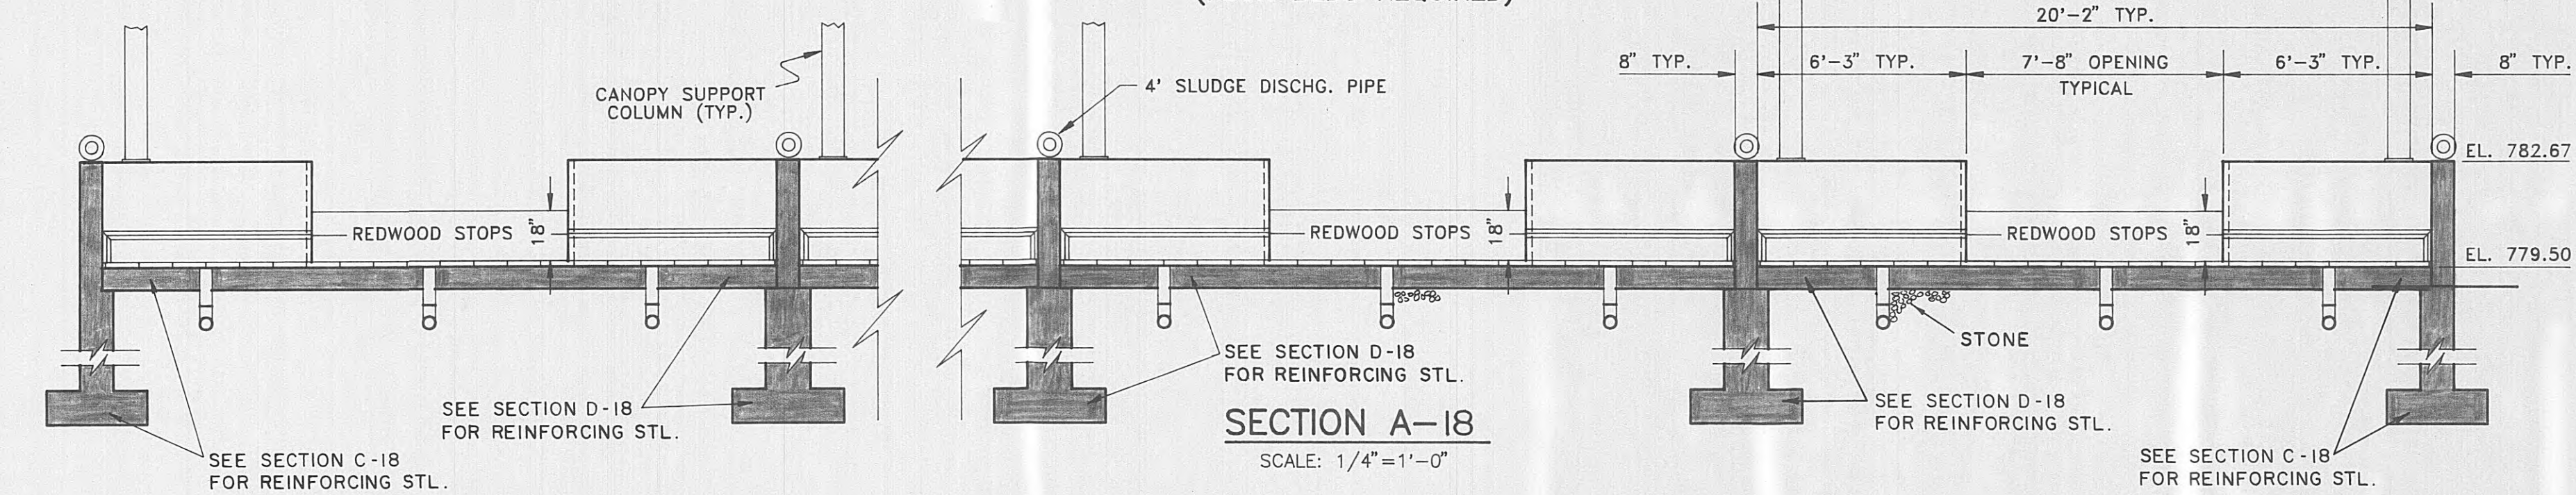


SECTION A-18  
SCALE: 1/4"=1'-0"

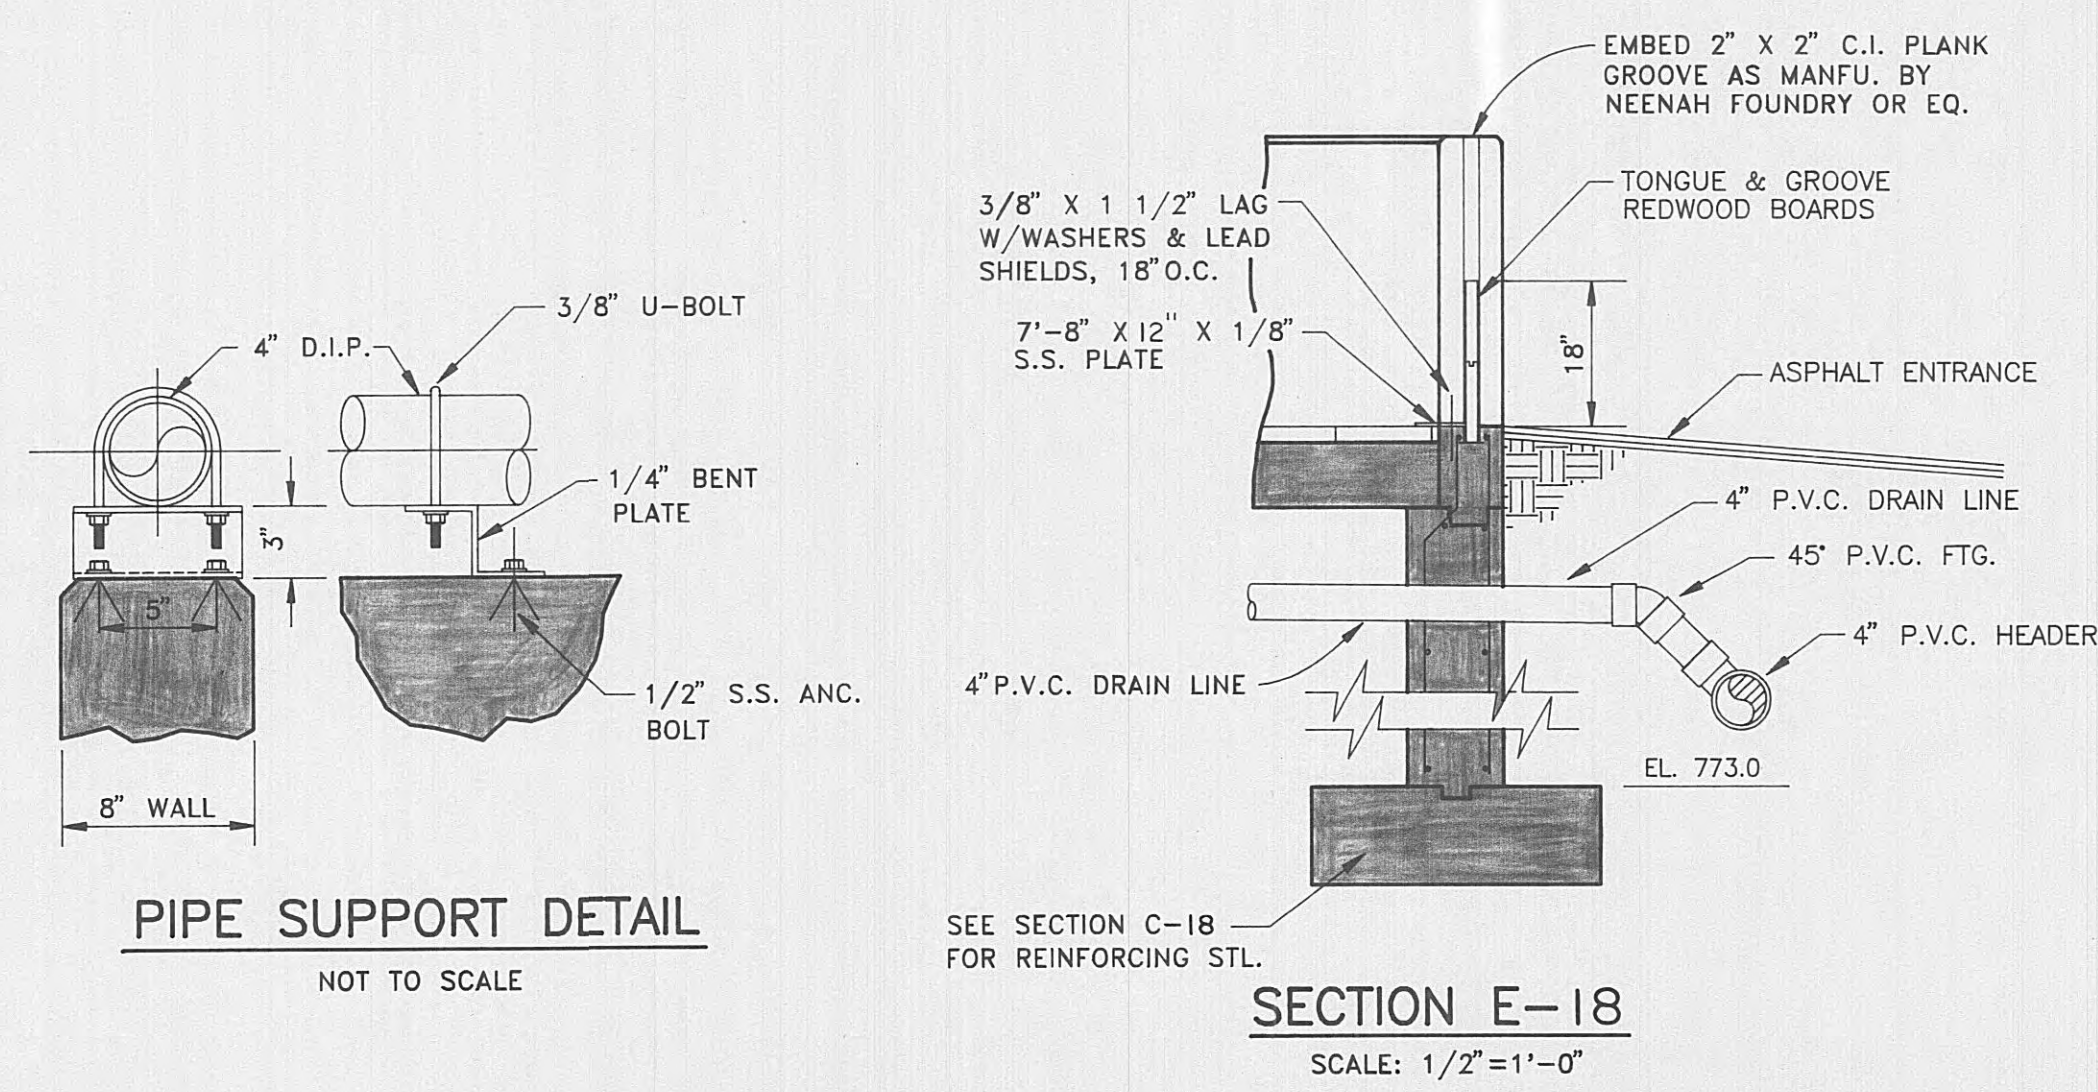

SECTION E-18  
SCALE: 1/2"=1'-0"

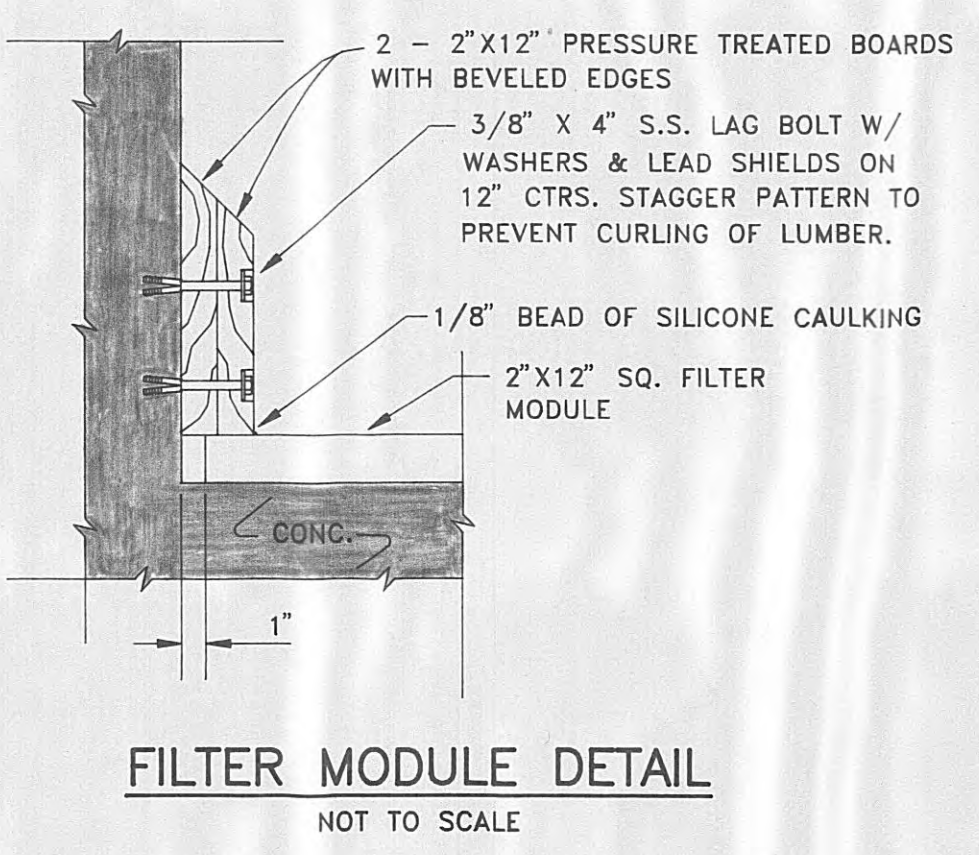

FILTER MODULE DETAIL  
NOT TO SCALE

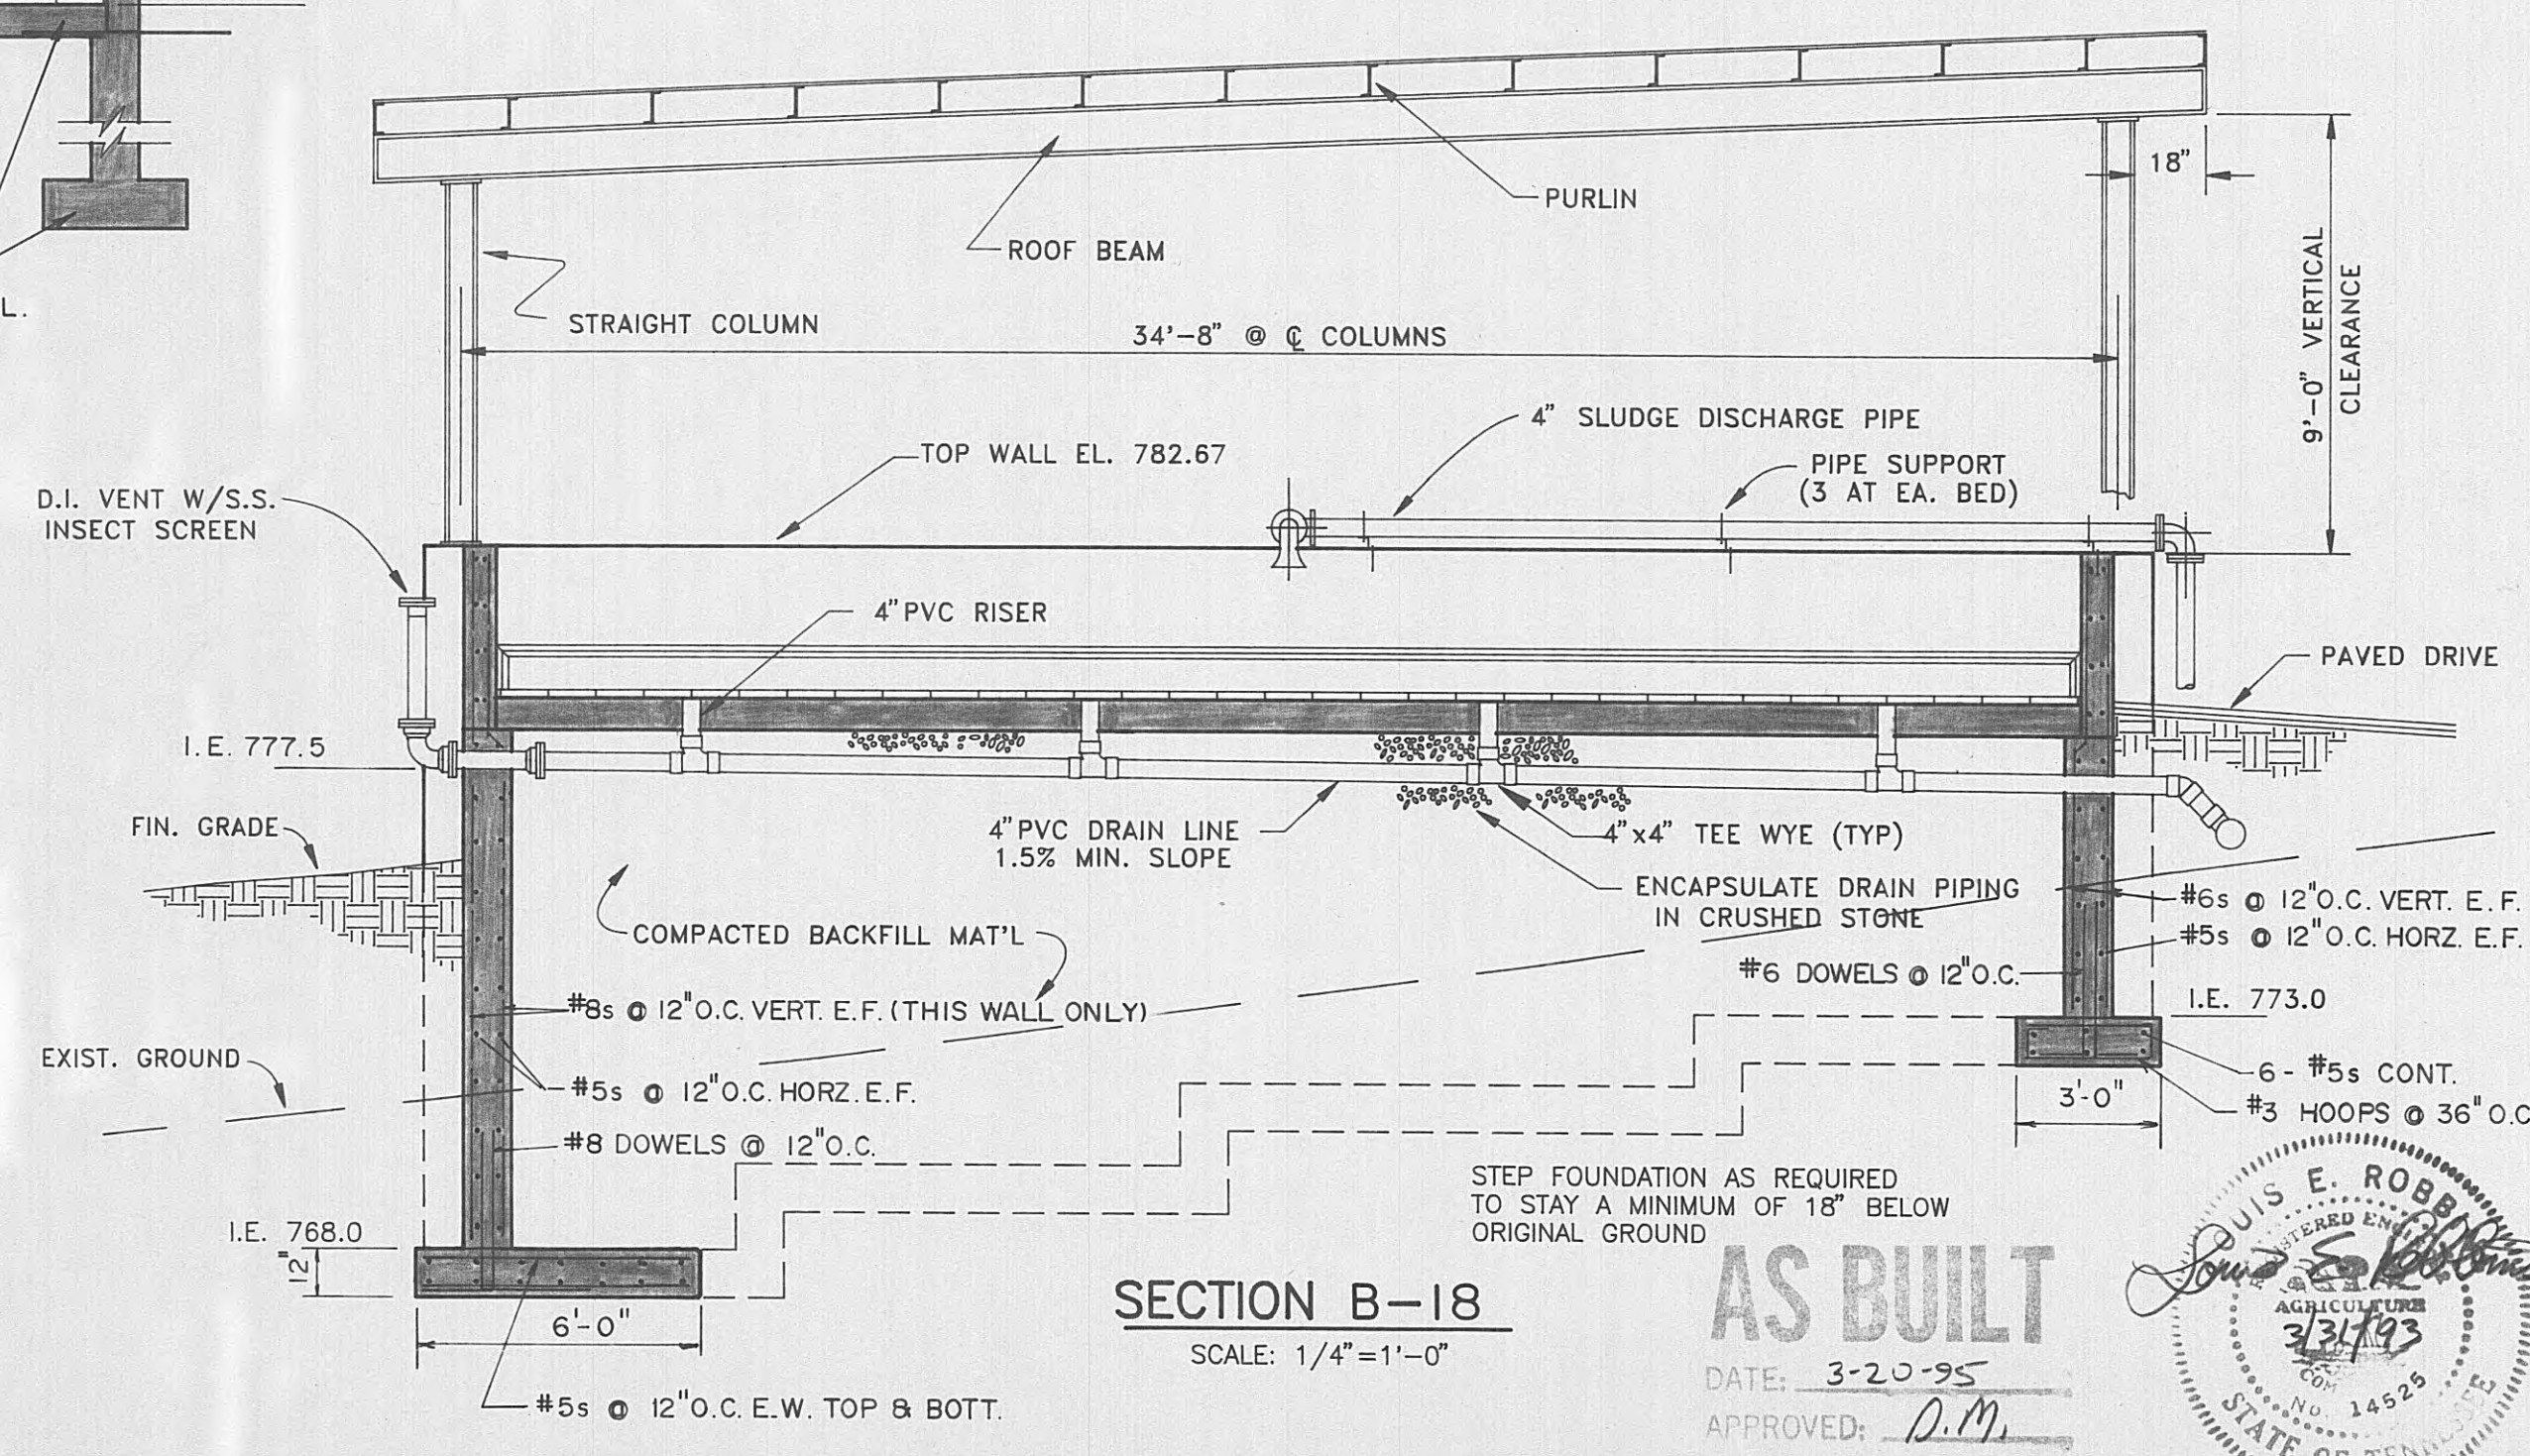


SECTION B-18  
SCALE: 1/4"=1'-0"


STEP FOUNDATION AS REQUIRED TO STAY A MINIMUM OF 18" BELOW ORIGINAL GROUND  
AS BUILT  
DATE: 3-20-95  
APPROVED: D.M.

DESIGNED: L. E. R.  
DRAWN: S. C. G.  
CHECKED: L. E. R.  
DATE: MARCH, 1993  
SCALE: AS NOTED  
PROJ. NO. 0592



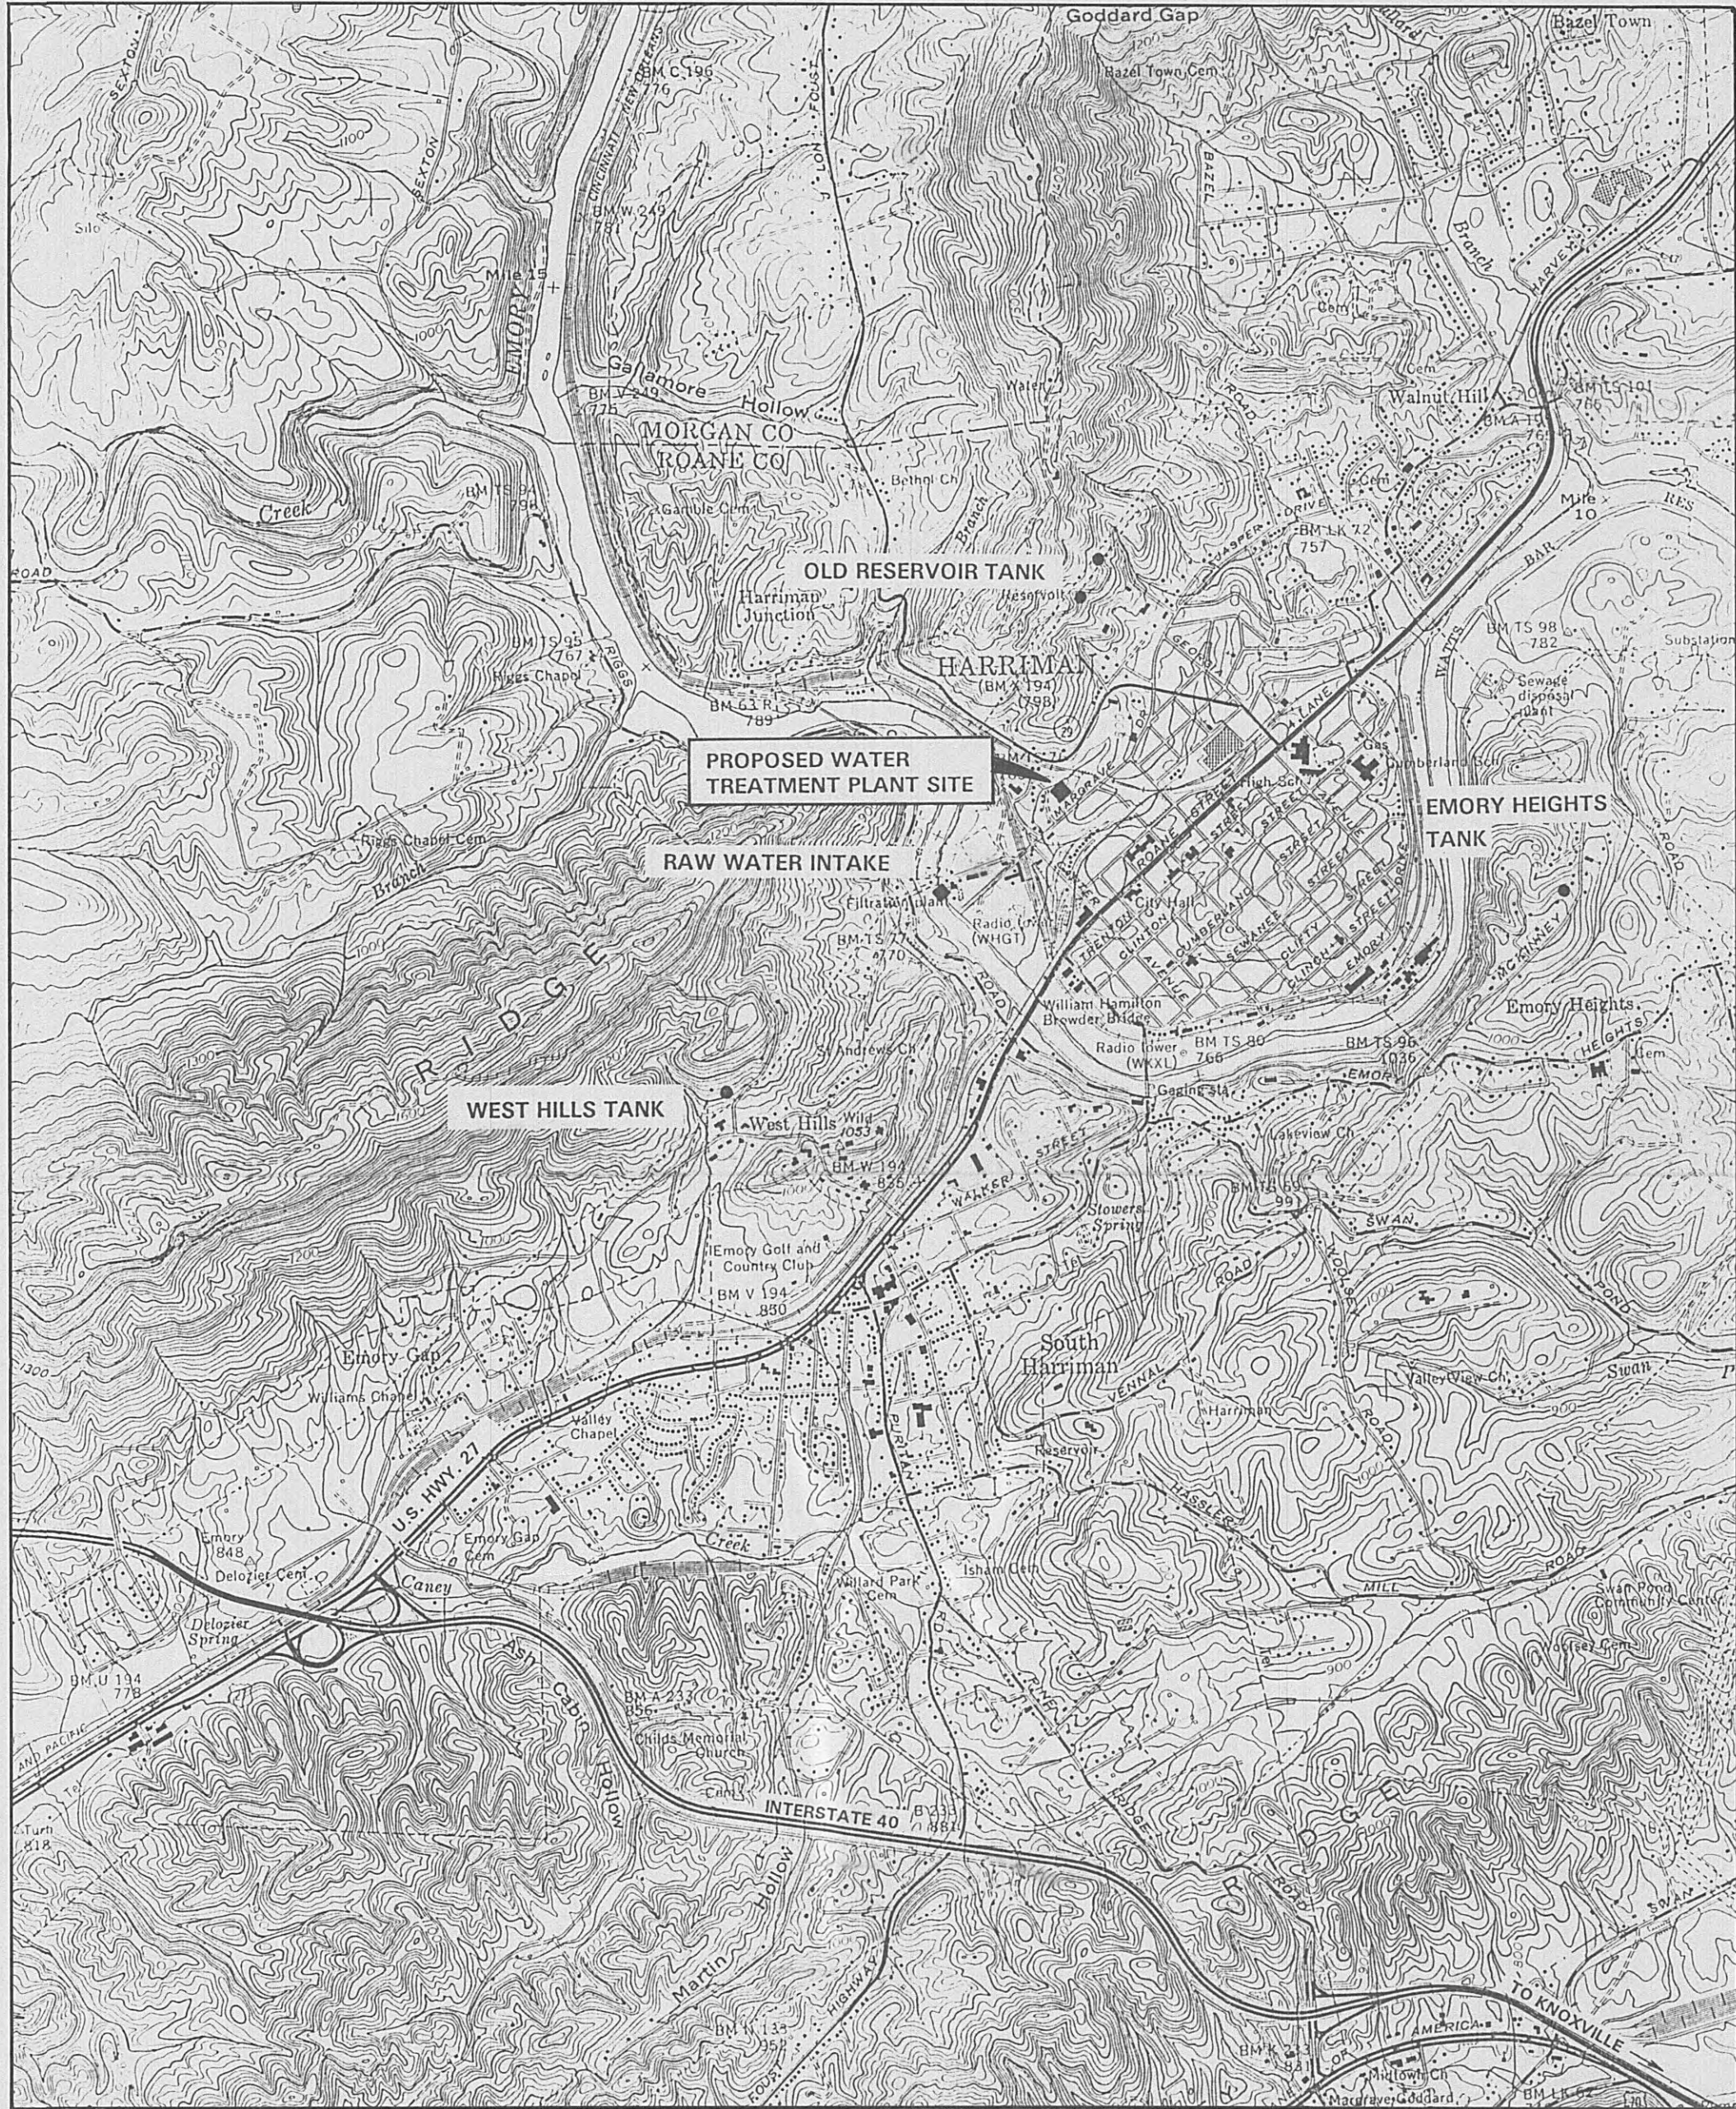

LOCATION PLAN  
SCALE 1" = 2000'

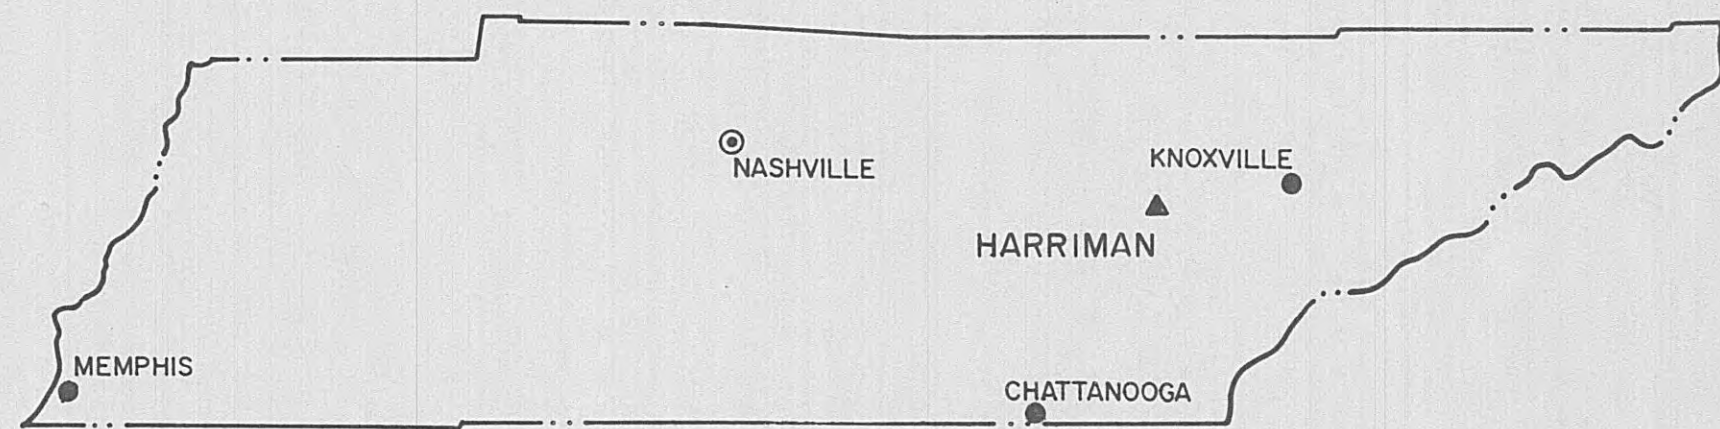


VICINITY MAP

INDEX OF SHEETS

SHT.NO.	DESCRIPTION
	COVER SHEET
1.	VICINITY, LOCATION PLAN, INDEX OF SHEETS
2.	SITE GRADING PLAN
3.	YARD PIPING PLAN
4.	FILTER/OPERATIONS BUILDING - PLAN VIEW
5.	OPERATIONS BUILDING - FLOOR PLAN AND INTERIOR DETAILS
6.	FILTER BUILDING SECTIONS, LABORATORY CONTROL PANEL
7.	FILTER BUILDING SECTIONS
8.	FILTER BUILDING SECTIONS AND DETAILS
9.	TOP PLAN-FILTER BUILDING, ROOF PLAN - FILTER/OPERATIONS BUILDING, TYPICAL WALL SECTIONS AND MAIN ENTRANCE SECTION
10.	FILTER/OPERATIONS BUILDING EXTERIOR ELEVATIONS AND MISCELLANEOUS DETAILS
11.	DOOR & WINDOW SCHEDULES AND DETAILS
12.	STRUCTURAL - FLOOR SLAB ELEVATION 767.0 FILTER/OPERATIONS BUILDING
13.	STRUCTURAL - FLOOR SLAB ELEVATION 782.0 - FILTER/OPERATIONS BUILDING
14.	FLOW DIAGRAM - FILTER PLANT
15.	CHLORINATION AND CHEMICAL FEED SCHEMATICS
16.	SURFACE WASH/CHEMICAL FEED WATER, LABORATORY WATER AND PLUMBING SCHEMATICS
17.	PROCESS WASTE BASIN - PLAN, SECTIONS, AND DETAILS
18.	SLUDGE DRYING BEDS - PLAN, SECTIONS, AND DETAILS
19.	FILTRATE PUMP STATION, FINISHED WATER FLOW METER, AND RETAINING WALL PLAN AND SECTIONS
20.	STORAGE BUILDING/POLYMER ROOM, PLAN AND SECTIONS
21.	MODIFICATIONS TO RAW WATER INTAKE STRUCTURE
22.	RAW WATER PUMP BUILDING - PLAN & DETAILS
23.	RAW WATER PUMP BUILDING SECTIONS
24.	RAW WATER LINE, FINISHED WATER LINE - PLAN AND PROFILE
25.	RAW WATER LINE, FINISHED WATER LINE - PLAN AND PROFILE
26.	MISCELLANEOUS CONSTRUCTION DETAILS
27.	ELECTRICAL SITE PLAN
28.	FILTER BUILDING LIGHTING PLAN
29.	FILTER BUILDING POWER FLOOR PLAN
30.	FILTER BUILDING PROCESS POWER PLAN
31.	FILTER BUILDING ONE LINE DIAGRAM
32.	POLYMER BUILDING ELECTRICAL PLAN
33.	WATER INTAKE BUILDING ELECTRICAL PLAN
34.	WATER INTAKE-FILTER BUILDING CONNECTOR
35.	FILTER BUILDING MECHANICAL PLAN
36.	POLYMER/INTAKE BUILDING MECHANICAL-SCHEDULES


AS BUILT  
DATE: 3-20-95  
APPROVED: D.M.

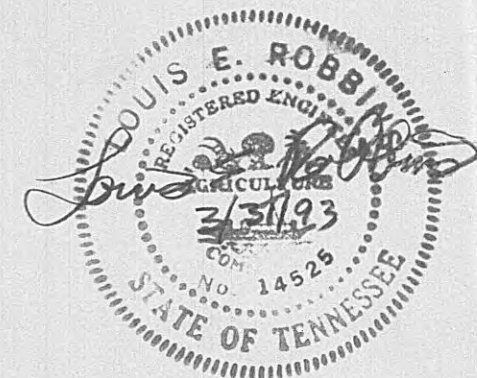




NOTE:

PICKET RAIL TO EXTEND 135'± FROM NEW CHAIN LINK FENCE

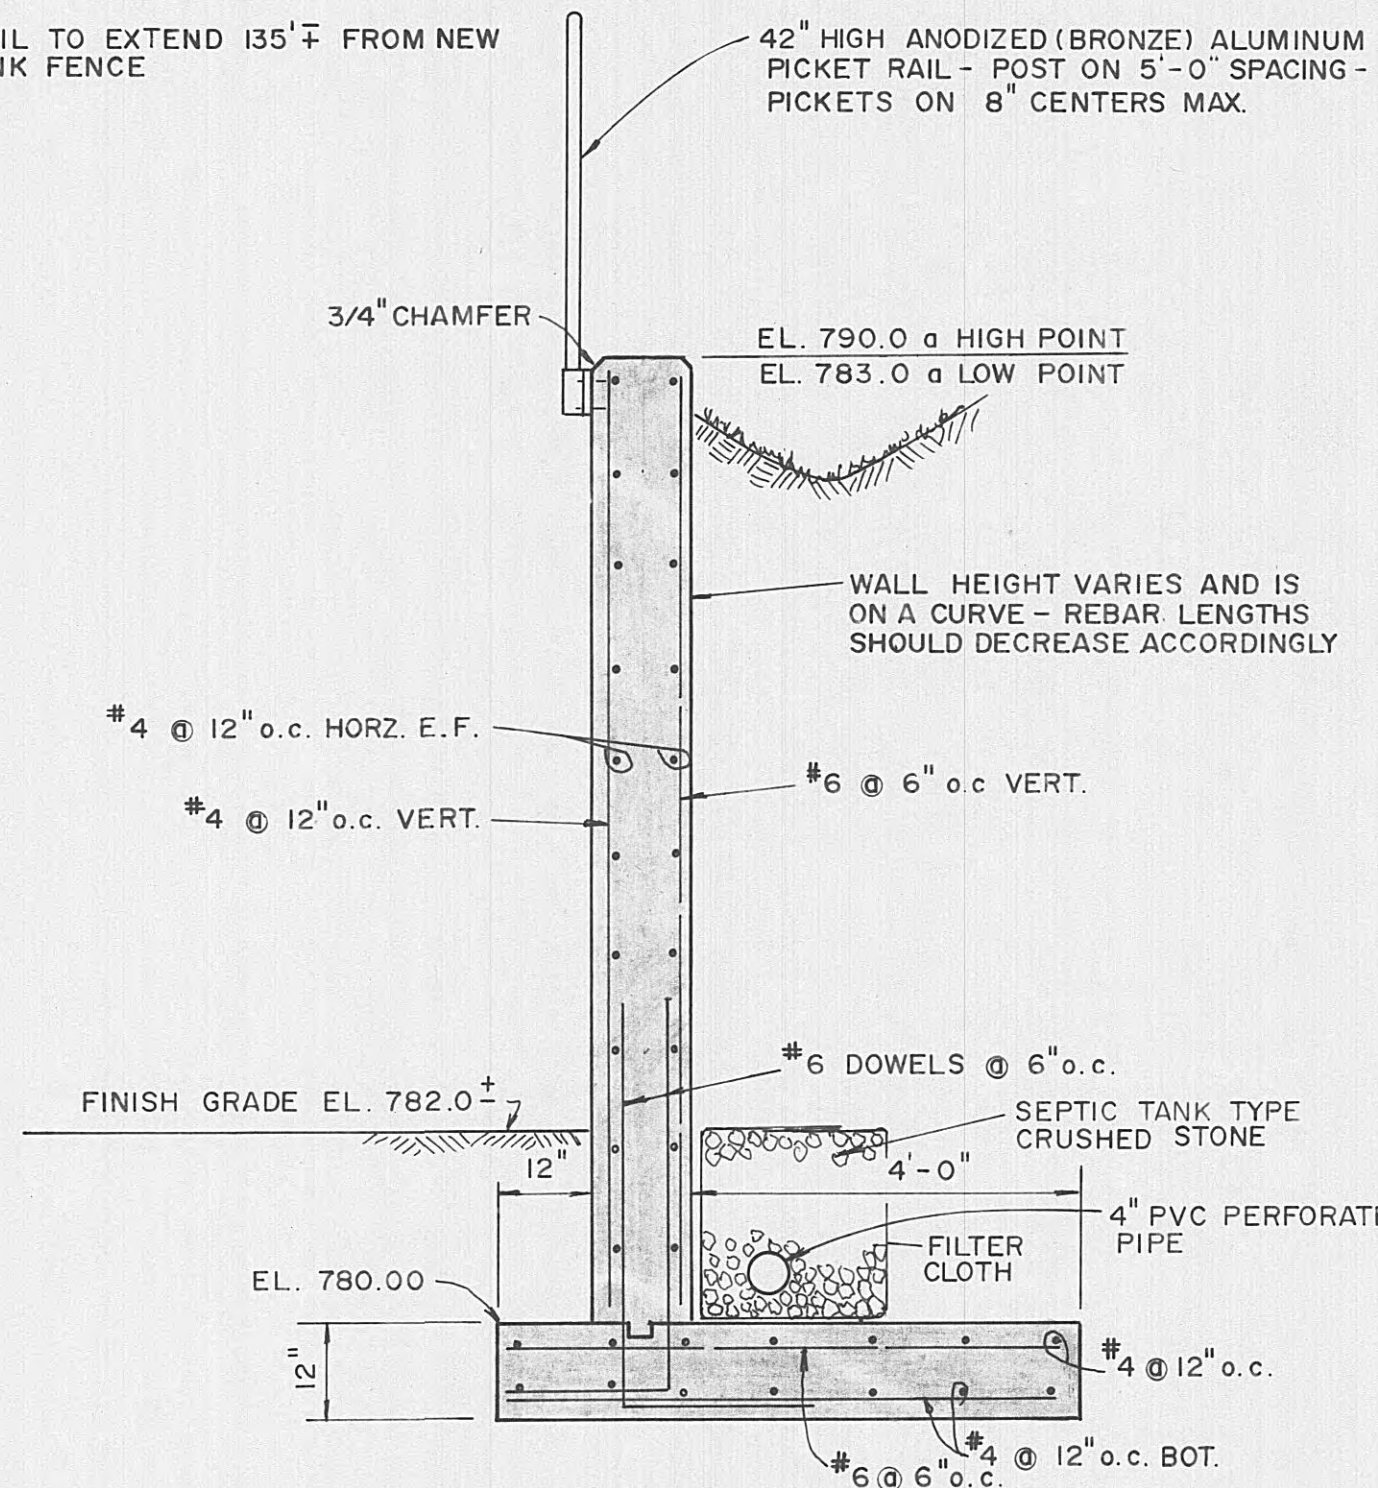


TYPICAL SECTION - RETAINING WALL

SCALE: 1/2" = 1'-0"  
SEE GRADING PLAN FOR WALL LOCATION

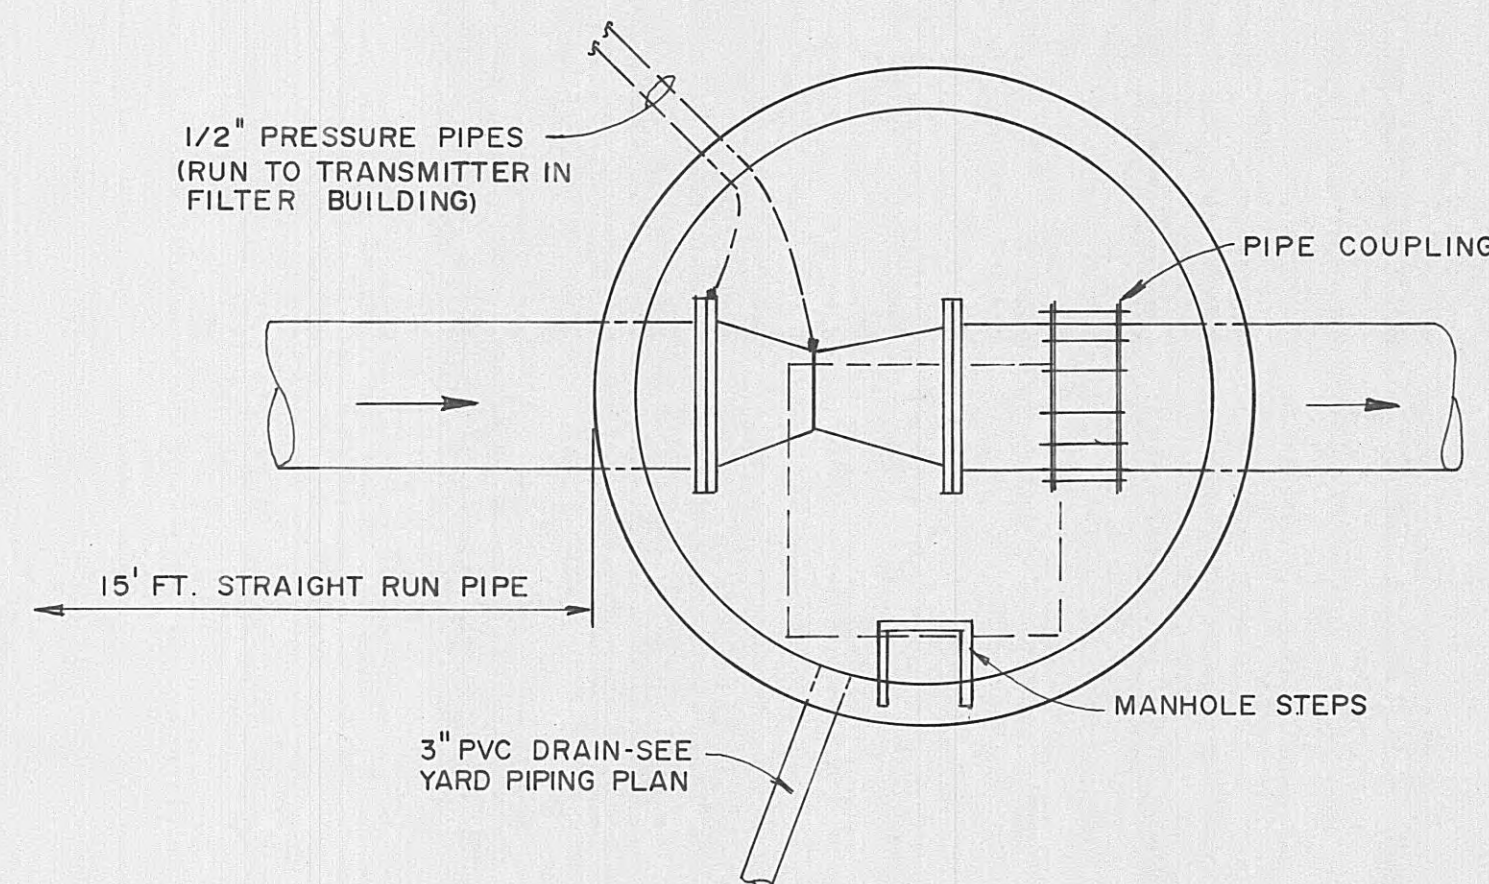

PLAN - FINISHED WATER FLOW METER


SCALE: 1/2" = 1'-0"

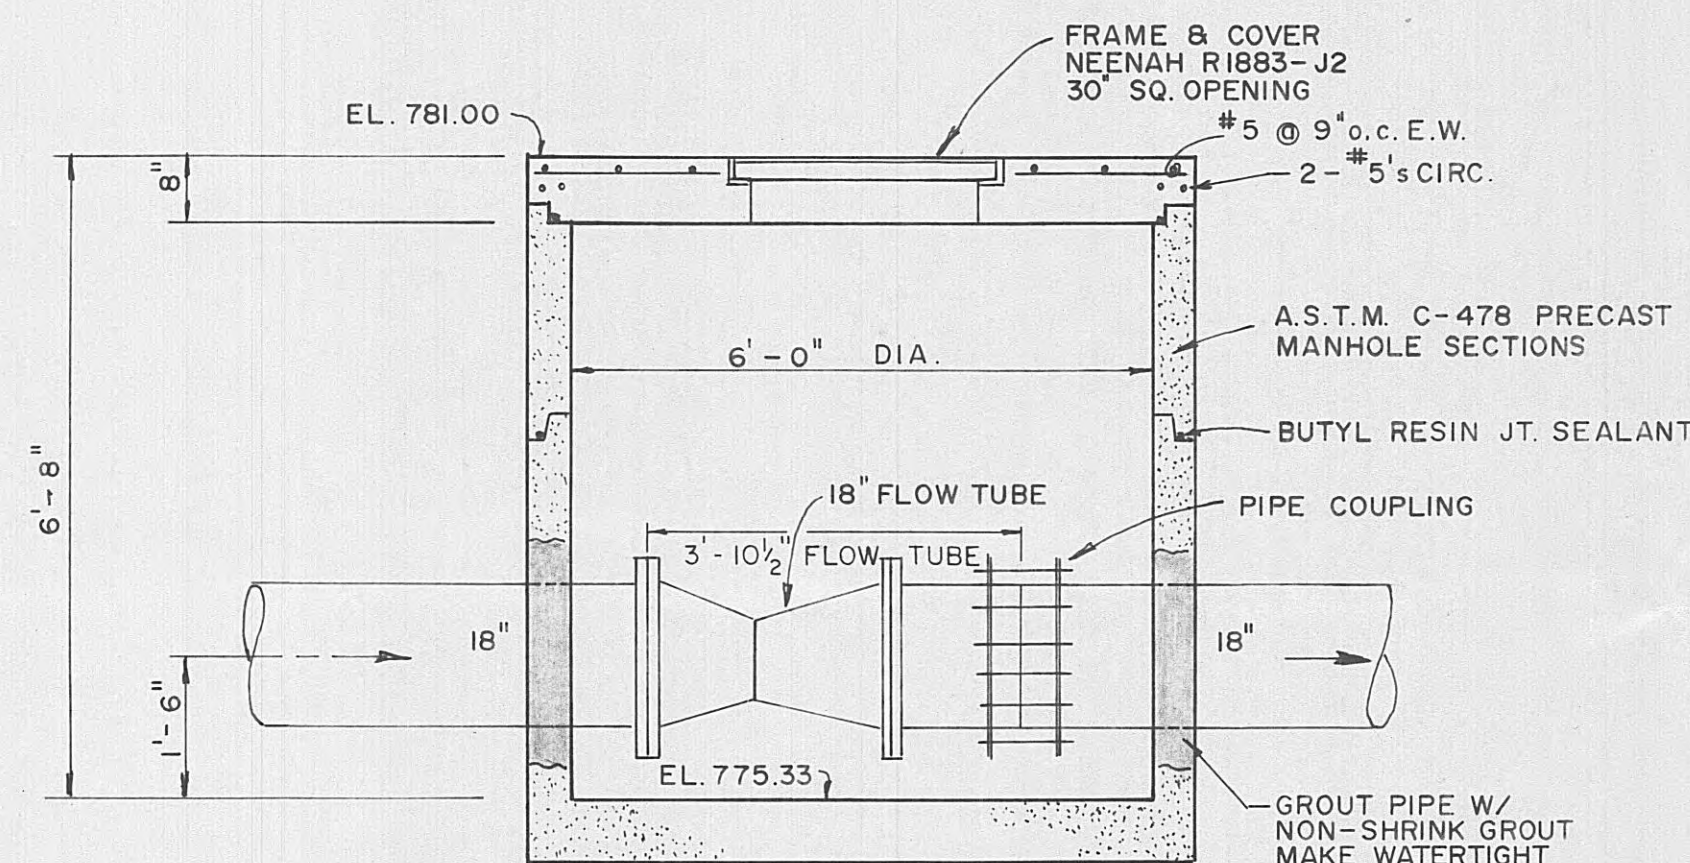

TYPICAL SECTION - FINISHED WATER METER


SCALE: 1/2" = 1'-0"

RAISED ALUM. LETTERS (HELVEITICA MEDIUM) ON BRONZE ANODIZED ALUM. PNL (.090 THK) W/5" MARGINS TYP. BOTH SIDES

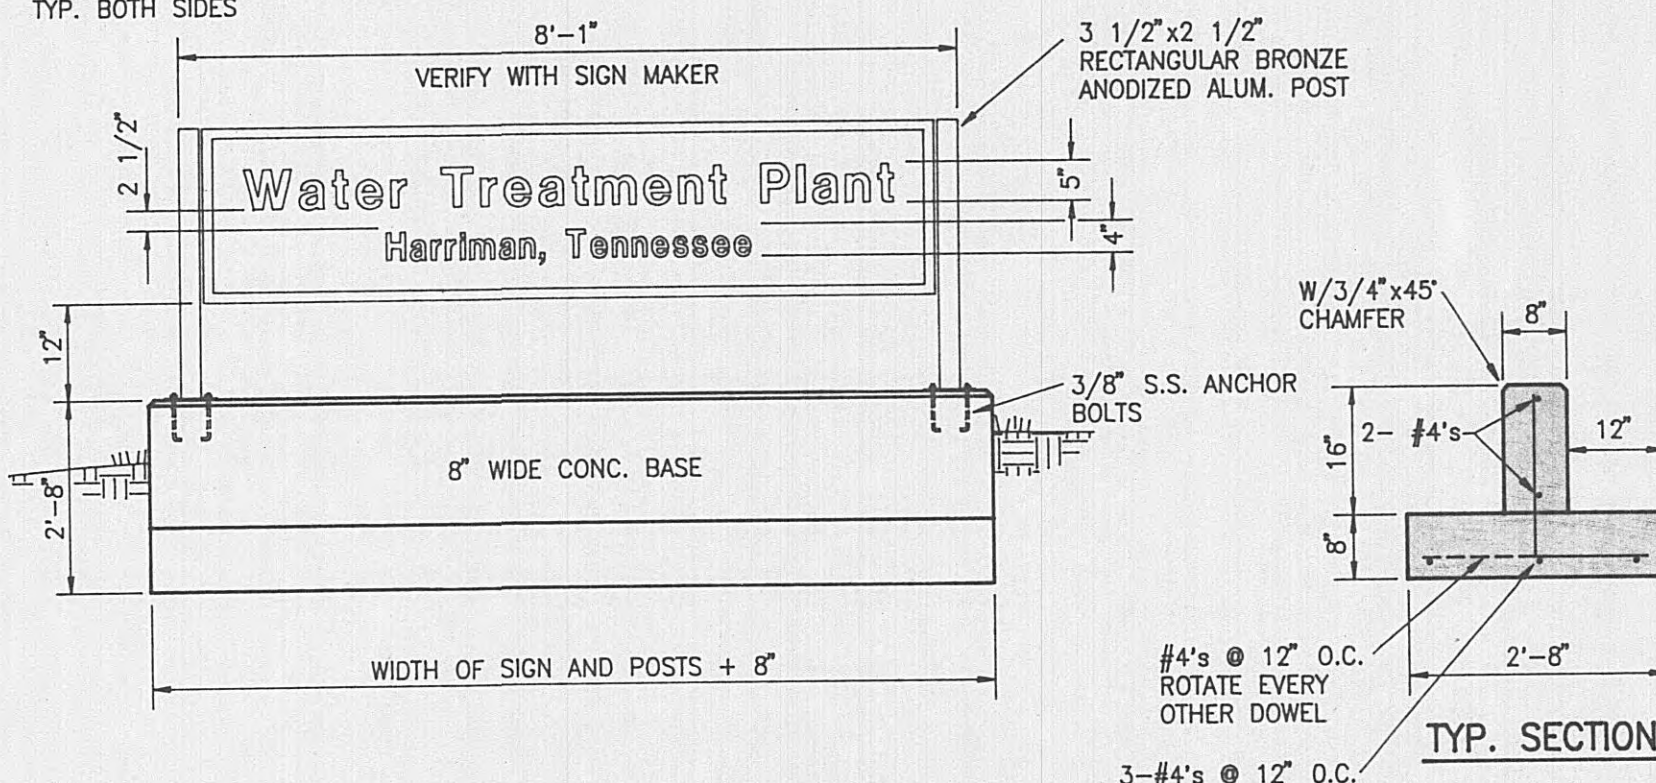


ENTRANCE SIGN DETAIL

SCALE: 1/2" = 1'-0"

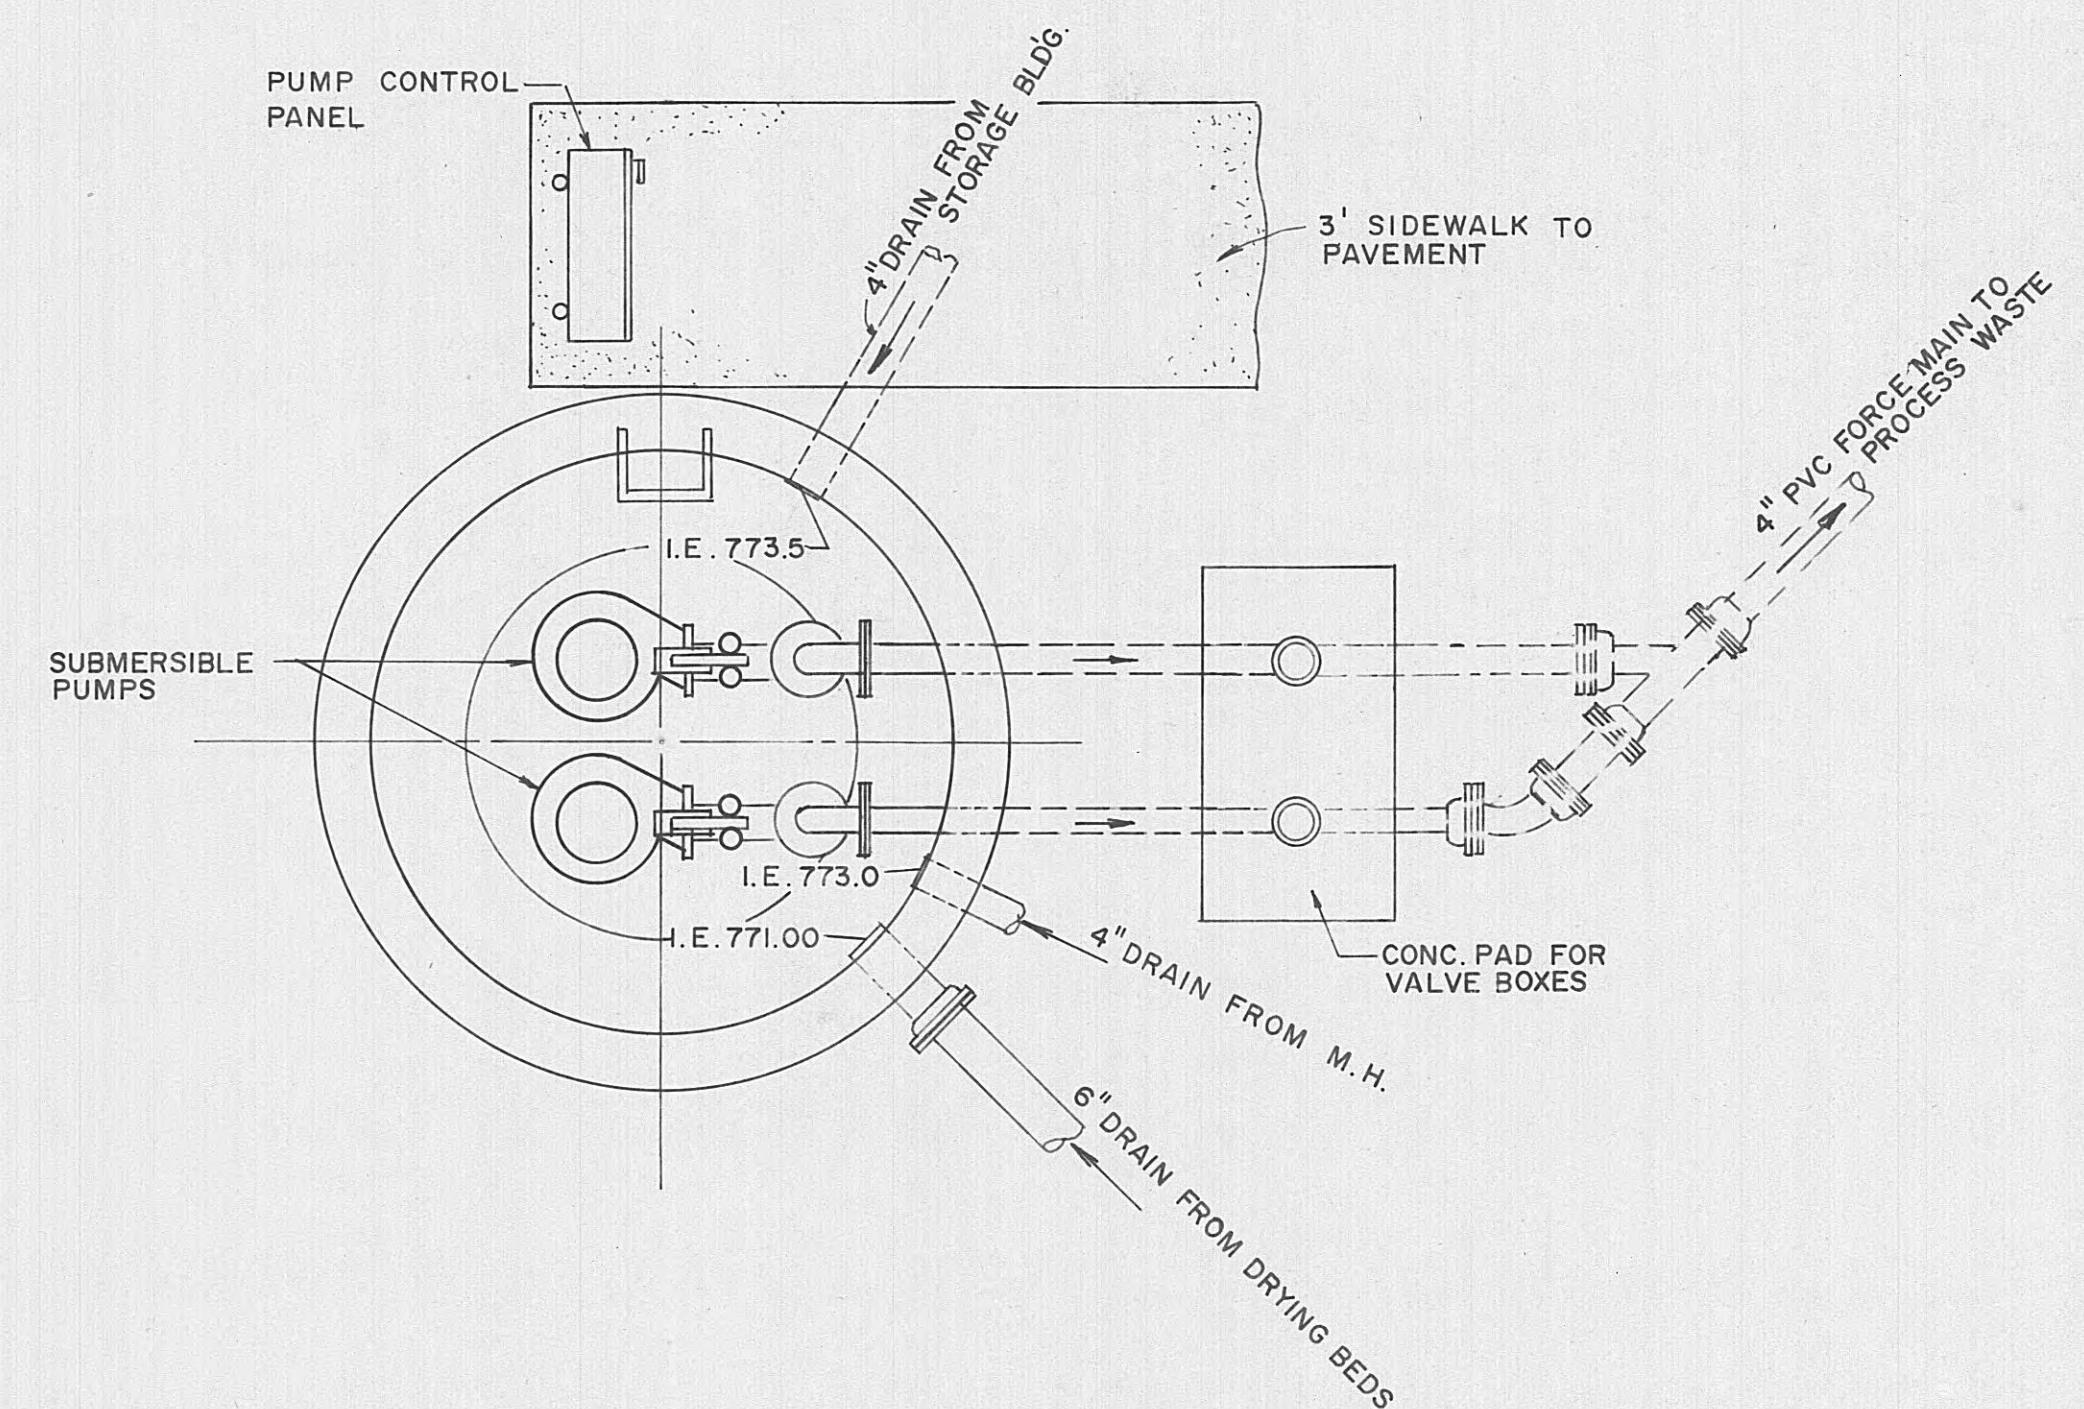

PLAN - FILTRATE PUMP STATION

SCALE: 1/2" = 1'-0"

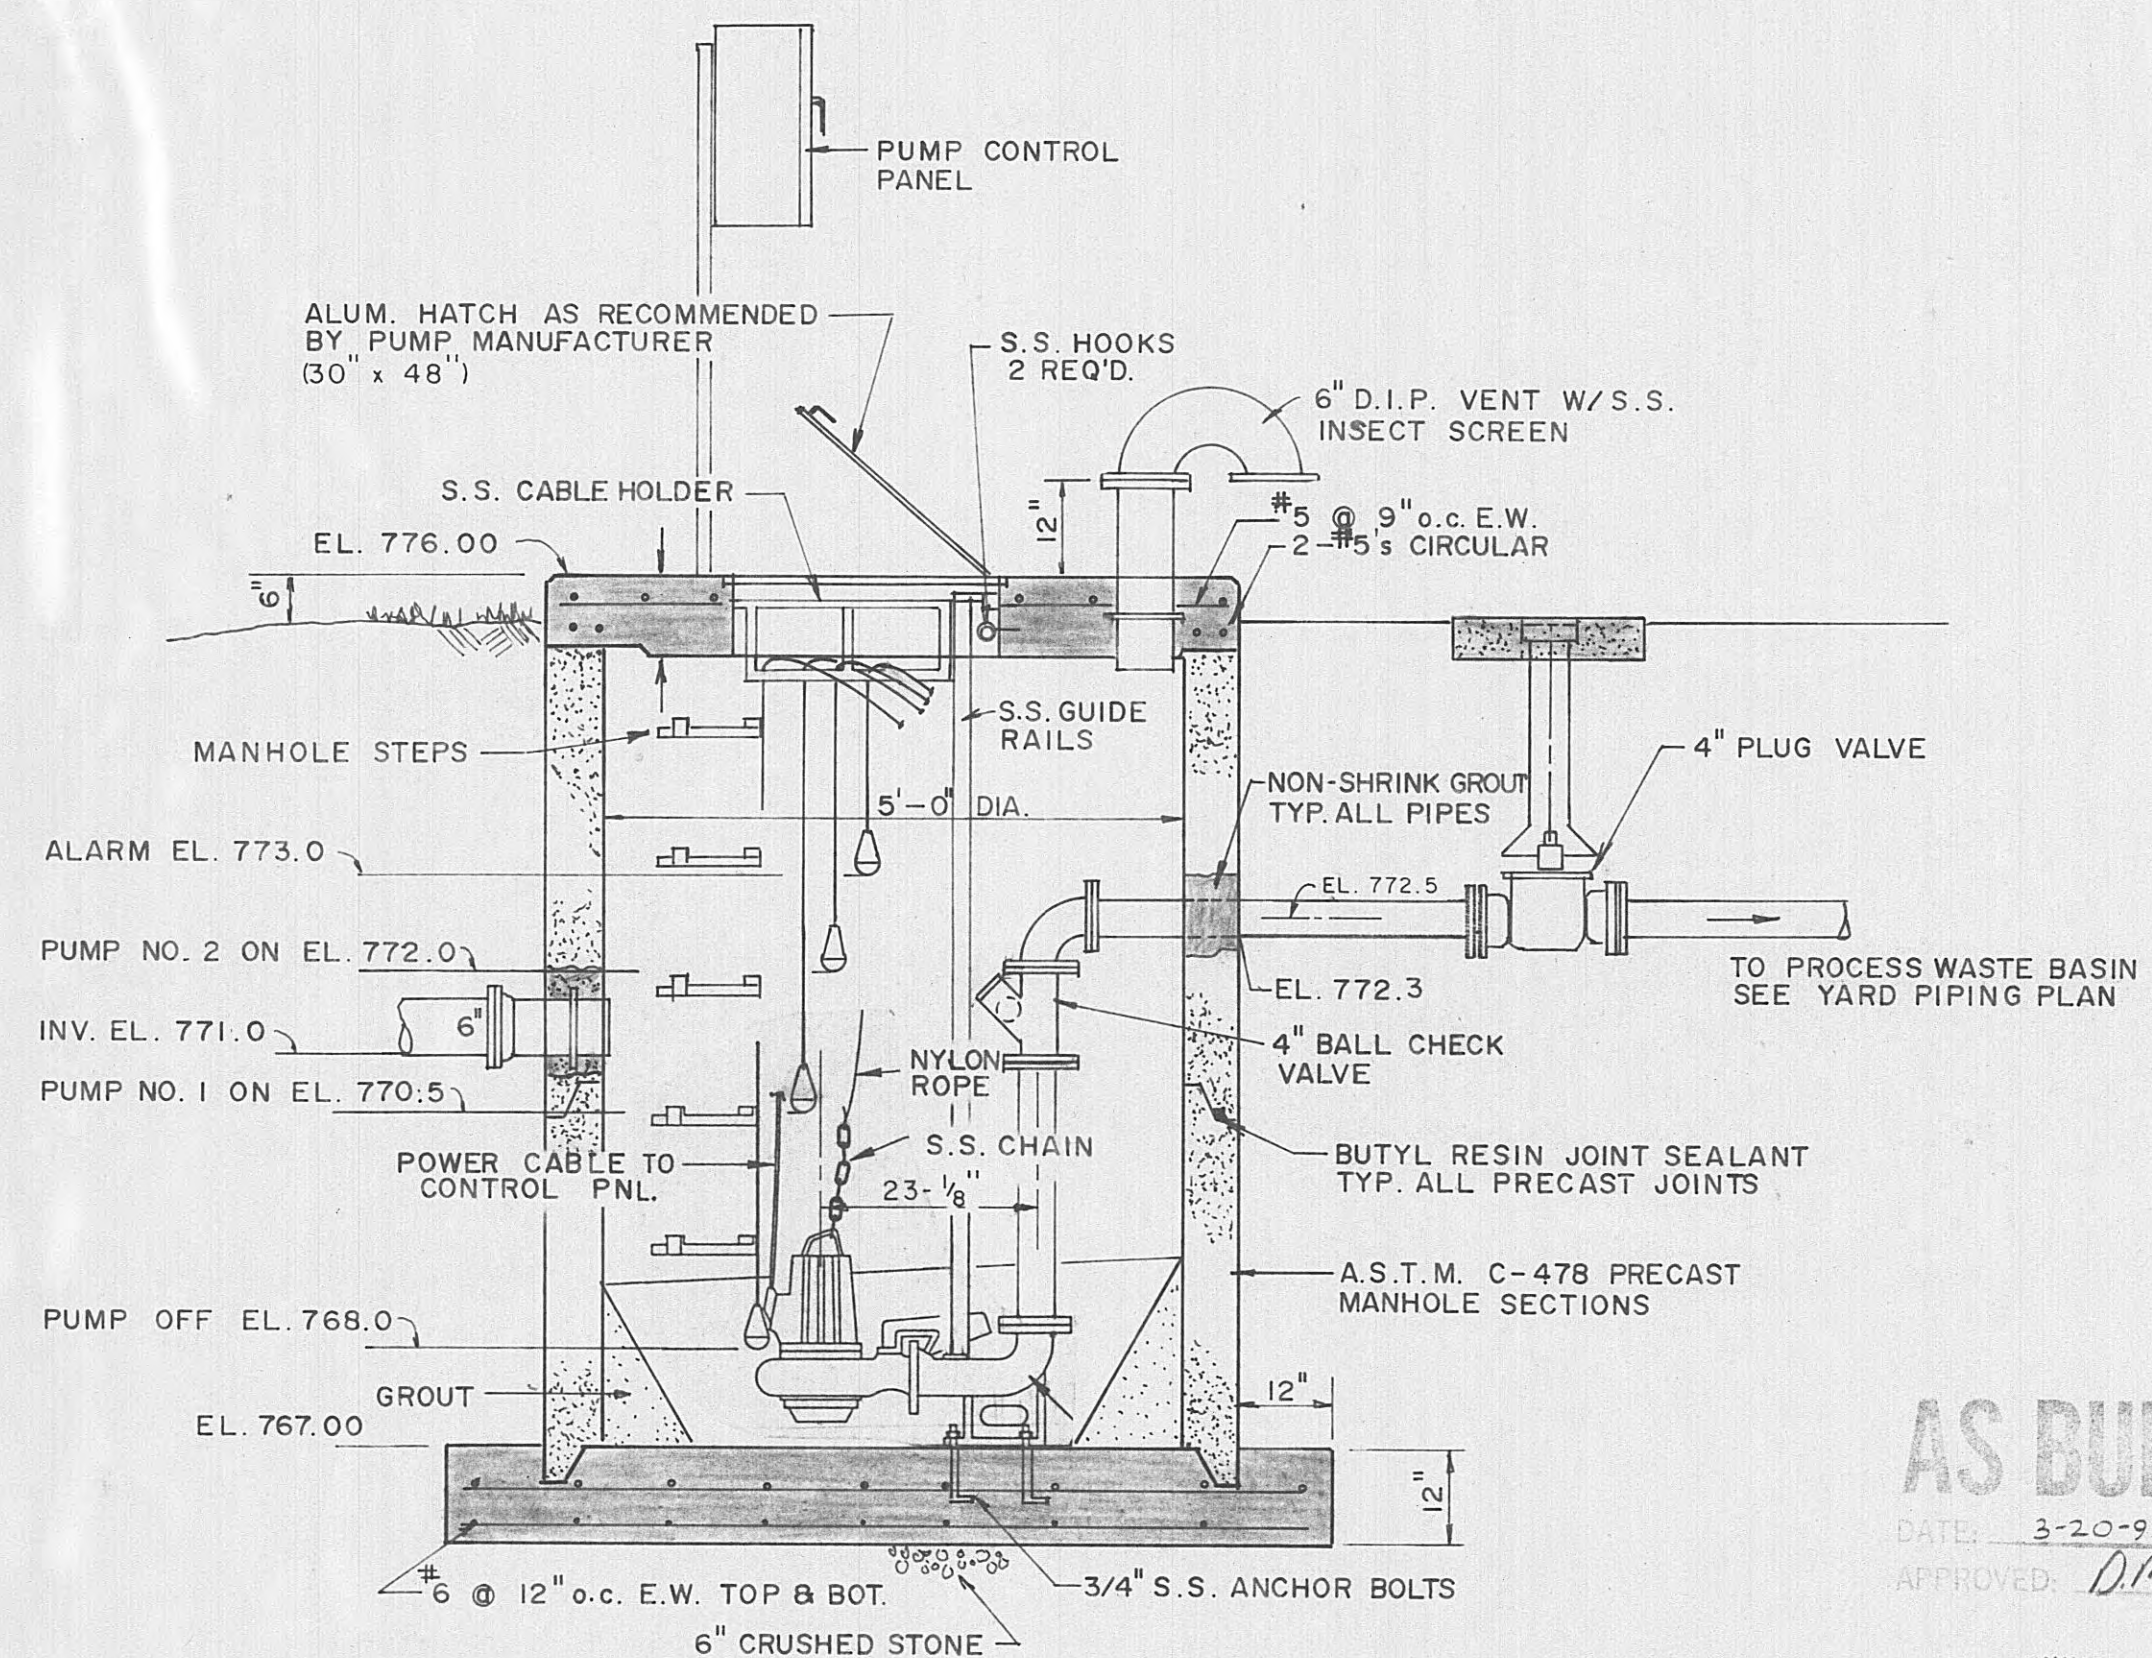


TYPICAL SECTION - FILTRATE PUMP STATION


SCALE: 1/2" = 1'-0"

AS BUILT

DATE: 3-20-95  
APPROVED: DM

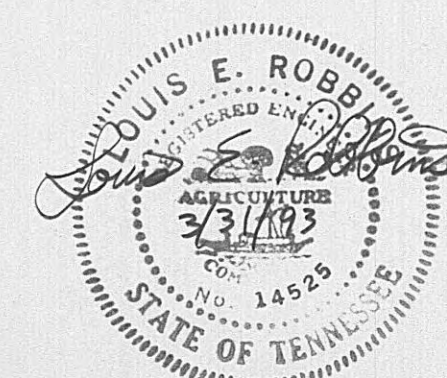

ELROD • DUNSON, INC.  
CONSULTING ENGINEERS  
NASHVILLE • KNOXVILLE  
LEXINGTON, KY

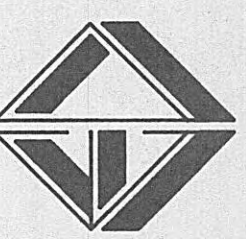

CONTRACT W93-04  
HARRIMAN, TENNESSEE  
FILTRATE PUMP STATION, FINISHED WATER METER PIT,  
RETAINING WALL PLAN AND SECTIONS

REVISIONS


3/3/93-Add Entrance Sign-Delete Exposed Aggregate on wall

DESIGNED: L.E.R.  
DRAWN: D.G.R.  
CHECKED: L.E.R.  
DATE: MARCH, 1993  
SCALE: AS NOTED  
PROJ. NO. 0592


SHEET 19

OF 36




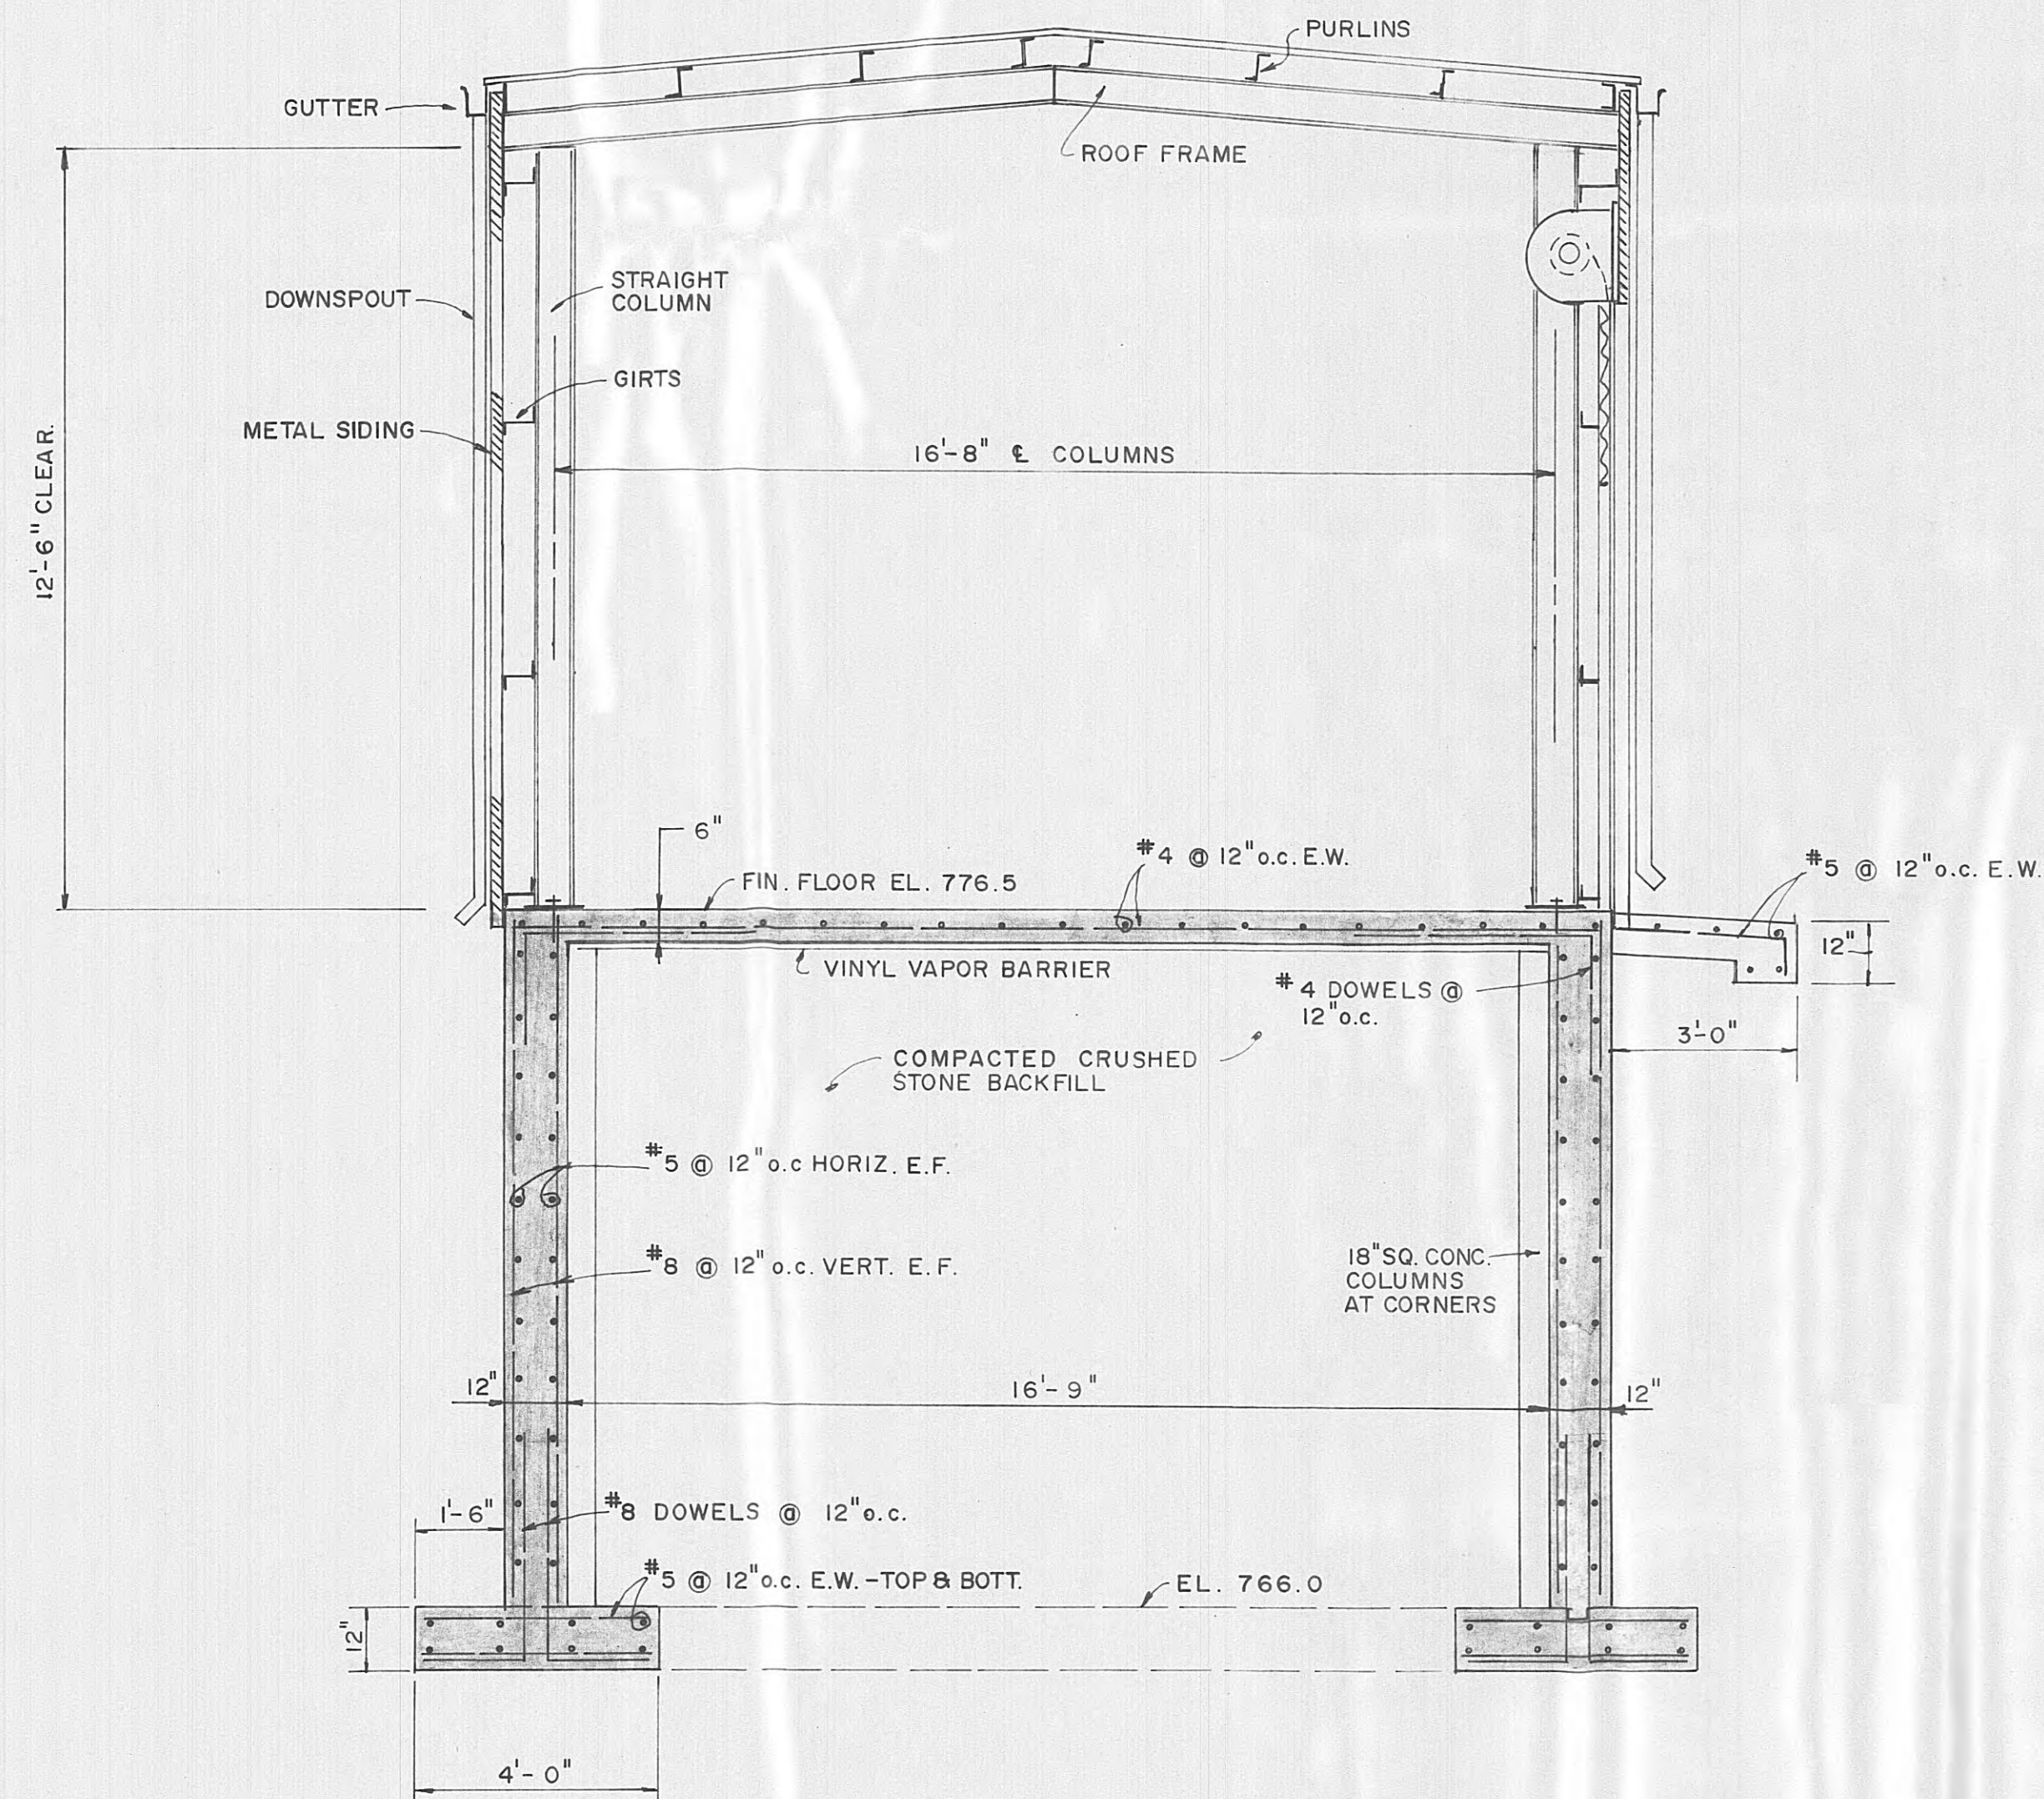


SECTION B-20  
SCALE: 3/8" = 1'-0"

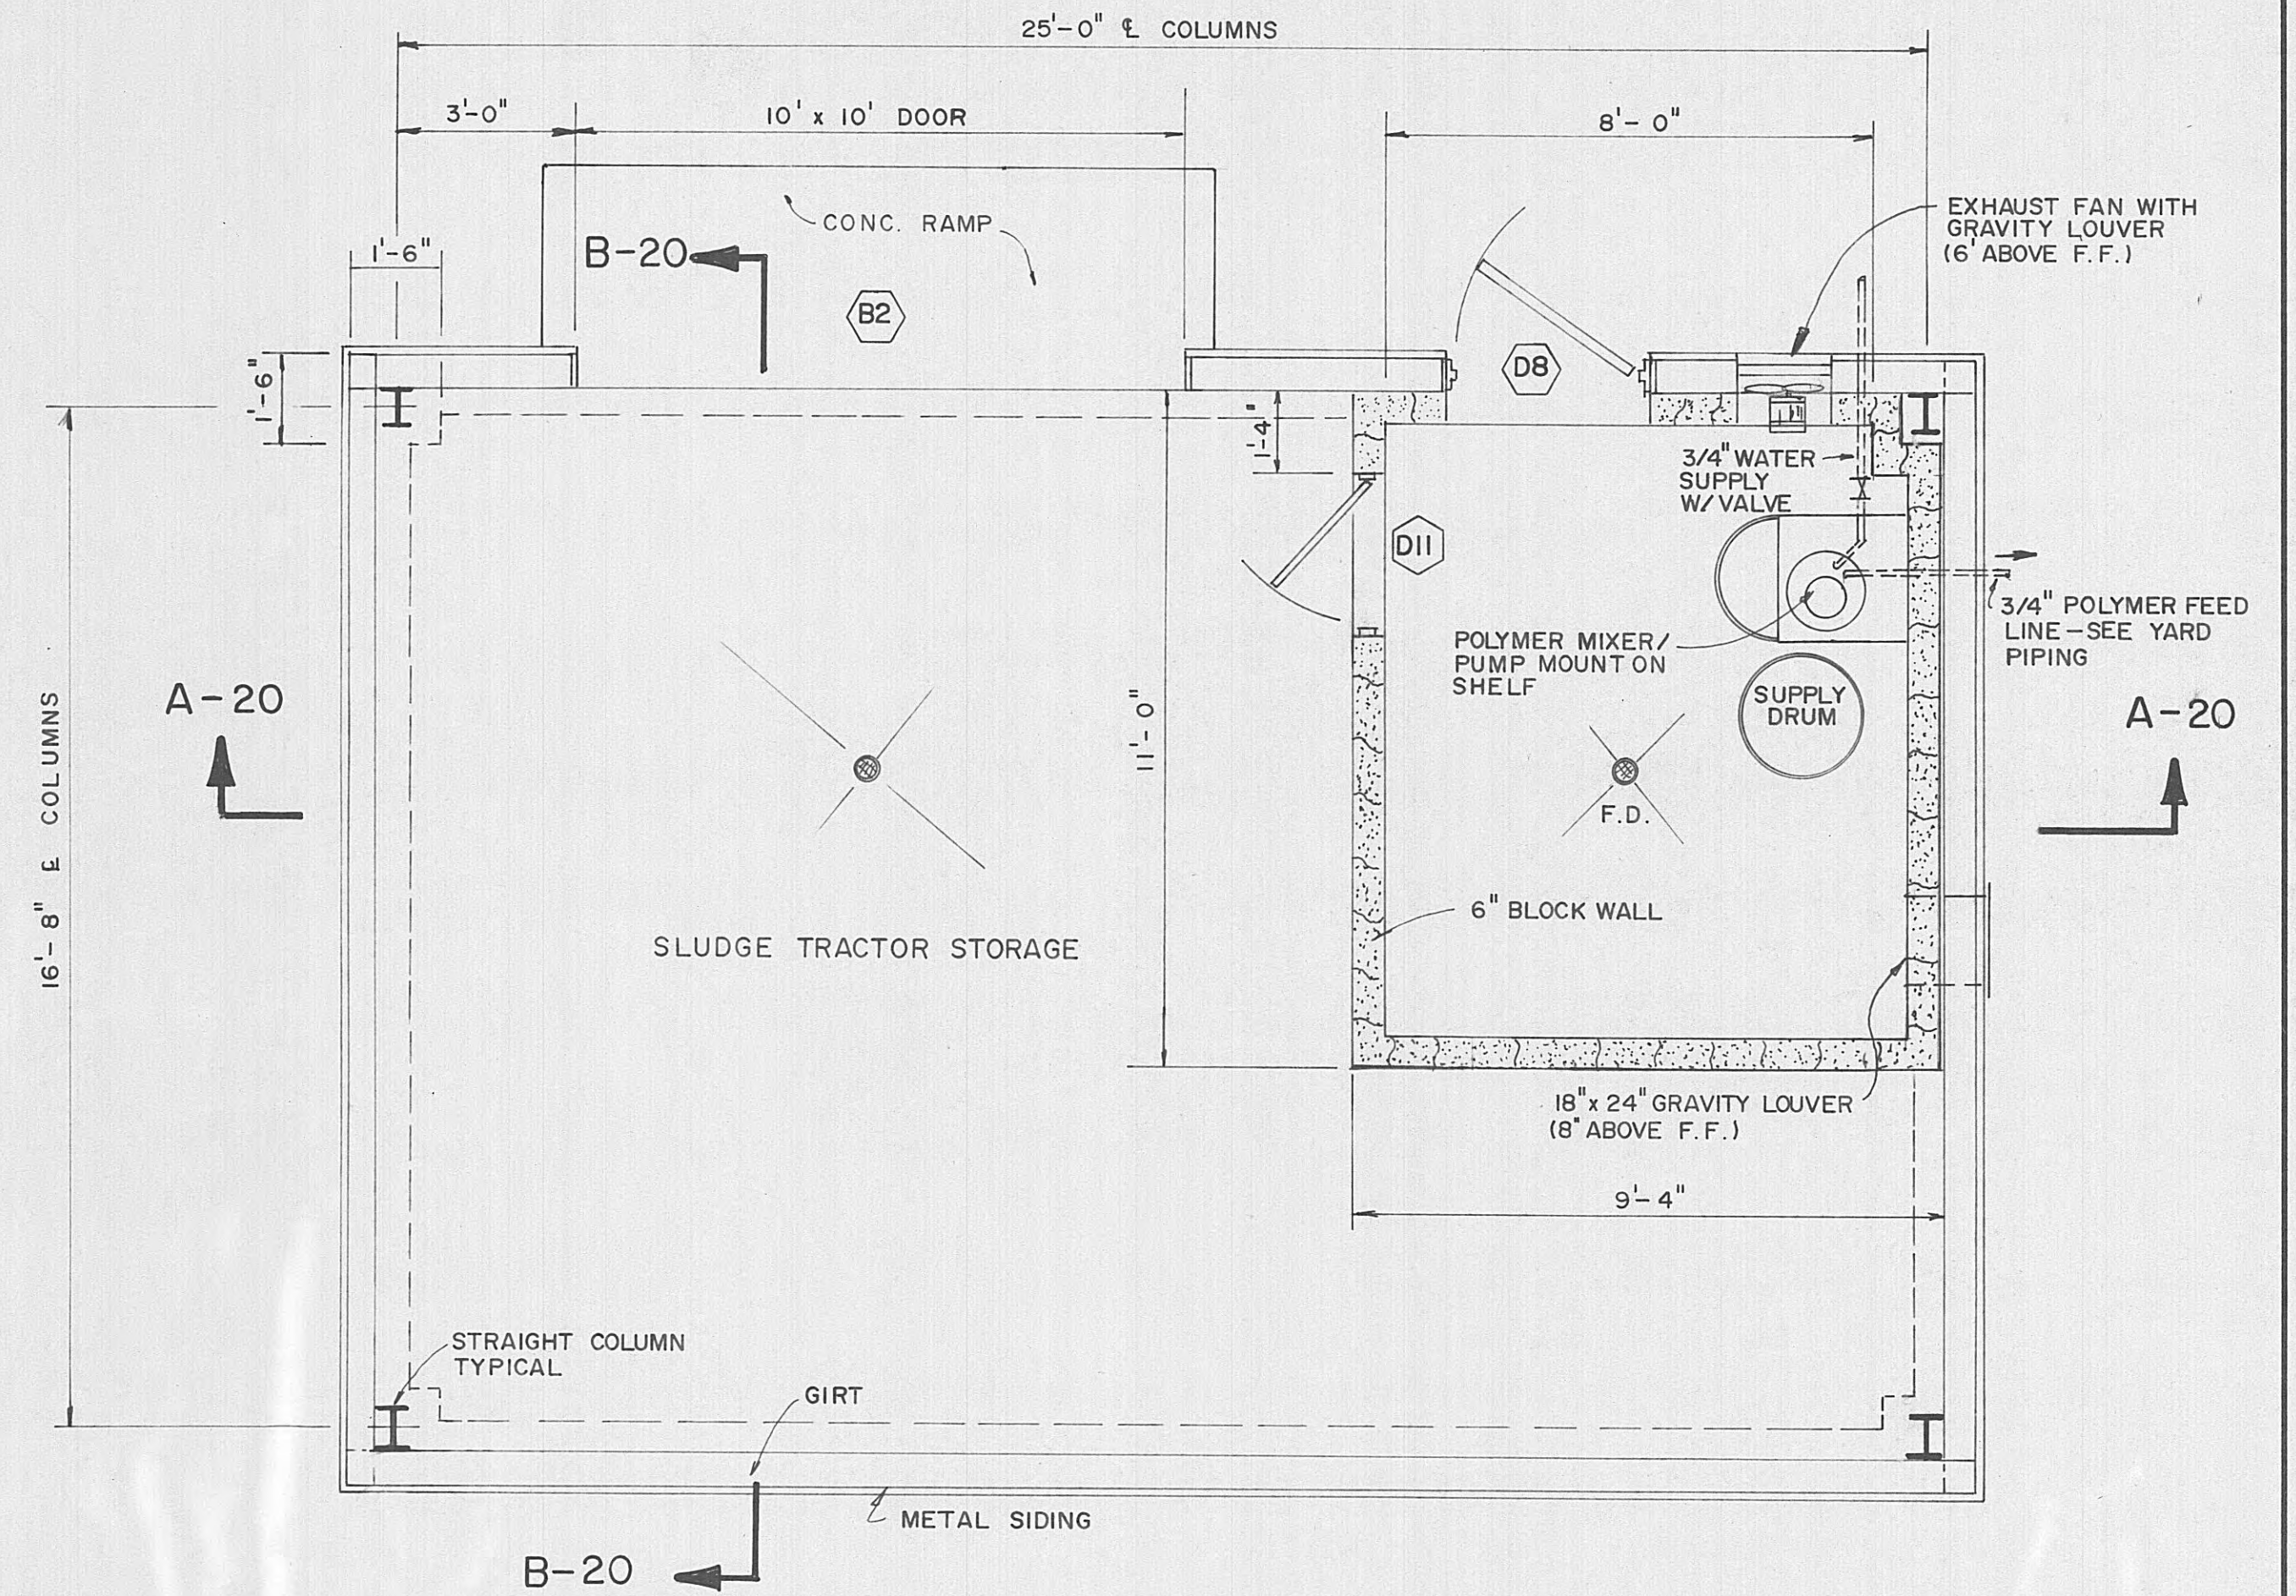

PLAN - STORAGE BUILDING/POLYMER FEED ROOM  
SCALE: 3/8" = 1'-0"

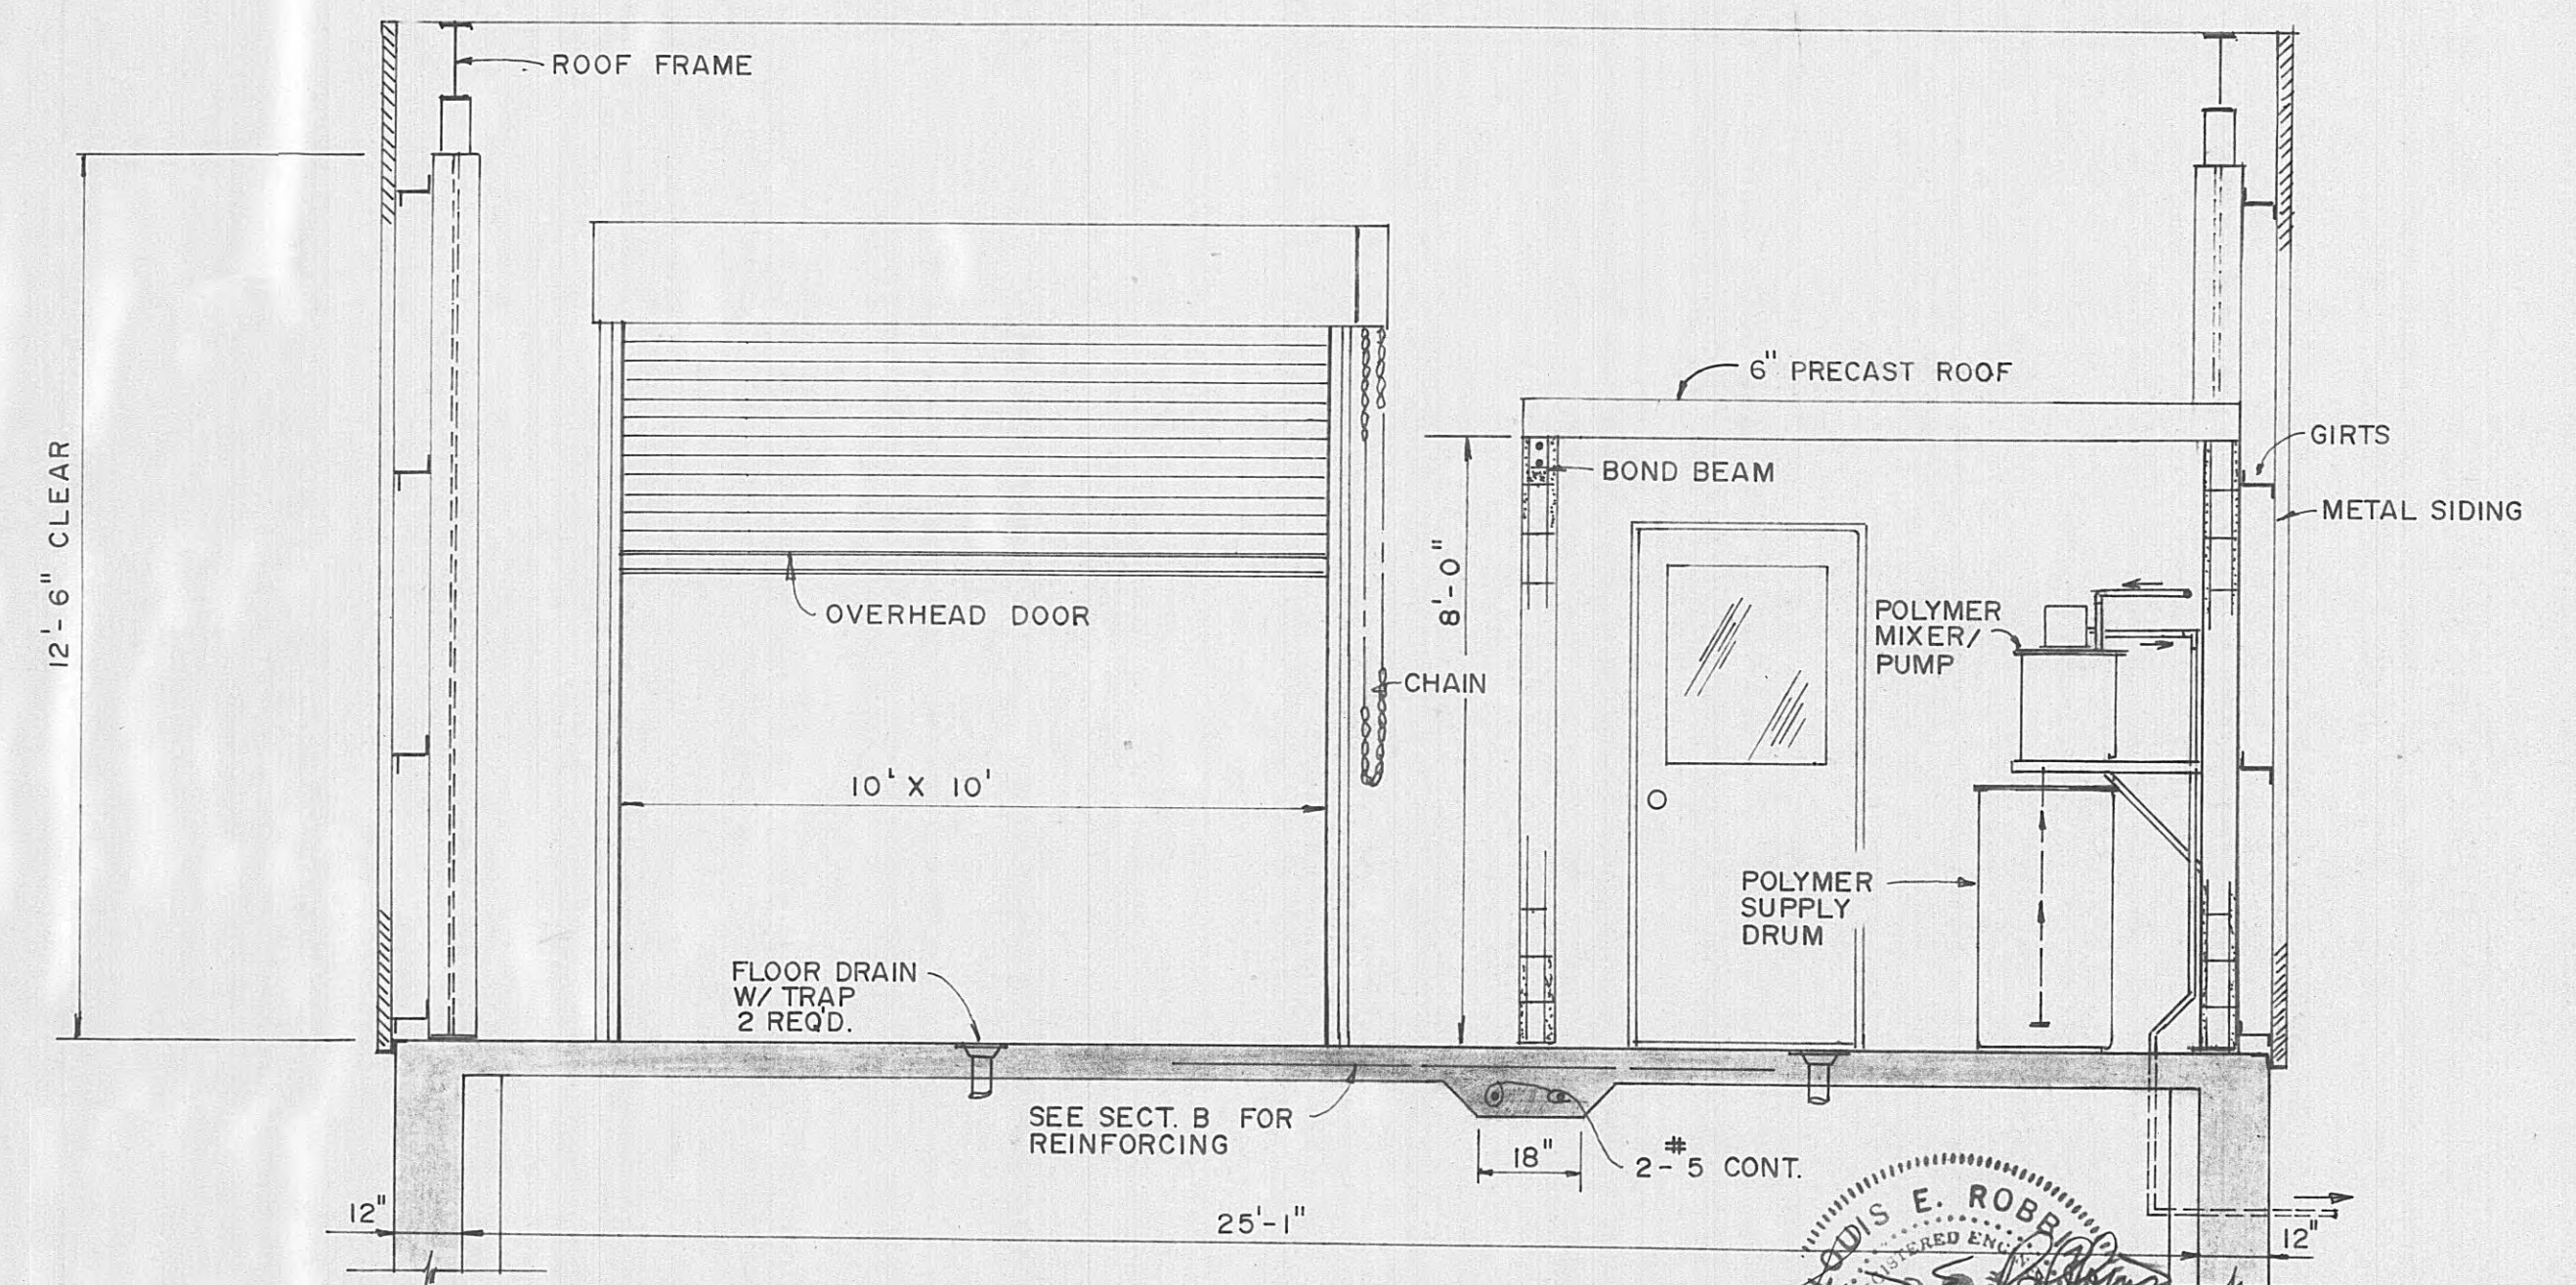

SECTION A-20  
SCALE: 3/8" = 1'-0"

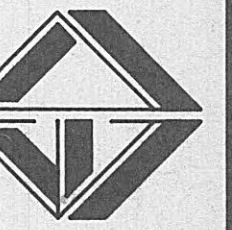


REVISIONS


DESIGNED: L.E.R.  
DRAWN: D.G.R.  
CHECKED: L.E.R.  
DATE: MARCH, 1993  
SCALE: AS NOTED  
PROJ. NO. 0592




CONTRACTOR SHALL CUT AND REMOVE DETERIORATED CONC. SLAB IN AREA SHOWN. A NEW SLAB SHALL BE POURED WITH NEW REBARS DOWELED INTO EXIST. SLAB. SEE DETAIL THIS SHEET.

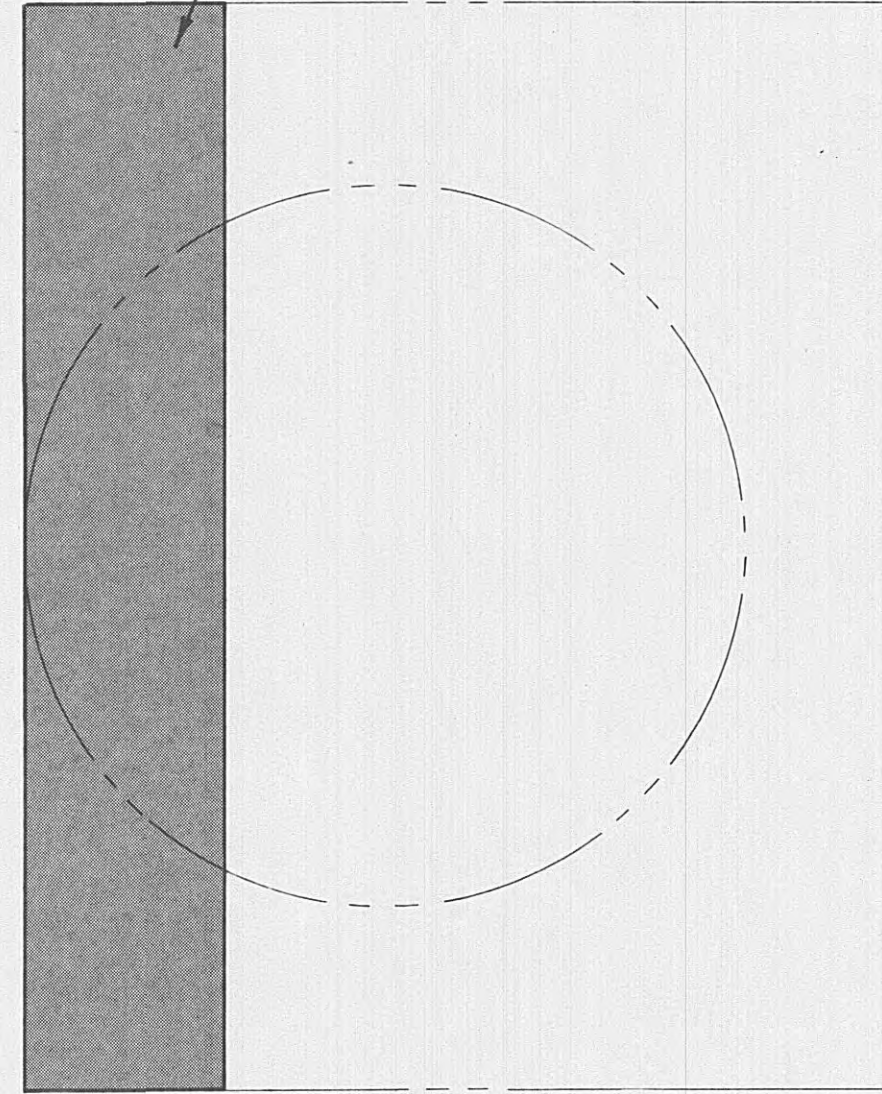


DETAIL - SLAB REPAIR  
SCALE:  $\frac{3}{8}" = 1'-0"$

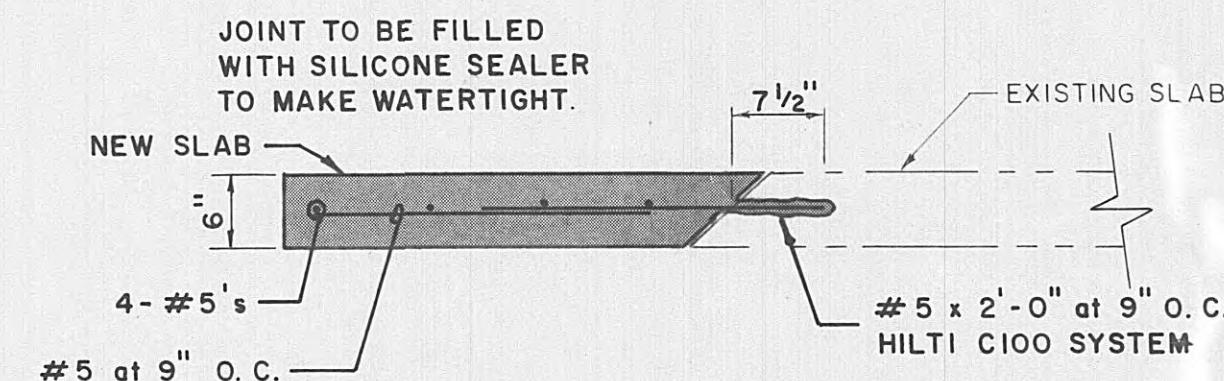


DETAIL - SLAB REPAIR JOINT  
SCALE:  $\frac{3}{4}" = 1'-0"$

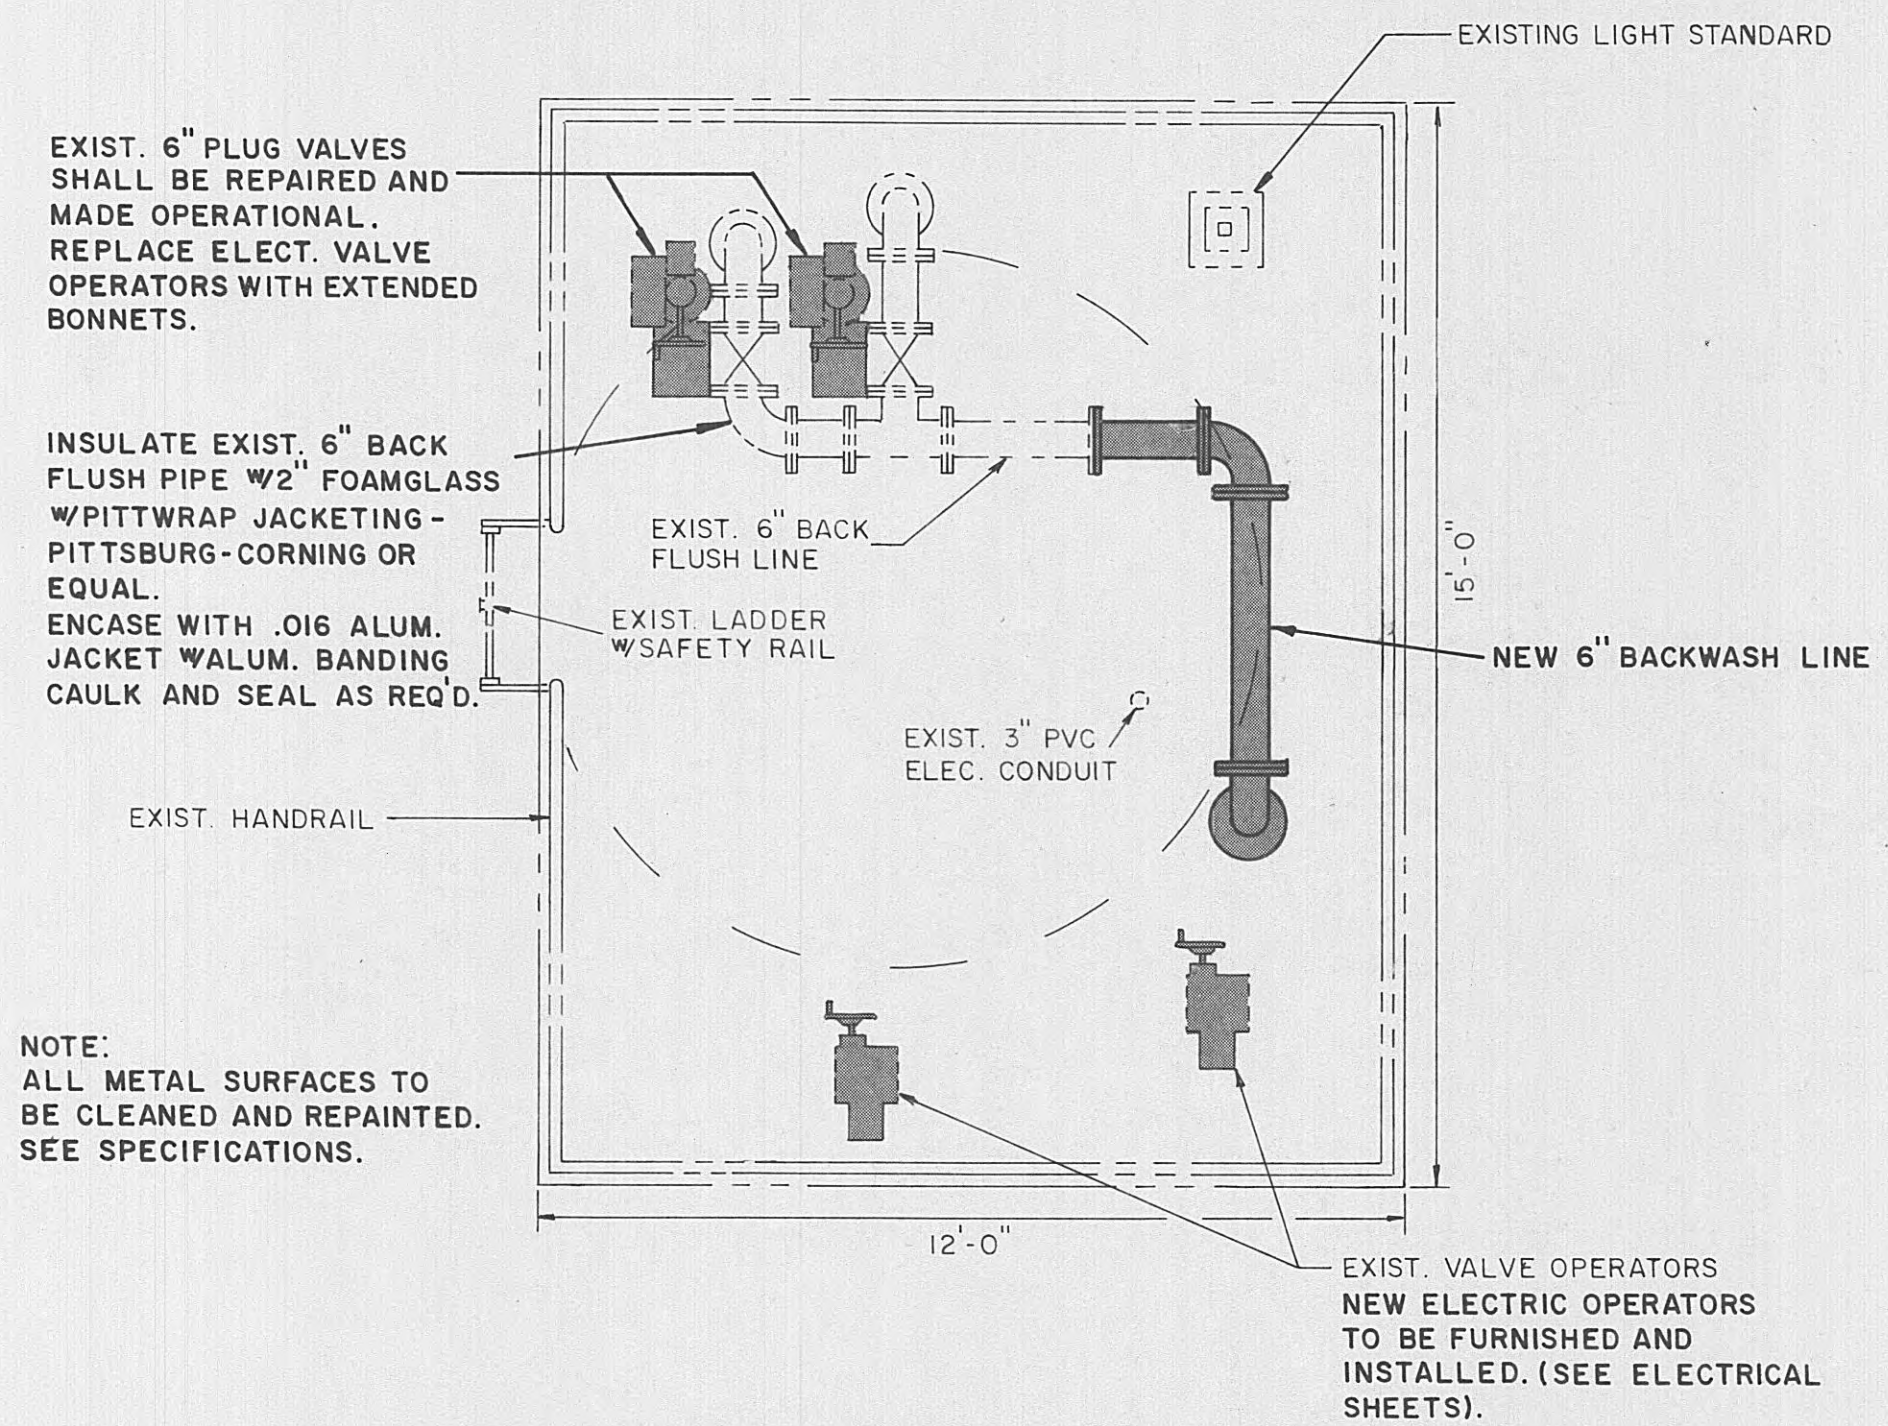

PLAN - INTAKE STRUCTURE  
SCALE:  $\frac{3}{8}" = 1'-0"$

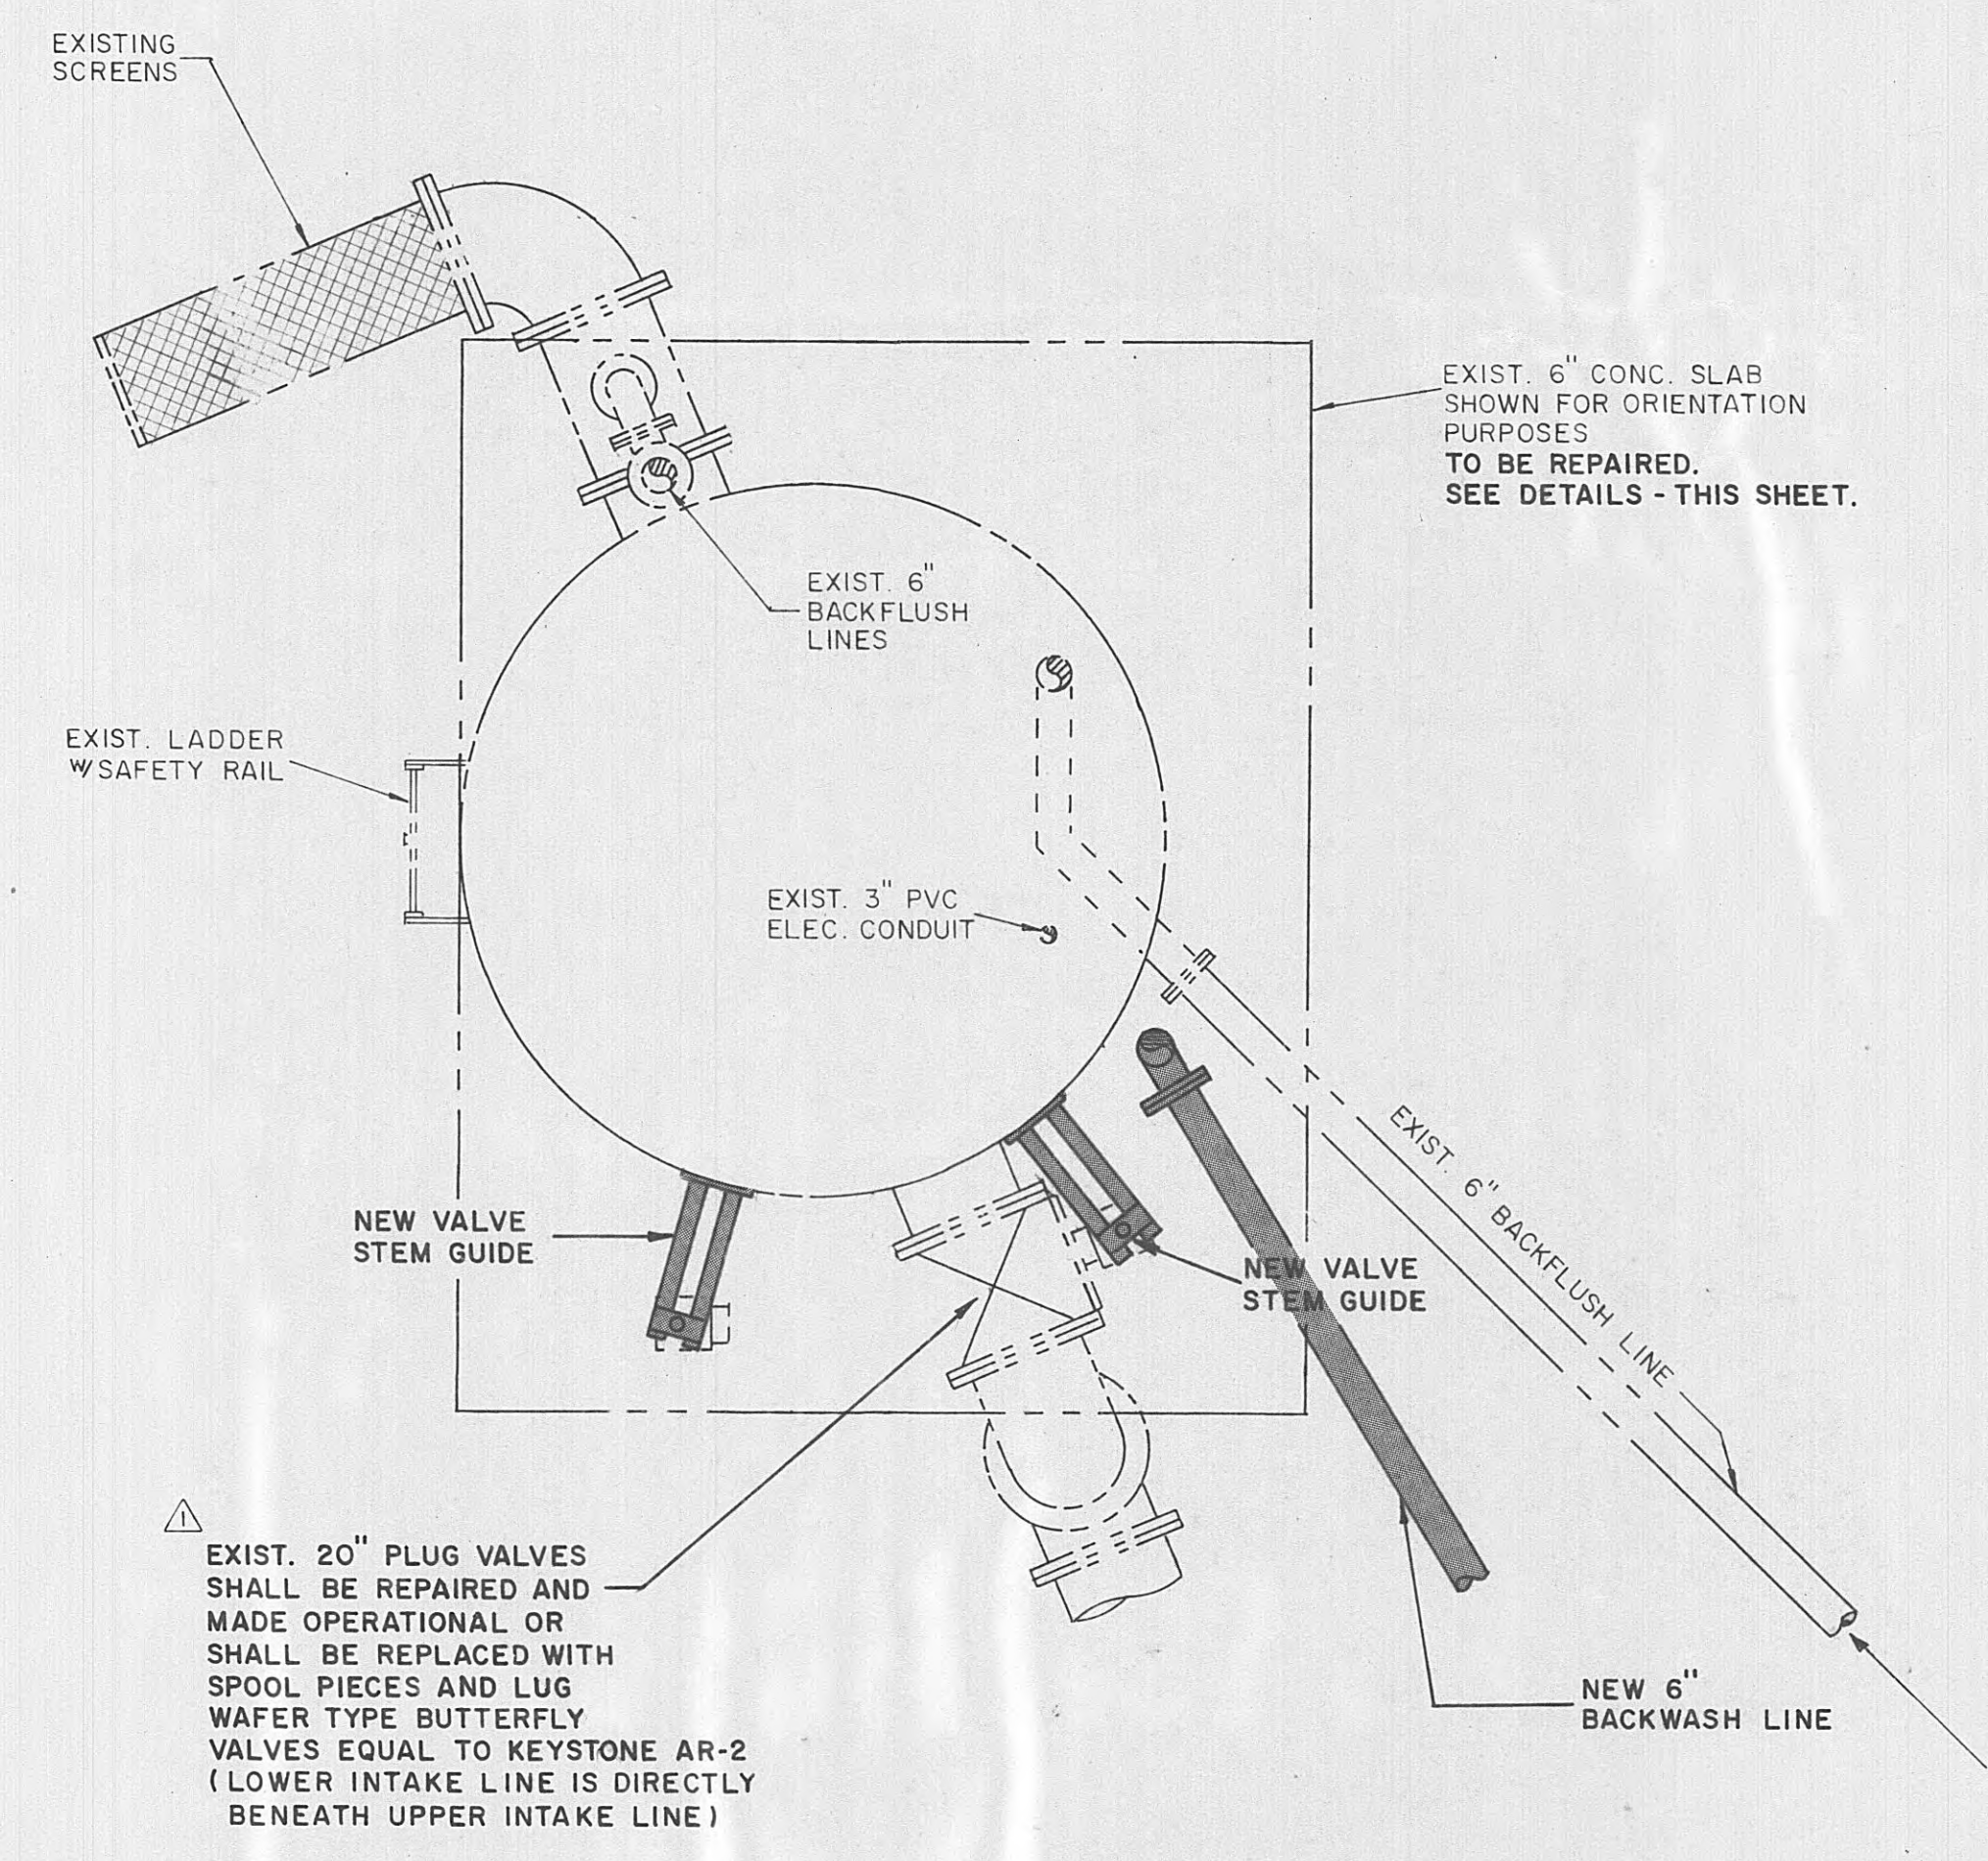


PARTIAL PLAN - INTAKE STRUCTURE  
SCALE:  $\frac{3}{8}" = 1'-0"$

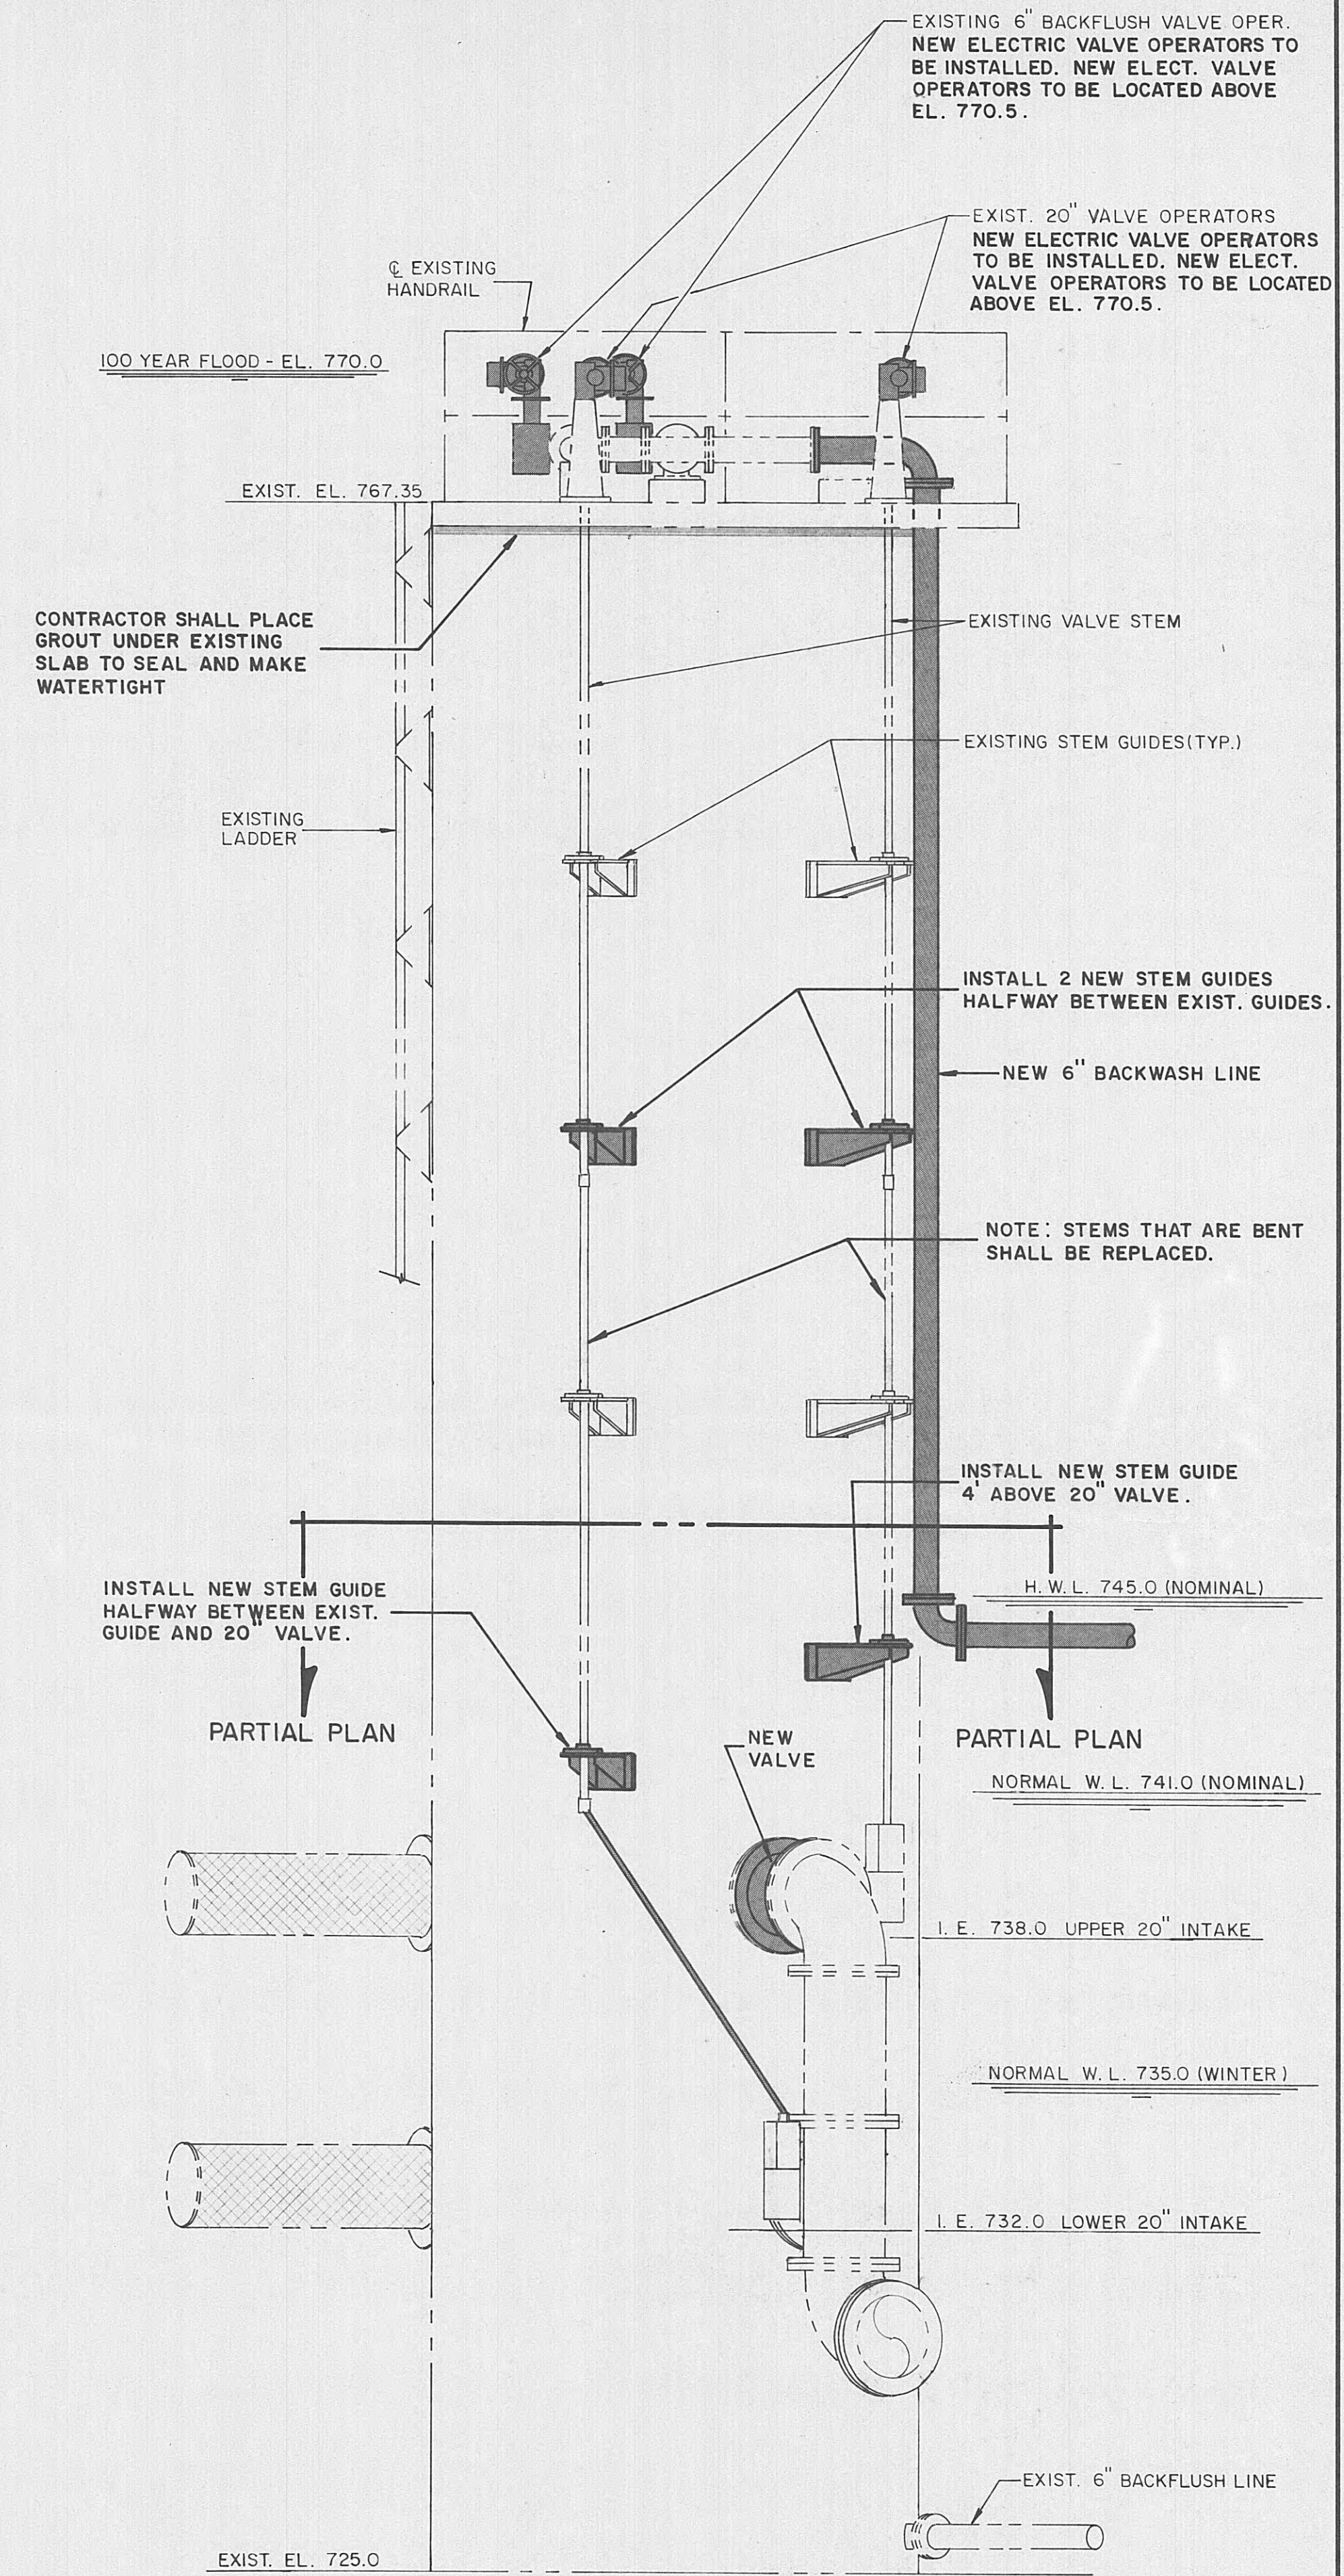

ELEVATION - INTAKE STRUCTURE  
SCALE:  $\frac{3}{8}" = 1'-0"$

AS BUILT  
DATE: 3-20-95  
APPROVED: *[Signature]*

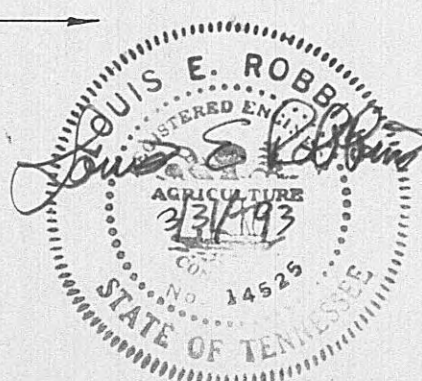

ELROD • DUNSON, INC.  
CONSULTING ENGINEERS  
NASHVILLE • KNOXVILLE  
LEXINGTON, KY


CONTRACT W93-04  
HARRIMAN, TENNESSEE  
MODIFICATIONS TO RAW WATER INTAKE STRUCTURE

REVISIONS  
7-7-93  
REVISION 1  
ADDENDUM NO. 1



DESIGNED: L. E. R.  
DRAWN: D. M.  
CHECKED: L. E. R.  
DATE: MARCH, 1993  
SCALE: AS NOTED  
PROJ. NO. 0592

SHEET 21  
OF 36



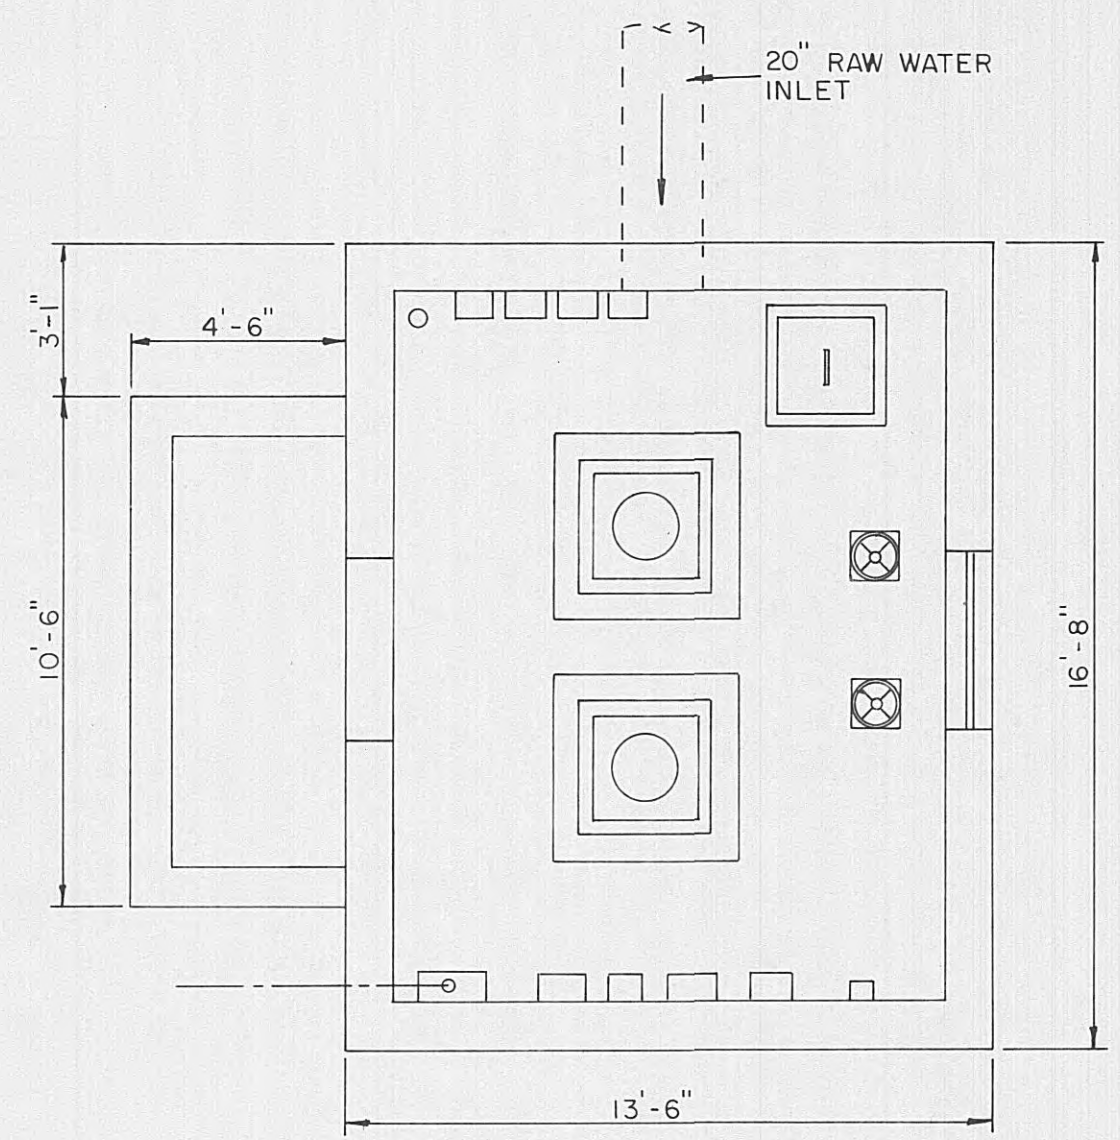

PLAN - EXISTING INTAKE PUMP BUILDING  
SCALE: 1/4" = 1'-0"

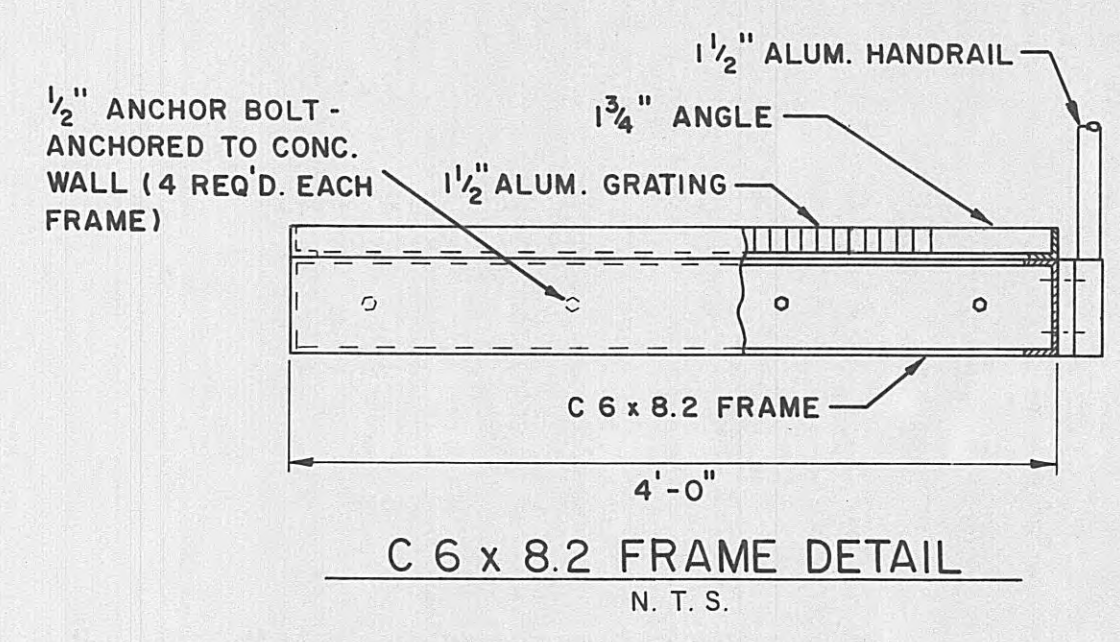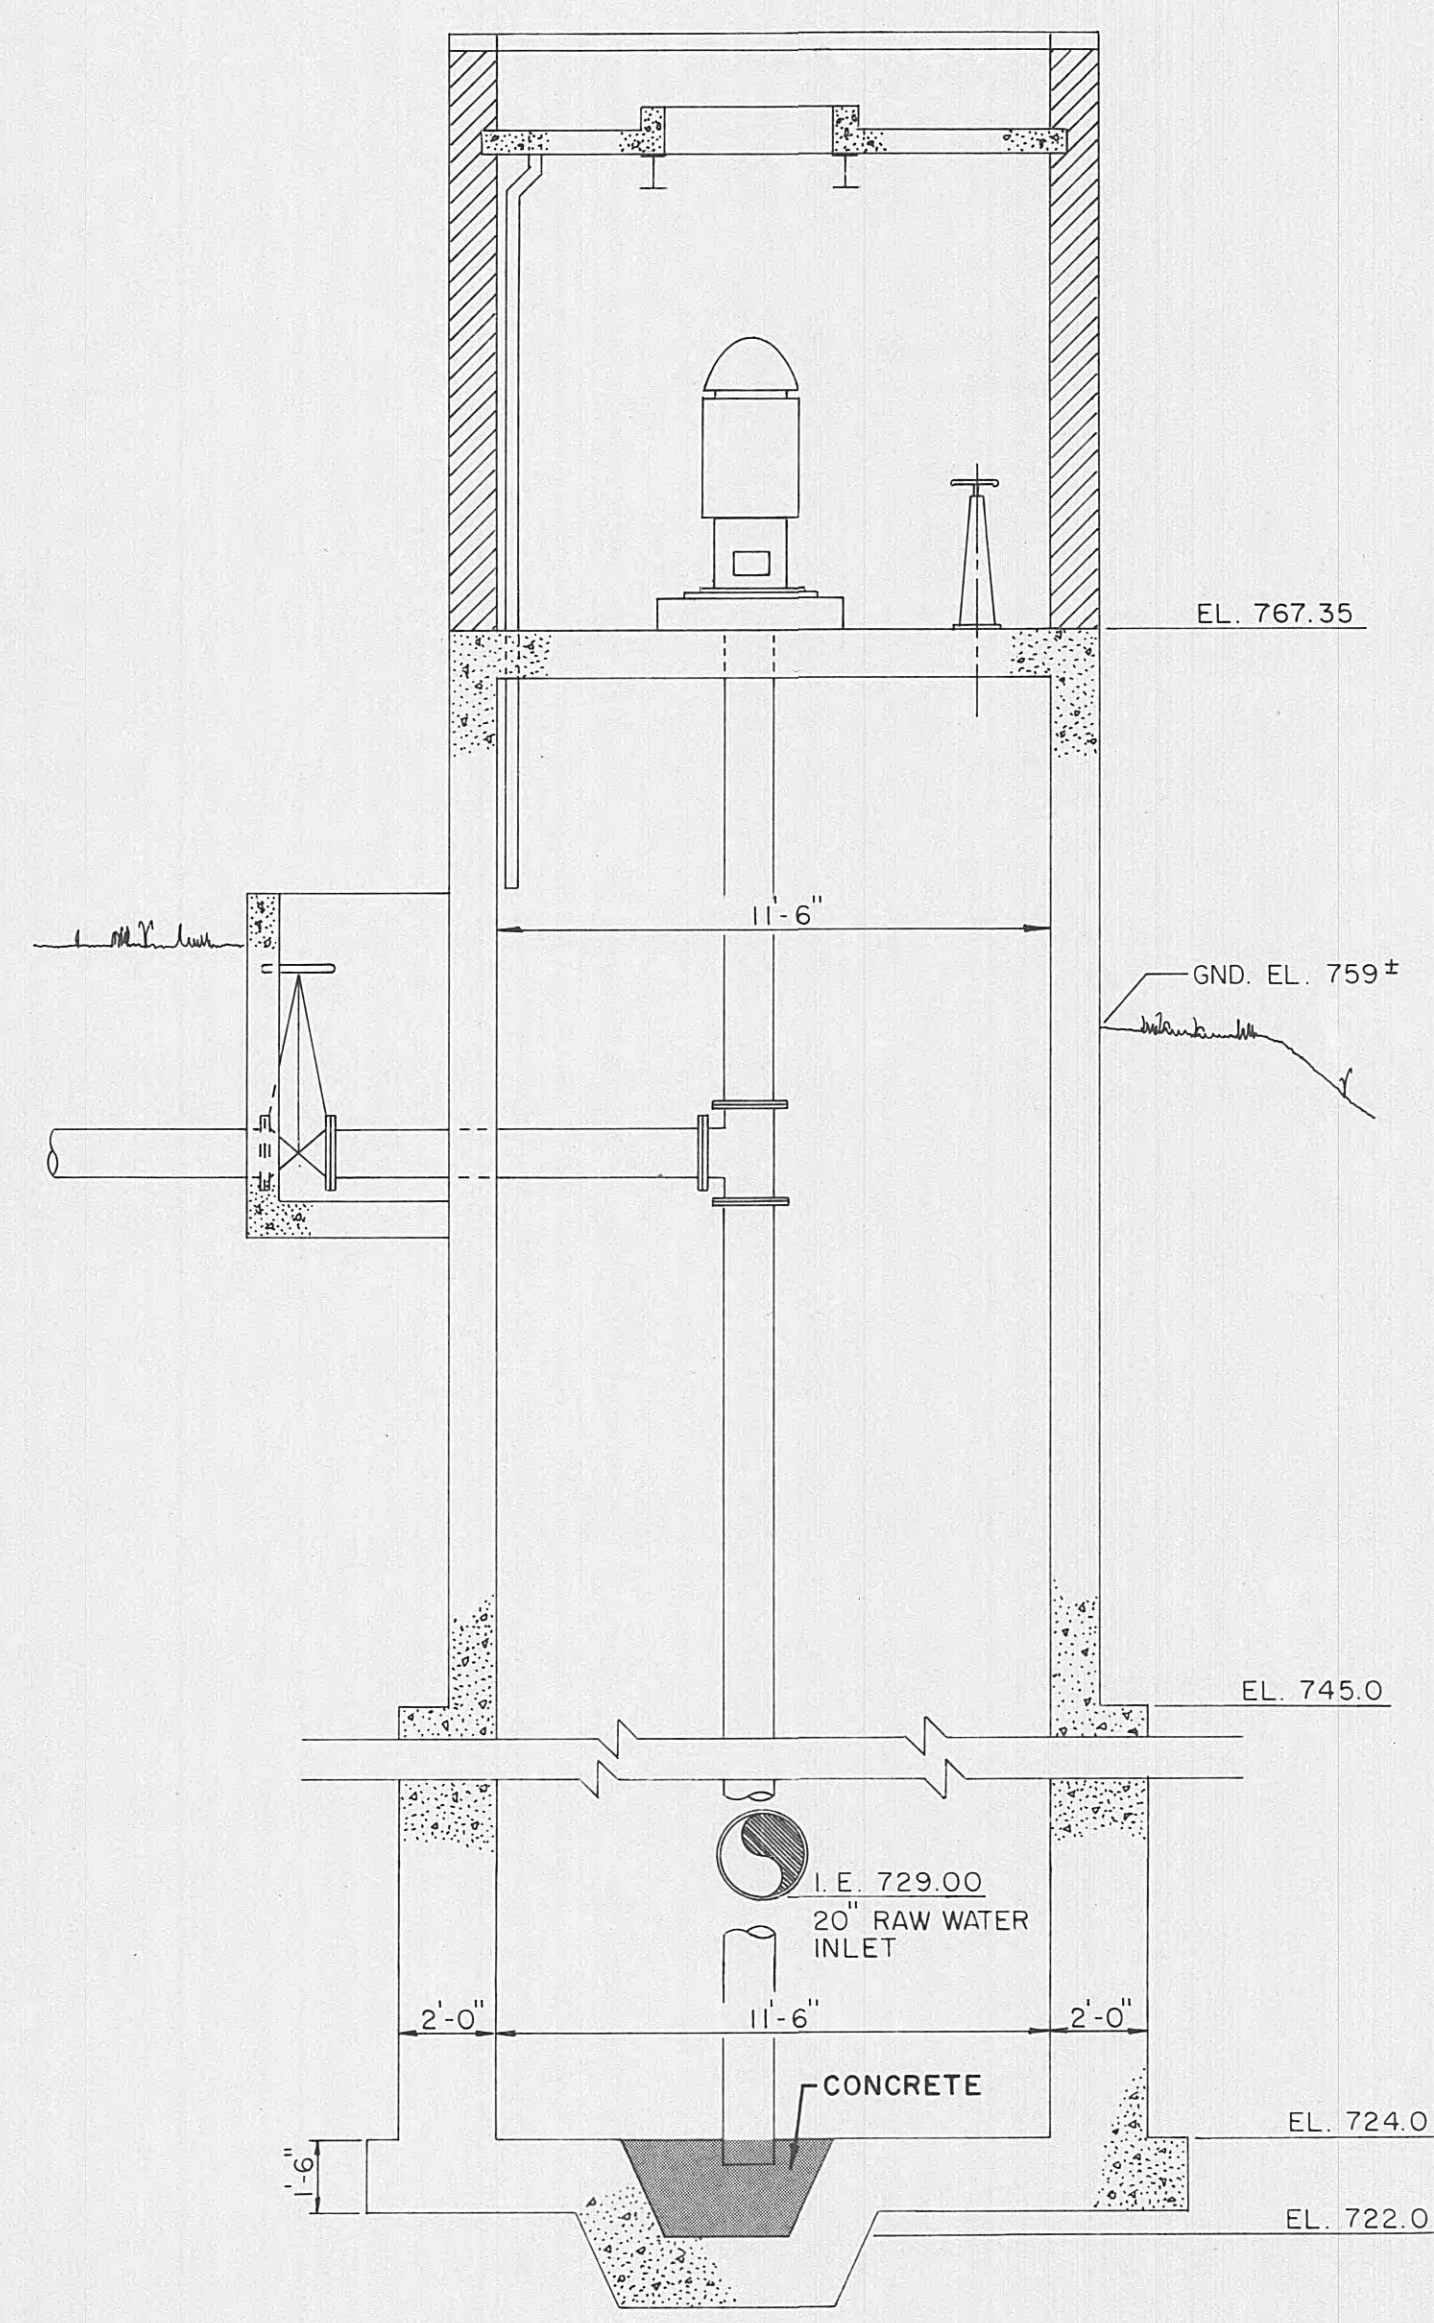


INTAKE PUMP BUILDING  
FOUNDATION CONSTRUCTION


NOTE: Refer to Subsurface Investigation Report developed by Foundation Systems Engineering located at end of Detailed Specifications.

- Grout Injection:
1. The Contractor shall prepare 16 each, 3-inch diameter (maximum) injection ports for low pressure grouting at the spacing shown below.
  2. Grout shall be Type I Portland with Type F Flyash with a compressive strength of 1000 psi. The Contractor shall submit the design mix for approval by the Engineer.
  3. Grout injection shall be initiated at the surface of the bedrock and retracted to the top of the relative injection port. Total injection pressures shall not exceed 100 psi.
  4. All grouting procedures shall be performed to eliminate all voids beneath the existing foundation and shall extend to a minimum 2-4 feet horizontal distance beyond the exterior dimensions of the existing concrete foundation as shown on Section B-23 on Sheet 23.
  5. It is the intention of this procedure to cement the underlying alluvial material between the existing foundation and bedrock so that minimal settlement from increased loading would occur. Injection rates and pressures must be recorded to assess the influx of grout into the alluvial materials. The installation of rock anchors described hereafter will be an indication of the success of grouting operations. If, during drilling operations, it is apparent that the initial grouting procedure was unsuccessful, then the Contractor shall regrout the deficient area to the satisfaction of the Engineer.


- Rock Anchor Installation:
6. After grouting is completed and the grout has reached a compressive strength of 1000 psi, the Contractor shall prepare 12 each, 1 1/2 inch diameter holes at the spacing shown below for the installation of 1" diameter rock anchors.
  7. Rock anchors and complete installation procedures shall be by DYWIDAG SYSTEMS INTERNATIONAL or approved equal.
  8. Rock anchors shall be 1-inch diameter, prestressing steel according to ASTM A722, and shall be installed to a minimum depth of 10 feet into the underlying bedrock. Resin anchoring material shall be selected for use in saturated/inundated conditions, and shall fully encapsulate the steel anchor from bottom to top prior to prestressing.
  9. A 6" x 6" x 1 1/4" steel plate and associated washer and nut specifically designed for this procedure must be installed as required by the manufacturer and prestressed to 40% of the ultimate strength of the steel anchor after the resin has fully set.
  10. The steel anchor, plate, washer, and nut shall be fusion bonded epoxy coated according to ASTM 775 prior to shipment. Epoxy patch kits which will allow final coating of exposed steel surfaces must also be provided.
  11. Any deviation of the manufacturer's recommended installation procedure must be brought to the immediate attention of the Engineer for approval.

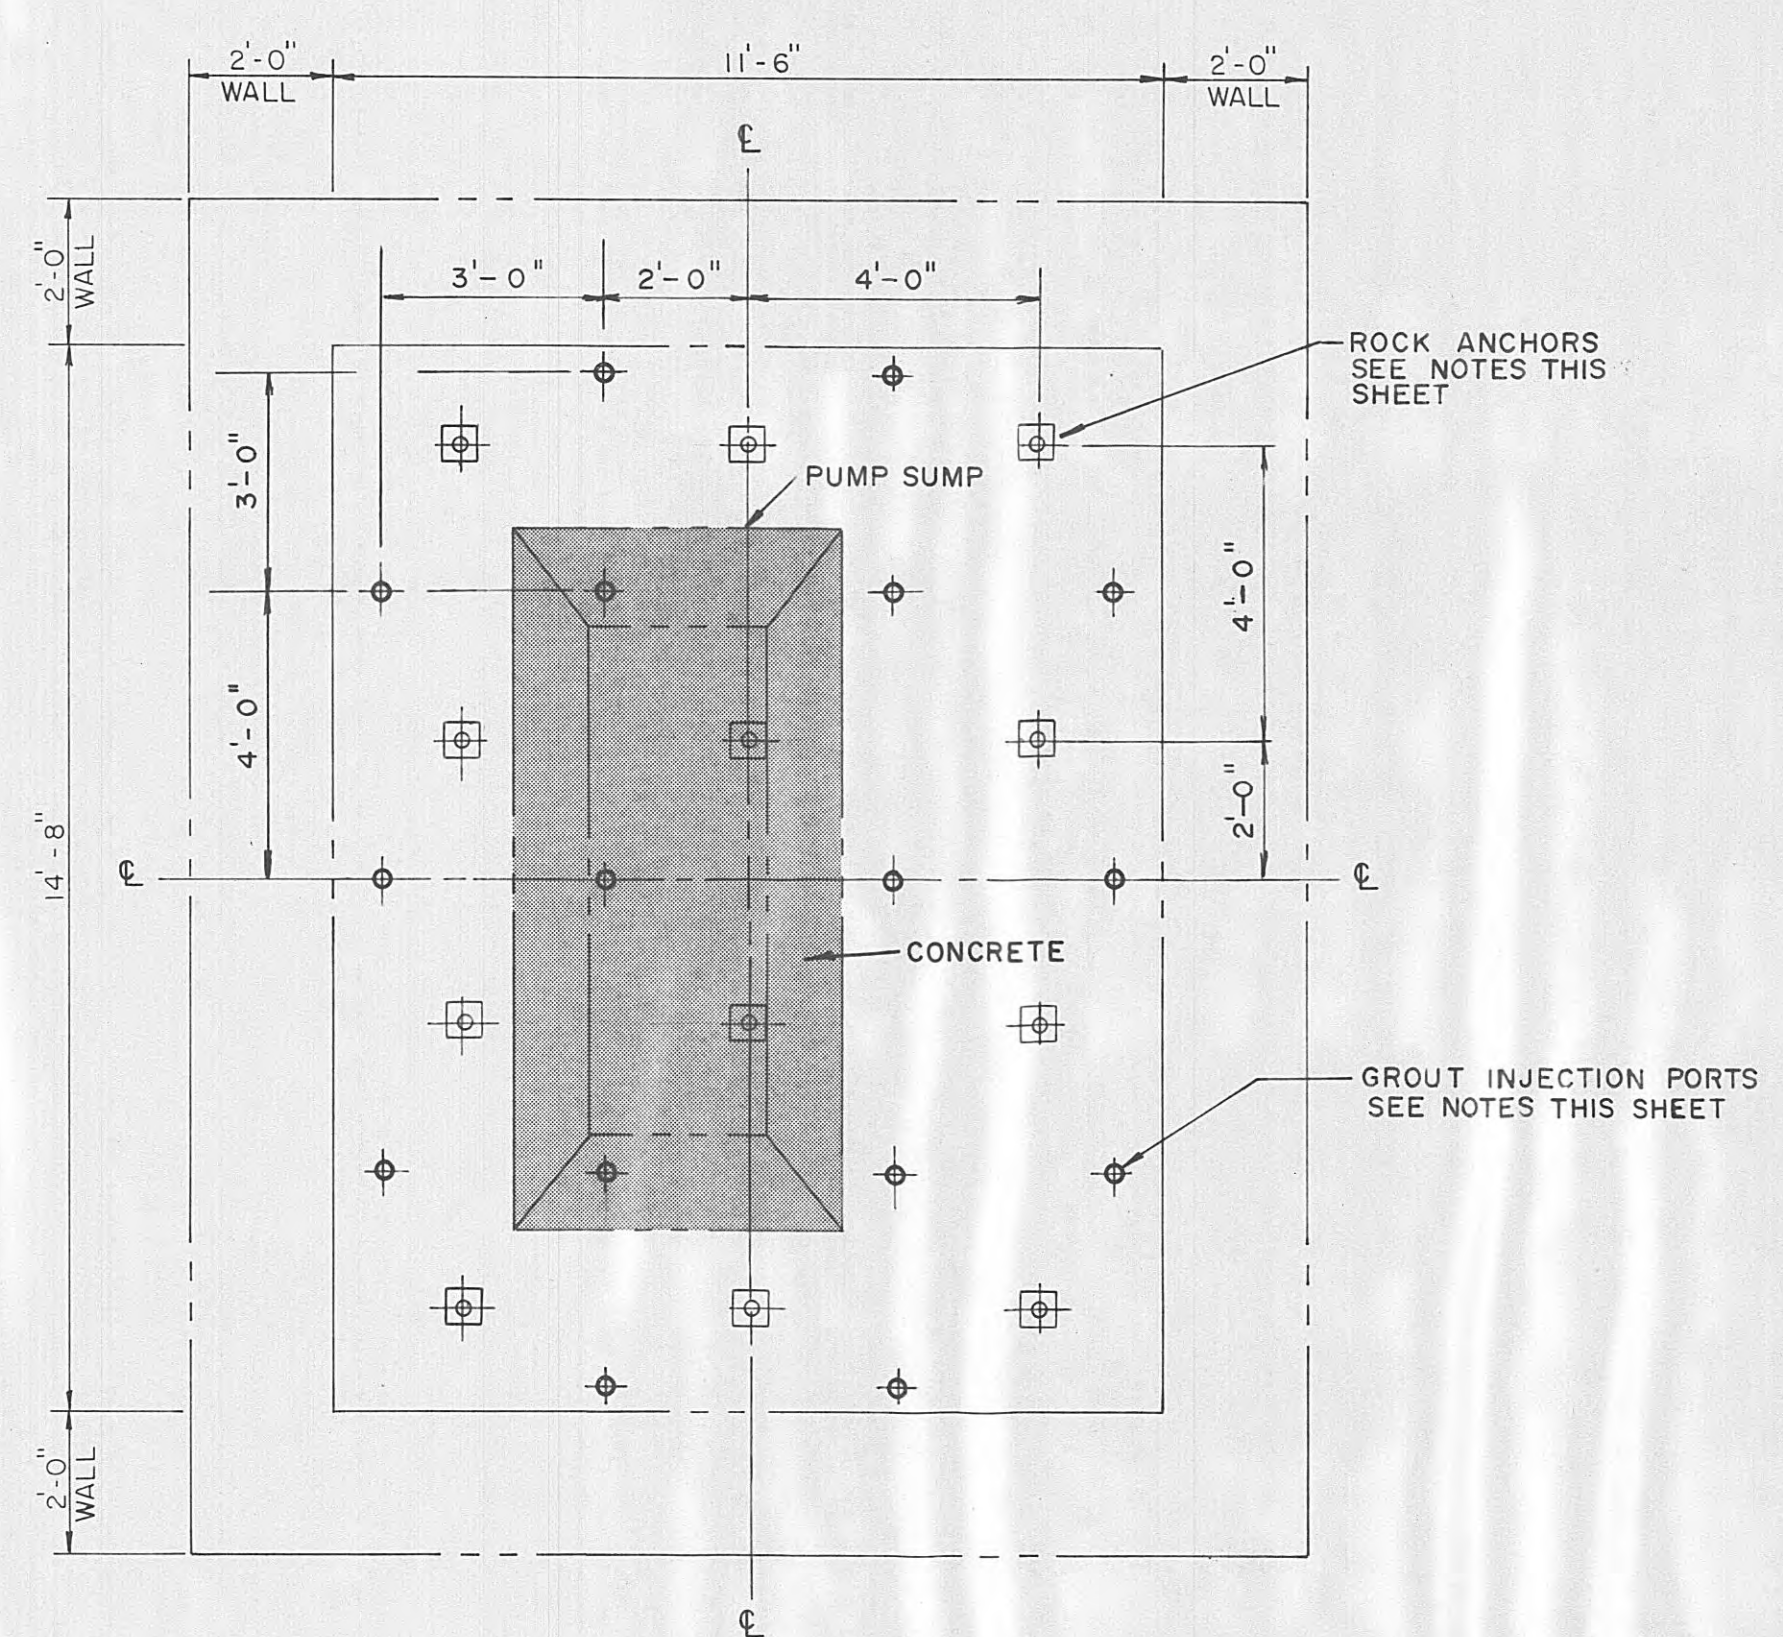

PLAN - BOTTOM ELEVATION 724.0  
SCALE: 3/8" = 1'-0"

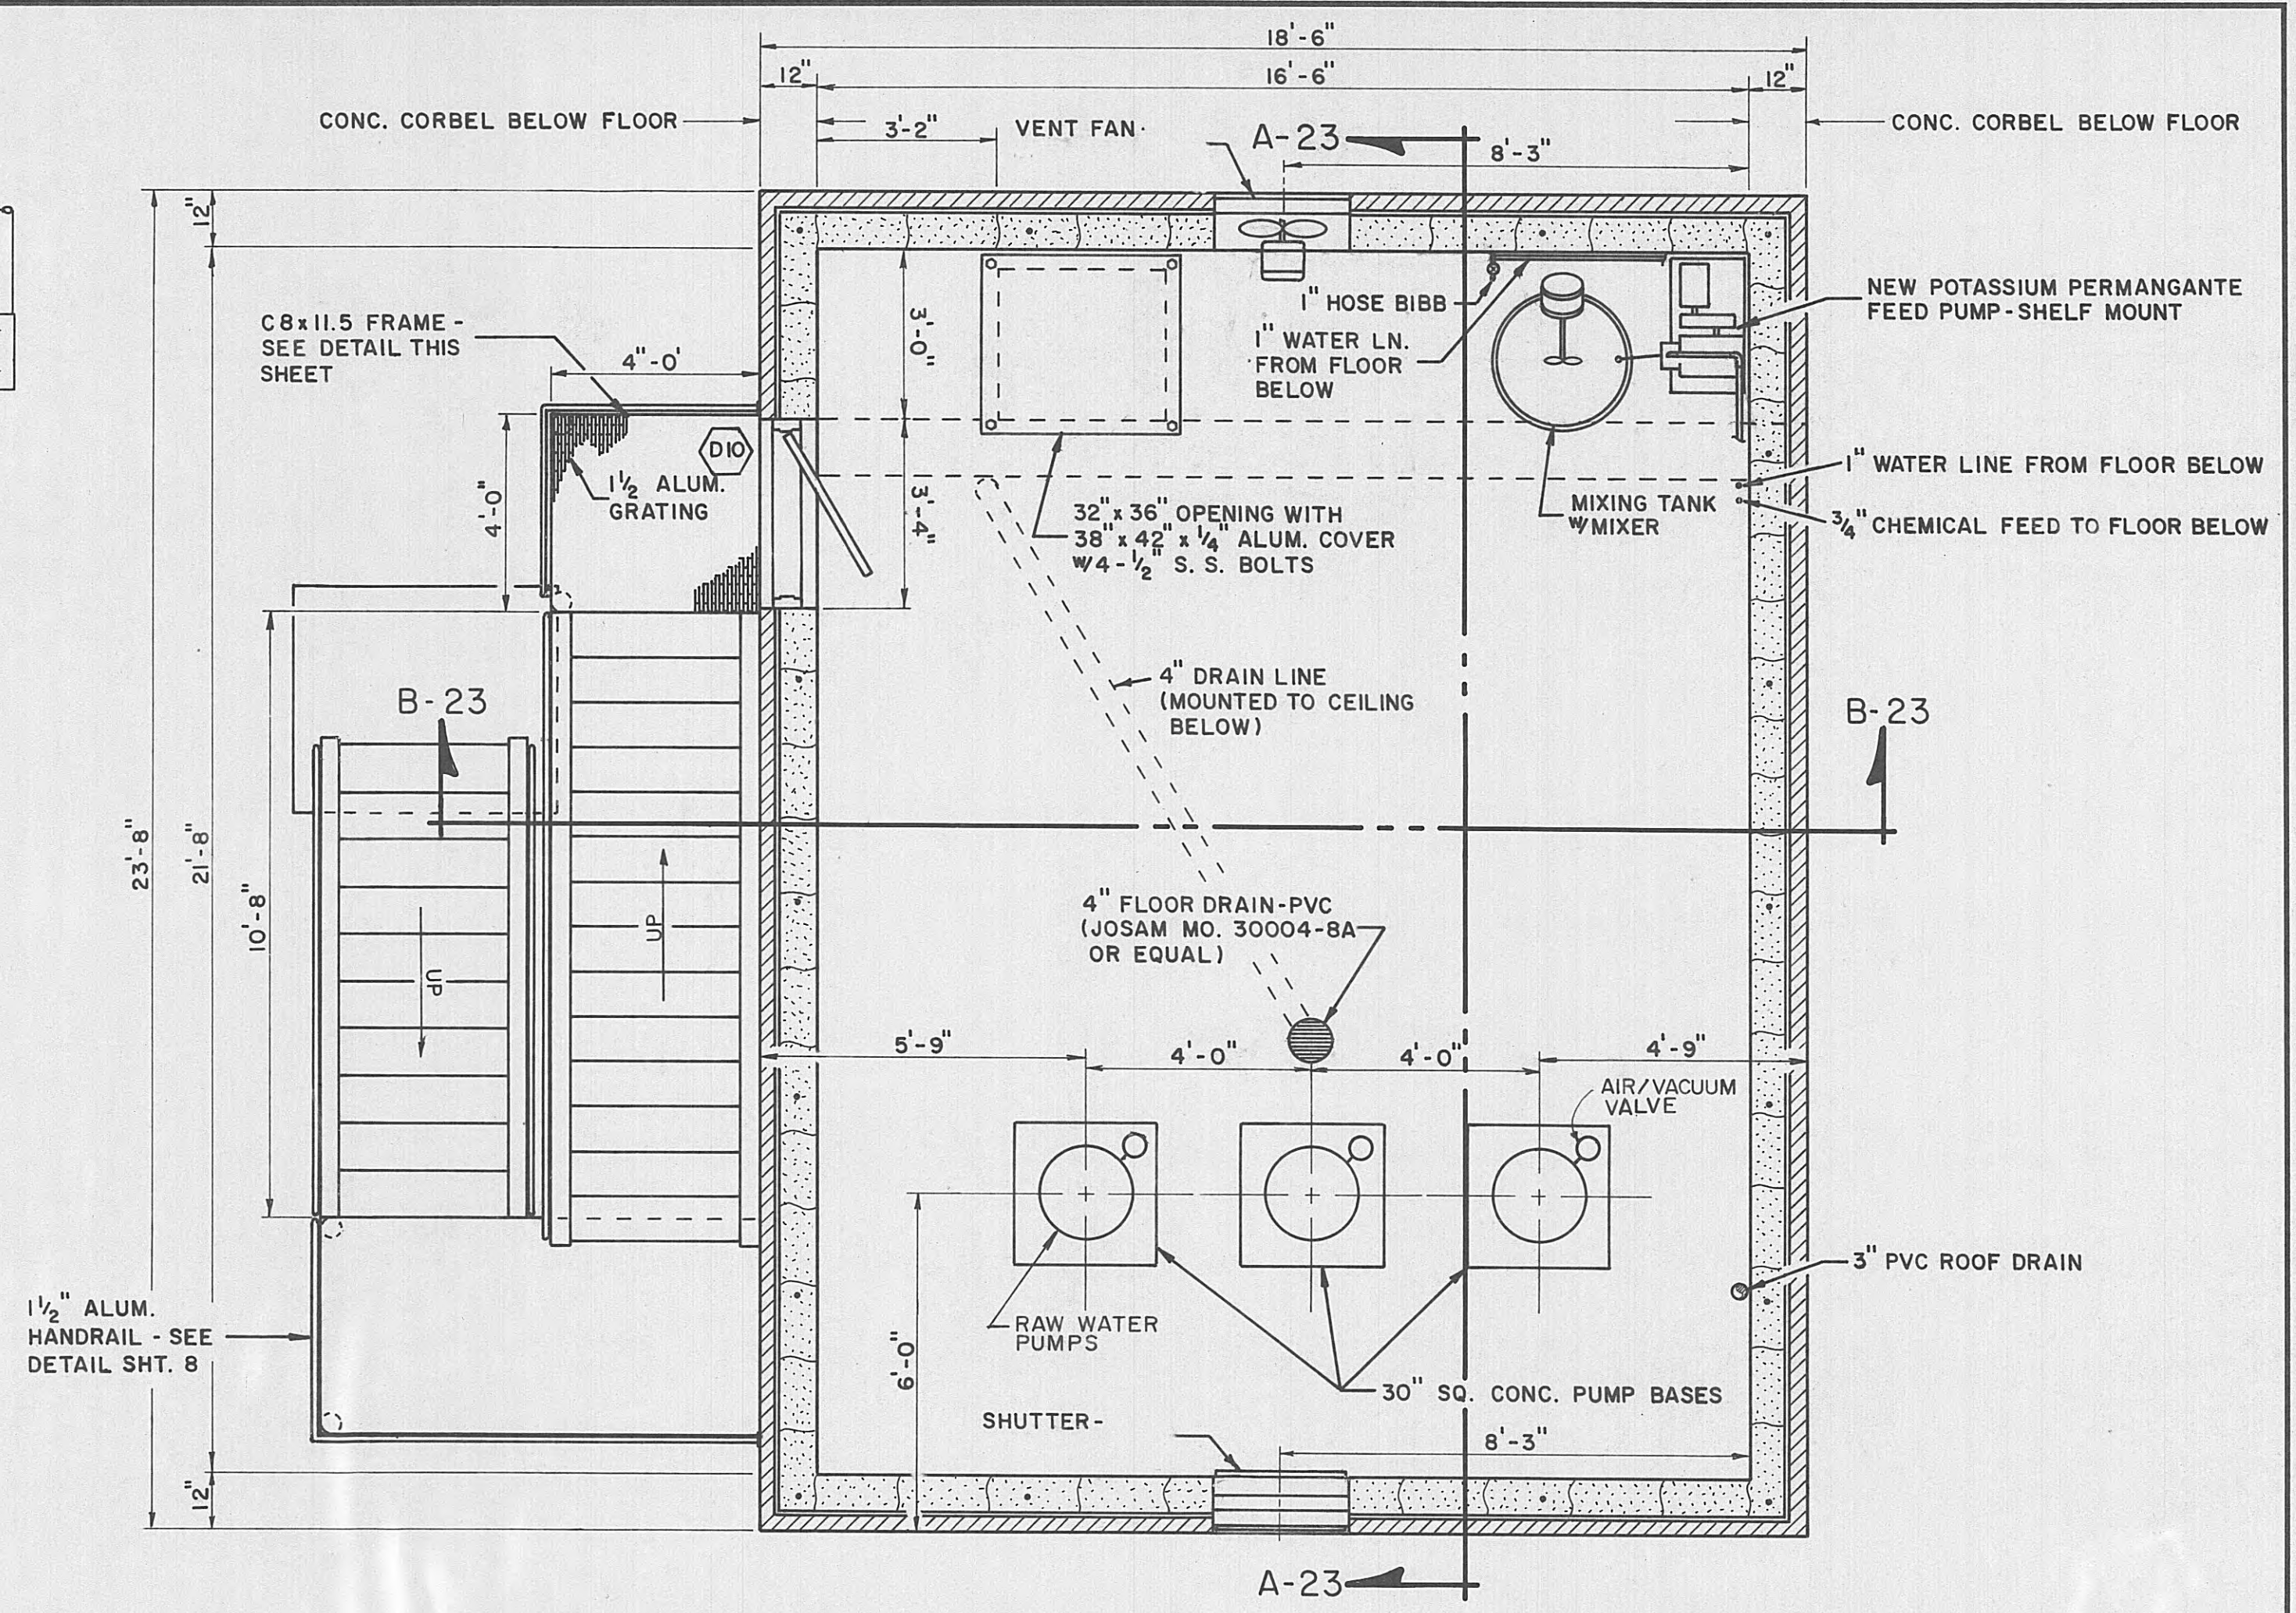

PLAN - FLOOR ELEVATION 778.06  
SCALE: 3/8" = 1'-0"

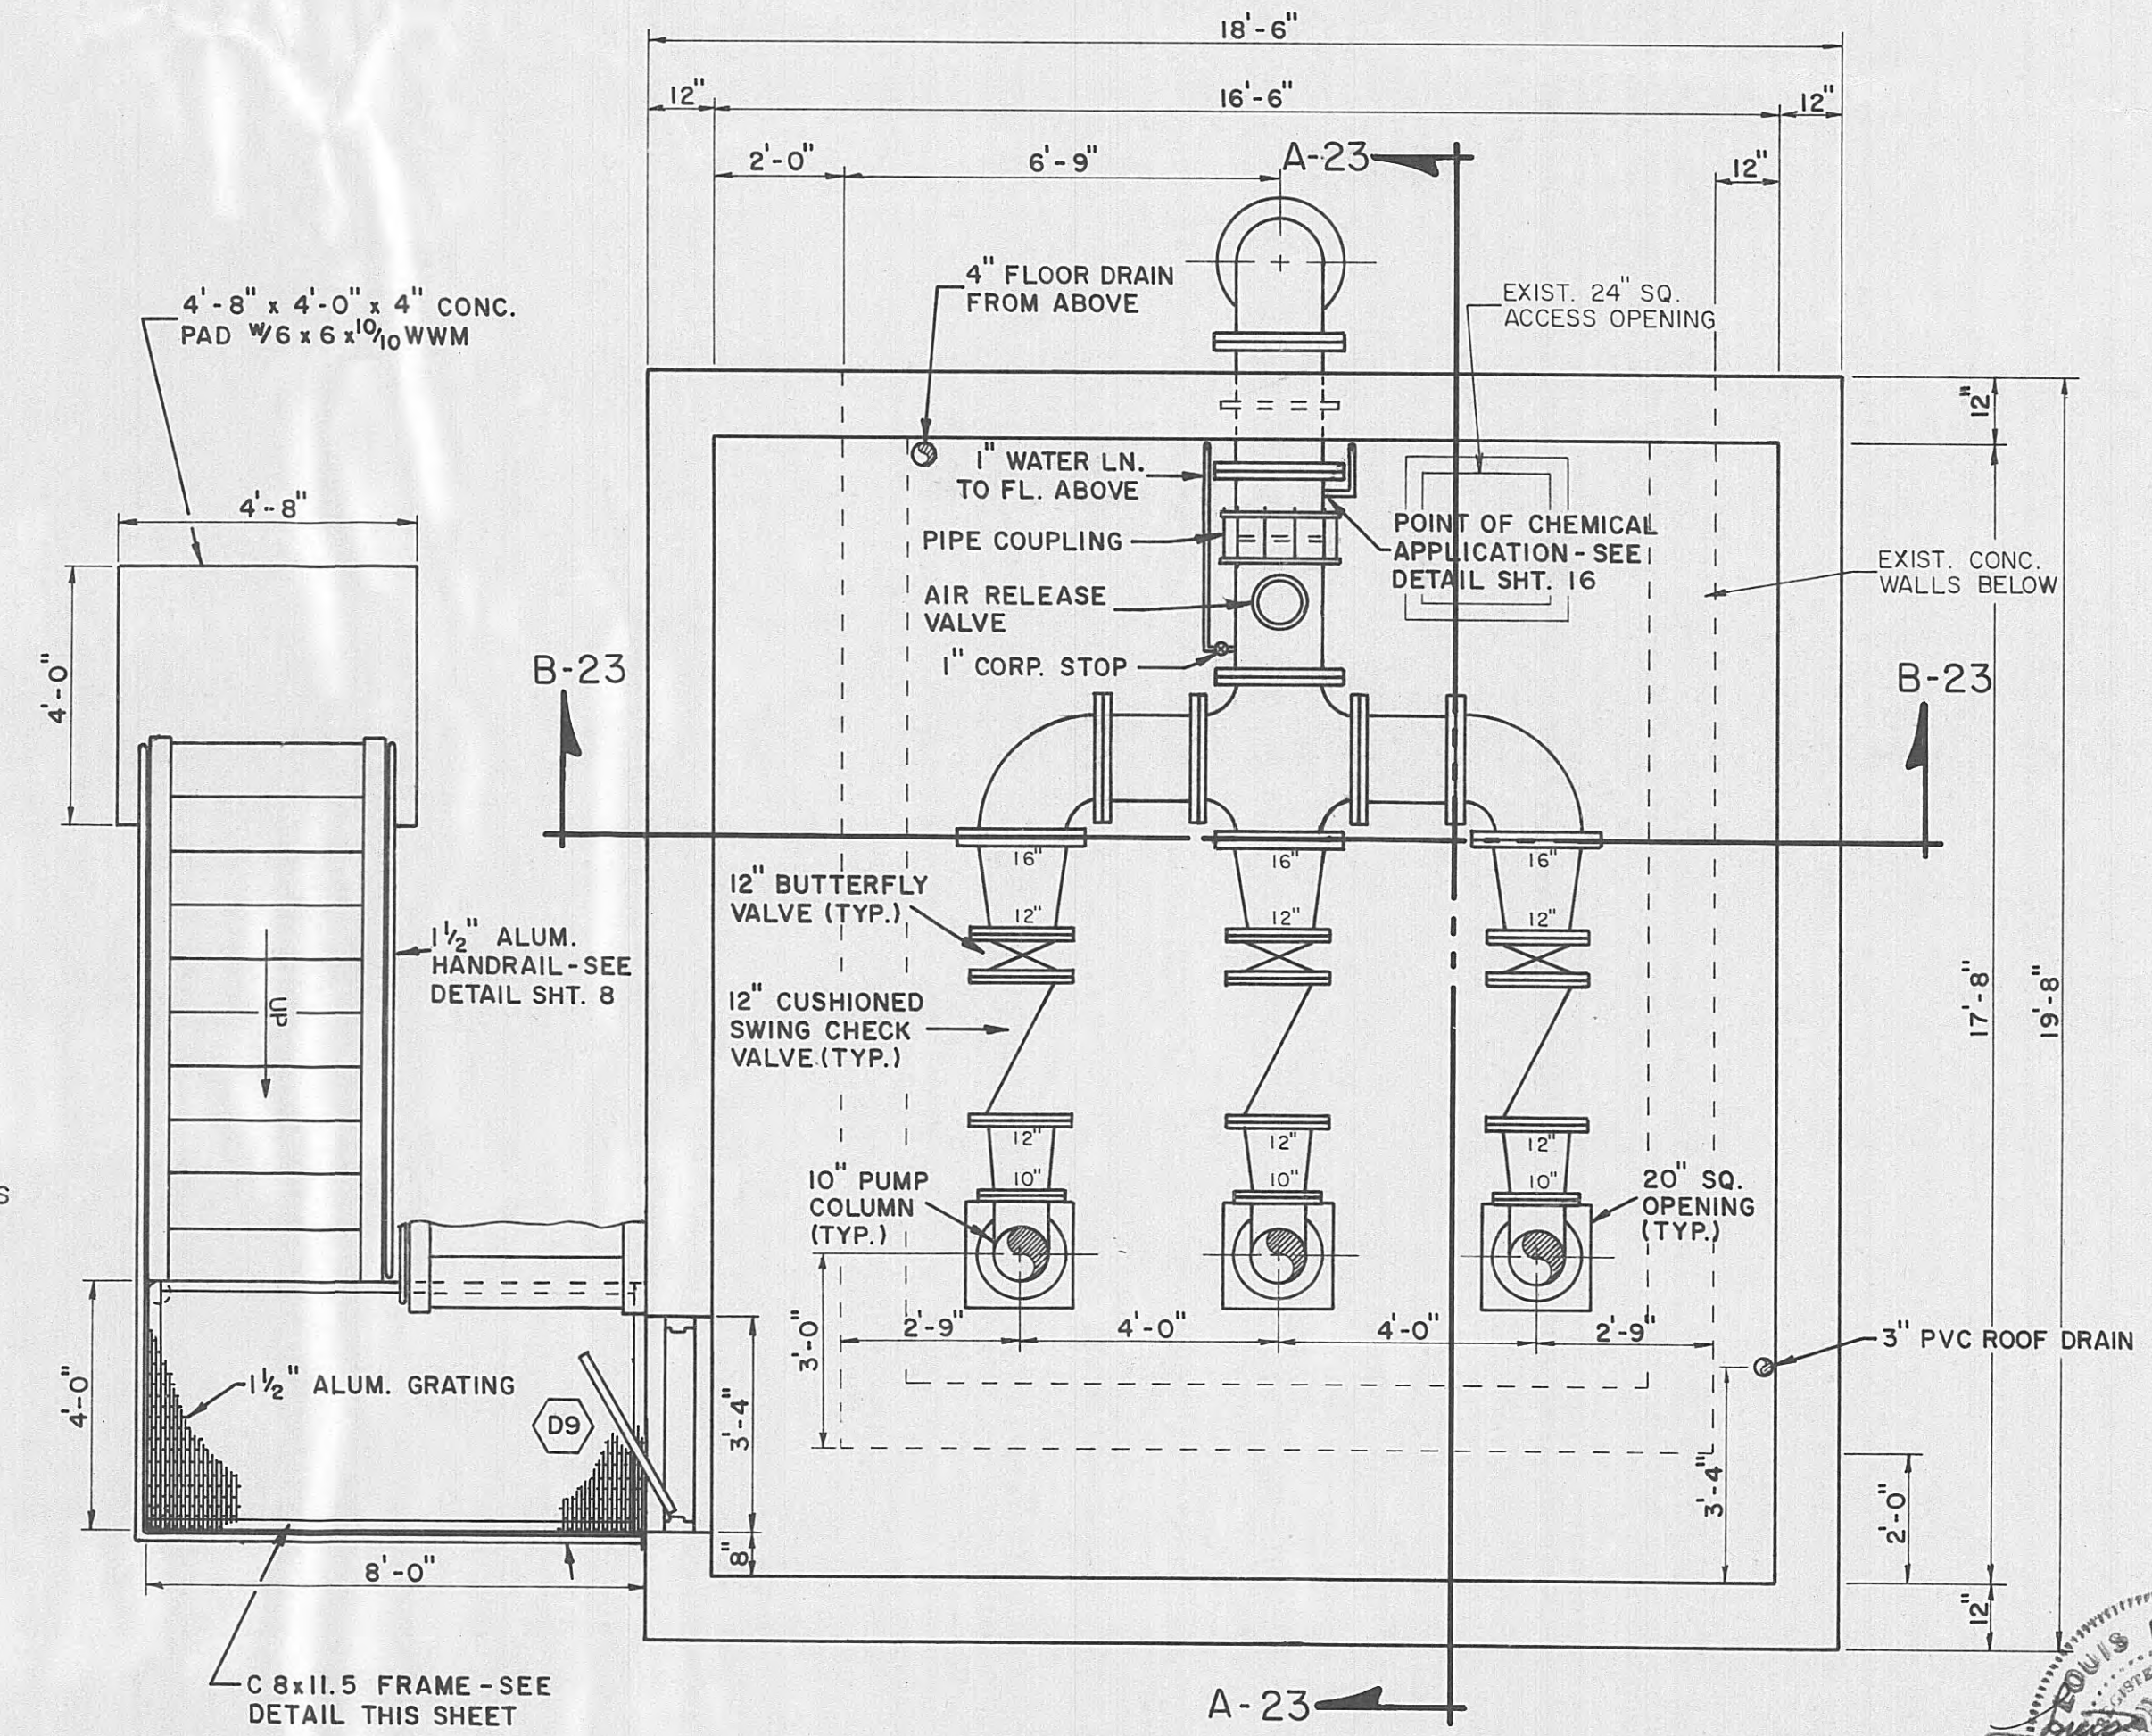


PLAN - FLOOR ELEVATION 768.35  
SCALE: 3/8" = 1'-0"

AS BUILT  
DATE: 3-20-95  
APPROVED: D.M.



ELROD • DUNSON, INC.  
CONSULTING ENGINEERS  
NASHVILLE • KNOXVILLE  
LEXINGTON, KY

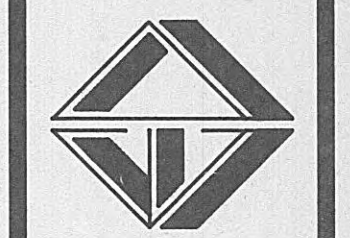


HARRIMAN, TENNESSEE  
CONTRACT W93-04  
RAW WATER PUMP BUILDING - PLAN AND DETAILS

REVISIONS


DESIGNED: L. E. R.  
DRAWN: D. G. R., D. M.  
CHECKED: L. E. R.  
DATE: MARCH, 1993  
SCALE: AS NOTED  
PROJ. NO. 0592

SHEET 22  
OF 36




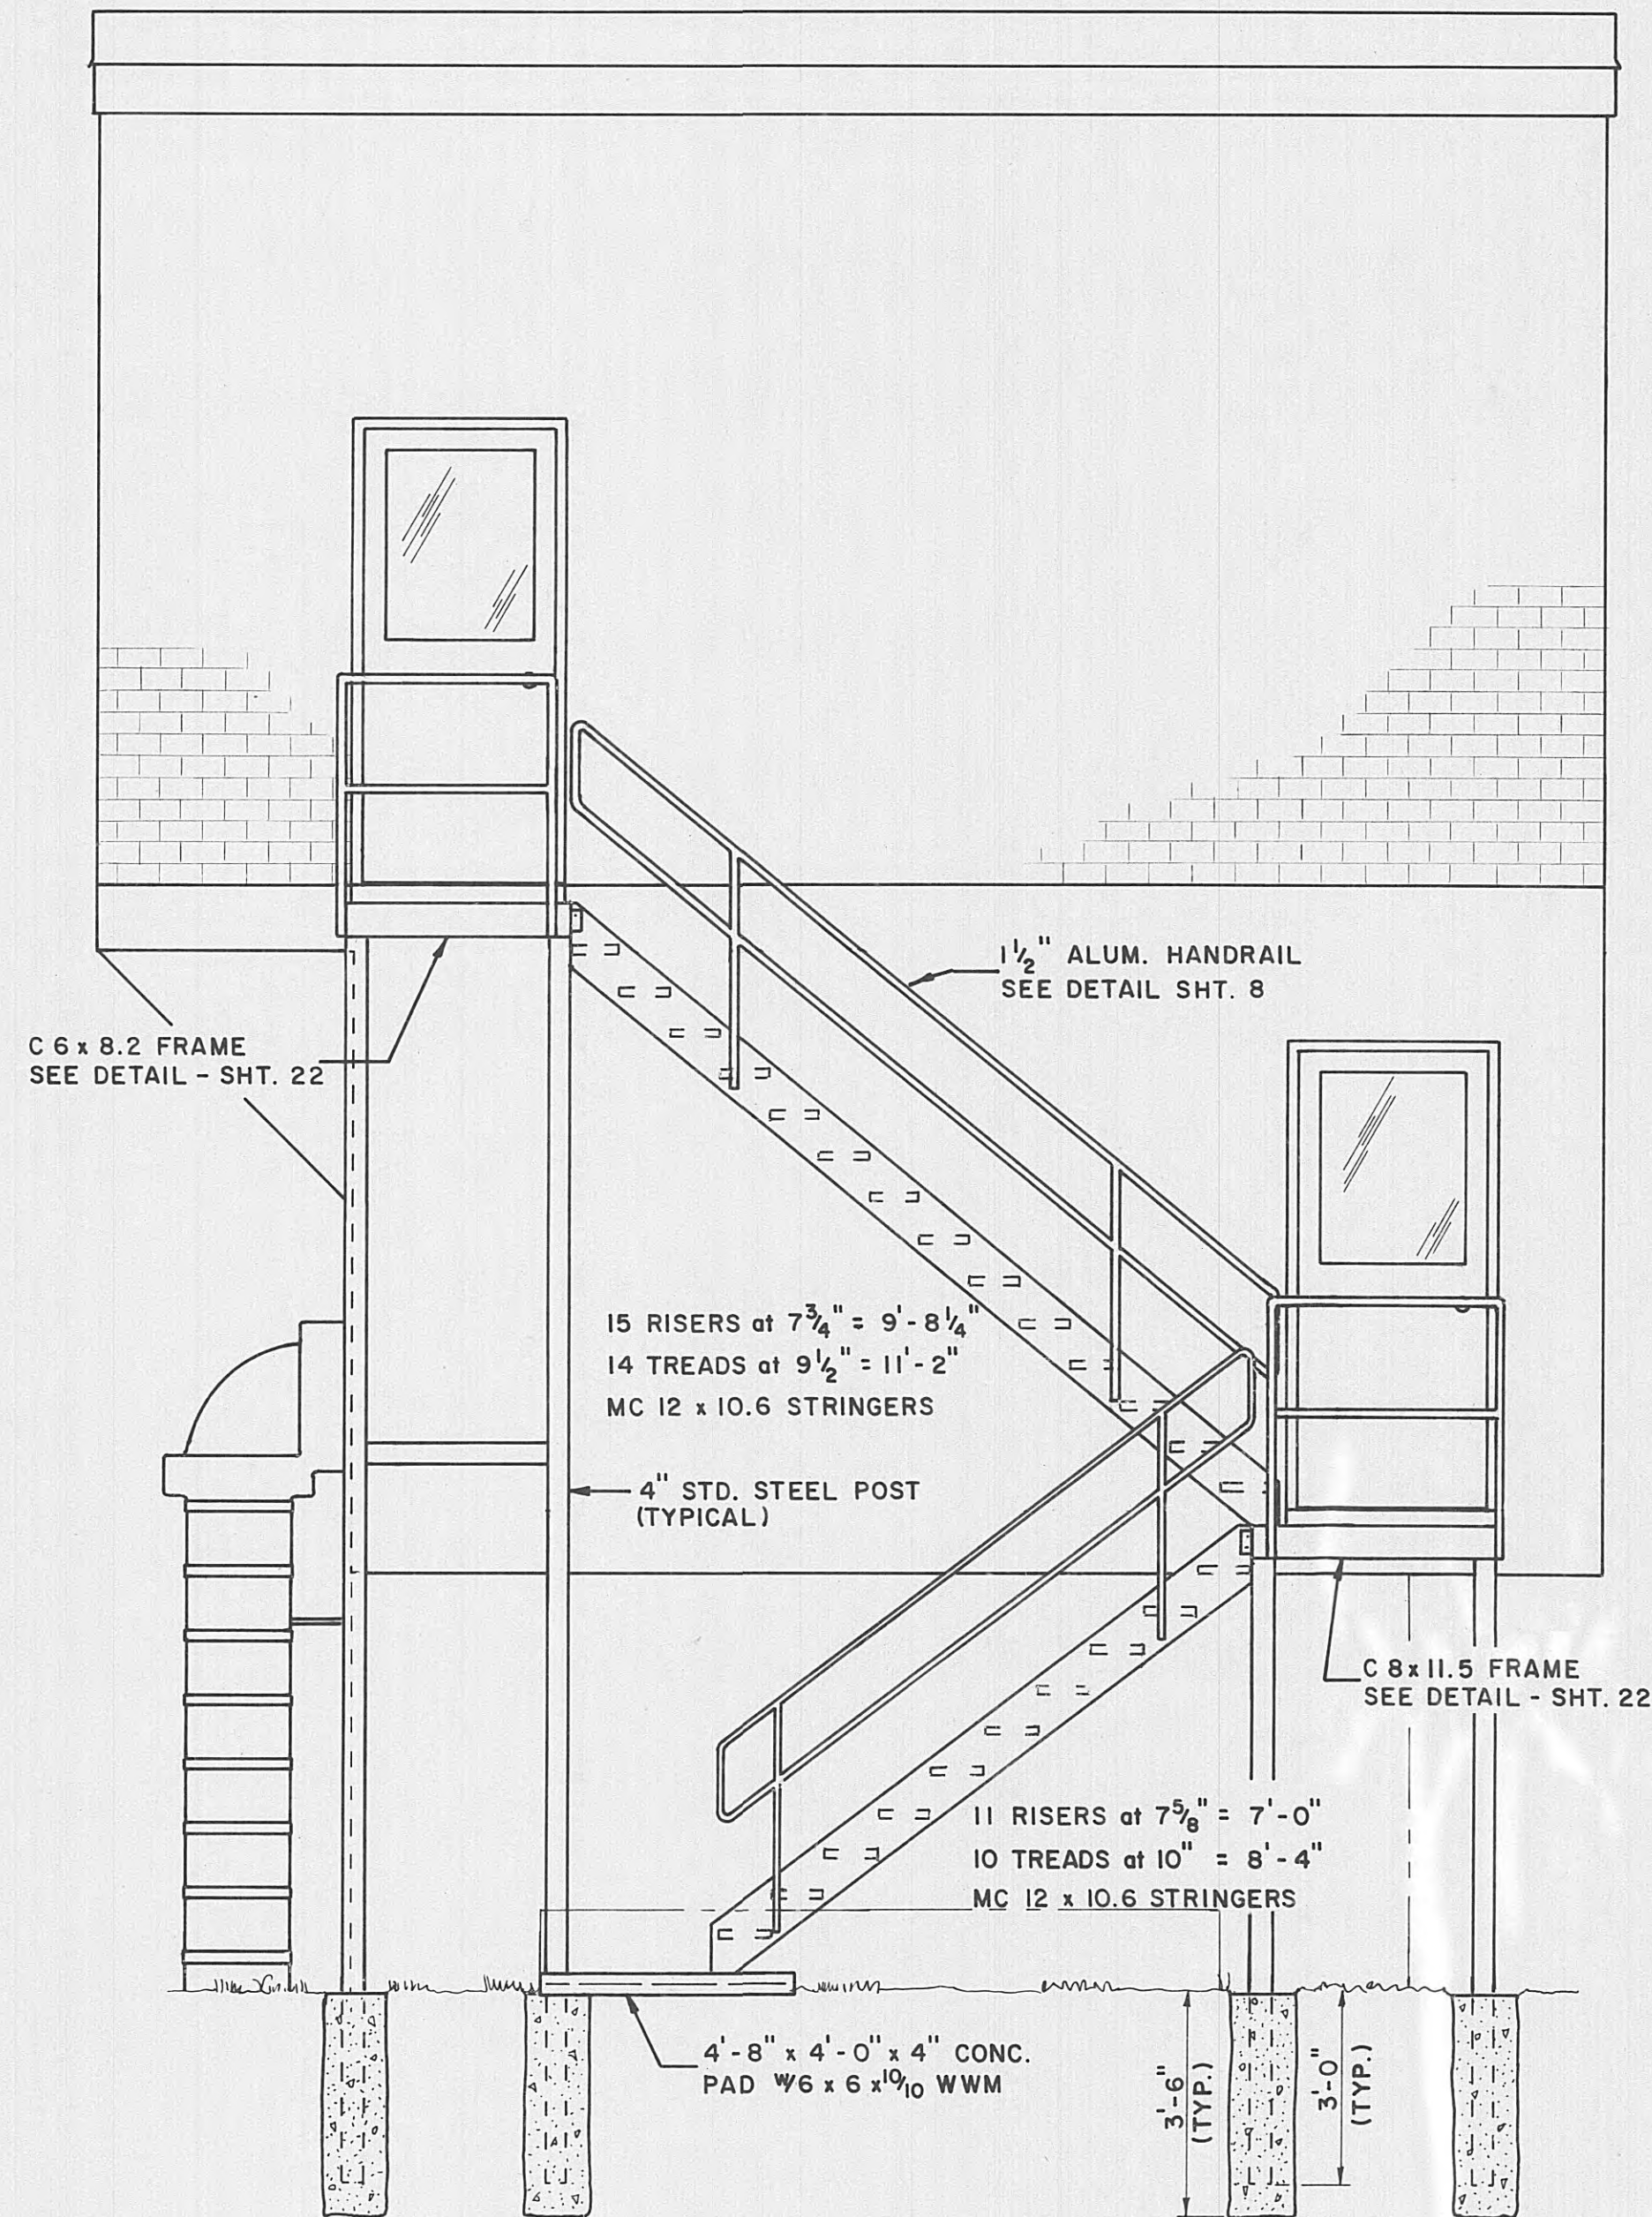

ELEVATION - RAW WATER INTAKE PUMP BUILDING  
SCALE: 3/8" = 1'-0"

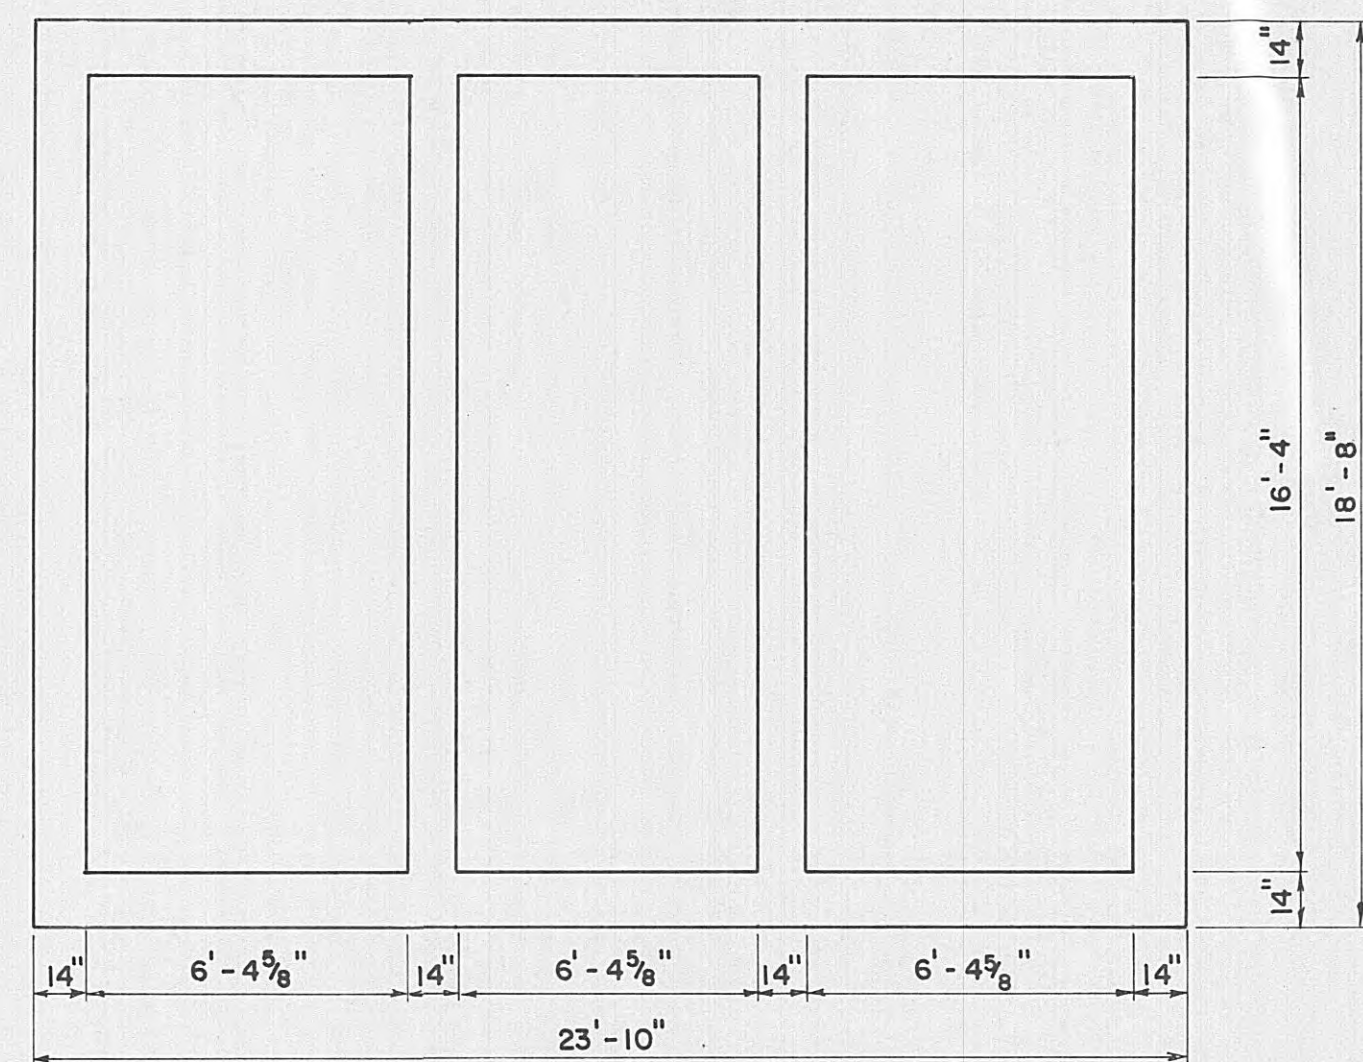



ROOF BEAM DIMENSIONS DETAIL  
N.T.S.

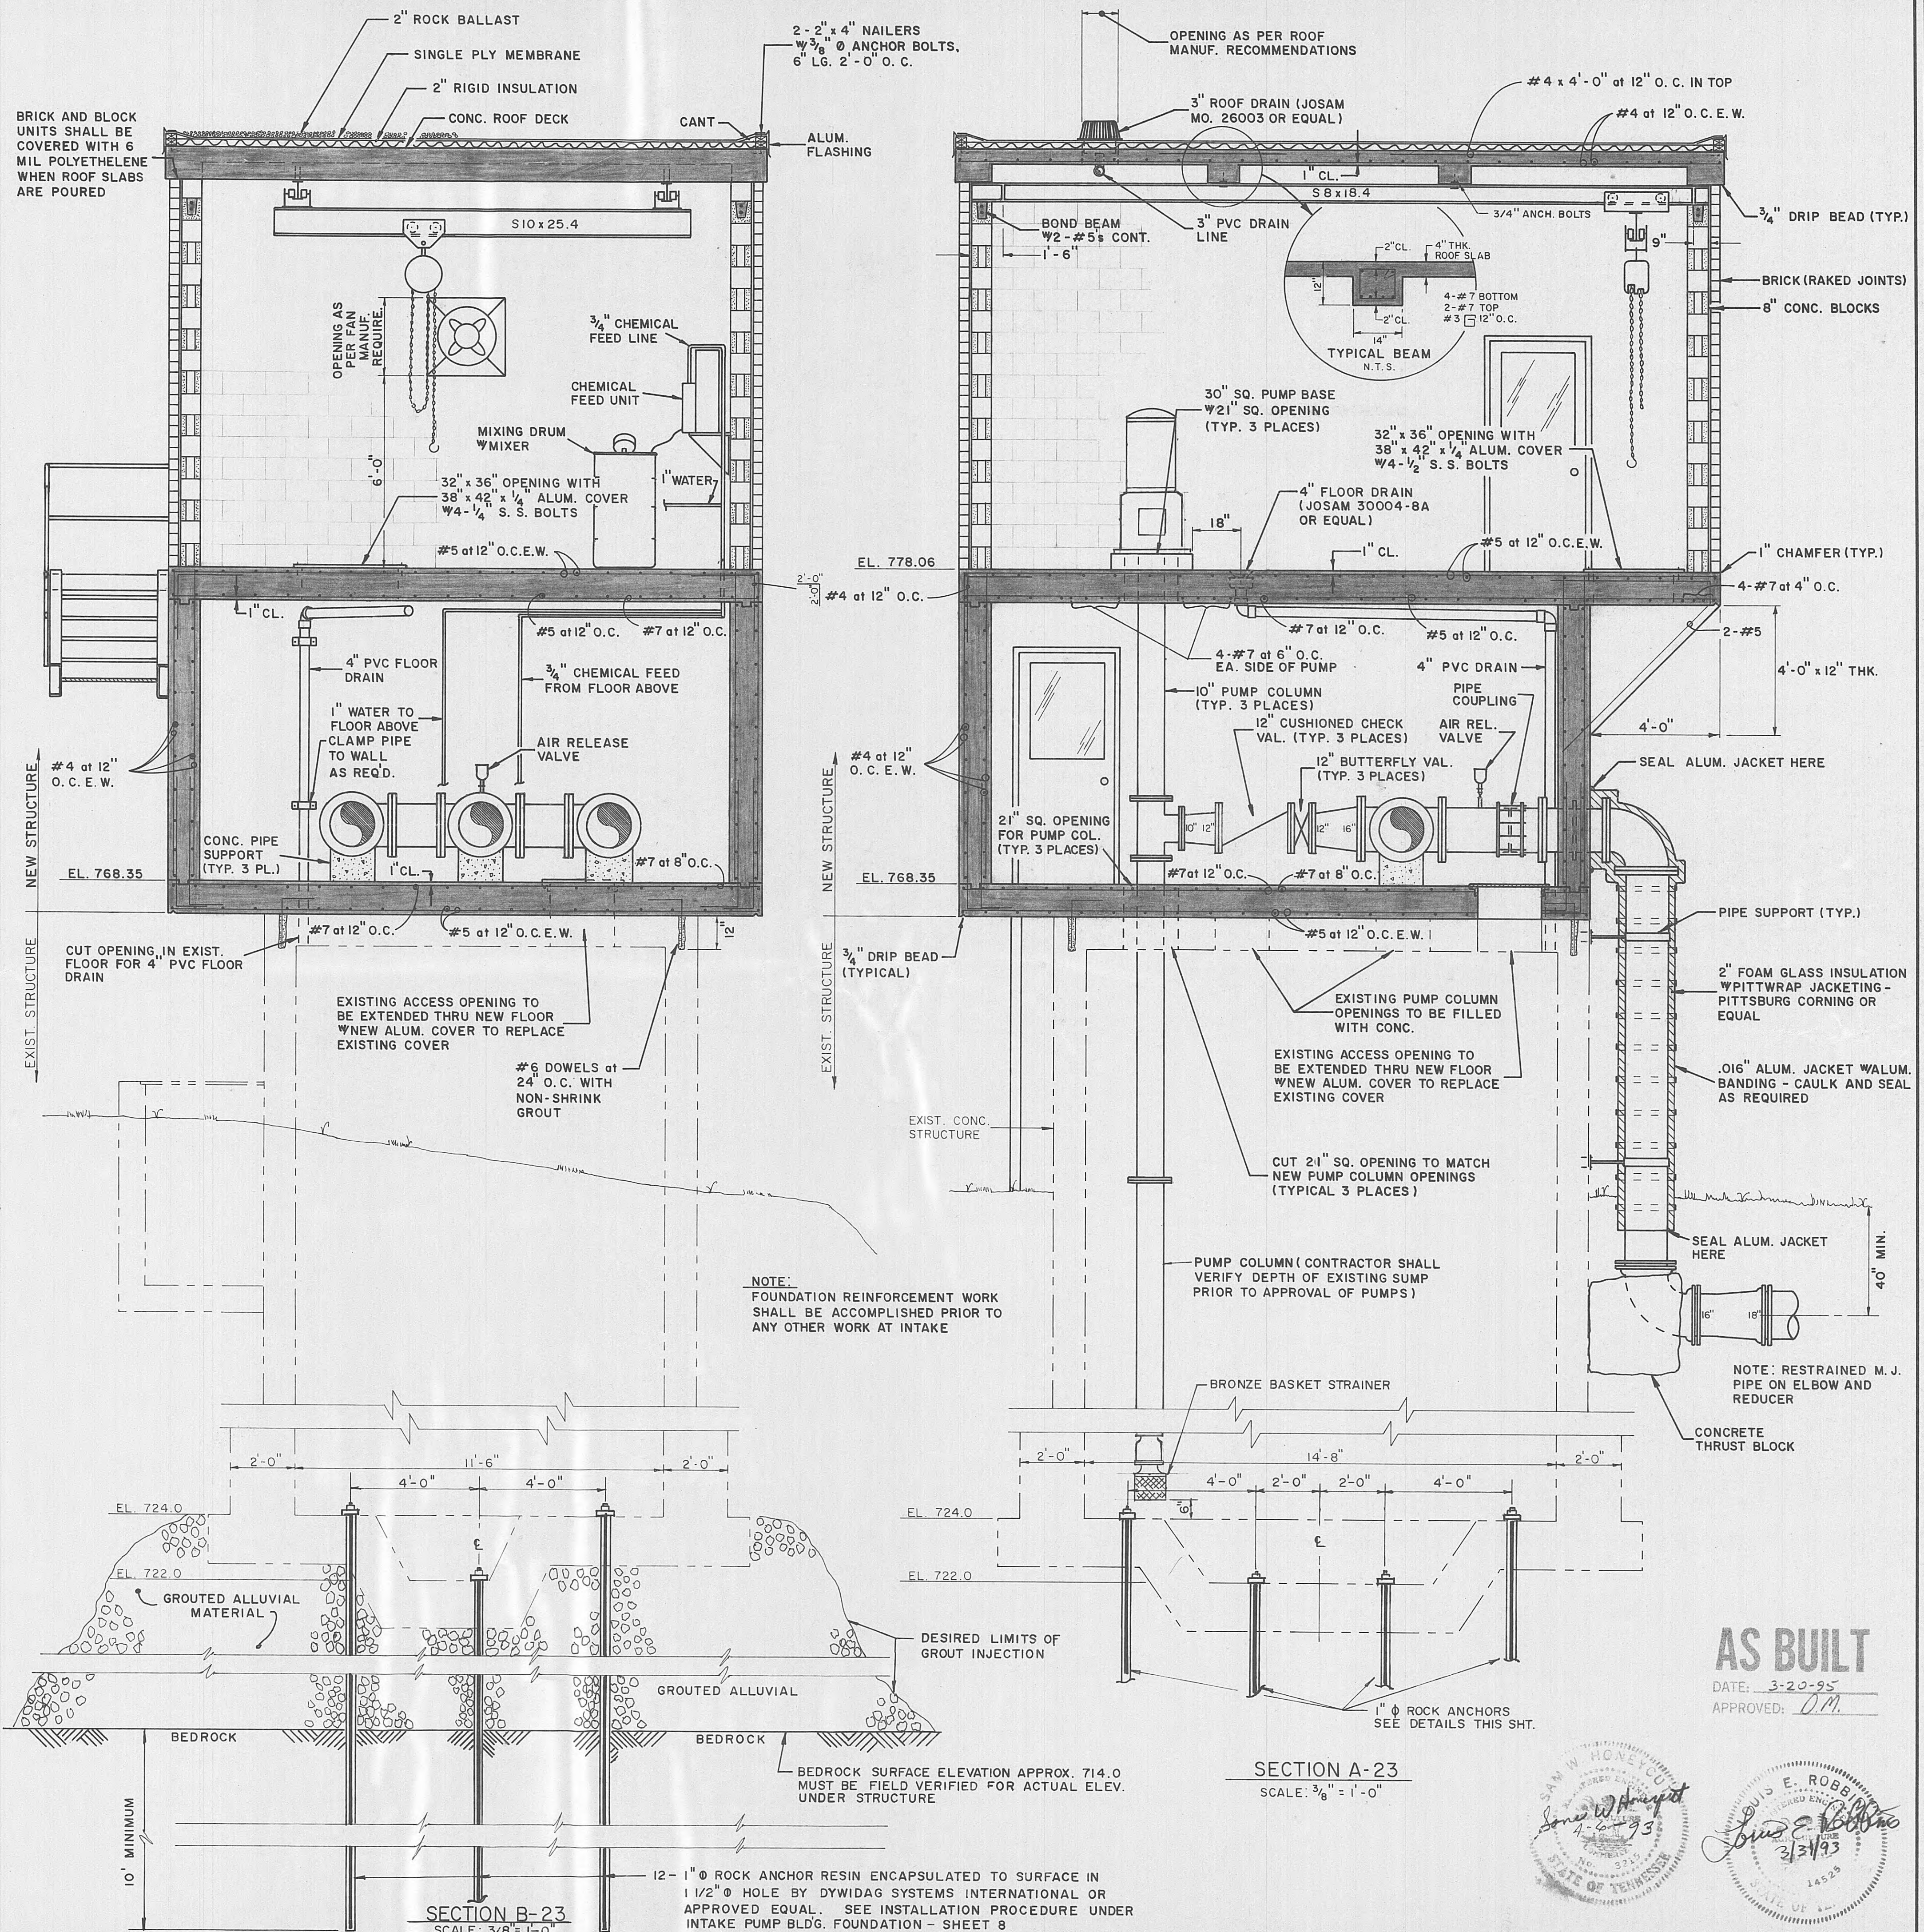

SECTION B-23  
SCALE: 3/8" = 1'-0"

SECTION A-23  
SCALE: 3/8" = 1'-0"


AS BUILT  
DATE: 3-20-95  
APPROVED: *[Signature]*

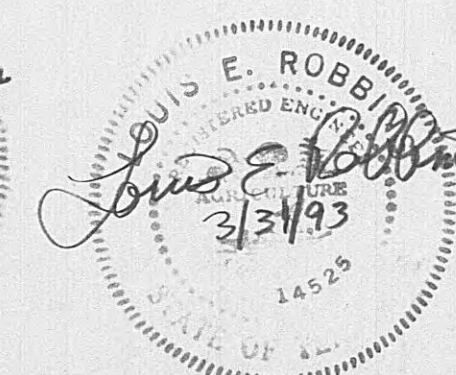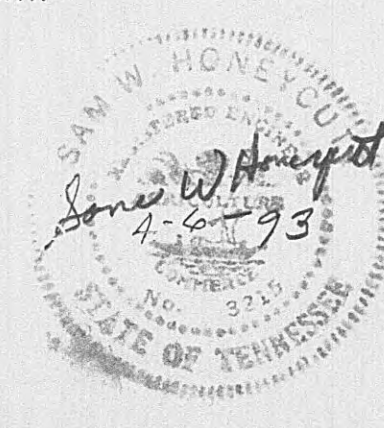



PLAN	SURVEYED	DATE
NOTE BOOK	ALIGNED	BY
NO.	RT. OF WAY CHECKED	
	STRUCTURE NOTATIONS CH'D	


PROFILE	SURVEYED	DATE
NOTE BOOK	GRADES CHECKED	BY
NO.	B. M. ± NOTED	
	STRUCTURE NOTATIONS CH'D	

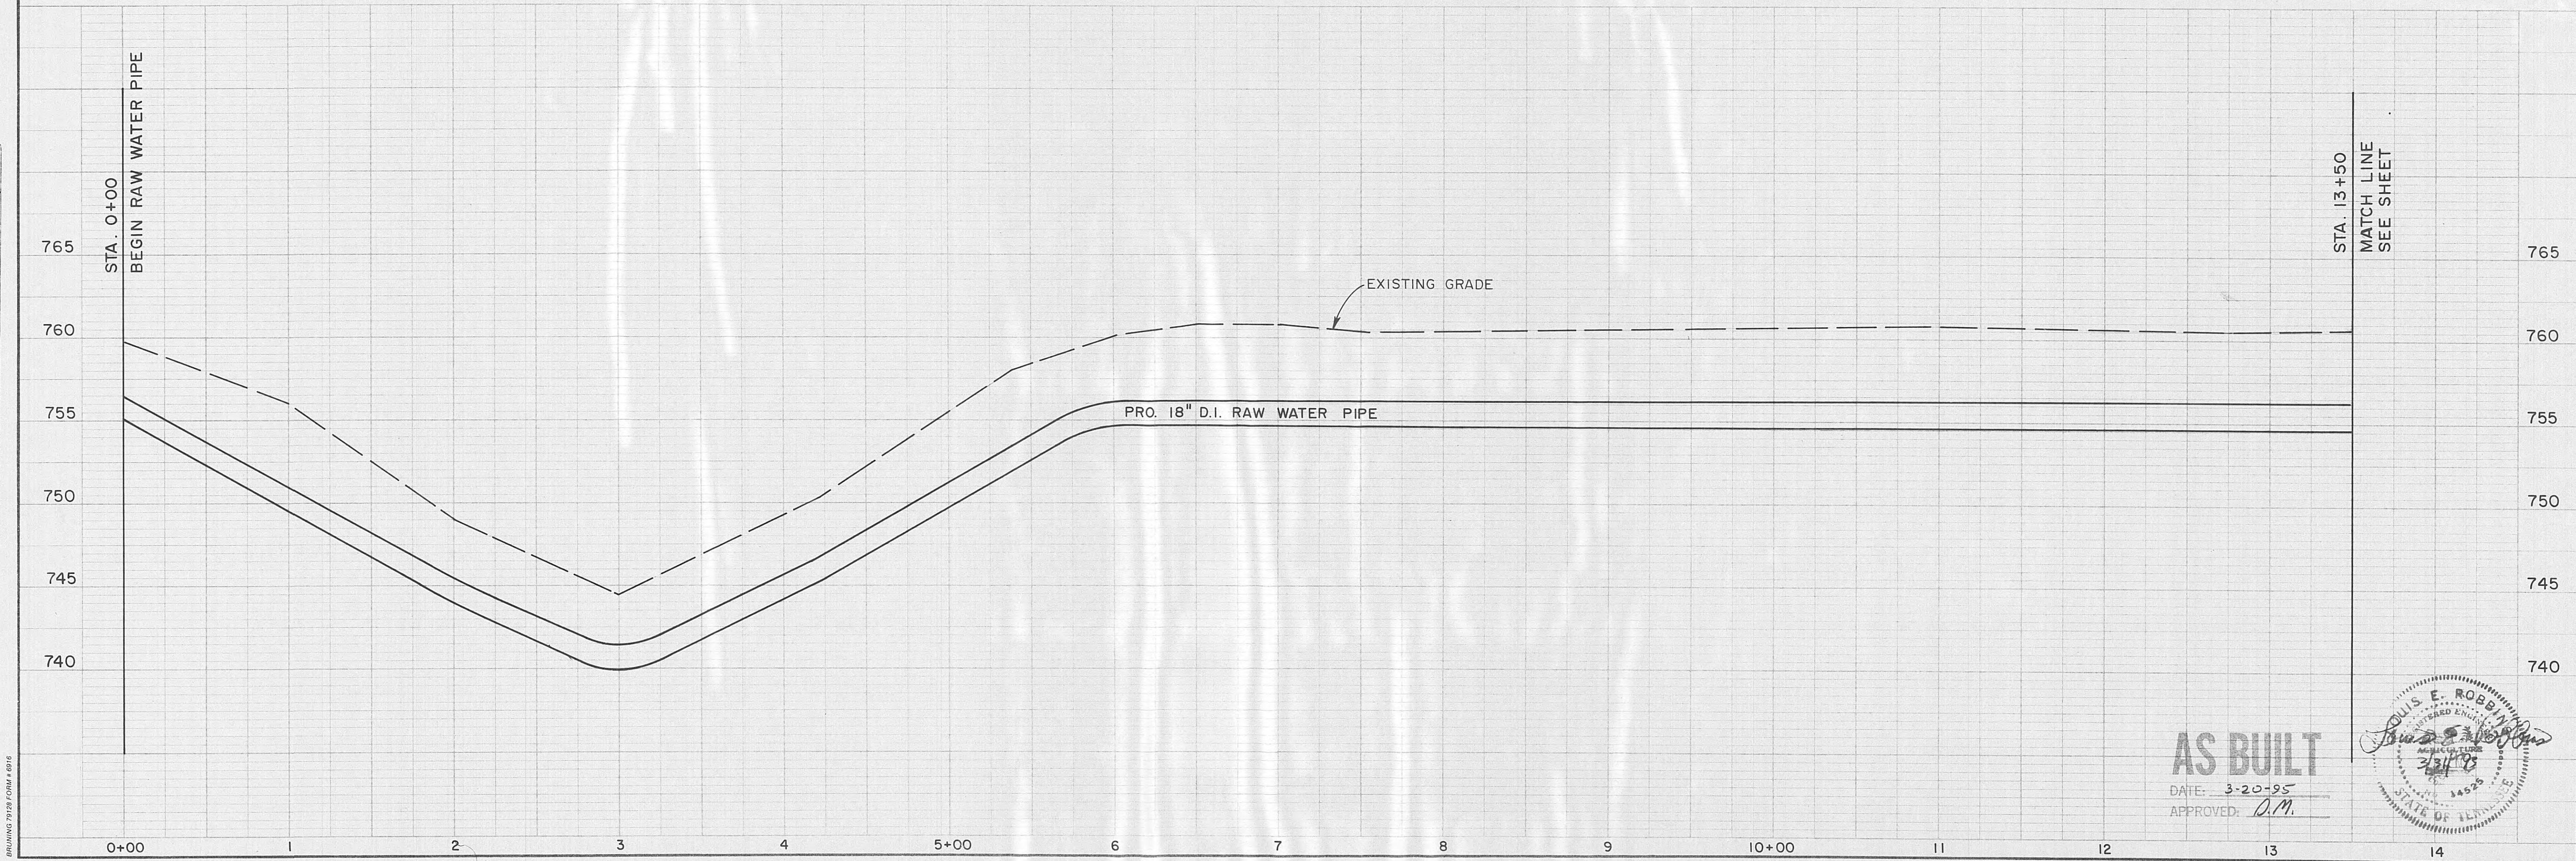

**AS BUILT**  
DATE: 3-20-95  
APPROVED: D.M.



- LEGEND**
- PROPOSED 18" D.I. RAW WATER PIPE
  - - - PROPOSED 18" D.I. FINISHED WATER
  - PROPOSED CONCRETE KICKER
  - PROPOSED GATE VALVE & BOX
  - △ CP 16 CONTROL POINT NUMBER 16
  - W.M. EXISTING WATER METER
  - W.V. EXISTING WATER VALVE
  - G.V. EXISTING GAS VALVE
  - 8" W. EXISTING WATER LINE 8" SIZE

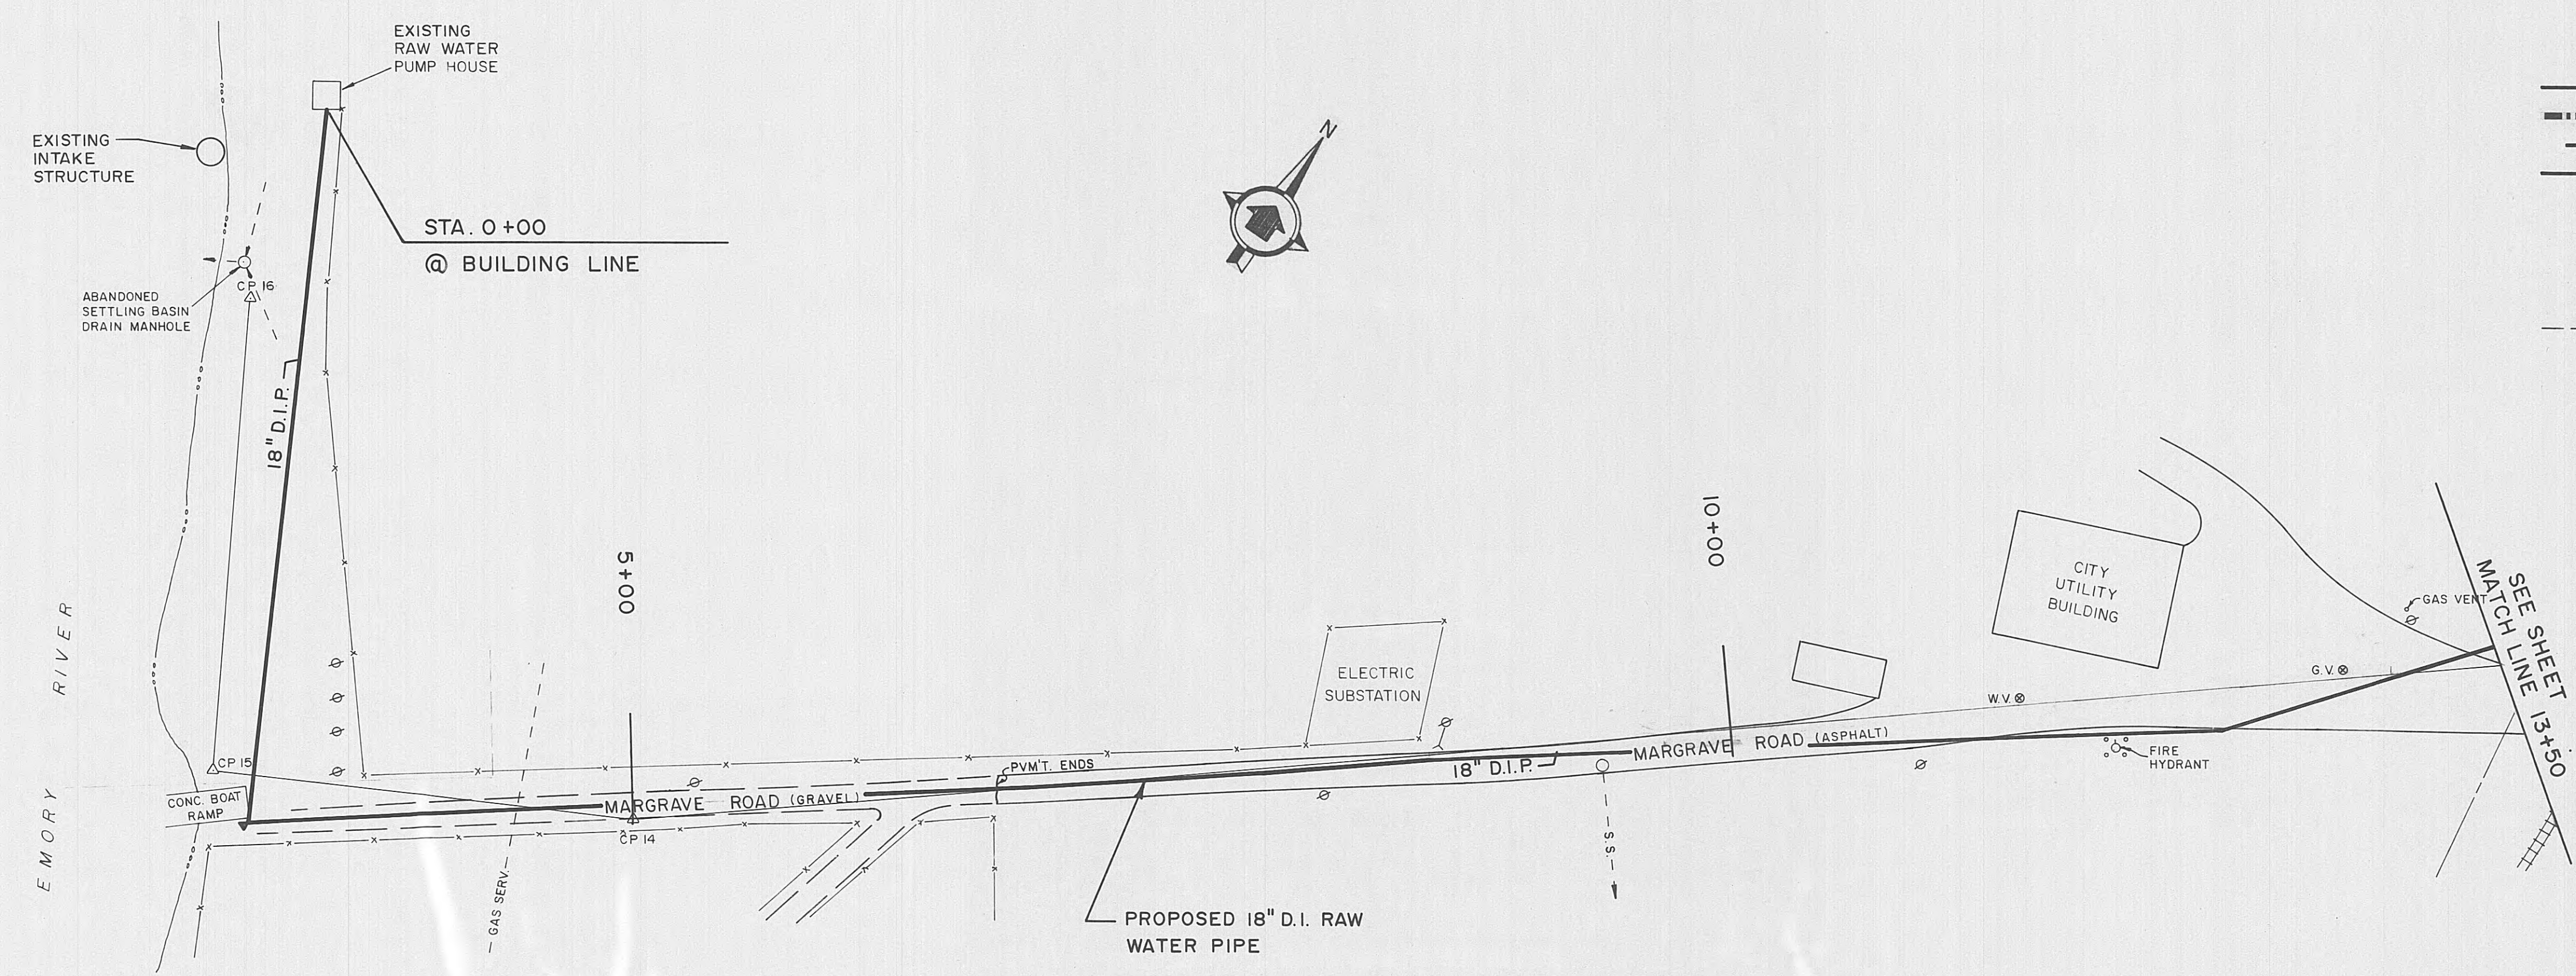

**ELROD · DUNSON, INC.**  
CONSULTING ENGINEERS  
NASHVILLE · KNOXVILLE  
LEXINGTON, KY

CONTRACT W93-04

**18" RAW WATER PIPE - STA. 0+00 TO 13+50**

DESIGNED: L. E. R.  
DRAWN: D. M.  
CHECKED: L. E. R.  
DATE: MARCH, 1993  
SCALE: HORZ. 1" = 50'  
VERT. 1" = 5'

HARRIMAN, TENNESSEE

REVISIONS



SHEET 24

OF 36




PLAN	DATE	BY
SURVEYED		
PLOTTED		
CHECKED		
NO.		

PROFILE	DATE	BY
SURVEYED		
GRADES CHECKED		
NO.		

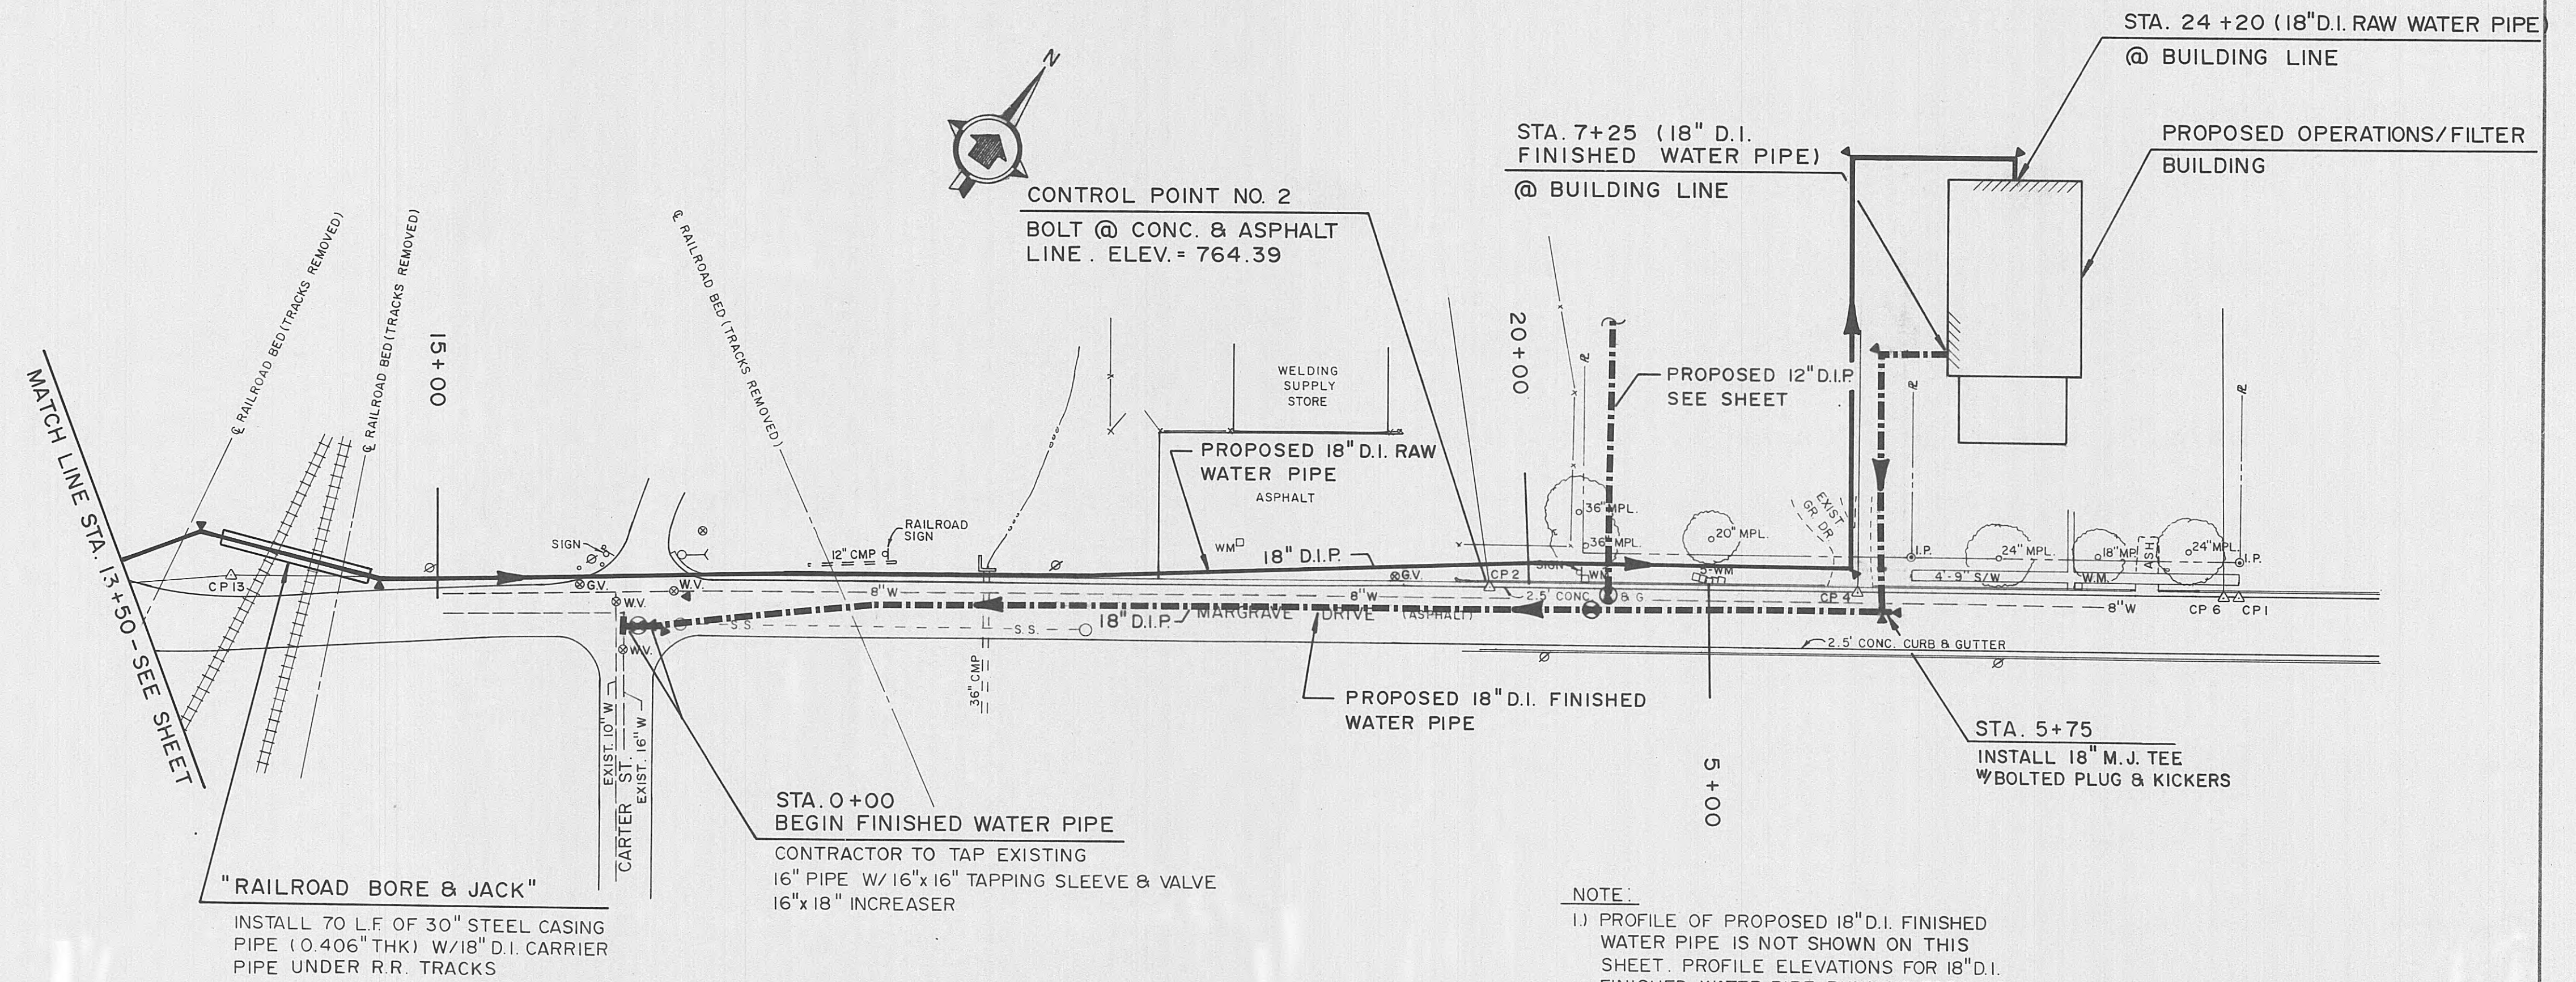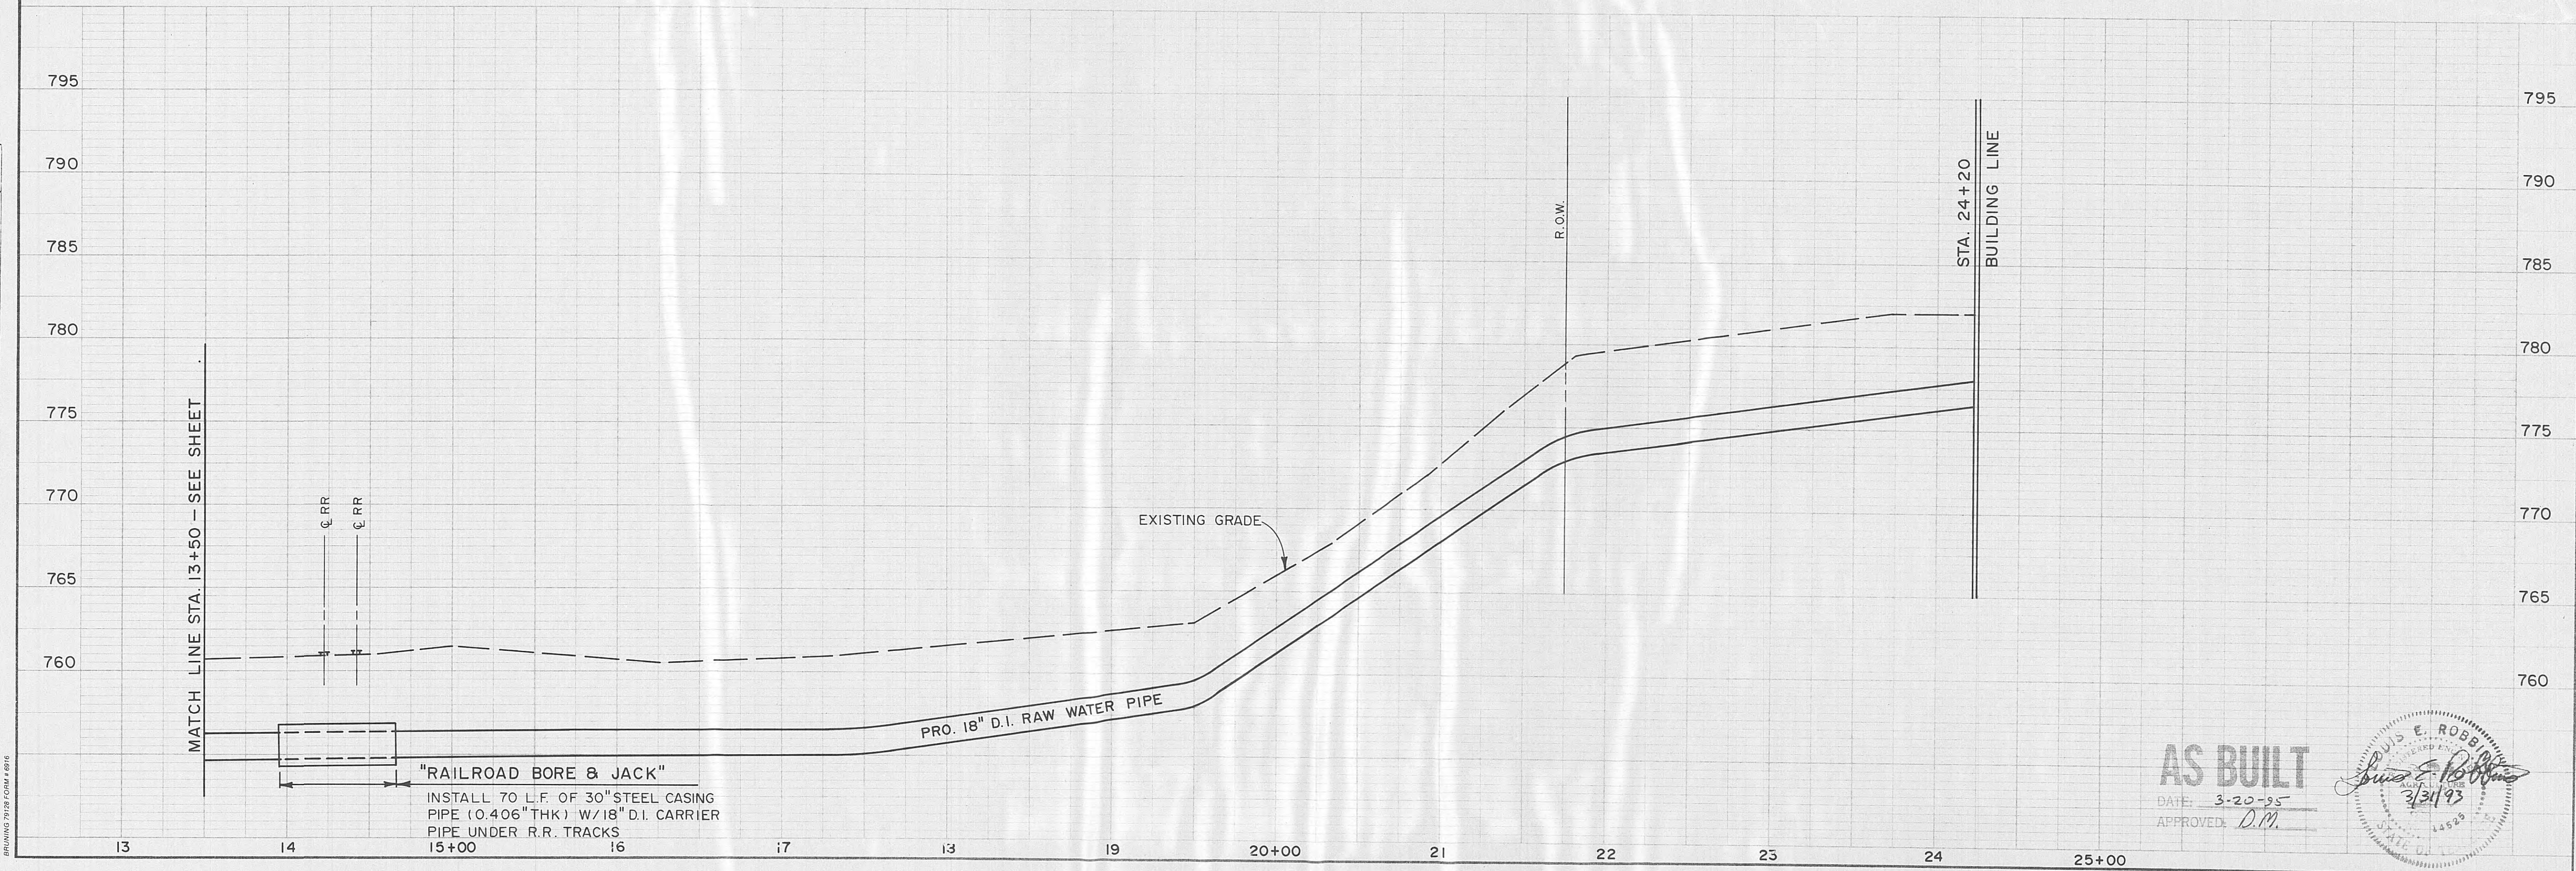

ELROD · DUNSON, INC.  
CONSULTING ENGINEERS  
NASHVILLE · KNOXVILLE  
LEXINGTON, KY

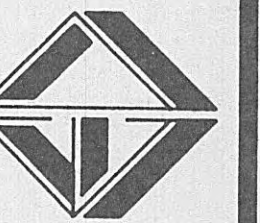

CONTRACT W93-04  
HARRIMAN, TENNESSEE  
18" RAW WATER PIPE - STA. 13+50 TO 24+20  
18" FINISHED WATER PIPE - STA. 0+00 TO 7+25


REVISIONS

DESIGNED: L. E. R.  
DRAWN: D. M.  
CHECKED: L. E. R.  
DATE: MARCH, 1993  
SCALE: HORZ. 1" = 50'  
VERT. 1" = 5'  
PROJ. NO. 0592


SHEET 25

OF 36



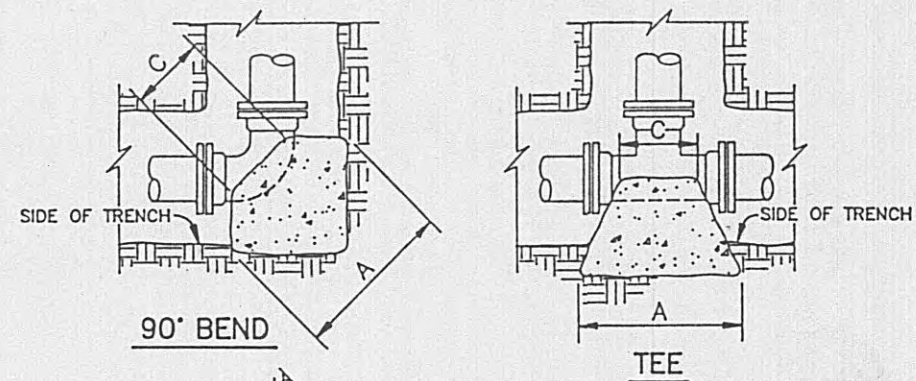

NOTES:  
1. THRUST BLOCKS DESIGNED FOR 200 PSI PRESSURE AND 2000 PSF SOIL BEARING. FOR GREATER PRESSURE OR LESS SOIL BEARING, QUANTITIES WILL HAVE TO BE RECALCULATED.  
2. THRUST BLOCKING TO BE POURED AGAINST UNDISTURBED EARTH.  
3. IF EXACT SIZE PIPE BLOCKING IS NOT SHOWN, USE NEXT LARGER SIZE.  
4. THRUST BLOCKING TO BE POURED IN PLACE CLASS B CONC.

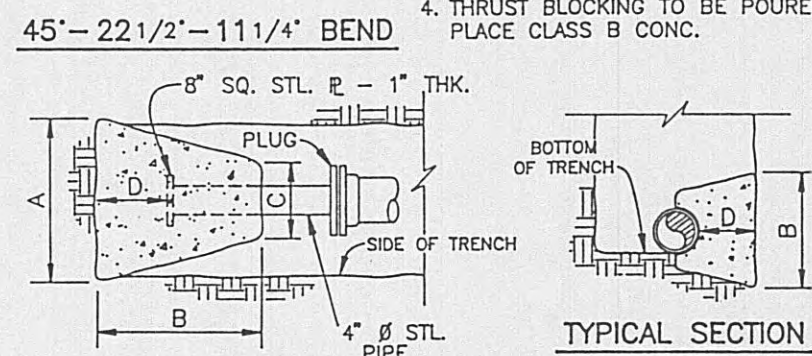

THRUST BLOCKING DETAIL  
NOT TO SCALE

90° BEND												
SIZE	18"	16"	12"	10"	8"	6"	4"	2"				
A	72	64	50	40	33	26	16	16				
B	72	64	50	40	33	24	16	16				
C	32	30	18	15	12	12	9	9				
D	36	32	25	20	16	12	8	8				

45° BEND												
SIZE	18"	16"	12"	10"	8"	6"	4"	2"				
A	54	48	37	31	24	18	12	12				
B	54	48	37	31	24	18	12	12				
C	16	18	14	12	12	8	8	8				
D	25	22	18	15	12	9	6	4				

22 1/2° BEND												
SIZE	18"	16"	12"	10"	8"	6"	4"	2"				
A	38	34	26	23	18	13	9	9				
B	38	34	26	23	18	13	9	9				
C	16	18	14	12	12	10	8	8				
D	18	16	13	11	9	6	4	4				

11 1/4° BEND												
SIZE	18"	16"	12"	10"	8"	6"	4"	2"				
A	27	24	18	16	13	11	9	9				
B	27	24	18	16	13	11	9	9				
C	16	18	14	12	12	10	8	8				
D	14	12	9	8	6	5	4	4				


  

PLUG												
SIZE	18"	16"	12"	10"	8"	6"	4"	2"				
A	60	54	52	43	34	26	26	26				
B	60	54	52	43	34	26	26	26				
C	12	12	12	12	12	12	12	12				
D	54	44	32	22	15	11	11	11				


  

TEE												
SIZE	18"	16"	12"	10"	8"	6"	4"	2"				
A	60	54	52	42	26	43	26	26				
B	60	54	52	43	26	43	26	26				
C	32	30	12	12	12	12	12	12				
D	36	30	26	21	13	21	13	13				


DIMENSIONS ARE IN INCHES

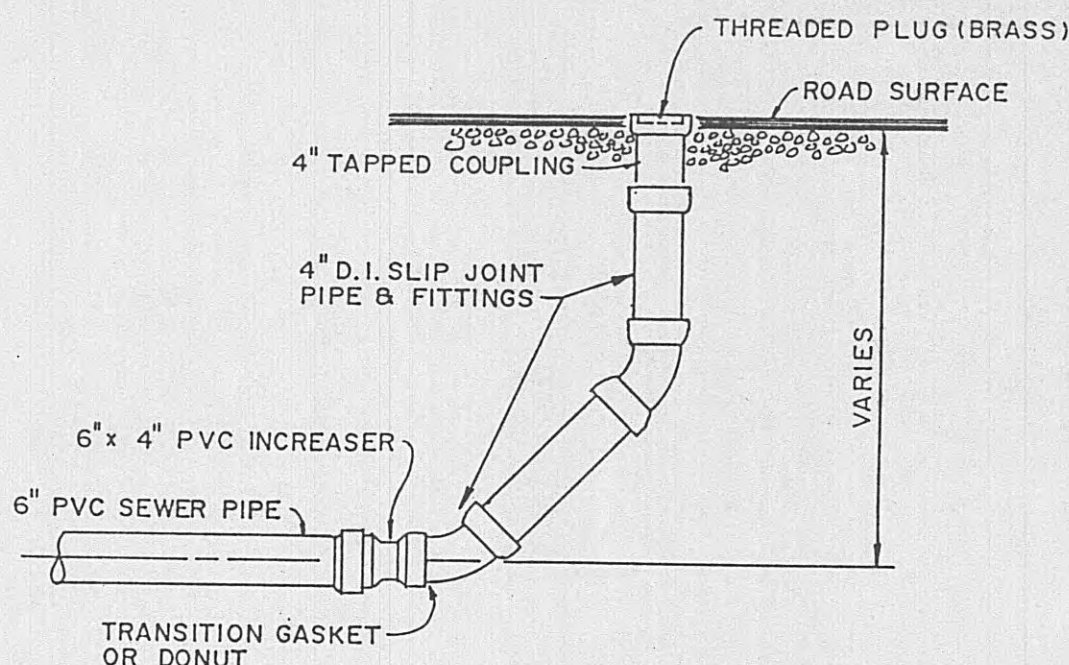


END-OF-LINE CLEANOUT (IN ROADWAY)  
NO SCALE

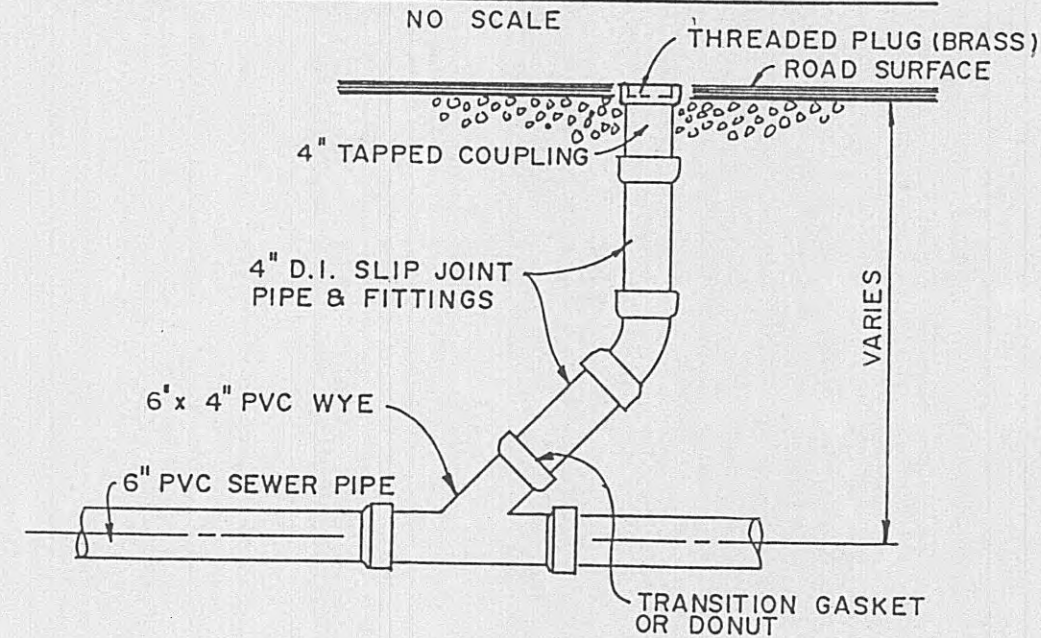


IN-LINE CLEANOUT (IN ROADWAY)  
NO SCALE

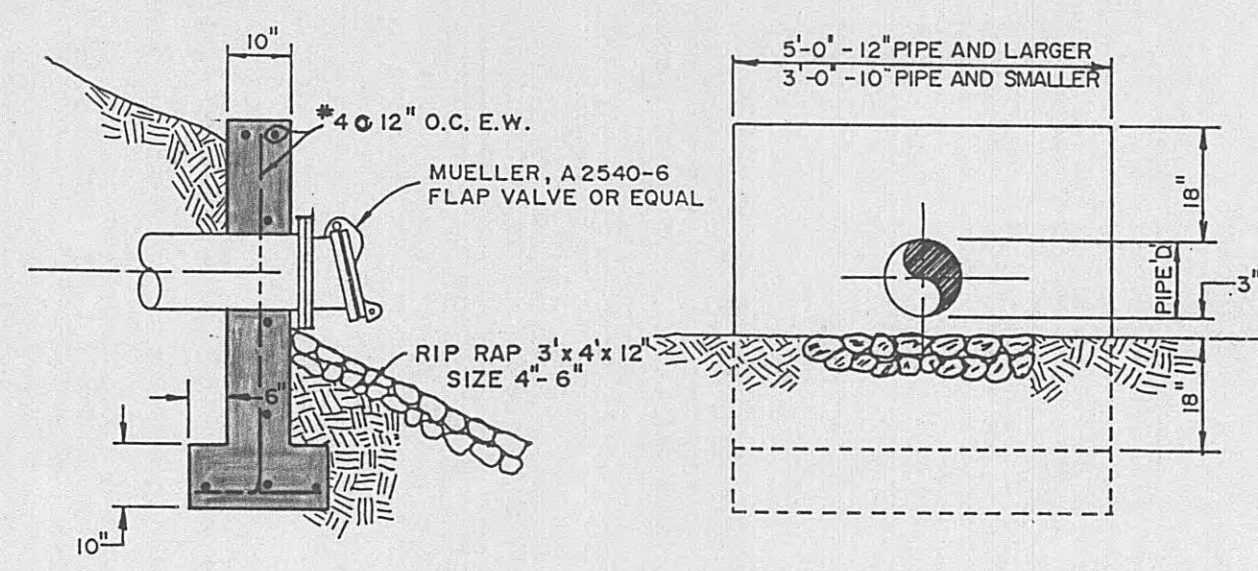


HEADWALL DETAIL  
SCALE: 1/2" = 1'-0"

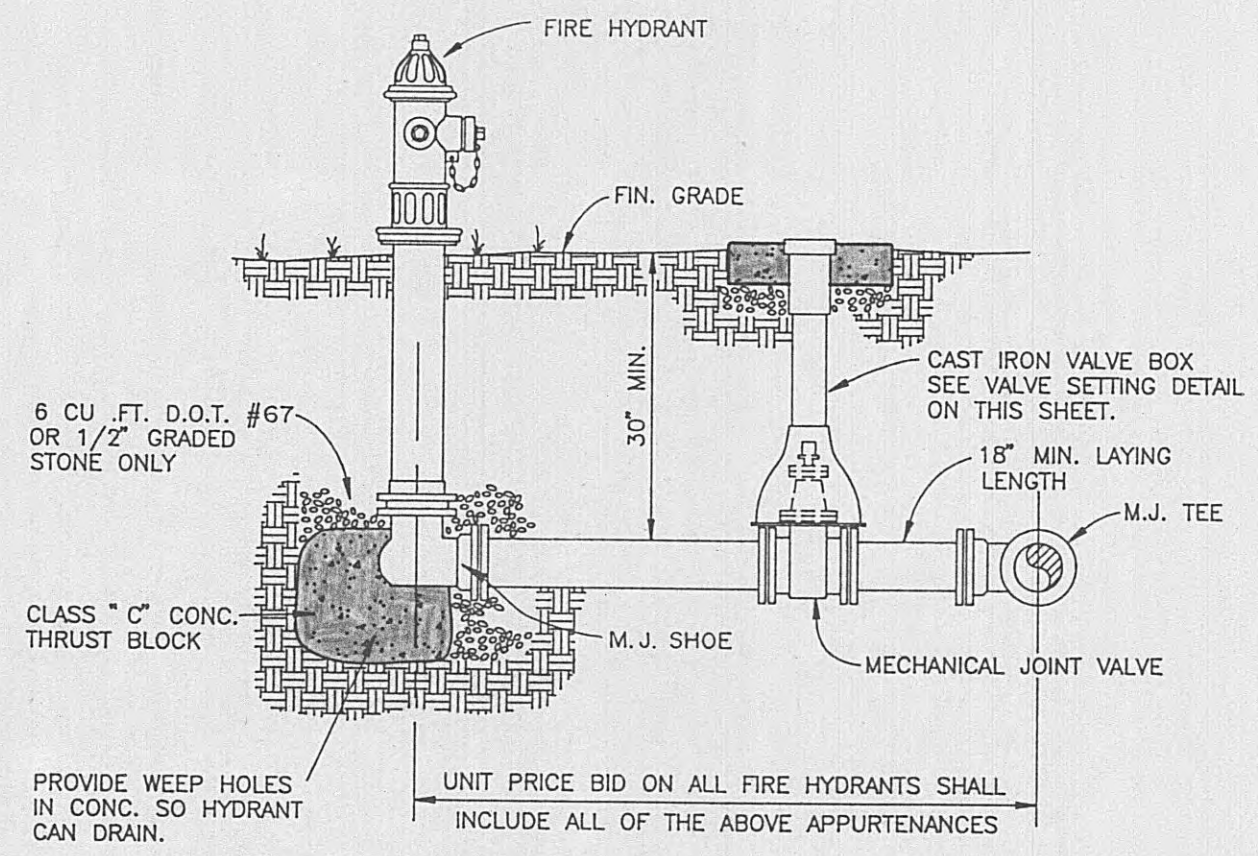


FIRE HYDRANT INSTALLATION  
NOT TO SCALE

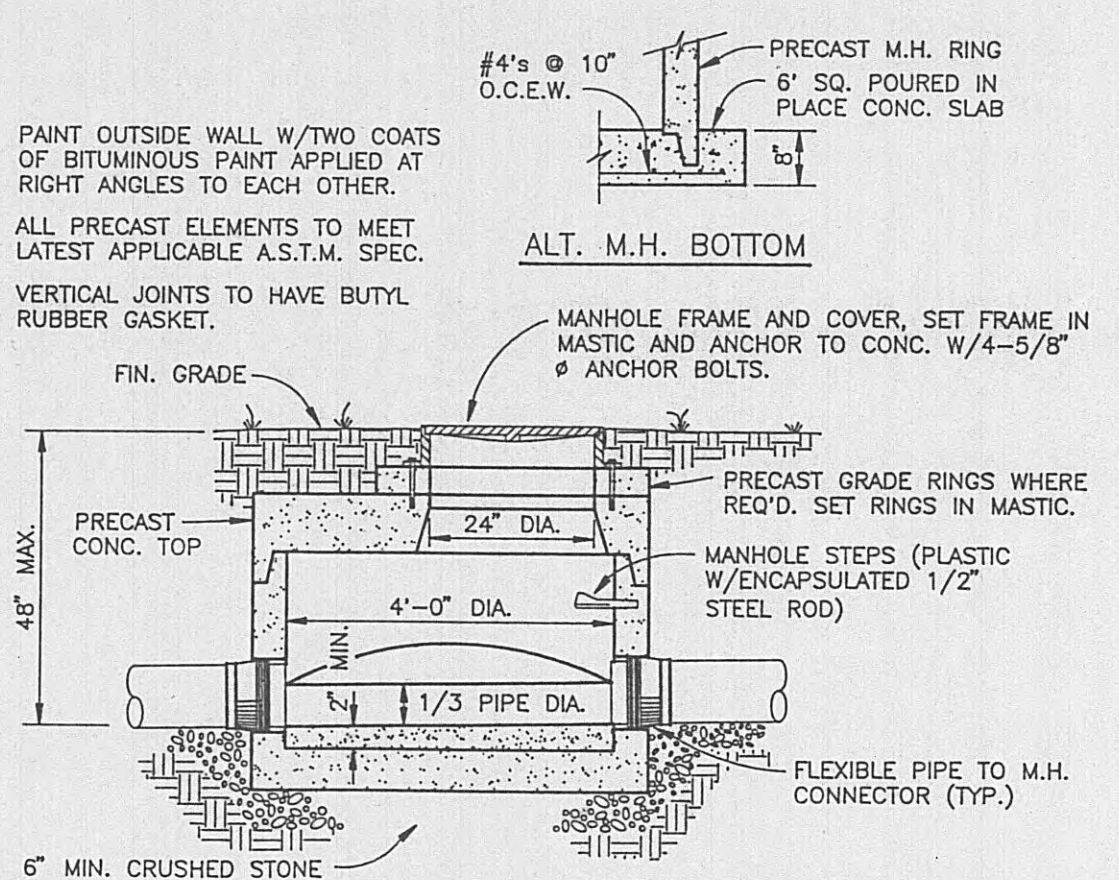


SHALLOW TYPE MANHOLE DETAIL  
NOT TO SCALE

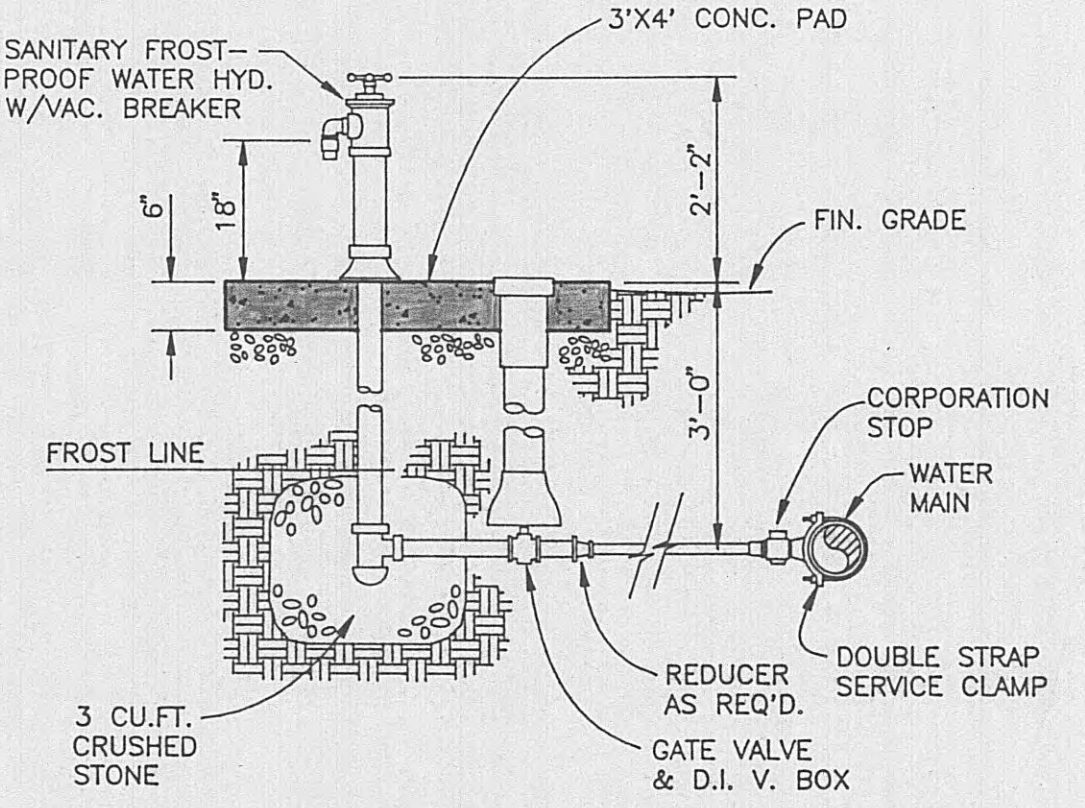


YARD HYDRANT DETAIL  
NOT TO SCALE

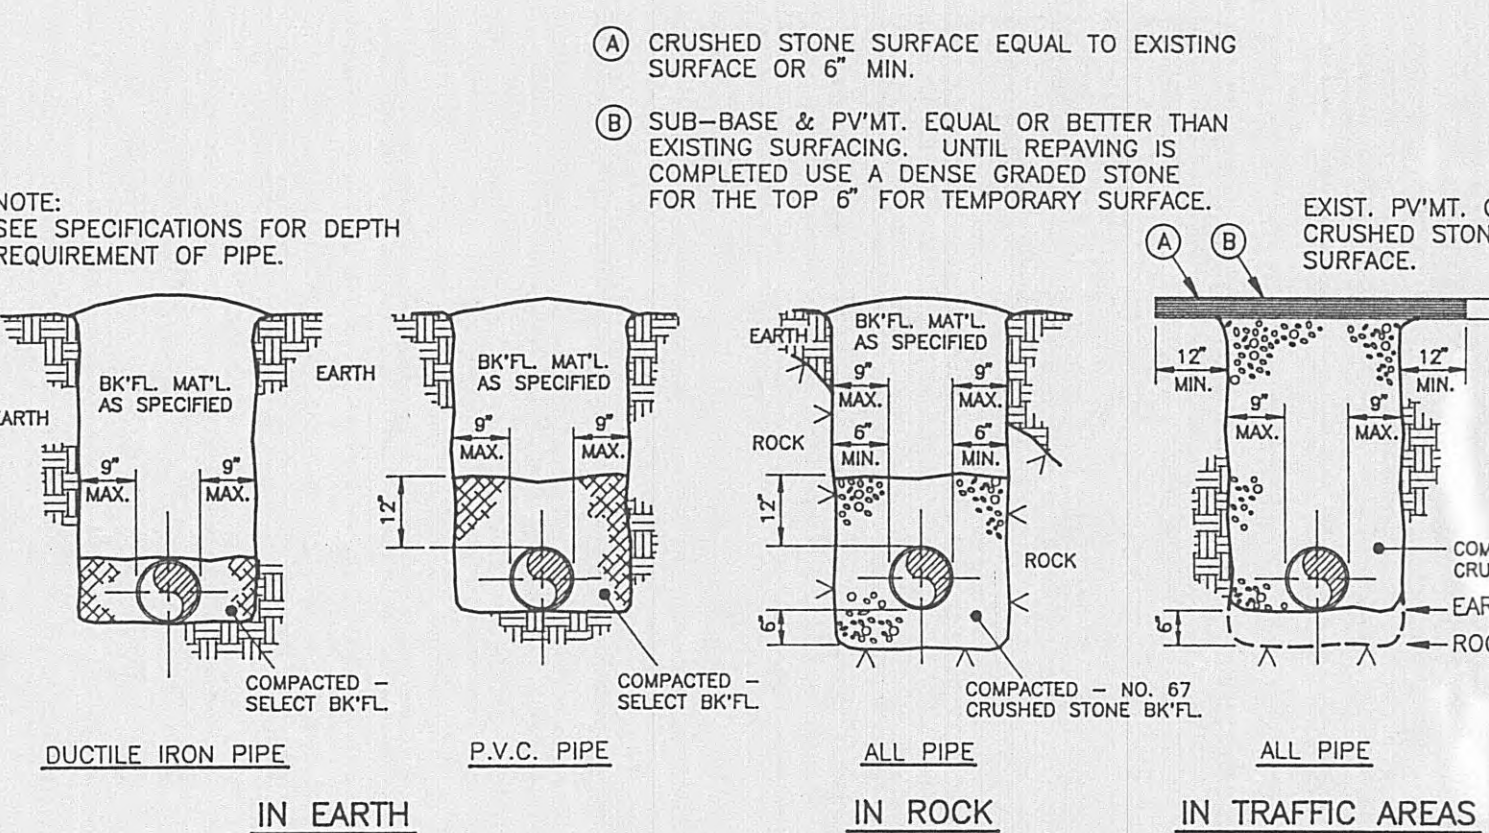


STANDARD WATER LINE BEDDING AND BACKFILLING  
NOT TO SCALE

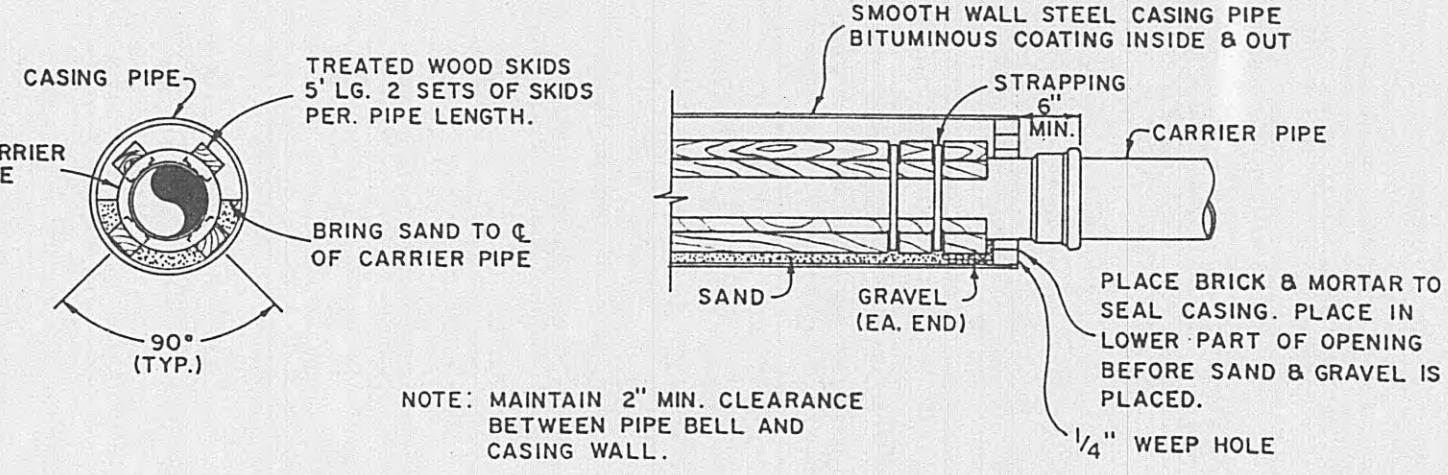


TYPICAL DETAIL OF CASING PIPE W/CARRIER PIPE  
NOT TO SCALE

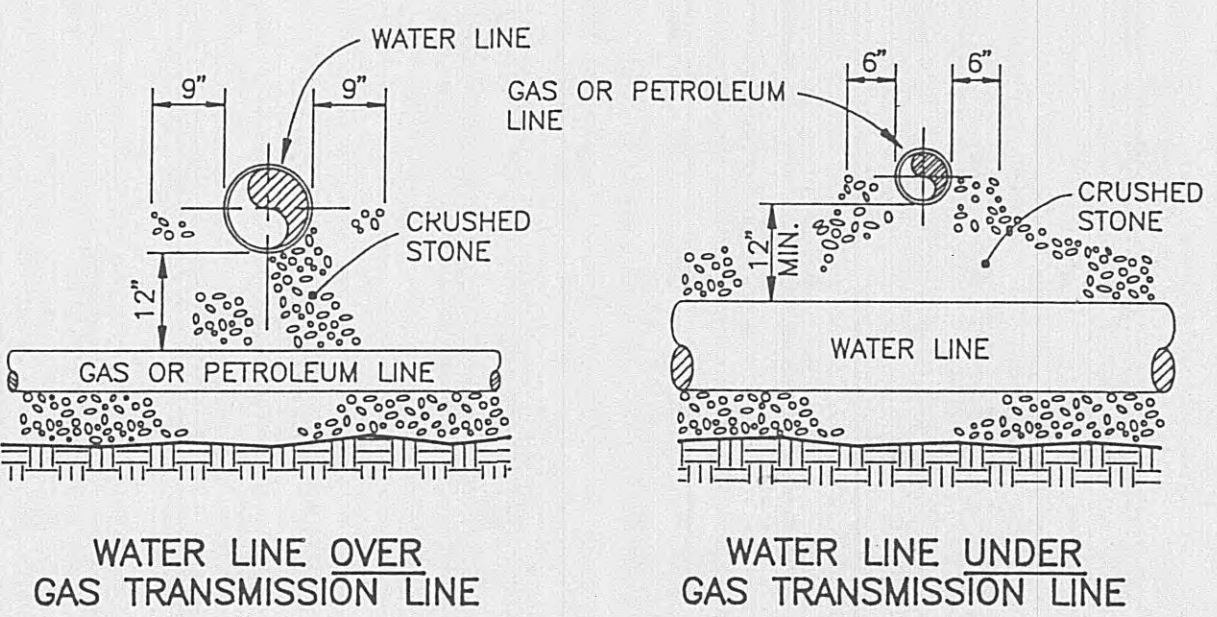


PIPE CROSSING  
FOR WATER LINE @ GAS MAIN  
NOT TO SCALE

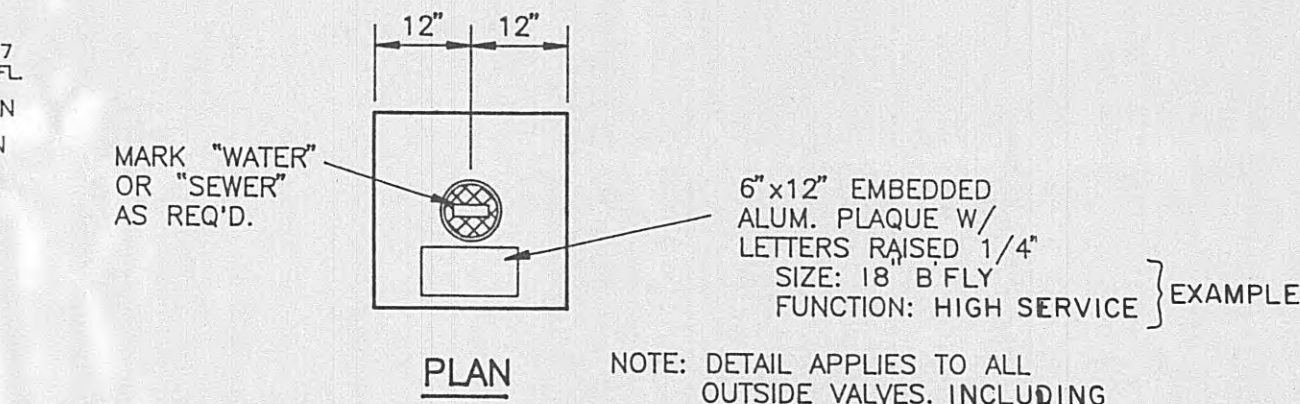


VALVE SETTING DETAIL  
NOT TO SCALE

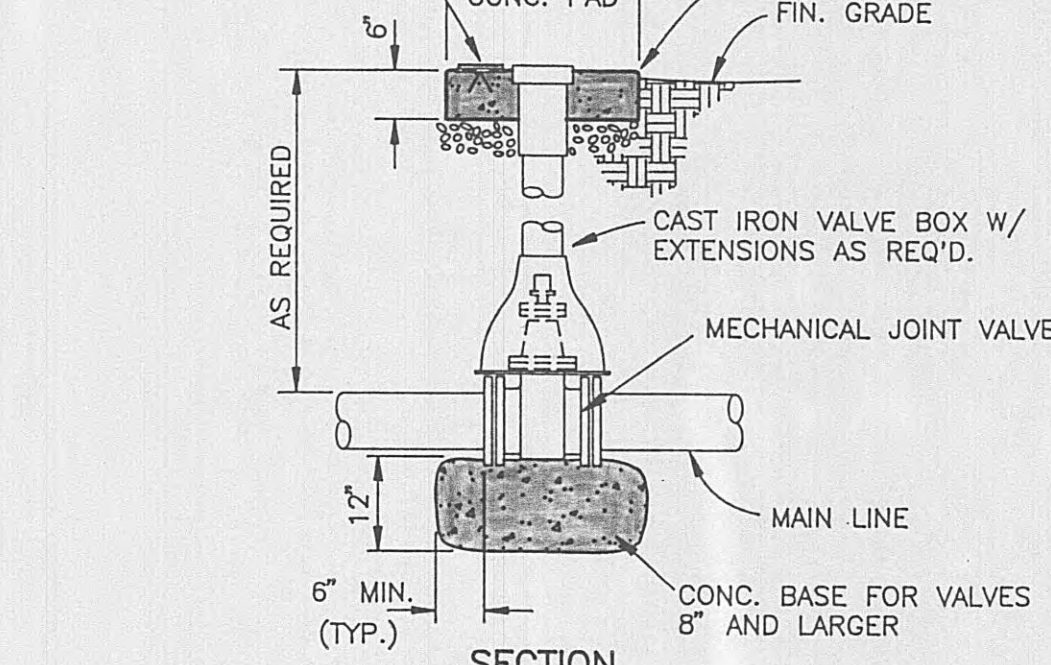

VALVE SETTING DETAIL  
NOT TO SCALE

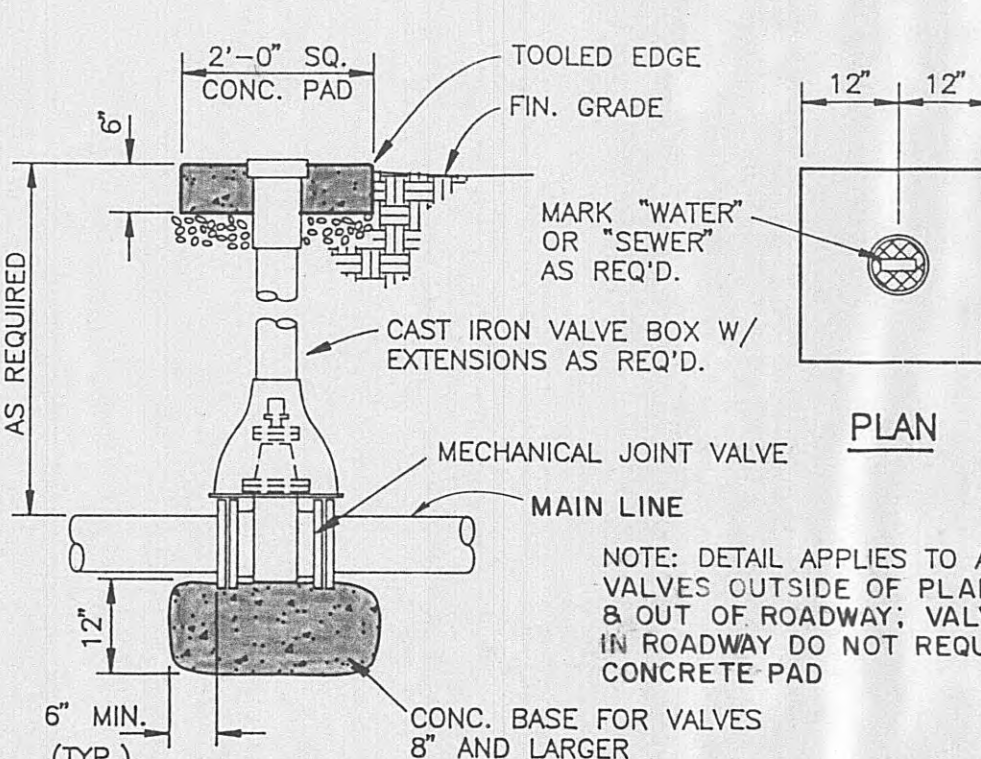


VALVE SETTING DETAIL  
NOT TO SCALE

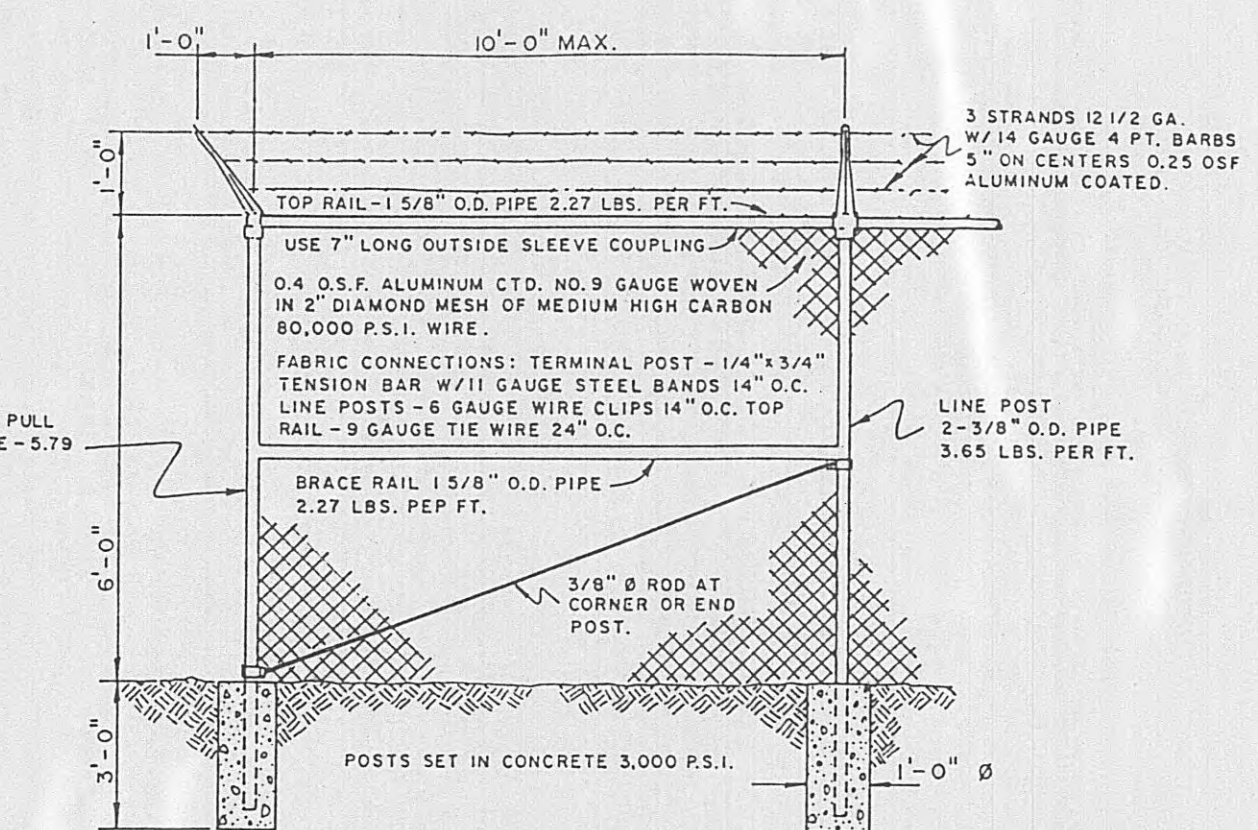

FENCE DETAIL

AS BUILT  
DATE: 3-20-95  
APPROVED: D.M.

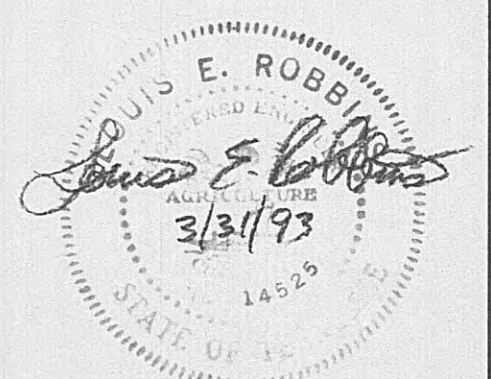

ELROD · DUNSON, INC.  
CONSULTING ENGINEERS  
NASHVILLE · KNOXVILLE  
LEXINGTON, KY

CONTRACT W93-04

HARRIMAN, TENNESSEE  
MISCELLANEOUS CONSTRUCTION DETAILS

REVISIONS

DESIGNED: L.E.R.  
DRAWN: S.H.  
CHECKED: L.E.R.  
DATE: MARCH, 1993  
SCALE: NONE  
PROJ. NO. 0592


SHEET 26

OF 36




LIGHTING FIXTURE SCHEDULE						
TYPE	MANUFACTURER & CATALOGUE NO.	MTG	LAMPS QTY/TYP	TOTAL WATTS	REMARKS	
A	LITHONIA TXL 250M A20 0 LCSP	PENDANT	250W MH COATED	290	LOW BAY	
B	LITHONIA TWH 250S 120V PE	WALL	250W HPS	290	FLOOD LIGHT	
C	LITHONIA TWH 150S 120V PE	WALL	150W HPS	190	FLOOD LIGHT	
D	LITHONIA C240 120V	SURFACE	2 - P40	85	STRIP	
E	LITHONIA 6ELM2 120V	WALL	-	15	EGRESS LIGHT W/BATTERY PACK	
E1	LITHONIA ELU2P 120V	WALL	-	16	EGRESS LIGHT W/BATTERY PACK	
F	LITHONIA 2GT 440A 120V	RECESSED	4 - P40	175	2' X 4'	
G	LITHONIA 2GT 240A 120V	RECESSED	2 - P40	85	2' X 4'	
H	LITHONIA 8TC 240 120V	SURFACE	4 - P40	175	TANDEM WIRED STRIP	
I	LITHONIA DMW 240 A 120V WLF	SURFACE	2 - P40	85	DUST/WET LOCATION	
J	HAZLITE XIM 15 120 C2	SURFACE	150W 1P	150	CLASS I DIVISION I	
K	LITHONIA C 240 120V 0"	SURFACE	2 - P40	85	STRIP WITH 0" BALLAST	
L	LITHONIA TWH 150S 120V PE	WALL	150W HPS	190	FLOOD LIGHT W/PHOTOELECTRIC	
X	LITHONIA QMSWR 120V EL	SURFACE	-	30	EXIT W/BATTERY PACK	
X1	LITHONIA XSWREL 120V	SURFACE	-	30	EXIT W/BATTERY PACK	

LEGEND	
ALL SYMBOLS MAY NOT BE USED	
2' X 4' - 4L OR 3L-RECESSED FLUOR.	DISCONNECT SWITCH
2' X 4' - 2L-RECESSED FLUORESCENT	MAGNETIC MOTOR STARTER
2L, 3L OR 4L SURFACE FLUORESCENT	COMBINATION STARTER
FLUORESCENT STRIP FIXTURE	FIRE ALARM HORN/LIGHT COMBO
RECESSED FIXTURE	FIRE ALARM PULL STATION
SURFACE MOUNTED FIXTURE	BELL
WALL BRACKET FIXTURE	SMOKE DETECTOR
EXIT SIGN WITH 1 FACE	DUCT TYPE SMOKE DETECTOR
EXIT SIGN WITH 2 FACES	FIRE ALARM FLASHING LIGHT
FLOOD OR SPOT LIGHT	MAGNETIC DOOR HOLDER
TRACK LIGHTS WITH FITTINGS: NUMBER OF HEADS AS SHOWN	TAMPER SWITCH
EGRESS LIGHTING	FLOW SWITCH
ISOLATED GROUND TYPE DUPLEX OUTLET 15A MTD. AT 15" AFF UON	JUNCTION BOX - SIZE AS REQUIRED
DUPLEX OUTLET 15A AT +15" AFF UON	TELEPHONE BXBD - 3/4" PLYWOOD
DUPLEX OUTLET - 1/2 SWITCHED AT +15" AFF UON	DISTRIBUTION BOARD
DUPLEX OUTLET - 20A MTD AT 15" AFF UON	SURFACE MTD PANEL
GFI DUPLEX OUTLET - 15A AT 4" ABOVE COUNTER OR BACKSPASH UON	RECESSED PANEL
DUPLEX OUTLET - 15A AT 4" ABOVE COUNTER OR BACKSPASH	ⓐ DENOTES DETAIL "A", SHEET E-1
250V, SINGLE PHASE OUTLET - SIZE AS NOTED	CONDUIT CONCEALED ABOVE CLG OR IN WALL
DOUBLE DUPLEX - 15A AT 15" AFF UON	CONDUIT UNDER SLAB OR BELOW GRADE
FLUSH FLOOR OUTLET - 15A	CONDUIT RUN EXPOSED
CLOCK OUTLET MTD. AT 7'-0" AFF UON	FLEX CONDUIT
THERMOSTAT - 1/2" C.O. TO UNIT NOTED	STUB UP
EXHAUST FAN	STUB DOWN
MOTOR OUTLET	NUMBER, NO. OF HASH MARKS INDICATE NO. OF CONDUCTORS IF MORE THAN TWO
SPEAKER OUTLET	ARK ABOVE FINISHED GRADE
TV OUTLET	APF ABOVE FINISHED FLOOR
TELEPHONE OUTLET - WALL MTD., 3/4" C.O. INTO ACCESSIBLE CEILING SPACE UON	NL NIGHT LIGHT
TELEPHONE FLOOR OUTLET	EWG ELECTRIC WATER COOLER
CRT OR COMPUTER OUTLET - 3/4" C.O. INTO ACCESSIBLE CEILING SPACE UON	W/P WEATHERPROOF - NEMA 3R
PUSH BUTTON	CO CONDUIT ONLY - WITH PULL WIRE
SWITCH - SINGLE POLE 120V OR 277V 48" MAXIMUM AFF - FLUSH MTD	GFI GROUND FAULT INTERRUPTOR
S2 - TWO POLE	IG ISOLATED GROUND
S3 - THREE WAY	UCN UNLESS OTHERWISE NOTED
S4 - FOUR WAY	F.A.P. FIRE ALARM PANEL
SP - PILOT LIGHT	N.O. NORMALLY OPEN
ST - TIMER	N.C. NORMALLY CLOSED
SK - KEY OPERATED	REFERENCE TO ELECTRICAL NOTES SAME SHEET
SM - MANUAL MOTOR STARTER W/THERMAL	
SD - DIMMER	

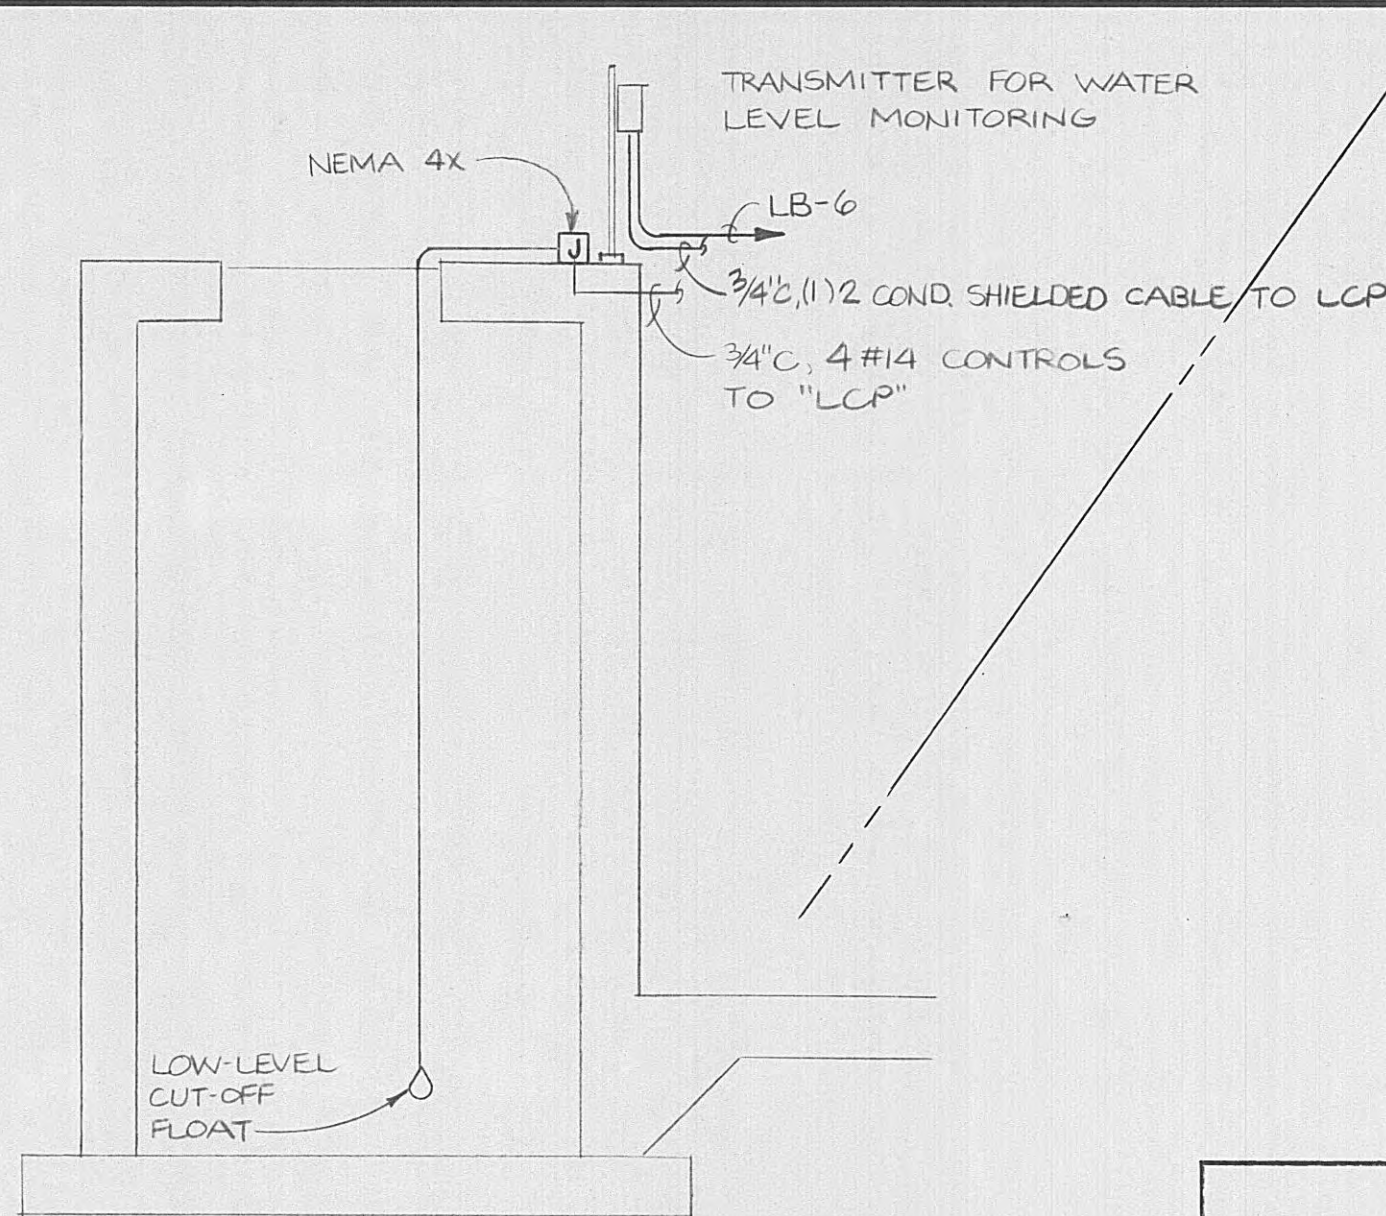

### DECANT PUMP CONTROL

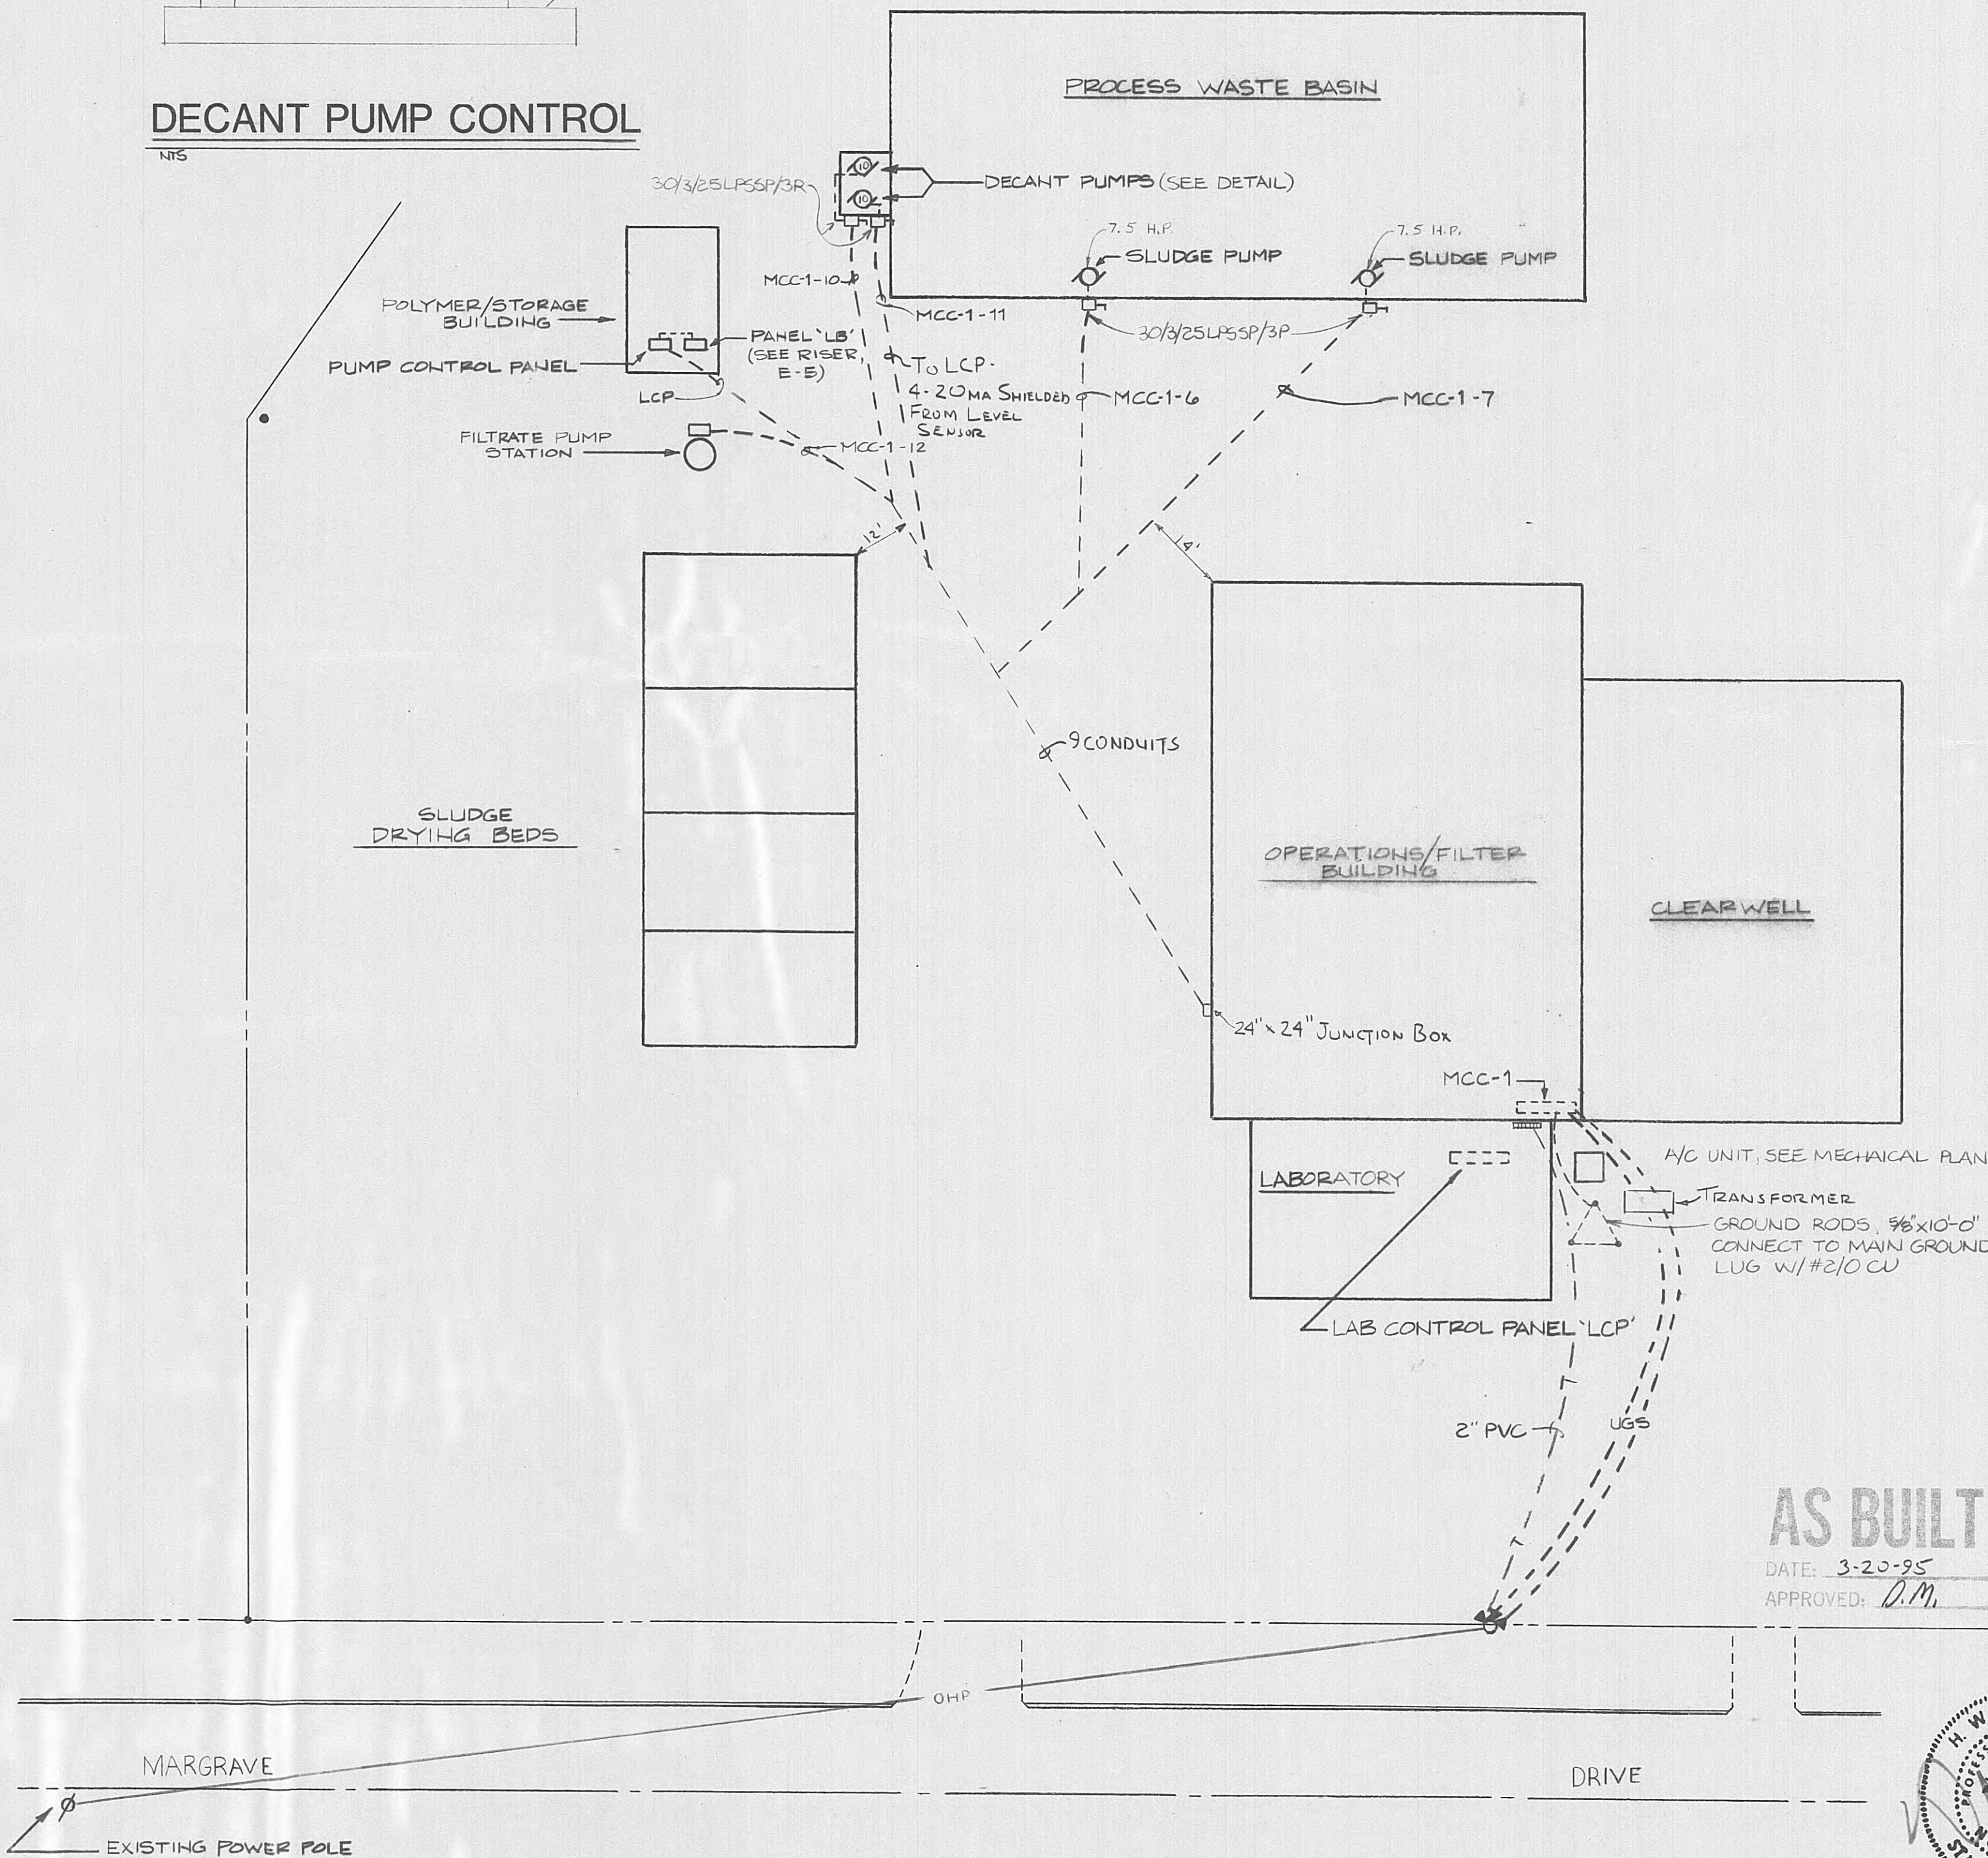

### ELECTRICAL SITE PLAN

SCALE: 1"=20'-0"

AS BUILT

DATE: 3-20-95  
APPROVED: D.M.



93072  
DUFF BROWN  
ENGINEERING INC.  
783 OLD HICKORY BLVD. BRENTWOOD, TN. 37027 (615) 377-3757  
93072

ELROD • DUNSON, INC.  
CONSULTING ENGINEERS  
NASHVILLE • KNOXVILLE  
LEXINGTON, KY

CONTRACT W93-04


HARRMAN, TENNESSEE  
ELECTRICAL SITE PLAN

REVISIONS

DESIGNED: D.L.S.  
DRAWN: M.R.A.  
CHECKED: H.W.D.  
DATE: MARCH 23, 1995  
SCALE: 1"=20'-0"  
PROJ. NO. Q592

SHEET 27  
E-1  
OF 36



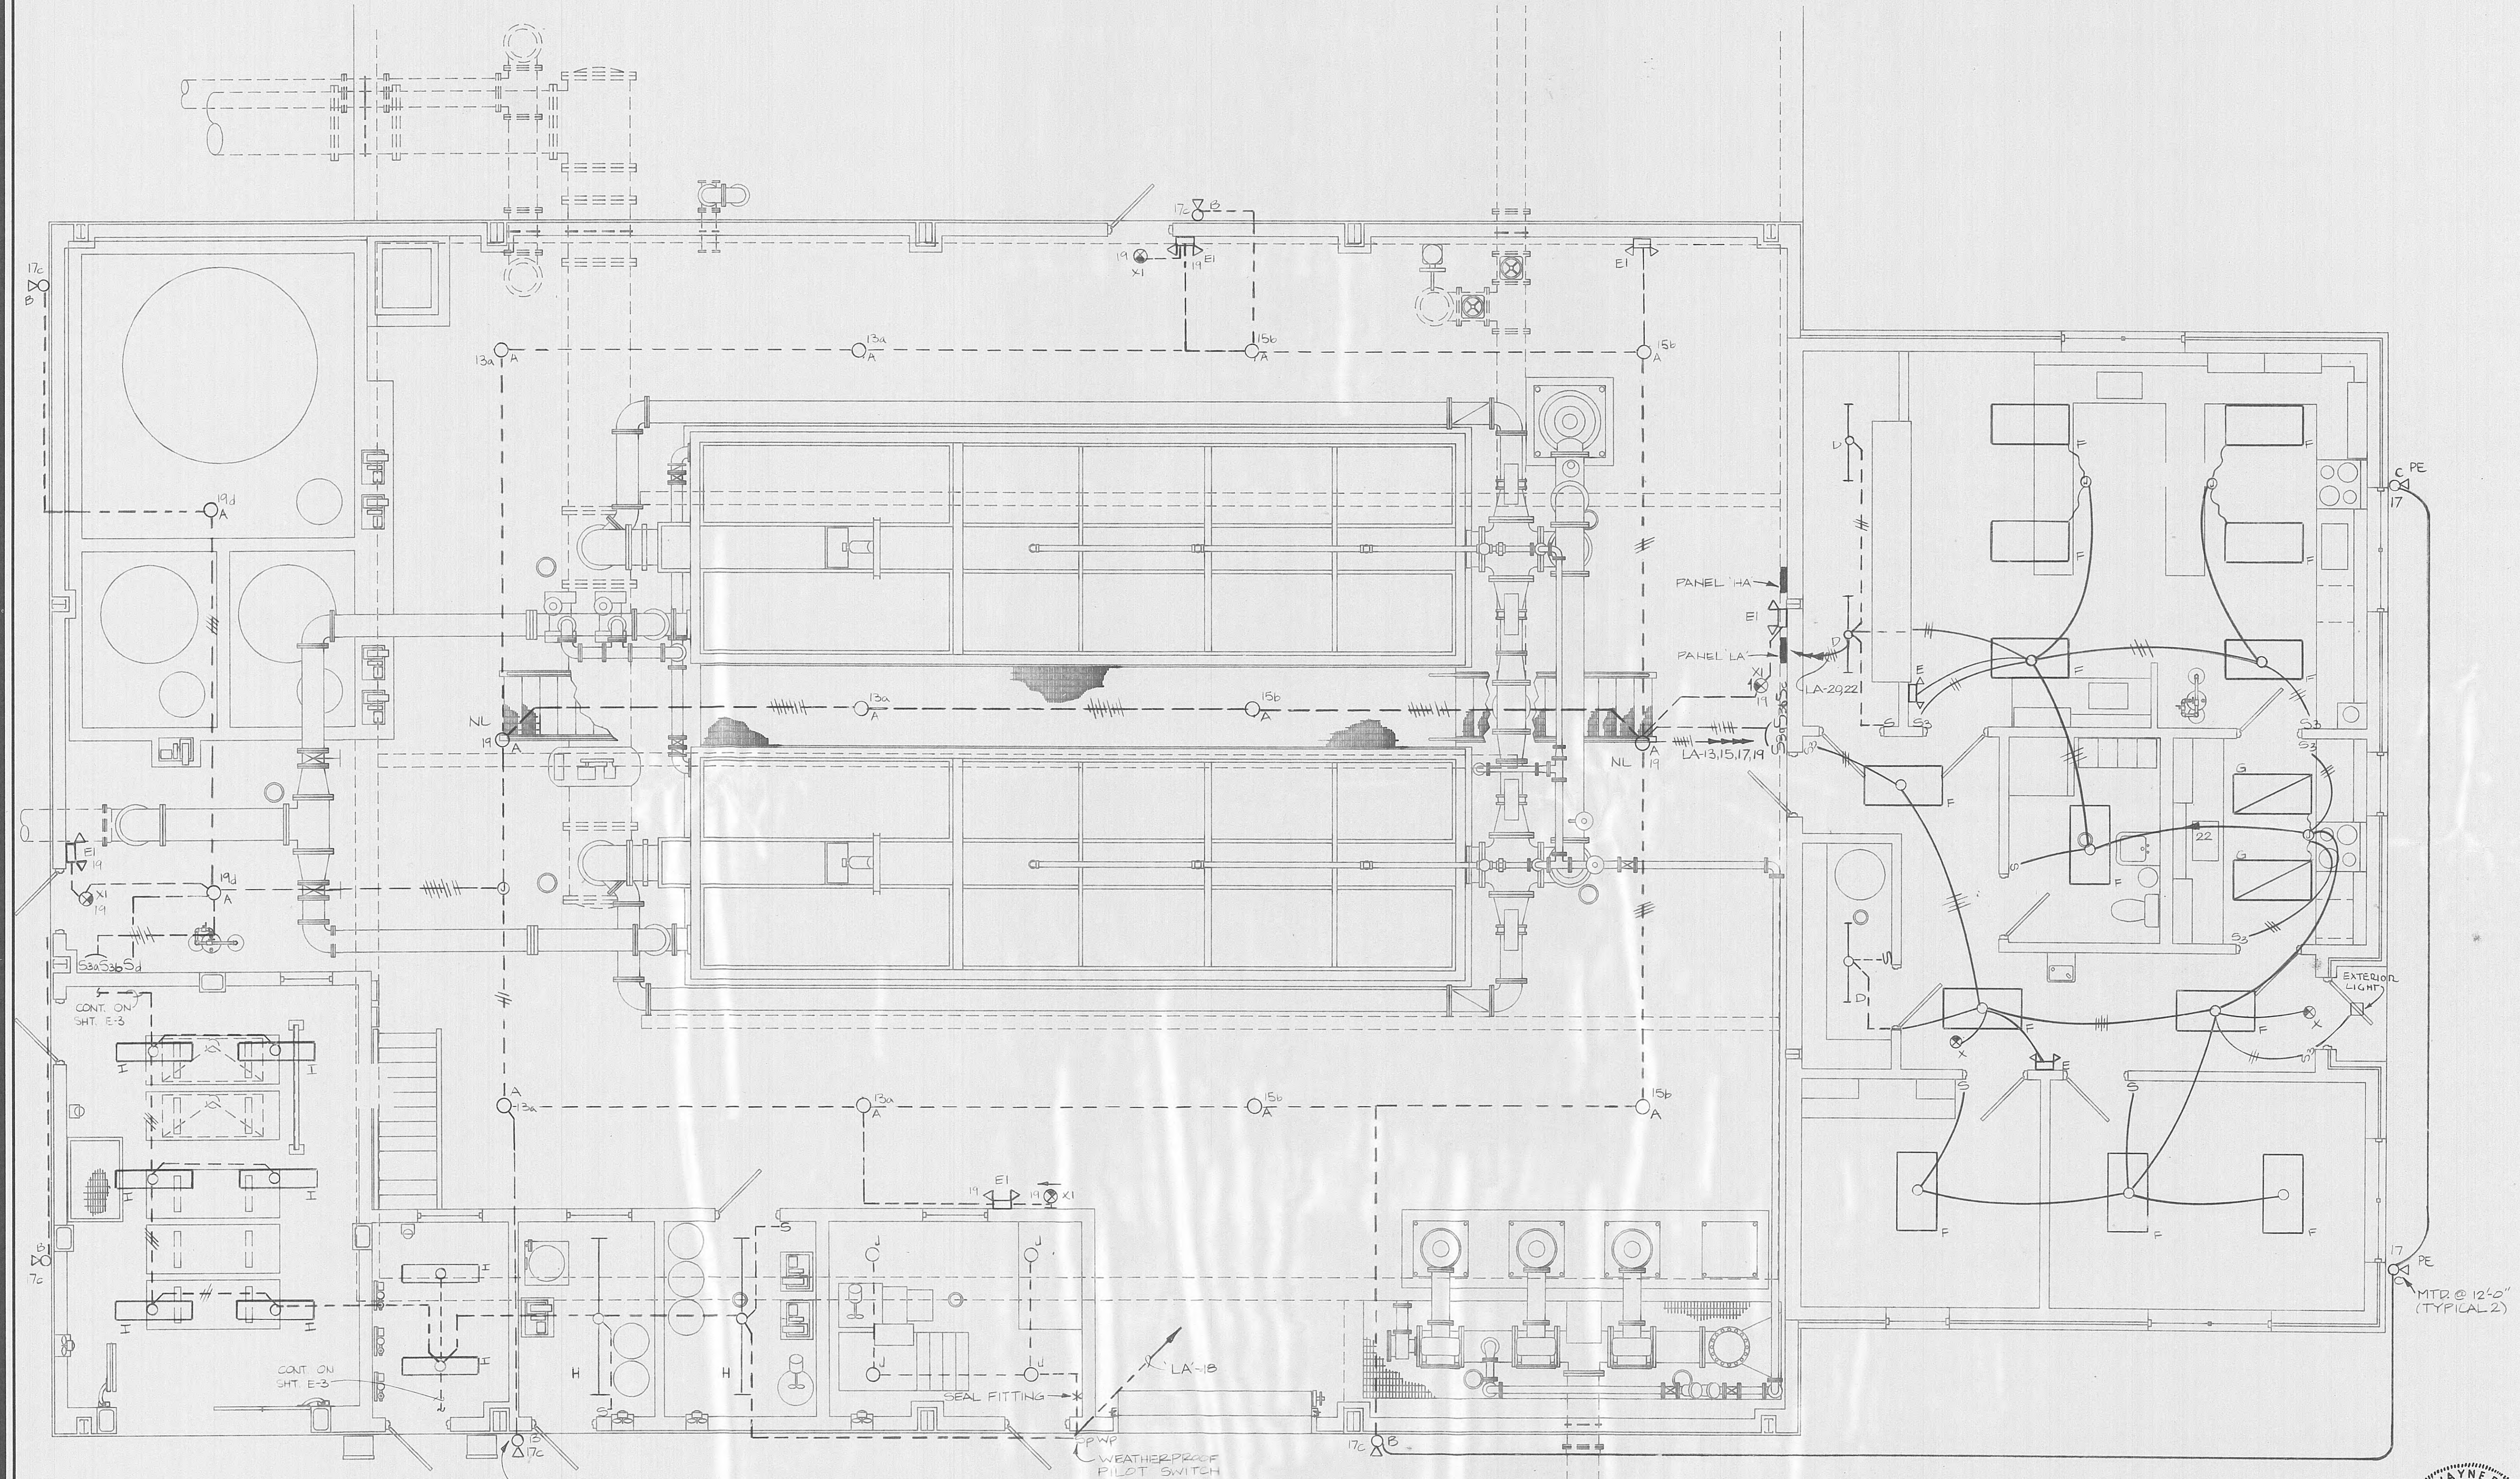

**FILTER BUILDING LIGHTING FLOOR PLAN**  
 SCALE: 1/4" = 1'-0"

**AS BUILT**  
 DATE: 3-20-95  
 APPROVED: D.M.



**DUFF BROWN**  
 ENGINEERING INC.  
 783 OLD HICKORY BLVD. BRENTWOOD, TN. 37027 (615) 377-3757

**ELROD · DUNSON, INC.**  
 CONSULTING ENGINEERS  
 NASHVILLE · KNOXVILLE  
 LEXINGTON, KY

CONTRACT W93-04


HARRIMAN, TENNESSEE  
**FILTER BUILDING LIGHTING PLAN**

REVISIONS

DESIGNED: D.L.S.  
 DRAWN: M.R.A.  
 CHECKED: H.J.D.  
 DATE: MARCH 31, 1995  
 SCALE: 1/4" = 1'-0"  
 PROJ. NO. 0592

SHEET 28  
**E-2**  
 OF 36



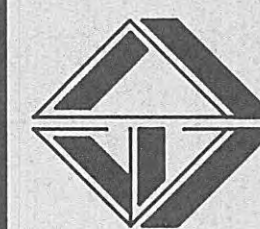

CONTRACT W93-04

HARRIMAN, TENNESSEE  
SITE GRADING PLAN

REVISIONS

5/3/93 Add Entrance Sign

DESIGNED: L.E.R.  
DRAWN: S.C.G.  
CHECKED: L.E.R.  
DATE: MARCH, 1993  
SCALE: 1" = 20'-0"  
PROJ. NO. 0952

SHEET 2


OF 36

LEGEND


- PROPOSED STRUCTURES
- EXISTING CONTOURS
- PROPOSED CONTOURS
- PROPOSED ASPHALT PAVING
- PROPOSED CONC. SIDEWALK
- PROPOSED FENCE

NOTE

SLOPE PAVEMENT TO DRAIN AWAY FROM BUILDING.

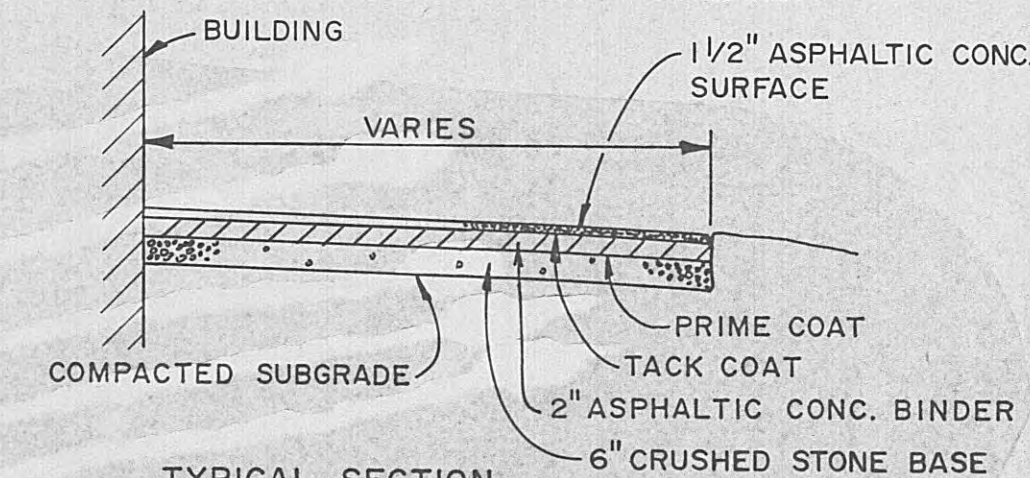


TYPICAL SECTION  
PAVED PARKING AREA & DRIVE  
NOT TO SCALE

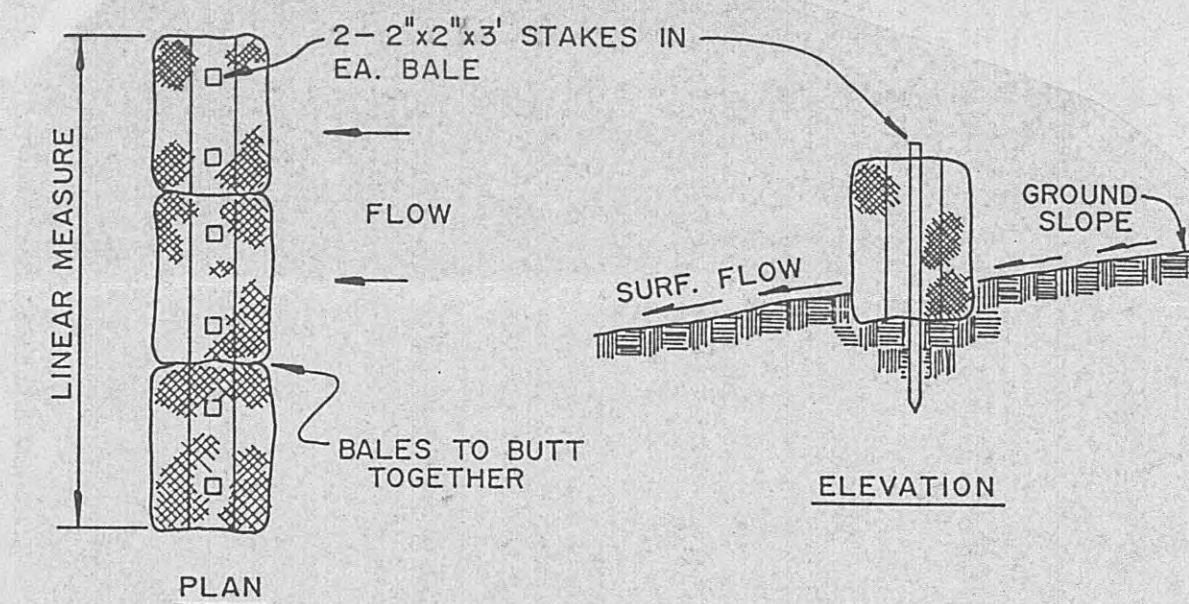


TO BE INSTALLED AS NOTED ON PLAN BEFORE COMMENCING GRADING OPERATION AND LEFT IN PLACE UNTIL A GOOD STAND OF GRASS IS ESTABLISHED OVER ALL DISTURBED AREAS. BARRIER SHOWN IS MINIMUM REQUIREMENT; CONTRACTOR RESPONSIBLE FOR EROSION CONTROL MEASURES.

EROSION - SILTATION BARRIER DETAIL

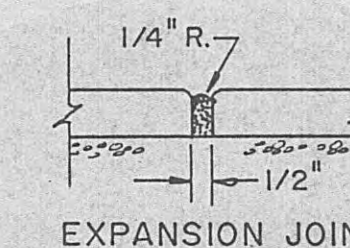


EXPANSION JOINT

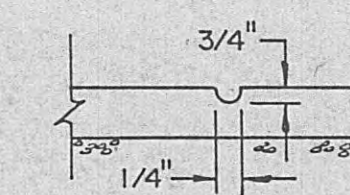

CONTRACTION JOINT


NOTE:  
PREFORMED 1/2" EXPANSION JOINTS SHALL BE EQUALLY SPACED AT 25' MAX. CENTERS, WITH 1/4" CONTRACTION JOINTS EQUALLY SPACED AT 5' MAX. CENTERS BETWEEN EXPANSION JOINTS FOR ALL SIDEWALKS SHOWN.

SIDEWALK JOINT DETAIL  
NOT TO SCALE

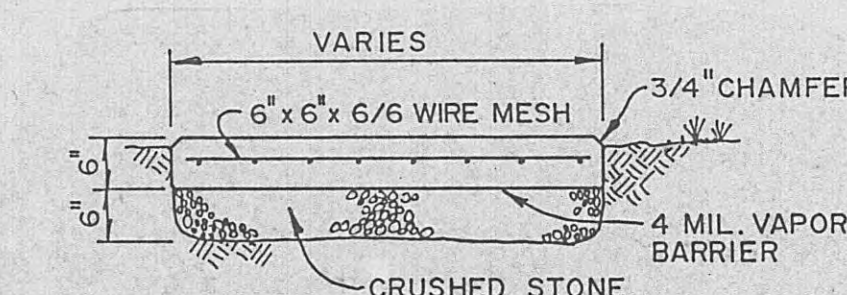


TYPICAL SIDEWALK DETAIL  
NOT TO SCALE

BUMPER DETAIL  
NOT TO SCALE

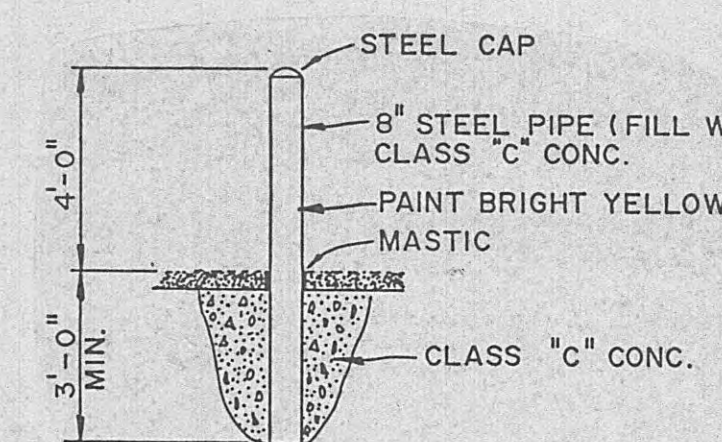

AS BUILT  
DATE: 3-20-95  
APPROVED: D.M.

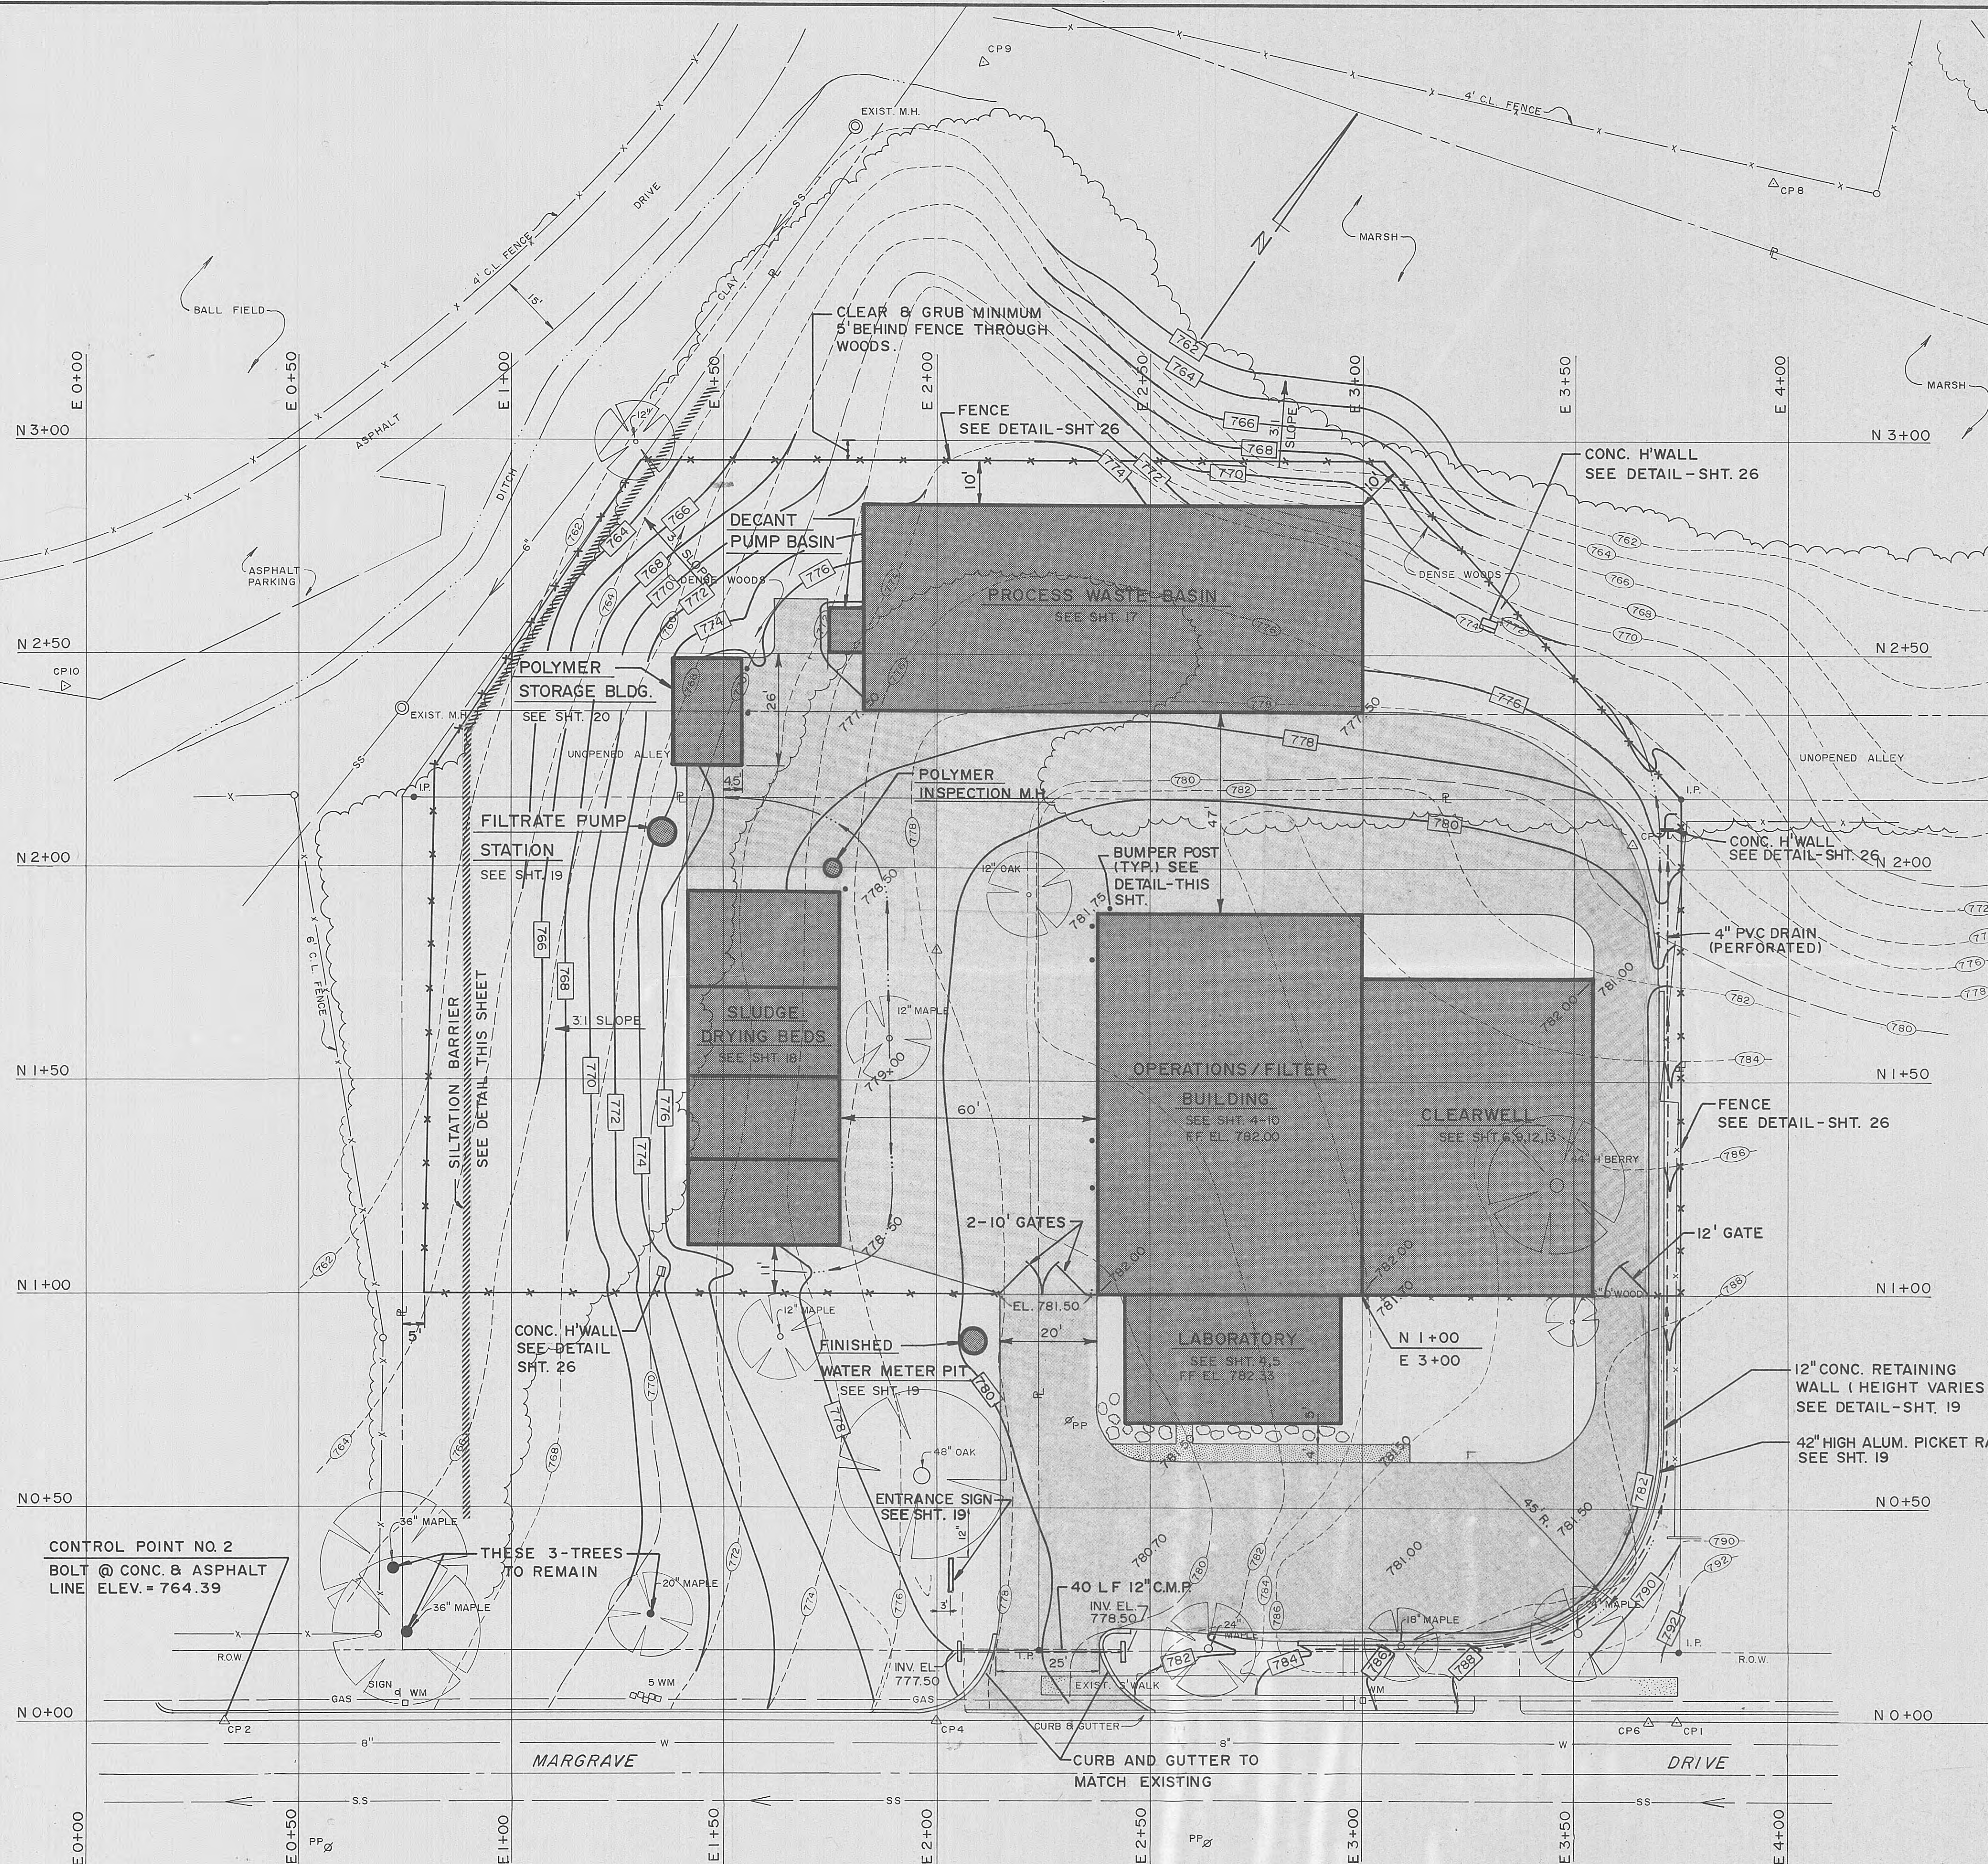

CONTROL POINT NO. 2  
BOLT @ CONC. & ASPHALT  
LINE ELEV. = 764.39

THESE 3-TREES  
TO REMAIN

ENTRANCE SIGN  
SEE SHT. 19

40 LF 12" C.M.P.  
INV. EL. 778.50



CURB AND GUTTER TO  
MATCH EXISTING

DRIVE

MARGRAVE




LABORATORY CASEWORK  
RECEPTACLE DETAIL

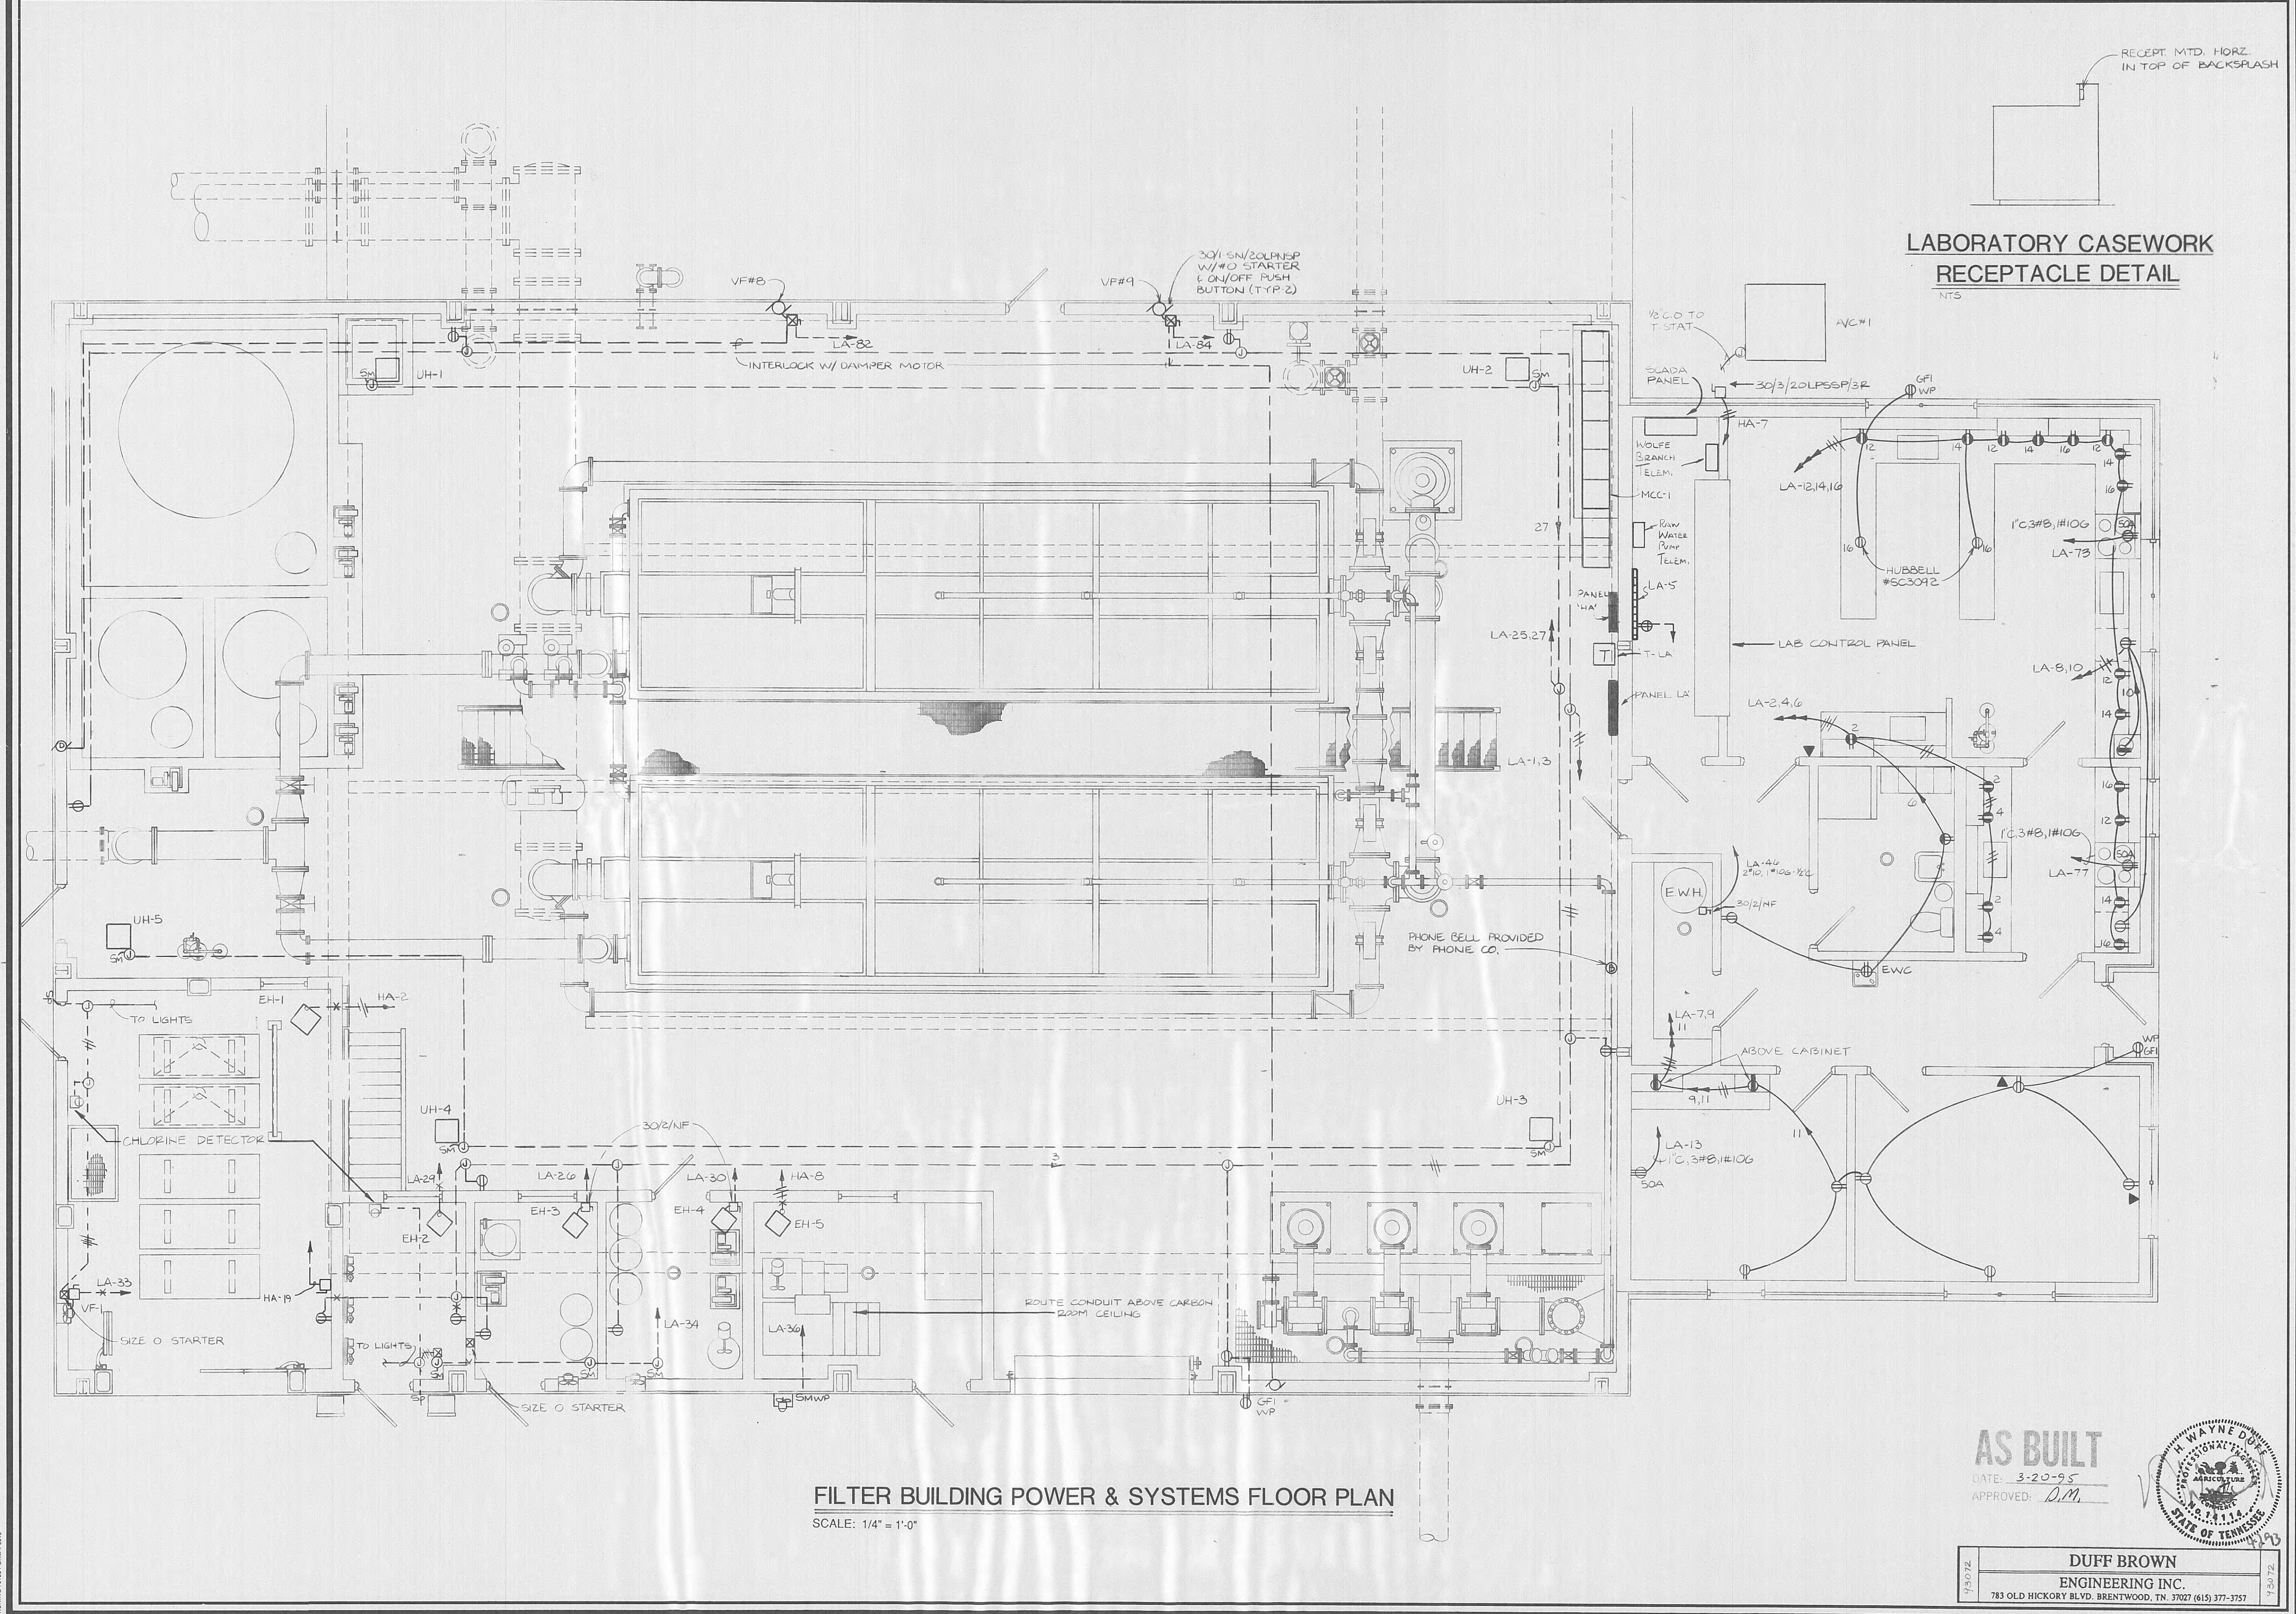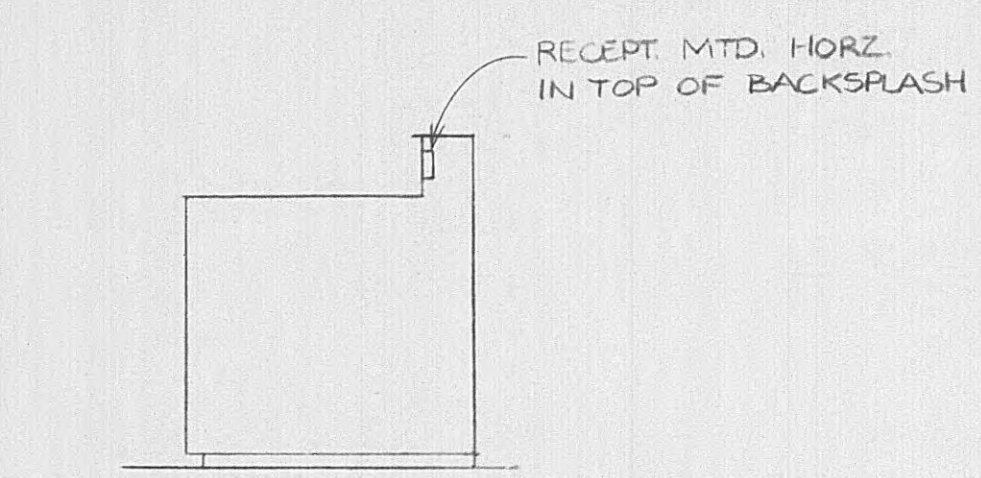

FILTER BUILDING POWER & SYSTEMS FLOOR PLAN  
SCALE: 1/4" = 1'-0"

AS BUILT  
DATE: 3-20-95  
APPROVED: D.M.

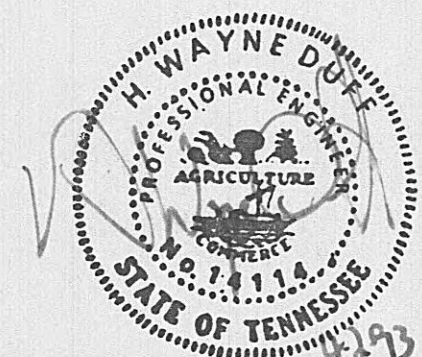

DUFF BROWN  
ENGINEERING INC.  
783 OLD HICKORY BLVD. BRENTWOOD, TN. 37027 (615) 377-3757



PROCESSING POWER PLAN NOTES: E-4

1. PRESSURE SWITCH, UNIT SWITCH, NORMAL SOLENOID, & EMERGENCY SOLENOID ARE FURNISHED BY OTHERS. CONTRACTOR SHALL PROVIDE INTERLOCK WIRING FROM DEVICES TO "PUMP DIRECTOR CABINET". COORDINATE WITH VENDOR FOR LOCATIONS & EXACT REQUIREMENTS.
2. PROVIDE A #18 TWISTED PAIR CONTROL WIRING IN 1/2" C. FROM "PUMP DIRECTOR CABINET" TO "MCC1" TO CONTROL STARTER COIL FOR HIGH SERVICE PUMP.
3. PROVIDE A SECURITY CONTROL STATION TO OFFER LOCAL CONTROL OF RESPECTIVE PUMP. STATION SHALL BE SQUARE D CLASS 9001, #KY298 IN A CAST ALUMINUM SURFACE MOUNT ENCLOSURE. ALL STATIONS SHALL BE EQUIPPED W/CYLINDER LEGEND PLATE MARKED "OPEN-CLOSE", AND PUSHBUTTON MARKED "STOP". ALL STATIONS SHALL BE KEYED A LIKE, AND OWNER SHALL BE PROVIDED 6 (SIX) KEYS.
4. VERIFY ALL PLANT PROCESS WIRING AND CONTROL REQUIREMENTS PRIOR TO ROUGH-IN.
5. ALL INTERCONNECTING WIRING TO BE #14 THHN STRANDED COPPER WITH CRIMPED TERMINATIONS.

6"X6" WIREWAY W/ HINGED COVER. MOUNT AS HIGH AS STRUCTURE WILL ALLOW


LABORATORY CONTROL PANEL "LCP"

SECTION-"MCC1" & "LCP"

NO SCALE

PROCESS DEVICE SCHEDULE


KEY	DESCRIPTION	KEY	DESCRIPTION
1	UNIT 1 BACKWASH INLET VALVE	13	UNIT 2 BACKWASH INLET VALVE
2	UNIT 1 OPTIONAL FILTER-TO-WASTE VALVE	14	UNIT 2 OPTIONAL FILTER-TO-WASTE VALVE
3	UNIT 1 LOW EFFLUENT PRESSURE SWITCH	15	UNIT 2 LOW EFFLUENT PRESSURE SWITCH
4	UNIT 1 SURFACE WASH VALVE	16	UNIT 2 SURFACE WASH VALVE
5	UNIT 1 LOW LEVEL SWITCH	17	UNIT 2 LOW LEVEL SWITCH
6	UNIT 1 EFFLUENT LEVEL VALVE	18	UNIT 2 EFFLUENT LEVEL VALVE
7	UNIT 1 FILTER EFFLUENT VALVE	19	UNIT 2 FILTER EFFLUENT VALVE
8	UNIT 1 AIR INLET VALVE	20	UNIT 2 AIR INLET VALVE
9	UNIT 1 INFLUENT HIGH PRESSURE SWITCH	21	UNIT 2 INFLUENT HIGH PRESSURE SWITCH
10	UNIT 1 INFLUENT LOW PRESSURE SWITCH	22	UNIT 2 INFLUENT LOW PRESSURE SWITCH
11	UNIT 1 INFLUENT VALVE	23	UNIT 2 INFLUENT VALVE
12	UNIT 1 WASTE GATE VALVE	24	UNIT 2 WASTE GATE VALVE
		25	BLOWER PRESSURE SWITCH

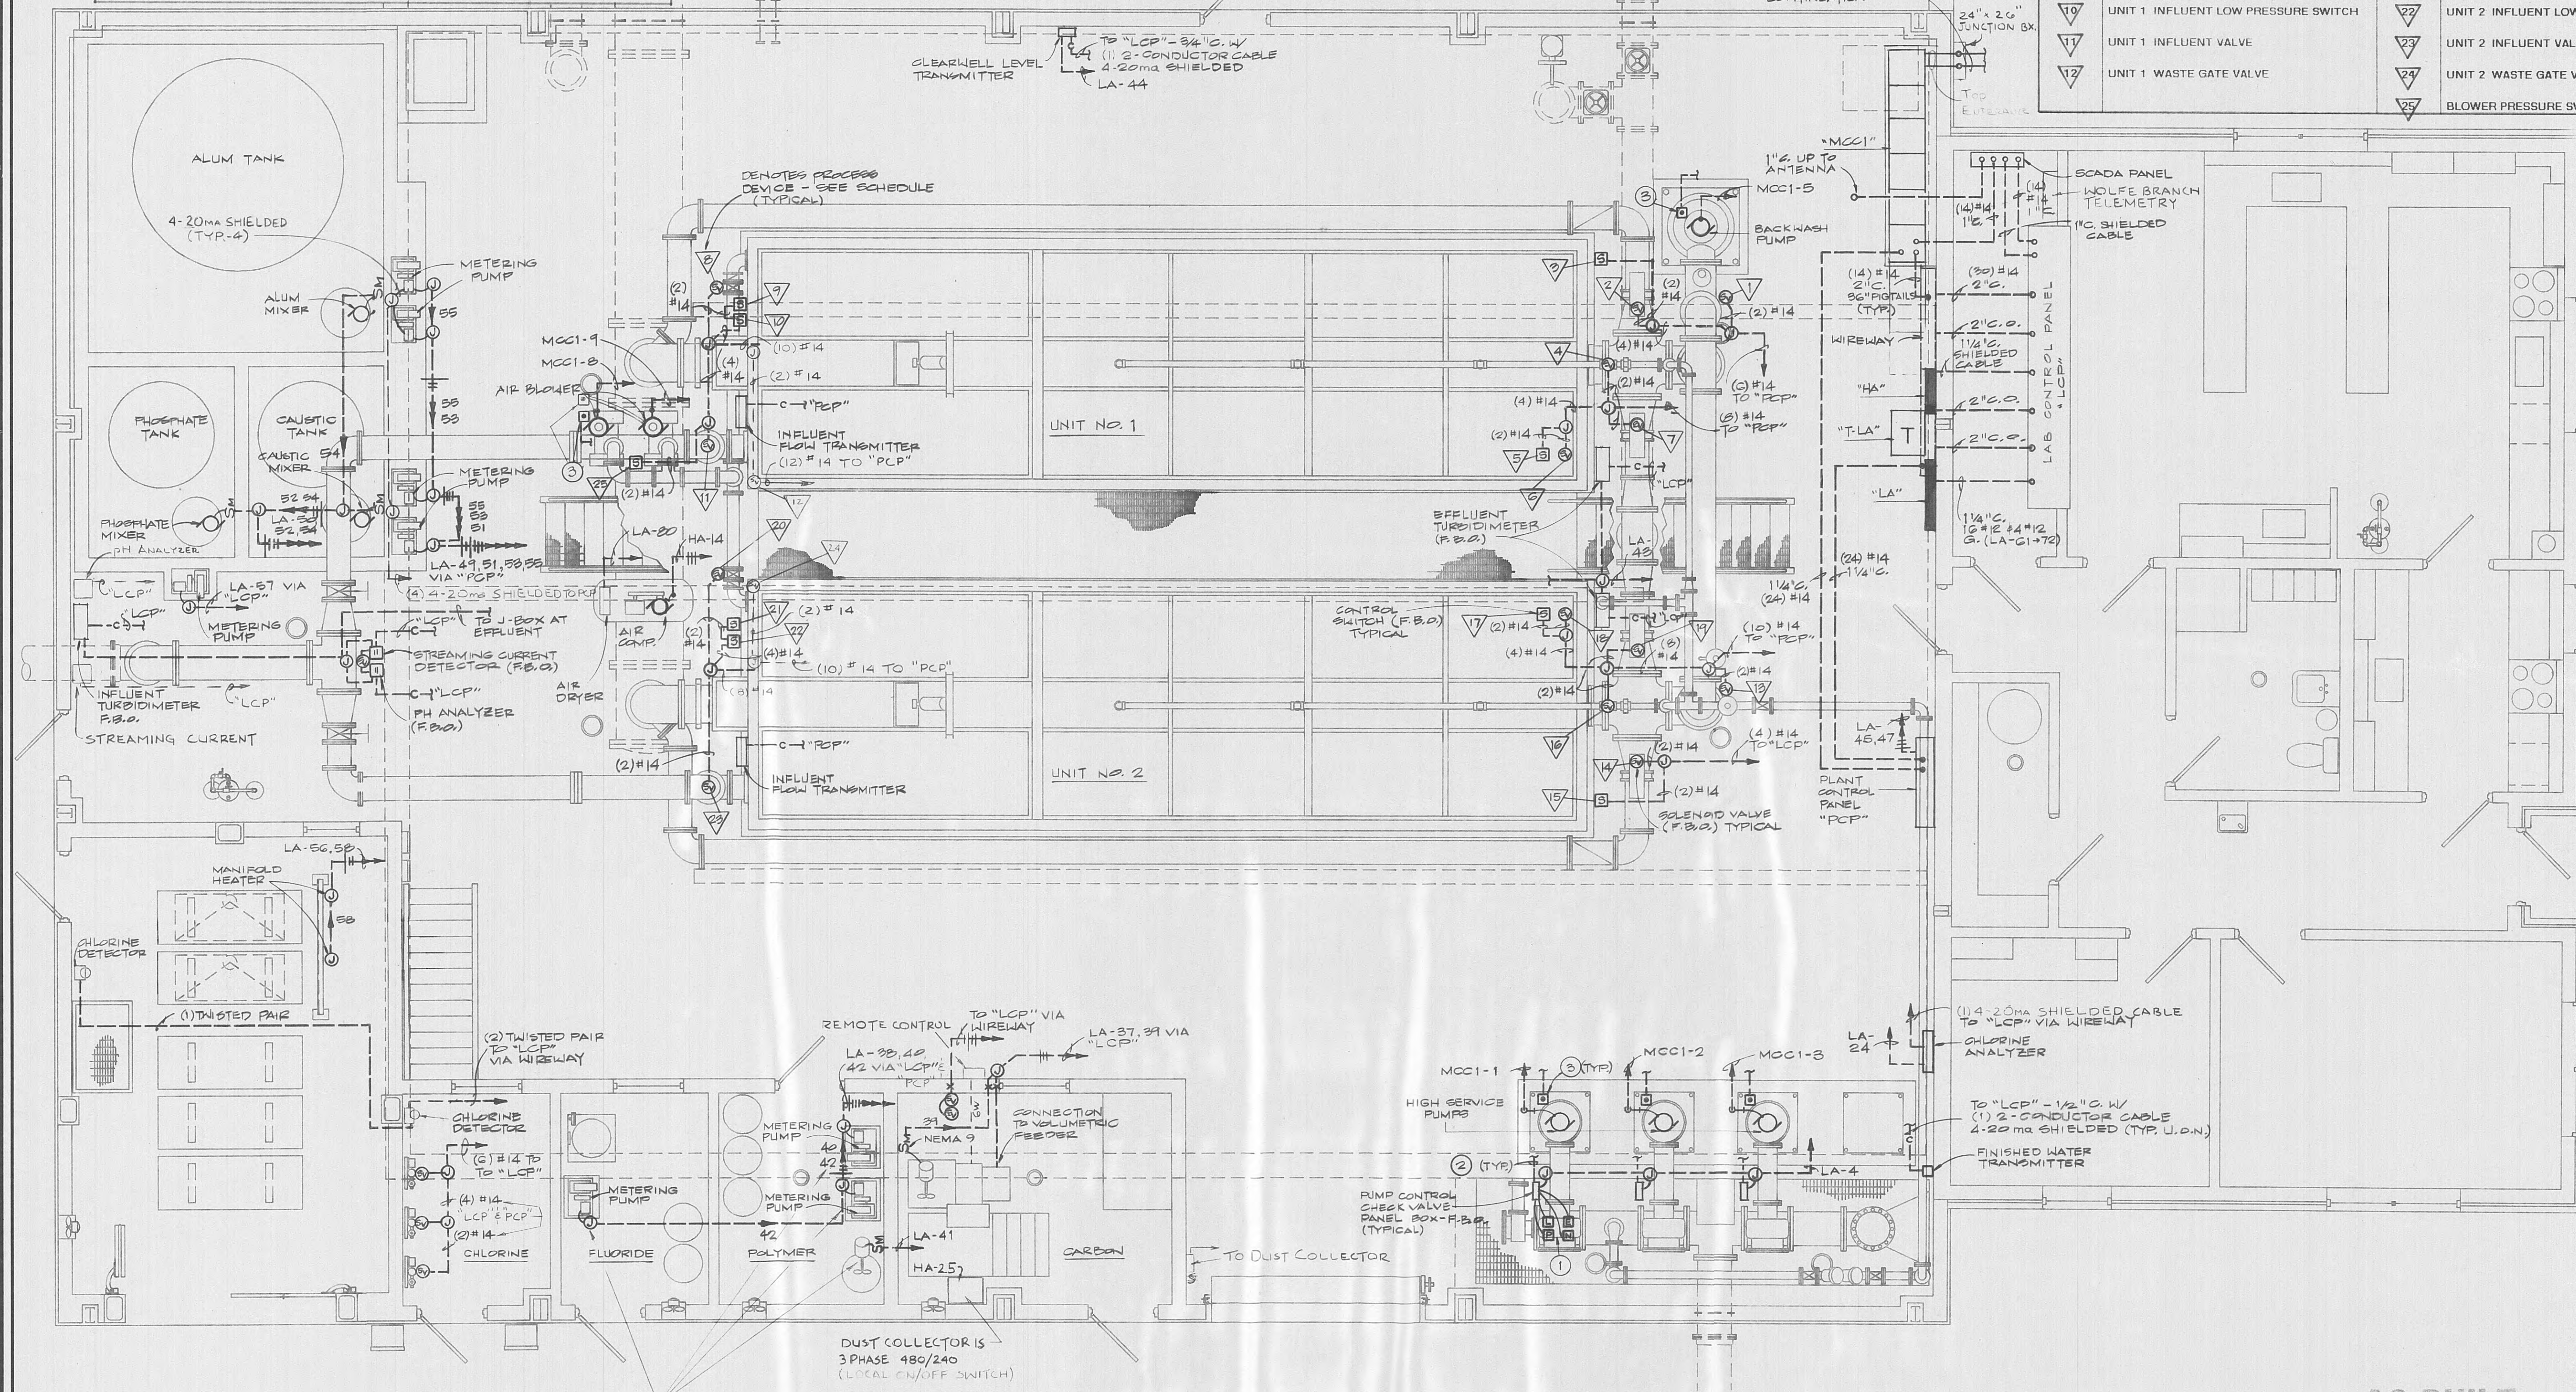

FILTER BUILDING - PROCESS POWER PLAN

SCALE: 1/4" = 1'-0"

AS BUILT  
DATE: 3-20-95  
APPROVED: D.M.

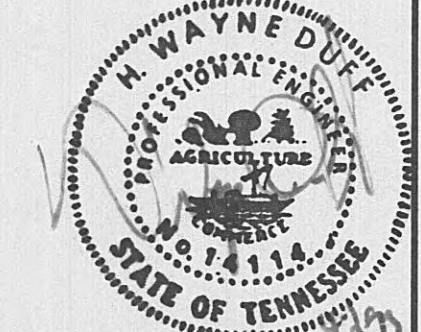

DUFF BROWN  
ENGINEERING INC.  
783 OLD HICKORY BLVD. BRENTWOOD, TN. 37027 (615) 377-3757

ELROD · DUNSON, INC.  
CONSULTING ENGINEERS  
NASHVILLE · KNOXVILLE  
LEXINGTON, KY

CONTRACT W93-04

HARRIMAN, TENNESSEE  
FILTER BUILDING PROCESS POWER PLAN

REVISIONS

DESIGNED: JFS  
DRAWN: JFS  
CHECKED: HWD  
DATE: 04-02-93  
SCALE: NOTED  
PROJ. NO. 0592

SHEET 30  
E-4  
OF 36




"MCC1"

MOTOR CONTROL CENTER SCHEDULE

VOLTS, AMPS & A.S.I.C.	BRANCH CIRCUIT BREAKER CIR. NO.	AMPS	POLES	STARTER	CONTROL ITEM ON STARTER	LOAD KVA	H.P.	CONDUIT & WIRE	FEEDS
480, 3PH 3 WIRE 800 A 25,000A	1	225	3	AUTOTRANSFORMER NEMA SIZE 5	S-P-ETM A-H	129.6	125	2"-3#3/0 1#6G	HIGH SERVICE PUMP
	2	225	3	AUTOTRANSFORMER NEMA SIZE 5	S-P-ETM A-H	129.6	125	2"-3#3/0 1#6G	HIGH SERVICE PUMP
800A FUSED SWITCH	3	225	3	AUTOTRANSFORMER NEMA SIZE 5	S-P-ETM A-H	129.6	125	2"-3#3/0 1#6G	HIGH SERVICE PUMP
	4	225	3	(CIRCUIT BREAKER)	-	107.1	-	2"-4#4/0 1#4G	PANEL HA
	5	100	3	AUTOTRANSFORMER NEMA SIZE 3	S-P-ETM A-H	54.0	50	1"-3#4 1#8G	BACKWASH PUMP
	6	25	3	X-LINE NEMA SIZE 1	S-P-H	11.6	7.5	3/4"-3#10 1#10G	SLUDGE PUMP
	7	25	3	X-LINE NEMA SIZE 1	S-P-H	11.6	7.5	3/4"-3#10 1#10G	SLUDGE PUMP
	8	60	3	X-LINE NEMA SIZE 2	S-P-H	22.4	20	3/4"-3#8 1#10G	BLOWER MOTOR
	9	60	3	X-LINE NEMA SIZE 2	S-P-H	22.4	20	3/4"-3#8 1#10G	BLOWER MOTOR
	10	25	3	X-LINE NEMA SIZE 1	S-P-H	11.6	10	3/4"-3#10 1#10G	DECANT PUMP
	11	25	3	X-LINE NEMA SIZE 1	S-P-H	11.6	10	3/4"-3#10 1#10G	DECANT PUMP
	12	30	3	(CIRCUIT BREAKER)	-	7.89	3(X2)	1"-10G	FILTRATE PUMPS
	13	-	3	SPACE W/PROVISIONS	-	-	-	-	-
	14	-	3	SPACE W/PROVISIONS	-	-	-	-	-
	15	-	3	SPACE W/PROVISIONS	-	-	-	-	-
	16	-	3	SPACE W/PROVISIONS	-	-	-	-	-


STARTER CONTROL ITEM LEGEND

S - START/STOP PUSHBUTTONS A - AMMETER  
P - PILOT LIGHT (GREEN) ETM - ELAPSED TIME METER  
H - HAND-OFF AUTO SEL. SWITCH  
PF - PHASE FAILURES RELAY W/ADJUSTABLE TIME DELAY

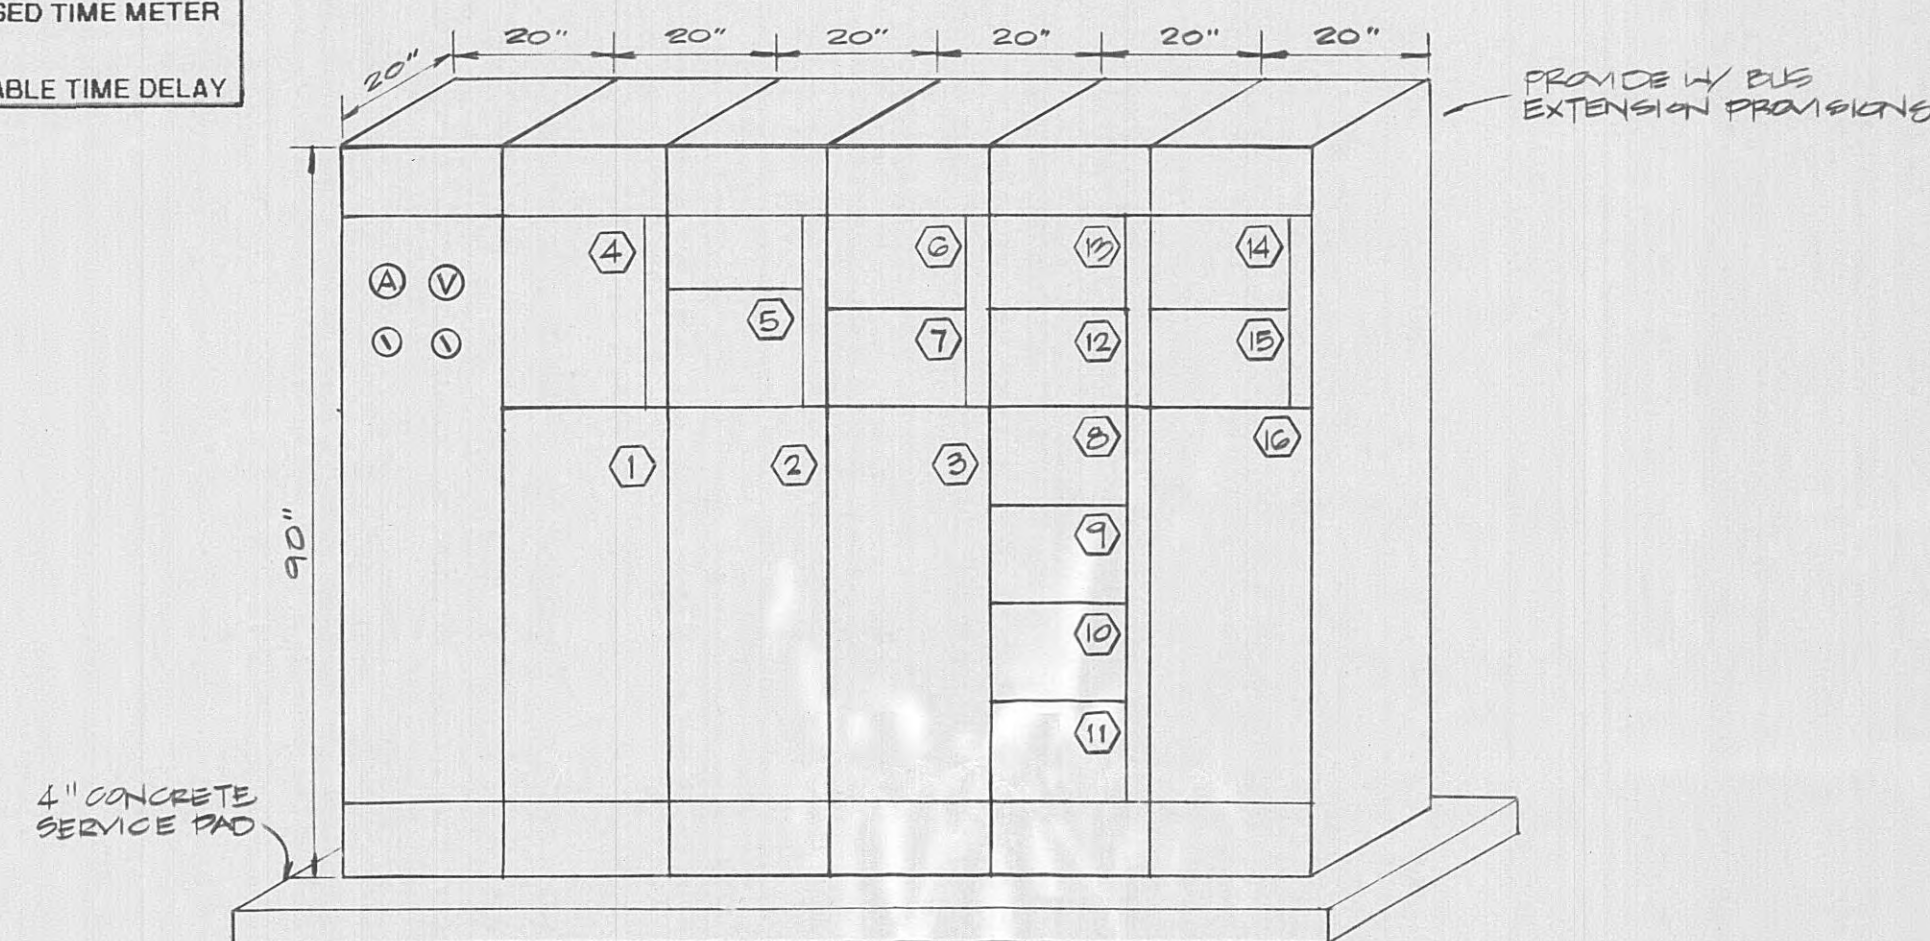

ELEVATION - MOTOR CONTROL CENTER "MCC1"

NO SCALE

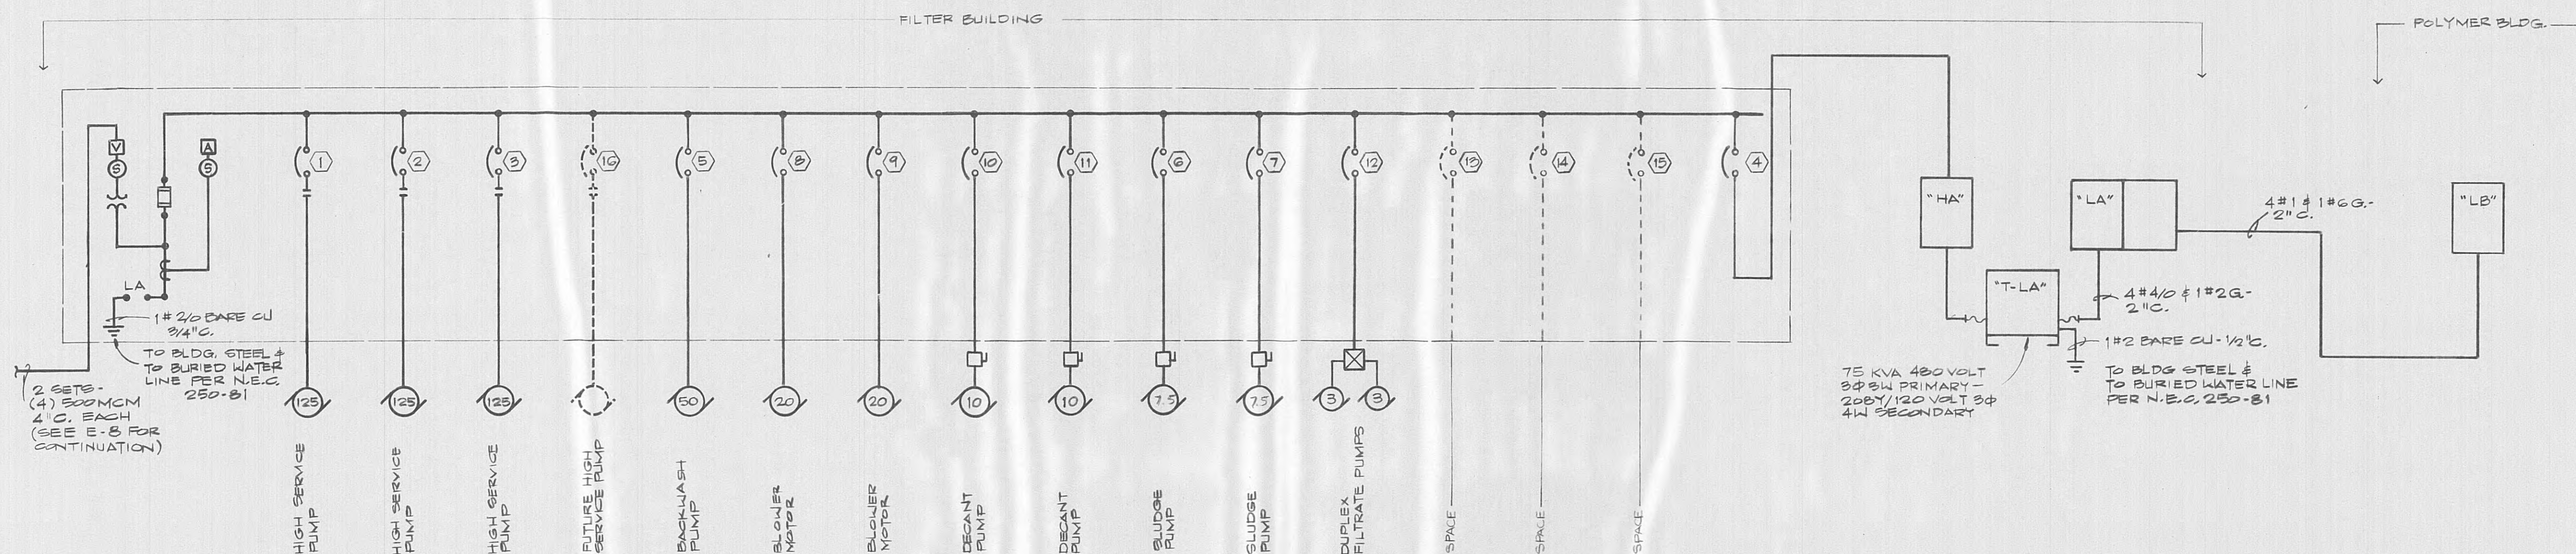

ONE LINE DIAGRAM & RISER - "MCC1"


NO SCALE

MOUNTING: SURFACE		C/B AIC RATING: 14,000A				PANEL SIZE: 225 AMP				
PANEL HA										
VOLTAGE: 480 DELTA, 3PH 3W				MAIN TYPE: M.L.O.						
LOCATION	WATTS/PHASE			C/B SIZE	CKT. NO.	C/B SIZE	WATTS/PHASE			LOCATION
	A	B	C				A	B	C	
SPACE	-	-	-	1	2	15/3	2500			EH - 2
SPACE				3	4	1		2500		
SPACE				5	6	1			2500	
A/C - 1	3879		20/3	7	8	15/3	1000			EH - 5
		3879		9	10	1		1000		
				11	12	1			1000	
TRANSFORMER "T-LA"	26265		100/3	13	14	15/3	720			AIR COMPRESSOR
		26265		15	16	1		720		
				17	18	1			720	
TROLLY	1274		15/3	19	20	-				SPACE
		1274		21	22	-				SPACE
				23	24	-				SPACE
SPACE			-	25	26	-				CARBON DUST COLLECTOR
SPACE			-	27	28	-				SPACE
SPACE			-	29	30	-				SPACE
SPACE			-	31	32	-				SPACE
SPACE			-	33	34	-				SPACE
SPACE			-	35	36	-				SPACE
SPACE			-	37	38	-				SPACE
SPACE			-	39	40	-				SPACE
SPACE			-	41	42	-				SPACE
TOTAL	31418	31418	31418				4220	4220	4220	TOTAL
LCL		W X 1.25 =		W			35638	35638	35638	PHASE TOTAL
AC= 11637 W; HEAT= 10500 W/ AC@125% HT @100% =				14546			106914			TOTAL WATT
MISC. LOAD				96414						
TOTAL LOAD				110460		W =				
LARGEST LOAD OF AC OR HEAT IS USED IN CALCS EXCEPT IN THE CASE OF HEAT PUMPS IN WHICH BOTH LOADS ARE USED.										
133.4 AMPS										

MOUNTING: SURFACE		C/B AIC RATING: 10,000				PANEL SIZE: 225 AMP					
PANEL LA											
VOLTAGE: 208Y/120V 3PH 4W				MAIN TYPE: 225A M.C.B.							
LOCATION	WATTS/PHASE			C/B SIZE	CKT. NO.	C/B SIZE	WATTS/PHASE			LOCATION	
	A	B	C				A	B	C		
RECEPT - FILTER BLDG	1080			20/1	1	2	20/1	540			RECEPT - LAB
RECEPT - FILTER BLDG		900		20/1	3	4	20/1		360		RECEPT - LAB
RECEPT - TELEPHONE			500	20/1	5	6	20/1			870	RECEPT - EWC
COFFEE MAKER	1500			20/1	7	8	20/1	1200			REFRIGERATOR
MICROWAVE		1200		20/1	9	10	20/1		1500		DISTILLERY
RECEPT - OFFICE			1080	20/1	11	12	20/1*			900	RECEPT - LAB
LTS - OPERATIONS	1450			20/1	13	14	20/1*	900			RECEPT - LAB
LTS - OPERATIONS		1450		20/1	15	16	20/1*		1080		RECEPT - LAB
LTS - OUTSIDE			1830	20/1	17	18	20/1			1630	LTG - CARBON,FLU,CHC
LTS - OPERATIONS	1160			20/1	19	20	20/1	1395			LTG - LAB
SPACE		-		20/1	21	22	20/1		1305		LTG - OFFICE
SPACE			-	20/1	23	24	20/1			500	CHLORINE ANALYZER
VF - 3,4,5	1188			20/1	25	26	20/2	1100			EH - 3
VH - 1,2		960		20/1	27	28	20/2		1100		
EH - 2			1000	20/2	29	30	20/2			1100	EH - 4
				31	32			1100			
VF - 1		795		15/2	33	34	20/1		984		VF - 2,3,4
			795	35	36	20/1				510	VF - 5
CARBON FEED	696			15/1	37	38	15/1	696			POLYMER METERING PP
CARBON MIXER		696			39	40	15/1		696		POLYMER METERING PP
POLYMER MIXER			696		41	42	15/1			696	FLUORIDE METERING PP
TURBIDIMETERS	540			20/1	43	44	20/1	180			CLEARWELL TRANSMITTER
PLANT CONTROL PANEL		600		20/1	45	46	30/2		2250		EWX
PLANT CONTROL PANEL			600	20/1	47	48				2250	
METERING PUMP	696			15/1	49	50	15/1	696			PHOSPHATE MIXER
METERING PUMP		696		15/1	51	52	15/1		696		CAUSTIC MIXER
METERING PUMP			696	15/1	53	54	15/1			696	ALUM MIXER
METERING PUMP	696			15/1	55	56	15/1	500			MANIFOLD HEATER
METERING PUMP		696		15/1	57	58	15/1		500		MANIFOLD HEATER
SPACE		-		-	59	60	-			-	SPACE
LAB CONTROL	600			20/1	61	62	20/1	600			LAB CONTROL
LAB CONTROL		600		20/1	63	64	20/1		600		LAB CONTROL
LAB CONTROL			600	20/1	65	66	20/1			600	LAB CONTROL
LAB CONTROL	600			20/1	67	68	20/1	600			LAB CONTROL
LAB CONTROL		600		20/1	69	70	20/1		600		LAB CONTROL
LAB CONTROL			600	20/1	71	72	20/1			600	LAB CONTROL
RANGE	3500			50/2	73	74	100/3	3000			PANEL "LB"
		3500			75	76			3000		
			3500	50/2	77	78				3000	
	3500				79	80	20/1	180			AIR DRYER
FUTURE RANGE		3500		50/2	81	82	20/1	1130			VF #8
			3500	83	84	20/1			1130		VF #9
TOTAL	10132	10192	9496					5756	7646	7146	TOTAL
LCL	10220	W X 1.25 =		12775	W			30713	30864	28249	PHASE TOTAL
AC= 3084 W;HEAT 8548 W/AC@125% HT @100% =				8548	W						PHASE TOTAL
MISC. LOAD				57474	W					89826	TOTAL WATTS
LARGEST LOAD OF AC OR HEAT IS USED IN CALCS EXCEPT IN THE CASE OF HEAT PUMPS IN WHICH BOTH LOADS ARE USED.											
TOTAL LOAD				=	78797	W	=	218 AMPS			


AS BUILT

DATE: 3-20-95  
APPROVED: D.M.

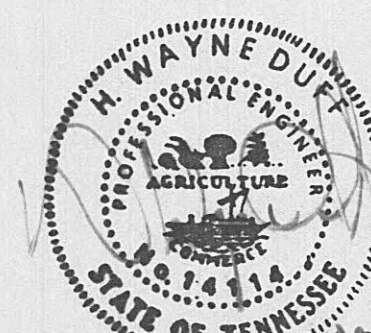

DUFF BROWN  
ENGINEERING INC.  
783 OLD HICKORY BLVD., BRENTWOOD, TN. 37027 (615) 377-3757

ELROD • DUNSON, INC.  
CONSULTING ENGINEERS  
NASHVILLE • KNOXVILLE  
LEXINGTON, KY

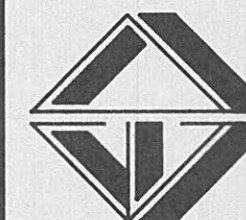

CONTRACT W93-04

HARRMAN, TENNESSEE  
FILTER BUILDING ONE LINE DIAGRAM

REVISIONS

DESIGNED: JFS  
DRAWN: JFS  
CHECKED: HWD  
DATE: 04-02-93  
SCALE: NOTED  
PROJ. NO. 0592

SHEET 31  
E-5  
OF 36









ELEVATION - MOTOR  
CONTROL CENTER "MCC2"

ONE LINE  
DIAGRAM & RISER - "MCC2"

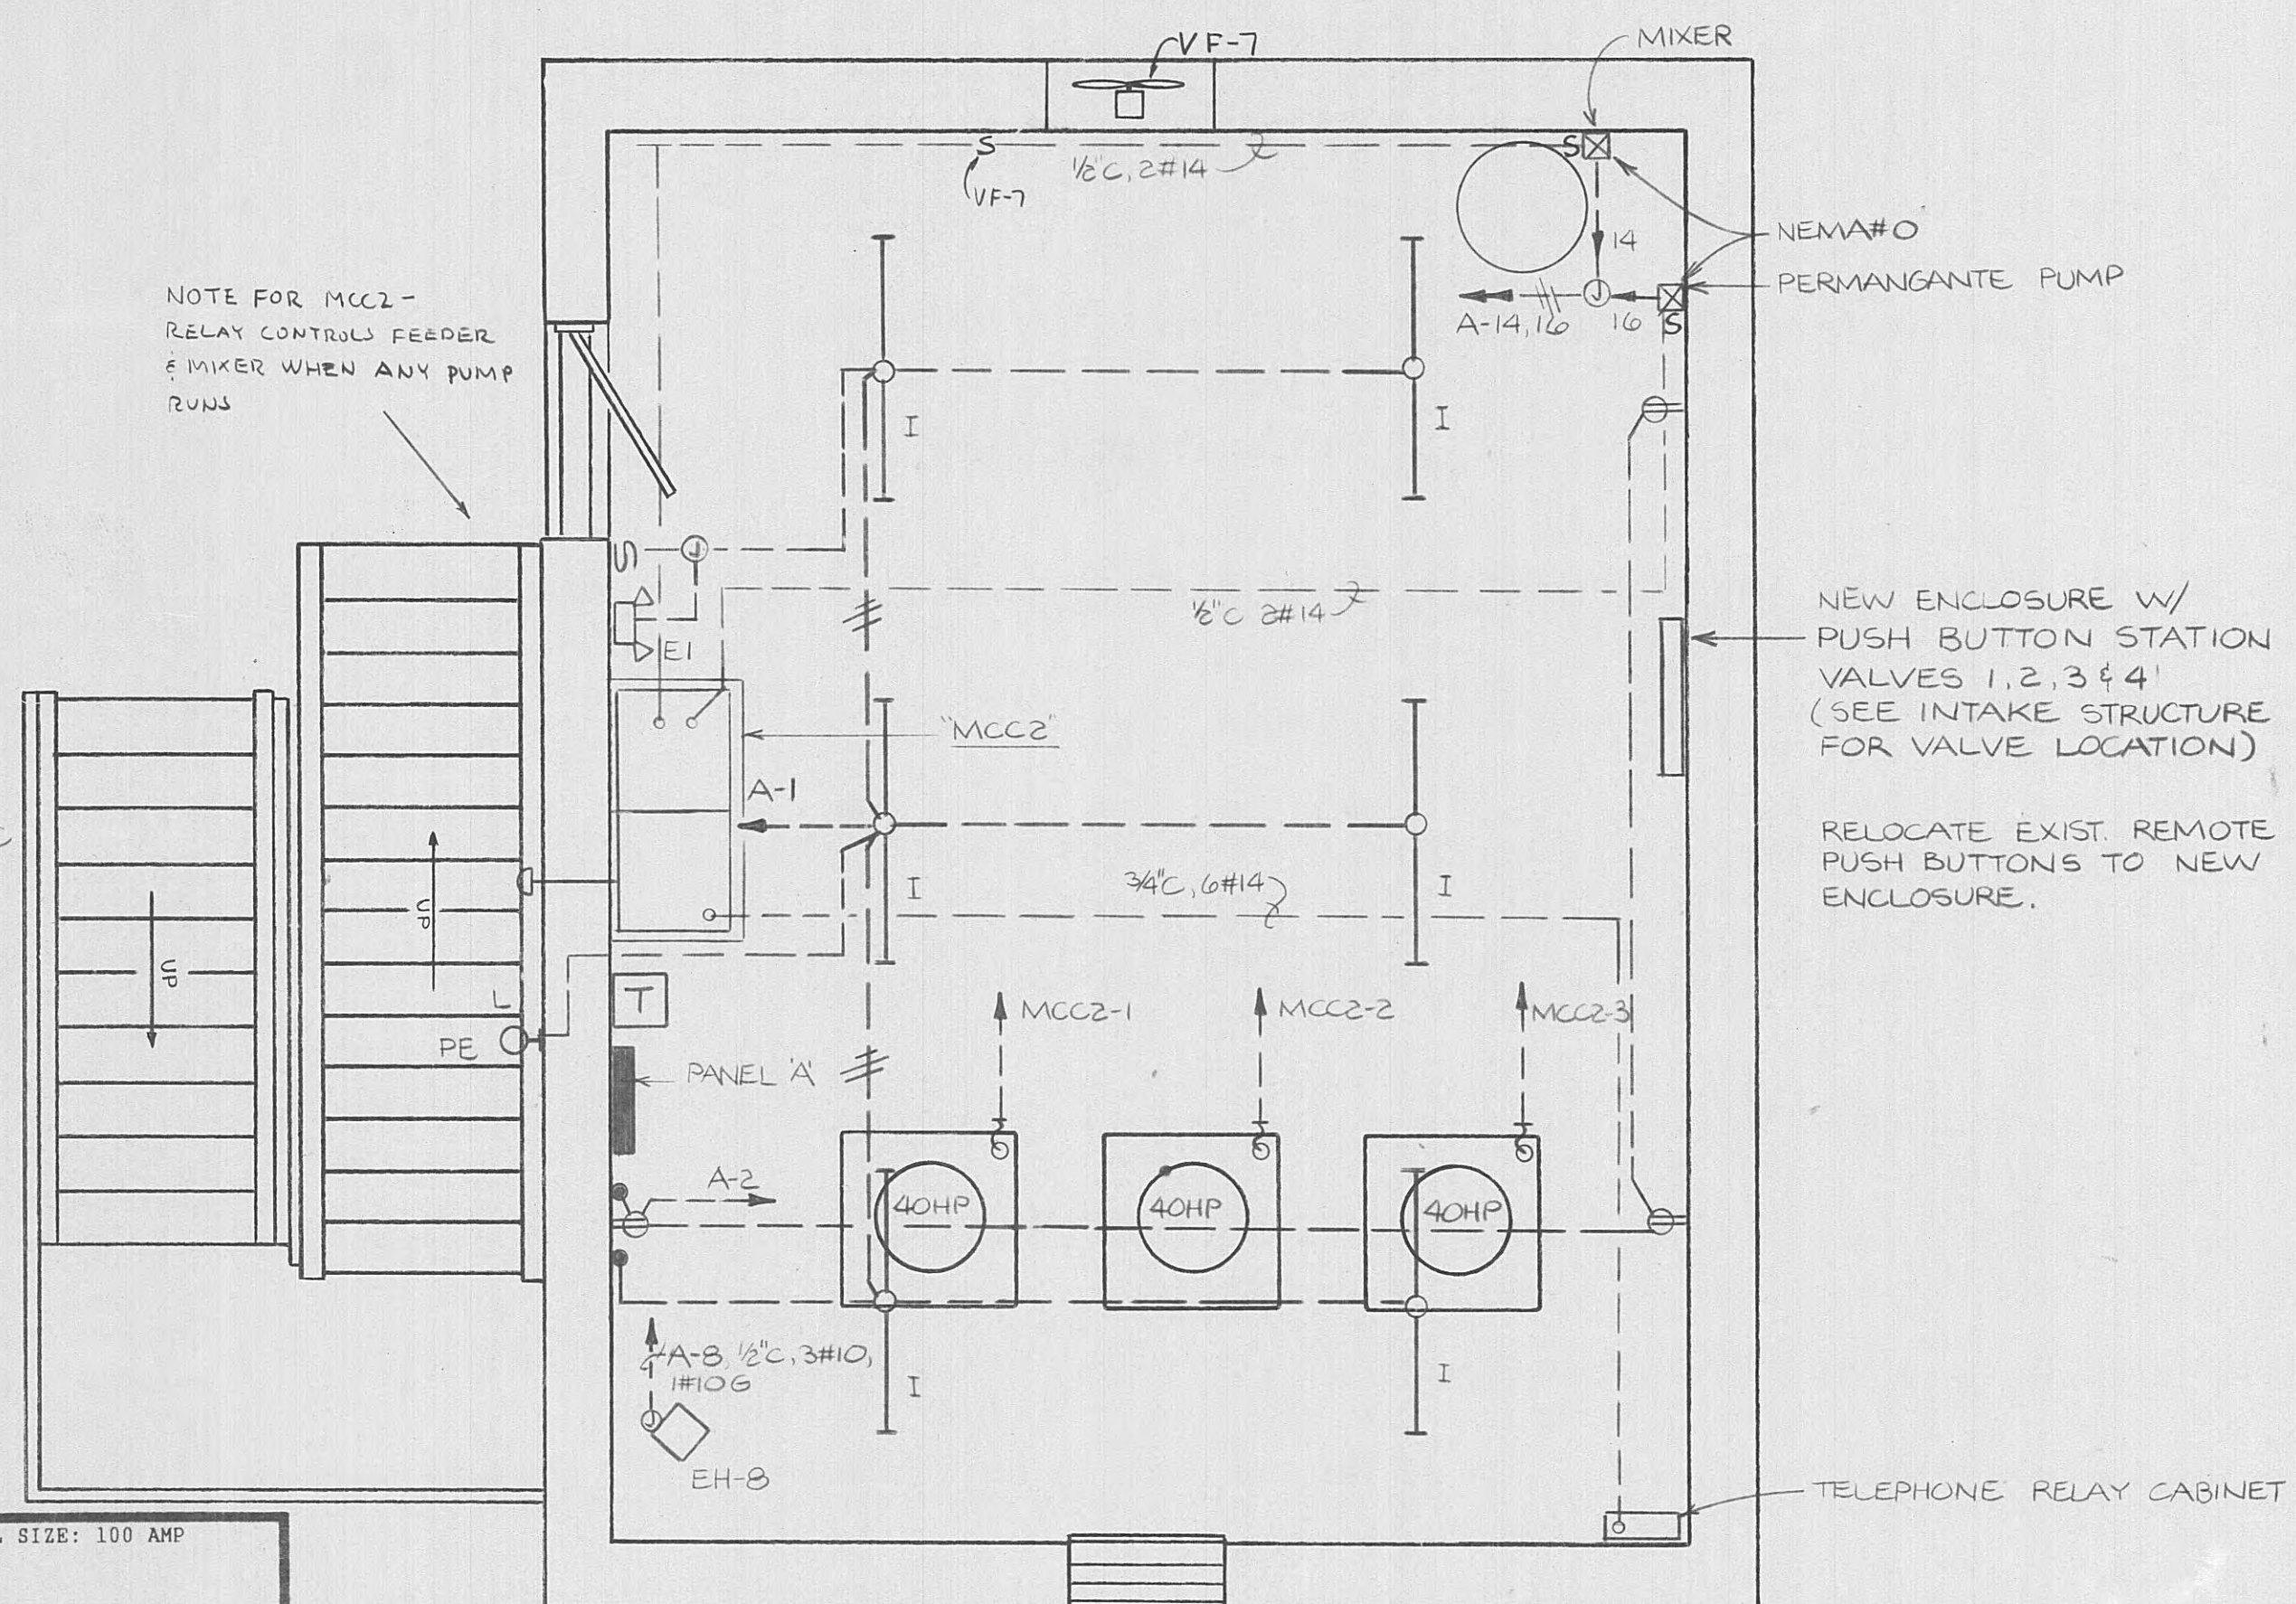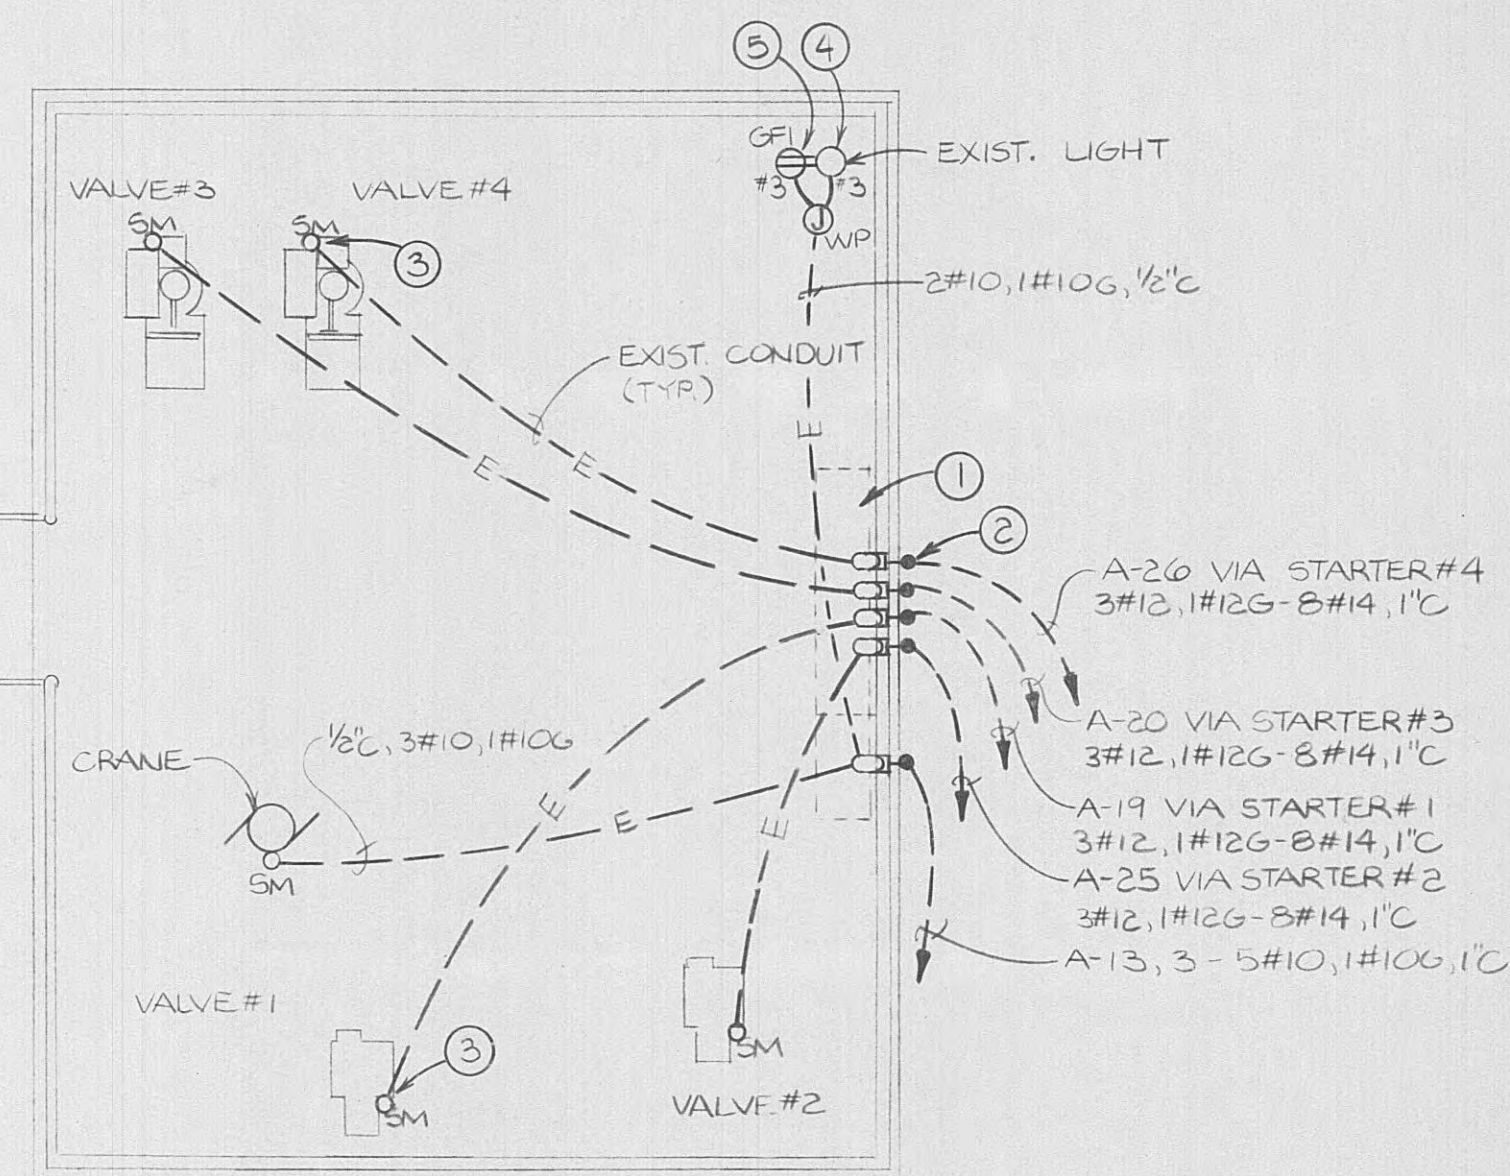


ELEVATION 778.06

MOTOR CONTROL CENTER SCHEDULE									
VOLTS, AMPS, & A.S.I.C.	BRANCH CIRCUIT BREAKER			STARTER	CONTROL ITEM ON STARTER	LOAD		CONDUIT & WIRE	FEEDS
	CIR. NO.	AMPS	POLES			KVA	H.P.		
400A 480, 3PH-1 3 WIRE 25,000A	1	90	3	X-LINE NEMA SIZE 3	S-P-ETM-A	43.2	40	1-1/4" C 3#3 1#8G	INTAKE PUMP
	2	90	3	X-LINE NEMA SIZE 3	S-P-ETM-A	43.2	40	1-1/4" C 3#3 1#8G	INTAKE PUMP
	3	90	3	X-LINE NEMA SIZE 3	S-P-ETM-A	43.2	40	1-1/4" C 3#3 1#8G	INTAKE PUMP
	4	45	3	CIRCUIT BREAKER	-	23.6	-	34" C 3#8 1#10G	TRANSF "A"
	5	-	3	SPACE W/PROVISIONS	-	-	-	-	-
	6	-	3	SPACE W/PROVISIONS	-	-	-	-	-

### STARTER CONTROL ITEM LEGEND

S - START/STOP PUSHBUTTONS    A - AMMETER  
P - PILOT LIGHT (GREEN)    ETM - ELAPSED TIME METER  
H - HAND-OFF AUTO SEL. SWITCH  
PF - PHASE FAILURES RELAY W/ADJUSTABLE TIME DELAY

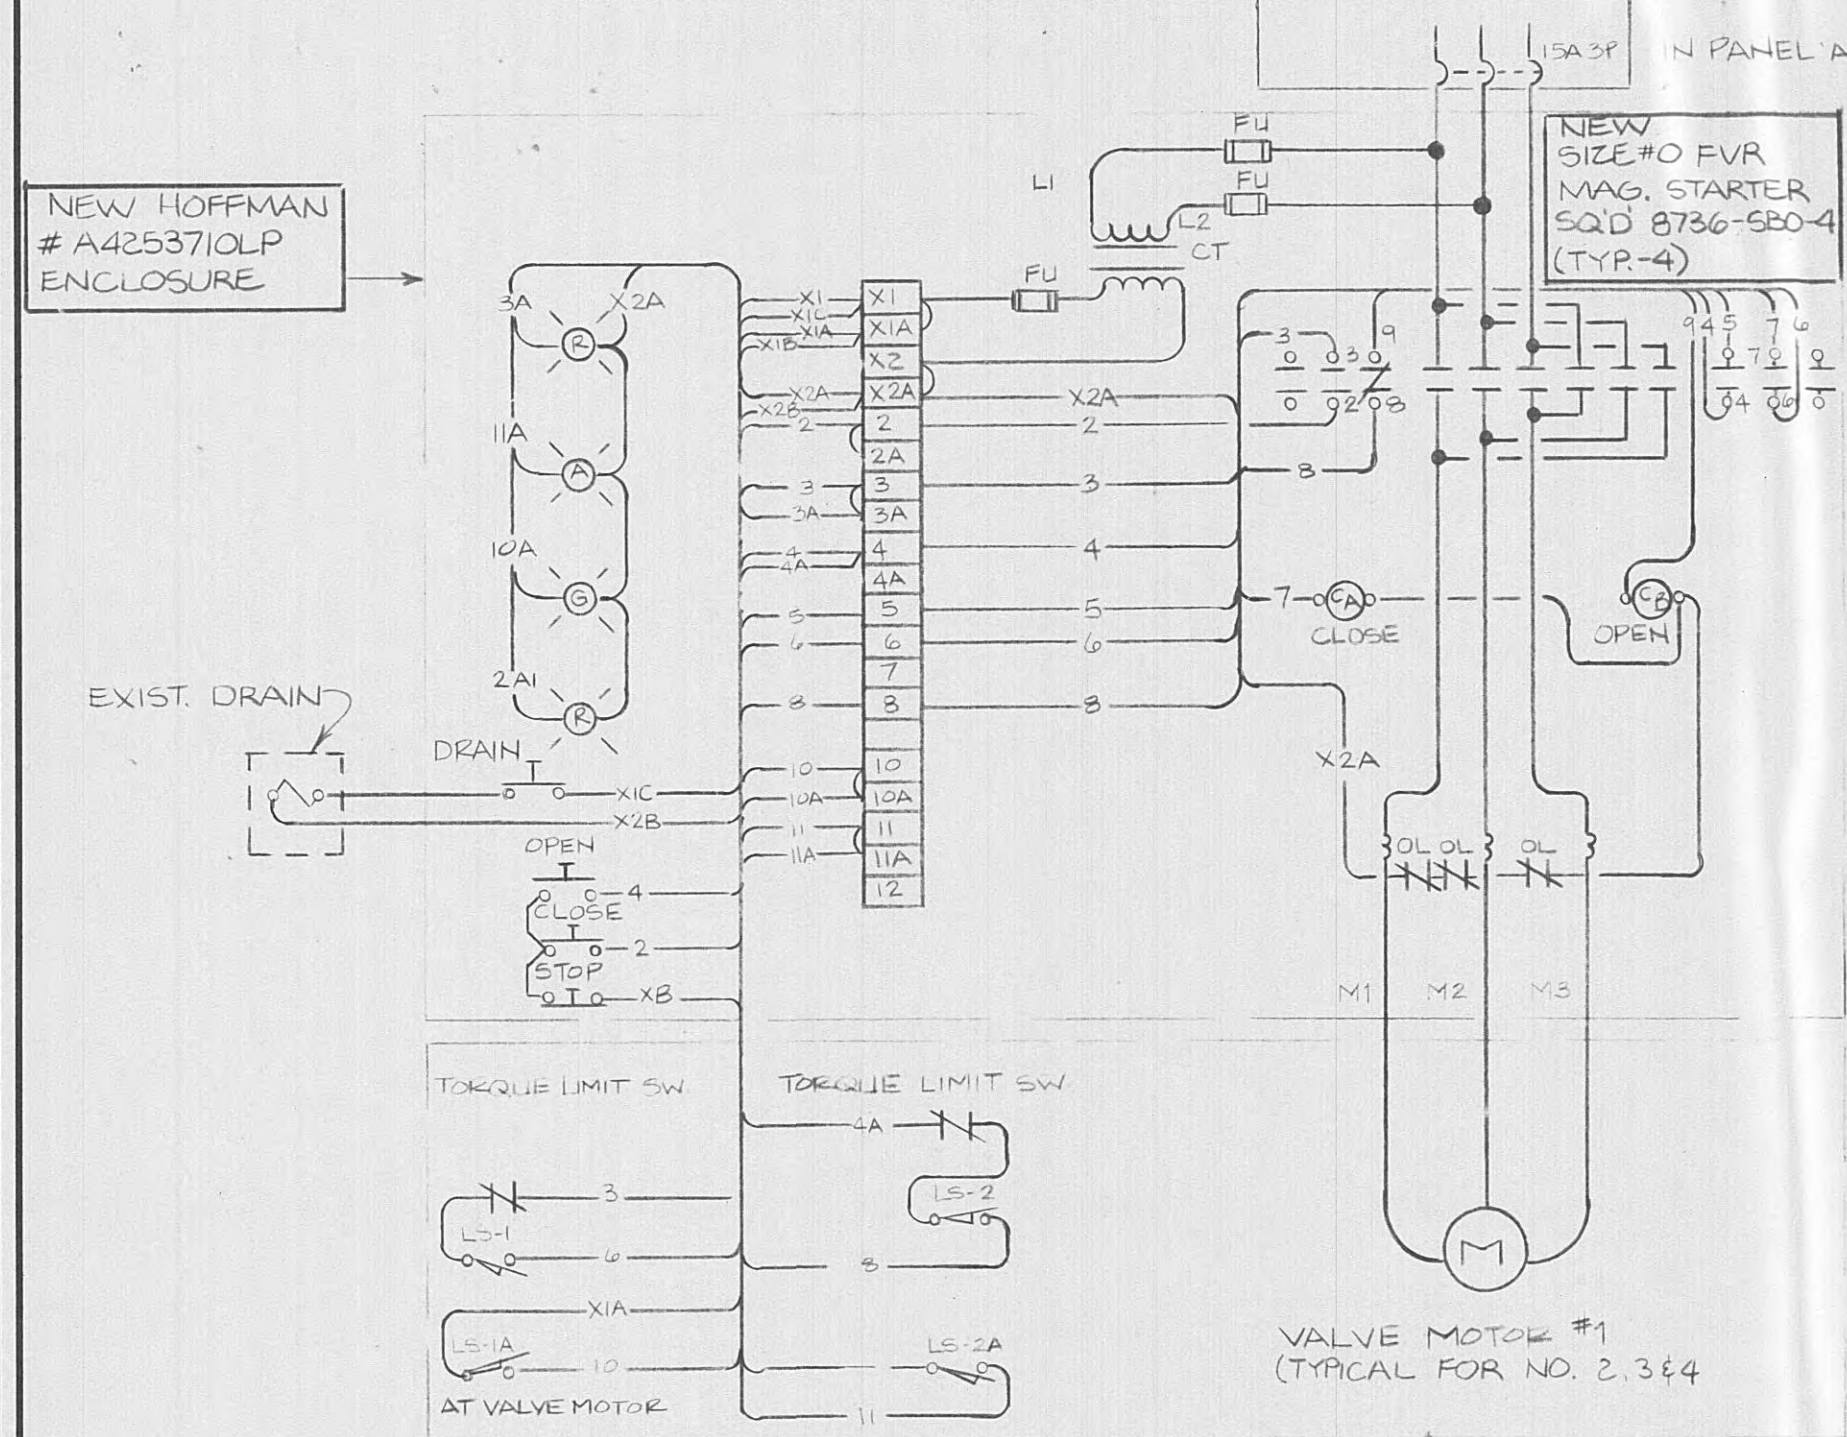

**TYPICAL VALVE MOTOR SCHEMATIC DIAGRAM**  
NO SCALE

NOTE: PROVIDE NEW ENCLOSURE & MAG STARTERS. RELOCATE ALL OTHER WIRING DEVICES FROM OLD ENCLOSURE TO NEW ENCLOSURE (SEE WATER INTAKE BLDG. FOR NEW LOCATION)

HOUNTING: SURFACE

C/B A/C RATING: 10,000

PANEL SIZE: 100 AMP

PANEL A

MAIN TYPE: 100A M.C.B.

VOLTAGE: 208Y/120V 3PH 4W

LOCATION

WATTS/PHASE

C/B SIZE

CKT. NO.

C/B SIZE

WATTS/PHASE

LOCATION

LTS - PUMP BLDG

850

20/1

1 2

20/1

900

RECEPT - PUMP BLDG.

L7/RECEPT-INTAKE STRUCTURE

210

20/1

3 4

20/1

SPARE

5 6

20/1

SPARE

EH - 7

1667

20/3

7 8

30/3

2500

EH - 8

|

1667

|

9 10

|

2500

|

|

1667

|

11 12

|

2500

|

CRANE

1707

20/3

13 14

20/1

670

MIXER

|

1707

|

15 16

20/1

670

PERMANGANTE PUMP

|

1707

|

17 18

VALVE #1

200

15/3

19 20

15/3

200

VALVE #3

|

200

|

21 22

|

200

|

|

200

|

23 24

|

200

|

VALVE #2

200

15/3

25 26

15/3

200

VALVE #4

|

200

|

27 28

|

200

|

|

200

|

29 30

|

200

|

31 32

VF-7

33 34

35 36

37 38

39 40

41 42

TOTAL

4624

3984

3774

4470

3570

2900

TOTAL

LCL

1060

W X 1.25 =

1325

W

9094

7554

6674

PHASE TOTAL

AC=

W; HEAT= 12500

WAC#125H

HT #100% =

12500

W

MISC. LOAD

=

9762

W

23322

TOTAL WATTS

TOTAL LOAD

=

23587

W


=

LARGEST LOAD OF AC OR HEAT IS USED IN CALCS EXCEPT IN THE CASE OF HEAT PUMPS IN WHICH BOTH LOADS ARE USED.

65.5 AMPS

## ELECTRICAL NOTES: E-7

- 1 REMOVE EXISTING PUMP CONTROL PANEL AND EXISTING PANEL "A".
- 2 INTERCEPT EXISTING 1" CONDUITS STUBBED UP WITH NEW PULL 90  
ELBOW. ROUTE NEW 1" CONDUITS DOWN EXISTING STRUCTURE TO NEW  
PUSH BUTTON STATION LOCATION.
- 3 REMOVE EXISTING FLEXIBLE CONNECTION AND INSTALL NEW RIGID  
CONDUIT UP ABOVE 770.5' FLOOD ELEVATION. INSTALL NEW 3-POLE  
MANUAL SWITCH EQUAL TO SQUARE D CLASS 2510 NEMA 4 ENCLOSURE.  
TYPICAL FIVE LOCATIONS.
- 4 CLEAN AND RELAMP EXISTING LIGHT FIXTURE.
- 5 INSTALL NEW GPI RECEPTACLE ON EXISTING LIGHT ABOVE 770.5'  
FLOOD ELEVATION.
- 6 REMOVE EXISTING TELEMETRY EQUIPMENT AT THE EXISTING WATER  
PLANT FOR REMOVE TANK LEVEL INDICATORS AND RELOCATE TO THE  
ELECTRICAL CLOSE TO THE FILTER BUILDING NEXT TO THE SCADA  
PANEL. FINAL CONNECTION OF TELEMETRY EQUIPMENT SHALL BE BY  
OTHERS.
- 7 MAINTAIN POWER TO ONE OF THE RAW WATER PUMPS AT ALL TIMES  
DURING CONSTRUCTION. RELOCATE EXISTING EQUIPMENT OR PROVIDE  
TEMPORARY SERVICE FOR MAINTAINING PUMP POWER AS NECESSARY.  
COORDINATE WITH ENGINEER AS TO WHICH PUMP IS REQUIRED TO  
MAINTAIN SERVICE.

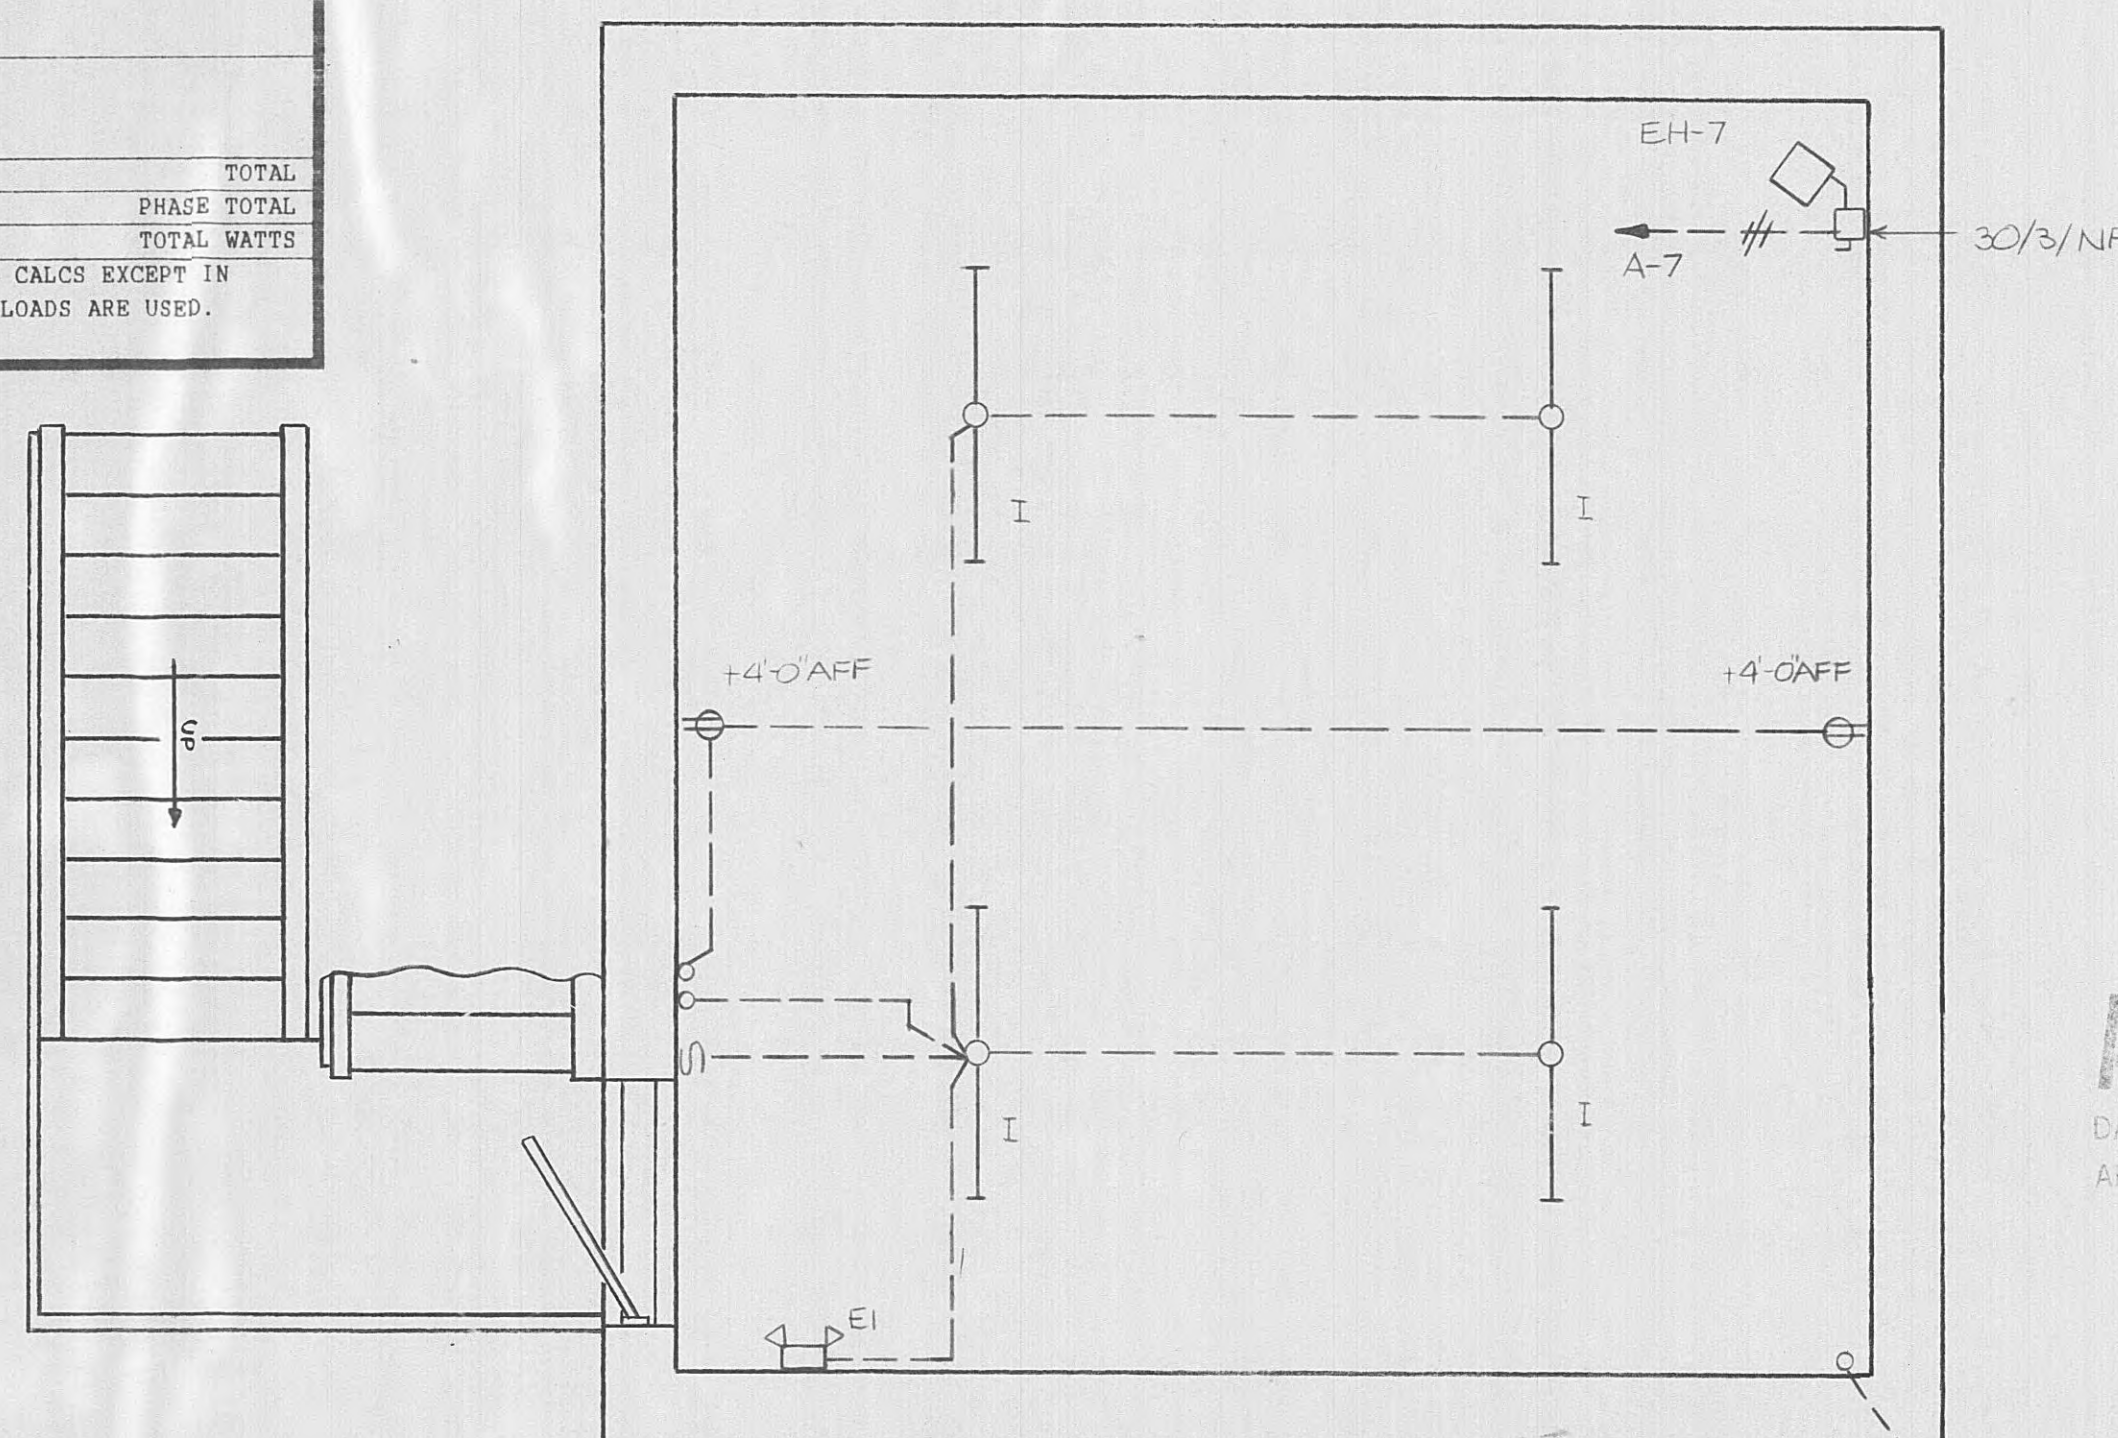

ELEVATION 768.35

# WATER INTAKE BUILDING ELECTRICAL PLAN

AS BUILT  
DATE: 3-20-95  
APPROVED: D.M.



**DUFF BROWN**  
**ENGINEERING INC.**  
 783 OLD HICKORY BLVD. BRENTWOOD, TN. 37027 (615) 377-3757

CONTRACT W93-04


HARRIMAN, TENNESSEE

## REVISIONS

DESIGNED: D.L.S.  
DRAWN: D.L.S.  
CHECKED: K.D.S.  
DATE: MARCH 31, 1993  
SCALE: SHOWN  
PROJ. NO. 0532


SHEET 33  
**E-7**  
OF 36



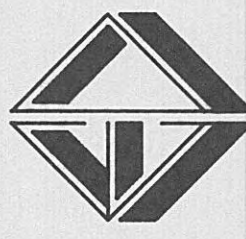


REVISIONS


DESIGNED: D.L.S.  
DRAWN: M.R.A.  
CHECKED: H.W.D.  
DATE: MARCH 31, 1993  
SCALE: 1" = 50'  
PROJ. NO. 0592

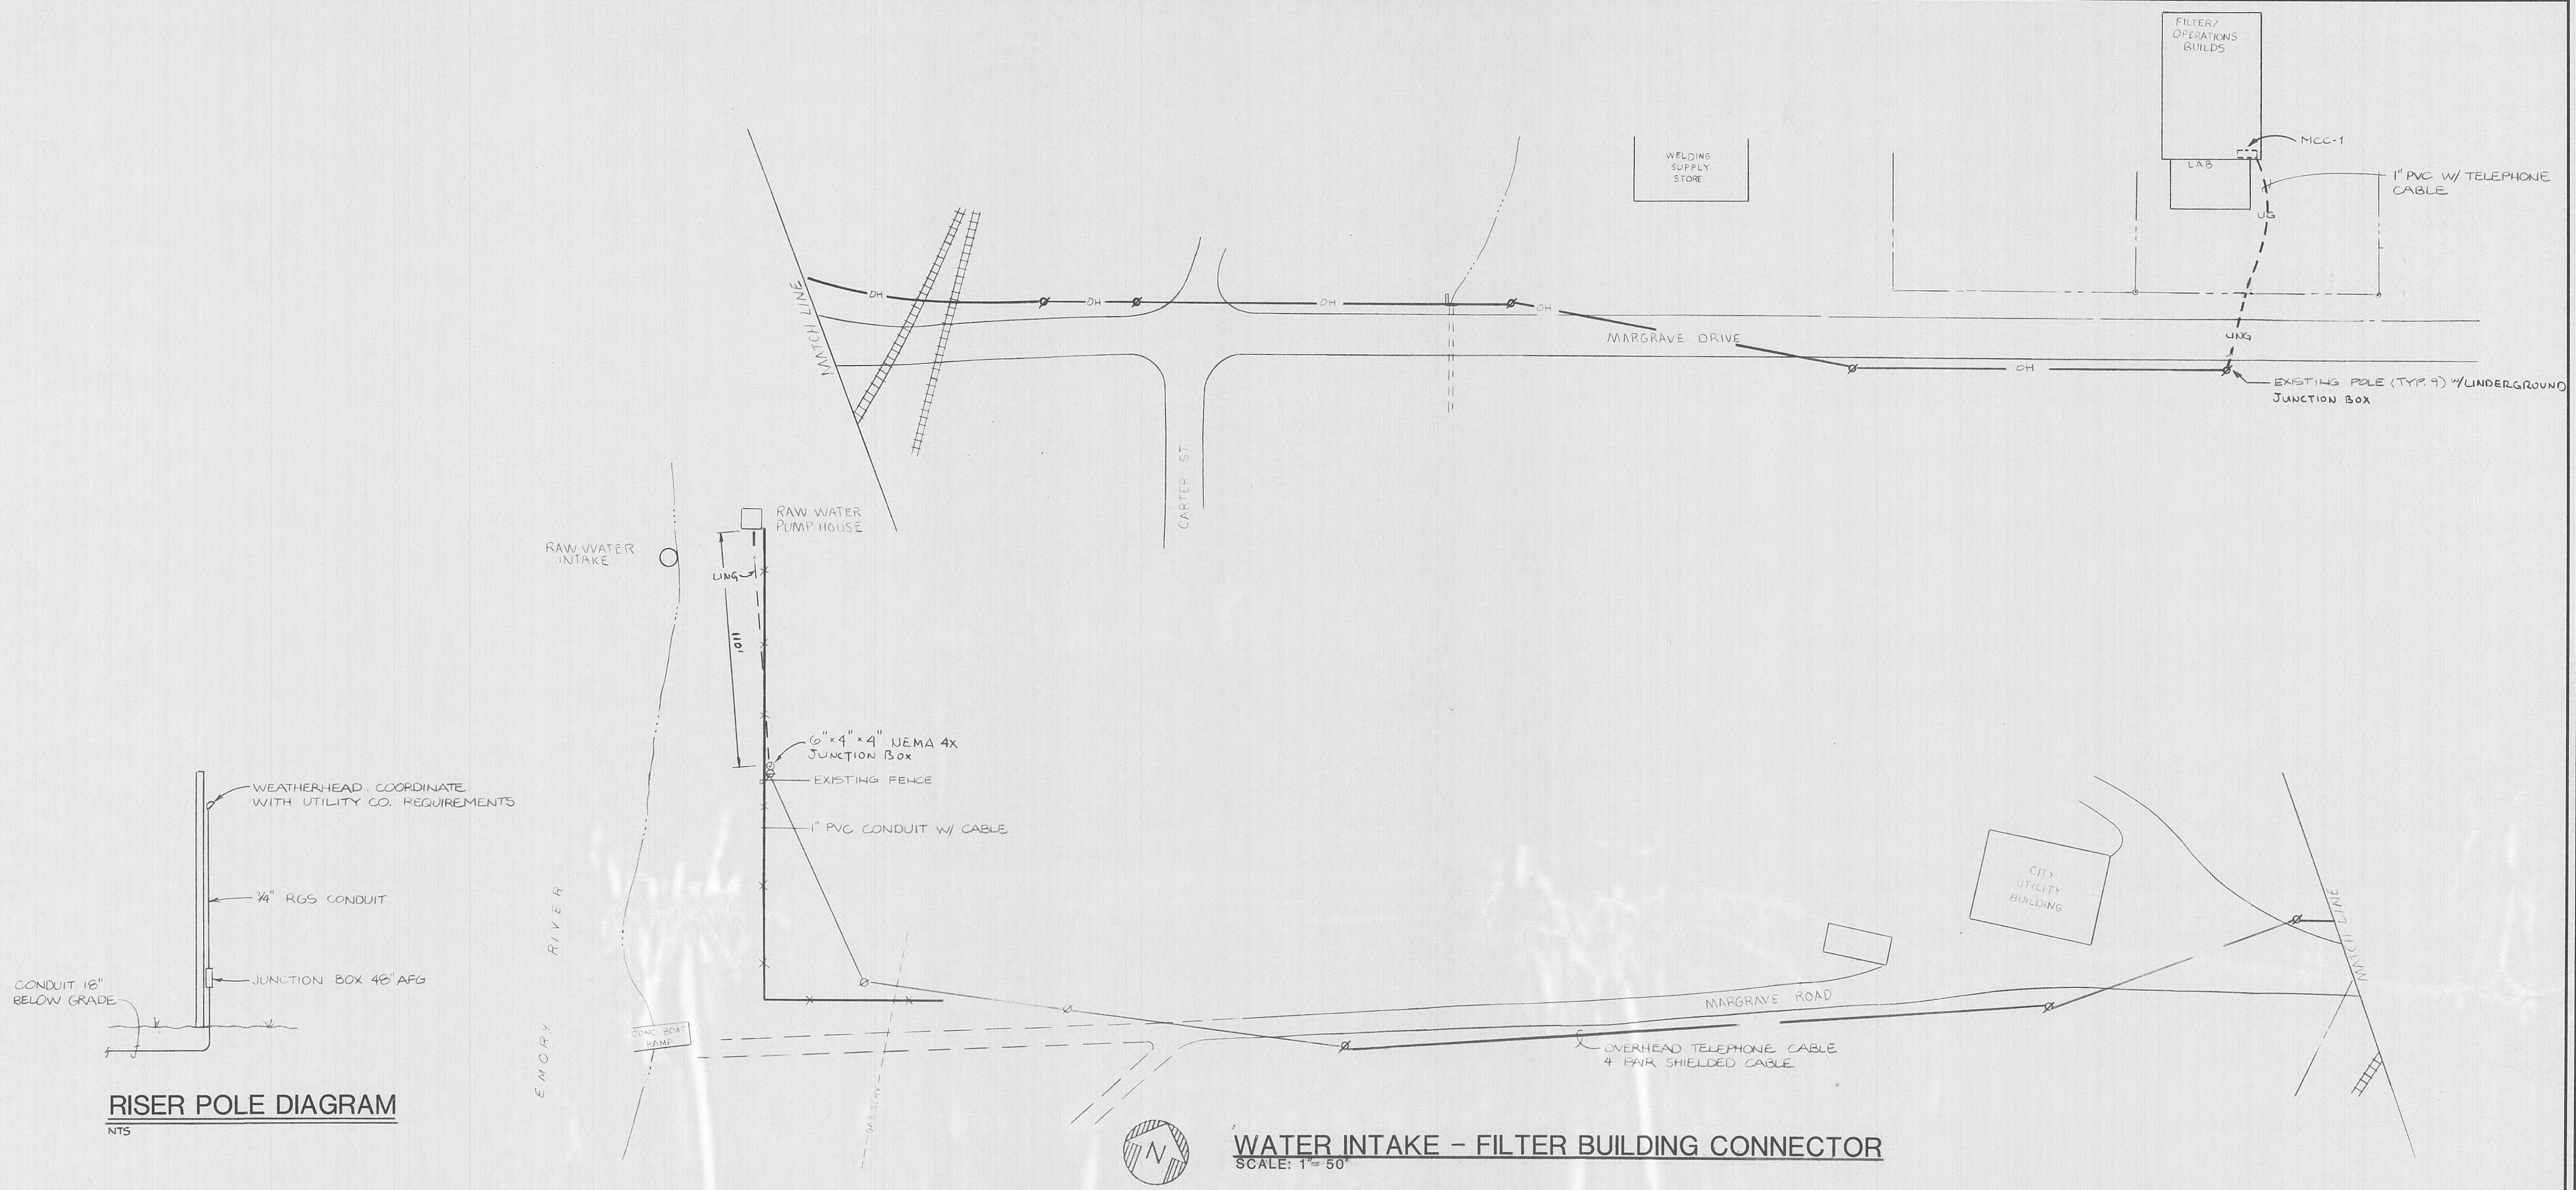

**RISER POLE DIAGRAM**  
NT5

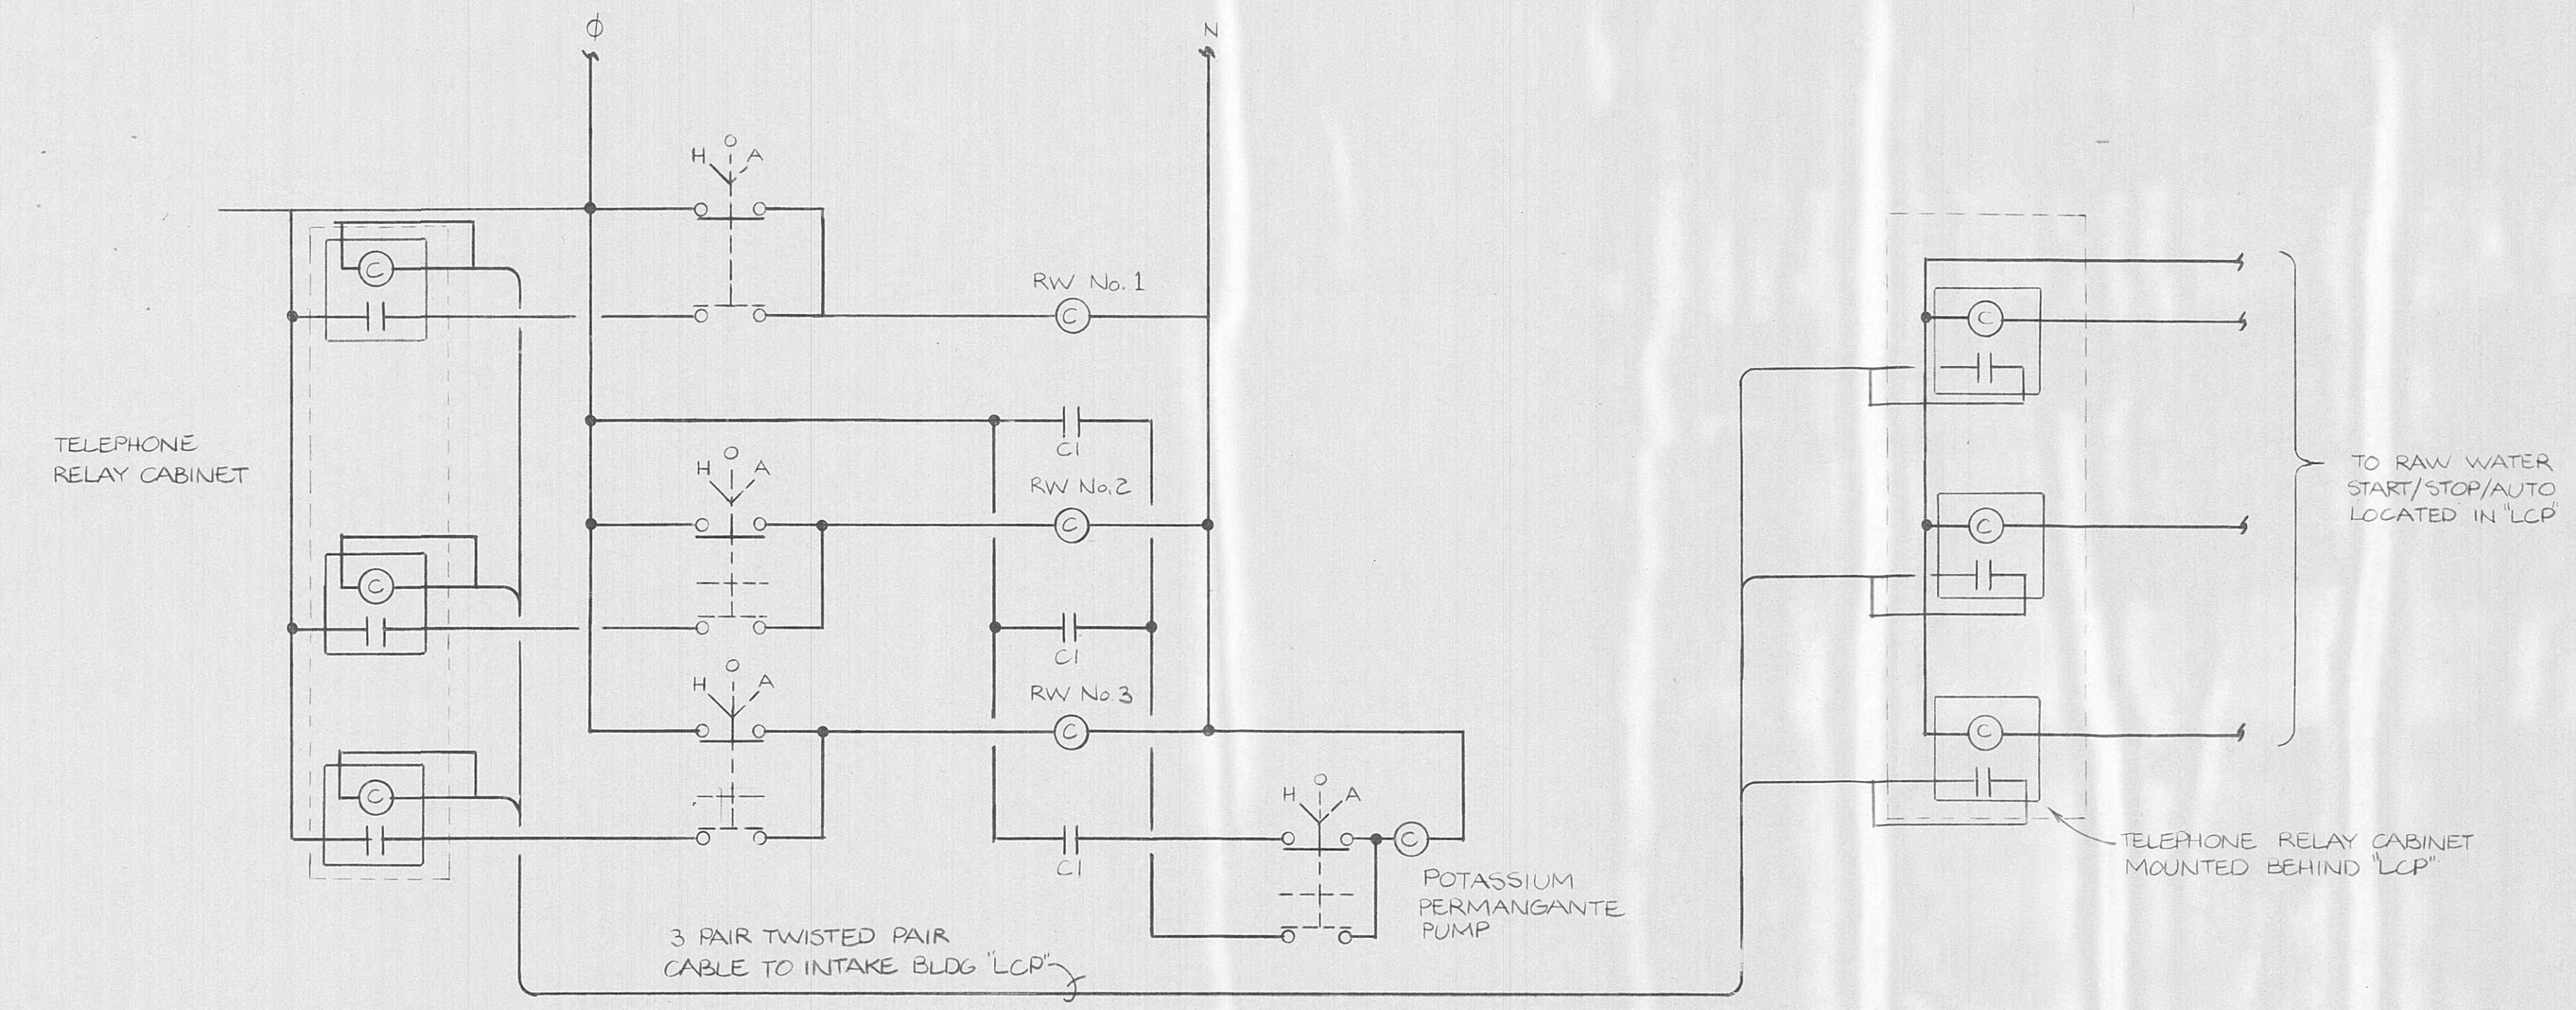


**AS BUILT**  
DATE: 3-20-95  
APPROVED: D.M.

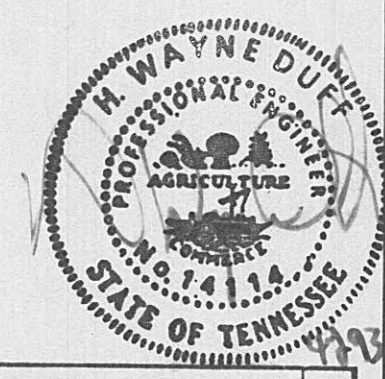

**DUFF BROWN**  
ENGINEERING INC.  
783 OLD HICKORY BLVD. BRENTWOOD, TN. 37027 (615) 377-3757




- KEY NOTES
- KEY NOTES ARE INDICATED ON DRAWING BY NUMBER ENCLOSED INSIDE SYMBOL.
- AIR HANDLING UNIT #1 NOMINAL 6 TON.
  - 4" CONCRETE PAD.
  - FLEX CONNECTOR.
  - WEATHER PROOF DUCTWORK.
  - SHEET METAL SHROUD.
  - CHASE BY GENERAL CONTRACTOR.
  - MANUAL VOLUME DAMPER (TYPICAL).
  - SIDEWALL RETURN GRILLE MOUNTED 6" ABOVE FINISHED FLOOR.
  - 8" ROUND TOILET EXHAUST UP TO ROOFJACK.
  - THERMOSTAT MOUNTED 48" ABOVE FINISHED FLOOR.
  - NOT USED
  - SEE AIR DEVICE SCHEDULE FOR RUNOUT SIZE (TYPICAL).
  - UNIT HEATER SHALL BE MOUNTED 12'-0" ABOVE FINISHED FLOOR (TYPICAL).
  - 7" ROUND FLUE UP TO APPROVED CAP.
  - 5" ROUND FLUE UP TO APPROVED CAP.
  - ELECTRIC UNIT HEATER MOUNTED 7'-6" ABOVE FINISHED FLOOR.
  - EXPLOSION PROOF ELECTRIC UNIT HEATER MOUNTED 10'-0" ABOVE FINISHED FLOOR.
  - VENTILATION FAN MOUNTED 10'-0" ABOVE FINISHED FLOOR.
  - VENTILATION FAN MOUNTED 7'-0" ABOVE FINISHED FLOOR.
  - VENTILATION FAN MOUNTED 1'-6" ABOVE FINISHED FLOOR.
  - NEW GAS METER LOCATED BY GAS COMPANY. ALL FEES SHALL BE PAID BY MECHANICAL CONTRACTOR. TOTAL CONNECTED LOAD 669 MBH AT 7" W.C.
  - 72" X 48" OUTSIDE AIR INTAKE LOUVER WITH BIRDSCREEN (AS HIGH AS POSSIBLE).
  - 30" X 24" INTAKE DUCT DOWN TO WITHIN 18" ABOVE FINISHED FLOOR. PROVIDE CORROSION RESISTANT DUCTWORK.
  - 6" DIAMETER (SCREENED) INTAKE DUCT (AS HIGH AS POSSIBLE).
  - 20" X 12" (SCREENED) INTAKE DUCT (AS HIGH AS POSSIBLE).
  - VENTILATION FAN INTERLOCKED WITH OUTSIDE AIR INTAKE LOUVER (MOUNTED AS HIGH AS POSSIBLE).
  - (2) 60" X 68" OUTSIDE AIR INTAKE LOUVERS (MOUNTED AS HIGH AS POSSIBLE). PROVIDE MOTOR ACTUATOR TO INTERLOCK WITH VENTILATION FAN.

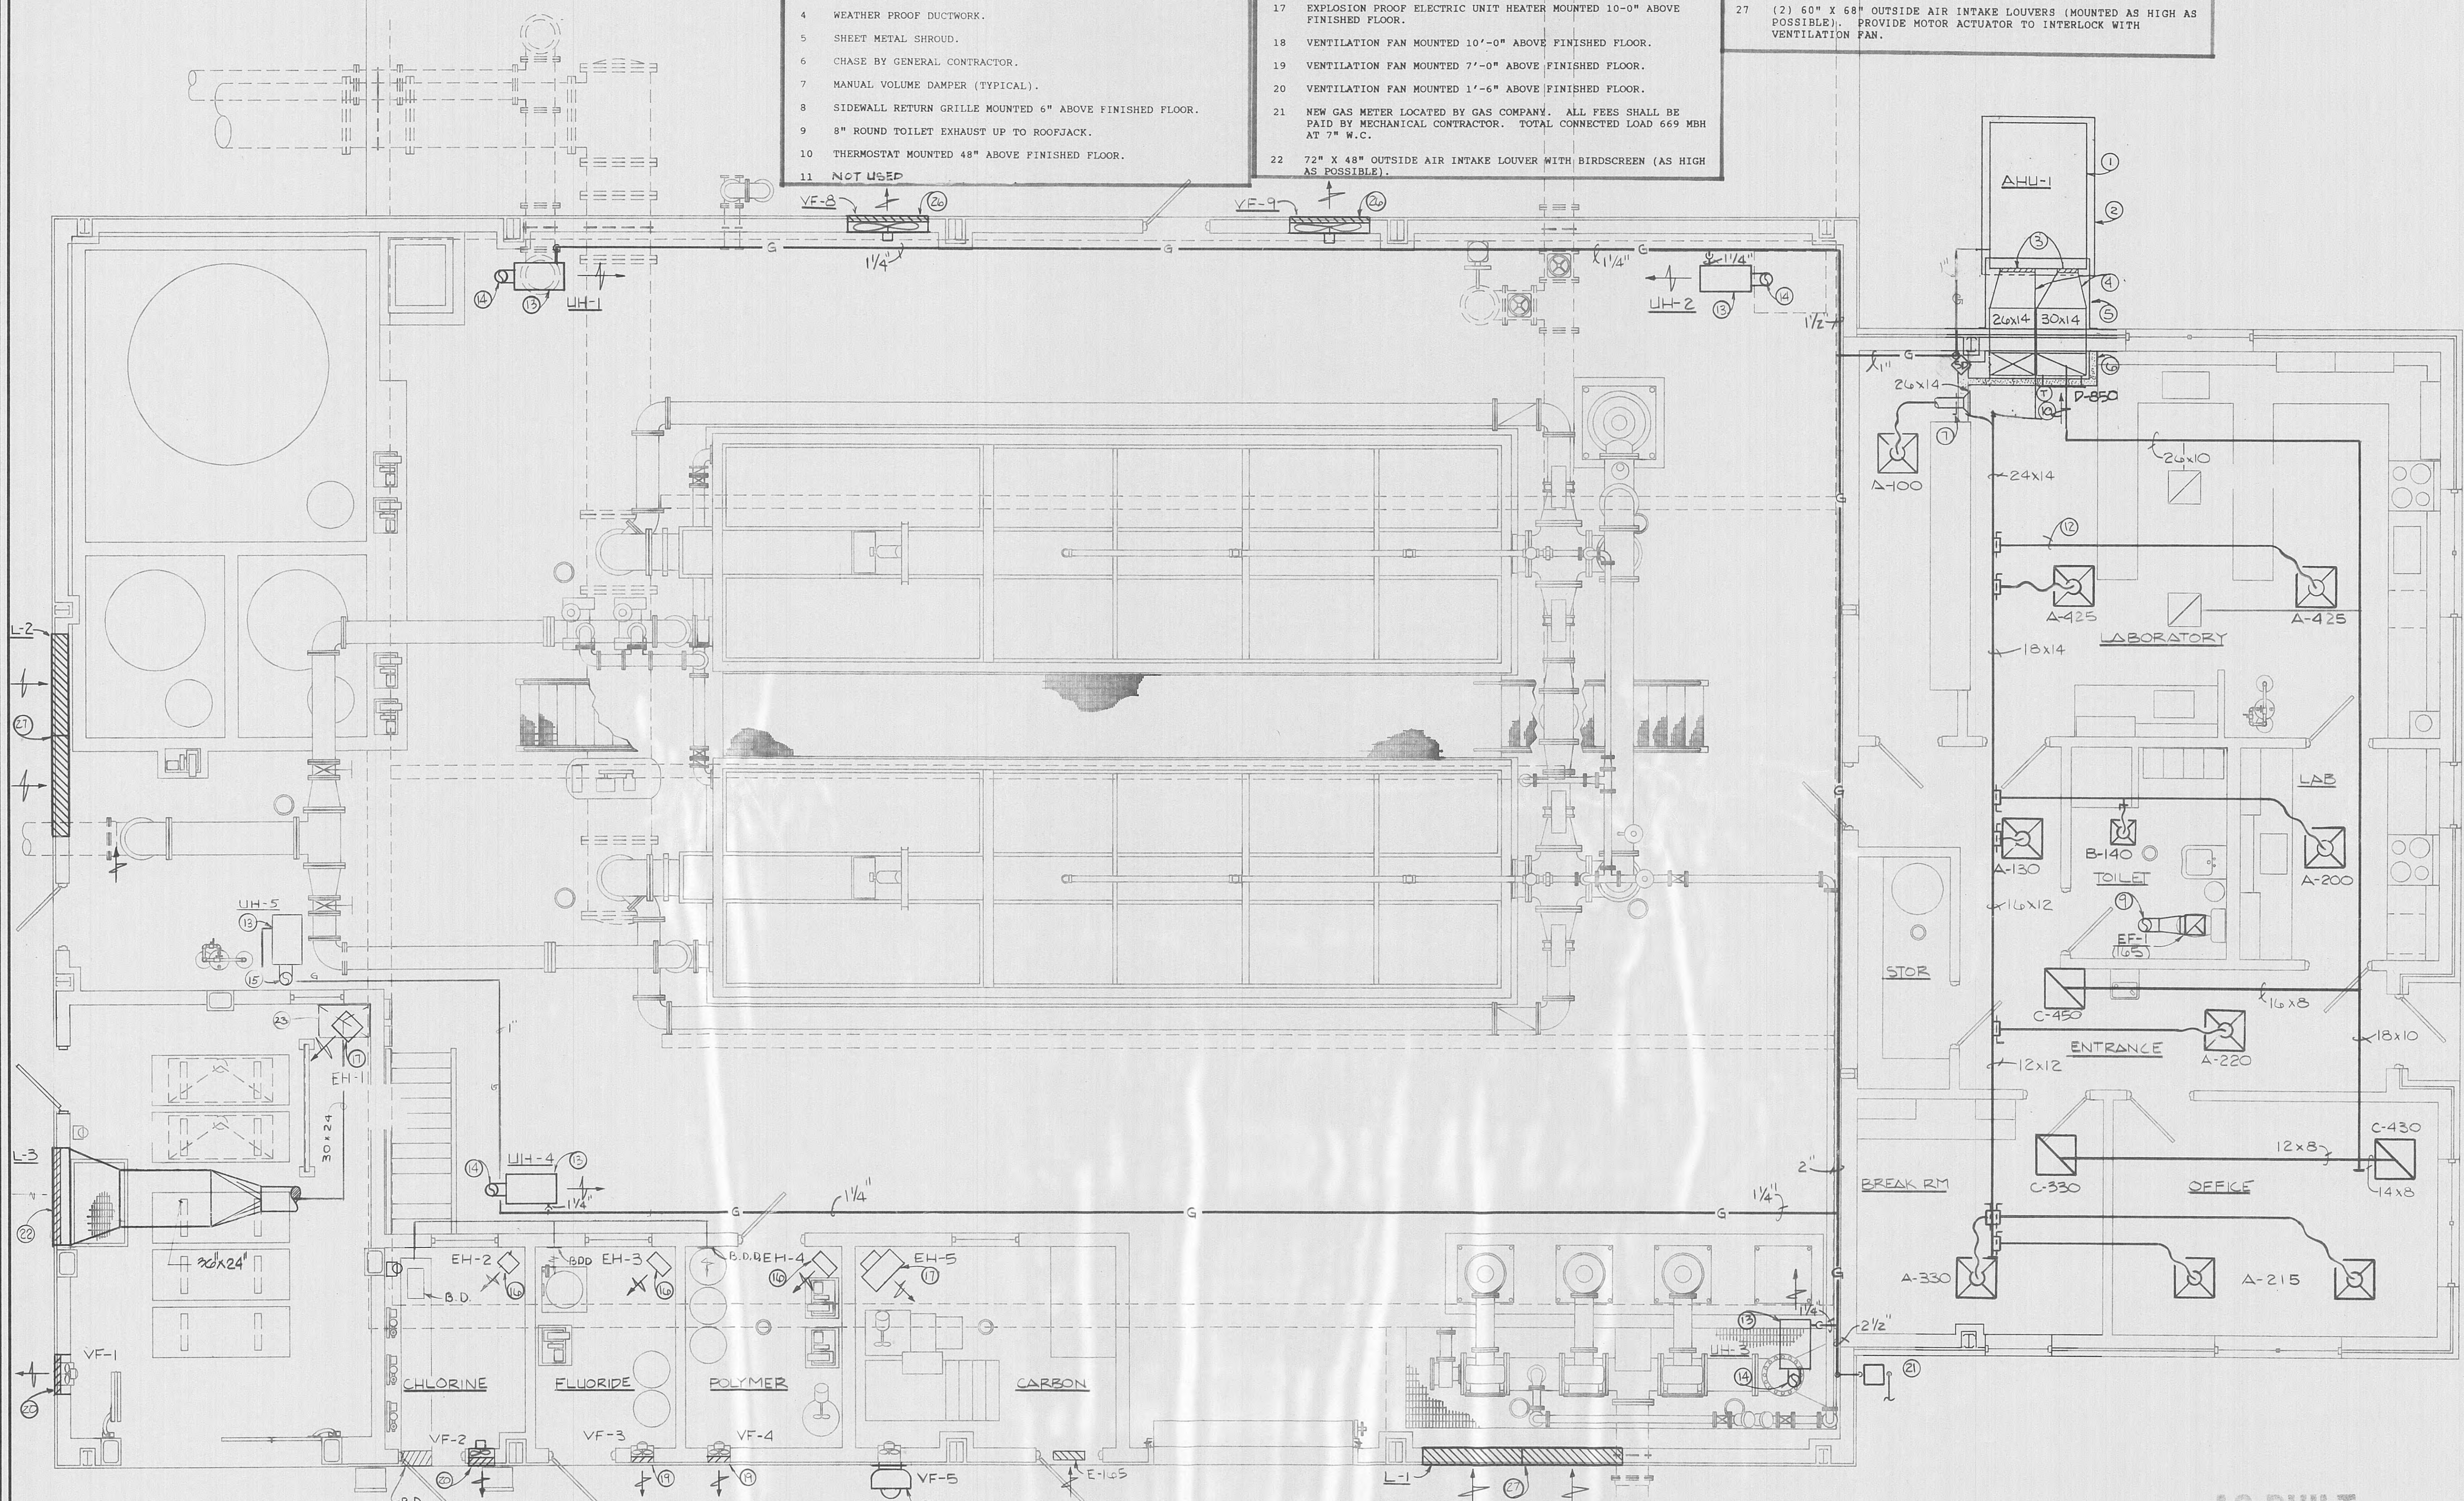


**FILTER/OPERATIONS BLDG. MECHANICAL**  
SCALE: 1/4" = 1'-0"

**AS BUILT**  
DATE: 3-20-95  
APPROVED: D.M.

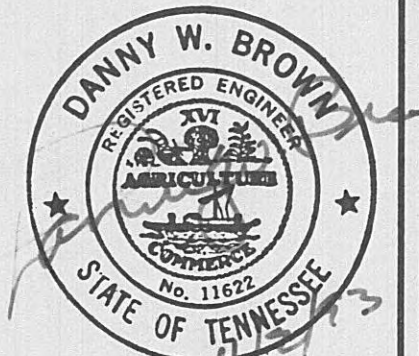

**DUFF BROWN**  
ENGINEERING INC.  
783 OLD HICKORY BLVD. BRENTWOOD, TN. 37027 (615) 377-3757

**ELROD • DUNSON, INC.**  
CONSULTING ENGINEERS  
NASHVILLE • KNOXVILLE  
LEXINGTON, KY

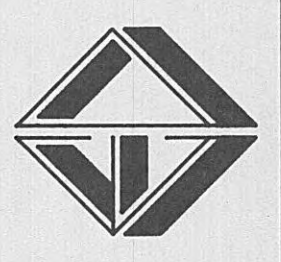

CONTRACT W93-04

HARRIMAN, TENNESSEE  
FILTER BUILDING MECHANICAL PLAN

REVISIONS

DESIGNED: MAL  
DRAWN: MAL  
CHECKED: DMB  
DATE: 3-31-93  
SCALE: NOTED  
PROJ. NO. 0592


SHEET 35  
**M-1**  
OF 36




## GAS FIRED UNIT HEATERS

- ① SPARK-IGNITED  
② THERMOSTAT AND RELAY & CONTROL TRANSFORMER


IDENT.	MFR.	MODEL NO.	FUEL	HTG. CAP.	CFM'S	HP	FLA	ELECT.	NOTES
UH-1	REZADR	F-130	NAT. GAS	130 MBH	1600	1/20	4.0	115/1/60	①②
UH-2									
UH-3									
UH-4									
UH-5									

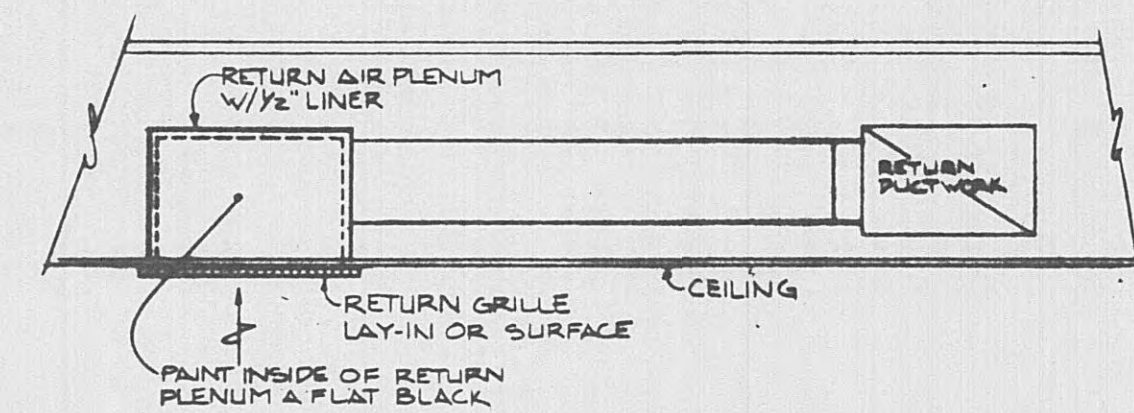


TYPICAL RETURN GRILLE  
SCALE: NONE

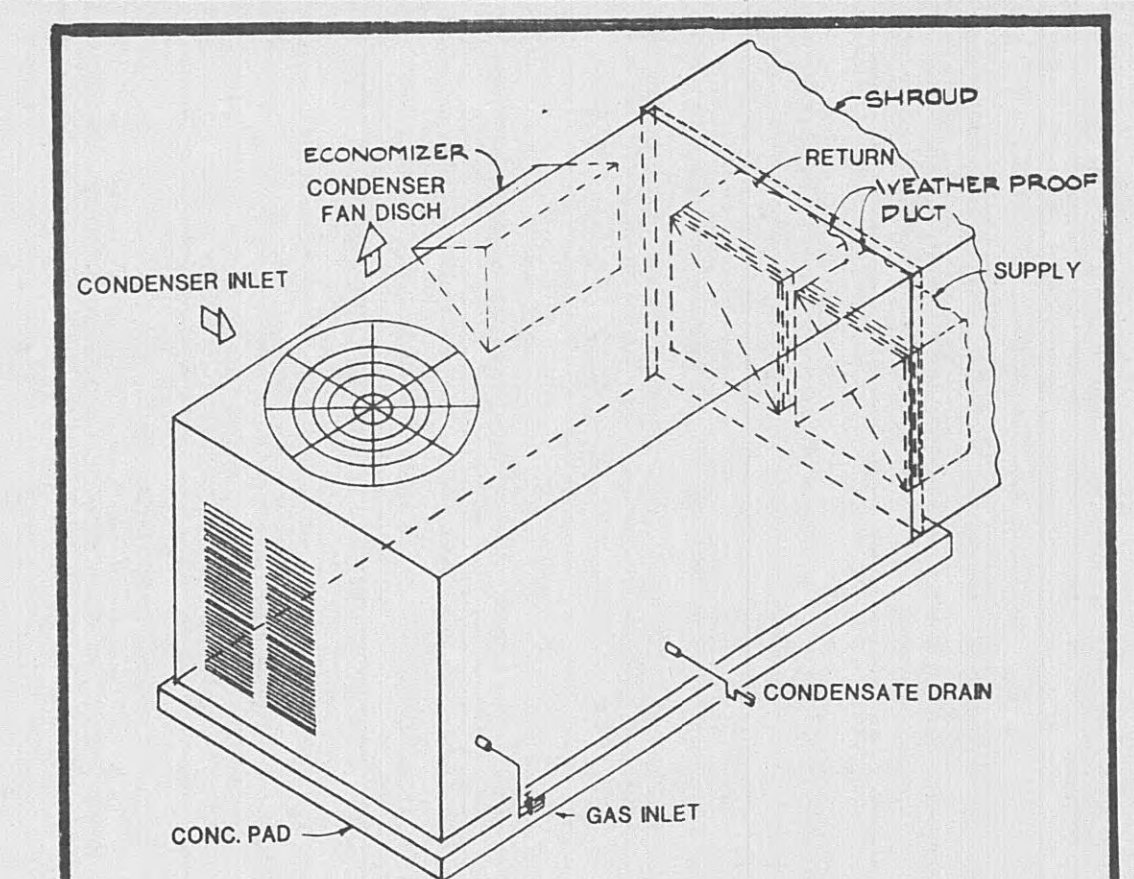

PACKAGE UNIT DETAIL  
NO SCALE

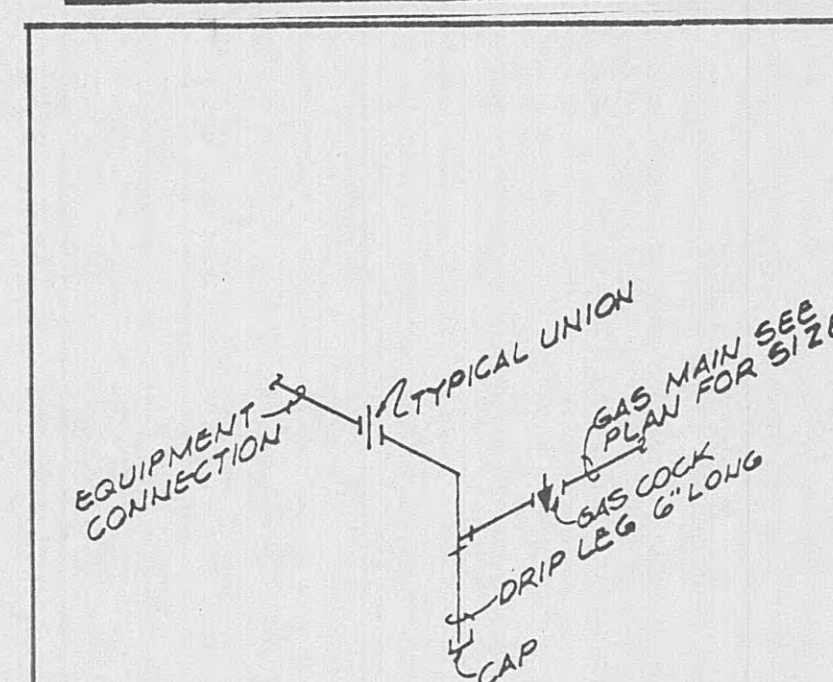

TYPICAL GAS CONNECTION  
SCALE: NONE

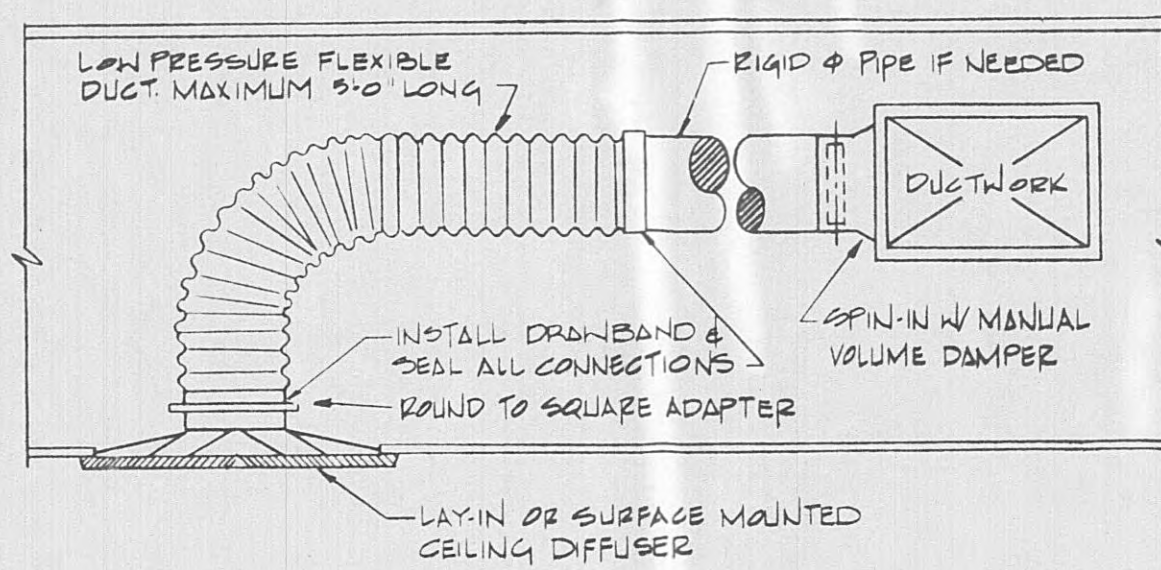

TYPICAL DIFFUSER CONNECTION  
NO SCALE

## ELECT. HEATER SCHEDULE


- ① MOUNTING KIT  
② SINGLE POINT CONNECTION  
③ CORROSION RESISTANT  
④ EXPLOSION PROOF  
⑤ UNIT MOUNTED THERMOSTAT  
⑥ EXPLOSION PROOF THERMOSTAT

IDENT.	MFR.	MODEL NO.	HTG. CAP.	WATTS	ELECT.	NOTES
EH-1	Q.M.A.R.T.	JUN750483	7.5 KW	25,590	480/3/60	①②③⑤
EH-2		JUN750081	2 KW	6,824	208/1/60	①②③⑤
EH-3		MUH03-21	2.2 KW	7,508		①②⑤
EH-4		MUH03-21	2.2 KW	7,508		①②⑤
EH-5		6UX3004831	3 KW	10,234	480/3/60	①②④⑥
EH-6		MUH03-21	2.2 KW	7,508	208/1/60	①②⑤
EH-7		MUH05-01	5 KW	17,065		①②⑤
EH-8		MUH07-0	7.5 KW	25,590		①②⑤

## FAN SCHEDULE

- ① INTEGRAL DISCONNECT SWITCH  
② SPEED CONTROL  
③ ROOF CAP W/CURB  
④ CORROSION RESISTANT  
⑤ EXPLOSION PROOF  
⑥ INTERLOCK W/ LOUVER  
⑦ ROOF CURB  
⑧ WALL SHUTTER  
⑨ WALL CAP  
⑩ BACKDRAFT DFR  
⑪ BIRD SCREEN  
⑫ INTERLOCK W/ LOUVER

IDENT.	MFR.	CFM	MODEL NO.	ESP	HP	RPM	ELECT.	NOTES
EF-1	LOREN-COOK	165	GEMINI 1445A	.125	1/4	1469	115/1/60	②④⑤⑥⑦⑧⑨⑩⑪⑫
VF-1		5900	24SPUB		3/4	824	208/1/60	①②④⑤
VF-2		1300	16SP10D		1/4	803	120/1/60	①②④⑤
VF-3		60	8SP15D		1/8	1087		①④⑤
VF-4		70	8SP15D		1/8	11268		①④⑤
VF-5		165	ACV-100V2B		1/4	442		①③④
VF-6		80	8SP15D		1/8	1450		①④⑤
VF-7		430	10SP15D		1/2	1158		①④⑤
VF-8/9		13,500	46SP5B		7/2	255		①②④⑤⑥

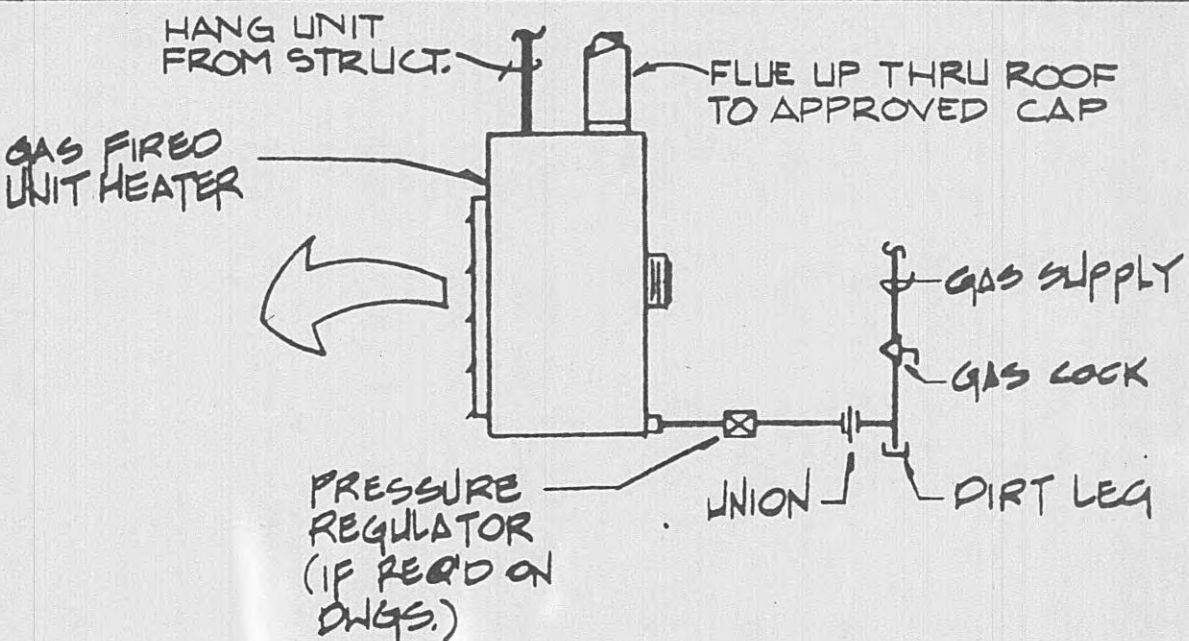

UNIT HEATER DETAIL  
NO SCALE

## AIR DEVICE SCHEDULE

- CD-CEILING SUPPLY DIFFUSER  
SSR-SIDEWALL SUPPLY REGISTER  
LD-LINEAR DIFFUSER  
SR-SIDEWALL RETURN REGISTER  
RG-RETURN GRILLE  
EG-EXHAUST GRILLE  
TG-TRANSFER GRILLE  
DG-DOOR GRILLE  
FSR-FLOOR SUPPLY DIFFUSER

IDENT.	MODEL NO.	CFM RANGE	NECK SIZE	TYPE	NOTES
Δ	5800-40	60-100	6" φ	CP24x24	②③④
		101-220	8" φ		
		221-400	10" φ		
		401-550	12" φ		
B	5800-40	60-100	8" φ	CP12x12	
C	CCS	0-1250	24" x 24"	RR24x24	
D	RH	0-1000	24" x 24"	SR24x24	
E	PGDF	0-200	16" x 16"	PG16x16	②④

- ① STEEL CONSTRUCTION  
② ALUM. CONSTRUCTION  
③ OPPOSED BLADE DAMPER  
④ OFF-WHITE ENAMEL  
⑤ ANODIZED FINISH  
⑥ GOLDEN SAND ENAMEL  
PROVIDE METALAREAS SPECIFIED ABOVE, OR APPROVED EQUAL.

## PACKAGE UNIT SCHEDULE

IDENT.	MFR.	MODEL NO.	SUPPLY CFM	OA CFM	ESP (W.G.)
AHU-1	CARRIER	48LJD	2400	240	.5

COOLING CAPACITY	
TOTAL (BTUH)	77,700
OA DB	95°F
ENT DB/WB	80°/67°F


HEATING CAPACITY	
INPUT (BTUH)	74,000
OUTPUT (BTUH)	59,200
TYPE	NAT. GAS

EVAP	FLA	LRA	COND	FLA	LRA	COMP	FLA	TOTAL WT.	VOLTAGE	NOTES
HP	1 1/2		HP	1/3				700 lbs	480/3/60	①②③④⑤⑥⑦⑧⑨⑩⑪⑫⑬⑭⑮⑯⑰⑱⑲⑳㉑㉒㉓㉔㉕㉖㉗㉘㉙㉚㉛㉜㉝㉞㉟㊱㊲㊳㊴㊵㊶㊷㊸㊹㊺㊻㊼㊽㊾㊿

- ① ROOF CURB  
② CURB ISOLATION RAILS  
③ ECONOMIZER  
④ LOW AMBIENT CONTROL-0 DEGS.  
⑤ THROWAWAY FILTERS  
⑥ THERMOSTAT  
⑦ FIRESTAT IN RETURN  
⑧ SMOKE DETECTOR IN SUPPLY  
⑨ SMOKE DETECTOR IN RETURN  
\* FURNISHED BY MECH. CONTR.  
INSTALLED BY MECH. CONTR.

## KEY NOTES


- KEY NOTES ARE INDICATED ON DRAWING BY NUMBER ENCLOSED INSIDE SYMBOL
- ELECTRIC UNIT HEATER MOUNTED 7'-0" ABOVE FINISHED FLOOR.
  - VENTILATION FAN MOUNTED 7'-0" ABOVE FINISHED FLOOR.
  - ELECTRIC UNIT HEATER MOUNTED 10'-0" ABOVE FINISHED FLOOR.
  - EH-7 ELECTRIC UNIT HEATER LOCATED IN BASEMENT MOUNTED AT 7'-0" ABOVE FINISHED FLOOR.
  - VENTILATION FAN MOUNTED 10'-0" ABOVE FINISHED FLOOR.
  - 24" X 16" OUTSIDE AIR INTAKE LOUVER (AS HIGH AS POSSIBLE).
  - 12" X 12" OUTSIDE AIR INTAKE LOUVER (AS HIGH AS POSSIBLE).

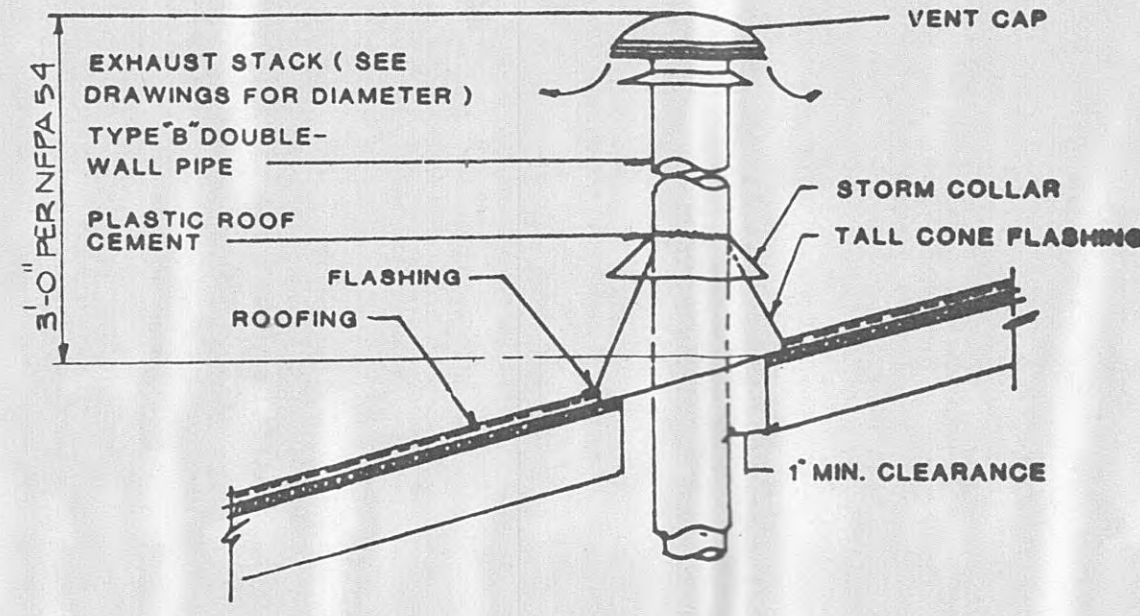

FLUE GAS EXHAUST STACK DETAIL  
SCALE: NONE

## STORAGE BLDG.


SCALE: 3/8" = 1'-0"

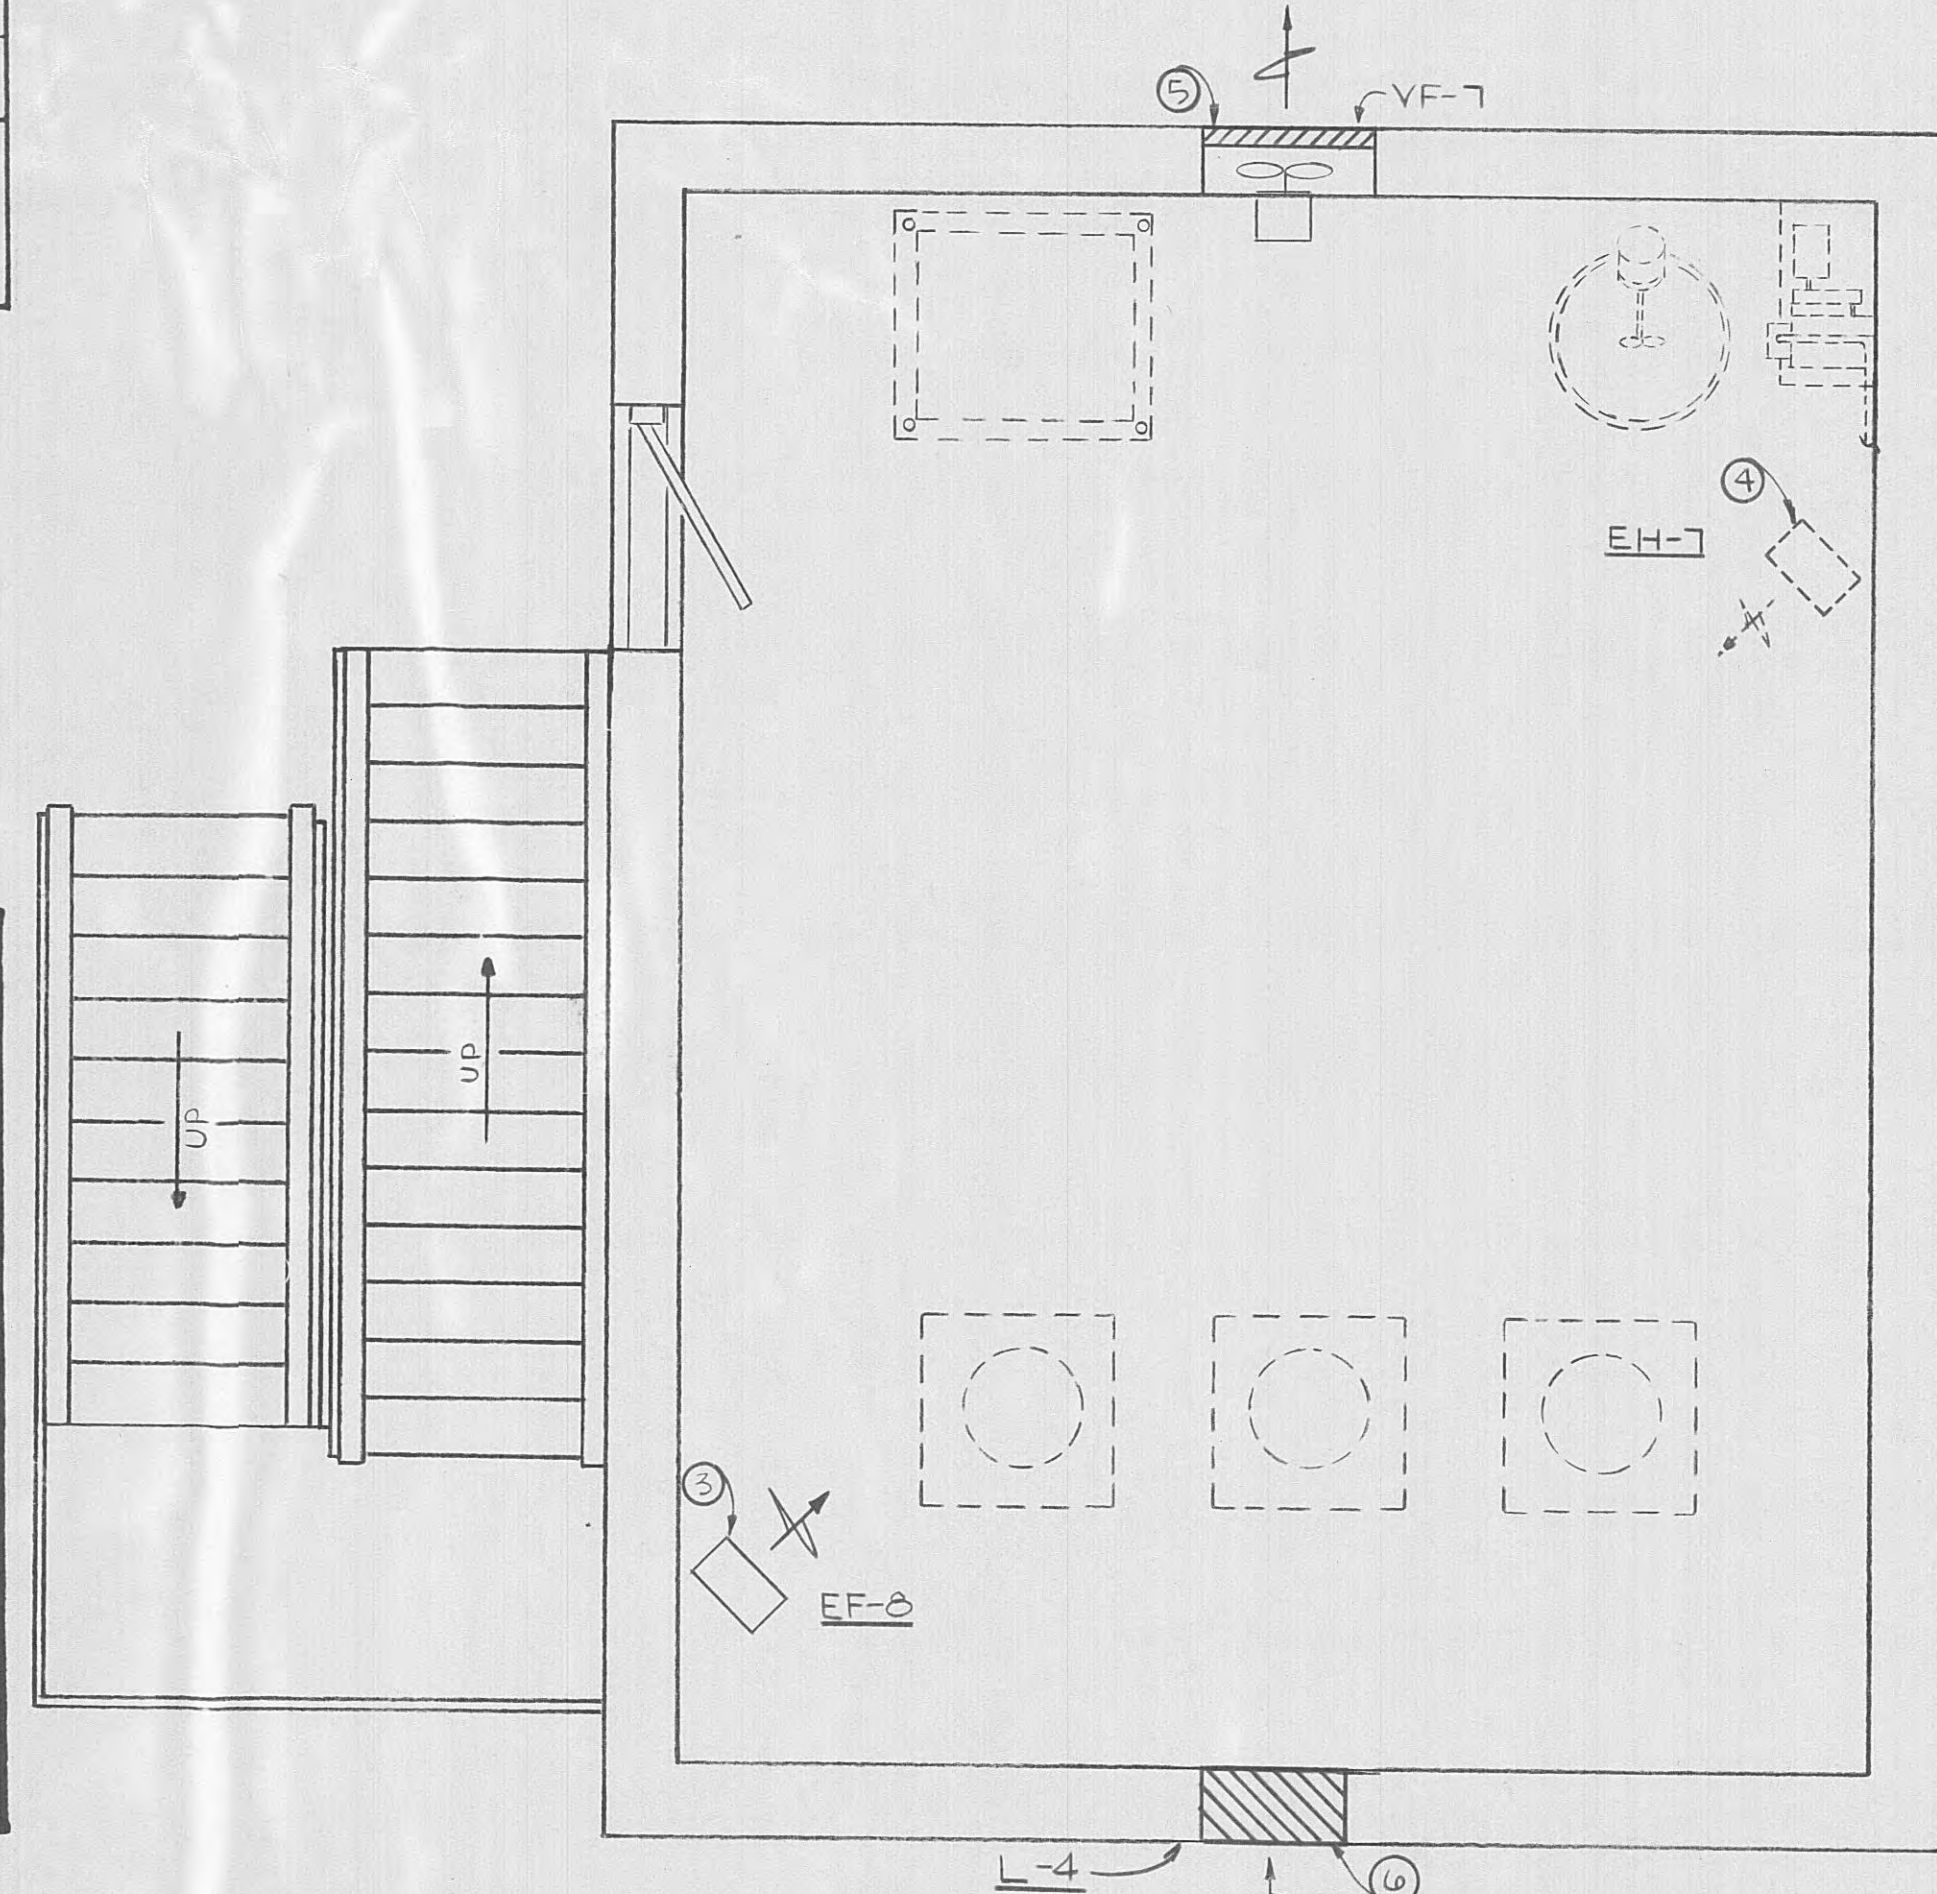

## RAW WATER INTAKE PUMP BLDG. MECHANICAL


SCALE: 3/8" = 1'-0"

AS BUILT  
DATE: 3-20-95  
APPROVED: D.M.

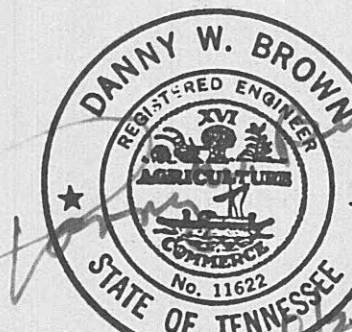

DUFF BROWN  
ENGINEERING INC.  
783 OLD HICKORY BLVD. BRENTWOOD, TN. 37027 (615) 377-3757



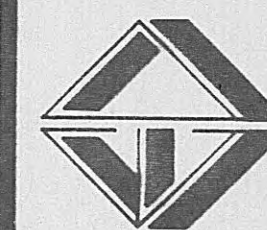

CONTRACT W93-04

HARRIMAN, TENNESSEE  
YARD PIPING PLAN


REVISIONS

4-19-93 ADDED  
DRAIN TO PIPE  
CHASE OF 36" PIPE

DESIGNED: L.E.R.  
DRAWN: S.C.G.  
CHECKED: L.E.R.  
DATE: MARCH, 1993  
SCALE: 1" = 20'-0"  
PROJ. NO. 0592

SHEET 3

OF 36

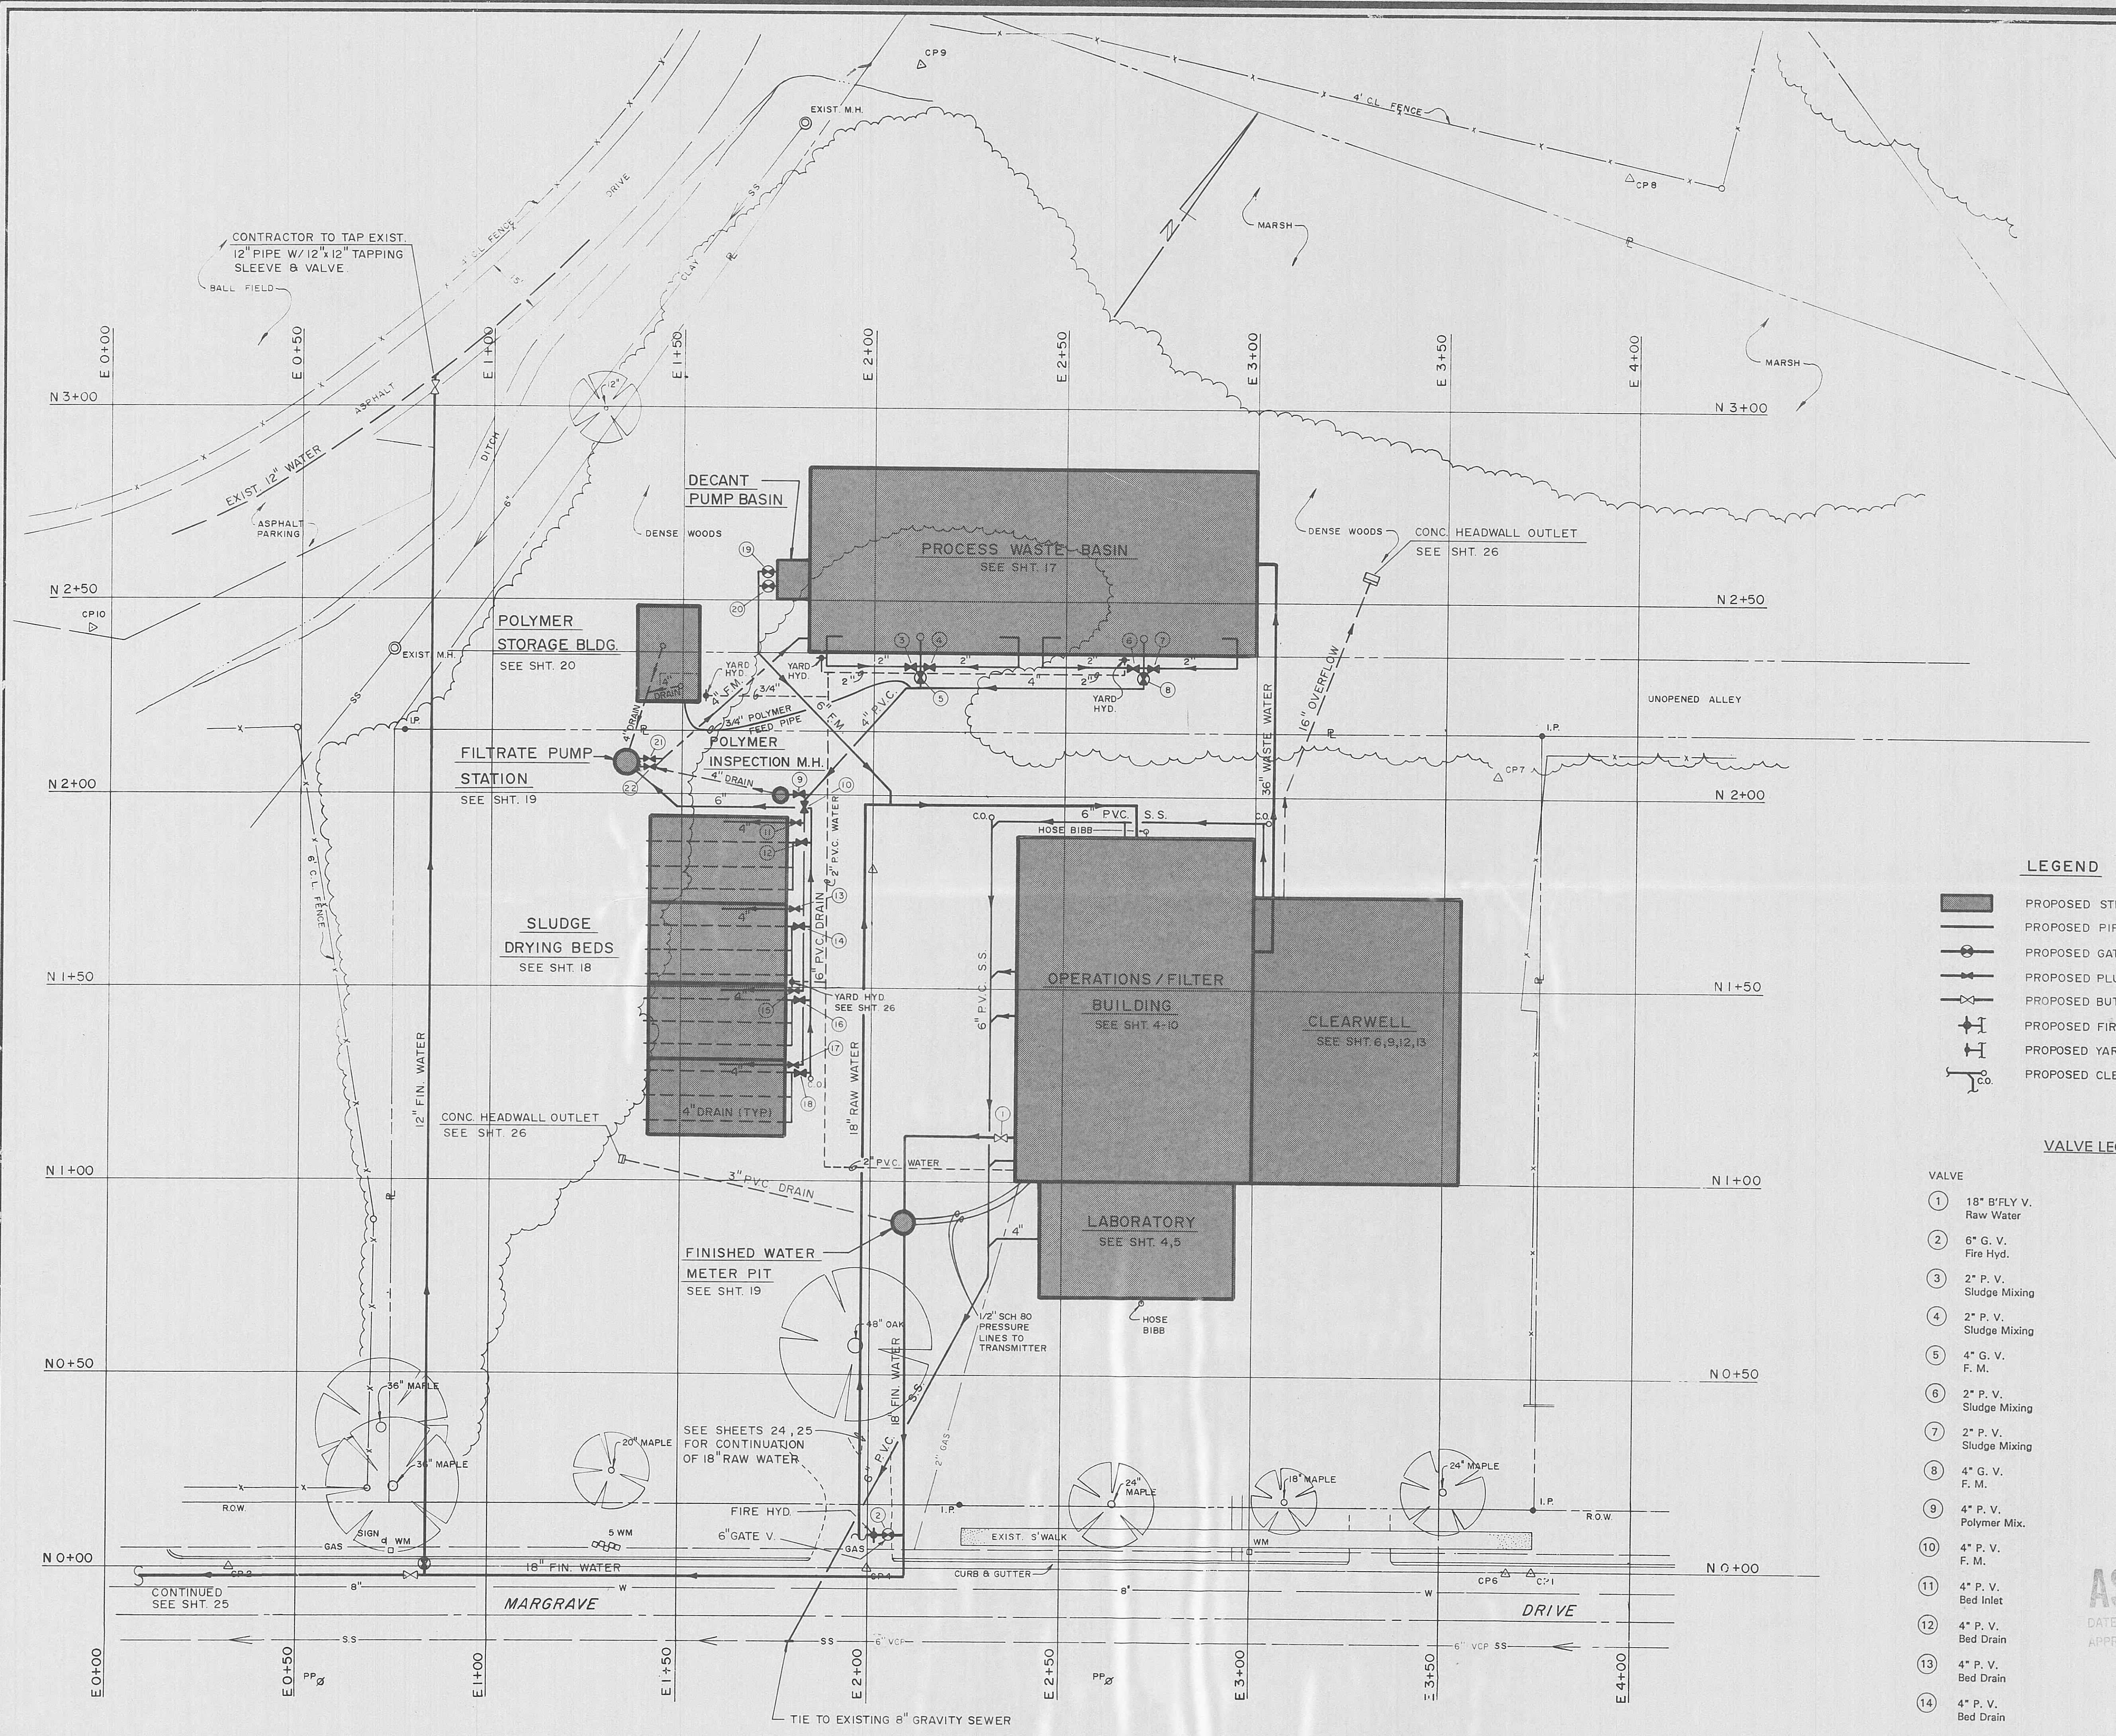

LEGEND


- PROPOSED STRUCTURES
- PROPOSED PIPING
- PROPOSED GATE VALVE
- PROPOSED PLUG VALVE
- PROPOSED BUTTERFLY VALVE
- PROPOSED FIRE HYDRANT
- PROPOSED YARD HYDRANT
- PROPOSED CLEANOUT

VALVE LEGEND


- |                             |                                 |
|-----------------------------|---------------------------------|
| VALVE                       | VALVE                           |
| 1 18" B'FLY V.<br>Raw Water | 15 4" P. V.<br>Bed Inlet        |
| 2 6" G. V.<br>Fire Hyd.     | 16 4" P. V.<br>Bed Drain        |
| 3 2" P. V.<br>Sludge Mixing | 17 4" P. V.<br>Bed Inlet        |
| 4 2" P. V.<br>Sludge Mixing | 18 4" P. V.<br>Bed Drain        |
| 5 4" G. V.<br>F. M.         | 19 6" G. V.<br>Decant Pump out. |
| 6 2" P. V.<br>Sludge Mixing | 20 6" G. V.<br>Decant Pump out. |
| 7 2" P. V.<br>Sludge Mixing | 21 4" P. V.<br>Bed Drain        |
| 8 4" G. V.<br>F. M.         | 22 4" P. V.<br>Bed Drain        |
| 9 4" P. V.<br>Polymer Mix.  |                                 |
| 10 4" P. V.<br>F. M.        |                                 |
| 11 4" P. V.<br>Bed Inlet    |                                 |
| 12 4" P. V.<br>Bed Drain    |                                 |
| 13 4" P. V.<br>Bed Drain    |                                 |
| 14 4" P. V.<br>Bed Drain    |                                 |

AS BUILT

DATE: 3-20-95  
APPROVED: D.M.

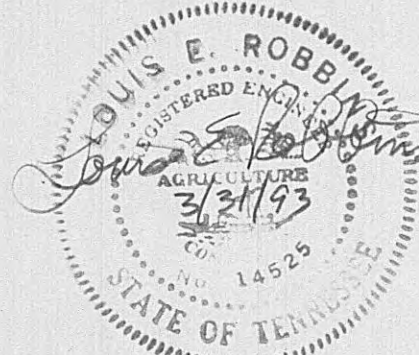





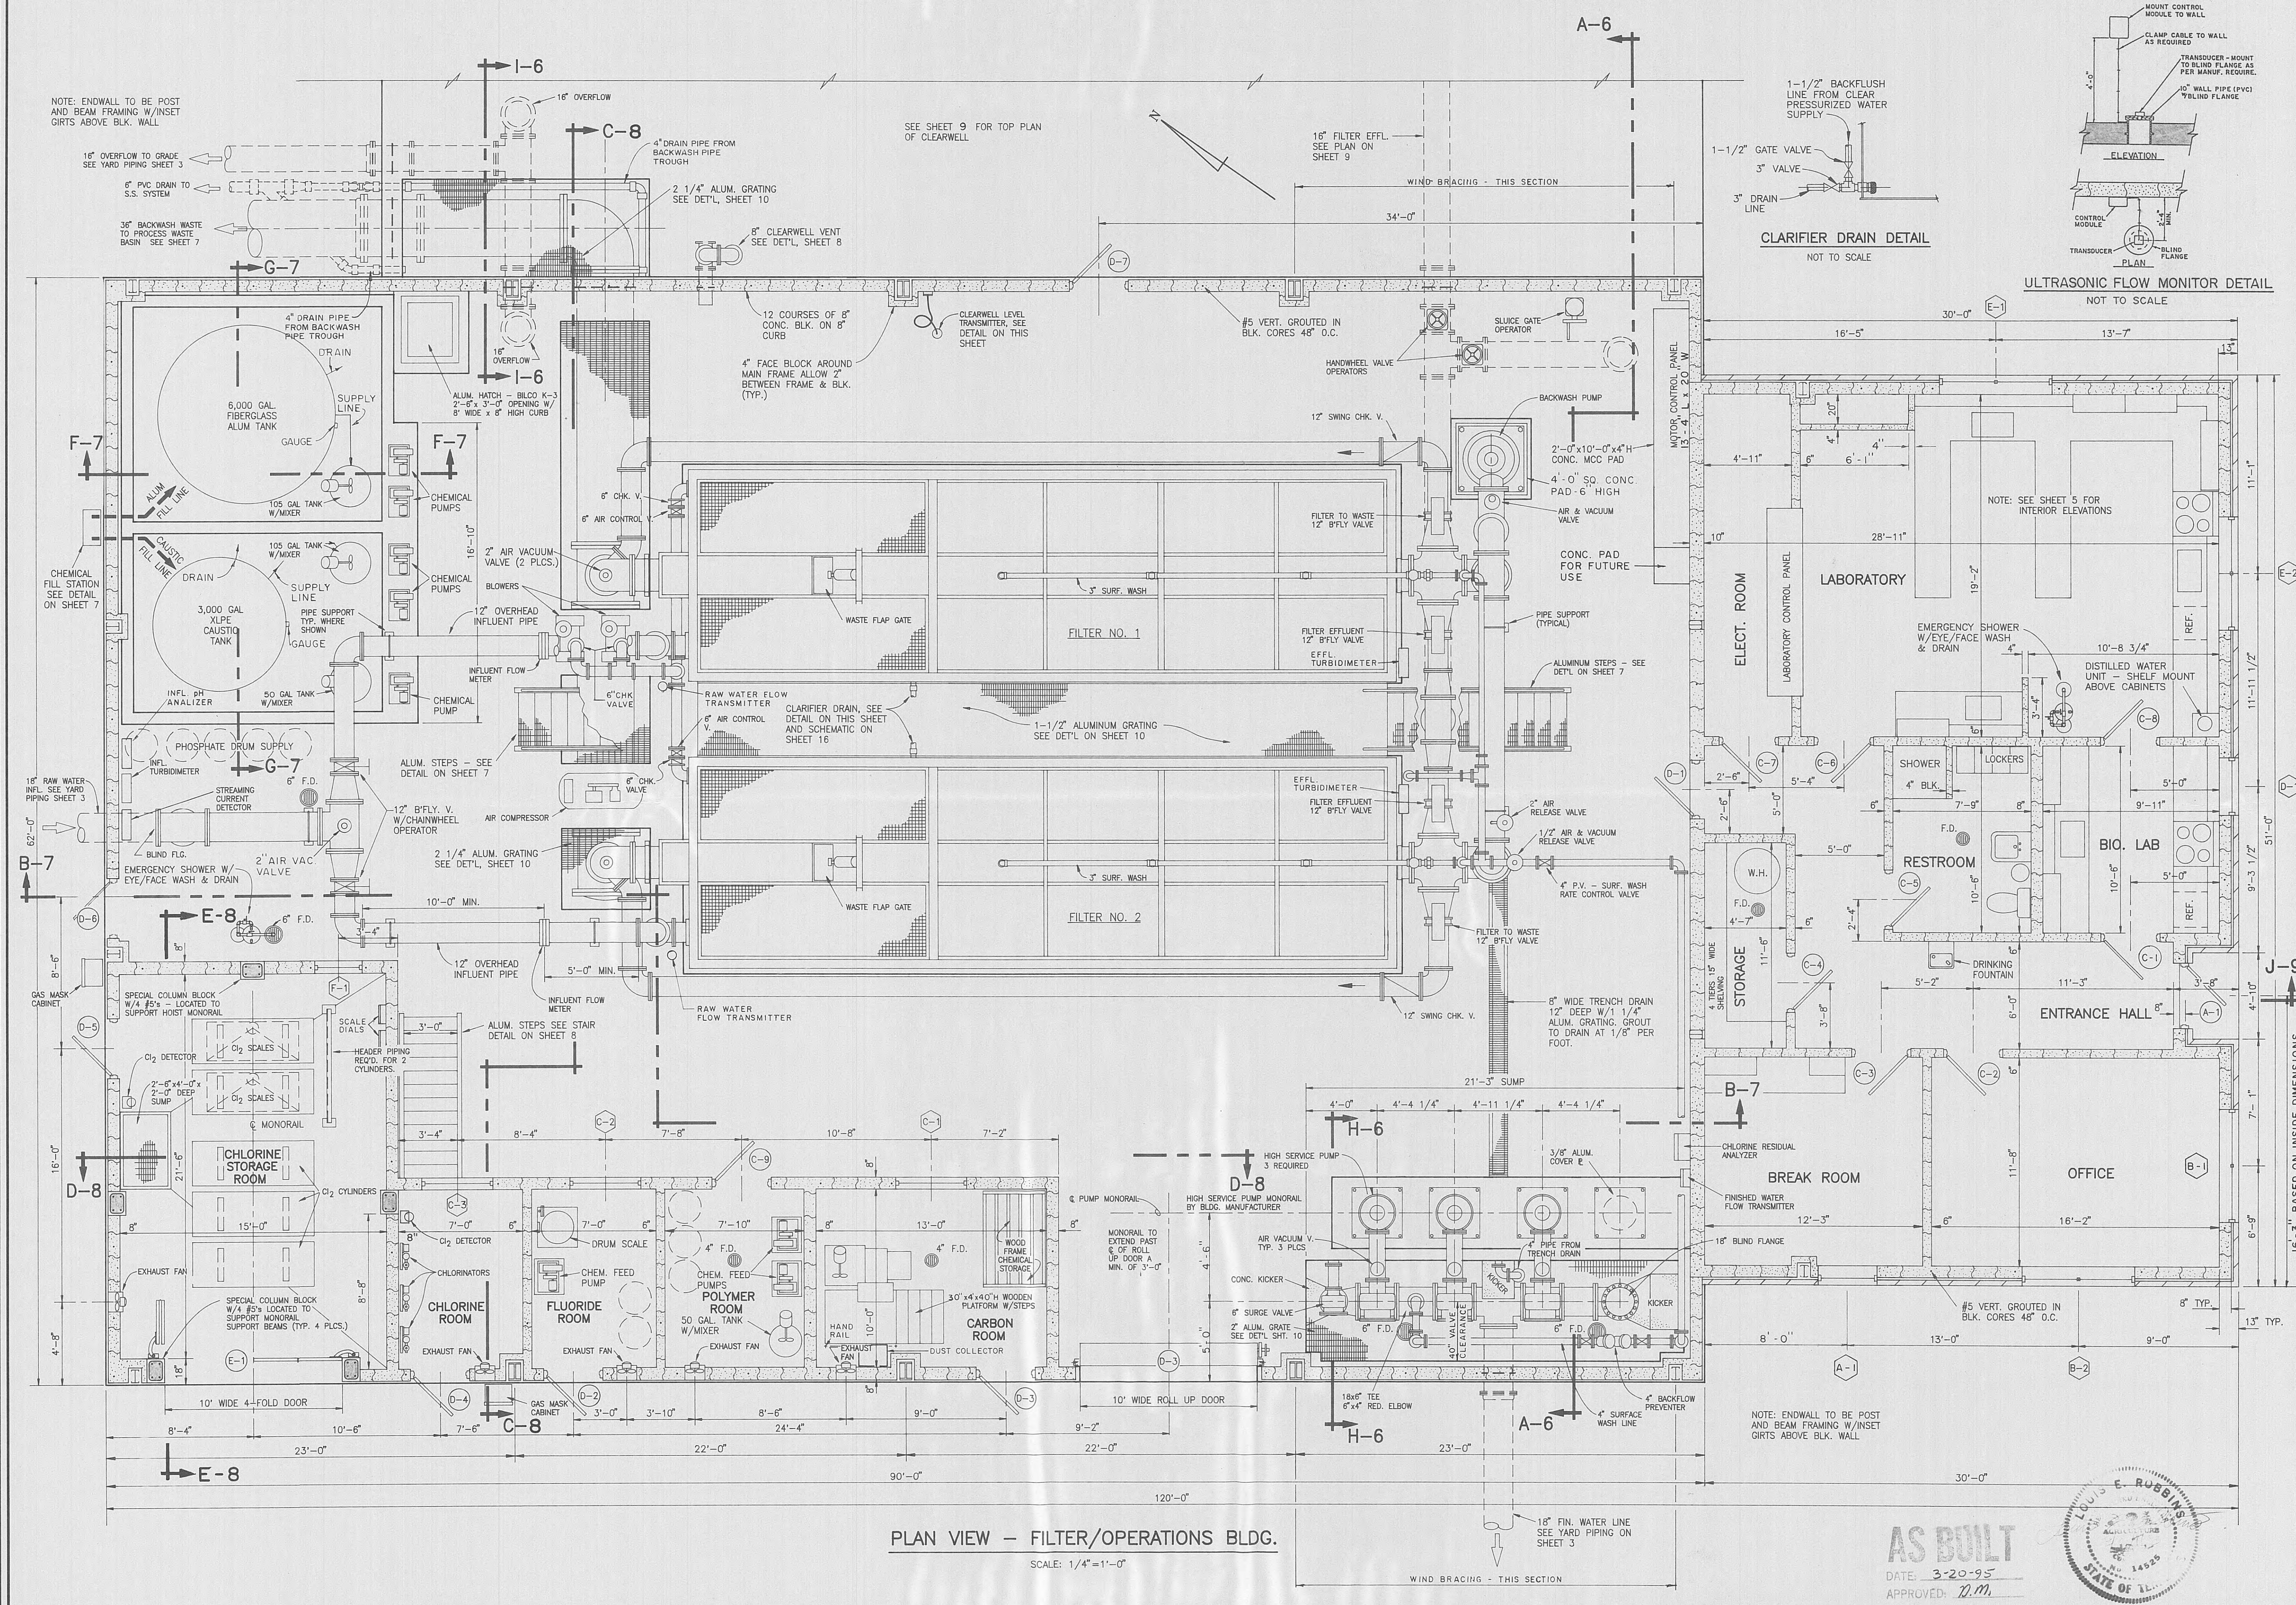





TYP. CABINET SECTION  
SCALE: 3/8"=1'-0"

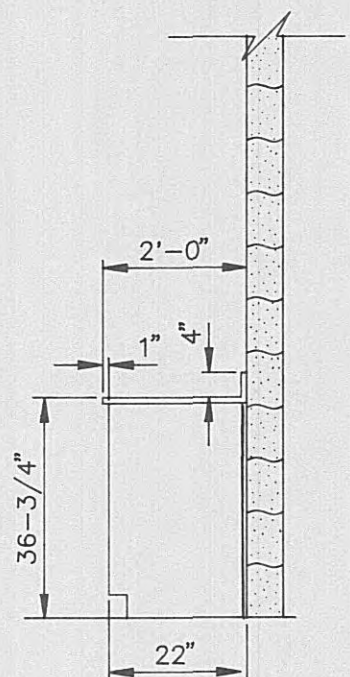


TYP. CABINET SECTION  
W/ BOX CURB  
SCALE: 3/8"=1'-0"

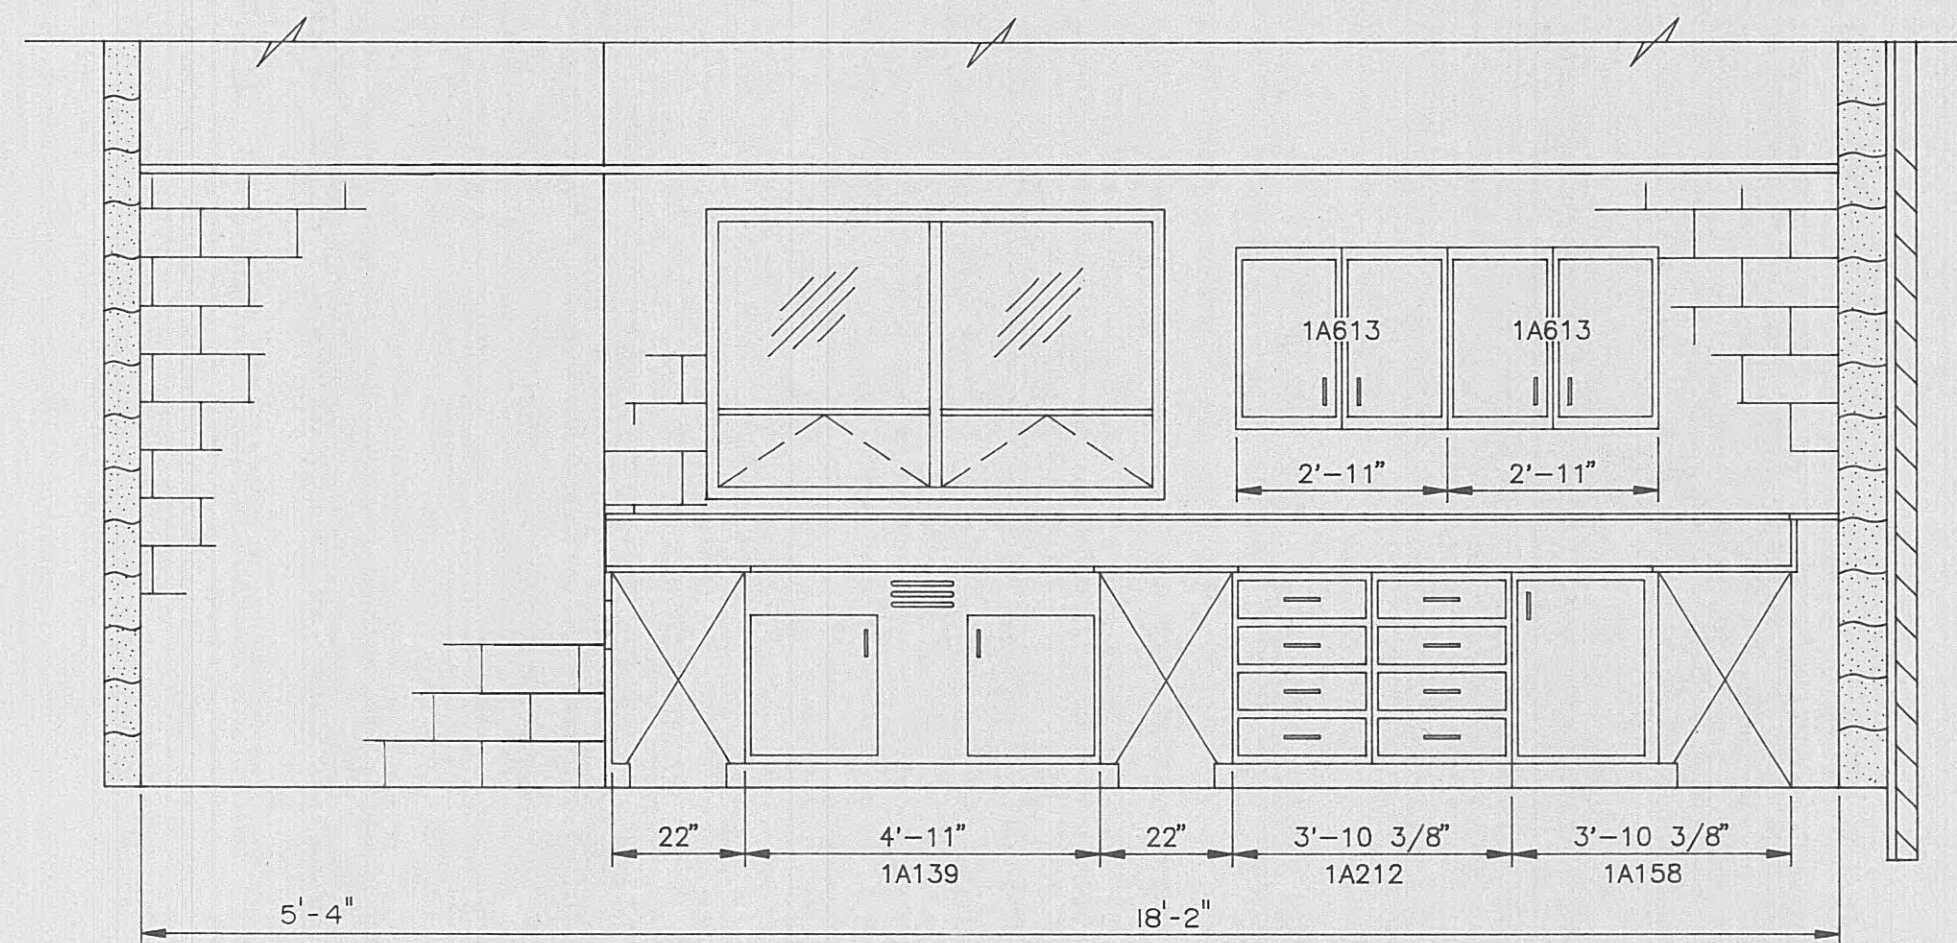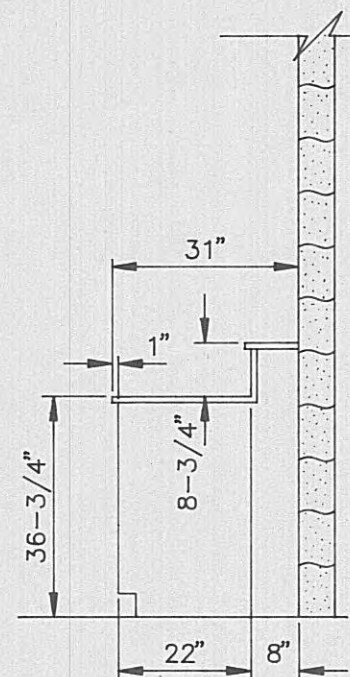


ELEVATION A-A  
SCALE: 3/8"=1'-0"

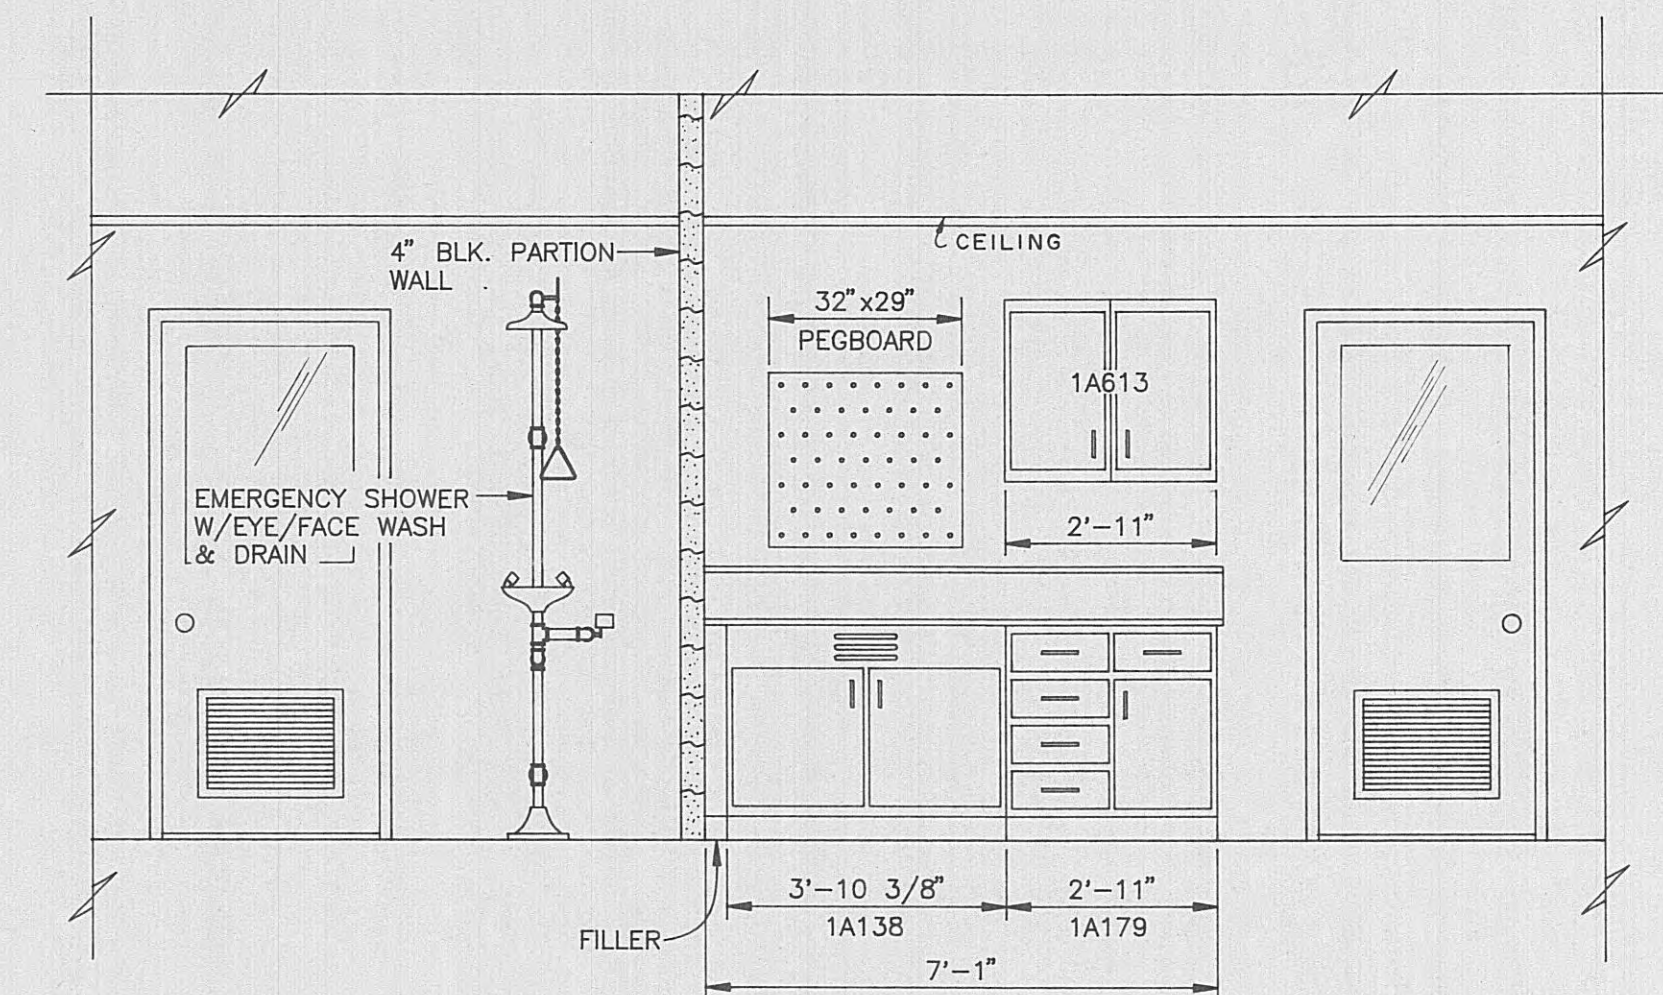


ELEVATION B-B  
SCALE: 3/8"=1'-0"

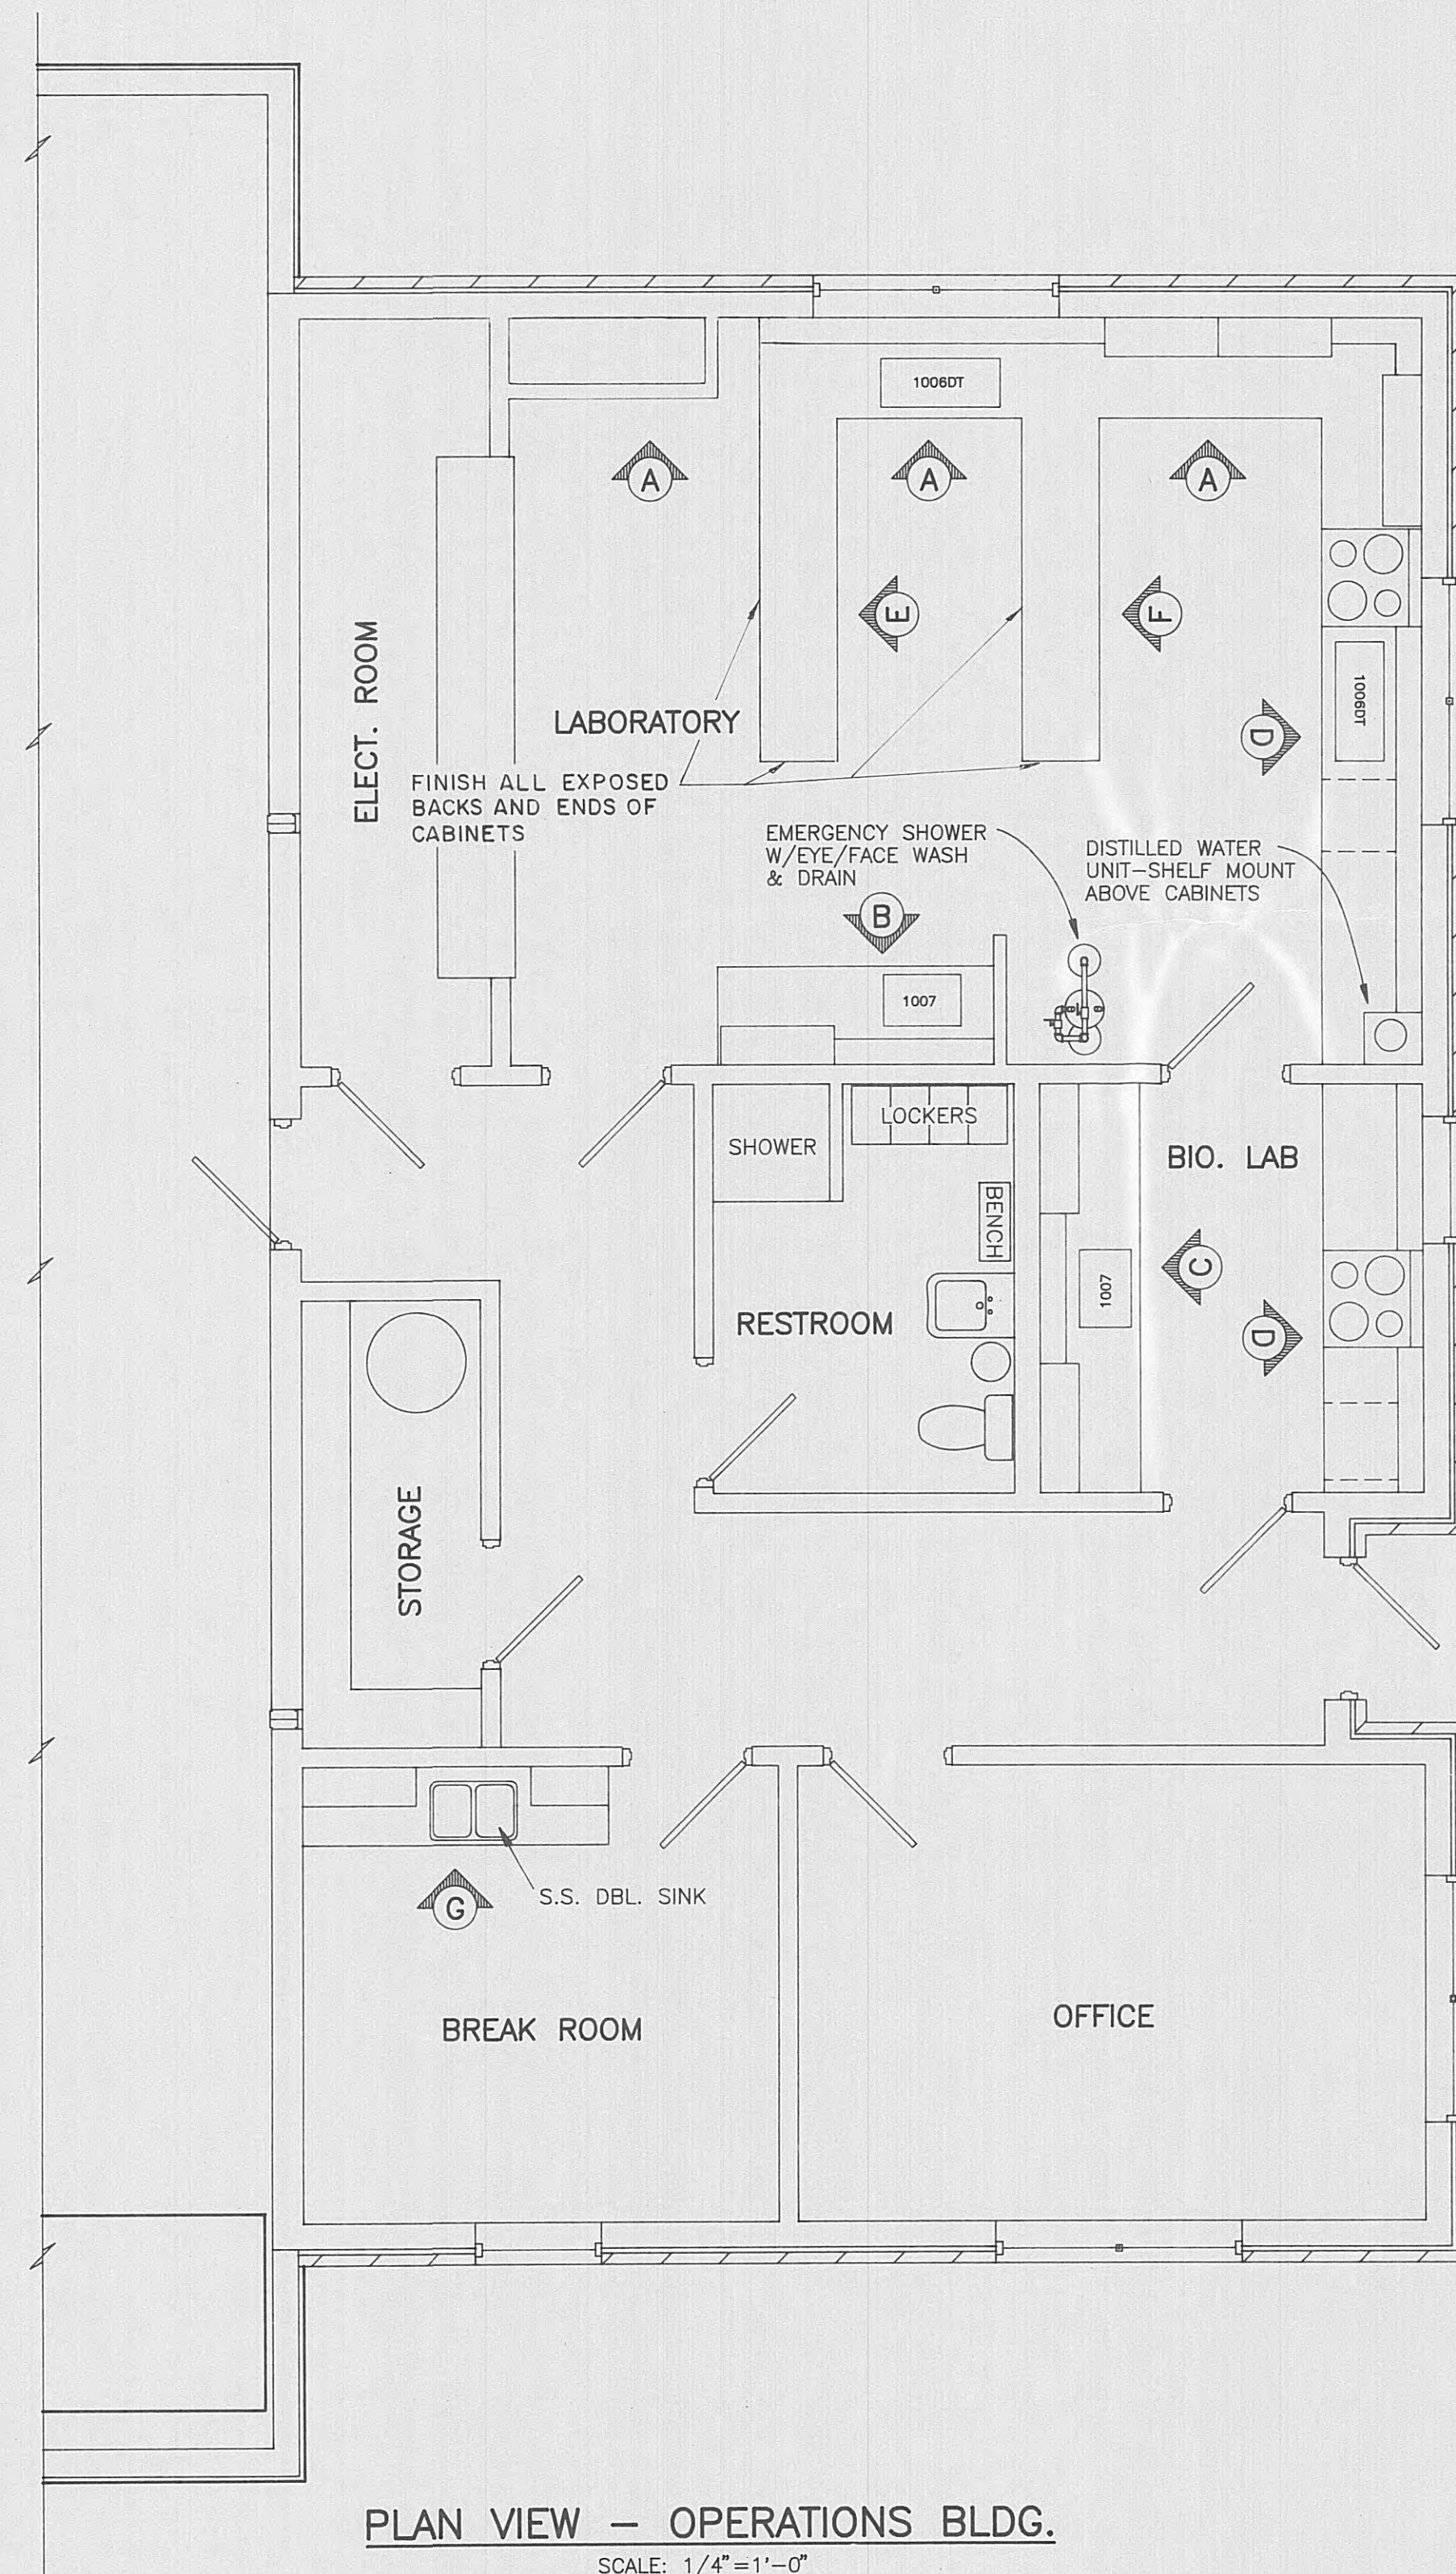


PLAN VIEW — OPERATIONS BLDG.  
SCALE: 1/4"=1'-0"

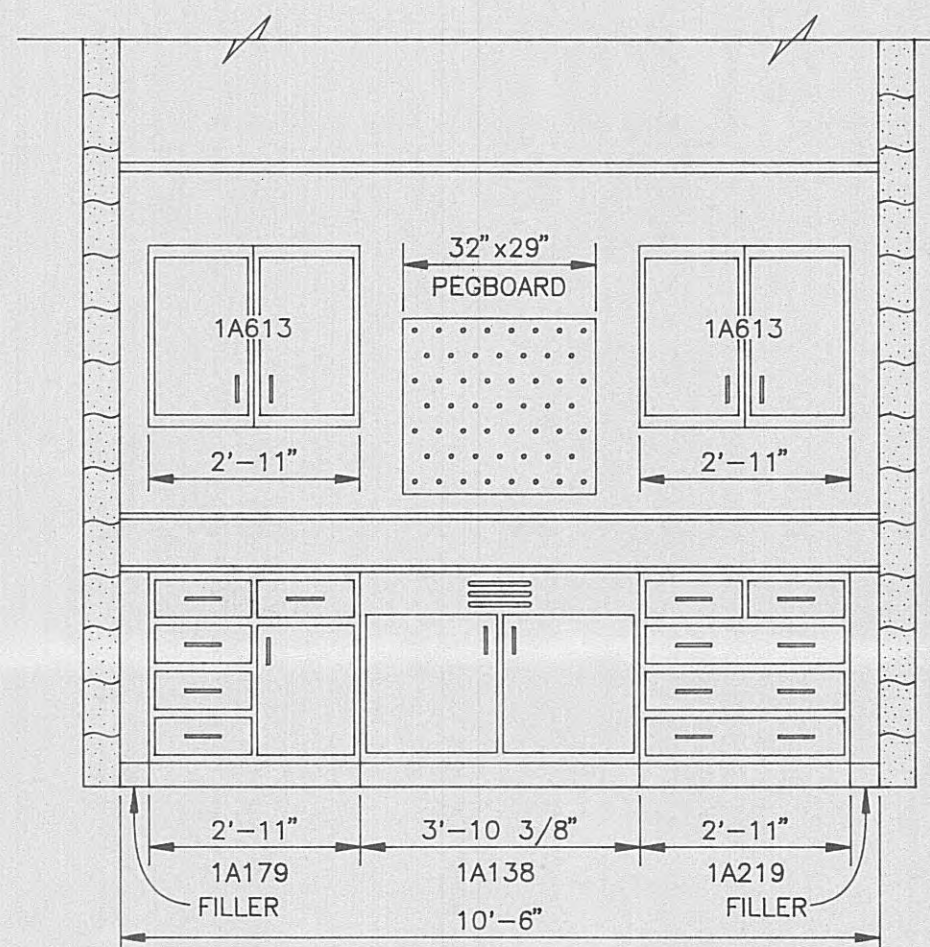


ELEVATION C-C  
SCALE: 3/8"=1'-0"

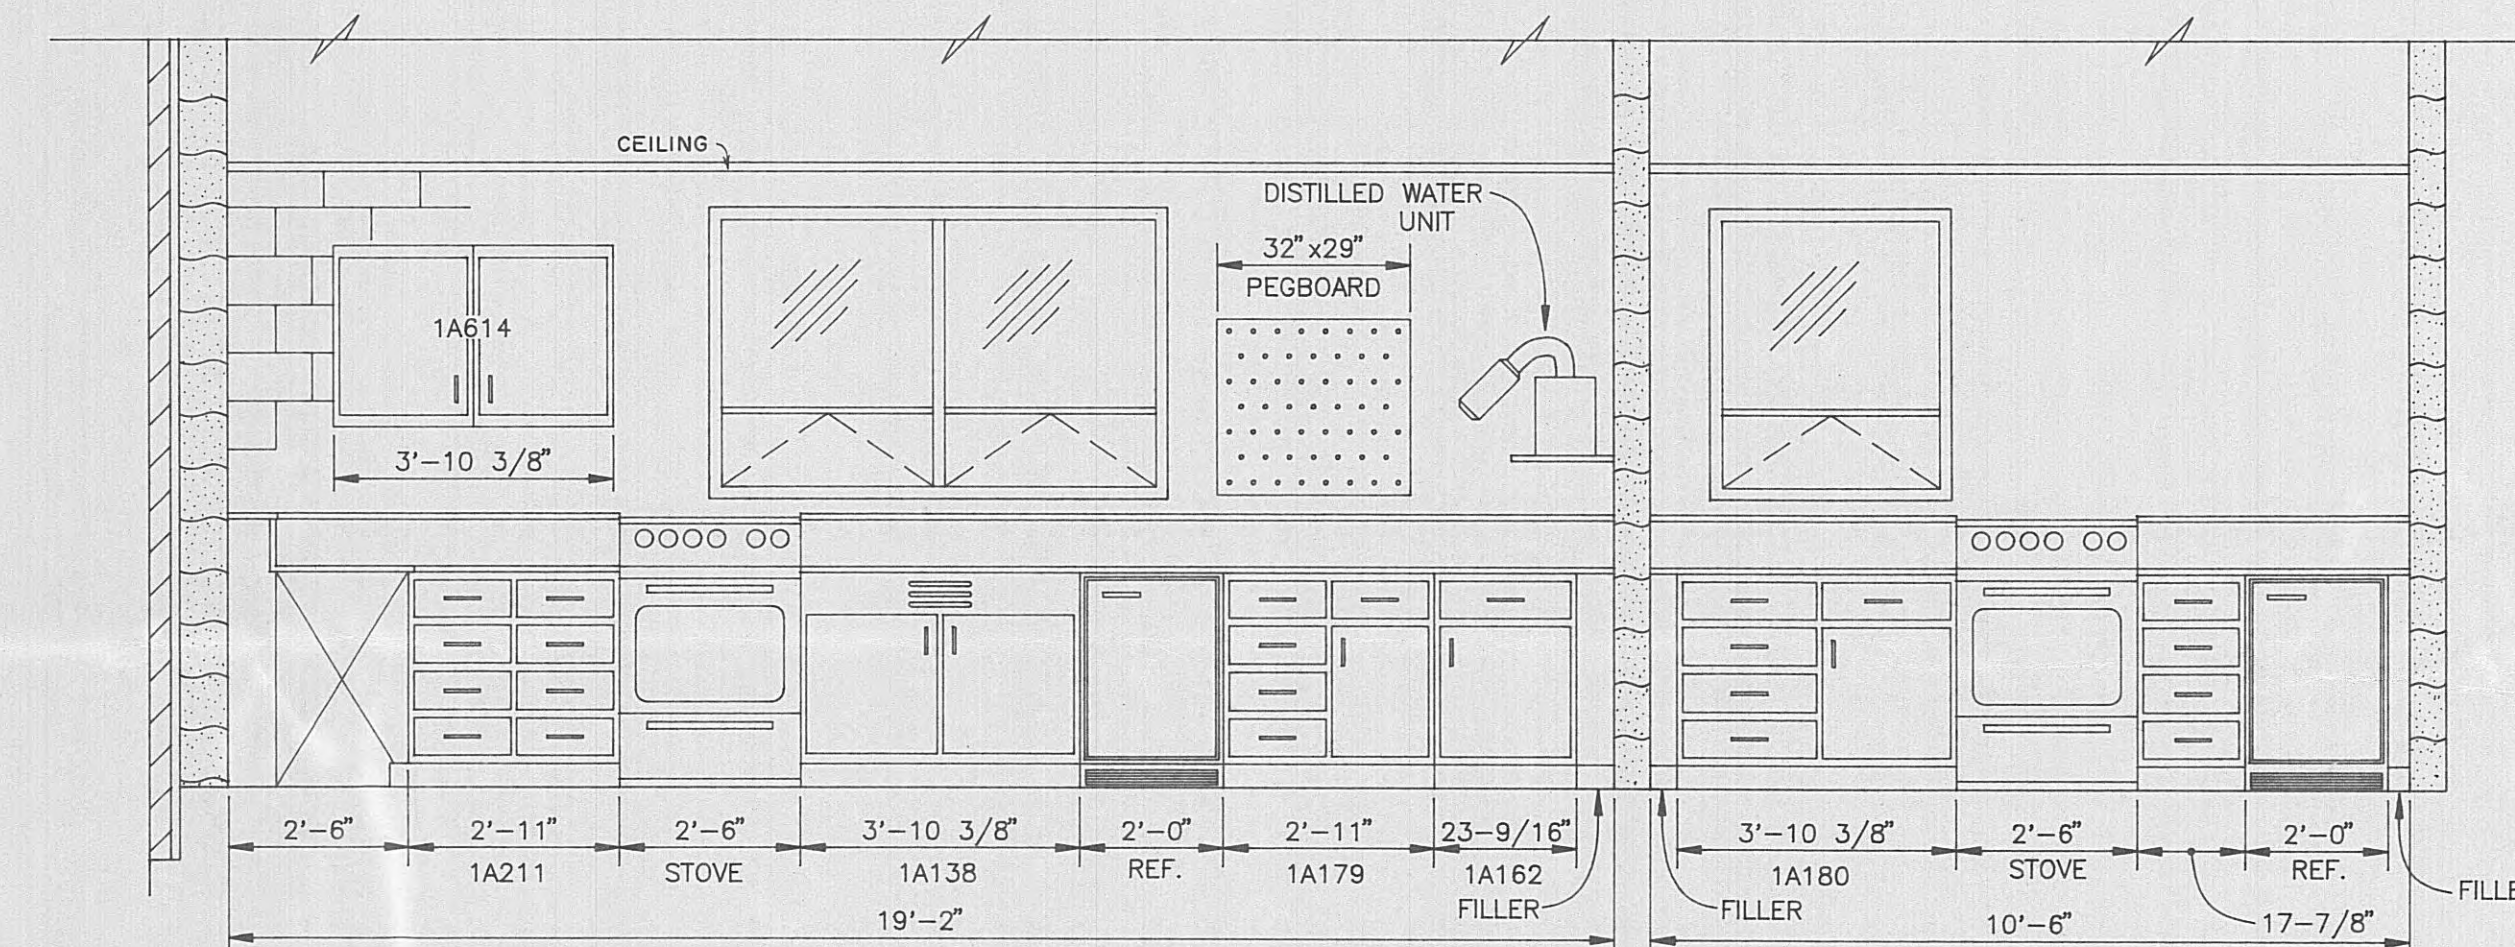


ELEVATION D-D  
SCALE: 3/8"=1'-0"

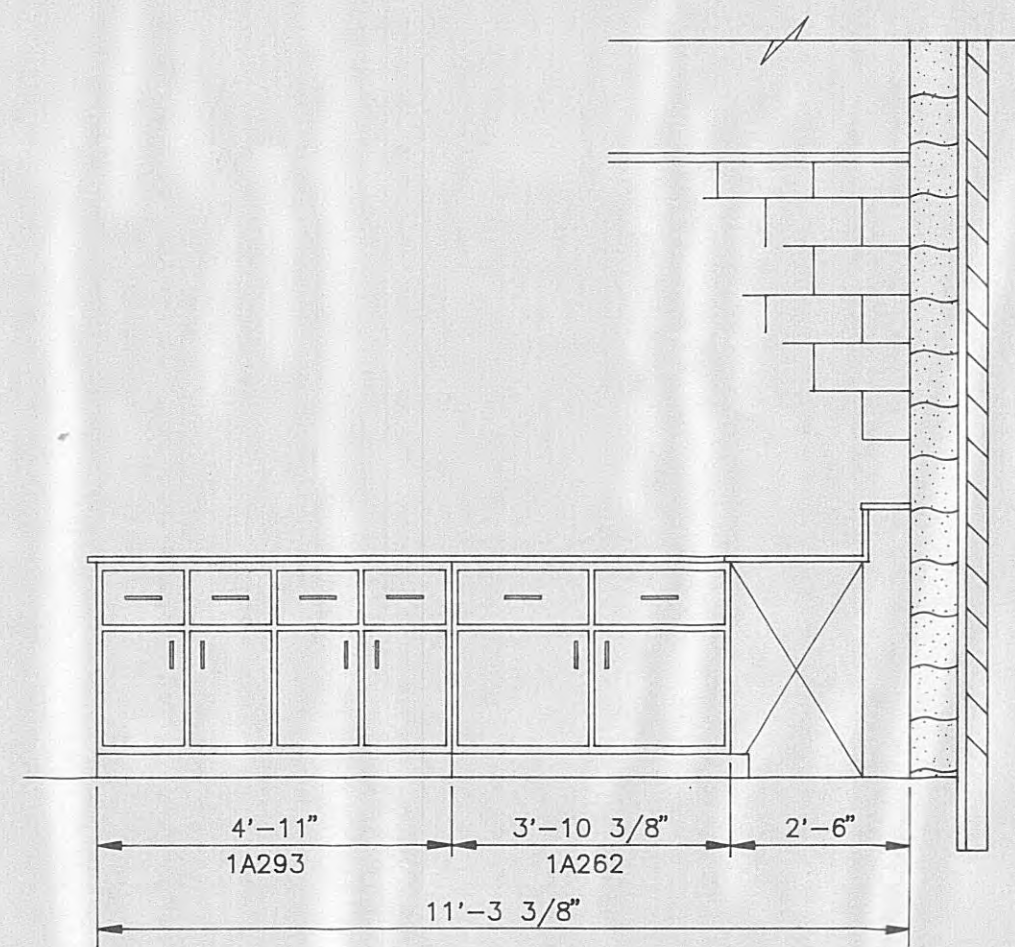

ELEVATION E-E  
SCALE: 3/8"=1'-0"

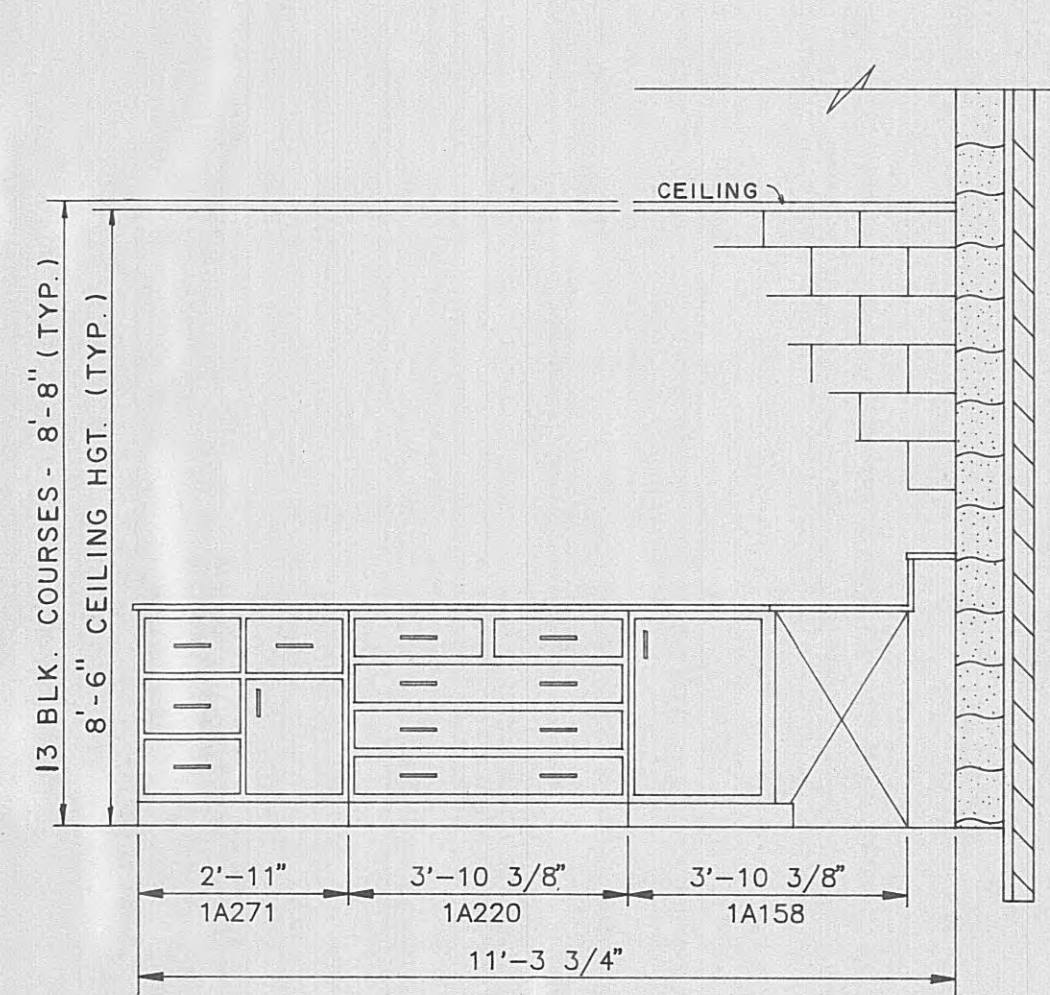


ELEVATION F-F  
SCALE: 3/8"=1'-0"

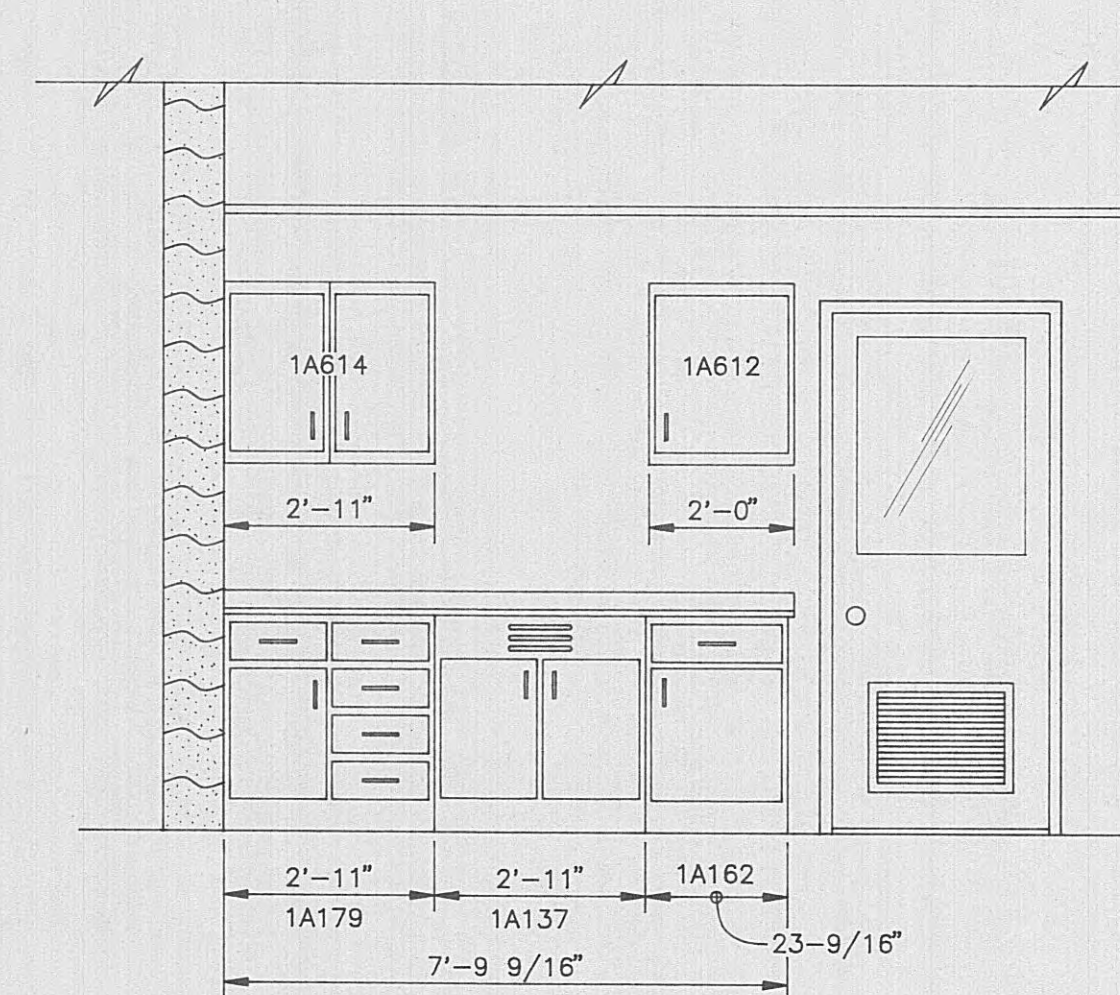


ELEVATION G-G  
SCALE: 3/8"=1'-0"


AS BUILT  
DATE: 3-20-95  
APPROVED: D.M.

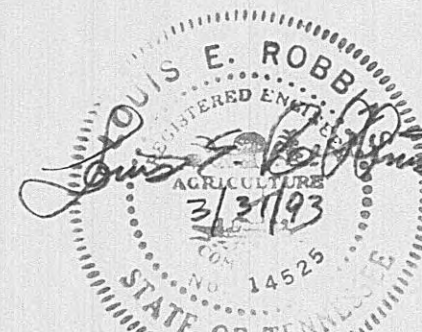




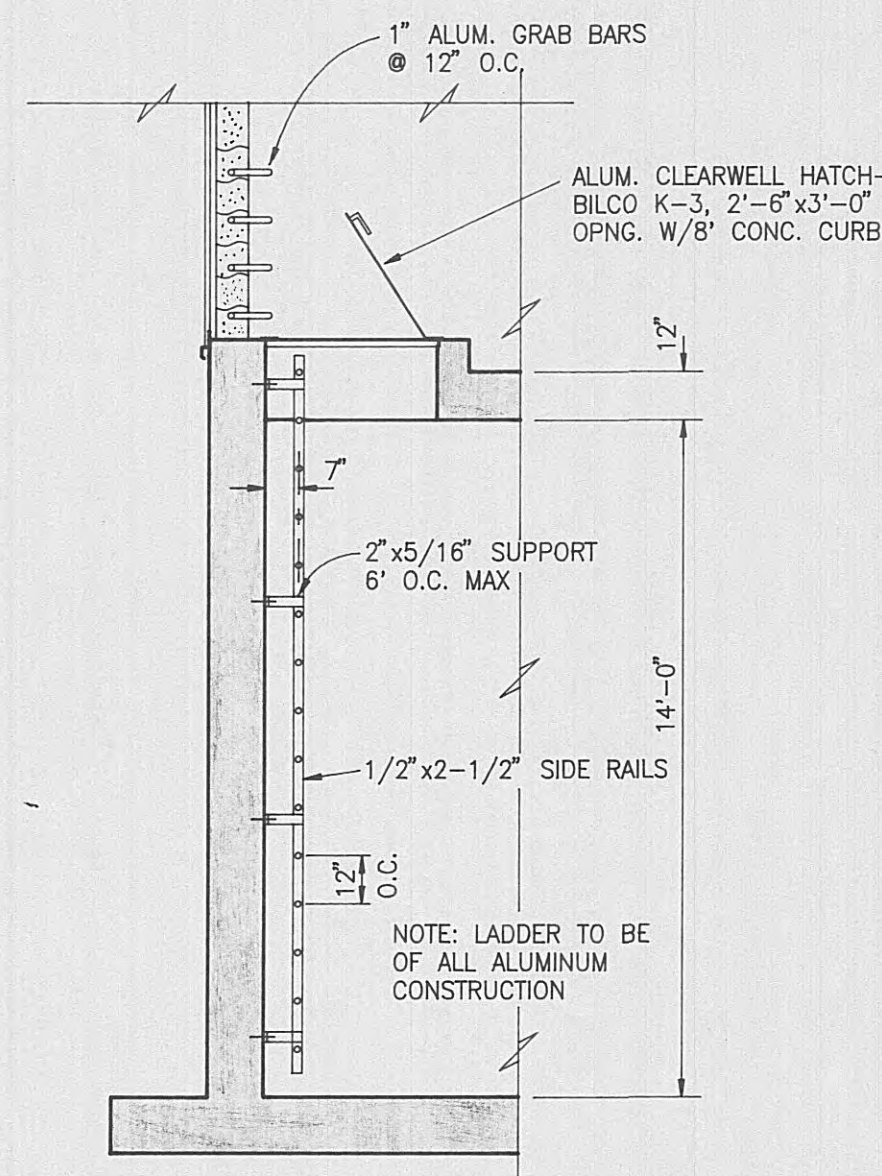


**CLEARWELL LADDER DETAIL**  
SCALE: 1/4"=1'-0"

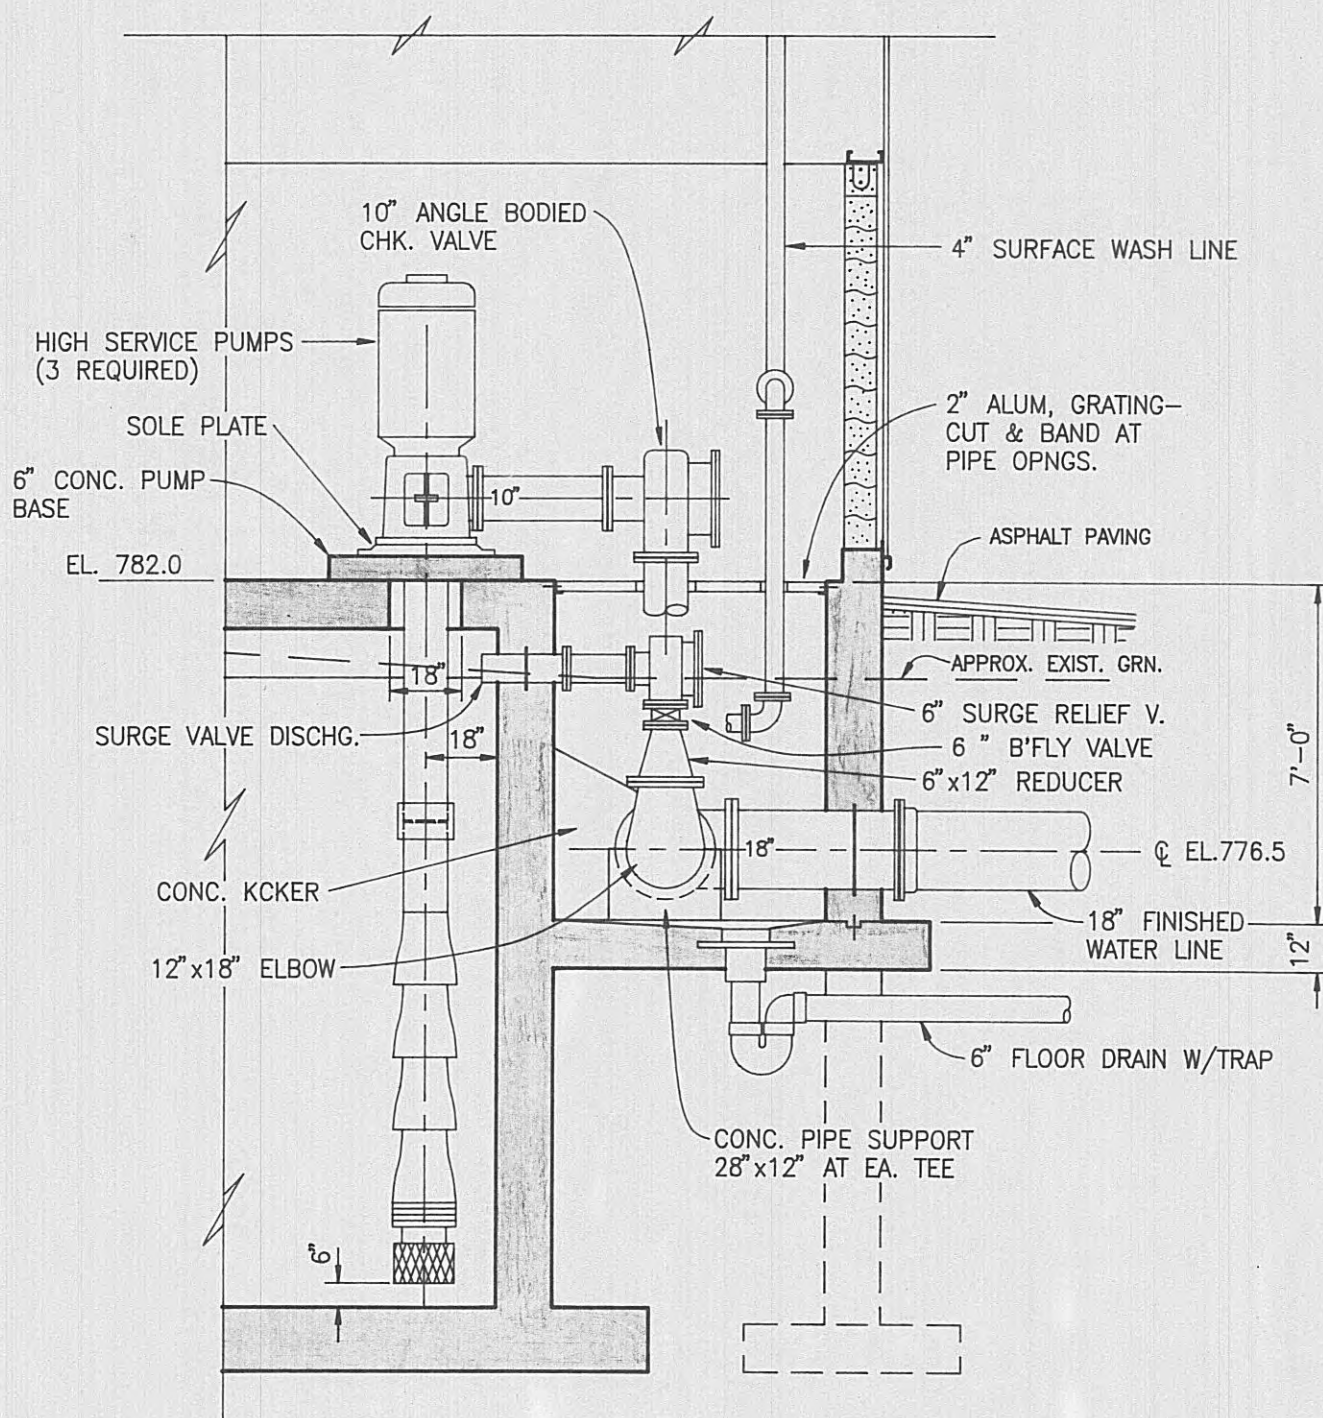

**SECTION H-6**  
SCALE: 1/4"=1'-0"

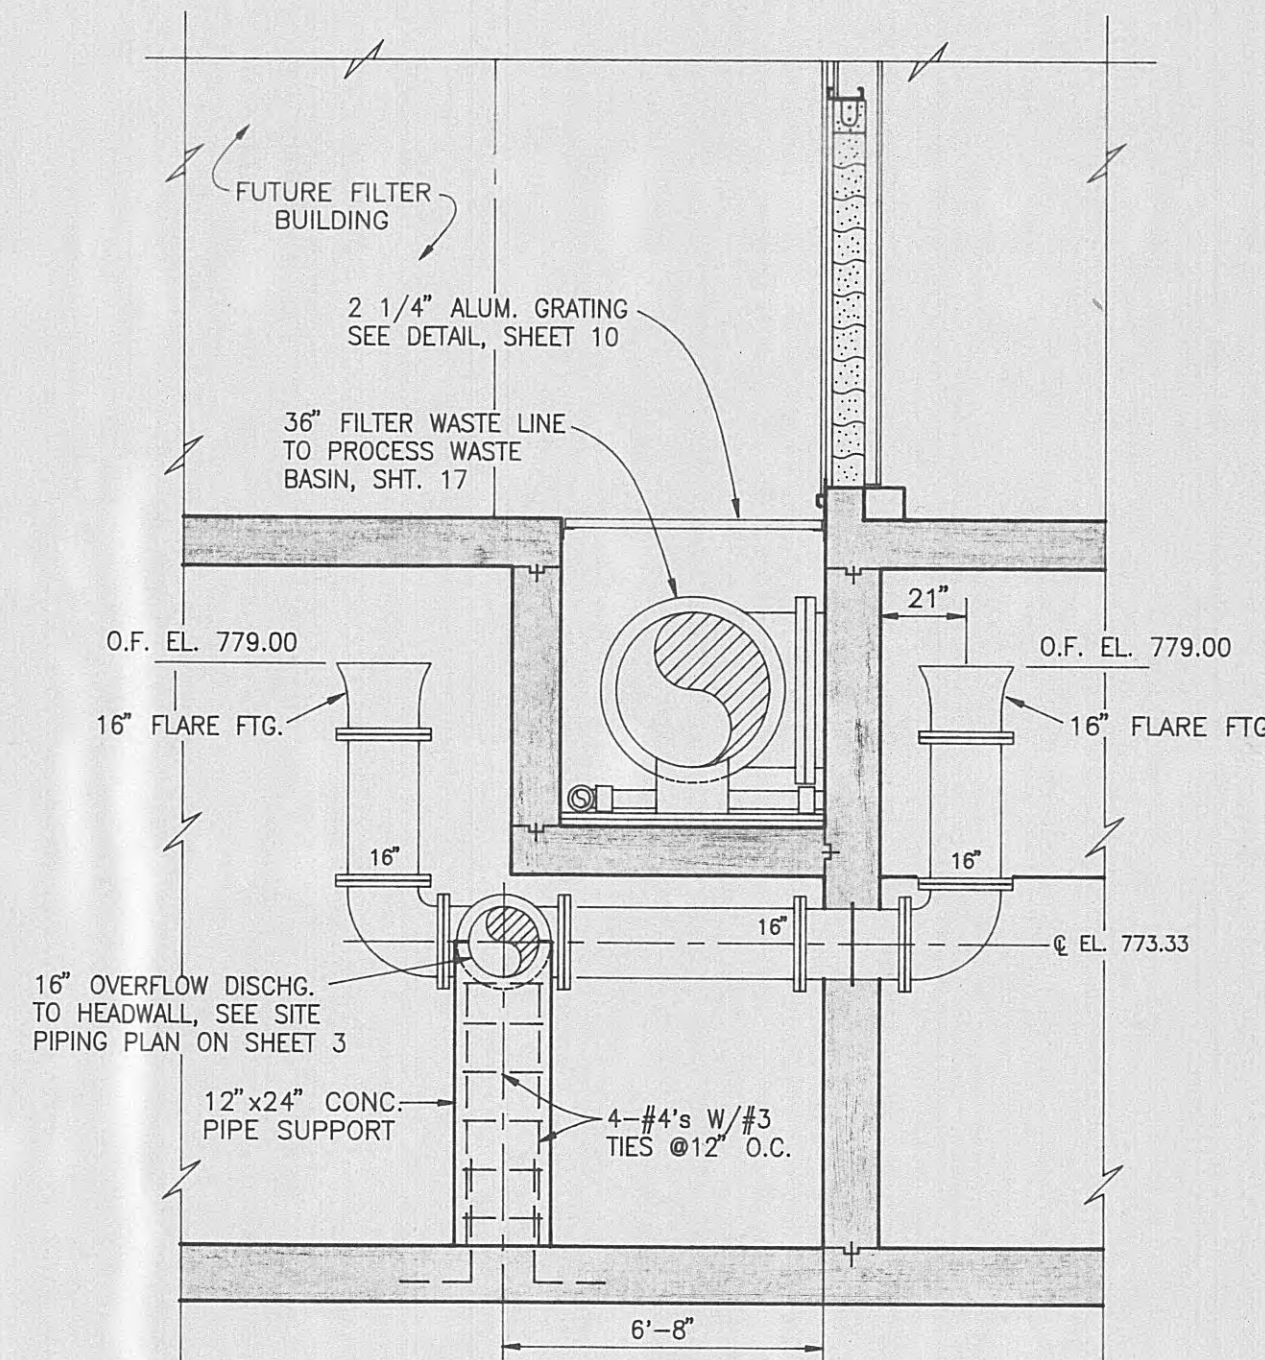


**SECTION I-6  
OVERFLOW PIPING DETAIL**  
SCALE: 1/4"=1'-0"

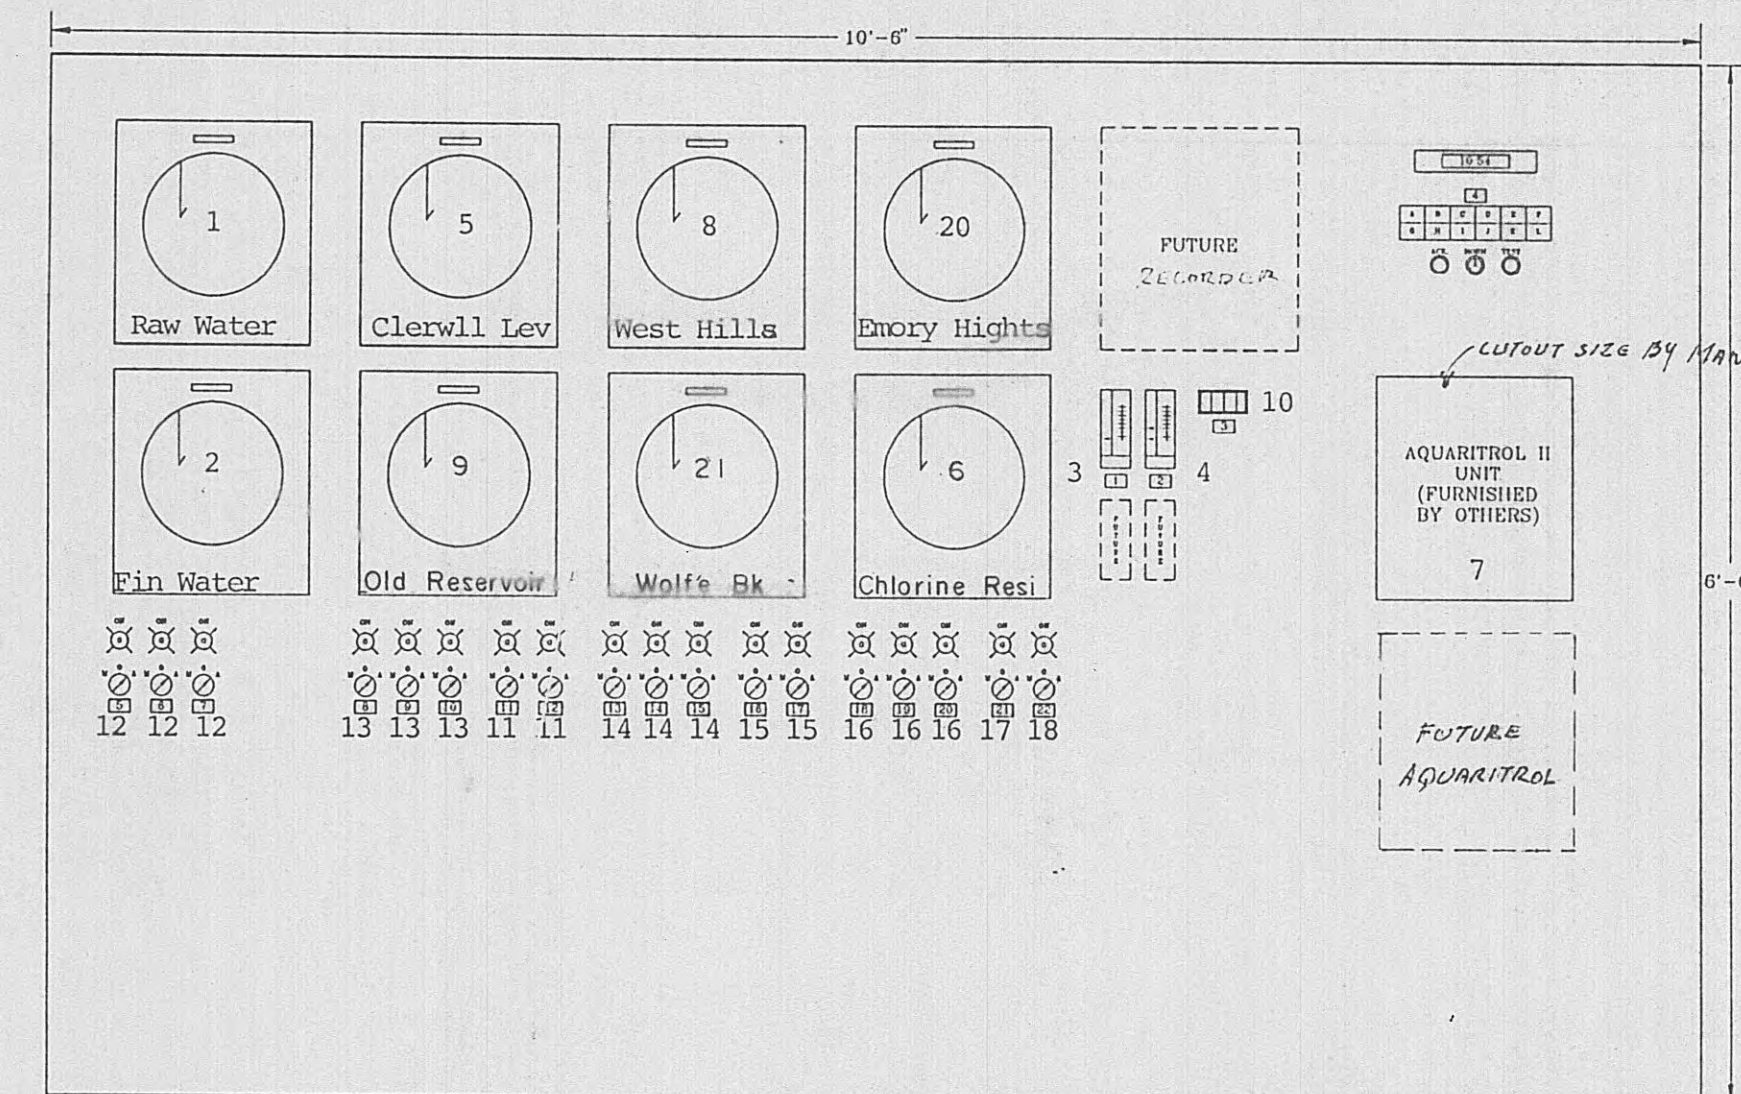


- MAIN CONTROL PANEL NAMEPLATE SCHEDULE**
1. RAW WATER TURBIDITY
  2. FINISHED WATER TURBIDITY
  3. PROCESS WASTE BASIN LEVEL
  4. ANNUNCIATOR
  5. HIGH SERVICE PUMP NO.1
  6. HIGH SERVICE PUMP NO.2
  7. HIGH SERVICE PUMP NO.3
  8. RAW WATER PUMP NO.1
  9. RAW WATER PUMP NO.2
  10. RAW WATER PUMP NO.3
  11. DECANT PUMP NO.1
  12. DECANT PUMP NO.2
  13. CHLORINATOR NO.1
  14. CHLORINATOR NO.2
  15. MIXER
  16. POLYMER FEED NO.1
  17. POLYMER FEED NO.2
  18. CARBON FEEDER NO.1
  19. CARBON FEEDER NO.2
  20. CARBON FEEDER NO.3
  21. CORROSION INHIBITOR FEED PUMP
  22. FLUORIDE FEED PUMP

- ANNUNCIATOR SCHEDULE**
- A. HIGH RAW WATER TURBIDITY
  - B. HIGH FINISHED WATER TURBIDITY
  - C. HIGH/LOW PH
  - D. LOW CHLORINE RESIDUAL
  - E. CLEARWELL LOW LEVEL
  - F. CLEARWELL HIGH LEVEL
  - G. PROCESS WASTE BASIN HIGH LEVEL
  - H. OLD RESERVOIR TANK HIGH LEVEL
  - I. OLD RESERVOIR TANK LOW LEVEL
  - J. CHLORINE LEAK ALARM
  - K. "BLANK"
  - L. "BLANK"

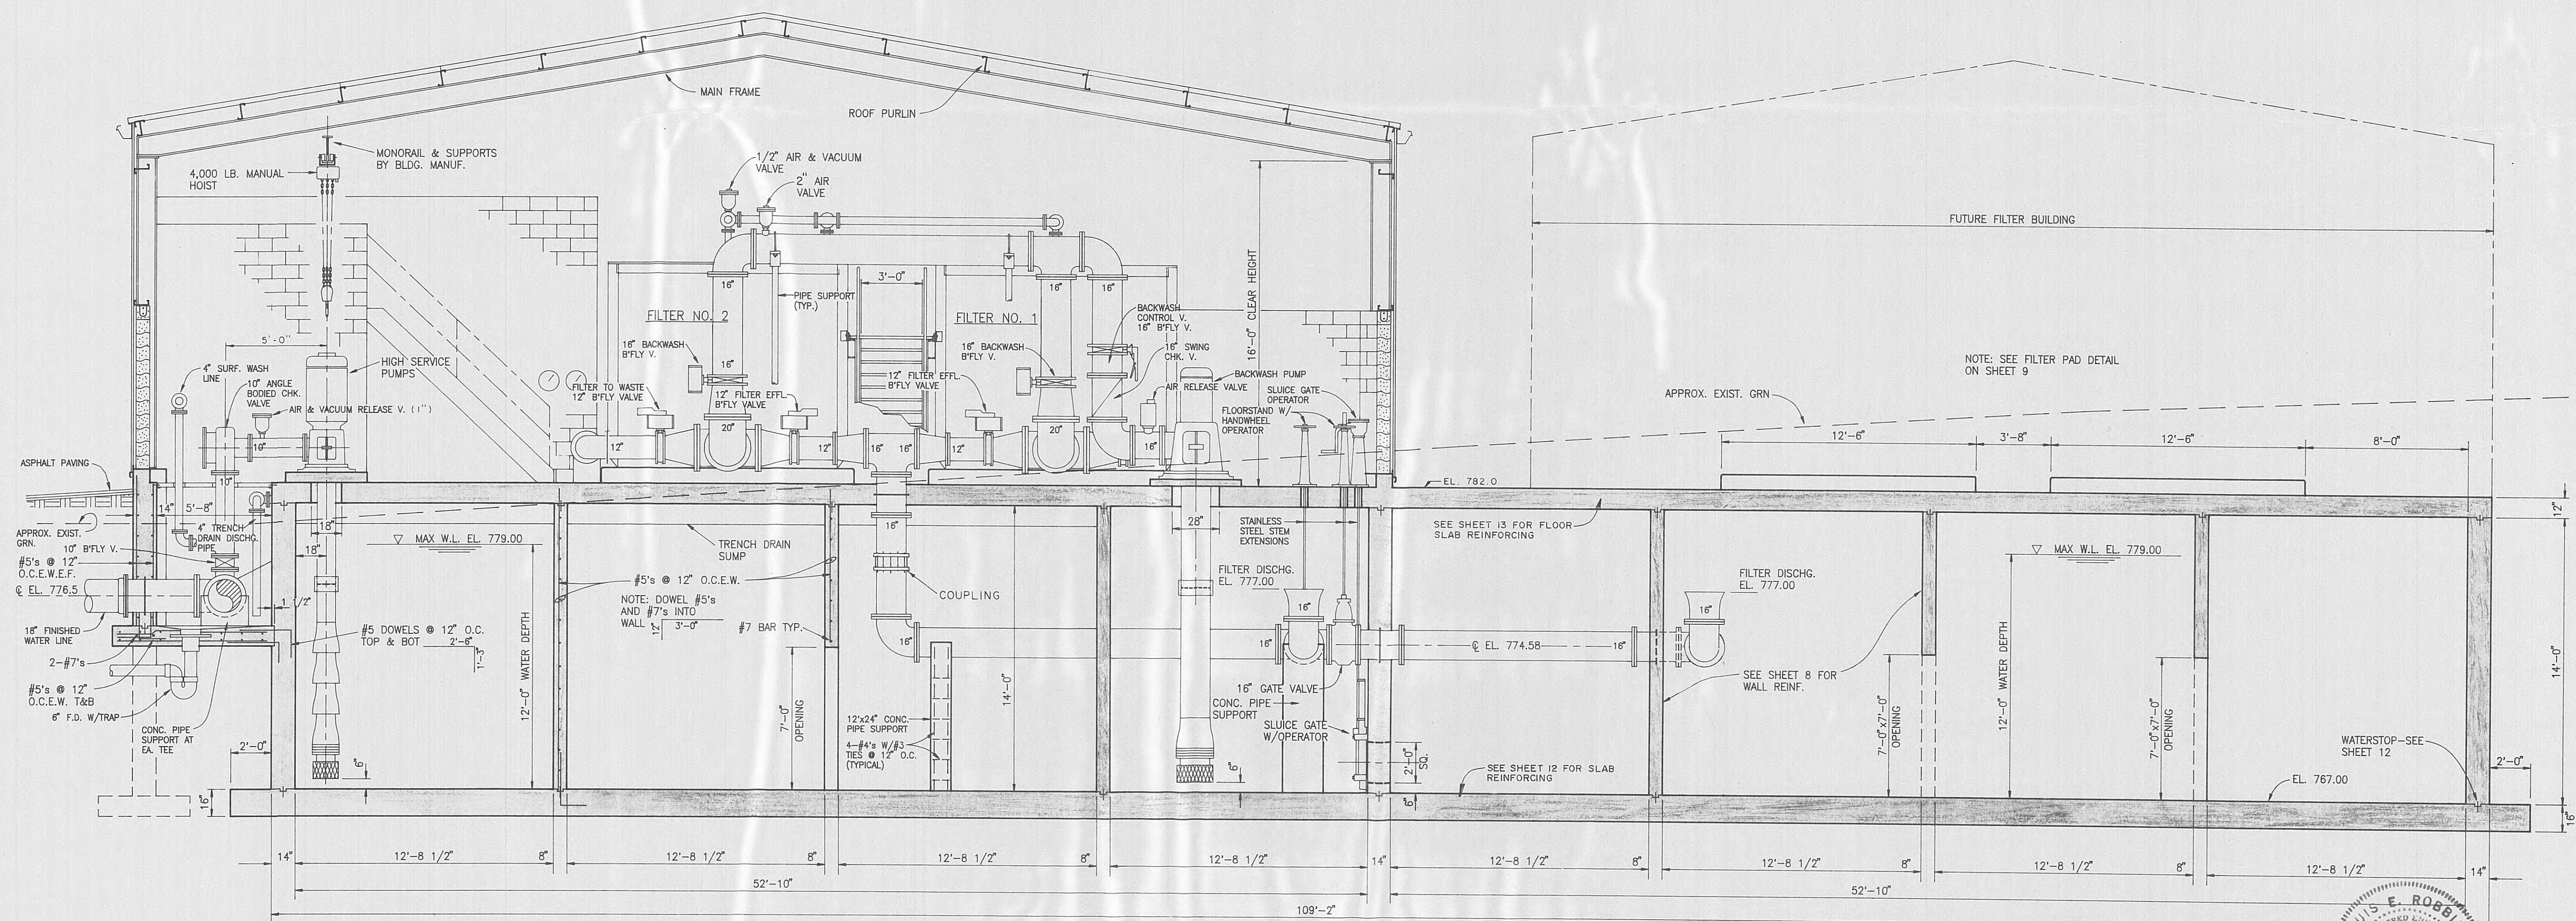

**SECTION A-6**  
SCALE: 1/4"=1'-0"






**AS BUILT**  
DATE: 3-20-95  
APPROVED: D.M.

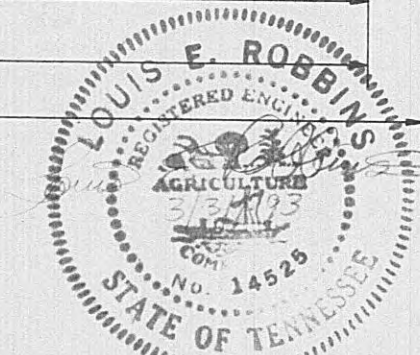

**REVISIONS**  
4/19/93  
ADDED TRENCH  
DRAIN AND OVER-  
FLOW PIPING DET'L

DESIGNED: L.E.R.  
DRAWN: S.C.G.  
CHECKED: L.E.R.  
DATE: MARCH, 1993  
SCALE: NOTED  
PROJ. NO. 0592



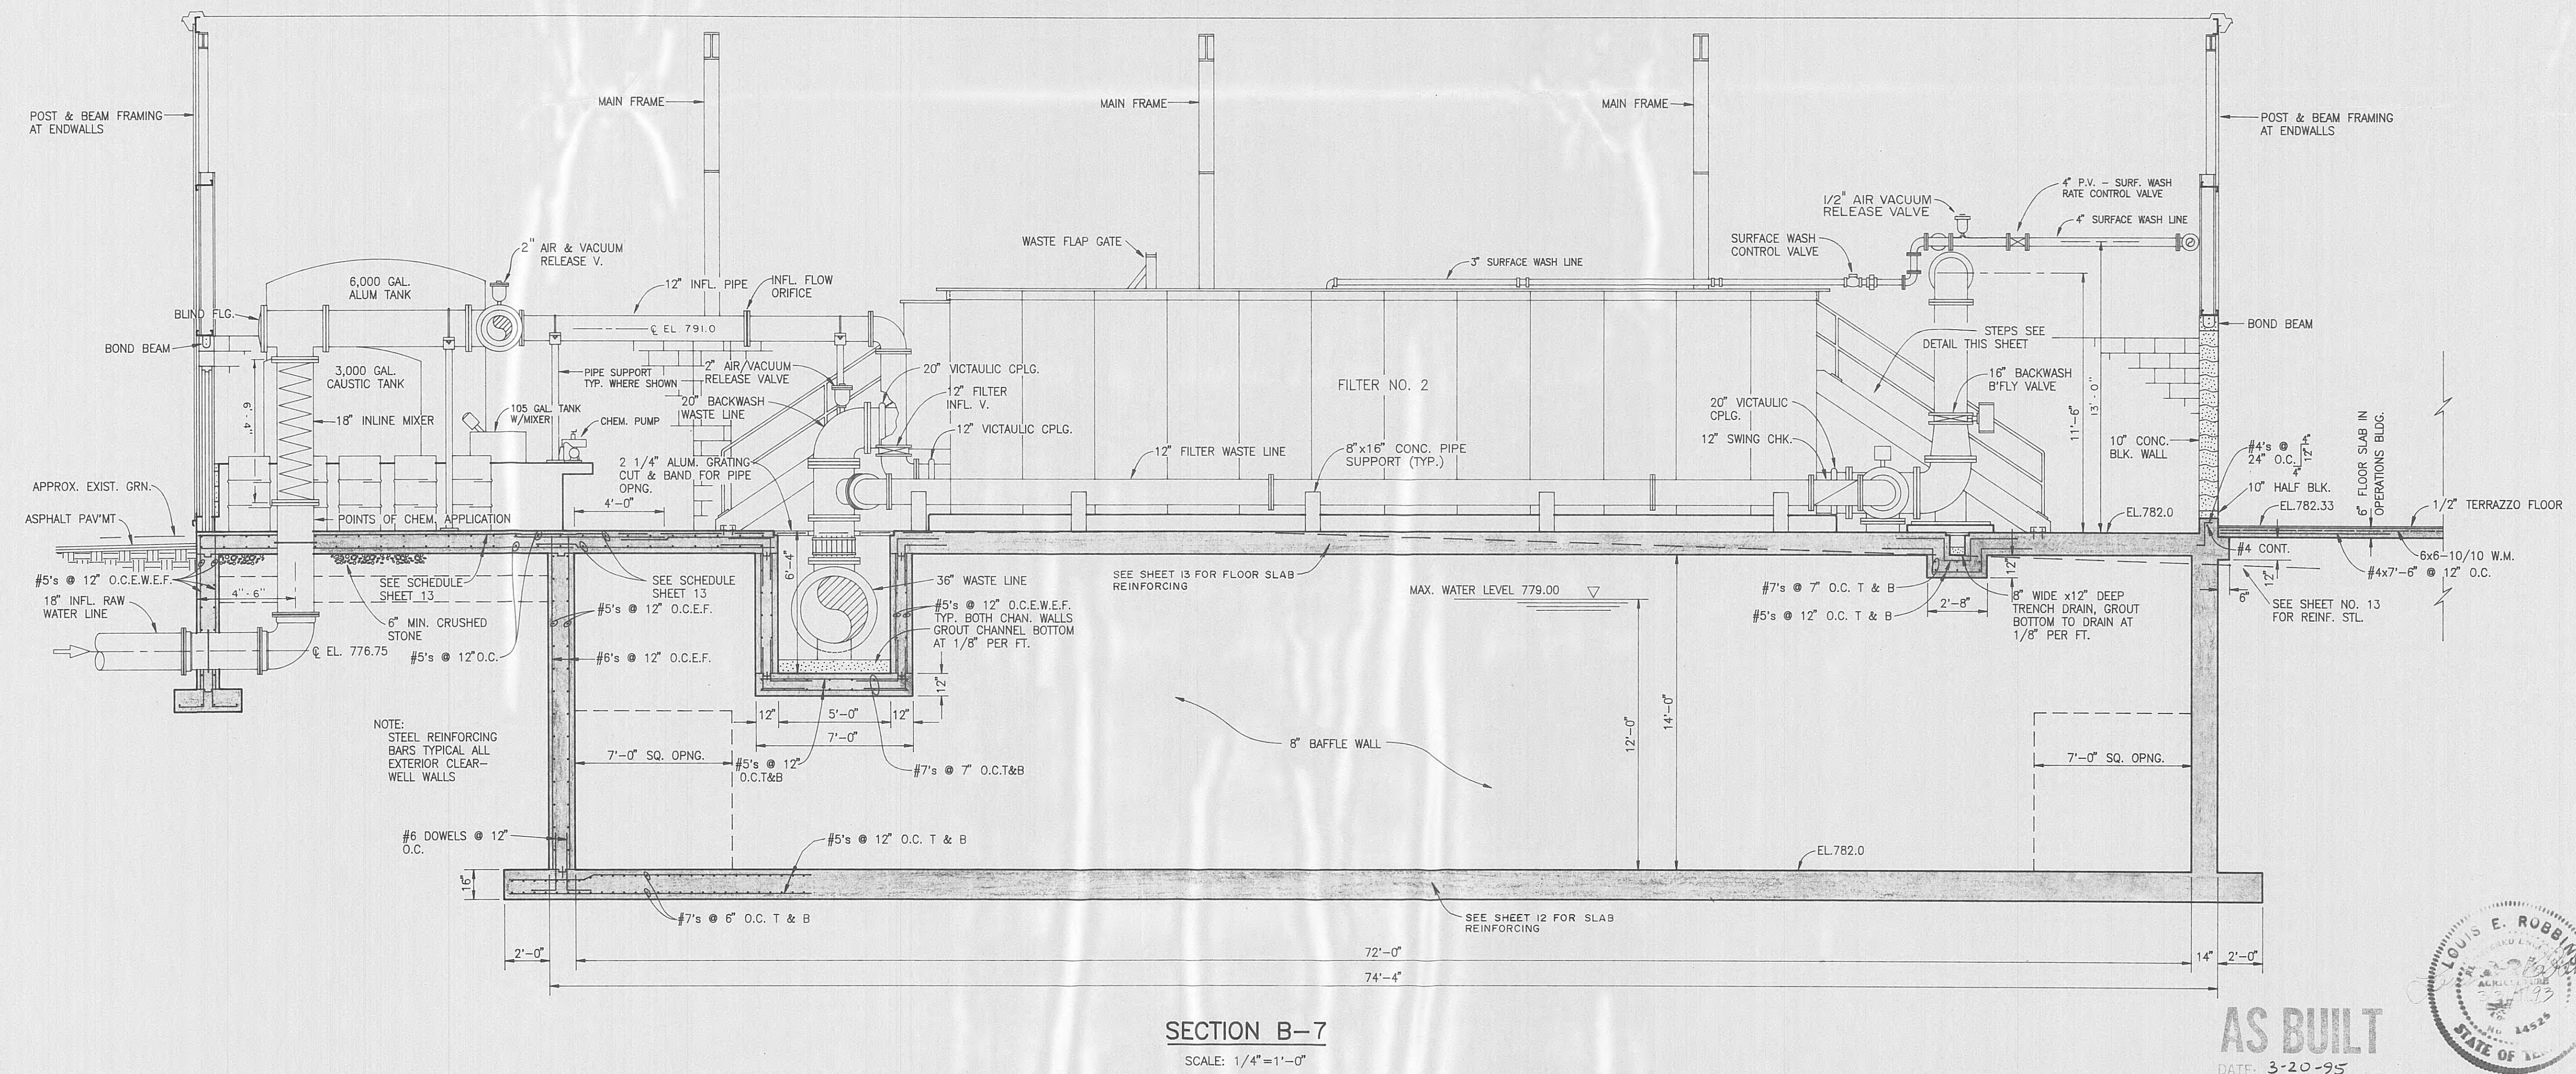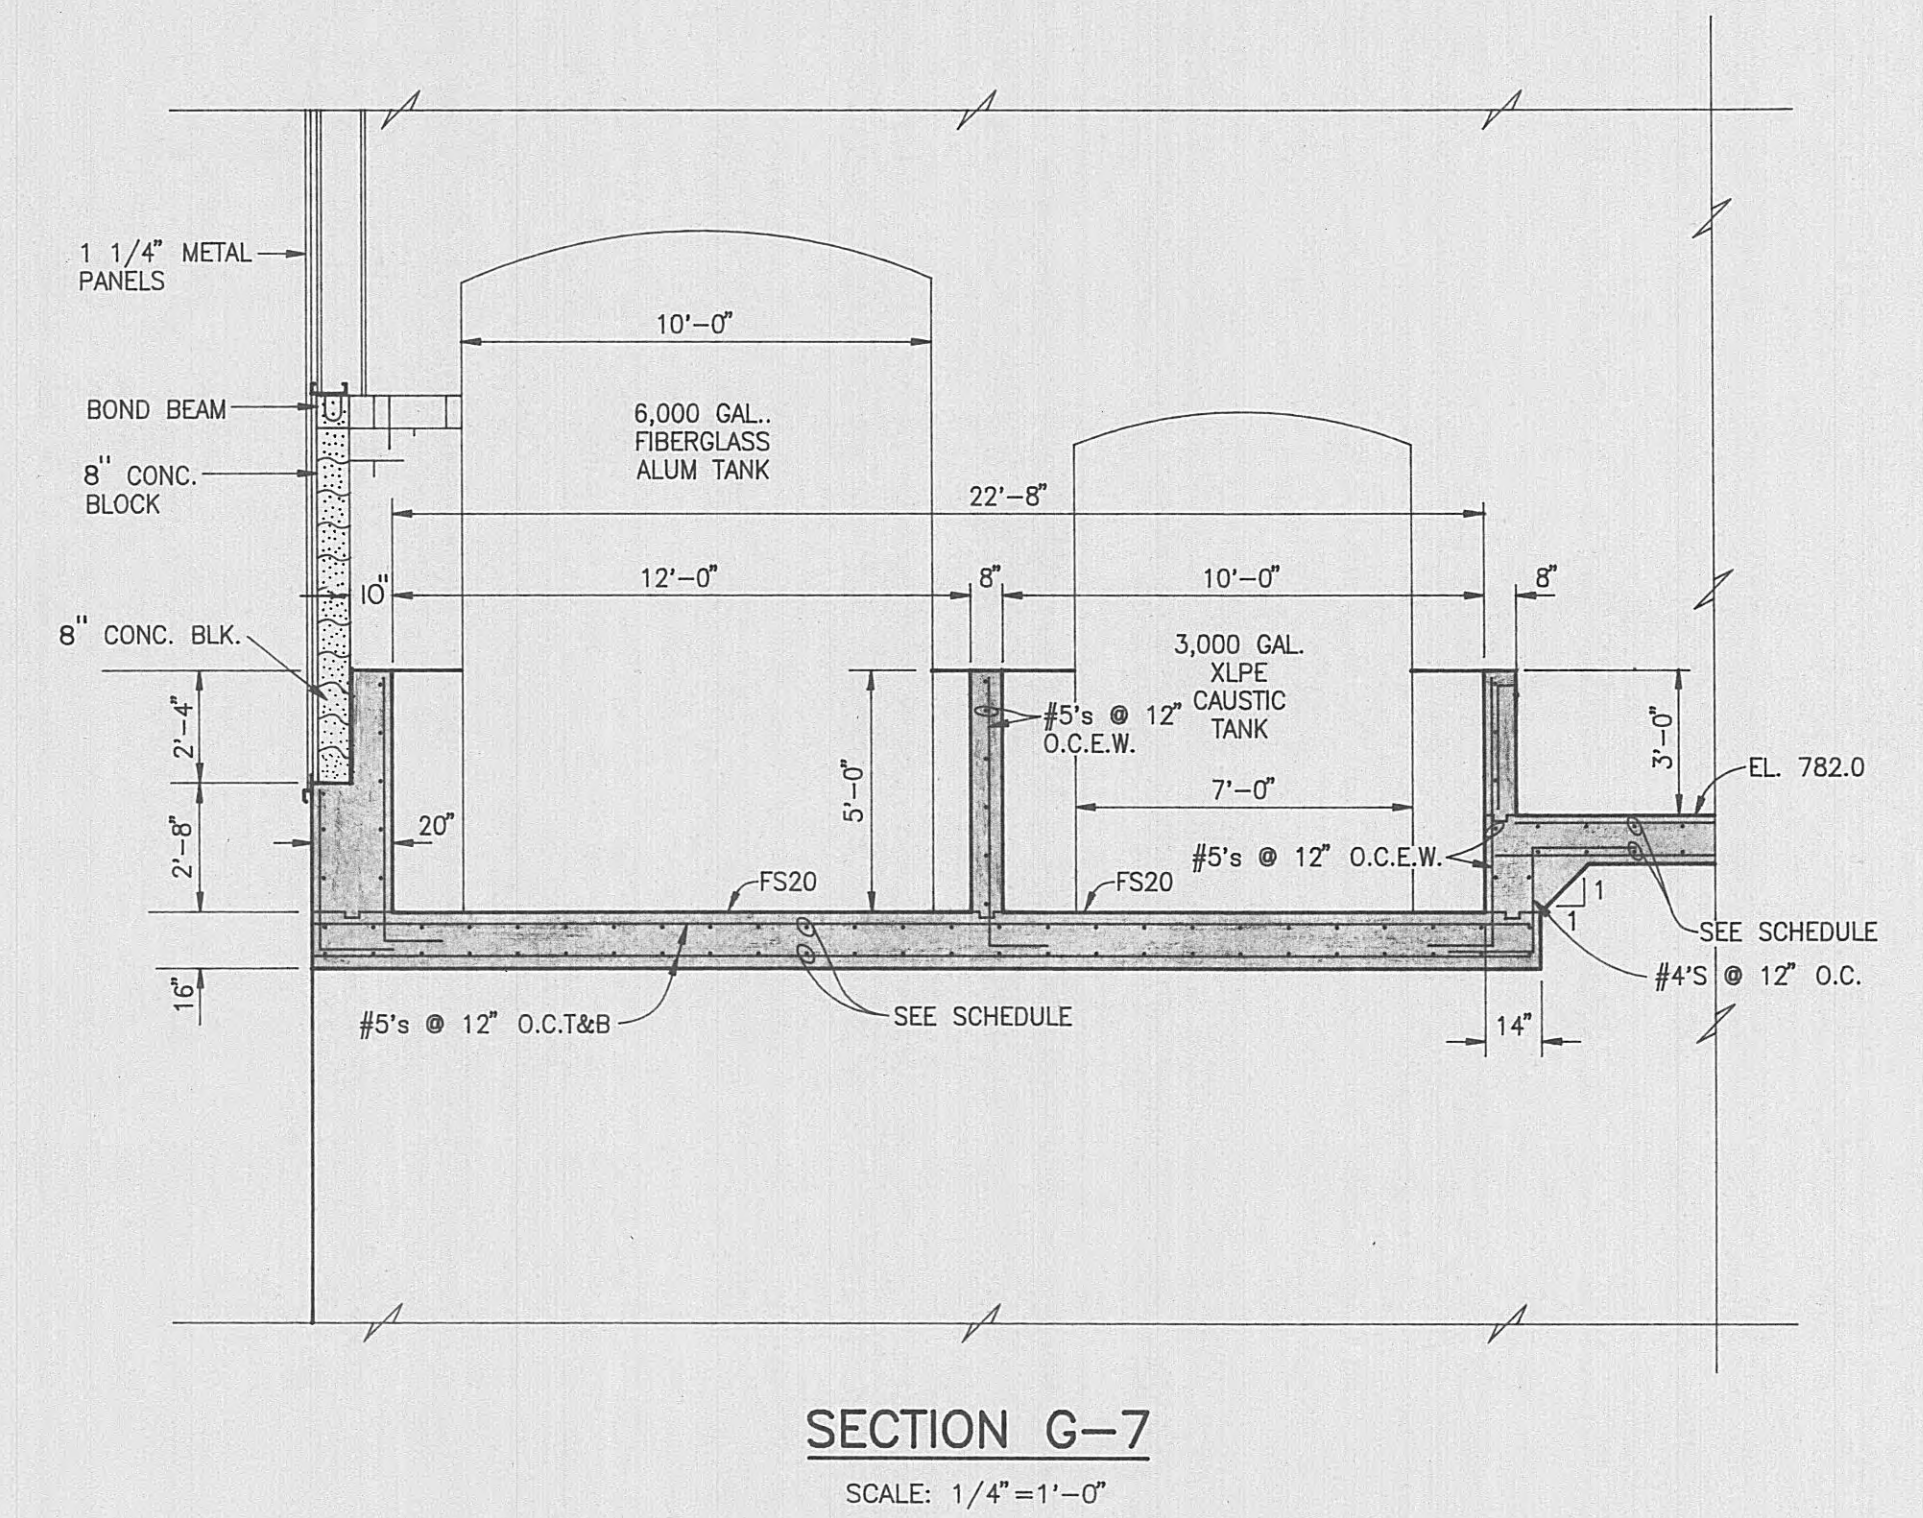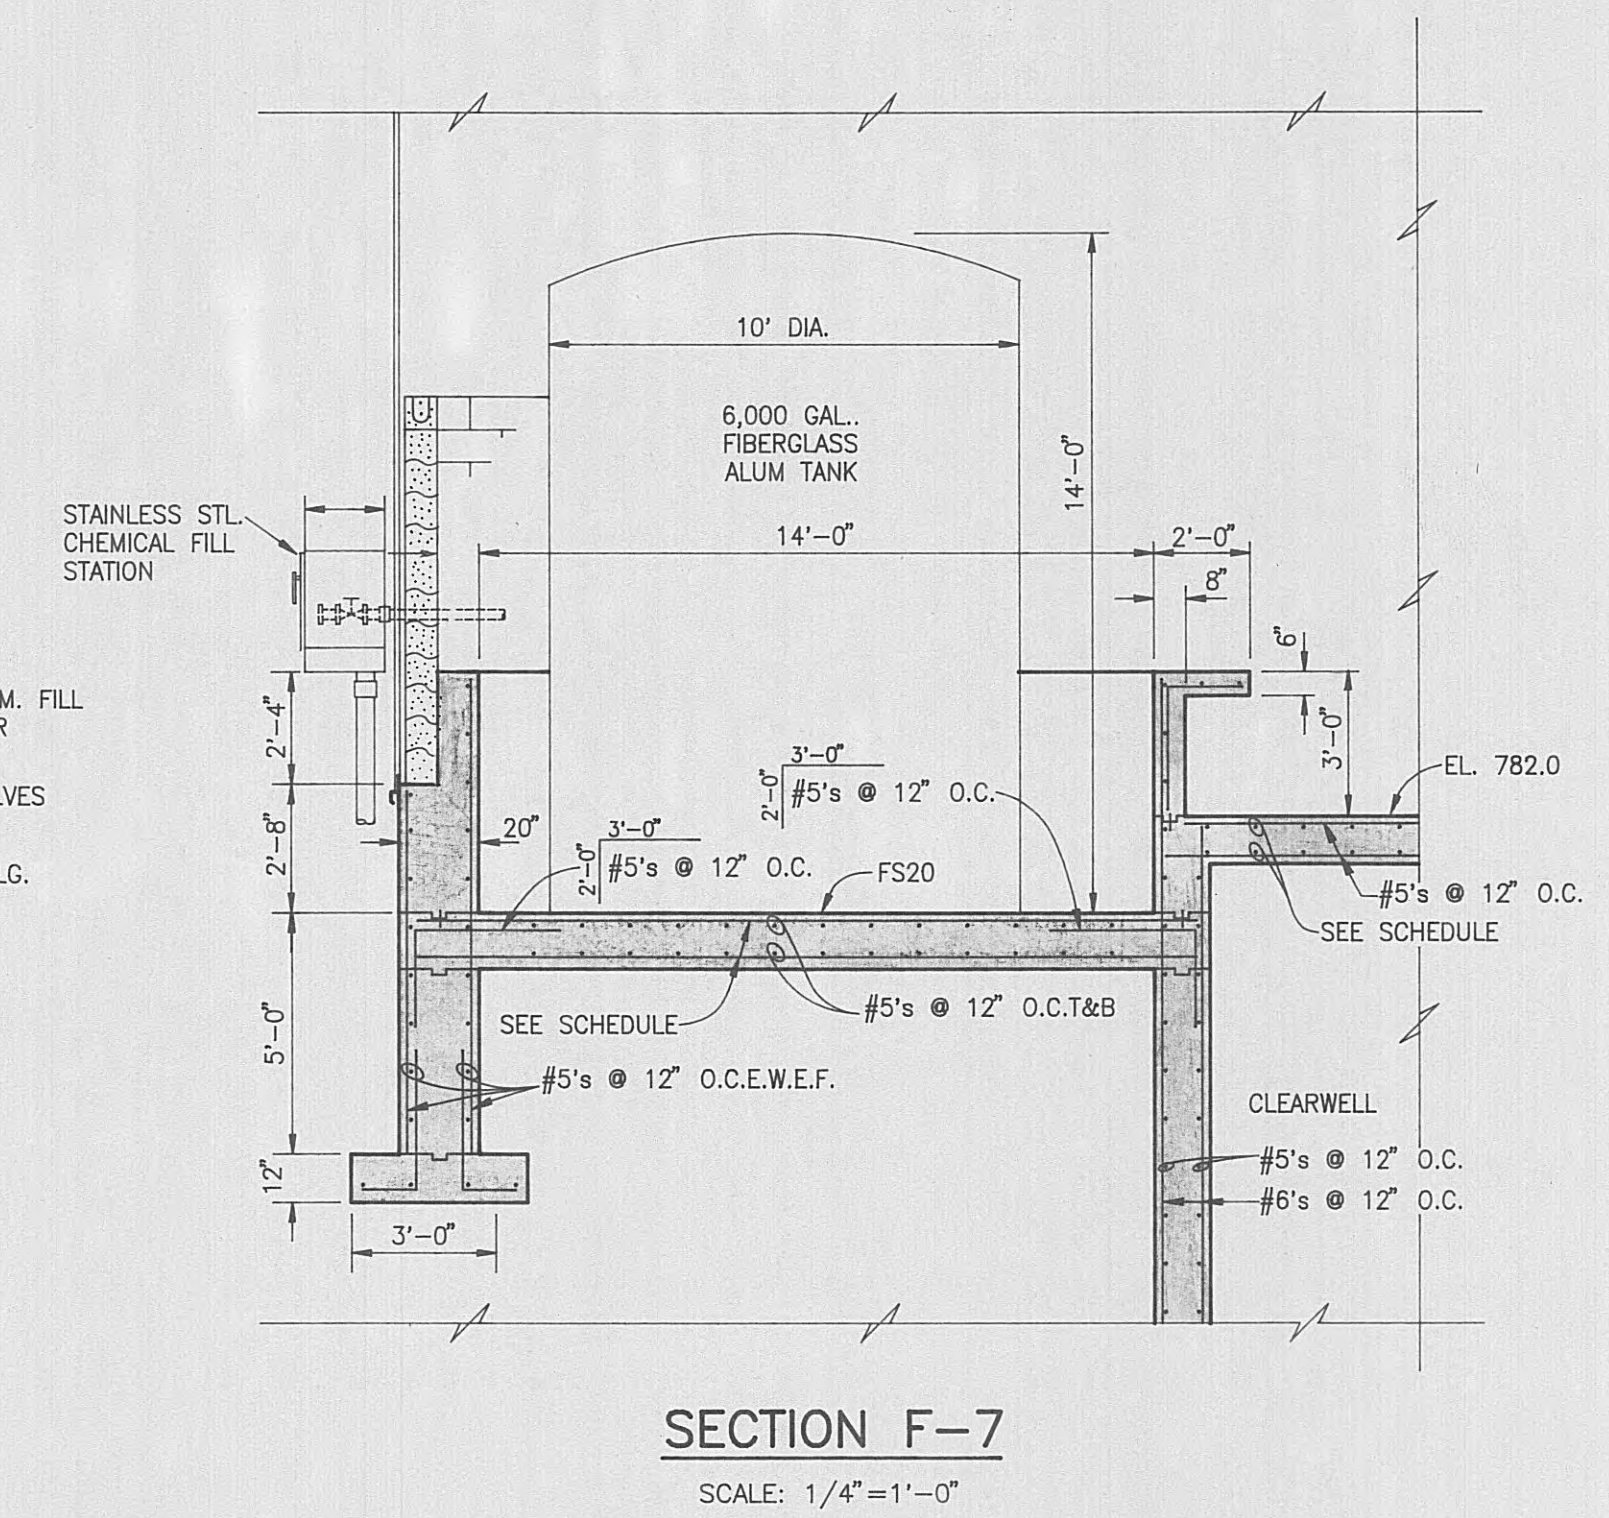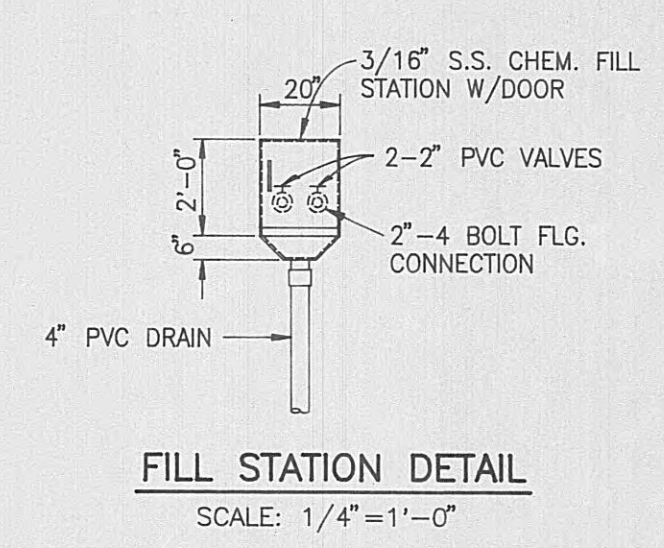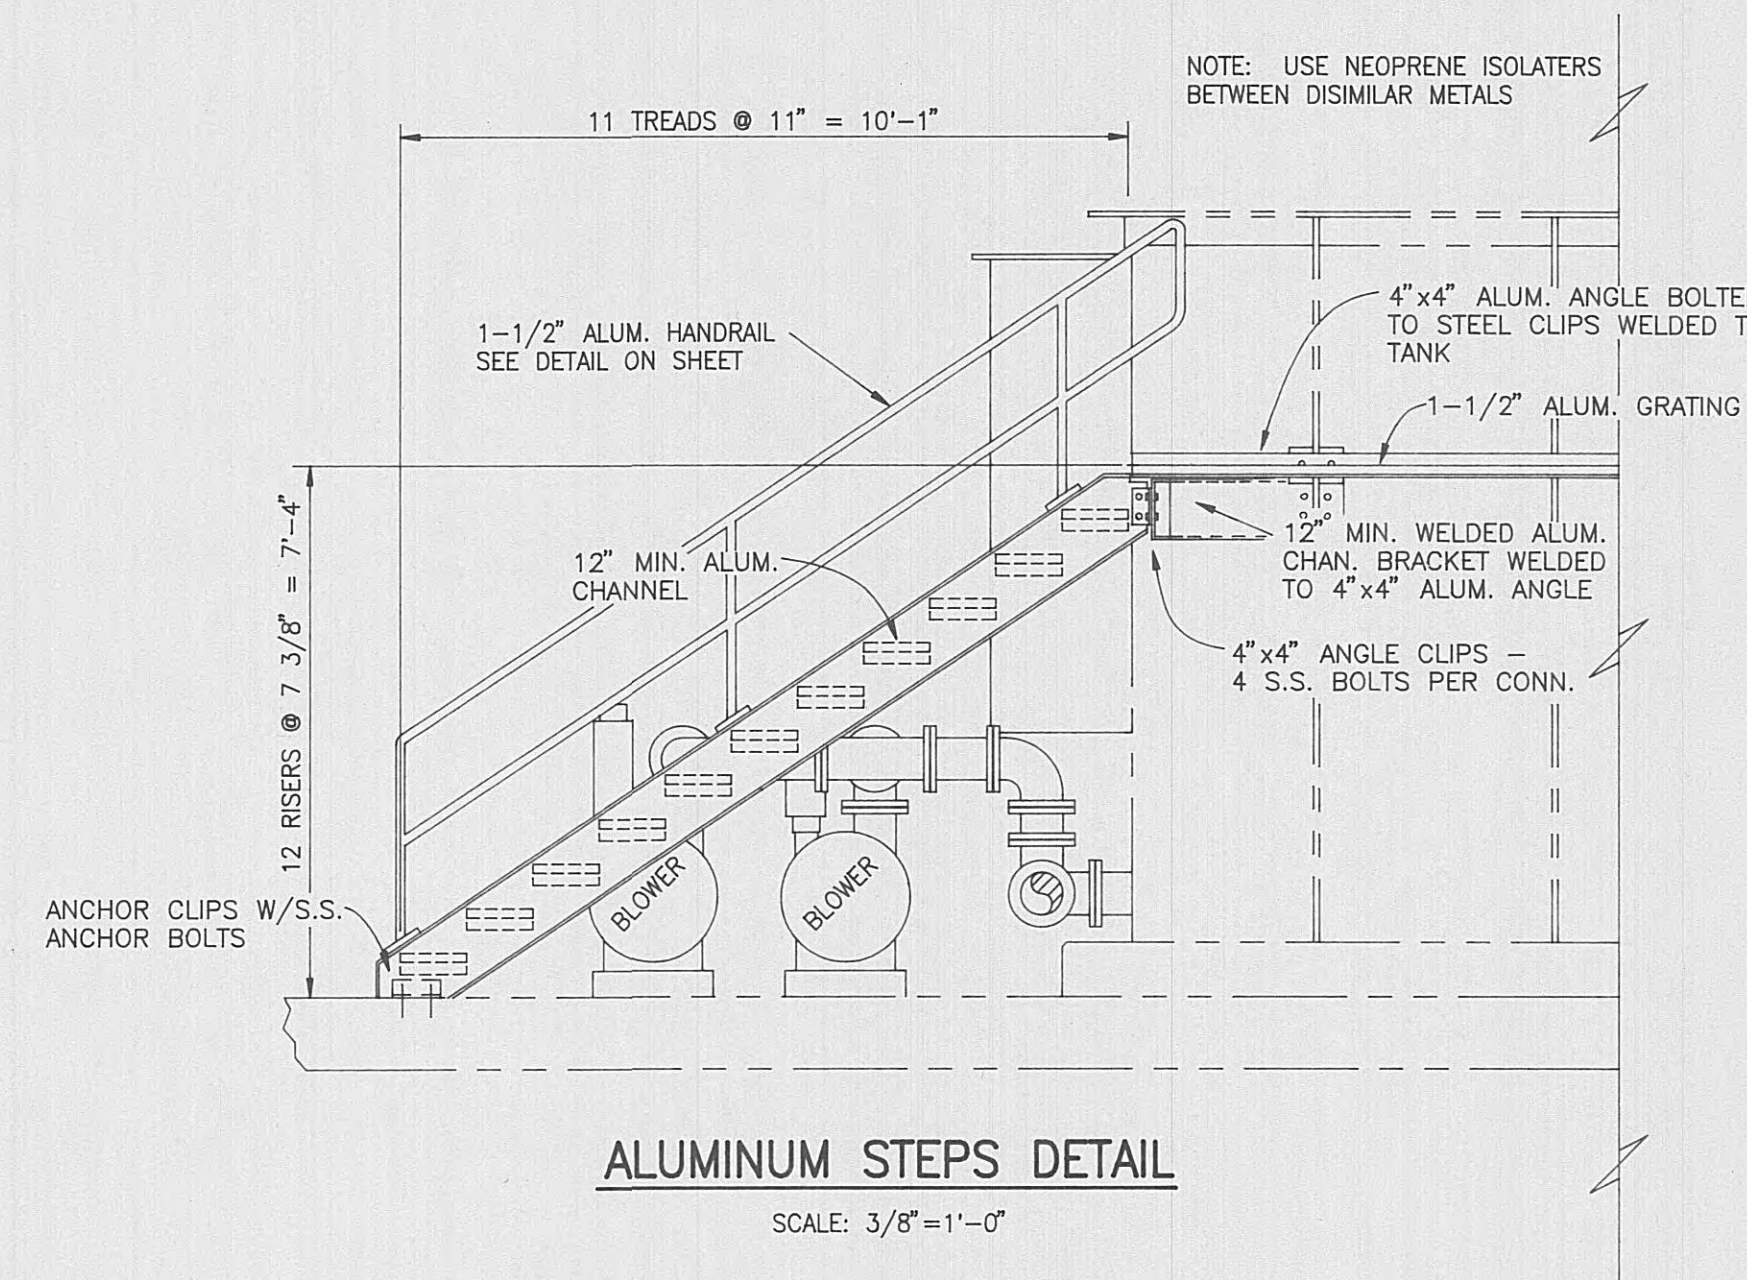

**ELROD • DUNSON, INC.**  
CONSULTING ENGINEERS  
NASHVILLE • KNOXVILLE  
LEXINGTON, KY

HARRIMAN, TENNESSEE  
CONTRACT W93-04  
FILTER BUILDING - SECTIONS AND ALUMINUM STEP DETAIL

## REVISIONS


4-19-93 ADDED 36"  
PIPE TRENCH AND  
TRENCH DRAIN

DESIGNED: L.E.R.  
DRAWN: S.C.G.  
CHECKED: L.E.R.  
DATE: MARCH, 1993  
SCALE: NOTED  
PROJ. NO. 0592

SHEET 7


OF 36



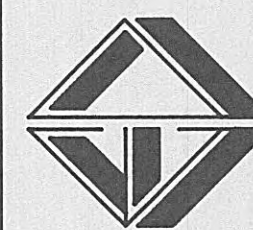


4-19-93 ADDED 36" PIPE TRENCH


DESIGNED: L.E.R.  
DRAWN: S.C.G.  
CHECKED: L.E.R.  
DATE: MARCH, 1993  
SCALE: NOTED  
PROJ. NO. 0592

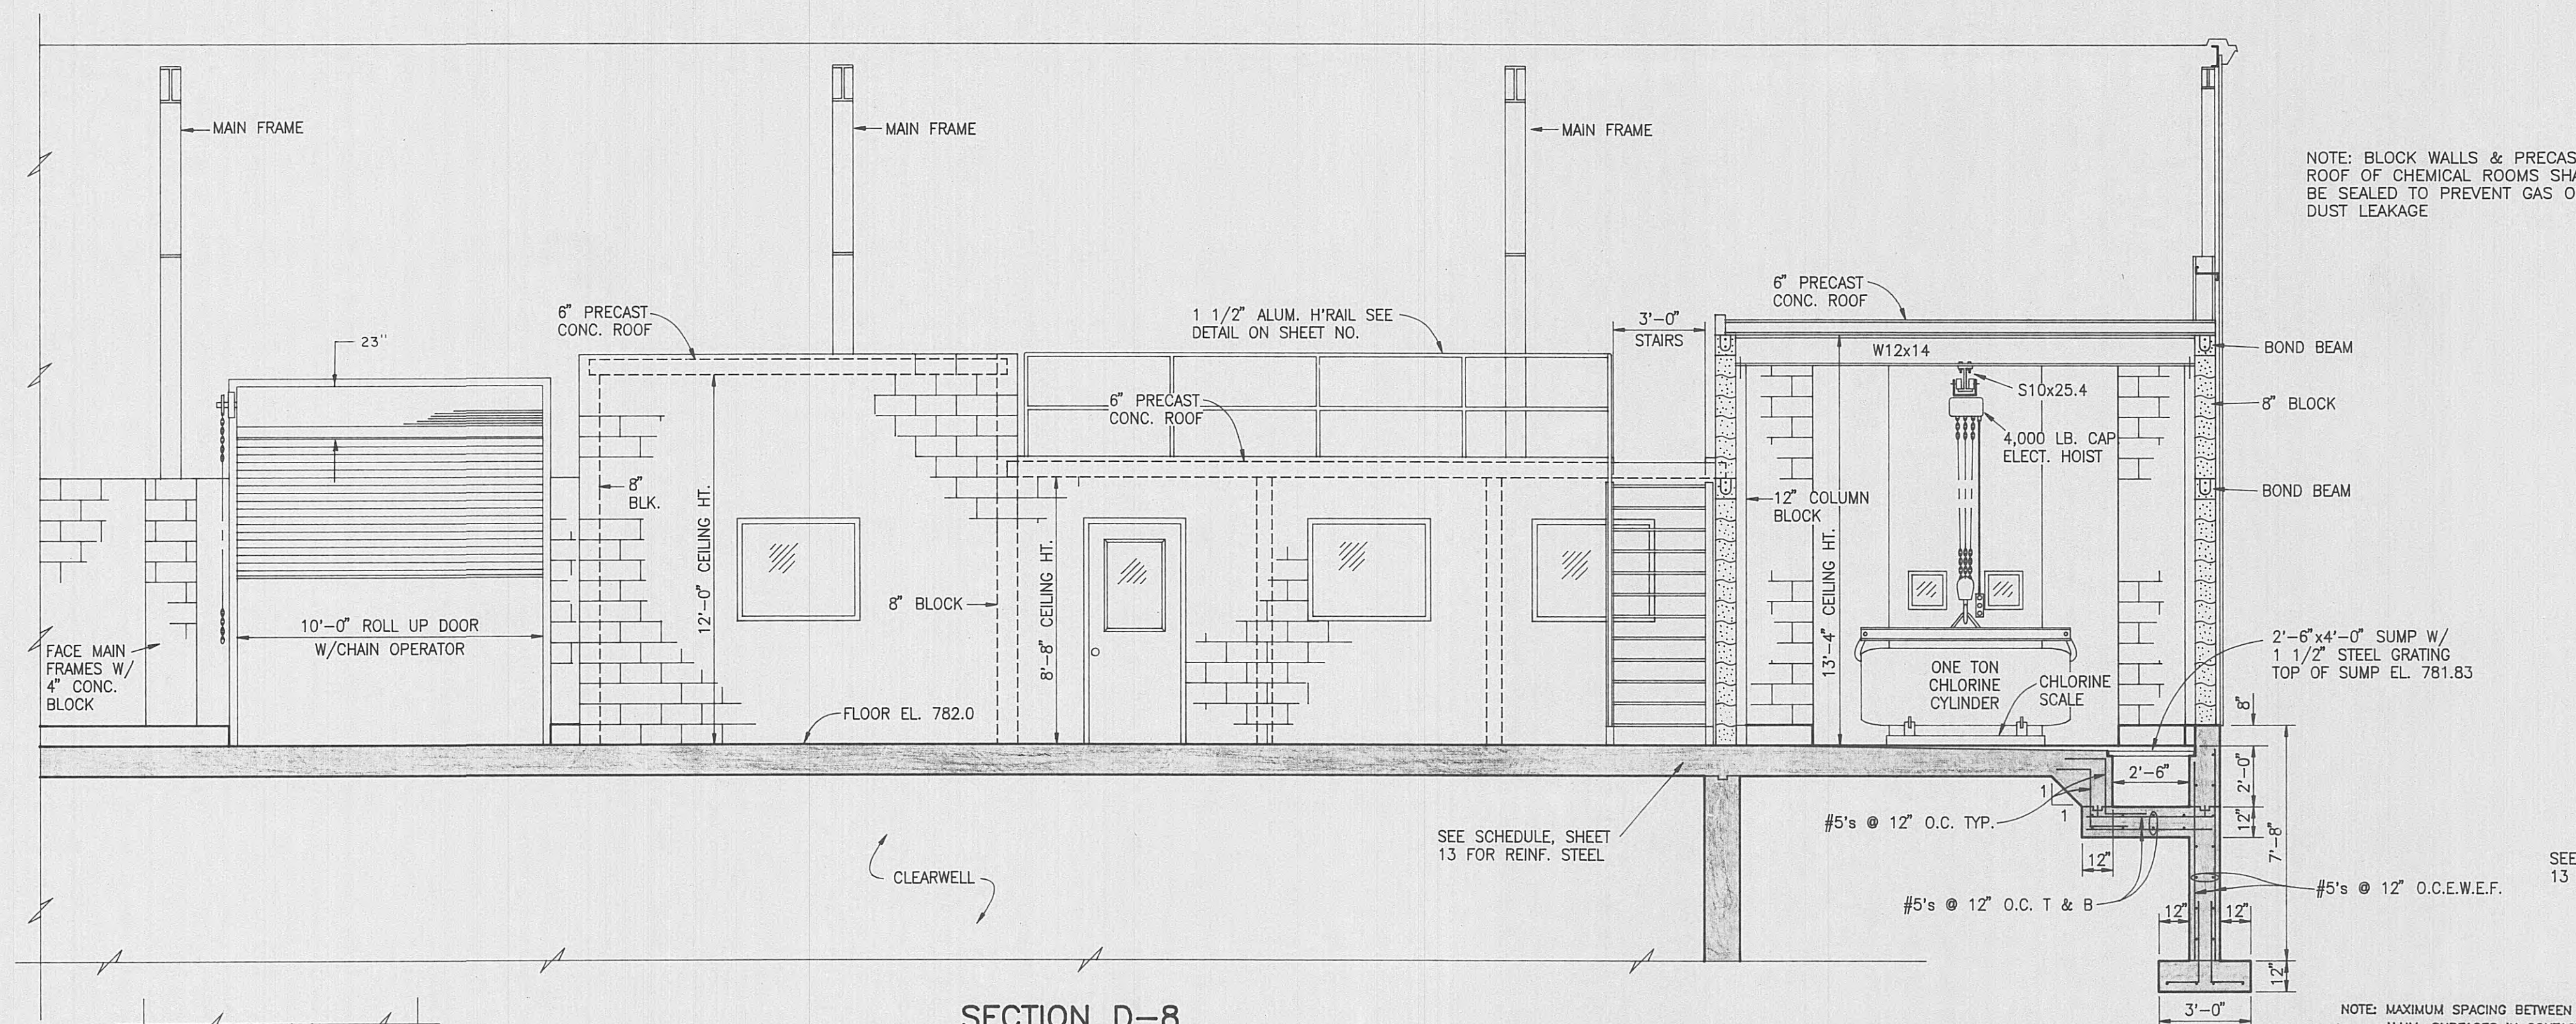


SECTION D-8  
SCALE: 1/4" = 1'-0"

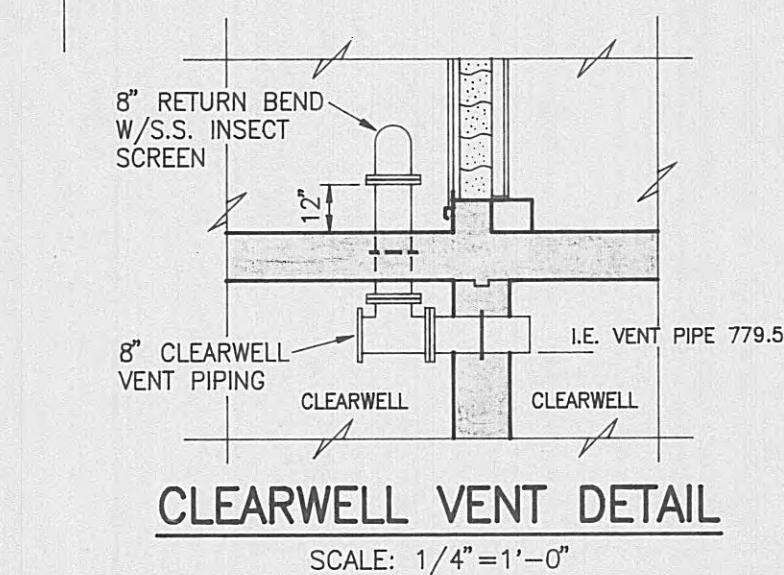


CLEARWELL VENT DETAIL  
SCALE: 1/4" = 1'-0"

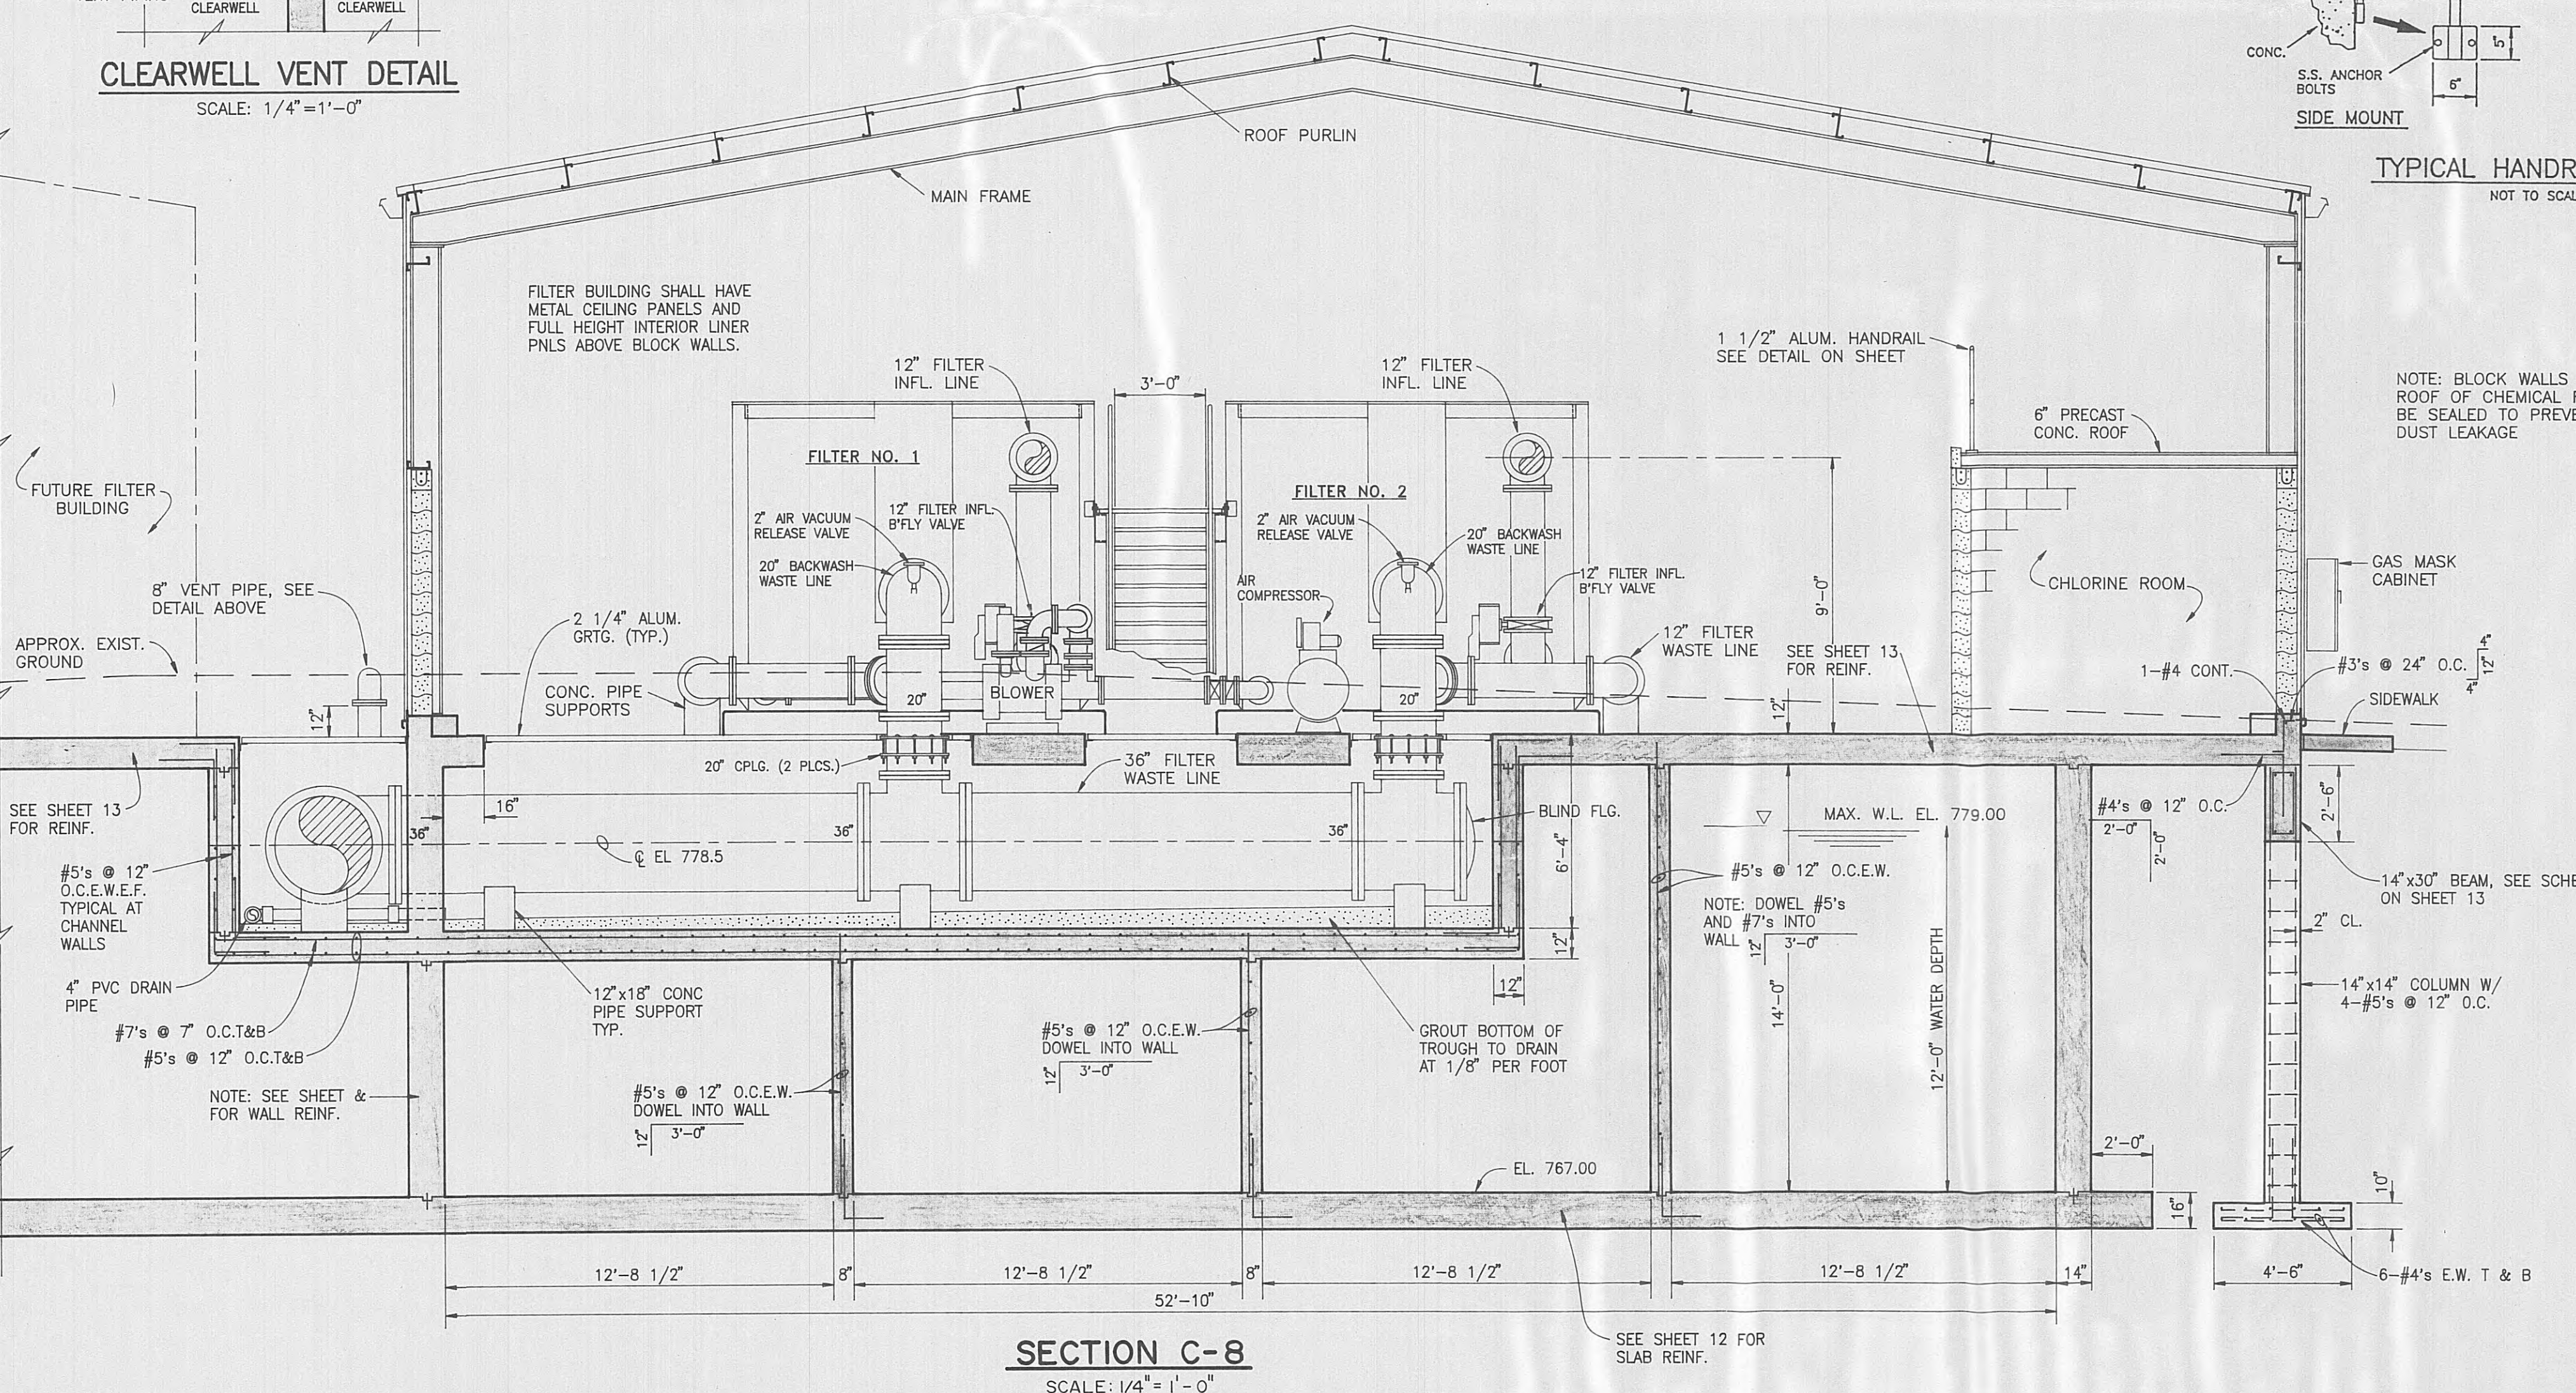


SECTION C-8  
SCALE: 1/4" = 1'-0"

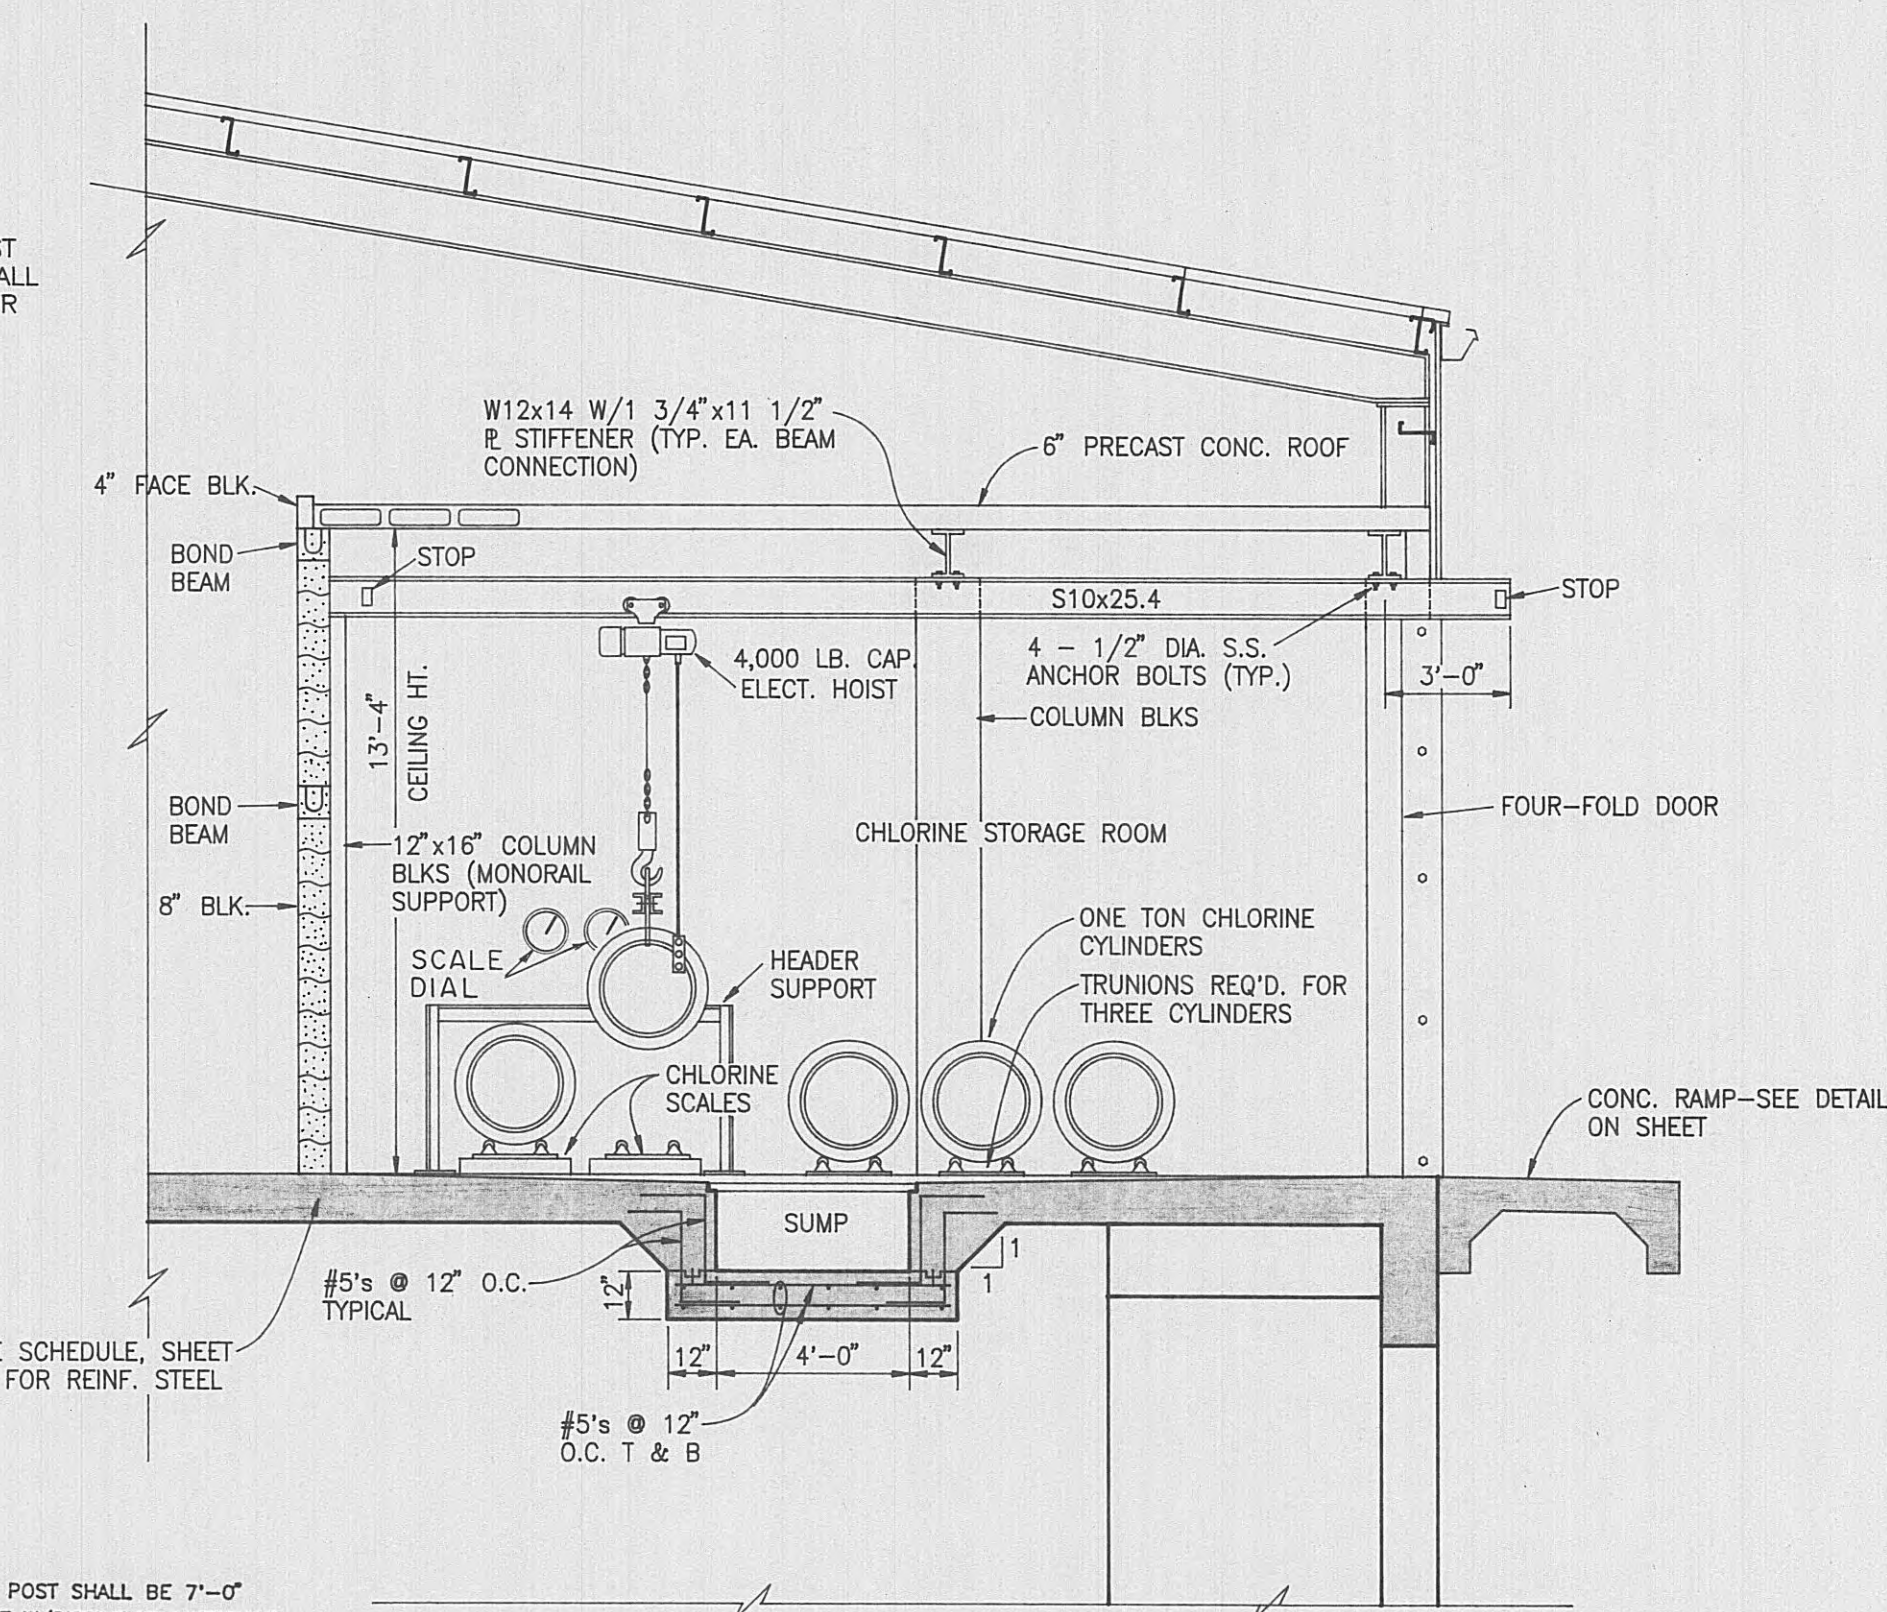

SECTION E-8  
SCALE: 1/4" = 1'-0"

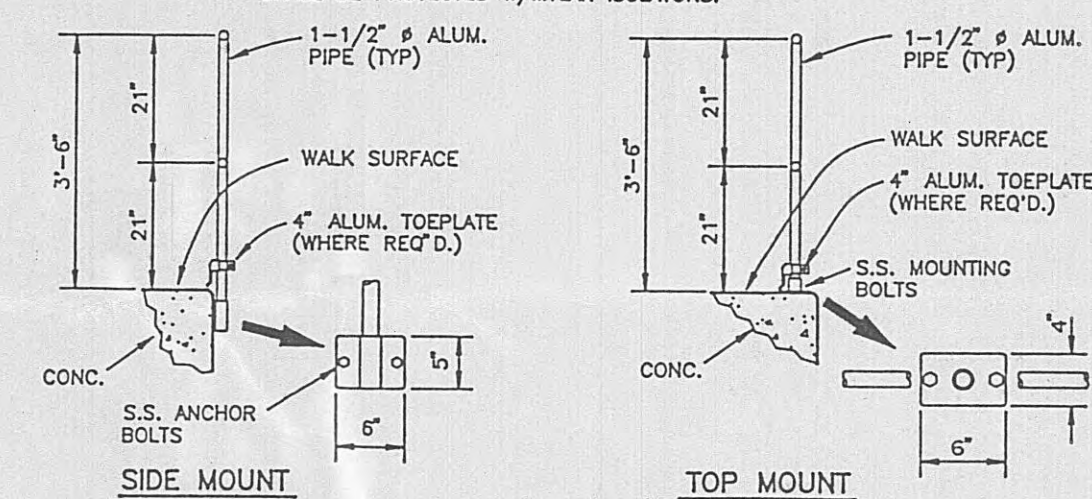

TYPICAL HANDRAIL DETAIL  
NOT TO SCALE

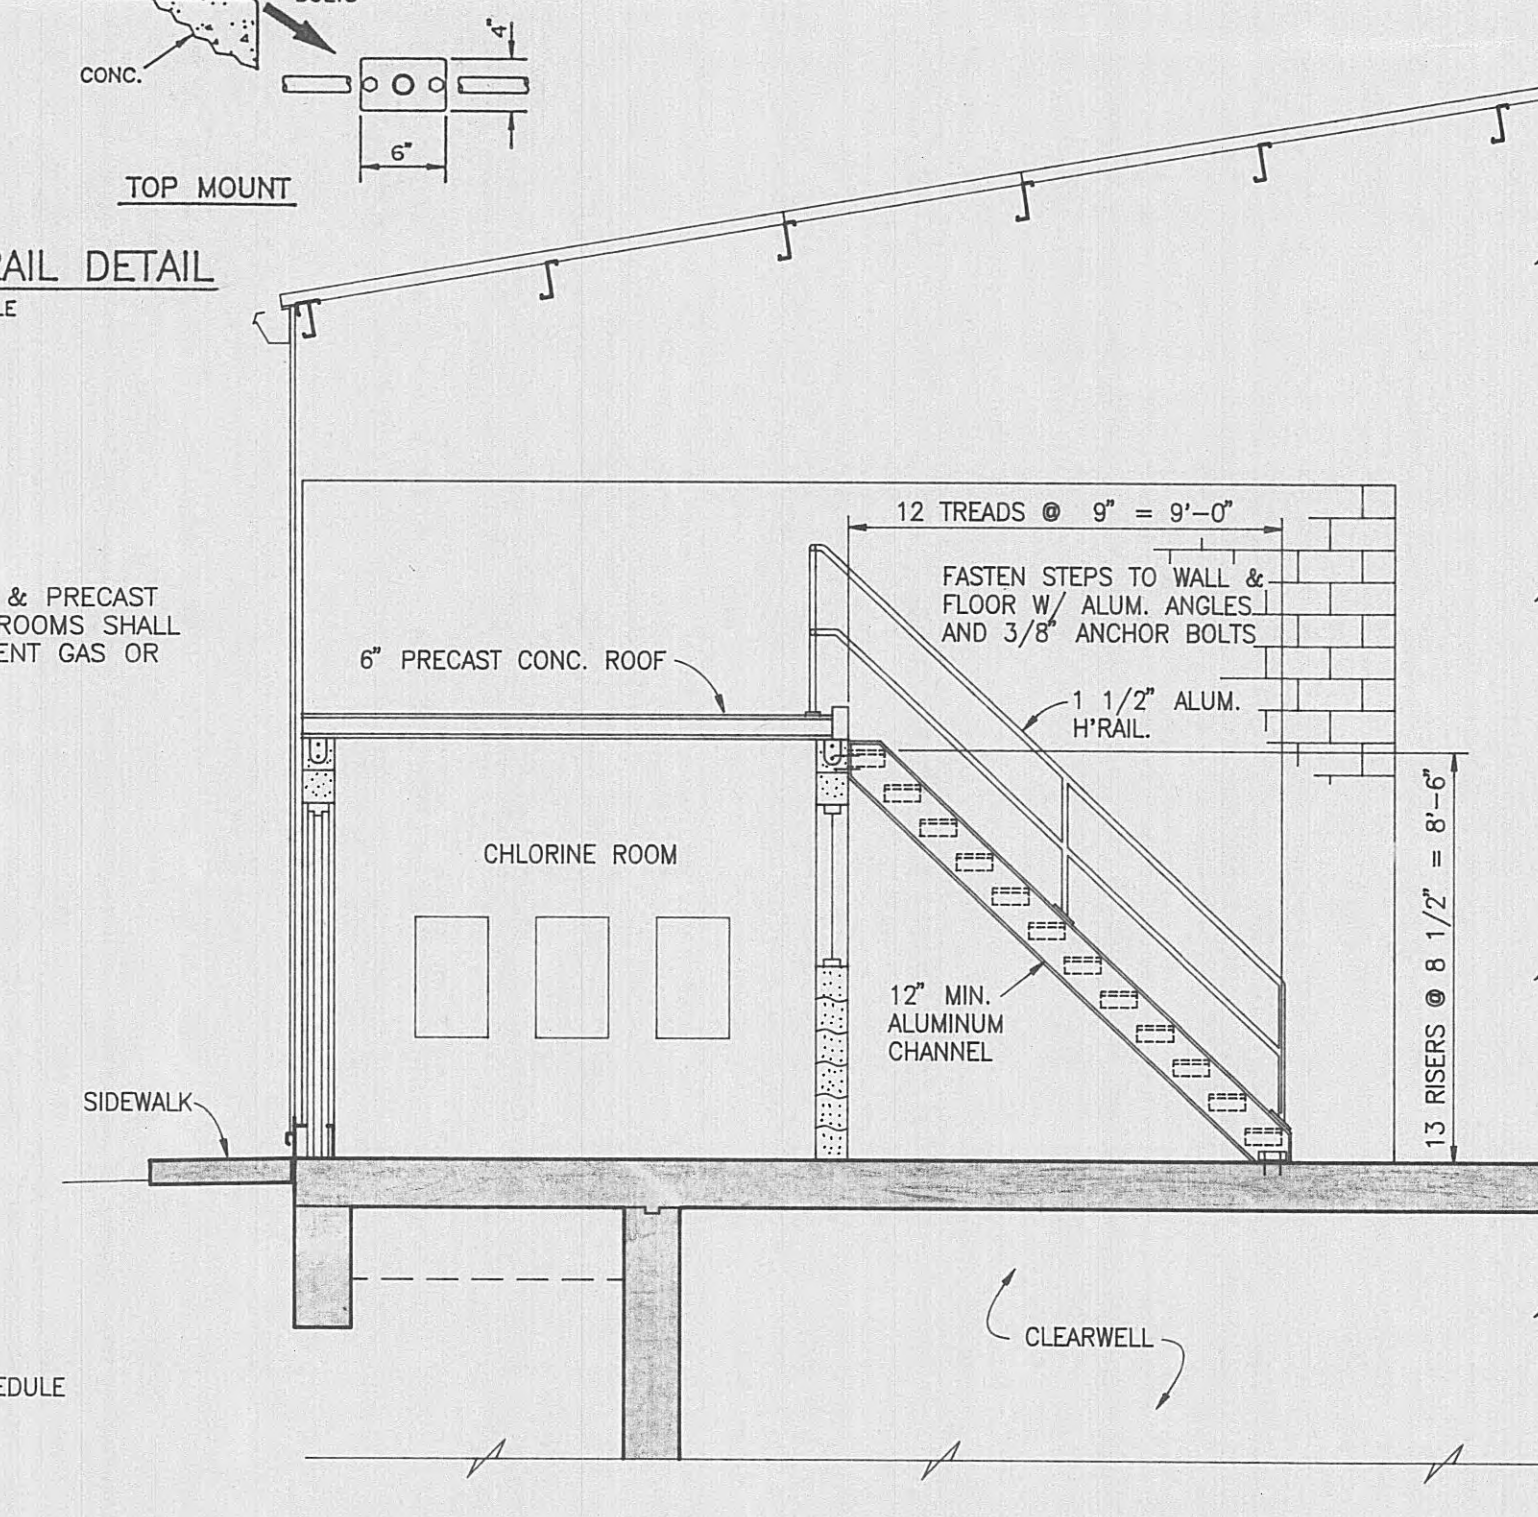

STAIR DETAIL  
SCALE: 1/4" = 1'-0"

AS BUILT  
DATE: 3-20-95  
APPROVED: D.M.

