


VALVE INDEX

VALVE NO.	FUNCTION	LOCATION
1	Aeration Drain	Treatment Unit #1
2	Clarifier Drain	Treatment Unit #1
3	Digester Drain	Treatment Unit #1
4	Digester Drain	Treatment Unit #2
5	Clarifier Drain	Treatment Unit #2
6	Aeration Drain	Treatment Unit #2
7	Sludge Return	Manhole #3

GATE NO.	FUNCTION	LOCATION
A	Comminutor Bypass	Comminutor Chamber
B	Comminutor Bypass	Comminutor Chamber
C	Flow to Treatment Unit #1	Comminutor Chamber
D	Flow to Treatment Unit #2	Comminutor Chamber

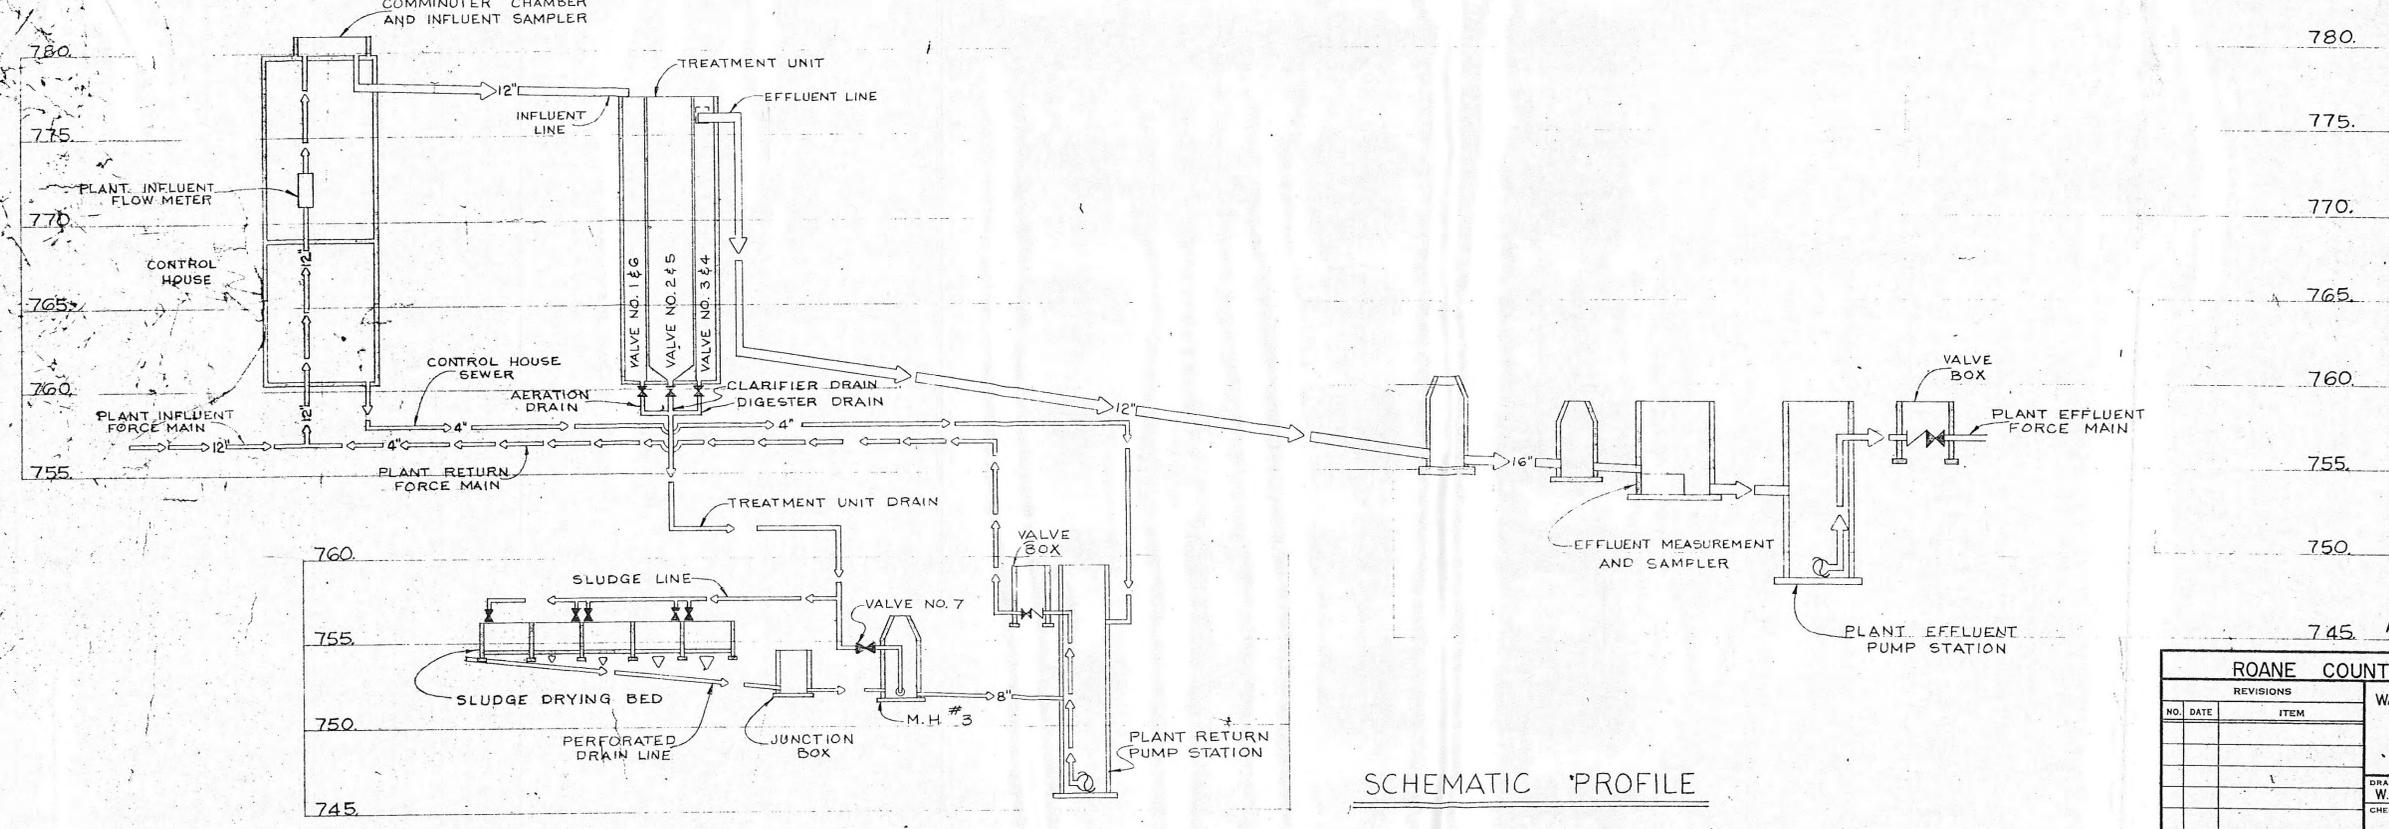


SCHEMATIC PROFILE

APPENDIX B





ROANE COUNTY INDUSTRIAL PARK		WASTEWATER TREATMENT FACILITIES		PLANT FLOW DIAGRAM AND VALVE INDEX
REVISIONS		DRAWN BY W. W. C.		
NO.	DATE	ITEM	DATE	FILE NO. 4077-01
			DEC, 1973	
CHECKED BY			FIELD DATA	DRAWN NO.
BARGE WAGGONER SUMNER & CANNON				
NASHVILLE		TENNESSEE		MORRISTOWN

TRIM ON THIS LINE FOR SEPARATE SHEETS.

TRIM ON THIS LINE FOR SEPARATE SHEETS

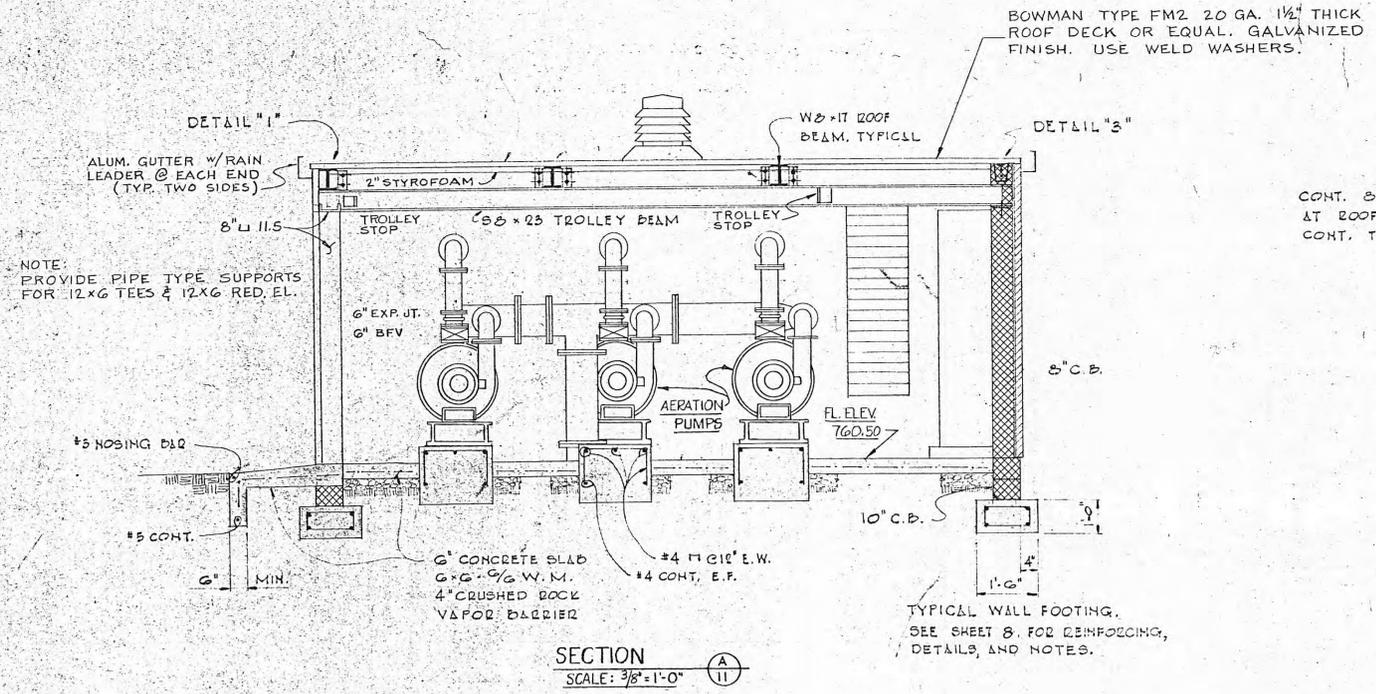

- NOTE
1. All pipes above floor shown as Std. cast iron pipe and fittings. Contractor may elect to use steel pipe as specified in Section 5, "Plant and Yard Piping, Paragraph 5.07, "Steel Air Pipe," of the specifications. All underground air pipe shall be cast iron.
 2. Galvanized roof deck and all siding shall be insulated from the alum. siding.

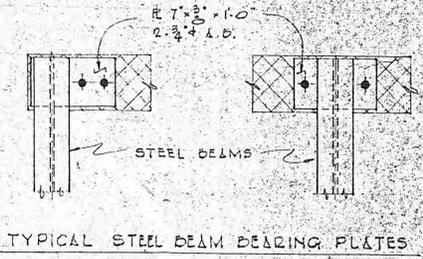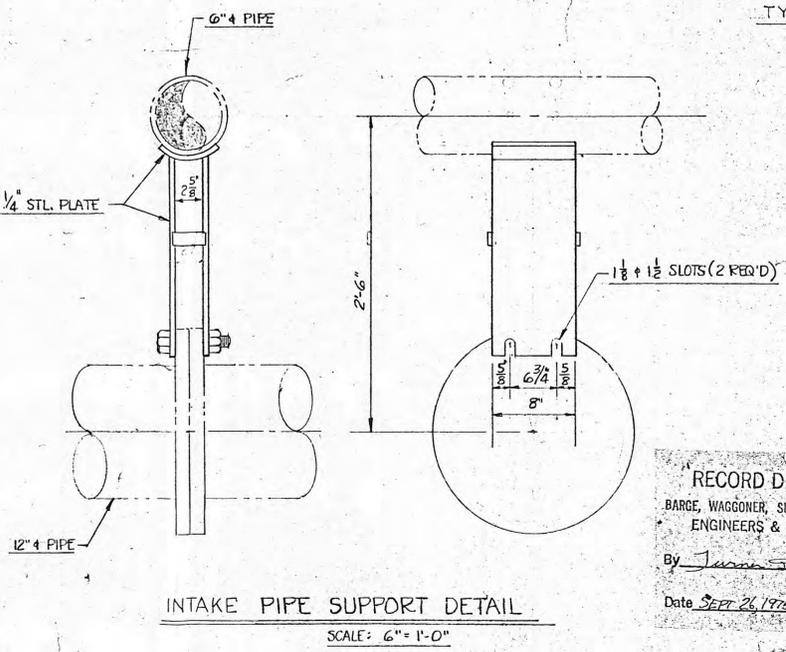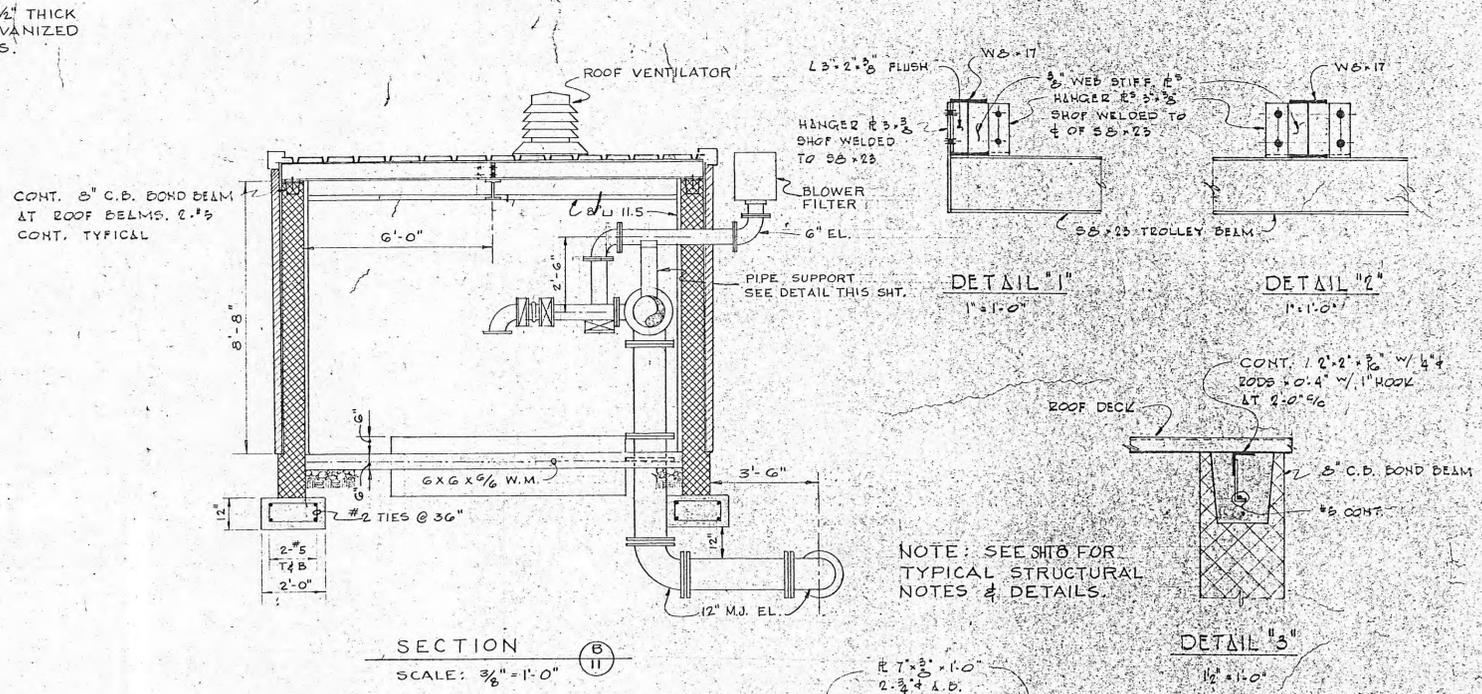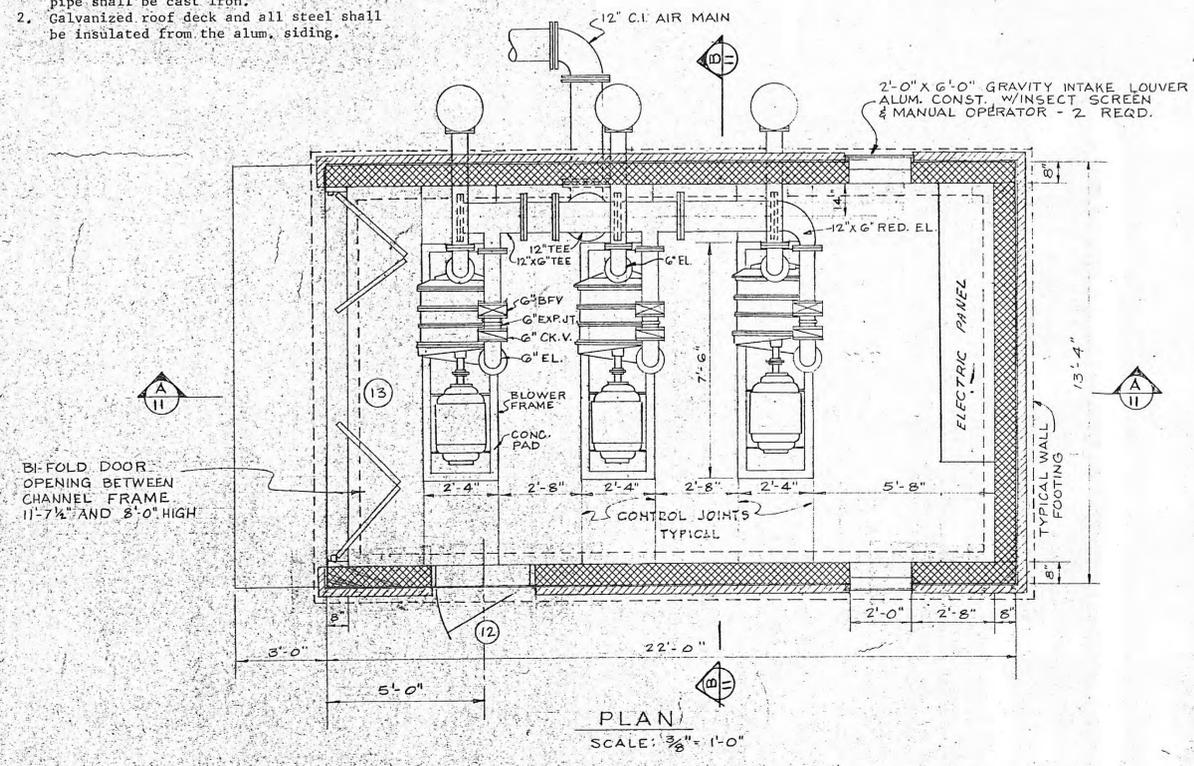


SPECIFICATIONS FOR BI-FOLD DOOR
 Door shall be constructed of 1 3/4" x 1 1/2" rectangular steel tubing as the basic frame. All corner joints shall be mitered, reinforced, welded and welds ground smooth. All intermediate stiffeners shall be on maximum 48" centers and all horizontal stiffeners shall occur at appropriate hinge locations. Cold roll sheet steel 14 gauge, shall be spot welded to both sides of the frame. All welds shall be ground smooth and filled. All exposed surfaces shall be given one coat of rust-inhibiting primer at the factory. Hardware shall consist of heavy-duty box track recessed in floor, sufficient track brackets, heavy-duty ball bearing hangers, ball bearing strap hinges, case bolts for bottom of door, spring loaded chain bolts for top of door and hand pulls. All hardware shall be primed with a rust-inhibitive paint at the factory.

RECORD DRAWING
 BARGE, WAGGONER, SUMNER & CANNON
 ENGINEERS & PLANNERS
 By *J. Sumner Cannon*
 Date *SEPT 26 1975* File # *4077-01*



REVISIONS		ROANE COUNTY INDUSTRIAL PARK	
NO.	DATE	ITEM	


WASTEWATER TREATMENT FACILITIES		
BLOWER BUILDING		
DRAWN BY W.W.C.	DATE DEC. 1973	FILE NO. 4077-01
CHECKED BY W.H.O.	FIELD DATA	DRAWG. NO.
BARGE WAGGONER SUMNER & CANNON ENGINEERS - PLANNERS		SHEET 11
NASHVILLE	TENNESSEE	MORRISTOWN

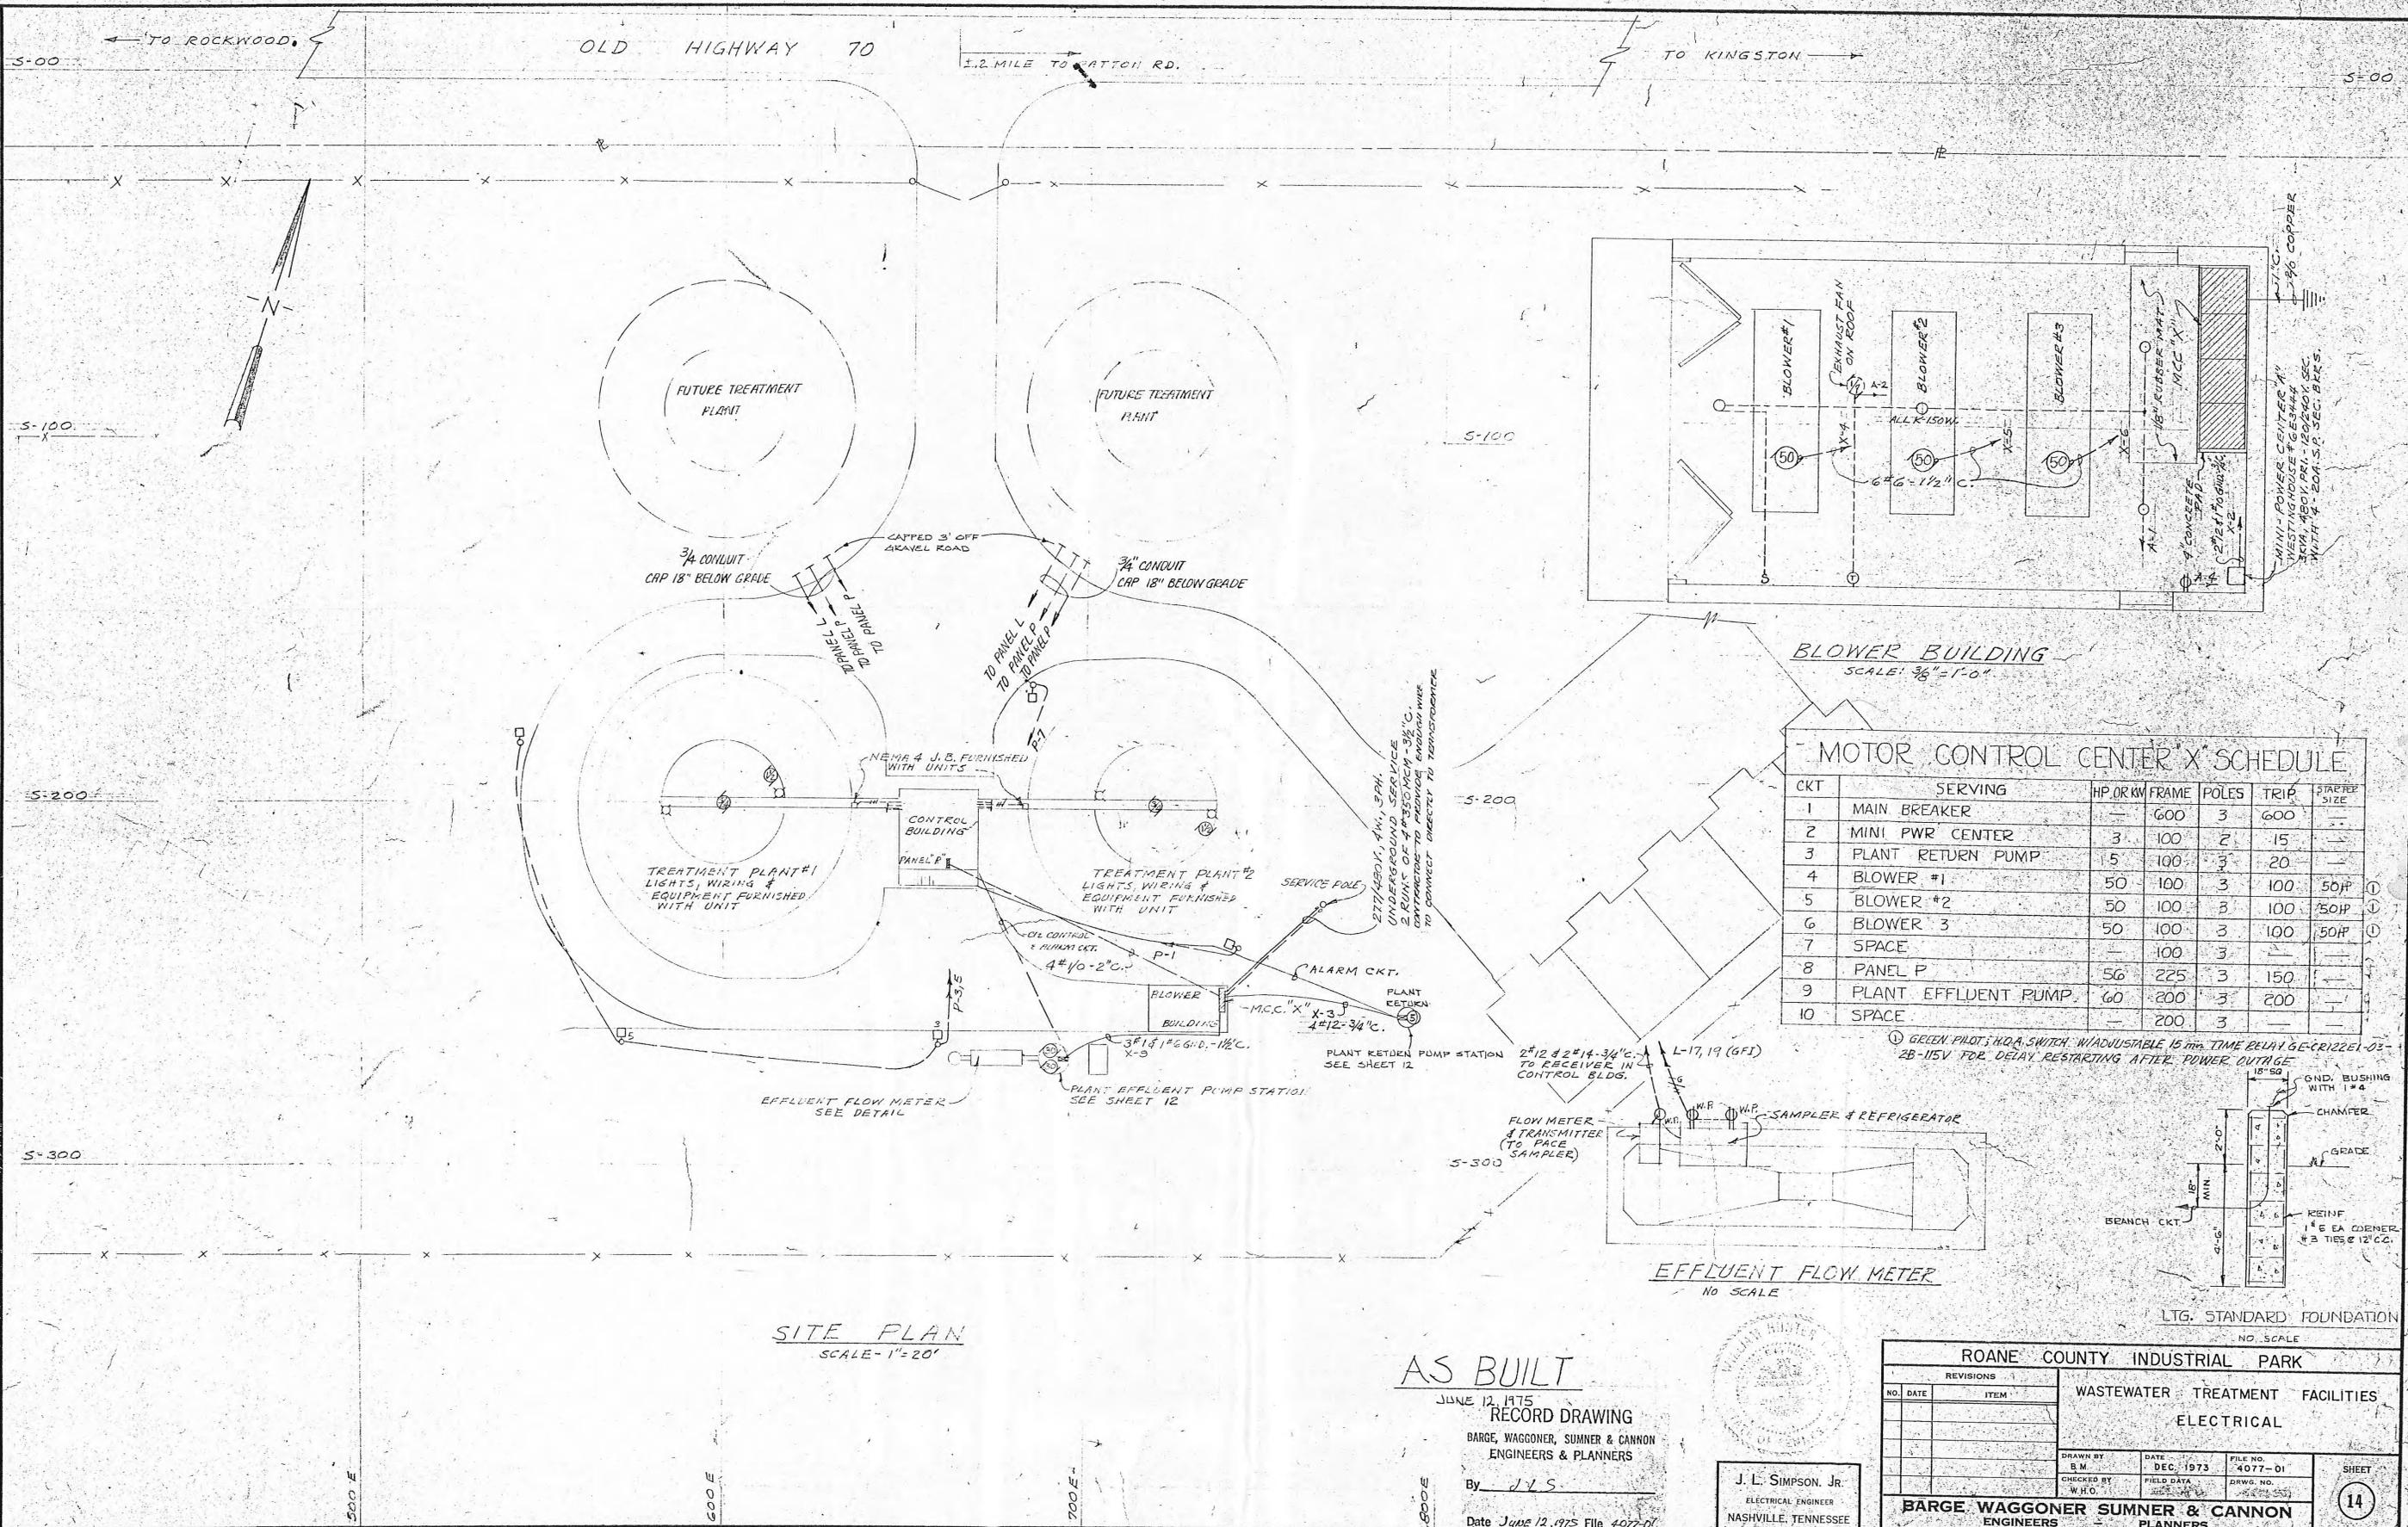

MOTOR CONTROL CENTER X SCHEDULE

CKT	SERVING	HP OR KW	FRAME	POLES	TRIP	STARTER SIZE
1	MAIN BREAKER	—	600	3	600	—
2	MINI PWR CENTER	3	100	2	15	—
3	PLANT RETURN PUMP	5	100	3	20	—
4	BLOWER #1	50	100	3	100	50HP
5	BLOWER #2	50	100	3	100	50HP
6	BLOWER #3	50	100	3	100	50HP
7	SPACE	—	100	3	—	—
8	PANEL P	56	225	3	150	—
9	PLANT EFFLUENT PUMP	60	200	3	200	—
10	SPACE	—	200	3	—	—

① GREEN PILOT: H.O.A. SWITCH: W/ADJUSTABLE 15 MIN. TIME DELAY GE-CR22E1-03-2B-115V FOR DELAY RESTARTING AFTER POWER OUTAGE

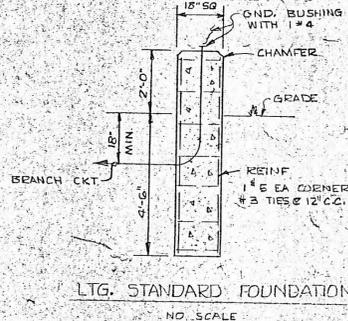


SITE PLAN
SCALE - 1" = 20'

EFFLUENT FLOW METER
NO SCALE

AS BUILT

JUNE 12, 1975
RECORD DRAWING
BARGE, WAGGONER, SUMNER & CANNON
ENGINEERS & PLANNERS

By *J.L.S.*
Date JUNE 12, 1975 File 4077-01

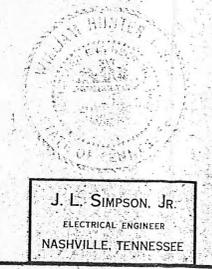

ROANE COUNTY INDUSTRIAL PARK

WASTEWATER TREATMENT FACILITIES ELECTRICAL

REVISIONS		DATE	FILE NO.
NO.	DATE		


DRAWN BY *S.M.* DATE DEC. 1973 FILE NO. 4077-01
 CHECKED BY *W.H.O.* FIELD DATA DRAWN AND CHECKED BY *S.M.*

BARGE WAGGONER SUMNER & CANNON
ENGINEERS PLANNERS
NASHVILLE TENNESSEE MORRISTOWN


SHEET **14** OF 15 SHEETS

TRIM ON THIS LINE FOR SEPARATE SHEETS


TRIM ON THIS LINE FOR SEPARATE SHEETS

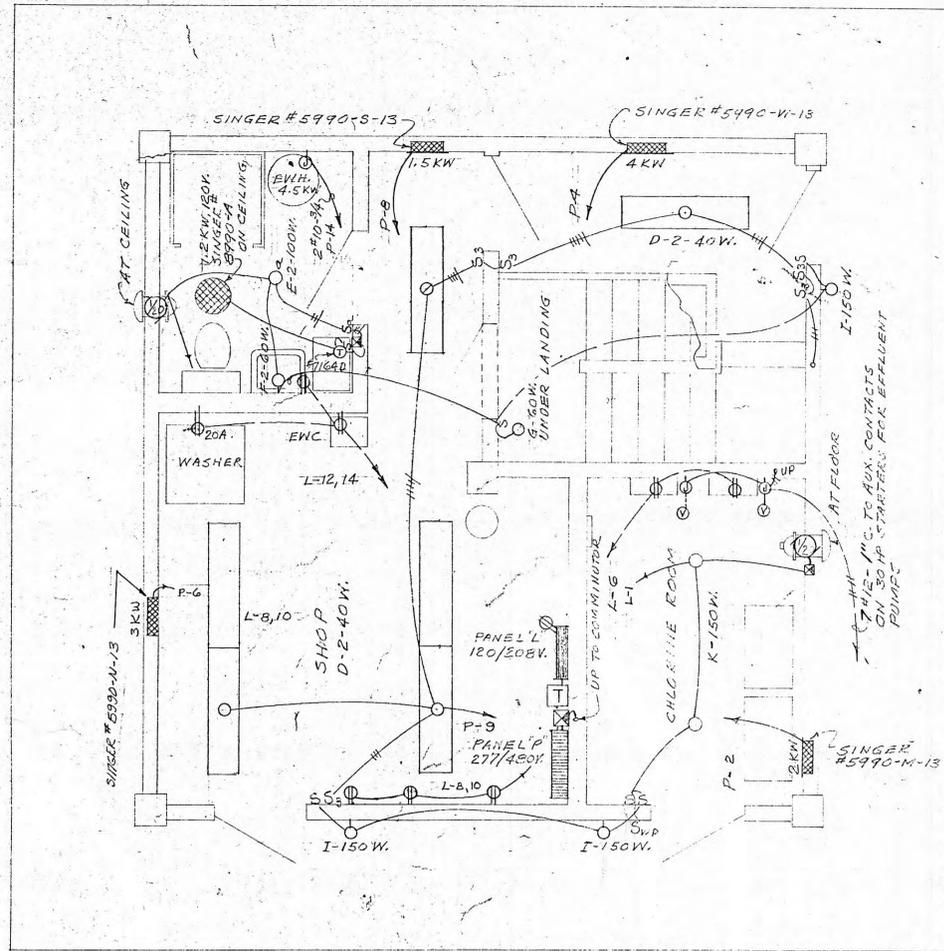

FIRST FLOOR PLAN
SCALE: 3/8"=1'-0"

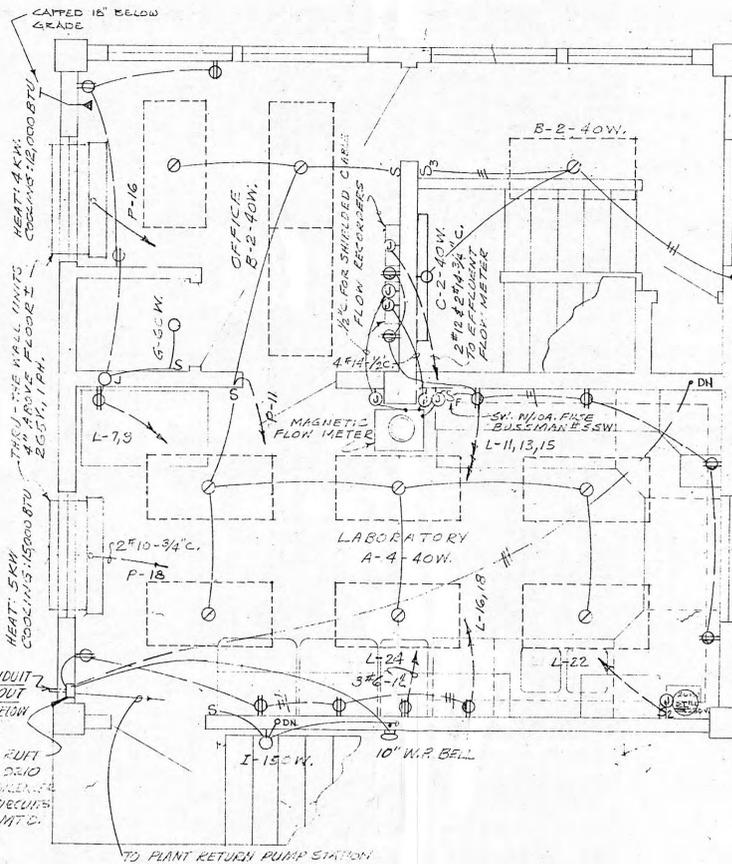


SECOND FLOOR PLAN
SCALE: 3/8"=1'-0"

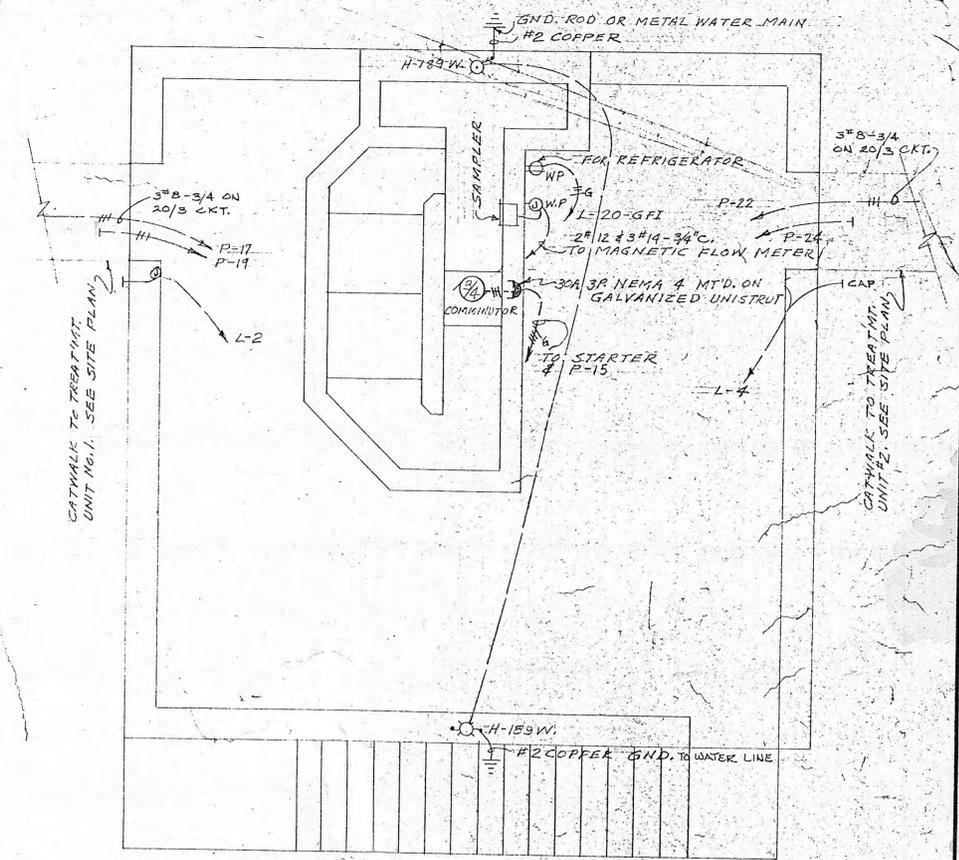

ROOF PLAN
SCALE: 3/8"=1'-0"

LIGHTING FIXTURE SCHEDULE			
TYPE	DESCRIPTION	LAMP	MOUNTING
A	2'x4', 40W. TROFFER WITH FRAMED ACRYLIC LENS DAYBRITE #2642-657-42TV	4 F40 CW	RECESSED IN GRID TYPE CEILING
B	2'x4', 2/40W. TROFFER WITH FRAMED ACRYLIC LENS DAYBRITE #4622-657-4-2TV	2 F40 CW	RECESSED IN GRID TYPE CEILING
C	2/40W. BRACKET UNIT WITH UP & DOWN LIGHT PRESCOLITE #3230-27TV	2 F40 CW	WALL 7'-6" ABOVE STAIR WALKWAYS
D	2/40W. ACRYLIC PLASTIC WEAIRROUND UNIT DAYBRITE #14W128-27TV OR METALUX #CC-240A-27TV	2 F40 CW	CEILING
E	INCANDESCENT DEWM UNIT LET METAL "LENS/DEW" #3353-5L	2-100W	CEILING
F	LABORATORY BRACKET UNIT AET METAL "WALLENS" #3543 PC	2-60W	BRACKET OVER MIRROR
G	KEYLESS PORCELAIN RECEPTACLE WITH WIRE LAMP GUARD BRANT #5228 #400L #433 POSTOP LIGHTING STANDARDS WITH 8' ALUMINUM PANE HOLLOWPINE #06343 POSTOP. (EERIGRAH #732001-99 WITH GROUND WLG FOR #2 COPPER GROUND WIRE)	60W	MOUNT ON PROJECT WALL WITH 15" ANCHOR BOLTS IN CONCRETE
H	WEATHERPROOF BRACKET UNIT HOLLOWPINE #400	150W	BRACKET ON WALL
I	WEATHERPROOF BRACKET UNIT HOLLOWPINE #400	150W	BRACKET ON WALL
J	KEYLESS THIRD LIGHTING STANDARDS 27TV #1L3395 AND #1L2590 PHOTOCENTERILL ASSEMBLY AND ONE 30" ALUMINUM RAIL WITH ONE #14225 MOUNTING BRACKET AND ONE #1L3323 A SUP FITTER	400W, MERCURY #H33-16-1DX	CONCRETE BASE SEE DETAIL ON PLAN
K	KLM DOME REFLECTOR UNIT MILLER #AE-30H	150W	OUTLET BOX

ELECTRICAL LEGEND	
SYMBOL	DESCRIPTION
○	CEILING OUTLET FOR LIGHTING FIXTURE
⊕	OUTLET FOR BRACKET LIGHT
⊙	OUTLET FOR RECESSED LIGHTING FIXTURE
⊕	UNION BOX
⊕	DUPLEX RECEPTACLE, 14" UP, 15A UNLESS NOTED
⊕	NAME, 48" U
⊕	20A, 208V. RECEPTACLE, 7" UP FOR STILL
⊕	20A, 208V. RECEPT. OLE FOR 20A, 14 1/2"
⊕	THERMOSTAT, 5'-6" UP
S	SINGLE POLE SWITCH
S ₃	THREE WAY SWITCH
S _{WP}	WEATHERPROOF 5-P SWITCH
⊕	ELECTRIC SPARE METER
⊕	277/480V, 4W, 3 PHASE PANELBOARD
⊕	120/208V, 4W, 3 PHASE W/NEUTRAL
⊕	TRANSFORMER
⊕	MOTOR, HOLLOWPINE INDICATED
⊕	MOTOR CONTROLLER
⊕	MOUNTED MOTOR STARTER
⊕	BRANCH CIRCUIT EXPOSED
⊕	BRANCH CIRCUIT CONCEALED UNDER FLOOR
⊕	BRANCH CIRCUIT CONCEALED IN CEILING
⊕	LIGHTING STANDARDS 4-400W
⊕	SOLENOID VALVE
⊕	OUTLET FOR TELEPHONE, 14" UP

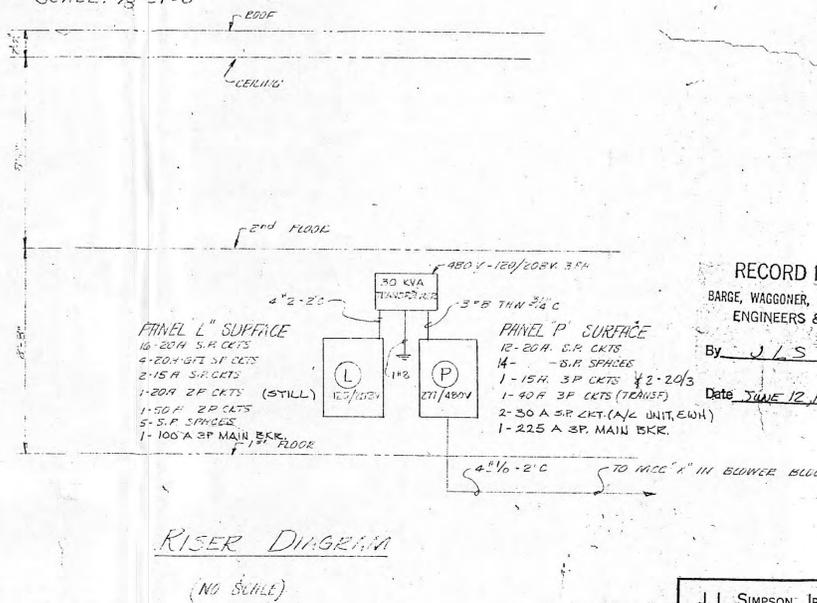

RISER DIAGRAM
(NO SCALE)

RECORD DRAWING
BARGE, WAGGONER, SUMNER & CANNON
ENGINEERS & PLANNERS
By JLS
Date: JUNE 12, 1975
File: 4077-01

ROANE COUNTY INDUSTRIAL PARK
WASTEWATER TREATMENT FACILITIES
ELECTRICAL

AS BUILT
JUNE 12, 1975



J. L. SIMPSON, JR.
ELECTRICAL ENGINEER
NASHVILLE, TENNESSEE

BARGE WAGGONER SUMNER & CANNON
ENGINEERS & PLANNERS
NASHVILLE TENNESSEE MORRISTOWN

REVISIONS	
NO.	DATE

DRAWN BY B. M.	DATE DEC. 1973	FILE NO. 4077-01
CHECKED BY C. W. O.	FIELD DATA	DRWG. NO.

SHEET 15 OF 15 SHEETS

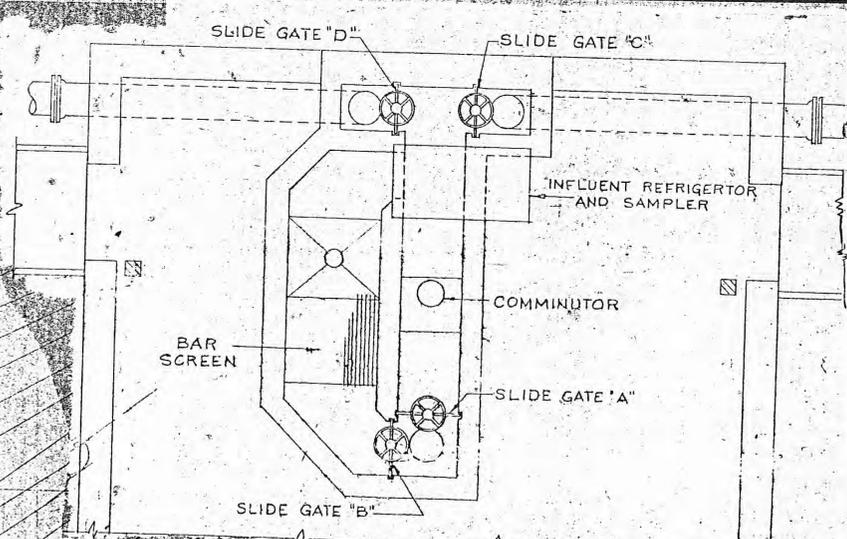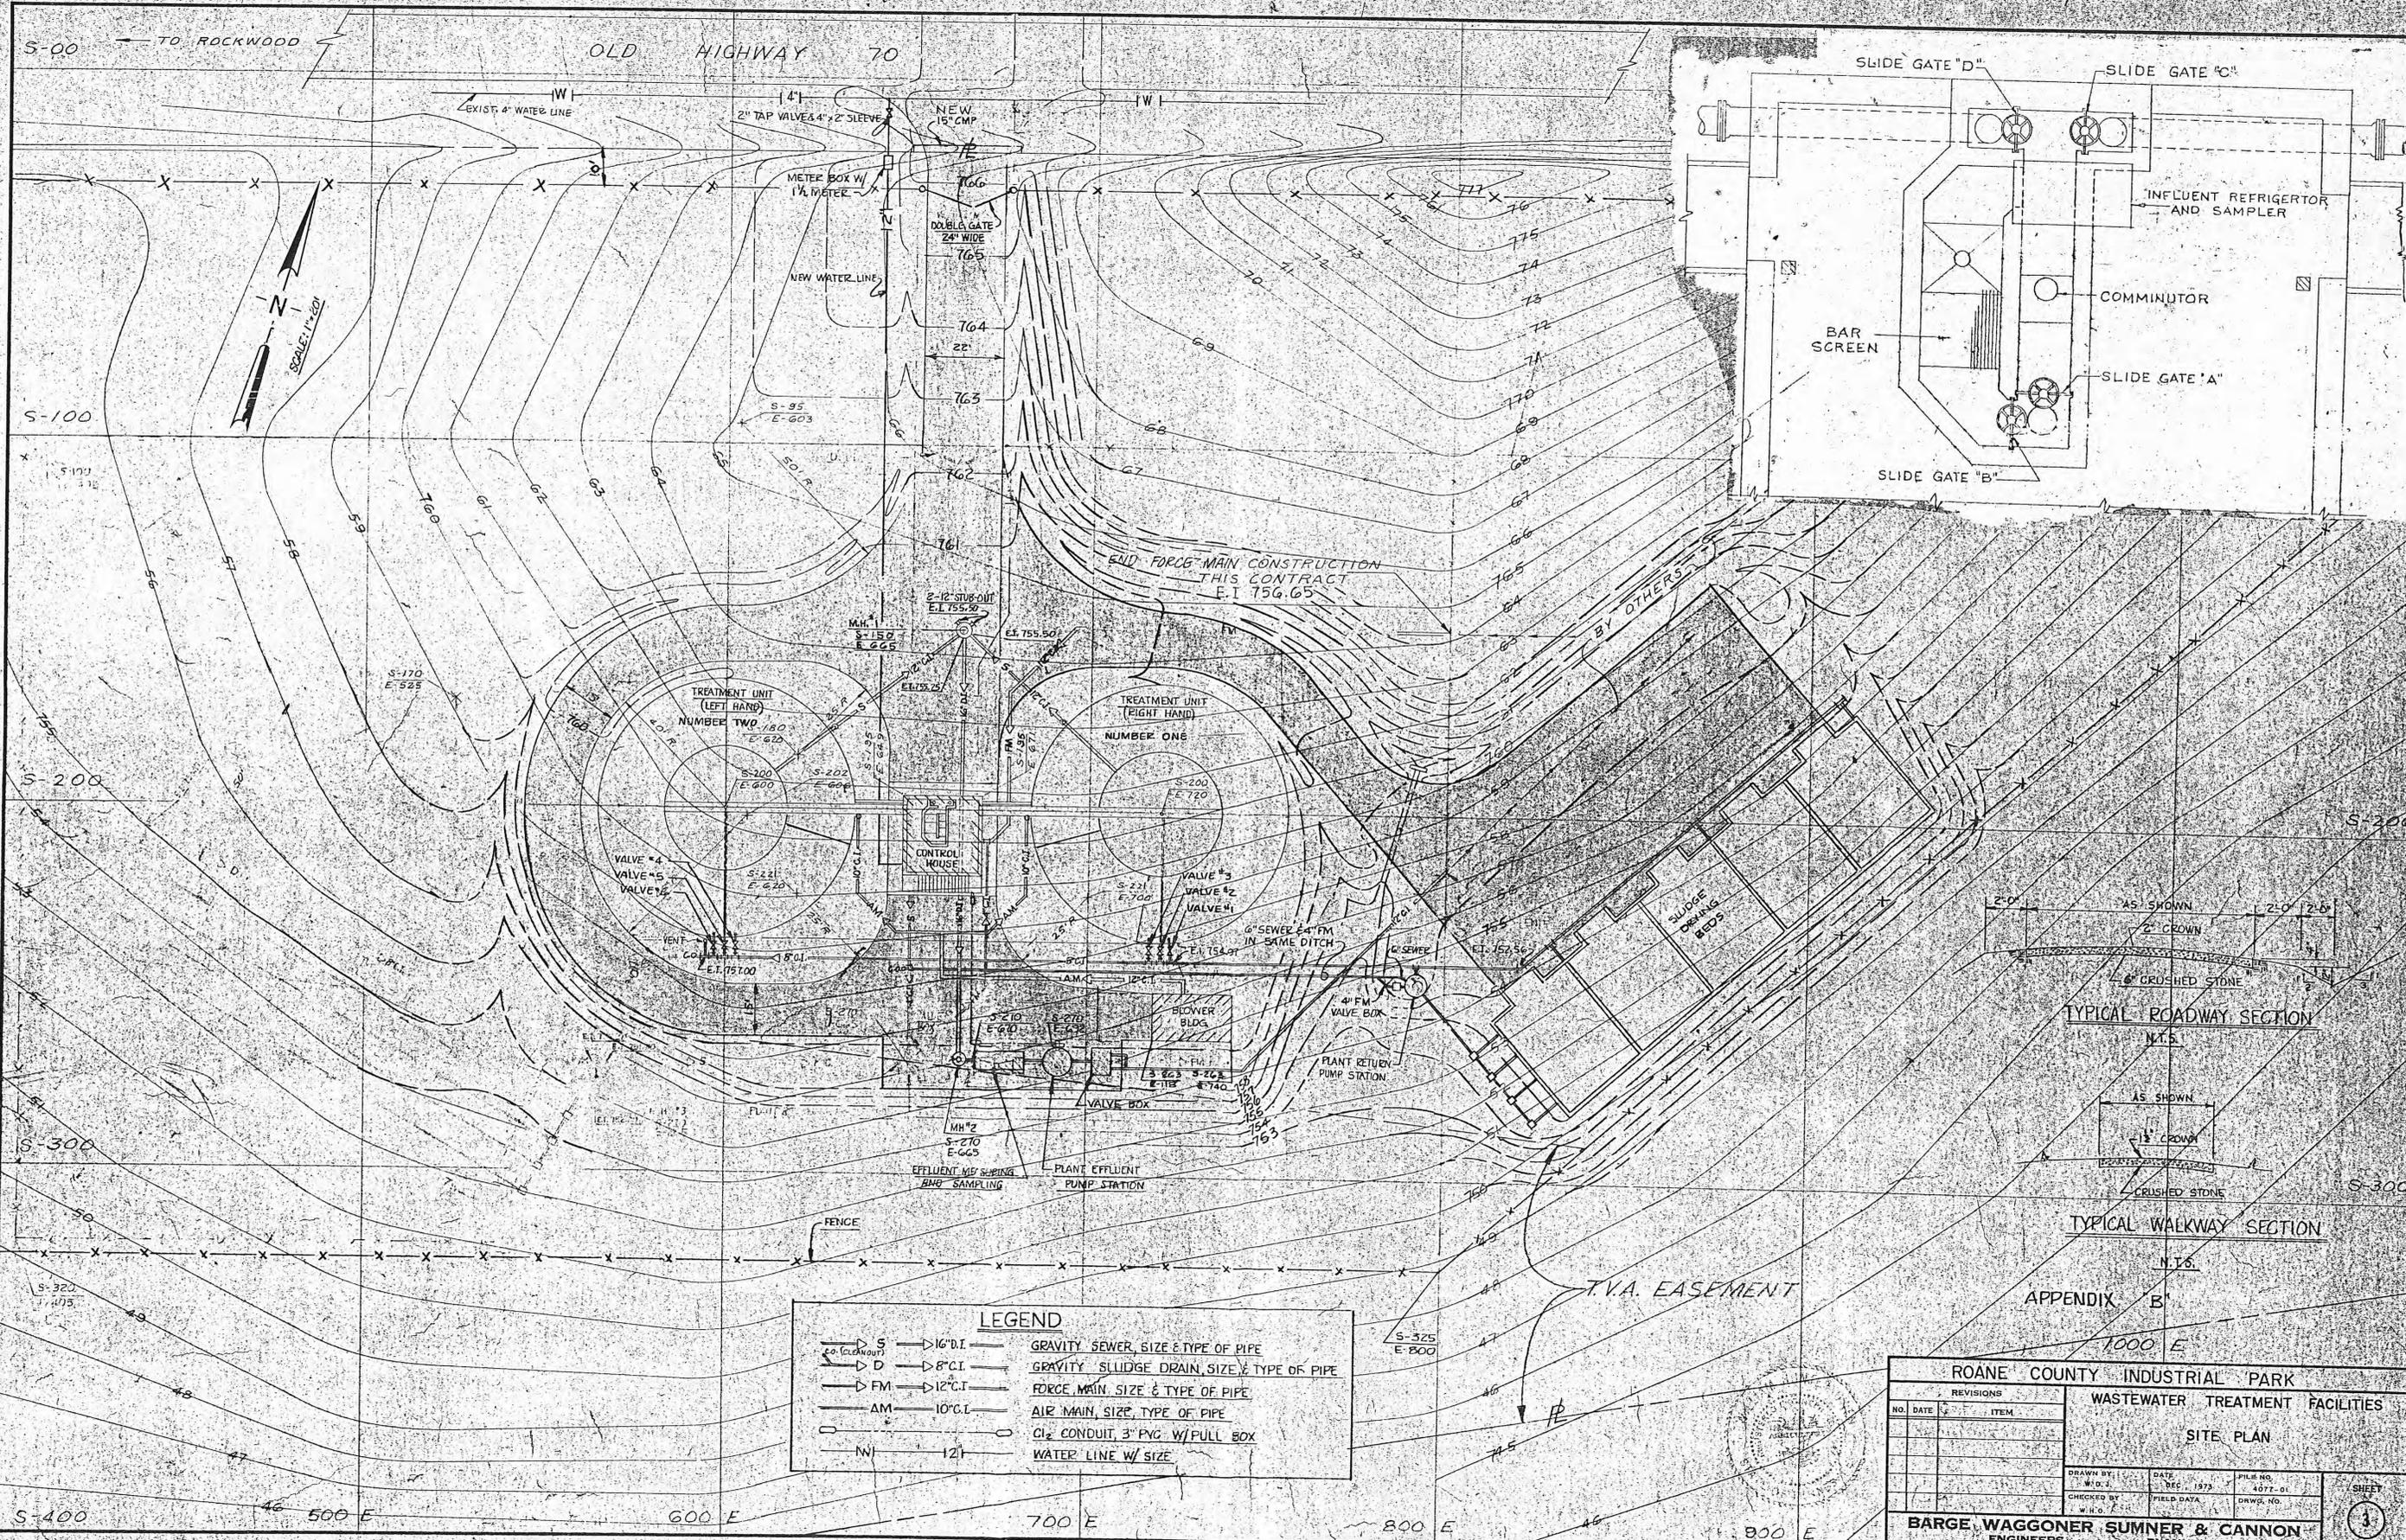

APPENDIX B
1000 E

LEGEND

S	16" D.I.	GRAVITY SEWER, SIZE & TYPE OF PIPE
D	8" C.I.	GRAVITY SLUDGE DRAIN, SIZE & TYPE OF PIPE
FM	12" C.I.	FORCE MAIN, SIZE & TYPE OF PIPE
AM	10" C.I.	AIR MAIN, SIZE & TYPE OF PIPE
CL	3" P.V.C.	CL ₂ CONDUIT, 3" P.V.C. W/PULL BOX
W	12"	WATER LINE W/ SIZE

ROANE COUNTY INDUSTRIAL PARK
WASTEWATER TREATMENT FACILITIES
SITE PLAN

REVISIONS		NO.	DATE	ITEM

DRAWN BY: W.D.S. DATE: FEB 1977 FILE NO. 4077-01
 CHECKED BY: FIELD DATA DRAWN BY: W.H.O.
BARGE, WAGGONER, SUMNER & CANNON
 ENGINEERS PLANNERS
 NASHVILLE, TENNESSEE MORRISTOWN

SHEET 3 OF 15 SHEETS

ROANE COUNTY INDUSTRIAL PARK

J. FRANK QUALLS, COUNTY JUDGE

INDUSTRIAL DEVELOPMENT BOARD OF THE COUNTY OF ROANE, TENNESSEE

ROBERT R. ELLIS, CHAIRMAN

GEORGE HOLLSTEIN, V-CHM.

DALE R. BORING, SEC.-TR.

DONALD G. BURNEY

WILLIAM A. BURROWS

ALBERT J. COOK

WALTER A. REED


RUSSELL E. SIMMONS

J. C. PARKER

MAURICE K. WILLIAMS

KENNETH C. YORK, COMMISSIONER

WASTEWATER TREATMENT FACILITIES
E P A PROJECT NO. C 470276 (ARC)

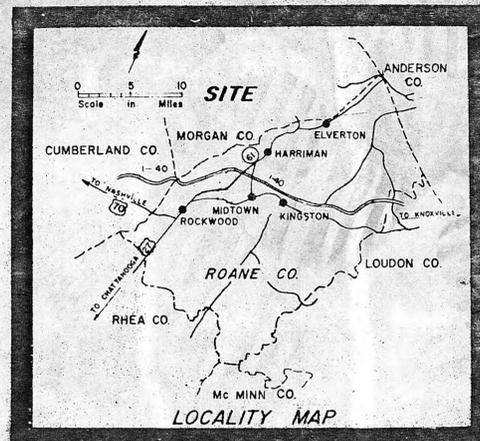

CONTRACT D

SET NO. _____



BARGE, WAGGONER, SUMNER AND CANNON
ENGINEERS PLANNERS
NASHVILLE KNOXVILLE MORRISTOWN

RECORD DRAWING
BARGE, WAGGONER, SUMNER & CANNON
ENGINEERS & PLANNERS

By *Jason Sumner*
Date *SEPT 26, 1975* File *4077-d*



4077-29

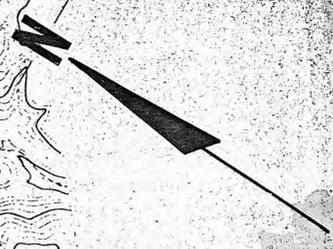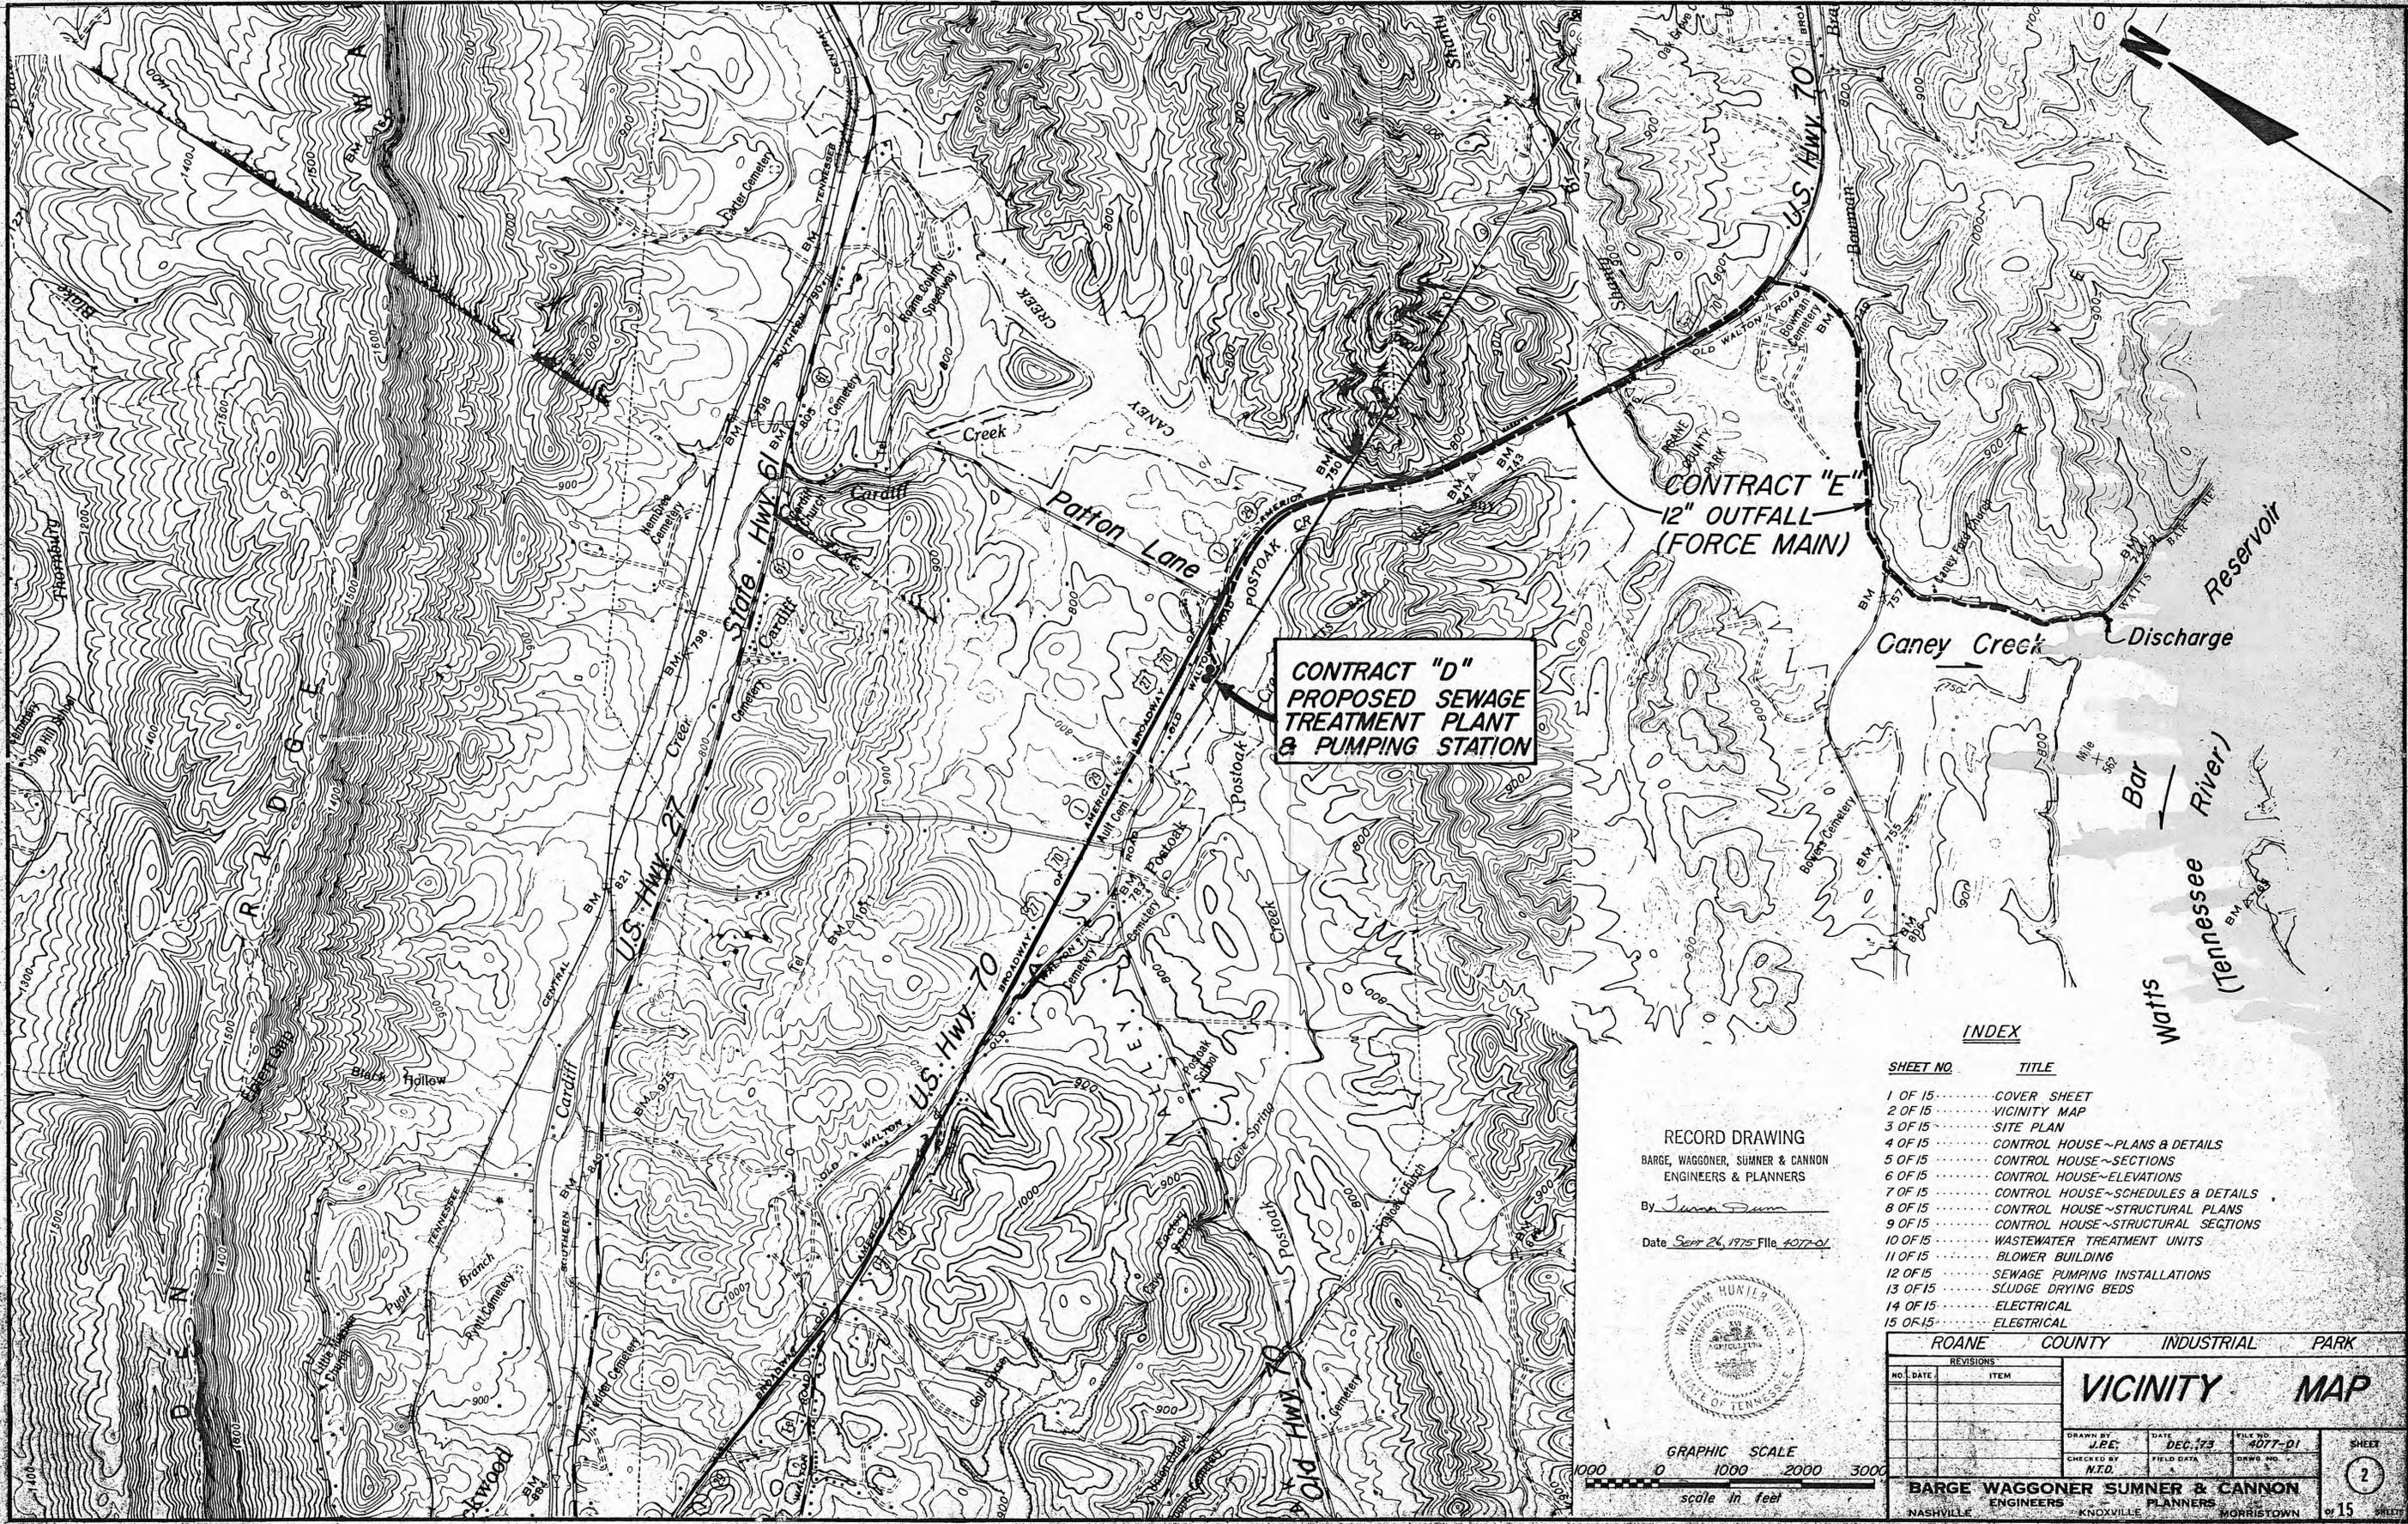

**CONTRACT "D"
PROPOSED SEWAGE
TREATMENT PLANT
& PUMPING STATION**

**CONTRACT "E"
12" OUTFALL
(FORCE MAIN)**

INDEX


SHEET NO.	TITLE
1 OF 15	COVER SHEET
2 OF 15	VICINITY MAP
3 OF 15	SITE PLAN
4 OF 15	CONTROL HOUSE~PLANS & DETAILS
5 OF 15	CONTROL HOUSE~SECTIONS
6 OF 15	CONTROL HOUSE~ELEVATIONS
7 OF 15	CONTROL HOUSE~SCHEDULES & DETAILS
8 OF 15	CONTROL HOUSE~STRUCTURAL PLANS
9 OF 15	CONTROL HOUSE~STRUCTURAL SECTIONS
10 OF 15	WASTEWATER TREATMENT UNITS
11 OF 15	BLOWER BUILDING
12 OF 15	SEWAGE PUMPING INSTALLATIONS
13 OF 15	SLUDGE DRYING BEDS
14 OF 15	ELECTRICAL
15 OF 15	ELECTRICAL

RECORD DRAWING





BARGE, WAGGONER, SUMNER & CANNON
ENGINEERS & PLANNERS

By *Juan Sumner*

Date *Sept 26, 1975 File 4077-01*

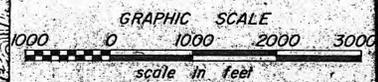

ROANE COUNTY INDUSTRIAL PARK		VICINITY MAP	
REVISIONS		DRAWN BY J.P.E.	DATE DEC. 173
		CHECKED BY N.T.D.	FILE NO. 4077-01
		SHEET 2	
BARGE WAGGONER SUMNER & CANNON		ENGINEERS PLANNERS	
NASHVILLE	KNOXVILLE	MORRISTOWN	

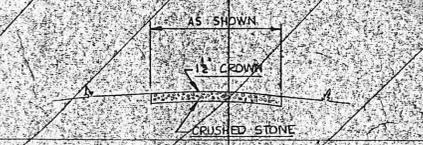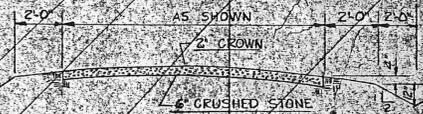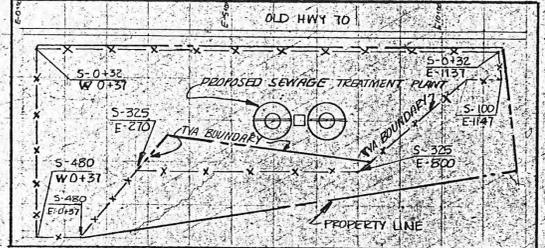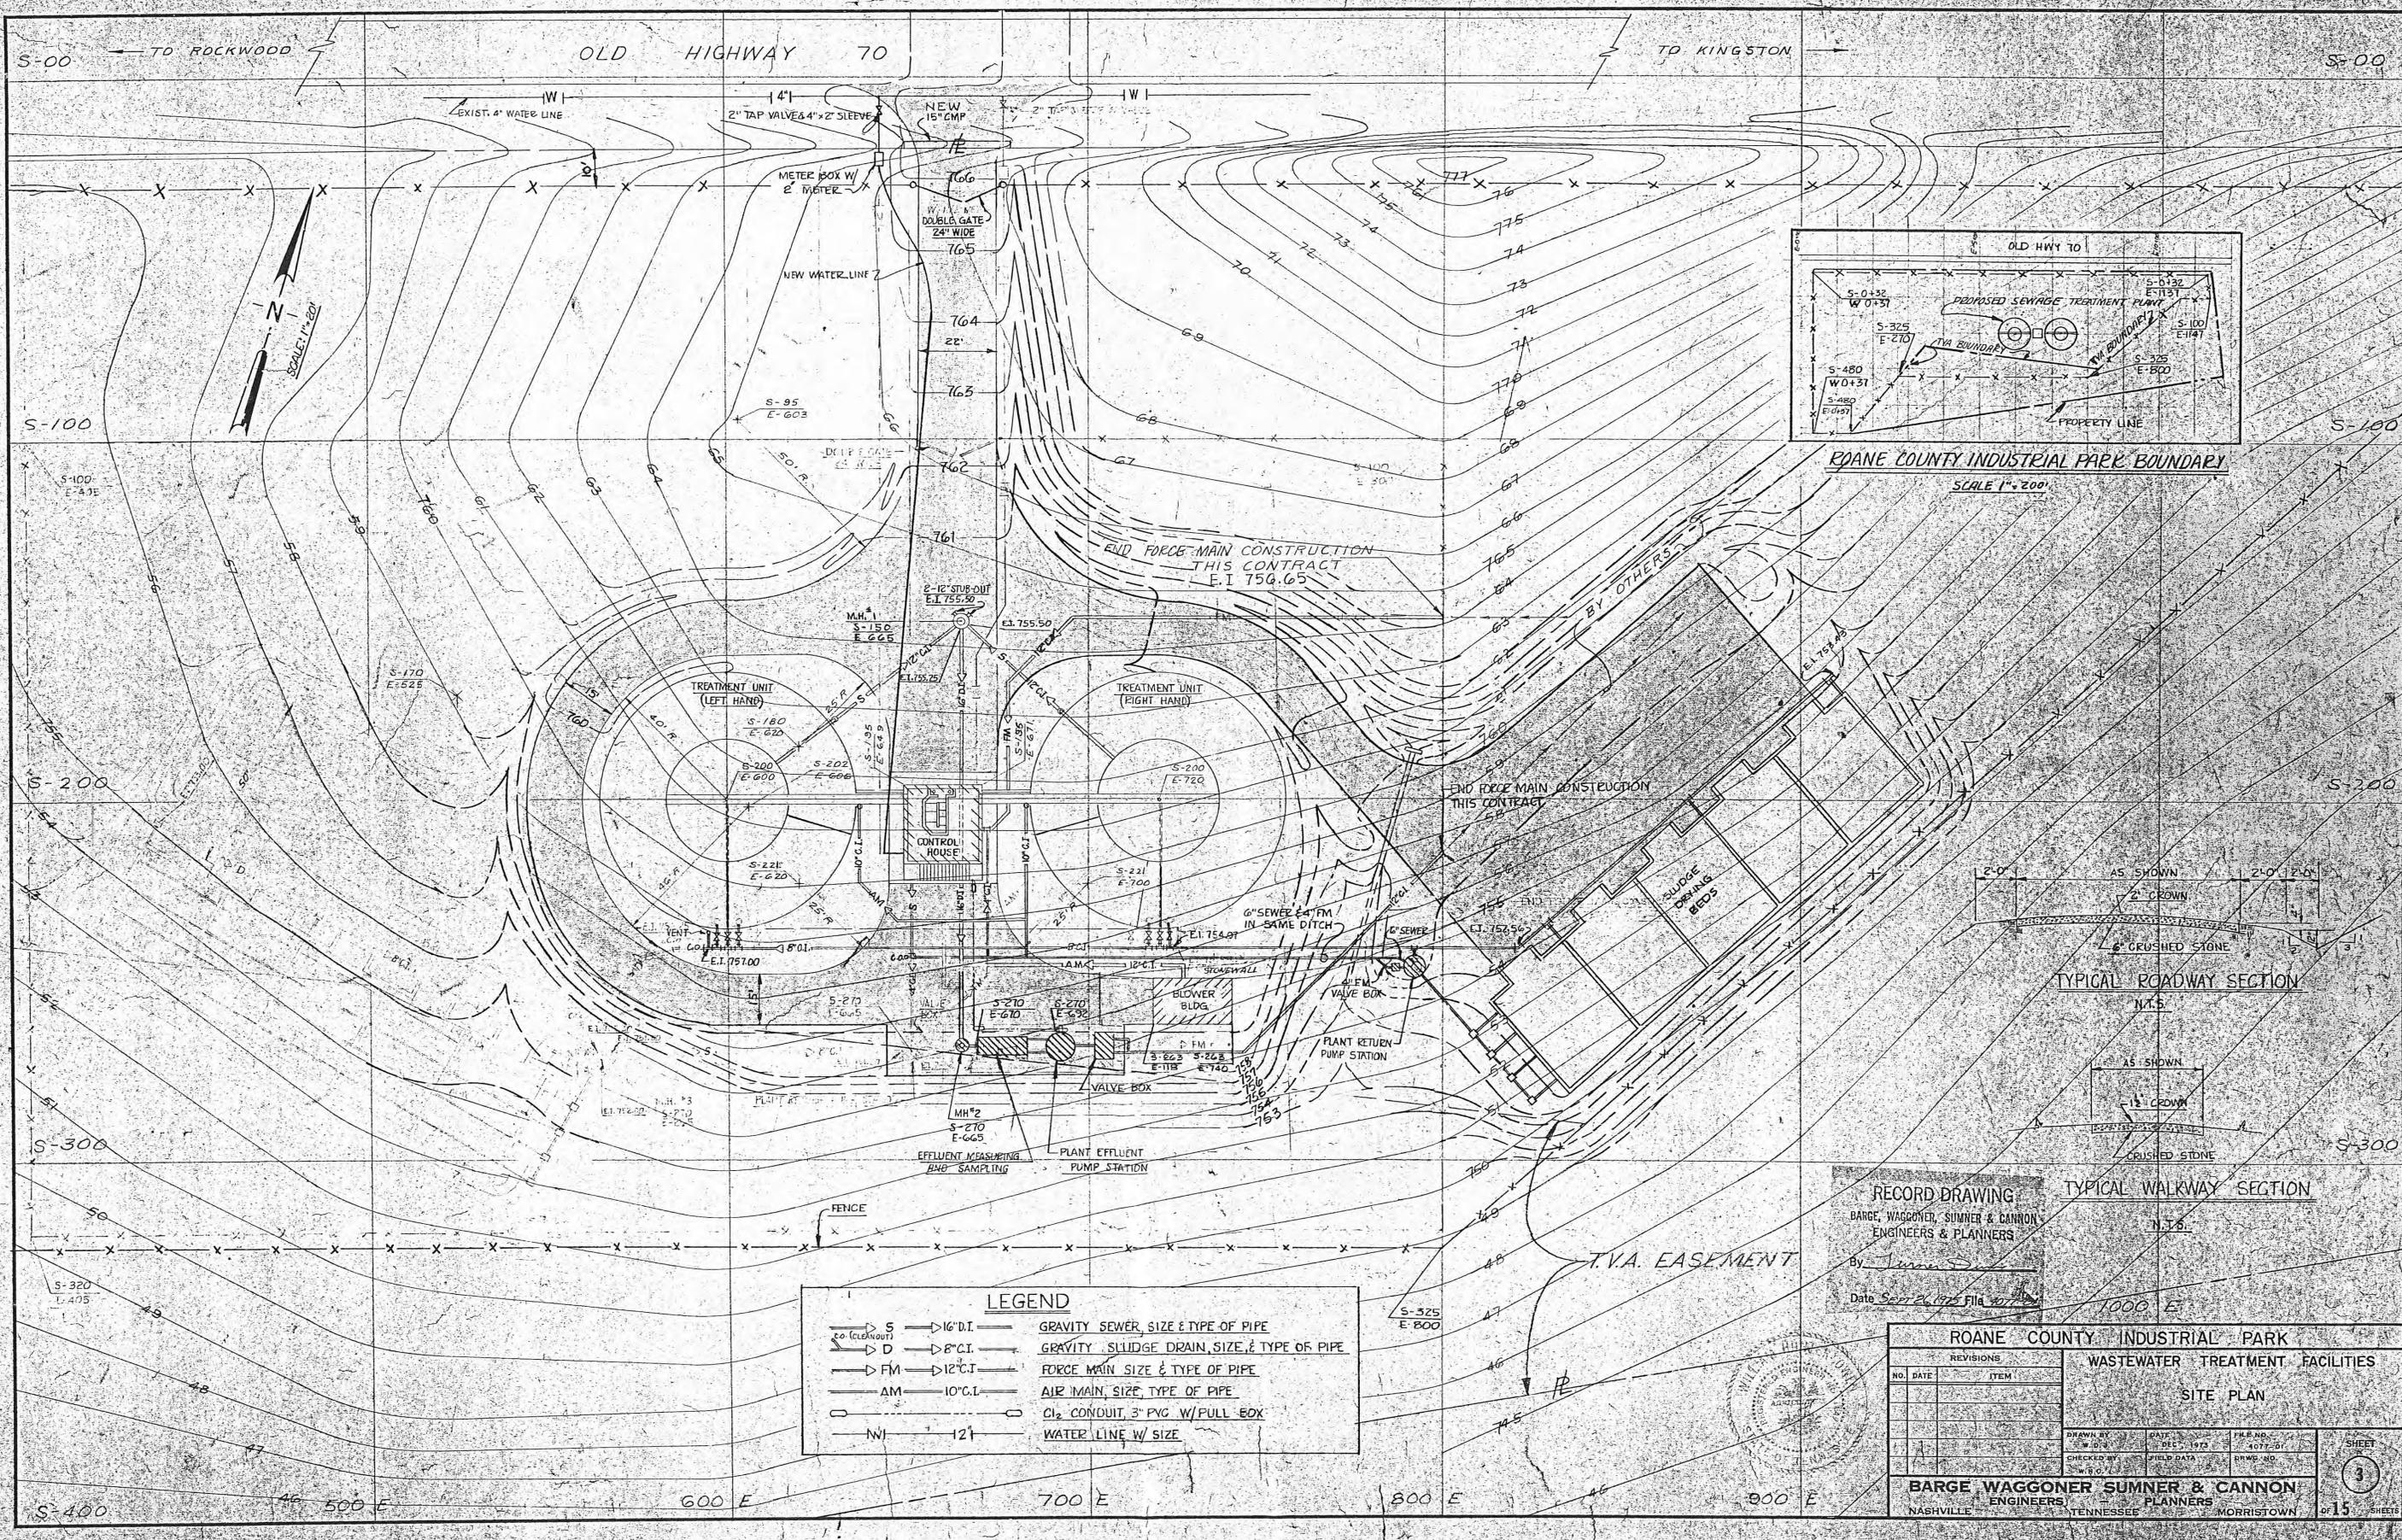

LEGEND

S	16" D.I.	GRAVITY SEWER, SIZE & TYPE OF PIPE
D	8" C.I.	GRAVITY SLUDGE DRAIN, SIZE & TYPE OF PIPE
FM	12" C.I.	FORCE MAIN, SIZE & TYPE OF PIPE
AM	10" C.I.	AIR MAIN, SIZE, TYPE OF PIPE
○	○	CL ₂ CONDUIT, 3" PVC W/FULL BOX
WI	12"	WATER LINE W/ SIZE

RECORD DRAWING
 BARGE, WAGGONER, SUMNER & CANNON
 ENGINEERS & PLANNERS
 By *James S. Cannon*
 Date *Sept 26, 1975* File *4077-01*


REVISIONS		NO. DATE		ITEM

ROANE COUNTY INDUSTRIAL PARK
WASTEWATER TREATMENT FACILITIES
SITE PLAN


DRAWN BY	DATE	FILE NO.
W. D. S.	DEC. 1972	4077-01
CHECKED BY	FIELD DATA	DRWG. NO.
W. D. S.		

BARGE WAGGONER SUMNER & CANNON
 ENGINEERS PLANNERS
 NASHVILLE TENNESSEE MORRISTOWN


SHEET **3** OF 15

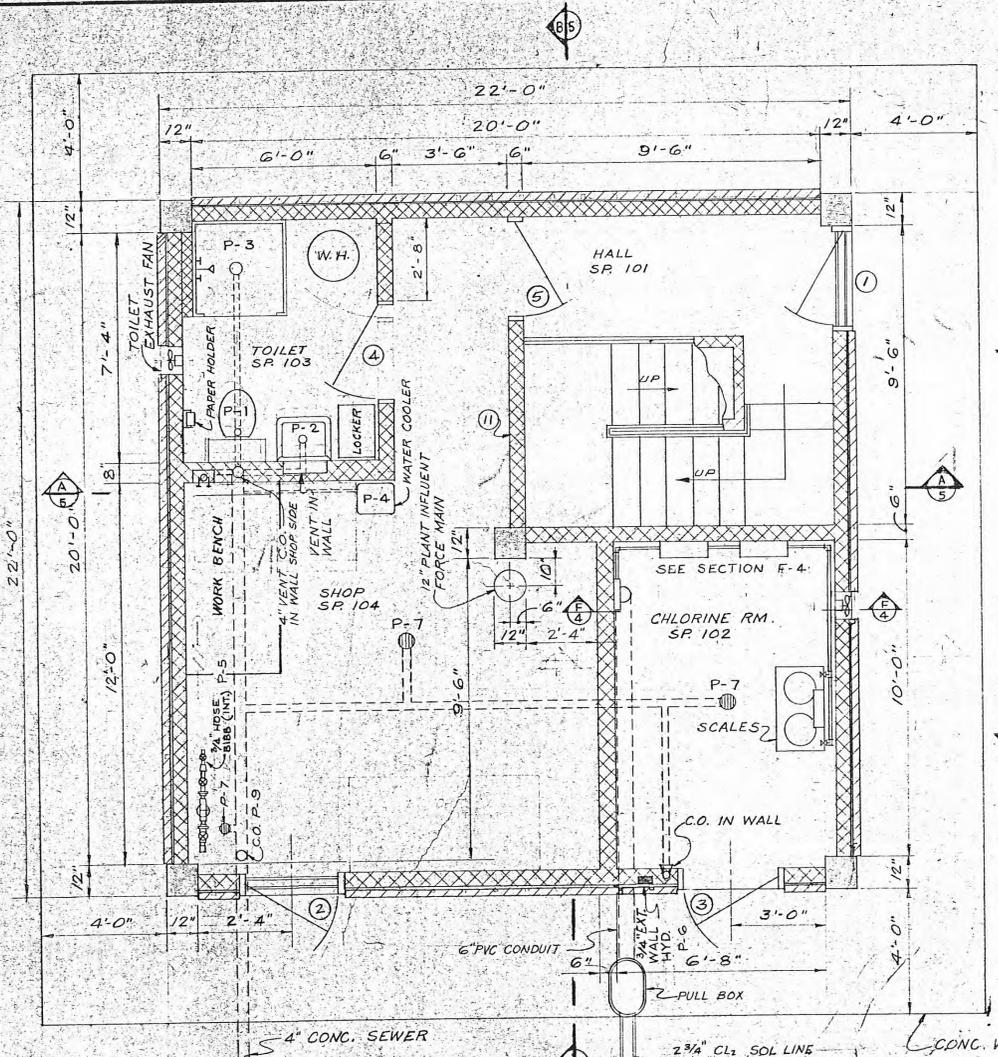

FIRST FLOOR PLAN
SCALE: 3/8" = 1'-0"

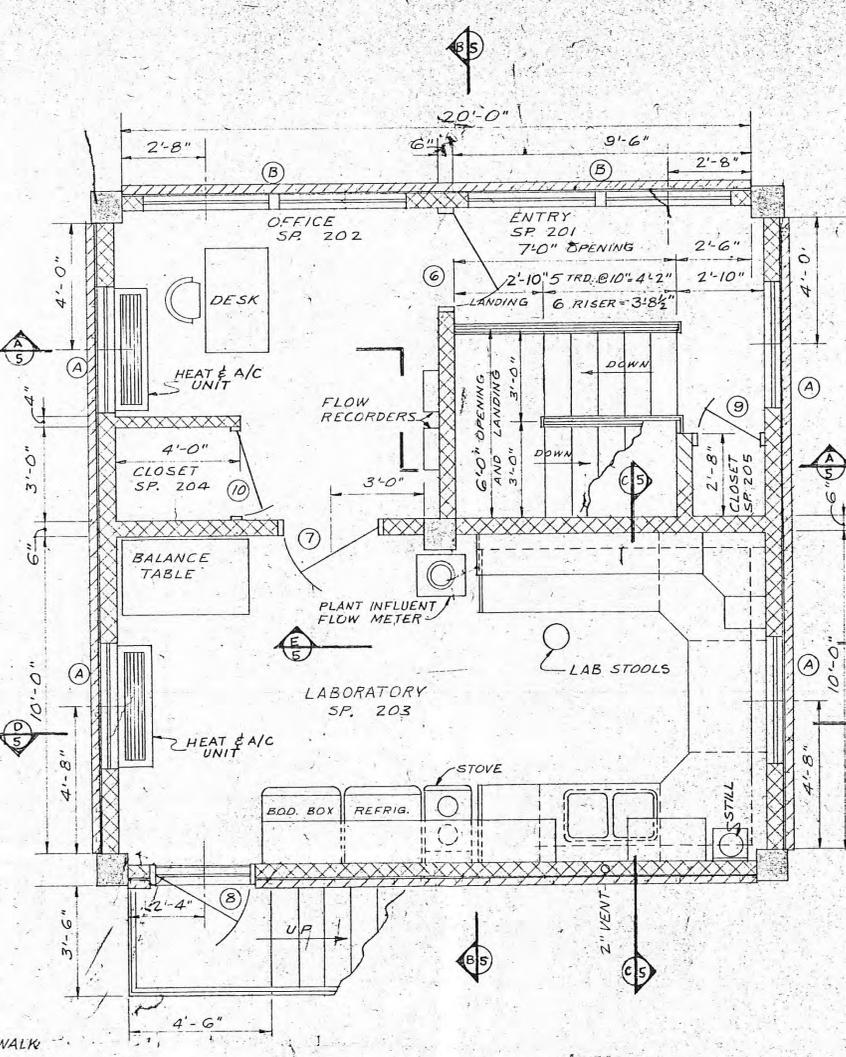


SECOND FLOOR PLAN
SCALE: 3/8" = 1'-0"

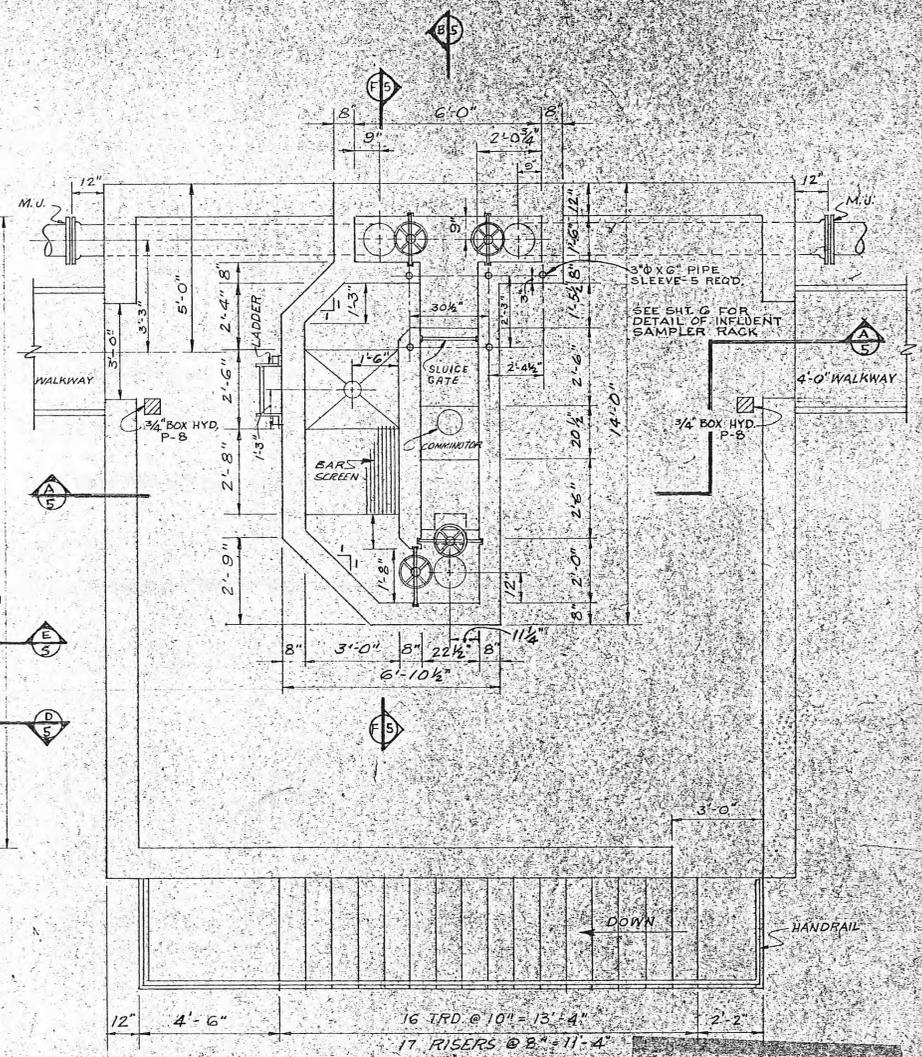


ROOF PLAN
SCALE: 3/8" = 1'-0"


RECORD DRAWING
BARGE, WAGGONER, SUMNER & CANNON
ENGINEERS & PLANNERS
By *J. D. Cannon*
Date *SEP 26, 1973 File 4077*

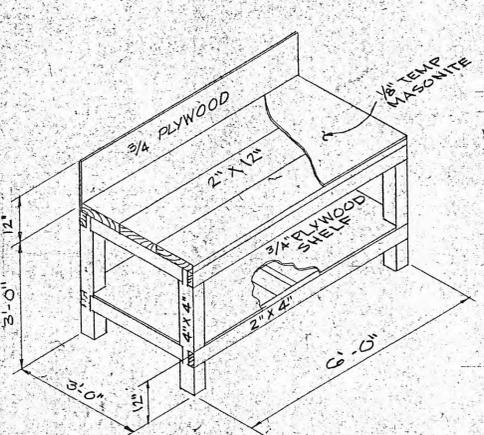

DETAIL WORK BENCH
SCALE: 1/2" = 1'-0"

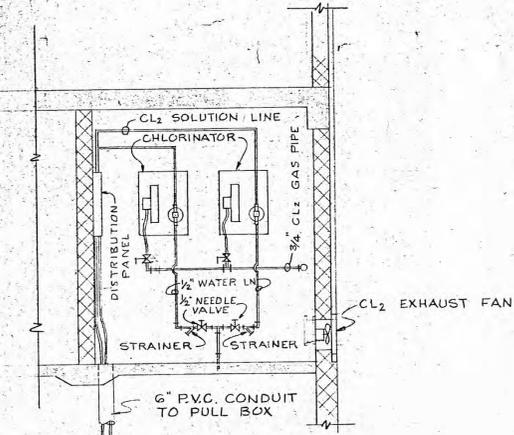


SECTION F-4
SCALE: 3/8" = 1'-0"

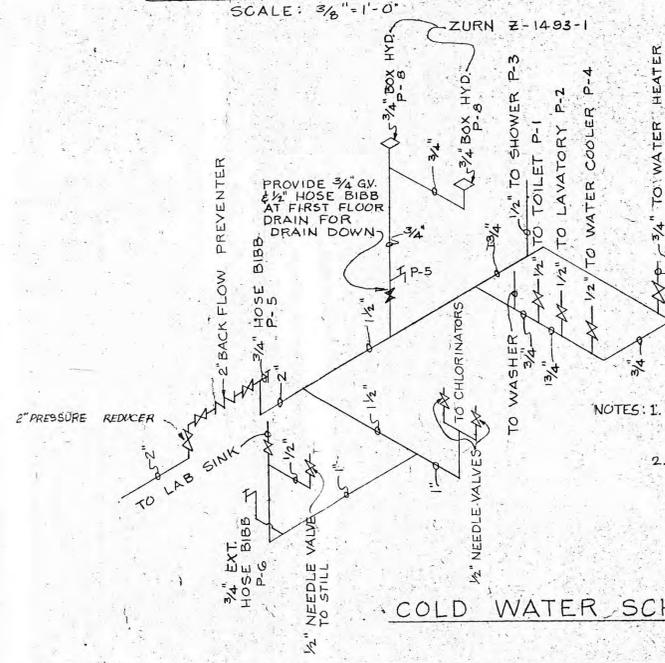

NOTES: 1. PROVIDE HOT WATER PIPING TO SHOWER, LAVATORY AND LAB. SINK.
2. BACKFLOW PREVENTER SHALL BE 2" IN SIZE W/ SCREWED CONNECTIONS OF THE REDUCED PRESSURE DESIGN SIMILAR & EQUAL TO BEECO MODEL G-C W/ GATE VALVES.

COLD WATER SCHEMATIC

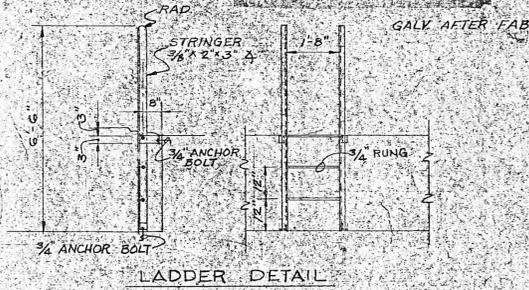

LADDER DETAIL
SCALE: 3/8" = 1'-0"



REVISIONS		DRAWN BY		DATE	FILE NO.	SHEET
NO.	DATE	W.D.C.	DATE	4077-01	4	
		W.D.C. <td>DEC. 1973 <td>4077-01 <td rowspan="2">15</td> </td></td>		DEC. 1973 <td>4077-01 <td rowspan="2">15</td> </td>	4077-01 <td rowspan="2">15</td>	15
		W.D.C. <td>FILED DATA <td>DRAWG. NO. </td></td>		FILED DATA <td>DRAWG. NO. </td>	DRAWG. NO.	

ROANE COUNTY INDUSTRIAL PARK
WASTEWATER TREATMENT FACILITIES
CONTROL HOUSE
PLANS & DETAILS


BARGE WAGGONER SUMNER & CANNON
ENGINEERS PLANNERS
NASHVILLE TENNESSEE MORRISTOWN

TRIM ON THIS LINE FOR SEPARATE SHEETS

TRIM ON THIS LINE FOR SEPARATE SHEETS

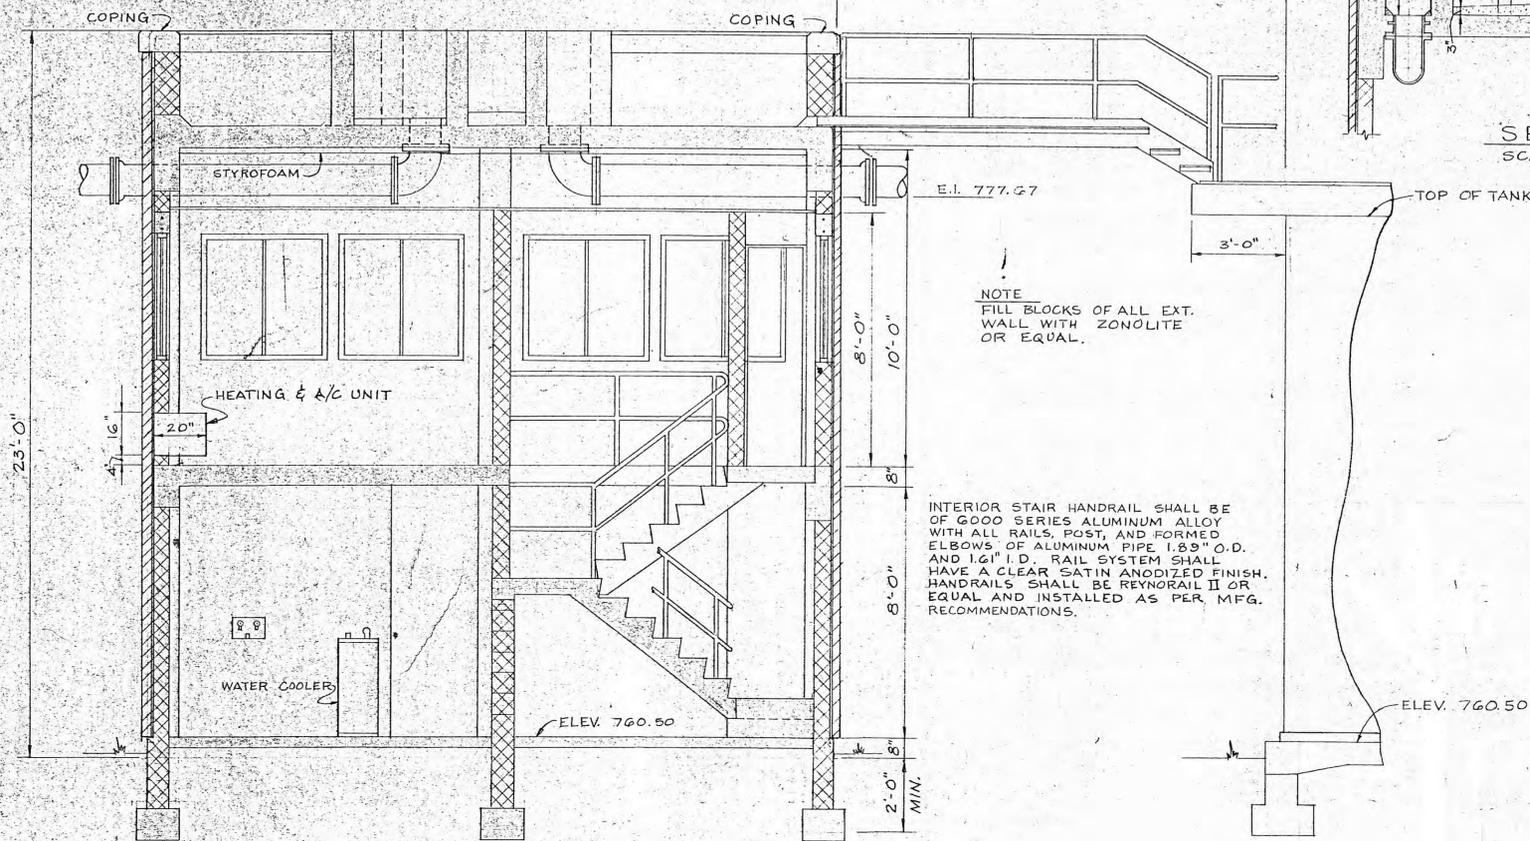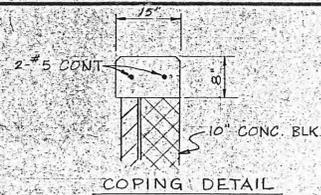


SECTION A
SCALE: 3/8" = 1'-0" (5)

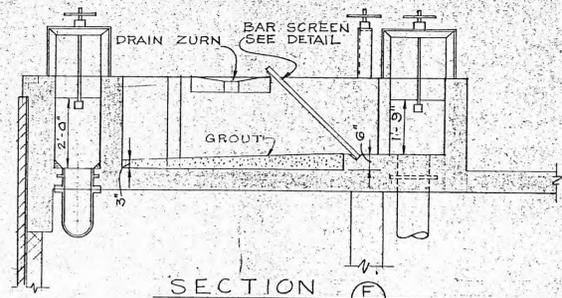


SECTION F
SCALE: 3/8" = 1'-0" (5)

NOTE
FILL BLOCKS OF ALL EXT. WALL WITH ZONOLITE OR EQUAL.


INTERIOR STAIR HANDRAIL SHALL BE OF GOOD SERIES ALUMINUM ALLOY WITH ALL RAILS, POST, AND FORMED ELBOWS OF ALUMINUM PIPE 1.39" O.D. AND 1.61" I.D. RAIL SYSTEM SHALL HAVE A CLEAR SATIN ANODIZED FINISH. HANDRAILS SHALL BE REYNORAIL II OR EQUAL AND INSTALLED AS PER MFG. RECOMMENDATIONS.

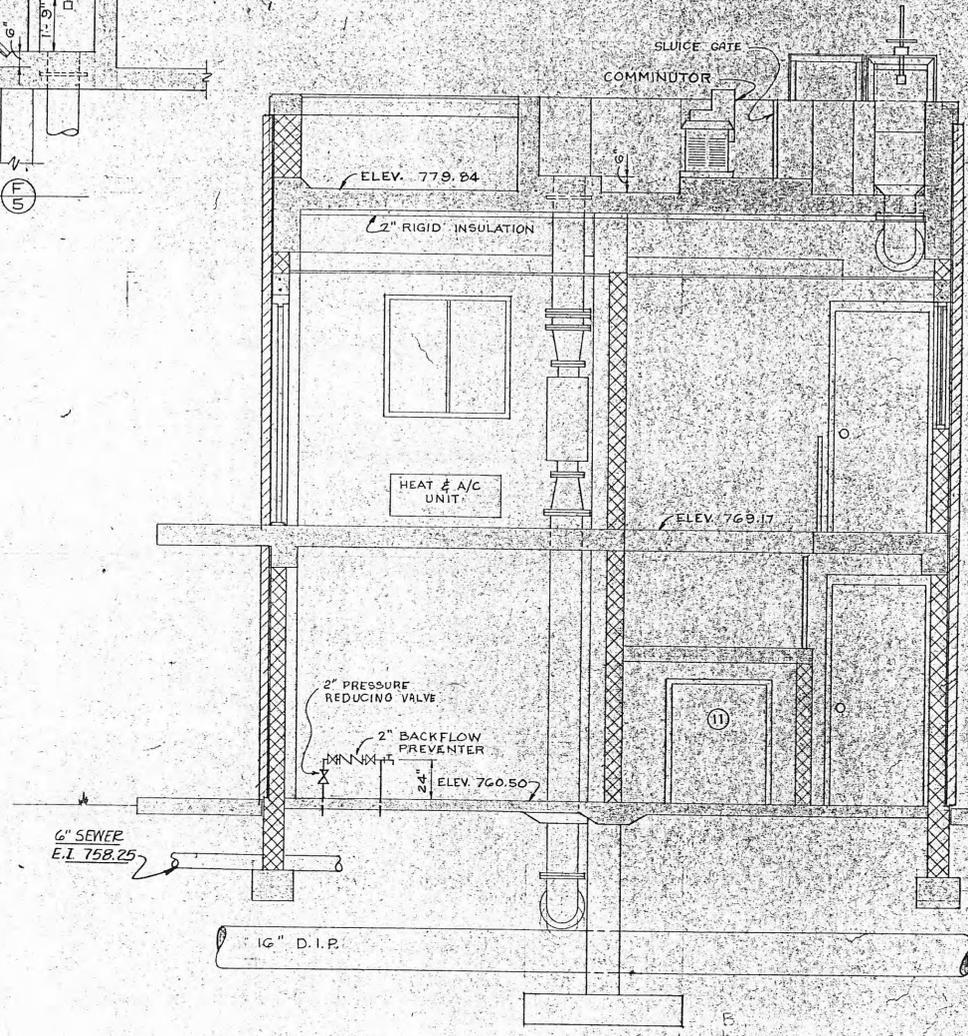


SECTION B
SCALE: 3/8" = 1'-0" (5)

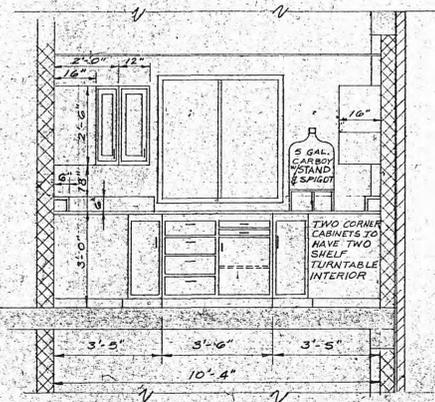

SECTION C
SCALE: 3/8" = 1'-0" (5)

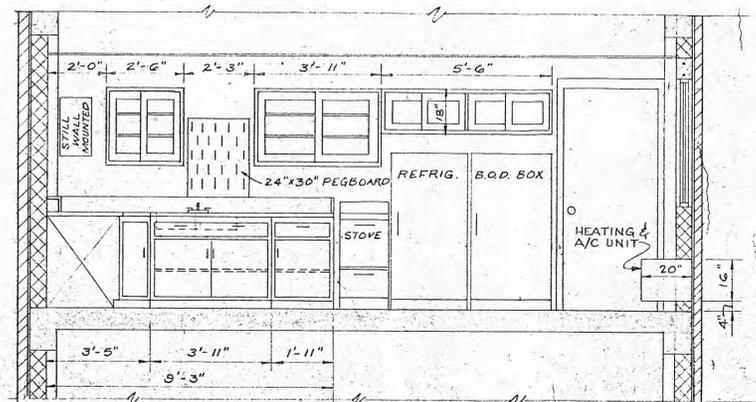

SECTION D
SCALE: 3/8" = 1'-0" (5)

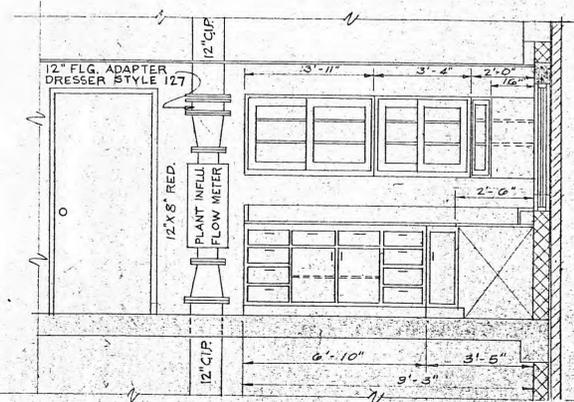

SECTION E
SCALE: 3/8" = 1'-0" (5)

RECORD DRAWING
BARGE, WAGGONER, SOMNER & CANNON
ENGINEERS & PLANNERS
By *James Somner*
Date Sept 26, 1975 File 4077-01




REVISIONS		ROANE COUNTY INDUSTRIAL PARK WASTEWATER TREATMENT FACILITIES CONTROL HOUSE SECTIONS		
NO.	DATE	ITEM	FILE NO.	SHEET
			4077-01	5

DRAWN BY: W.W.C. DATE: DEC. 1973
CHECKED BY: FIELD DATA DRWG. NO. 4077-01

BARGE WAGGONER SOMNER & CANNON
ENGINEERS PLANNERS
NASHVILLE TENNESSEE MORRISTOWN


TRIM ON THIS LINE FOR SEPARATE SHEETS

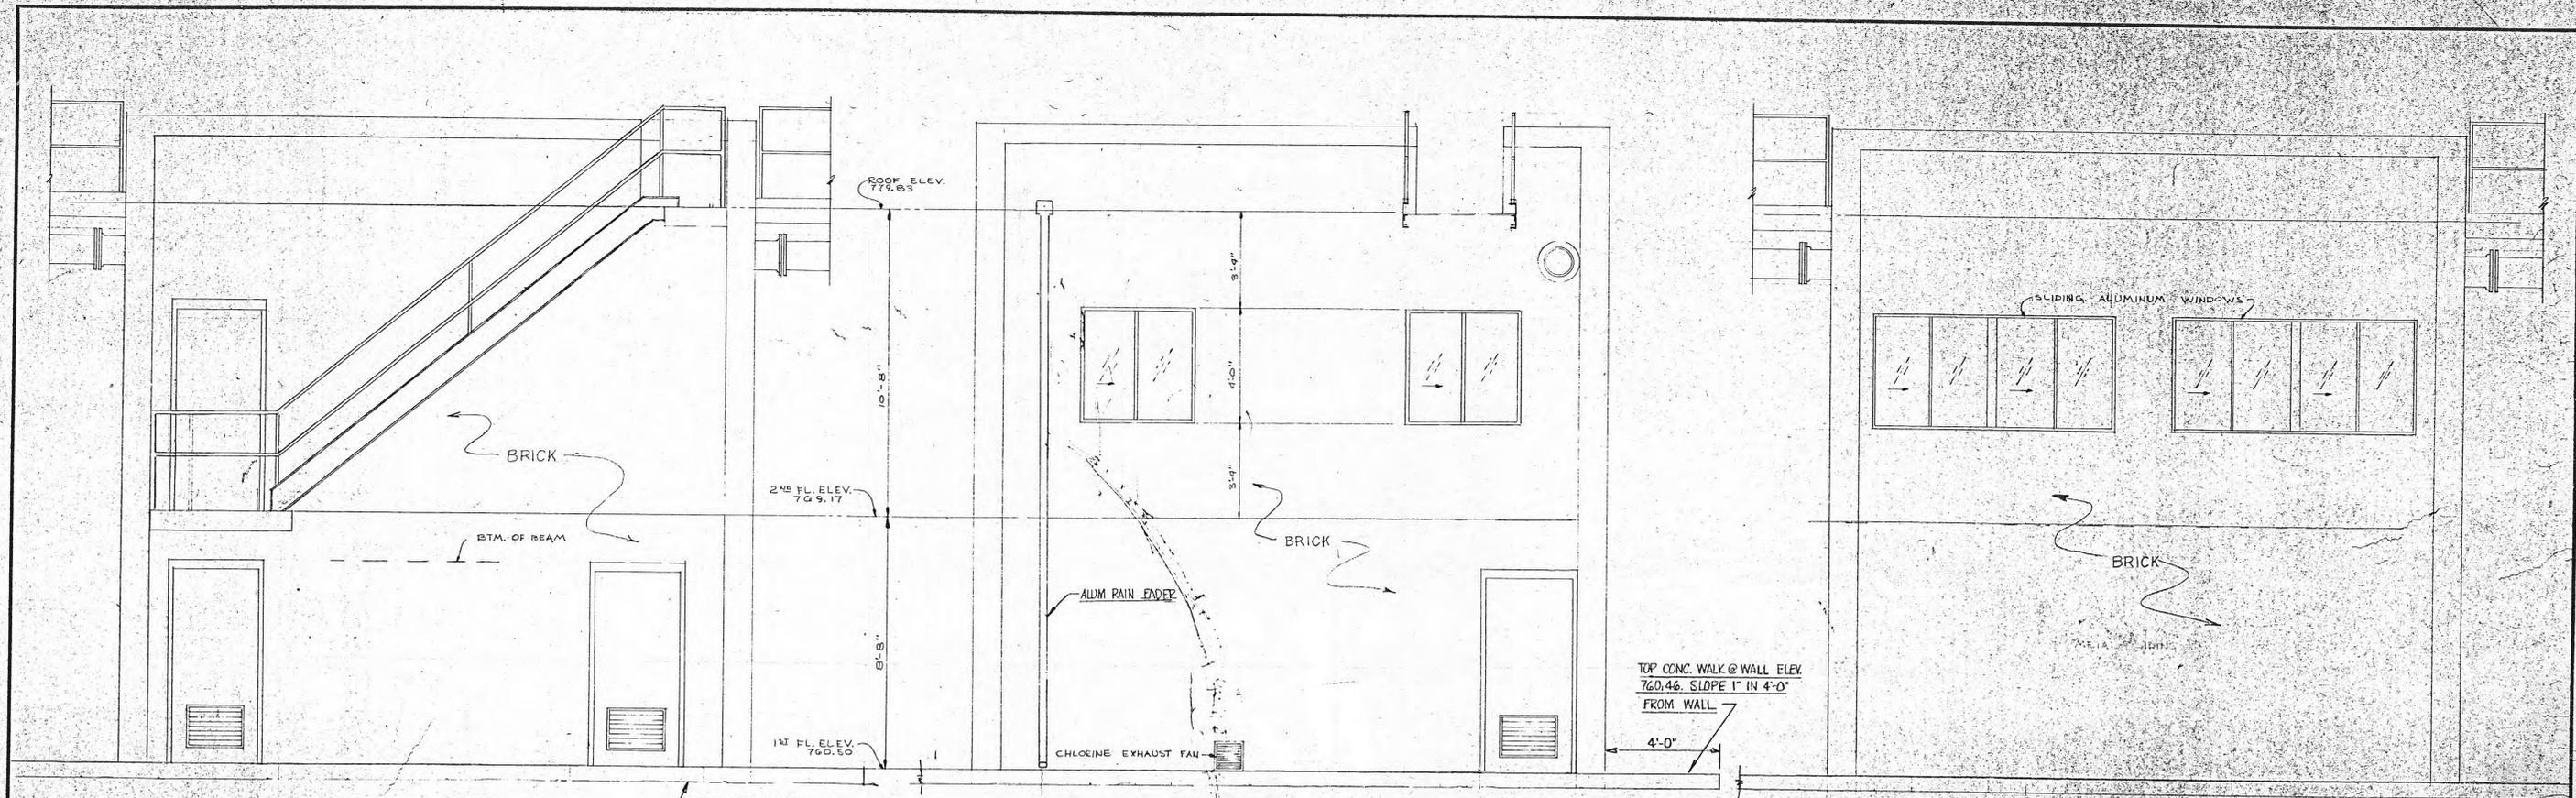


SOUTH ELEVATION
SCALE: 3/8" = 1'-0"

EAST ELEVATION
SCALE: 3/8" = 1'-0"


NORTH ELEVATION
SCALE: 3/8" = 1'-0"

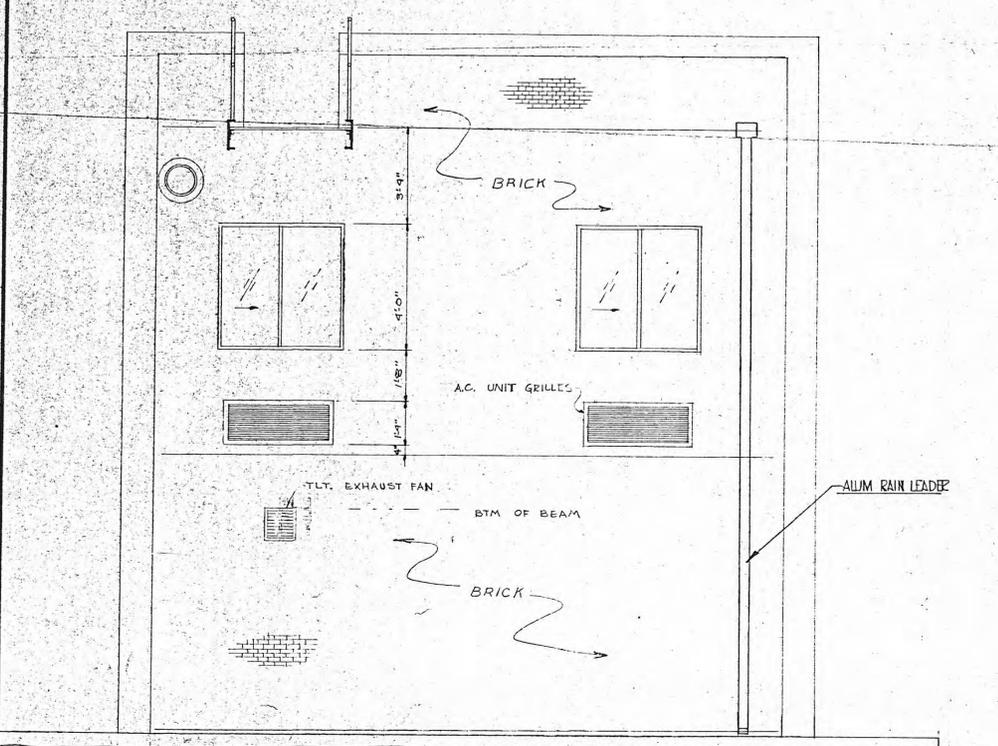


WEST ELEVATION
SCALE: 3/8" = 1'-0"

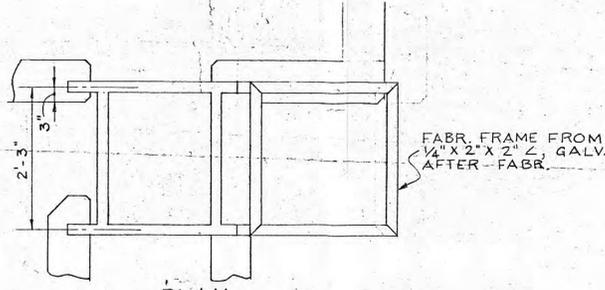

PLAN
SCALE: 3/4" = 1'-0"

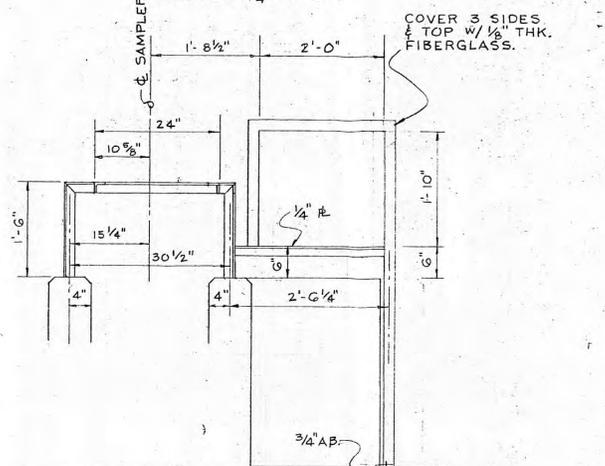

INFLUENT SAMPLER RACK
SCALE: 3/4" = 1'-0"

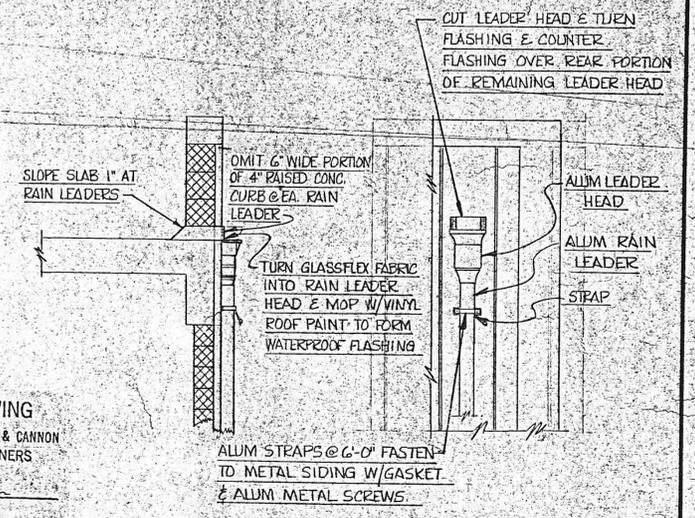

DETAIL - LEADER HEAD & FLASHING
SCALE: 1/2" = 1'-0"

RECORD DRAWING
BARGE, WAGGONER, SUMNER & CANNON
ENGINEERS & PLANNERS
By *Juan D...*
Date *Sept 26, 1975* File *A077-2*



REVISIONS		ROANE COUNTY INDUSTRIAL PARK	
NO.	DATE	ITEM	

WASTEWATER TREATMENT FACILITIES	
ELEVATIONS	
DRAWN BY	DATE
CHECKED BY	FIELD DATA
FILE NO. 4077-01	DRWG. NO.

BARGE WAGGONER SUMNER & CANNON
ENGINEERS & PLANNERS
NASHVILLE TENNESSEE MORRISTOWN



SHEET **6** OF 15 SHEETS

FINISH SCHEDULE

DOOR SCHEDULE

SP. NO.	SPACE NAME	FLOOR	BASE	WALL	CEIL.	CEIL. HT.	PAINTING				REMARKS	MARK	FRAME DETAILS	SP. NO.	TYPE	DOOR SIZE			DESCRIPTION	FRAME	THRESH.	REMARKS	
							WALL	DOOR	CEIL.	TRIM						WIDTH	HEIGHT	THICK.					
101	HALL	EXP CONC.	—	CONC. BLK	EXP CONC.	8'-0"	✓	✓	✓	✓		1	A	EXT. TO 101		3'-0"	6'-8"	1 3/4"	HOLLOW METAL	METAL	ALUM		
102	CHLORINE ROOM	EXP CONC.	—	CONC. BLK	EXP CONC.	8'-0"	✓	✓	✓	✓		2	A	EXT. TO 104		3'-0"	6'-8"	1 3/4"	HOLLOW METAL	METAL	ALUM		
103	TOILET	EXP CONC.	—	CONC. BLK	EXP CONC.	8'-0"	✓	✓	✓	✓		3	A	EXT. TO 102		3'-0"	6'-8"	1 3/4"	HOLLOW METAL	METAL		16" x 24" GRAVITY LOUVER INSTALLED	
104	SHOP	EXP CONC.	—	CONC. BLK	EXP CONC.	8'-0"	✓	✓	✓	✓		4	D	104 TO 103		3'-0"	7'-0"	1 3/4"	HOLLOW METAL	METAL			
105	STAIR	EXP CONC.	—	CONC. BLK	ACOUS. TILE	8'-0"*	✓	✓	✓	✓		5	D	101 TO 104		3'-0"	7'-0"	1 3/4"	HOLLOW METAL	METAL		8" x 12" WIRE GLASS VISION PANEL	
201	ENTRY	EXP CONC.	—	CONC. BLK	ACOUS. TILE	8'-0"	✓	✓	✓	✓		6	B	201 TO 202		3'-0"	7'-0"	1 3/4"	HOLLOW METAL	METAL		SWEEP STRIP / 1/2 WIRE GLASS WEATHER STRIP	
202	OFFICE	V.A.T.	RUBBER	CONC. BLK	ACOUS. TILE	8'-0"	✓	✓	✓	✓		7	B	202 TO 203		3'-0"	7'-0"	1 3/4"	HOLLOW METAL	METAL		1/2 WIRE GLASS	
203	LABORATORY	V.A.T.	RUBBER	CONC. BLK	ACOUS. TILE	8'-0"	✓	✓	✓	✓		8	C	EXT. TO 203		3'-0"	7'-0"	1 3/4"	HOLLOW METAL	METAL	ALUM	WEATHER STRIP SWEEP STRIP	
204	CLOSET	V.A.T.	RUBBER	CONC. BLK	ACOUS. TILE	8'-0"	✓	✓	✓	✓		9	B	201 TO 205		2'-0"	7'-0"	1 3/4"	HOLLOW METAL	METAL			
205	CLOSET	EXP CONC.	—	CONC. BLK	ACOUS. TILE	8'-0"	✓	✓	✓	✓		10	B	202 TO 204		2'-8"	7'-0"	1 3/4"	HOLLOW METAL	METAL			
												11	E	104 TO UNDER STAIRS		3'-0"	4'-0"	1 3/4"	HOLLOW METAL	METAL			
	BLOWER BUILDING	EXP CONC.	—	CONC. BLK	EXP. CONST.		✓	✓	✓	✓		12	F	BLOWER BLDG		3'-0"	7'-0"	1 3/4"	HOLLOW METAL	METAL	ALUM		
												13		BLOWER BLDG	BI-FOLD	11'-7 1/2"	8'-0"	1 3/4"	HOLLOW METAL	METAL CHANNEL			SEE SPECIFICATIONS SHEET 11


NOTE: ALL EXPOSED PIPING SHALL BE COLOR-CODE PAINTED. COLORS TO BE FURNISHED BY ENGINEER.

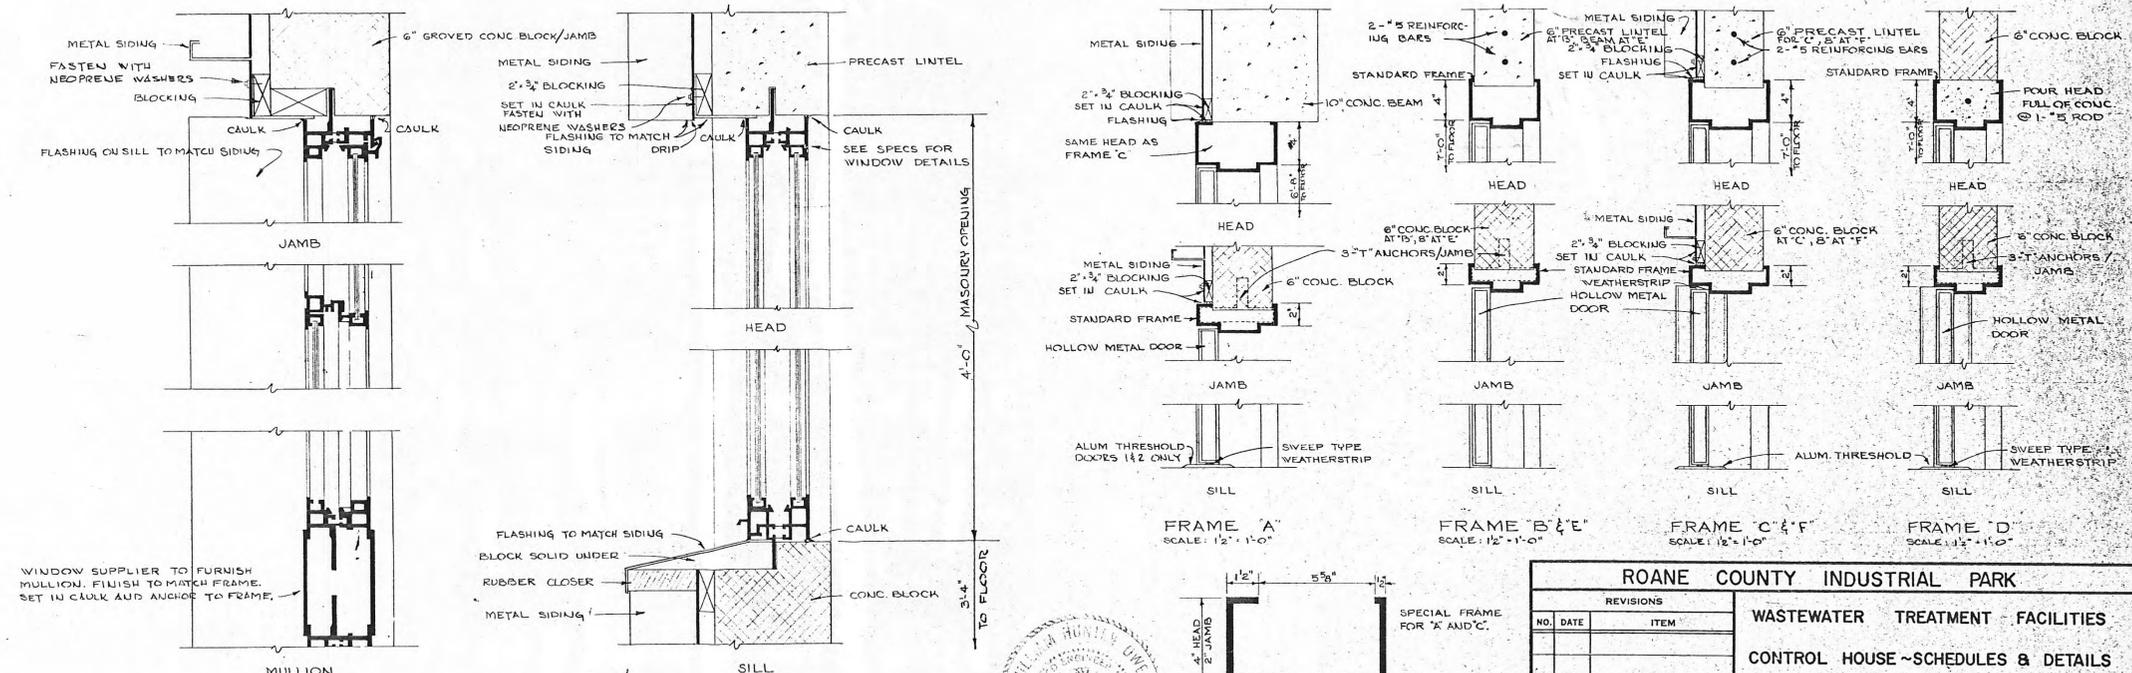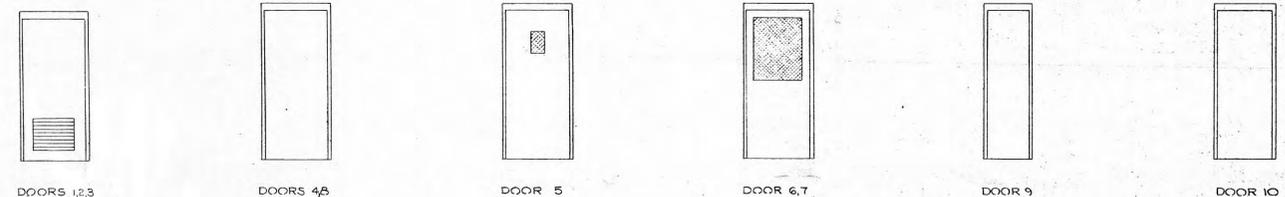


REVISIONS			ROANE COUNTY INDUSTRIAL PARK		
NO.	DATE	ITEM	WASTEWATER TREATMENT FACILITIES		
			CONTROL HOUSE - SCHEDULES & DETAILS		
DRAWN BY C.B.S.		DATE DEC. 1973	FILE NO. 4077-01		SHEET
CHECKED BY W.H.O.		FIELD DATA	DRWG. NO.		7
BARGE WAGGONER SUMNER & CANNON					
NASHVILLE		KNOXVILLE		MORRISTOWN	
ENGINEERS		PLANNERS		OF 15 SHEETS	

RECORD DRAWING
BARGE, WAGGONER, SUMNER & CANNON
ENGINEERS & PLANNERS
By *William Underwood*
Date *SEPT 26 1973 FILE 4077-01*


TRIM ON THIS LINE FOR SEPARATE SHEETS

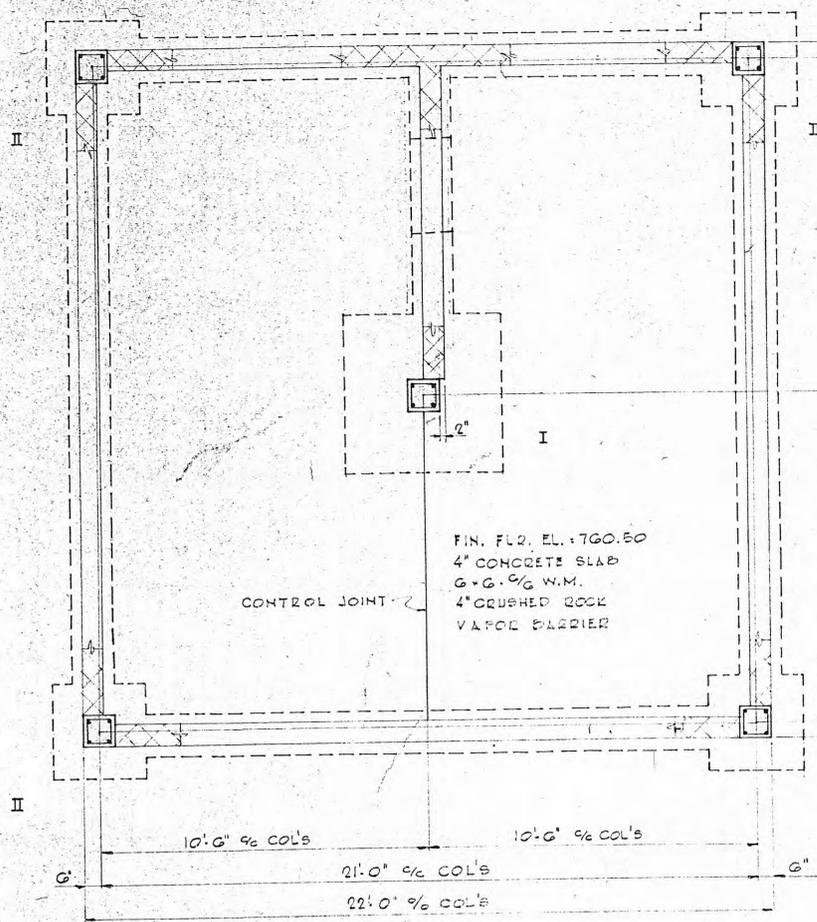


FOUNDATION AND FIRST FLOOR FRAMING PLAN
1/4" = 1'-0"

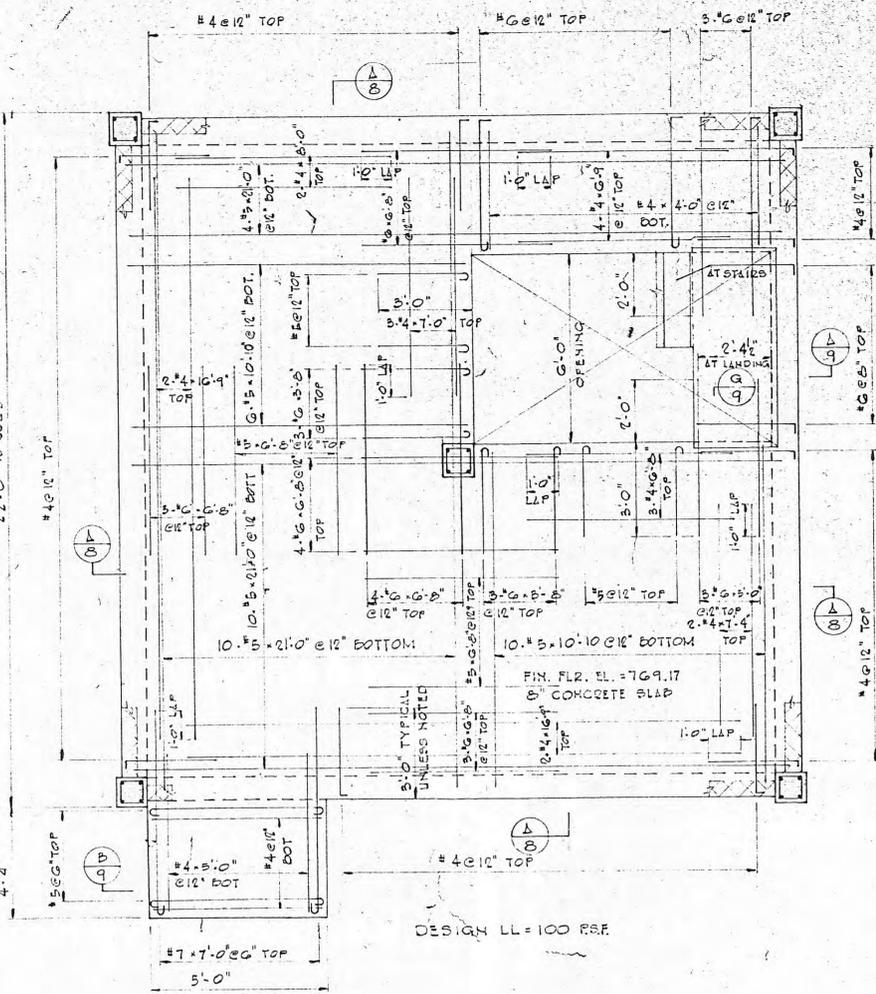


SECOND FLOOR FRAMING PLAN
1/8" = 1'-0"

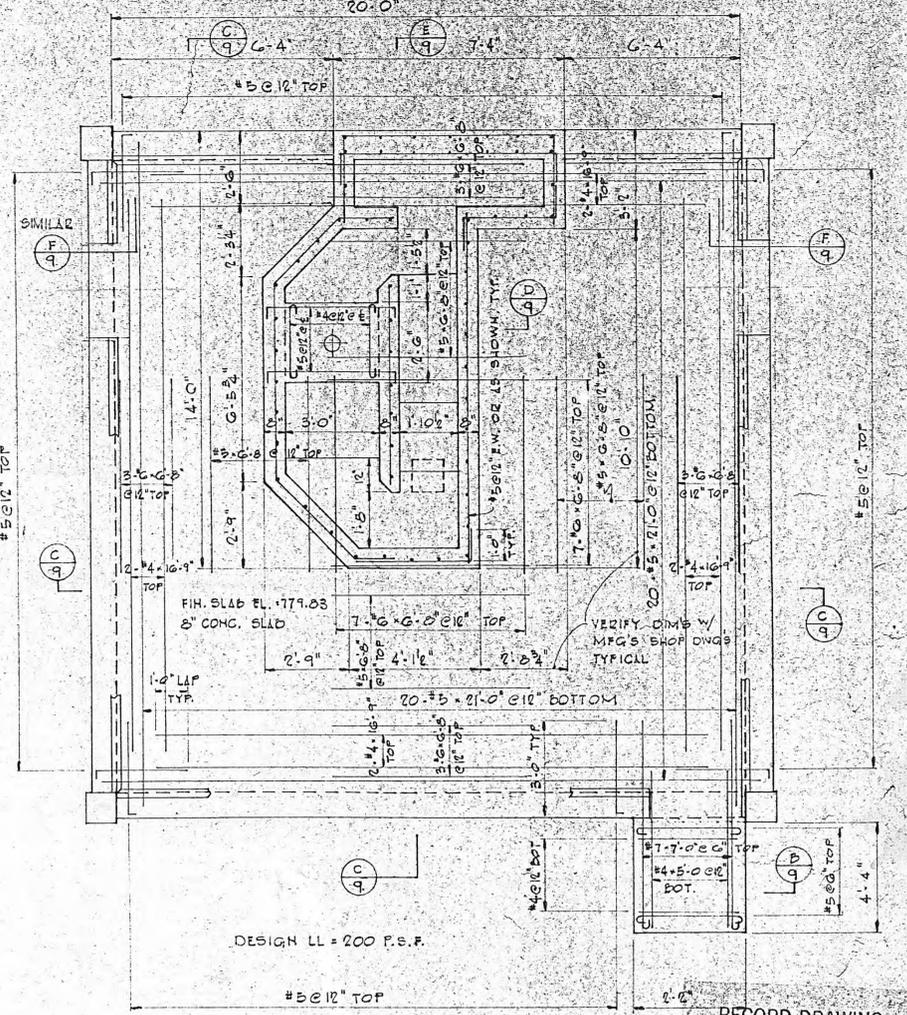


ROOF FRAMING PLAN
1/8" = 1'-0"

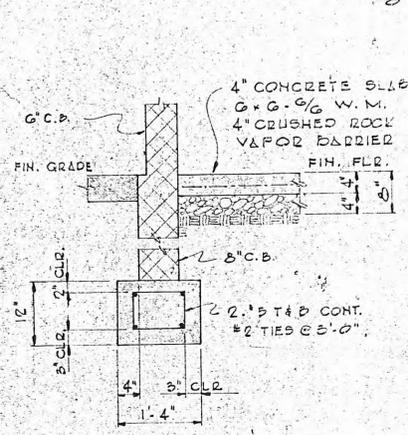


EXTERIOR C.B. WALL FOOTING
1/4" = 1'-0"
(INTERIOR LOAD BEARING C.B. WALLS SIMILAR)

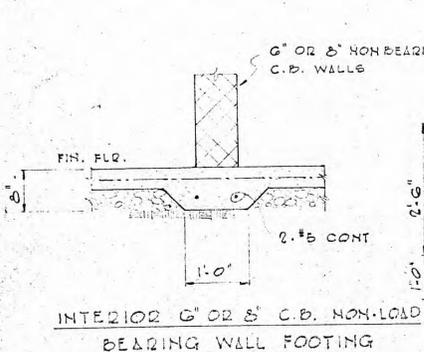

INTERIOR C.B. NON-LOAD BEARING WALL FOOTING

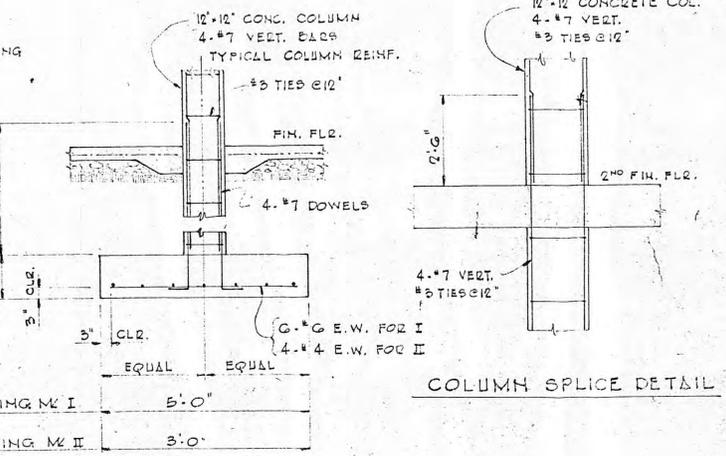

COLUMN FOOTING DETAIL

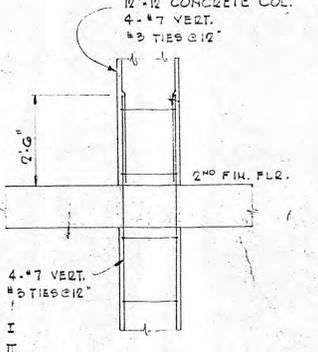


COLUMN SPLICE DETAIL

GENERAL NOTES

- All concrete work shall conform to the Building Code Requirements for Reinforced Concrete (2,3,4, 318-71). Detailing shall conform to the recommended practices of the Manual of Standard Practice for Detailing Reinforced Concrete Structures, 20th Edition.
- All concrete shall be 4000 P.S.I. f'c except column and wall footings shall be 3000 P.S.I.
- All load bearing and exterior footings to bear on natural earth with a minimum bearing capacity of 3 K.S.F. Bottom of footing to be a minimum of 2'-0" below existing grade.
- All bars marked continuous shall be lapped a minimum of 36 bar diameters at splices and corners.
- All reinforcing steel shall be deformed bars conforming to A.S.T.M. A615 requirements. All bars #6 or larger are to be Grade 60; #5 or smaller to be Grade 40.
- Design, fabrication and erection of structural steel shall be in accordance with current A.I.S.C. Specifications.
- Control joints for concrete slabs on grade to be "Stress Lock" strips inserts or equal.
- All structural steel to have one shop coat paint, red lead primer or equal.
- All structural steel to be A.S.T.M. A36.

RECORD DRAWING
BARGE, WAGGONER, SUMNER & CANNON
ENGINEERS & PLANNERS
By *J. W. Cannon*
Date *Sept 26, 1975 File 4077-01*

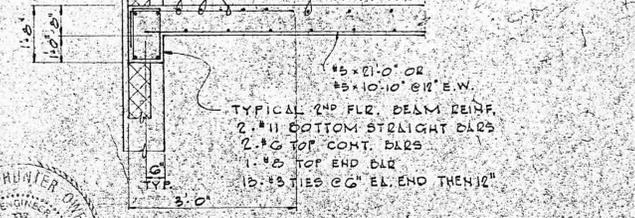

SECTION
1/2" = 1'-0"



REVISIONS		ROANE COUNTY INDUSTRIAL PARK	
NO.	DATE	ITEM	

WASTEWATER TREATMENT FACILITIES		FILE NO. 4077-01	SHEET 8
STRUCTURAL PLANS		DRAWN BY J.T. CARRELL	DATE DEC. 1975
		CHECKED BY W.A.G.	FIELD DATA
			DRAWG. NO.
BARGE WAGGONER SUMNER & CANNON		ENGINEERS PLANNERS	
NASHVILLE TENNESSEE		MORRISTOWN	