

10.00 0.00 υ υ υ υ υ υ 4 ω υ υ υ υ υ 4 ω υ υ 4 υ υ
 7.1

 7.2

 7.3

 7.0

 7.5

 7.6

 7
 8
 8
 8
 3

 7
 8
 2
 3
 1
 3

 7
 4
 6
 2
 3
 1
 3

 7.7

 7
 8
 8
 7
 9

 7
 8
 9
 5
 1
 9

 7
 8
 2
 9
 5
 1
 9

 7
 6
 2
 9
 5
 1
 9

 9.2 9.4 7.7 7.4 8.0 8 . 8 8.4 9.5 9.5 9.0 9.7 7.3 оо • • 5 8.7 8.2 8.0 7.7 8°.8 8 9 8 • • • 8 N 6 8.4 8.4 7.9 7.8 8.0 .9 7.6 7.4 8.0 7.0 7.2 • 7.5 8.1 6. б. 2 б.<u>4</u> б : • 2.0 7.1 5.7 5.7 б. З 3.2 7.7 0.3 4.7 × 3.0 7.4 4.6 4 τυ τυ τυ το α α α Γ α α ο ο ω τυ ω τυ α ο ω 4 4 7 Γ Γ Γ δ δ δ 4 Ω 4 Γ Γ 8 4 δ 2 2 8 8 3.7 3.9 ÷.2 HA. FOODLION BUILDING 60.00 0.00

Sec.

-0

Russle Street


TN #29

	4	4	44 •																					
	ա բ տ	ა თ თ	4ı 10	ர	ы	ы	ர	ы	ы	4	44	41	ω	ω							ų			
	œ	.0	.7	ω	Ļ	••	.»	• 4	• 4	÷.	• •	ω	.7	• #										
	6. 8	7.7	7.5	7.0	. ດ ບ	б.	7.0	7.3	6. 6	л • б	л 2	4.7	4.2	4.0	8	ω .ω	2.8	2.4	2.3		·			
	7.4	8 • 8	8.7	8 .3	7.8	7.8	8 • 2	8.4	7.6	6.0	ហ • ហ	5.1	4 •5	и 4	.4 .4	4.1	ω .5	3.1	з. 0	з. 0				
	7.8	9.2	8 • 8	8 • 5	8.2	8 • 2		8 • 8	8 .3	б . Л	6.1	ы • 8	ហ ហ	л •	თ	5.0	4.4	4.0	3.8	ω.9	з. 8	3 •4		
	8.1	9.5	9.2	8.8	8.4	ю 5	9.0	9.4	8 .8	7.3	7.2	7.1	6.7	6.7	6.6	6.1	თ •თ	5.1	ъ. 0	5.0	л О	4.7	4.0	
	80 • 20	9.0	.9 •	8 • J	7.8	7.9	8. 6	9.2	8.7	7.8	7.8	7.7	7.5	7.7	8.2	7.8	7.0	6.5	6.3	б	6.7	5.7	.4 • 6	4.0
	7.8	8.2	7.9	7.4	7.1	7.3	7.8	8 • 3	8 • J	7.7	7.7	7.8	7.4	8 • 2	9.2	8 • 8	8 • J	7.8	7.6	7.7	7.5	6.2	4 . 5	3.9
	7.3	7.7	7.7	7.2	6.8	7.0	7.6	7.8	7.6	7.1	7.1	.7.3	7.3	8.4	9 • 5	9.0	е Сл	8.1	8.0	7.8	7.7	6.4	4.4	з. 8
	7.7	8.0	7.7	7.2	6.9	7.1	7.6	8.0	8.0	7.5	7.5	7.8	7.8	8 • 6	9.7	9.3	8.7	8.2	8.1	8.1	8.0	ი • ნ	4.8	4.2
	8 • 3	8.7	ю • ц	7.7	7.3	7.5	8.1	8.7	8.8	8.2	8 • 3	8 • 3	8.2	8 • 5	9.2	8 • 8	8.0	7.4	7.3	7.6	7.6	о	л •ω	4.6
	8.2	• 9.4	9.3	8.7	8.2	8 • 3	9.2	9.7	9.2	8.0	8.0	8.1	7.9	8.0	8.1	7.6	6.9	ი თ	6.4	6.4	6.4	б. 0	ъ.	4.6
	7.6	بون ن	8.9	8.8	о С.	8 • 8	9.1	9.4	9.1	7.5	7.1	7.0	6.9	7.1	7.2	7.0	6.3	5.9	5.7	л • ∞	5.7	5.1	4.4	ω 8
	7.0	80 .00	с. с.	8.4	8 • J	8 .5	8.7	9.1	8.6	7.0	6.6	б. 5	6.3	6.7	6.9	6.7	6.0	თ • თ	ъ.	л. б	5.4	4 • 8	ω ∞	3.4
	6.7	•	8.2	₽ 7.9	7.6	7.7	α 	. 8.7	8.1	6.9	ი . ი	6.4	6.4	6.7	7.2	6.7	6.0	л •4	5. 4	თ • ი	ர •	4.7	ω ω .8	₽ 3.3
	е 6.0	2 6.7	б. б	Ф.З	6.1	6.2	6. 8	7.2	. 7.2	6.7	6.7	 6.4	б.з	6.7	7.4	7.1	б . З	5.7	5.7	л .9	6b 5.9	41 •	ω •	ω
		л •	л •	4 •	41 •		•		ი •	ი •	ი •	ი •	ი •	ი •	· 7.	7.	ი •	ი •	ი •	б. •	9 6.	∞ 5	94.	4 3.
	0 3.	3 4.	1 4.	9 3.	9 3.	1 4.	б 4 •	ю 5	N 5	ц 5.	ы 5 •	ω σ	1 6.	7 7.	4 8	ы С С	78.	0 7.	1 7.	37.	0 6.	о 	0 4.	94.
-	7		ц ц	9		4	<u></u>	<u> </u>	N	41		≥ 0.	л л.	0 7.	, 4 8.	4 9.	2 9.	. 6	7 9.	4 8.	8 7.	4ч Ю	о О	ი თ
												<u>о</u>	0 7	СО СО	9	5 10	9 10	4 9	ω Q	7 8.	2 7	∞ л	н л	N Л
												н Б	•1 6	.2 7	υ. 9	•1 9	.4 10	.9 10	.79	.9 .8	.2 7	•7	ò	÷
												ज	ັທ	.9	ů	•	б Ц	ώ μ	œ	.7	ц	თ • თ	4.7	4.8
												5.1	6.0	7.5	••	9.5	0.3 1	0.1 1	9.7	е В В В В В В В В В В В В В В В В В В В	7.0	ហ • ហ	ф. 5	4.7
												5.1	1 9	7.5	9.0	9.6	0.4	0.0	9.6	8 • 5	6.9	σ •	4 •4	4.6
						•						5.2	б. З	7.5	8 • 6	9.5	9.8	9.4	9.3	ю •5	6.7	л N	4 • 3	4.2
												5 .1	5.7	6 •	7.5	о Сл	.0	8.7	8 • 6	8.0	6.4	м О	4.0	ა . გ
		њ															A	uto z	CONE		0			
		1.0												1. 1.5 Page 12			the state of the second state of the			a martine and	(1			

P=====================================
CALA/Pro - ver 1.01
Analysis Area Number: 1
Comment: Food Lion, Harrima Statistics (fc):
Average: 6.60 M
Ave/Min: 3.56 M
Analysis Area Description:
Output scale (ft/inch): L
T
Orientation: 180 - T
Location of analysis points
The decimal of the respecti
L = Luminaire Location


-0

10.00 440.00 0.00 V 1-S ω .ω 2.7 2.9 ω • 5 3 3 • 8 0 ъ 2.5 ω.1 ω . ω 2.6 **2.2 3.0** 3 3 2 2 2 3 3 2 3 2 4 4 4 μ α α ω ω ω υ τ. α ω ω υ τ. ω μ. ω 4. ພ ພ ພ ພ • • • • ຜ ຜ ໑ ໑ 2.6 3.4 5.0 ÷ б. 5 7.6 7.6 6.9 · の . ÷ .4 iN 260.00 440.00 0.00 V Run Number: 4226 Analysis Points: 740 OC spacing (ft): 10.00 Man, TN - Front Parking Area Minimum: 1.86 Max/Min: 5.90 Maximum: 10.94 U.I.: 76 Left to right: 20.00 Top to bottom: 20.00 Tilt: 0 ive number. A = Luminaire Aiming Location _______

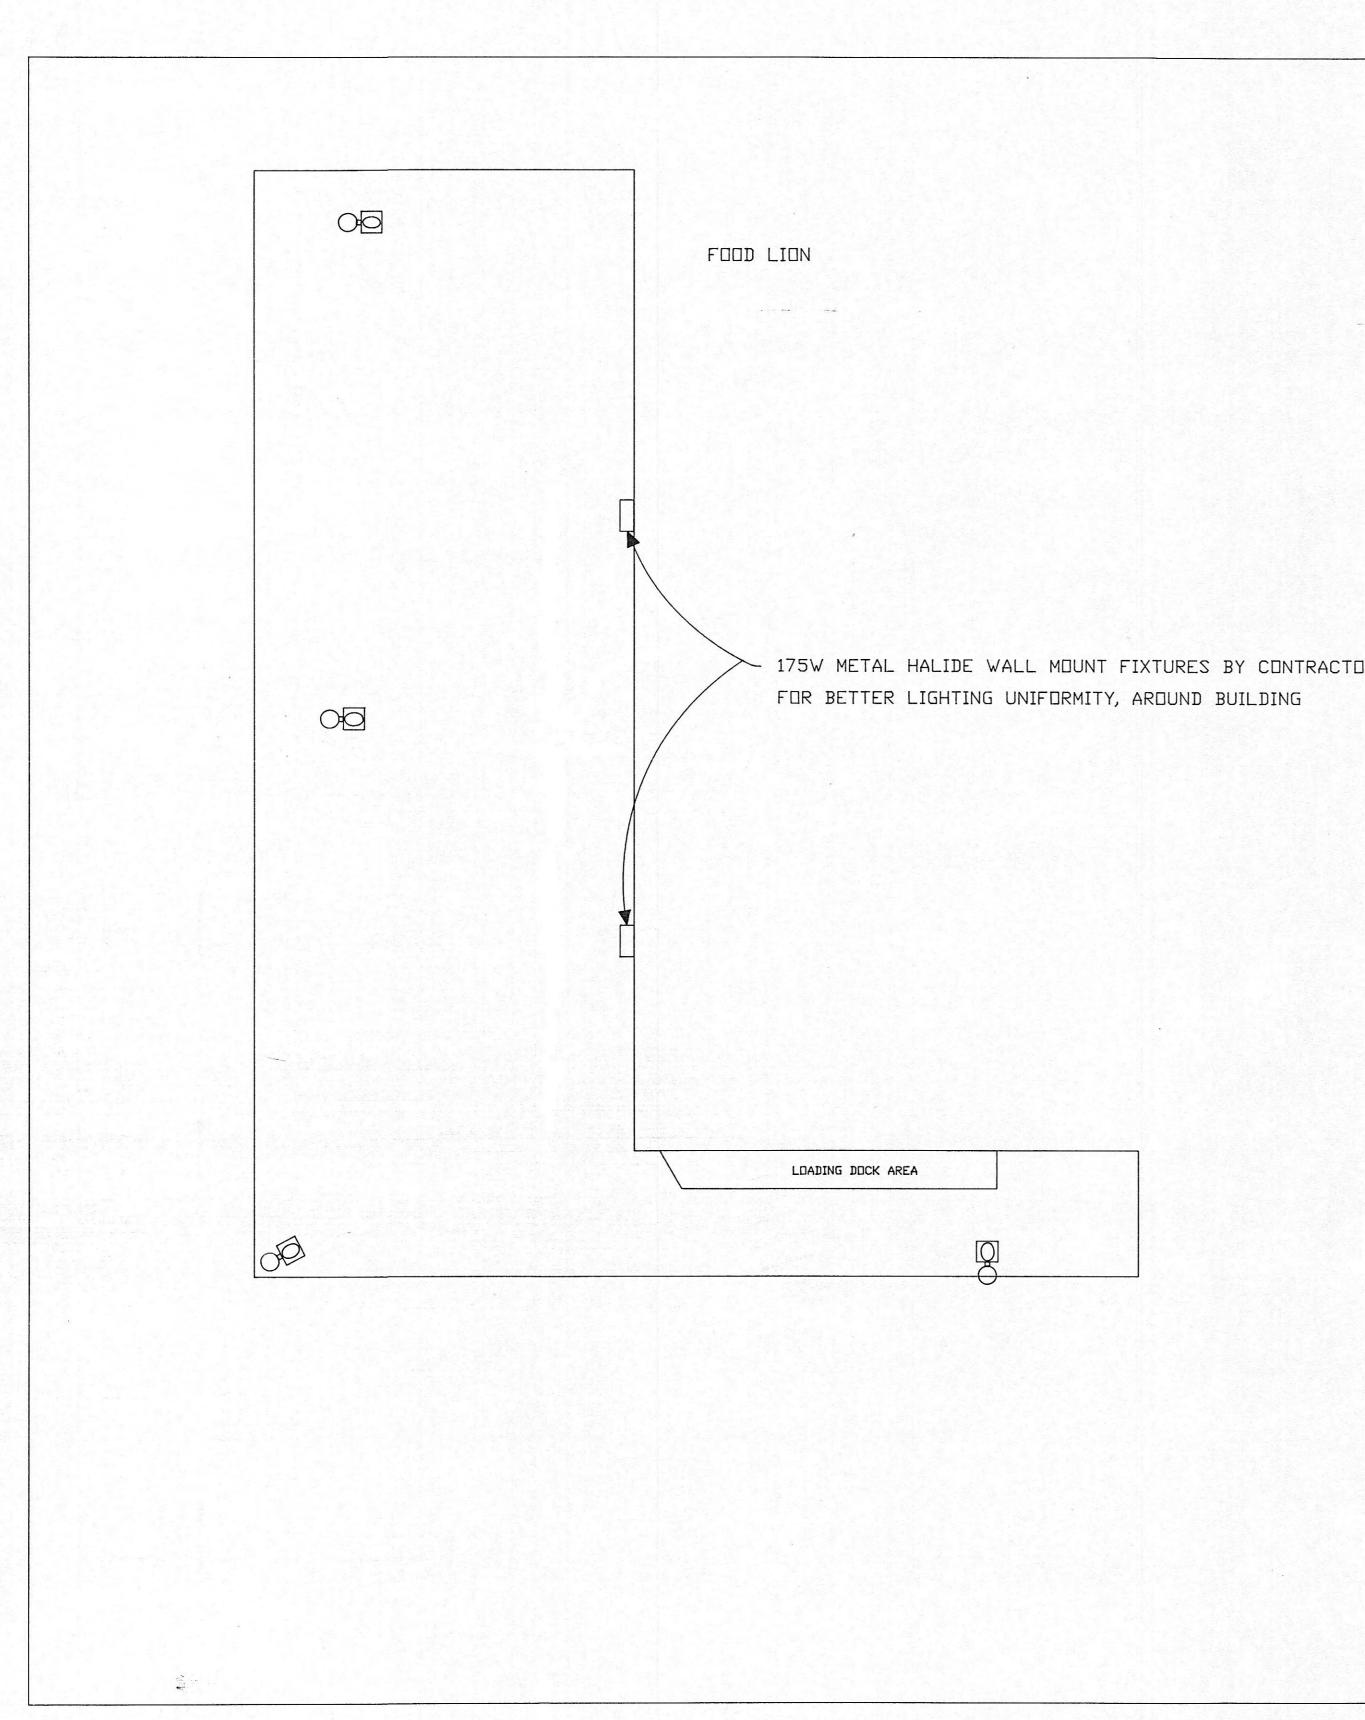

2.29	4.21	6.82	4.97	1.78	0.84	0.52								
2,30	C 4.22	6.83	4.98	1.79	0.85	0.53	0,25			FD	JD LI	DN		
2.00	3.46	6,71	4,80	1.81	0.76	0.40	0.20							
1.29	2.20	3.60	3.40	1,35	0,66	0.33	0.16							
0,84	1.25	261	2.88	1,47	0.61	0.31	0.16							
1.62	0.86	2.56	3,48	2.27	0.81	0,28	0,16							
1,57	0.95	2.30	3.65	2.77	0.75	0.33	0.18							
1.72	1.08	2.50	3,66	2.13	0.74	0.29	0.17							
1.00	160	3,01	3.16	160	0.67	0.33	0.17							
1.58	2.79	5.17	5.11	1.84	0.78	0.39	0.18							
2.12	4.11	7.89	5.94	2.21	0.89	0,49	0.23							
2.15	4.12 🖸	7.14	6.04	1.97	0.98	0.57	0.25							
2.09	3.90	7,95	5.92	2.16	0,84	0.46	0.21							
1.51	2.57	4,48	4.58	1.57	0.64	0,32	0,17							
L14	141	2.67	2.99	1.22	0.47	0.25	0.15							
1,13	1.00	213	2.90	1.41	0.53	0.22	0.15							
L,56	0.86	125	SOS	1.68	0.45	0,21	0.15							
2.28	102	0.84	1.17	0.92	0,49	0.23	810							
2.87	144	0.84	0.75	0.62	0.49	0.32	0.31							
3.75	3.25	1.46	0.87	0.72	0.47	0.37	0.46							
5.38	6.01	2.61	1.16	9.82	0.49	0.37	0.56	1.01	1.62	2.07	1.90	2.80	3.55	3.69
5.11	7.98	4.42	175	0.83	0.44	0.34	8.43	0,72	143	2.02	2.25	3.60	6.03	613
E) 132	7.52	6.63	2.82	0.91	0.43	0.28	0,29	0.43	8.74	1.04	1.48	2.55	4.00	4.33 🕞

				hand the second second
			방법에 눈 있었다	
3.69 3.55 2.79				
6.13 6.02 3,60				
4.33 4.00 2.54				
	1. INSTALL 400W METAL HALID	E, GE DECASHIELD DR SIMILIAR TO	EXISTING POLES	
		ING FIXTURES TO BE DETERMINED E		
		FOOD LION		
	STALE S	TREET SIDE PARKING	1	
		MAN UTILITY BOARD		
		TARDA CITETILI DUARD		
		CUSTOMER SERVICE	UENIER	
	IENNESS	EE VALLEY AUTHORI	ΙΥ	
	DESIGNED BY ISEC	NOT TO SCALE		
	DRAWN BY I SEC	DATE 1		
	L			
••				

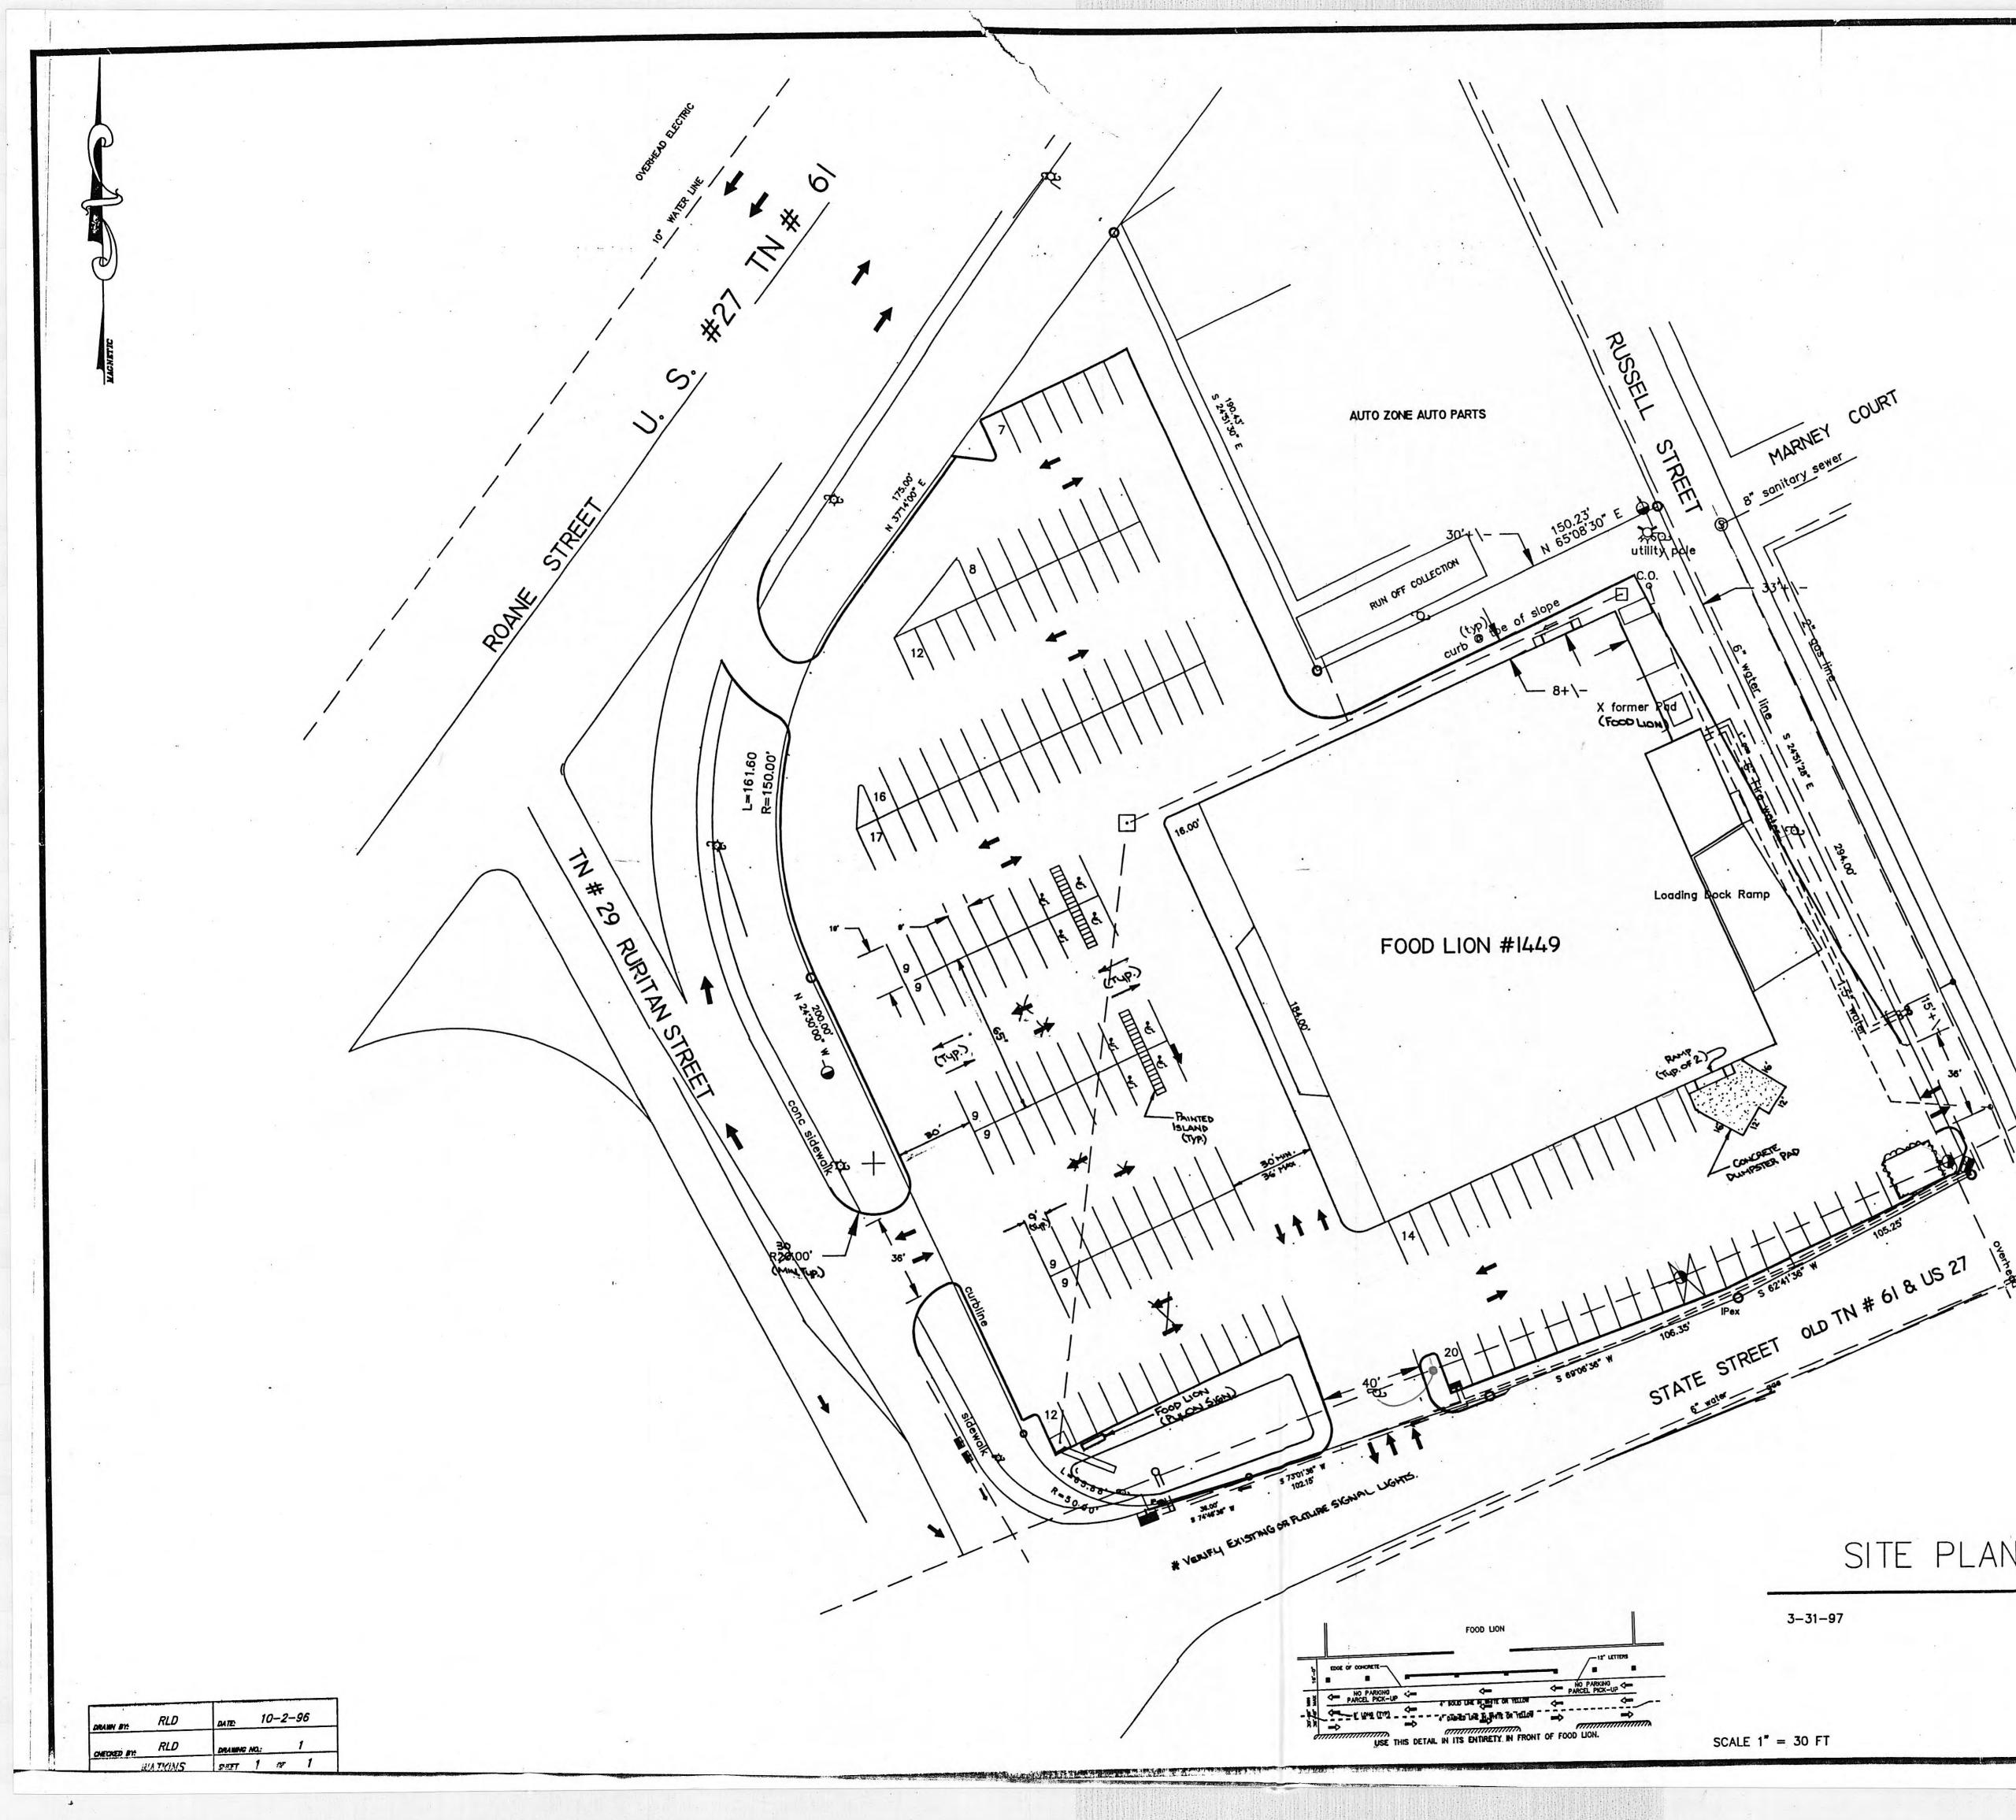



APPROVED AS NOTED FOOD LION, INC. Checked By May . MI Data: 4-8-91

Note:

- PROVIDE A LEGEND FOR GLA & PARKING RATIOS.

- SHOW COMPLETE METES & BOUNDS.
- SHOW MCINITY MAP QUATER OF A MILE RADIUS MIN.

IMPORTANT NOTE:

-RESTRICTED SITE, PARKING SCARCE DIRECTLY IN FRONT OF FOOD LION.

. .

NO FUTURE EXPANSION THIS SITE.

SITE PLAN #1449

FOOD LION MODEL 29-97


U.S. # 27 & TN # 29

SOUTH HARRIMAN COMMUNITY

ROANE STREET, HARRIMAN


IST CIVIL DISTRICT ROANE COUNTY TN


1449

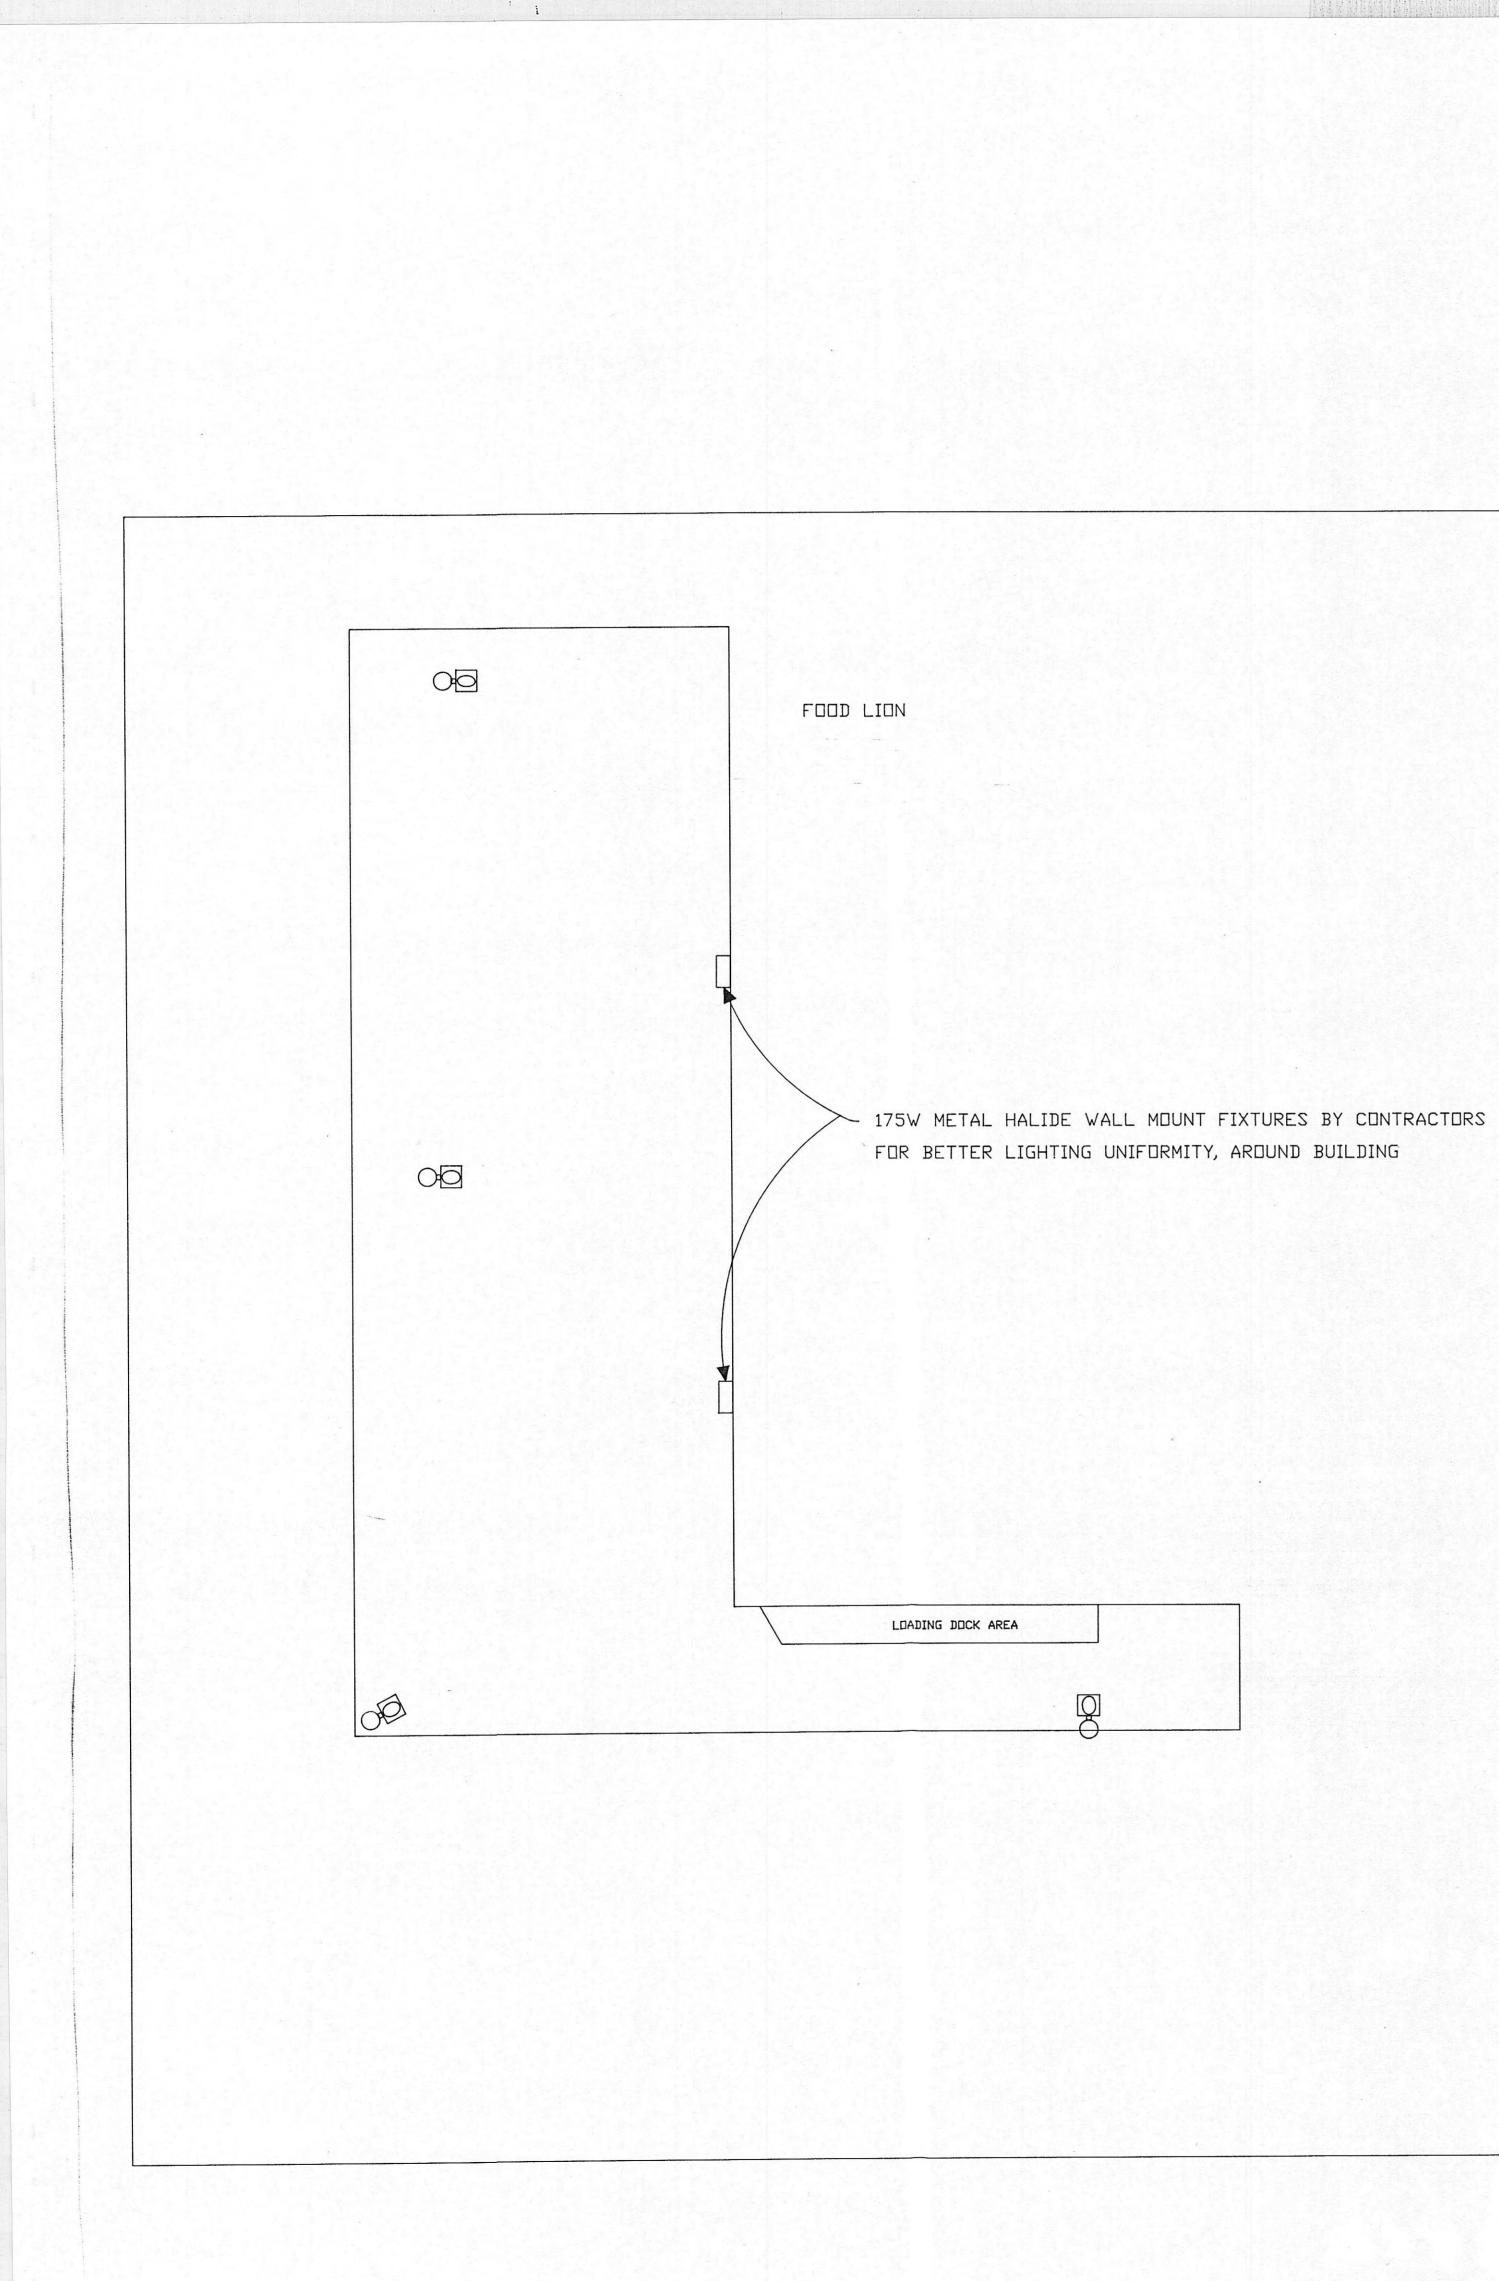


29	4.21	6.82	4.97	1.78	0.84	0.52	0.25							
.30	4.22	6.83	4.98	1.79	0.85	0.53	0.25			FDD	D LIC]N		
.00	3.46	6.71	4.80	1.81	0.76	0.40	0.20							
29	2.20	3.60	3.40	1.35	0,66	0.33	0.16							
.84	1.25	2.61	2.88	1.47	0.61	0.31	0,16							
.62	0.86	2.56	3.48	2.27	0.81	0,28	0.16							
.57	0.95	230	3.65	2.77	0.75	0,33	0.18							
.72	1.08	2.50	3.66	213	0.74	0.29	0.17							
.00	160	3.01	3.16	1.60	0.67	0,33	0.17							
.58	2.79	5.17	5.11	1,84	0.78	0.39	0.18							
2.12	4.11	7.89	5.94	2.21	0,89	0,49	0.23							
2.15	4.12 🖸	7.14	6.04	1.97	0.98	0.57	0.25							
2.09	3.90	7.95	5.92	2.16	0.84	0.46	0.21							
.51	2,57	4.48	4,58	1,57	0.64	0,32	0,17							
.14	L41	2.67	2.99	1.22	0.47	0.25	0.15							
.13	1.00	213	2.90	1.41	0.53	0.22	015							
L.56	0.86	125	202	1.68	0.45	0,21	0.15							
2,28	102	0.84	1.17	0.92	0.49	0.23	810							
2.87	144	0.84	0.75	0.62	0.49	0.32	0.31							
3.75	3.25	146	0.87	0.72	0.47	0,37	0.46							
6.38	6.01	2.61	1.16	0.82	0.49	0.37	0.56	1.01	1,62	2.07	1.90	2.80	3.55	3.6
5.11	7.98	4.42	175	0.83	0.44	0.34	0.43	0.72	143	2.02	2.25	3.60	6.03	6.1:
Ð														

¥		
3.69 3.55 2.79 5.13 6.02 3.60		
<u>4.33 4.00 2.54</u>		
	INSTALL 400W METAL HALIDE, GE DECASHIELD OR SIMILIAR TO EXISTING POLES EXACT LOCATION OF LIGHTING FIXTURES TO BE DETERMINED BY UTILITY. FOOD LION	
	STATE STREET SIDE PARKING HARRIMAN UTILITY BOARD	
	KNOXVILLE CUSTOMER SERVICE CENTER TENNESSEE VALLEY AUTHORITY DESIGNED BY (SEC NOT TO SCALE	
	DESIGNED BY ISEC NOT TO SCALE DRAWN BY I SEC DATE I	

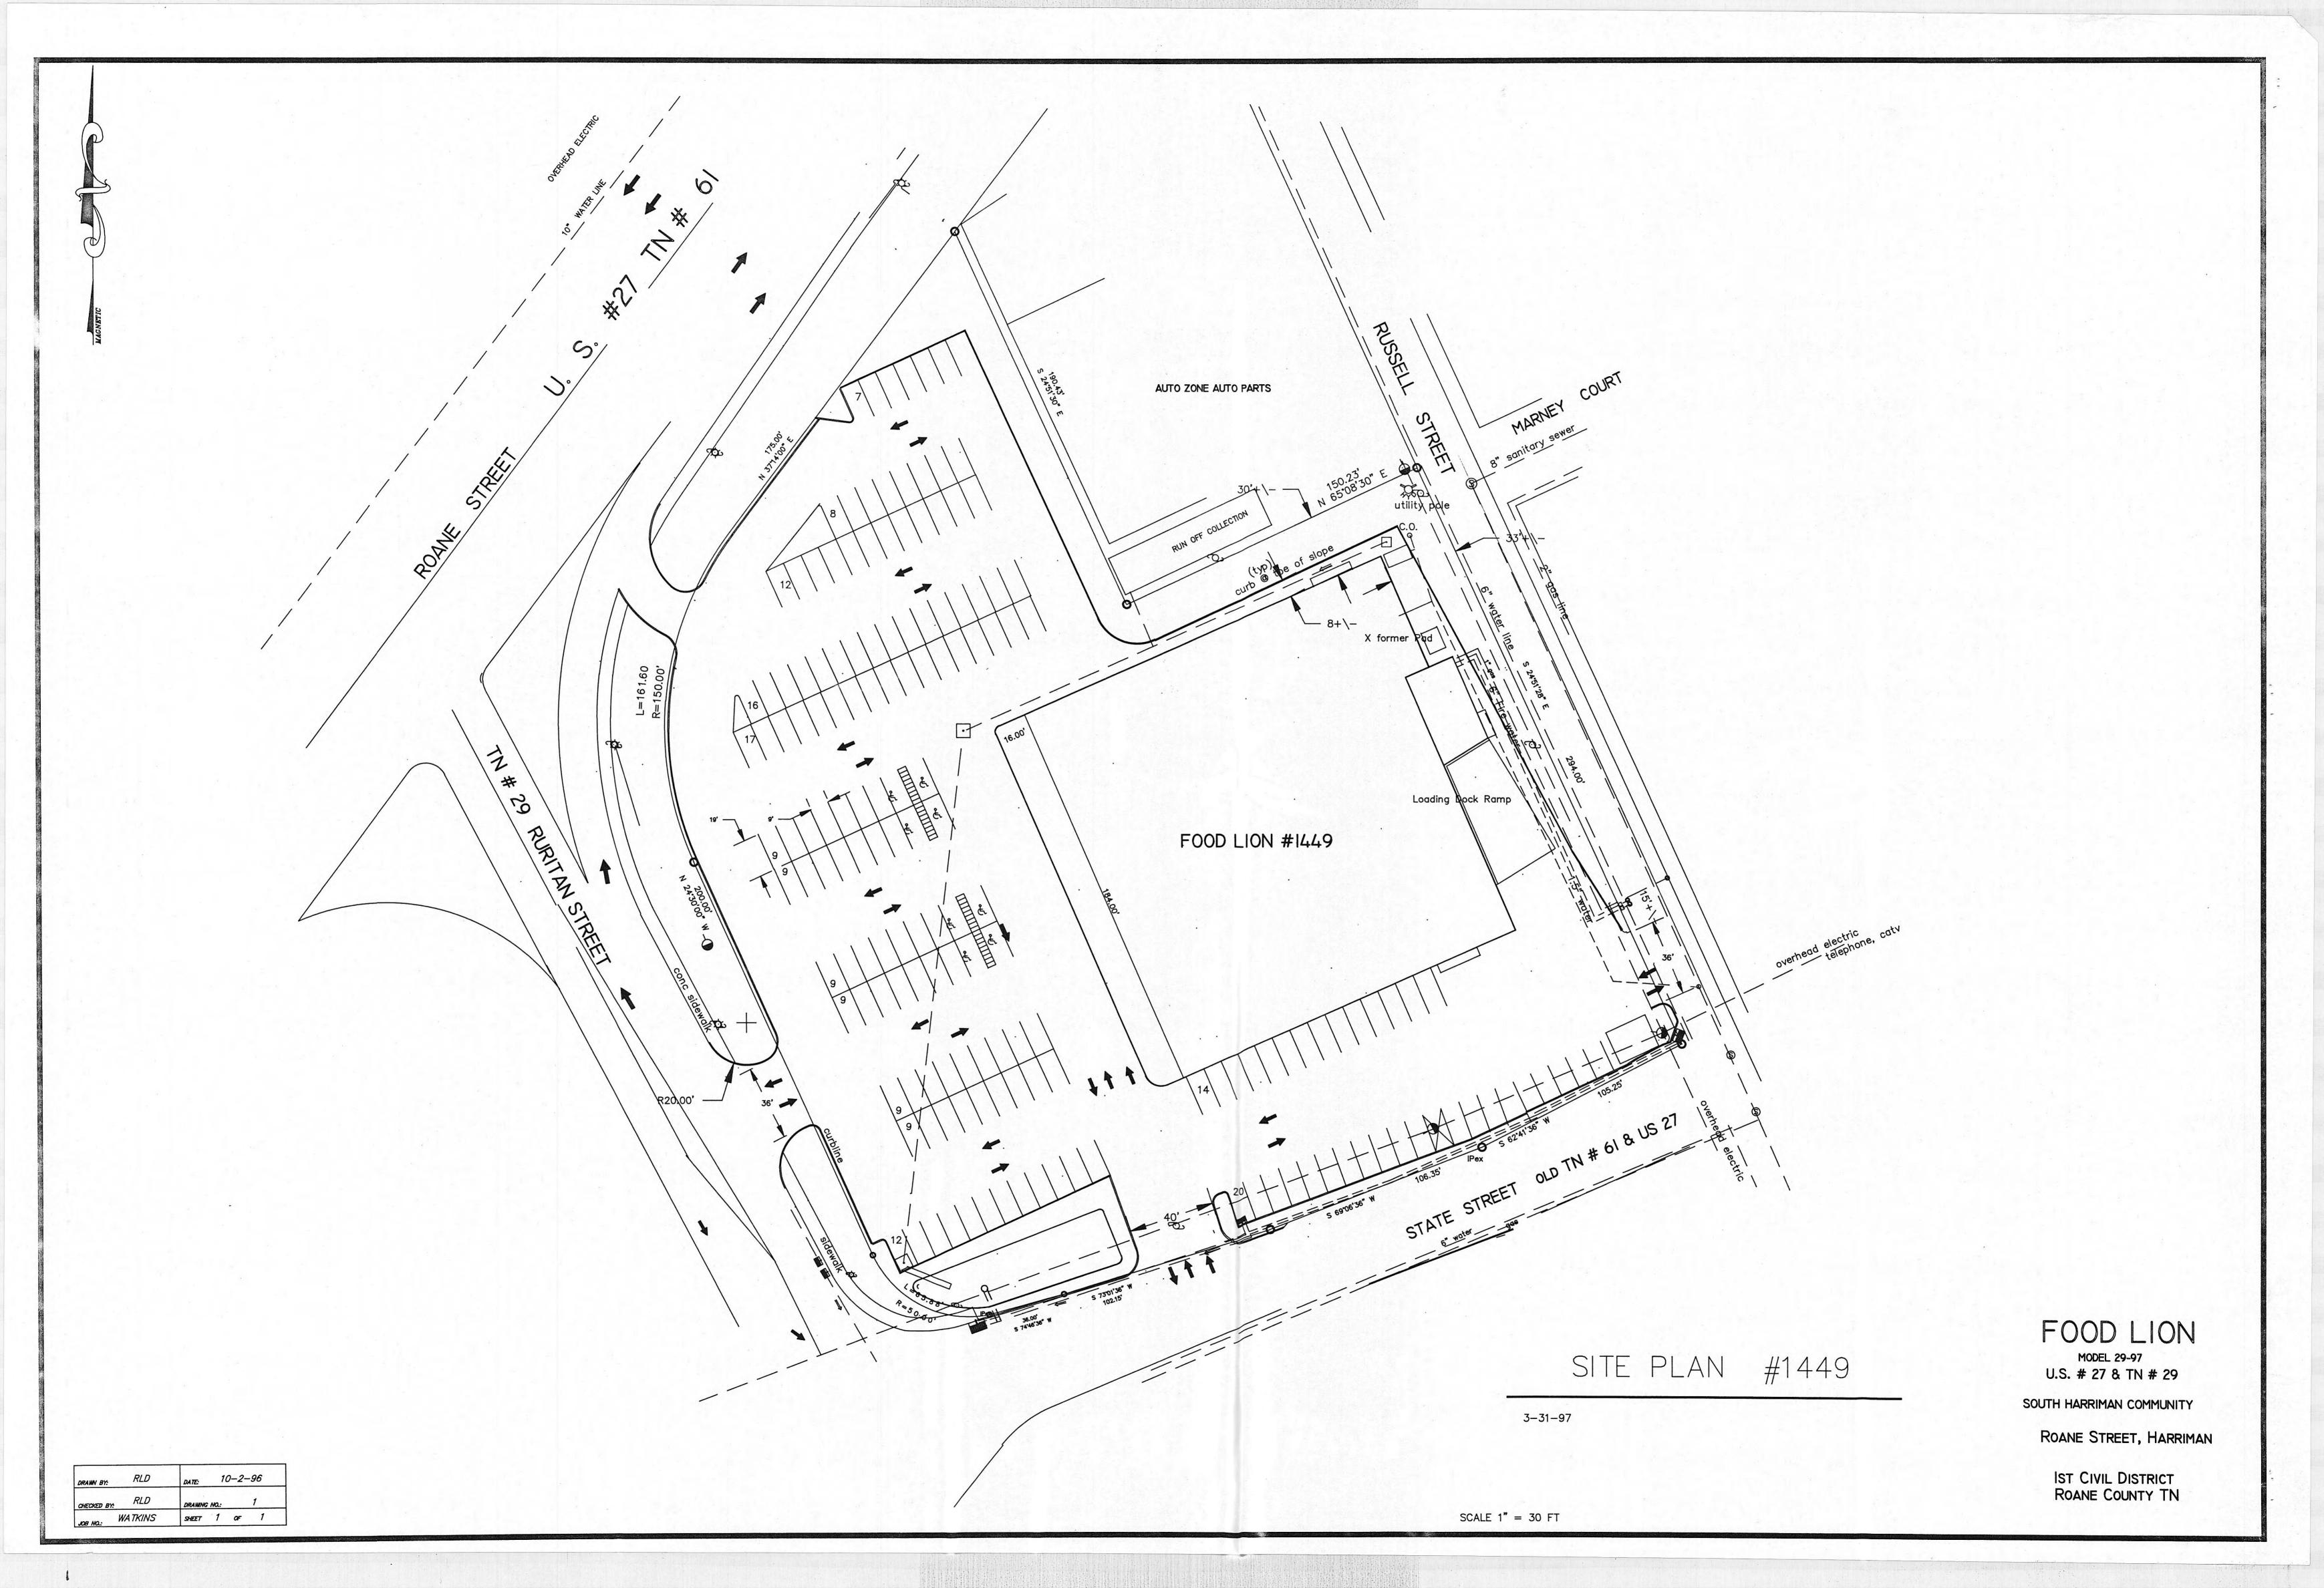

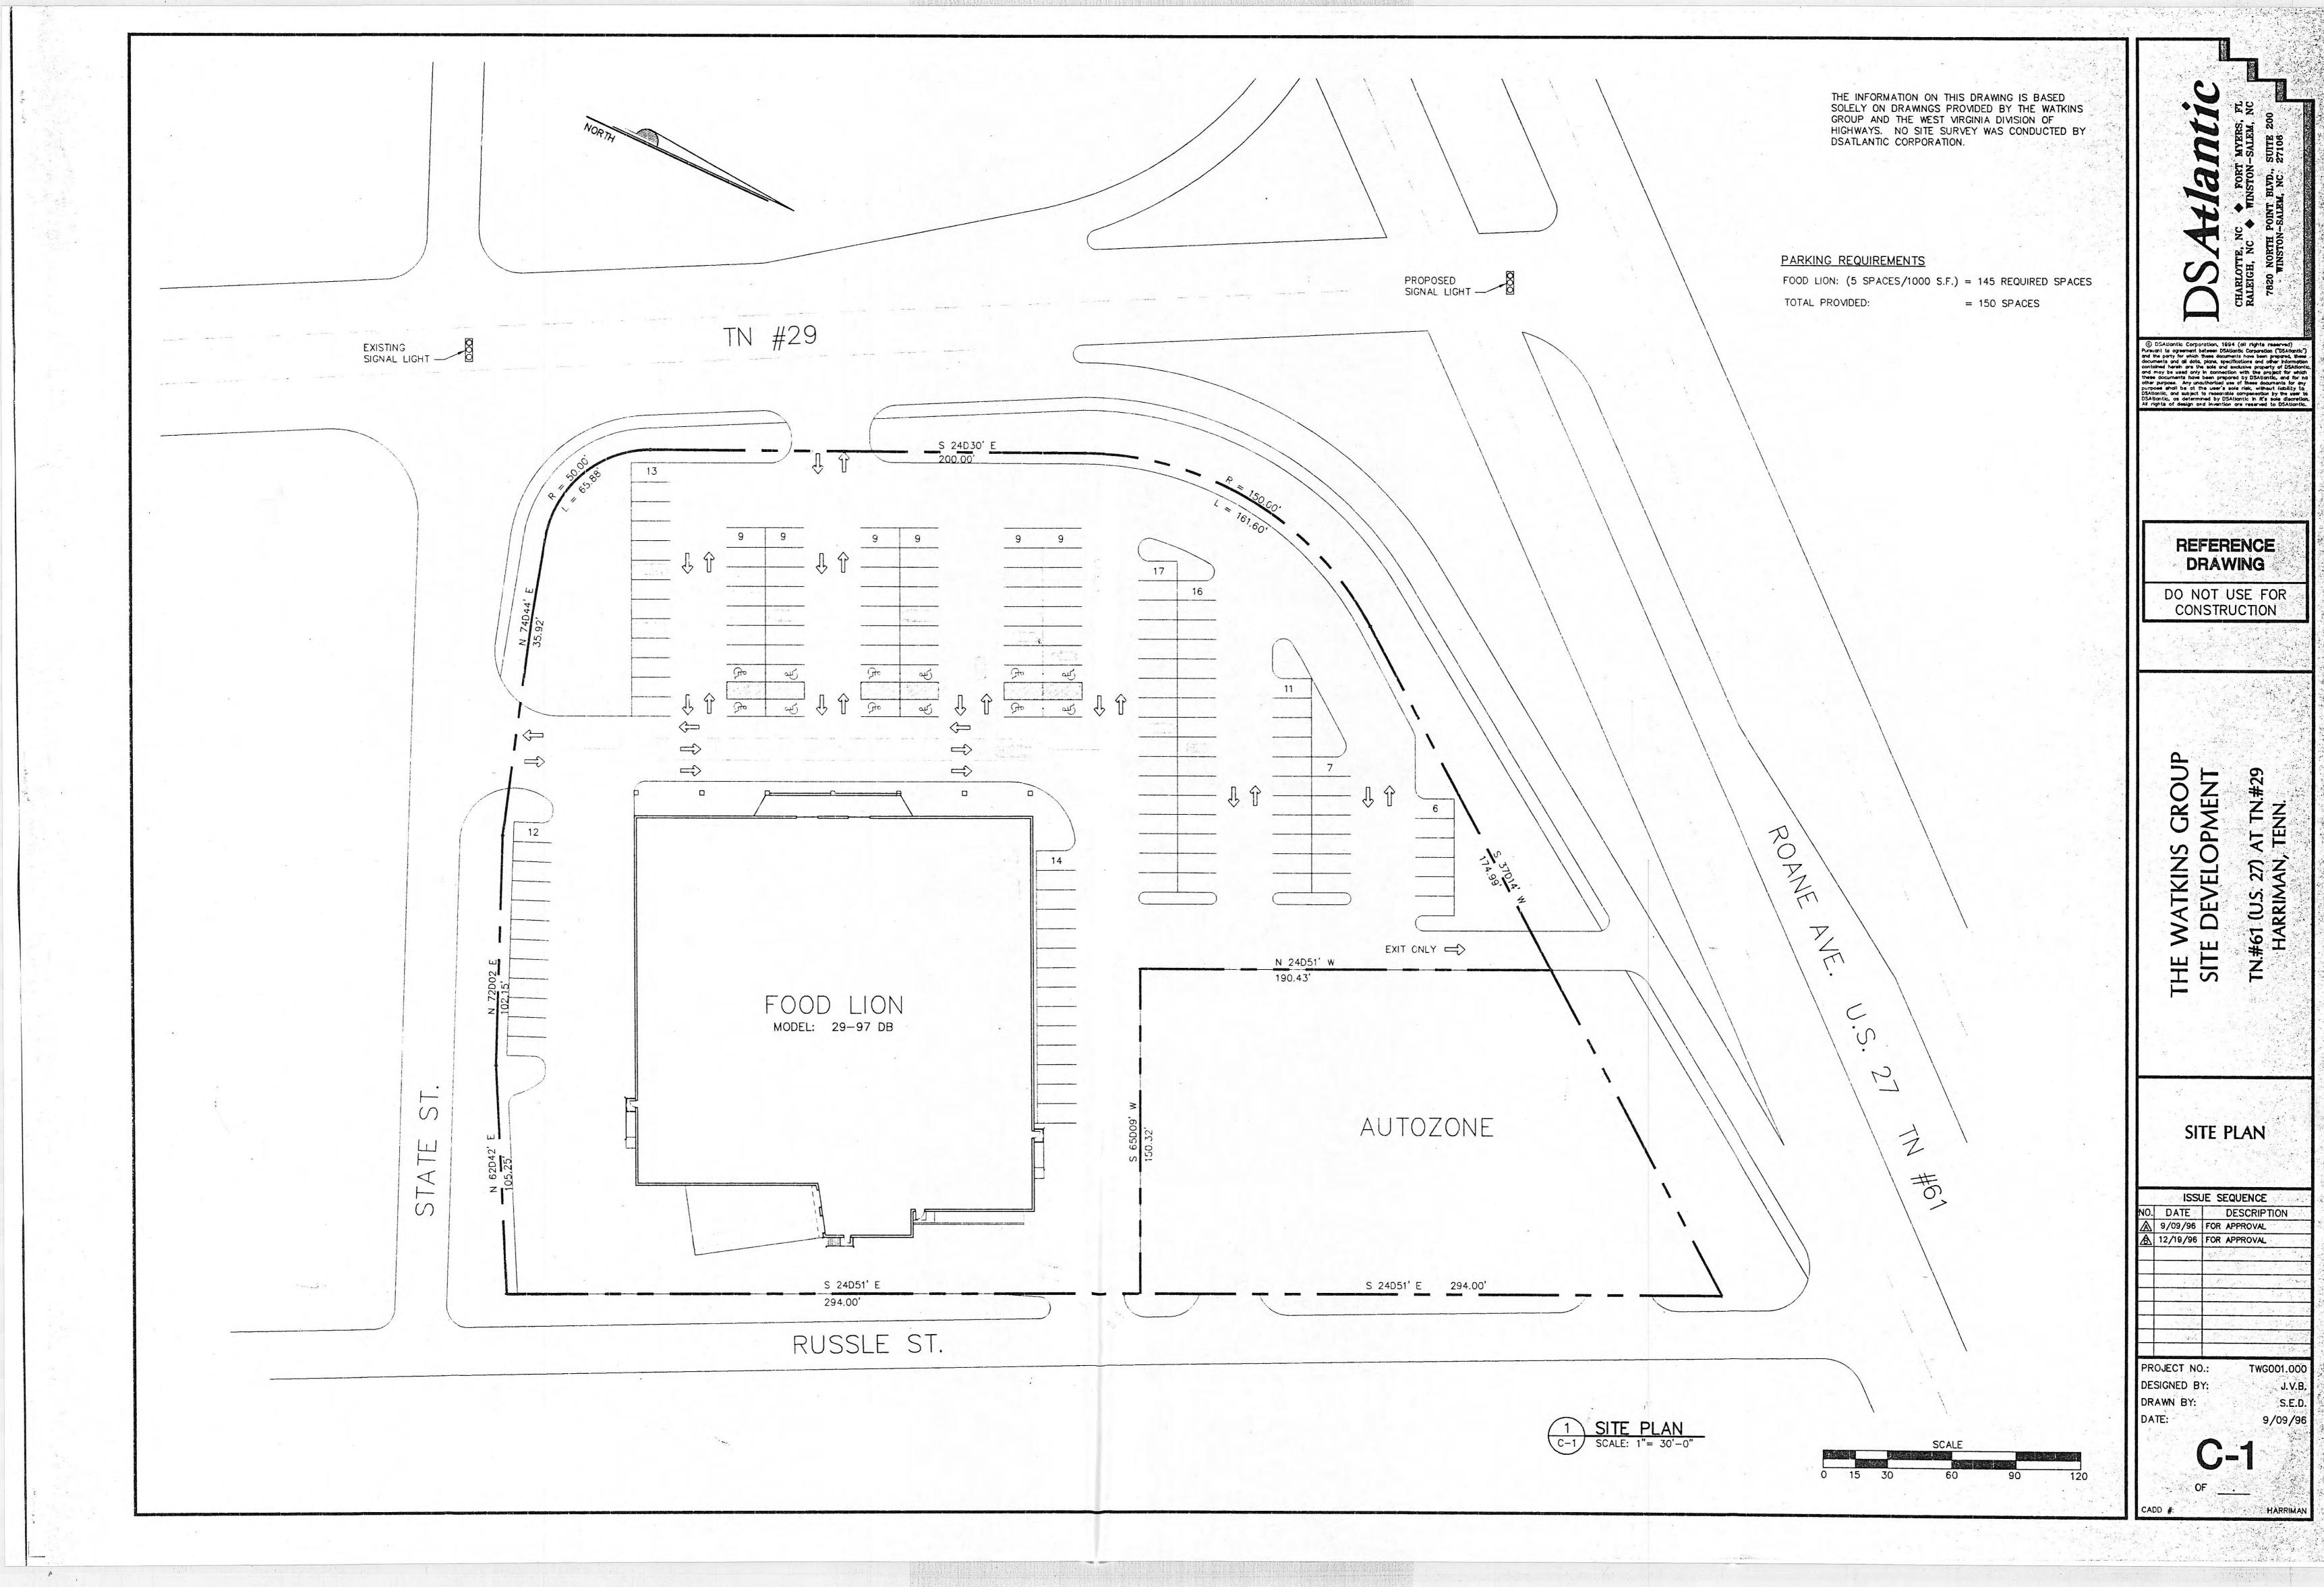

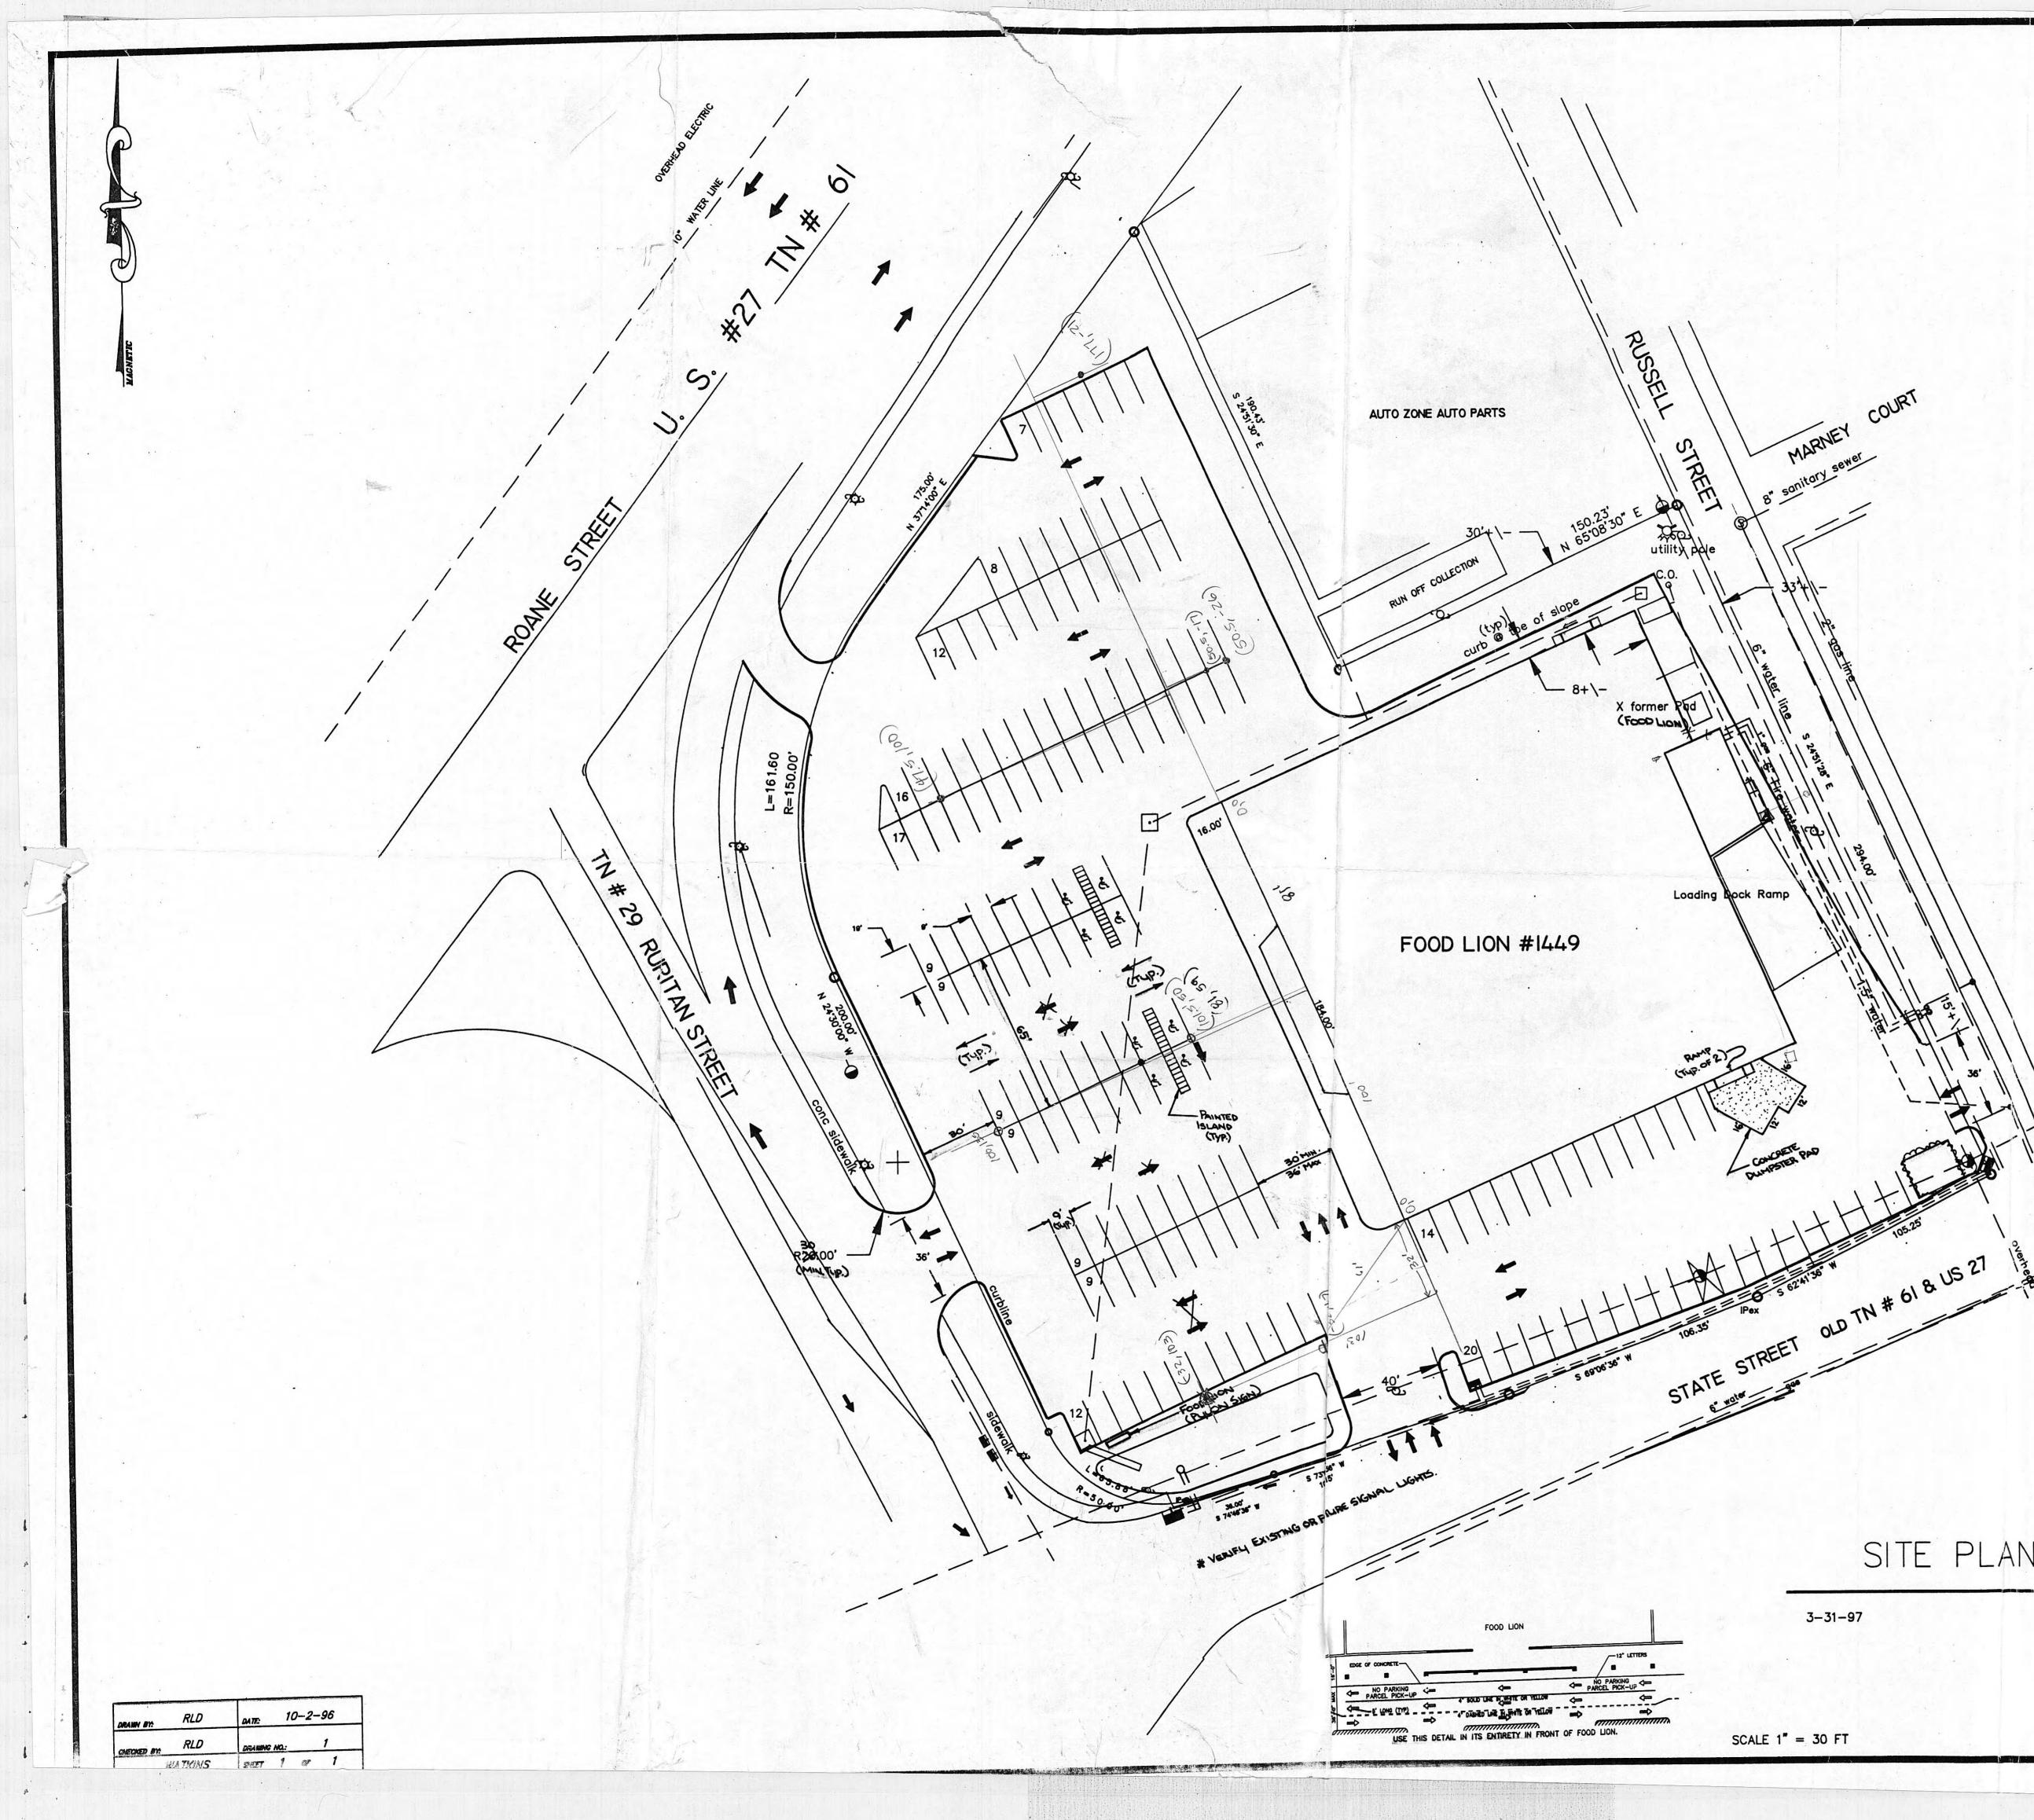



Dela: 4-8-97

APPROVED AS NOTED FOOD LION, INC. head electric catv Choched By la

NOTE: - PROVIDE A LEGEND FOR GLA & PARKING RATIOS. - SHOW COMPLETE HETES & BOUNDS. - SHOW MCINITY MAP - QUATER OF A MILE RADIUS MIN.

> IMPORTANT NOTE: -RESTRICTED SITE, PARKING SCARCE DIRECTLY IN FRONT OF FOOD LION. NO FUTURE EXPANSION THIS SITE.

SITE PLAN #1449

T-it-

FOOD LION

MODEL 29-97 U.S. # 27 & TN # 29

SOUTH HARRIMAN COMMUNITY

ROANE STREET, HARRIMAN

IST CIVIL DISTRICT ROANE COUNTY TN # 1449