


MAYS PUMP STATION IMPROVEMENTS AND SEWER REHABILITATION

CITY OF HARRIMAN, TENNESSEE

CONTRACT NO. S11-01
CDBG PROJECT # GG-11-34964-00

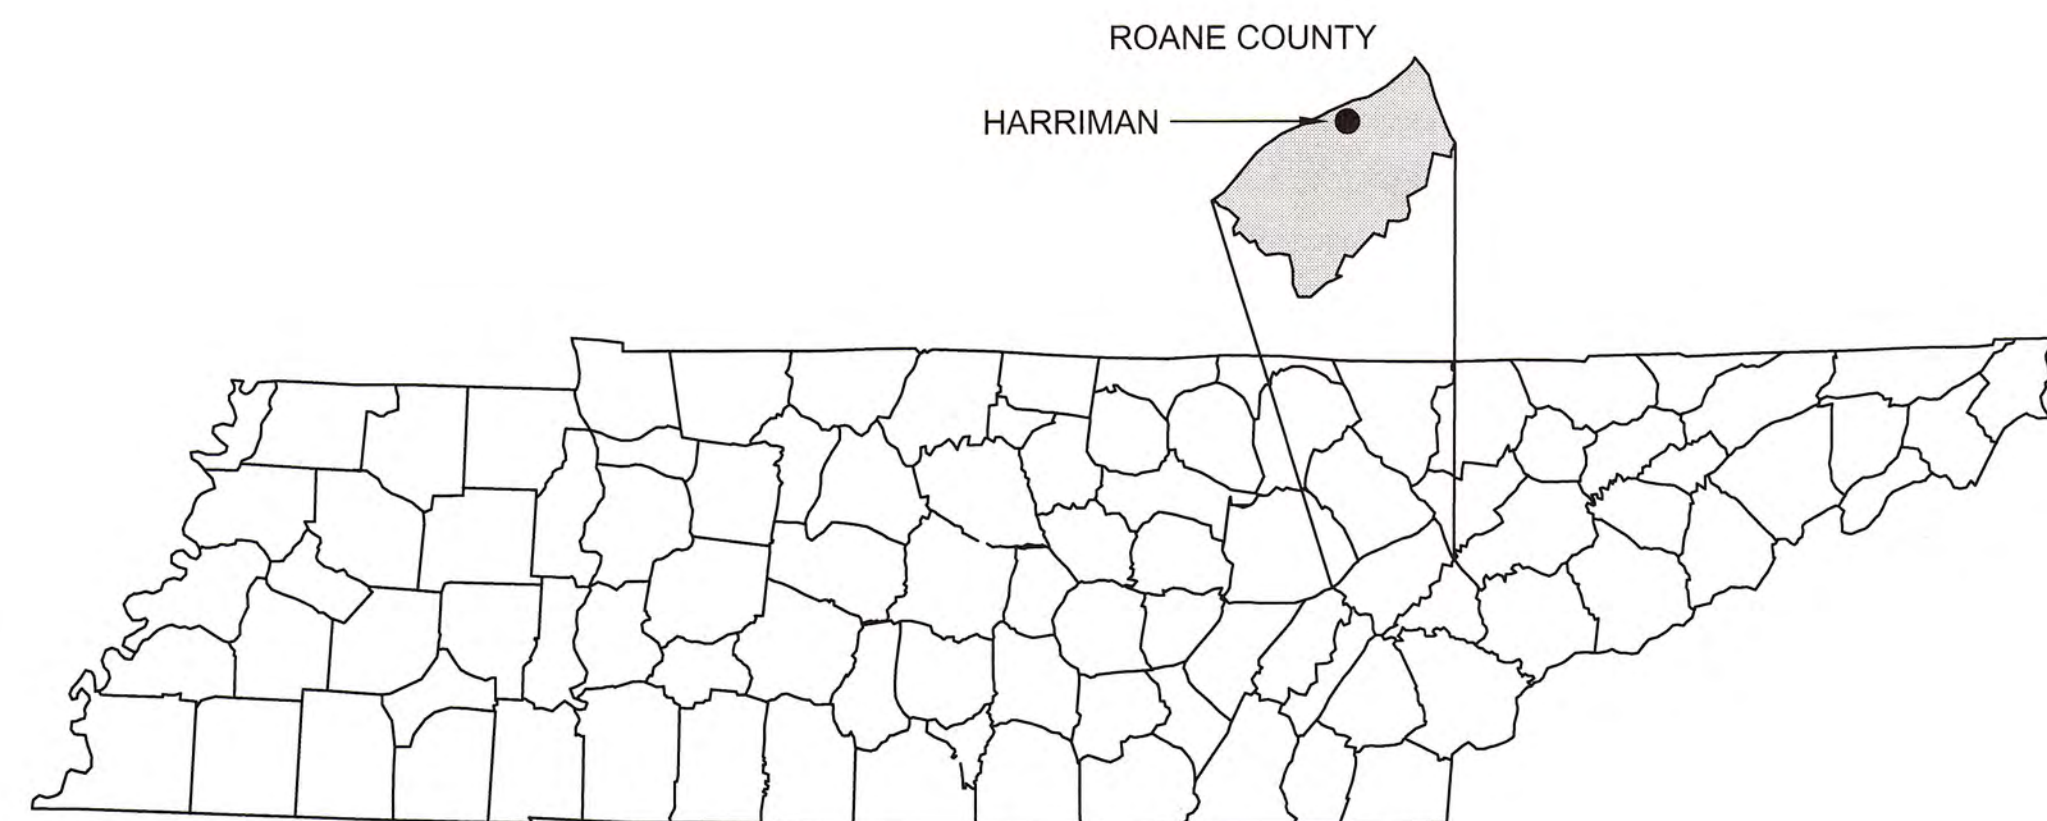


ENGINEERS - ARCHITECTS - PLANNERS

www.grwinc.com

DWG. No.	INDEX OF DRAWINGS
G-0-001 -	COUNTY AND LOCATION MAPS
C-0-102 -	SEWER SYSTEM REHABILITATION PLANS
C-1-103 -	NEW W.A.S. PUMP STATION - PLANS AND SECTIONS
C-0-504 -	STANDARD DETAILS
C-0-505 -	STANDARD FORCE MAIN DETAILS
E-1 -	PUMP STATION SITE PLAN - ELECTRICAL

THIS RECORD DOCUMENT HAS BEEN PREPARED BASED ON INFORMATION PROVIDED BY THE CONSTRUCTION CONTRACTOR. GRW ENGINEERS, INC. HAS ATTEMPTED TO VERIFY THE ACCURACY AND/OR COMPLETENESS OF THIS INFORMATION BUT SHALL NOT BE RESPONSIBLE FOR ANY ERRORS OR OMISSIONS WHICH MAY BE INCORPORATED HEREIN AS A RESULT.



GRW Engineers, Inc.
Engineers, Architects, Planners
1000 North Main Street, Suite 200
Harriman, Tennessee 37057
Phone: 615.881.1111
Fax: 615.881.1112
Email: info@grwinc.com

ENGINEER'S REPRESENTATIVE: *B. Morris*
CONSTRUCTION COMPANY: *PORTLAND UTILITIES CONST. CO.*
DATE: *3/22/2012*

MAY, 2011

GRW PROJECT NO. 3947-02

- 1) LOCATION OF EXISTING POLE MOUNTED TRANSFORMER BANK TO BE REMOVED AFTER NEW PUMP STATION SERVICE IS INSTALLED COMPLETE. MAINTAIN ONE 240V TRANSFORMER FOR LIGHTING CIRCUIT.
- 2) EXISTING OVERHEAD SECONDARY SERVICE TO BE REMOVED AFTER NEW PUMP STATION IS OPERATIONAL.
- 3) LOCATION OF NEW 480V POLE MOUNTED TRANSFORMER BANK INSTALLED BY UTILITY COMPANY.
- 4) NEW OVERHEAD SECONDARY SERVICE TO RISER POLE. SEE FEEDER DIAGRAM.
- 5) NEW SERVICE DISCONNECT AND METER BASE ON EXISTING RISER POLE. PROVIDE ADDITIONAL 200A UNFUSED NEMA 4XSS DISCONNECT ON LINE SIDE OF RISER IF REQUIRED BY UTILITY COMPANY.
- 6) NEW UNDERGROUND SECONDARY SERVICE. SEE FEEDER DIAGRAM. BOTTOM FINISH OF 36" DEEP WITH MARKER AT 12" BELOW FINISHED GRADE. PROVIDE 4" OF ROCK FILLING IN BURRY OF DISCONNECT.

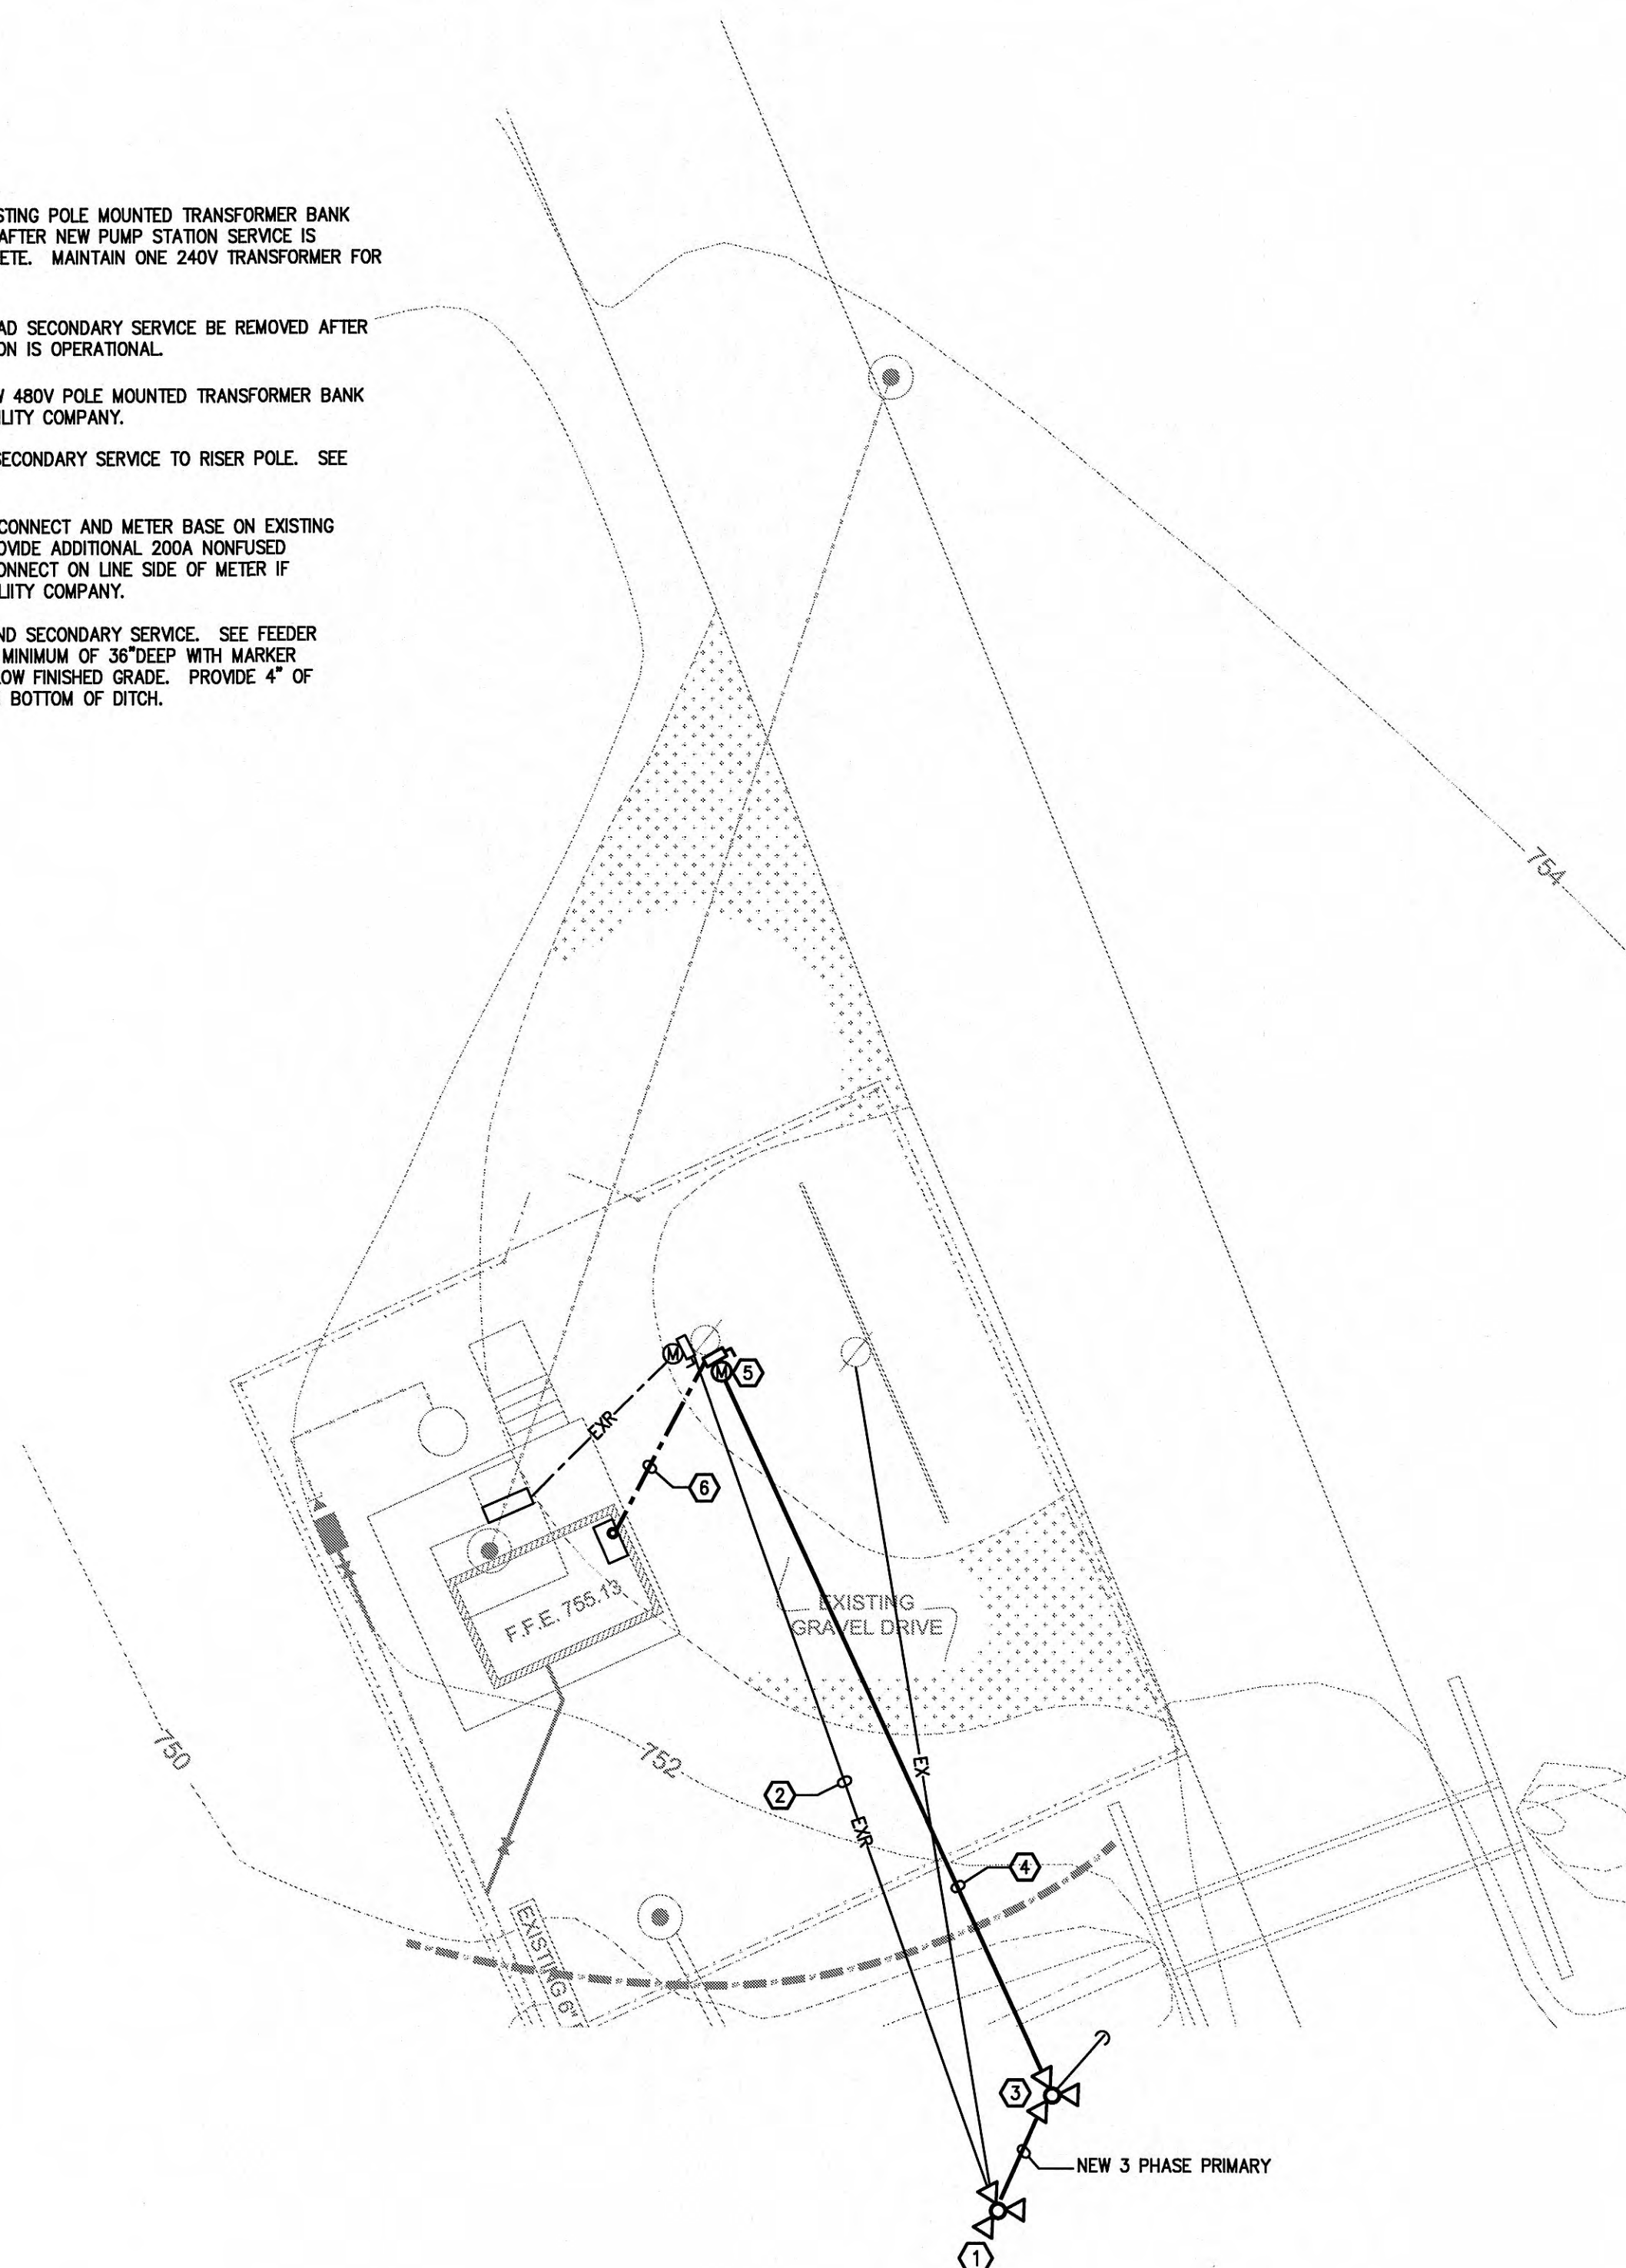

SCALE: 1" = 10'

1. THE ELECTRICAL CONTRACT WORK SHALL INCLUDE ALL ELECTRICAL MATERIALS AND INSTALLATION TO RESULT IN A BUILDING READY AND SUITABLE FOR USE AS INTENDED BY OWNER. THE CONTRACTOR SHALL REFER TO ALL PLANS INCLUDING THE SITE, ARCHITECTURAL, AND MECHANICAL PLANS.

1.2 ALL ELECTRICAL INSTALLATIONS SHALL BE MADE IN ACCORDANCE WITH THE LATEST EDITION OF THE NATIONAL ELECTRICAL CODE AND ITS SUPPLEMENTS IN FORCE AT THE TIME OF BIDDING, AND ALL MATERIALS EMPLOYED SHALL BE UL LISTED, APPROVED AND BEAR THE UL FACTORY LABELS WHERE SUCH LABELING IS CUSTOMARY. IN THE EVENT THAT LOCAL CODES ARE MORE RIGID THAN THE NATIONAL CODE, BOTH CODES SHALL THEN BE CONSIDERED AS JOINTLY GOVERNING AND THE REQUIREMENTS OF THE MOST RIGID SHALL THEN PREVAIL. THE CONTRACTOR SHALL BE RESPONSIBLE FOR THE PROPER SELECTION AND APPLICATION OF MATERIALS AND METHODS OF THEIR INSTALLATION. PRINCIPAL FEATURES ARE AS FOLLOWS:

A. SERVICE ENTRANCE TO NEW PUMP STATION

1.3 POWER SERVICE

A. POWER SERVICE SHALL BE 277/480-VOLTS, 3-PHASE, 4-WIRE. CONTRACTOR SHALL CONSULT WITH THE LOCAL POWER UTILITY AND COMPLY WITH ALL THEIR INSTRUCTIONS. CONTRACTOR SHALL BE RESPONSIBLE FOR PAYING ALL FEES AND CONSTRUCTION CONTRIBUTIONS REQUIRED BY THE POWER AND TELEPHONE COMPANIES.

1.4 DISTRIBUTION EQUIPMENT

A. DISTRIBUTION EQUIPMENT AND BRANCH CIRCUIT PANELBOARDS SHALL BE MOLDED CASE CIRCUIT BREAKER EQUIPMENT HAVING THE NECESSARY INTERRUPTING RATINGS BUT NOT LESS THAN 10,000 AIC. GROUND FAULT SENSING AND AUTOMATIC INTERRUPTING SHALL BE FURNISHED ON ANY OUTDOOR POWER CIRCUITS AND AS OTHERWISE REQUIRED. EQUIPMENT SHALL BE SQUARE-D OR EQUAL.

1.5 GROUNDING

A. PROVIDE CODE GROUNDING FOR ANY SYSTEM ADDITIONS.

1.6 TYPES OF WIRING AND RACEWAYS

A. THE TYPES AND GRADES OF MATERIALS TO BE EMPLOYED IN THE WIRING SYSTEMS ARE SUBJECT TO BUILDING STRUCTURAL CONDITIONS AND THE GOVERNING CODES. THE WIRING SHALL BE GALVANIZED CONDUIT AND GALVANIZED STEEL AND DEVICE BOXES. ALL CONDUCTORS SHALL BE COPPER.

B. UNLESS PARTICULARLY STATED OTHERWISE, ALL WIRING SHALL BE RUN CONCEALED AND OUTLETS SHALL BE FLUSH MOUNTED IN WALLS AND CEILINGS.

C. ALL CONDUITS INSTALLED UNDERGROUND, IN CONCRETE SLABS, OR EXTERIOR OF BUILDINGS, MAY BE PLASTIC "PVC" EXCEPT WHEN EXPOSED, THEY SHALL BE SUITABLE GALVANIZED STEEL.

D. WIRING SYSTEMS WITH OUTLET DEVICES AND BOXES, SHALL BE GROUNDED AS REQUIRED BY THE GOVERNING CODES.

1.7 MATERIALS

A. BASIC MATERIALS AND DEVICES REQUIRED IN THE WIRING SYSTEMS SHALL BE UL APPROVED STANDARDS. IN THE EVENT THAT UL STANDARD IS REVISED, SUPPLEMENTED, OR MODIFIED, ETC., THE LATEST REQUIREMENTS SHALL THEN GOVERN.

B. AT THE REQUEST OF THE OWNER OR HIS DESIGNATED REPRESENTATIVE, THE CONTRACTOR SHALL SUBMIT A LIST OF MATERIALS PROPOSED TO BE USED IN THE CONSTRUCTION OR PROVIDE SAMPLES, ETC., FULLY ESTABLISHING THE TYPE, GRADE, AND QUALITY OF EACH DEVICE OR ITEM OF MATERIAL. THE CONTRACTOR SHALL BE RESPONSIBLE FOR INSTALLING ONLY SUCH DEVICES AND MATERIALS AS OBVIOUSLY MEET GOVERNING REQUIREMENTS.

1.8 WORK QUALITY


A. ALL ELECTRICAL WORK SHALL BE SPECIFIED TO BE PERFORMED IN A WORKMANLIKE AND PROFESSIONAL MANNER BY WORKMEN SKILLED IN THE TRADE REQUIRED. THE WORK SHALL RESULT IN A FINISHED AND OPERATING SYSTEM.

1.9 GUARANTEE

A. THE ELECTRICAL CONTRACTOR SHALL GUARANTEE ALL WORK TO BE FREE OF GROUNDS AND SHORT CIRCUITS AND SHALL REPAIR OR REPLACE ALL DEFECTIVE WORK WITHIN A PERIOD OF ONE YEAR AFTER ACCEPTANCE BY THE OWNER.

1.10 CODES, PERMITS, FEES

A. THE ELECTRICAL CONTRACTOR SHALL PAY FOR AND SECURE ALL NECESSARY PERMITS. THE ELECTRICAL WORK SHALL BE PERFORMED IN ACCORDANCE WITH THE NATIONAL ELECTRICAL CODE AND CONFORMING TO ALL LOCAL, STATE AND NATIONAL GOVERNING CODES. NOTE: THE PROJECT COMES UNDER STATE OF TENNESSEE ELECTRICAL INSPECTOR.

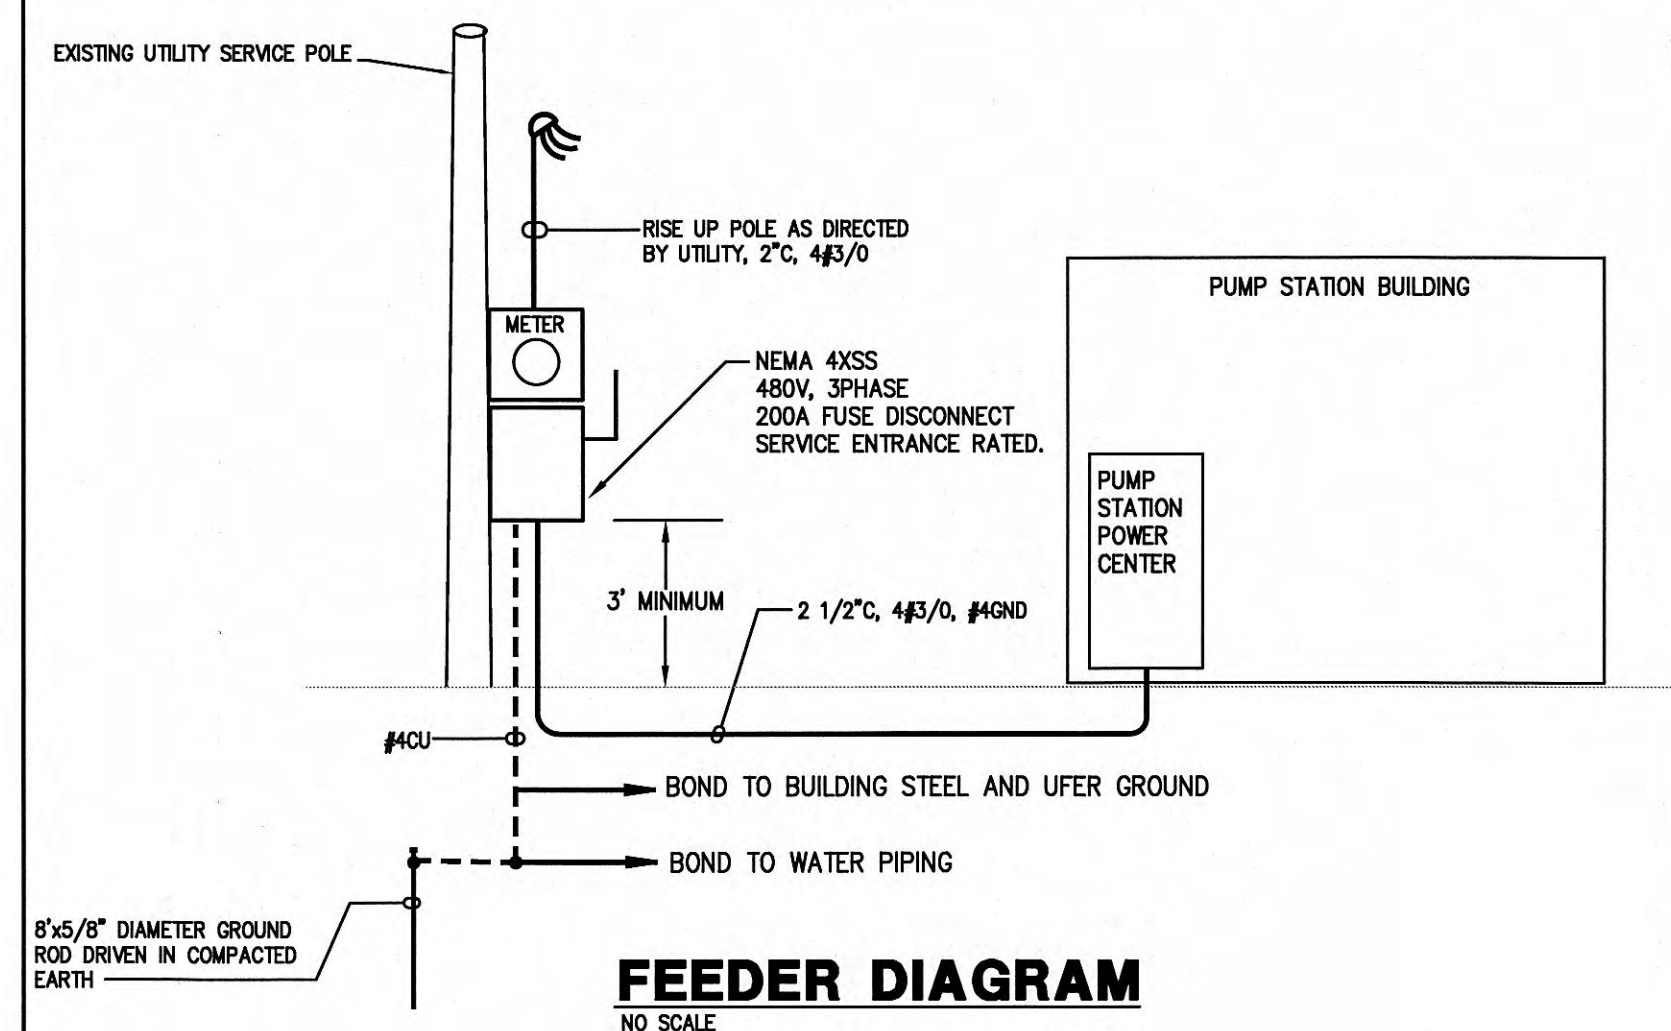

GRW PROJECT NO. 3947-02

CLIENT PROJECT NO. XXXXX

ALL RIGHTS RESERVED:
THIS DOCUMENT IS THE PROPERTY OF
GRW ENGINEERS, INC. AND SHALL NOT
BE REPRODUCED IN WHOLE OR IN PART
FOR USE FOR CONSTRUCTION OF
ANY OTHER THAN THIS SPECIFIC PROJECT
WITHOUT WRITTEN PERMISSION

3

ENGINEERS - ARCHITECTS - PLANNERS

EXTREME QUANTILES 0.00000

PUMP STATION SITE PLAN - ELECTRICAL

WAYS PUMP STATION IMPROVEMENTS & SEWER REHAB
CITY OF HARRIMAN, TENNESSEE

REVISIONS			DESIGNED:	
NO	DESCRIPTION	DATE	BY	RAC
				DRAWN:
				RAC
				REVIEWED:
				RAC
				APPROVED:

DATE:
APRIL 2011

SCALE:
1" = 10'

SHEET NO.

E-1

SITE UTILITIES NOTE
PRIOR TO STARTING SERVICE ENTRANCE WORK, THE CONTRACTOR SHALL CONTACT THE LOCAL POWER COMPANY & SHALL DETERMINE ALL REQUIREMENTS. PROVIDE NECESSARY LABOR AND MATERIALS UNDER THE CONTRACT TO INSTALL EACH SERVICE ENTRANCE COMPLETE. CONTRACTOR SHALL PAY ALL FEES & CONTRIBUTIONS TO CONSTRUCTION REQUIRED BY THE LOCAL POWER COMPANY.


WWR
ENGINEERS INC

West, Welch, Reed Engineers, Inc.
WWR PROJECT# 111033

THIS DRAWING IS GENERALLY DIAGRAMMATIC AND, EXCEPT WHERE SPECIFICALLY DIMENSIONED OR DETAILED, INDICATES THE GENERAL ARRANGEMENT OF THE WORK. THE CONTRACTOR SHALL INSTALL HIS WORK TO CONFORM AS NEARLY AS POSSIBLE TO THE LOCATIONS AND ARRANGEMENTS SHOWN, WITH ONLY SUCH MINOR ADJUSTMENTS AS NECESSARY TO COORDINATE THE WORK WITH ALL OTHER TRADES TO AVOID INTERFERENCE.

PRINTED: 3/12/2012 @ 2:02PM

FILE NAME: I:\3947-Harriman-Utility\02-Mays PS Cherry MB\Working Drawings\RECORD Drawings\02_G-0-001_Location Maps.dwg

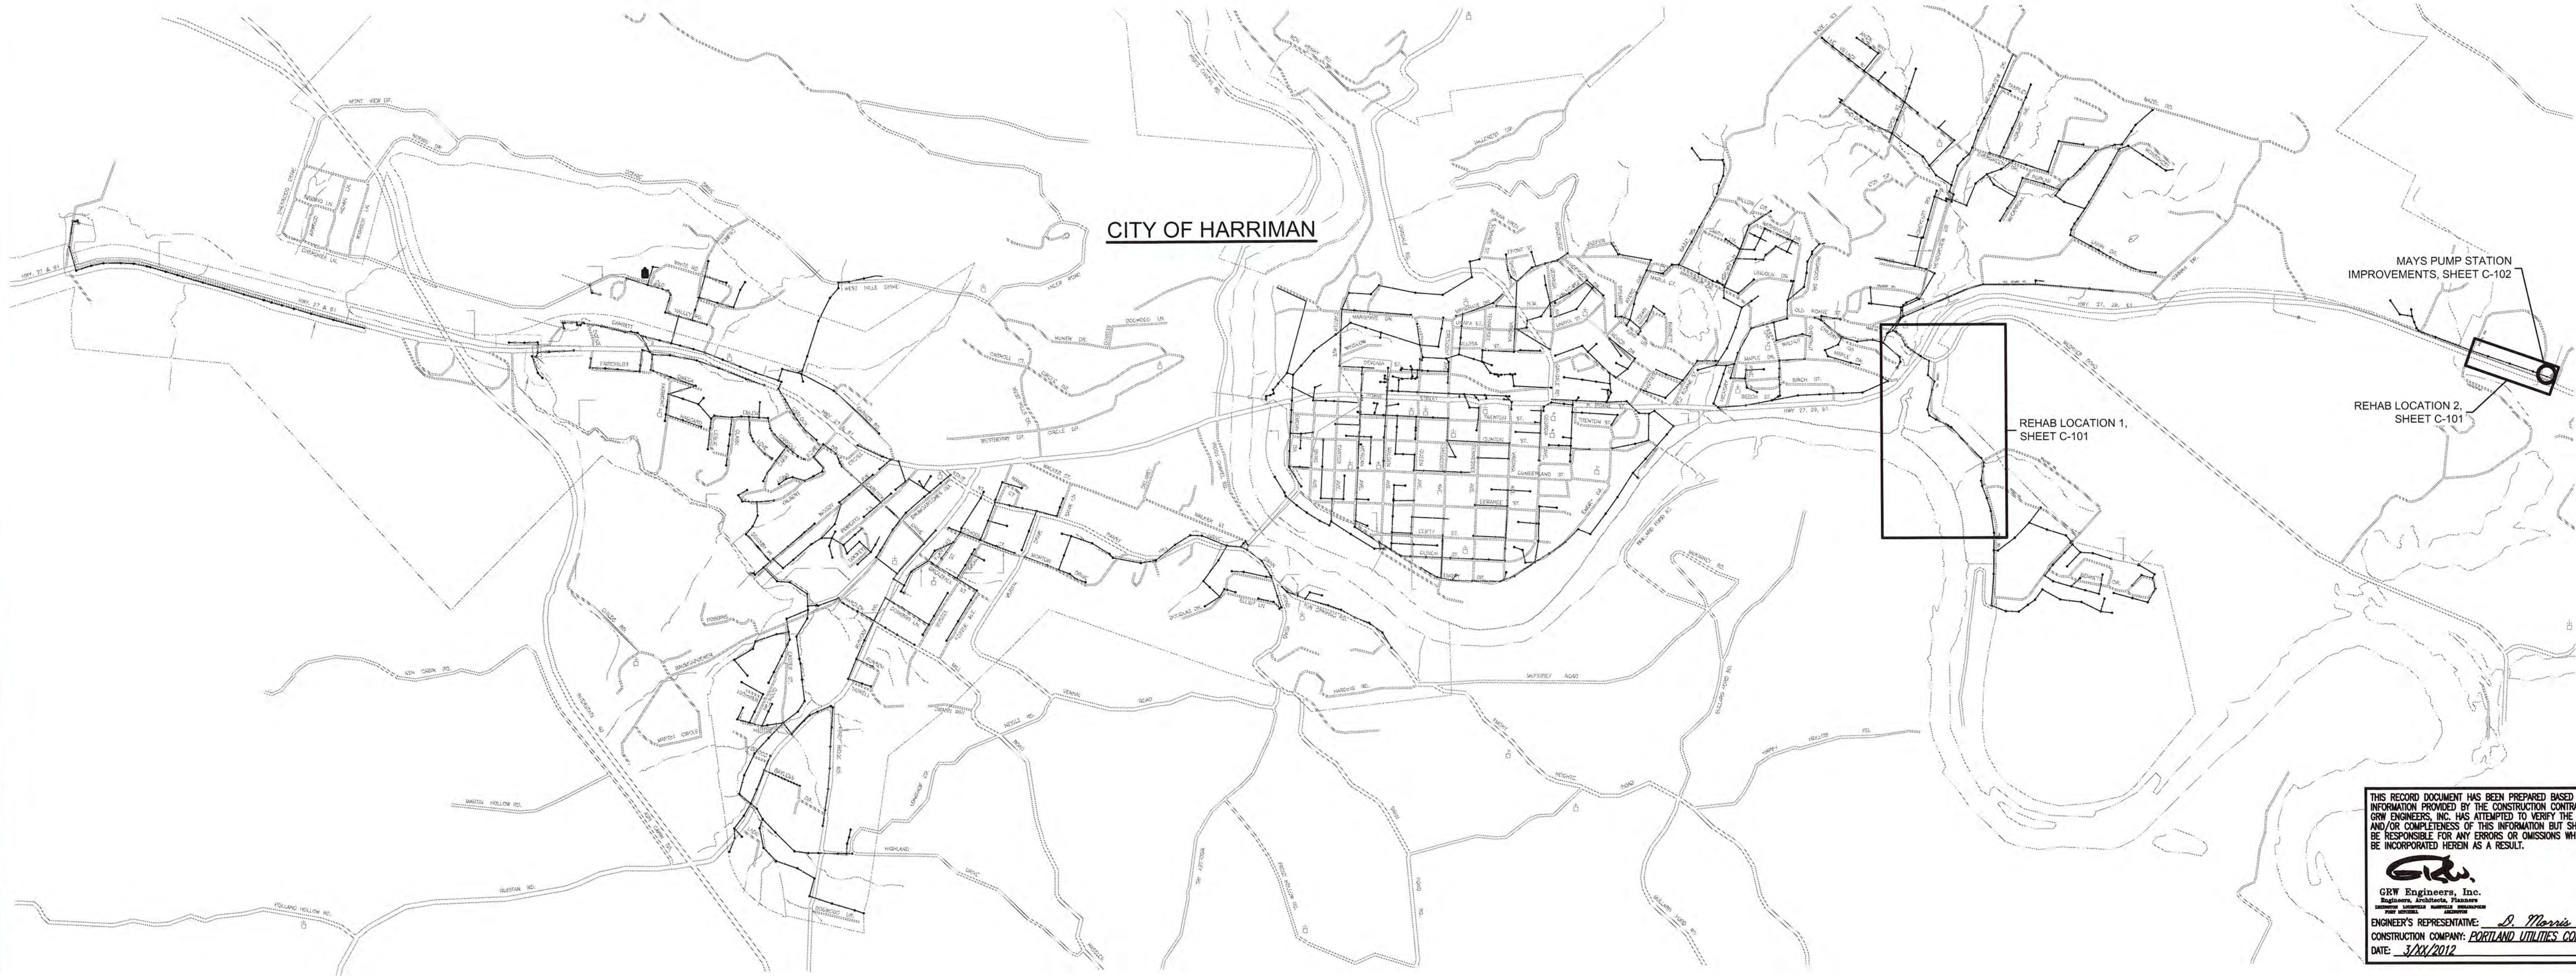


THIS RECORD DOCUMENT HAS BEEN PREPARED BASED ON INFORMATION PROVIDED BY THE CONSTRUCTION CONTRACTOR. GRW ENGINEERS, INC. HAS ATTEMPTED TO VERIFY THE ACCURACY AND/OR COMPLETENESS OF THIS INFORMATION BUT SHALL NOT BE RESPONSIBLE FOR ANY ERRORS OR OMISSIONS WHICH MAY BE INCORPORATED HEREIN AS A RESULT.

GRW
GRW Engineers, Inc.
Engineers, Architects, Planners
Surveyors, Environmental Scientists

ENGINEER'S REPRESENTATIVE: *D. Morris*
CONSTRUCTION COMPANY: *PORTLAND UTILITIES CONST. CO.*
DATE: *3/22/2012*

LOCATION MAP
NOT TO SCALE

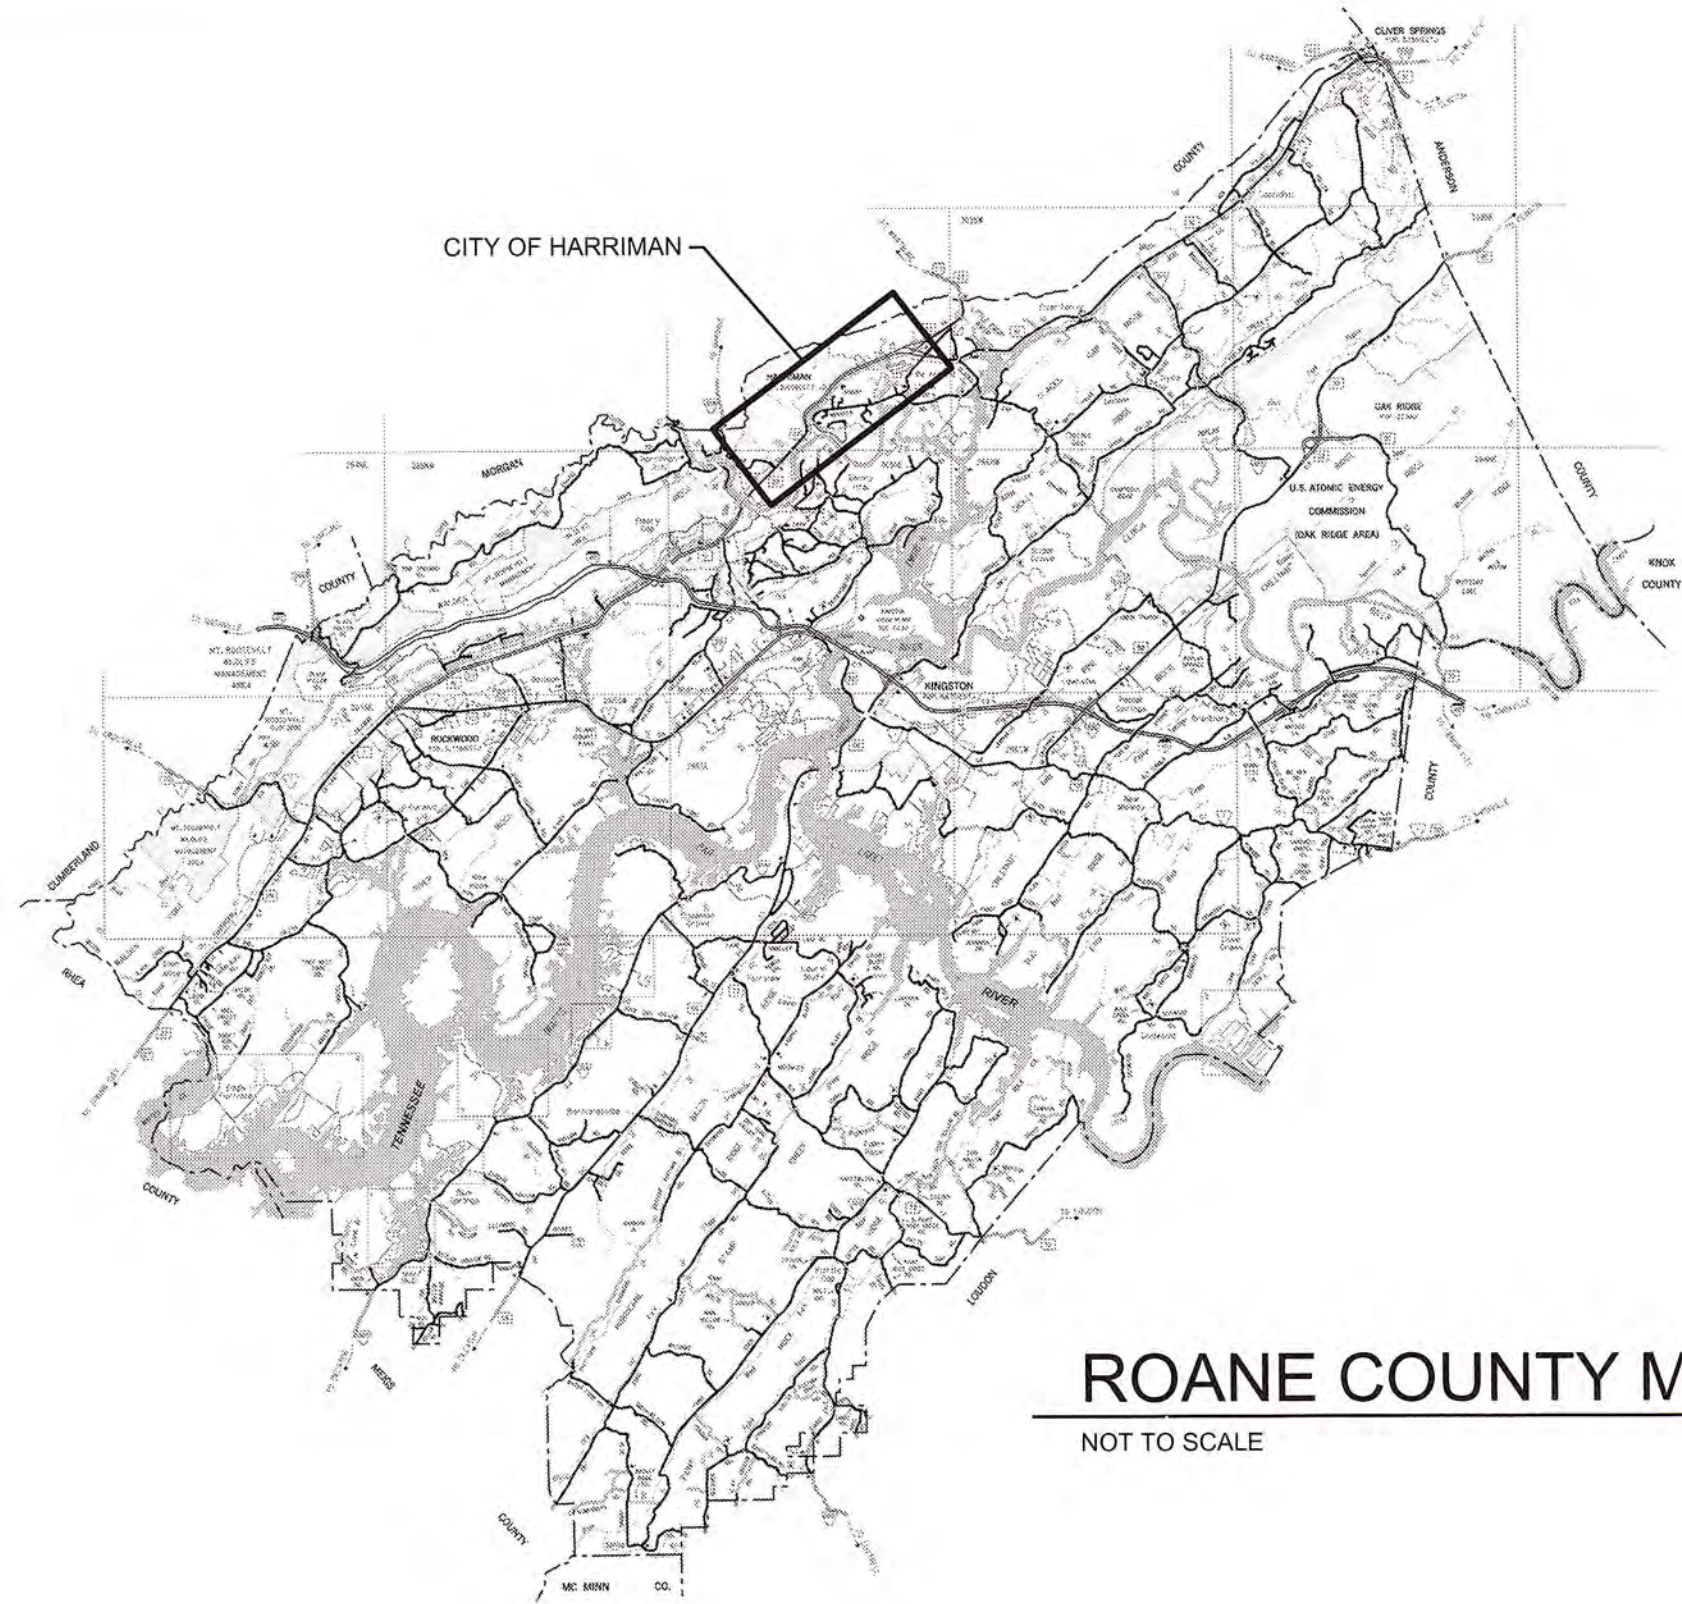

ROANE COUNTY MAP
NOT TO SCALE



COUNTY AND LOCATION MAPS

MAYS PUMP STATION IMPROVEMENTS & SEWER REHAB
CITY OF HARRIMAN, TENNESSEE

NO.	DATE	BY	DESCRIPTION	DESIGNED: ACH	DRAWN: CAJ	REVIEWED: ACH	APPROVED: RGT	SCALE CHECK	DATE	SCALE	SHEET NO.





ENGINEERS - ARCHITECTS - PLANNERS
www.grwinc.com

GRW PROJECT NO. 3947-02
CLIENT PROJECT NO. XXXXX
ALL RIGHTS RESERVED.
THIS DOCUMENT IS THE PROPERTY OF GRW ENGINEERS, INC. AND SHALL NOT BE REPRODUCED IN WHOLE OR IN PART WITHOUT WRITTEN PERMISSION.



STATE SUBMITTAL

G-0-001

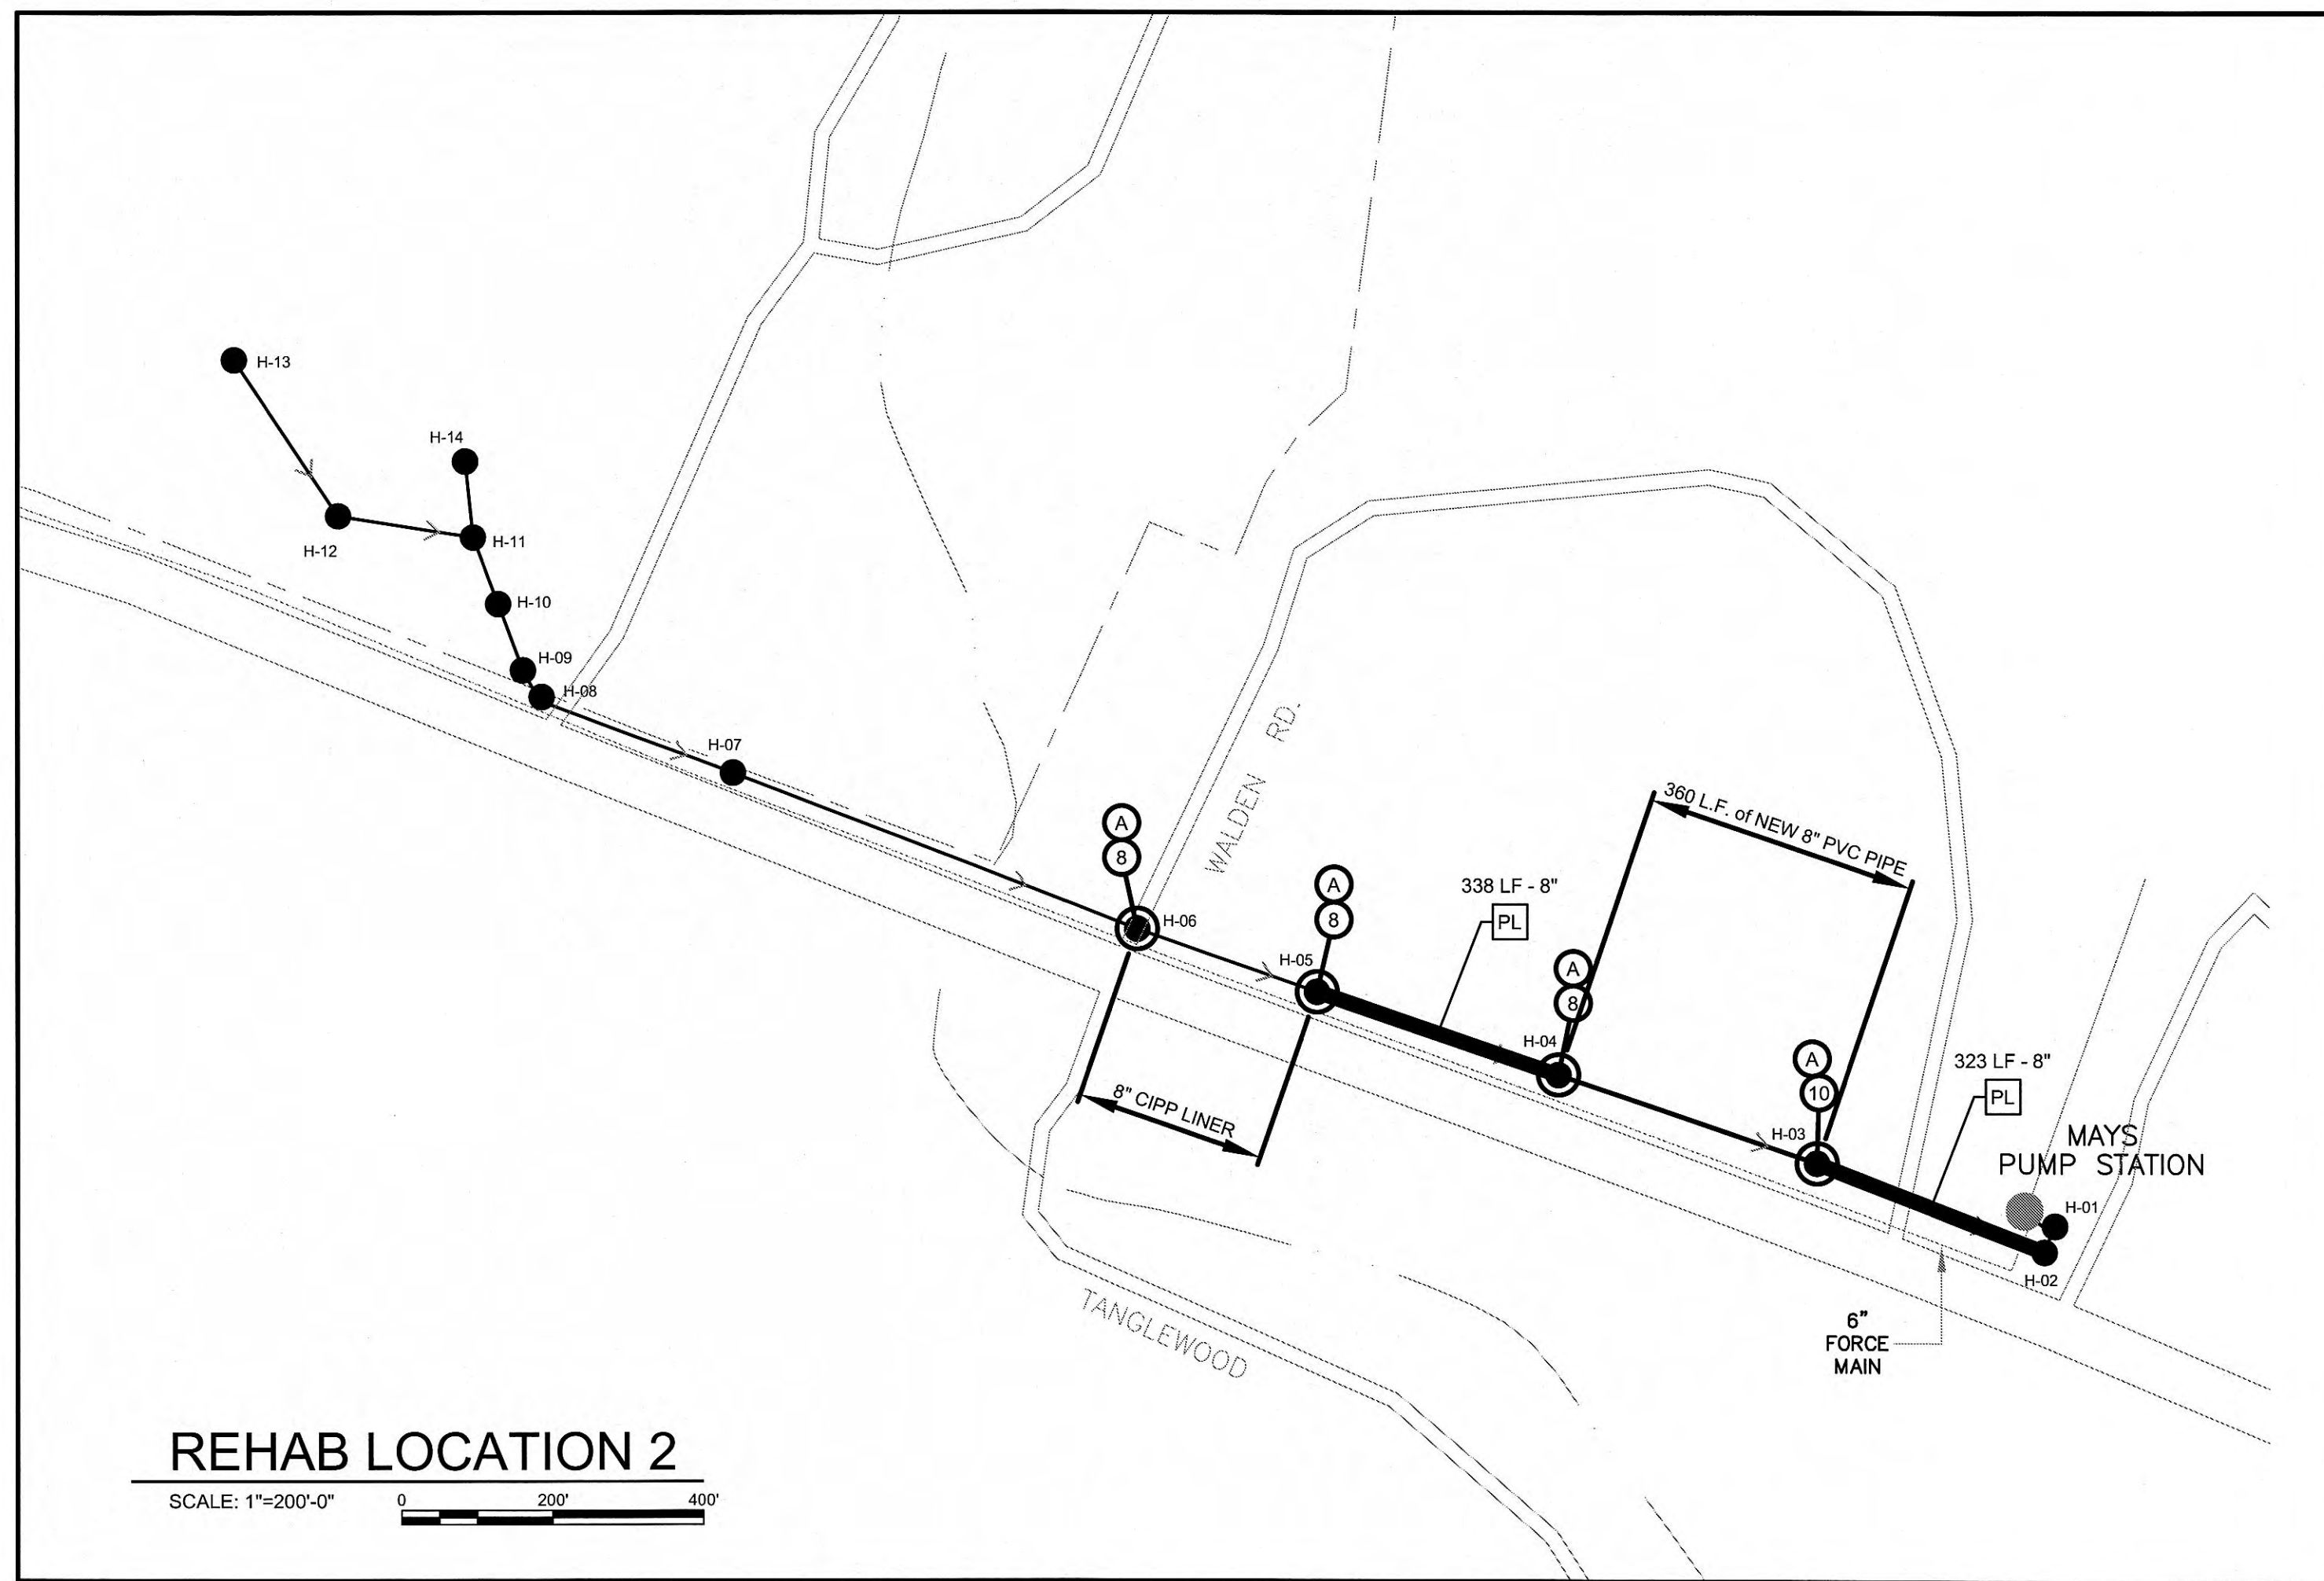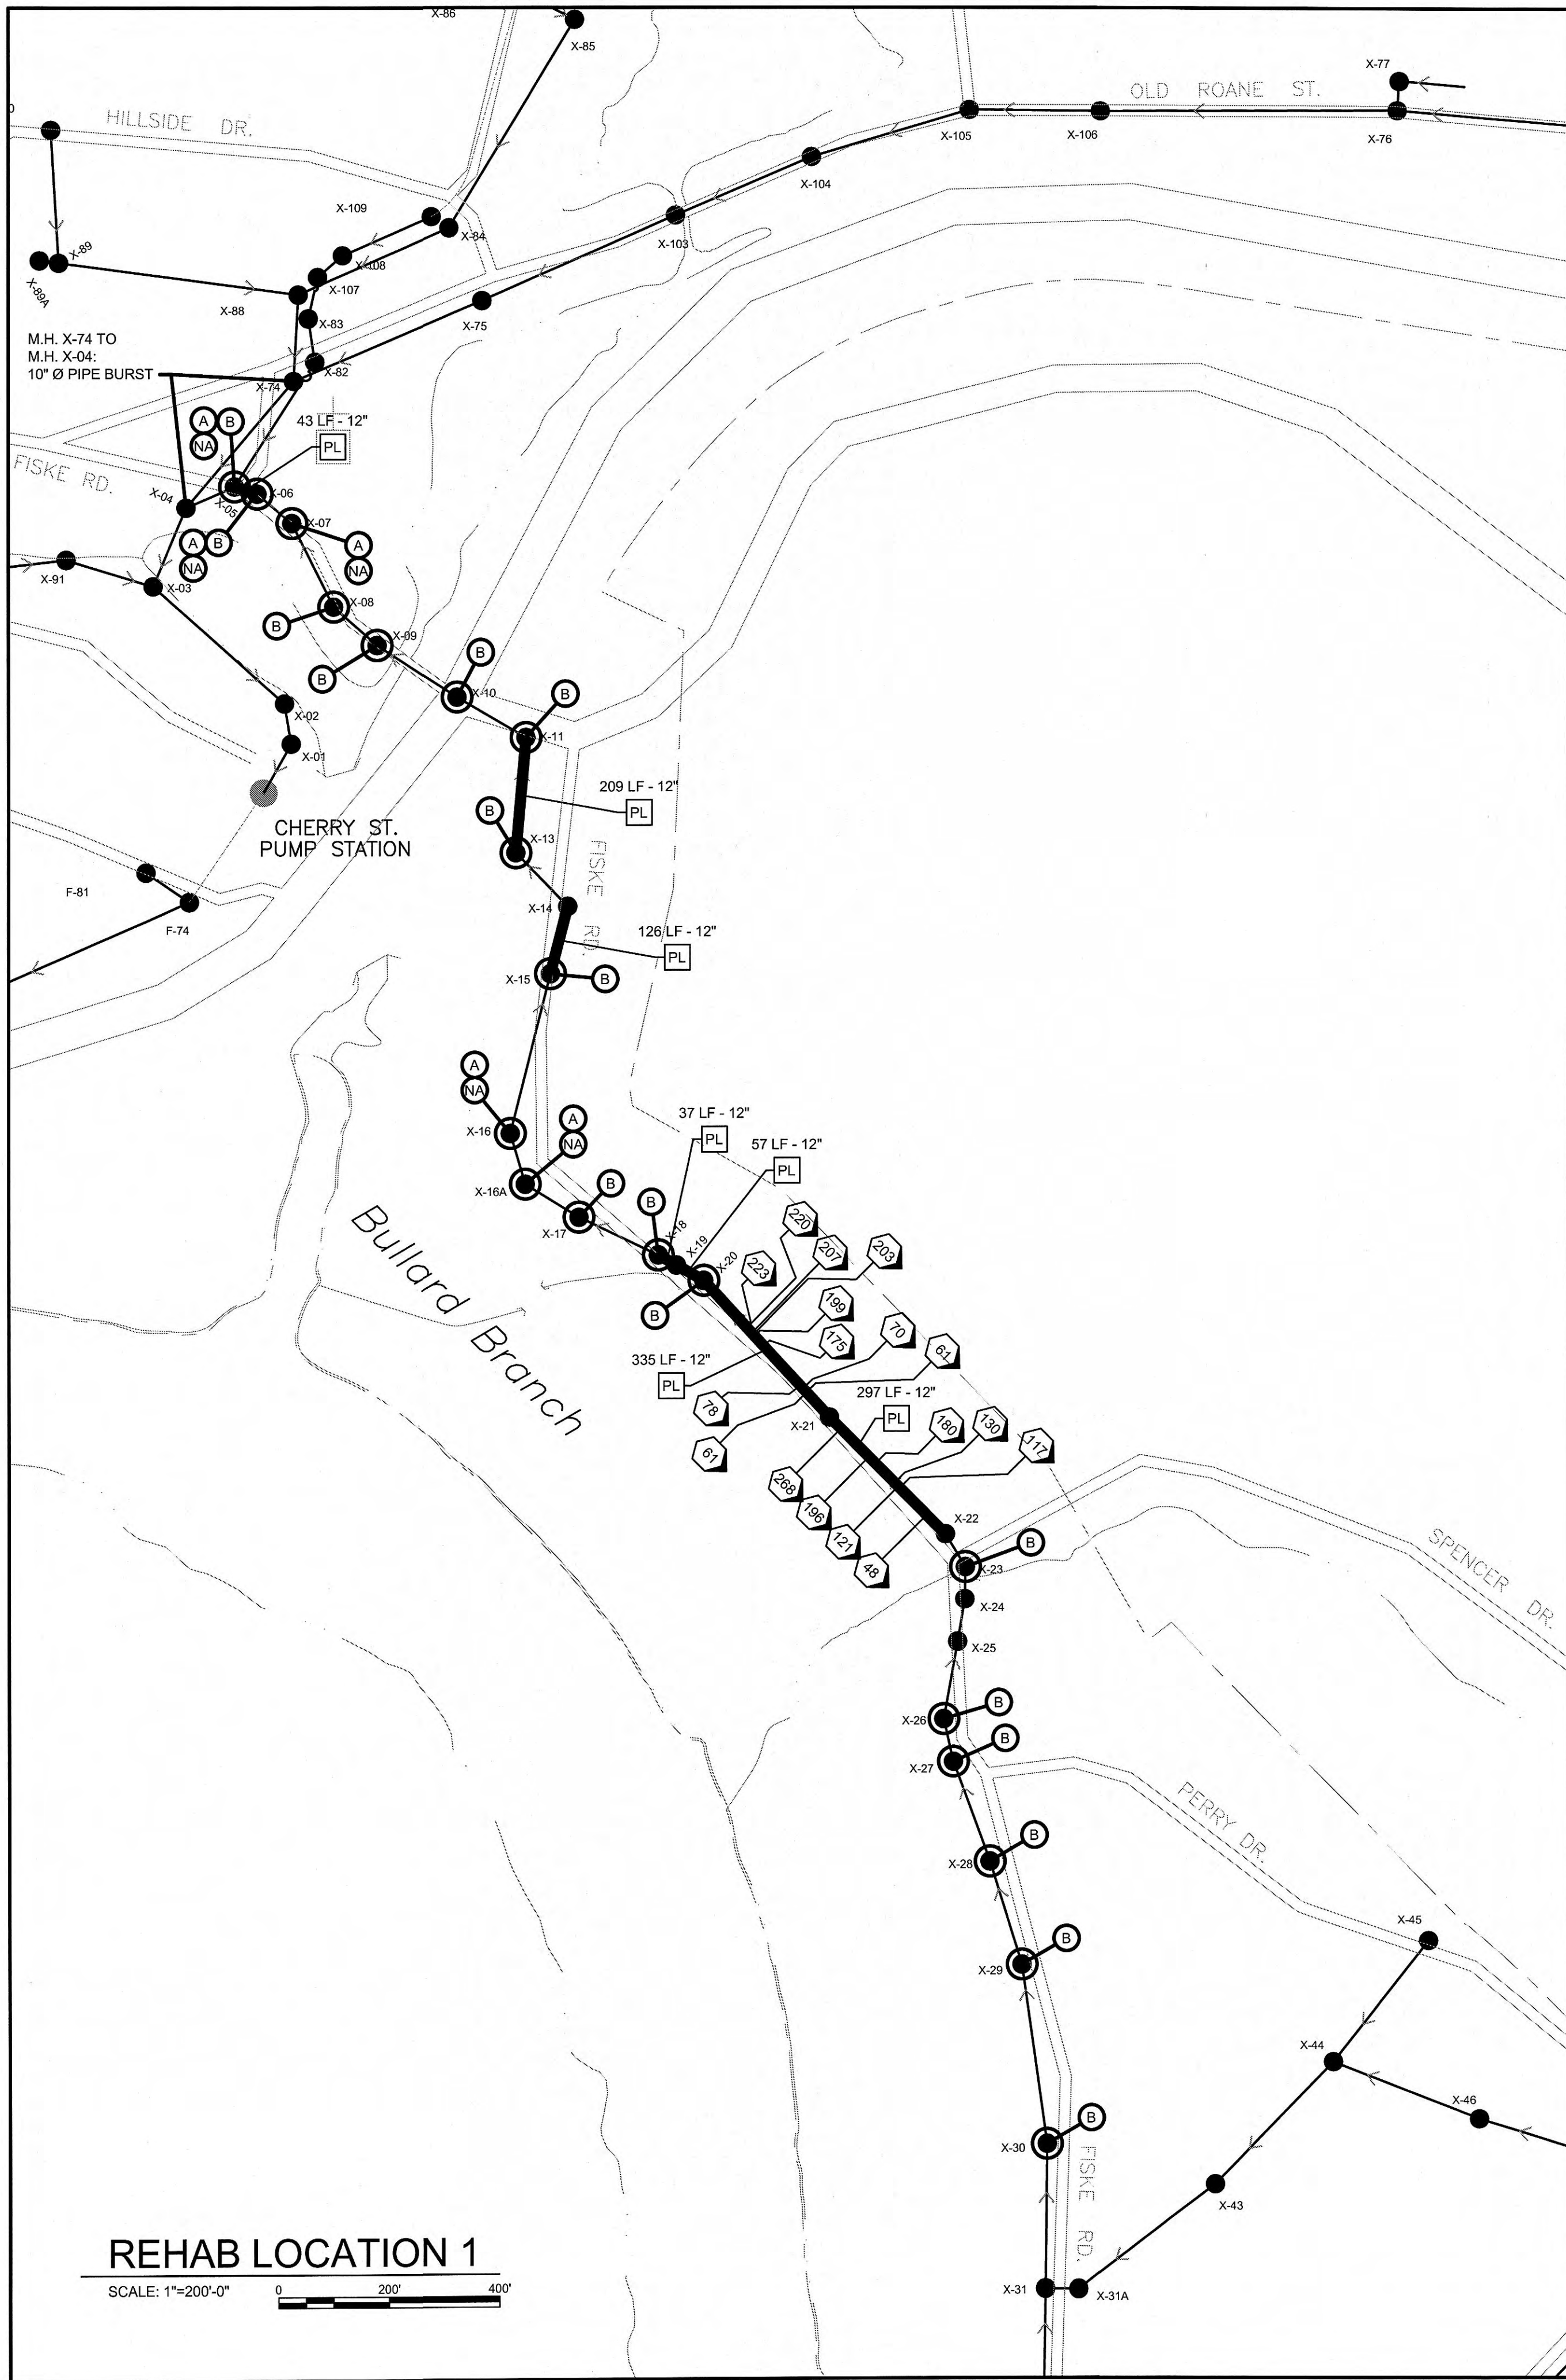

REHAB LOCATION 2

SCALE: 1"=200'-0"

MANHOLE REHABILITATION

MH #	DEPTH (FT)	MH DIA. (FT)	REHAB TYPE
X-30	N/A	4	REPLACE LID
X-29	N/A	4	REPLACE LID
X-28	N/A	4	REPLACE LID
X-27	N/A	4	REPLACE LID
X-26	N/A	4	REPLACE LID
X-23	N/A	4	REPLACE LID
X-20	N/A	4	REPLACE LID
X-18	N/A	4	REPLACE LID
X-17	N/A	4	REPLACE LID
X-16A	N/A	4	REPLACE LID, RAISE TO GRADE, & CEMENTITIOUS COATING
X-16	N/A	4	REPLACE LID, RAISE TO GRADE, & CEMENTITIOUS COATING
X-15	N/A	4	REPLACE LID
X-13	N/A	4	REPLACE LID
X-11	N/A	4	REPLACE LID
X-10	N/A	4	REPLACE LID
X-09	N/A	4	REPLACE LID
X-08	N/A	4	REPLACE LID
X-07	N/A	4	CEMENTITIOUS COATING
X-06	N/A	4	REPLACE LID & CEMENTITIOUS COATING
X-05	N/A	4	REPLACE LID & CEMENTITIOUS COATING
H-06	8	4	CEMENTITIOUS COATING
H-05	8	4	CEMENTITIOUS COATING
H-04	8	4	CEMENTITIOUS COATING
H-03	10	4	CEMENTITIOUS COATING

CURED-IN-PLACE LINER REHABILITATION

UPSTREAM MH	DEPTH (FT)	DOWNSREAM MH	DEPTH (FT)	SEGMENT LENGTH (L.F.)	PIPE DIA.	SERVICE CONNECTIONS
X-22	N/A	X-21	N/A	297	12"	48' L 117' R 121' L 130' R 180' R 196' L 268' L
X-21	N/A	X-20	N/A	335	12"	61' R 61' L 78' L 175' R 199' R 203' R 207' R 220' R 223' R
X-20	N/A	X-19	N/A	57	12"	-
X-19	N/A	X-18	N/A	37	12"	-
H-05	8	H-04	8	338	8"	-
H-04	8	H-03	10	358	8"	-
H-03	10	H-02	N/A	323	8"	-

REHAB KEYNOTES

- 207 SERVICE CONNECTIONS AND DISTANCE TO MANHOLE
- 100 LF - 8" PIPE LINING BY CURED-IN-PLACE METHOD WITH TRENCHLESS OR EXCAVATABLE SERVICE RENEWAL / LENGTH SIZE

MANHOLE REHAB KEYNOTES


- A CEMENTITIOUS COATING
- B REPLACE LID

MANHOLE DEPTHS (FEET)


- 6 0.0 - 6.0
- 8 6.1 - 8.0
- 10 8.1 - 10.0
- 12 10.1 - 12.0
- 14 12.1 - 14.0
- 16 14.1 - 16.1
- NA UNKNOWN

THIS RECORD DOCUMENT HAS BEEN PREPARED BASED ON INFORMATION PROVIDED BY THE CONSTRUCTION CONTRACTOR. GRW ENGINEERS, INC. HAS ATTEMPTED TO VERIFY THE ACCURACY AND/OR COMPLETENESS OF THIS INFORMATION BUT SHALL NOT BE RESPONSIBLE FOR ANY ERRORS OR OMISSIONS WHICH MAY BE INCORPORATED HEREIN AS A RESULT.

GRW
GRW Engineers, Inc.
Engineers, Architects, Planners
CONSTRUCTION COMPANY: *Portland Utilities Const. Co.*
DATE: *3/12/2012*

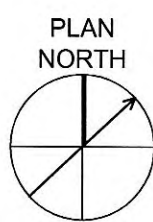

GRW PROJECT NO. 3047-02
CLIENT PROJECT NO. XXXXX
ALL RIGHTS RESERVED. THE INFORMATION CONTAINED HEREIN IS THE PROPERTY OF GRW ENGINEERS, INC. AND SHALL NOT BE REPRODUCED IN WHOLE OR IN PART WITHOUT WRITTEN PERMISSION.

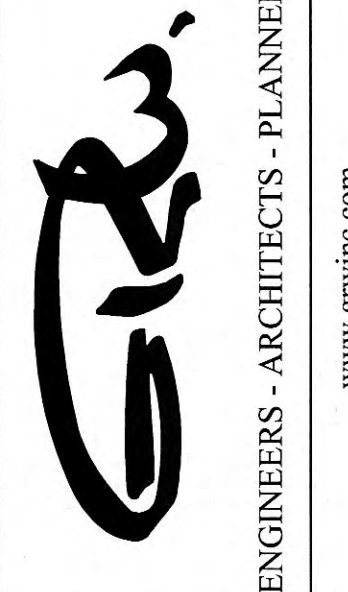

SEWER SYSTEM REHABILITATION PLANS
MAYS PUMP STATION IMPROVEMENTS & SEWER REHAB
CITY OF HARRIMAN, TENNESSEE

DESIGNED: ACH
DRAWN: CAJ
REVIEWED: ACH
APPROVED: RGT




REVISIONS	DATE	DESCRIPTION
NO.		

DATE: MAY 2011

SCALE: 1" = 200'-0"

SHEET NO.



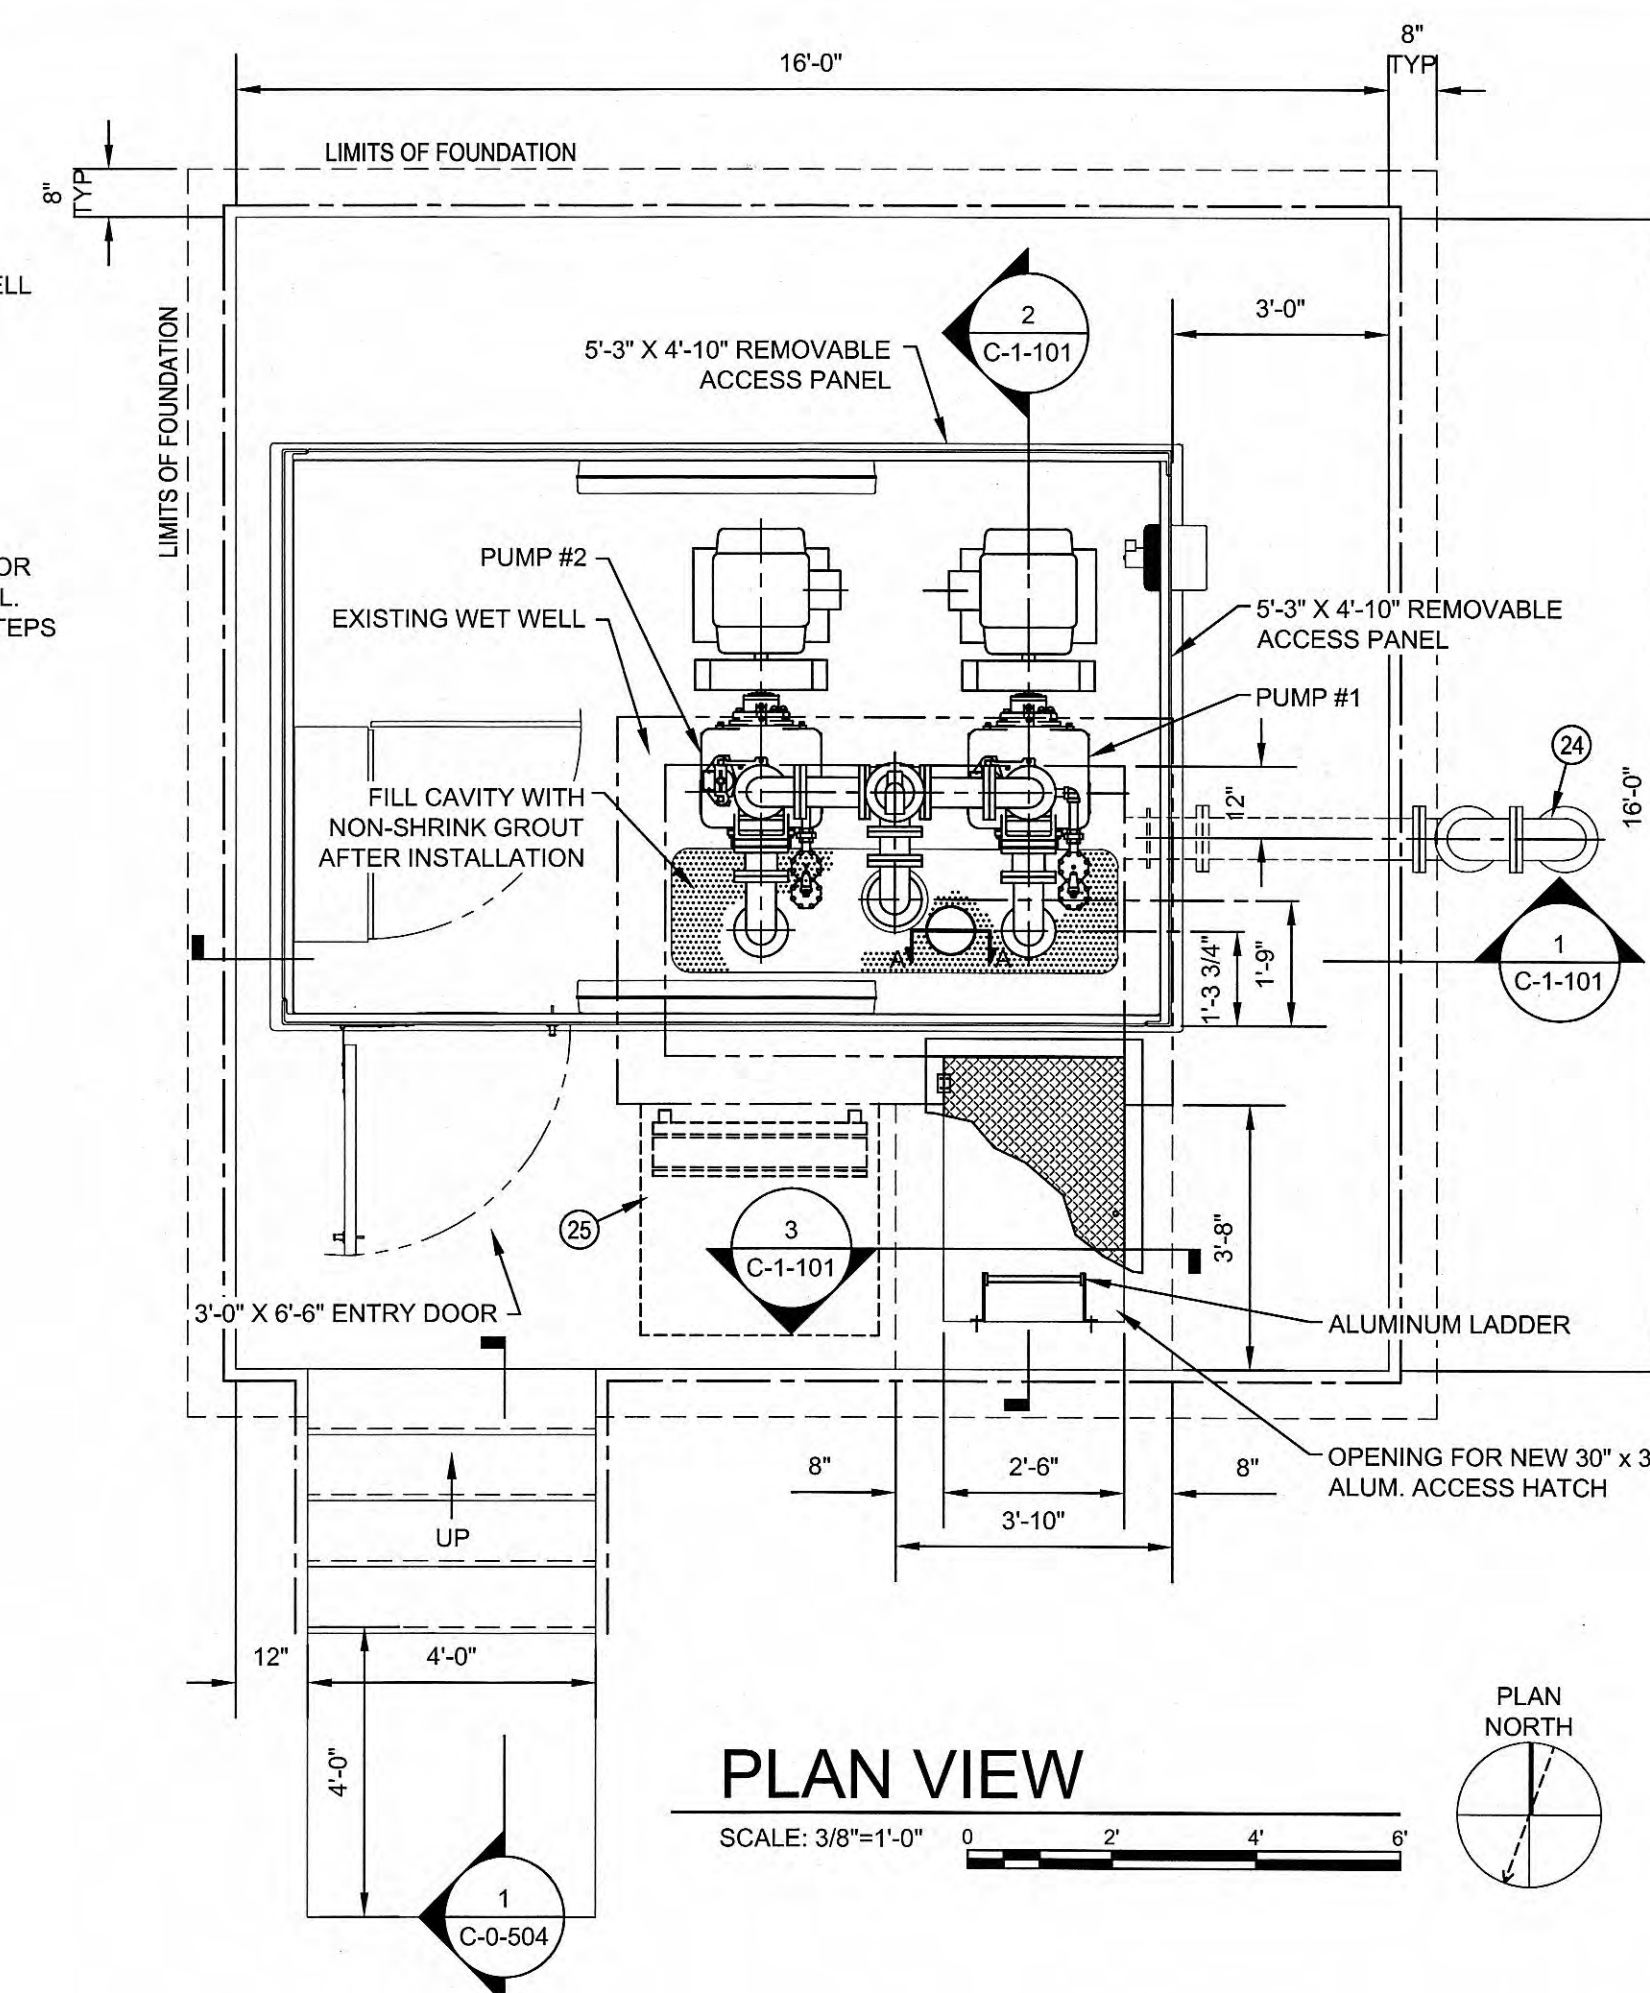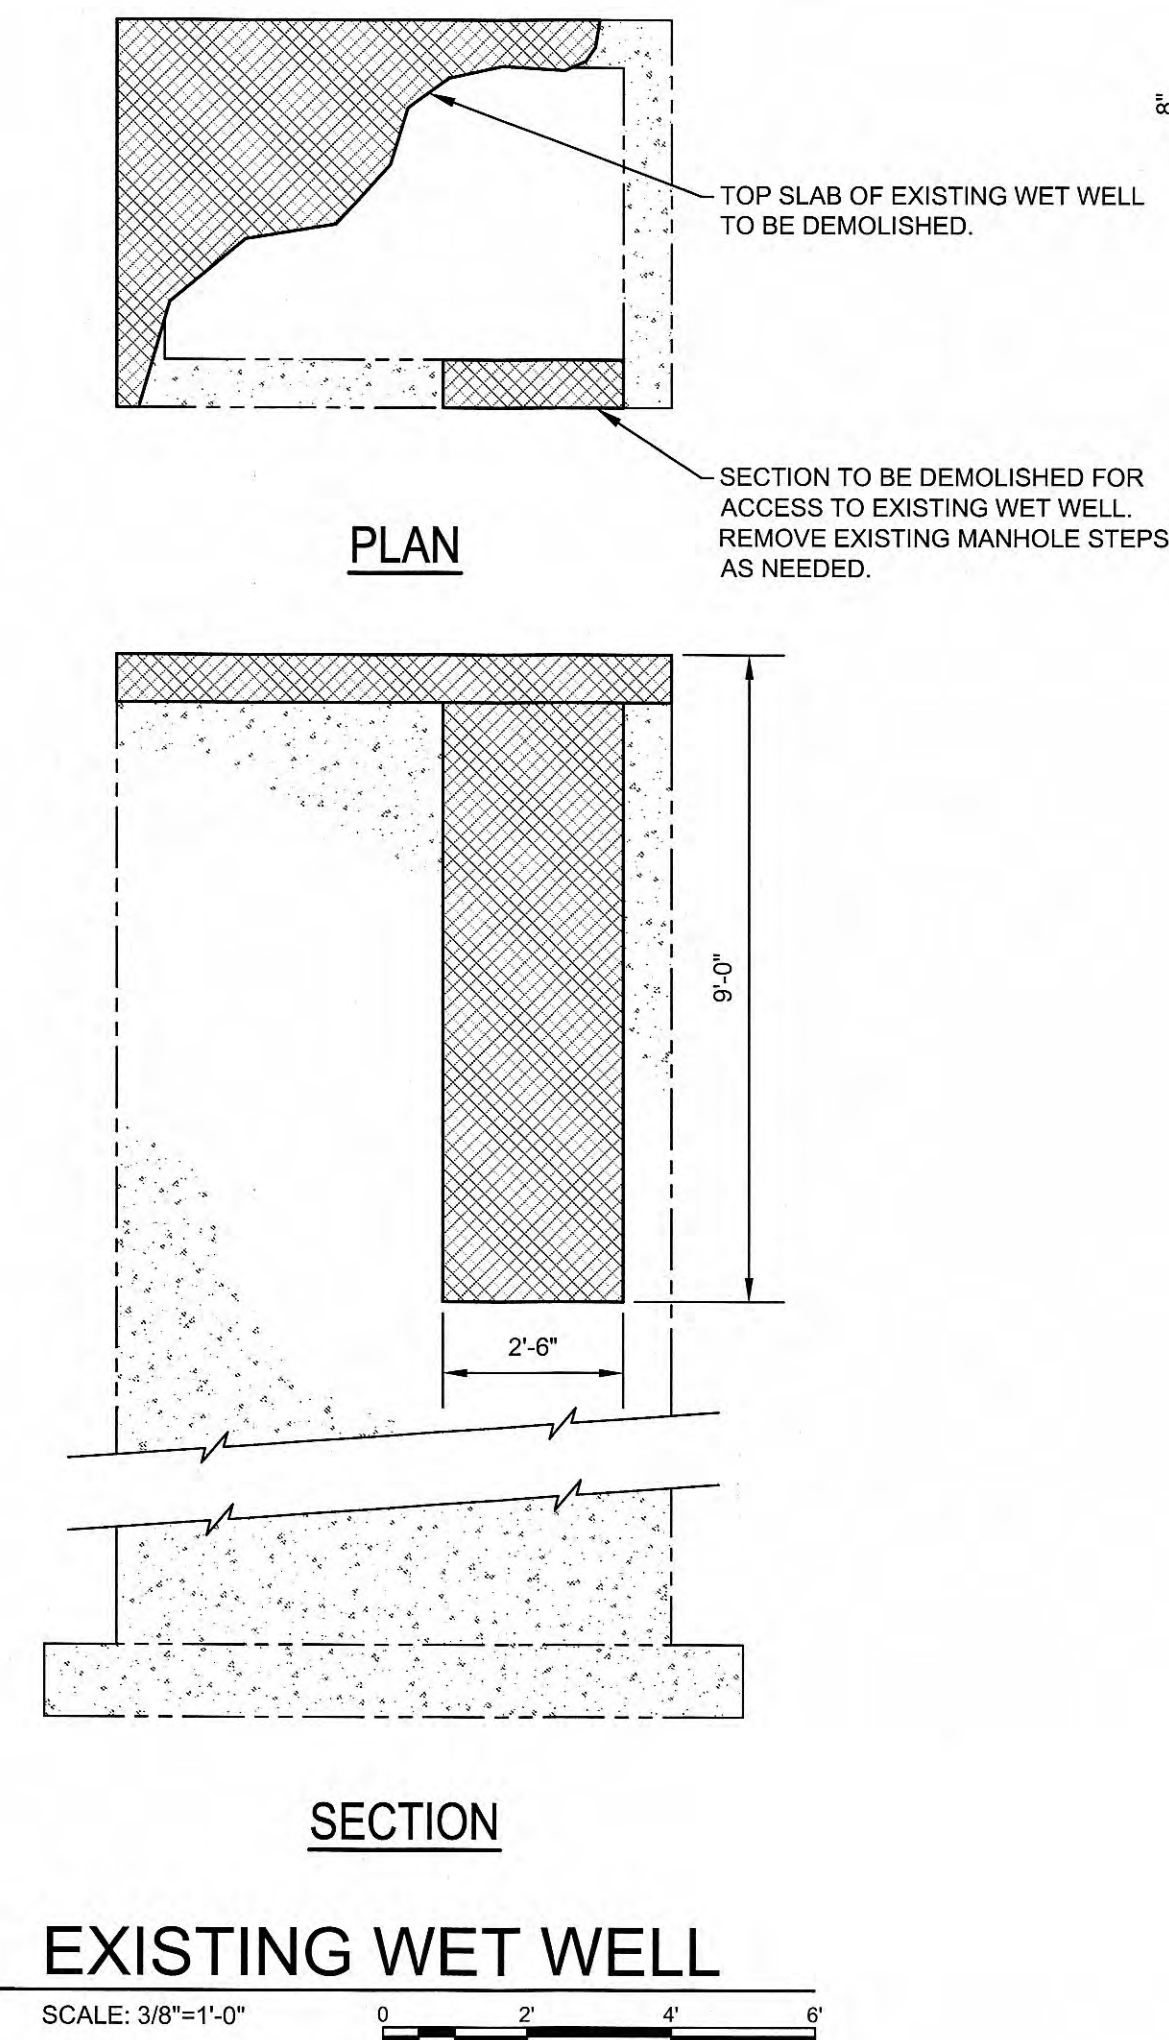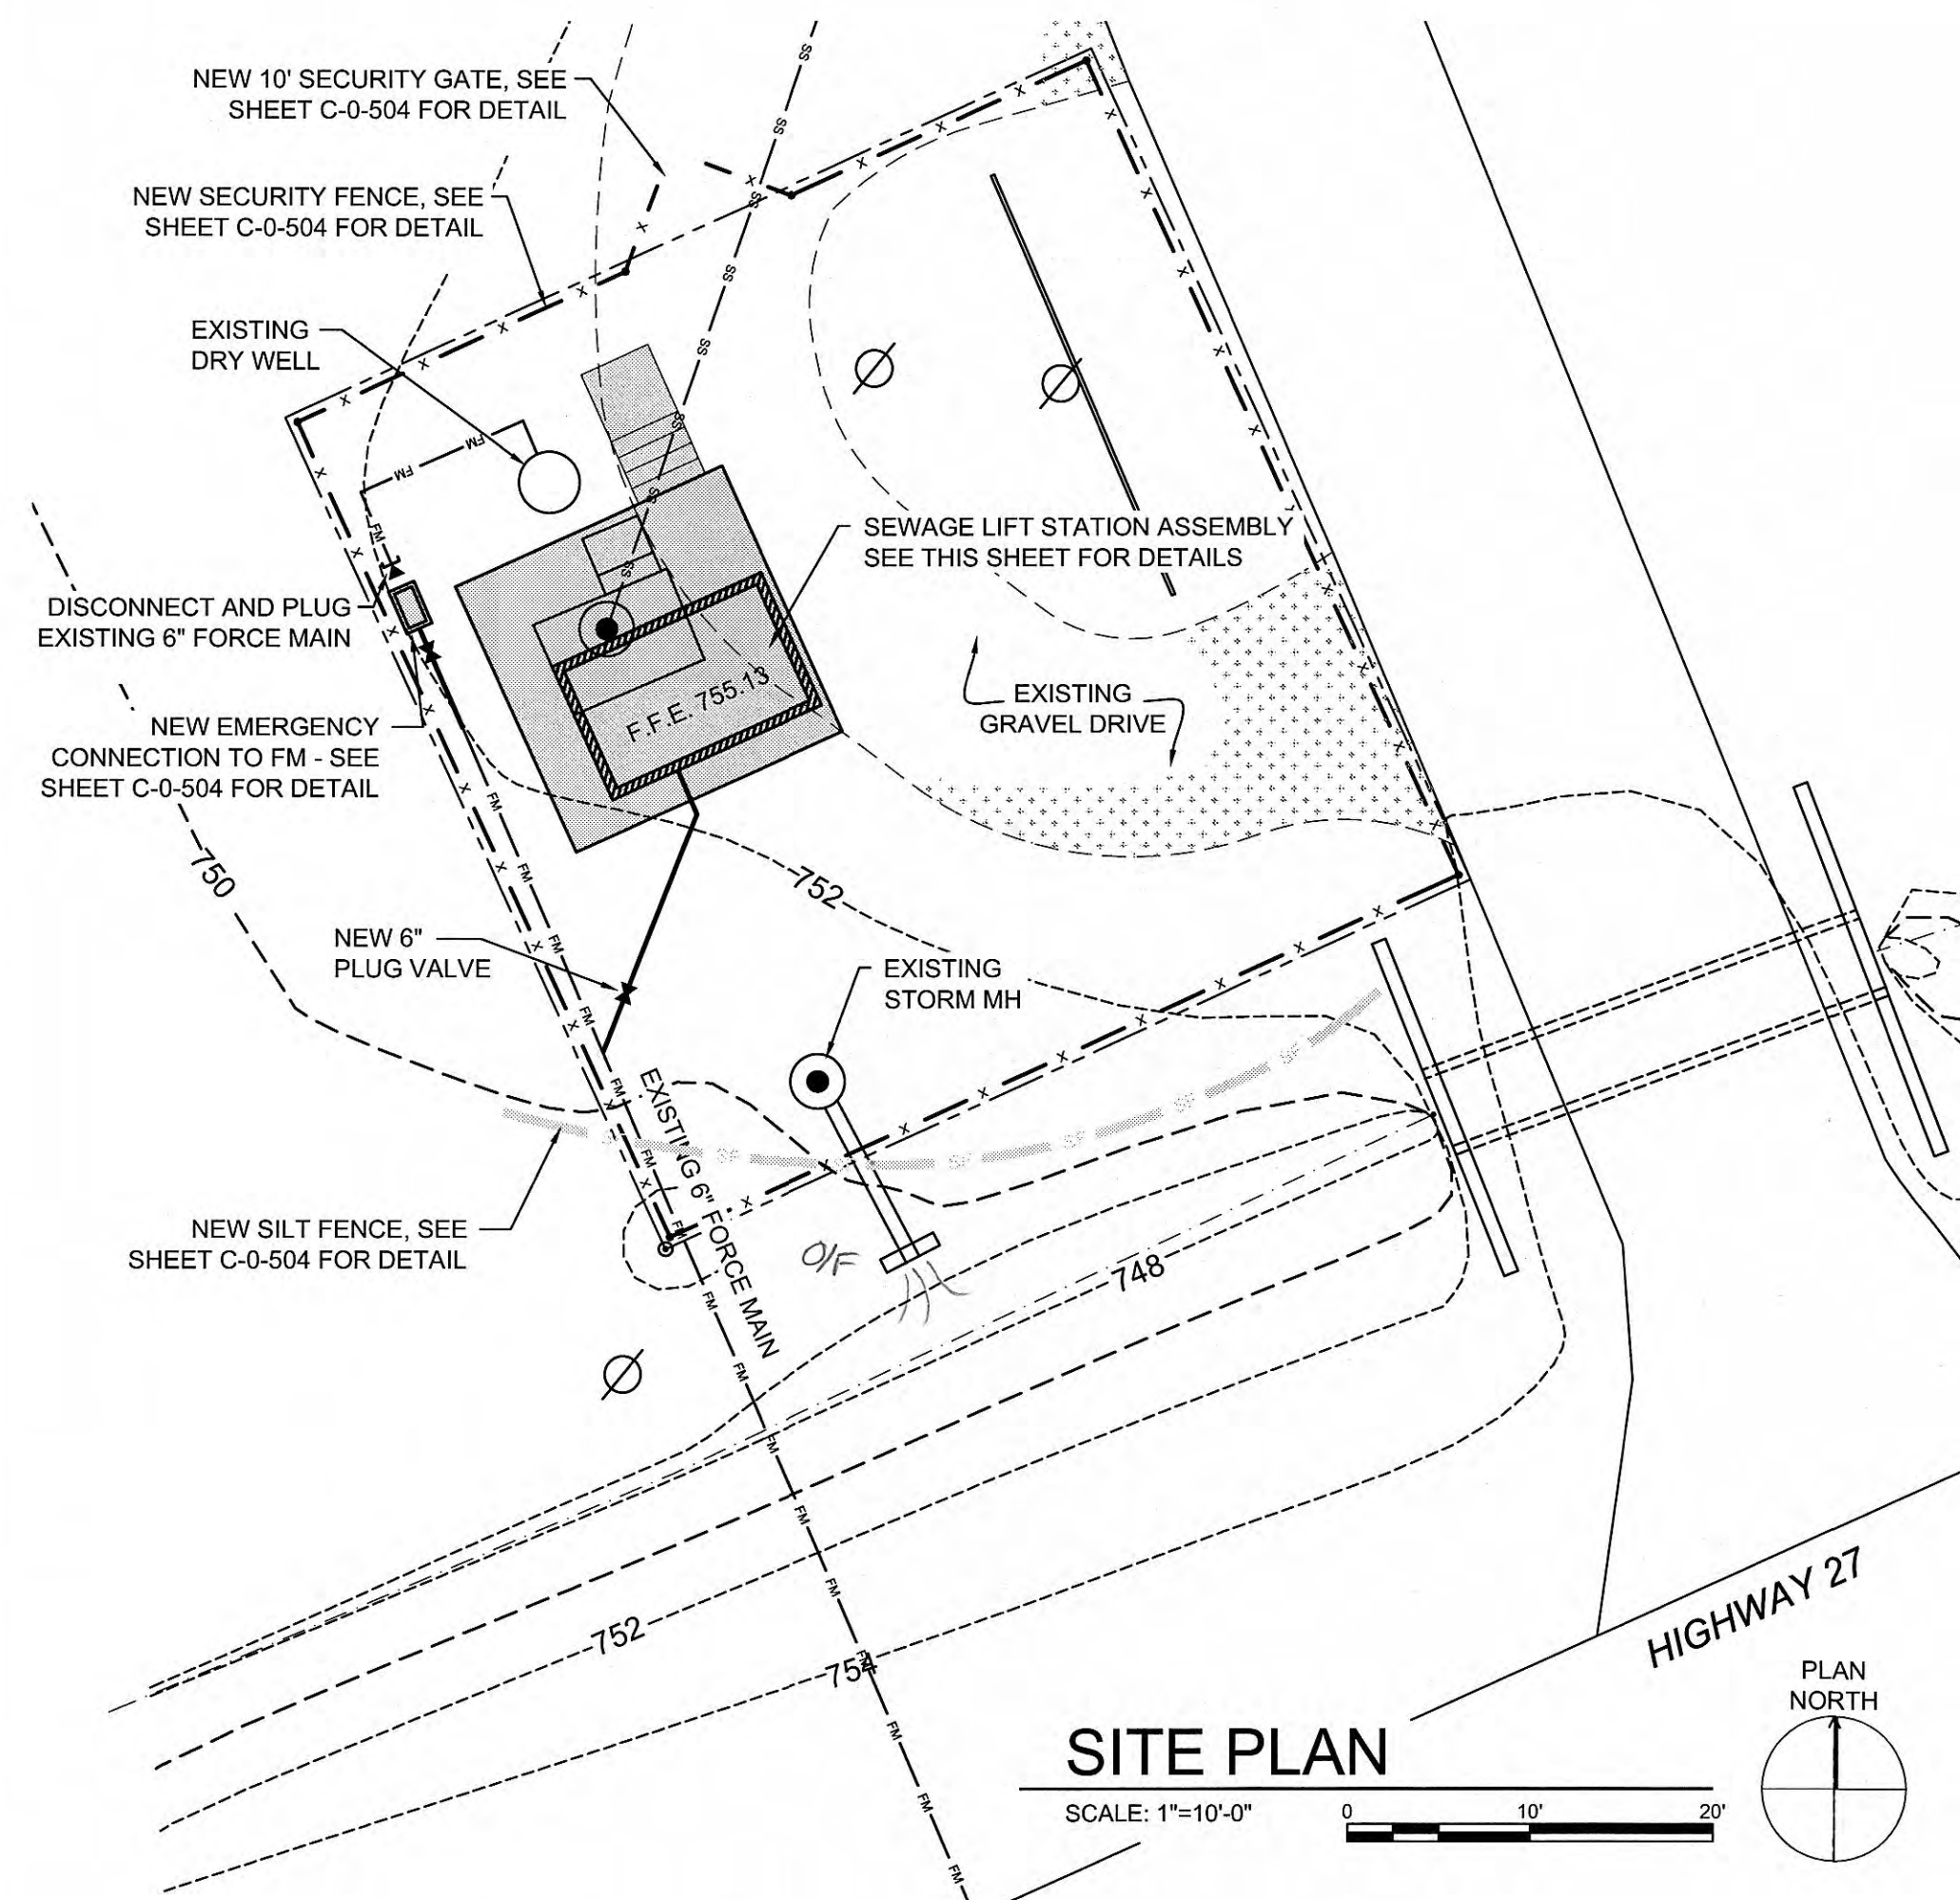


C-0-102



KEYNOTES


- ① PUMP
- ② MOTOR
- ③ MOTOR STAND ASSEMBLY
- ④ 4" Ø DISCHARGE CHECK VALVE
- ⑤ 4" Ø DISCHARGE PLUG VALVE
- ⑥ AIR RELEASE VALVE
- ⑦ STATION BASE ASSEMBLY
- ⑧ BELT GUARD ASSEMBLY
- ⑨ STATION ENCLOSURE ASSEMBLY
- ⑩ EXHAUST FAN
- ⑪ FLUORESCENT LIGHT FIXTURE
- ⑫ MOTOR CONTROL PANEL
- ⑬ INTAKE VENT ASSEMBLY
- ⑭ 4" Ø 90° FLANGED ELBOW
- ⑮ 4" Ø FLANGED SPOOL
- ⑯ 4" x 6" Ø FLANGED INCREASER
- ⑰ 4" Ø RESTRAINED JOINT FLANGE ADAPTER
- ⑱ 6" Ø RESTRAINED JOINT FLANGE ADAPTER
- ⑲ 6" Ø 90° FLANGED ELBOW
- ⑳ 4" COUPLING
- ㉑ 6" WALL PIPE
- ㉒ 4" Ø 90° FLANGED BASE ELBOW
- ㉓ 4" Ø FLANGED LONG RADIUS ELBOW
- ㉔ D.I.P. VENT PIPE, 2 - 6" Ø 90° ELBOWS
W/ S.S. INSECT SCREEN
- ㉕ EXISTING CONTROL PANEL TO BE
TEMPORARILY RELOCATED DURING
CONSTRUCTION AND DEMOLITION
AFTER NEW PUMP STATION START
UP.

LEGEND


- | | |
|---|---|
|  | NEW STRUCTURE / PIPING /
POURED IN PLACE CONC. |
|  | NEW GROUT |
|  | NEW GRAVEL BACKFILL |
|  | EXISTING CONCRETE |
|  | TO BE DEMOLISHED |

GENERAL NOTES


- A. ALL ANCHOR BOLTS AND FASTNERS USED IN PUMP STATION SHALL BE STAINLESS STEEL UNLESS OTHERWISE NOTED.
- B. COORDINATE PIPING LOCATION WITH EQUIPMENT SUPPLIED.
- C. ALL ENTRANCES INTO PUMP BUILDING FROM WET WELL SHALL BE SEALED GAS TIGHT.
- D. SEE TYPICAL STRUCTURAL DETAILS FOR ADDITIONAL REINFORCING AT OPENINGS. SEE GENERAL STRUCTURAL NOTES FOR CONCRETE PROTECTION OF REINFORCING.
- E. PROVIDE CORNER BARS AT ALL CAST-IN-PLACE CONCRETE WALL INTERSECTIONS. SEE SECTION 1 FOR SIZE AND SPACING
- F. SLABS TO BE CAST ON A 4" LAYER (MIN.) OF CLEAN, CRUSHED AND COMPACTED #5 STONE. SURROUND CONCRETE VAULT WALLS WITH A MIN. OF 4" CRUSHED #5 STONE.
- G. CONTRACTOR TO CLEAN WET WELL PRIOR TO CONSTRUCTION.
- H. CONTRACTOR TO MAINTAIN WARNING TAPE AND TEMPORARY FENCING AROUND OPEN WET WELL.

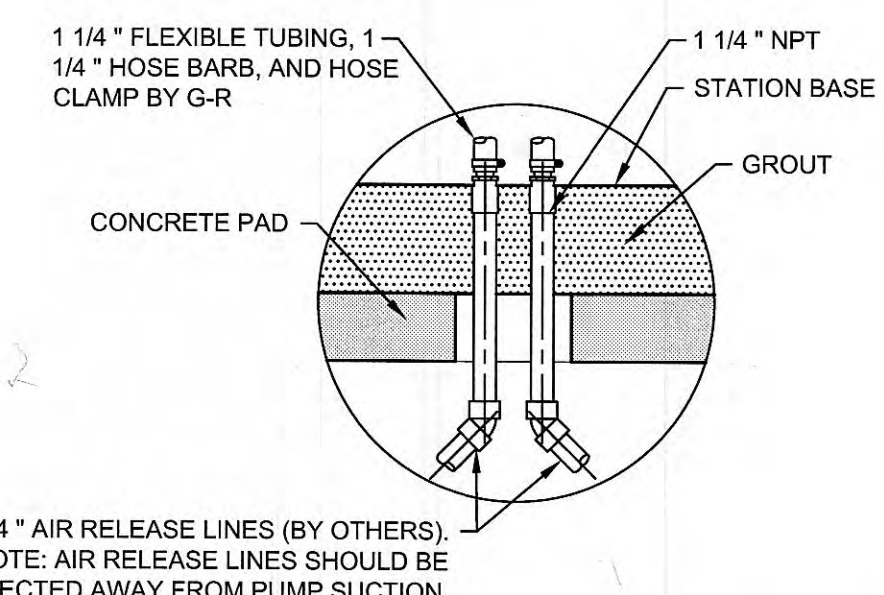


SECTION 'A-A'

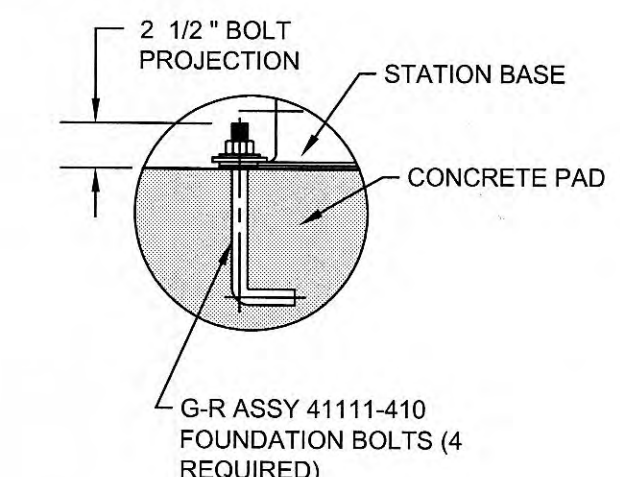


DETAIL B

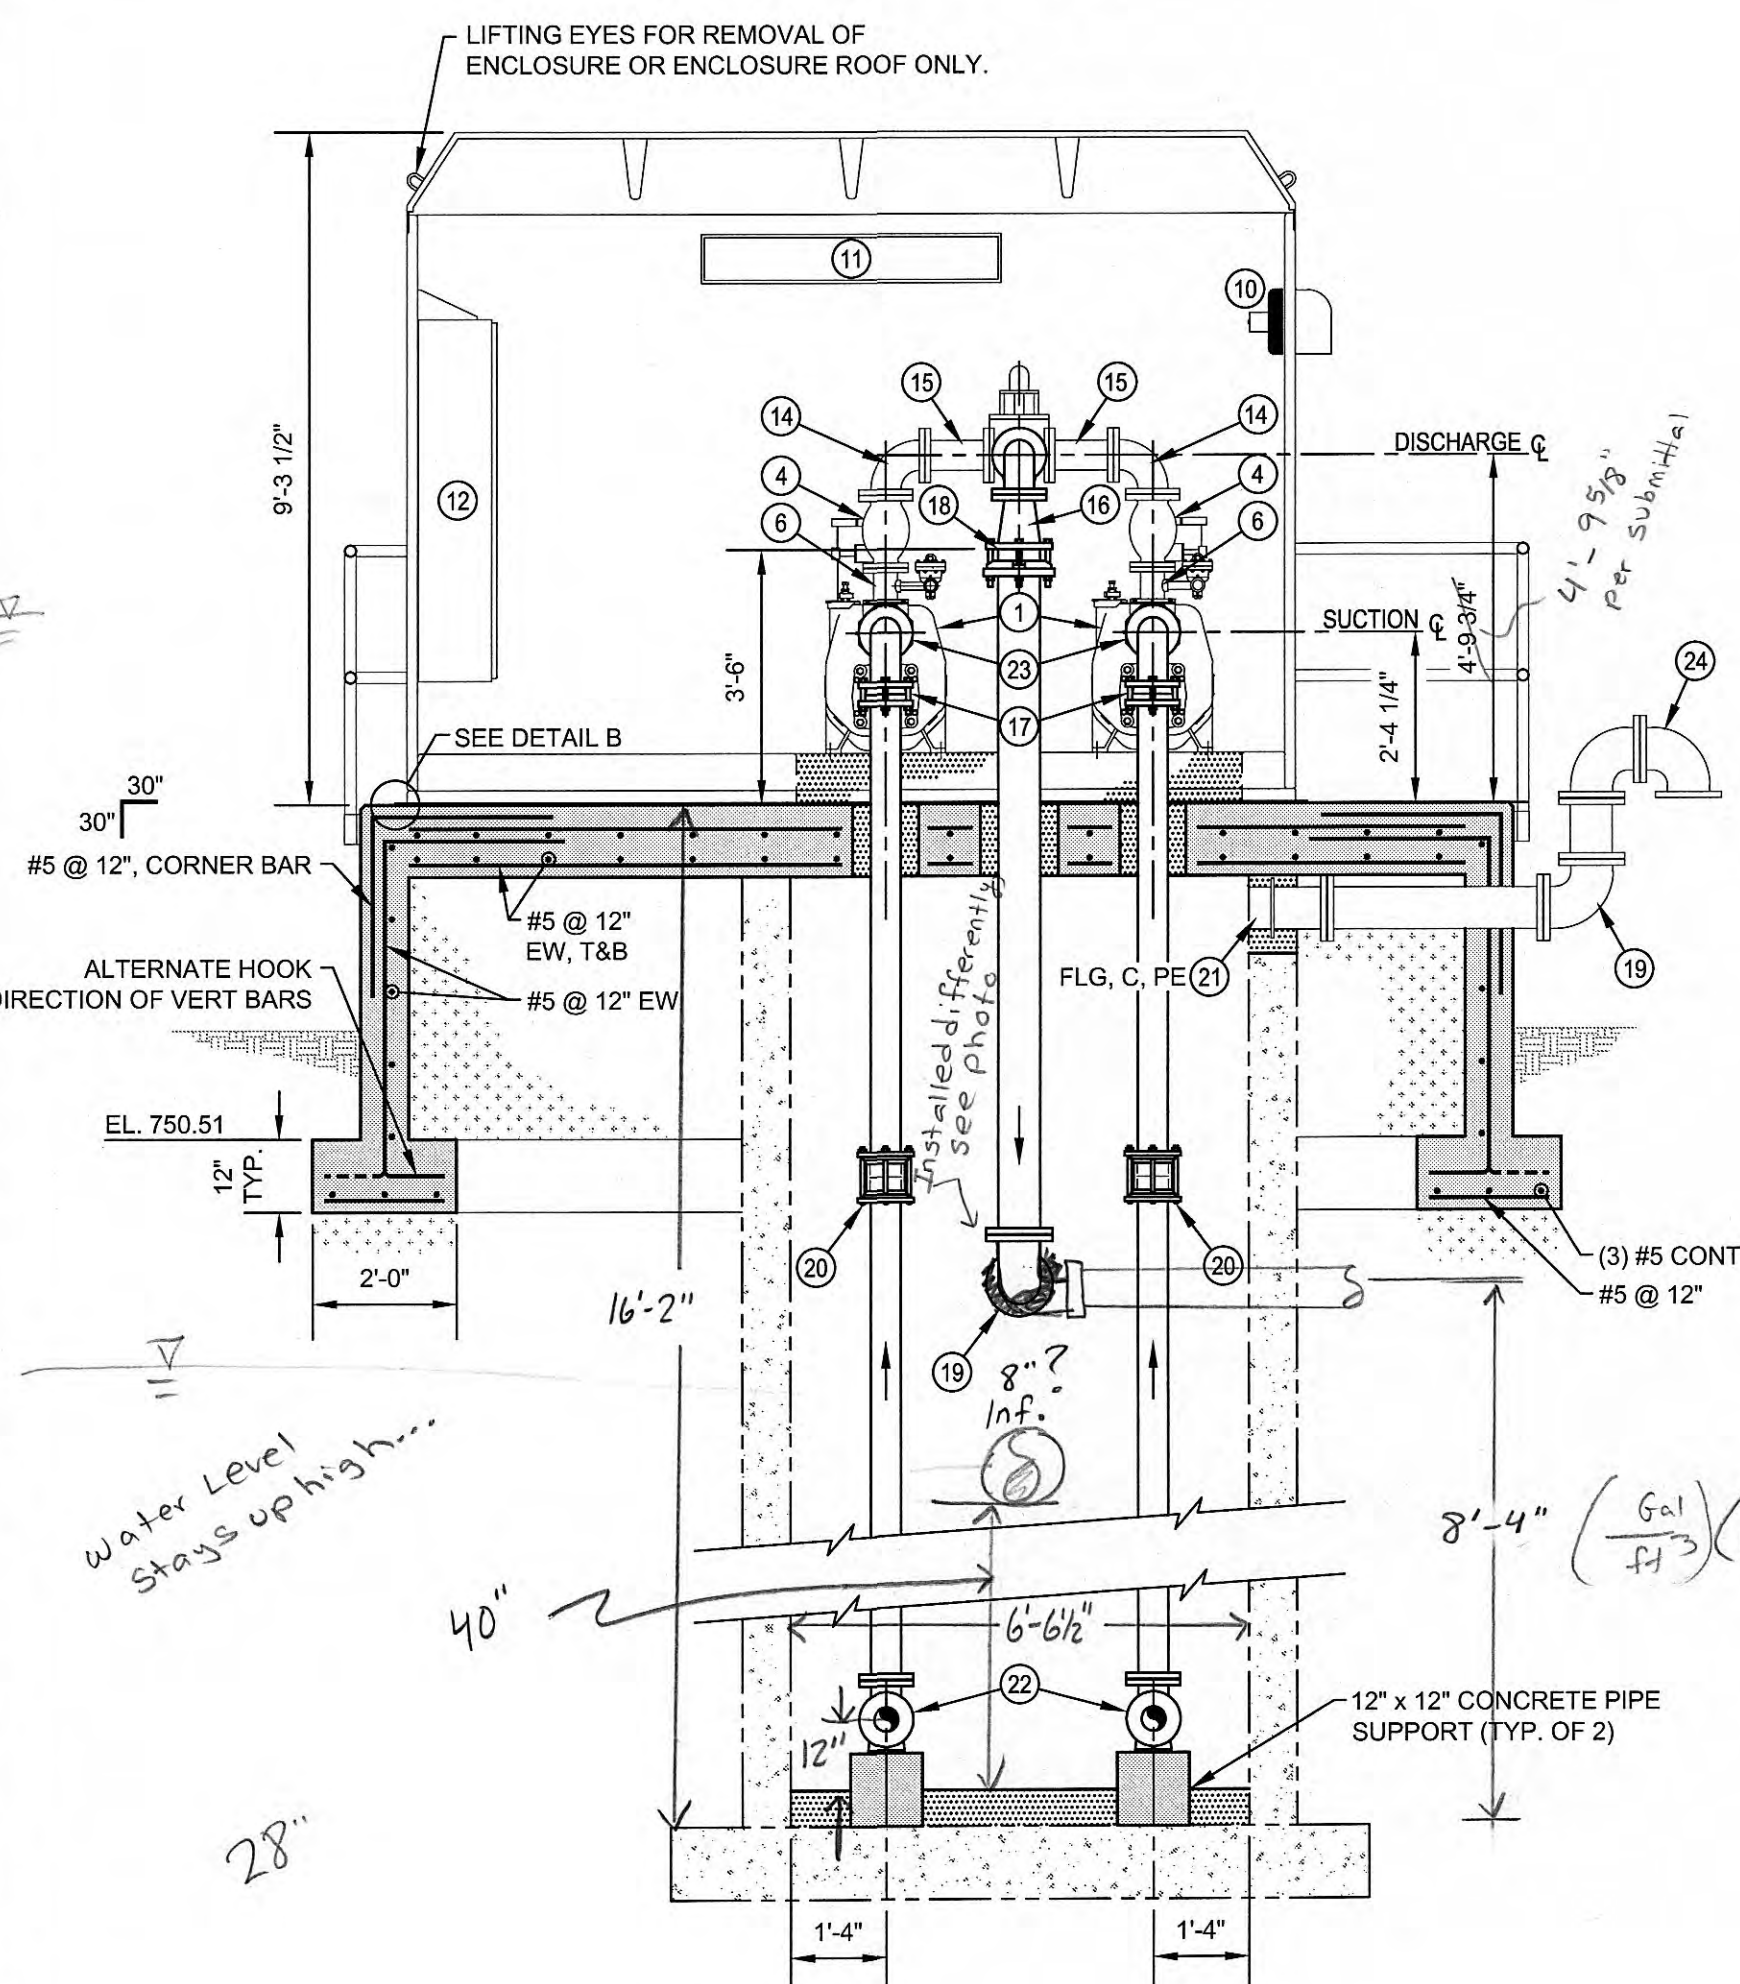

1 SECTION
SCALE: 3/8"=1'-0" 0 2' 4'

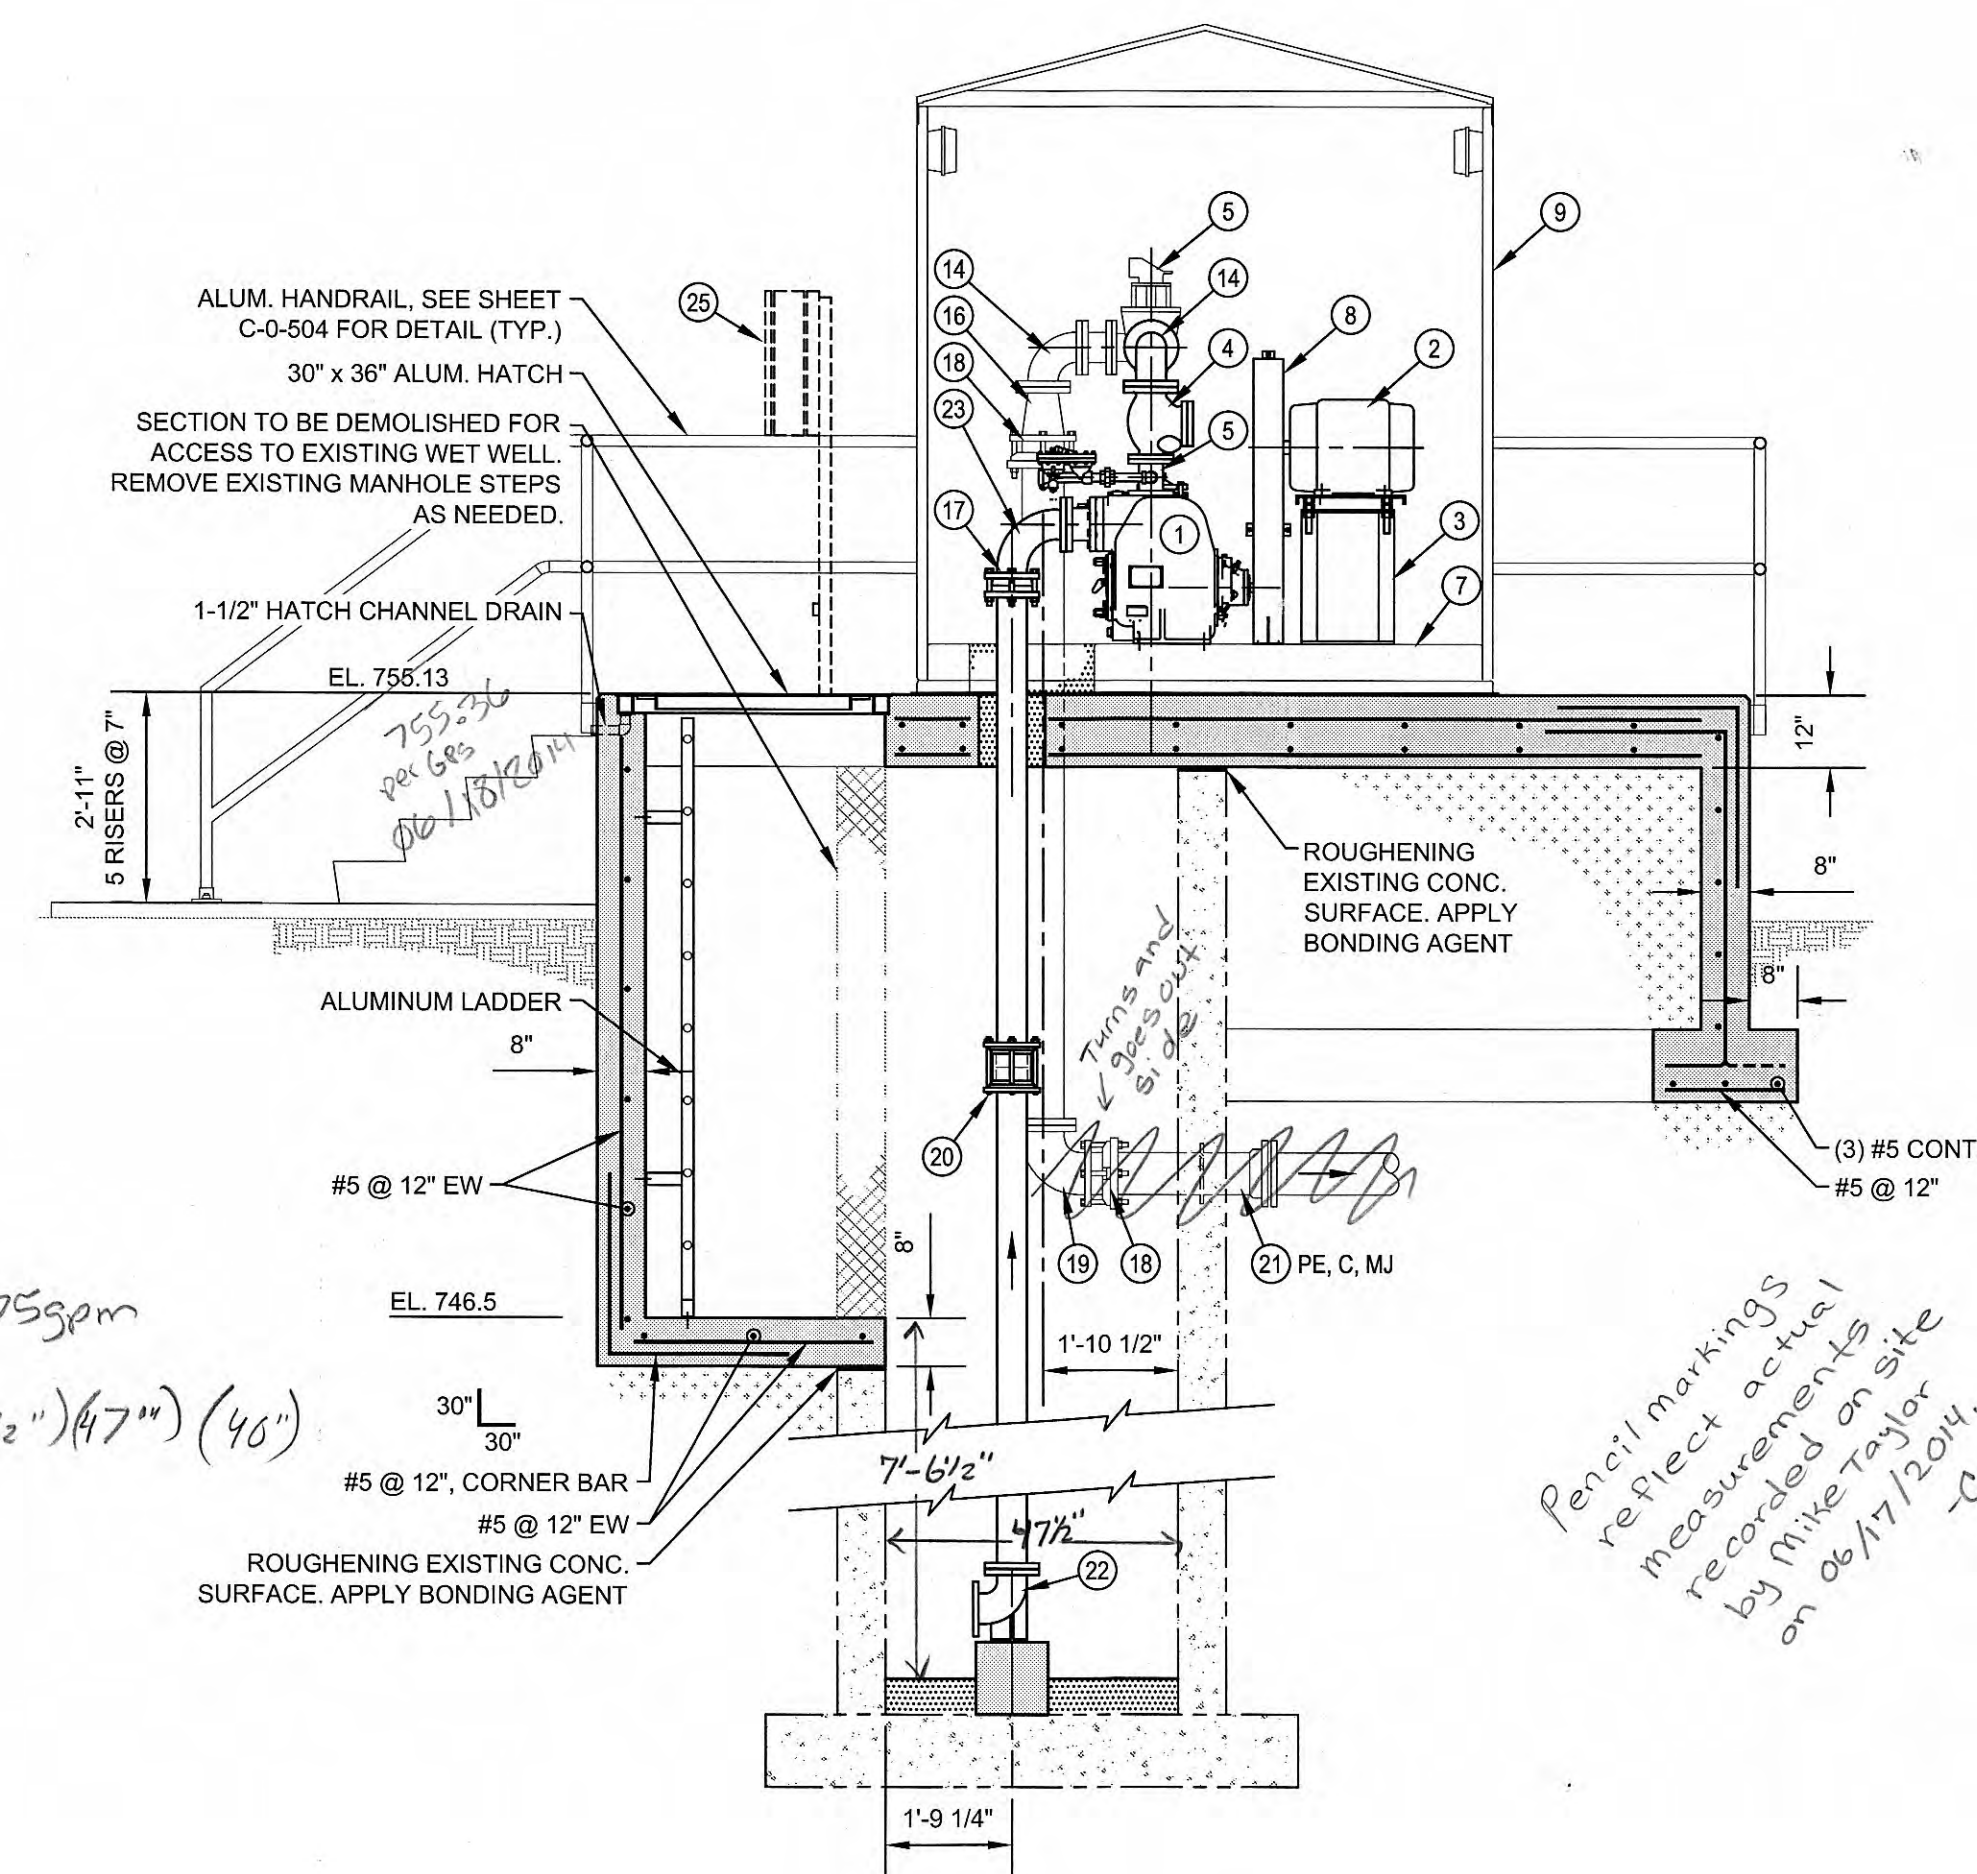

2 SECTION

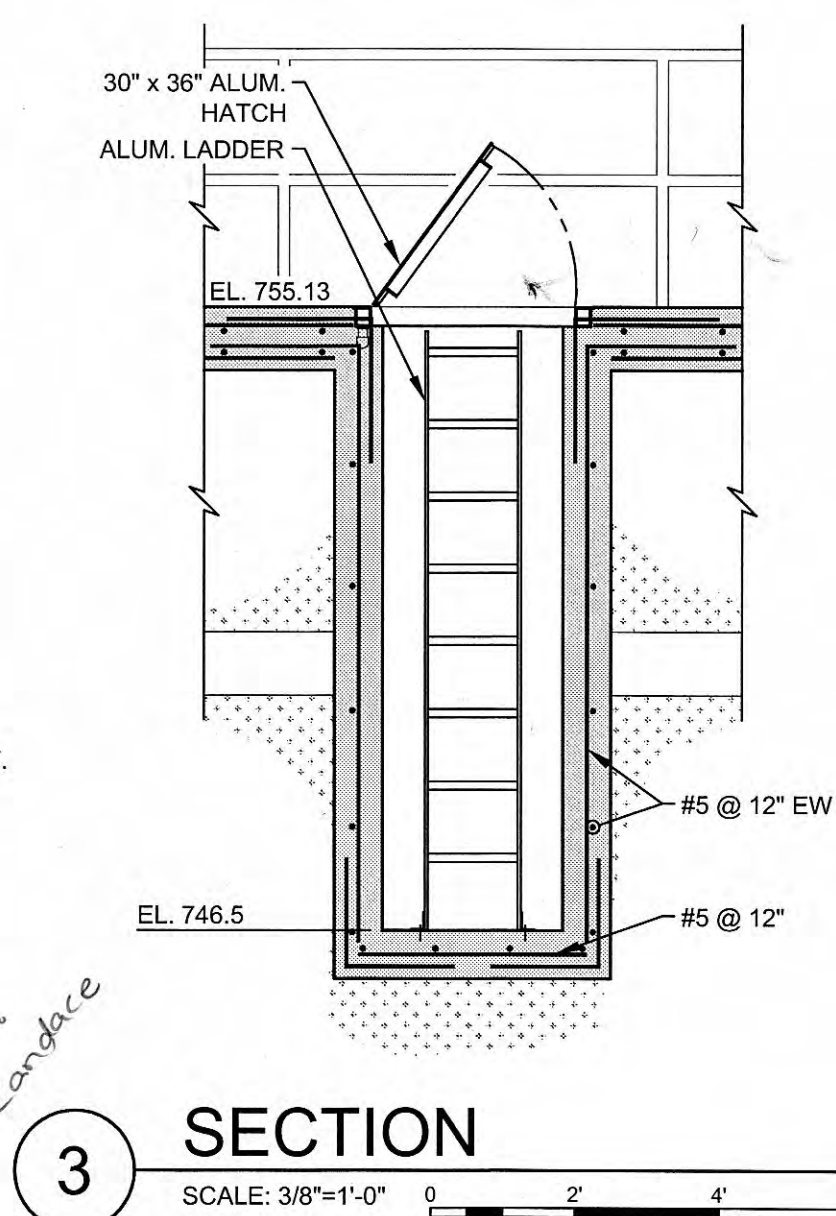


3 SECTION

SCALE: 3/8"=1'-0"

0 2' 4'

THIS RECORD DOCUMENT HAS BEEN PREPARED BASED ON INFORMATION PROVIDED BY THE CONSTRUCTION CONTRACTOR, GRW ENGINEERS, INC.'S ATTEMPTED TO VERIFY THE ACCURACY AND/OR COMPLETENESS OF THIS INFORMATION BUT SHALL NOT BE RESPONSIBLE FOR ANY ERRORS OR OMISSIONS WHICH MAY BE INCORPORATED HEREIN AS A RESULT.


GRW Engineers, Inc.
Engineers, Architects, Planners
and Environmental Scientists
10000 Corporate Square, Suite 200
Houston, Texas 77036
713/661-1100

ENGINEER'S REPRESENTATIVE: S. Morris

CONSTRUCTION COMPANY: PORTLAND UTILITIES CONST. CO.

DATE: 3/XX/2012



GRW PROJECT NO. 3947-02

CLIENT PROJECT NO. XXXXX

ALL RIGHTS RESERVED:
THIS DOCUMENT IS THE PROPERTY OF
GRW ENGINEERS, INC. AND SHALL NOT

OR USED FOR CONSTRUCTION OF
OTHER THAN THIS SPECIFIC PROJECT
WITHOUT WRITTEN PERMISSION

STATE SUBMITTAL



ENGINEERS - ARCHITECTS - PLANNERS

www.grwinc.com

NEW W.A.S. PUMP STATION
PLANS AND SECTIONS
WAYS PUMP STATION IMPROVEMENTS & SEWER REHAB
CITY OF HARRIMAN, TENNESSEE

ALY VISION		BY		CAJ
NO	DESCRIPTION	DATE		DRAWN:
				CAJ
				REVIEWED:
				RGT
				APPROVED:
SCALE CHECK: <input type="checkbox"/> THIS MARK SHOULD MEASURE EXACTLY 1" WHEN PLOTTED				RGT

DATE: MAY 2011

DATE: 01/20/2011	TIME: 10:00
SALE:	


AS SHOWN

SHEET NO.

100


C 1 103

C-1-103

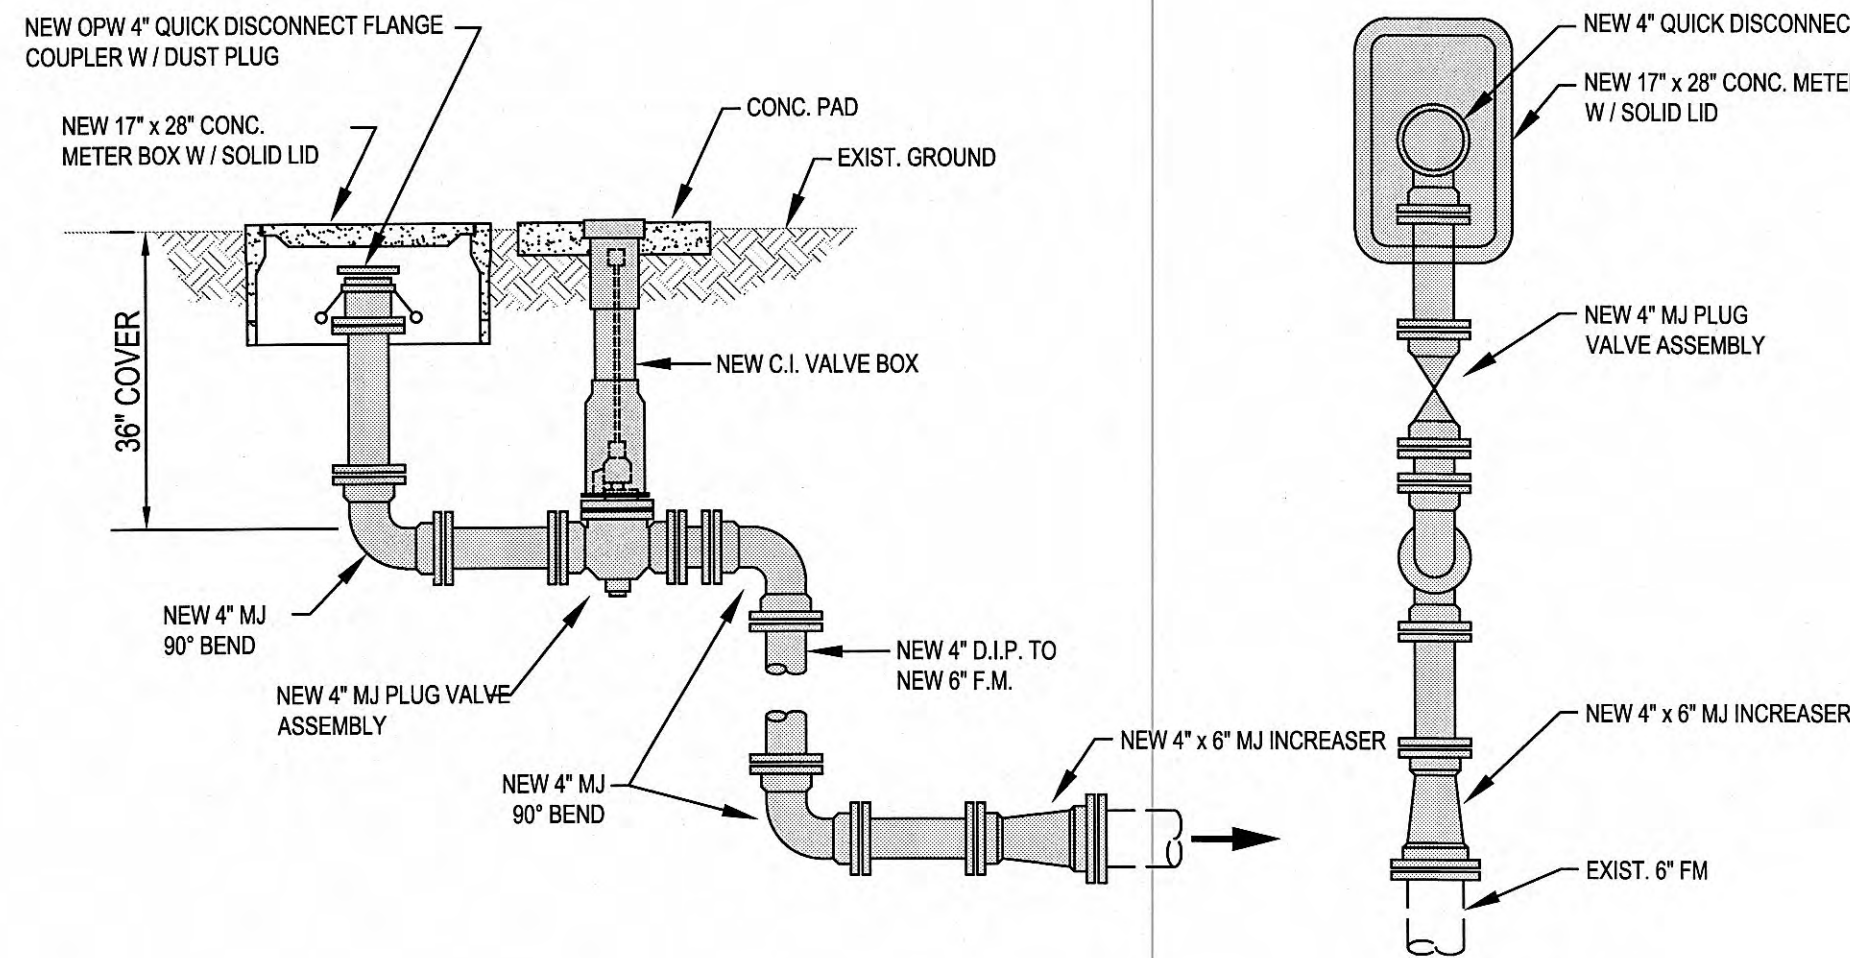

EMERGENCY CONNECTION DETAIL

SCALE: 1/2"=1'-0"

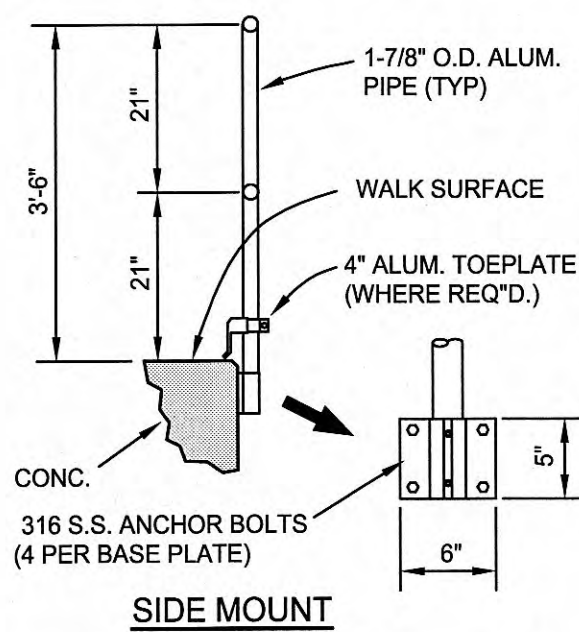


TYPICAL HANDRAIL DETAIL

NOT TO SCALE

STRUCTURAL NOTES


CONDITION	CLEAR COVER OVER BARS
CONCRETE CAST AGAINST AND PERMANENTLY EXPOSED TO EARTH	3"
CONCRETE EXPOSED TO EARTH OR WEATHER	2"
#6 THROUGH #18 BARS	1 1/2"
#5 BAR, W31 OR D31 WIRE AND SMALLER	1 1/2"
CONCRETE NOT EXPOSED TO WEATHER OR IN CONTACT WITH GROUND	1 1/2"
SLABS, WALLS, AND JOISTS	3/4"
#14 AND #18 BARS	
#11 BAR AND SMALLER	

- NOTES:
1. MAIN REINFORCING INTERRUPTED BY OPENING TO BE LOCATED EQUALLY ON EACH SIDE OF OPENING.
 2. ADD MAIN STEEL OR TEMPERATURE REINFORCING AS SCHEDULED OPPOSITE THE OPENING.
 3. ADD (2) #5 TOP & BOTTOM ON EACH SIDE OF OPENING UNLESS OTHERWISE NOTED ON PLAN.
 4. ADD DIAGONAL BARS (#4 TOP & BOTTOM x 3'-0").
 5. IF OPENING DIMENSION IS < 16", SPREAD SCHEDULED REINFORCING & ADD CORNER BARS.

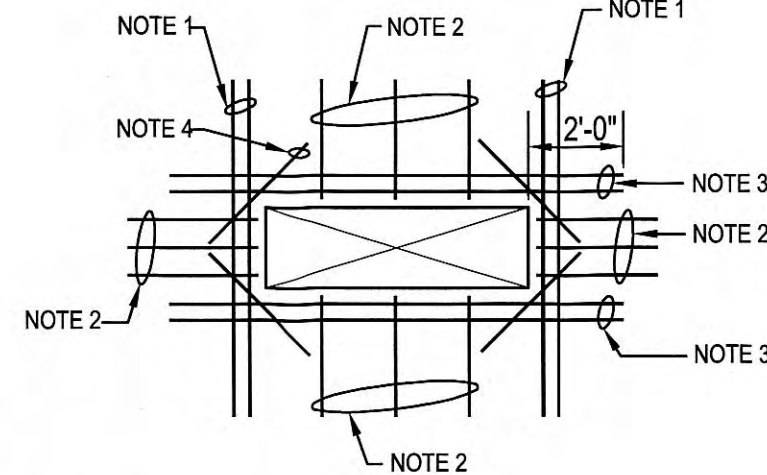

REINFORCING AT FLOOR OPENINGS


NOT TO SCALE

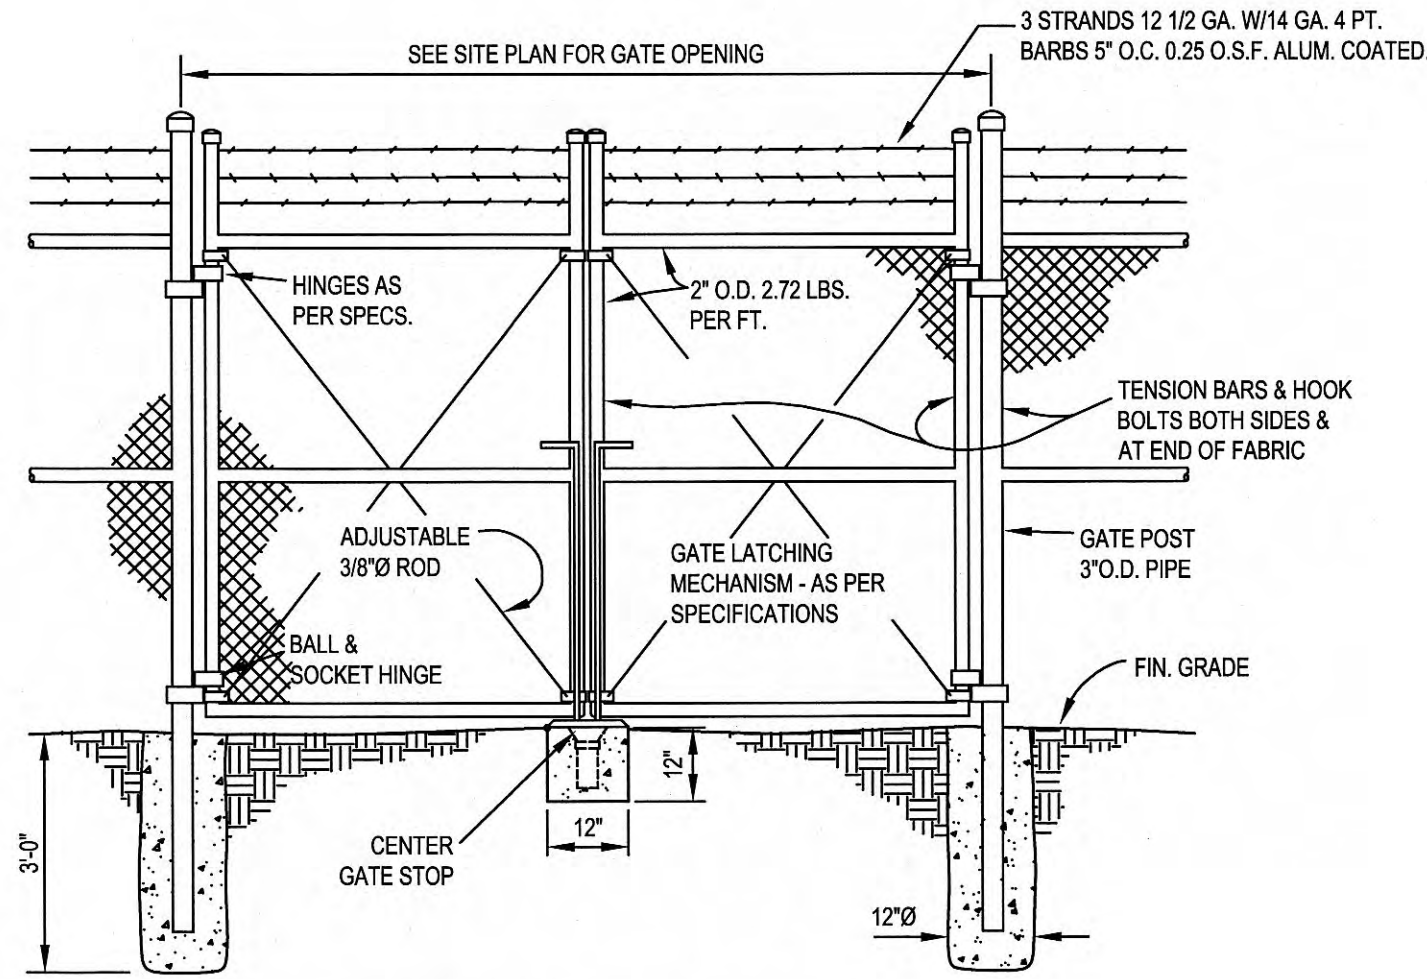

ALL POSTS & OTHER APPURTENANCES SHALL BE HOT DIP GALVANIZED WITHIN 2.0 O.S.F. ZINC. ALL FITTINGS SHALL BE MALLEABLE CAST IRON OR PRESSED STEEL.


GATE DETAIL

NOT TO SCALE

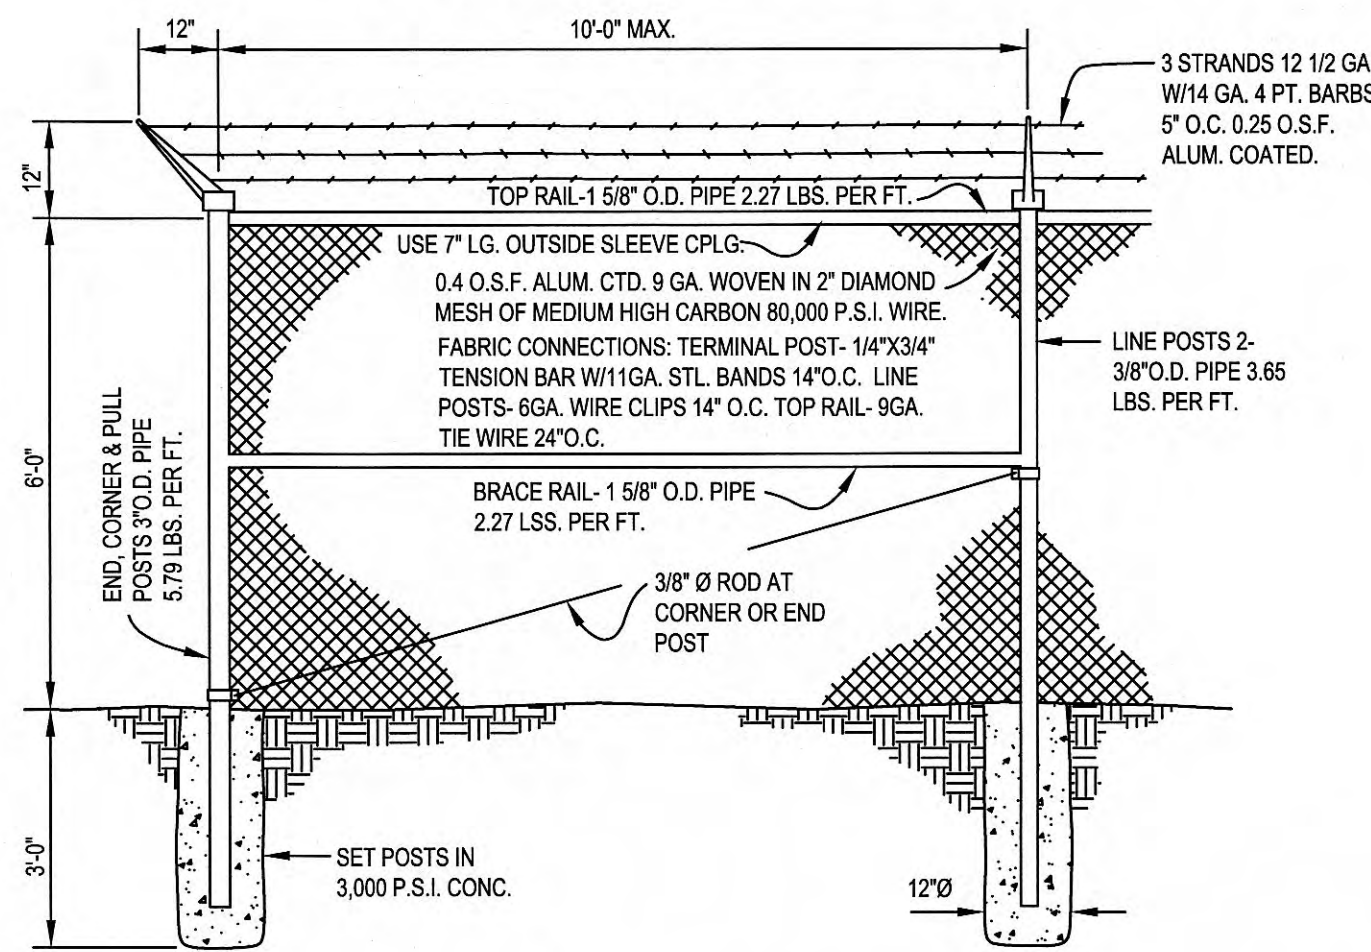

FENCE DETAIL

NOT TO SCALE

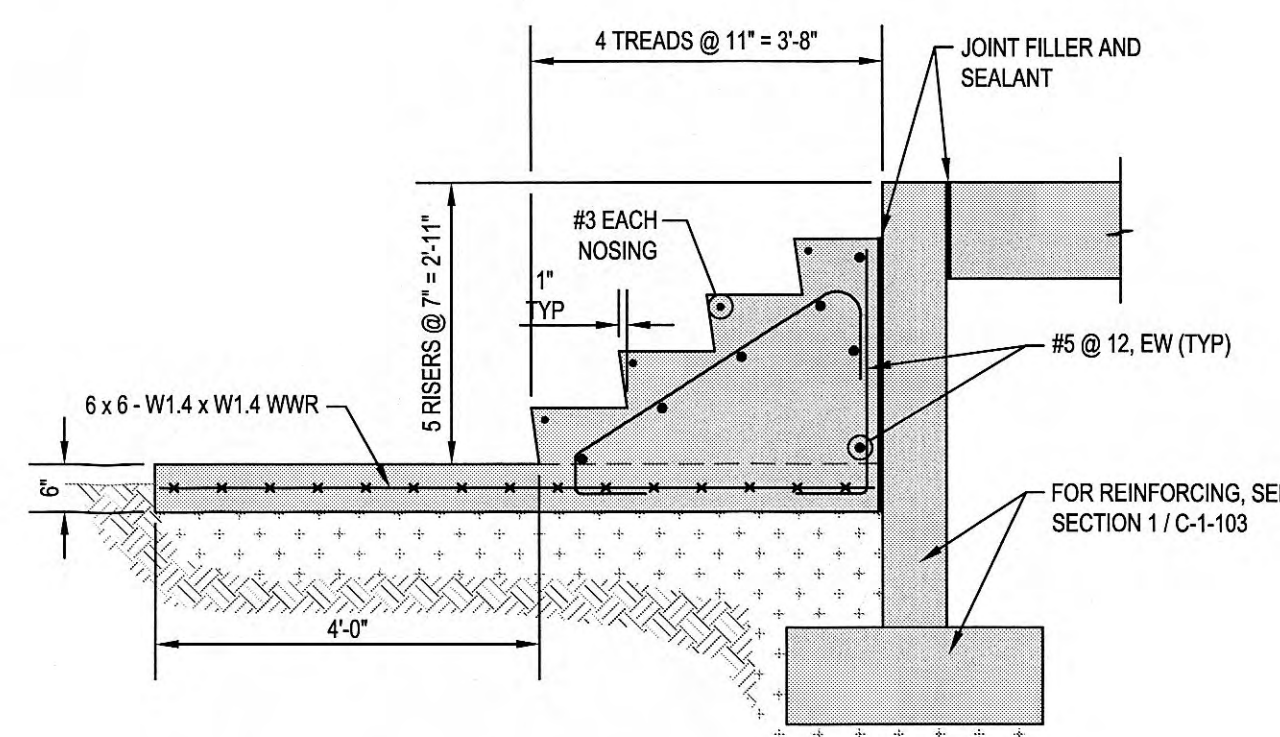



STAIR SECTION

SCALE: 1/2"=1'-0"

SILT FENCE SPECIFICATIONS

TYPE FENCE	A	B	C
TENSILE STRENGTH (LBS. MIN.) (1) (ASTM D-4632)	WARP - 120 FILL - 100	WARP - 120 FILL - 100	WARP - 360 FILL - 180
ELONGATION (% MAX.) (ASTM D-4632)	40	40	40
AOS (APPARENT OPENING SIZE) (SIZE) (ASTM D-4751)	(MAX. SIEVE #30)	#30	#30
FLOW RATE (GAL/MIN/SQ. FT.) (GDT-87)	25	25	70
ULTRAVIOLET STABILITY (2) AFTER 300 HOURS WEATHERING IN ACCORDANCE WITH ASTM D-4395	80	80	80
BURSTING STRENGTH (PSI MIN.) (ASTM D-3786 DIAPHRAGM BURSTING STRENGTH TESTER)	175	175	175
MINIMUM FABRIC WIDTH (INCHES)	36	22	36

(1) MINIMUM ROLL AVERAGE OF FIVE SPECIMENS.
(2) PERCENT OF REQUIRED INITIAL MINIMUM TENSILE STRENGTH.

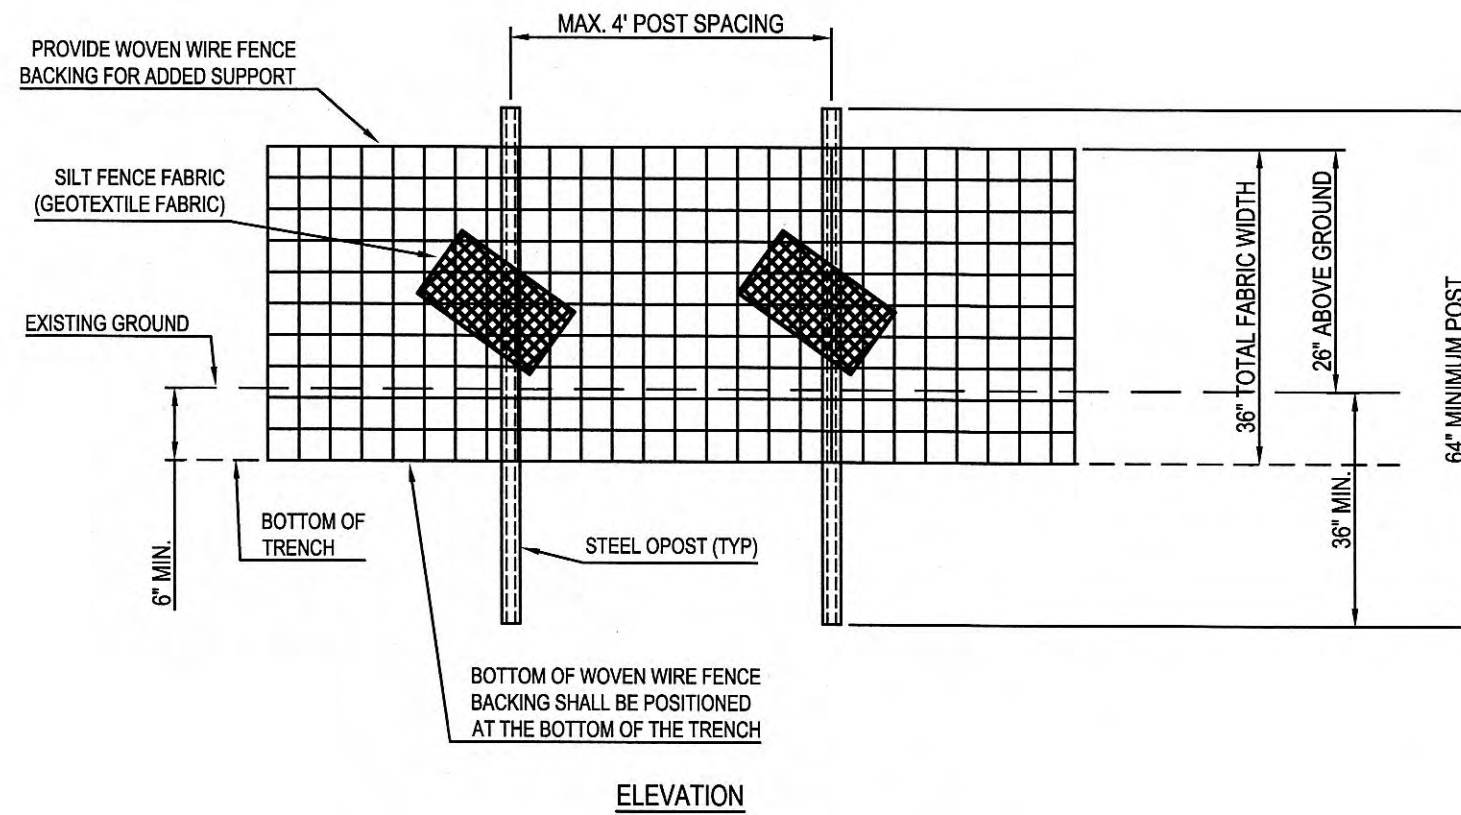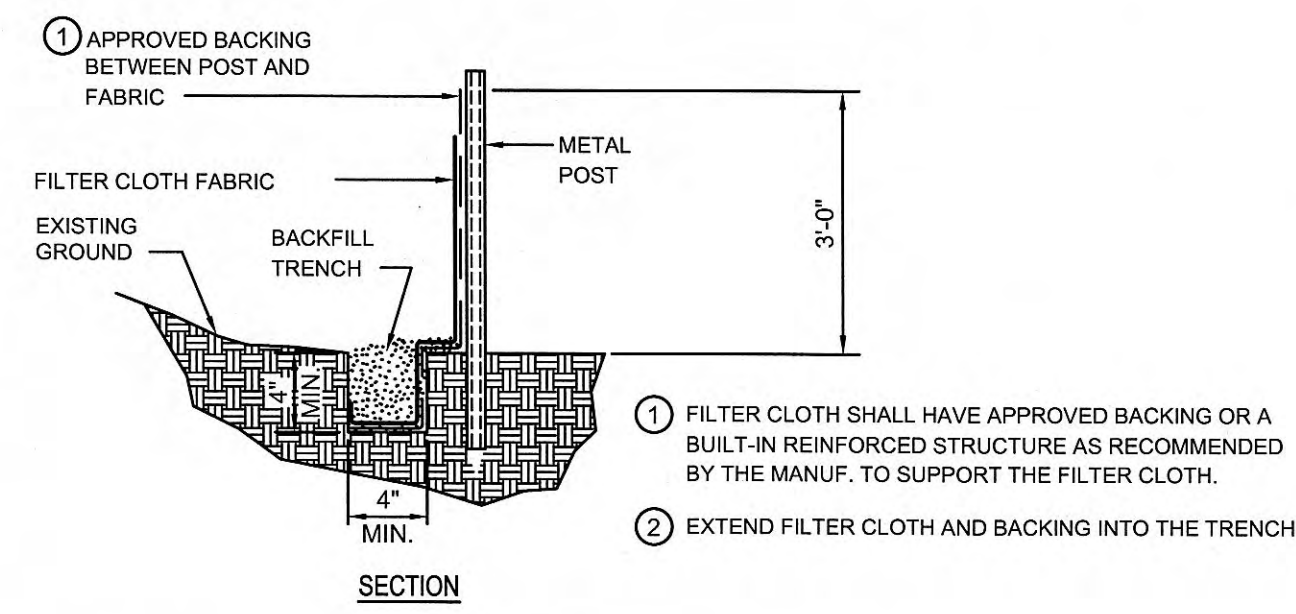

SILT FENCE DETAIL

NOT TO SCALE

THIS RECORD DOCUMENT HAS BEEN PREPARED BASED ON INFORMATION PROVIDED BY THE CONSTRUCTION CONTRACTOR. GRW ENGINEERS, INC. HAS ATTEMPTED TO VERIFY THE ACCURACY AND/OR COMPLETENESS OF THIS INFORMATION BUT SHALL NOT BE RESPONSIBLE FOR ANY ERRORS OR OMISSIONS WHICH MAY BE INCORPORATED HEREIN AS A RESULT.

GRW Engineers, Inc.
Engineers, Architects, Planners

ENGINEER'S REPRESENTATIVE: *B. Morris*
CONSTRUCTION COMPANY: *PORTLAND UTILITIES CONST. CO.*
DATE: *3/11/2012*



GRW PROJECT NO. 3947-02
CLIENT PROJECT NO. XXXXX
ALL RIGHTS RESERVED. NO PART OF THIS DOCUMENT SHALL BE REPRODUCED IN WHOLE OR IN PART WITHOUT THE WRITTEN PERMISSION OF GRW ENGINEERS, INC.



STANDARD DETAILS

MAYS PUMP STATION IMPROVEMENTS & SEWER REHAB


CITY OF HARRIMAN, TENNESSEE

DESIGNED:	CAJ
DRAWN:	CAJ
REVIEWED:	RGT
APPROVED:	RGT

REVISIONS	DATE	DESCRIPTION
NO.		
1		
2		
3		
4		
5		
6		
7		
8		
9		
10		

DATE: MAY 2011
SCALE: AS SHOWN
SHEET NO.

C-0-504

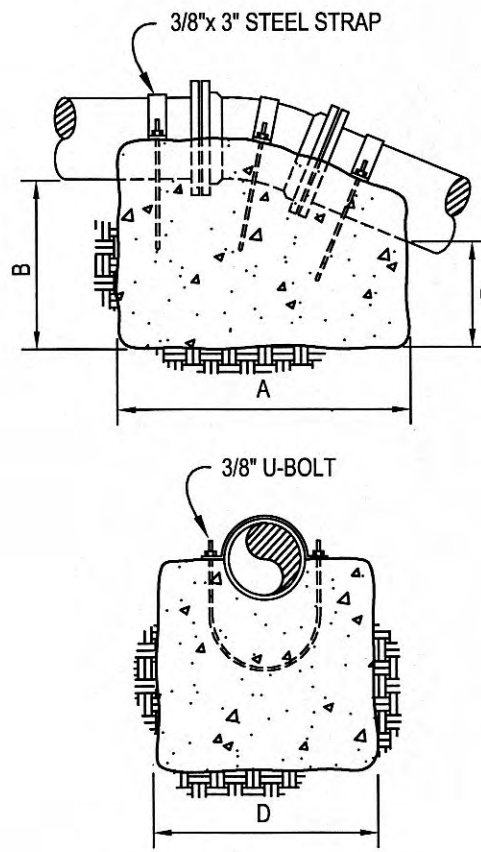

- NOTES:
- THRUST BLOCKS DESIGNED FOR 150 PSI PRESSURE. FOR GREATER PRESSURE QUANTITIES WILL HAVE TO BE RECALCULATED.
 - THRUST BLOCKING TO BE POURED AGAINST UNDISTURBED EARTH.
 - IF EXACT SIZE PIPE BLOCKING IS NOT SHOWN, USE NEXT LARGER SIZE.
 - THRUST BLOCKING TO BE POURED IN PLACE - CLASS "C" CONCRETE.

90° BEND							
SIZE	16"	12"	10"	8"	6"	4"	2"
A	85	67	60	54	42	34	30
B	85	67	60	54	42	34	18
C	80	63	56	50	38	30	16
D	76	66	60	48	48	36	24

45° BEND							
SIZE	16"	12"	10"	8"	6"	4"	2"
A	72	60	50	46	35	30	24
B	72	60	50	46	35	28	24
C	68	56	46	42	30	24	18
D	72	60	60	48	48	36	24


22 1/2 ° BEND							
SIZE	16"	12"	10"	8"	6"	4"	2"
A	58	50	42	38	30	24	18
B	58	48	42	38	30	24	18
C	54	44	38	34	26	20	14
D	60	48	48	36	36	30	24

11 1/4 ° BEND							
SIZE	16"	12"	10"	8"	6"	4"	2"
A	42	36	30	29	24	20	18
B	42	36	30	29	24	20	18
C	38	32	26	24	20	16	14
D	60	48	48	36	30	24	24

DIMENSIONS ARE IN INCHES

VERTICAL CONCRETE ANCHOR

NOT TO SCALE

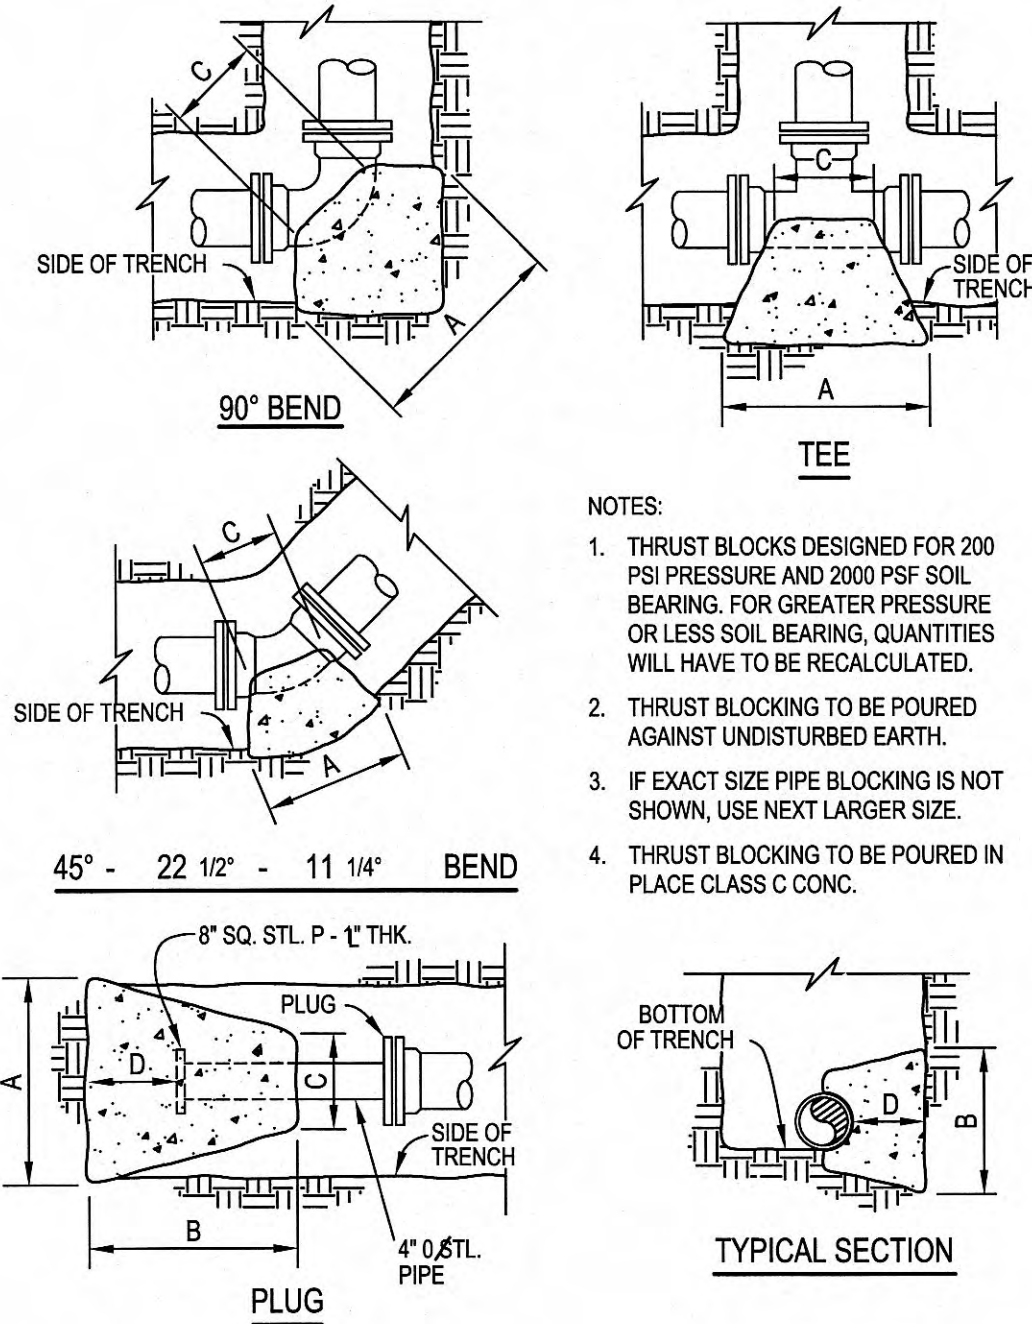

- NOTES:
- THRUST BLOCKS DESIGNED FOR 200 PSI PRESSURE AND 2000 PSF SOIL BEARING. FOR GREATER PRESSURE OR LESS SOIL BEARING, QUANTITIES WILL HAVE TO BE RECALCULATED.
 - THRUST BLOCKING TO BE POURED AGAINST UNDISTURBED EARTH.
 - IF EXACT SIZE PIPE BLOCKING IS NOT SHOWN, USE NEXT LARGER SIZE.
 - THRUST BLOCKING TO BE POURED IN PLACE CLASS C CONC.

90° BEND							
SIZE	16"	12"	10"	8"	6"	4"	2"
A	84	60	51	42	32	24	18
B	72	60	51	42	32	24	18
C	30	18	16	12	12	9	9
D	34	30	24	17	13	9	9

45° BEND							
SIZE	16"	12"	10"	8"	6"	4"	2"
A	58	43	38	32	24	18	12
B	58	43	38	32	24	18	12
C	24	16	14	12	12	8	8
D	24	18	15	12	9	6	6

22 1/2 ° BEND							
SIZE	16"	12"	10"	8"	6"	4"	2"
A	42	32	27	24	18	12	9
B	42	32	27	24	18	12	9
C	18	16	14	12	10	8	8
D	18	13	11	9	6	4	4

11 1/4 ° BEND							
SIZE	16"	12"	10"	8"	6"	4"	2"
A	30	24	21	17	12	9	9
B	30	24	21	17	12	9	9
C	18	16	14	12	10	8	8
D	12	9	8	6	5	4	4


PLUG							
SIZE	16"	12"	10"	8"	6"	4"	2"
A	66	52	43	34	27	20	18
B	66	52	43	34	27	20	18
C	12	12	12	12	12	12	12
D	44	32	22	15	11	11	11

TEE							
SIZE	16"	12"	10"	8"	6"	4"	2"
A	66	52	43	34	27	20	18
B	66	52	43	34	27	20	18
C	30	12	12	12	12	12	12
D	30	26	21	14	21	13	13

DIMENSIONS ARE IN INCHES


THRUST BLOCKING DETAIL

NOT TO SCALE

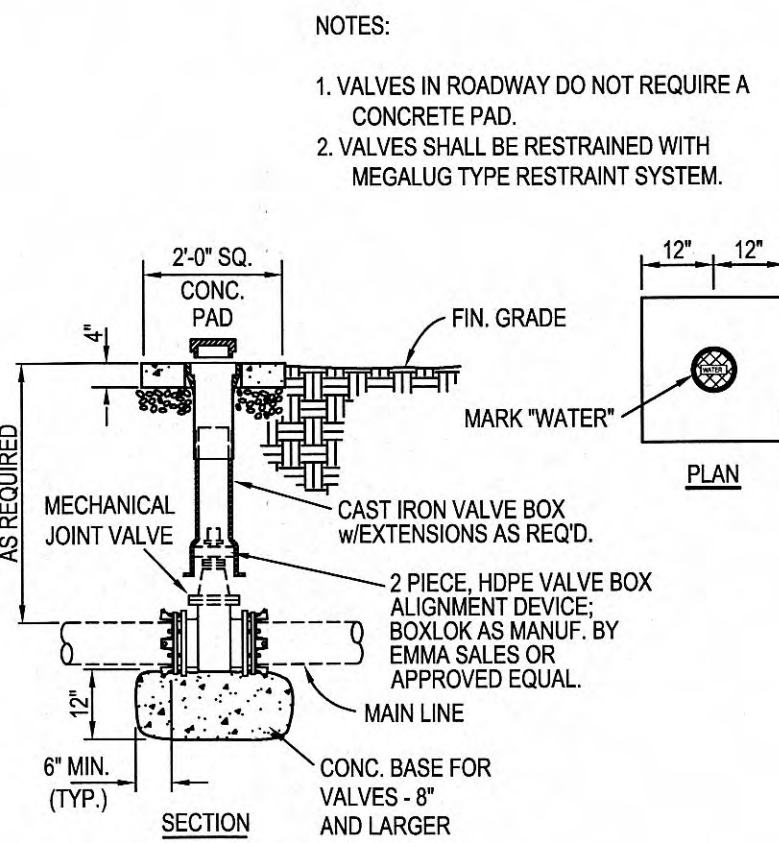


VALVE SETTING DETAIL

NOT TO SCALE

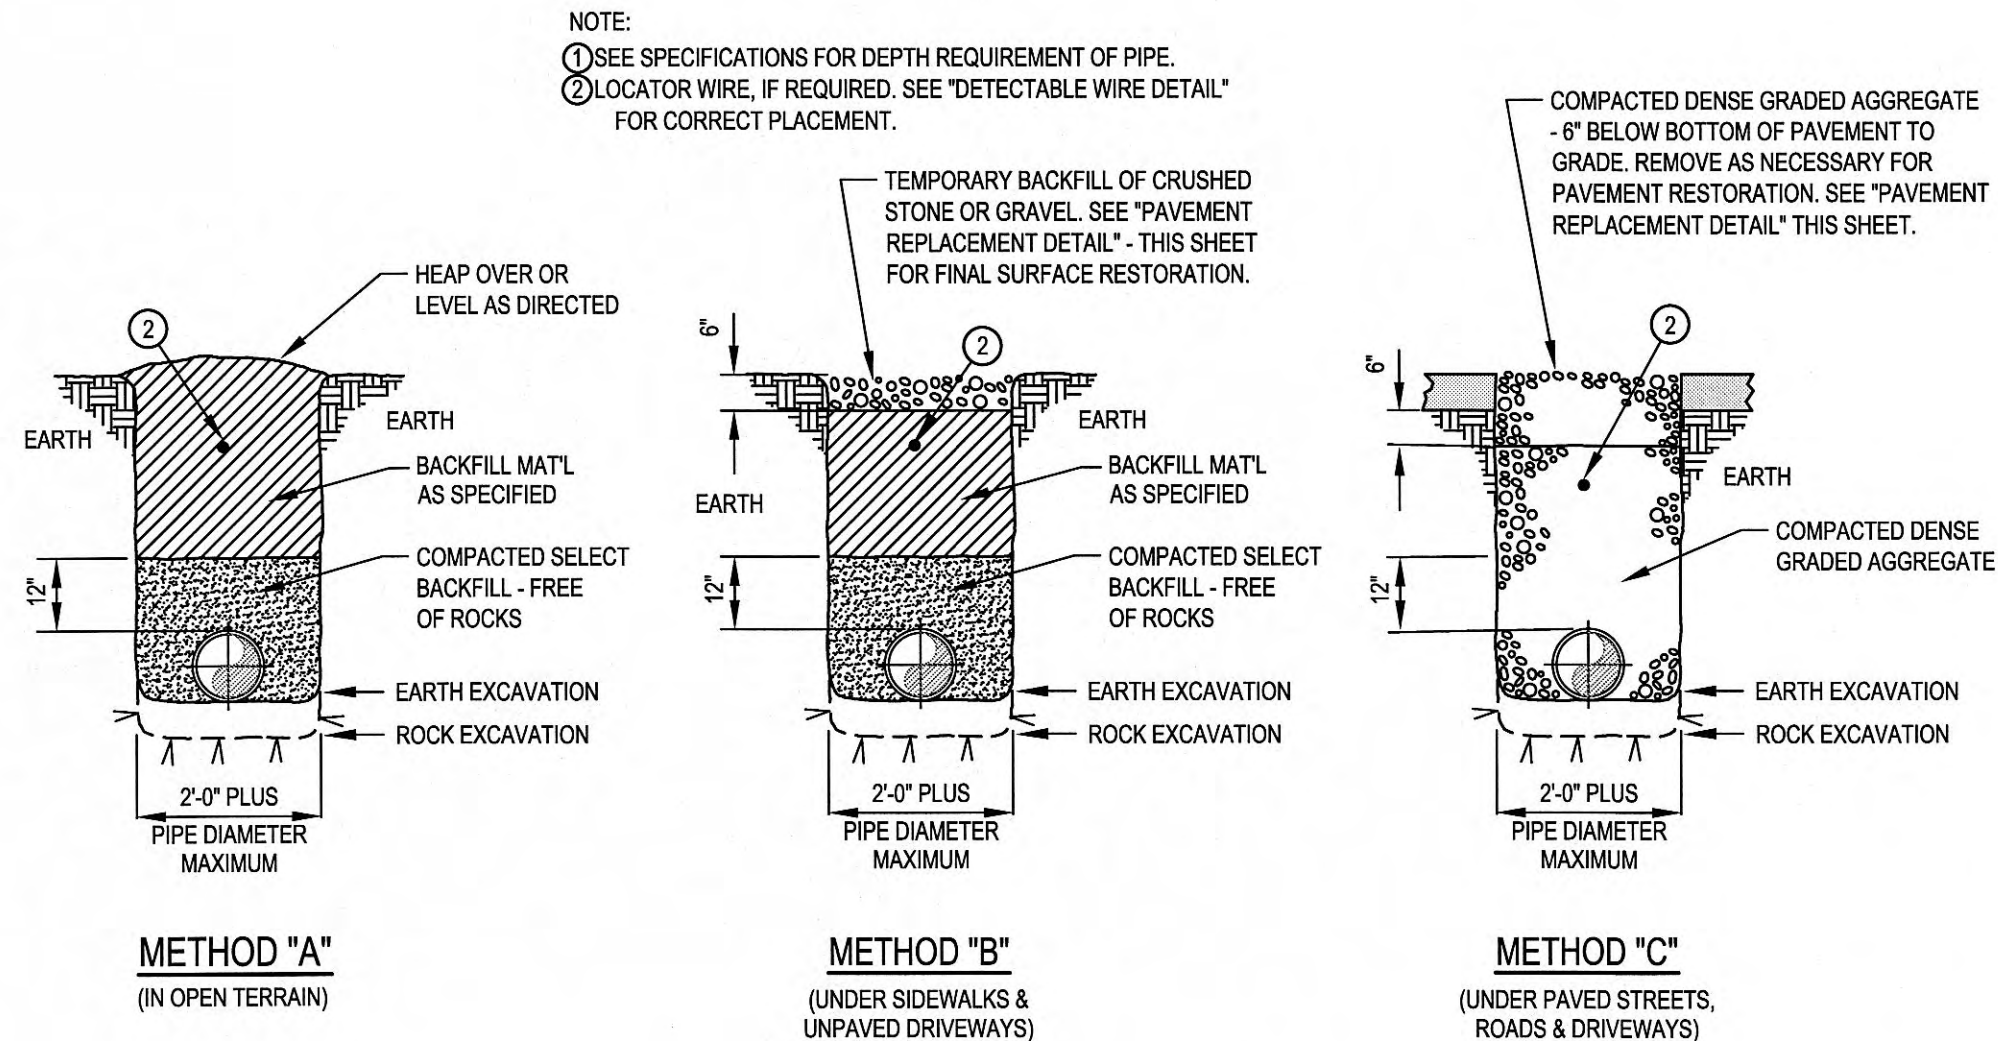

PRESSURE PIPE BEDDING AND BACKFILLING DETAILS

NOT TO SCALE

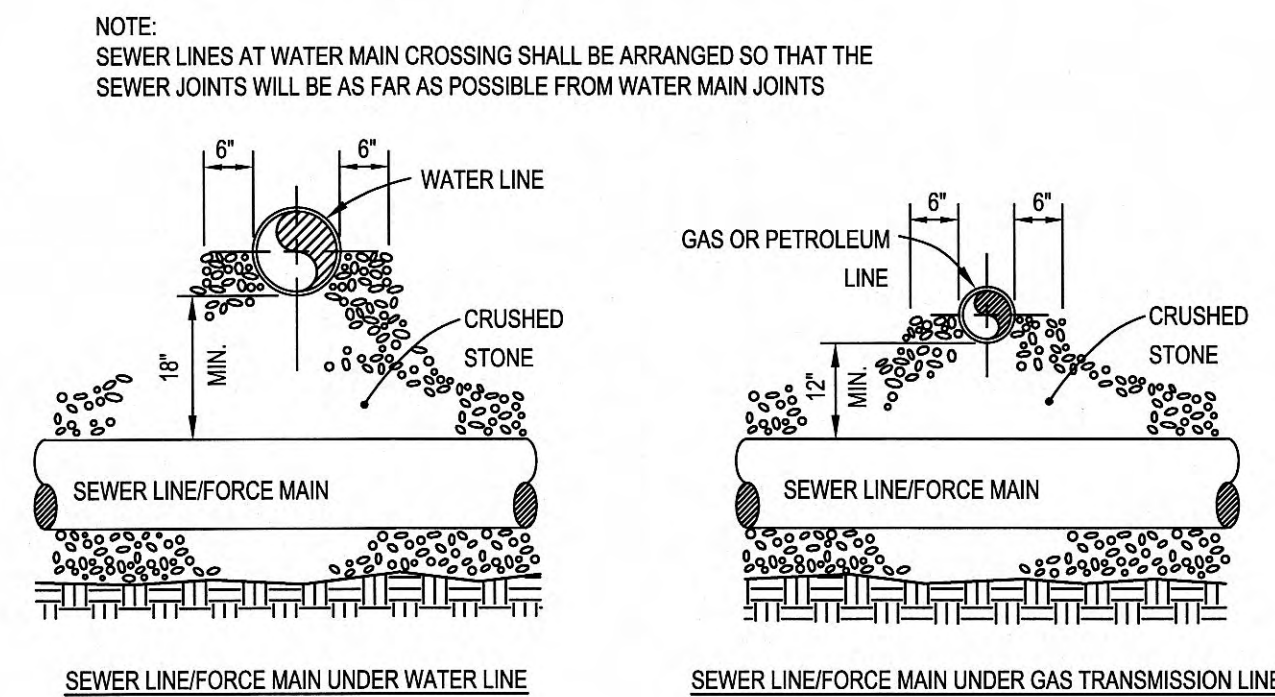

PIPE CROSSING FOR SEWER LINE/FORCE MAIN

NOT TO SCALE

THIS RECORD DOCUMENT HAS BEEN PREPARED BASED ON INFORMATION PROVIDED BY THE CONSTRUCTION CONTRACTOR. GRW ENGINEERS, INC. HAS ATTEMPTED TO VERIFY THE ACCURACY AND/OR COMPLETENESS OF THIS INFORMATION BUT SHALL NOT BE RESPONSIBLE FOR ANY ERRORS OR OMISSIONS WHICH MAY BE INCORPORATED HEREIN AS A RESULT.

GRW
GRW Engineers, Inc.
Engineers, Architects, Planners
1000 N. Main Street
Harriman, TN 37057
(615) 891-1111
www.grwinc.com

ENGINEER'S REPRESENTATIVE: *L. Morris*
CONSTRUCTION COMPANY: *CARTLAND UTILITIES CONST. CO.*
DATE: *3/22/2012*



GRW PROJECT NO. 3947-02
CLIENT PROJECT NO. XXXXX
ALL RIGHTS RESERVED. THE INFORMATION CONTAINED HEREIN IS THE PROPERTY OF GRW ENGINEERS, INC. AND SHALL NOT BE REPRODUCED IN WHOLE OR IN PART WITHOUT WRITTEN PERMISSION.

GRW
ENGINEERS - ARCHITECTS - PLANNERS
www.grwinc.com

STANDARD FORCE MAIN DETAILS
MAYS PUMP STATION IMPROVEMENTS & SEWER REHAB
CITY OF HARRIMAN, TENNESSEE

DESIGNED:	CAJ	DRAWN:	CAJ	REVIEWED:	RGT	APPROVED:	RGT
DATE:							
REVISIONS	NO.	DESCRIPTION	DATE	BY	CAJ	RGT	RGT

DATE: MAY 2011
SCALE: AS SHOWN
SHEET NO.

C-0-505

STATE SUBMITTAL