


				DESIGNED KA			HARRIMAN UTILITY BOARD HARRIMAN PRIMARY SUBSTATION ONE LINE DIAGRAM	PROJECT NUMBER: 07-70014-01317-1000
4	09-15-10			CONFORMED TO CONSTRUCTION RECORDS.		R.W. Beck 131 Saundersville Rd., Suite 300 Hendersonville, TN 37075 (615) 431-3200 <small>An SAIC Company</small>	SHEET OF: 1 1	
3	02-08-10	RNJ	KA	MISC. CORRECTIONS DURING WIRING.			DRAWING NUMBER: 01317-100.4	
2	10-30-09	RNJ	KA	REVISED CT CIRCUITS, ADDED PK TEST BLOCKS. ISSUED FOR CONSTRUCTION.				
1	10-09-09	RNJ	KA	ADDED BYPASS SWITCHES.				
0	10-02-09	RNJ	KA	ISSUED FOR BIDS.				
REV	DATE	CHKD	APPD	REVISION DESCRIPTION				
<small>Copyright 2009 R.W. BECK, INC. All Rights Reserved.</small>								


LEGEND
 **RELAY PANEL TERMINAL BLOCK**
 **INTERCONNECTIONS BETWEEN RELAY PANELS AND FIELD EQUIPMENT**
 **RELAY PANEL WIRING**
 **FIELD DEVICE TERMINAL BLOCK**



			DESIGNED RNJ	CONFORMED TO CONSTRUCTION RECORDS			HARRIMAN UTILITY BOARD HARRIMAN PRIMARY SUBSTATION SCADA ALARM CONNECTIONS	PROJECT NUMBER: 07-70014-01317-1000
DRAWN RAW								
1 09-15-10			CONFORMED TO CONSTRUCTION RECORDS.					
0 11-09-09 KA RNJ			ISSUED FOR CONSTRUCTION.					
REV DATE CHKD APPD			REVISION DESCRIPTION					

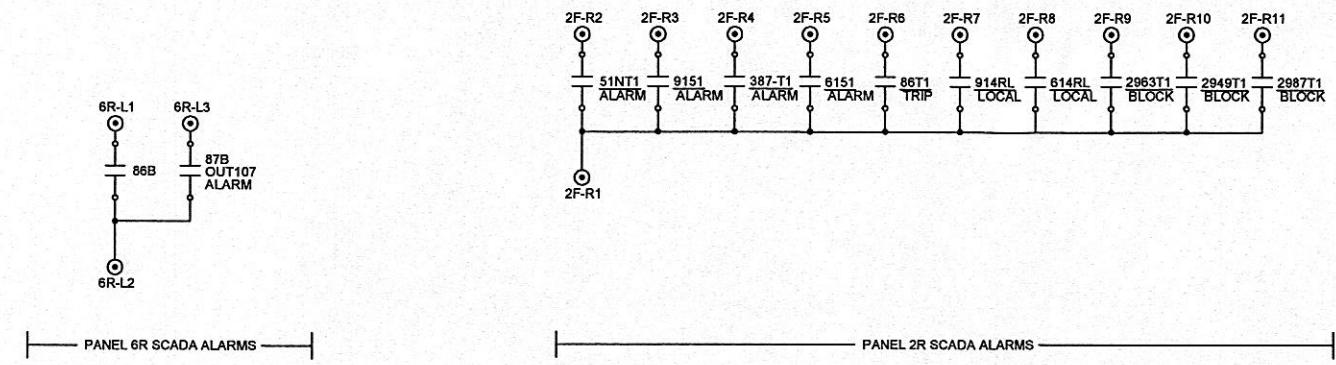

R.W. Beck
131 Saundersville Rd., Suite 300
Hendersonville, TN 37075
(615) 431-3200

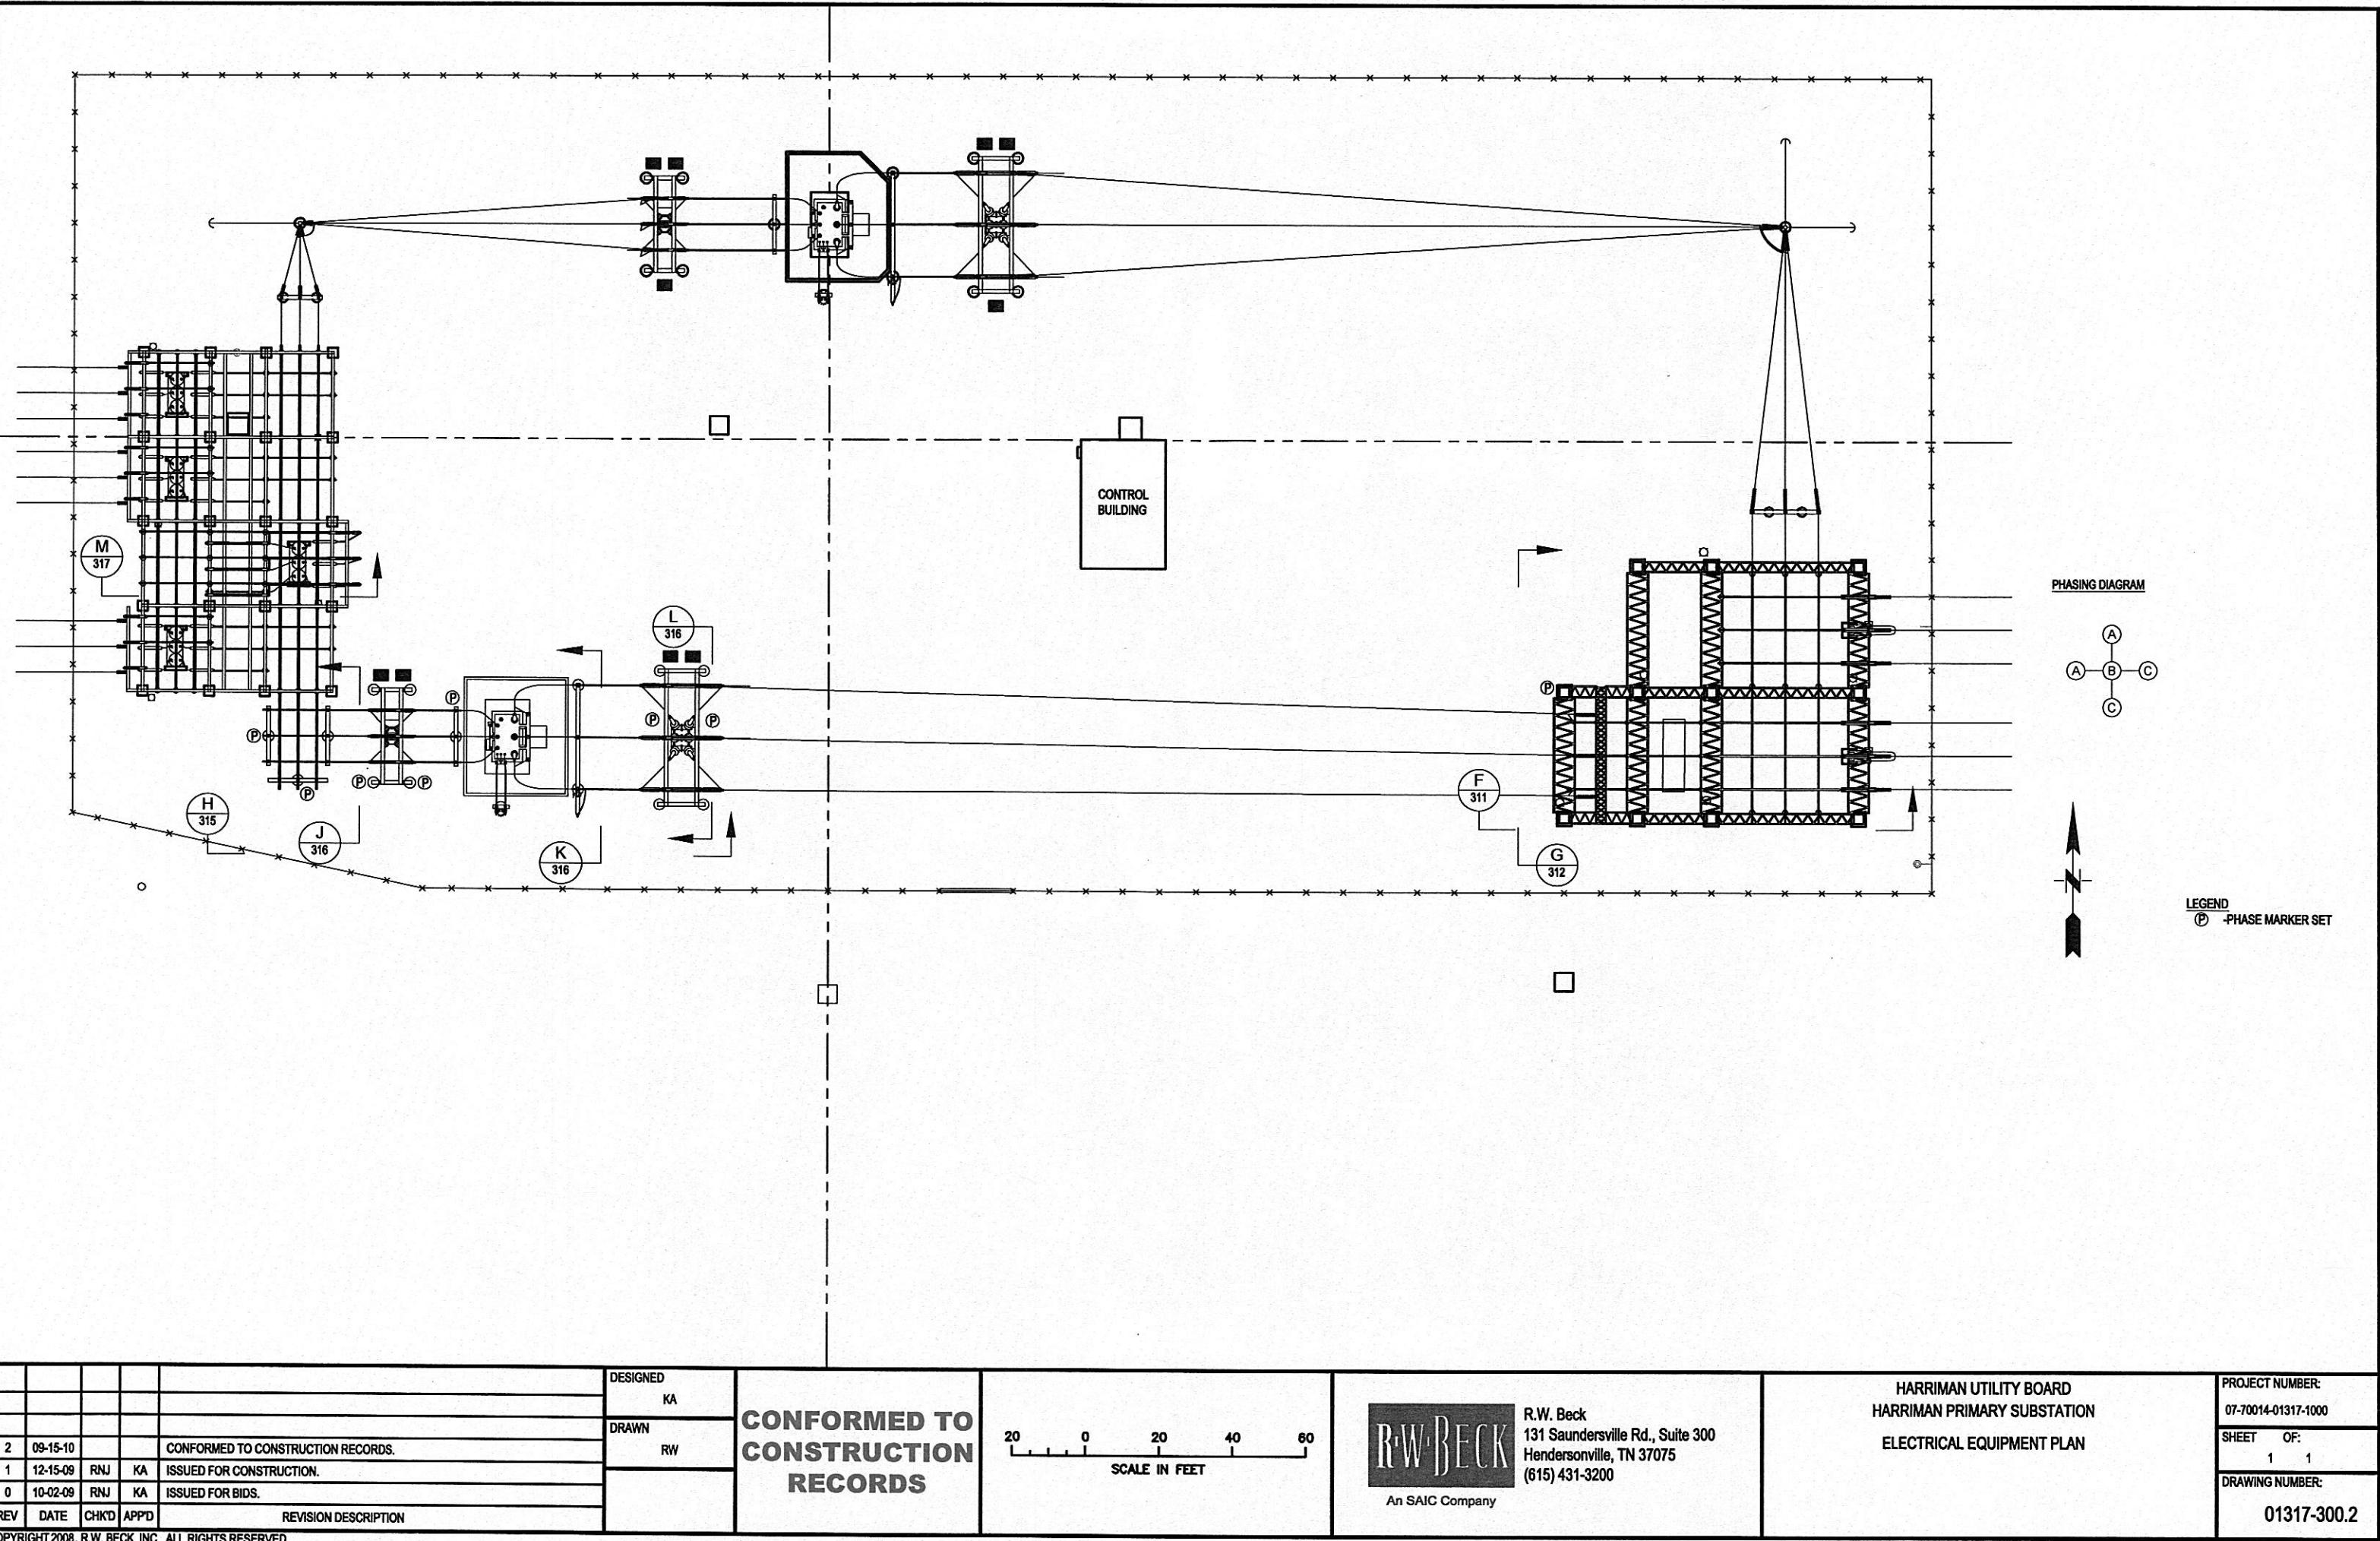

			DESIGNED KA	
REV	DATE	CHKD APPD	DRAWN RW	
2	09-15-10		CONFORMED TO CONSTRUCTION RECORDS.	
1	12-15-09	RNJ	ISSUED FOR CONSTRUCTION.	
0	10-02-09	RNJ	ISSUED FOR BIDS.	
				REVISION DESCRIPTION

**CONFORMED TO
CONSTRUCTION
RECORDS**


20 0 20 40 60
SCALE IN FEET



R.W. Beck
131 Saundersville Rd., Suite 300
Hendersonville, TN 37075
(615) 431-3200
An SAIC Company

HARRIMAN UTILITY BOARD
HARRIMAN PRIMARY SUBSTATION
ELECTRICAL EQUIPMENT PLAN


PROJECT NUMBER:
07-70014-01317-1000
SHEET OF:
1 1
DRAWING NUMBER:
01317-300.2

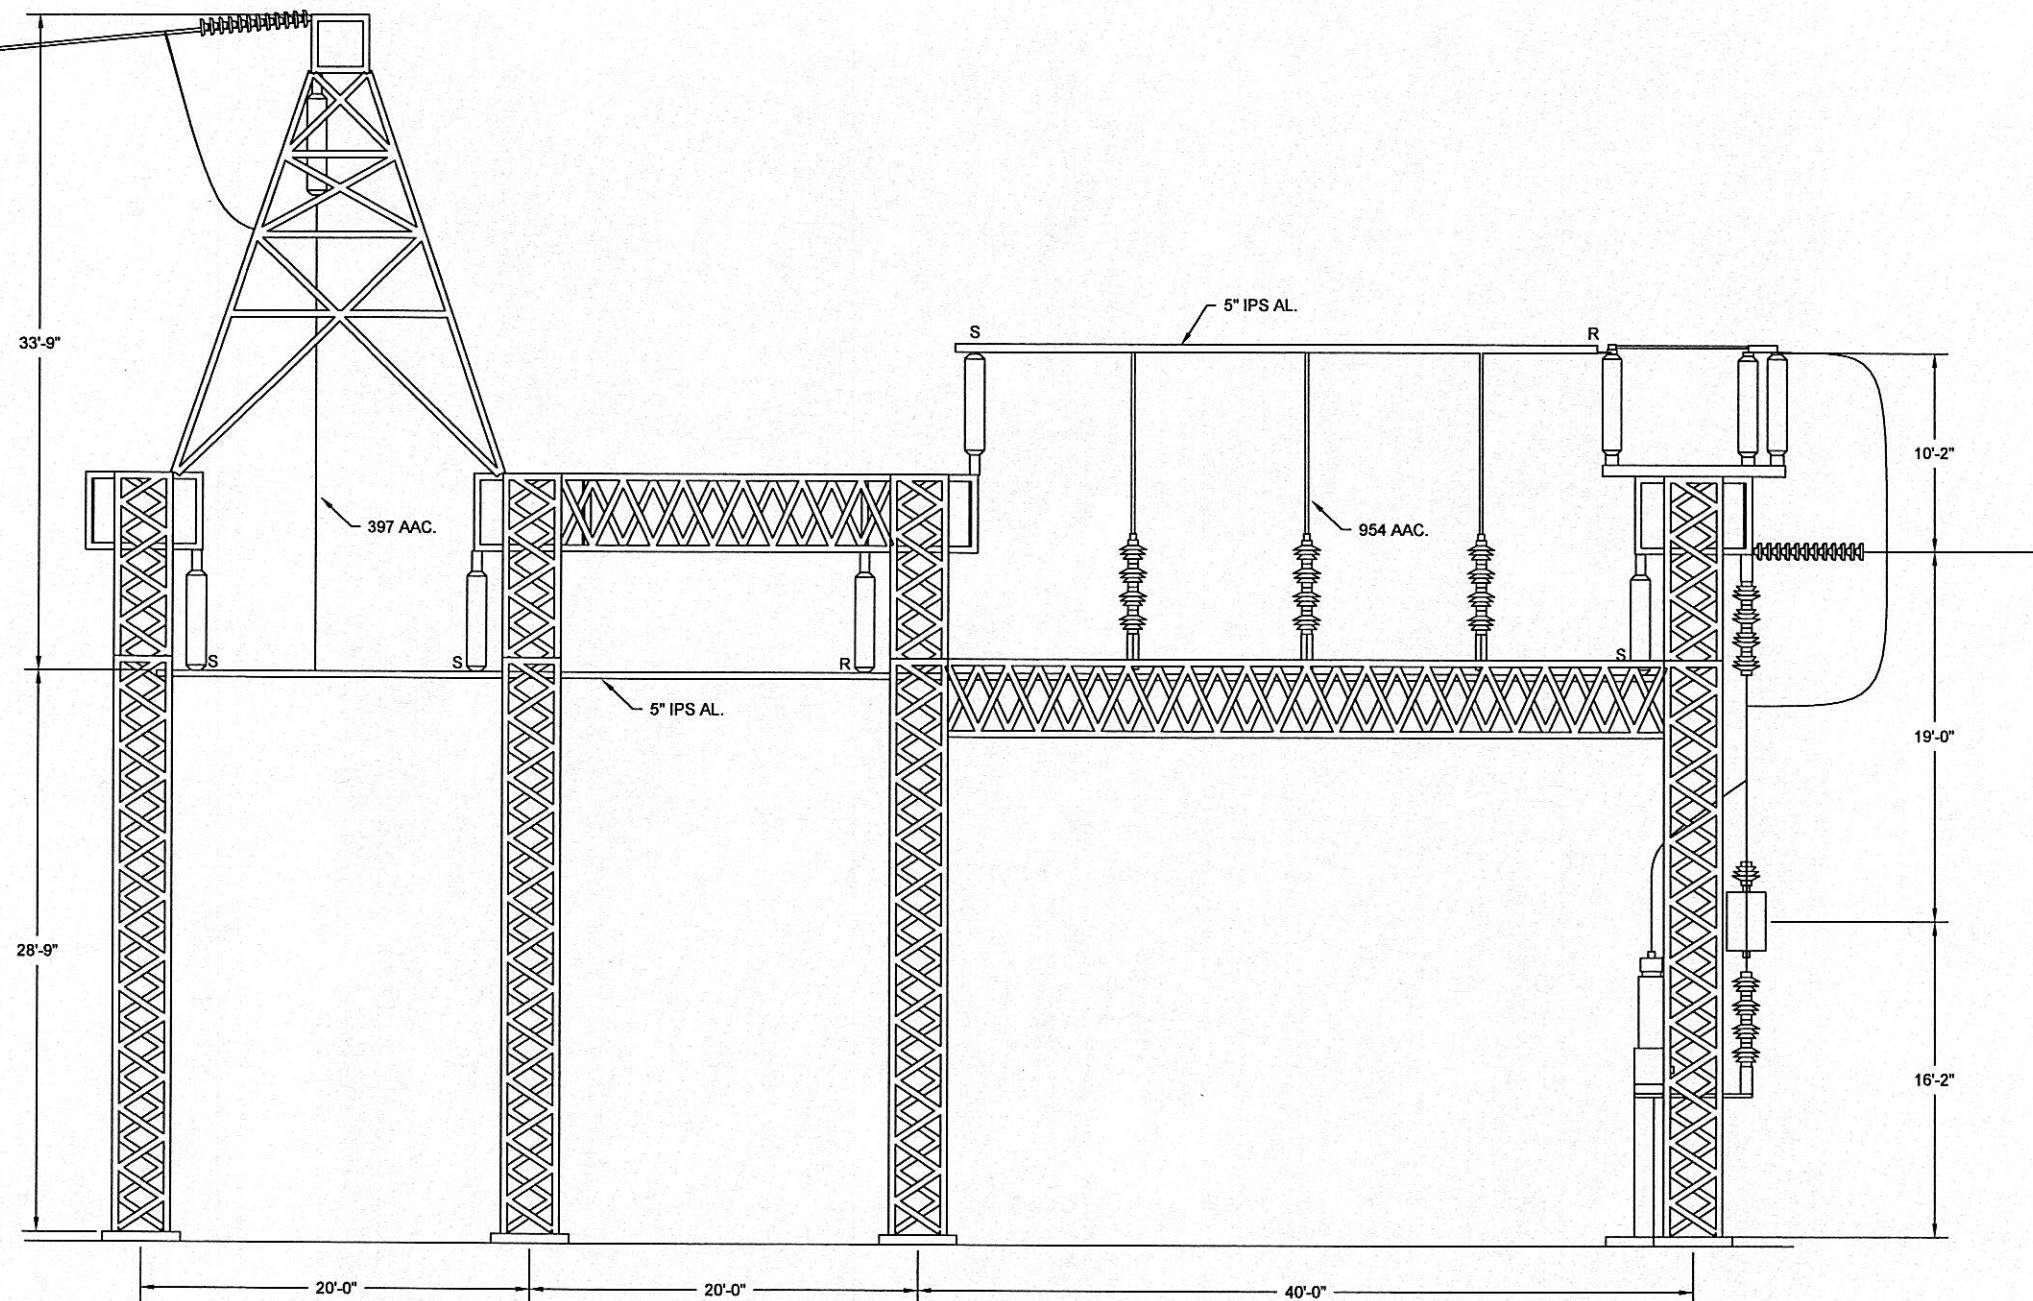

LEGEND
S - SLIP BUS FITTING
R - RIGID BUS FITTING

SECTION F
300

DESIGNED	DRAWN	CONFORMED TO CONSTRUCTION RECORDS		SCALE IN FEET	HARRIMAN UTILITY BOARD	PROJECT NUMBER:
KA	RW			5 0 5 10 15	HARRIMAN PRIMARY SUBSTATION	07-70014-01317-1000
2 09-15-10		CONFORMED TO CONSTRUCTION RECORDS.			R.W. Beck	SHEET OF:
1 12-15-09	RNU KA	ISSUED FOR CONSTRUCTION.			131 Saundersville Rd., Suite 300	1 1
0 10-02-09	RNU KA	ISSUED FOR BIDS.			Hendersonville, TN 37075	DRAWING NUMBER:
REV DATE	CHK'D APPD	REVISION DESCRIPTION			(615) 431-3200	01317-311.2

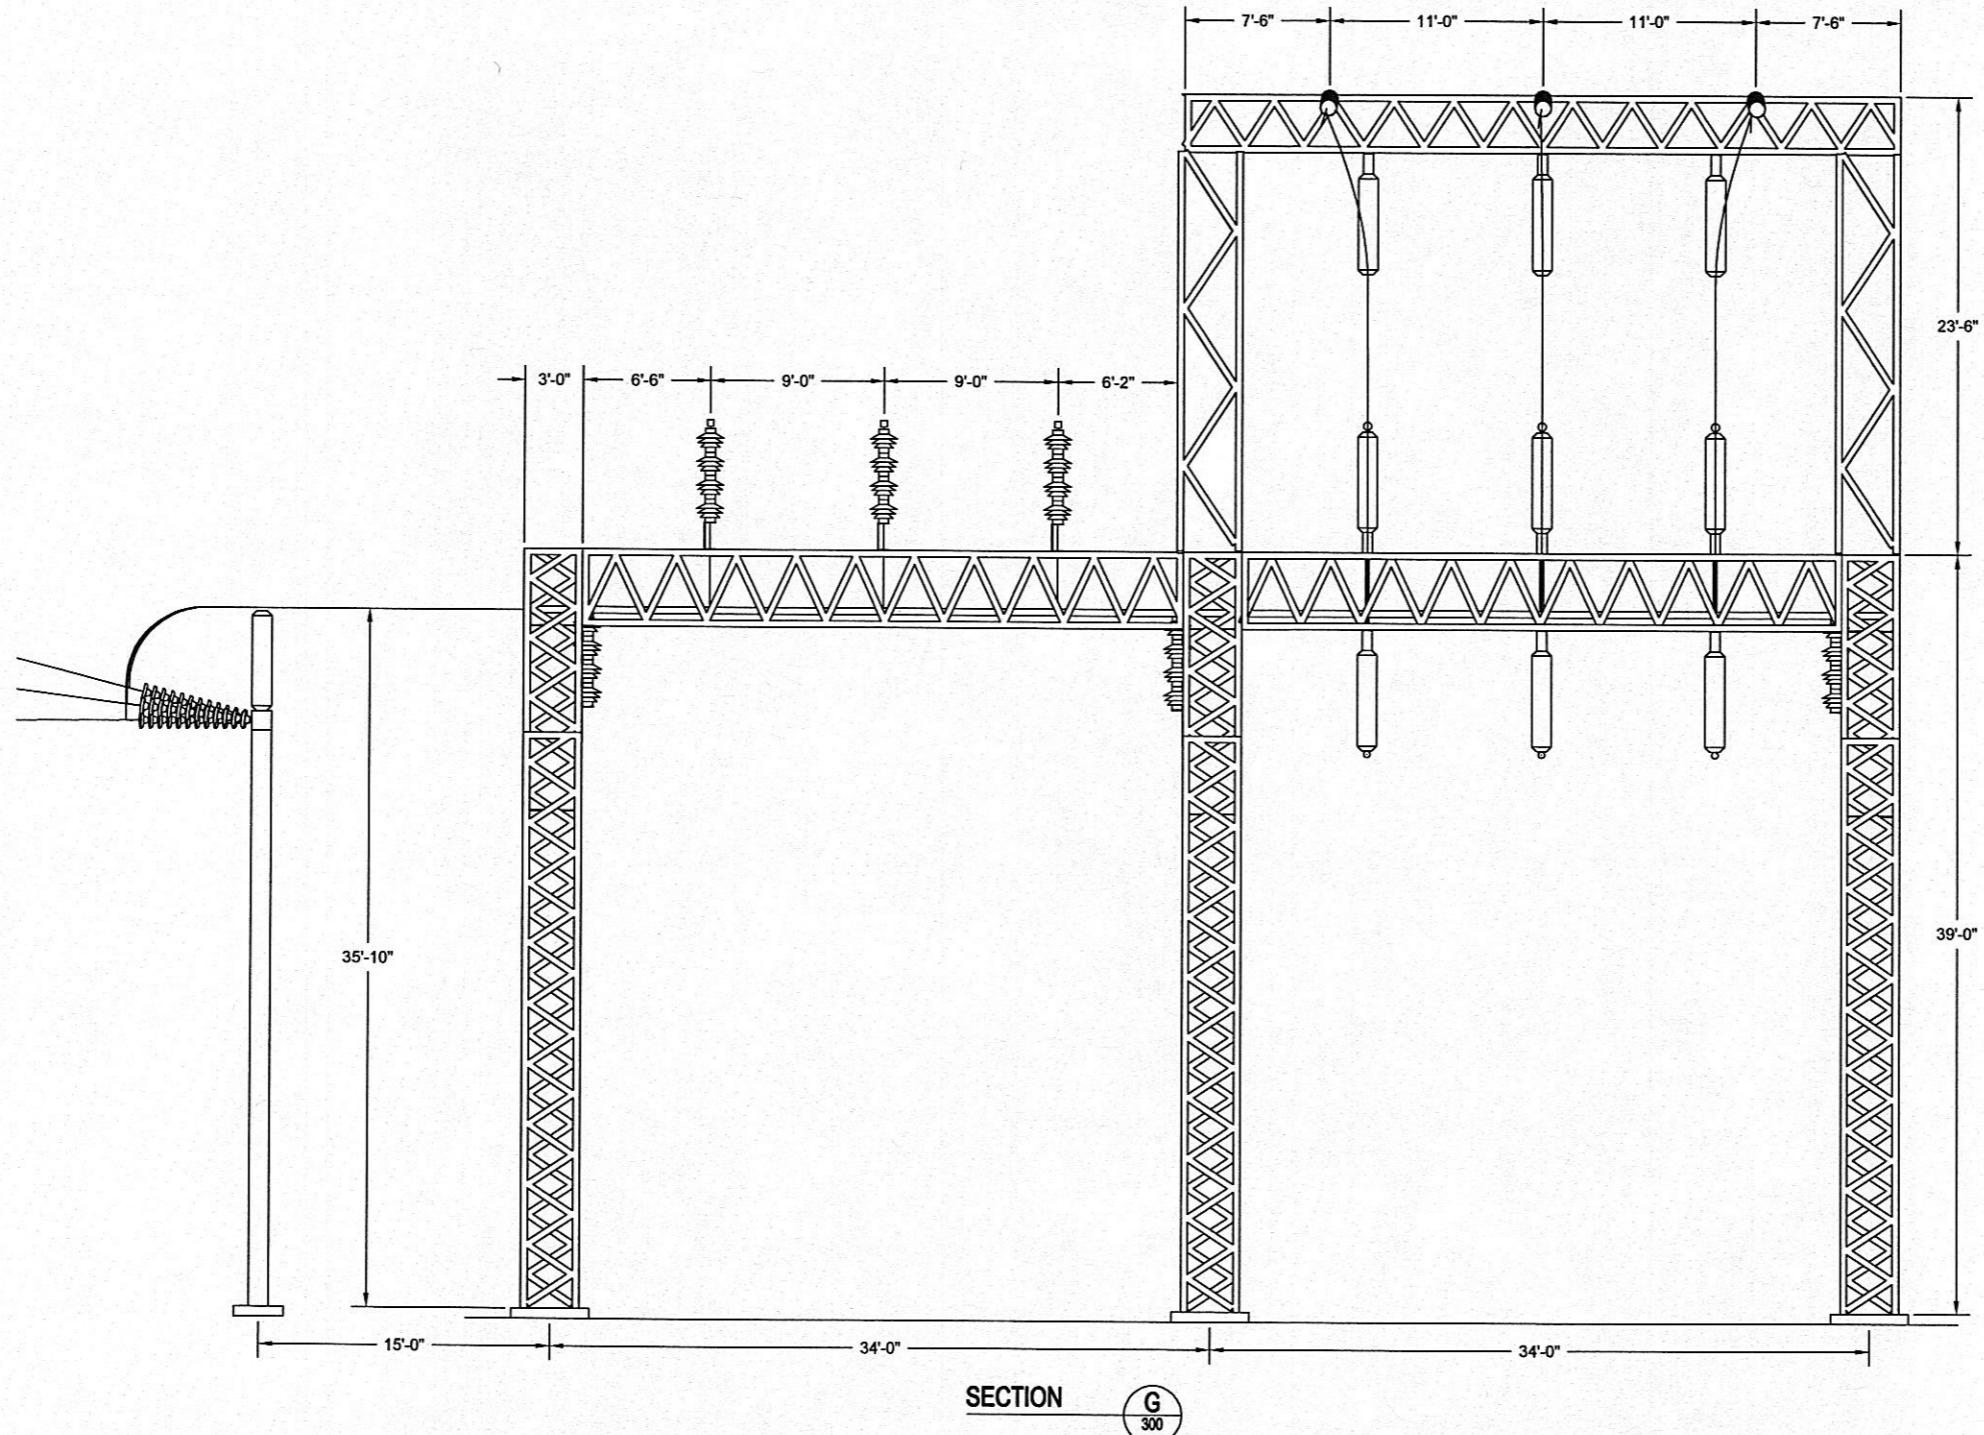

PLOT: 9/16/2010 WALESRA-13:18 - G:\0\053007-70014-01917 HARRIMAN UB-PRIMARY\WORK PRODUCTS\CTCR01317-312.DWG : LAYOUT1

				DESIGNED KA
REV	DATE	CHKD	APPD	DRAWN RW
2	09-15-10			CONFORMED TO CONSTRUCTION RECORDS.
1	12-15-09	RNJ	KA	ISSUED FOR CONSTRUCTION.
0	10-02-09	RNJ	KA	ISSUED FOR BIDS.
REVISION DESCRIPTION				

COPYRIGHT 2008, R.W. BECK, INC. ALL RIGHTS RESERVED

CONFORMED TO CONSTRUCTION RECORDS


5 0 5 10 15
SCALE IN FEET



R.W. Beck
131 Saundersville Rd., Suite 300
Hendersonville, TN 37075
(615) 431-3200
An SAIC Company

HARRIMAN UTILITY BOARD
HARRIMAN PRIMARY SUBSTATION
ELECTRICAL EQUIPMENT
SECTION VIEW G




PROJECT NUMBER:
07-70014-01317-1000
SHEET OF:
1 1
DRAWING NUMBER:
01317-312.2

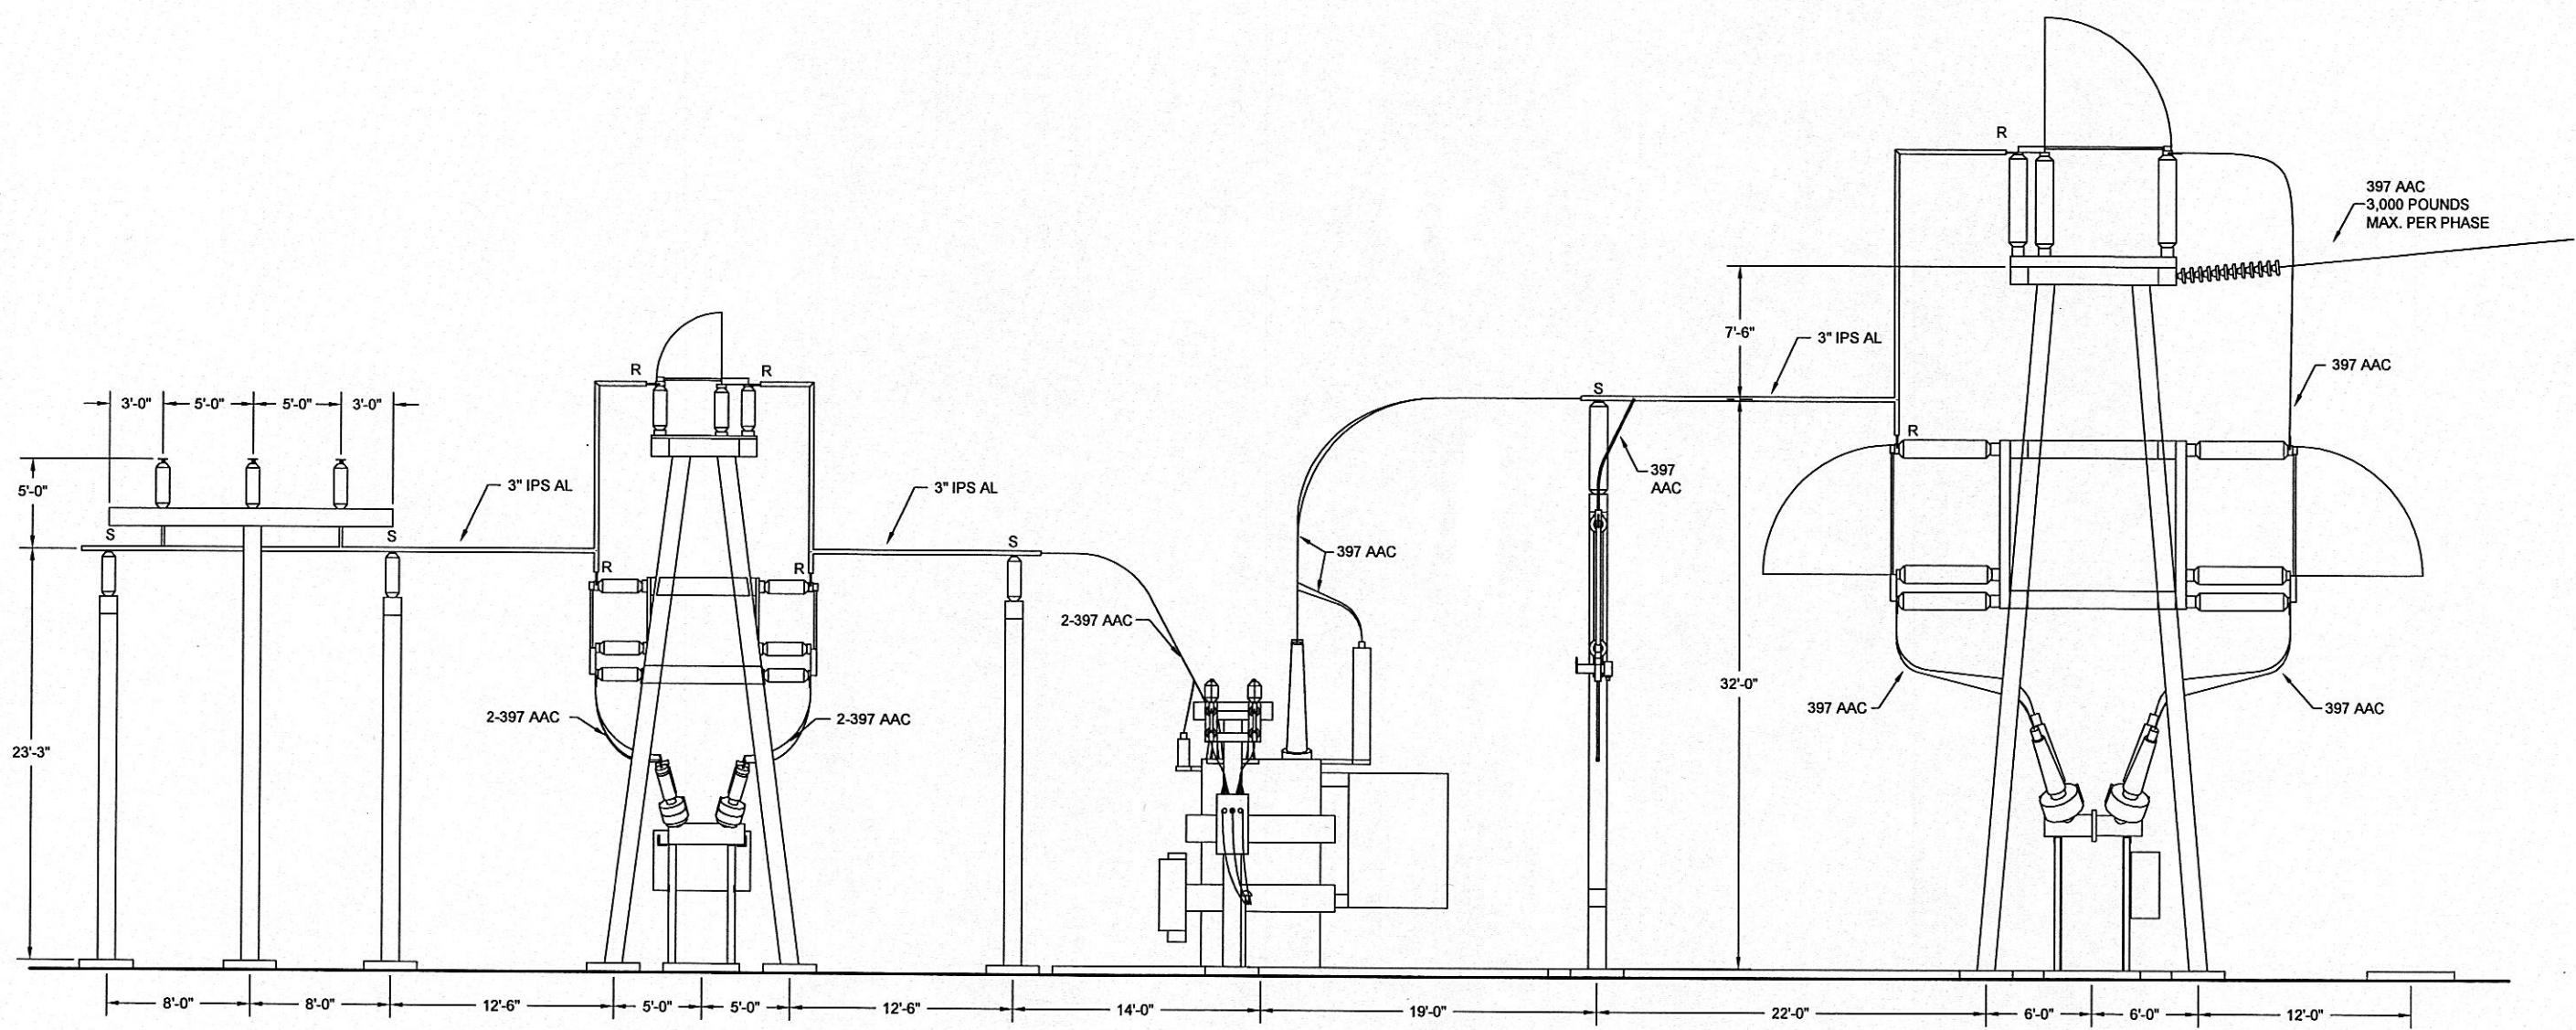

LEGEND

S -SLIP BUS FITTING
R -RIGID BUS FITTING

				DESIGNED KA	CONFORMED TO CONSTRUCTION RECORDS	 R.W. BECK An SAIC Company	R.W. Beck 131 Saundersville Rd., Suite 300 Hendersonville, TN 37075 (615) 431-3200	HARRIMAN UTILITY BOARD			PROJECT NUMBER:
				DRAWN RW				HARRIMAN PRIMARY SUBSTATION			07-70014-01317-1000
3	09-15-10	CONFORMED TO CONSTRUCTION RECORDS.		ELECTRICAL EQUIPMENT				SHEET OF:			
2	12-15-09	RNJ	KA	SECTION VIEW H				1 1			
1	10-09-09	RNJ	KA					DRAWING NUMBER:			
0	10-02-09	RNJ	KA					01317-315.3			
REV	DATE	CHKD	APPD	REVISION DESCRIPTION							
COPRIGHT 2008, R.W. BECK, INC. ALL RIGHTS RESERVED											

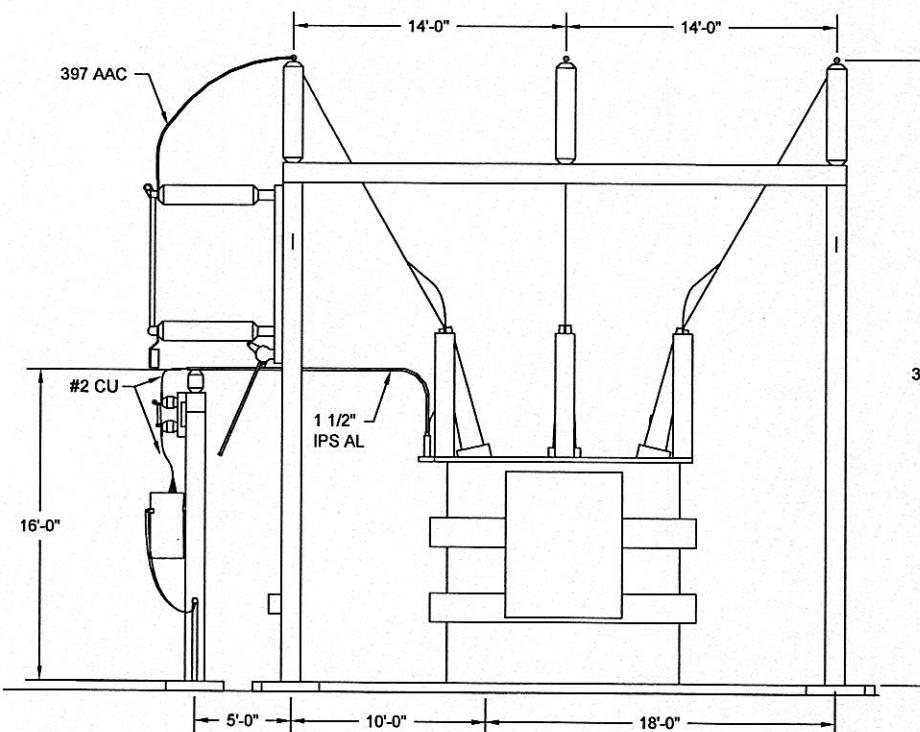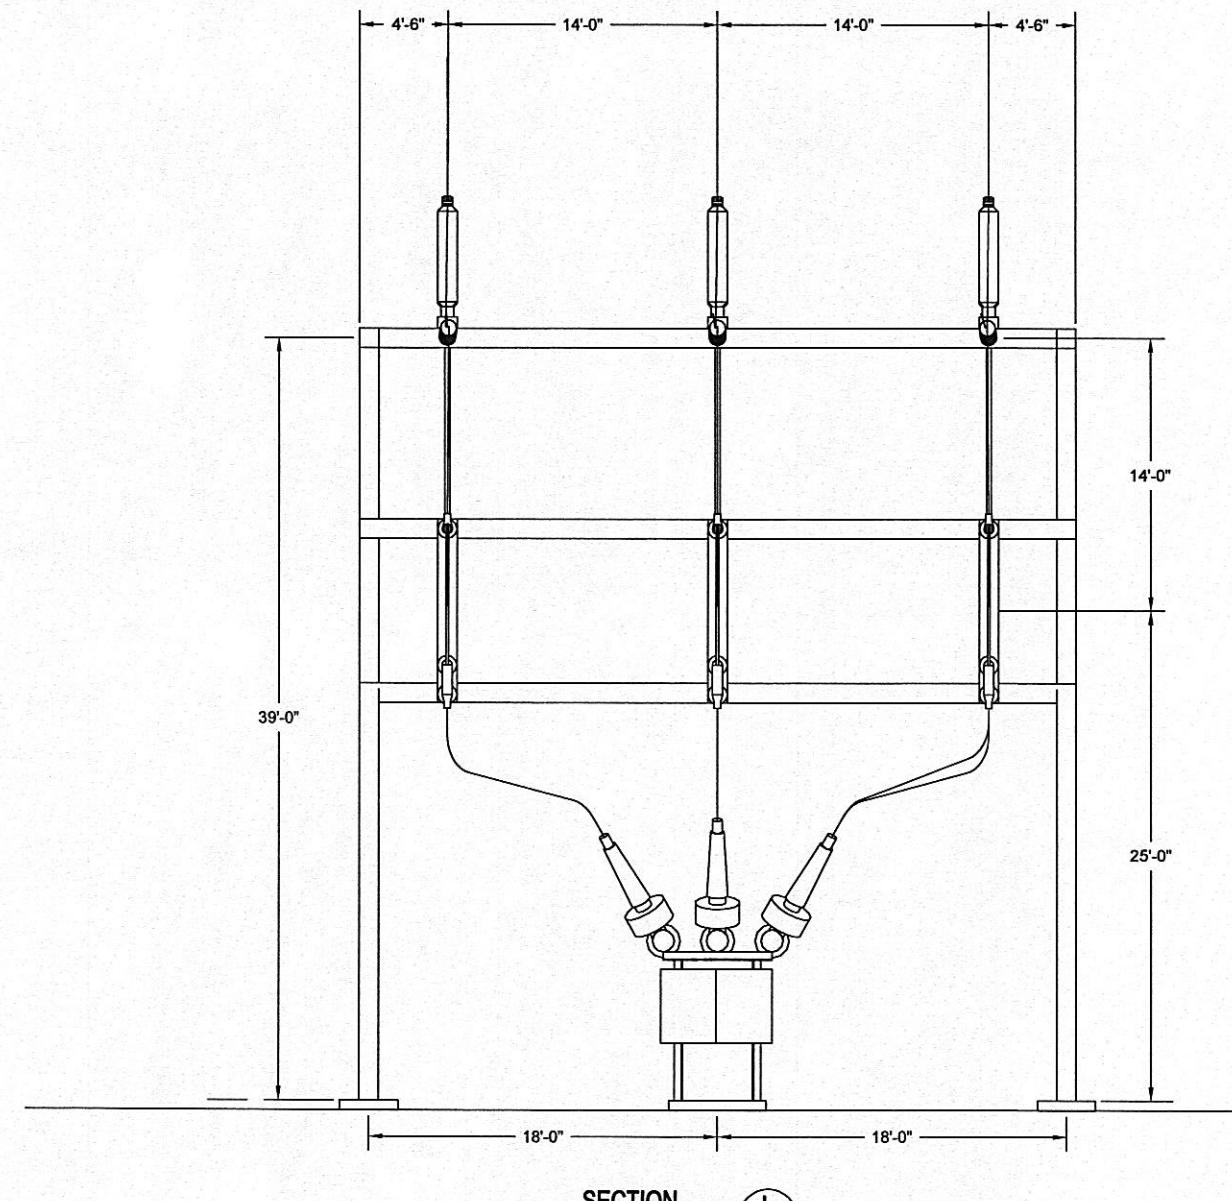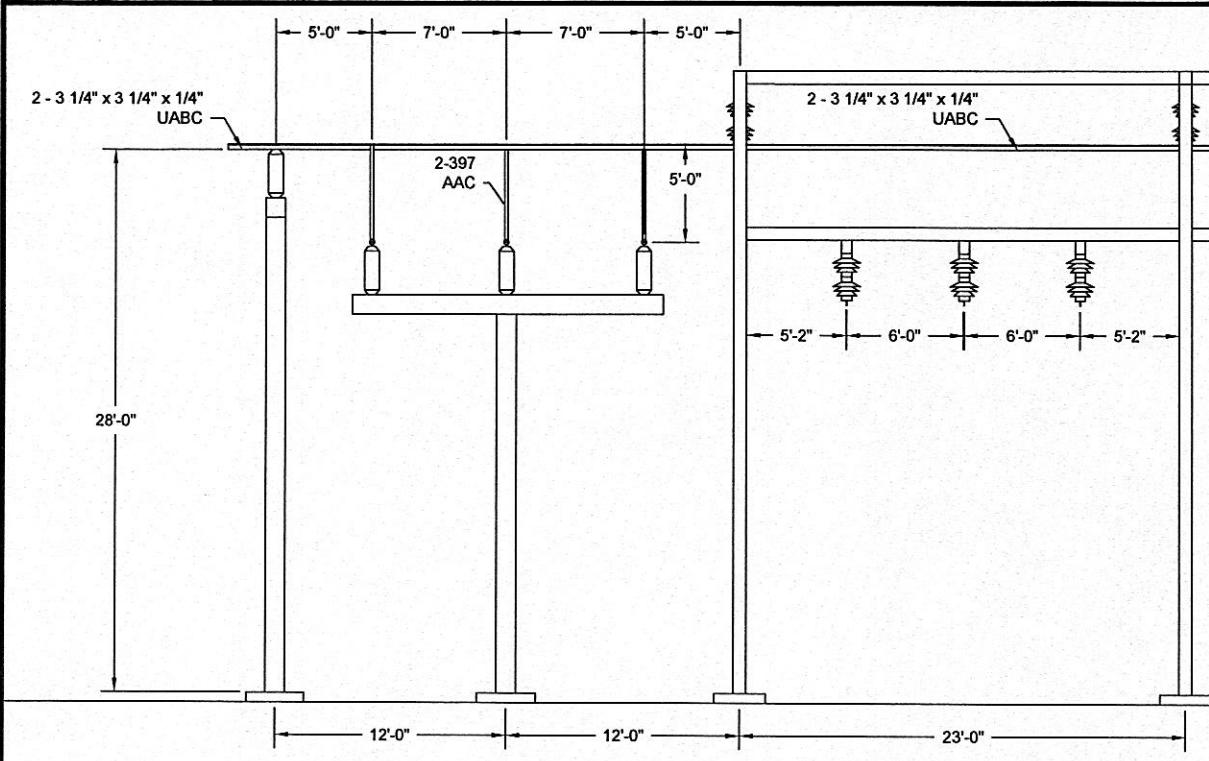

REV	DATE	CHKD	APPD	REVISION DESCRIPTION
3	09-15-10			CONFORMED TO CONSTRUCTION RECORDS.
2	12-15-09	RNJ	KA	ISSUED FOR CONSTRUCTION.
1	10-09-09	RNJ	KA	ADDED BYPASS SWITCHES.
0	10-02-09	RNJ	KA	ISSUED FOR BIDS.

**CONFORMED TO
CONSTRUCTION
RECORDS**

DESIGNED
KA

DRAWN
RW


5 0 5 10 15
SCALE IN FEET



R.W. Beck
131 Saundersville Rd., Suite 300
Hendersonville, TN 37075
(615) 431-3200

HARRIMAN UTILITY BOARD
HARRIMAN PRIMARY SUBSTATION
ELECTRICAL EQUIPMENT
SECTION VIEWS J, K, & L

PROJECT NUMBER:
07-70014-01317-1000
SHEET OF:
1 1
DRAWING NUMBER:
01317-316.3

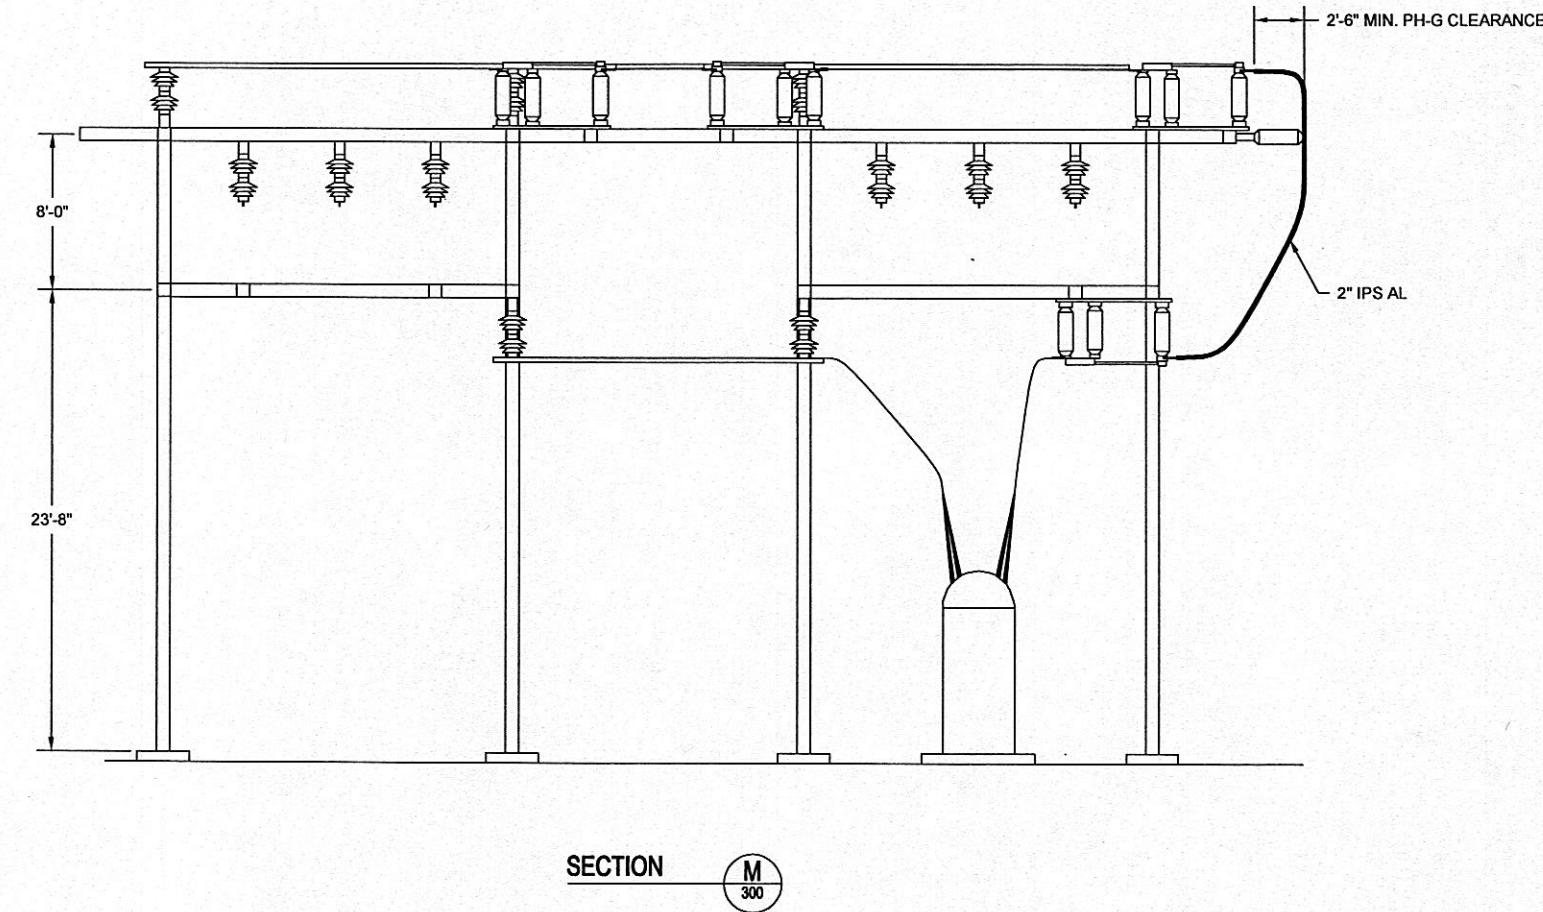

5 0 5 10 15
SCALE IN FEET




R.W. Beck
131 Saundersville Rd., Suite 300
Hendersonville, TN 37075
(615) 431-3200

HARRIMAN UTILITY BOARD
HARRIMAN PRIMARY SUBSTATION
ELECTRICAL EQUIPMENT
SECTION VIEW M

PROJECT NUMBER:
07-70014-01317-1000
SHEET OF:
1 1
DRAWING NUMBER:
01317-317.2

			DESIGNED
			KA
2	09-15-10		CONFORMED TO CONSTRUCTION RECORDS.
1	12-15-09	RNJ	ISSUED FOR CONSTRUCTION.
0	10-02-09	RNJ	ISSUED FOR BIDS.
REV	DATE	CHK'D APPD	REVISION DESCRIPTION

CONFORMED TO CONSTRUCTION RECORDS

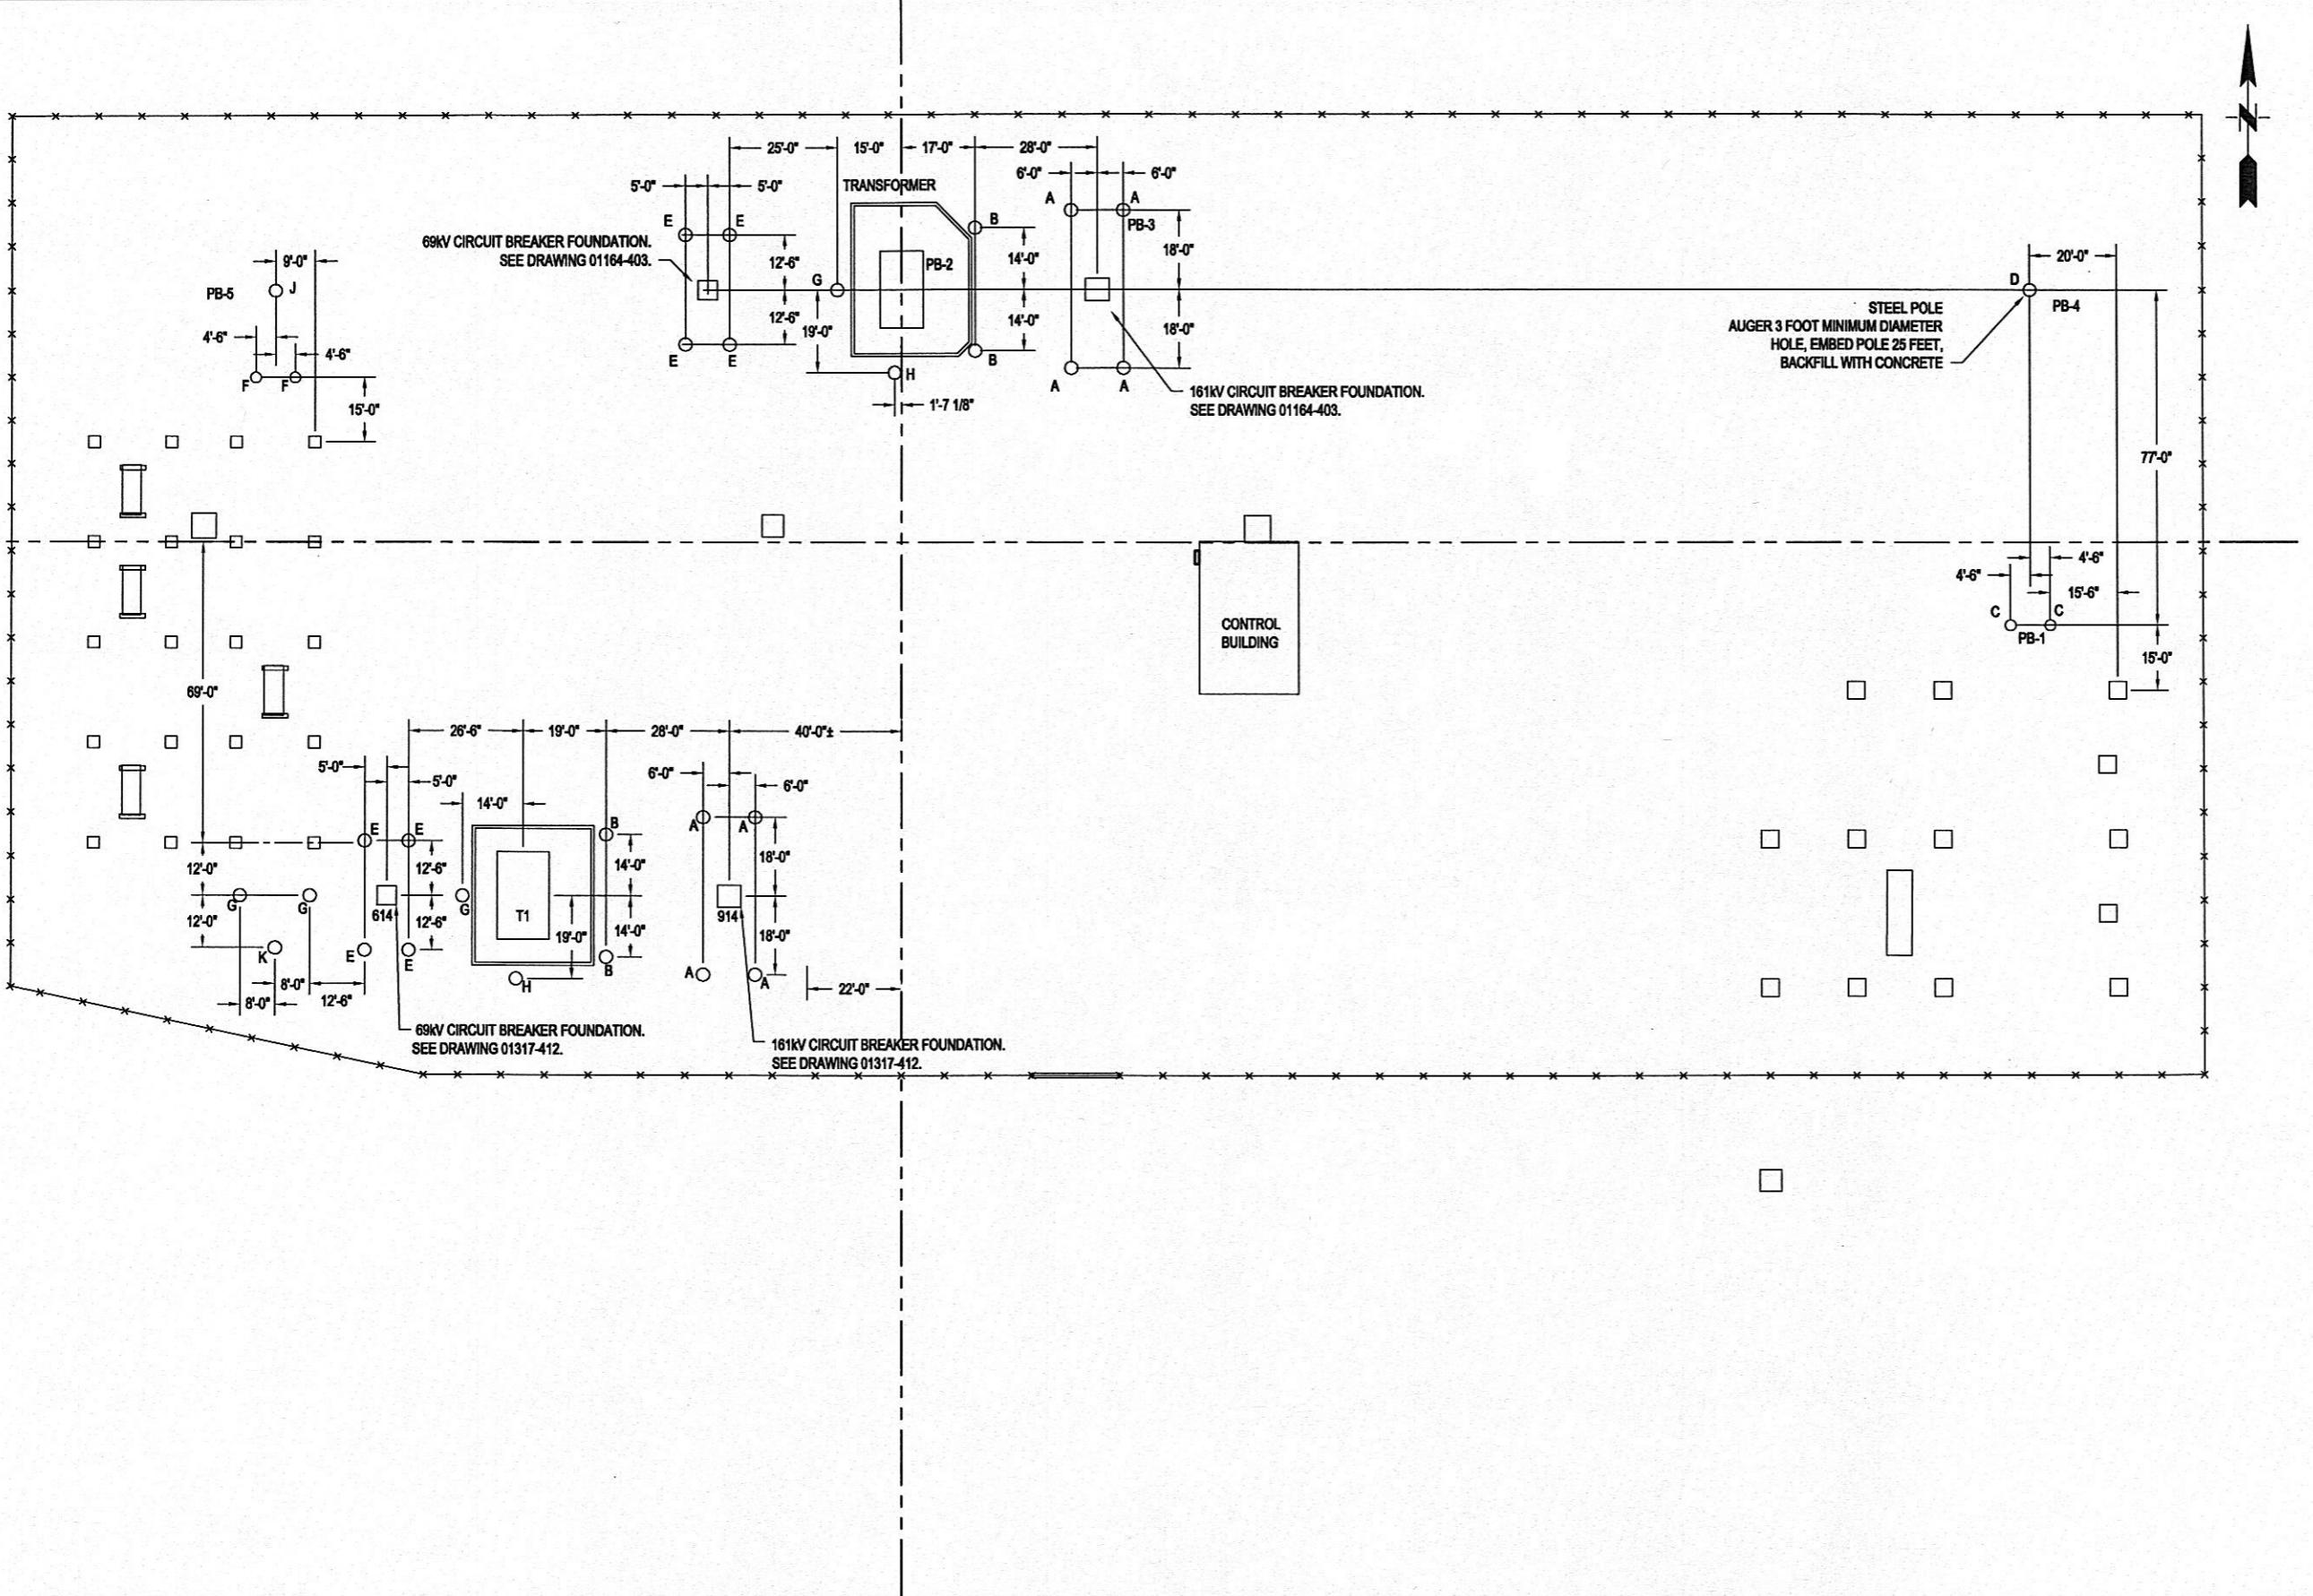

OTES:

REFER TO DRAWING 01317-411 FOR TRANSFORMER 1 FOUNDATION DETAILS.

ALL TOP OF CONCRETE (TOC) ELEVATIONS ARE 101.0

DIMENSIONS ARE TO CENTER OF BASEPLATE.


ALL FOUNDATIONS NOTED FOR REMOVAL SHALL BE REMOVED TO A LEVEL AT LEAST ONE FOOT BELOW GRADE. RESTORE GRAVEL AREA AFTER REMOVAL. REFER TO DRAWING 01317-404 FOR MODIFICATIONS TO ADJACENT OIL CONTAINMENT PIPING.

				DESIGNED	CONFORMED TO CONSTRUCTION RECORDS	 SCALE IN FEET	 R.W. Beck 131 Saundersville Rd., Suite 300 Hendersonville, TN 37075 (615) 431-3200 An SAIC Company	HARRIMAN UTILITY BOARD HARRIMAN PRIMARY SUBSTATION FOUNDATION PLAN		PROJECT NUMBER: 07-70014-01317-1000 SHEET OF: DRAWING NUMBER: 01317-400.3			
3	09-15-10	CONFORMED TO CONSTRUCTION RECORDS.									DRAWN		
2	12-15-09	MDB	KA	GENERAL REVISIONS. RE-ISSUED FOR CONSTRUCTION									
1	11-05-09	MDB	KA	ISSUED FOR CONSTRUCTION									
0	10-02-09	MDB	KA	ISSUED FOR BIDS.									
REV	DATE	CHK'D	APP'D	REVISION DESCRIPTION									
PLOT: 9/16/2010 WALESRA - SAVED													



COPYRIGHT 2008, R.W. BECK, INC., ALL RIGHTS RESERVED

NOTES:

1. CONCRETE SHALL HAVE A COMPRESSIVE STRENGTH OF 3,500 PSI AT 28 DAYS PER ASTM C39.
2. REINFORCING SHALL BE DEFORMED NEW BILLET STEEL PER ASTM A615, GRADE 60.
3. CHAMFER ALL EXPOSED EDGES 1".
4. MAXIMUM SIZE OF AGGREGATE SHALL BE 2".
5. EXPOSED SURFACE OF CONCRETE TO BE SMOOTH FORM FINISH.
6. ALL REINFORCING BARS TO HAVE MINIMUM 3" CLEARANCE FROM EDGE OF CONCRETE.
7. NOT ALL REINFORCING BARS SHOWN FOR CLARITY.
8. THREADS OF ANCHOR BOLTS AND NUTS TO BE THOROUGHLY CLEANED OF CONCRETE AND PROTECTED AFTER PLACEMENT.
9. FOR FOUNDATION DESIGNATIONS REFER TO DRAWING 01317-400.
10. SUBSURFACE CONDITIONS MAY VARY FROM ENGINEER'S ASSUMPTIONS. IF ROCK OR SOFT CONDITIONS ARE ENCOUNTERED CONTACT ENGINEER.
 - 10.1. IN CASE OF ROCK, CONTINUE TO MINIMUM EMBEDMENT DEPTH REGARDLESS OF ROCK DEPTH.
 - 10.2. IN CASE OF SOFT SOIL, INCREASE DEPTH TO STIFFER SOIL OR ROCK IS ENCOUNTERED.
11. FOR ANCHOR BOLT PLAN AND ANCHOR BOLT DETAILS, REFER TO DRAWINGS DG-2482-AP1 AND DG-2482-AP2 BY SUBSTATION ENTERPRISES, INC.
12. TOP OF CONCRETE (TOC) ELEVATION SHALL BE 101.0.

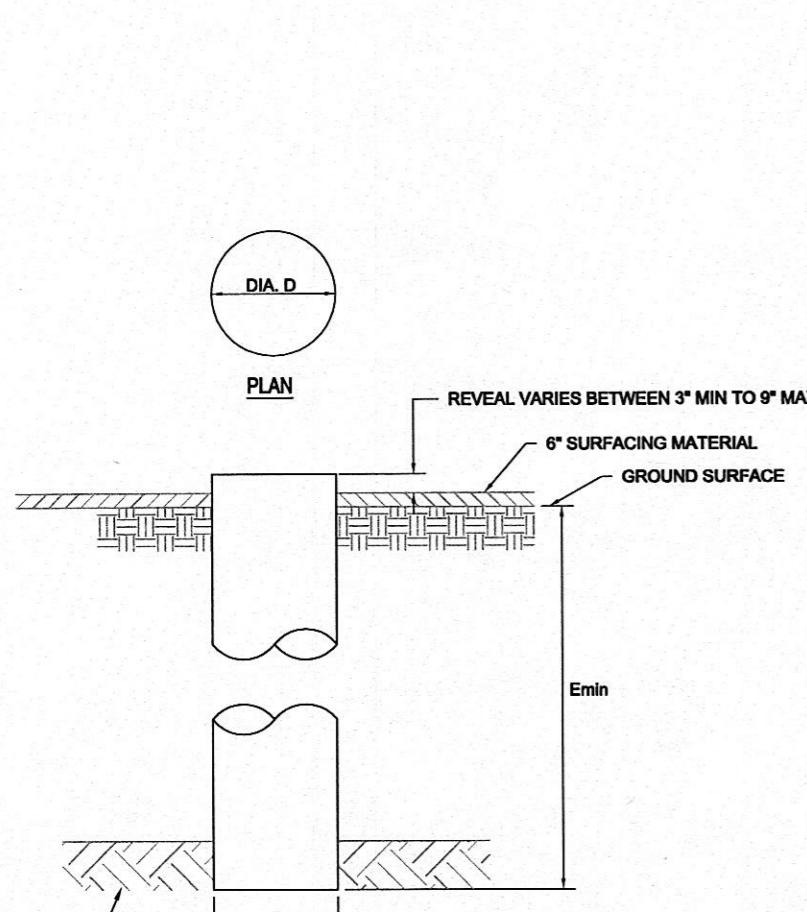

**FOUNDATION
CONCRETE DETAIL**
SCALE: N.T.S.

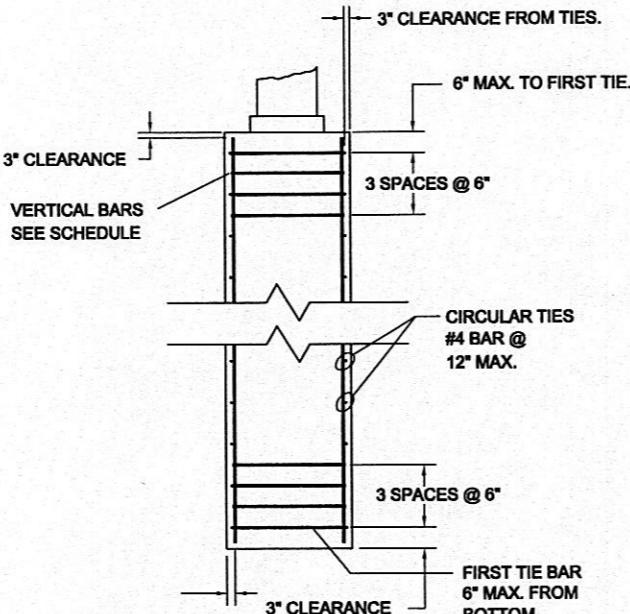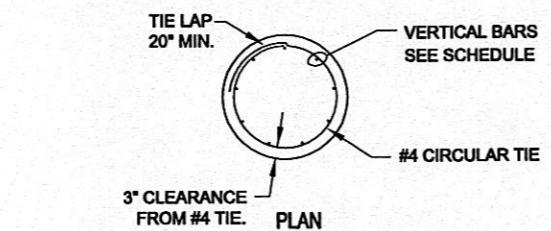

**FOUNDATION
REBAR DETAIL**
SCALE: N.T.S.

**CONFORMED TO
CONSTRUCTION
RECORDS**

DRAWN


DESIGNED

2	09-15-10			CONFORMED TO CONSTRUCTION RECORDS.
1	12-15-09	MDB	KA	ISSUED FOR CONSTRUCTION.
0	10-02-09	MDB	KA	ISSUED FOR BIDS.


REV DATE CHKD APPD

REVISION DESCRIPTION

DRILLED PIER SCHEDULE										
FND TYPE	DIAMETER D (FT)	TOTAL EMBEDMENT Emin (FT)	VERTICAL BAR EVENLY SPACED		NUMBER OF AB N	ABØ (IN)	SPACING SIZE (IN) S-1 S-2	AB PROJECTION P (IN)	AB EMBEDMENT BE (FT-IN)	ANCHOR BOLT PATTERN
			NUMBER	SIZE						
A	3.5	15.0	14	5	4	1.25	16 16	5.0	3-1	P-1
B	3.0	11.0	11	5	4	1.25	14 14	5.0	3-1	P-2
E	2.5	10.0	7	5	4	1.00	10 10	4.0	2-2	P-3
G	2.5	10.0	7	5	4	1.00	12 12	4.0	2-2	P-4
H	2.5	9.0	7	5	4	1.00	12 12	4.0	2-2	P-4
K	3.0	10.5	11	5	4	1.25	14 14	5.0	3-1	P-2

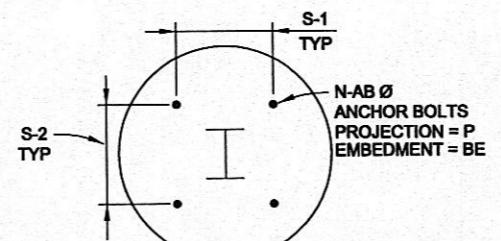

ANCHOR BOLT DETAILS
SCALE: N.T.S.

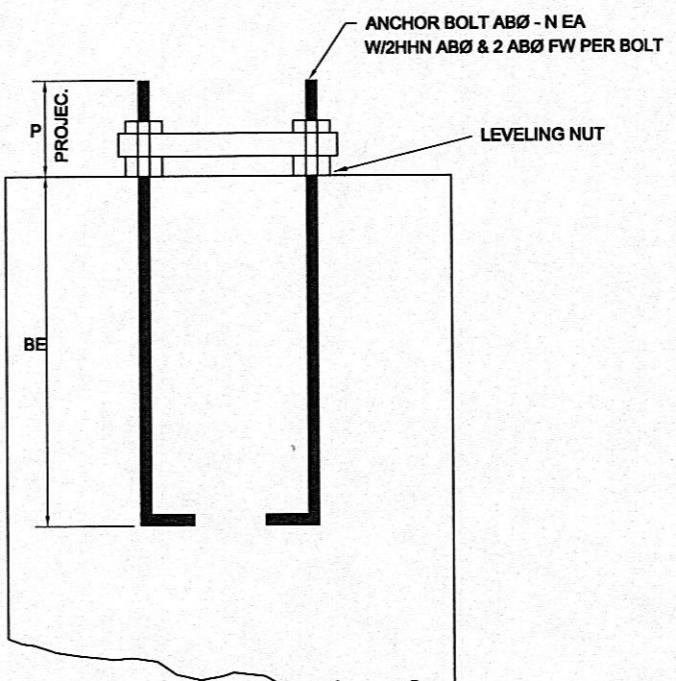

**FOUNDATION
ANCHOR BOLT DETAIL**
SCALE: N.T.S.

HARRIMAN UTILITY BOARD
HARRIMAN PRIMARY SUBSTATION

DRILLED PIER
FOUNDATION DETAILS

PROJECT NUMBER:
07-70014-01317-1000


SHEET OF:

DRAWING NUMBER:
01317-401.2



R.W. Beck
131 Saundersville Rd., Suite 300
Hendersonville, TN 37075
(615) 431-3200

An SAIC Company

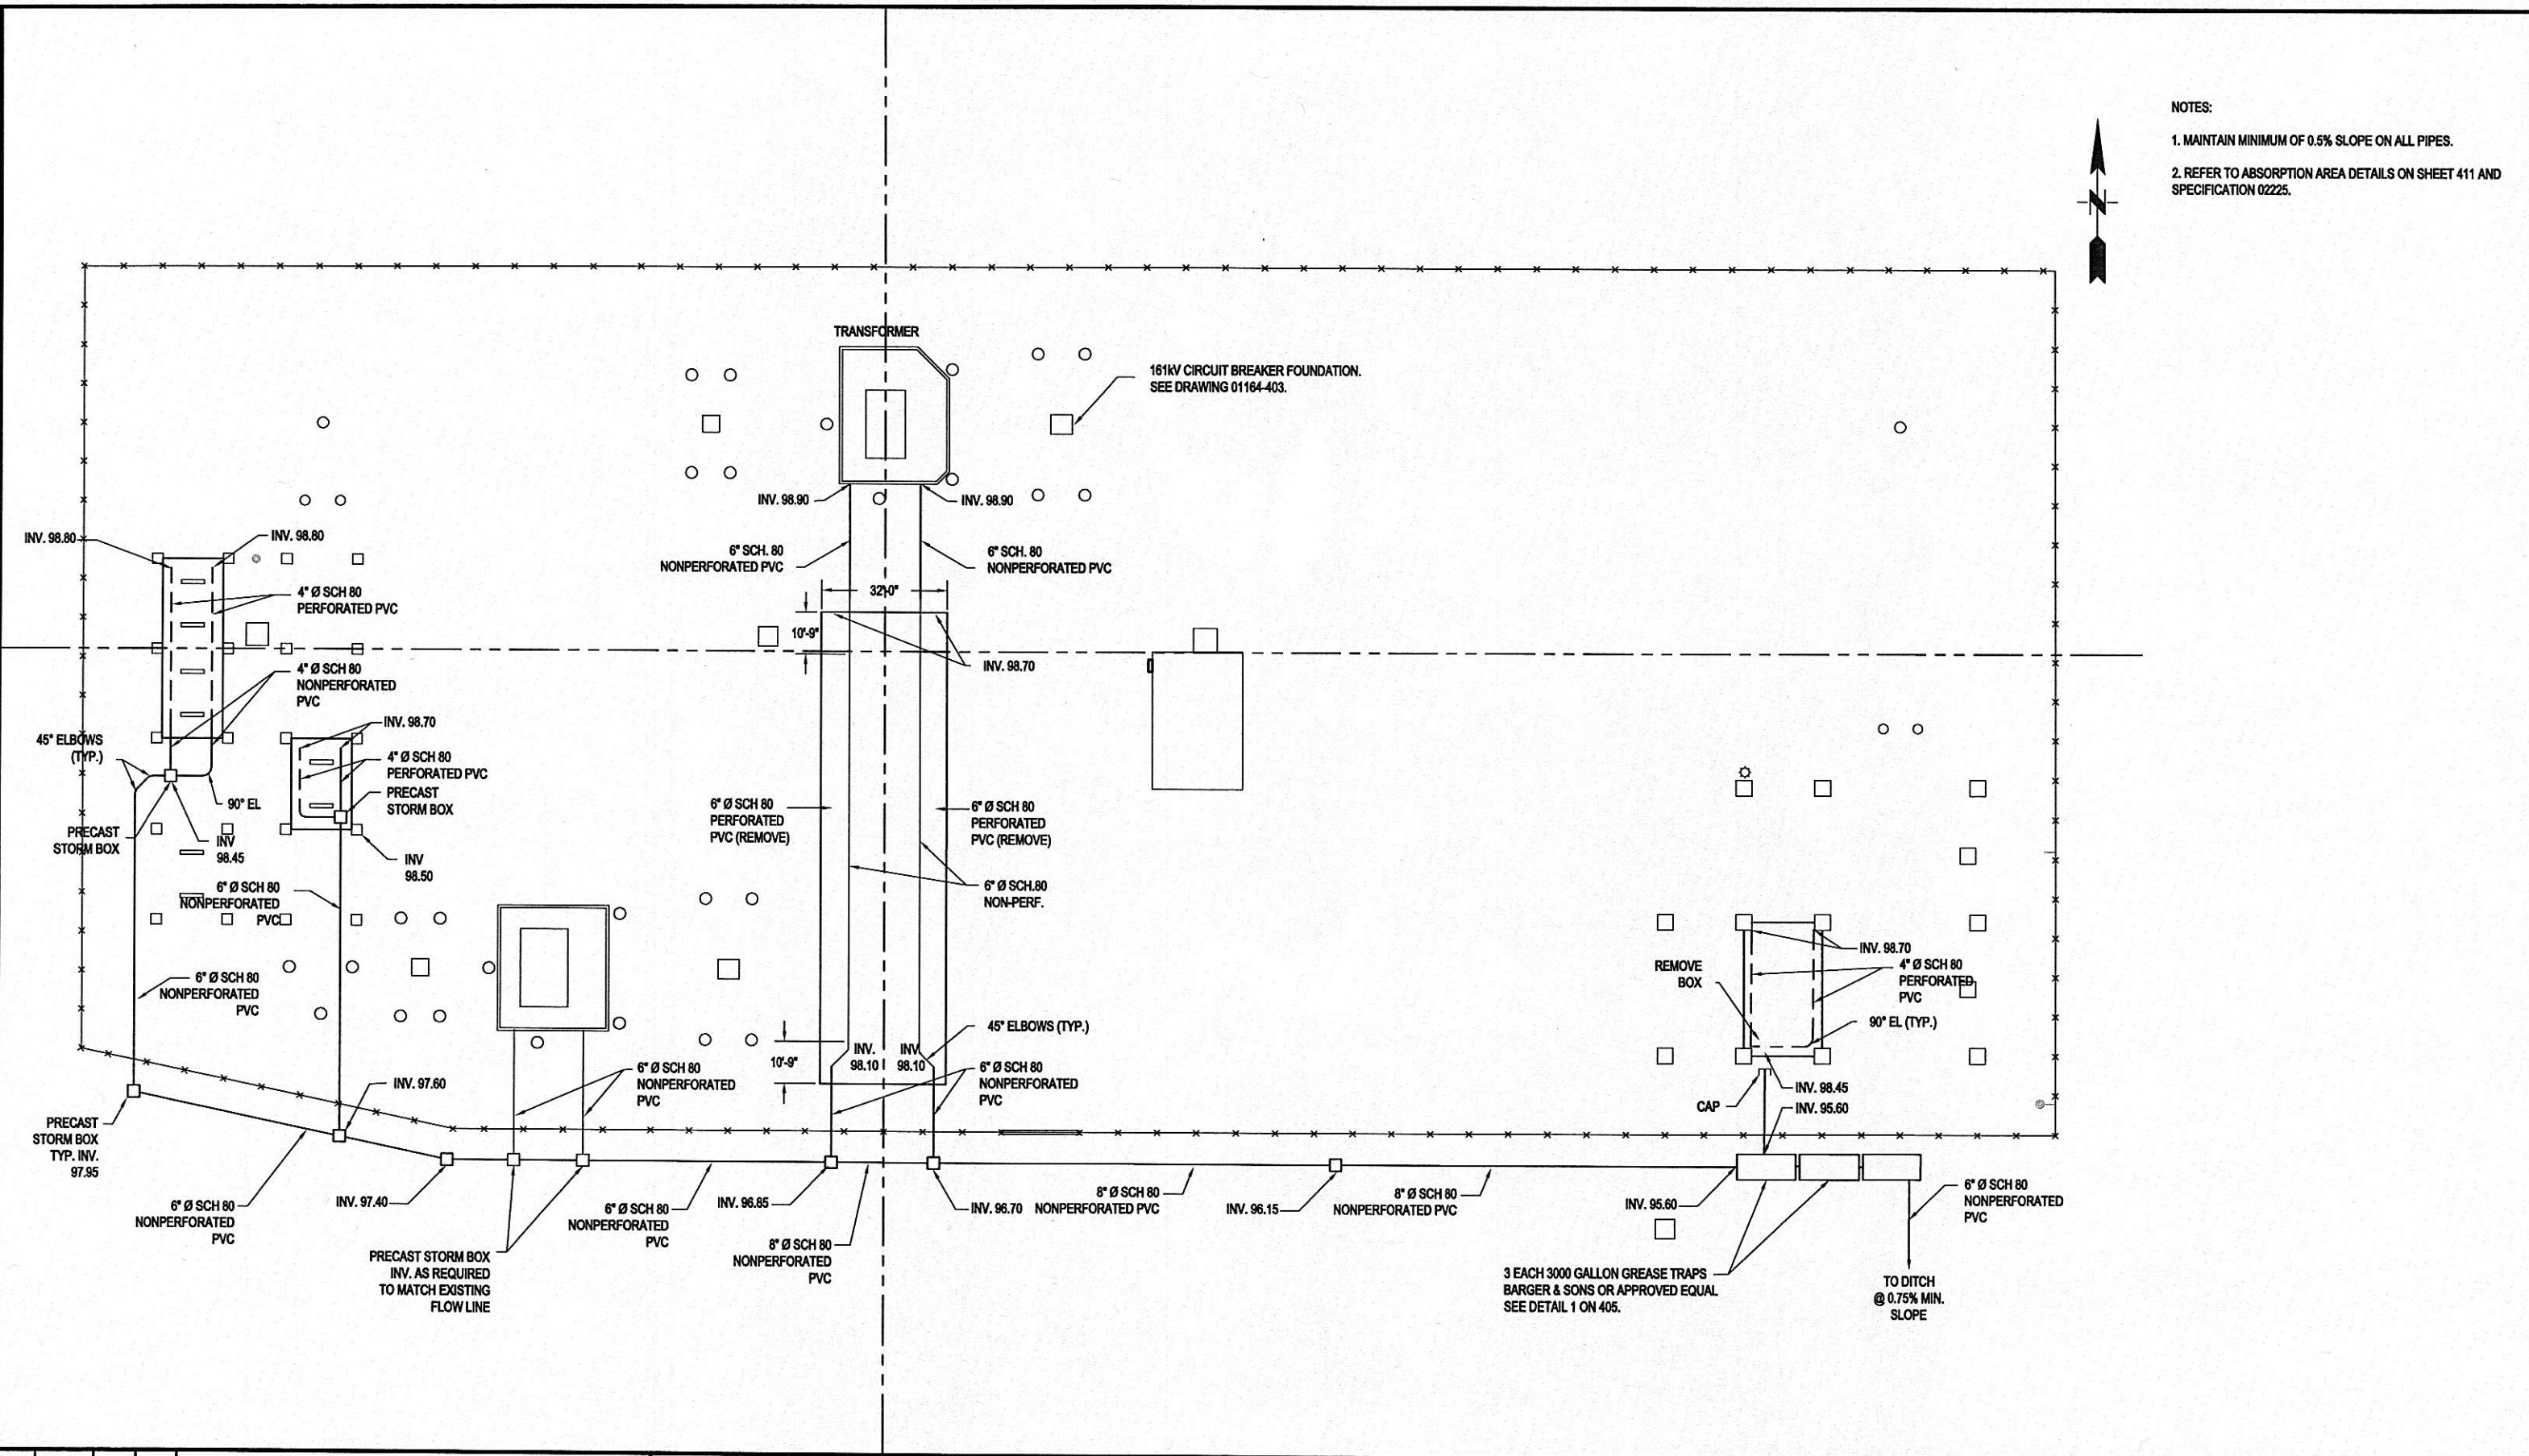


				DESIGNED	CONFORMED TO CONSTRUCTION RECORDS	 SCALE IN FEET			HARRIMAN UTILITY BOARD HARRIMAN PRIMARY SUBSTATION OIL CONTAINMENT	PROJECT NUMBER: 07-70014-01317-1000 SHEET OF: DRAWING NUMBER: 01317-404.2		
2	09-15-10	CONFORMED TO CONSTRUCTION RECORDS.		DRAWN								R.W. Beck 131 Saundersville Rd., Suite 300 Hendersonville, TN 37075 (615) 431-3200
1	12-15-09	MDB	KA	ISSUED FOR CONSTRUCTION.								
0	10-02-09	MDB	KA	ISSUED FOR BIDS.								
REV	DATE	CHKD	APPD	REVISION DESCRIPTION								

PLOT: 9/16/2010 WALESRA - SAVED

COPYRIGHT 2008 R.W.BECK INC. ALL RIGHTS RESERVED.



R.W.BECK
An SAIC Company

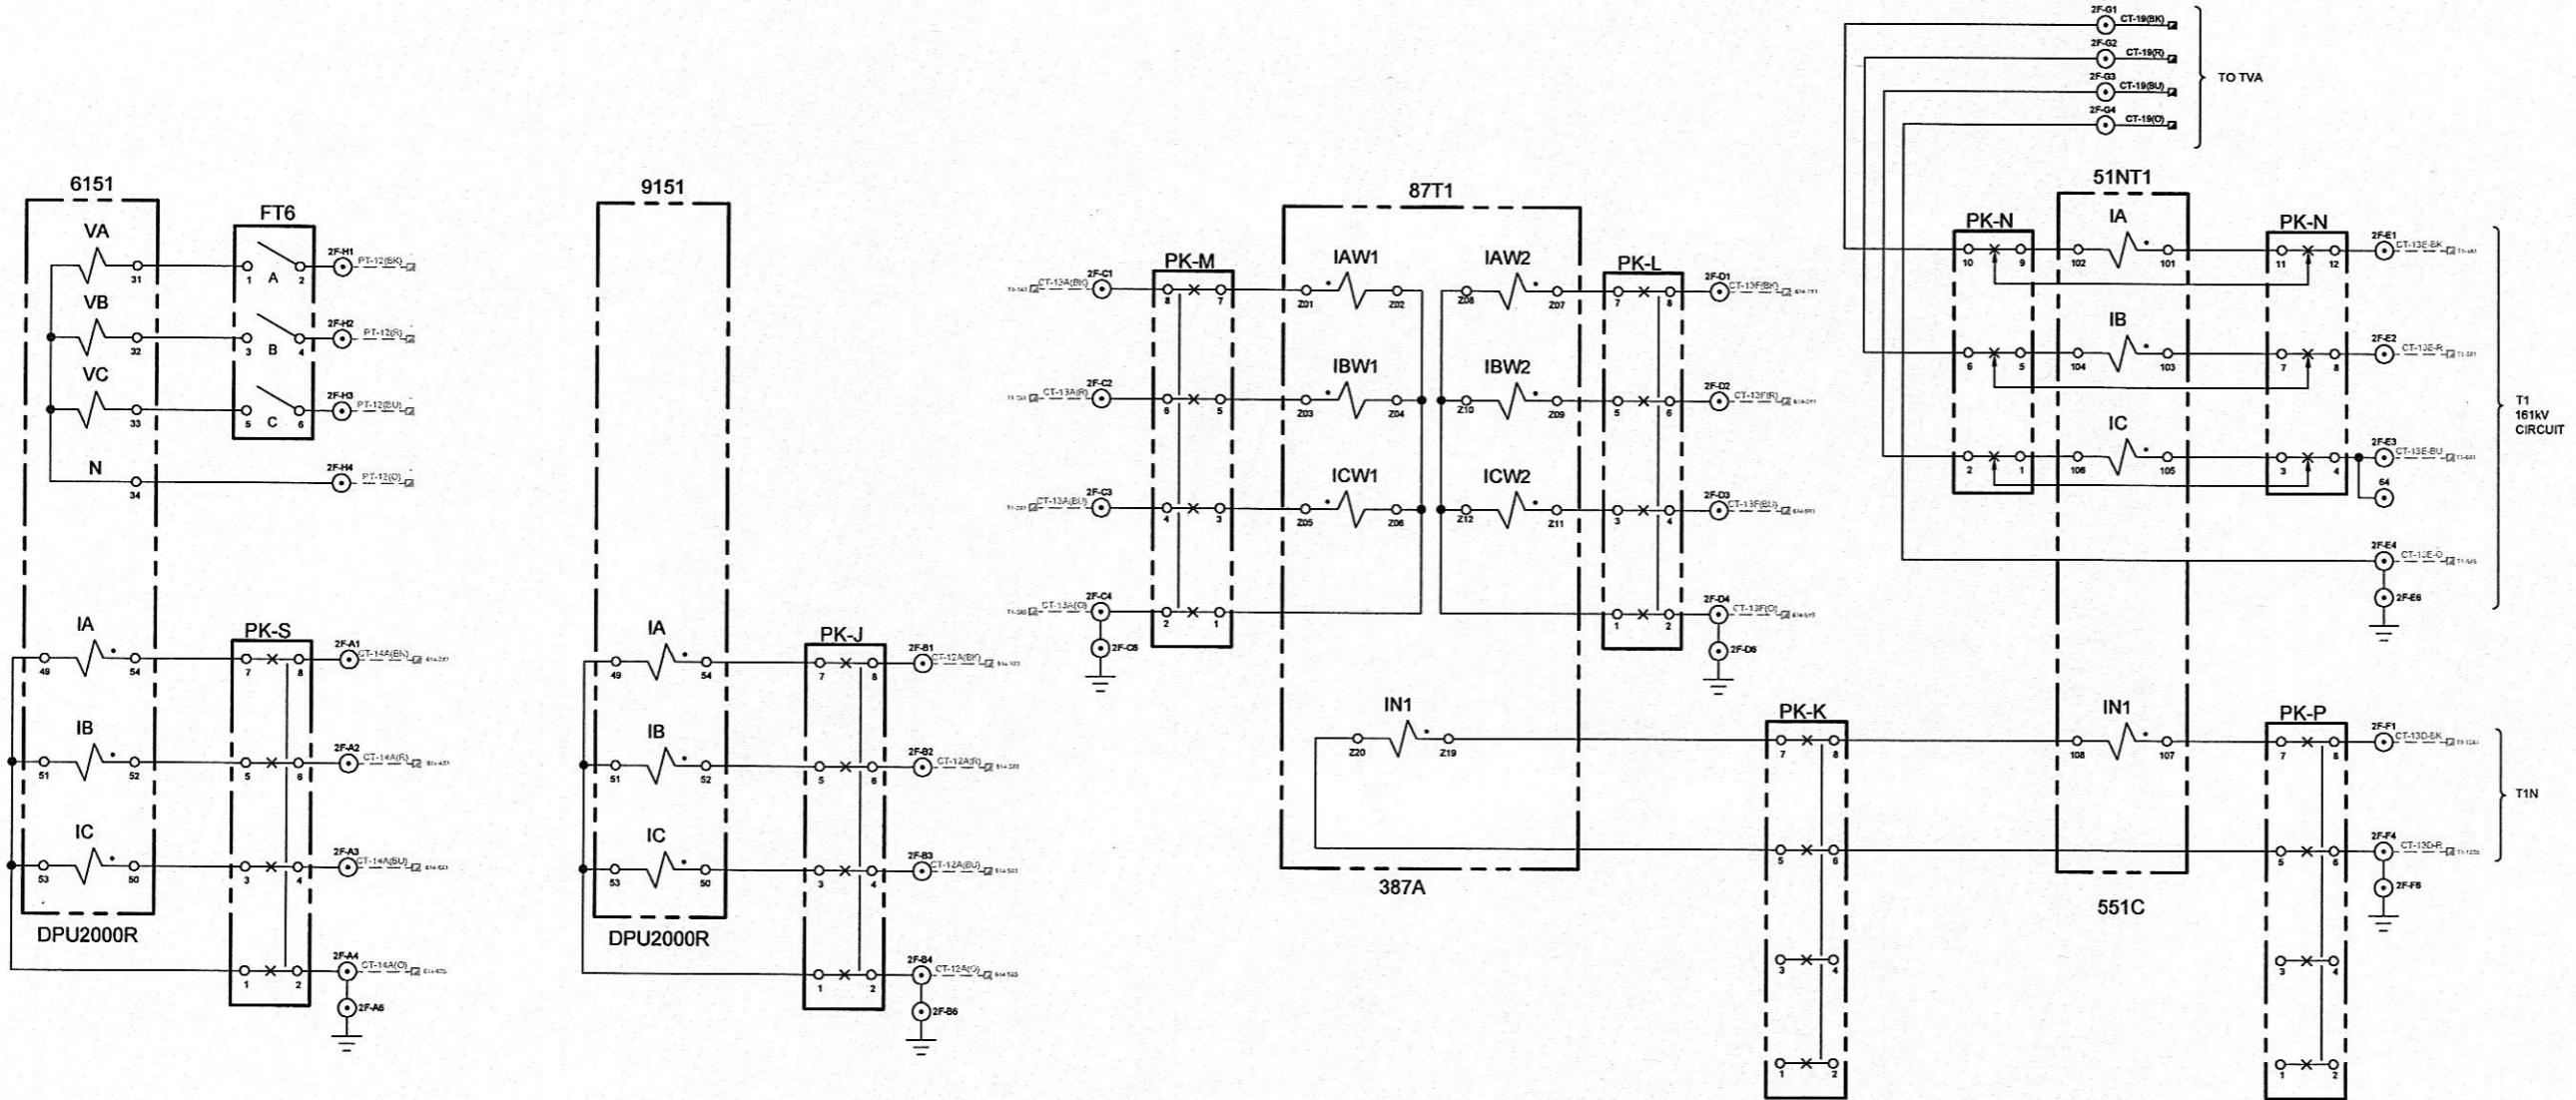



PLOT: 9302010 WALESRA - SAV								DESIGNED RNJ		CONFORMED TO CONSTRUCTION RECORDS				R.W. Beck 131 Saundersville Rd., Suite 300 Hendersonville, TN 37075 (615) 431-3200 An SAIC Company		HARRIMAN UTILITY BOARD HARRIMAN PRIMARY SUBSTATION CURRENT ELEMENTARIES BREAKERS 914 AND 614		PROJECT NUMBER: 07-70014-01317-1000 SHEET OF: 1 1 DRAWING NUMBER: 01317-101.4	
4	09-15-10			CONFORMED TO CONSTRUCTION RECORDS.				DRAWN RAW											
3	3-4-10	KA	RNJ	REVISED PK BLOCK DESIGNATIONS, REISSUED FOR CONSTRUCTION.															
2	02-23-10	KA	RNJ	ADDED TVA CONNECTION.															
1	2-22-10	KA	RNJ	REVISED FIELD TERMINATIONS															
0	11-09-09	KA	RNJ	ISSUED FOR CONSTRUCTION.															
REV	DATE	CHKD	APPD	REVISION DESCRIPTION															
COPYRIGHT 2008, R.W. BECK, INC. ALL RIGHTS RESERVED																			

NOTES:


1. CONCRETE SHALL HAVE A COMPRESSIVE STRENGTH OF 3500 PSI AT 28 DAYS IN ACCORDANCE WITH ASTM C39. REINFORCING SHALL BE DEFORMED NEW BILLET STEEL IN ACCORDANCE WITH ASTM A615, GRADE 60.
2. CHAMFER ALL EXPOSED EDGES 1".
3. MAXIMUM SIZE OF AGGREGATE SHALL BE 1 1/2". EXPOSED SURFACE OF CONCRETE TO BE SMOOTH FORM FINISH.
4. BAR GRATING AND ALL EXPOSED STEEL TO BE GALVANIZED.
5. MISCELLANEOUS STEEL: ASTM A-36, HOT DIP GALVANIZED AFTER FABRICATION.
6. PROVIDE WATER STOPS WHERE SHOWN AND AT ALL VERTICAL CONSTRUCTION JOINTS IN THE OIL CATCHMENT TRENCH WALLS.
7. SLOPE TRENCH AT 0.5% MINIMUM TO OUTLETS.
8. SUBGRADE TO BE COMPACTED TO 98% MAX. DENSITY PER ASTM D1557.
9. NOT ALL REINFORCING BARS SHOWN FOR CLARITY.
10. TYPICAL 3" CLEAR SPACING FOR ALL REINFORCING BARS.
11. ALL CONDUIT TO BE PVC, SCHEDULE 80 BELOW GRADE.
12. GRATING IN AREA OVER DRAIN TO BE REMOVABLE SEPARATELY FROM OTHER GRATING SECTIONS, 120 LB MAXIMUM.
13. INSTALL EUCOLASTIC II (2 PART URETHANE SEALANT) MANUFACTURED BY EUCLID CHEMICAL COMPANY OR EQUIVALENT. INSTALL IN ACCORDANCE WITH MANUFACTURER'S SPECS.
14. INSTALL EPOXY BONDING AGENT AT ALL COLD JOINTS.
15. ENSURE PROPER COMPACTION OF SOIL AND GRAVEL UNDER ALL NEW INSTALLATIONS.

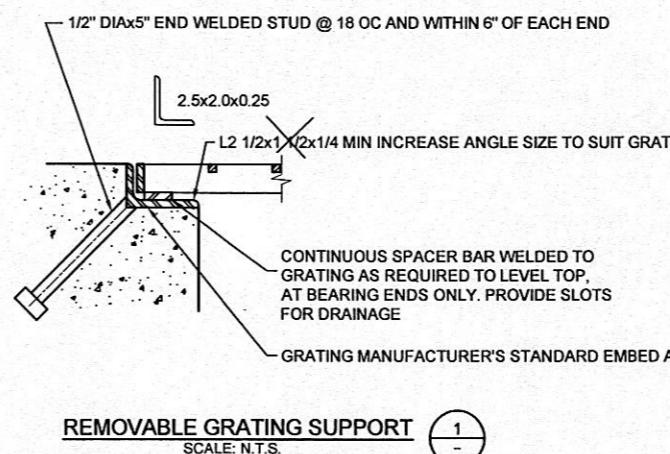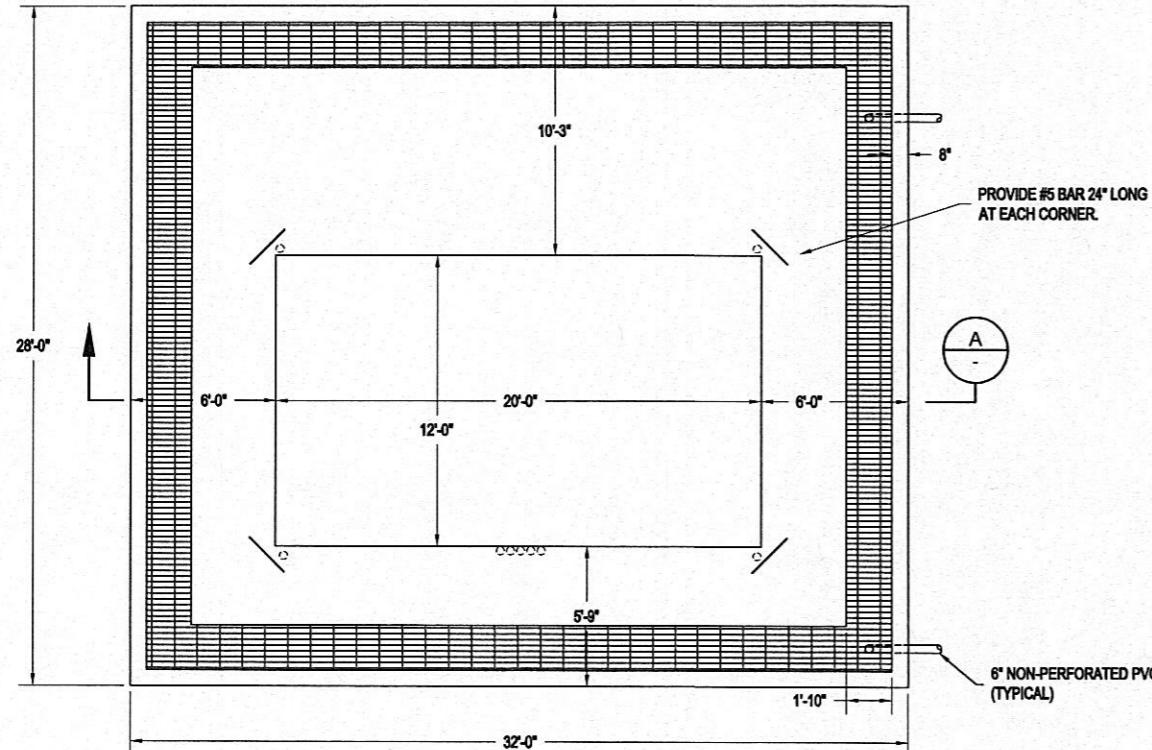


REMOVABLE GRATING SUPPORT SCALE: N.T.S.

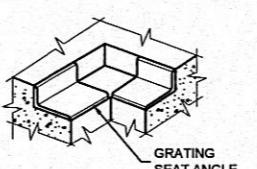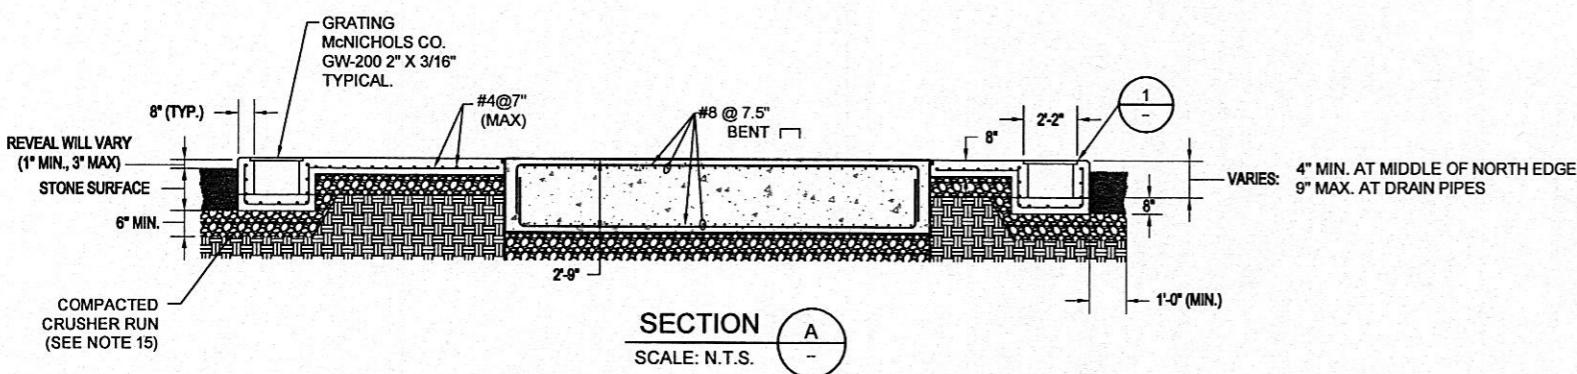

DESIGNED	CONFORMED TO CONSTRUCTION RECORDS			R.W. Beck 131 Saundersville Rd., Suite 300 Hendersonville, TN 37075 (615) 431-3200 An SAIC Company	HARRIMAN UTILITY BOARD HARRIMAN PRIMARY SUBSTATION TRANSFORMER BANK 1 FOUNDATION AND OIL CONTAINMENT APRON	PROJECT NUMBER: 07-70014-01317-1000 SHEET OF: DRAWING NUMBER: 01317-411.2
DRAWN	CONFORMED TO CONSTRUCTION RECORDS.	ISSUED FOR CONSTRUCTION	ISSUED FOR BIDS.			
2 09-15-10						
1 11-05-09	MDB KA	ISSUED FOR CONSTRUCTION				
0 10-02-08	MDB KA	ISSUED FOR BIDS.				
REV DATE	CHK'D APP'D	REVISION DESCRIPTION				

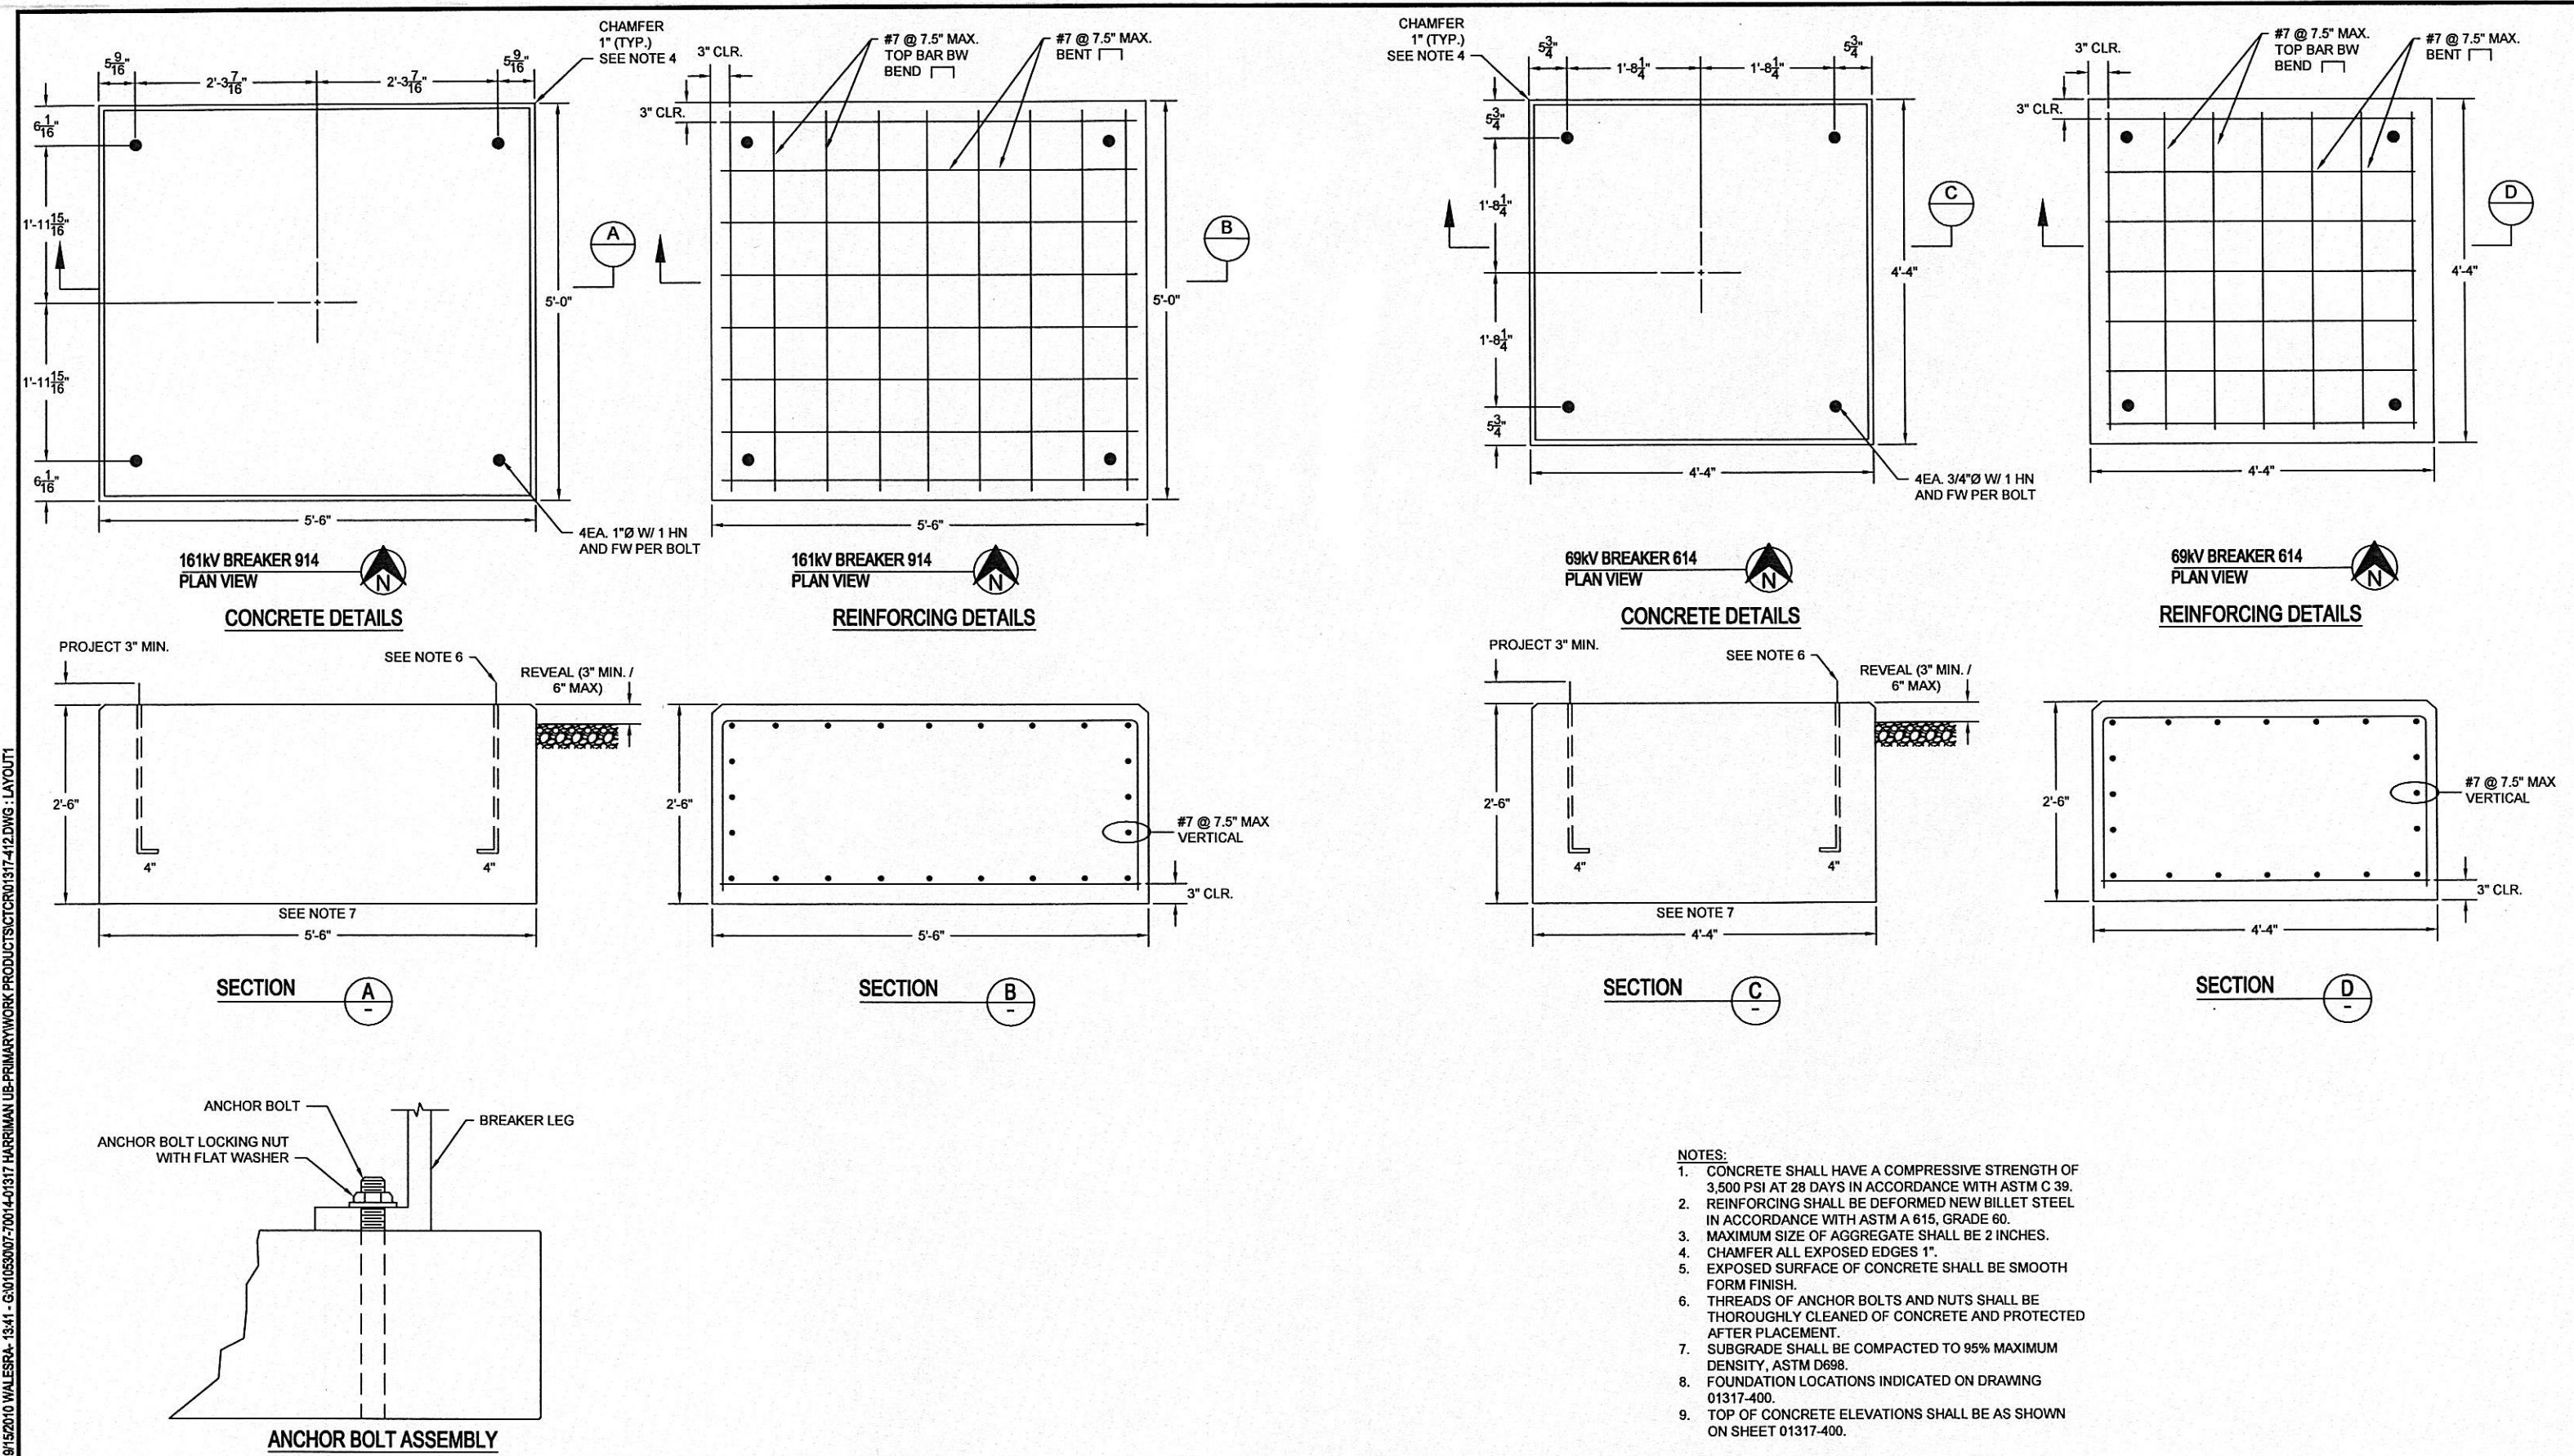

			DESIGNED	DRAWN	CONFORMED TO CONSTRUCTION RECORDS		R.W. Beck	HARRIMAN UTILITY BOARD HARRIMAN PRIMARY SUBSTATION BREAKER 914 AND BREAKER 614 FOUNDATION DETAILS	PROJECT NUMBER: 07-70014-01317-1000
2	09-15-10				CONFORMED TO CONSTRUCTION RECORDS.				SHEET OF:
1	12-15-09	MDB	KA		LOCATED CENTERLINES, CONVERTED TO FRACTIONS, ISSUED FOR CONSTRUCTION.				DRAWING NUMBER: 01317-412.2
0	10-02-09	MDB	KA		ISSUED FOR BIDS.				
REV	DATE	CHKD	APPD		REVISION DESCRIPTION				

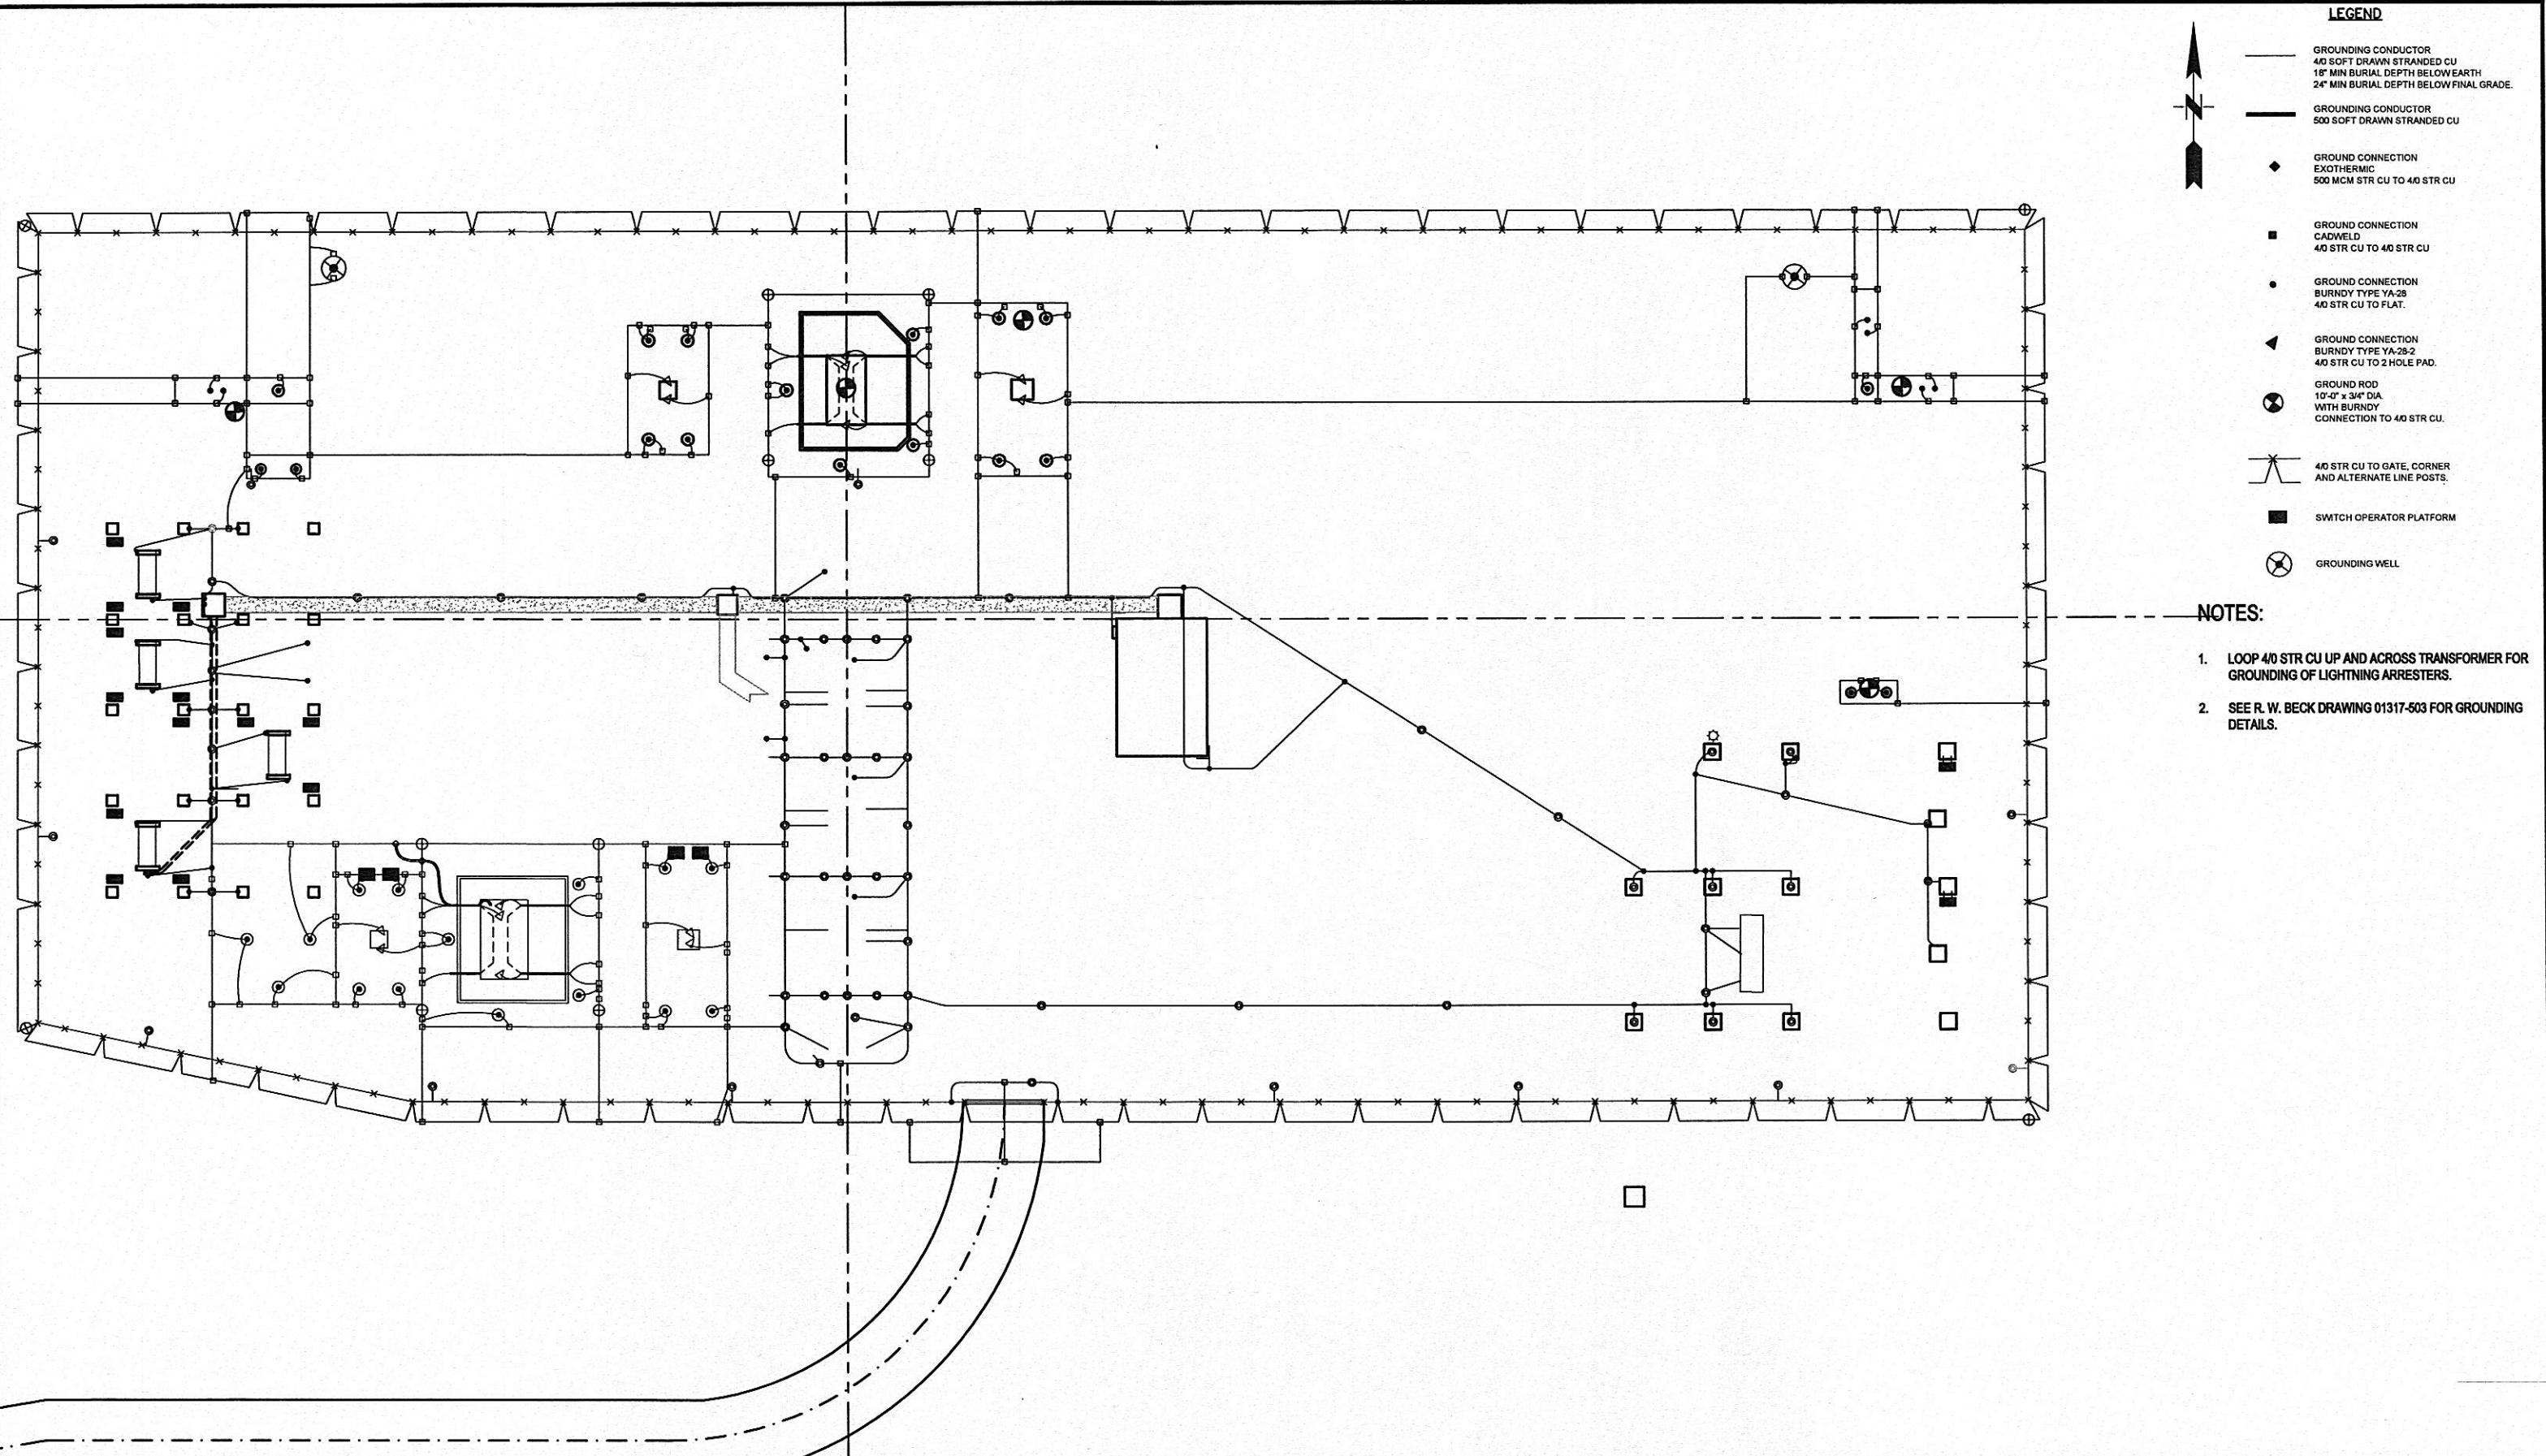

LEGEND	
—	GROUNDING CONDUCTOR 4/0 SOFT DRAWN STRANDED CU 18" MIN BURIAL DEPTH BELOW EARTH 24" MIN BURIAL DEPTH BELOW FINAL GRADE.
—	GROUNDING CONDUCTOR 500 SOFT DRAWN STRANDED CU
◆	GROUND CONNECTION EXOTHERMIC 500 MCM STR CU TO 4/0 STR CU
■	GROUND CONNECTION CADWELD 4/0 STR CU TO 4/0 STR CU
●	GROUND CONNECTION BURNDY TYPE YA-28 4/0 STR CU TO FLAT.
◀	GROUND CONNECTION BURNDY TYPE YA-28-2 4/0 STR CU TO 2 HOLE PAD.
○	GROUND ROD 10'-0" x 3/4" DIA. WITH BURNDY CONNECTION TO 4/0 STR CU.
—	4/0 STR CU TO GATE, CORNER AND ALTERNATE LINE POSTS.
■	SWITCH OPERATOR PLATFORM
○	GROUNDING WELL

NOTES:

1. LOOP 4/0 STR CU UP AND ACROSS TRANSFORMER FOR GROUNDING OF LIGHTNING ARRESTERS.
2. SEE R. W. BECK DRAWING 01317-503 FOR GROUNDING DETAILS.

REV	DATE	CHKD	APPD	REVISION DESCRIPTION
2	09-15-10			CONFORMED TO CONSTRUCTION RECORDS.
1	12-15-09	RJ	KA	ISSUED FOR CONSTRUCTION.
0	10-02-09	RJ	KA	ISSUED FOR BIDS.

**CONFORMED TO
CONSTRUCTION
RECORDS**

DESIGNED
KADRAWN
RW

20 0 20 40 60
SCALE IN FEET



R.W. Beck
131 Saundersville Rd., Suite 300
Hendersonville, TN 37075
(615) 431-3200
An SAIC Company

HARRIMAN UTILITY BOARD
HARRIMAN PRIMARY SUBSTATION
GROUNDING PLAN


PROJECT NUMBER:
07-70014-01317-1000
SHEET OF:
1 1
DRAWING NUMBER:
01317-500.2

NOTES:

1. BELOW GRADE CONDUIT TO BE SCHEDULE 40, ABOVE GRADE TO BE SCHEDULE 80, UNLESS NOTED OTHERWISE.
2. MINIMUM CONDUIT BURIAL DEPTH SHALL BE 24" BELOW FINAL GRADE UNLESS NOTED OTHERWISE.
3. SEE R.W. BECK DRAWING 01317-503 FOR CONDUIT DETAILS.
4. SEE R.W. BECK DRAWING 01317-504 FOR CIRCUIT LIST.
5. FIELD VERIFY ALL CONDUIT TERMINATION LOCATIONS.
6. CONTRACTOR TO CONNECT ALL JUNCTION BOXES WITH CABLE AND CONDUIT TO ALL OVERHEAD EQUIPMENT.
7. CONDUIT SHALL BE 2" UNLESS OTHERWISE NOTED.

LEGEND:

- JUNCTION BOX
- CONDUIT CIRCUIT
- SUBSTATION LUMINAIRE

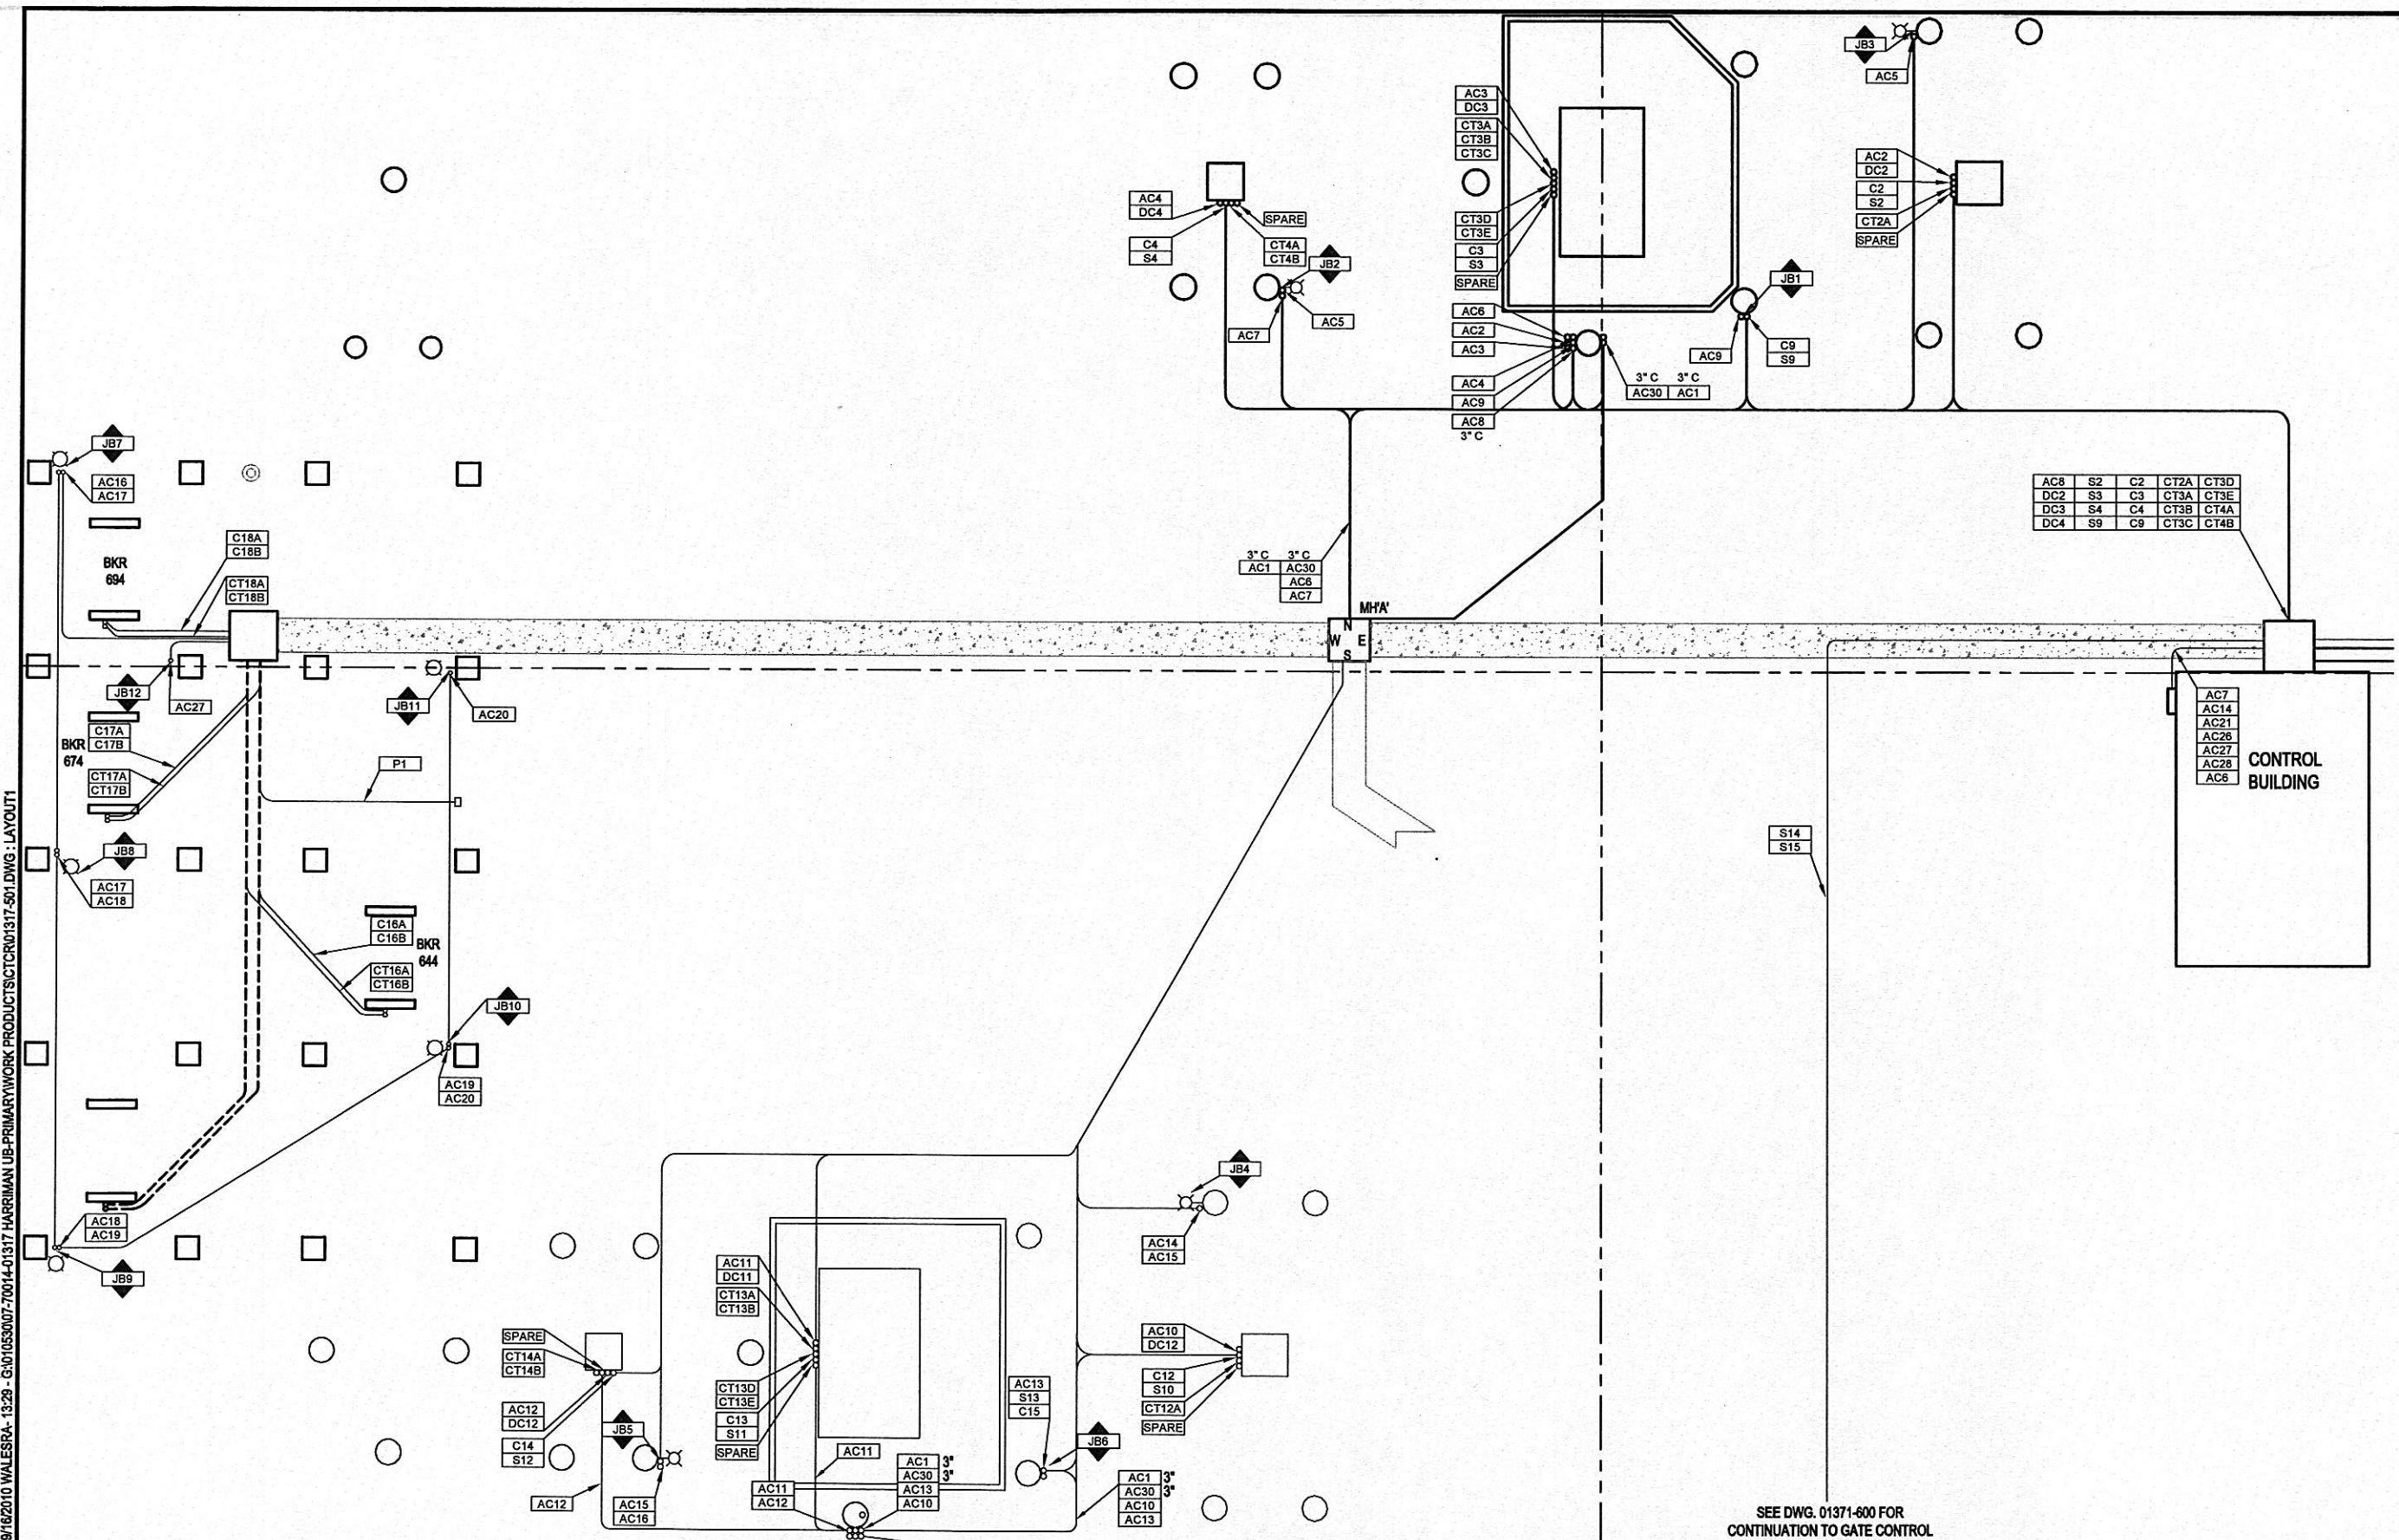

PLOT: 9/18/2010 WALESRA - 1329 - G:\0\0530\07-70014-01317 HARRIMAN UB-PRIMARY\WORK PRODUCTS\CTRD\01317-501.DWG : LAYOUT1
SAVED: 9/18/2010 WALESRA

REV	DATE	CHKD	APPD	REVISION DESCRIPTION
3	09-15-10			CONFORMED TO CONSTRUCTION RECORDS.
2	02-24-10	RJ	KA	CORRECTIONS TO AC CABLES.
1	12-15-09	RJ	KA	ISSUED FOR CONSTRUCTION.
0	10-02-09	RJ	KA	ISSUED FOR BIDS.

DESIGNED
KA
DRAWN
RW
**CONFORMED TO
CONSTRUCTION
RECORDS**

10 0 10 20 30
SCALE IN FEET





R.W. Beck
131 Saundersville Rd., Suite 300
Hendersonville, TN 37075
(615) 431-3200
An SAIC Company

HARRIMAN UTILITY BOARD
HARRIMAN PRIMARY SUBSTATION
LIGHTING AND CONDUIT PLAN

PROJECT NUMBER:
07-70014-01317-1000
SHEET OF:
1 1
DRAWING NUMBER:
01317-501.3

- NOTES:**
1. BELOW GRADE CONDUIT TO BE SCHEDULE 40, ABOVE GRADE TO BE SCHEDULE 80, UNLESS NOTED OTHERWISE.
 2. MINIMUM CONDUIT BURIAL DEPTH SHALL BE 24" BELOW FINAL GRADE UNLESS NOTED OTHERWISE.
 3. SEE R.W. BECK DRAWING 01164-504 FOR CONDUIT DETAILS.
 4. SEE R.W. BECK DRAWING 01164-505 FOR CIRCUIT LIST.
 5. FIELD VERIFY ALL CONDUIT TERMINATION LOCATIONS.
 6. CONTRACTOR TO CONNECT ALL JUNCTION BOXES WITH CABLE AND CONDUIT TO ALL OVERHEAD EQUIPMENT.
 7. CONDUIT SHALL BE 2" UNLESS OTHERWISE NOTED.
 8. INTERCEPT CONDUITS C1 AND R1, EXTEND TO COUPLING CAPACITORS AS SHOWN AND INSTALL NEW CABLES P2 AND P3.
 9. EXTEND 2-Spare 2" CONDUITS (SP5 AND SP6) TO THIS LOCATION AND CAP ENDS.

LEGEND:

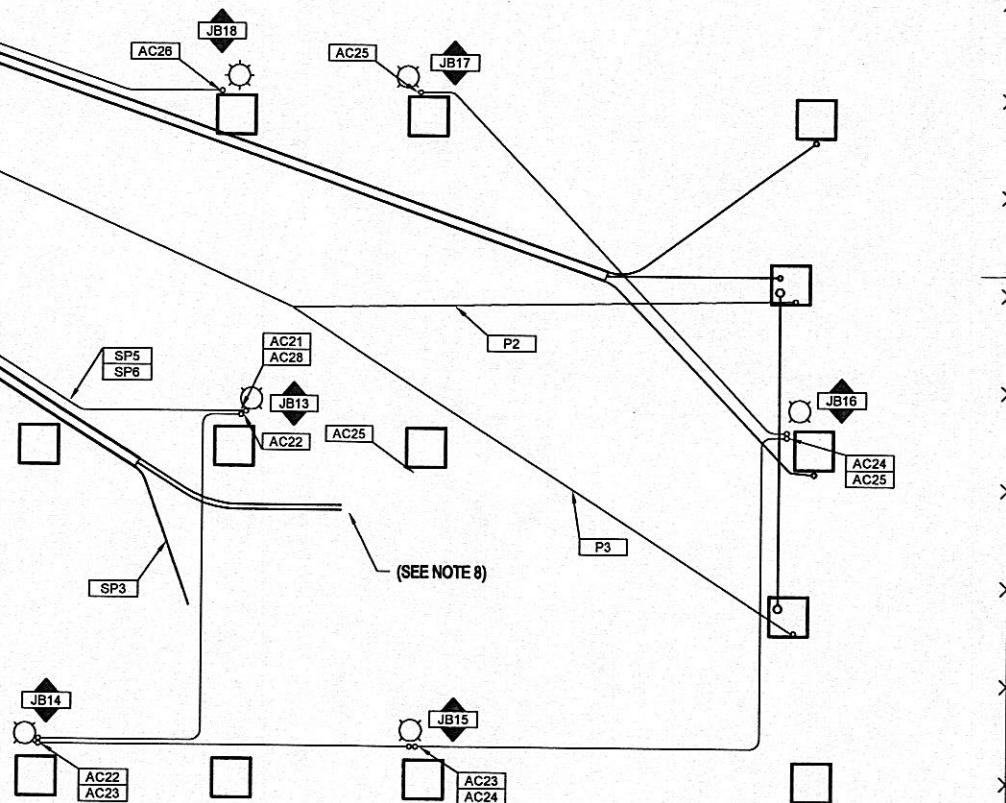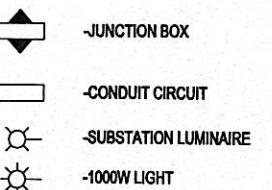

REV	DATE	CHKD	APPD	REVISION DESCRIPTION
2	09-15-10			CONFORMED TO CONSTRUCTION RECORDS.
1	12-15-09	RJ	KA	ISSUED FOR CONSTRUCTION.
0	10-02-09	RJ	KA	ISSUED FOR BIDS.

DESIGNED
KA

DRAWN
RW

**CONFORMED TO
CONSTRUCTION
RECORDS**


10 0 10 20 30
SCALE IN FEET



HARRIMAN UTILITY BOARD
HARRIMAN PRIMARY SUBSTATION
LIGHTING AND CONDUIT PLAN


PROJECT NUMBER:
07-70014-01317-1000
SHEET OF:
1 1
DRAWING NUMBER:
01317-502.2

PLOT: 91162010 WALESRA - SAVED: 91162010 WALESRA - 13:38 - G:\D010530\07-7014-01317 HARRIMAN UB-PRIMARY\WORK PRODUCTS\CTCR1317-503.DWG : LAYOUT

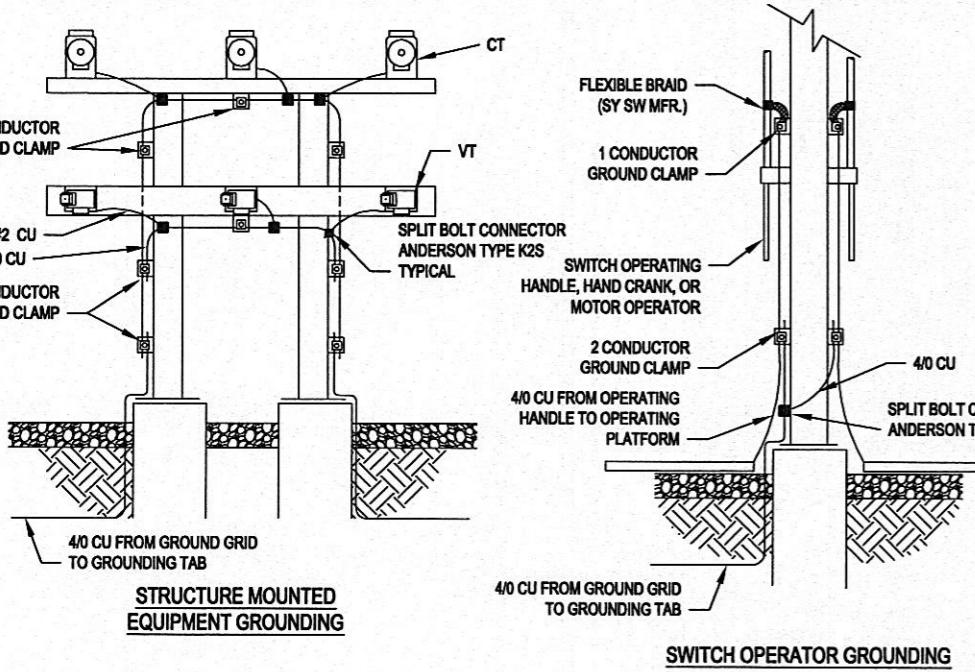


**STRUCTURE MOUNTED
EQUIPMENT GROUNDING**


SWITCH OPERATOR GROUNDING

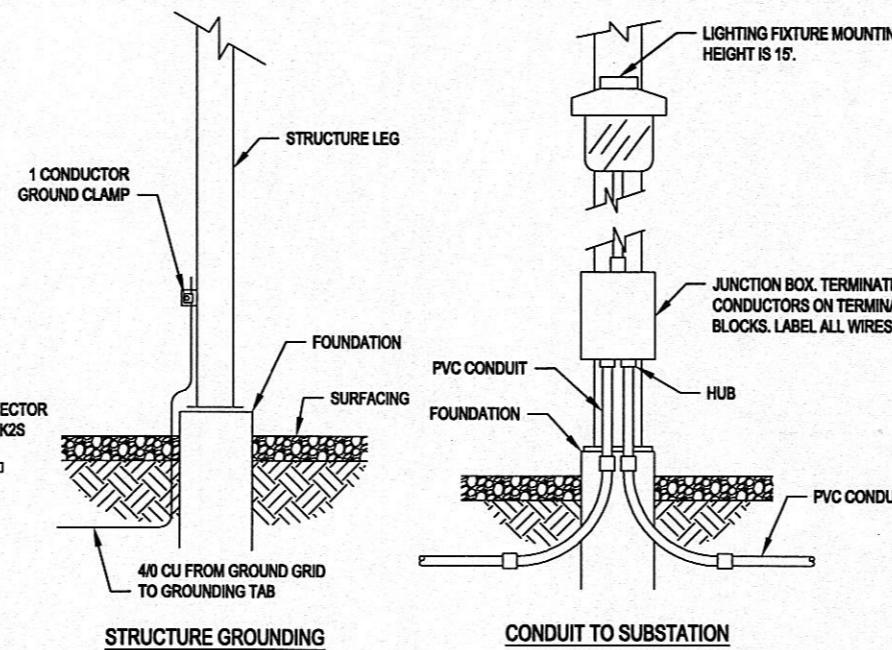


STRUCTURE GROUNDING

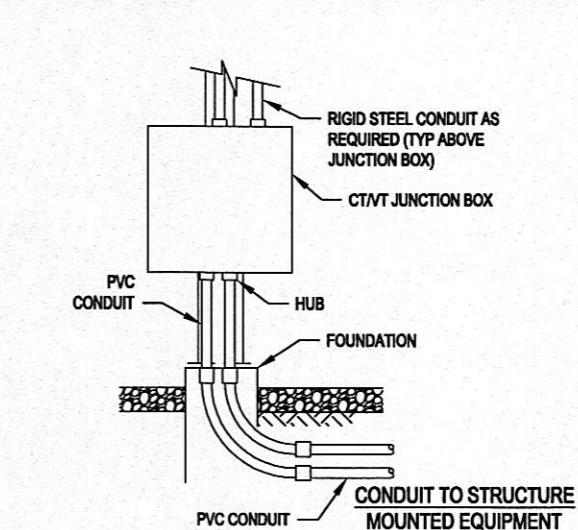


CONDUIT TO STRUCTURE
MOUNTED EQUIPMENT

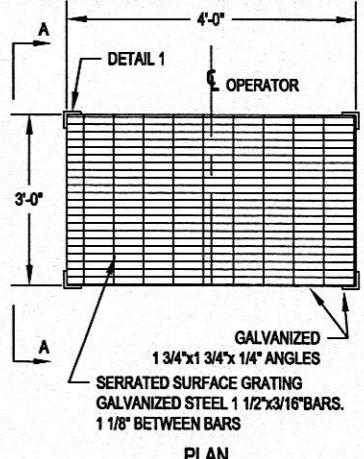


NOTES:
1. ALL STEEL TO BE HOT DIP
GALVANIZED AFTER
FABRICATION.

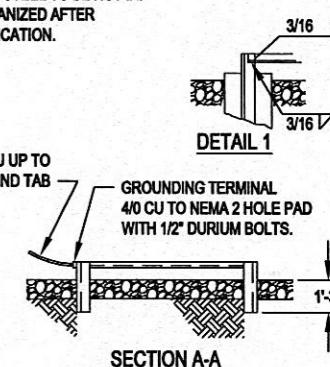


SWITCH OPERATING PLATFORM GROUNDING

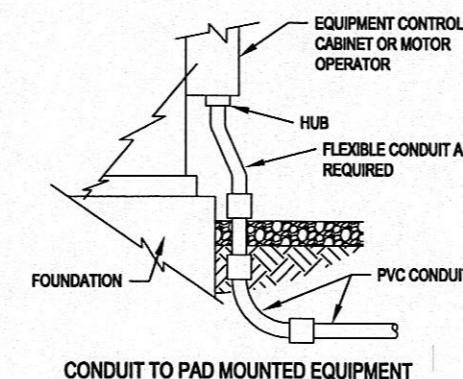


CONDUIT TO PAD MOUNTED EQUIPMENT

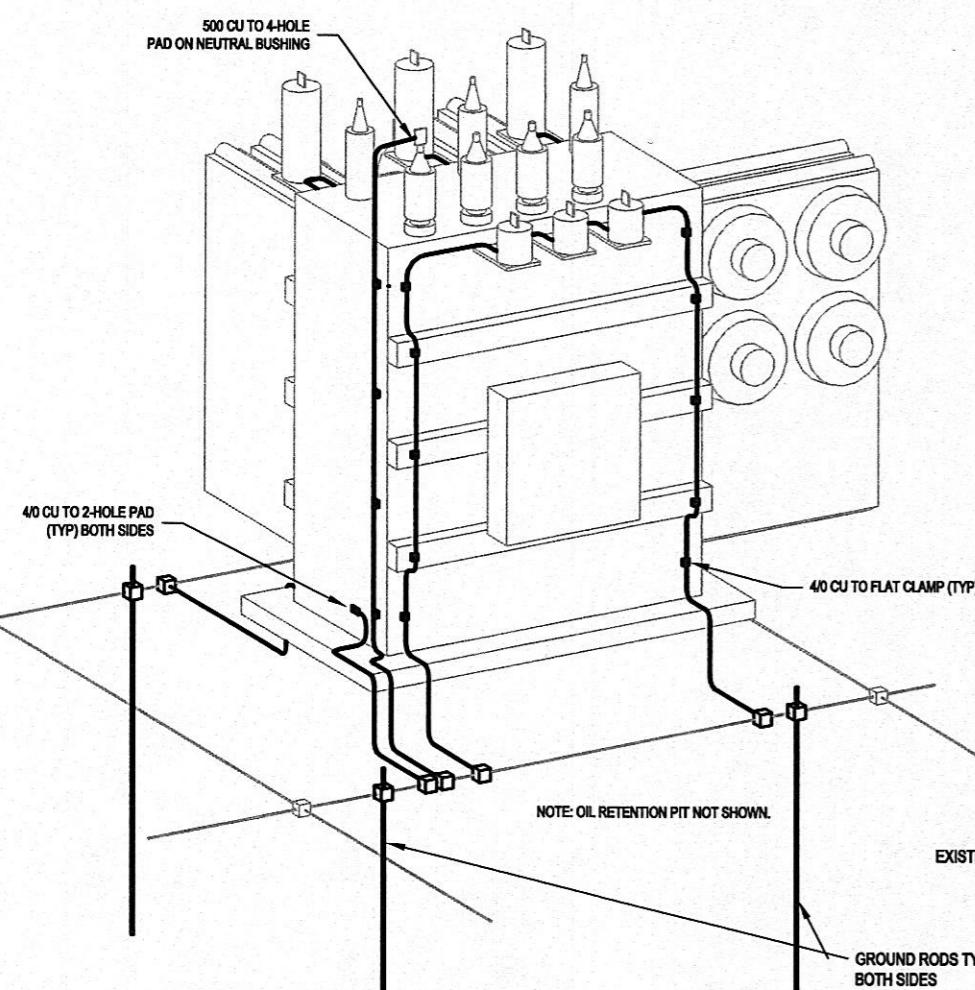

TRANSFORMER GROUNDING DETAIL

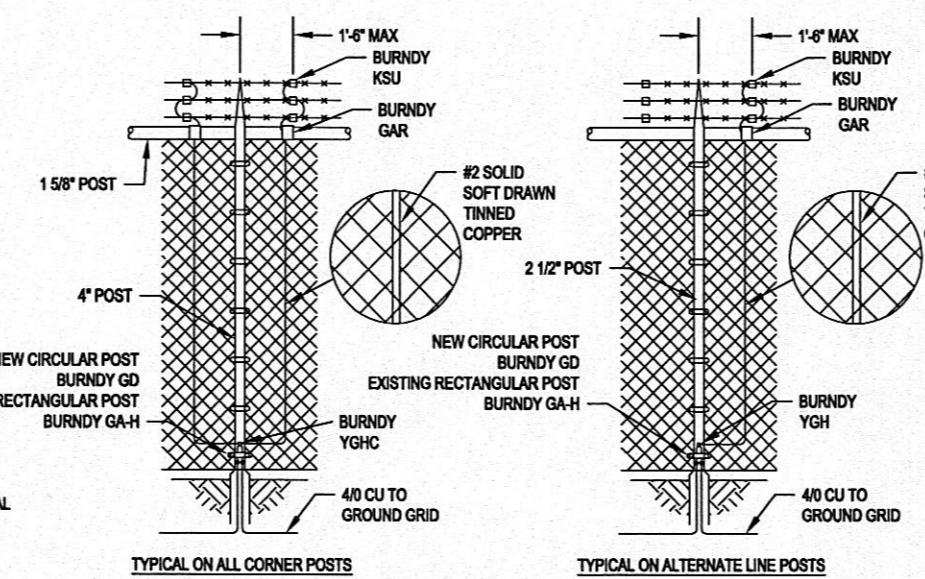

TYPICAL ON ALL CORNER P

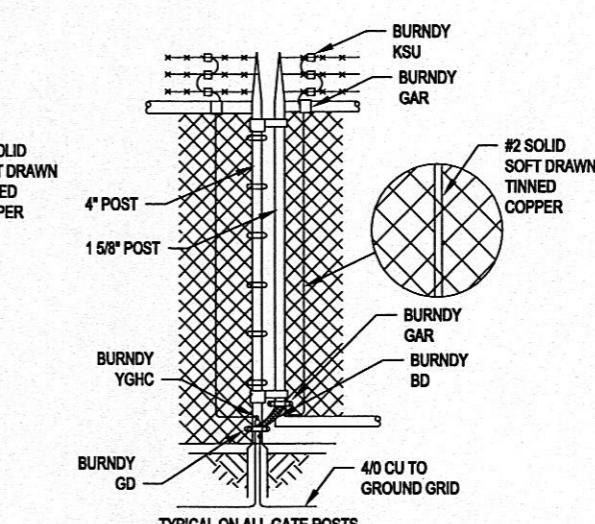

TYPICAL ON ALTERNATE LINE POSTS

PLOT: 9162010 WALESRA - SAVED				
REV	DATE	CHKD	APPD	REVISION DESCRIPTION
2	09-15-10			CONFORMED TO CONSTRUCTION RECORDS.
1	12-15-09	RJ	KA	ISSUED FOR CONSTRUCTION.
0	10-02-09	RJ	KA	ISSUED FOR BIDS.

COPYRIGHT 2008, R.W. BECK, INC., ALL RIGHTS RESERVED

CONFORMED TO CONSTRUCTION RECORDS



R.W.BECK

An SAIC Company

**HARRIMAN UTILITY BOARD
HARRIMAN PRIMARY SUBSTATION
CONDUIT AND GROUNDING DETAILS**


PROJECT NUMBER:
07-70014-01317-1000

SHEET OF:
1 1

DRAWING NUMBER:
01317-503.2

NEW CIRCUIT	# OF CONDUCTORS	CONDUCTOR SIZE	OPERATING VOLTAGE	INSULATION VOLTAGE	COLOR CODE	DESCRIPTION	CIRCUIT FROM	CIRCUIT TO
CT CIRCUITS								
CT-2A	4cc	#10	AC	600V	E2	9251 CURRENTS	BREAKER 924	CONTROL BUILDING
CT-3A	4cc	#10	AC	600V	E2	161 KV DIFF. CURRENTS	TRANSFORMER 2	CONTROL BUILDING
CT-3B	4cc	#10	AC	600V	E2	BUS DIFF CURRENTS	TRANSFORMER 2	CONTROL BUILDING
CT-3C	4cc	#10	AC	600V	E2	13 KV DIFF CURRENTS	TRANSFORMER 2	CONTROL BUILDING
CT-3D	4cc	#10	AC	600V	E2	NEUTRAL DIFF CURRENT	TRANSFORMER 2	CONTROL BUILDING
CT-3E	4cc	#10	AC	600V	E2	5112 CURRENTS	TRANSFORMER 2	CONTROL BUILDING
CT-4A	4cc	#10	AC	600V	E2	6851 CURRENTS	BREAKER 684	CONTROL BUILDING
CT-4B	4cc	#10	AC	600V	E2	69 KV DIFF CURRENTS	BREAKER 684	CONTROL BUILDING
CT-12A	4cc	#10	AC	600V	E2	9151 CURRENTS	BREAKER 914	CONTROL BUILDING
CT-13A	4cc	#10	AC	600V	E2	161 KV DIFF. CURRENTS	TRANSFORMER 1	CONTROL BUILDING
CT-13B	4cc	#10	AC	600V	E2	BUS DIFF CURRENTS	TRANSFORMER 1	CONTROL BUILDING
CT-13D	4cc	#10	AC	600V	E2	NEUTRAL DIFF CURRENT	TRANSFORMER 1	CONTROL BUILDING
CT-13E	4cc	#10	AC	600V	E2	5111 CURRENTS	TRANSFORMER 1	CONTROL BUILDING
CT20	4cc	#10	AC	600V	E2	TVA T1 XWDG CURRENTS	T1	CONTROL BUILDING
CT21	4cc	#10	AC	600V	E2	TVA T1 XWDG CURRENTS	T1	CONTROL BUILDING
CONTROL CIRCUITS								
C2	12cc	#10	125VDC	600V	E2	924 TRIP/CLOSE	BREAKER 924	CONTROL BUILDING
C3	12cc	#10	125VDC	600V	E2	TRANSFORMER TRIPS	TRANSFORMER 2	CONTROL BUILDING
C4	12cc	#10	125VDC	600V	E2	684 TRIP/CLOSE	BREAKER 684	CONTROL BUILDING
C9	12cc	#10	125VDC	600V	E2	92G1 TRIP	GROUND SWITCH 92G1	CONTROL BUILDING
C10	12cc	#18	125VDC	600V	E2	SCADA CONTROL	RELAY PANEL 3F	RTU
SC11	12cc	#18	125VDC	600V	E2	SCADA CONTROL	RELAY PANEL 2F	RTU
C12	12cc	#10	125VDC	600V	E2	914 TRIP/CLOSE	BREAKER 614	CONTROL BUILDING
C13	12cc	#10	125VDC	600V	E2	TRANSFORMER TRIPS	TRANSFORMER 1	CONTROL BUILDING
C14	12cc	#10	125VDC	600V	E2	614 TRIP/CLOSE	BREAKER 614	CONTROL BUILDING
C15	12cc	#10	125VDC	600V	E2	91G1 TRIP	GROUND SWITCH 91G1	CONTROL BUILDING
C16A	12cc	#10	125VDC	600V	E2	664 TRIP/CLOSE	BREAKER 664	CONTROL BUILDING
C16B	4cc	#10	125VDC	600V	E2	664 CONTROL	BREAKER 664	CONTROL BUILDING
C17A	12cc	#10	125VDC	600V	E2	674 TRIP/CLOSE	BREAKER 674	CONTROL BUILDING
C17B	4cc	#10	125VDC	600V	E2	674 CONTROL	BREAKER 674	CONTROL BUILDING
C18A	12cc	#10	125VDC	600V	E2	694 TRIPCLOSE	BREAKER 694	CONTROL BUILDING
C18B	4cc	#10	125VDC	600V	E2	694 CONTROL	BREAKER 694	CONTROL BUILDING
STATUS CIRCUITS								
S2	12cc	#18	125VDC	600V	E2	BREAKER 924 STATUS	BREAKER 924	CONTROL BUILDING
S3	12cc	#18	125VDC	600V	E2	TRANSFORMER 2 STATUS	TRANSFORMER 2	CONTROL BUILDING
S4	12cc	#18	125VDC	600V	E2	BREAKER 684 STATUS	BREAKER 684	CONTROL BUILDING
S9	12cc	#18	125VDC	600V	E2	92G1 STATUS	GROUND SWITCH 92G1	CONTROL BUILDING
S10	12cc	#18	125VDC	600V	E2	BREAKER 914 STATUS	BREAKER 914	CONTROL BUILDING
S11	12cc	#18	125VDC	600V	E2	TRANSFORMER 1 STATUS	TRANSFORMER 1	CONTROL BUILDING
S12	12cc	#18	125VDC	600V	E2	BREAKER 614 STATUS	BREAKER 614	CONTROL BUILDING
S13	12cc	#18	125VDC	600V	E2	91G1 STATUS	GROUND SWITCH 91G1	CONTROL BUILDING
S14	12cc	#18	125VDC	600V	E2	GATE 1 STATUS	GATE 1	CONTROL BUILDING
S15	12cc	#18	125VDC	600V	E2	GATE 2 STATUS	GATE 2	CONTROL BUILDING

NEW CIRCUIT	# OF CONDUCTORS	CONDUCTOR SIZE	OPERATING VOLTAGE	INSULATION VOLTAGE	COLOR CODE	DESCRIPTION	CIRCUIT FROM	CIRCUIT TO
AC CIRCUITS								
AC1	3	4/0 CU	120/240 VAC	600V	E1	STATION SERVICE	STATION SERVICE TRANSFORMER 1	AC TRANSFER SWITCH
AC1	3	4/0 CU	120/240 VAC	600V	E1	STATION SERVICE	EXISTING STATION SERVICE PANEL	AC TRANSFER SWITCH
AC30	3	4/0 CU	120/240 VAC	600V	E1	STATION SERVICE	STATION SERVICE TRANSFORMER 1	AC TRANSFER SWITCH
AC2	3	#10	120/240 VAC	600V	E1	BREAKER 924 AC POWER	BREAKER 924	STATION SERVICE DISTRIBUTION PANEL
AC3	3	#6 CU	120/240 VAC	600V	E1	TRANSFORMER 2 AC POWER	TRANSFORMER 2	STATION SERVICE DISTRIBUTION PANEL
AC4	4cc	#10	120/240 VAC	600V	E1	BREAKER 684 AC POWER	BREAKER 684	STATION SERVICE DISTRIBUTION PANEL
AC5	4cc	#10	120/240 VAC	600V	E1	LIGHTING	YARD LIGHT JB3	YARD LIGHT JB2
AC5	7cc	#10	120/240 VAC	600V	E1	LIGHTING	YARD LIGHT JB3	YARD LIGHT JB2
AC6	3	1/0 CU	120/240 VAC	600V	E1	LIGHTING	STATION SERVICE DISTRIBUTION PANEL	LIGHTING DISTRIBUTION BOX
AC6	3	1/0 CU	120/240 VAC	600V	E1	LIGHTING	STATION SERVICE DISTRIBUTION PANEL 2	LIGHTING JUNCTION BOX JB LT
AC7	4cc	#10	120/240 VAC	600V	E1	LIGHTING	YARD LIGHT JB2	LIGHTING DISTRIBUTION BOX
AC7	7cc	#10	120/240 VAC	600V	E1	LIGHTING	YARD LIGHT JB2	LIGHTING JUNCTION BOX JB LT
AC8	7cc	4/0 CU	120/240 VAC	600V	E1	STATION SERVICE	STATION SERVICE DISTRIBUTION PANEL	CONTROL BUILDING AC PANEL
AC9	7cc	#10	120/240 VAC	600V	E1	GROUND SWITCH HEATER	GROUND SWITCH 92G1	STATION SERVICE DISTRIBUTION PANEL
AC10	4	#10	120/240 VAC	600V	E1	BREAKER 914 AC POWER	BREAKER 914	STATION SERVICE DISTRIBUTION PANEL 1
AC11	3	#6	120/240 VAC	600V	E1	TRANSFORMER 1 AC POWER	TRANSFORMER 1	STATION SERVICE DISTRIBUTION PANEL 1
AC12	4	#10	120/240 VAC	600V	E1	BREAKER 614 AC POWER	BREAKER 614	STATION SERVICE DISTRIBUTION PANEL 1
AC13	4	#10	120/240 VAC	600V	E1	GROUND SWITCH HEATER	GROUND SWITCH 91G1	STATION SERVICE DISTRIBUTION PANEL 1
AC14	7cc	#10	120/240 VAC	600V	E1	LIGHTING	YARD LIGHT JB4	YARD JUNCTION BOX JB LT
AC15	7cc	#10	120/240 VAC	600V	E2	LIGHTING	YARD LIGHT JB5	YARD LIGHT JB4
AC16	7cc	#10	120/240 VAC	600V	E3	LIGHTING	YARD LIGHT JB5	YARD LIGHT JB5
AC17	7cc	#10	120/240 VAC	600V	E4	LIGHTING	YARD LIGHT JB6	YARD LIGHT JB7
AC18	7cc	#10	120/240 VAC	600V	E5	LIGHTING	YARD LIGHT JB9	YARD LIGHT JB8
AC19	7cc	#10	120/240 VAC	600V	E6	LIGHTING	YARD LIGHT JB10	YARD LIGHT JB9
AC20	7cc	#10	120/240 VAC	600V	E7	LIGHTING	YARD LIGHT JB11	YARD LIGHT JB10
AC21	7cc	#10	120/240 VAC	600V	E8	LIGHTING	YARD LIGHT JB13	LIGHTING DISTRIBUTION BOX JB LT
AC22	7cc	#10	120/240 VAC	600V	E9	LIGHTING	YARD LIGHT JB14	YARD LIGHT JB13
AC23	7cc	#10	120/240 VAC	600V	E10	LIGHTING	YARD LIGHT JB15	YARD LIGHT JB14
AC24	7cc	#10	120/240 VAC	600V				

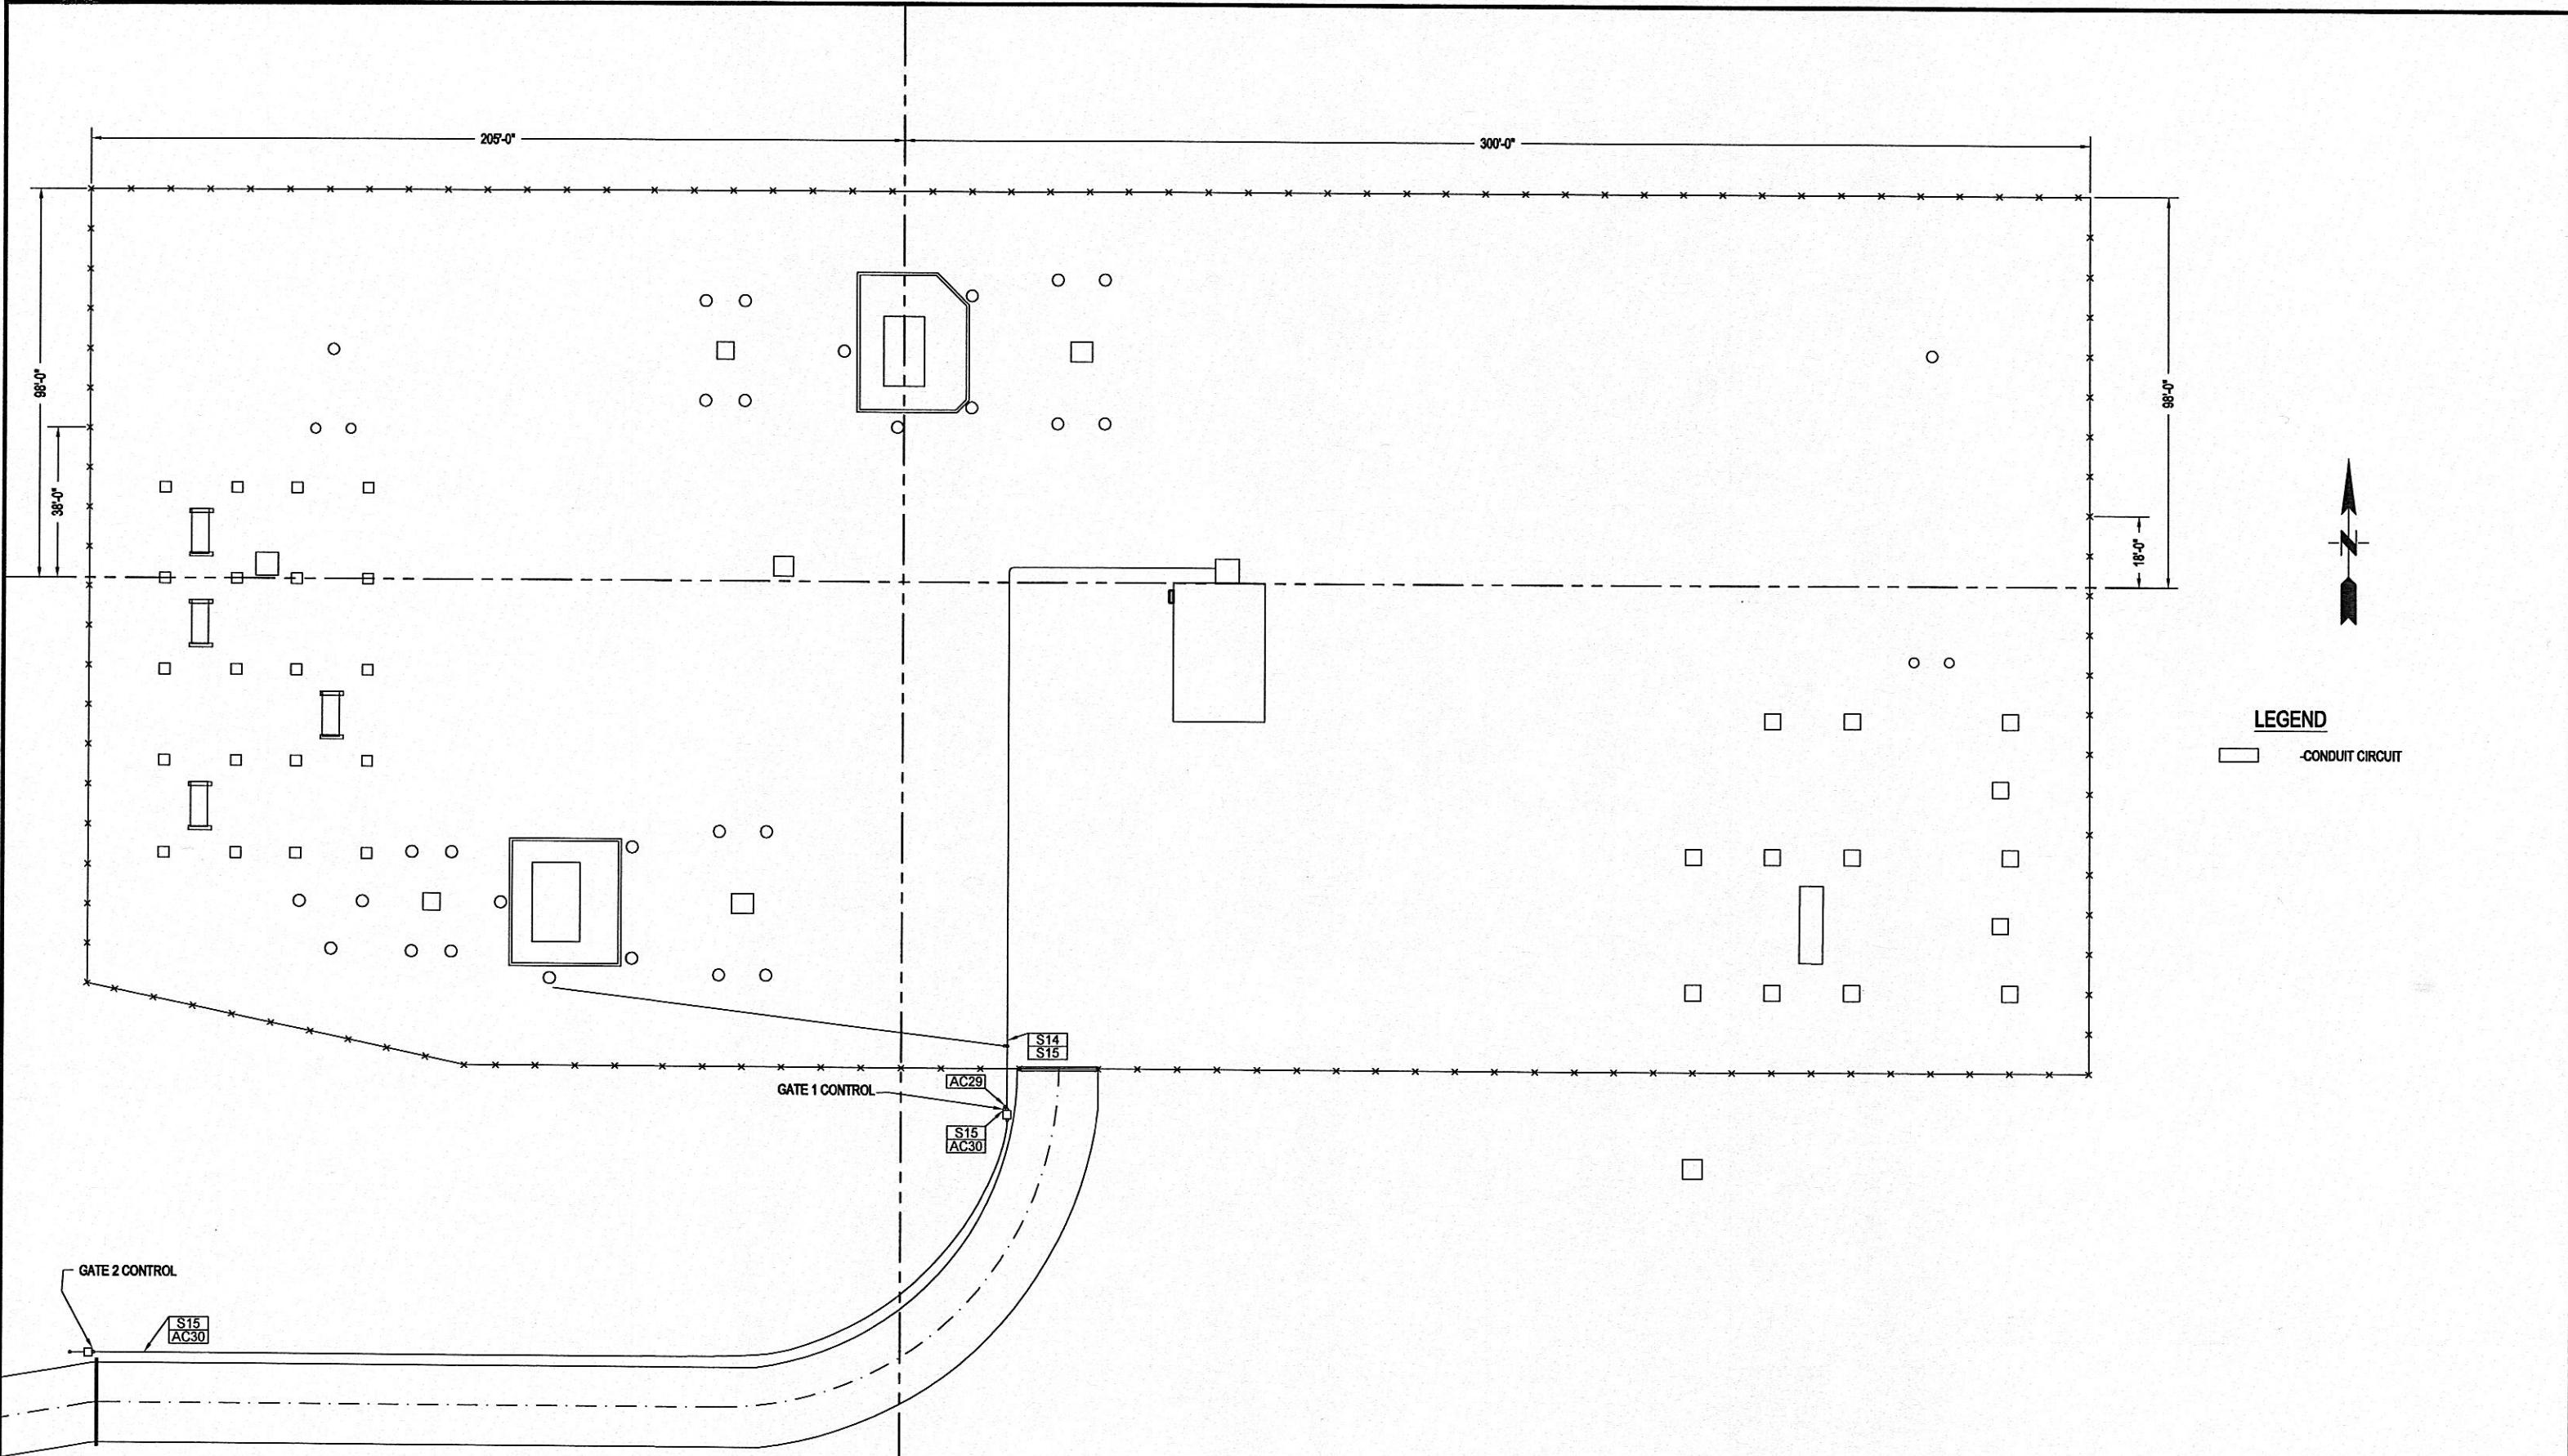

REV	DATE	CHKD	APPD	CONFORMED TO CONSTRUCTION RECORDS	
				DESIGNED KA	DRAWN RW
2	09-15-10			CONFORMED TO CONSTRUCTION RECORDS.	
1	12-15-09	RJ	KA	ISSUED FOR CONSTRUCTION.	
0	10-02-09	RJ	KA	ISSUED FOR BIDS.	
REVISION DESCRIPTION					

COPYRIGHT 2008, R.W. BECK, INC., ALL RIGHTS RESERVED

CONFORMED TO CONSTRUCTION RECORDS


20 0 20 40 60
SCALE IN FEET



R.W. Beck
131 Saundersville Rd., Suite 300
Hendersonville, TN 37075
(615) 431-3200
An SAIC Company

HARRIMAN UTILITY BOARD
HARRIMAN PRIMARY SUBSTATION
YARD IMPROVEMENT PLAN


PROJECT NUMBER:
07-70014-01317-1000
SHEET OF:
1 1
DRAWING NUMBER:
01317-600.2

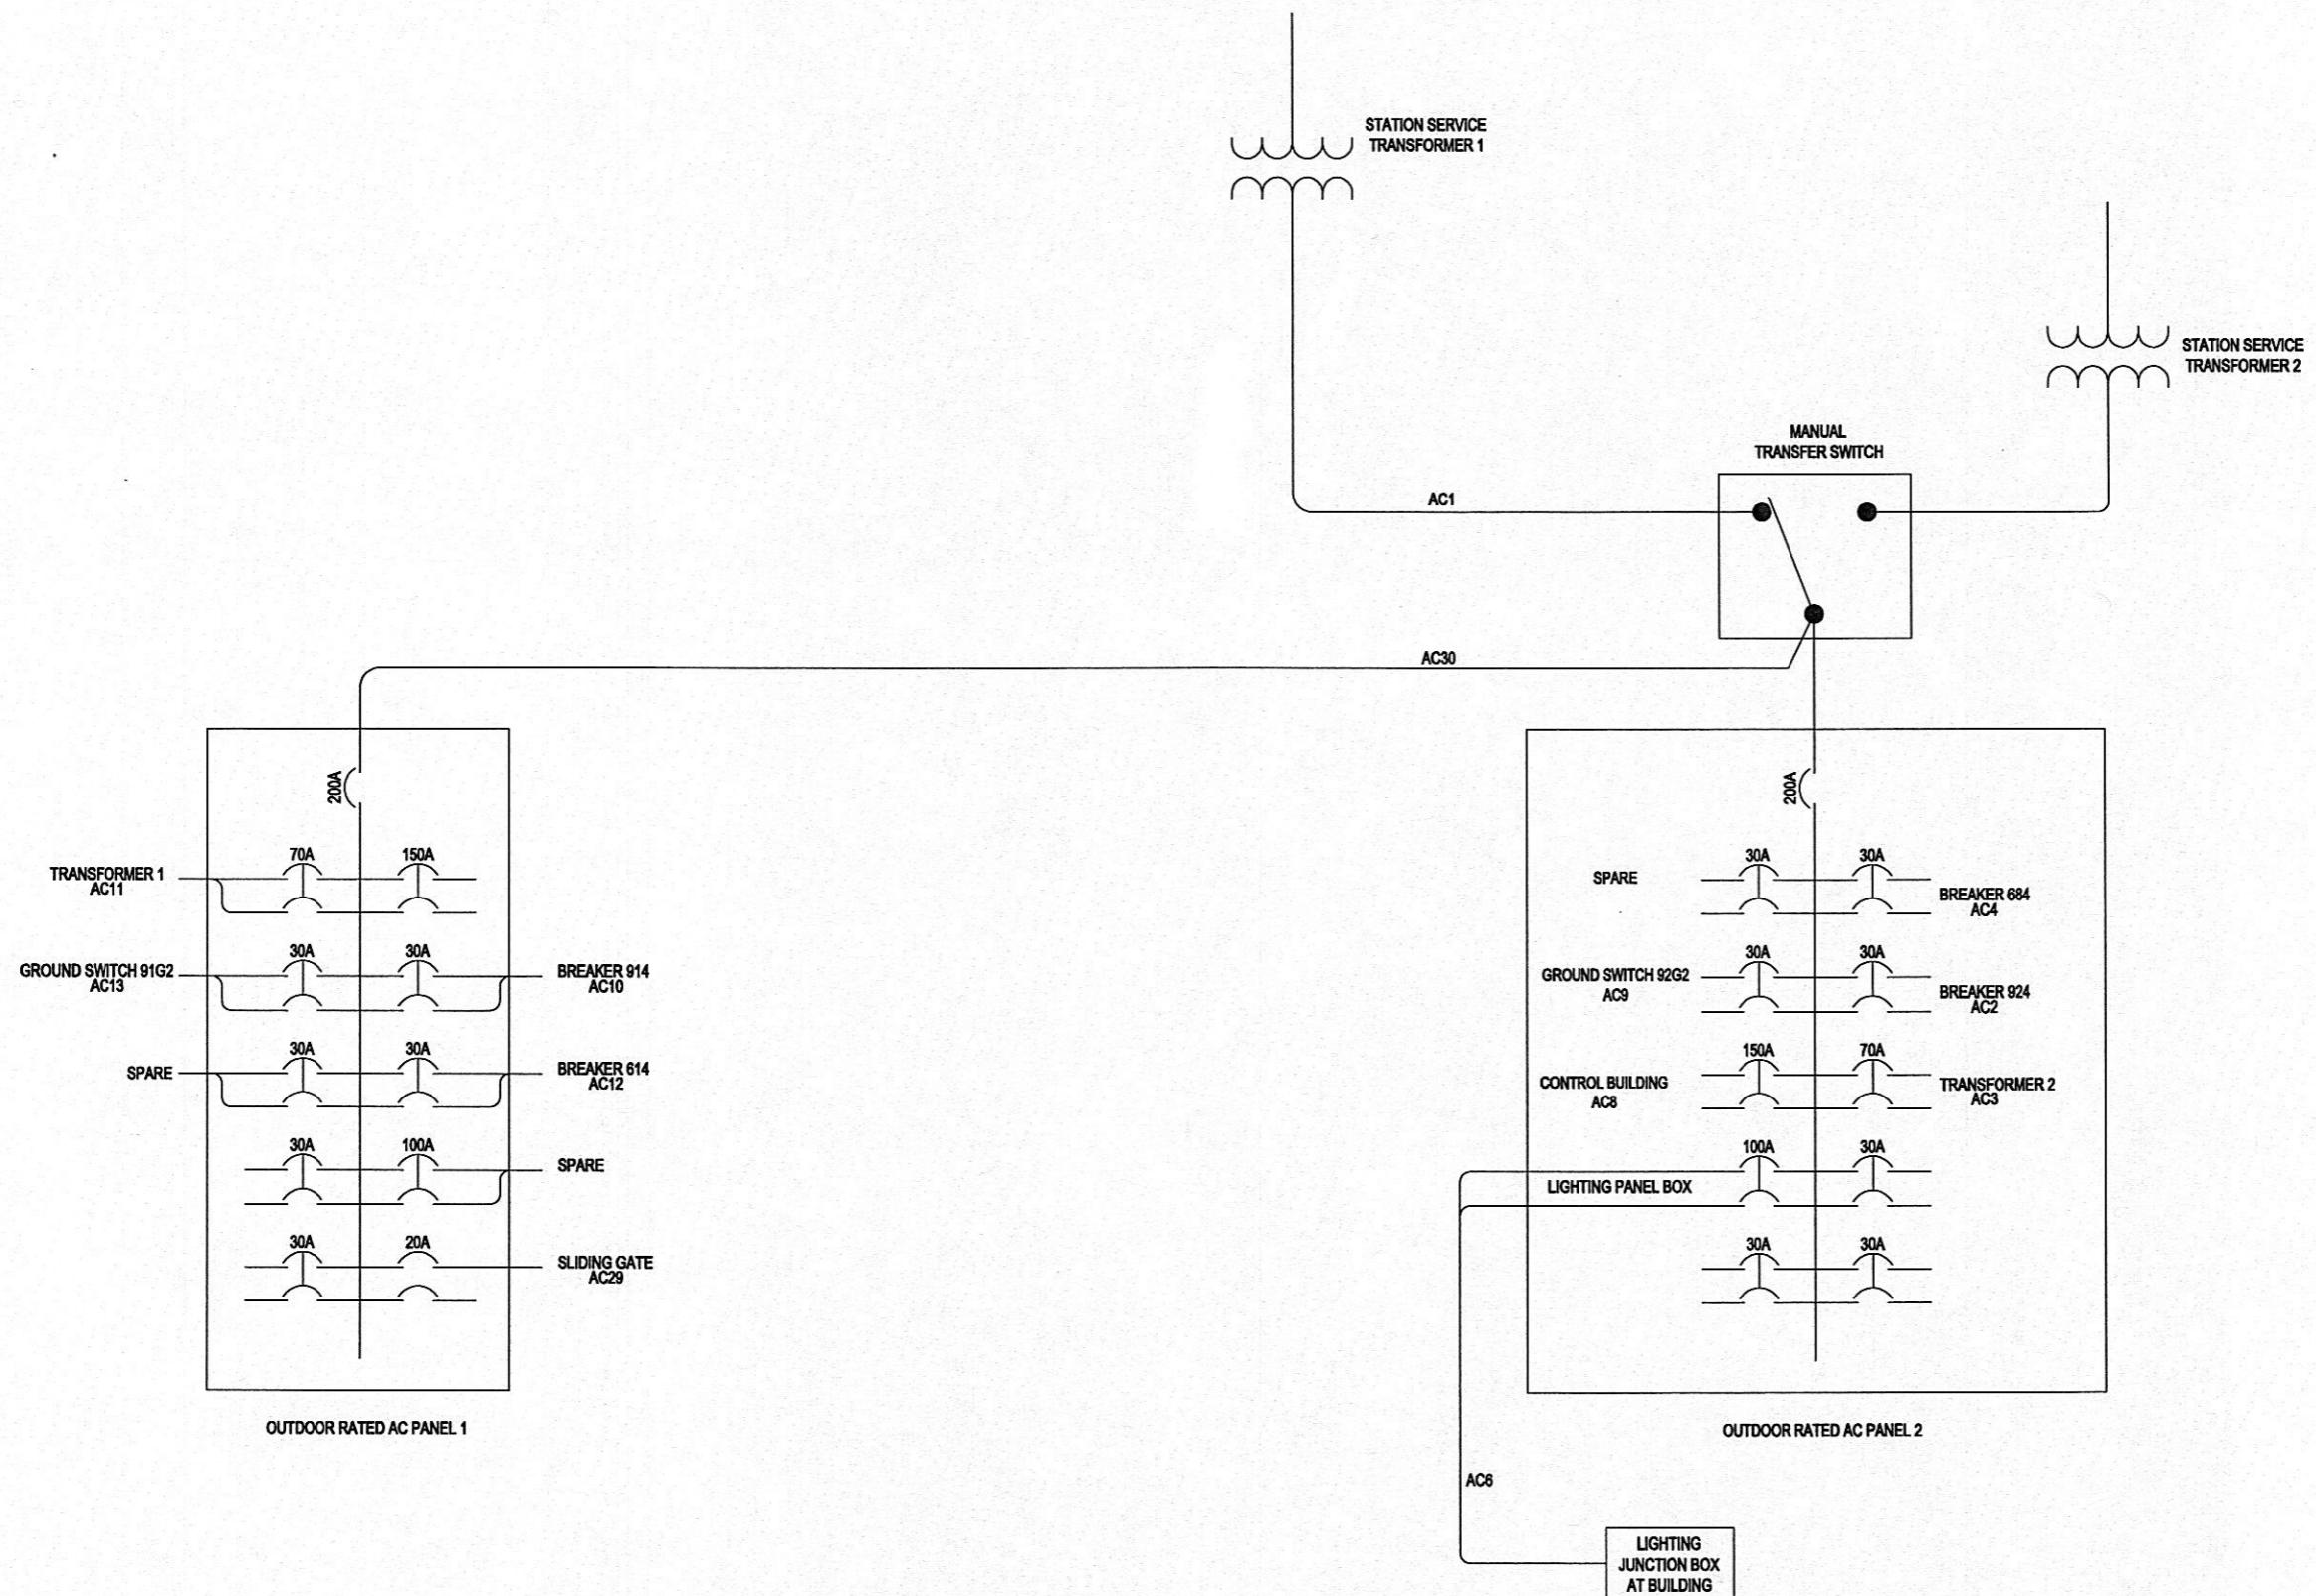

				DESIGNED KA	CONFORMED TO CONSTRUCTION RECORDS		HARRIMAN UTILITY BOARD HARRIMAN PRIMARY SUBSTATION STATION SERVICE AC DISTRIBUTION MODIFICATIONS	PROJECT NUMBER: 07-70014-01317-1000
3	09-15-10	RJ	KA	CONFORMED TO CONSTRUCTION RECORDS.	DRAWN RW		SHEET OF: 1 1	
2	02-24-10	RJ	KA	CHANGED TRANSFORMER 1 AC BREAKER TO 70A.			DRAWING NUMBER: 01317-700.3	
1	12-15-09	RJ	KA	ISSUED FOR CONSTRUCTION.				
0	10-02-09	RJ	KA	ISSUED FOR BIDS.				
REV	DATE	CHKD	APPD	REVISION DESCRIPTION				



R.W. Beck
131 Saundersville Rd., Suite 300
Hendersonville, TN 37075
(615) 431-3200
An SAIC Company

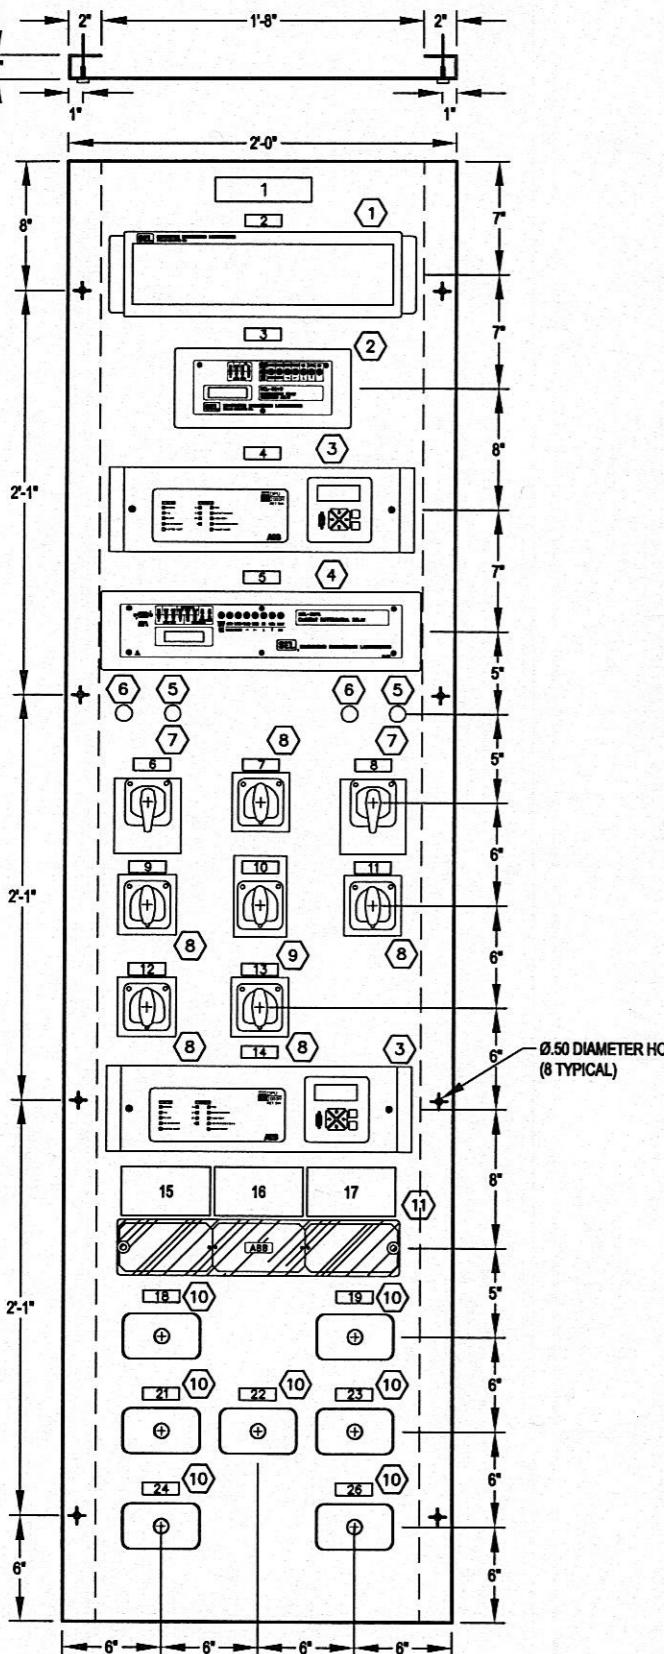

FRONT VIEW

PLOT: 9162010 WALESRA - SAVED				
2	09-15-10			CONFORMED TO CONSTRUCTION RECORDS.
1	11-09-09	KA	RNJ	ISSUED FOR CONSTRUCTION.
0	08-24-09	KA	RNJ	ISSUED FOR BIDS.
REV	DATE	CHK'D	APPD	REVISION DESCRIPTION

CONFORMED TO CONSTRUCTION RECORDS

NAMEPLATE NO.	LINE 1	LINE 2	LINE 3
1	PANEL 2F		
2	95	TIME SOURCE	
3	51N-T1	TRANSFORMER 1	NEUTRAL OVERCURRENT
4	9151	BREAKER 914	161 KV OVERCURRENT
5	87T1	TRANSFORMER 1	DIFFERENTIAL RELAY
6	9101	BREAKER 914	CONTROL SWITCH
7	63SP-T1 TCO	SUDDEN PRESSURE	TRIP CUTOUT, T1
8	6101	BREAKER 614	CONTROL SWITCH
9	43S-914	BREAKER 914	SUPERVISORY CONTROL
10	86-T1	TRANSFORMER 1	LOCKOUT RELAY
11	43S-614	SUPERVISORY CUTOUT	BREAKER 614
12	49T-T1 TCO	WINDING TEMP.	TRIP CUTOUT, T1
13	87T1-TCO	DIFFERENTIAL	TRIP CUTOUT, T1
14	6151	BREAKER 614	OVERCURRENT
15	FT-4	SEE DWG 01317-704 FOR DETAILS	
16	FT-5	SEE DWG 01317-704 FOR DETAILS	
17	FT-6	SEE DWG 01317-704 FOR DETAILS	
18	PK-J	BREAKER 914	9151 CURRENTS
19	PK-K	TRANSFORMER 1	87T NEUTRAL CURRENT
20	(NOT USED)		
21	PK-L	TRANSFORMER 1	69 KV CURRENTS
22	PK-M	TRANSFORMER 1	161 KV CURRENTS
23	PK-N	TRANSFORMER 1	51T CURRENTS
24	PK-P	TRANSFORMER 1	51N CURRENT
25	(NOT USED)		
26	PK-S	BREAKER 614	6151 CURRENTS

REFER TO DWG 01317-705 FOR ITEMS MOUNTED ON BACK OF PAN



R.W. Beck
131 Saundersville Rd., Suite 30
Hendersonville, TN 37075
(615) 431-3200

**HARRIMAN UTILITY BOARD
HARRIMAN PRIMARY SUBSTATION
REPLACEMENT PANEL 2F
FRONT VIEW**

PROJECT NUMBER:
07-70014-01317-1000

SHEET OF:
1 1

DRAWING NUMBER:
01317-702.2

			DESIGNED RNJ
3	09-15-10		CONFORMED TO CONSTRUCTION RECORDS.
2	3-4-10	KA	DRAWN RAW
1	2-2-10	KA	RNJ REVISED TERMINAL CONNECTIONS Z13-18, REISSUED FOR CONSTRUCTION.
0	11-09-09	KA	RNJ REVISED DEVICE TERMINATIONS
REV	DATE	CHKD APPD	ISSUED FOR CONSTRUCTION.
			REVISION DESCRIPTION

COPYRIGHT 2008, R.W. BECK, INC., ALL RIGHTS RESERVED


**CONFORMED TO
CONSTRUCTION
RECORDS**




R.W. Beck
131 Saundersville Rd., Suite 300
Hendersonville, TN 37075
(615) 431-3200
An SAIC Company

HARRIMAN UTILITY BOARD
HARRIMAN PRIMARY SUBSTATION
CURRENT ELEMENTARIES
687 B

PROJECT NUMBER:
07-70014-01317-1000
SHEET OF:
1 1
DRAWING NUMBER:
01317-102.3

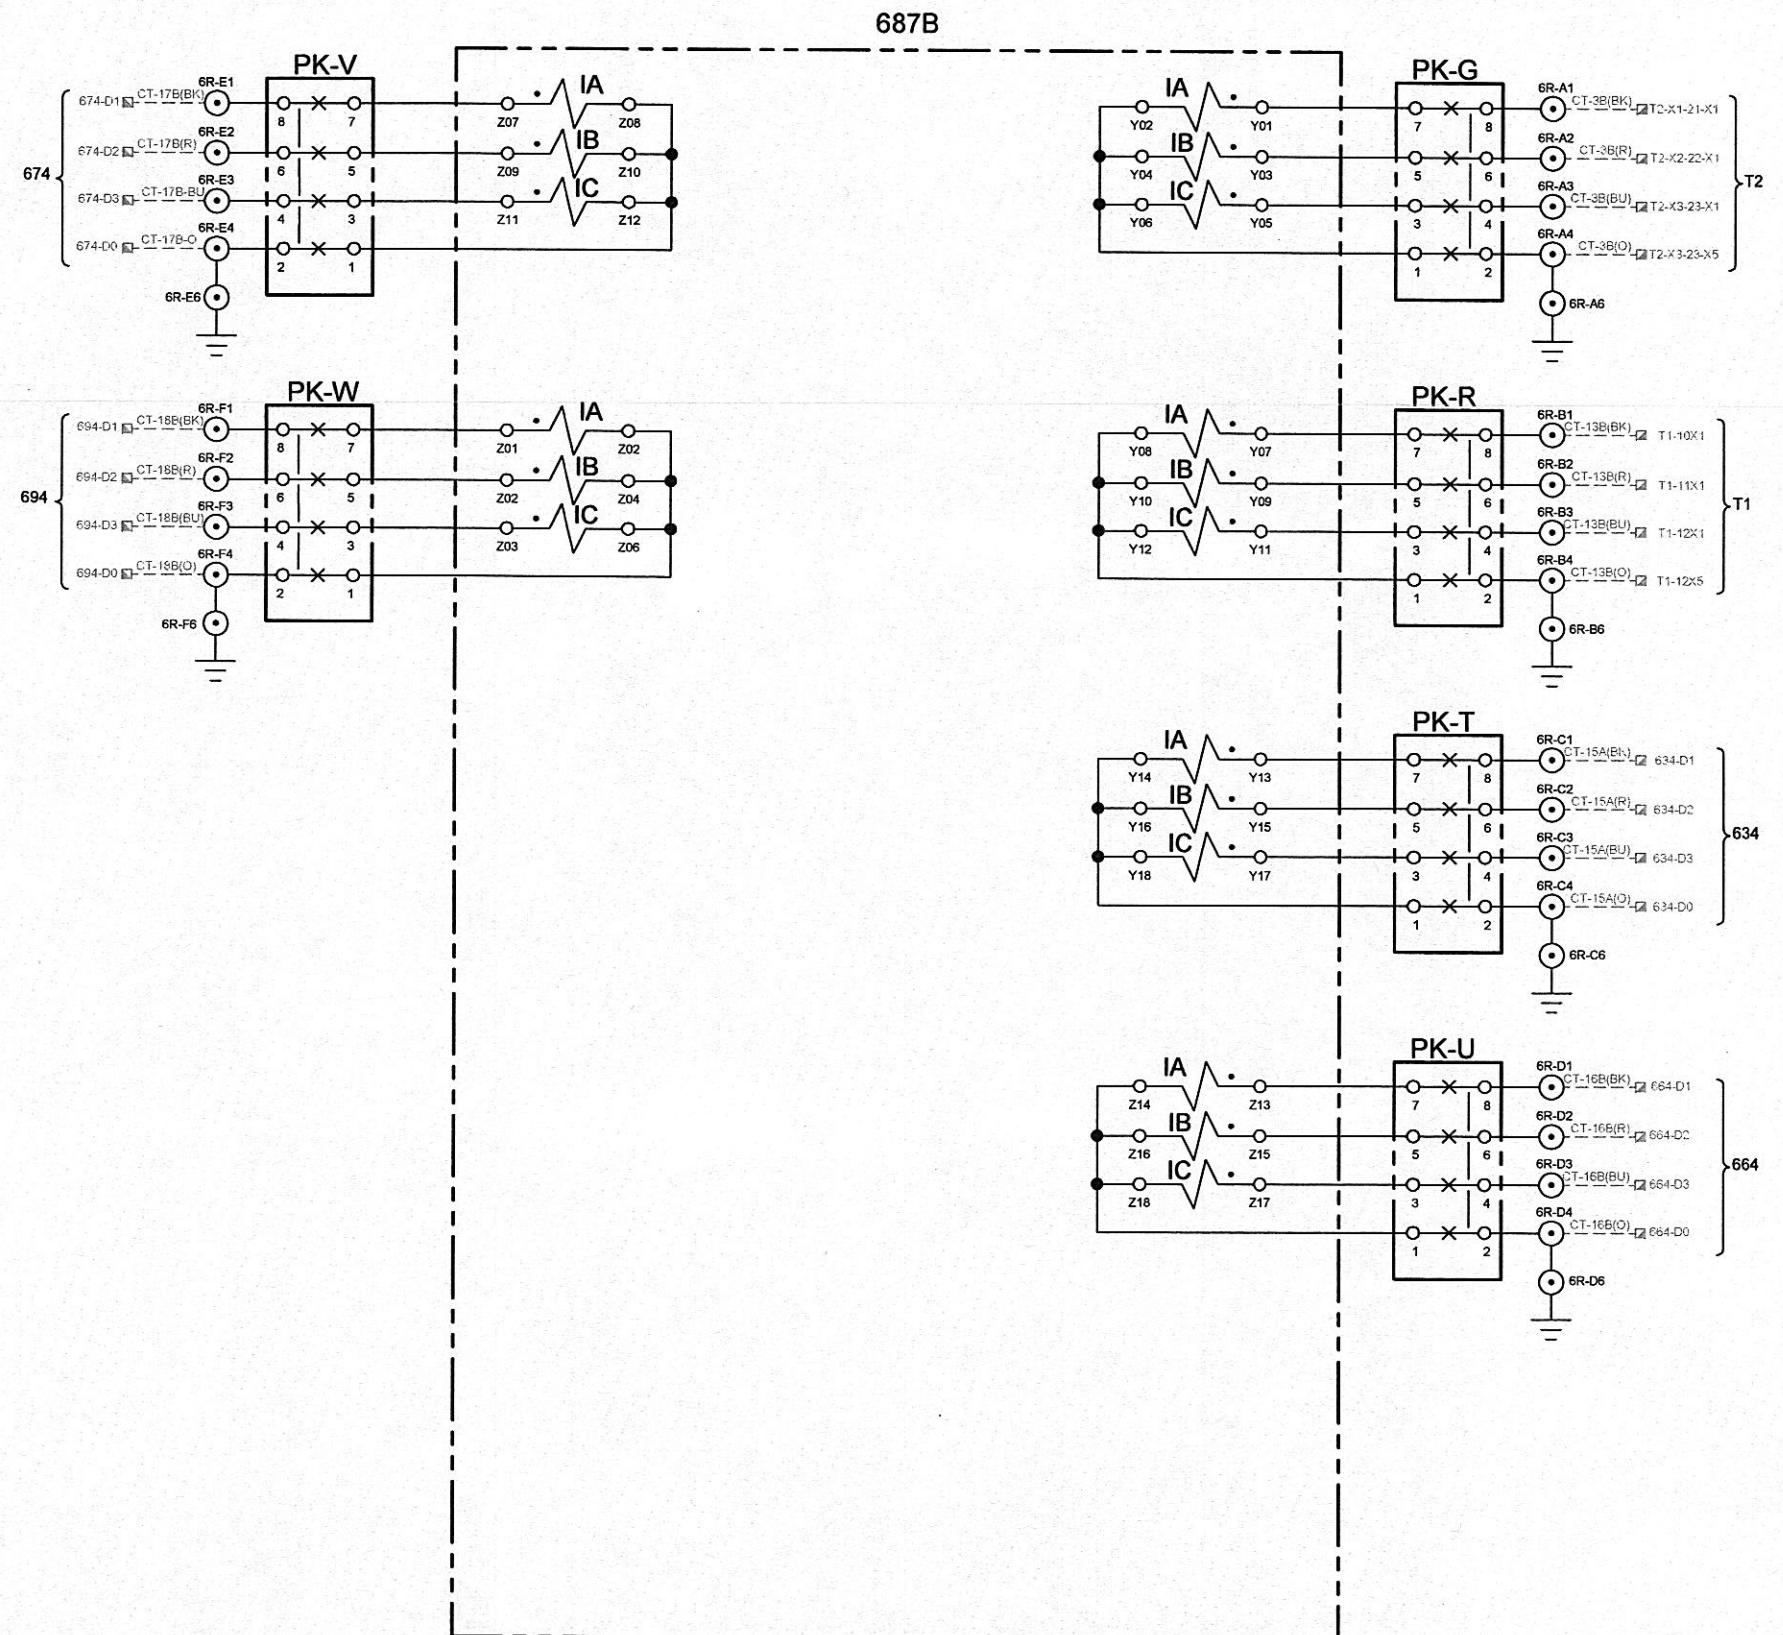

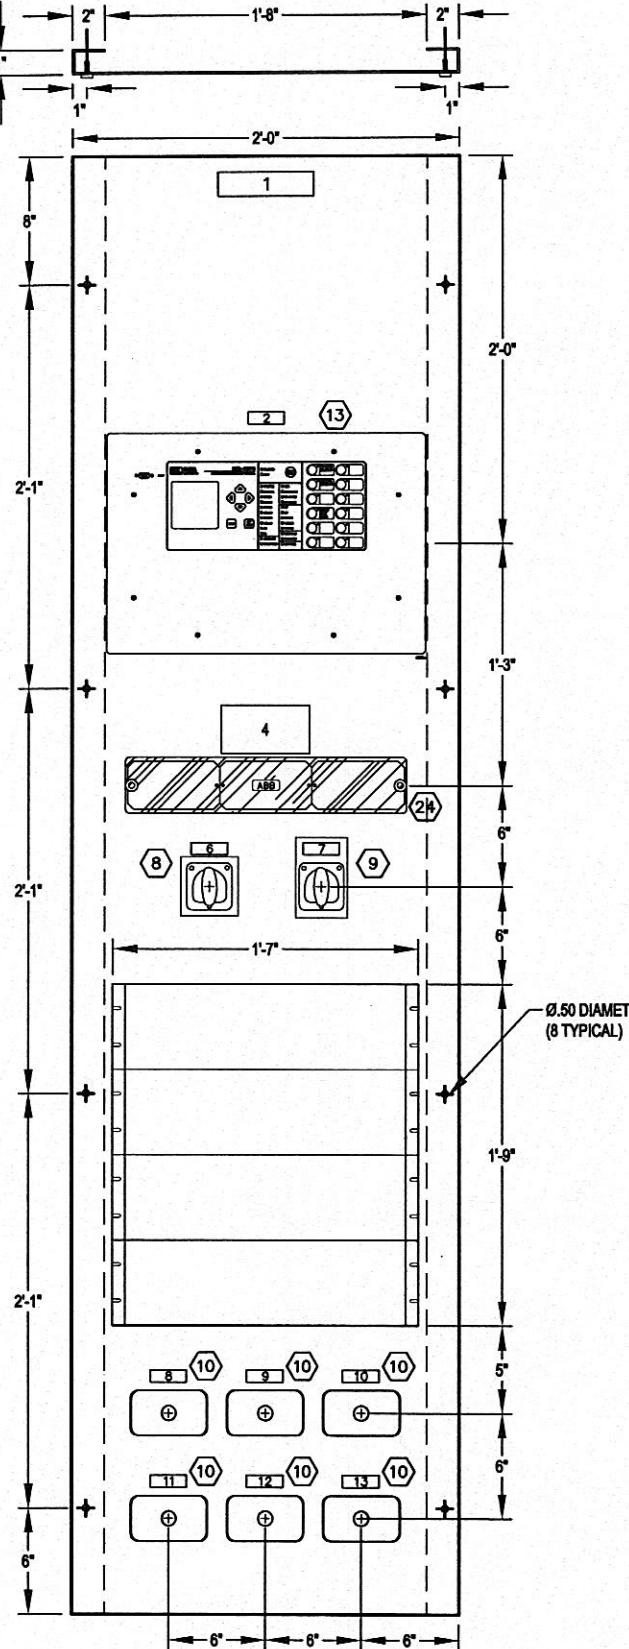

FRONT VIEW

NAMEPLATE NO.	LINE 1	LINE 2	LINE 3
1	PANEL 6R		
2	687	69-KV BUS	DIFF. RELAY
3		(NOT USED)	
4		SEE SHEET E-102 FOR DETAILS	
5		(NOT USED)	
6	687B-TCO	69-KV BUS DIFF	TRIP CUTOUT
7	86B	69-KV BUS	LOCKOUT RELAY
8	PK-R	BANK 1	687B CURRENTS
9	PK-G	BANK 2	687B CURRENTS
10	PK-T	BKR 634	687B CURRENTS
11	PK-U	BKR 664	687B CURRENTS
12	PK-V	BKR 674	687B CURRENTS
13	PK-W	BKR 694	687B CURRENTS

REFER TO DWG 01317-705 FOR ITEMS MOUNTED ON BACK OF PANEL

- NOTES:
1. PANEL MANUFACTURER TO DETERMINE STIFFENER LOCATIONS.
 2. PANEL MANUFACTURER TO PROVIDE RACK UNIT WITH UNISTRUT AND REMOVABLE PLATES FOR FUTURE INSTALLATIONS.

REV	DATE	CHKD	APPD	REVISION DESCRIPTION
2	09-15-10			CONFORMED TO CONSTRUCTION RECORDS.
1	11-09-09	KA	RNJ	ISSUED FOR CONSTRUCTION.
0	08-24-09	KA	RNJ	ISSUED FOR BIDS.

**CONFORMED TO
CONSTRUCTION
RECORDS**

DESIGNED
RNJ







DRAWN
RNJ



R.W. Beck
131 Saundersville Rd., Suite 300
Hendersonville, TN 37075
(615) 431-3200
An SAIC Company

HARRIMAN UTILITY BOARD
HARRIMAN PRIMARY SUBSTATION
REPLACEMENT PANEL 6R
FRONT VIEW

PROJECT NUMBER:
07-70014-01317-1000
SHEET OF:
1 1
DRAWING NUMBER:
01317-703.2

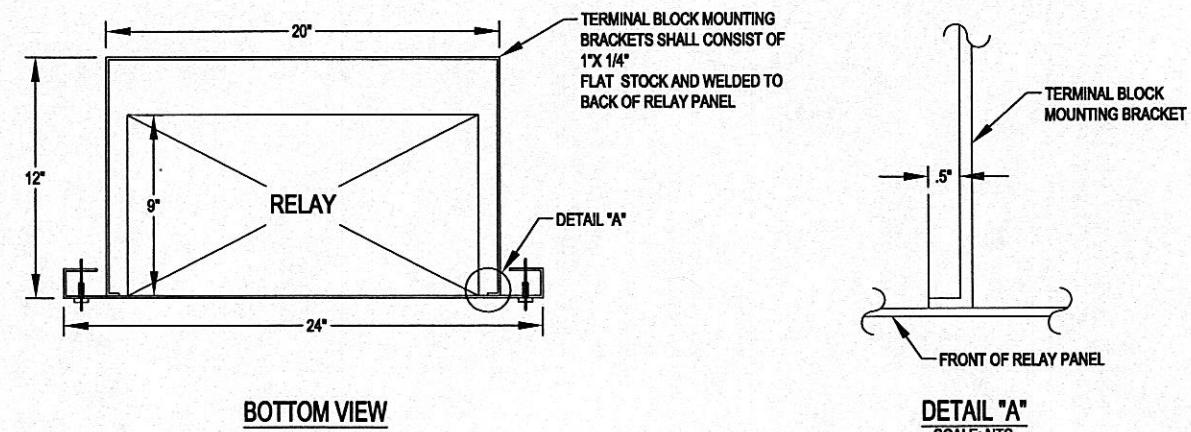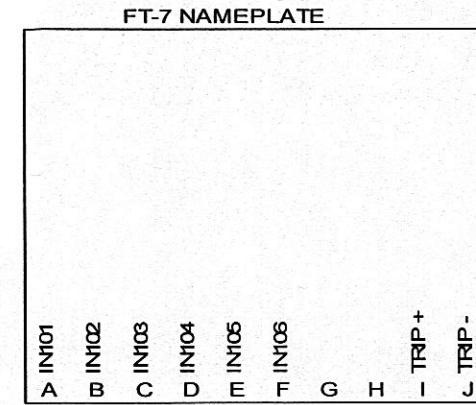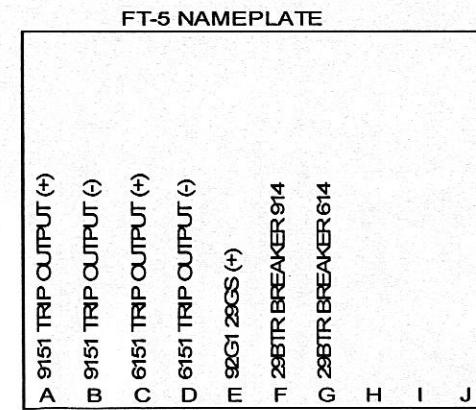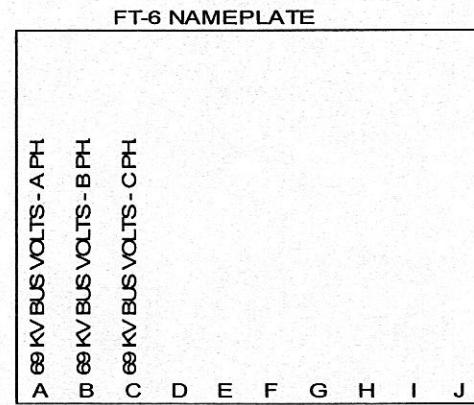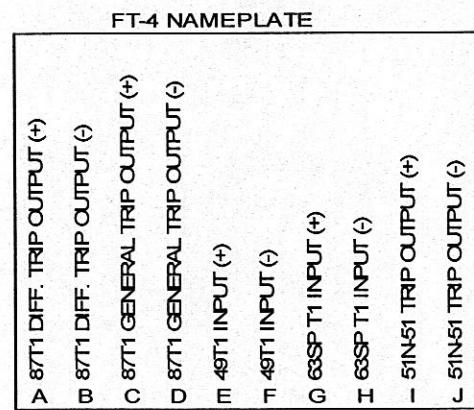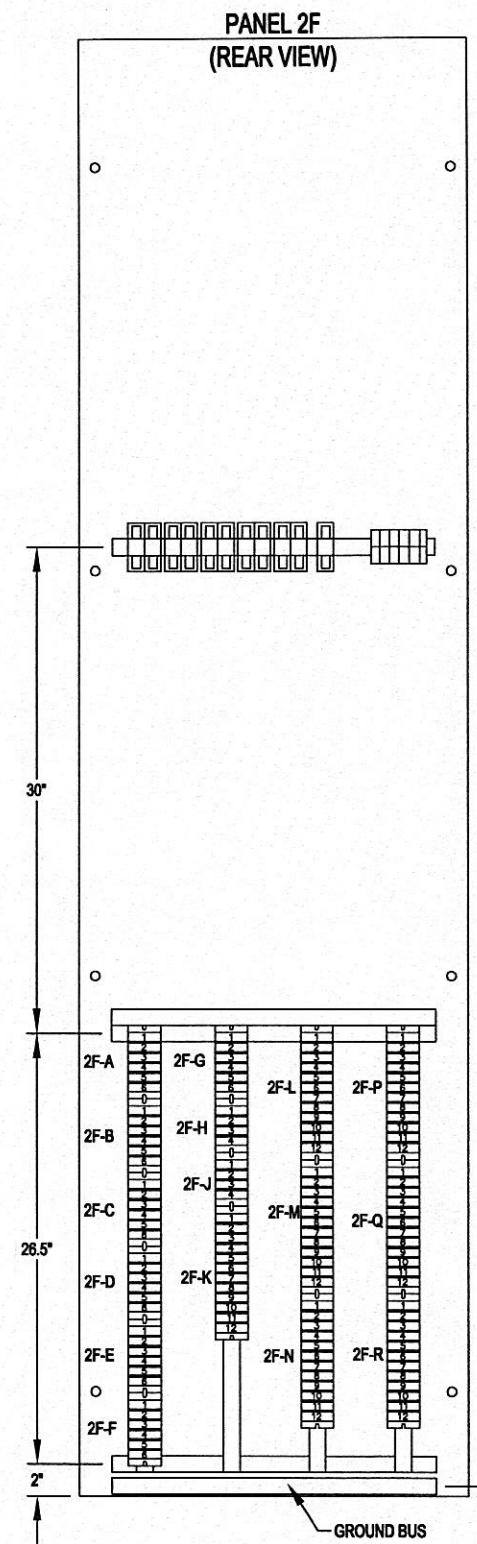

NOTE:
REFER TO SPECIFICATIONS
FOR QUANTITIES AND TYPES
OF TERMINAL BLOCKS AND
FUSE BLOCKS.

REV	DATE	CHKD	APPD	REVISION DESCRIPTION
2	09-15-10			CONFORMED TO CONSTRUCTION RECORDS.
1	11-09-09	KA	RNJ	ISSUED FOR CONSTRUCTION.
0	08-24-09	KA	RNJ	ISSUED FOR BIDS.

DESIGNED
RNJ

DRAWN
RNJ

**CONFORMED TO
CONSTRUCTION
RECORDS**






R.W. Beck
131 Saundersville Rd., Suite 300
Hendersonville, TN 37075
(615) 431-3200

HARRIMAN UTILITY BOARD
HARRIMAN PRIMARY SUBSTATION
PANEL 2F REAR VIEW
CONSTRUCTION DETAILS

PROJECT NUMBER:
07-70014-01317-1000

SHEET OF:
1 1

DRAWING NUMBER:
01317-704.2

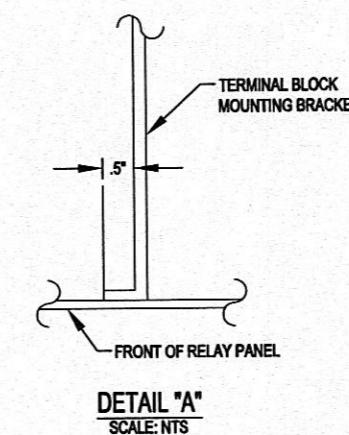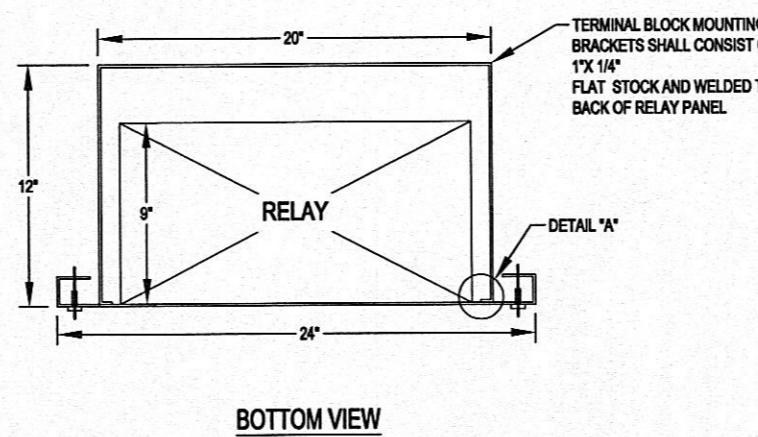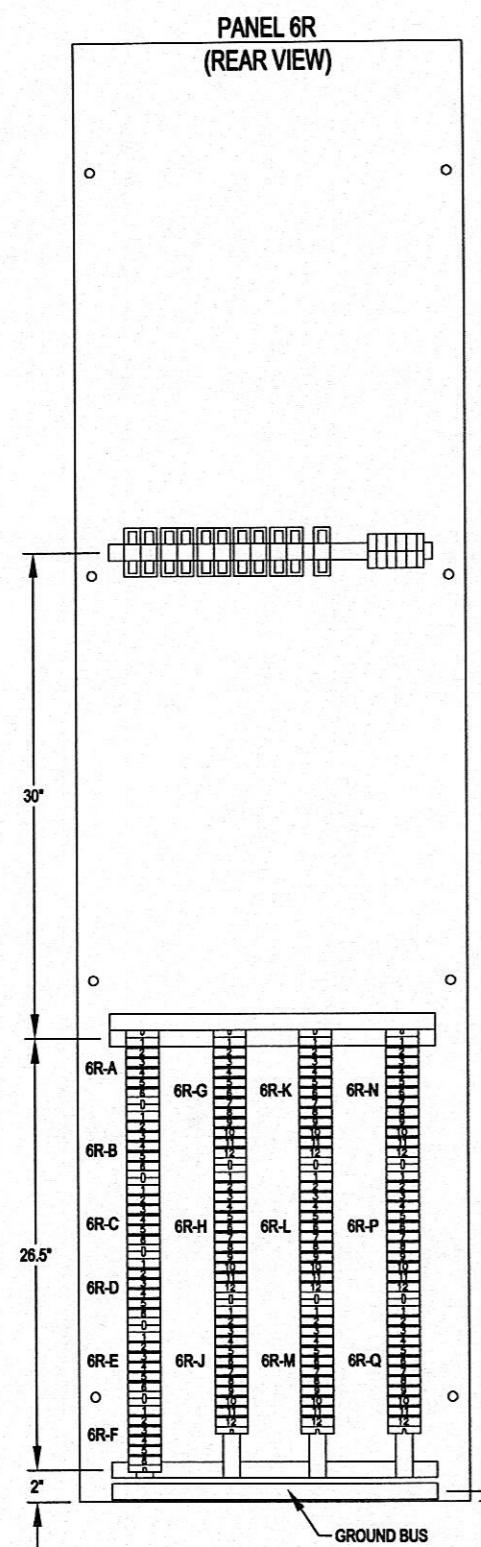

NOTE:
REFER TO SPECIFICATIONS
FOR QUANTITIES AND TYPES
OF TERMINAL BLOCKS AND
FUSE BLOCKS.

				DESIGNED RNJ
				DRAWN RNJ
2	09-15-10		CONFORMED TO CONSTRUCTION RECORDS.	
1	11-09-09	KA	ISSUED FOR CONSTRUCTION.	
0	08-24-09	KA	ISSUED FOR BIDS.	
REV	DATE	CHKD APPD	REVISION DESCRIPTION	

CONFORMED TO
CONSTRUCTION
RECORDS



R.W. Beck
131 Saundersville Rd., Suite 300
Hendersonville, TN 37075
(615) 431-3200

HARRIMAN UTILITY BOARD
HARRIMAN PRIMARY SUBSTATION
PANEL 6R REAR VIEW
CONSTRUCTION DETAILS

PROJECT NUMBER:
07-70014-01317-1000
SHEET OF:
1 1
DRAWING NUMBER:
01317-705.2

BOM#	Panel	Part#	Qty	Description	Mfg.
1	2F	24041441X	1	SATELLITE SYNCHRONIZED CLOCK, RACK MOUNT, 125 VDC POWER SUPPLY, WITH GPS BULET ANTENNA (235-0103) AND 75 FEET OF CABLE (C960-75)	SEL
2	2F	0551C0BX533X	1	OVERCURRENT RELAY, 125 VDC, 5 AMP, PANEL MOUNT, EIA-232 FRONT PORT AND REAR PORT	SEL
3	2F	587R0418-61111	2	TYPE DPU 2000R, THREE-PHASE MICROPROCESSOR BASED DISTRIBUTION PROTECTION UNIT	ABB
4	2F	0387A010HX3X341	1	THREE WINDING CURRENT DIFFERENTIAL RELAY, PANEL MOUNT, 125 VDC, 5 AMP	SEL
5	2F, 6R	116B6708G43R53C4	2	RED INDICATING LED, 125 VDC	GE
6	2F	116B6708G43G53C4	2	GREEN INDICATING LED, 125 VDC	GE
7	2F	8857DB	2	CONTROL SWITCH, ELECTRICALLY OPERATED, 125 VDC CONTROL, PISTOL GRIP HANDLE, ESCUTCHEON ENGRAVE "TRIP" ON 11 O'CLOCK POSITION AND "CLOSE" ON 1 O'CLOCK POSITION	ESW
8	2F	24205B	6	OVAL HANDLE, ESCUTCHEON ENGRAVE, "ON" ON 12 O'CLOCK POSITION, AND 'OFF" ON 1 O'CLOCK POSITION	ESW
9	2F, 6R	7805D	2	LOCKOUT RELAY, OVAL HANDLE, 125 VDC, 5 DECK, TYPE D COIL	ESW
10	2F, 6R	6422120G1	13	4 POLE PK TEST BLOCK	GE
11	2F	FR2G001001001	1	FT-19R FLEXITEST SWITCH ASSEMBLY, TWO RACK UNITS, GRAY, FULL LENGTH CLEAR COVER, CONSISTING OF THREE, R129A501G01 POTENTIAL TEST SWITCHES	ABB
12	2F	NTE5890	2	TRIPPING RECTIFIER	
13	6R	0487B065X2EXXXXC	1	BUS DIFFERENTIAL RELAY, 125-VDC, 5-A, PANEL MOUNT	SEL
15	**	915900043	1	GPS BULLET ANTENNA MOUNTING KIT	SEL
20	**	C256	2	RG-58 CABLE WITH BNC MALE CONNECTOR AND 9-PIN MALE "D" SUB CONNECTOR, 5 FEET	SEL
21	**	C962	2	RG-58 CABLE WITH BNC MALE CONNECTOR ON ONE END, TINNED WIRES ON OTHER, 10 FEET	SEL
	**	C953	1	RG-58 CABLE WITH BNC MALE CONNECTORS ON BOTH ENDS, 60 FEET	SEL
24	6R	FR3H000246000	1	FT-19R FLEXITEST SWITCH ASSEMBLY, TWO RACK UNITS, GRAY, FULL LENGTH CLEAR COVER, CONSISTING OF TWO BLANK COVERS AND ONE, R1586C42G30 TEST SWITCH	ABB
26	**	SEL-C662	1	RELAY PROGRAMMING CABLE, USB PORT TO 9-PIN MALE CONNECTOR	SEL
27	2F*, 6R*	EB25B12	11	TERMINAL BLOCK, 12 POINT	GE
28	2F*, 6R*	EB25B04	4	TERMINAL BLOCK, 4 POINT	GE
29	2F*, 6R*	EB27B06S	13	TERMINAL BLOCK 6 POINT SHORTING TYPE	GE
30	2F*, 6R*		6	FUSE BLOCK, 2 POLE	
31	2F*		1	FUSE BLOCK, 1 POLE	

* INDICATES MOUNTING ON BACK OF PANEL

** INDICATES MATERIAL TO BE SHIPPED LOOSE


				DESIGNED RNJ	CONFORMED TO CONSTRUCTION RECORDS		 R.W. Beck, Inc. 131 Mir Parkway, Suite 300 Hendersonville, TN 37075 (615) 431-3200 An SAIC Company	HARRIMAN, TN UTILITY BOARD HARRIMAN PRIMARY SUBSTATION MODIFICATIONS RELAY PANEL BILL OF MATERIALS			PROJECT NUMBER: 07-70014-01317-1000			
2	09-15-10	CONFORMED TO CONSTRUCTION RECORDS.		DRAWN RNJ										SHEET OF: 1 1
1	11-09-09	KA	RNJ	ISSUED FOR CONSTRUCTION.										DRAWING NUMBER: 01317-706.2
0	08-24-09	KA	RNJ	ISSUED FOR BIDS.										
REV	DATE	CHKD	APPD	REVISION DESCRIPTION										

NOTES:

1. THIS DRAWING DEVELOPED FROM TVA
DRAWING LC-46656, R-0.

COMPLETE THE FOLLOWING IMPROVEMENTS TO THE
CONTROL BUILDING.


1. REMOVE AND REPLACE ROOF WITH EQUIVALENT STRUCTURAL ROOFING.
2. REPLACE DOWNSPOUTS WITH NEW ALUMINUM 6" DOWNSPOUTS.
3. INSTALL PERMANENT WOOD FRAME AND HINGED DOOR TO CRAWL SPACE ACCESS DOORS.
4. REPLACE EIGHT EXISTING WINDOWS WITH DOUBLE HUNG, TILT IN, TRIPLE PANE REPLACEMENT WINDOWS.
5. CLEAN, PREP, PRIME, AND PAINT BUILDING EXTERIOR INCLUDING STAIR HAND RAILS, DOWNSPOUTS, GUTTERS, AND WALLS. COLOR TO BE SELECTED BY HUB.
6. CLEAN, PREP, PRIME, AND PAINT COMPLETE BUILDING CEILING WHITE.
7. CLEAN, PREP, PRIME, AND PAINT COMPLETE BUILDING INTERIOR WALLS. COLOR TO BE SELECTED BY HUB.
8. REPLACE ALL FLUORESCENT AND INCANDESCENT CEILING FIXTURES WITH NEW 4 LAMP, 40 WATT, T12 BALLAST, 120 VOLT, SURFACE MOUNT FIXTURES. 15 REQUIRED.
9. REPLACE EXTERIOR LIGHTS AT DOORS WITH 120 VOLTS, OUTDOOR WALL PACK FIXTURE WITH 70W HPS BULB AND PHOTOCELL.
10. INSTALL 6" OF BLOWN INSULATION IN THE ATTIC.
11. REPLACE EXISTING BATTERIES, RACK, AND CHARGER WITH NEW EQUIPMENT AND WIRING. BATTERIES SHALL BE COMPRISED OF FIAMM LEAD ACID TYPE, 60 CELL, TYPE SD-11. RACK SHALL BE SGL 3-27. CHARGER SHALL BE C & D TYPE: ARE-M13025, 240 VOLTS, 25 AMP OUTPUT.
12. INSTALL BATTERY EXHAUST FAN. FAN SHALL BE 10", 115 VOLT, SHUTTER MOUNTED, DAYTON MODEL 1HLA1. INSTALL RAIN HOOD AND AN ADJUSTABLE TIMER TO RUN 1-15 MINUTES PER HOUR.
13. INSTALL TWO THRU WALL HEAT PUMPS. HEAT PUMPS SHALL BE GE ZONELINE AZ58H15DAC.
14. REPLACE CABLE ENTRY COVER PLATES BEHIND PANELS AT FLOOR.
15. REMOVE INCANDESCENT FIXTURES ALONG RELAY AISLE AND REPLACE WITH 2 LAMP, 40 WATT, T12 BALLAST, 120 VOLT FLUORESCENT FIXTURES, 4 REQUIRED.
16. REPLACE DC BOX WITH DC PANEL. PANEL SHALL BE SQUARE D, I-LINE WITH 225 AMP MAIN BREAKER AND BRANCH BREAKERS AS SHOWN ON DC PANEL SCHEDULE. CORE DRILL CONCRETE FLOOR AND INSTALL 3-4" CONDUITS FROM PANEL TO CABLE TRAY BELOW FLOOR.
17. REMOVE PANELS 6R AND 2F. PANELS ARE ASBESTOS. DISPOSE OF PANELS APPROPRIATELY. INSTALL OWNER FURNISHED PANELS 6R AND 2F.
18. REPLACE EXISTING EMERGENCY LIGHT WITH NEW 120VAC LED EMERGENCY LIGHT. LIGHT SHALL BE GILBERT LED GEMINI STAR (WWW.GILBERTINC.COM). INSTALL POWER FOR LIGHT IN EMT CONDUIT.

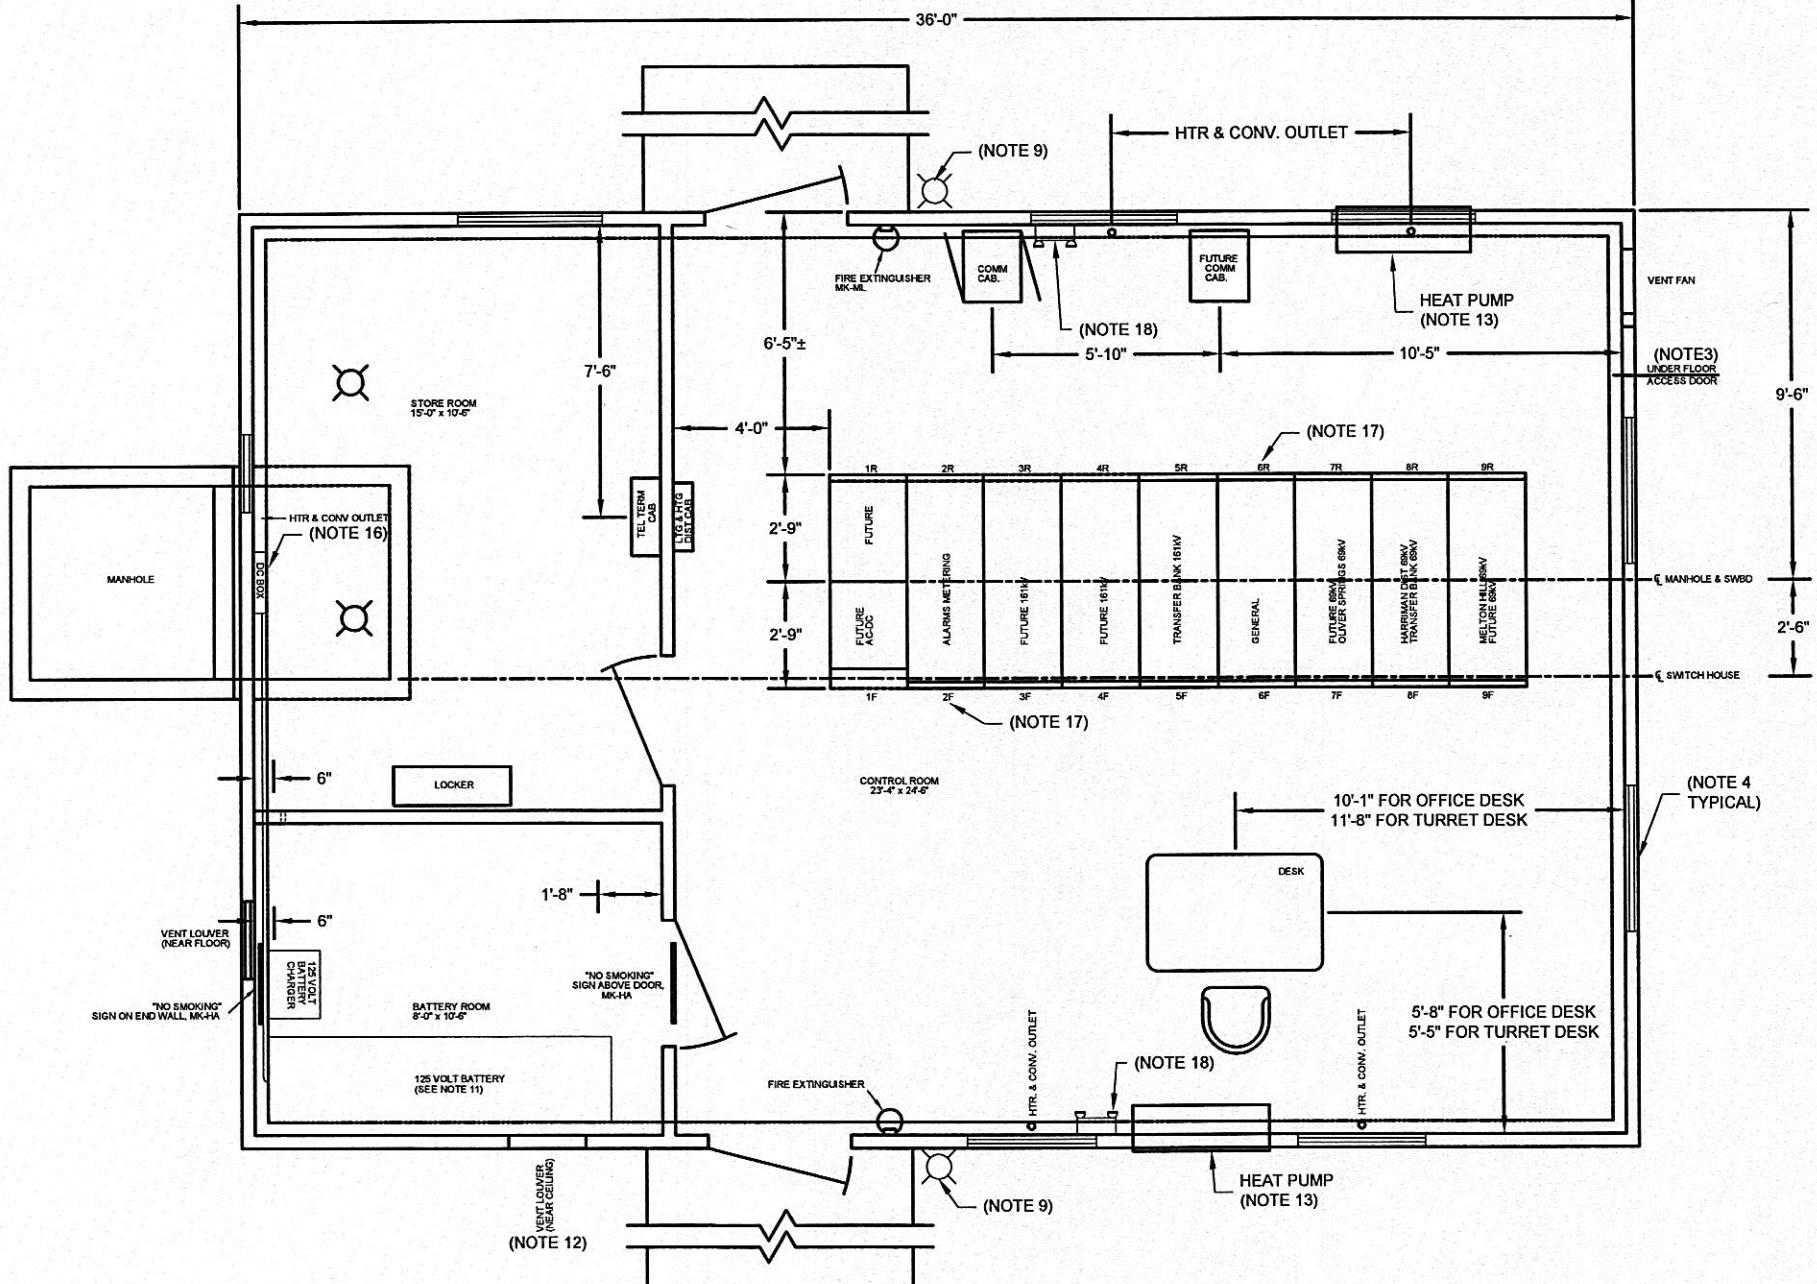


REFERENCES:
BILL OF MATERIAL: BMC-46653
CONDUIT AND CABLE LIST CMC-46656
SW. HOUSE CONDUIT AND LIGHTING LC-46652

			DESIGNED	DRAWN	CONFORMED TO CONSTRUCTION RECORDS	SCALE IN FEET	R.W. Beck, Inc.	HARRIMAN, TN UTILITY BOARD	PROJECT NUMBER:
3	09-15-10	CONFORMED TO CONSTRUCTION RECORDS.	KA	RW		2.5 0 2.5 5 7.5	131 Saundersville Rd., Suite 300 Hendersonville, TN 37075 (615) 431-3200 An SAIC Company	HARRIMAN PRIMARY SUBSTATION MODIFICATIONS	07-7004-01317-100
2	12-15-09	RNU	KA	ISSUED FOR CONSTRUCTION.					
1	10-16-09	RNU	KA	GENERAL REVISIONS: BATTERY SYSTEM, DC PANEL, EMERGENCY LIGHTS.					
0	10-02-09	RNU	KA	ISSUED FOR BIDS.					
REV	DATE	CHKD	APPD	REVISION DESCRIPTION					

SHEET OF:	1 1
DRAWING NUMBER:	01317-710.3

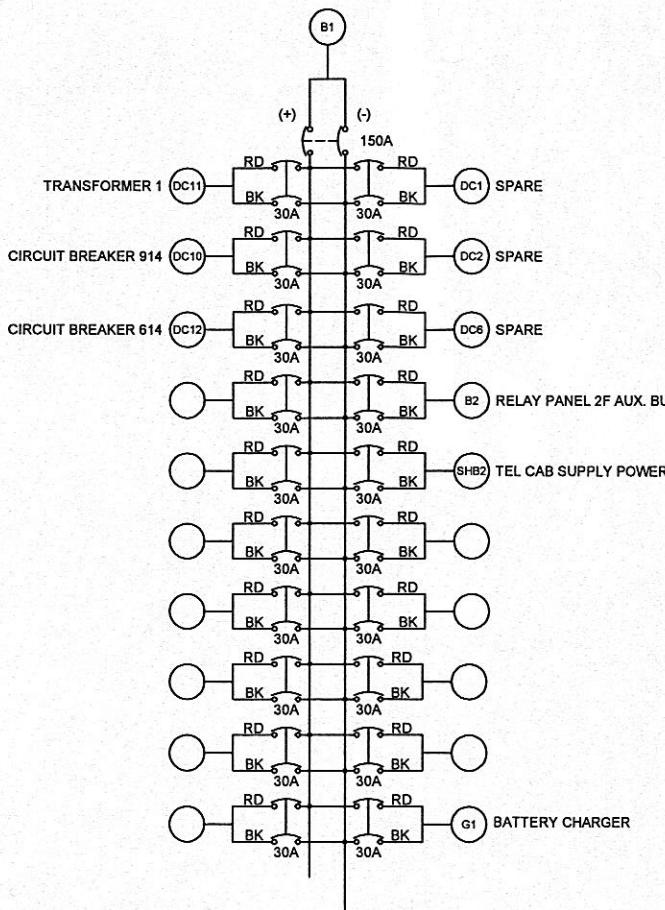D.C. DISTRIBUTION PANEL

REV	DATE	CHGD	APPD	REVISION DESCRIPTION	DESIGNED KA	DRAWN RW	CONFORMED TO CONSTRUCTION RECORDS	R.W. Beck An SAIC Company	HARRIMAN UTILITY BOARD HARRIMAN PRIMARY SUBSTATION DC DISTRIBUTION PANEL	PROJECT NUMBER: 07-70014-01317-1000
2	09-15-10			CONFORMED TO CONSTRUCTION RECORDS.						SHEET OF: 1 1
1	12-15-09	RNJ	KA	ISSUED FOR CONSTRUCTION.						DRAWING NUMBER: 01317-712.2
0	10-02-09	RNJ	KA	ISSUED FOR BIDS.						

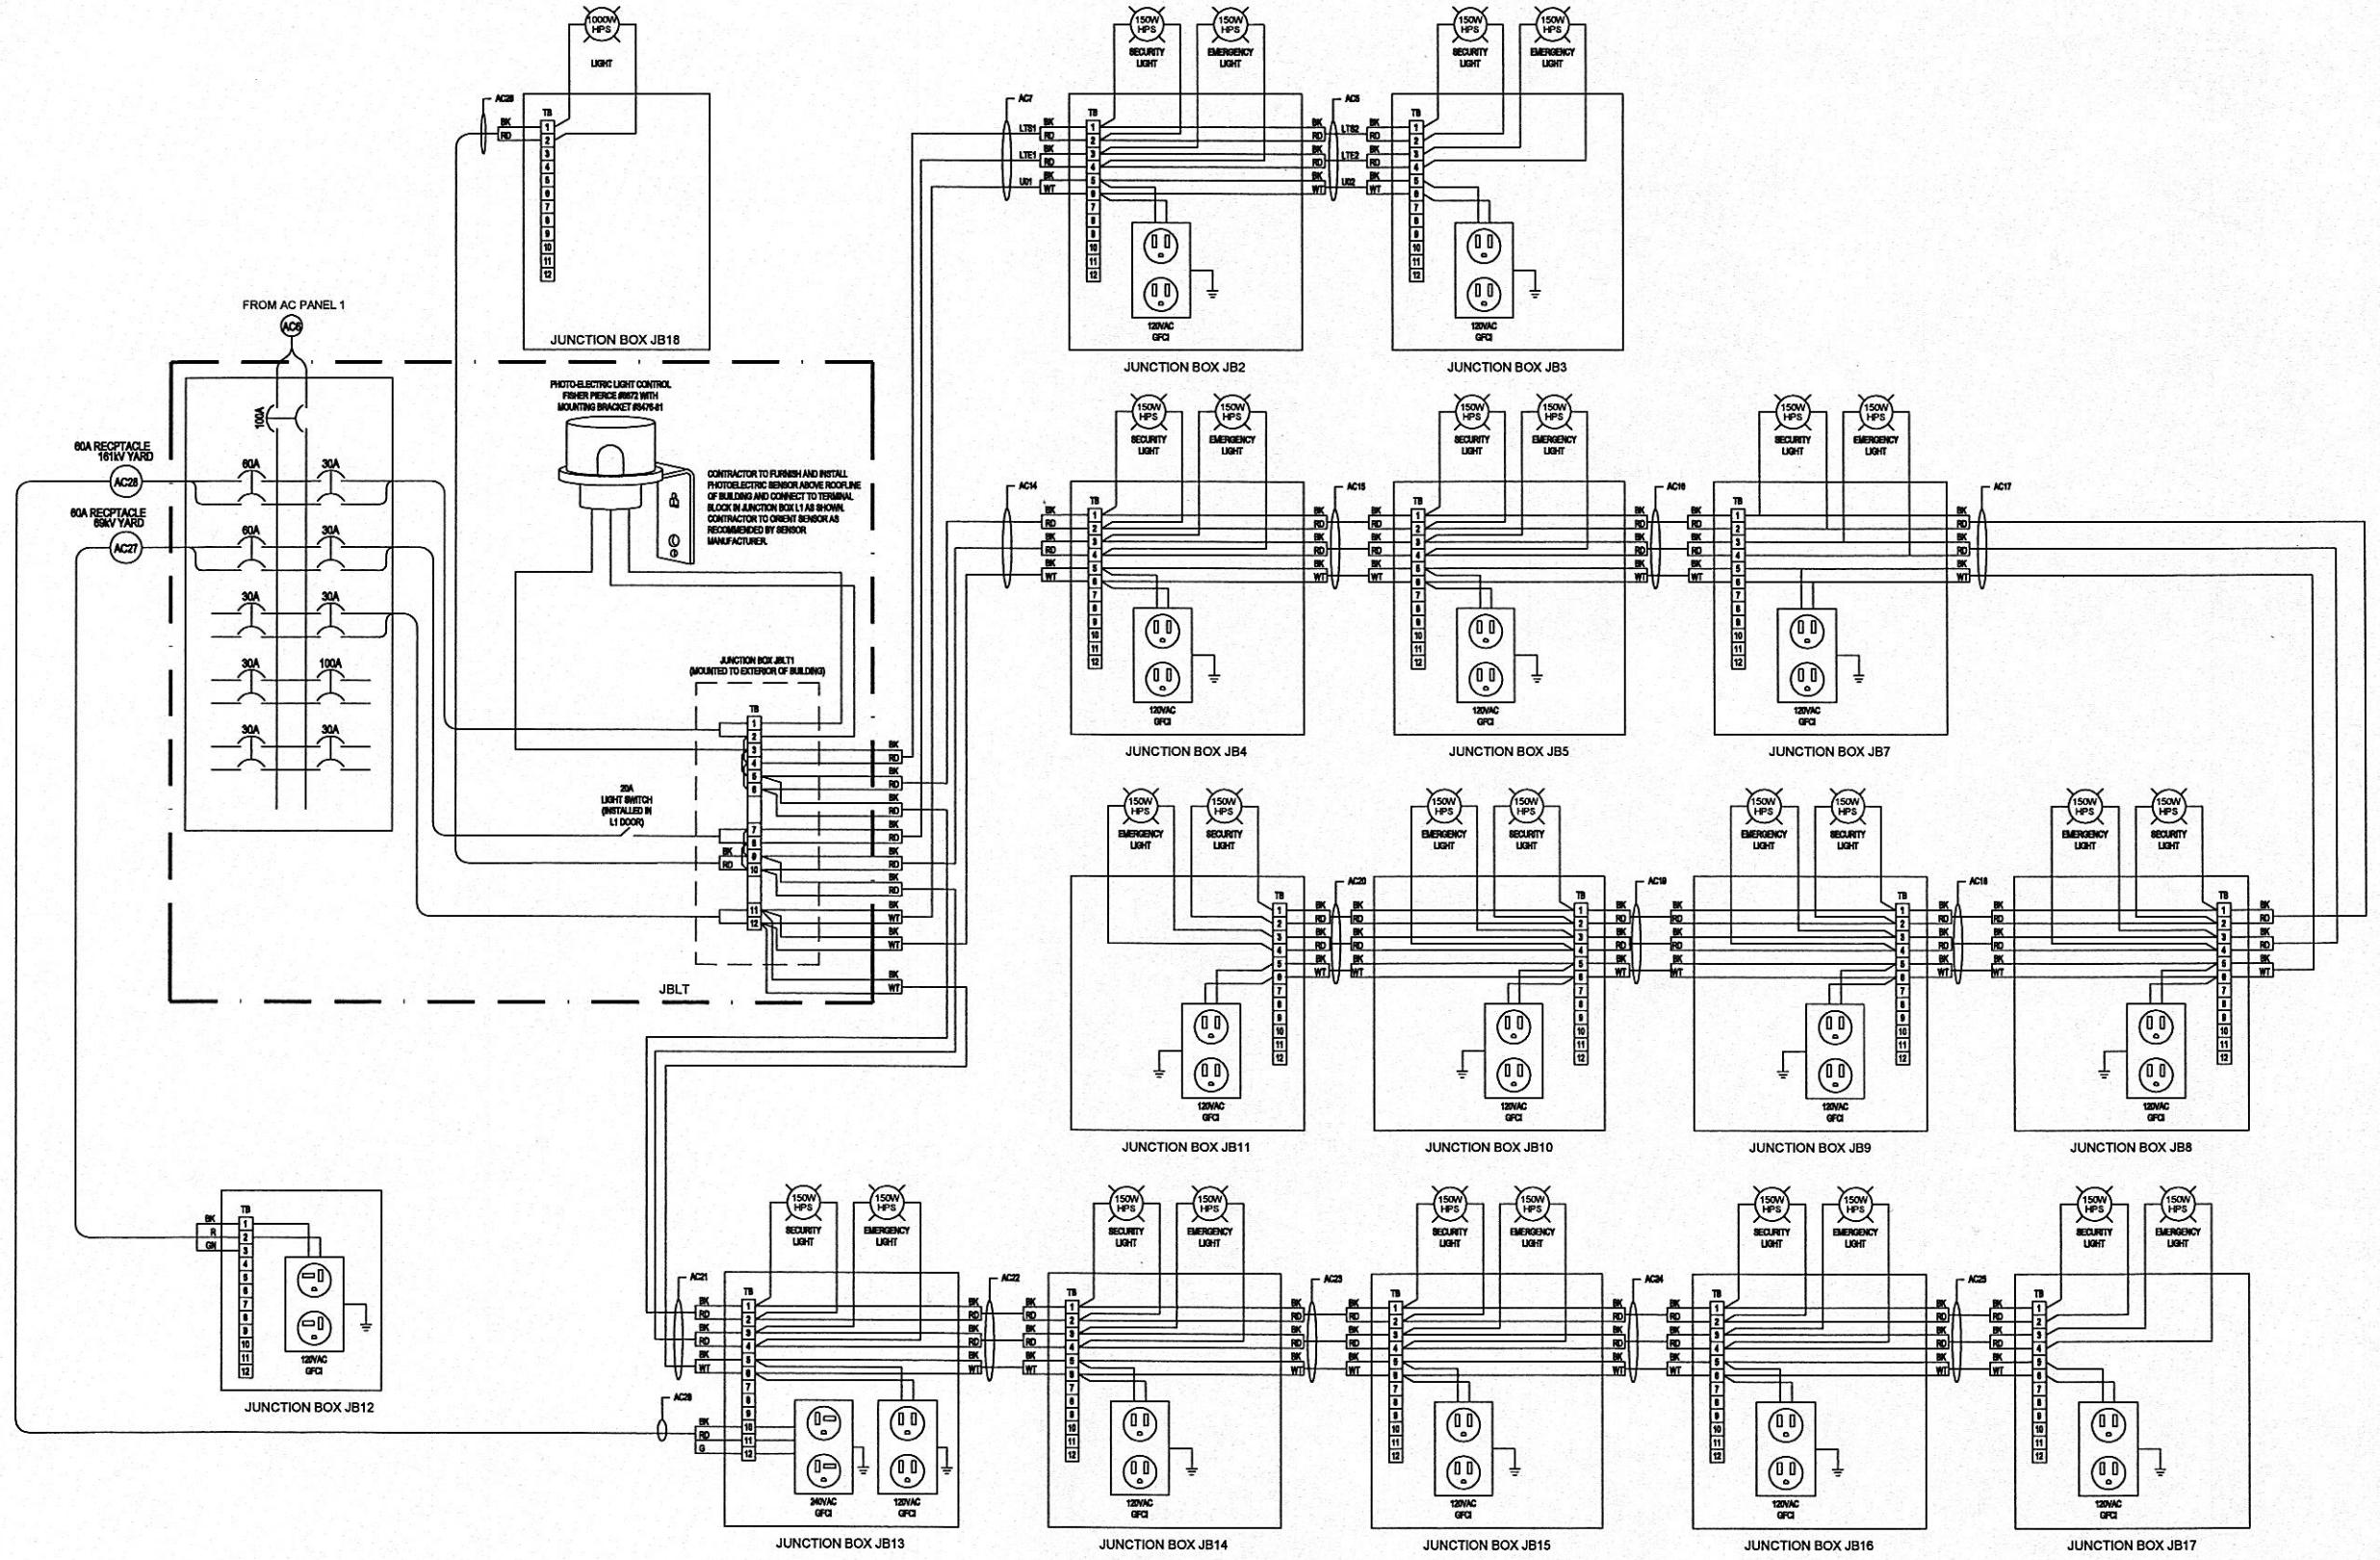

REV	DATE	CHK'D	APPD	REVISION DESCRIPTION
3	09-15-10			CONFORMED TO CONSTRUCTION RECORDS.
2	02-24-10	RJ	KA	CORRECTED DESIGNATION FOR CABLE AC6.
1	12-15-09	RJ	KA	ISSUED FOR CONSTRUCTION.
0	10-02-09	RJ	KA	ISSUED FOR BIDS.

COPYRIGHT 2008, R.W. BECK, INC., ALL RIGHTS RESERVED.

CONFORMED TO CONSTRUCTION RECORDS





An SAIC Company

R.W. Beck
131 Saundersville Rd., Suite 300
Hendersonville, TN 37075
(615) 431-3200

**HARRIMAN UTILITY BOARD
HARRIMAN PRIMARY SUBSTATION
YARD LIGHTING AND UTILITIES
SCHEMATIC**

PROJECT NUMBER:
7-70014-01317-1000
SHEET OF:
1 1
DRAWING NUMBER:
01317-711.3

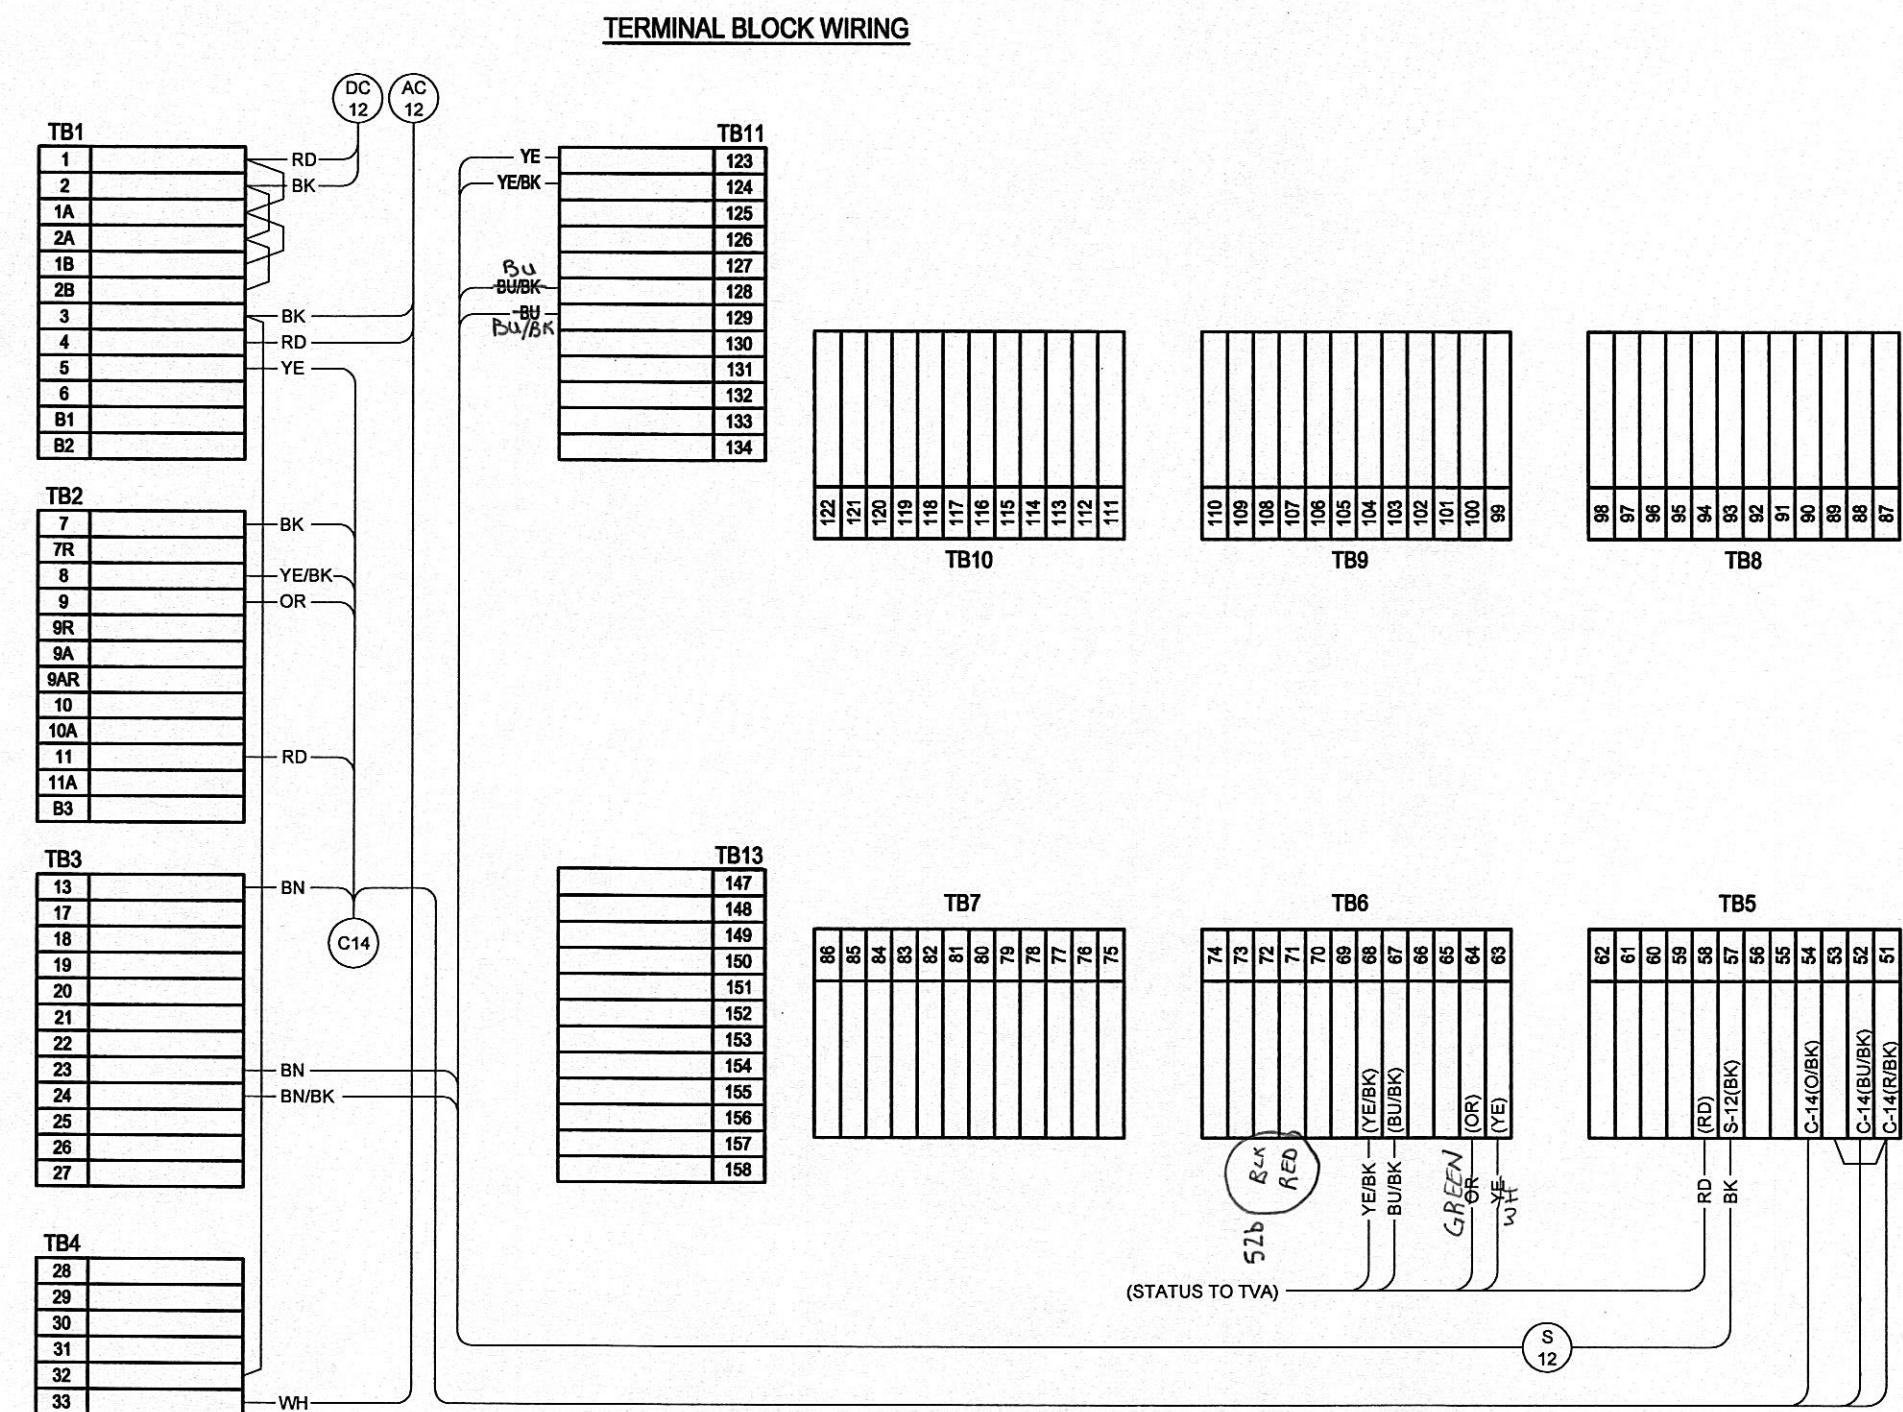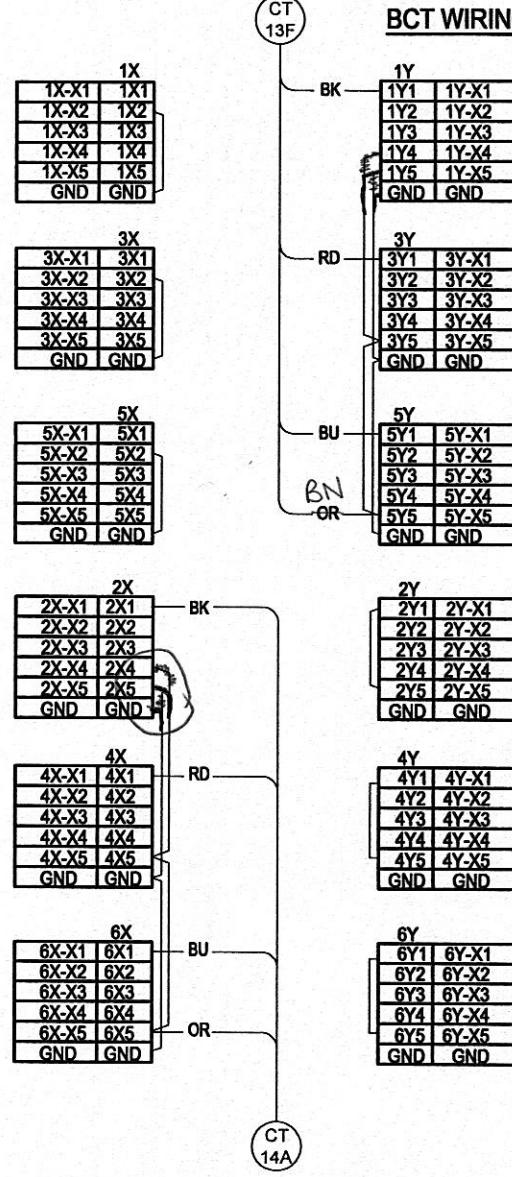

REV	DATE	CHKD	APPD	REVISION DESCRIPTION
3	09-15-10			CONFORMED TO CONSTRUCTION RECORDS.
2	03-04-10			ADDED STATUS CIRCUIT. ISSUED FOR CONSTRUCTION.
1				
0				

COPYRIGHT 2008, R.W. BECK, INC., ALL RIGHTS RESERVED


DESIGNED
DRAWN
CONFORMED TO
CONSTRUCTION
RECORDS



R.W. Beck
131 Saundersville Rd., Suite 300
Hendersonville, TN 37075
(615) 431-3200
An SAIC Company

HARRIMAN UTILITY BOARD
HARRIMAN PRIMARY SUBSTATION
BREAKER 614
CONNECTION DIAGRAM

PROJECT NUMBER:
07-70014-01317-1000
SHEET OF:
1 1
DRAWING NUMBER:
01317-800.3

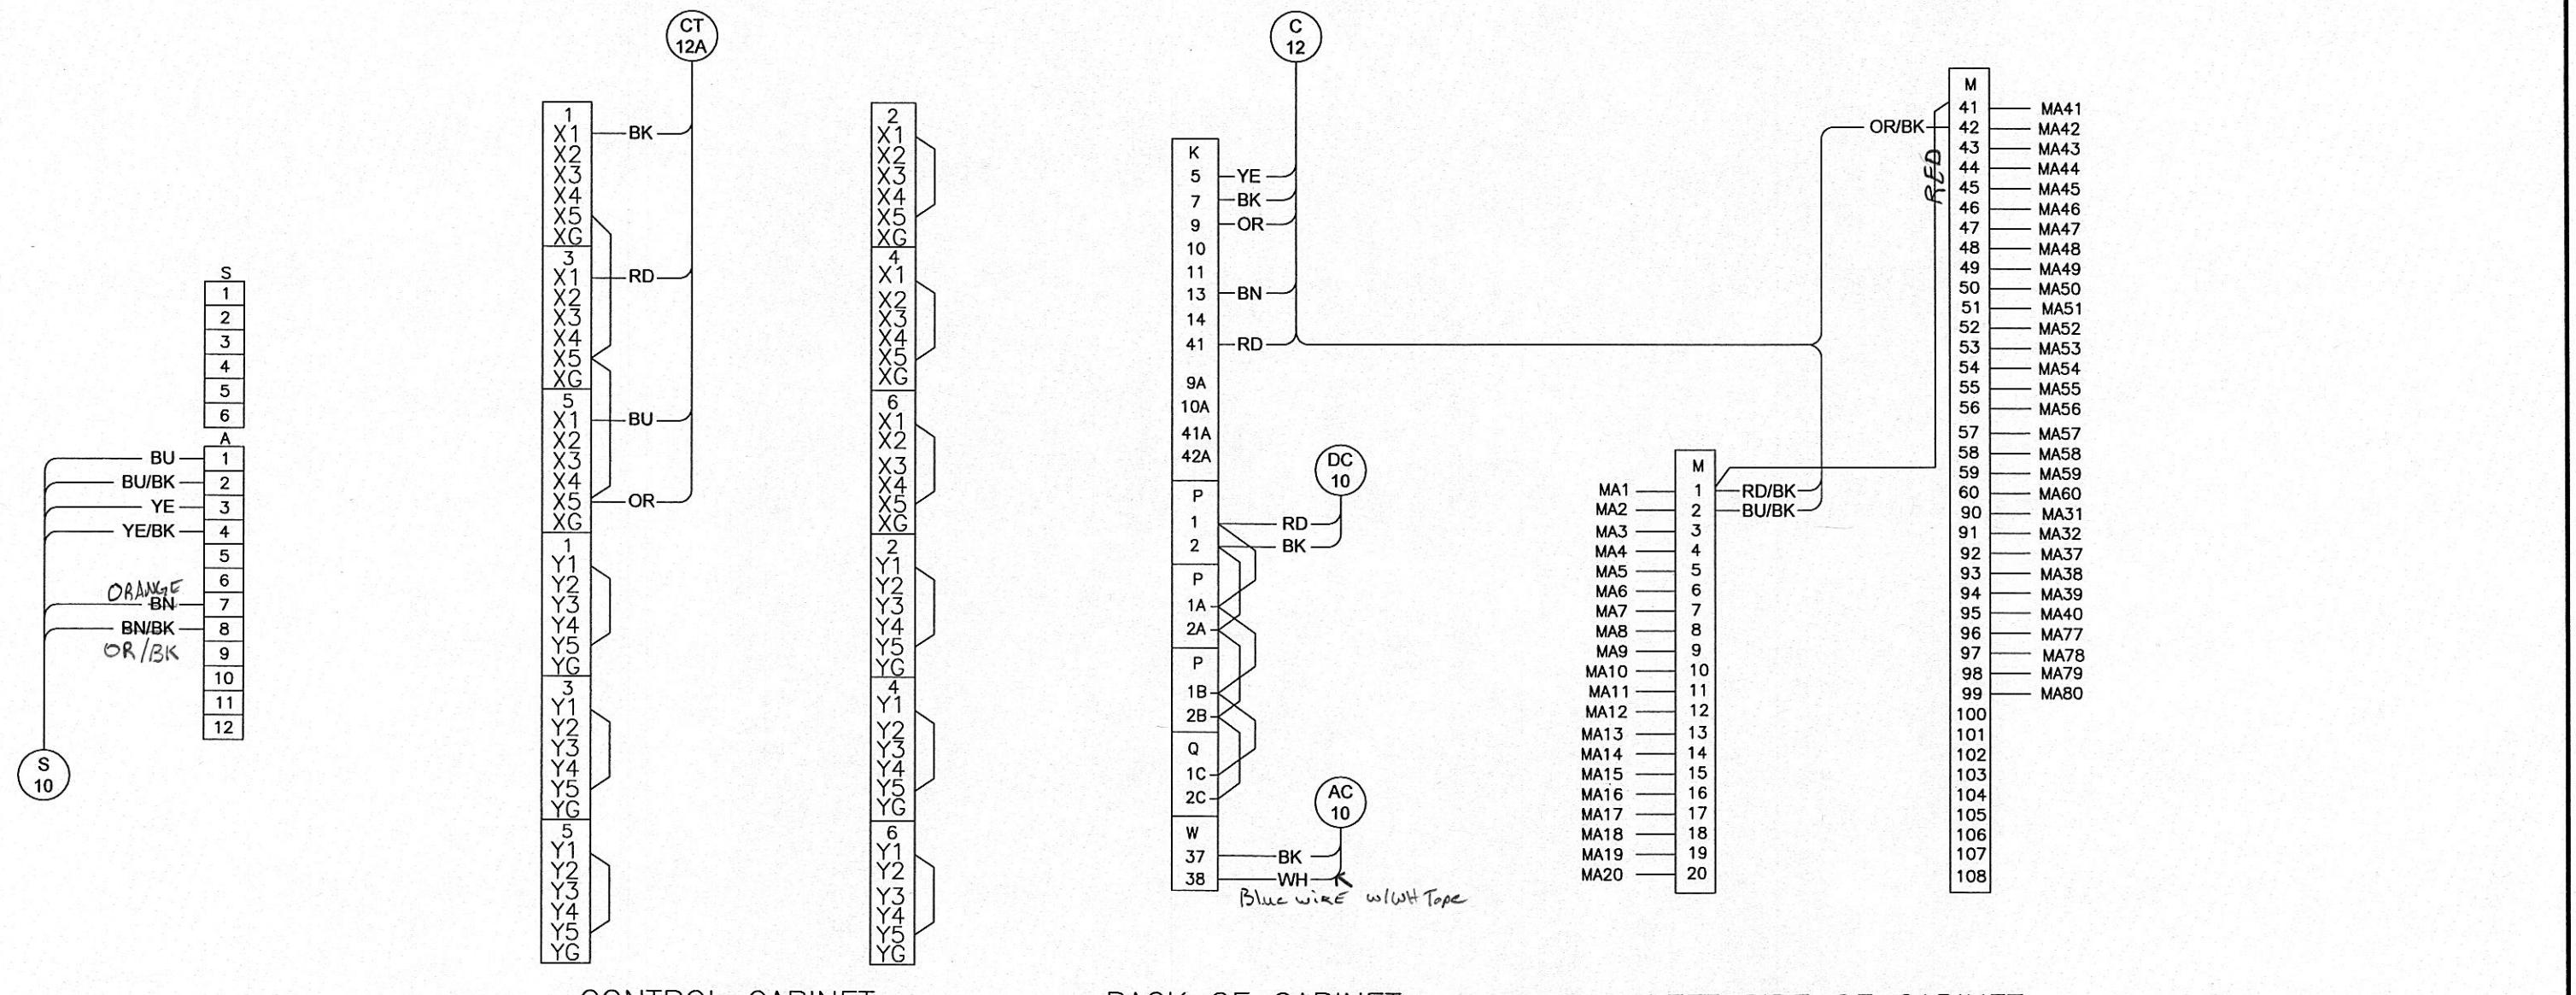

REV	DATE	CHRD	APPD	REVISION DESCRIPTION
3	09-15-10			CONFORMED TO CONSTRUCTION RECORDS.
2	03-04-10			ADDED STATUS CIRCUIT. ISSUED FOR CONSTRUCTION.
1				
0				


DESIGNED
RNJ
DRAWN
RNJ
**CONFORMED TO
CONSTRUCTION
RECORDS**



R.W. Beck
131 Saundersville Rd., Suite 300
Hendersonville, TN 37075
(615) 431-3200
An SAIC Company

HARRIMAN UTILITY BOARD
HARRIMAN PRIMARY SUBSTATION
BREAKER 914
CONNECTION DIAGRAM

PROJECT NUMBER:
07-70014-01317-1000
SHEET OF:
1 1
DRAWING NUMBER:
01317-801.3

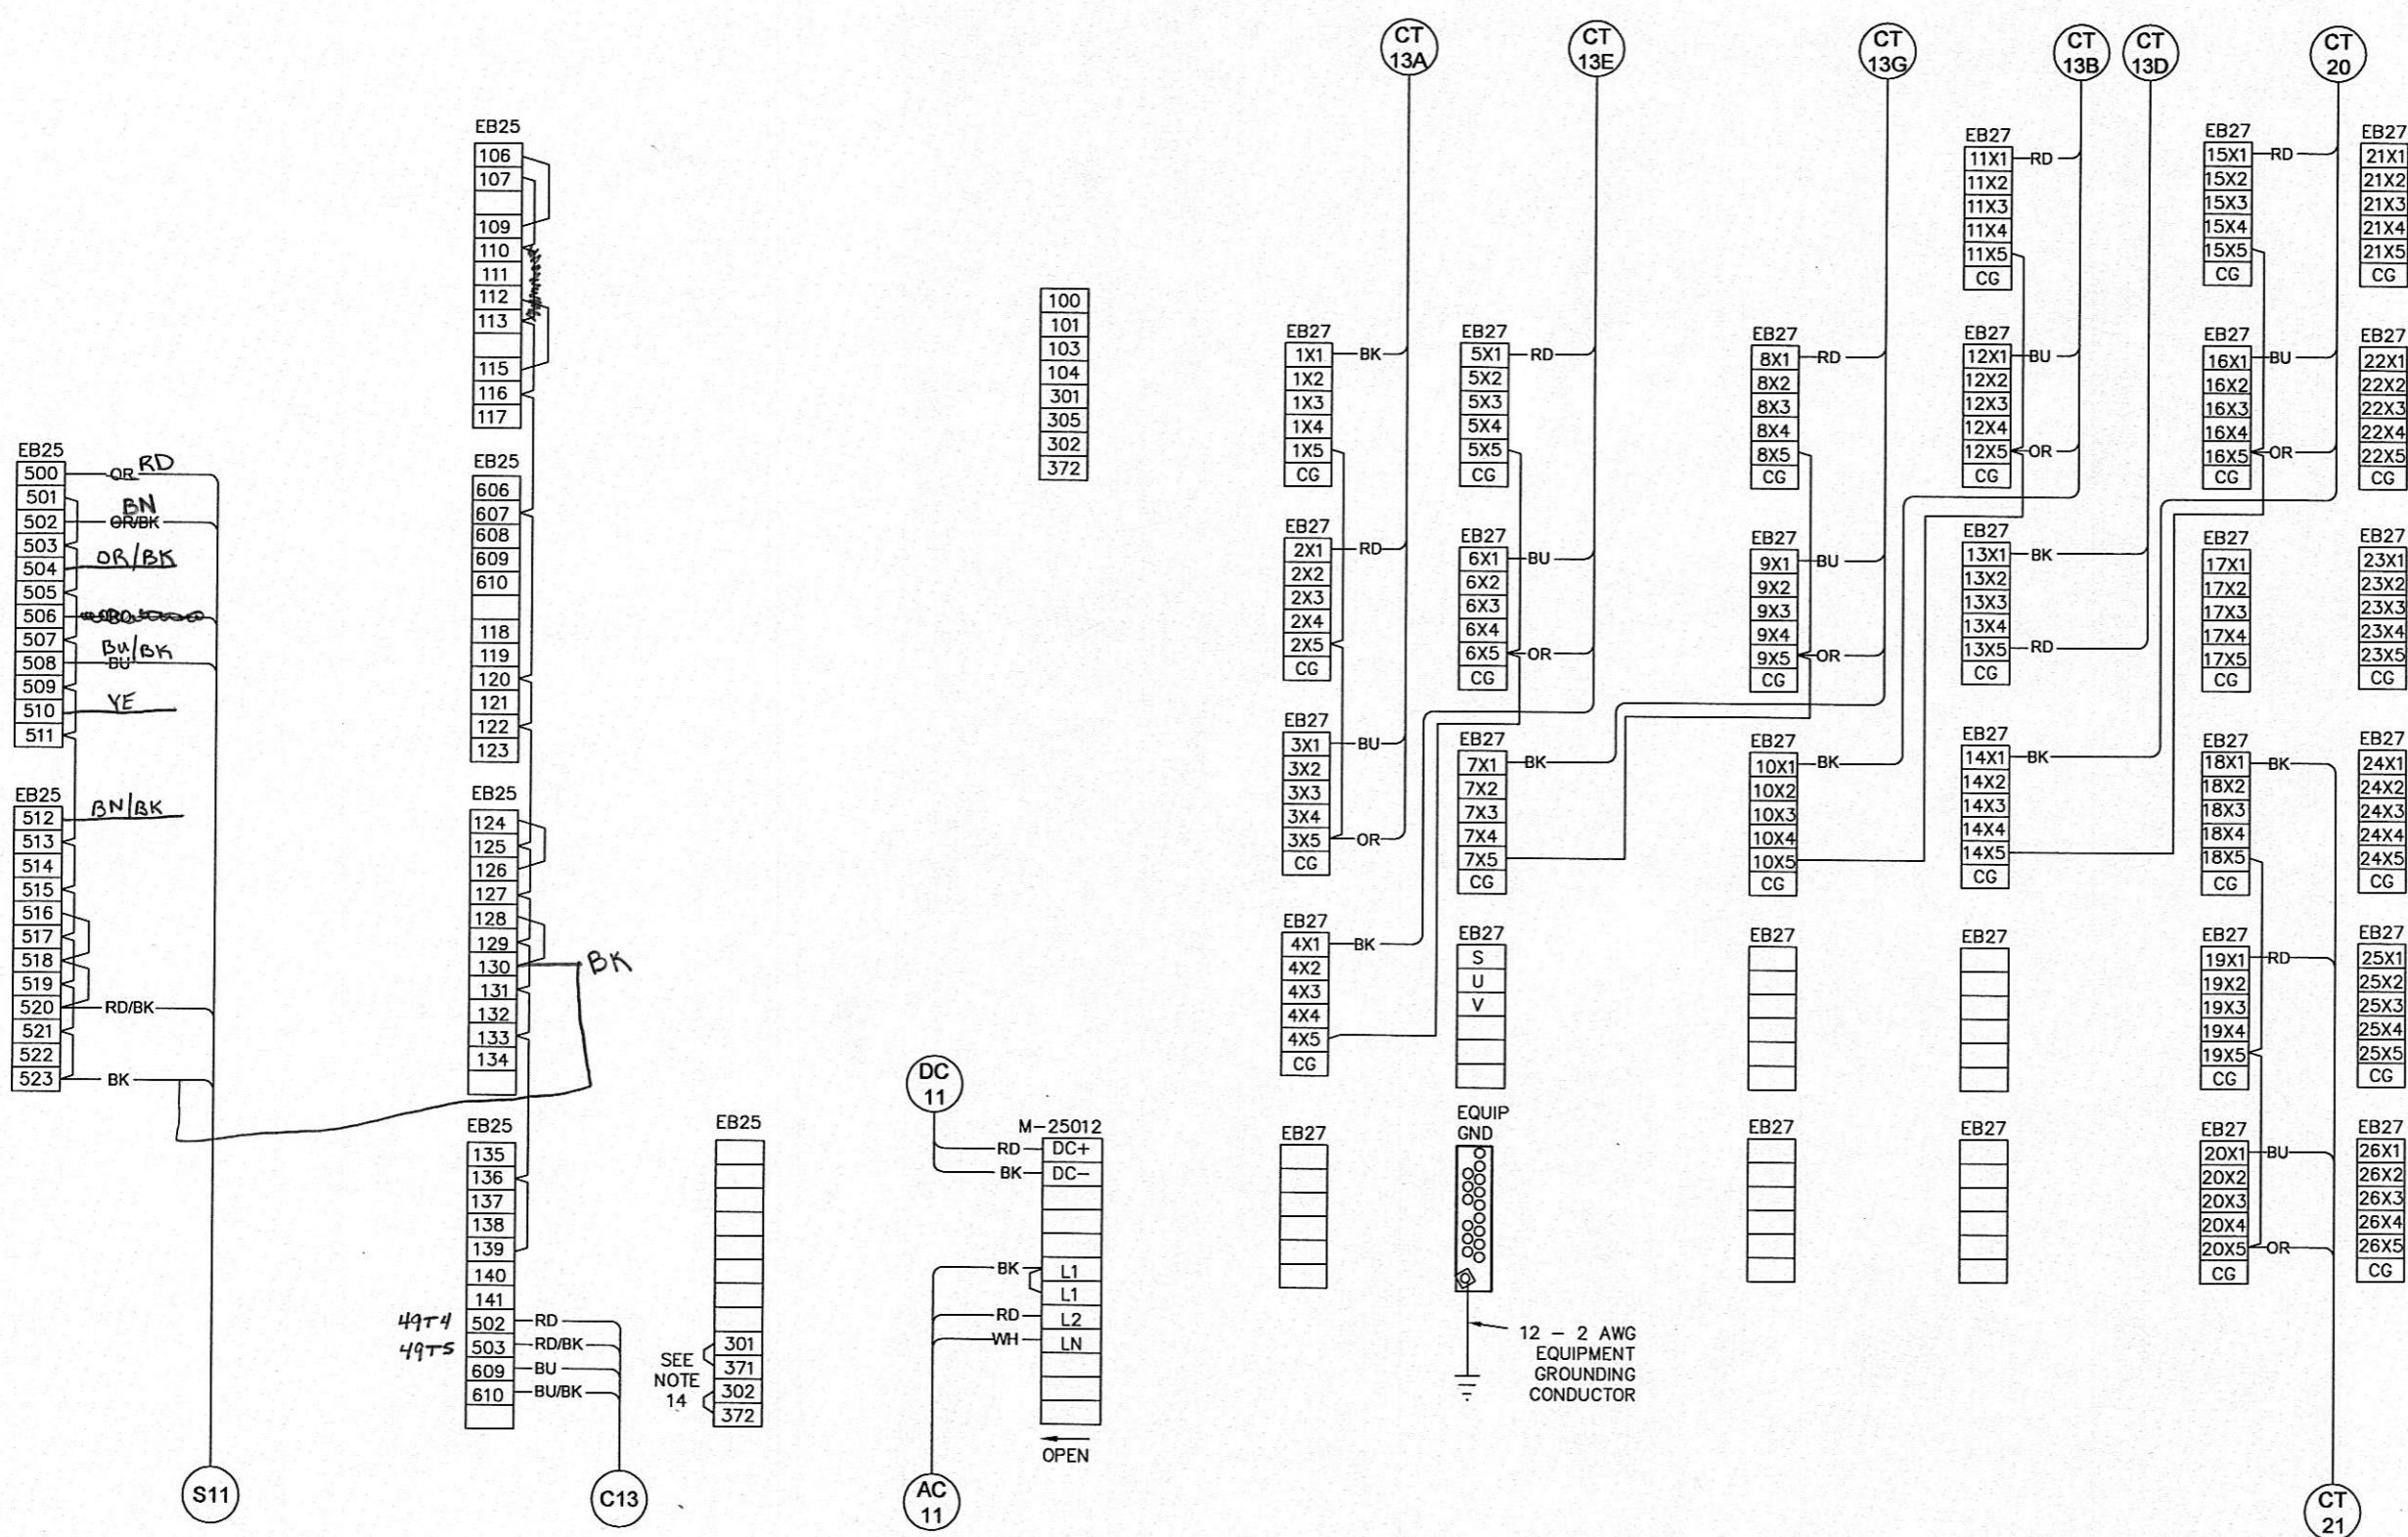

DESIGNED RNJ	DRAWN RW	CONFORMED TO CONSTRUCTION RECORDS			HARRIMAN UTILITY BOARD HARRIMAN PRIMARY SUBSTATION TRANSFORMER 1 CONNECTION DIAGRAM	PROJECT NUMBER: 07-70014-01317-1000
2 09-15-10		CONFORMED TO CONSTRUCTION RECORDS.			R.W. Beck 131 Saundersville Rd., Suite 300 Hendersonville, TN 37075 (615) 431-3200 An SAIC Company	SHEET OF: 1 1
1 03-04-10		ISSUED FOR CONSTRUCTION.				DRAWING NUMBER: 01317-803.2
0						
REV DATE CHKD APPD		REVISION DESCRIPTION				


LEGEND

◎ RELAY PANEL TERMINAL BLOCK

INTERCONNECTIONS BETWEEN RELAY PANELS AND FIELD EQUIPMENT

RELAY PANEL WIRING

FIELD DEVICE TERMINAL BLOCK

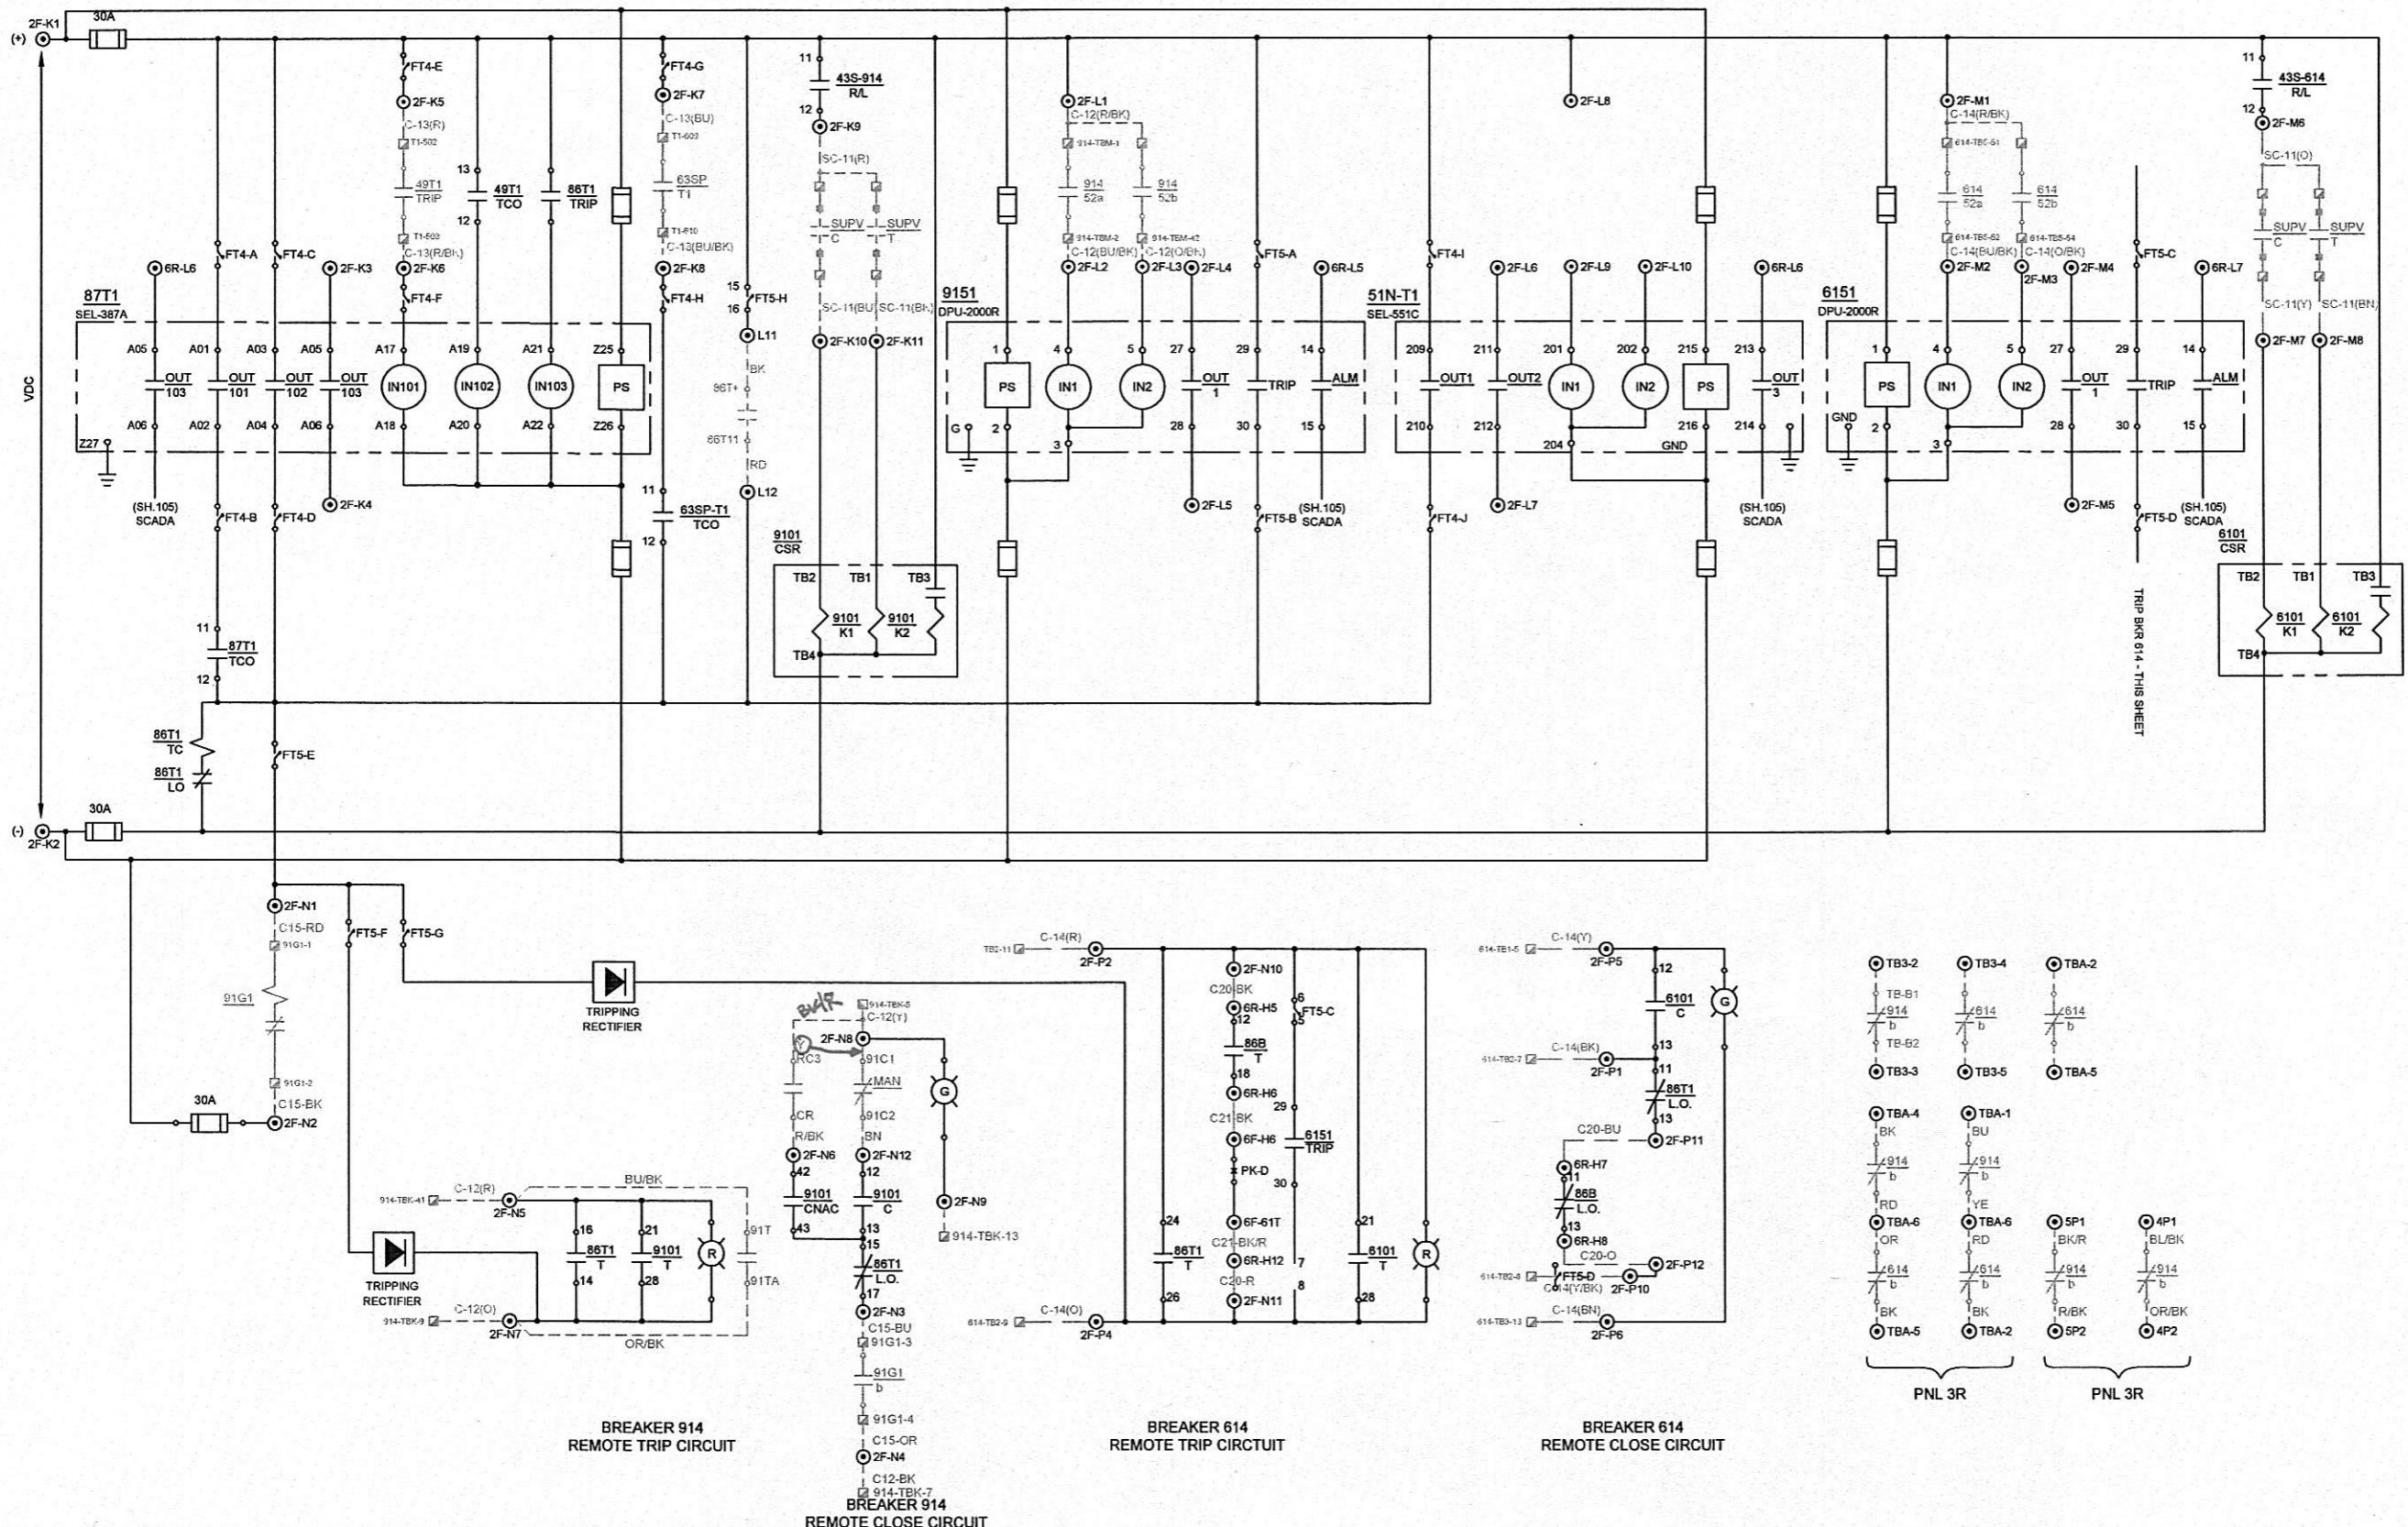

PLT: 9/30/2010 WALESRA - 1434 - G:\\01053007-7014-01317 HARRIMAN UB-PRIMARY\\WORK PRODUCTS\\CTCR01317-103.DWG : MODEL

			DESIGNED	RNU
			DRAWN	RAW
2	09-15-10		CONFORMED TO CONSTRUCTION RECORDS.	
1	2-22-10	KA	RNJ	UPDATED TERMINATIONS
0	11-09-09	KA	RNJ	ISSUED FOR CONSTRUCTION.
REV	DATE	CHKD	APPD	REVISION DESCRIPTION

COPYRIGHT 2008, R.W. BECK, INC., ALL RIGHTS RESERVED



CONFORMED TO
CONSTRUCTION
RECORDS

R.W. Beck
131 Saundersville Rd., Suite 300
Hendersonville, TN 37075
(615) 431-3200

An SAIC Company

HARRIMAN UTILITY BOARD
HARRIMAN PRIMARY SUBSTATION
BREAKER CONTROL SCHEME
BREAKERS 914 AND 614

PROJECT NUMBER:
07-70014-01317-1000
SHEET OF:
1 1
DRAWING NUMBER:
01317-103.2

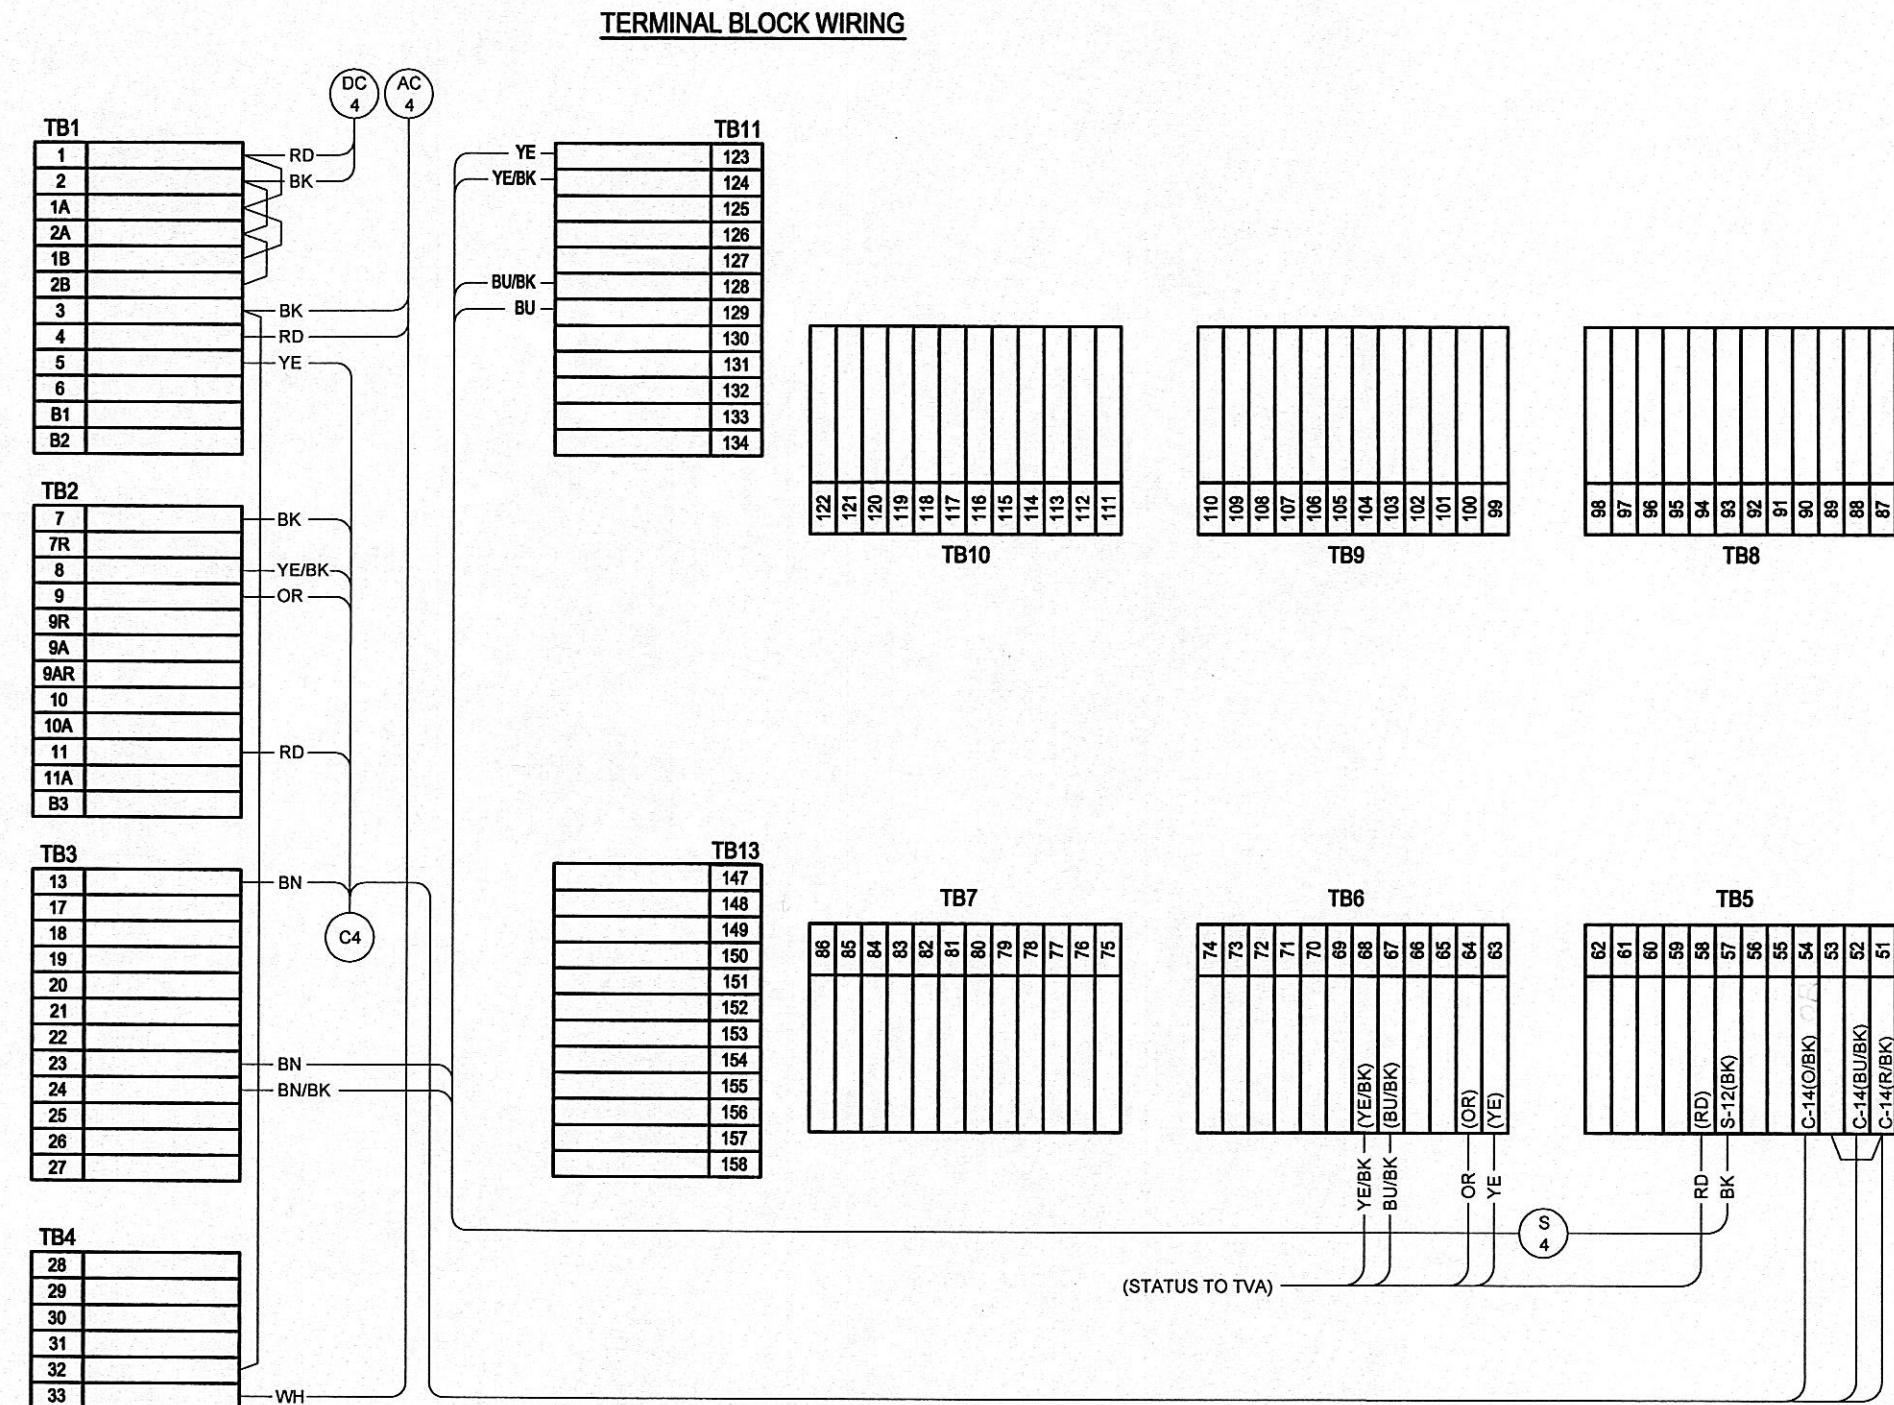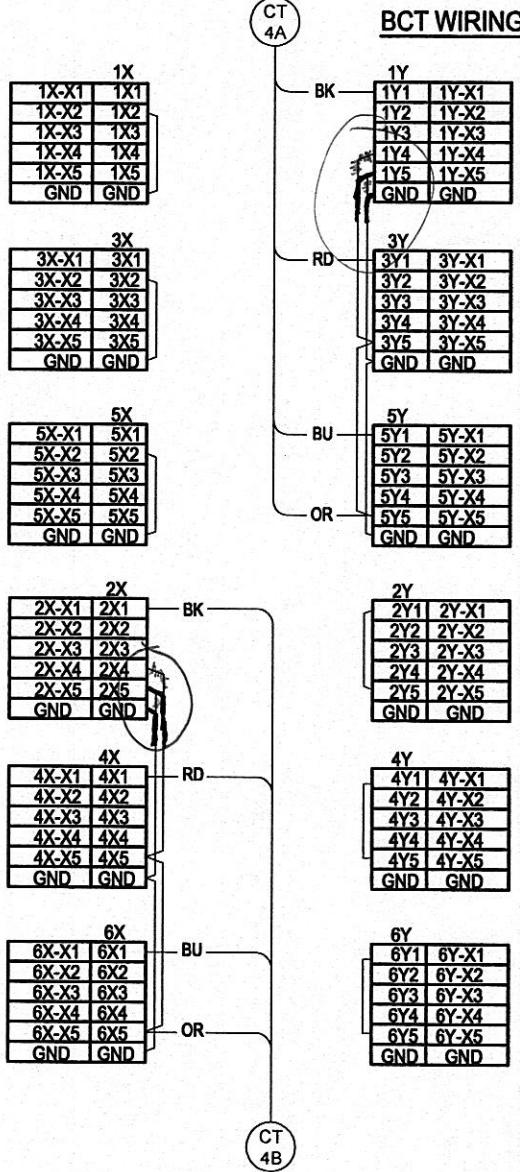

DESIGNED
DRAWN

RNJ
RNJ

**CONFORMED TO
CONSTRUCTION
RECORDS**


0 09-15-10 CONFORMED TO CONSTRUCTION RECORDS.
REV DATE CHK'D APP'D REVISION DESCRIPTION



R.W. Beck
131 Saundersville Rd., Suite 300
Hendersonville, TN 37075
(615) 431-3200

HARRIMAN UTILITY BOARD
HARRIMAN PRIMARY SUBSTATION
BREAKER 684
CONNECTION DIAGRAM

PROJECT NUMBER:
07-70014-01317-1000
SHEET OF:
1 1
DRAWING NUMBER:
01317-804.0

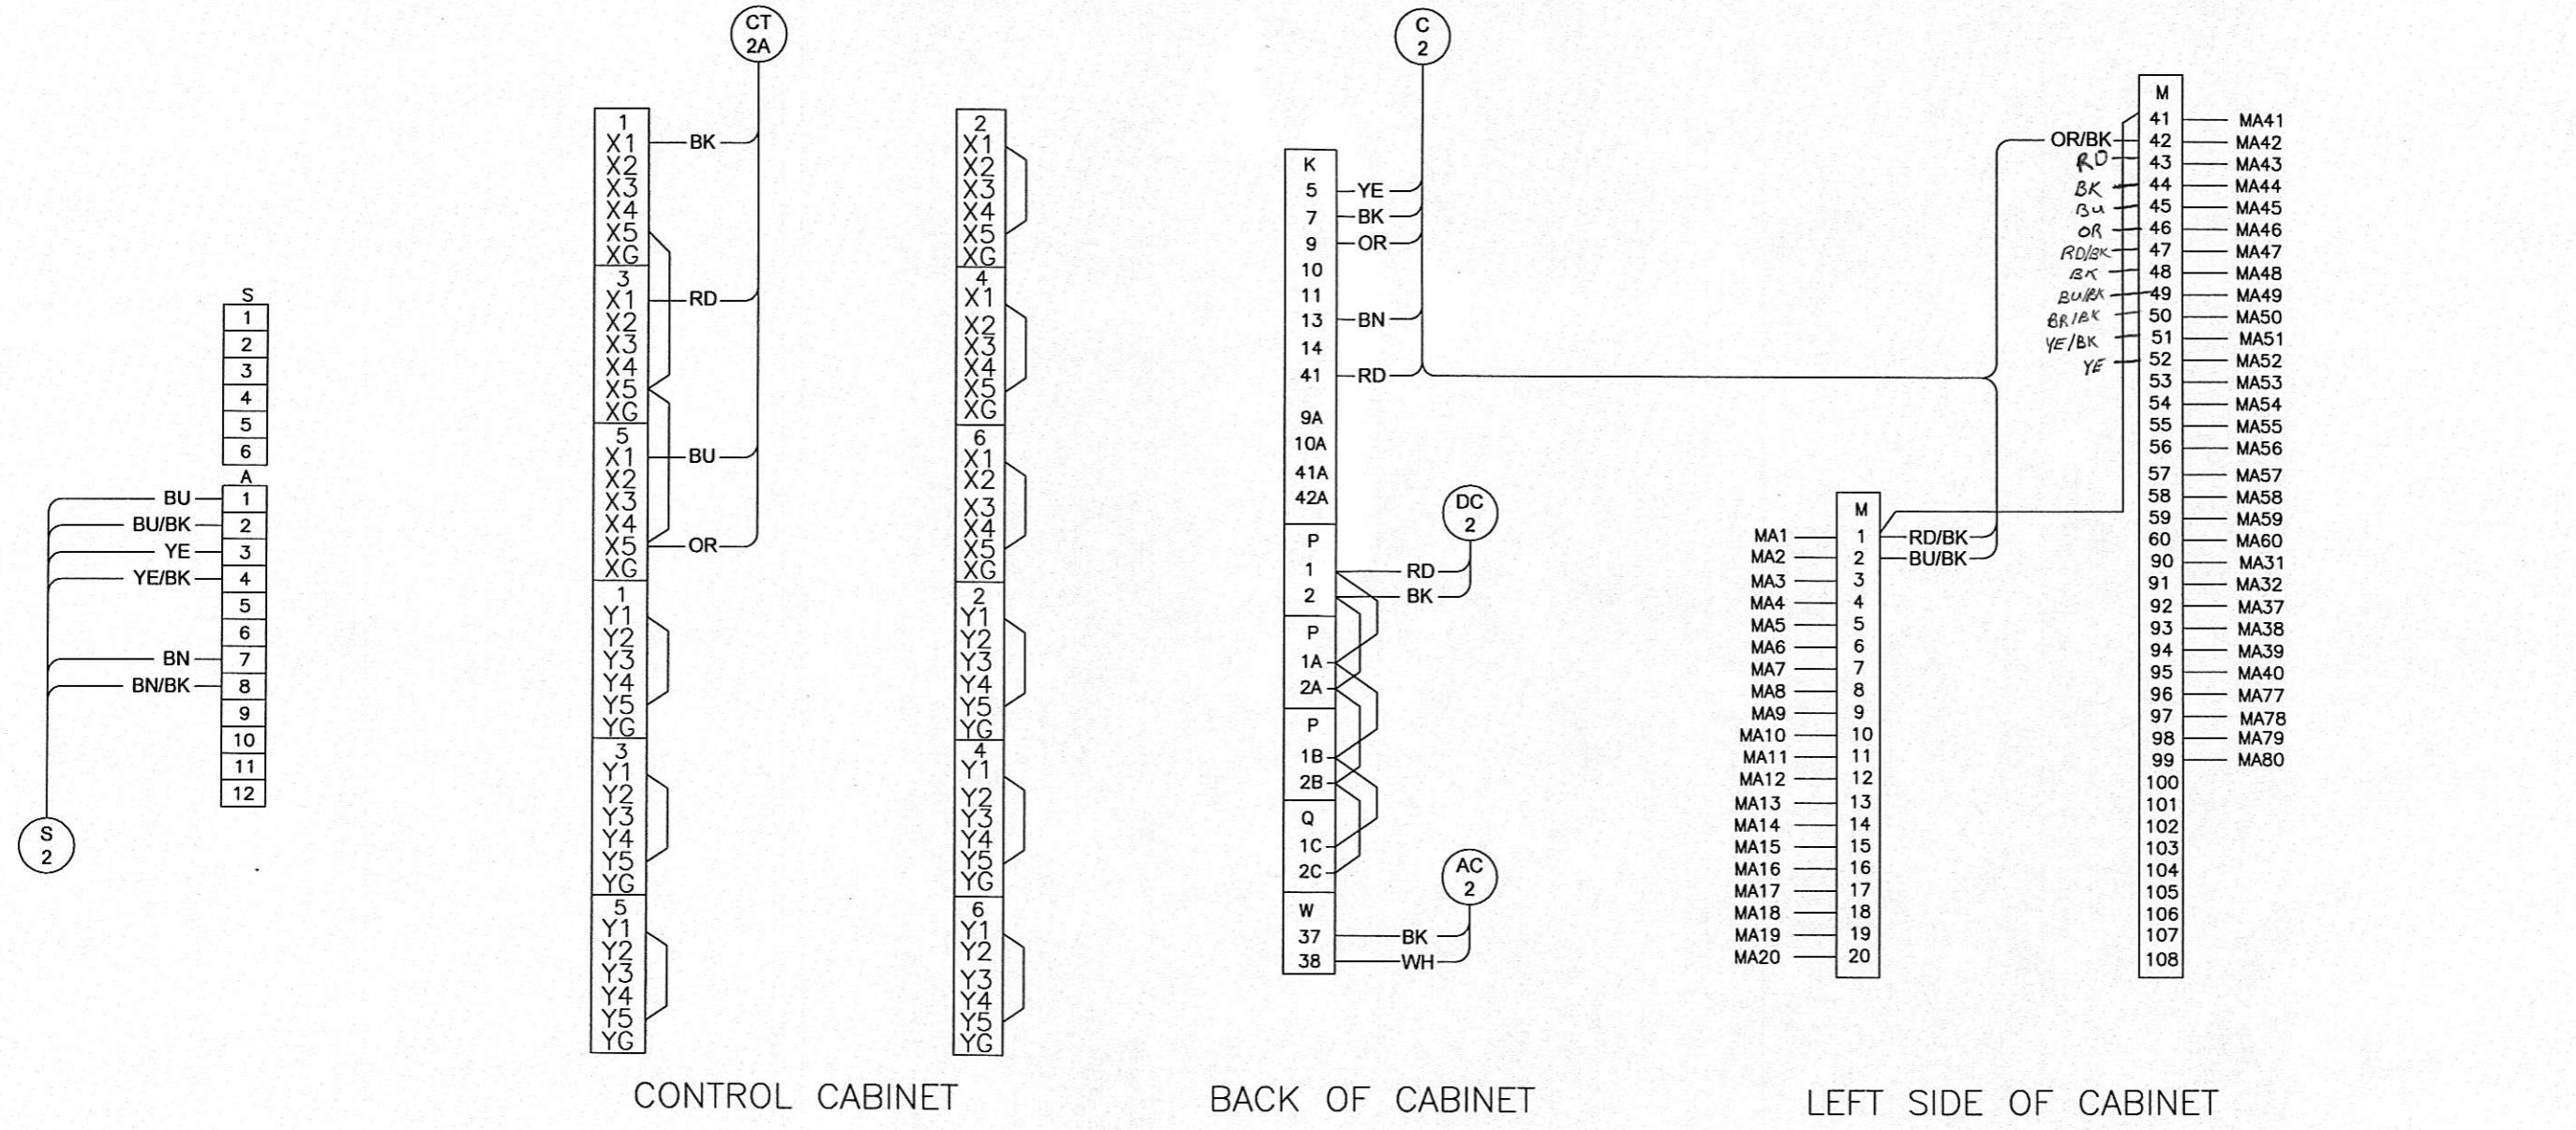

CONTROL CABINET

BACK OF CABINET

LEFT SIDE OF CABINET

0	09-15-10		CONFORMED TO CONSTRUCTION RECORDS.	
REV	DATE	CHKD APPD	REVISION DESCRIPTION	
COPYRIGHT 2008, R.W. BECK, INC., ALL RIGHTS RESERVED				


DESIGNED
DRAWN
CONFORMED TO CONSTRUCTION RECORDS



R.W. Beck
131 Saundersville Rd., Suite 300
Hendersonville, TN 37075
(615) 431-3200
An SAIC Company

HARRIMAN UTILITY BOARD
HARRIMAN PRIMARY SUBSTATION
BREAKER 924
CONNECTION DIAGRAM

PROJECT NUMBER:
07-70014-01317-1000
SHEET OF:
1 1
DRAWING NUMBER:
01317-805.0

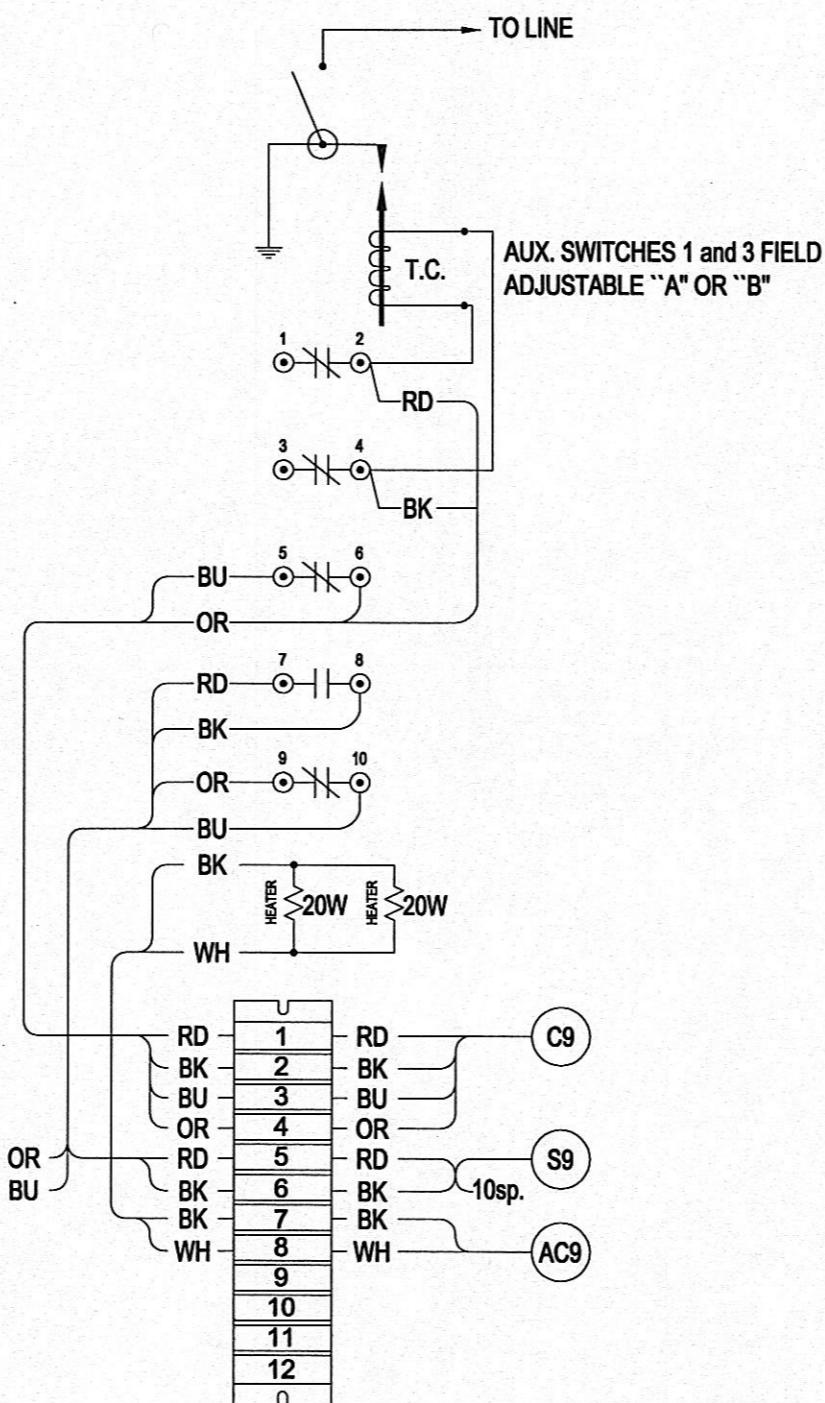


				DESIGNED RNJ	CONFORMED TO CONSTRUCTION RECORDS	
DRAWN RW						
0 09-15-10			CONFORMED TO CONSTRUCTON RECORDS.			
REV DATE	CHKD APPD		REVISION DESCRIPTION			




R.W. Beck
131 Saundersville Rd., Suite 300
Hendersonville, TN 37075
(615) 431-3200

HARRIMAN UTILITY BOARD
HARRIMAN PRIMARY SUBSTATION
GROUND SWITCH 92G1
CONNECTION DIAGRAM


PROJECT NUMBER:
07-70014-01317-1000 .
SHEET OF:
1 1
DRAWING NUMBER:
01317-806.0

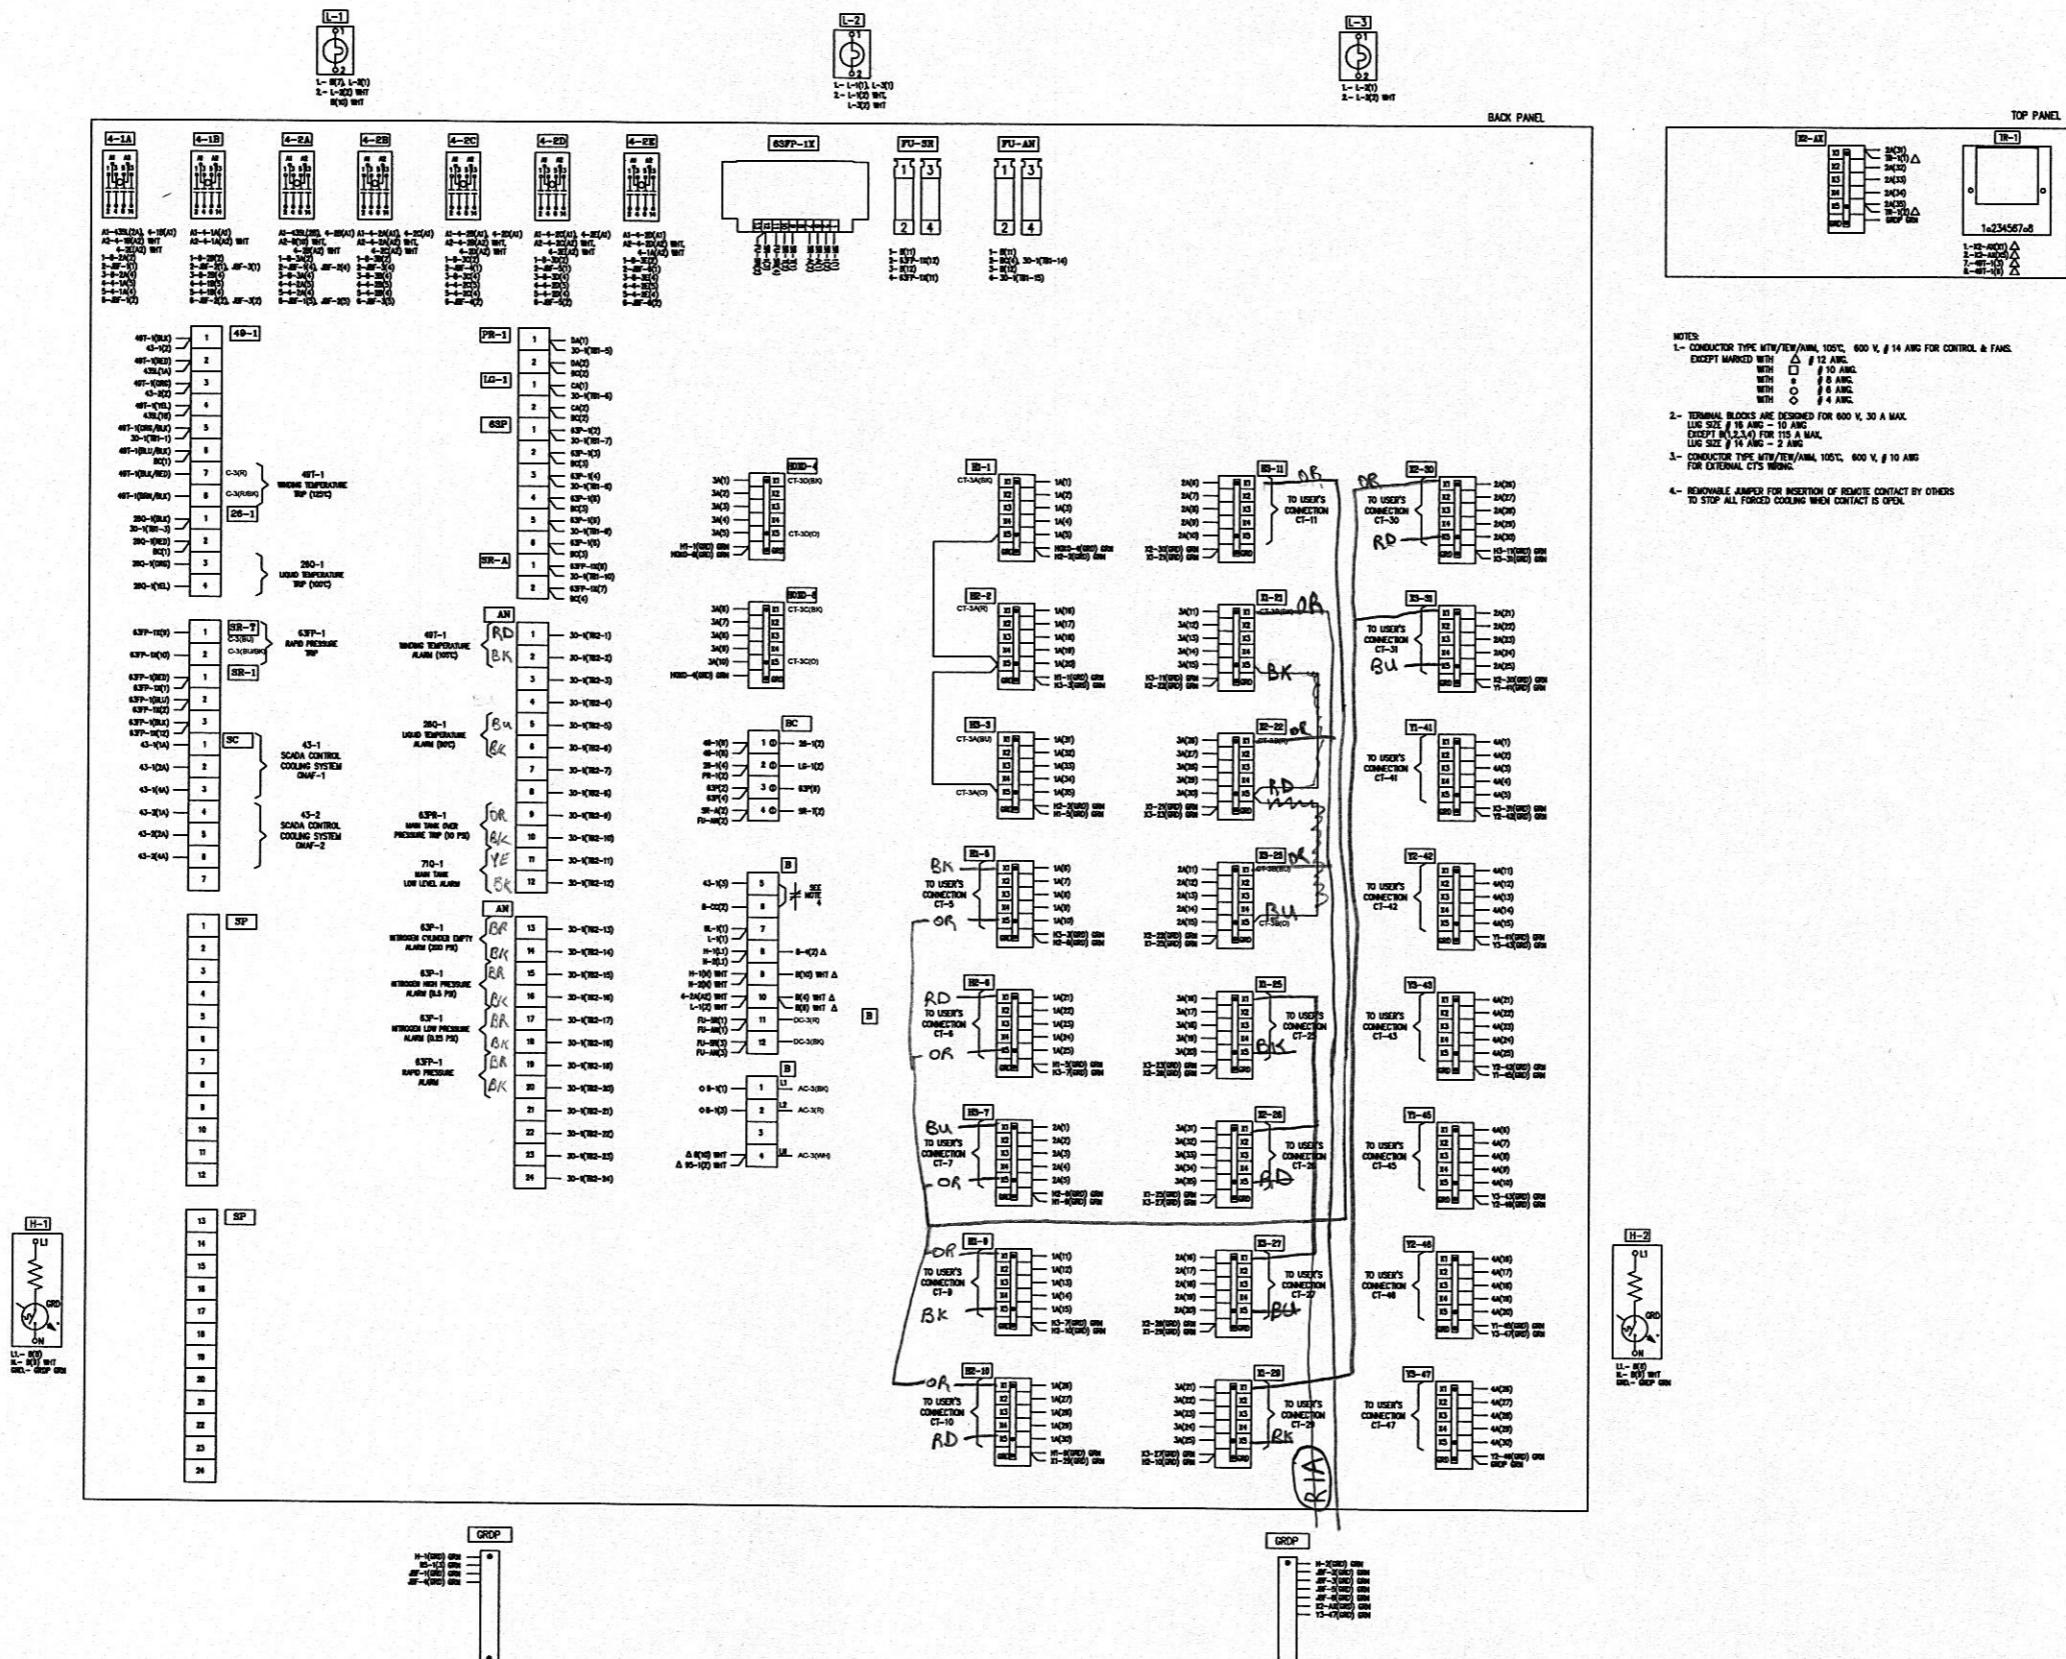


			DESIGNED RNJ	CONFORMED TO CONSTRUCTION RECORDS			R.W. Beck 131 Saundersville Rd., Suite 300 Hendersonville, TN 37075 (615) 431-3200 An SAIC Company	HARRIMAN UTILITY BOARD HARRIMAN PRIMARY SUBSTATION TRANSFORMER 2 CONNECTION DIAGRAM	PROJECT NUMBER: 07-70014-01317-1000
DRAWN RW									SHEET OF: 1 1
0 09-15-10		CONFORMED TO CONSTRUCTION RECORDS.							DRAWING NUMBER: 01317-807.0
REV DATE CHKD APPD		REVISION DESCRIPTION							

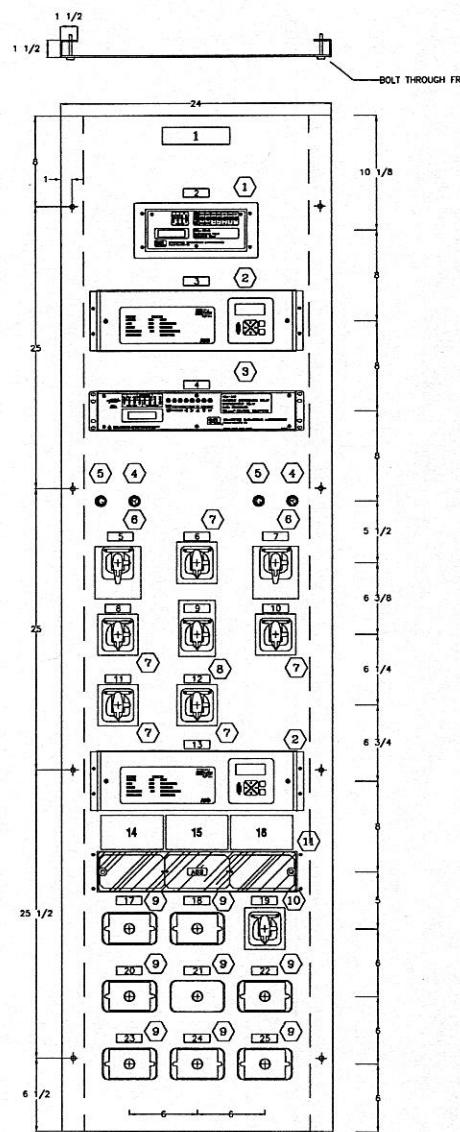


FRONT VIEW

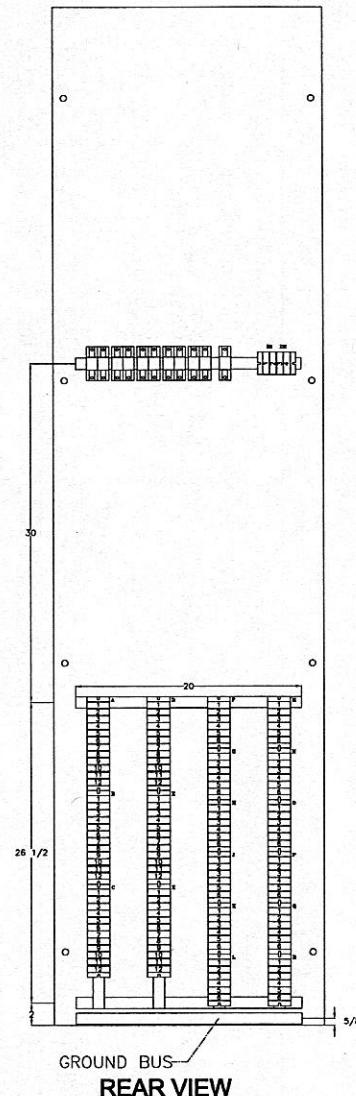

REAR VIEW

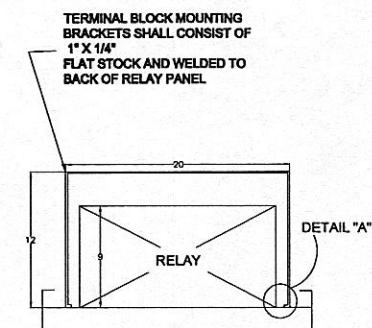




BOTTOM VIEW

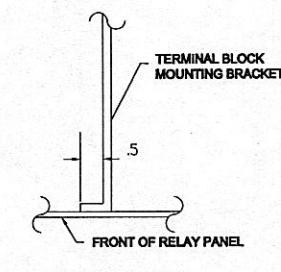


DETAIL "A"
SCALE, 1/2" = 1"






REV	DESCRIPTION	BY	APRV	DATE
www.keystonemc.com KEYSTONE ELECTRICAL MANUFACTURING CO.				
SCALE: 1/8=1	PROJ ENGR: EAP	CHK BY:	APPROVED	
DATE: 9/26/07	DRW BY: EAP			
REPLACEMENT PANEL 3F HARRIMAN PRIMARY SUBSTATION STRUCTURAL DRAWING				
HARRIMAN UTILITIES HARRIMAN, TN 01164-P3			DWG NO. 4249-SL1	SHEET: 1 OF 1

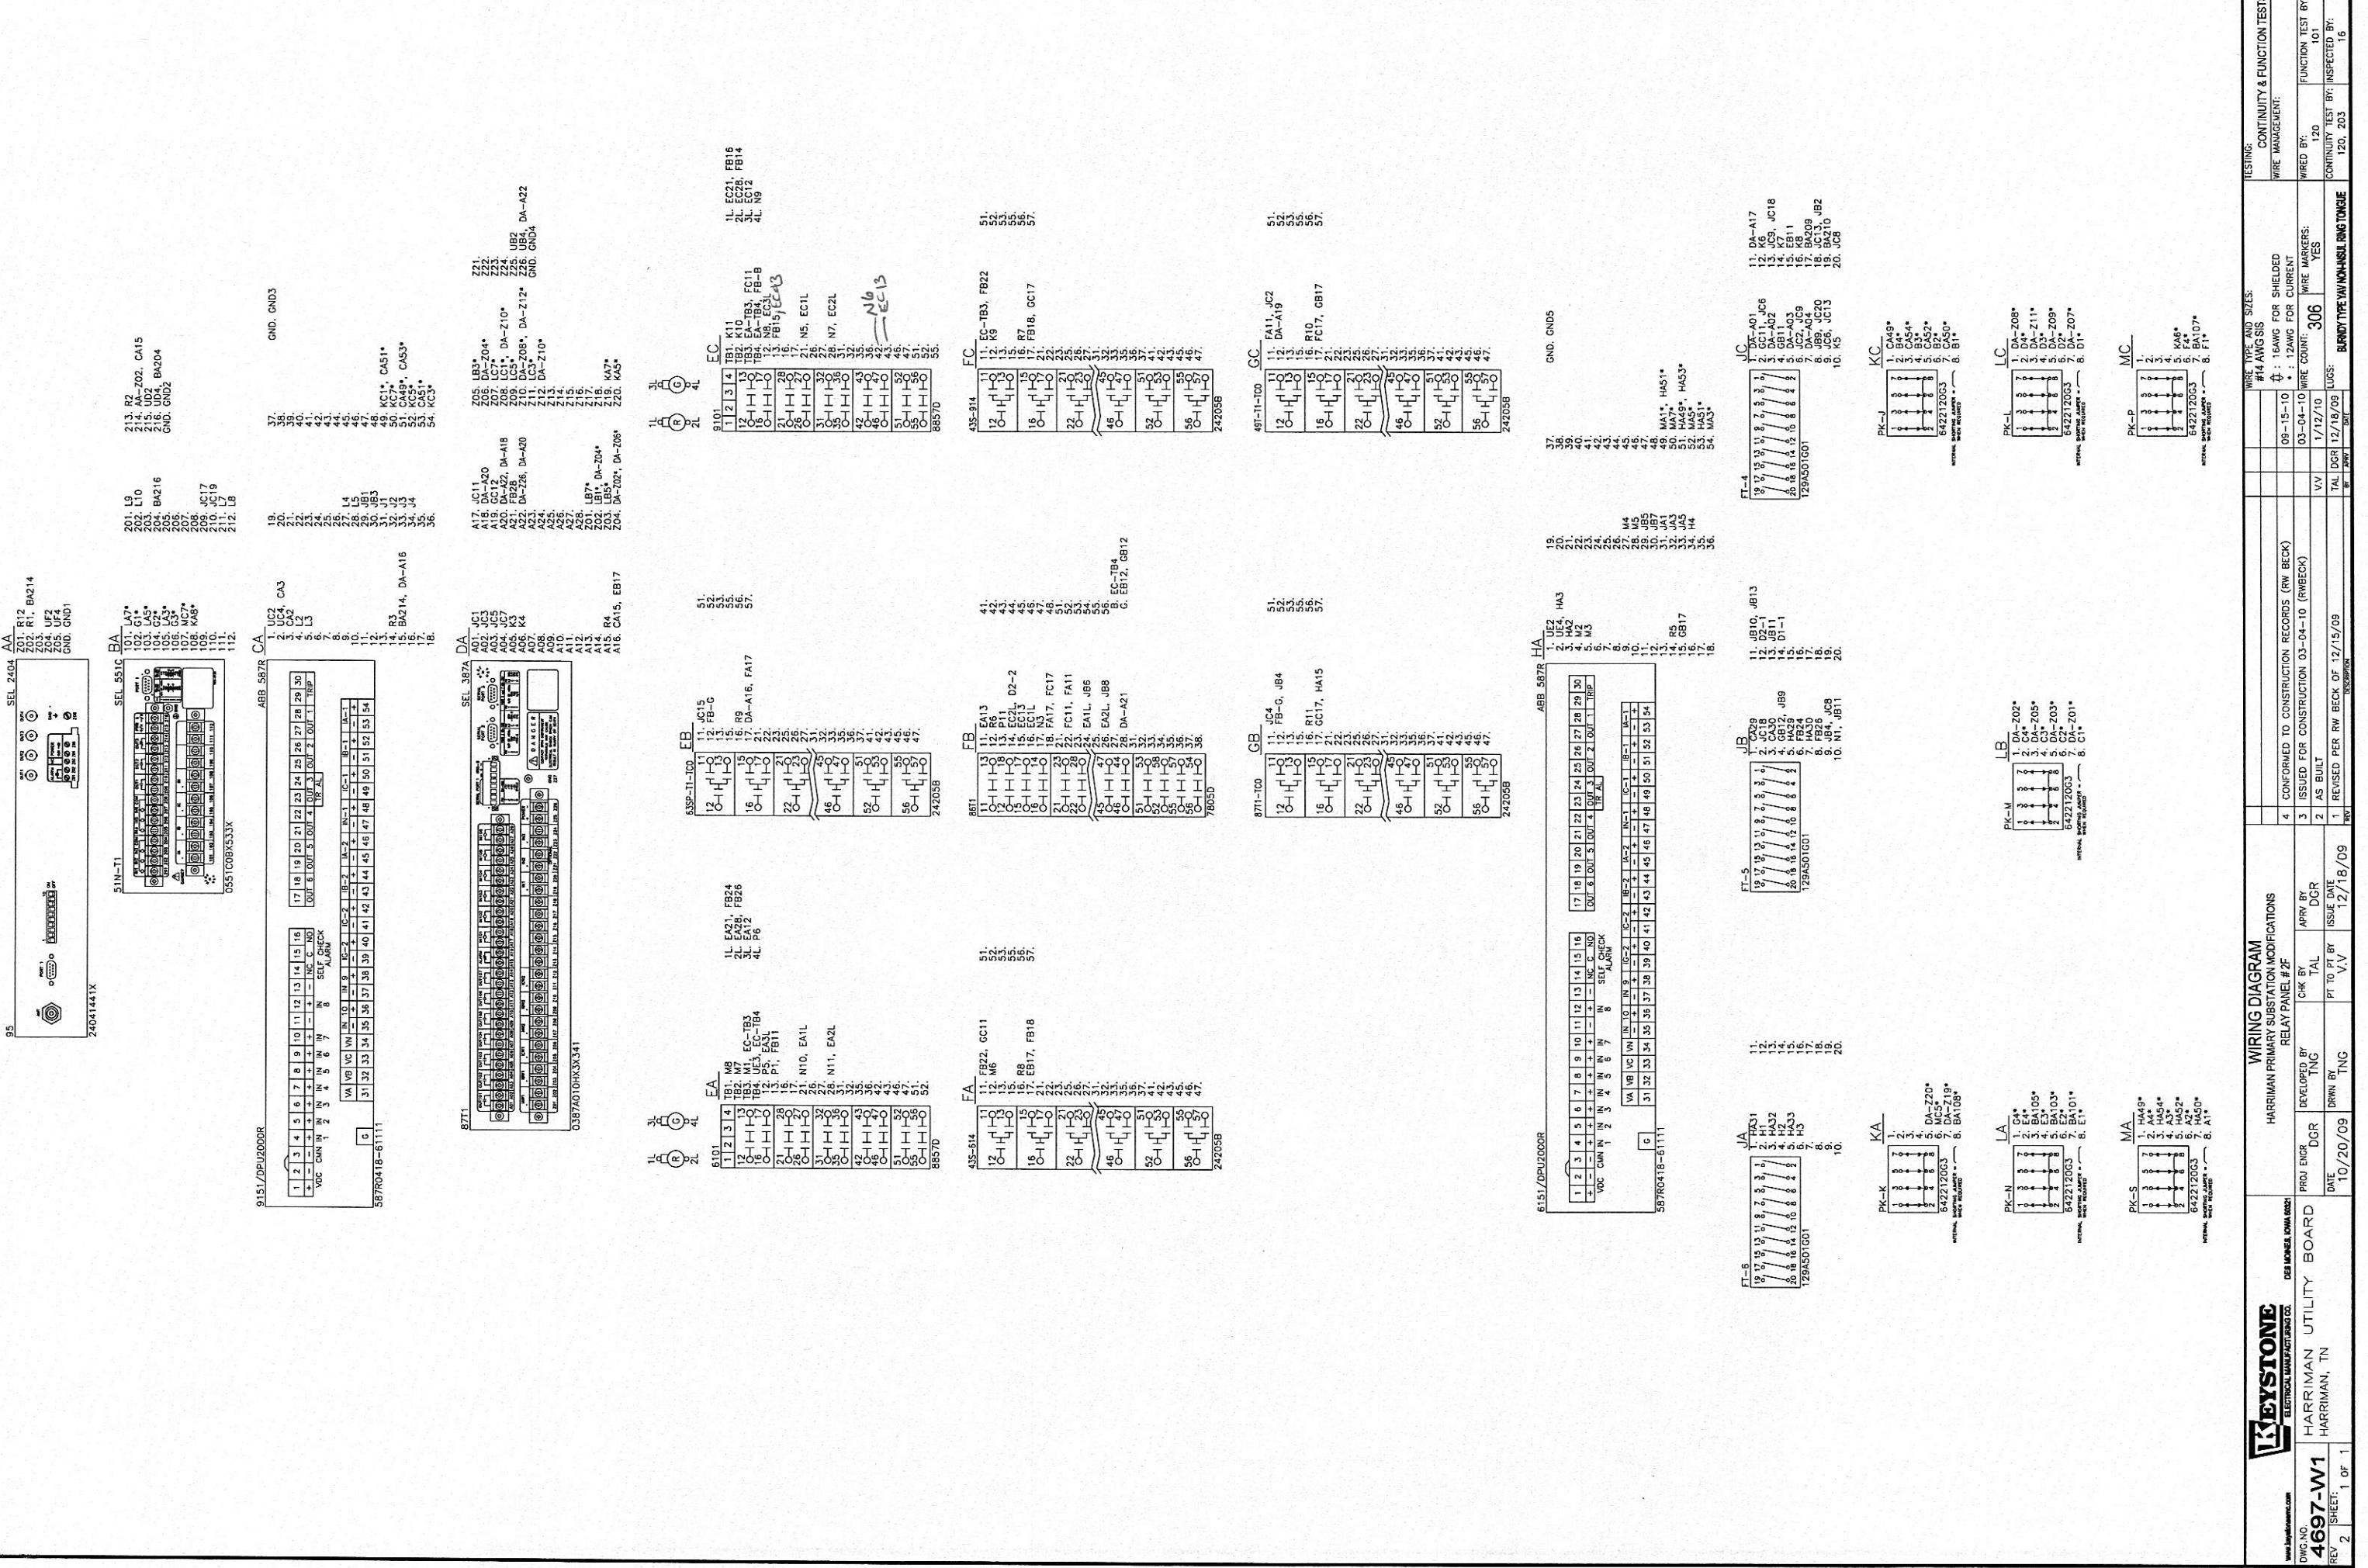


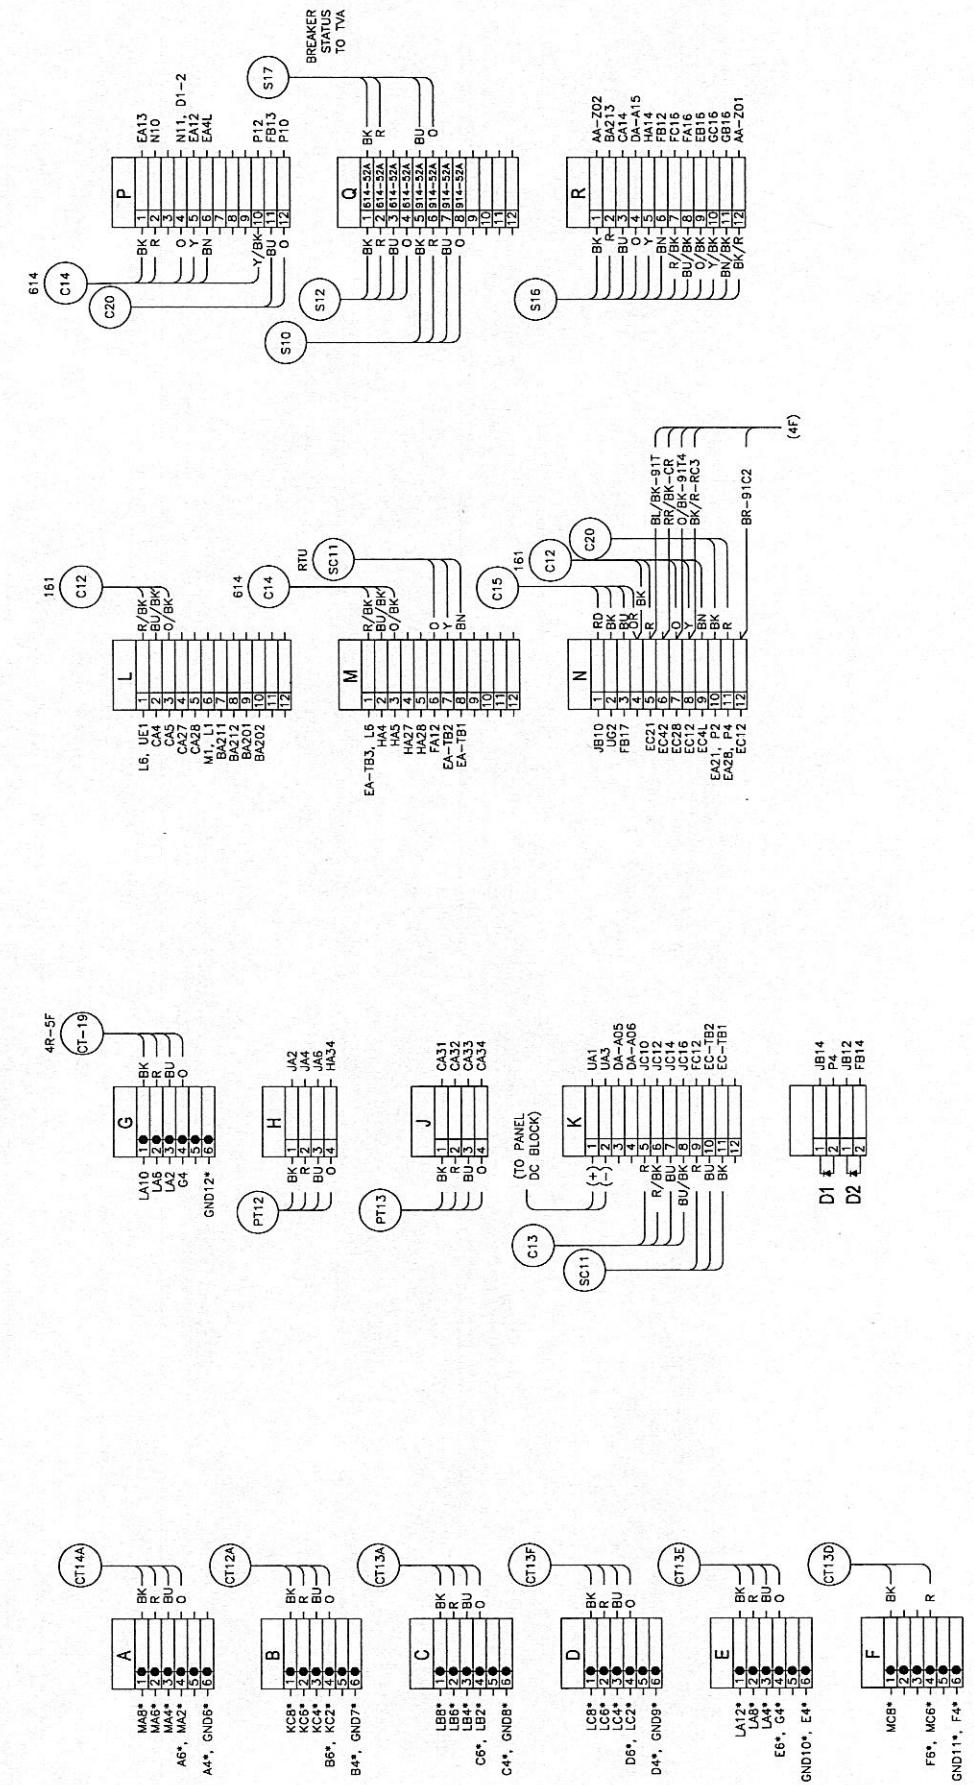
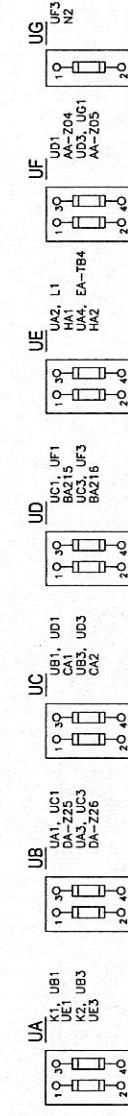


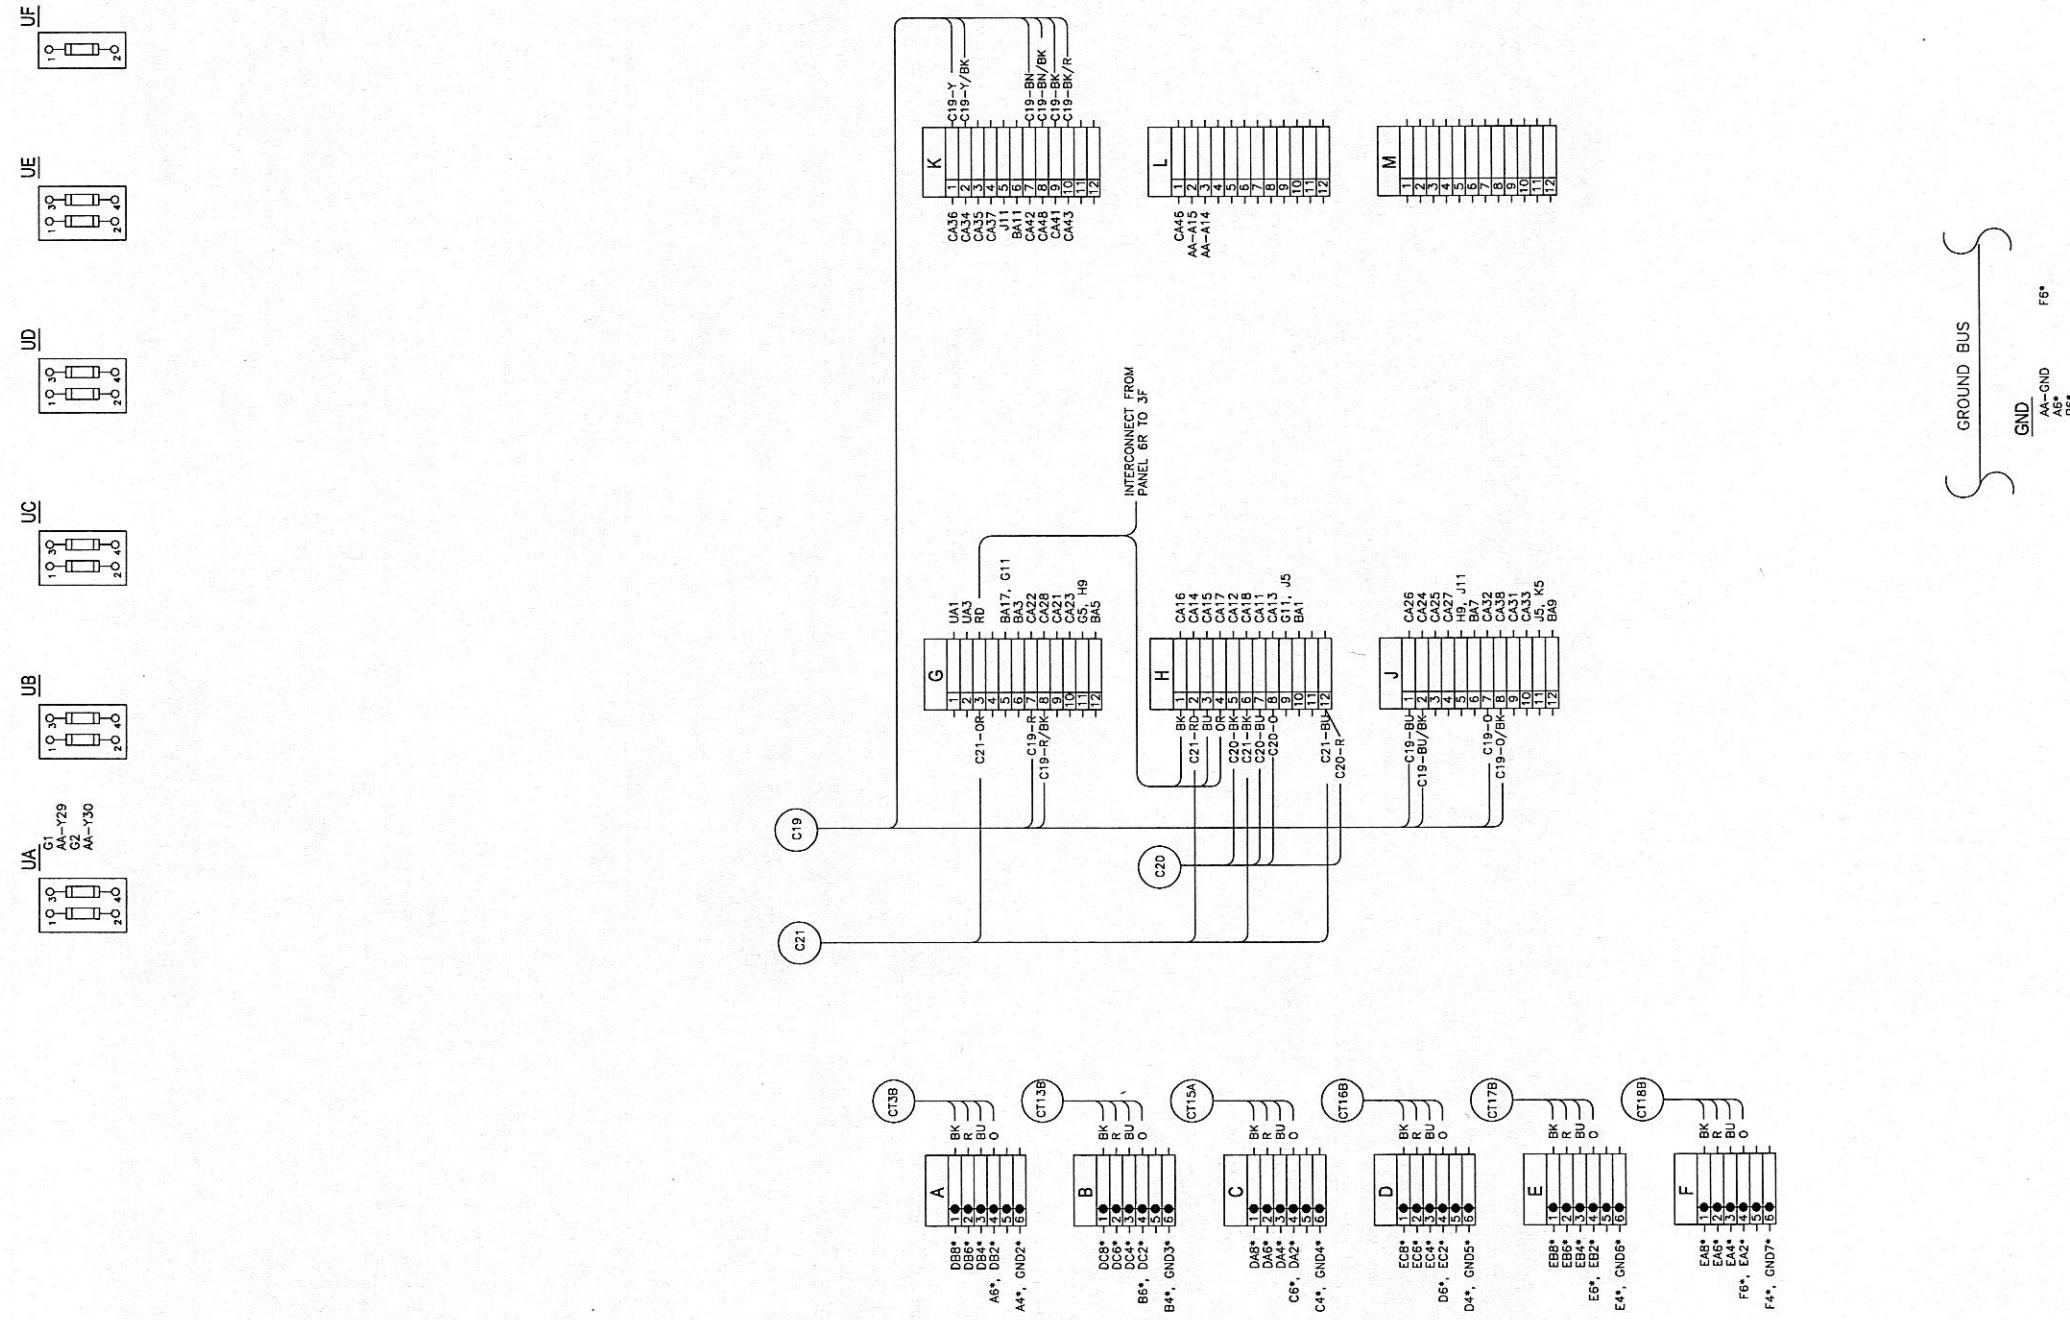


KEYSTONE ELECTRICAL MANUFACTURING CO.		WIRING DIAGRAM HARRIMAN PRIMARY SUBSTATION MODIFICATIONS						TESTING:	
DES. NUMBER: IOWA-00021		RELAY PANEL #6R		PROJ. ENGR. DCR		APRV BY DCR		WIRE TYPE AND SIZES: #14 AWG SIS # : 16AWG FOR SHIELDED * : 12AWG FOR CURRENT	
DRAWING NO. 4697-W2T		HARRIMAN UTILITY BOARD		DEVELOPED BY TNG		CHK BY TAL		WIRE COUNT: 09-15-10	
REV SHEET: 1 OF 1		DATE: 10/20/09		DRAWN BY TNG		PT TO PT BY TN		WIRE MARKERS: YES	
REV SHEET: 1 OF 1		DATE: 10/20/09		ISSUE DATE: 12/18/09		ISSUE BY: AS BUILT		WIRED BY: 120	
www.keystoneinc.com		HARRIMAN, TN		HARRIMAN, TN		DESCRIPTION		FUNCTION TEST BY: 13. HI-POT	
								CONTINUITY TEST BY: INSPECTED BY: 13.	
								BLANKING TYPE: W/N HANSI RING TONGUE	

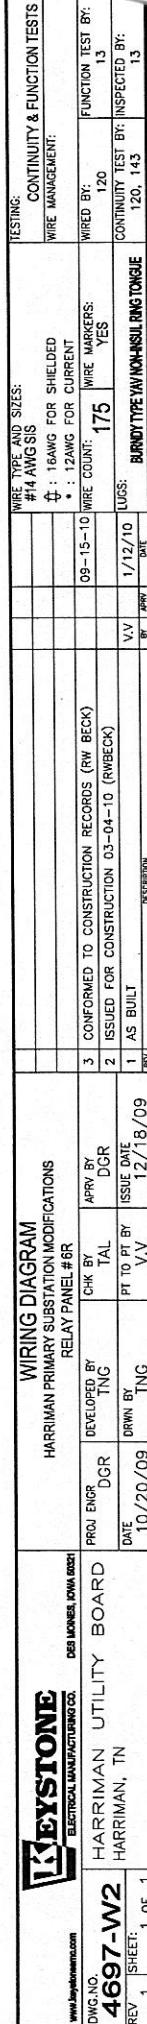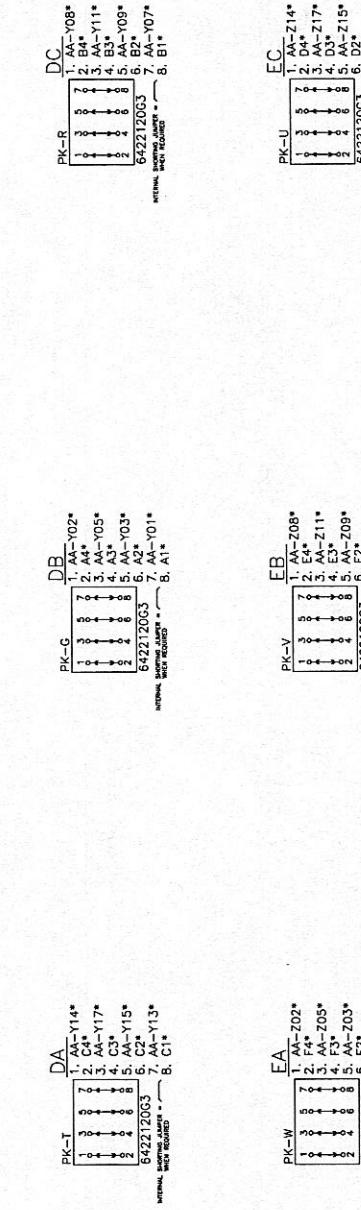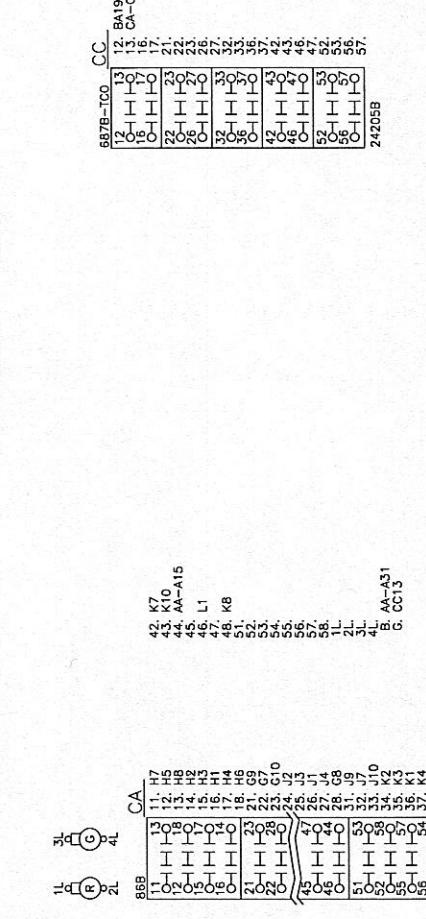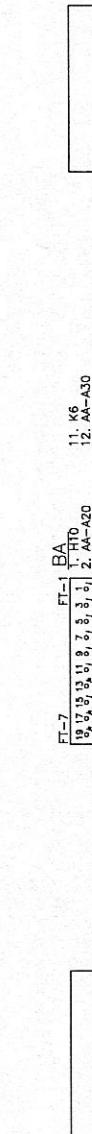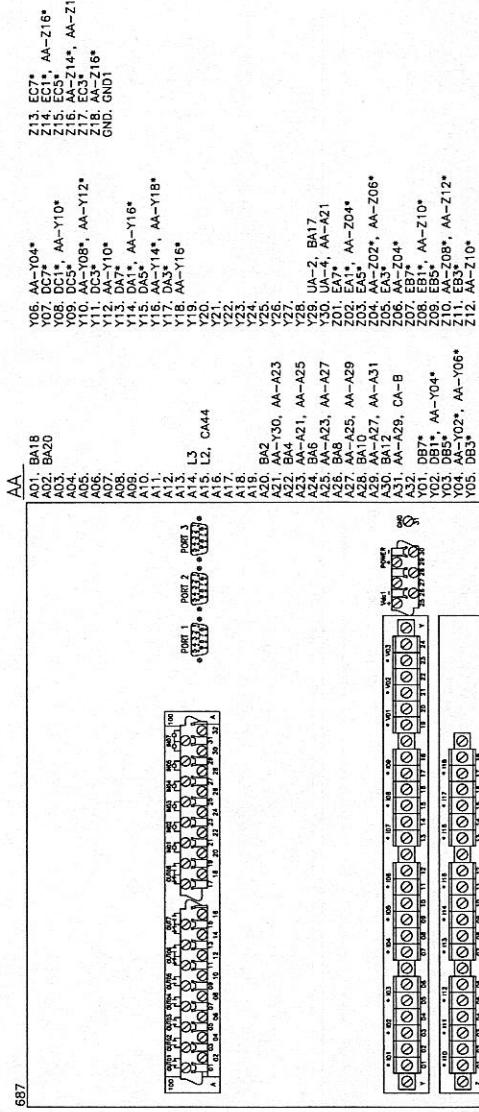


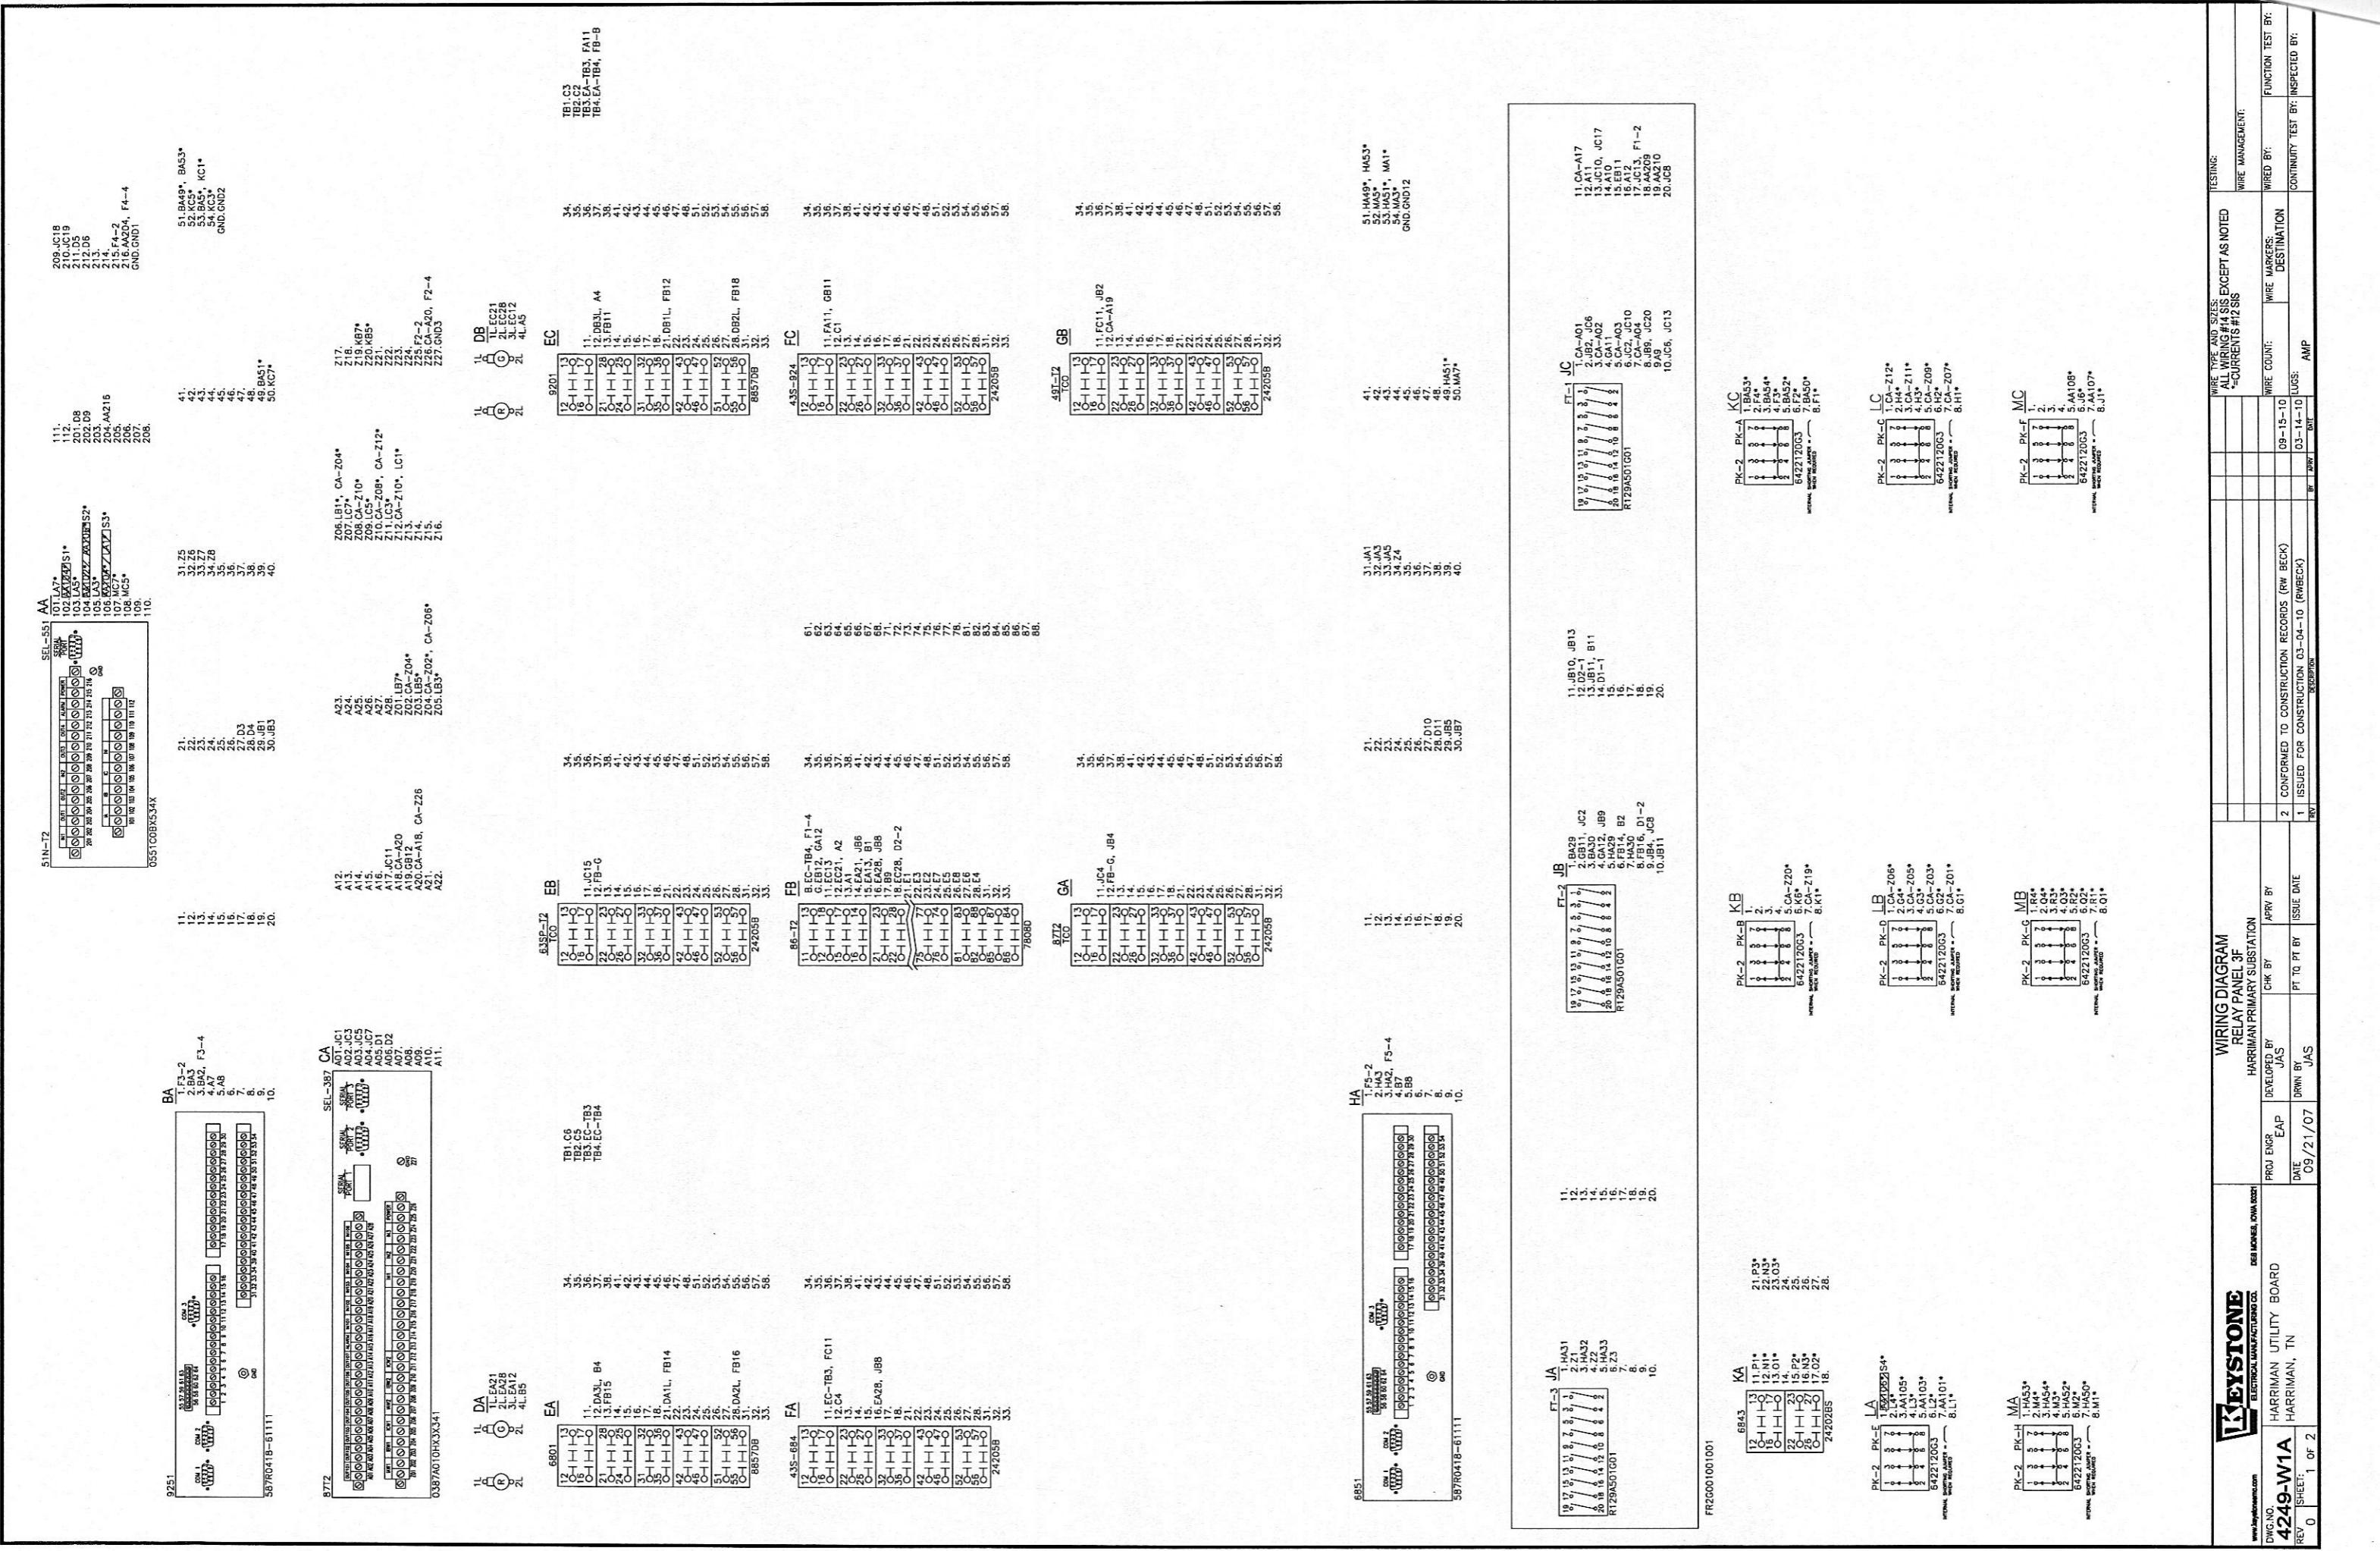

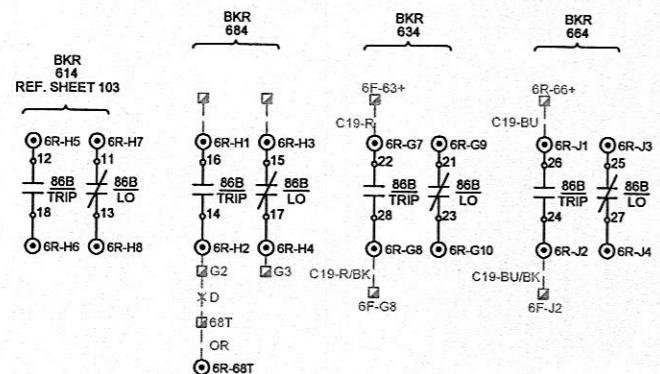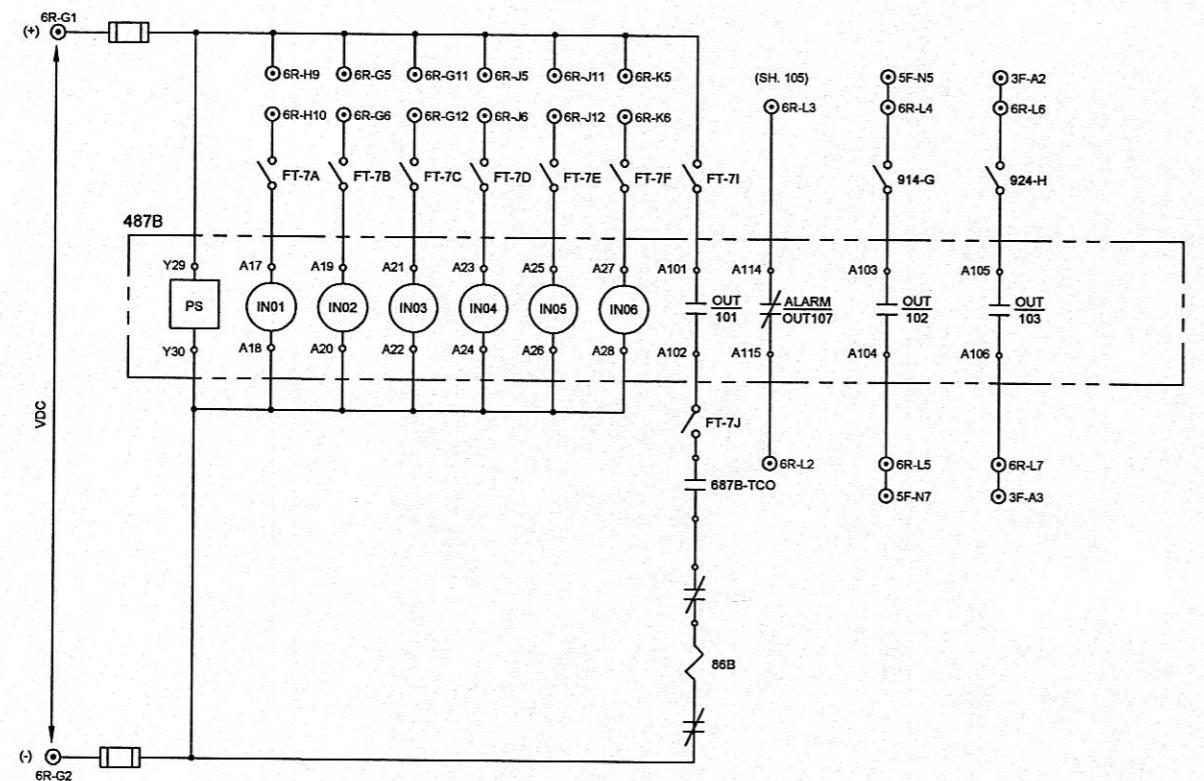

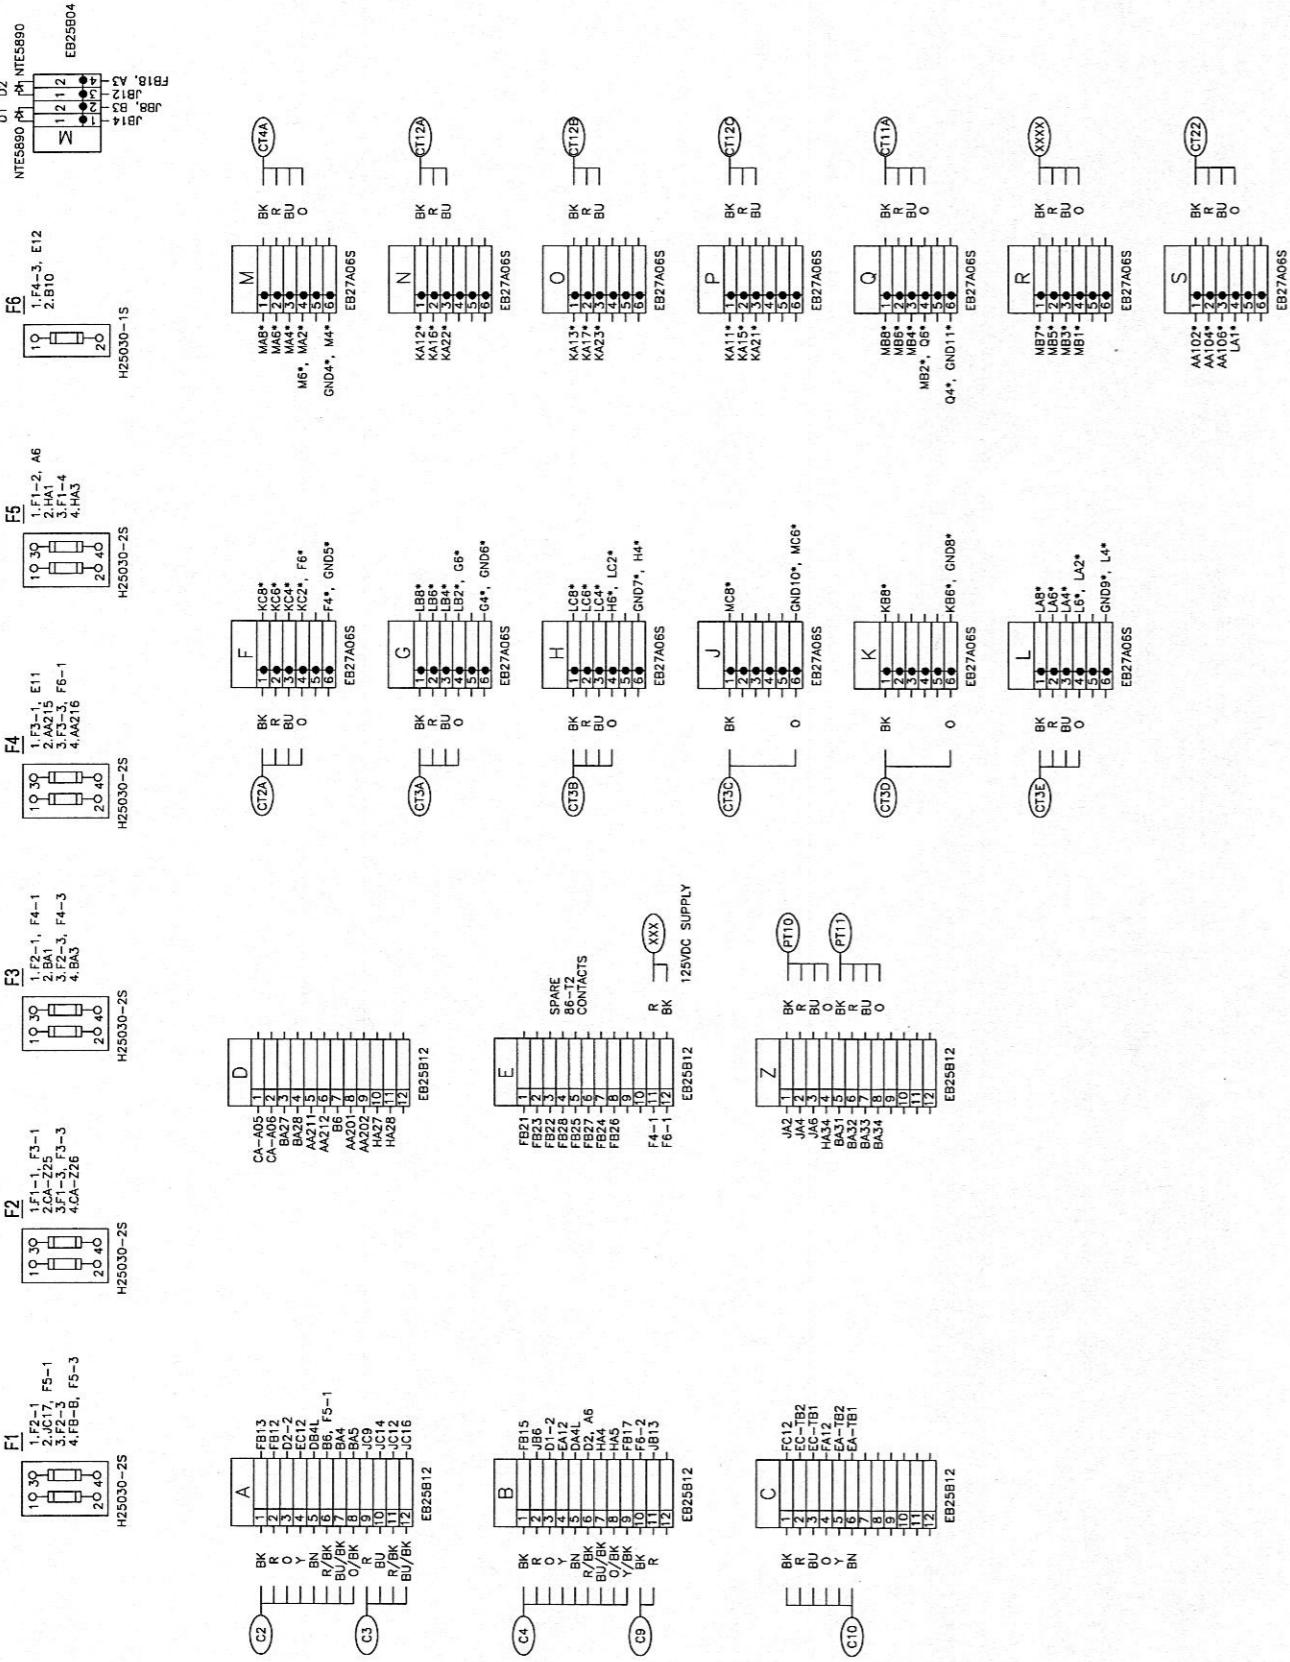

KEystone
ELECTRICAL MANUFACTURING CO.
HARRIMAN UTILITY BOARD
HARRIMAN, TN

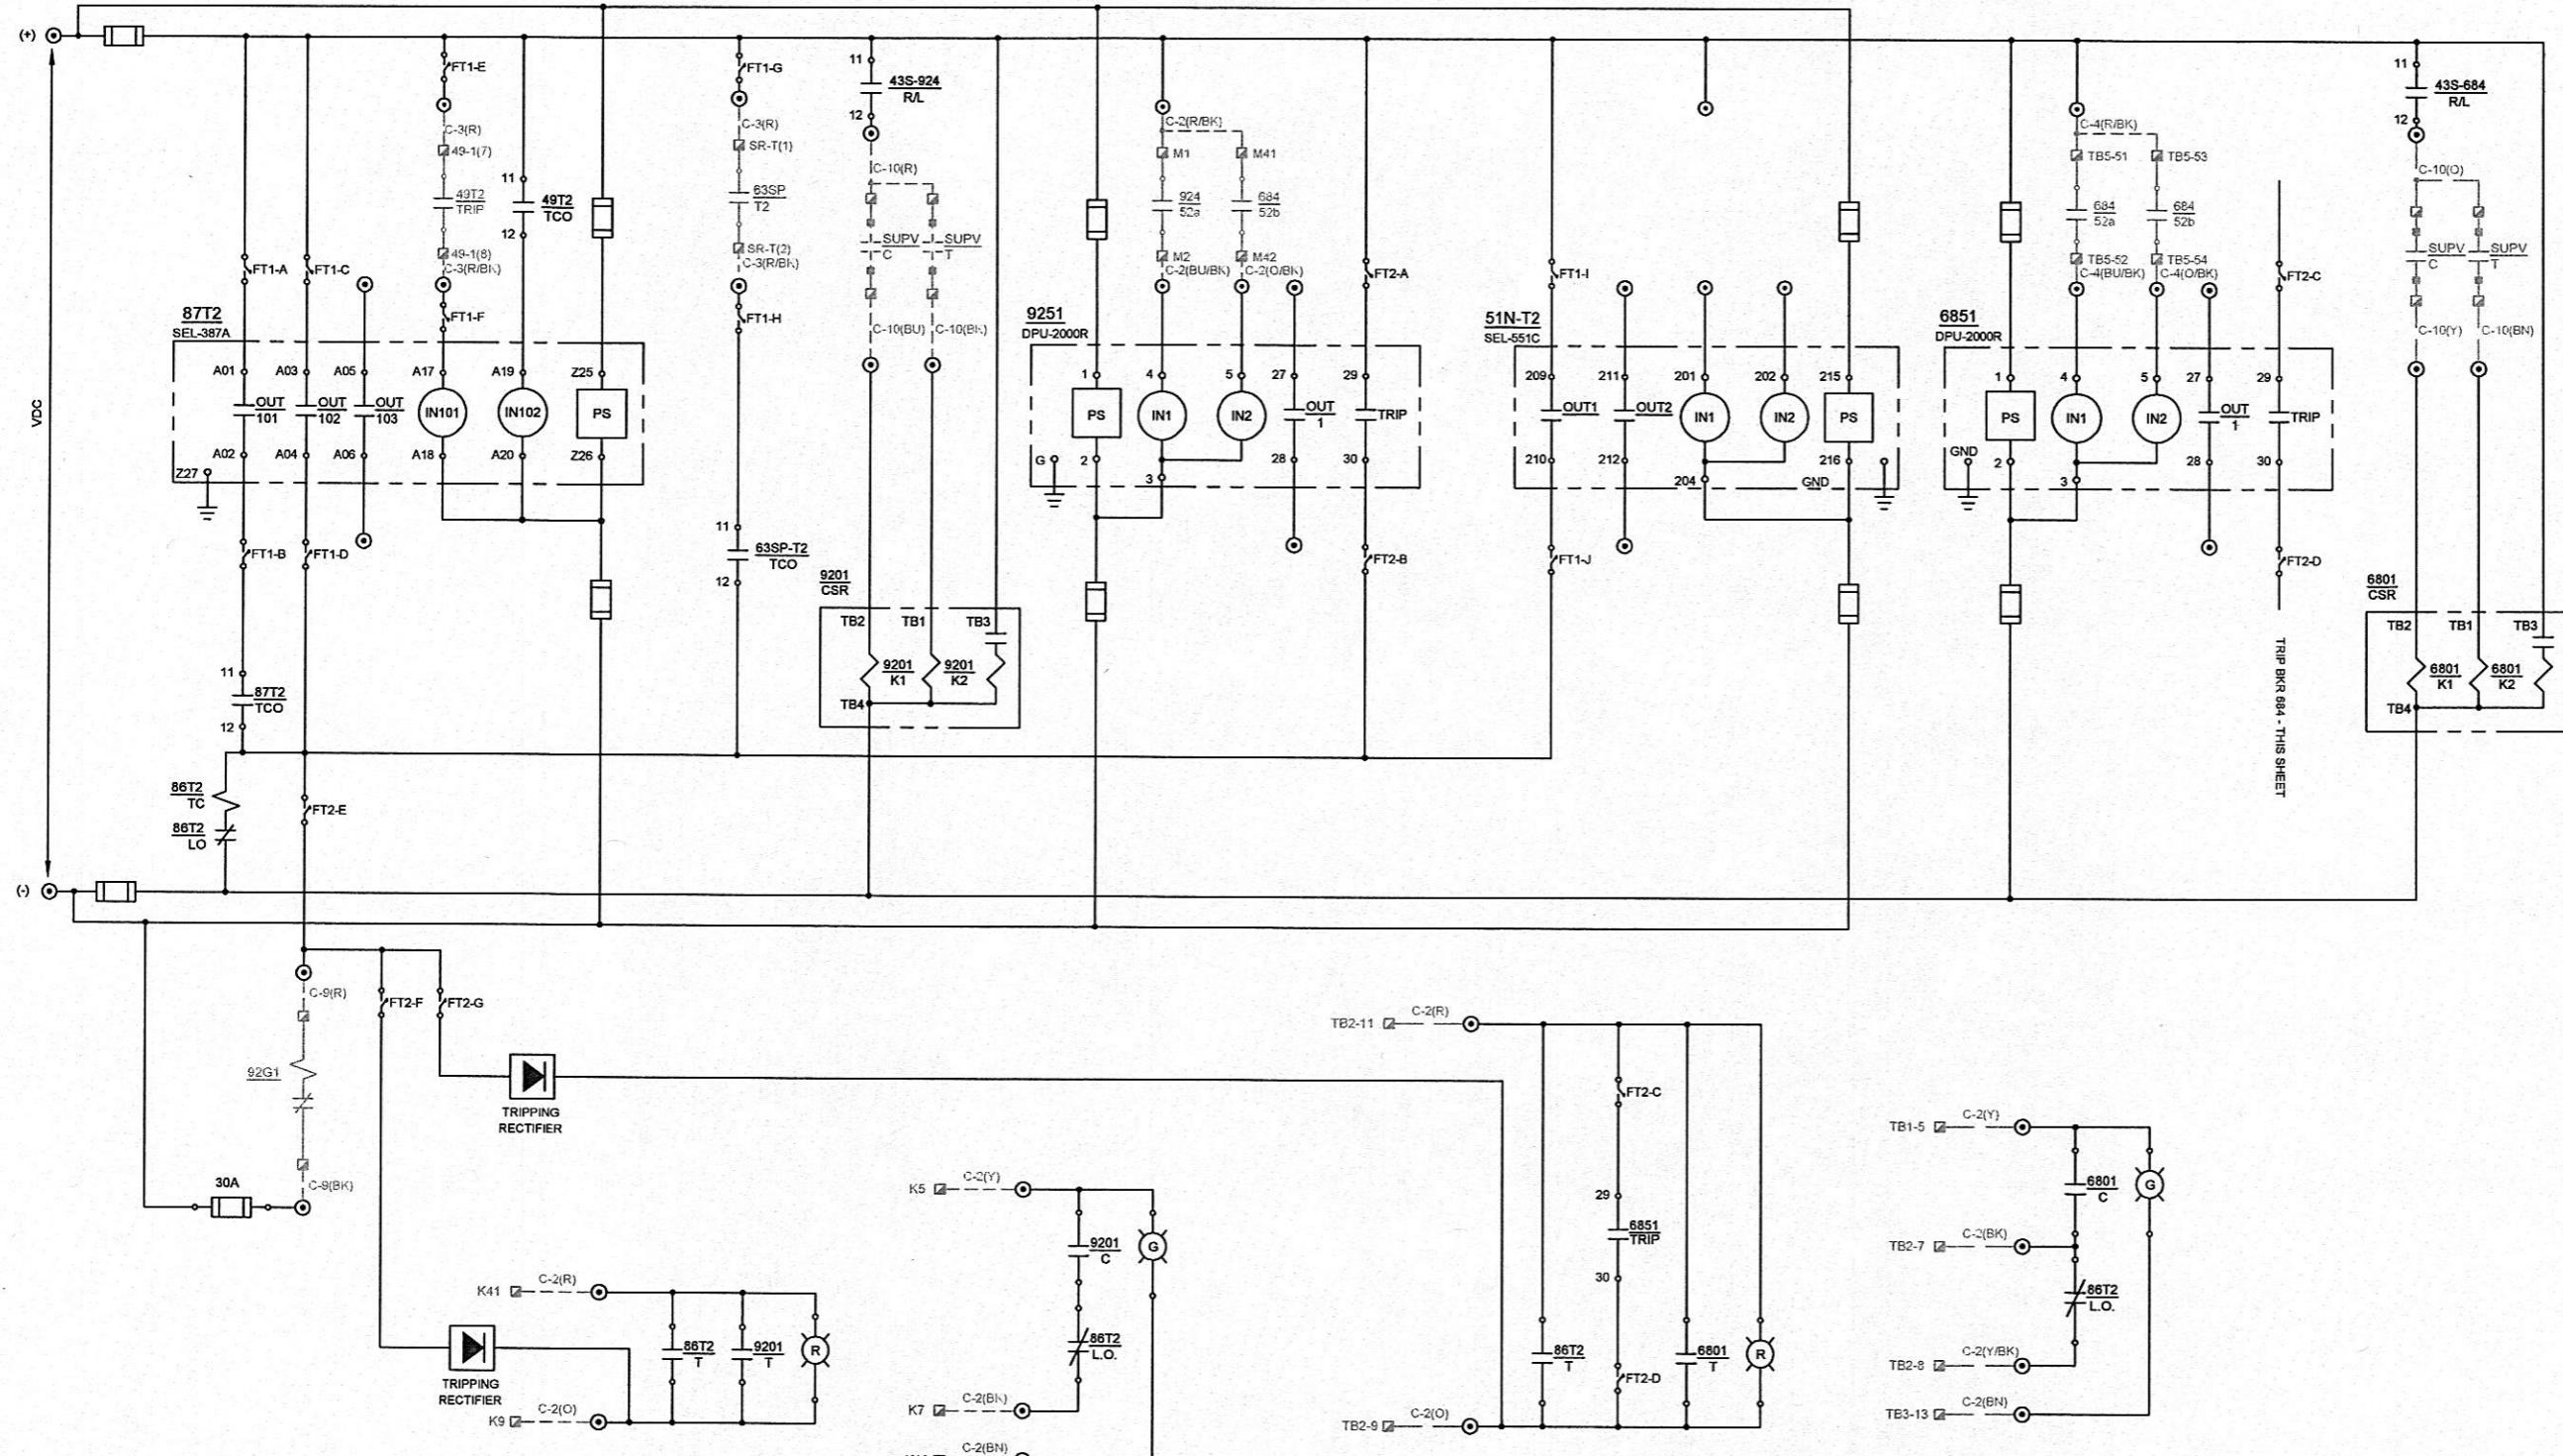

REV	DATE	CHKD	APPD	REVISION DESCRIPTION
2	09-15-10			CONFORMED TO CONSTRUCTION RECORDS FOR PHASE II.
1	8/30/2007			ISSUED FOR CONSTRUCTION

DESIGNED		DRAWN	CONFORMED TO CONSTRUCTION RECORDS	



R.W. Beck, Inc.
400 Professional Park Dr.
Goodlettsville, TN 37072-2100
(615) 859-3900



HARRIMAN UTILITY BOARD
HARRIMAN PRIMARY SUBSTATION
BREAKER CONTROL SCHEME

PROJECT NUMBER:
07-70014-01164-1000
SHEET OF:
1 1
DRAWING NUMBER:
01164-101.2

LEGEND

- ◎ RELAY PANEL TERMINAL BLOCK
- INTERCONNECTIONS BETWEEN RELAY PANELS AND FIELD EQUIPMENT
- RELAY PANEL WIRING
- ☒ FIELD DEVICE TERMINAL BLOCK

TO TVA

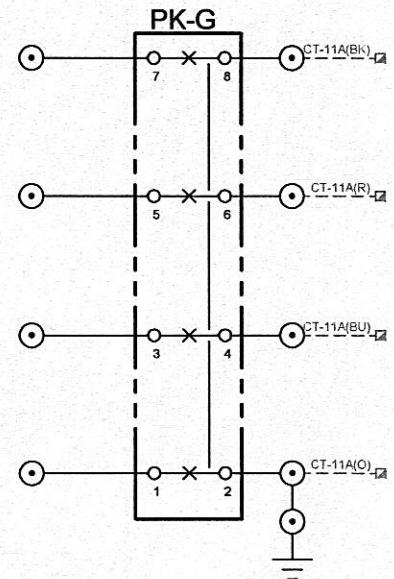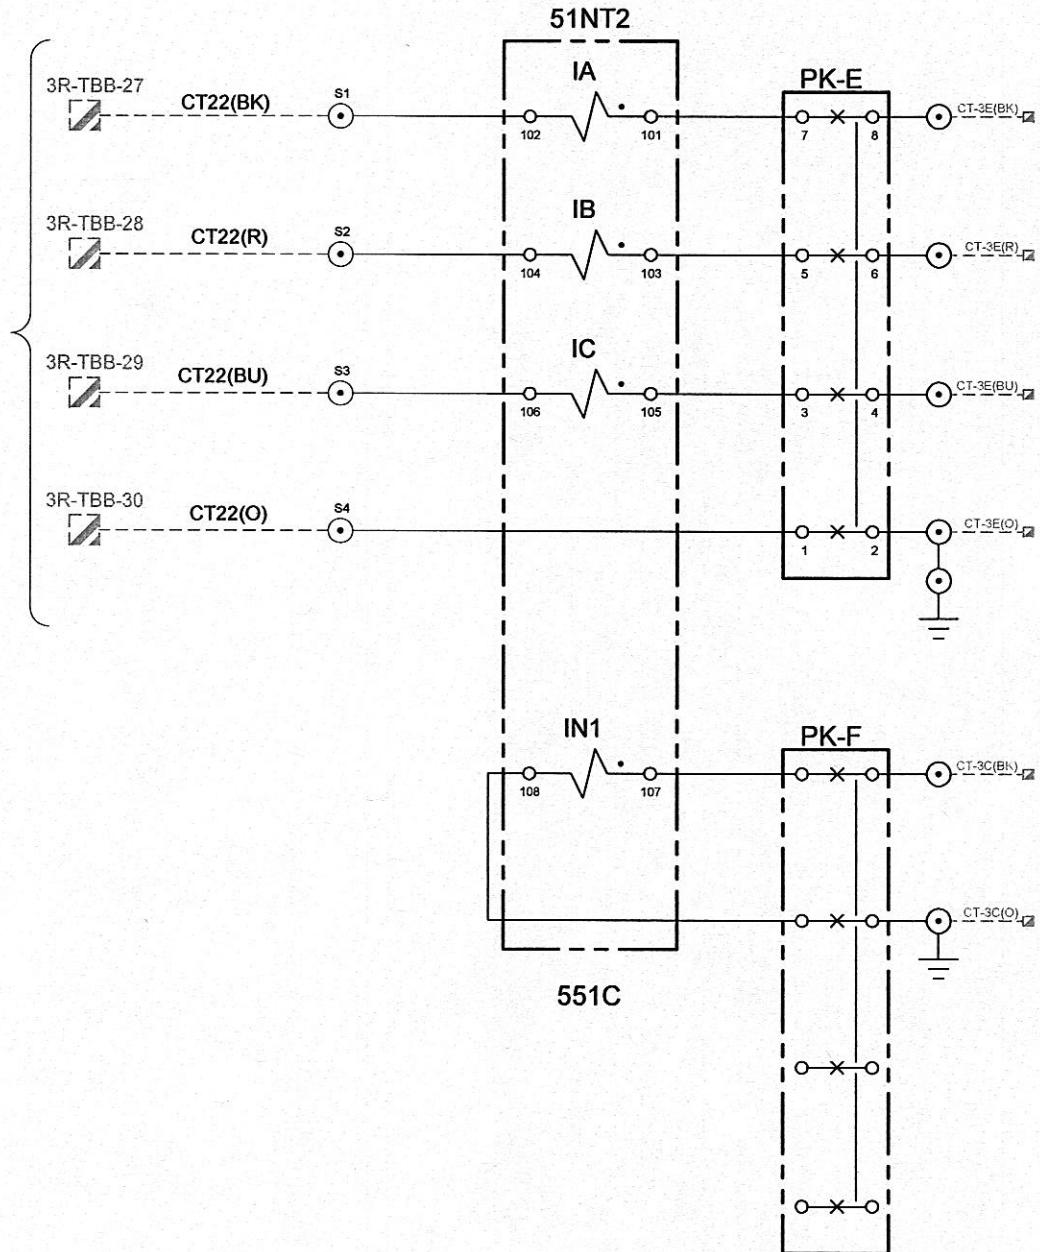

REV	DATE	CHKD	APPD	REVISION DESCRIPTION
2	09-15-10			CONFORMED TO CONSTRUCTION RECORDS.
1	2/25/10			REVISED FOR PHASE II
0	8/30/2007			ISSUED FOR CONSTRUCTION

DESIGNED
DRAWN

CONFORMED TO CONSTRUCTION RECORDS




R.W. Beck, Inc.
400 Professional Park Dr.
Goodlettsville, TN 37072-2100
(615) 859-3900

HARRIMAN UTILITY BOARD
HARRIMAN PRIMARY SUBSTATION
CURRENT ELEMENTARIES


PROJECT NUMBER:
07-70014-01164-1000
SHEET OF:
2 2
DRAWING NUMBER:
01164-104.2

LEGEND

- ◎ RELAY PANEL TERMINAL BLOCK
- INTERCONNECTIONS BETWEEN RELAY PANELS AND FIELD EQUIPMENT
- RELAY PANEL WIRING
- FIELD DEVICE TERMINAL BLOCK

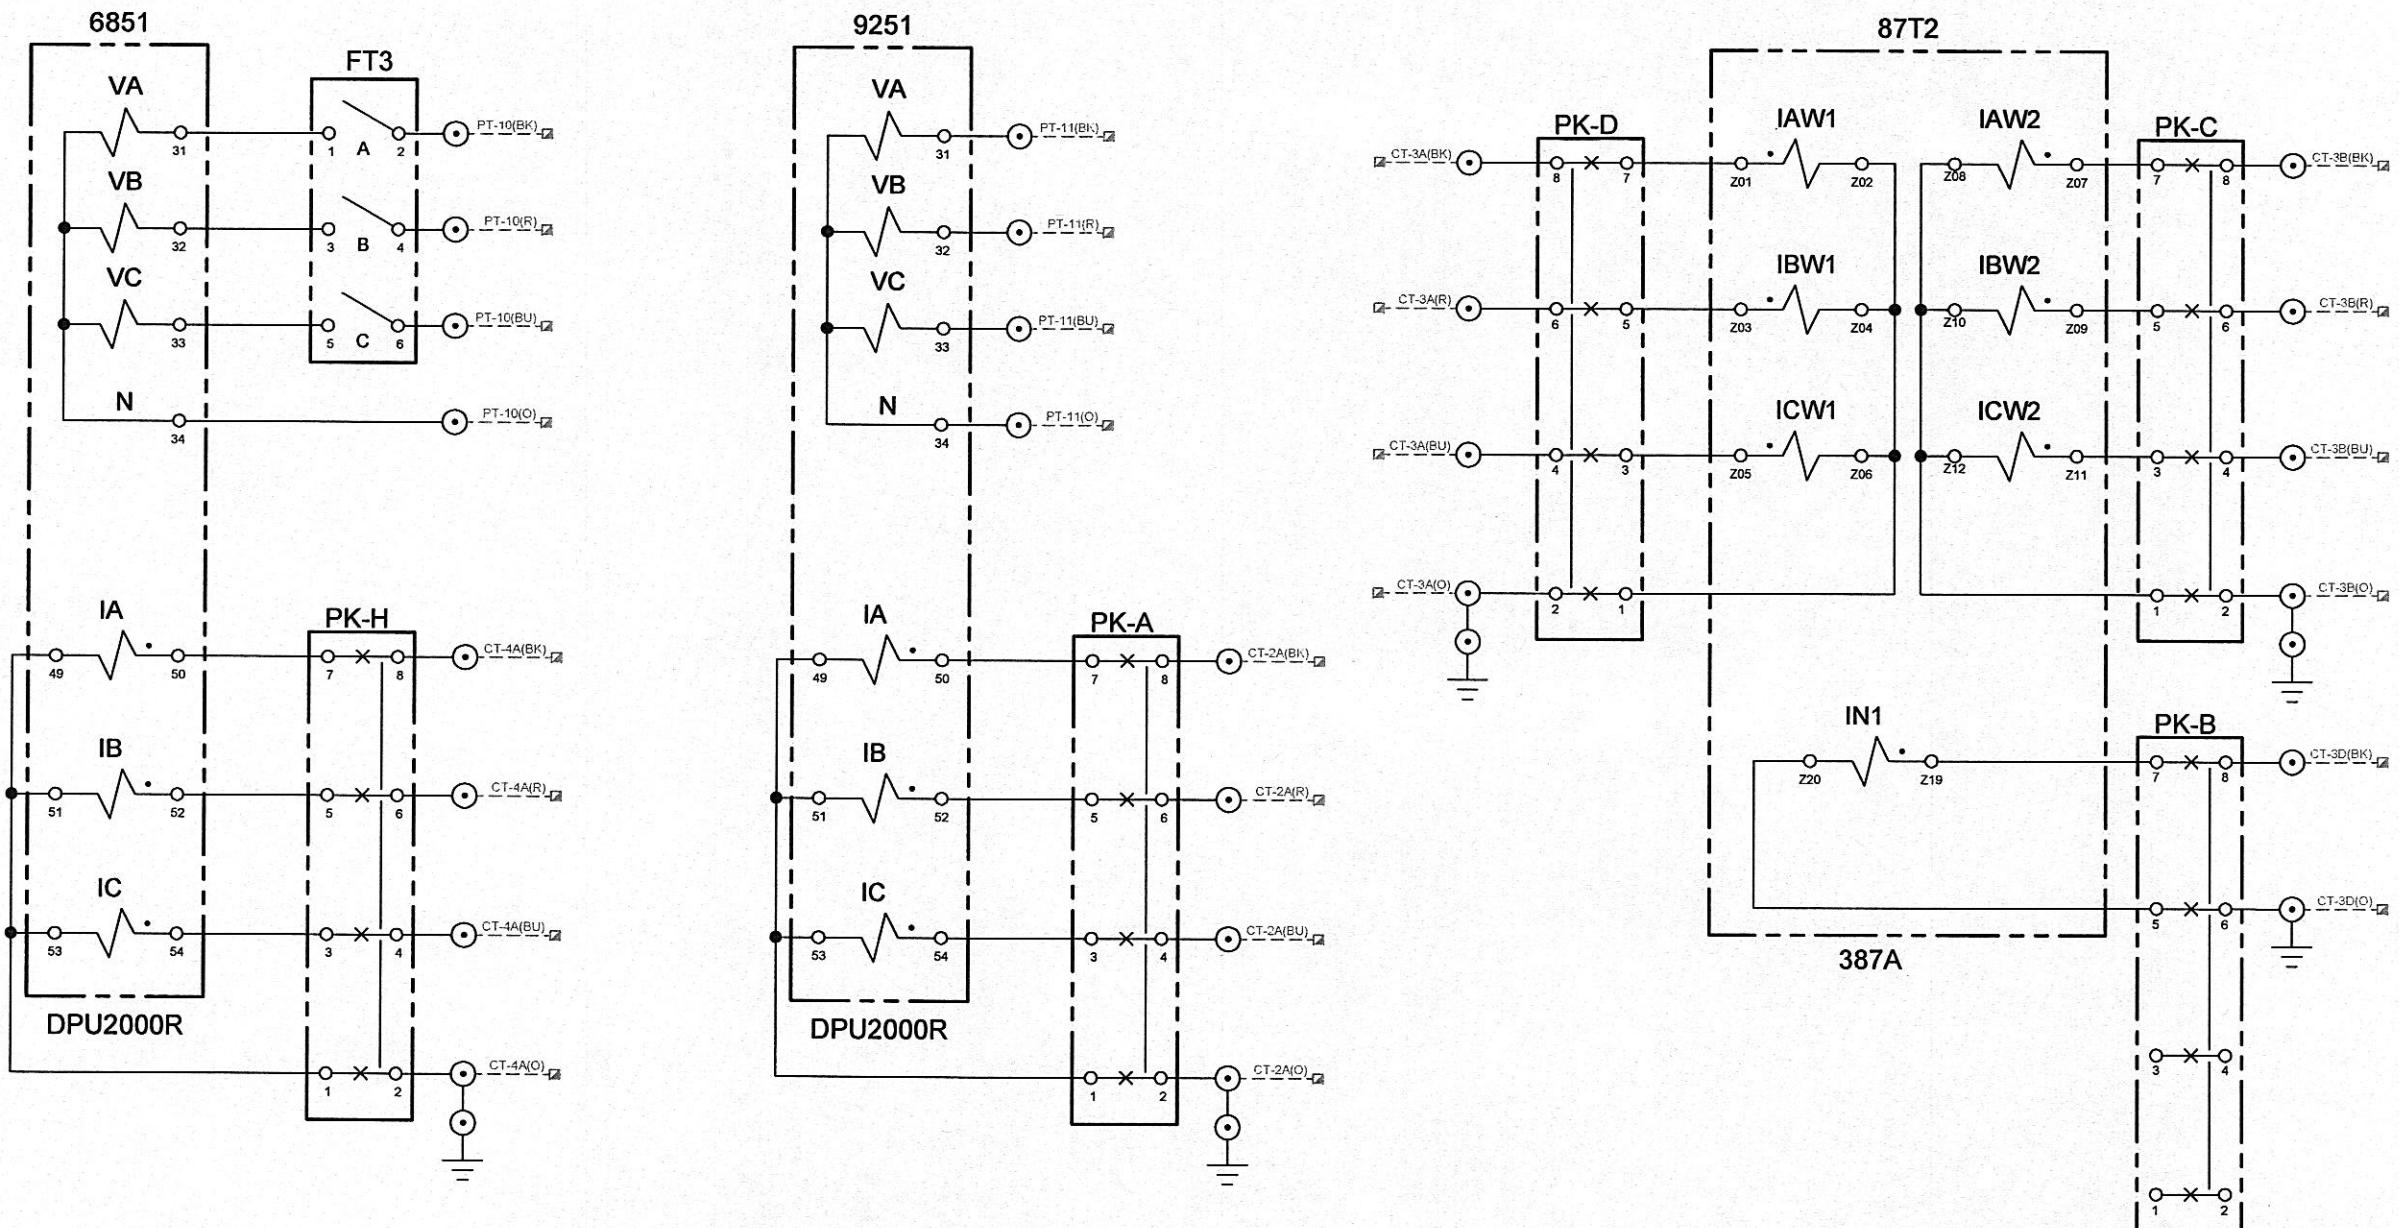

				DESIGNED	CONFORMED TO CONSTRUCTION RECORDS	R.W. Beck, Inc. 400 Professional Park Dr. Goodlettsville, TN 37072-2100 (615) 859-3900	HARRIMAN UTILITY BOARD HARRIMAN PRIMARY SUBSTATION CURRENT ELEMENTARIES	PROJECT NUMBER: 07-70014-01164-1000
REV	DATE	CHKD	APPD	DRAWN				SHEET OF: 1 2
1	09-15-10				CONFORMED TO CONSTRUCTION RECORDS FOR PHASE II.			DRAWING NUMBER: 01164-103.1
0	8/30/2007				ISSUED FOR CONSTRUCTION			
REV	DATE	CHKD	APPD		REVISION DESCRIPTION			

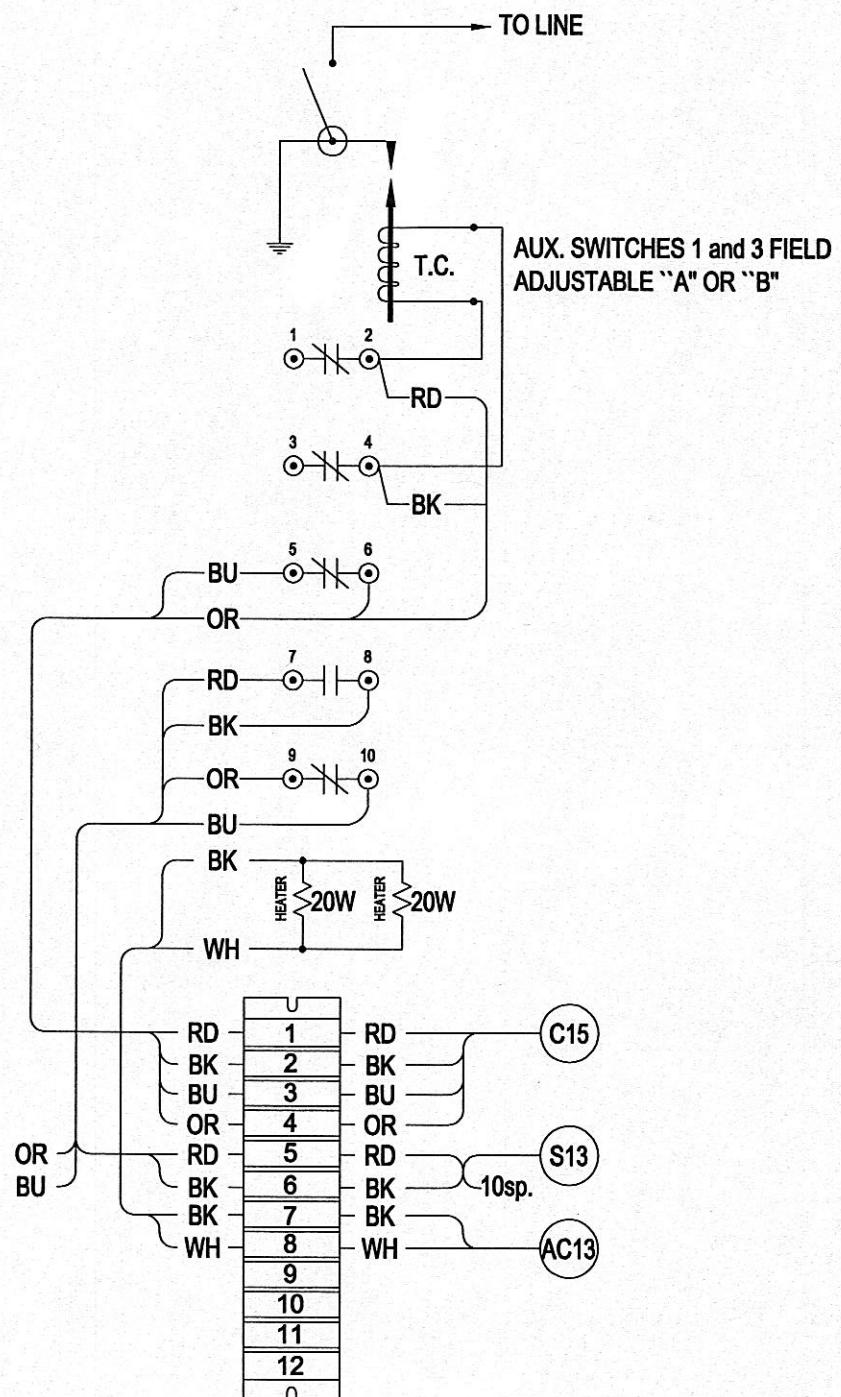

PLOT: 930/2010 WALESRA - SAVILLE				
2	09-15-10	CONFORMED TO CONSTRUCTION RECORDS.		
1	03-04-10	ISSUED FOR CONSTRUCTION.		
0				
REV	DATE	CHK'D	APPD	REVISION DESCRIPTION

DES

1

DR

1

1

CONFORMED TO CONSTRUCTION RECORDS



R.W. Beck
131 Saundersville Rd., Suite 300
Hendersonville, TN 37075
(615) 431-3200

**HARRIMAN UTILITY BOARD
HARRIMAN PRIMARY SUBSTATION
GROUND SWITCH 91G1
CONNECTION DIAGRAM**

PROJECT NUMBER:
07-70014-01317-1000

SHEET OF:
1 1

DRAWING NUMBER:
01317-802