




CONTROL CABINET REAR PANEL

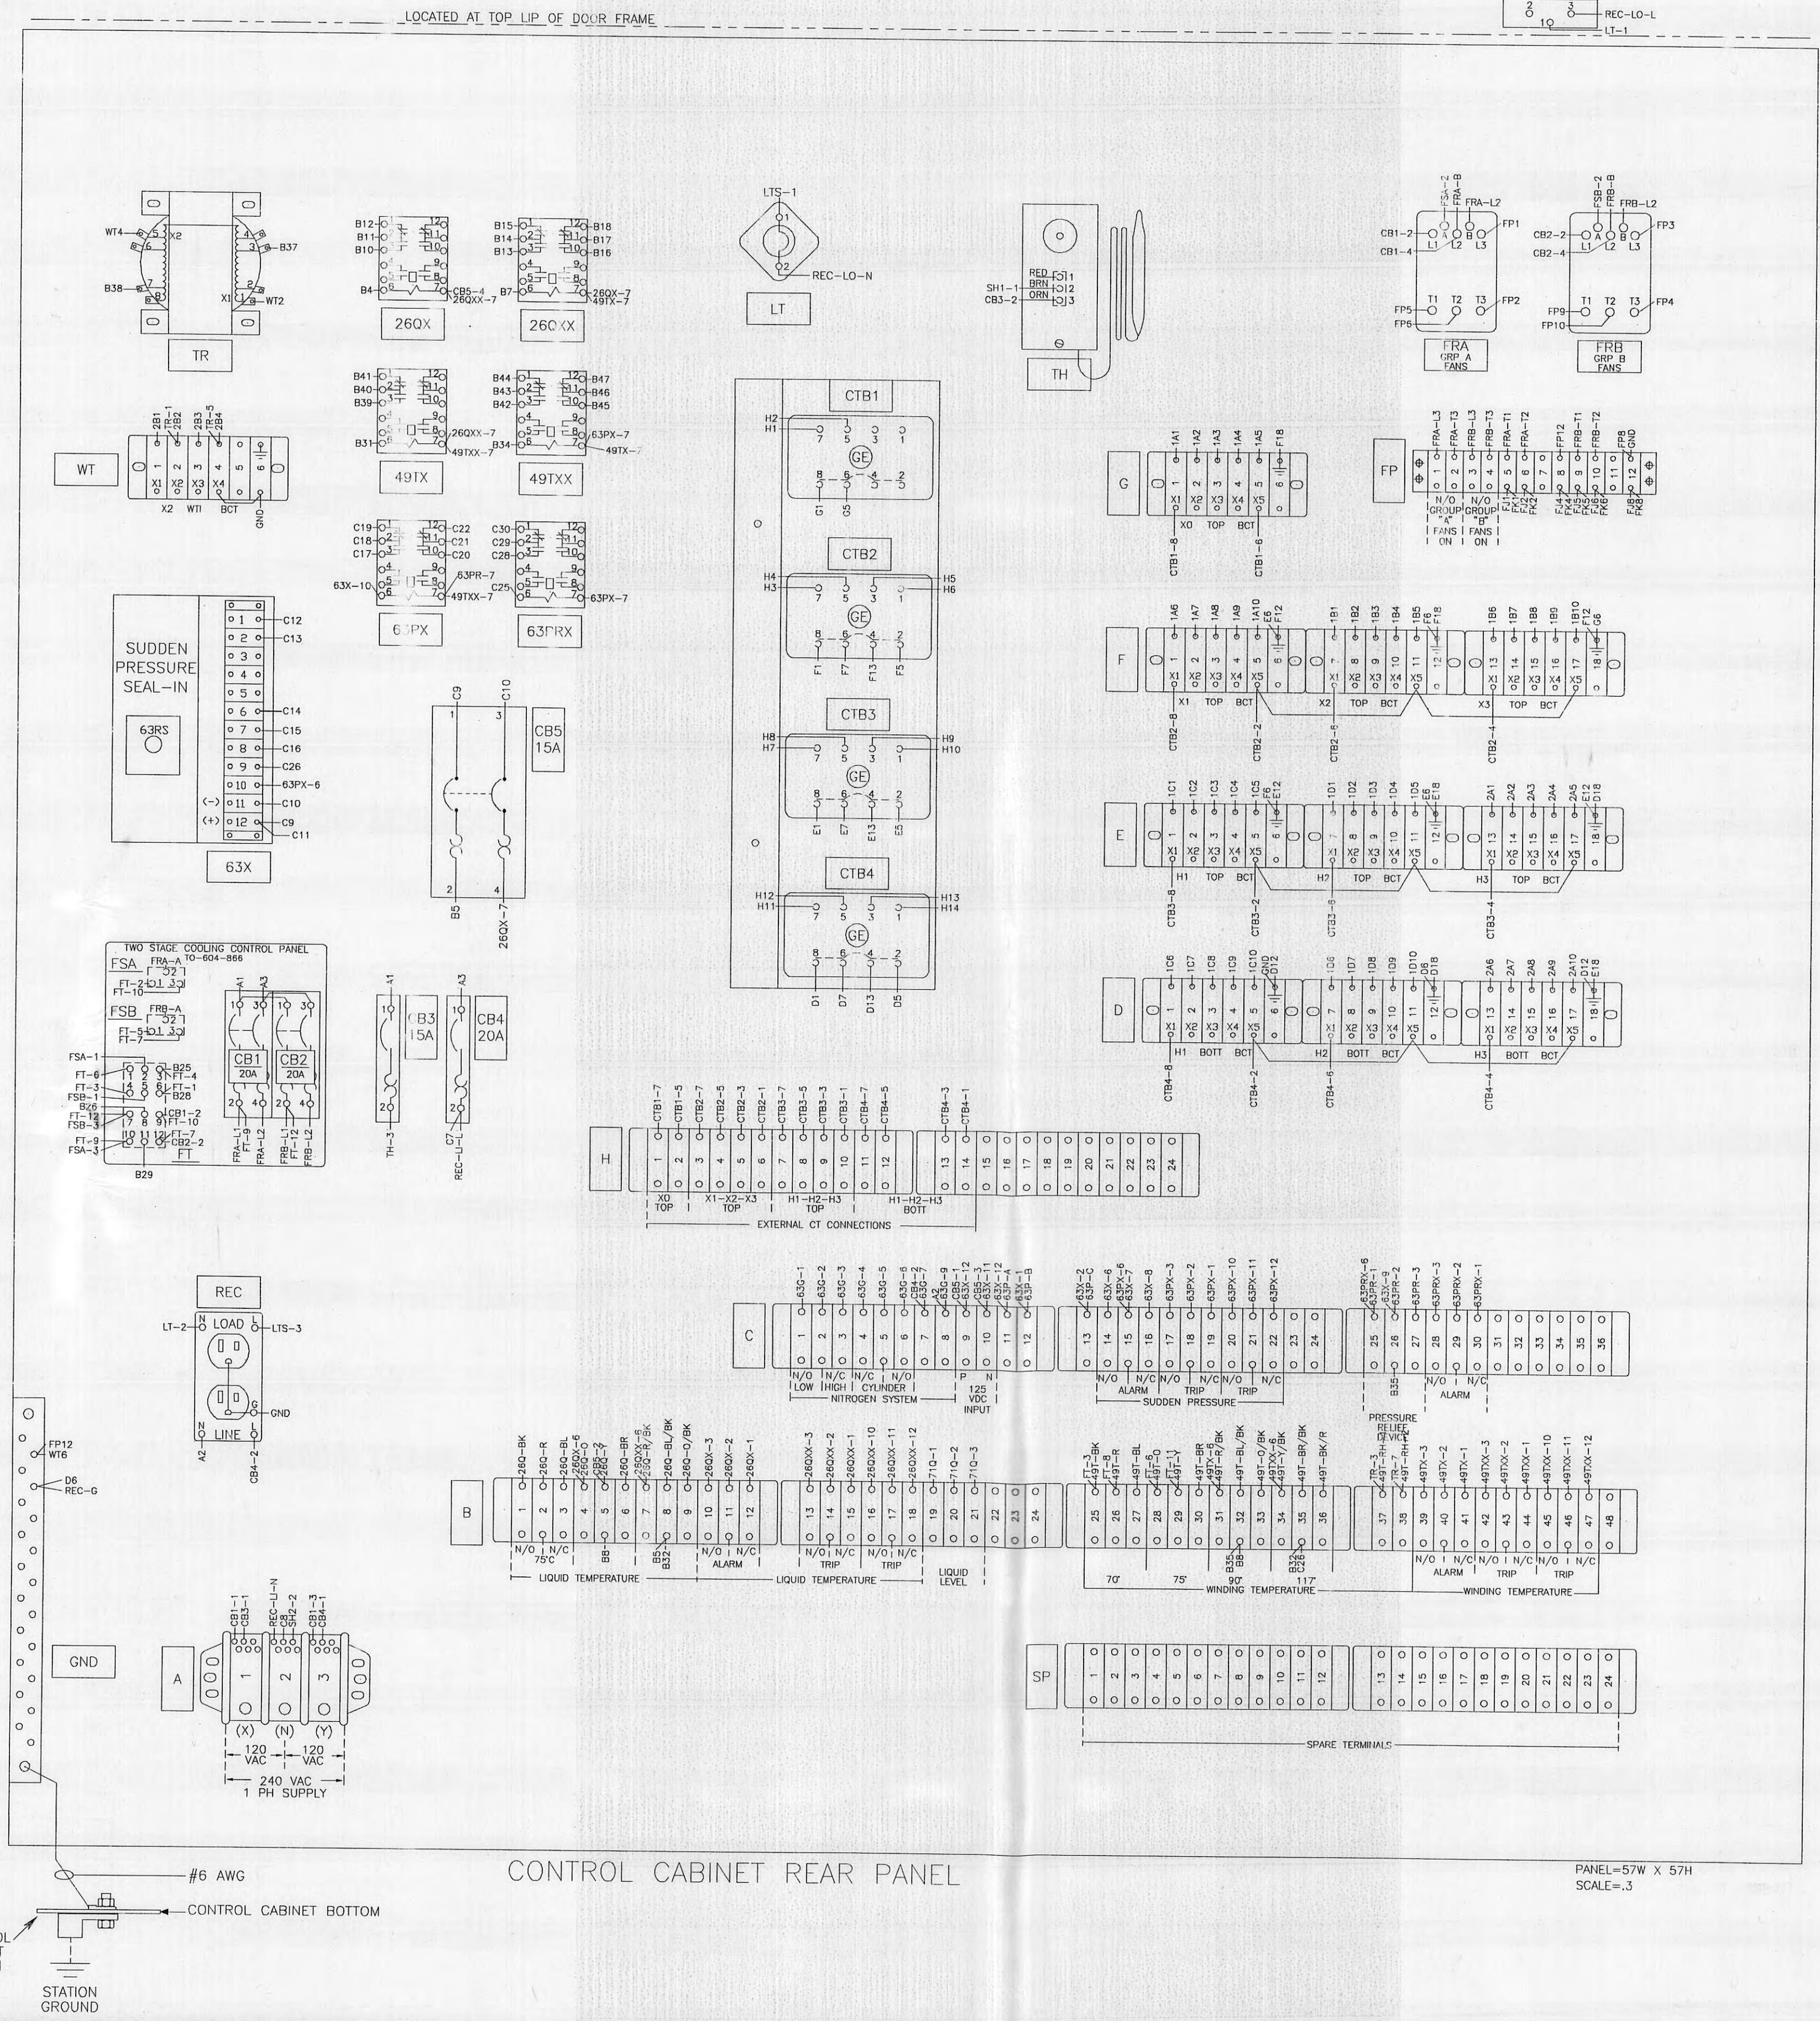


CONTROL CABINET REAR PANEL

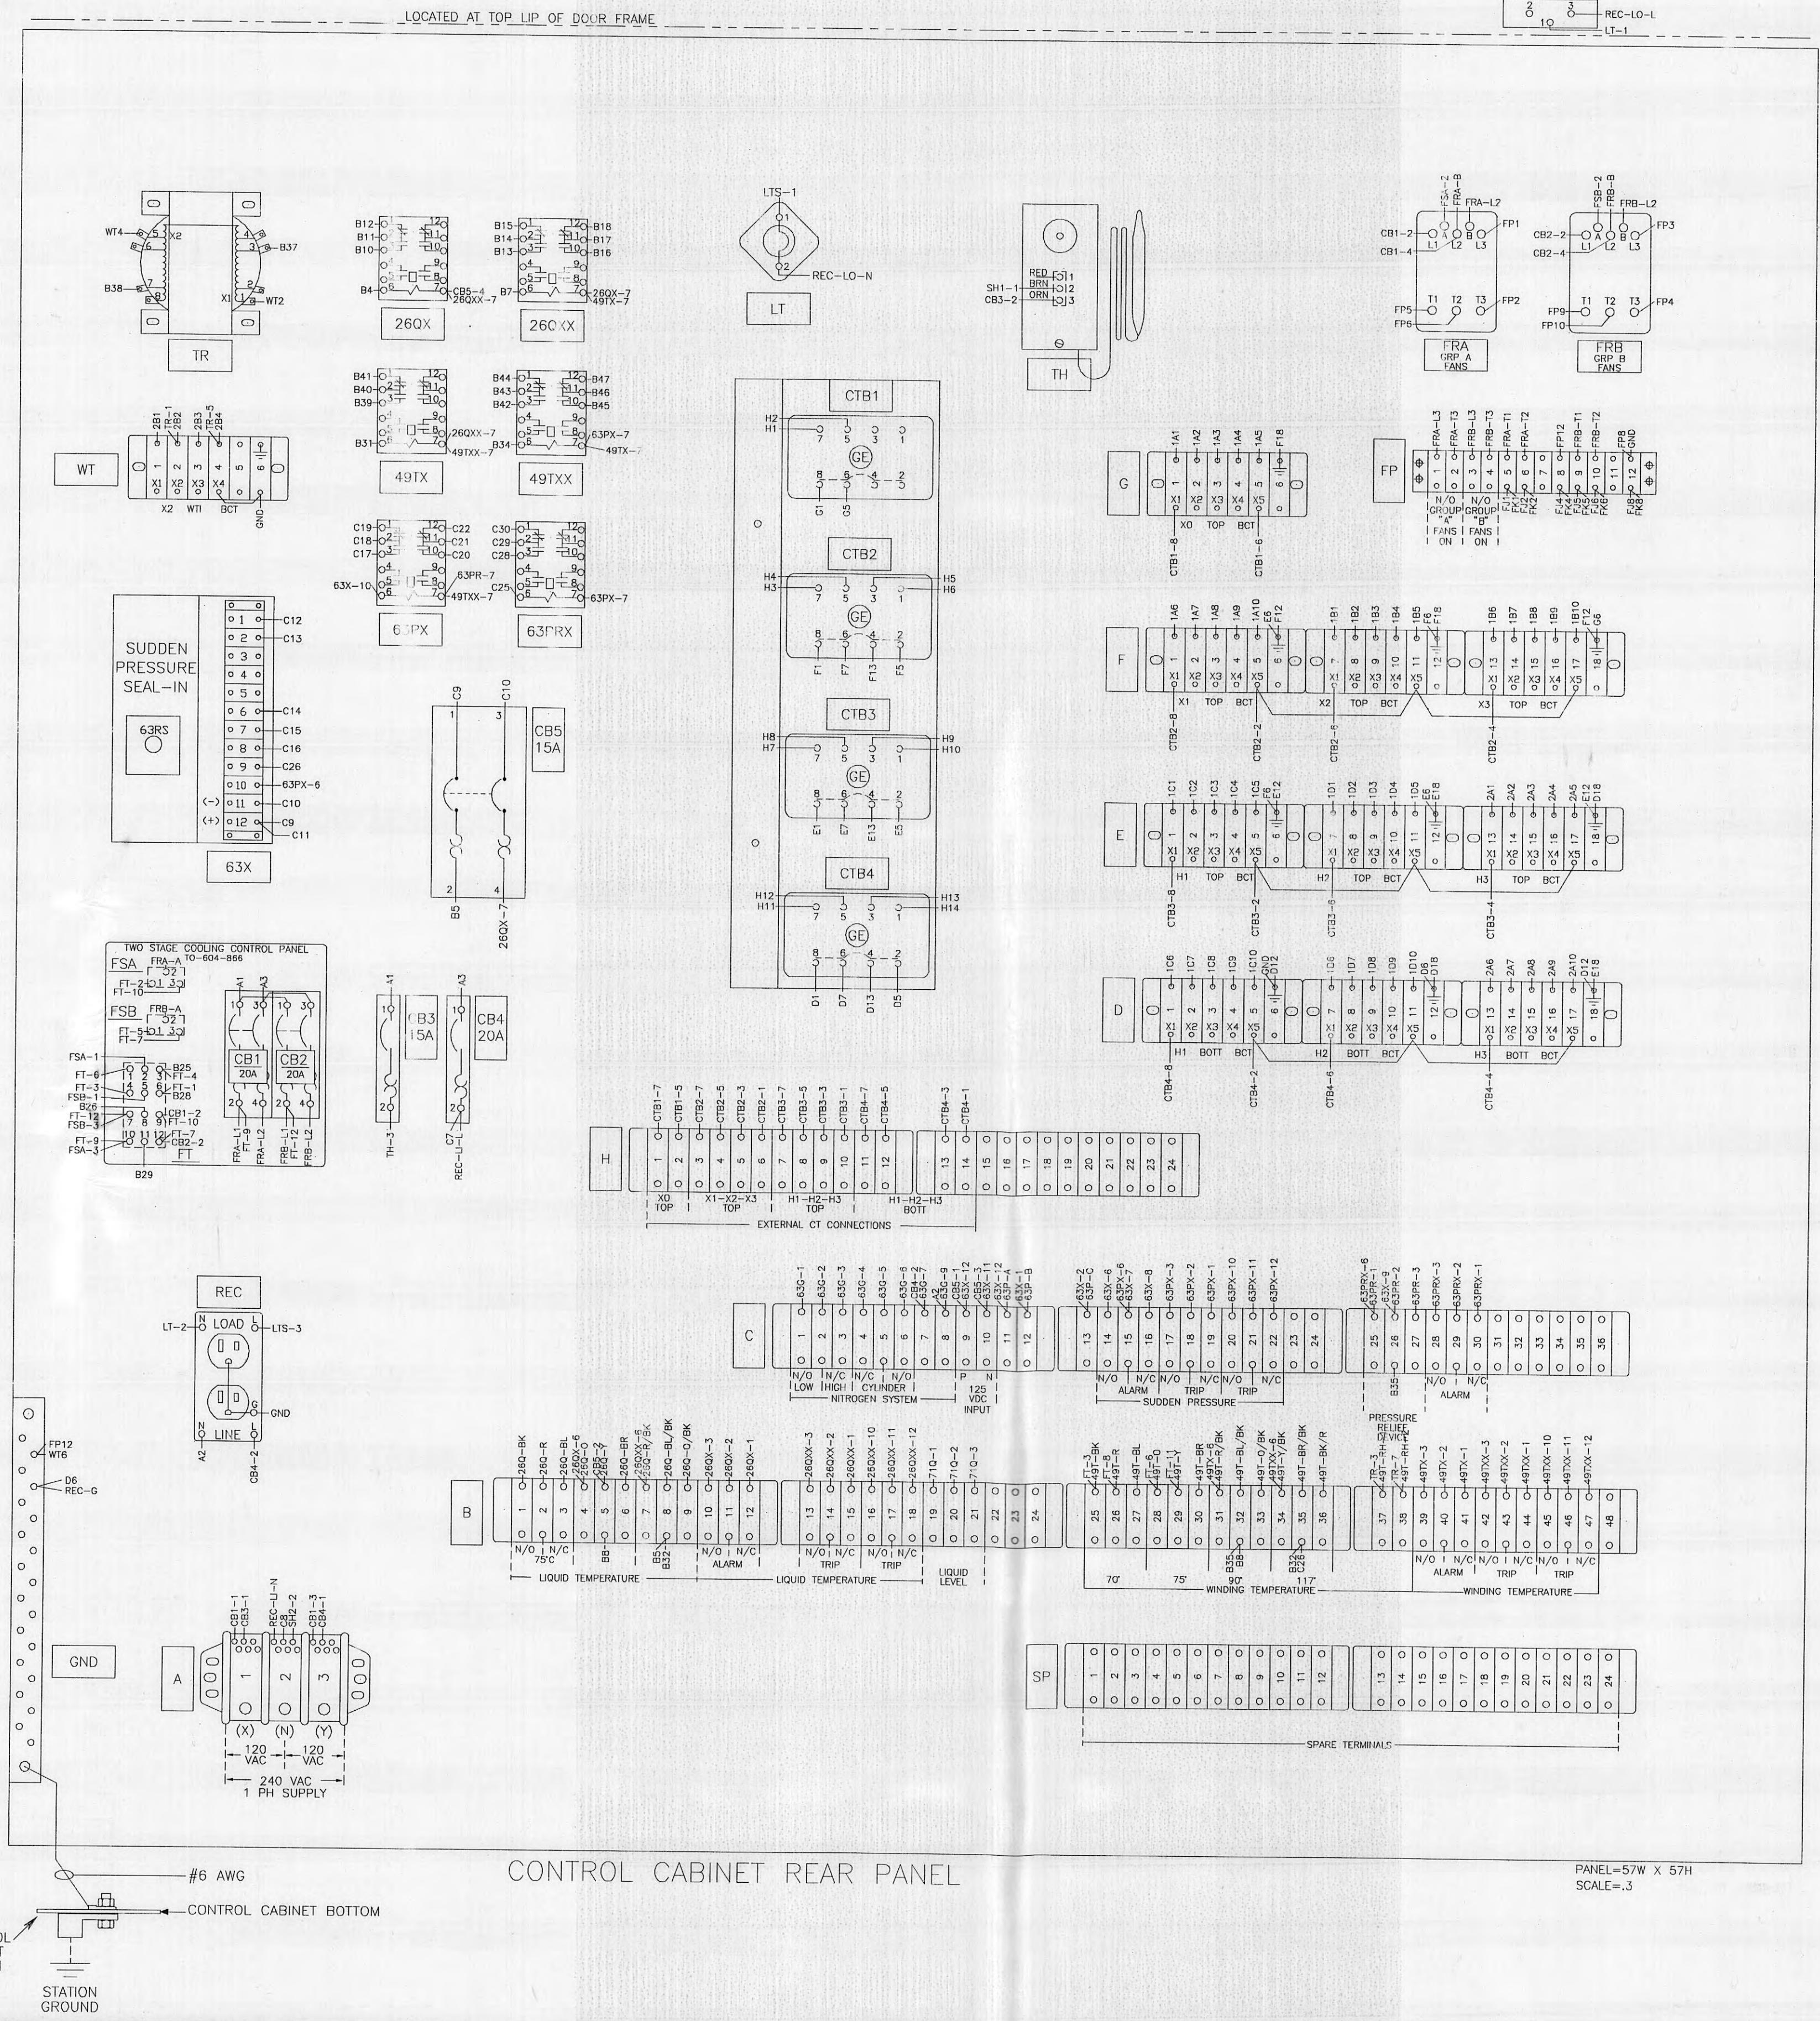


CONTROL CABINET BOTTOM

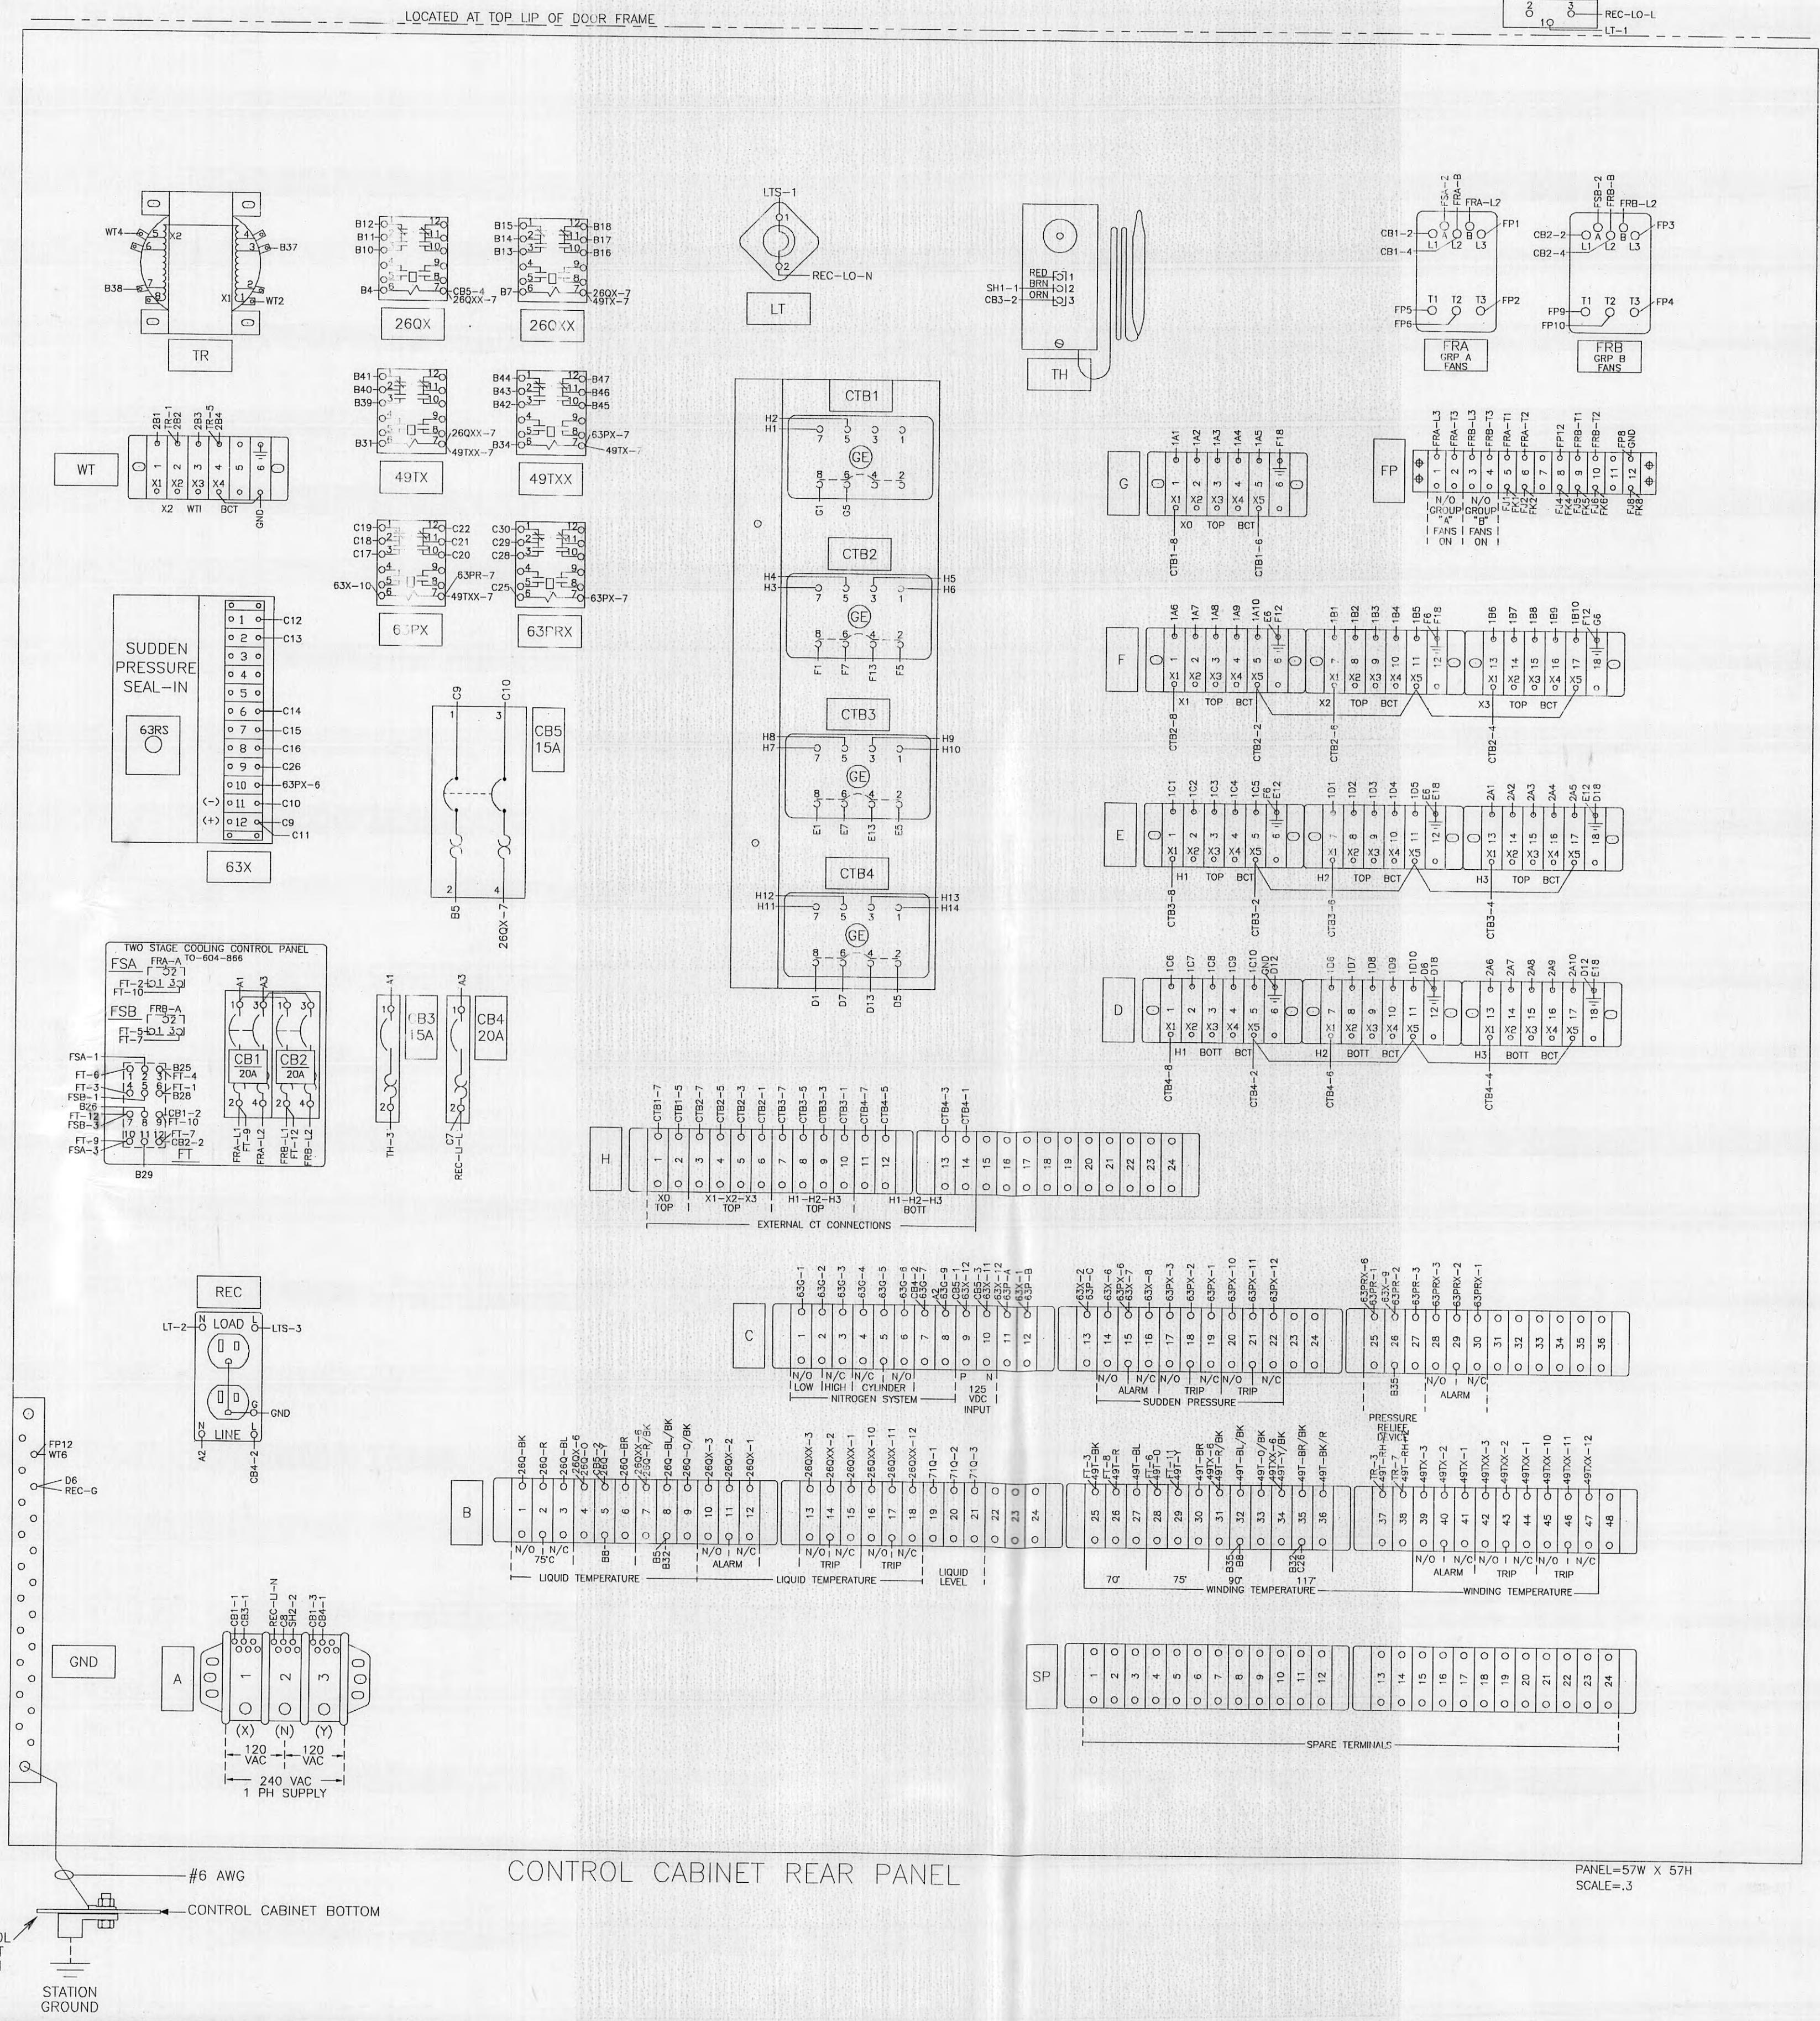


CONTROL CABINET BOTTOM

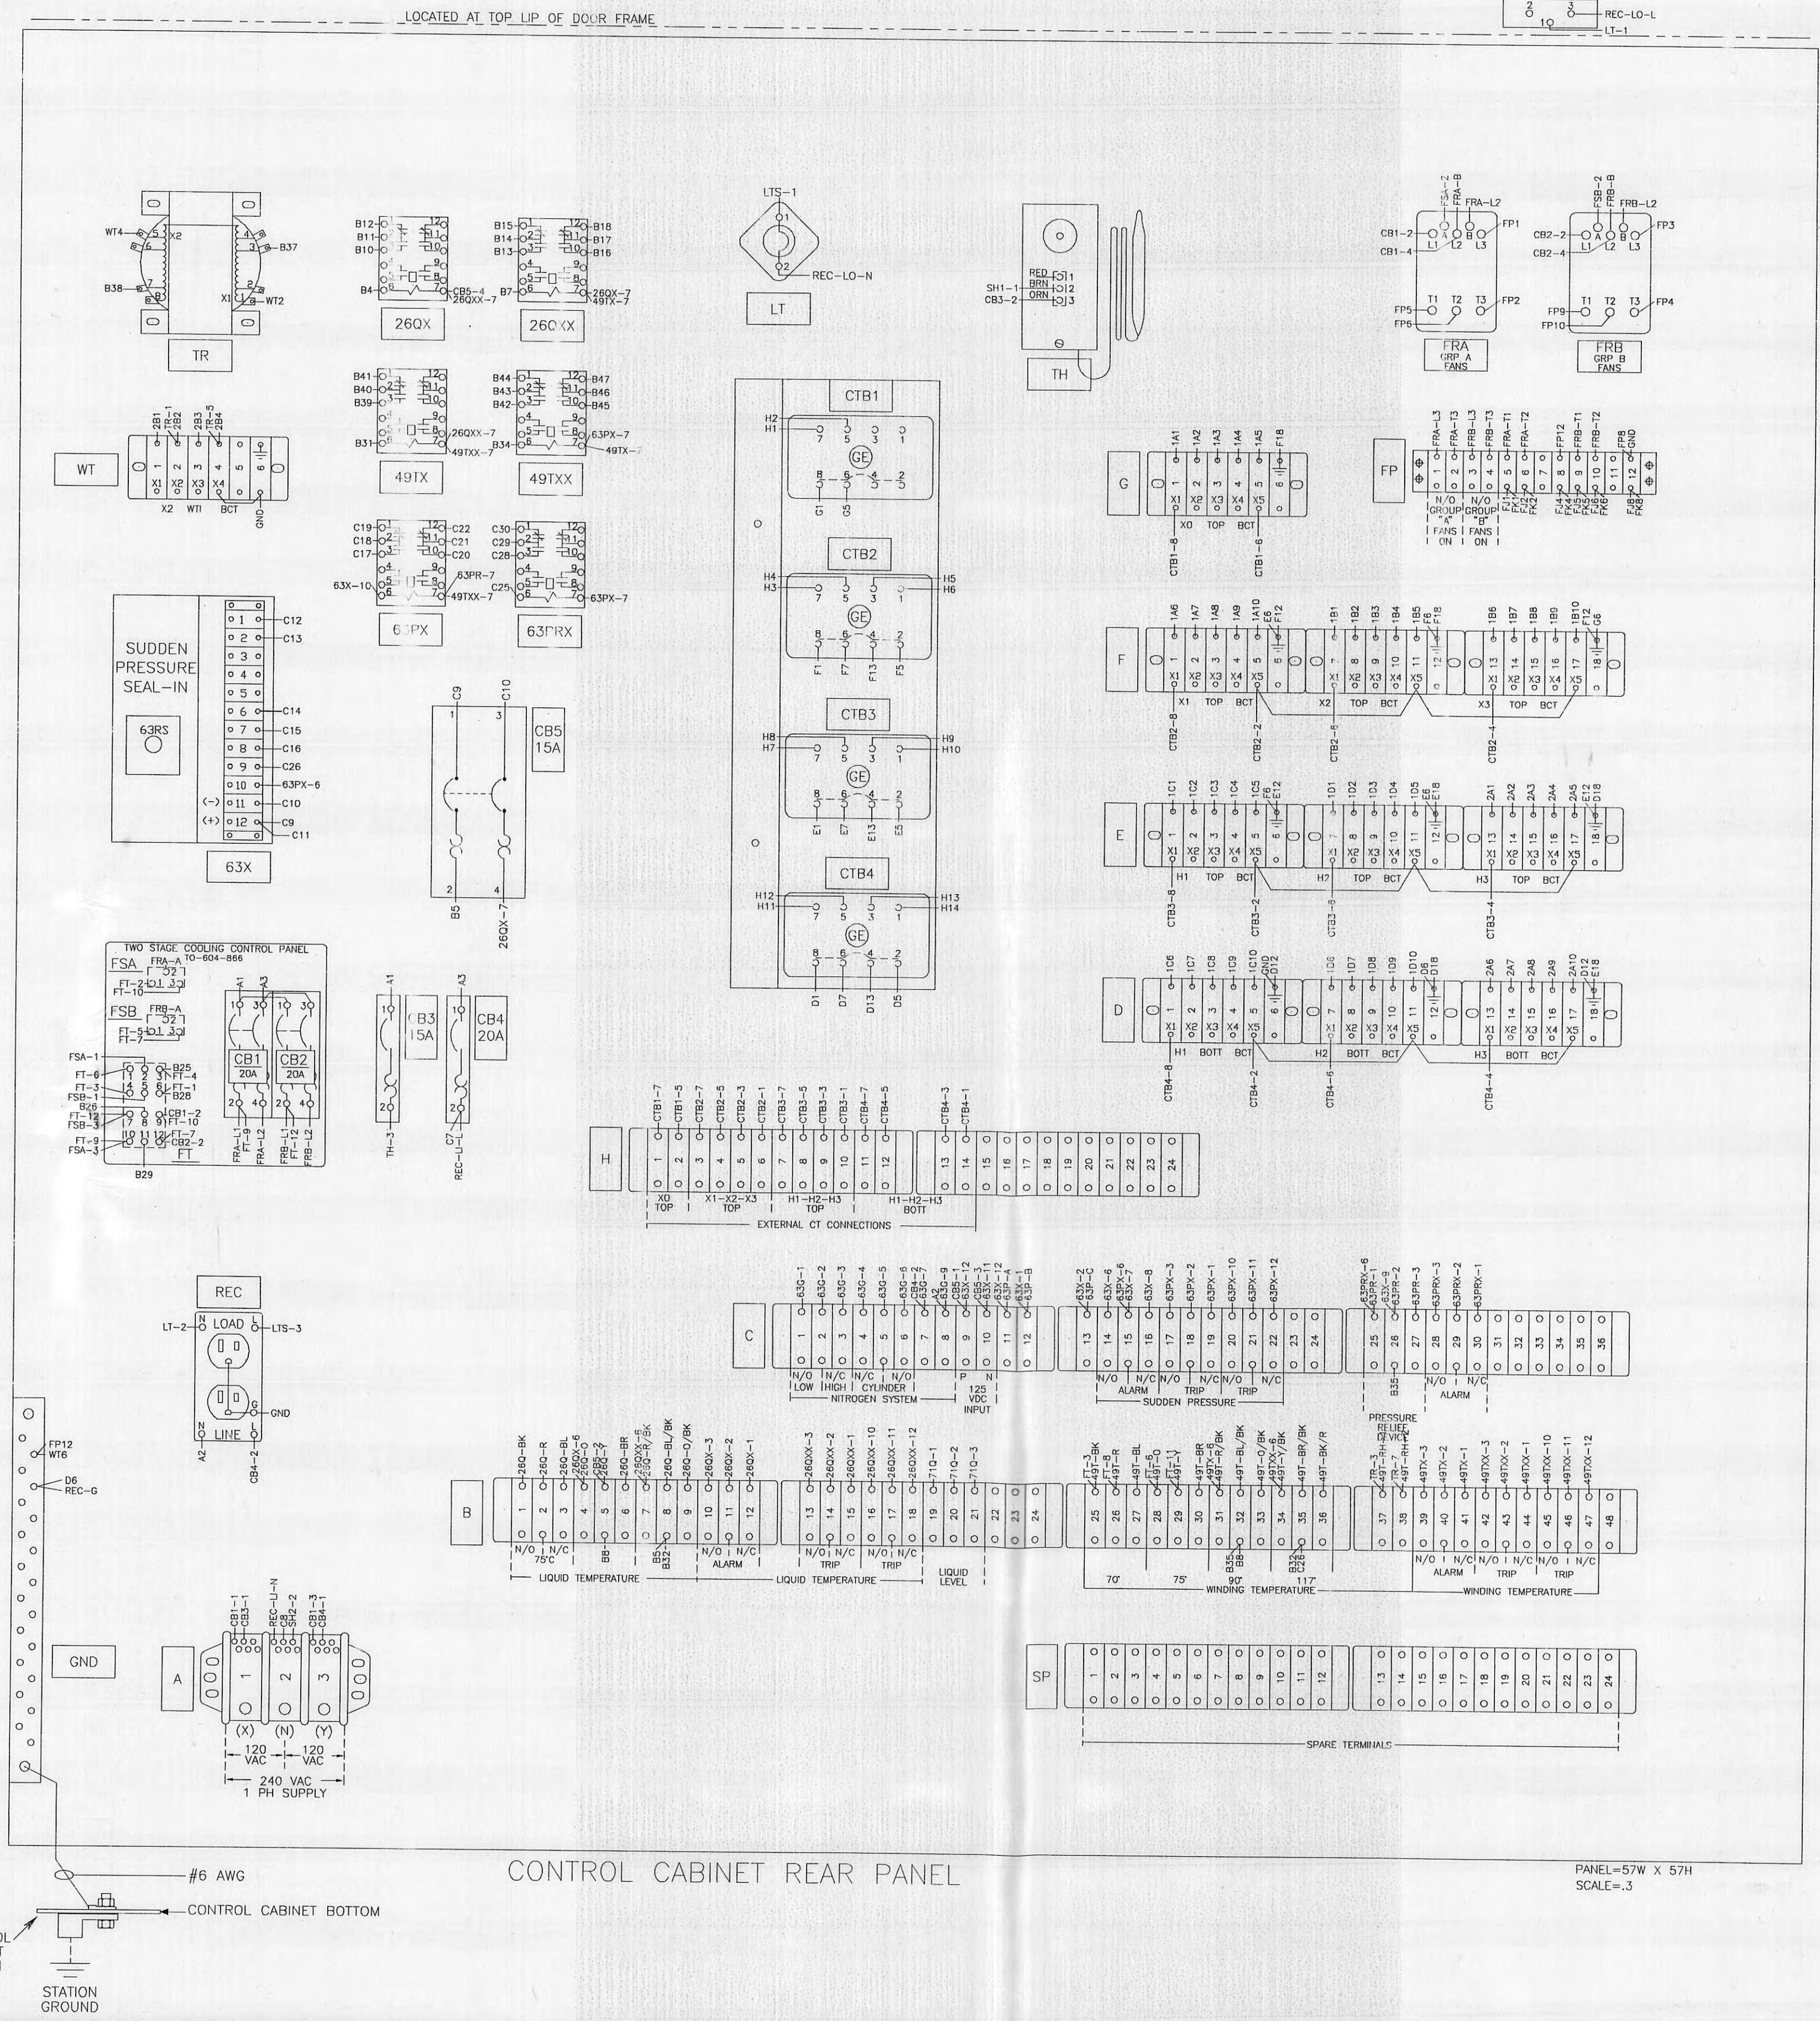


CONTROL CABINET BOTTOM

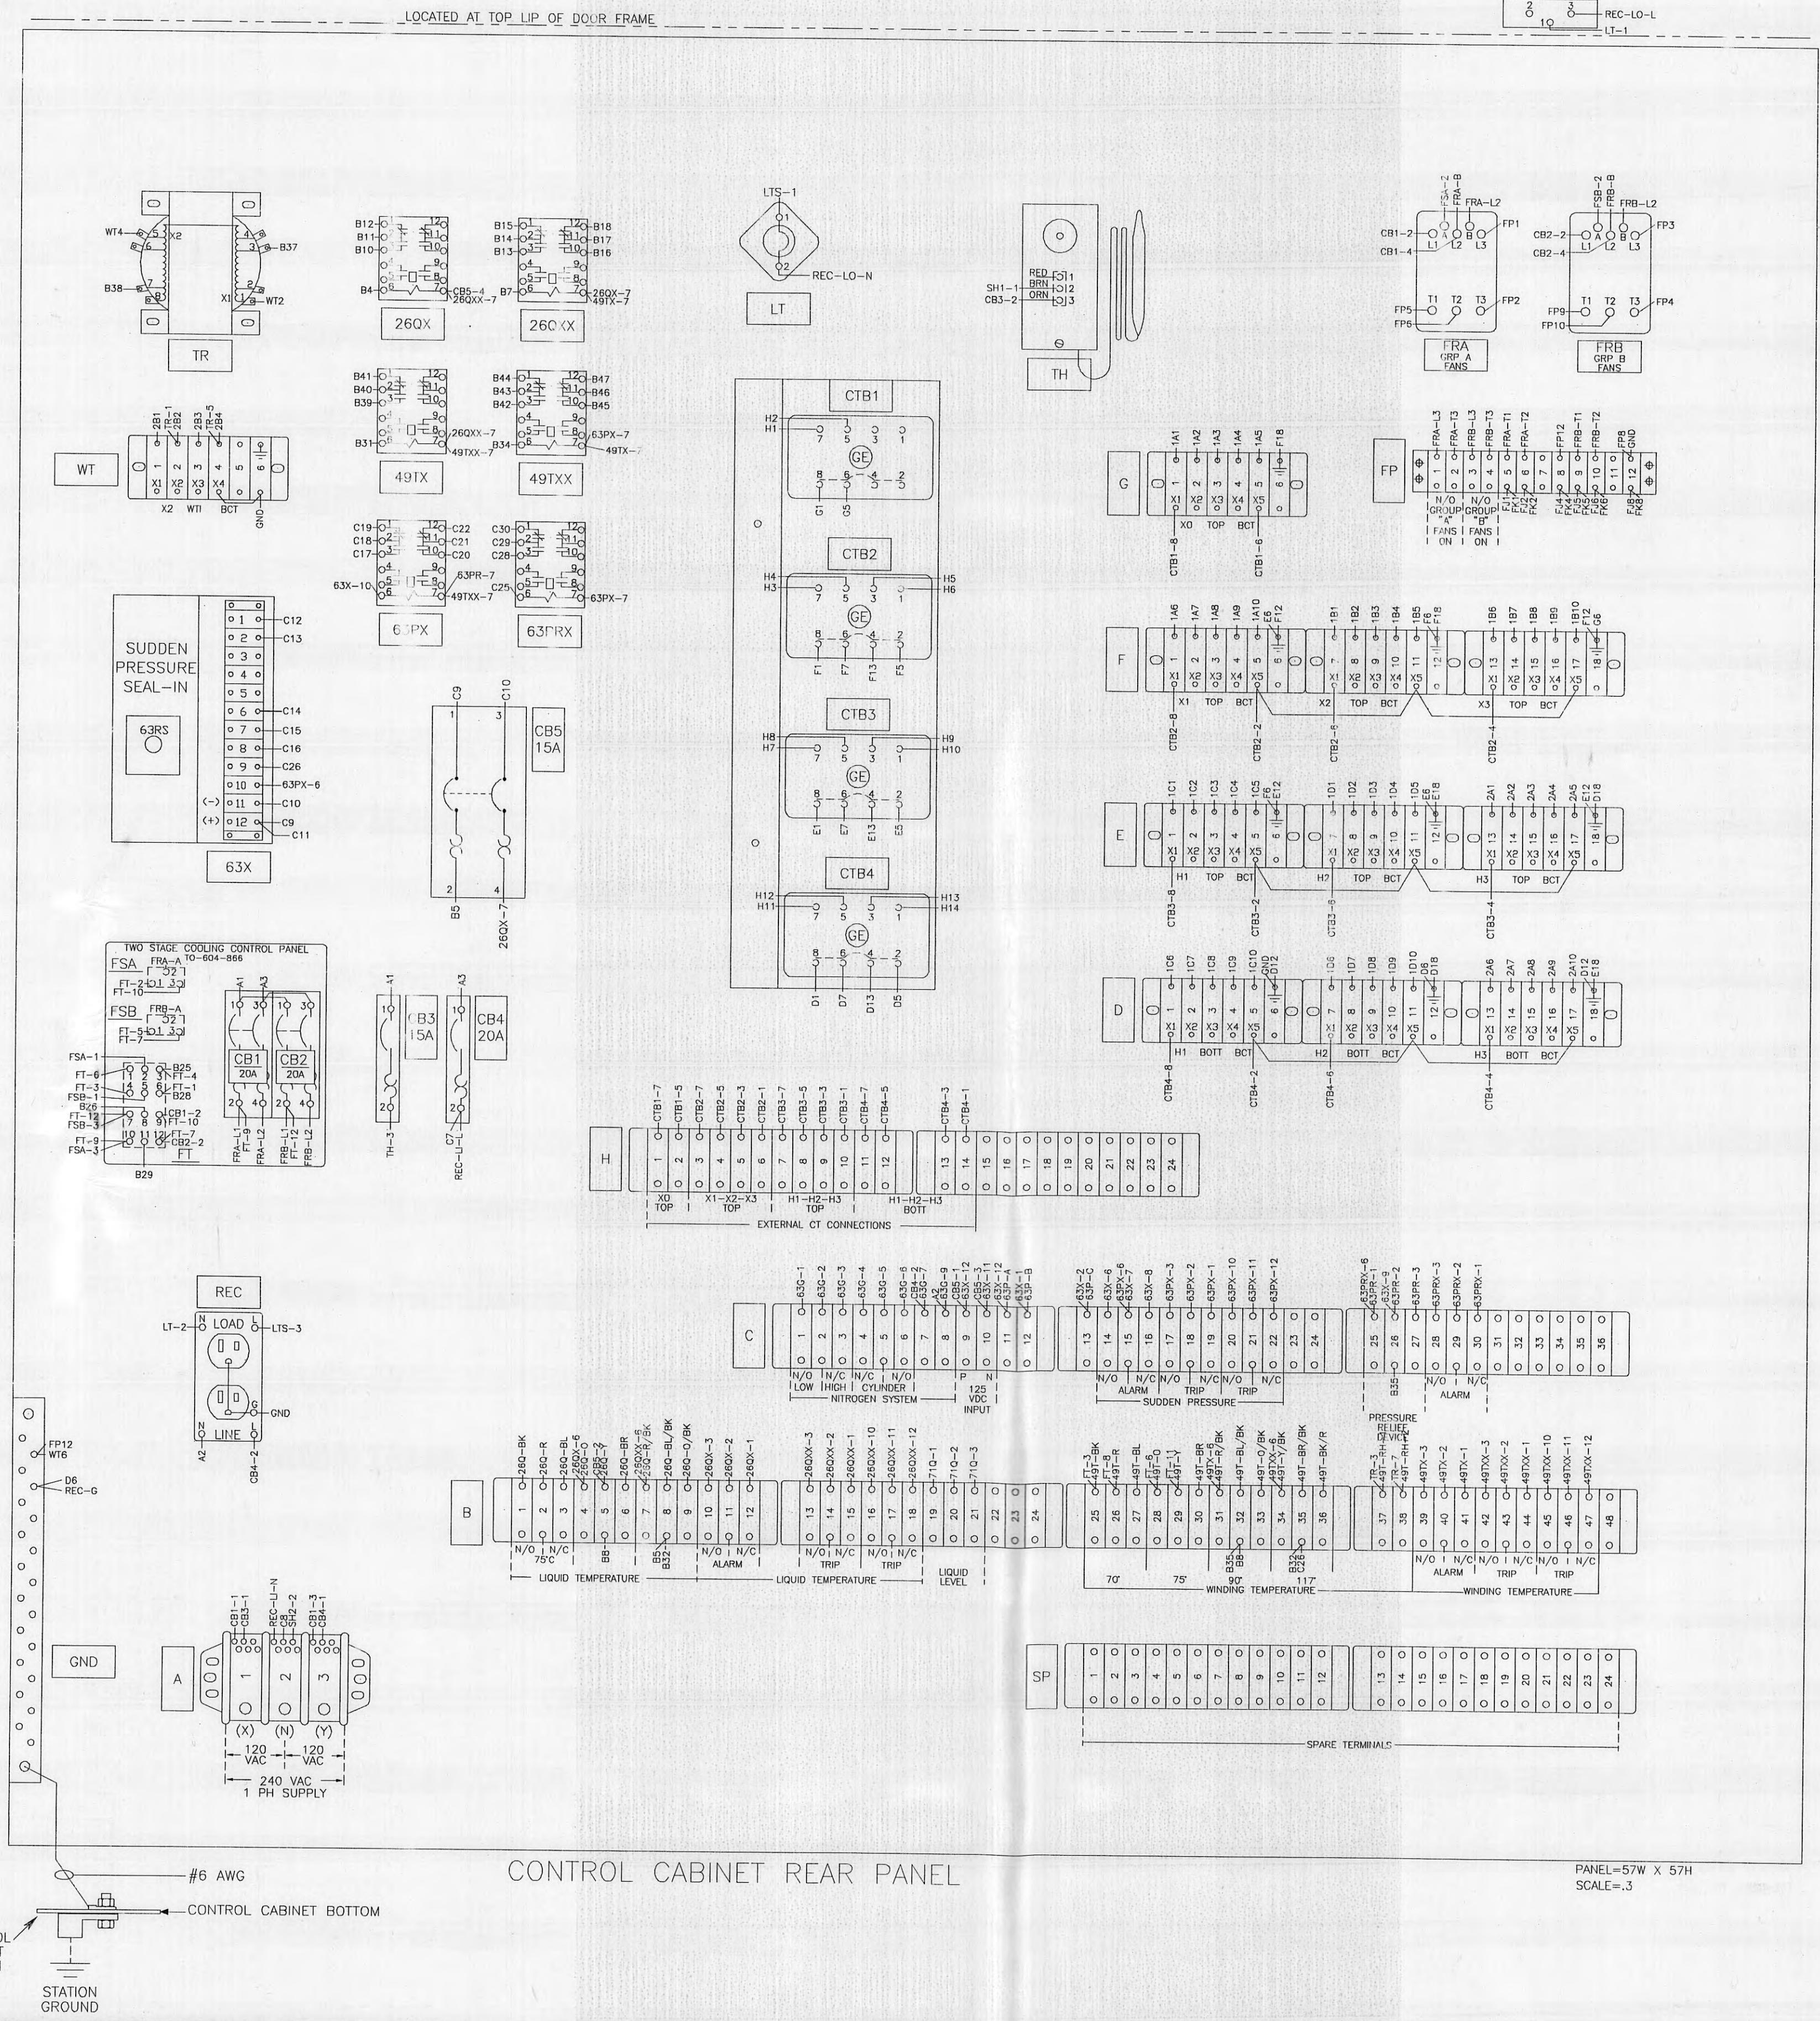


CONTROL CABINET BOTTOM

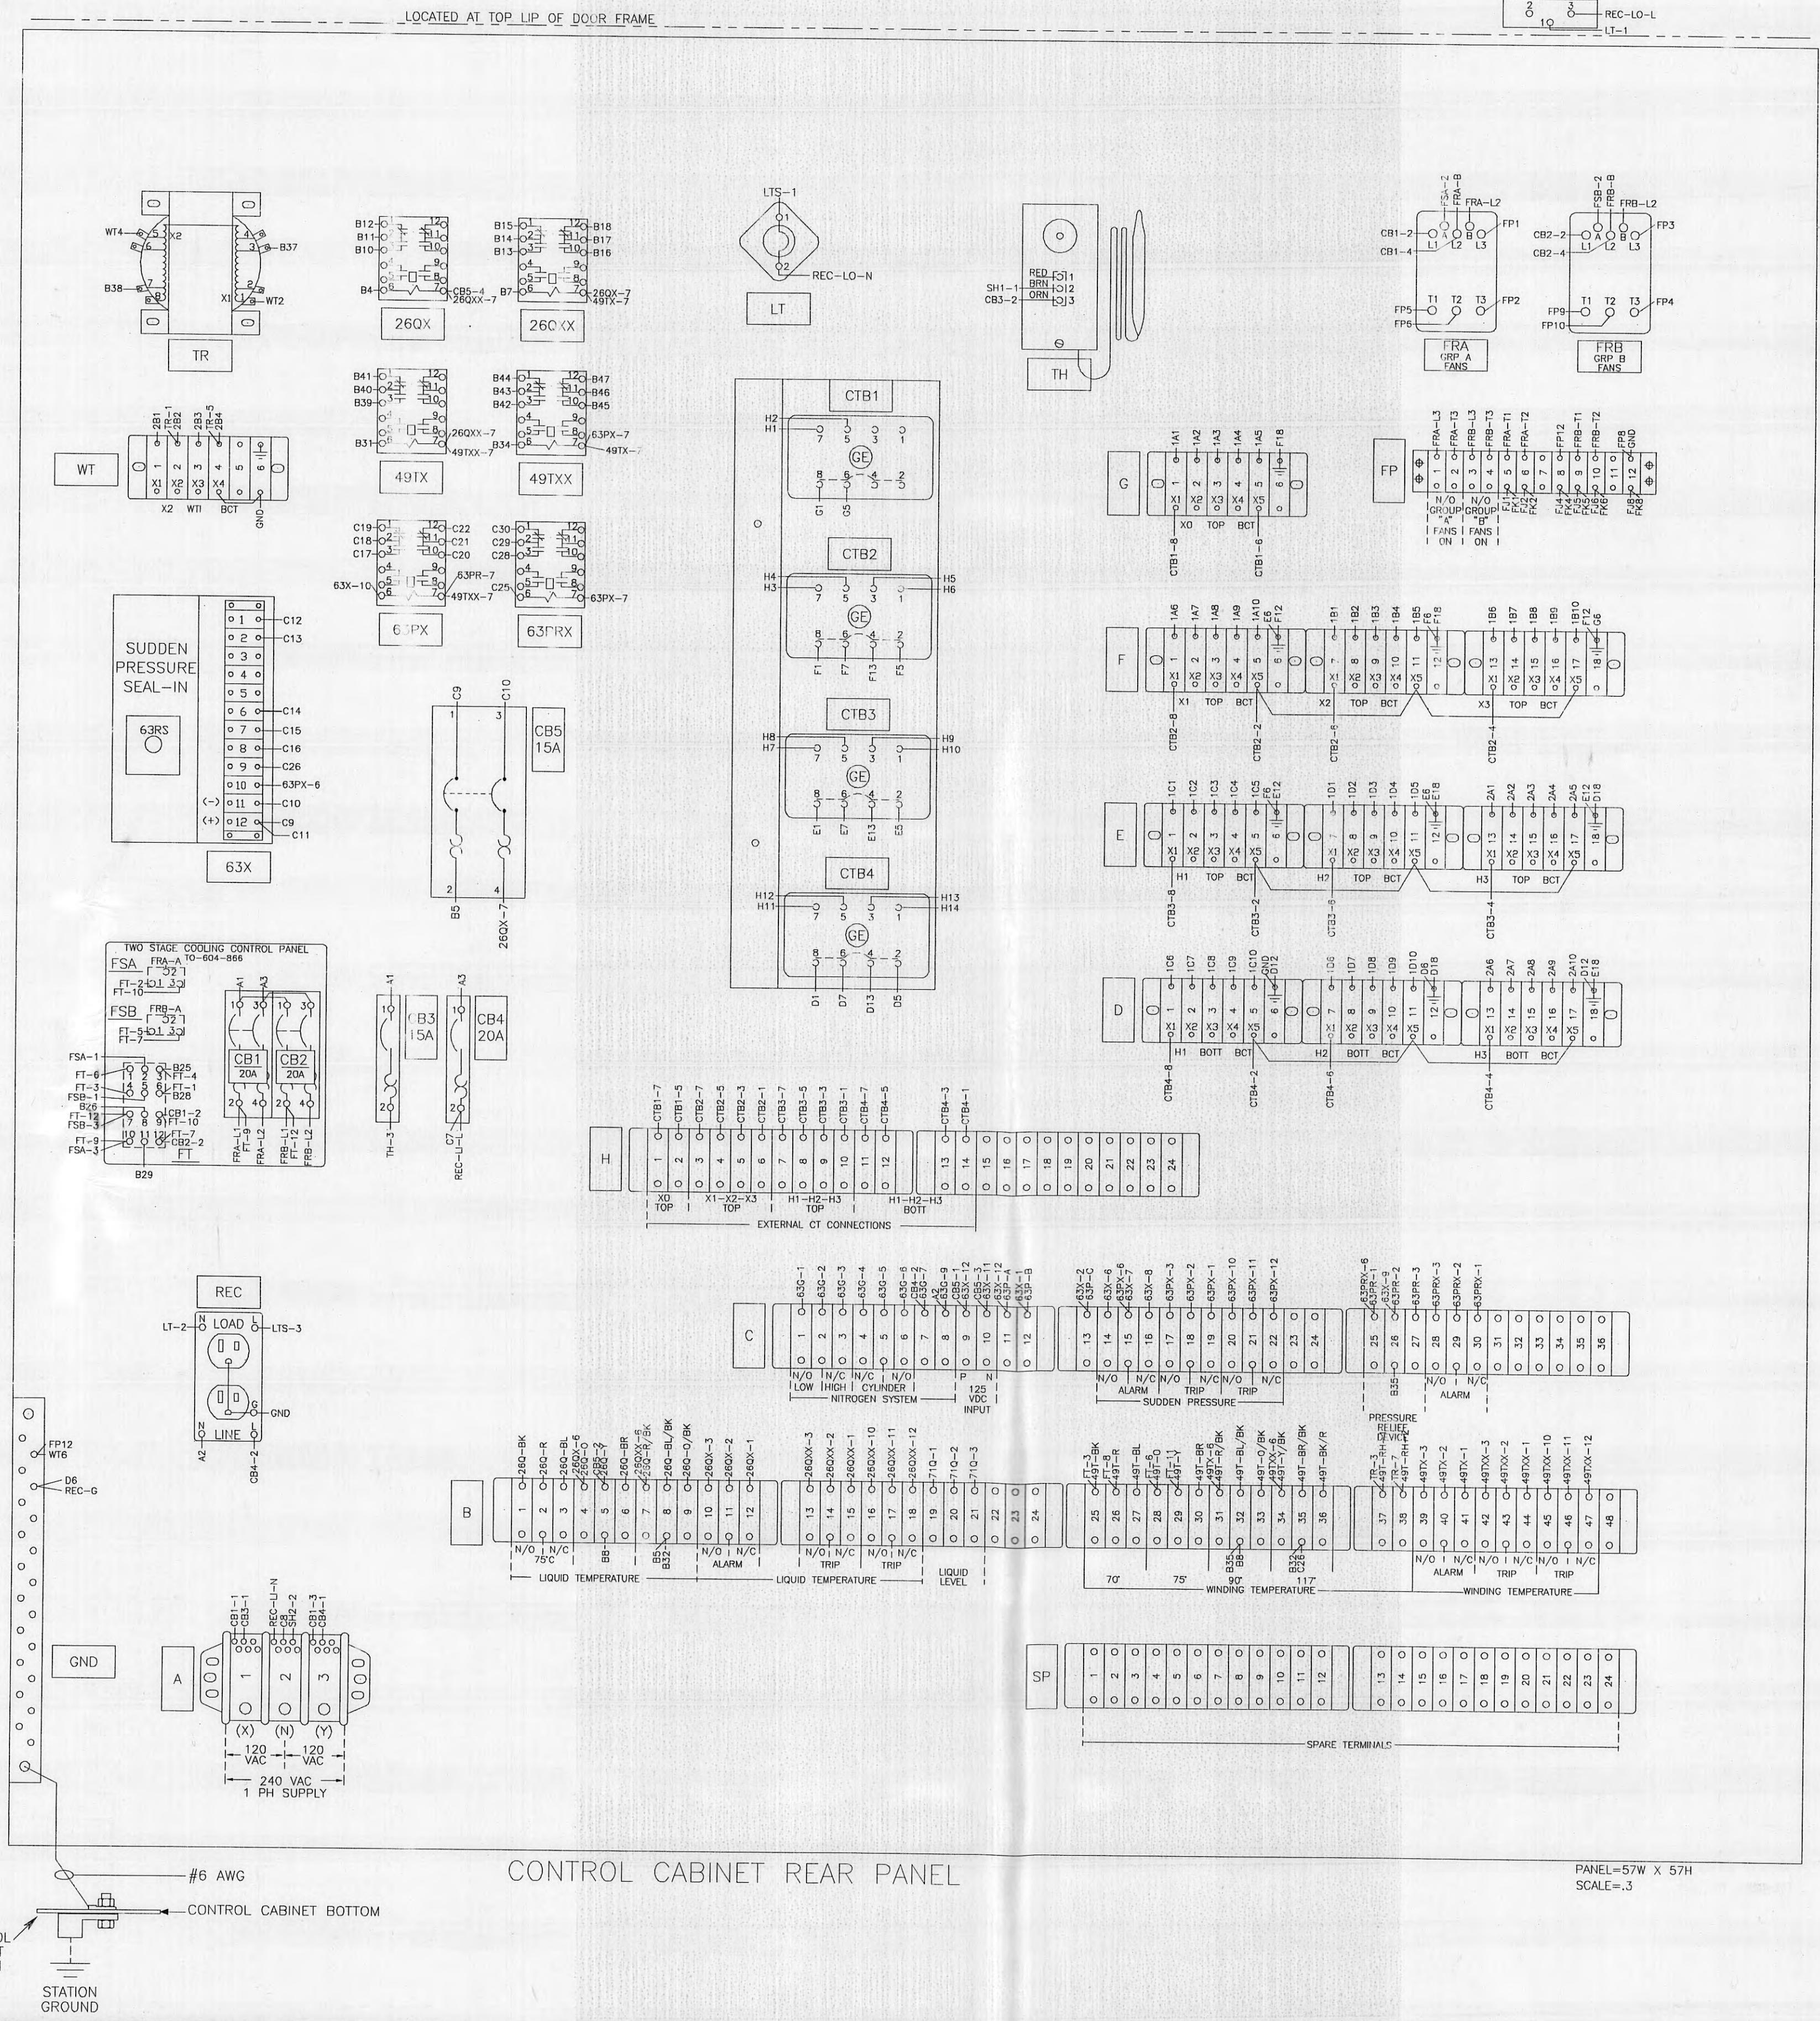


CONTROL CABINET BOTTOM

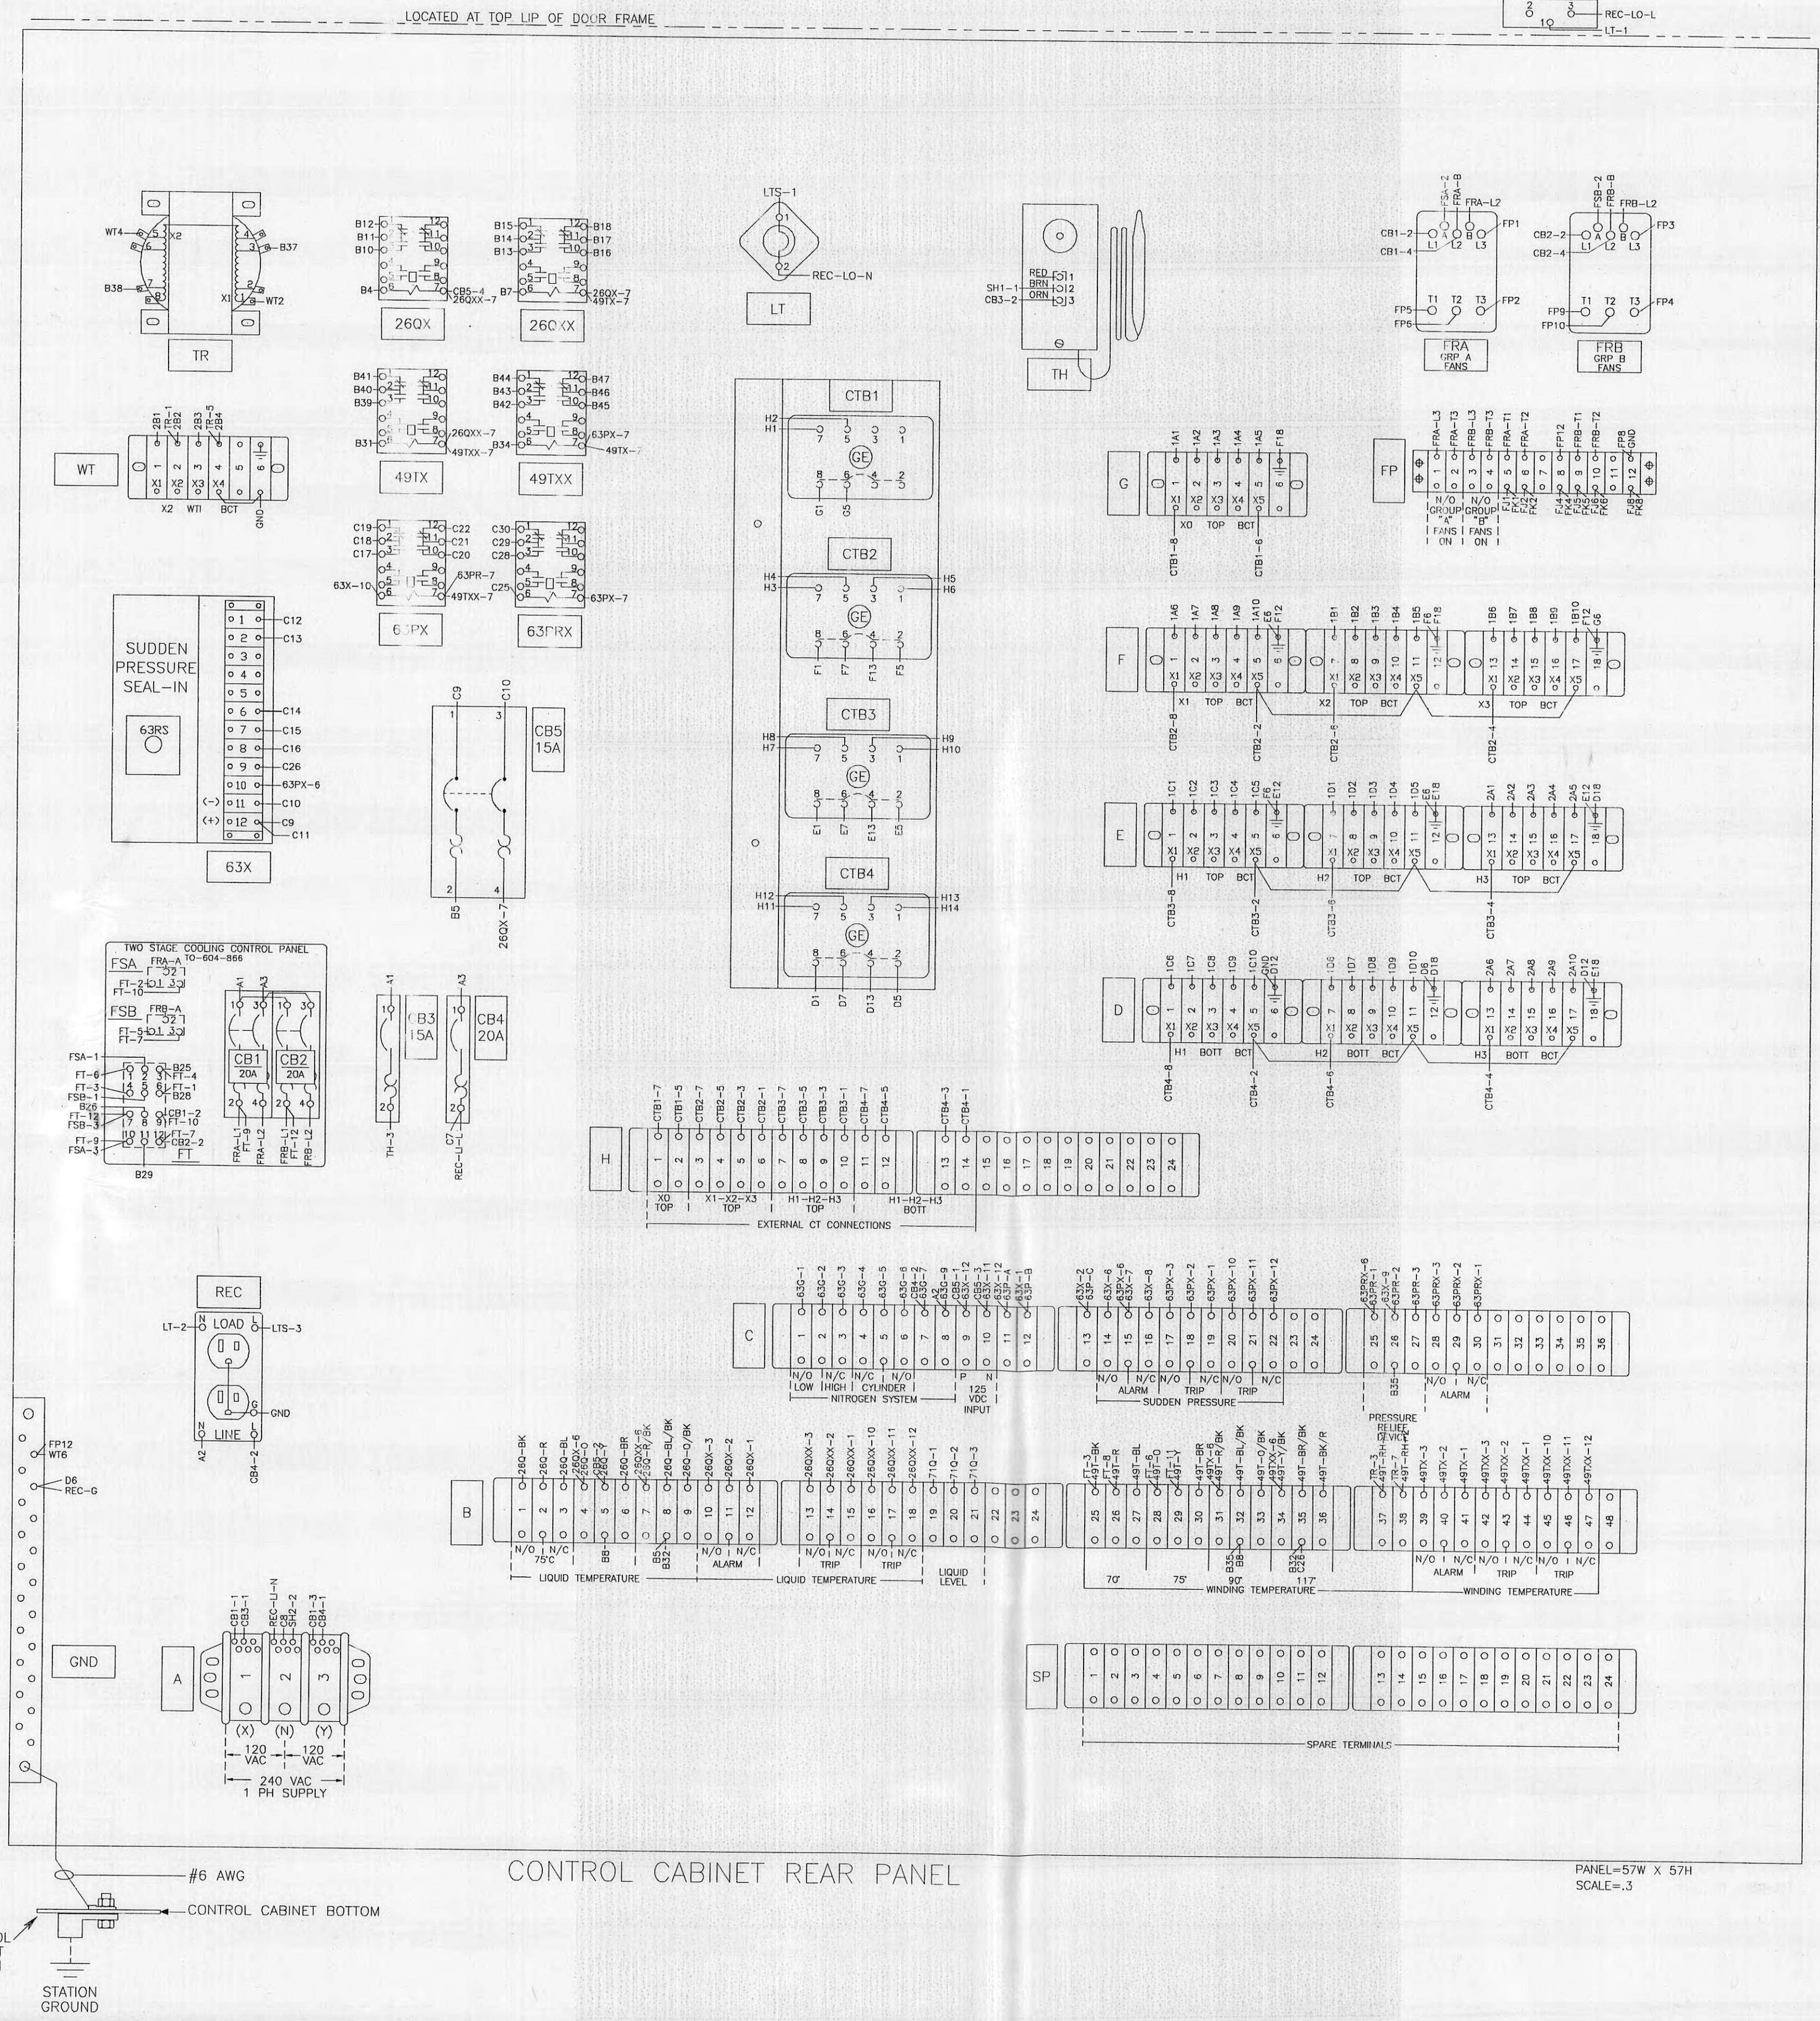


CONTROL CABINET BOTTOM

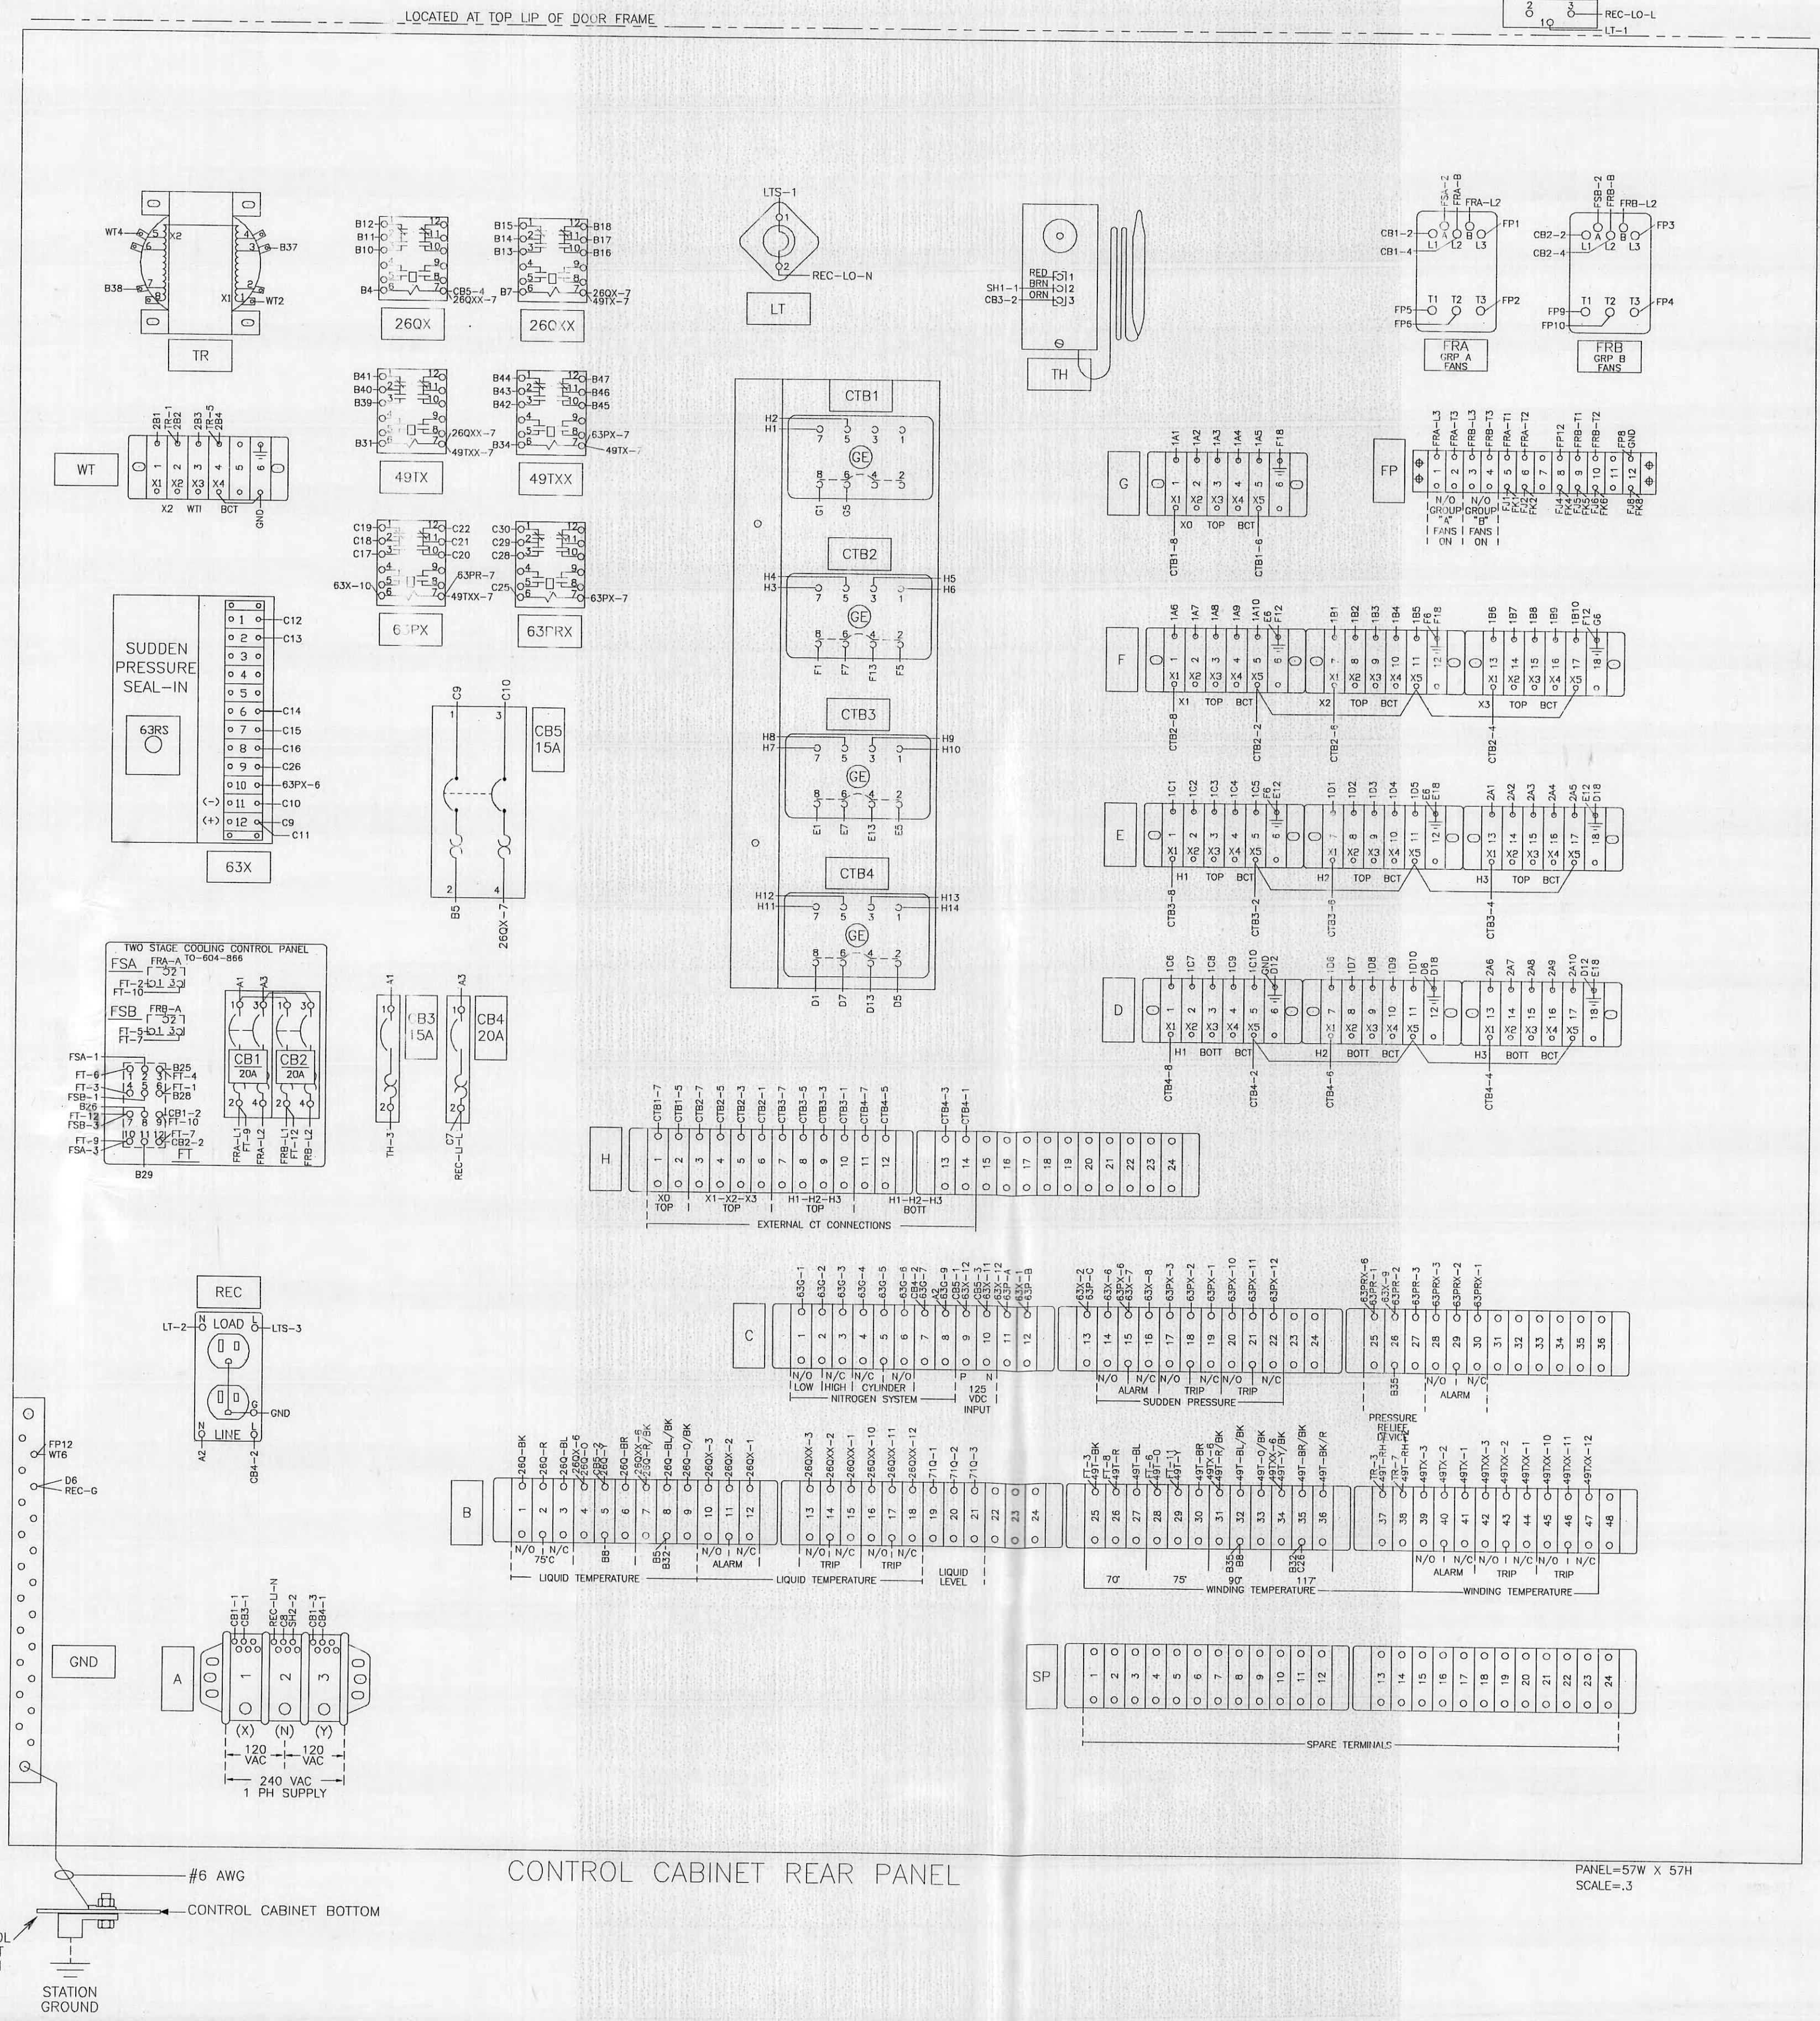


CONTROL CABINET BOTTOM

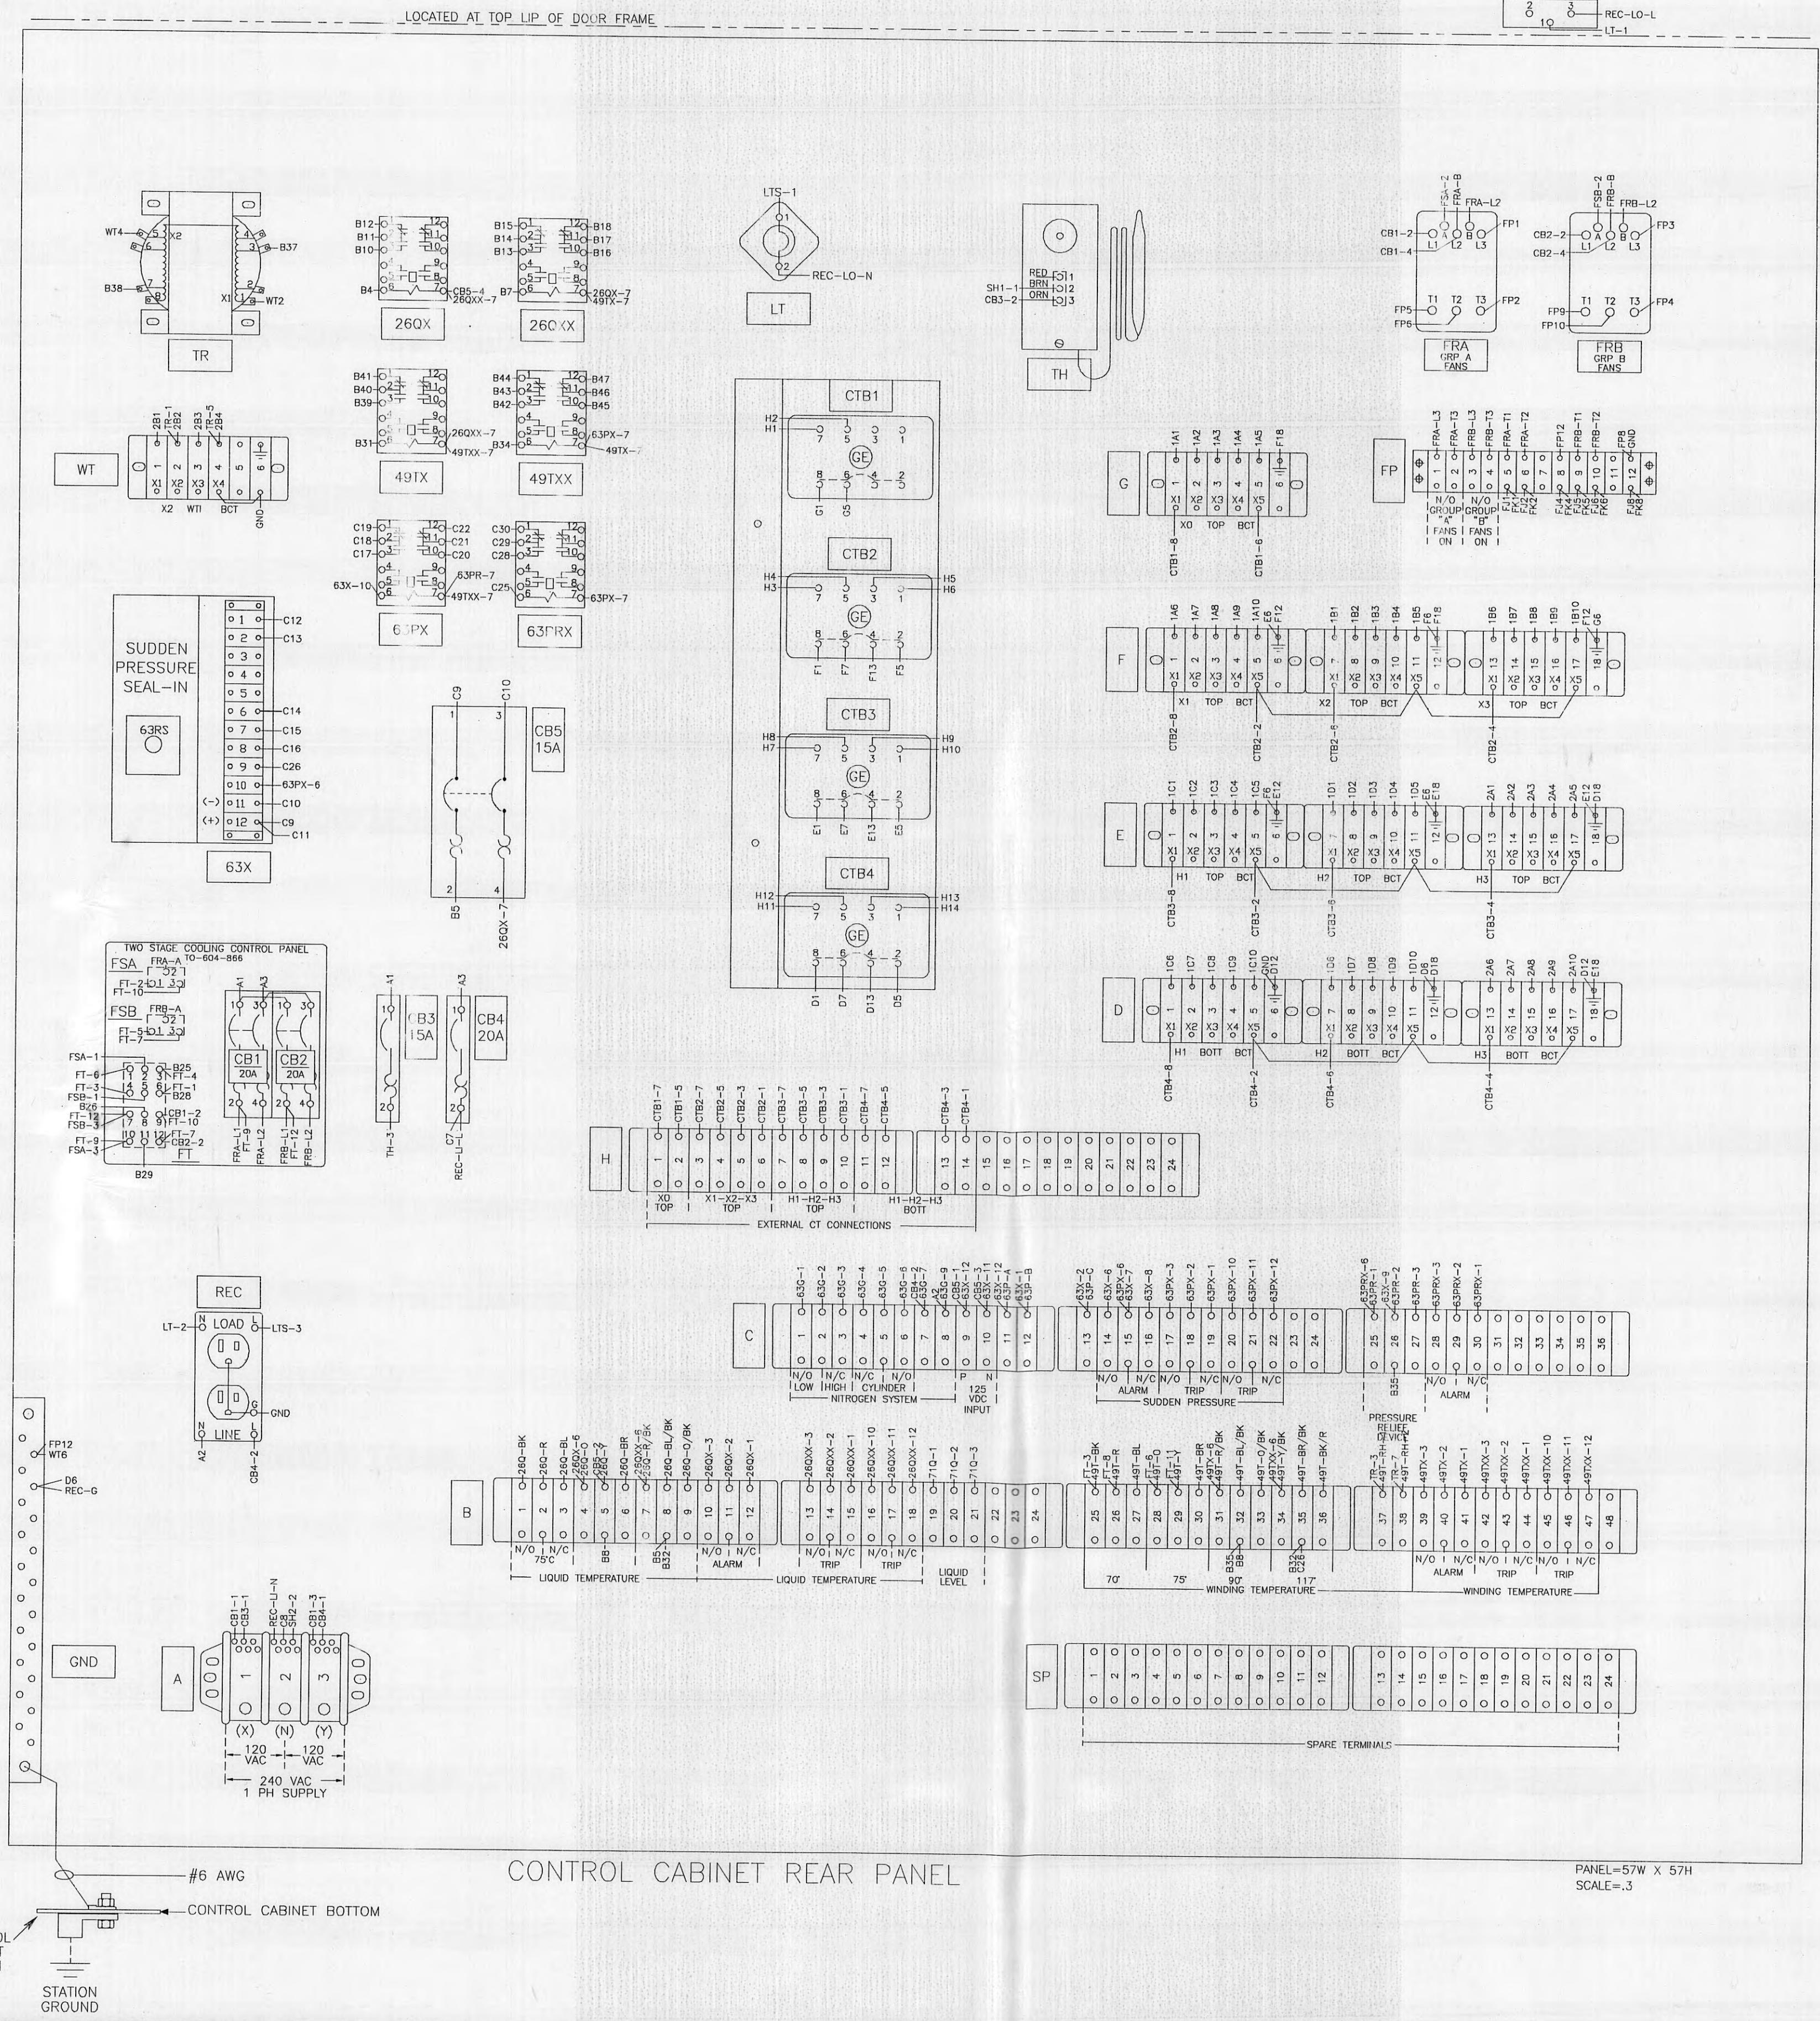


CONTROL CABINET BOTTOM

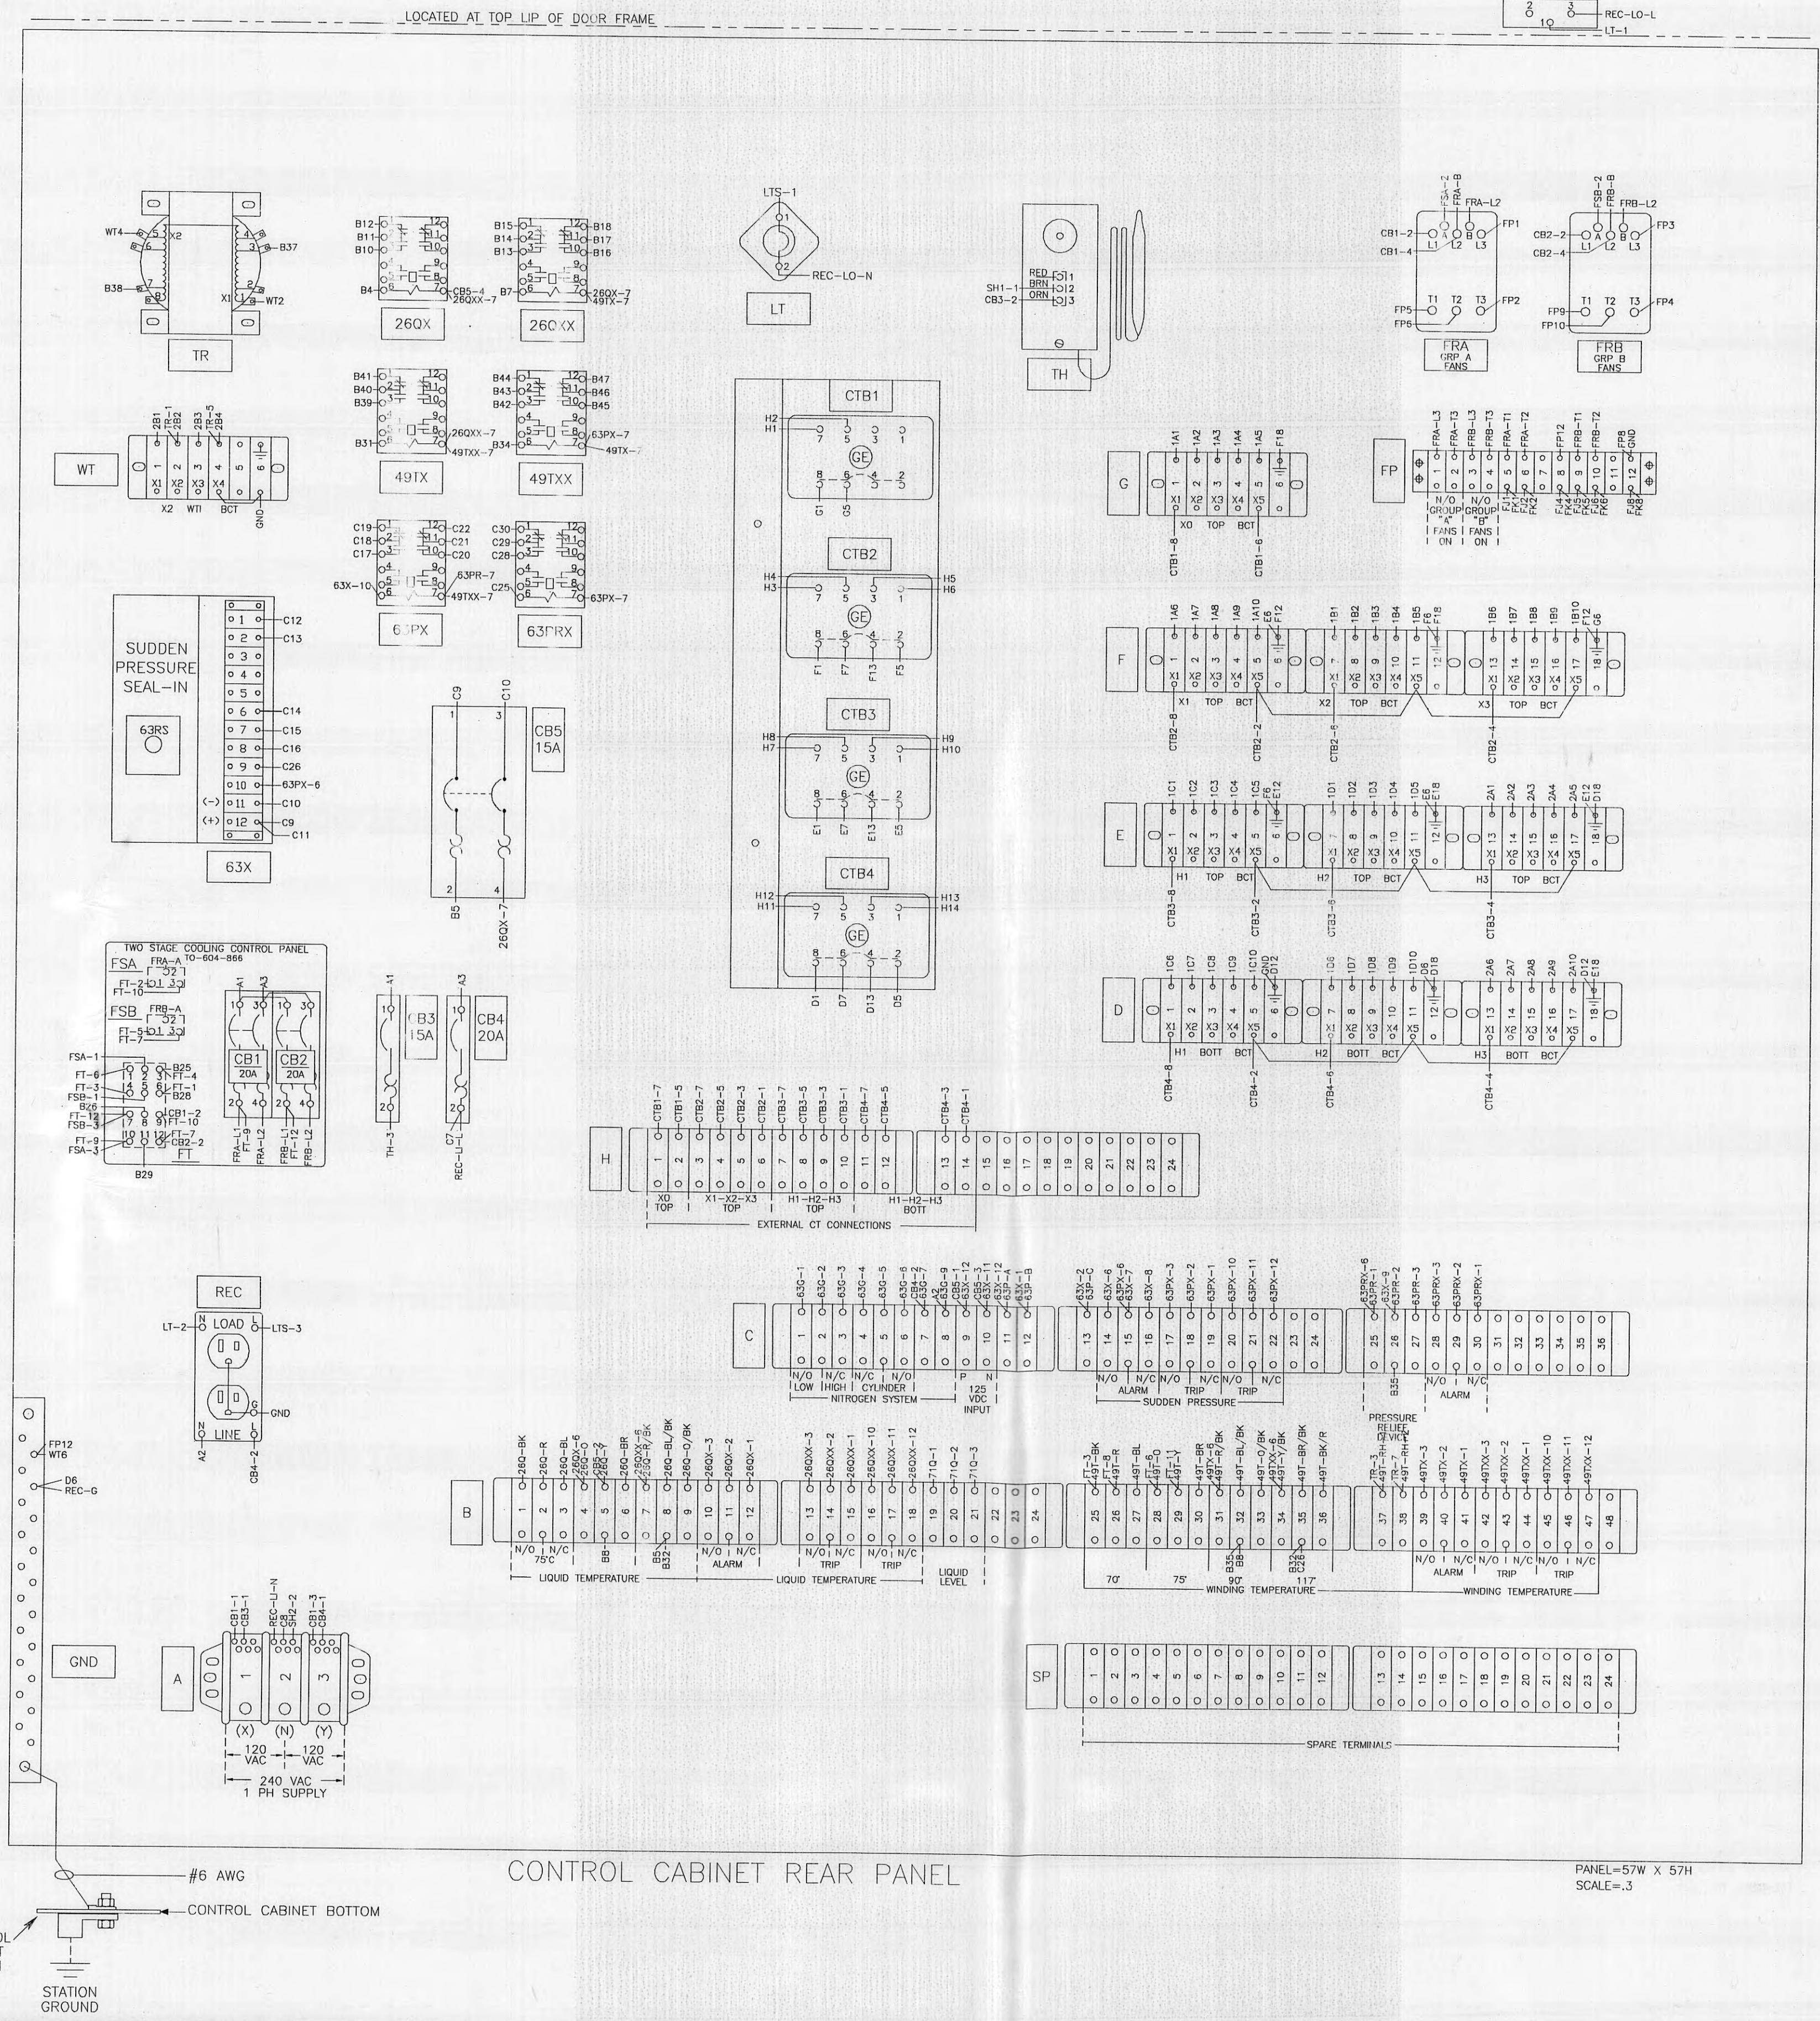


CONTROL CABINET BOTTOM

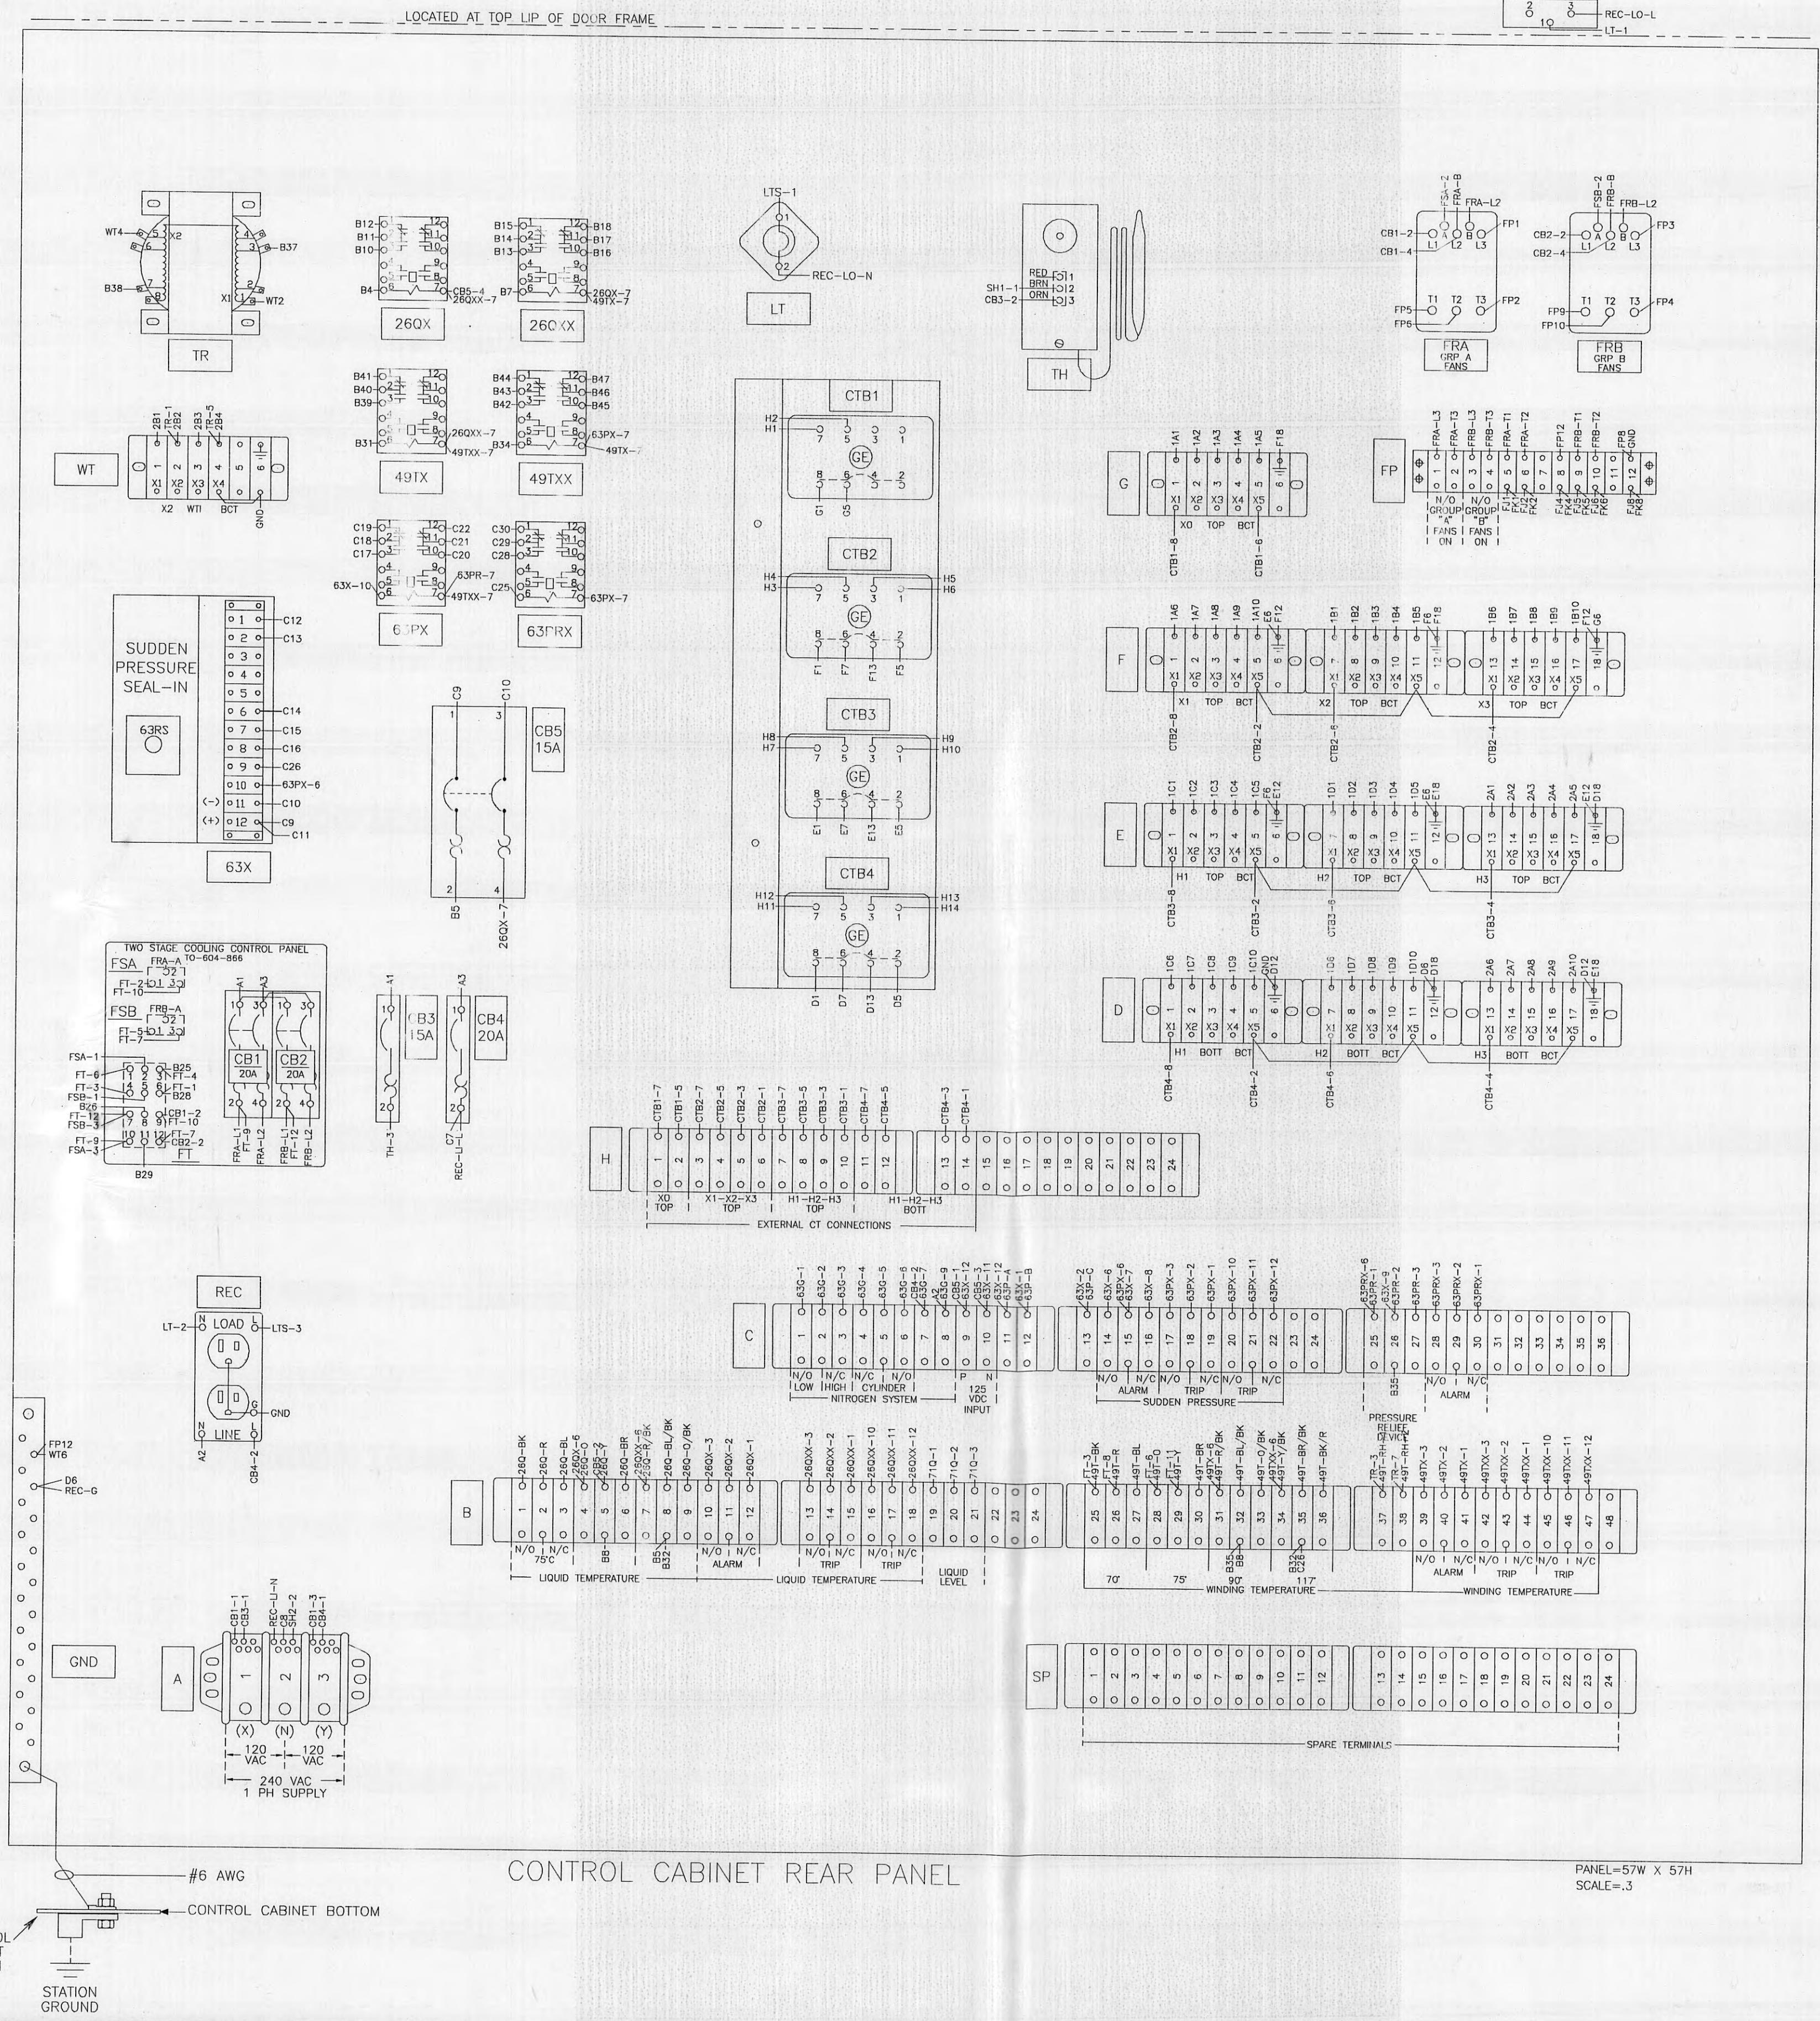


CONTROL CABINET BOTTOM

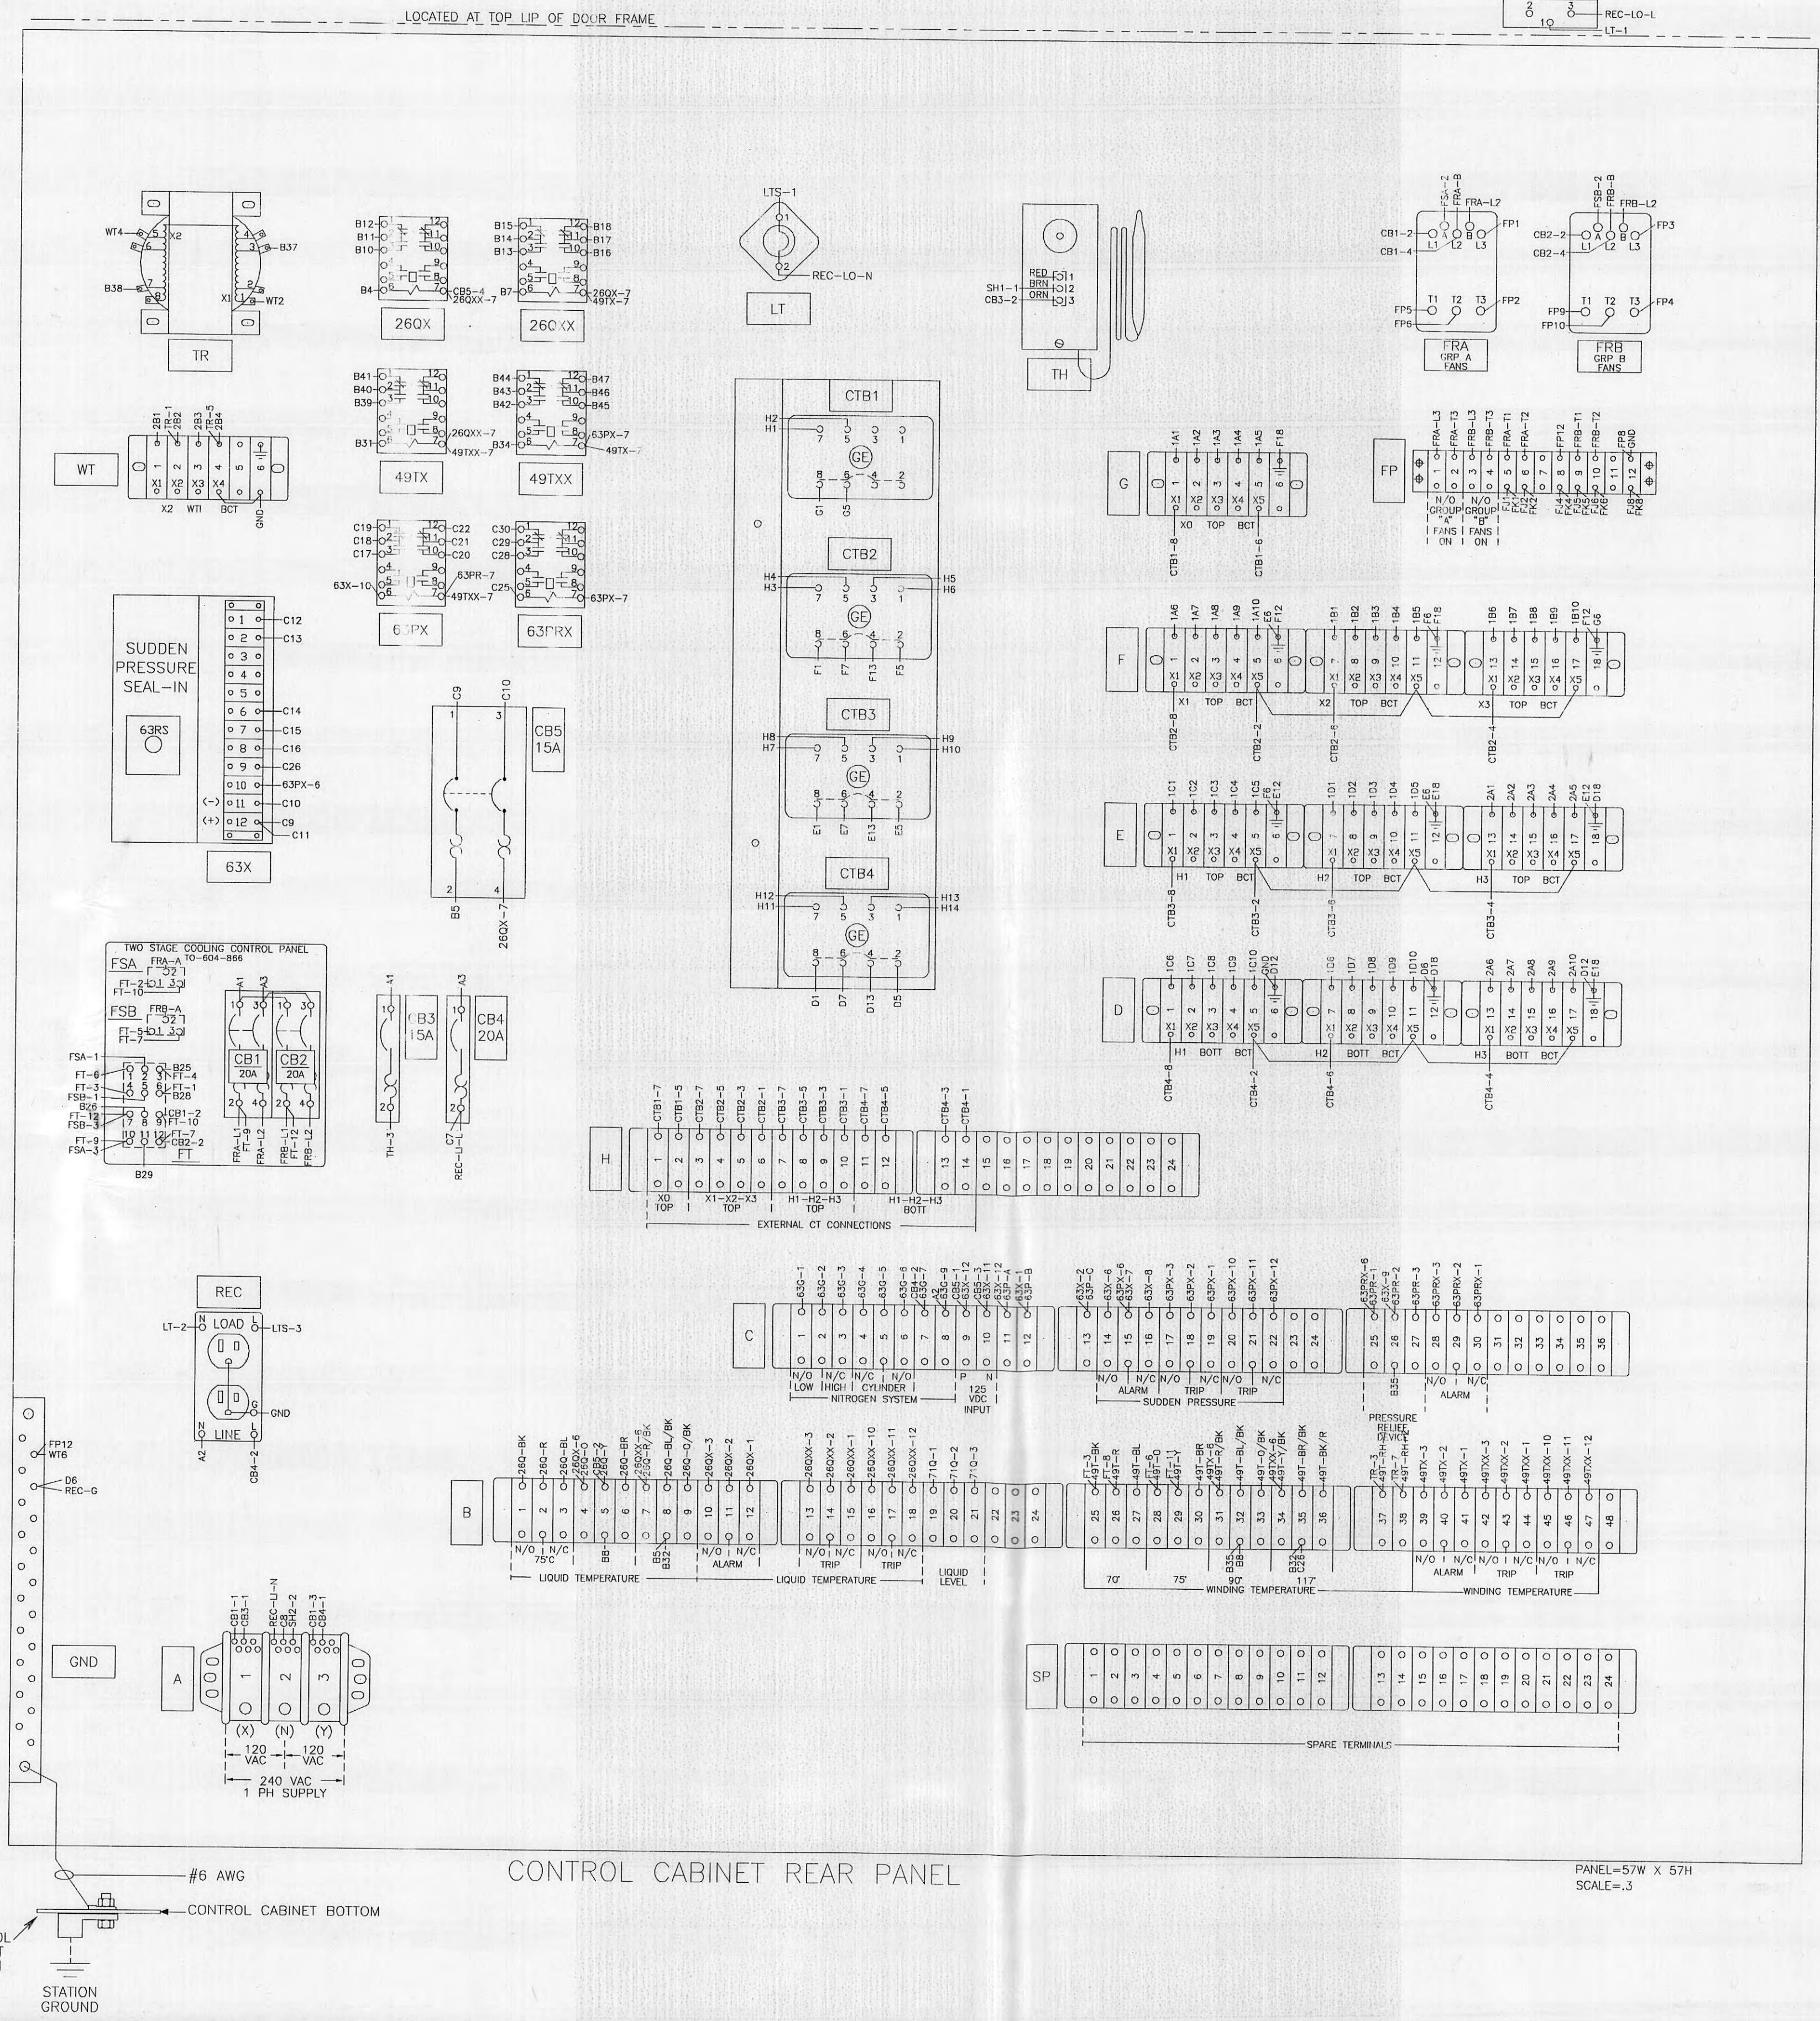


CONTROL CABINET BOTTOM

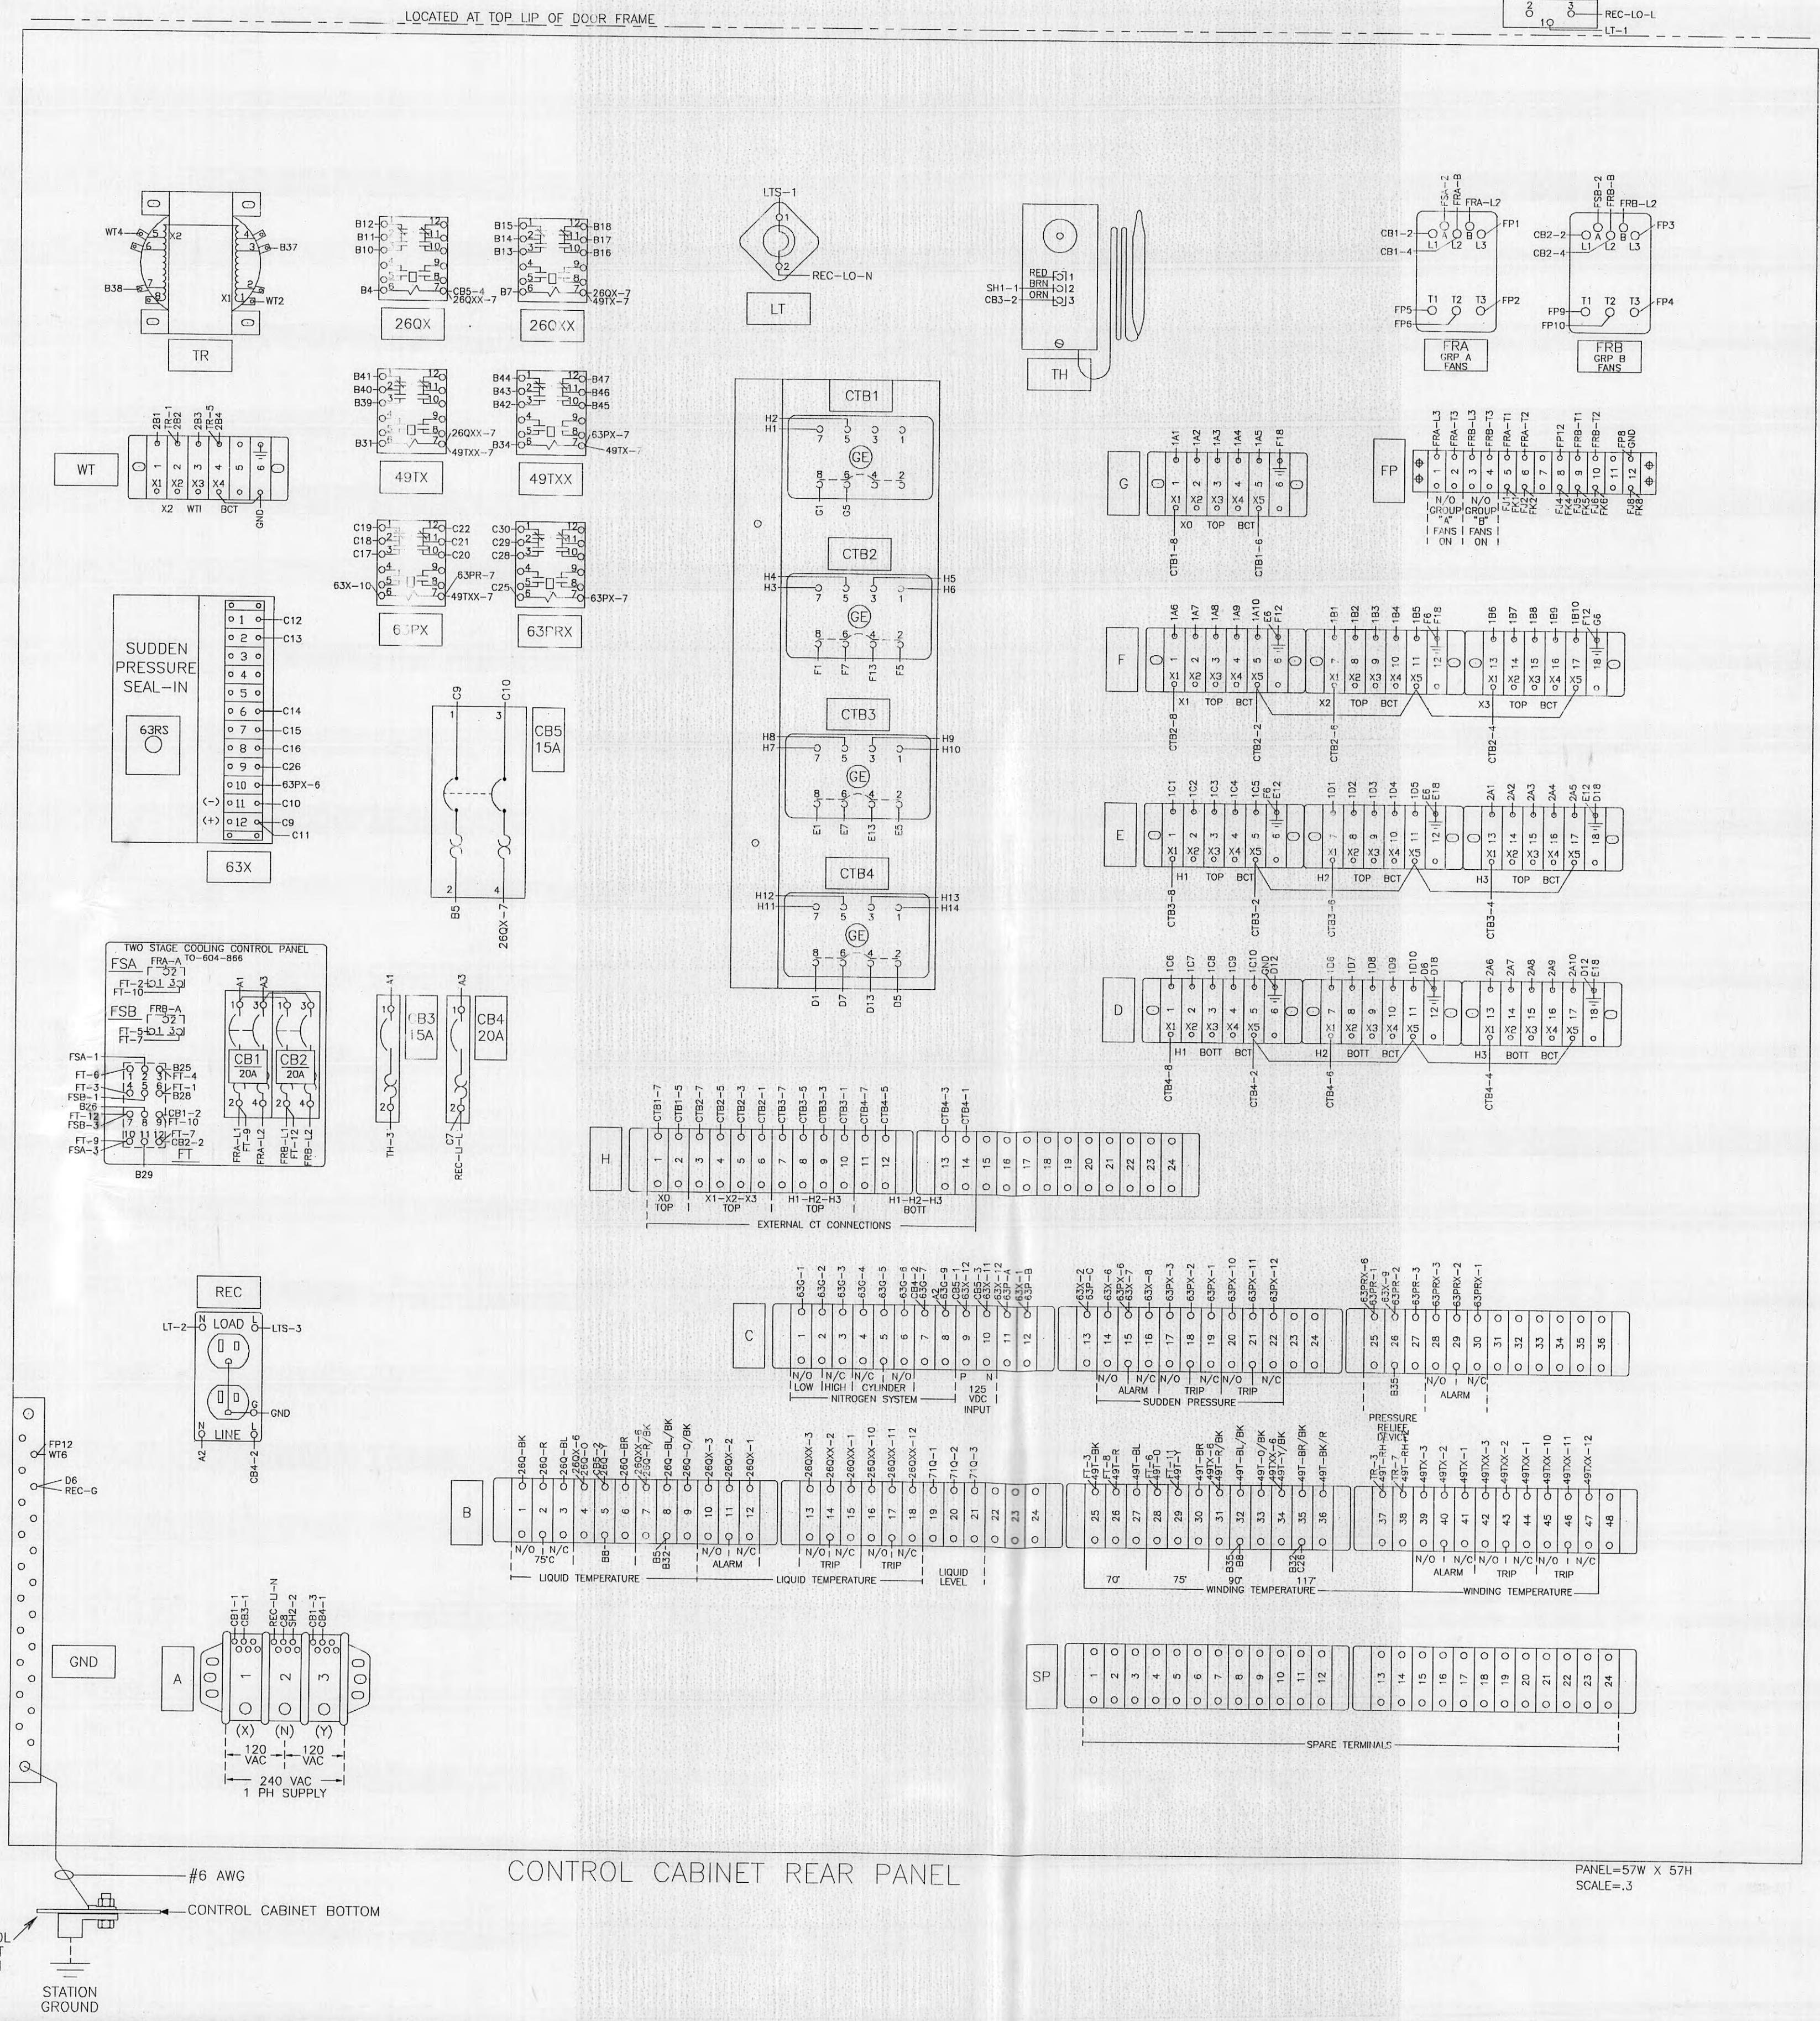


CONTROL CABINET BOTTOM

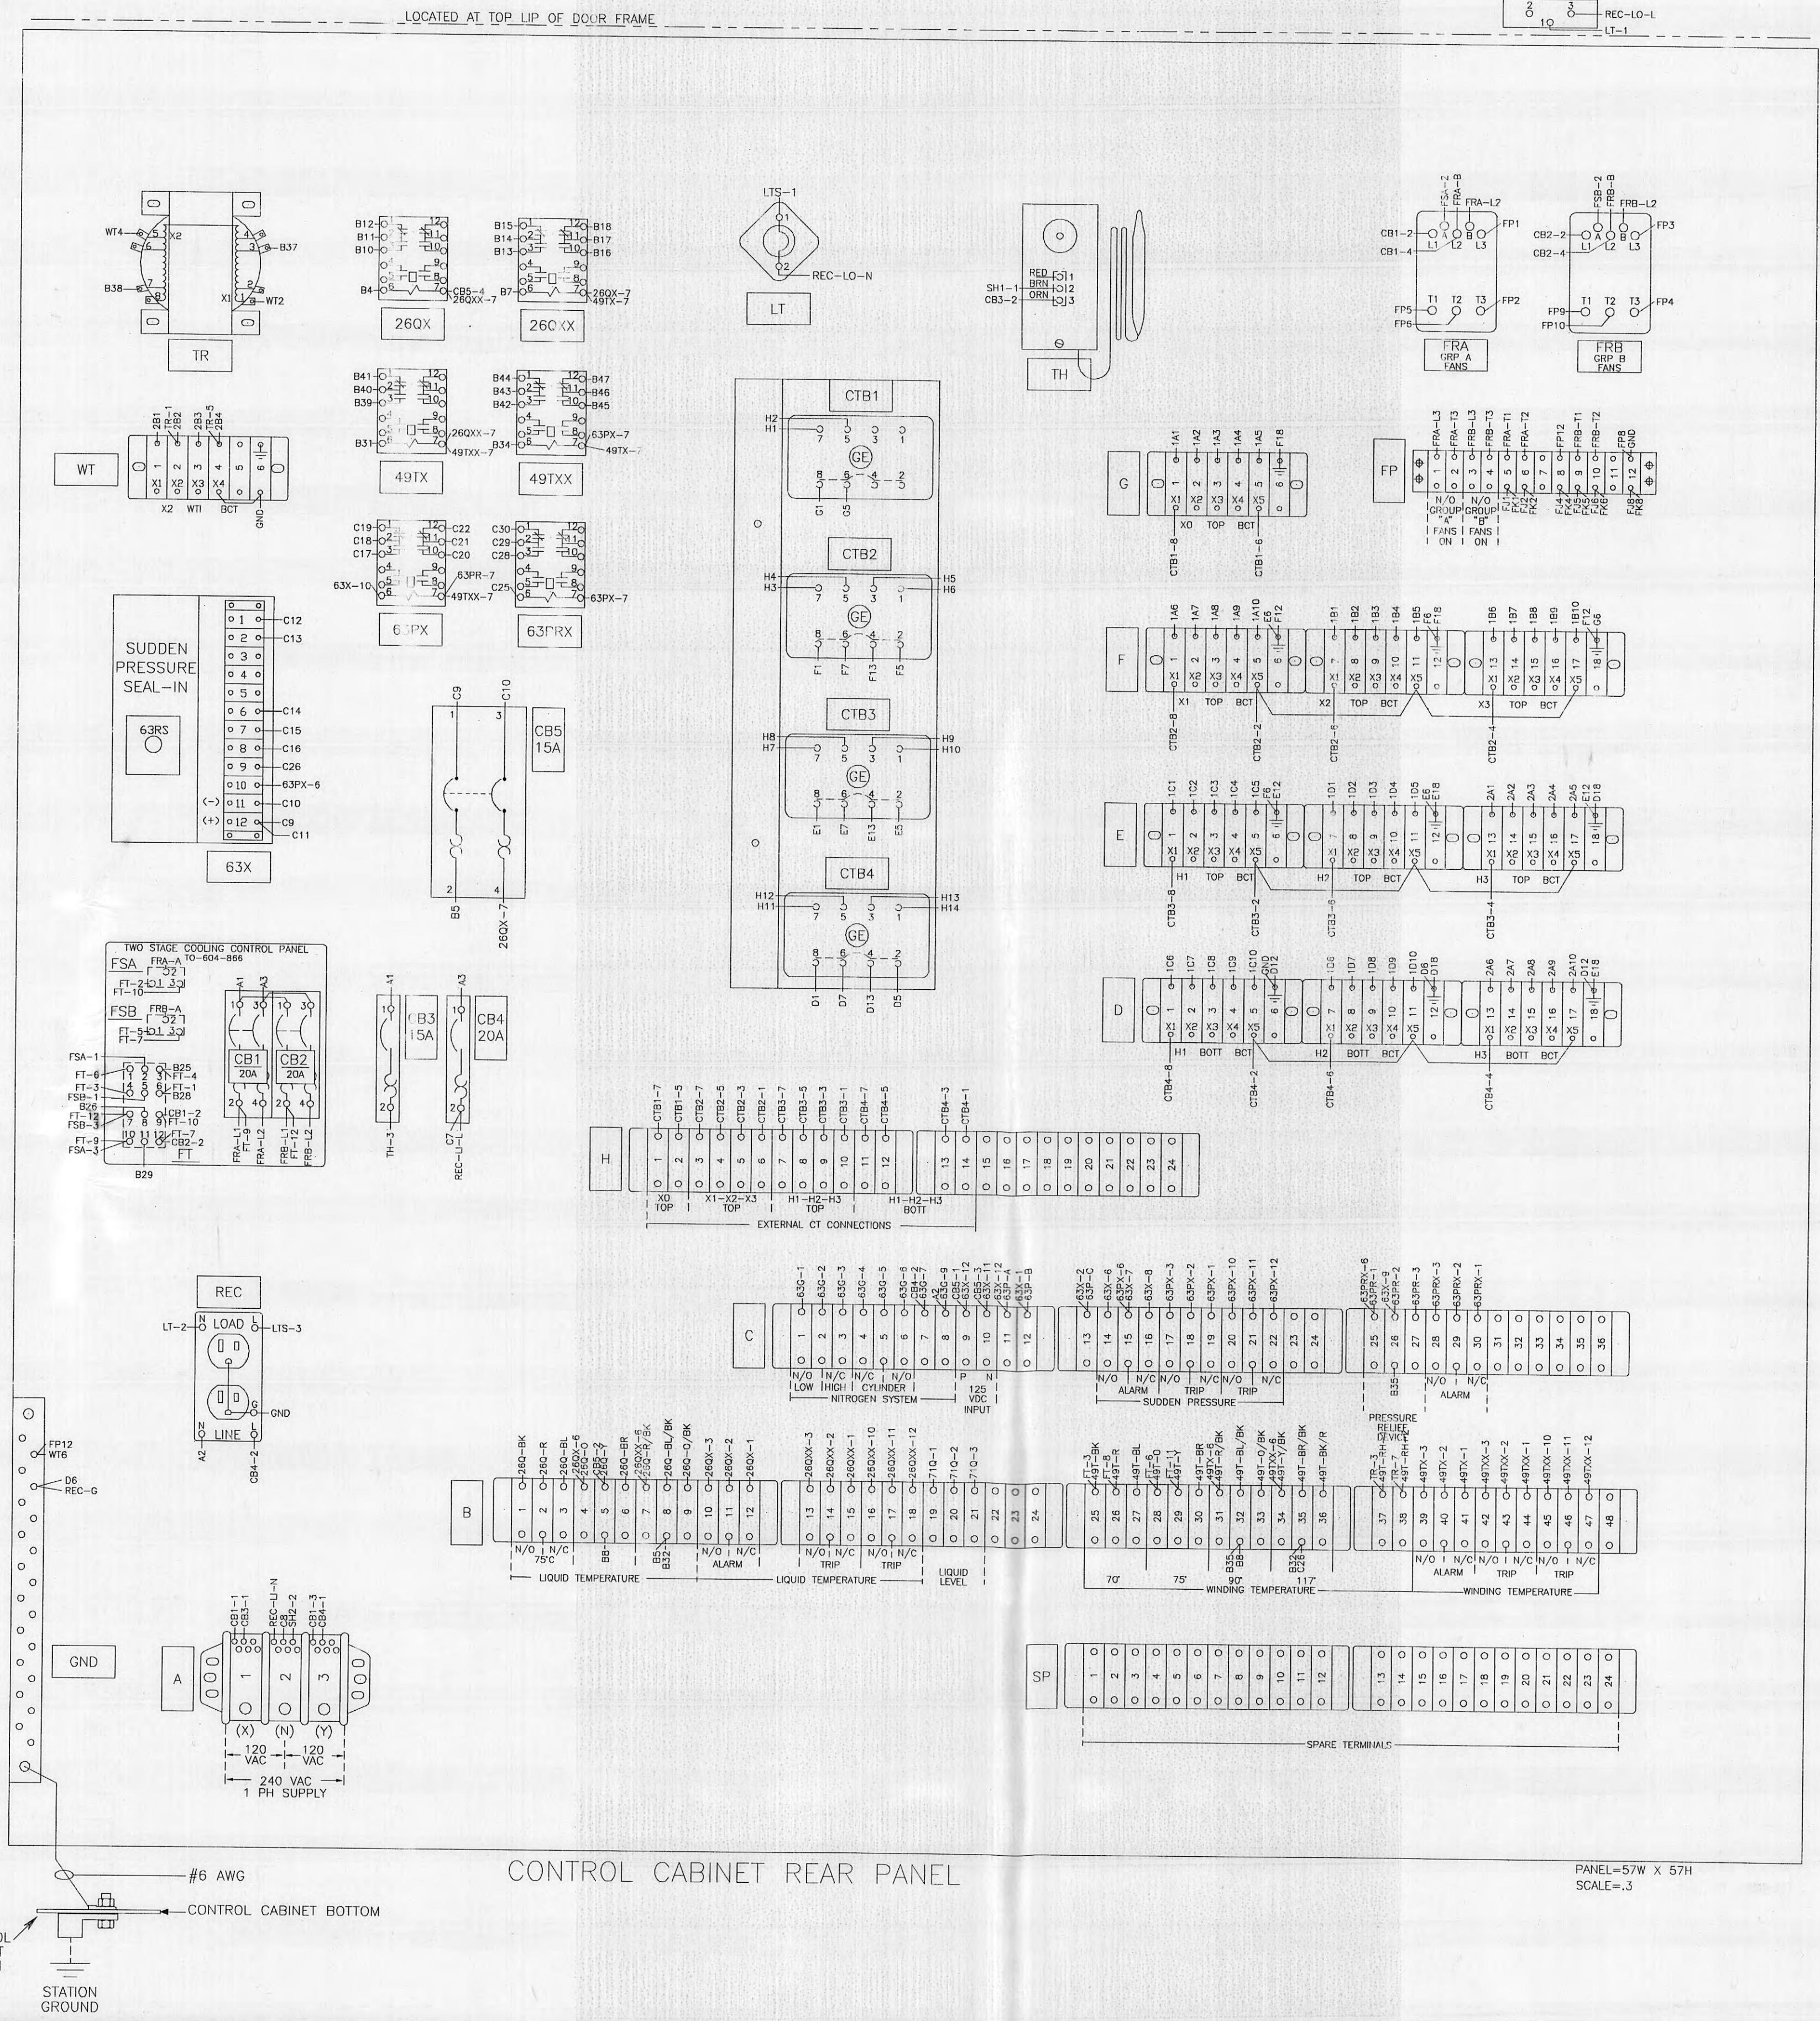


CONTROL CABINET BOTTOM

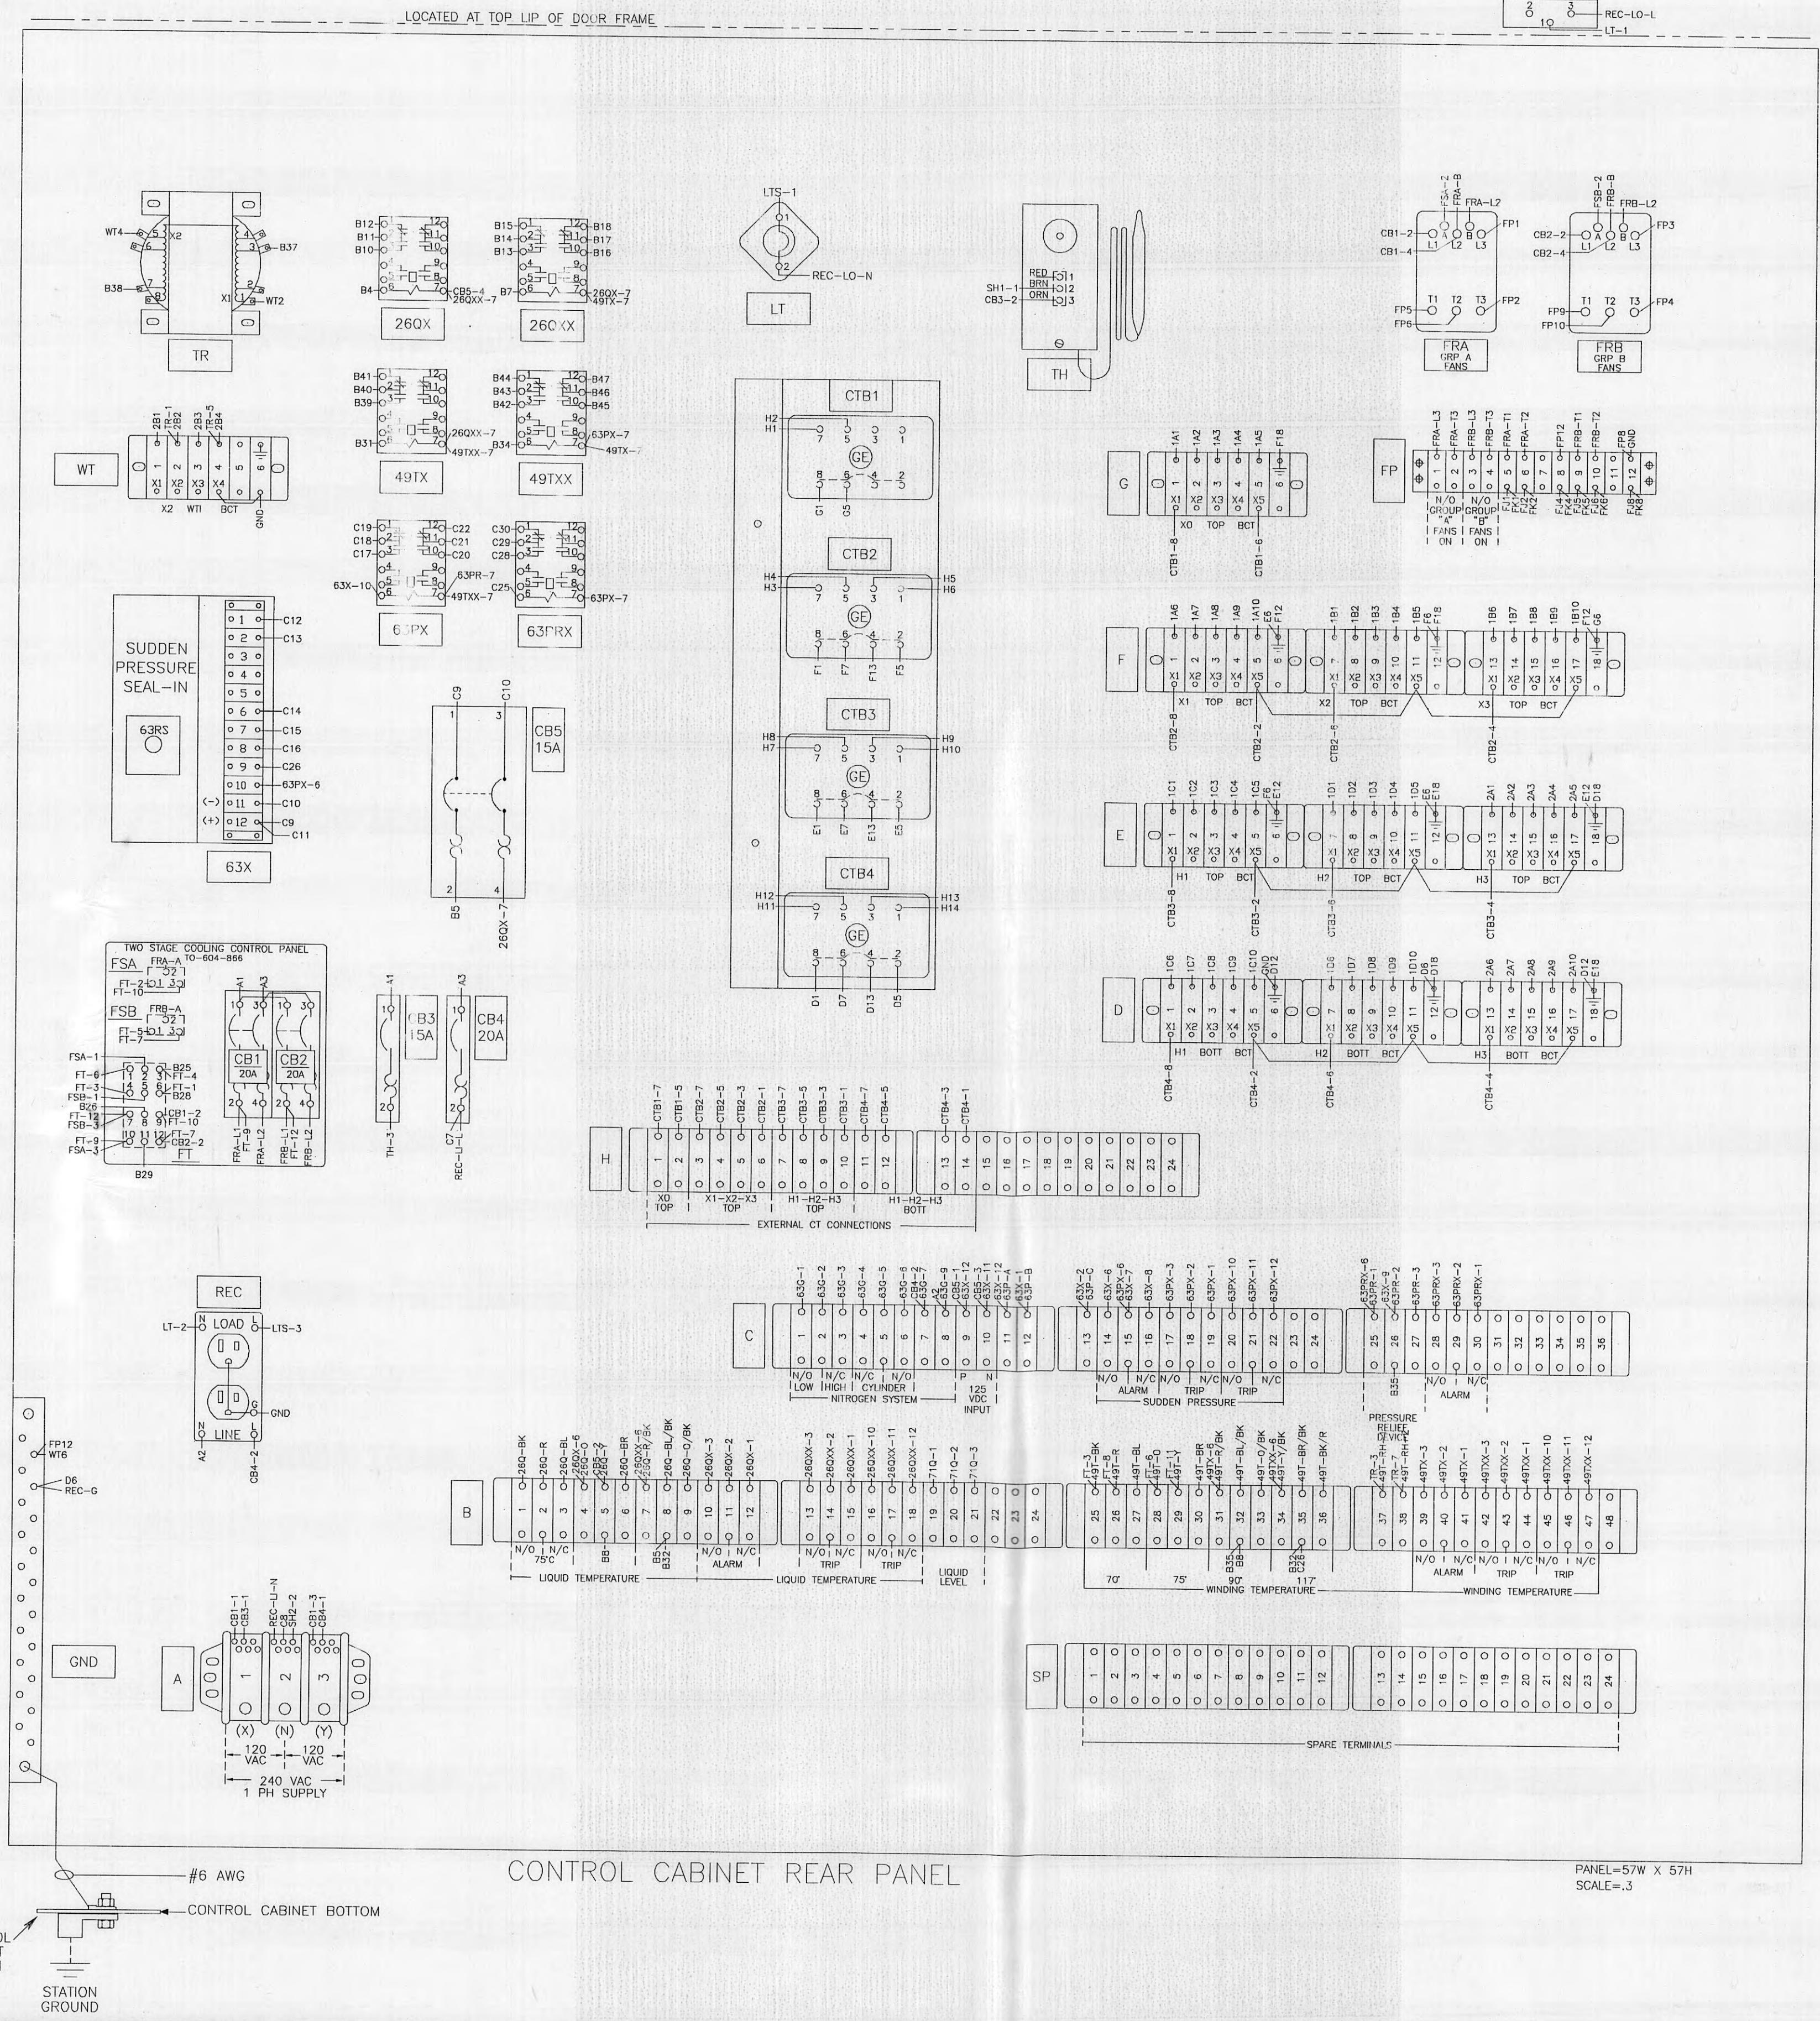


CONTROL CABINET BOTTOM

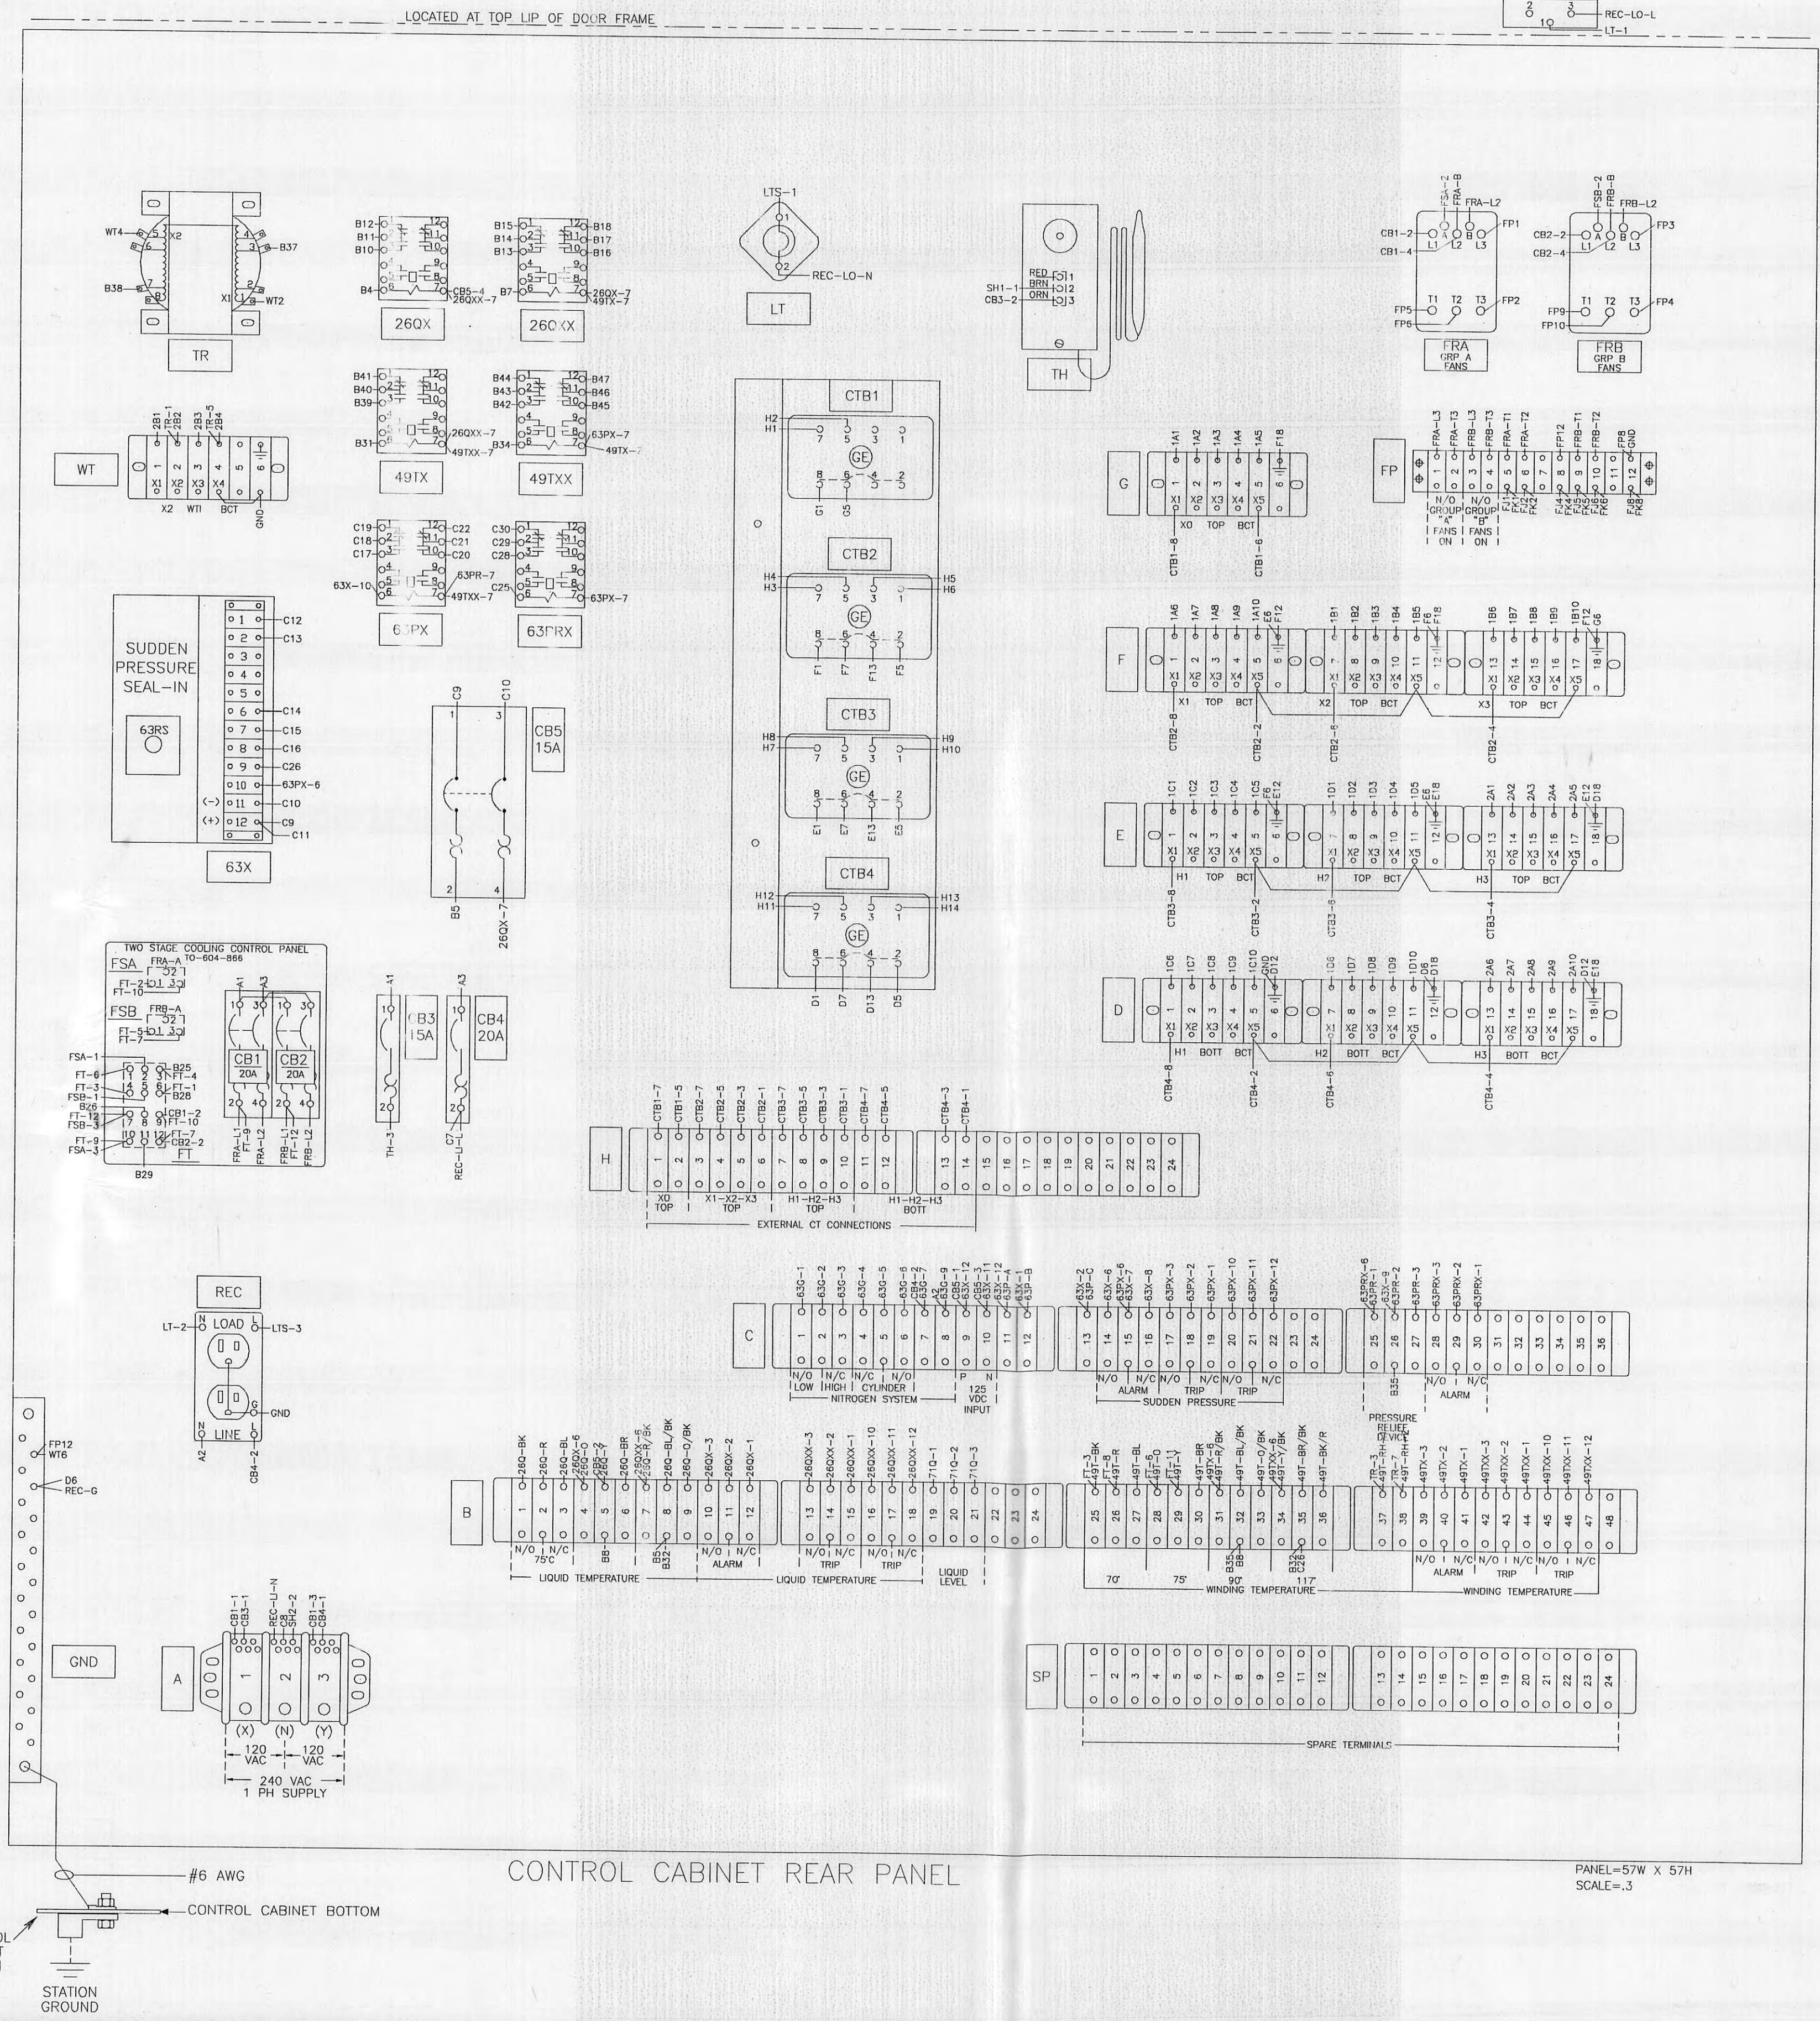


CONTROL CABINET BOTTOM

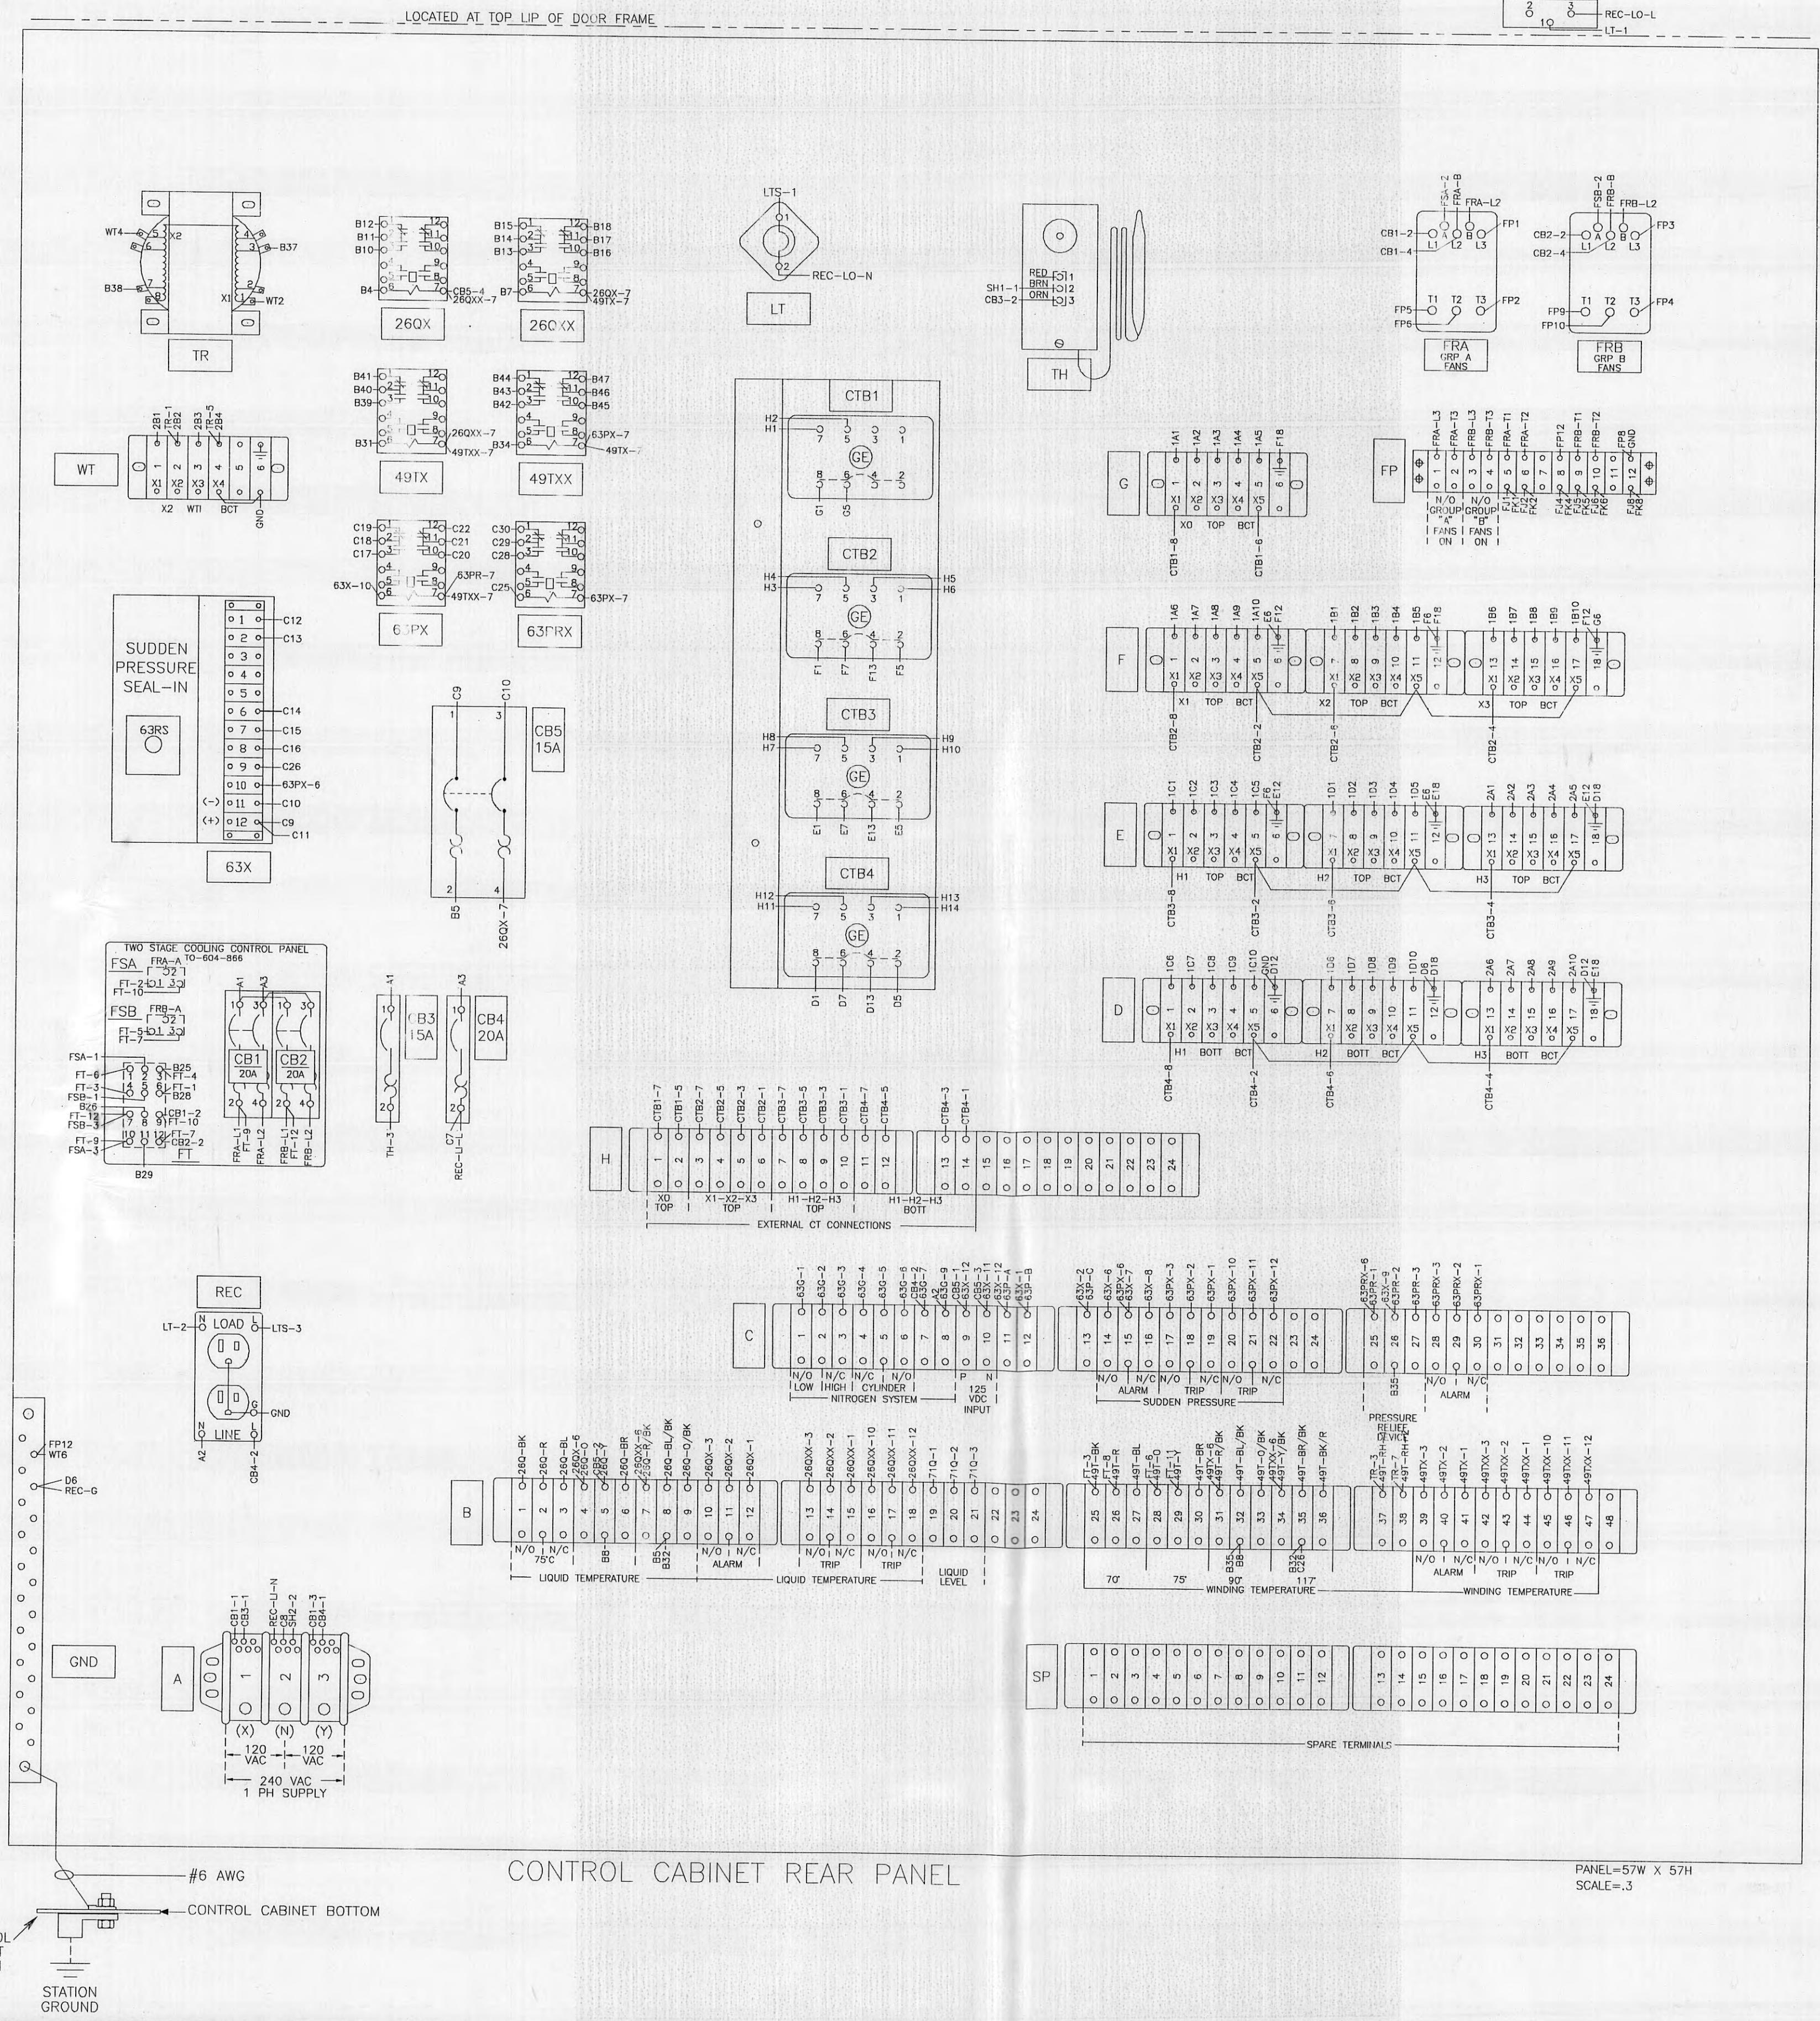


CONTROL CABINET BOTTOM

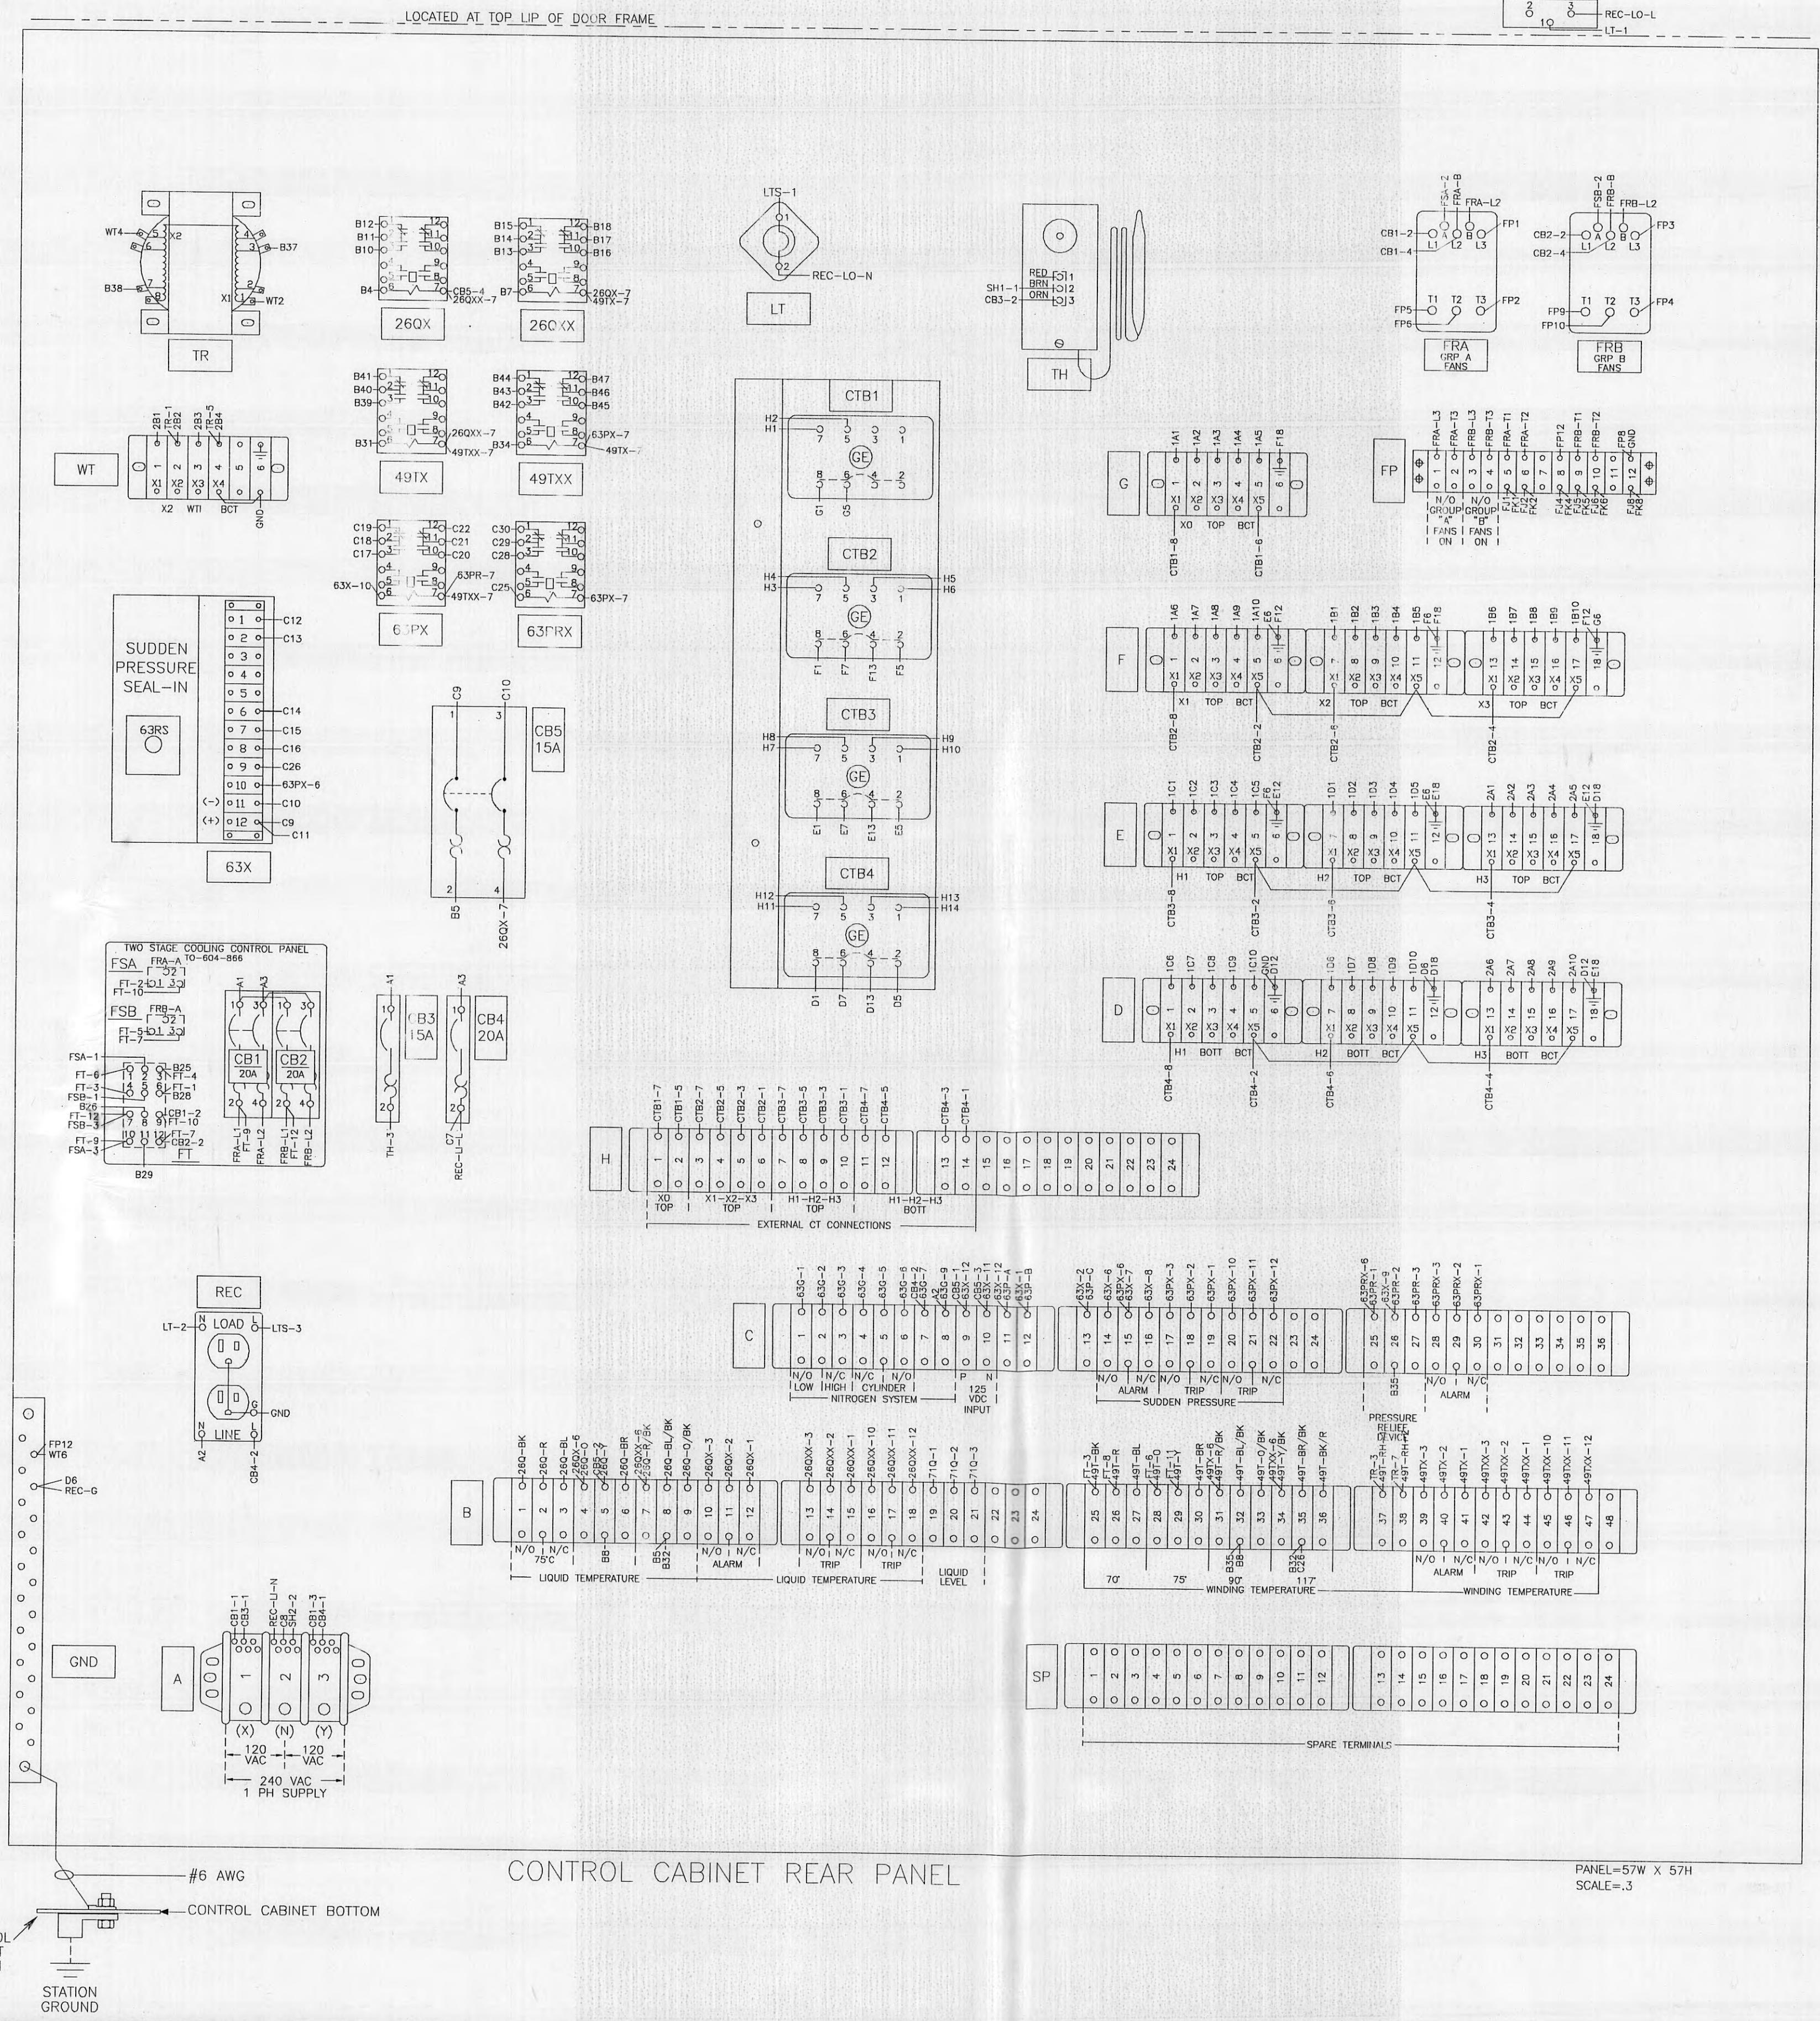


CONTROL CABINET BOTTOM

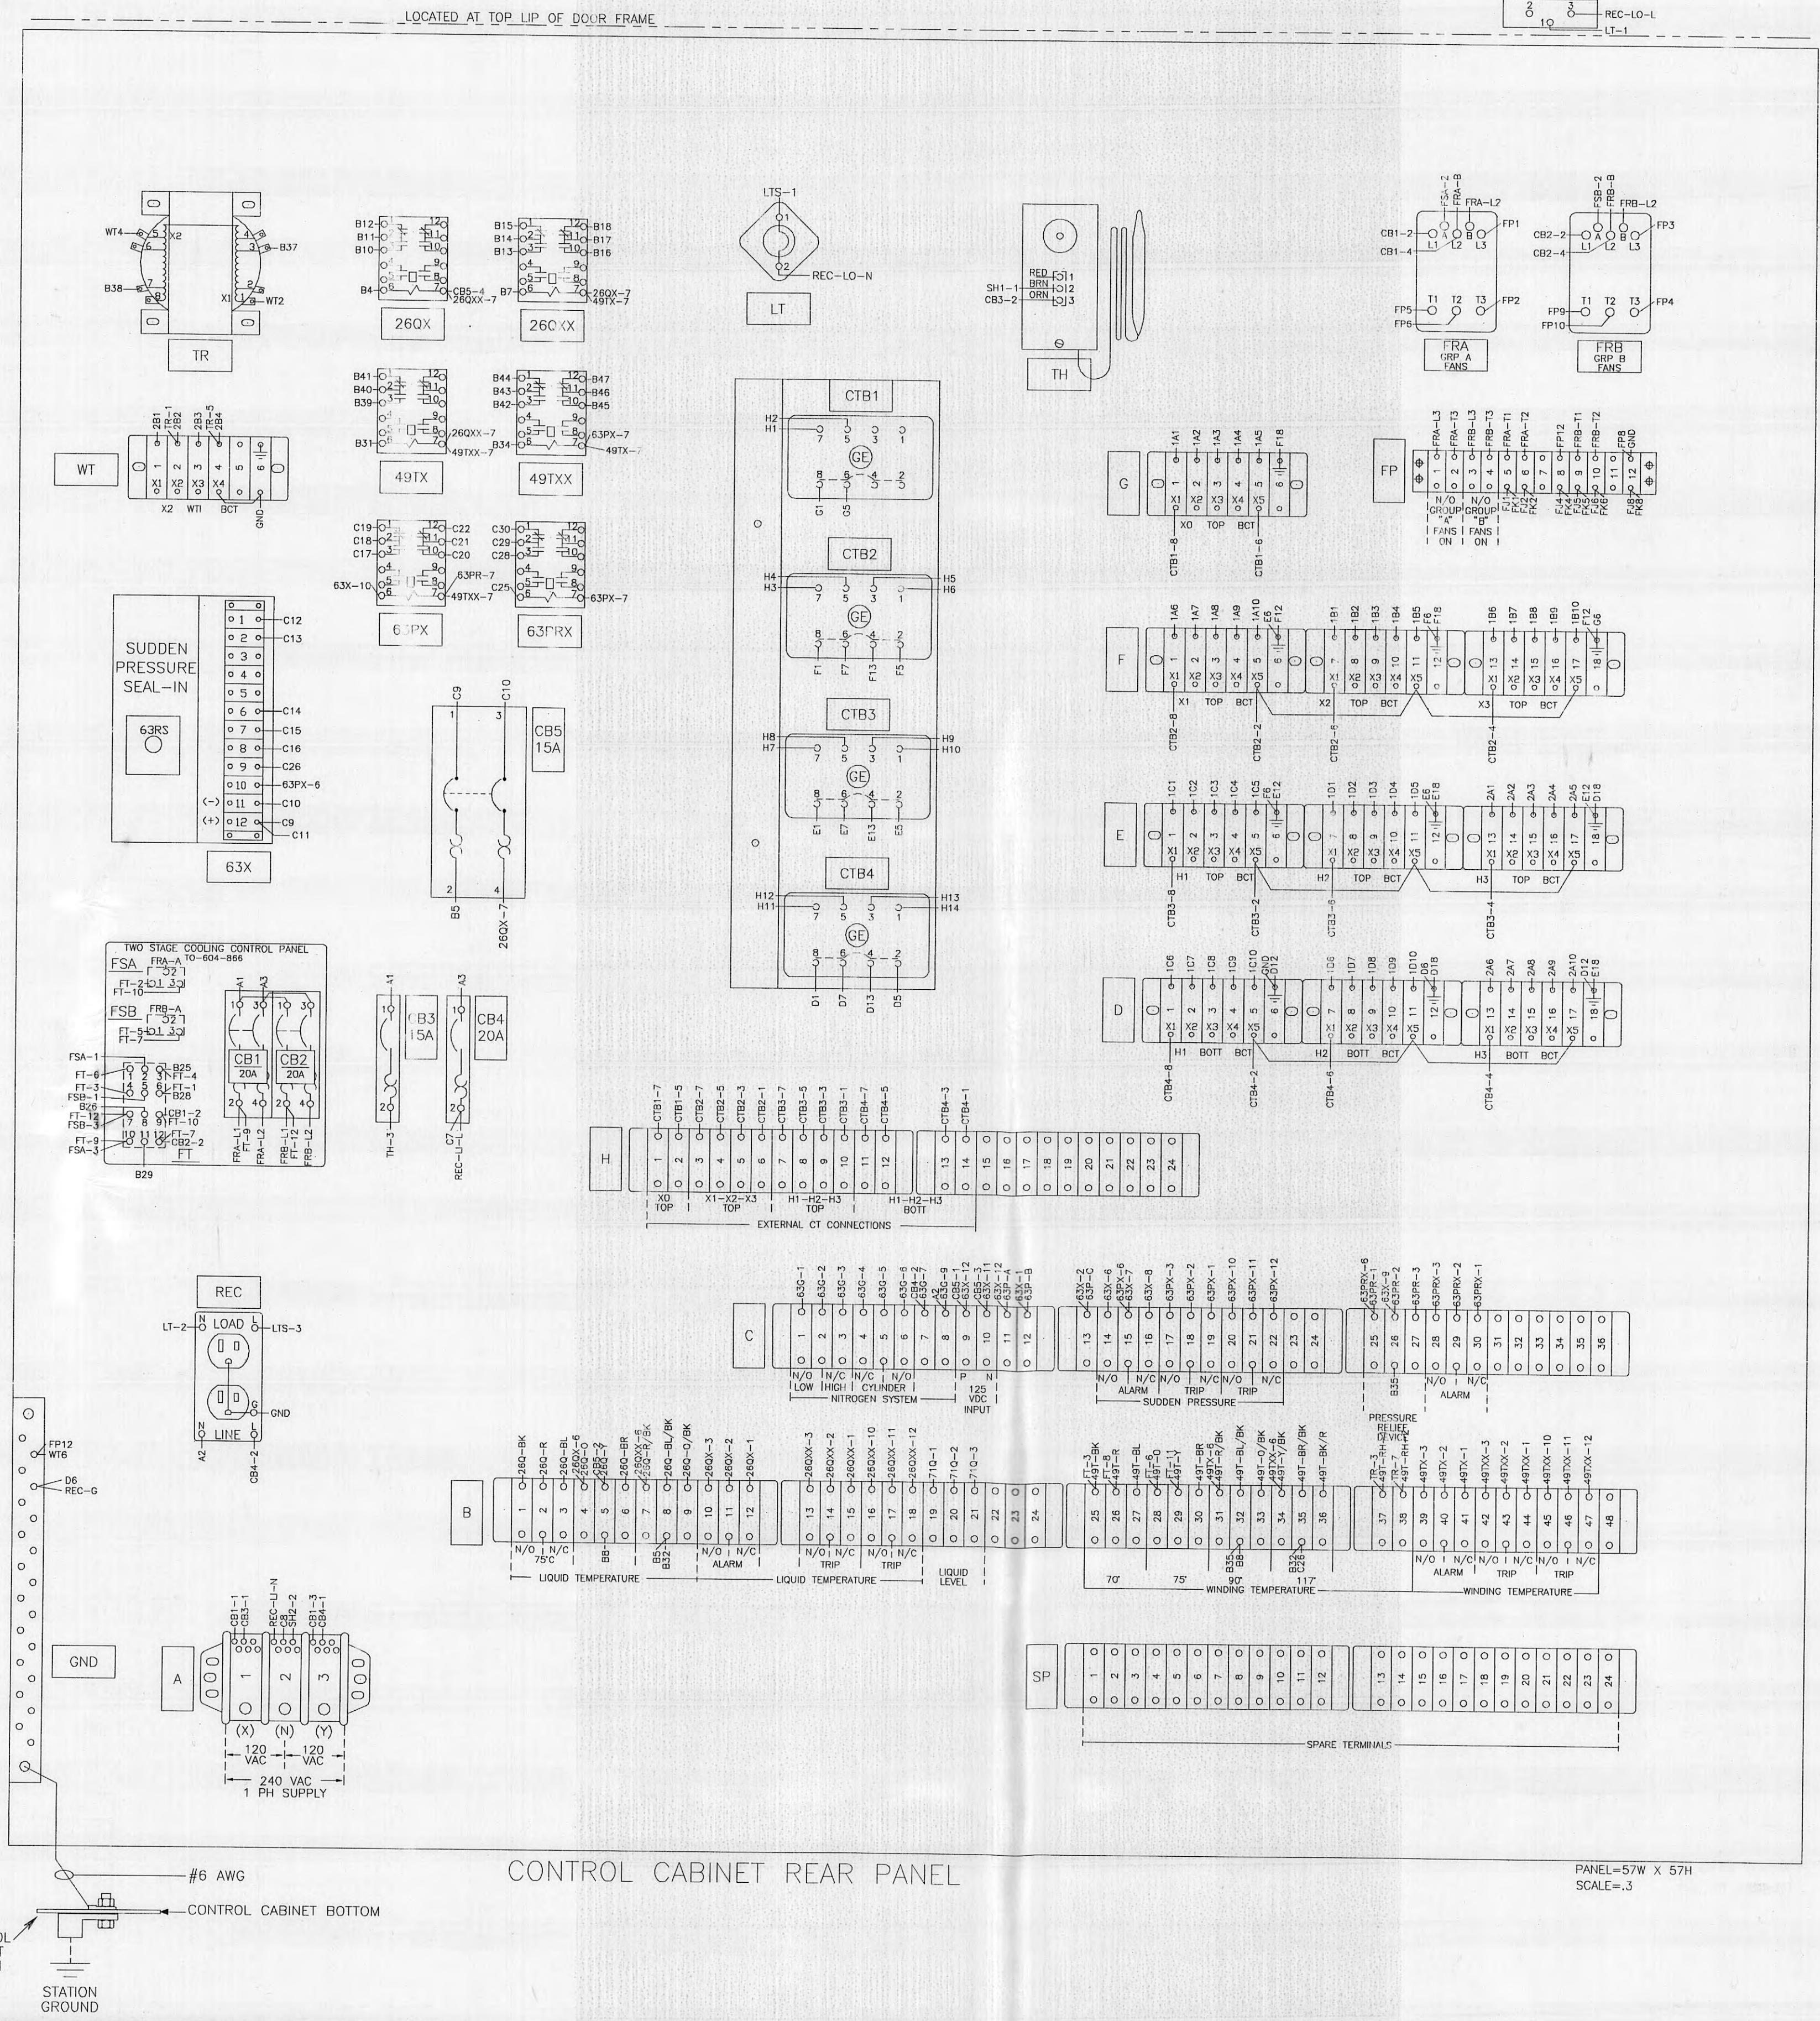


CONTROL CABINET BOTTOM

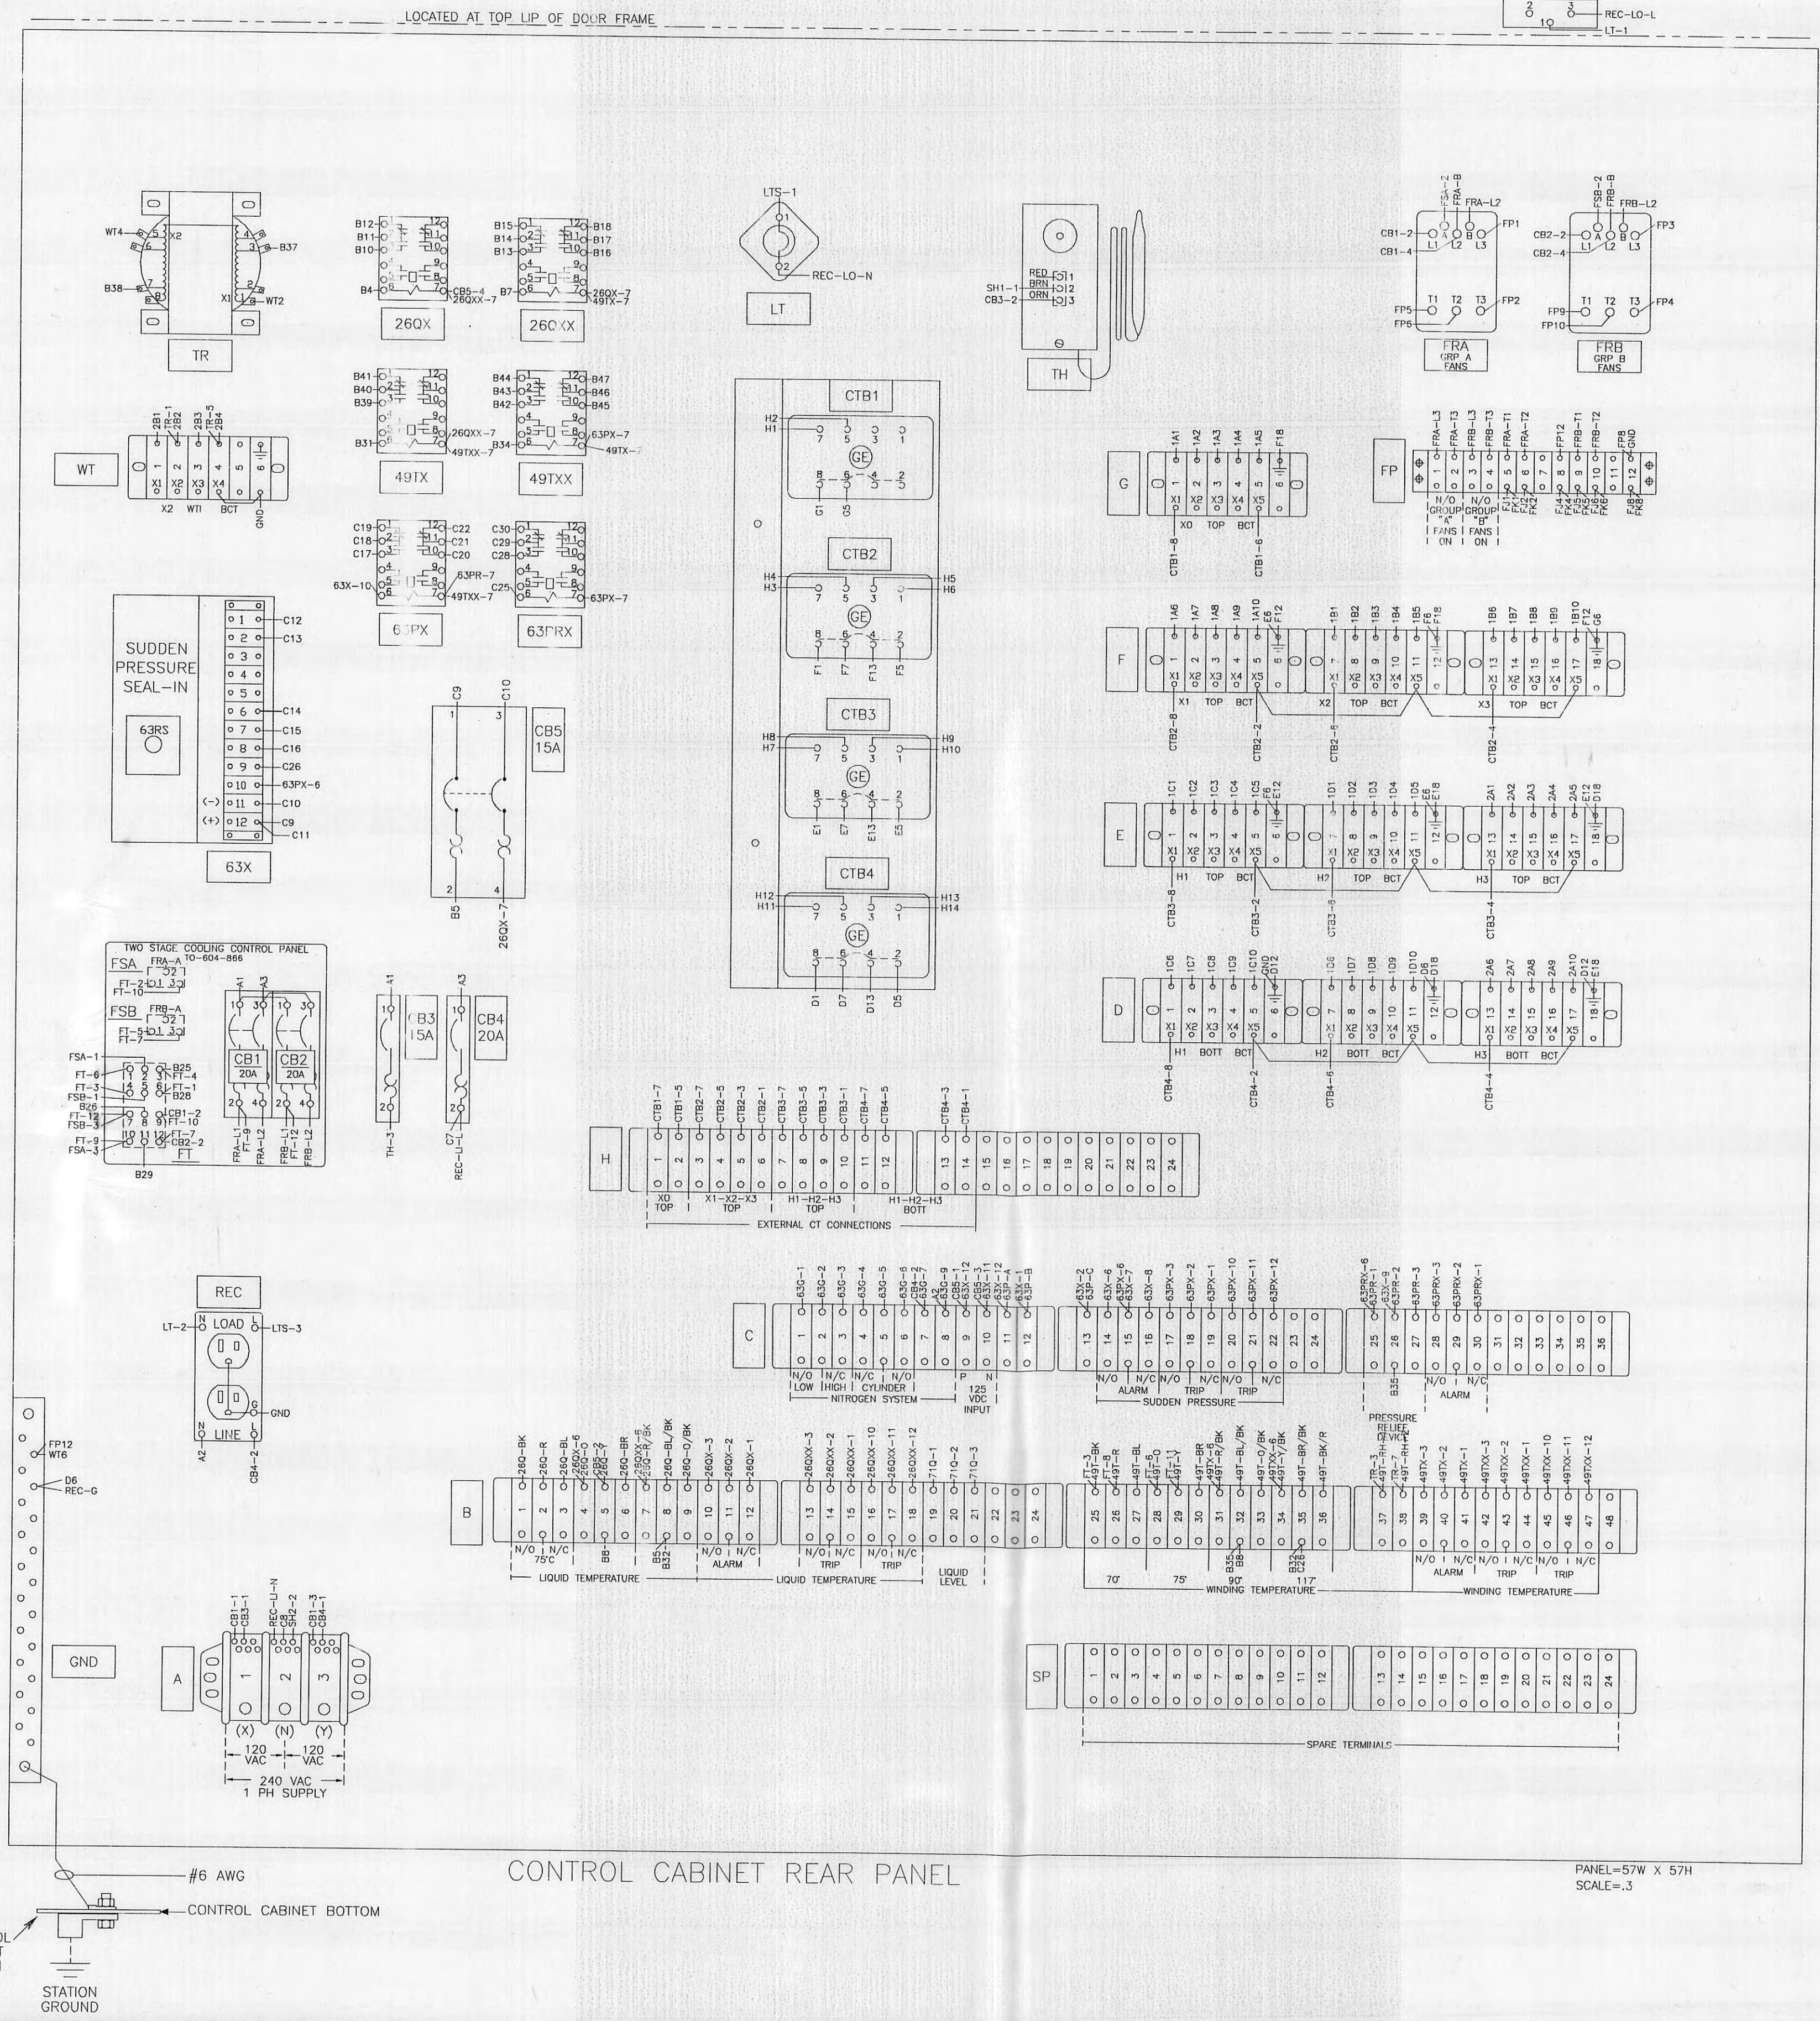


CONTROL CABINET BOTTOM

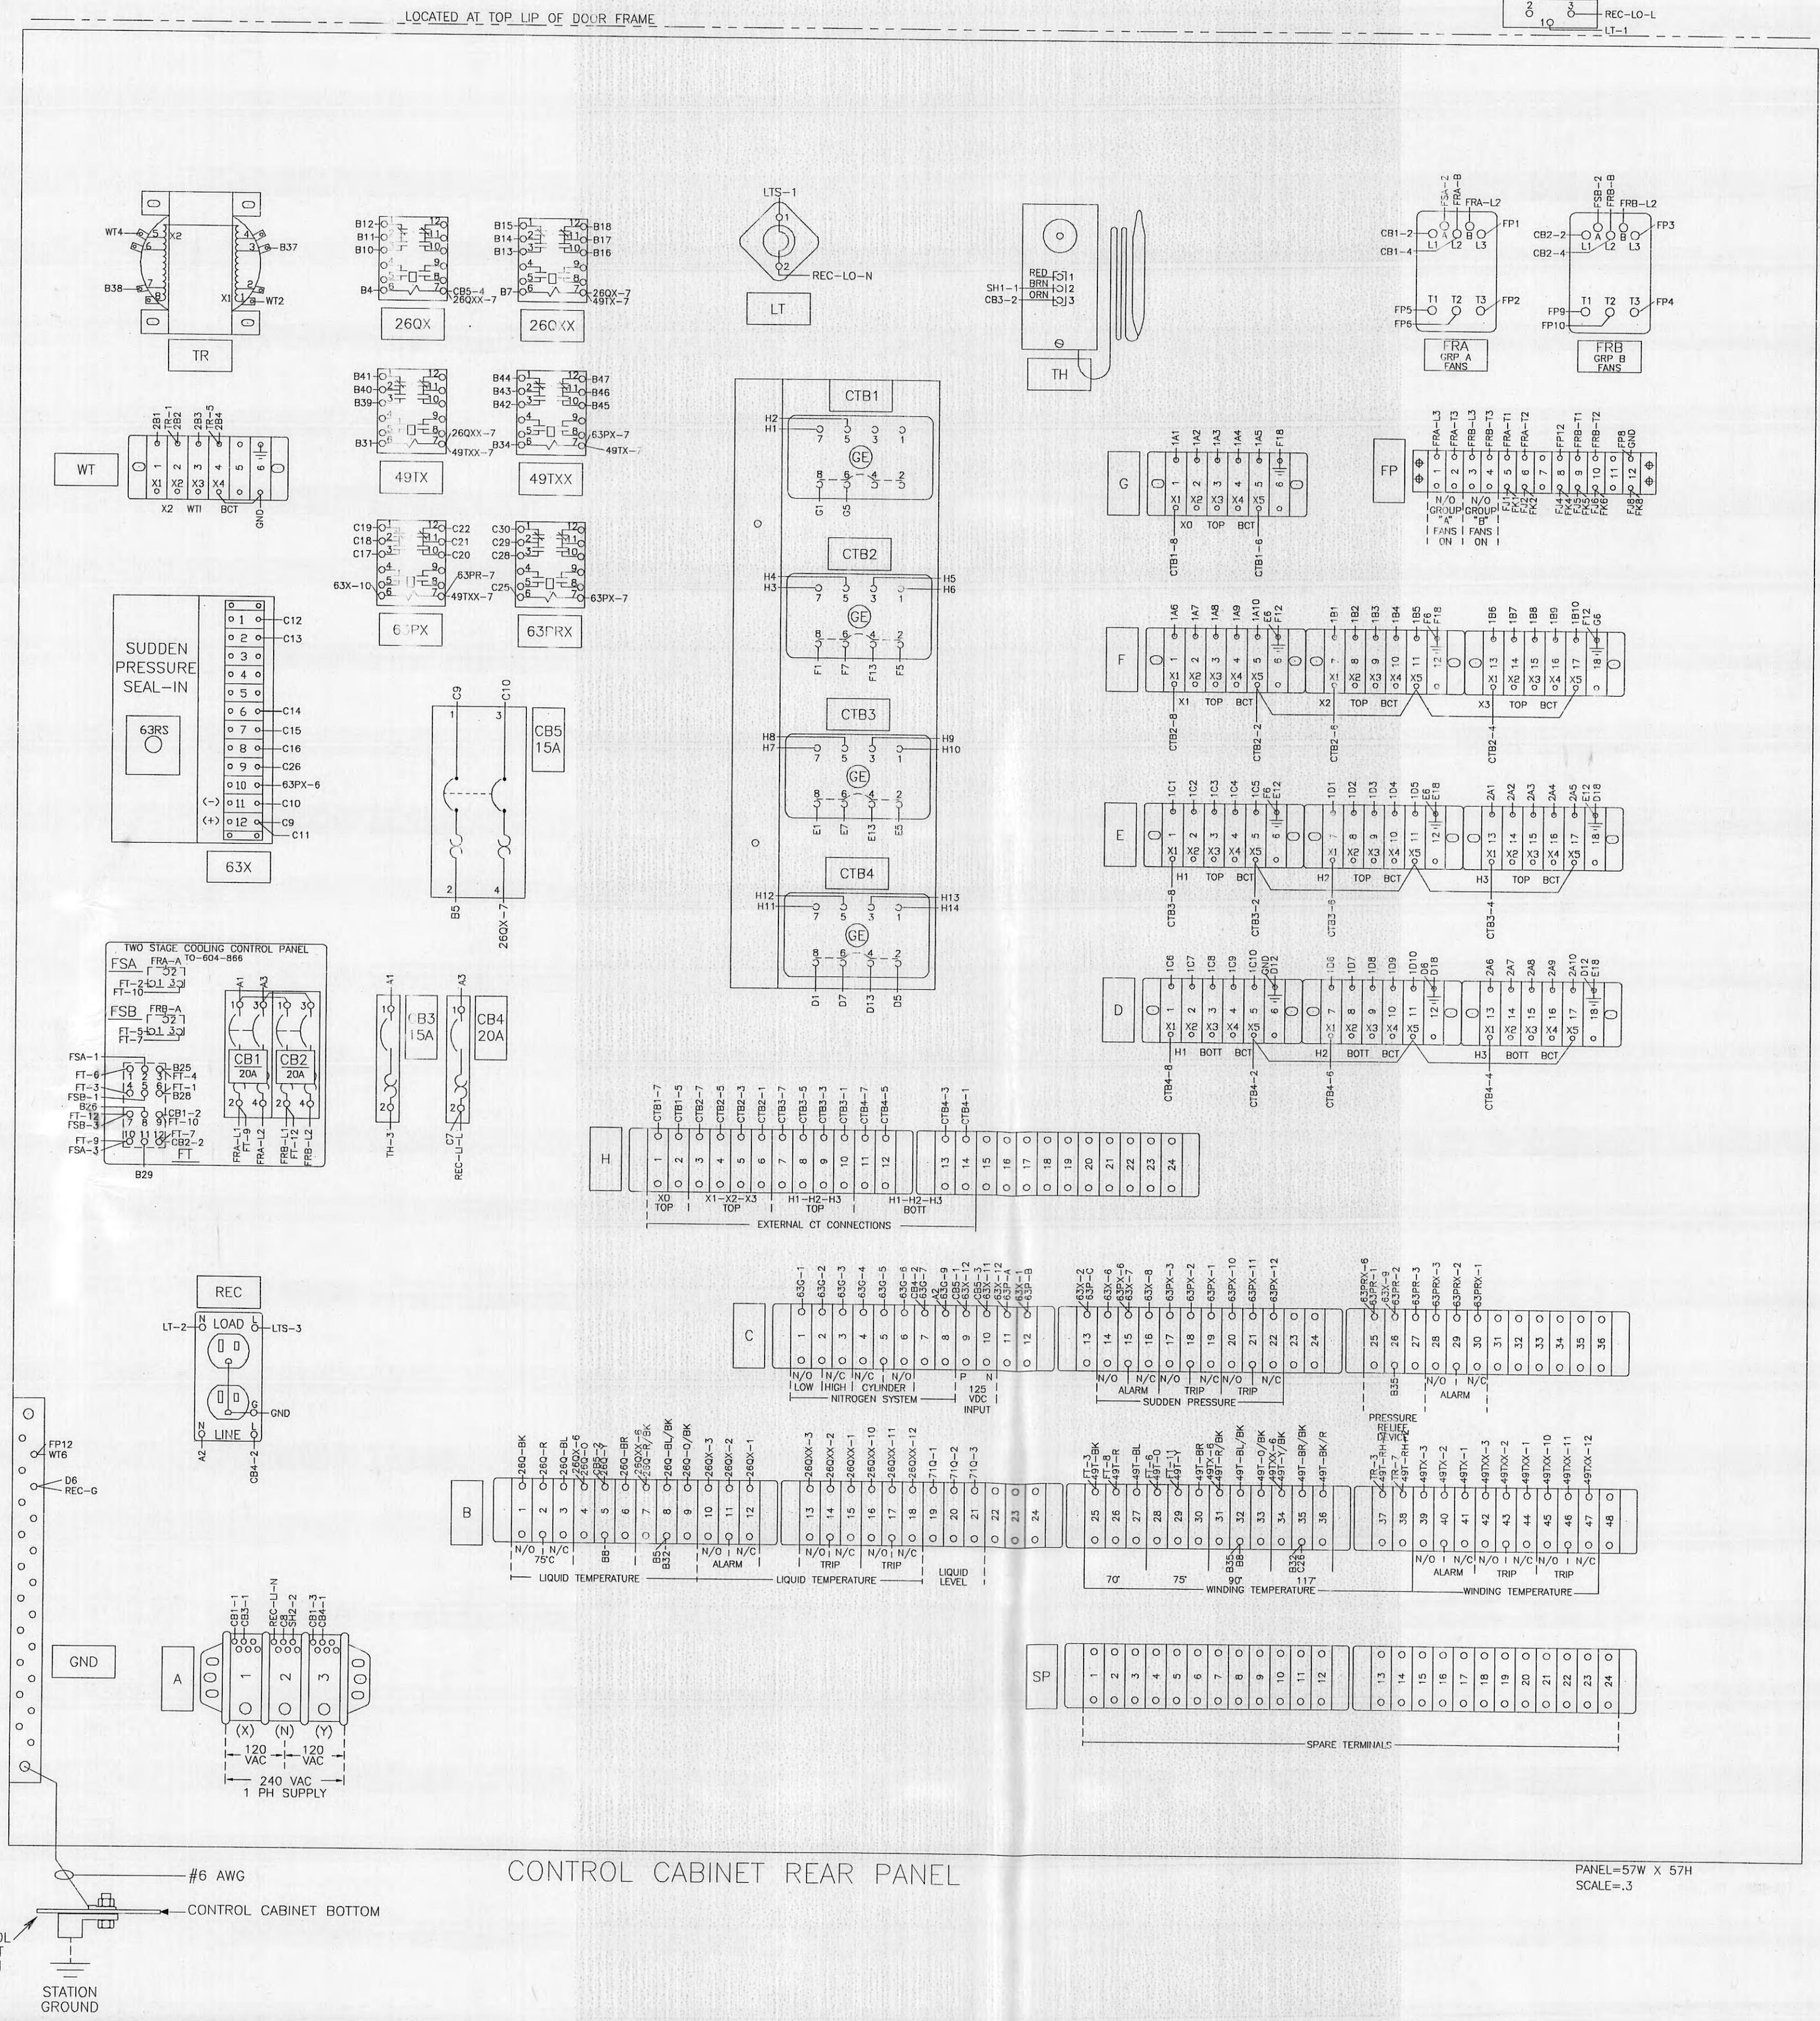


CONTROL CABINET BOTTOM

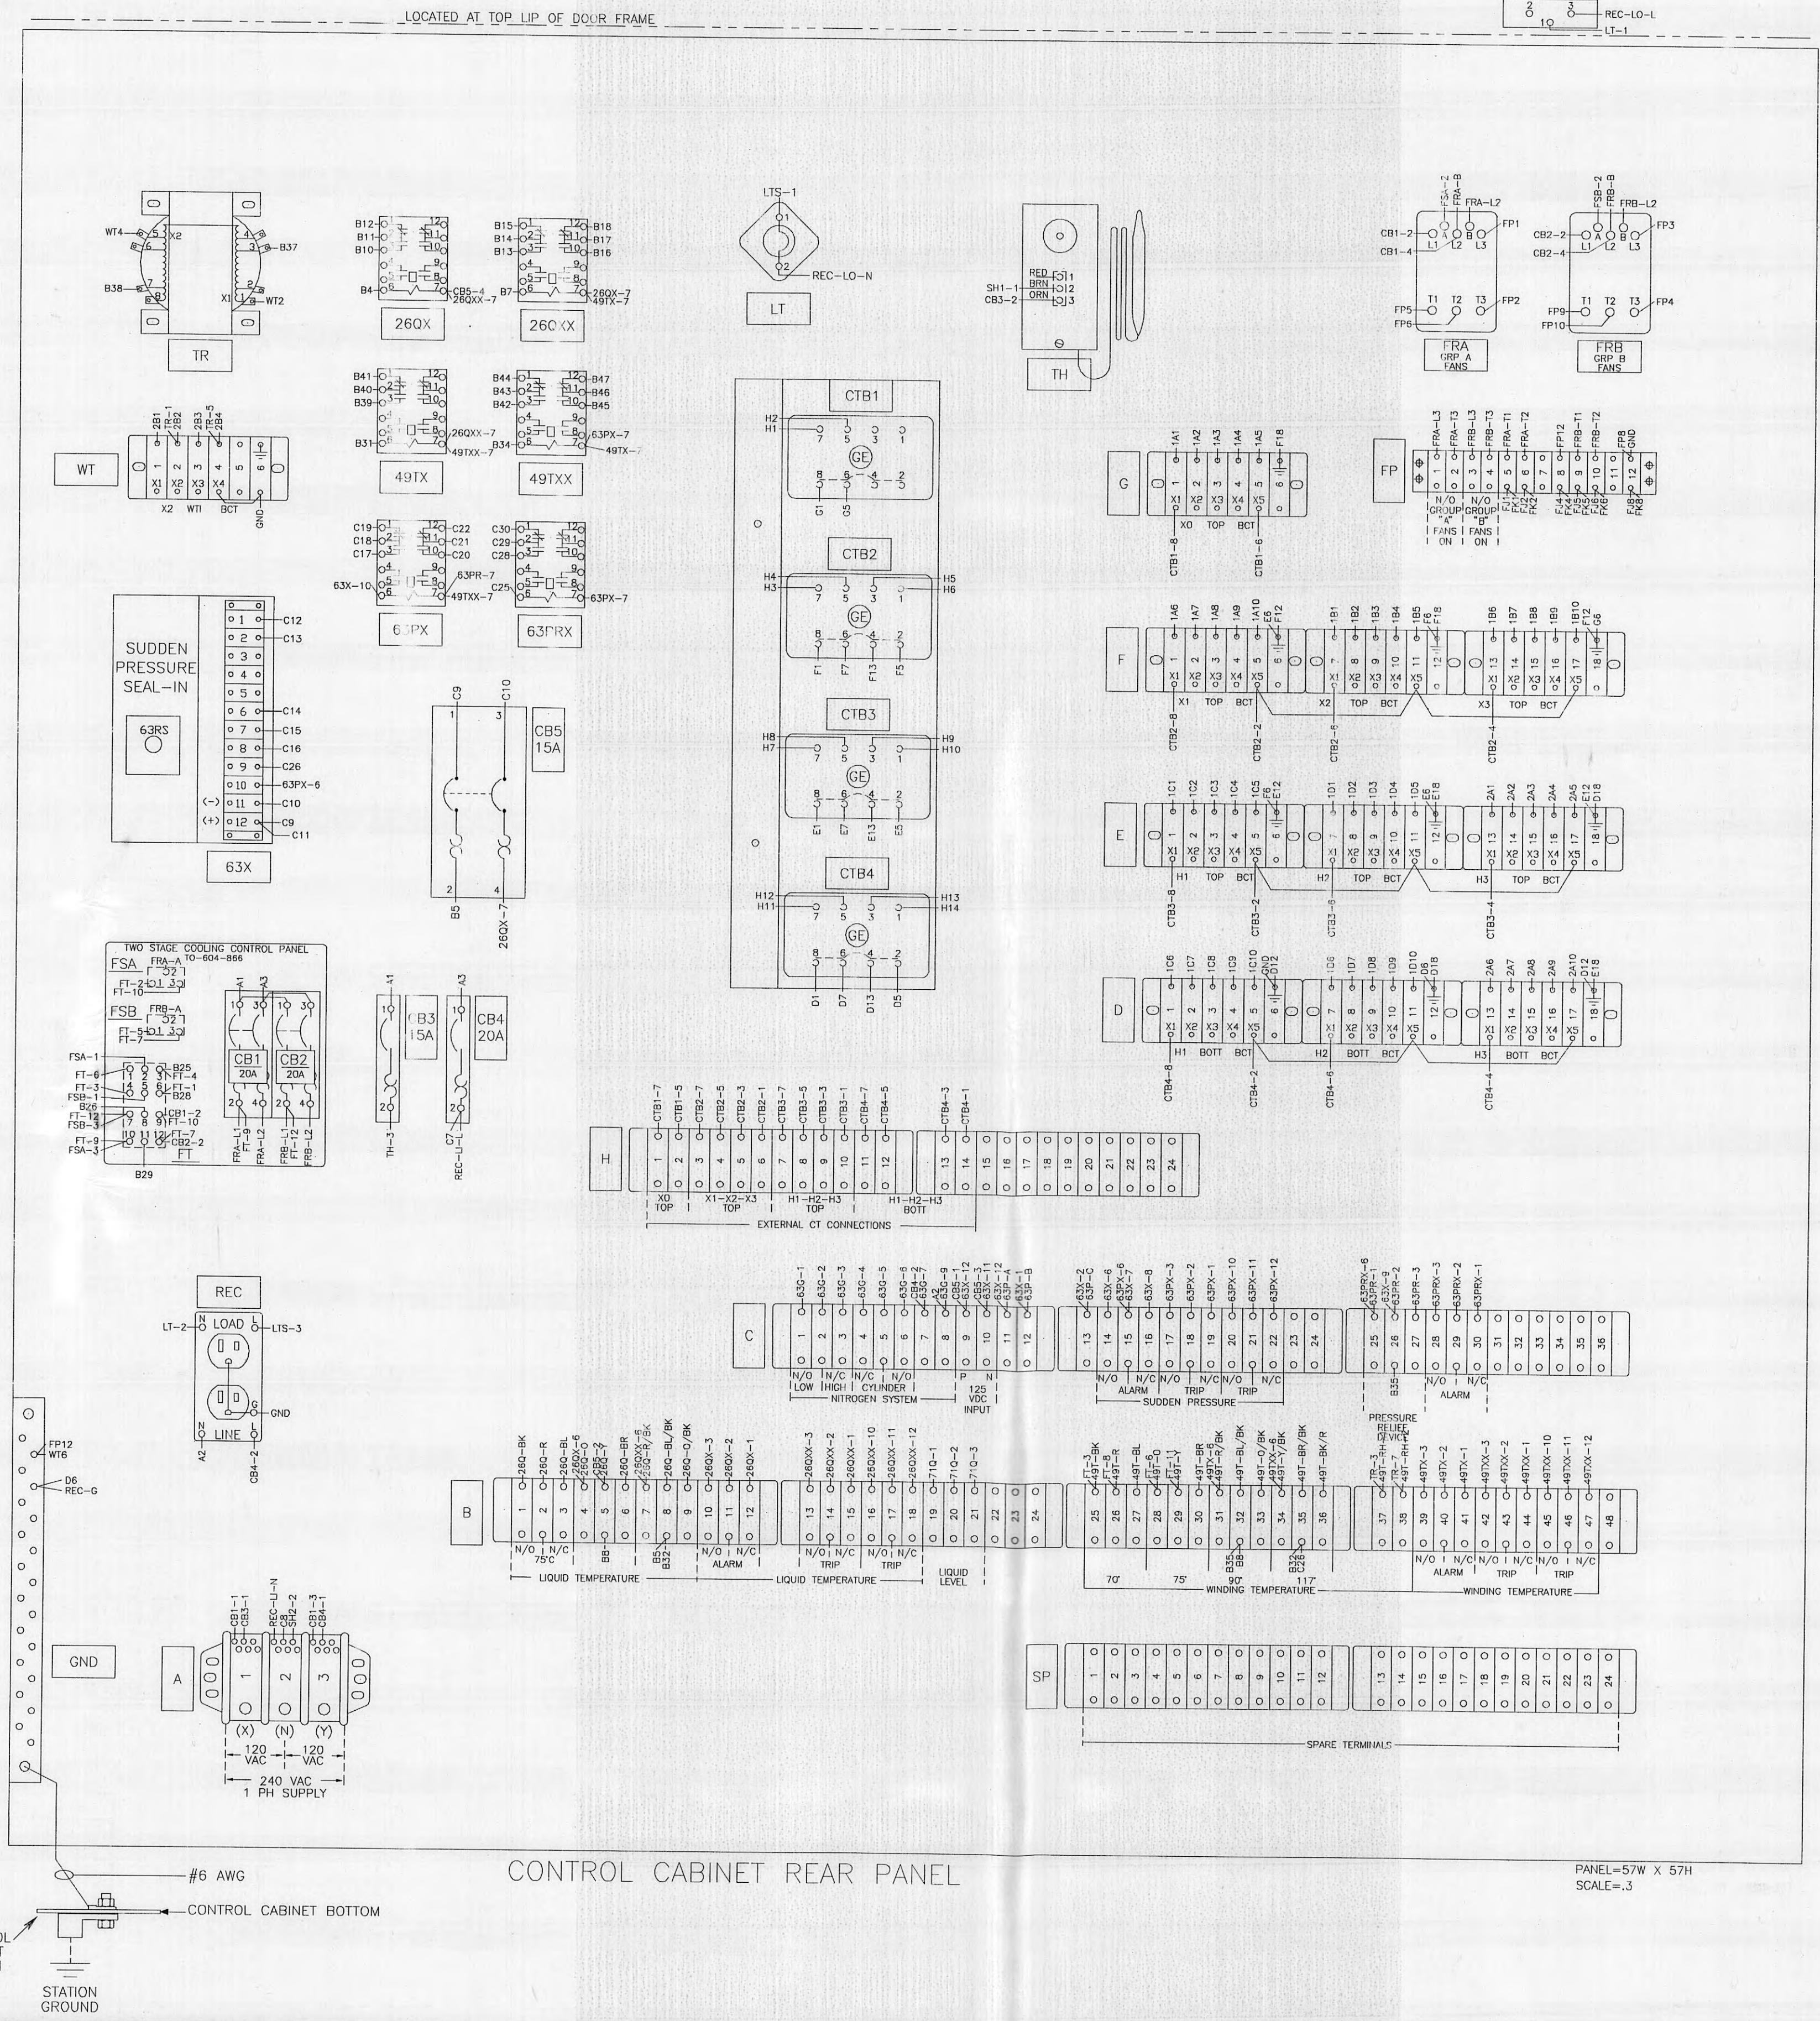


CONTROL CABINET BOTTOM

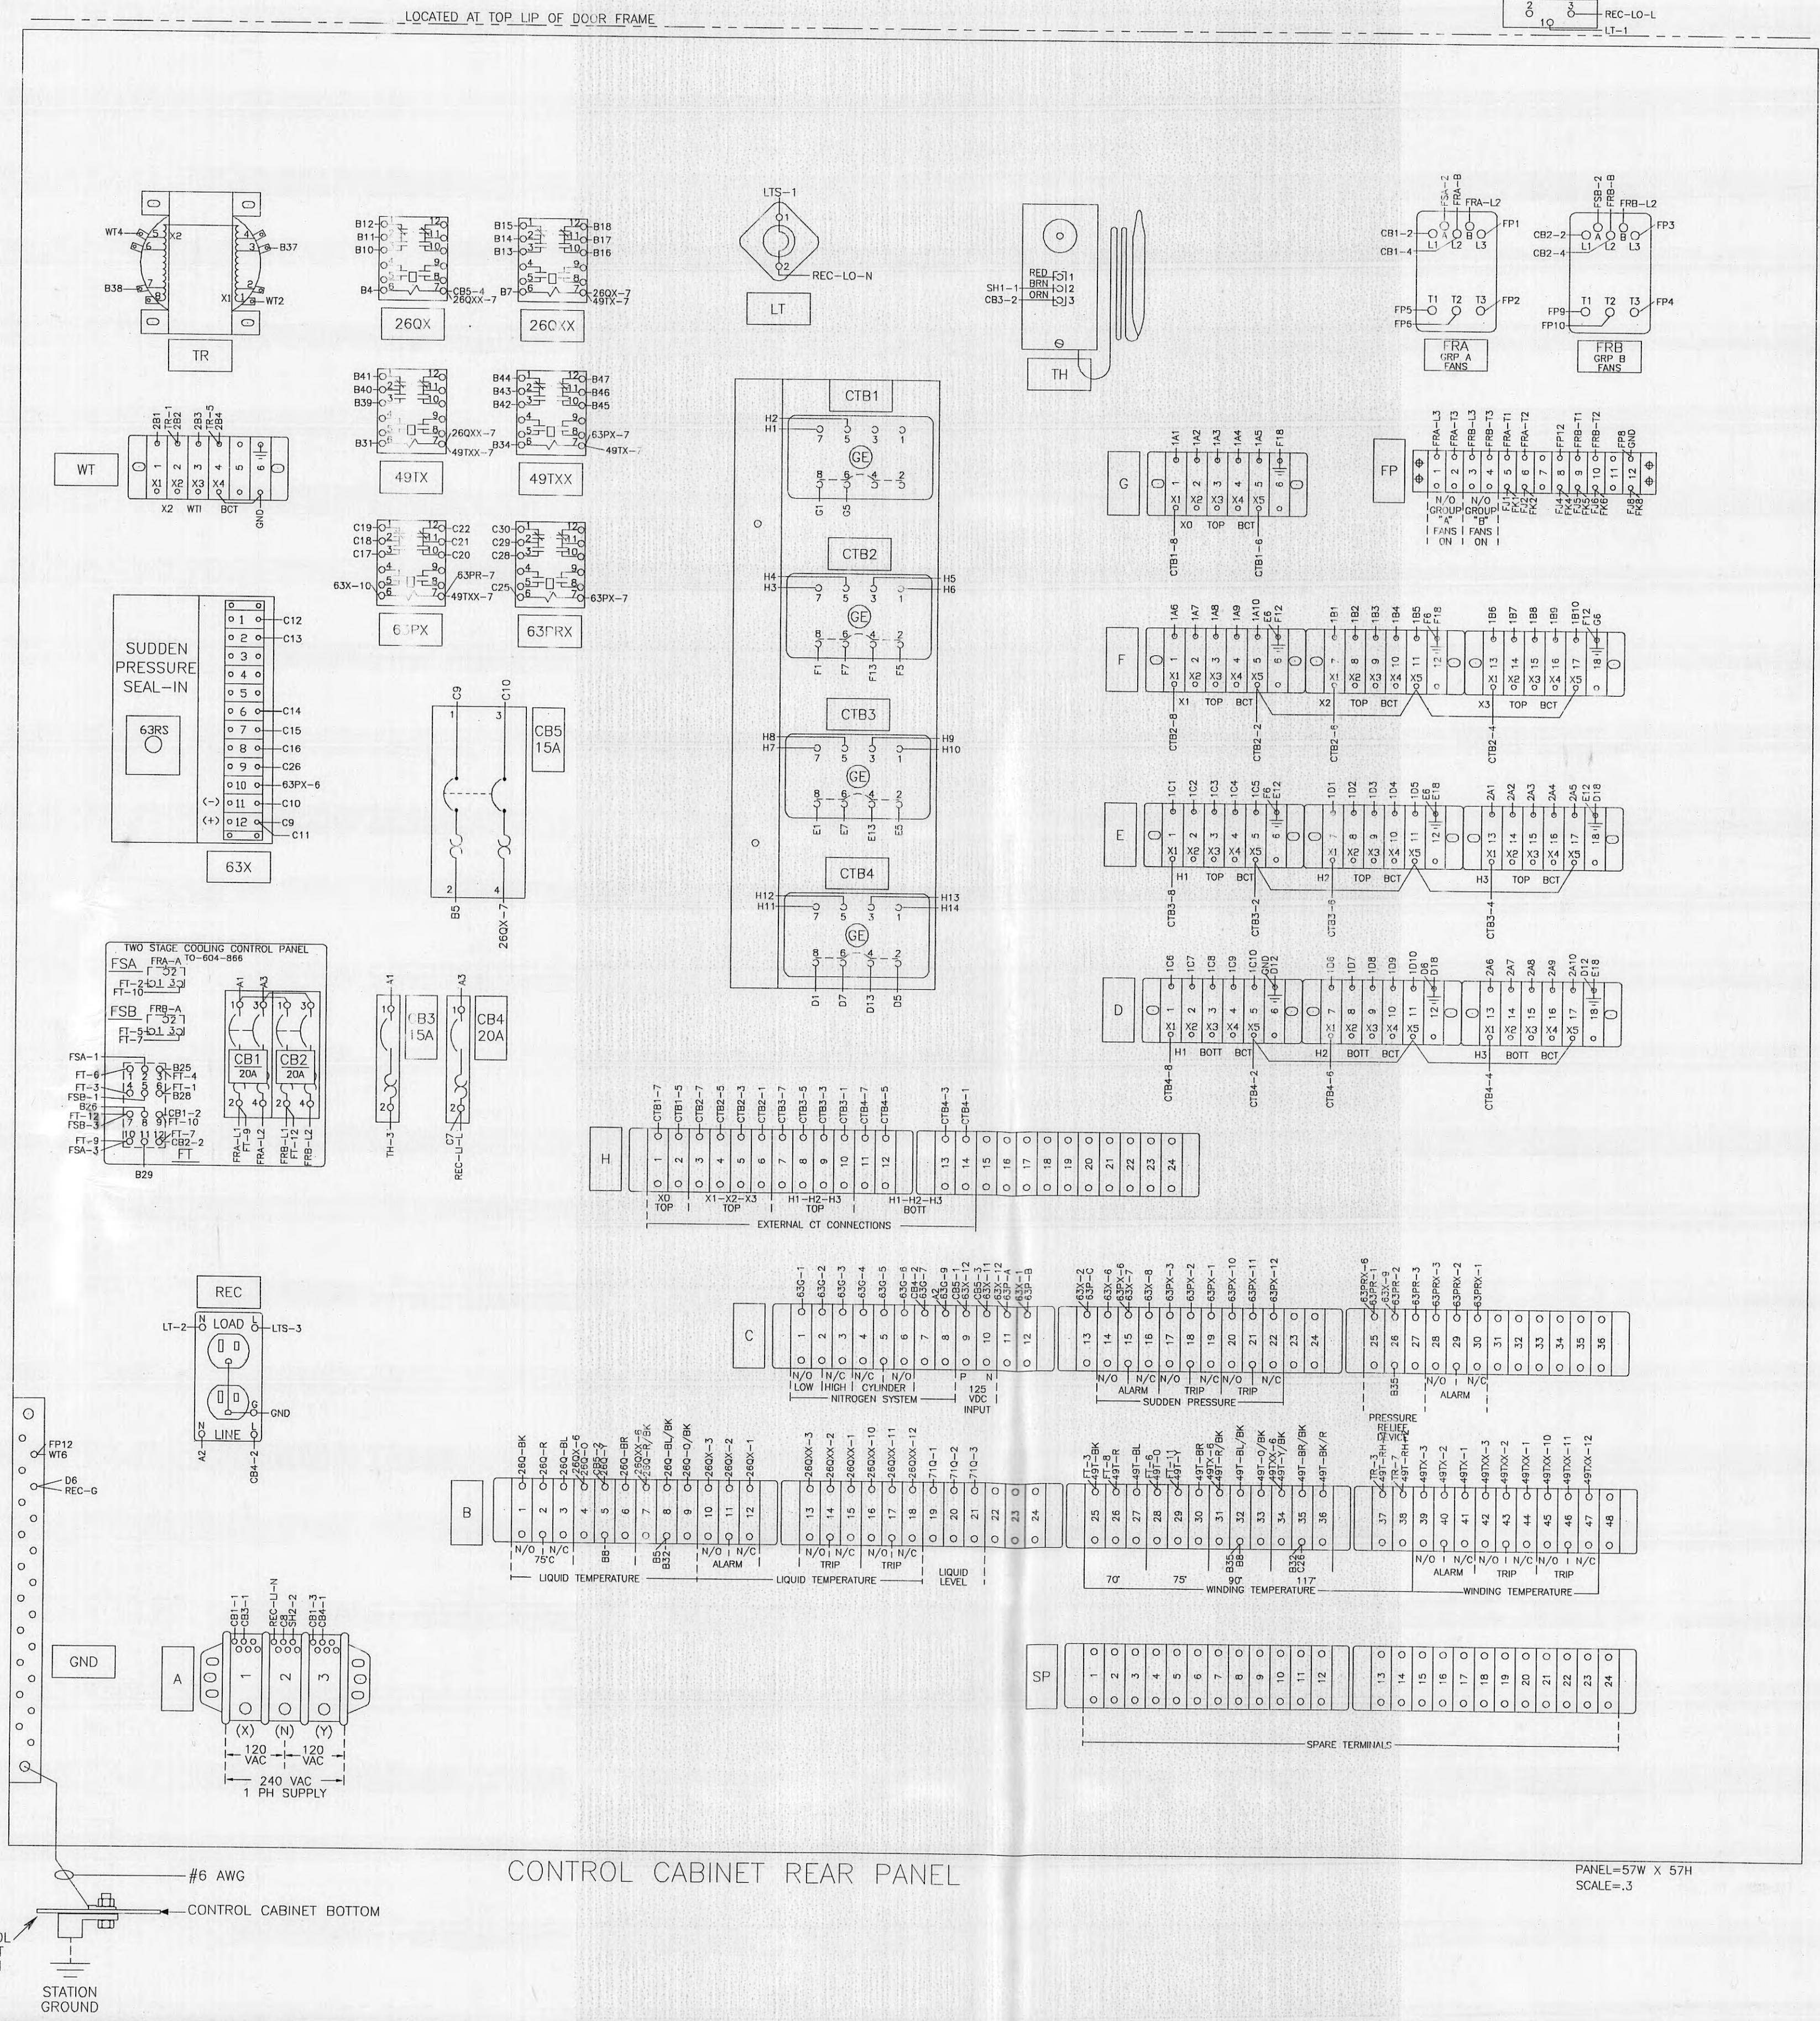


CONTROL CABINET BOTTOM

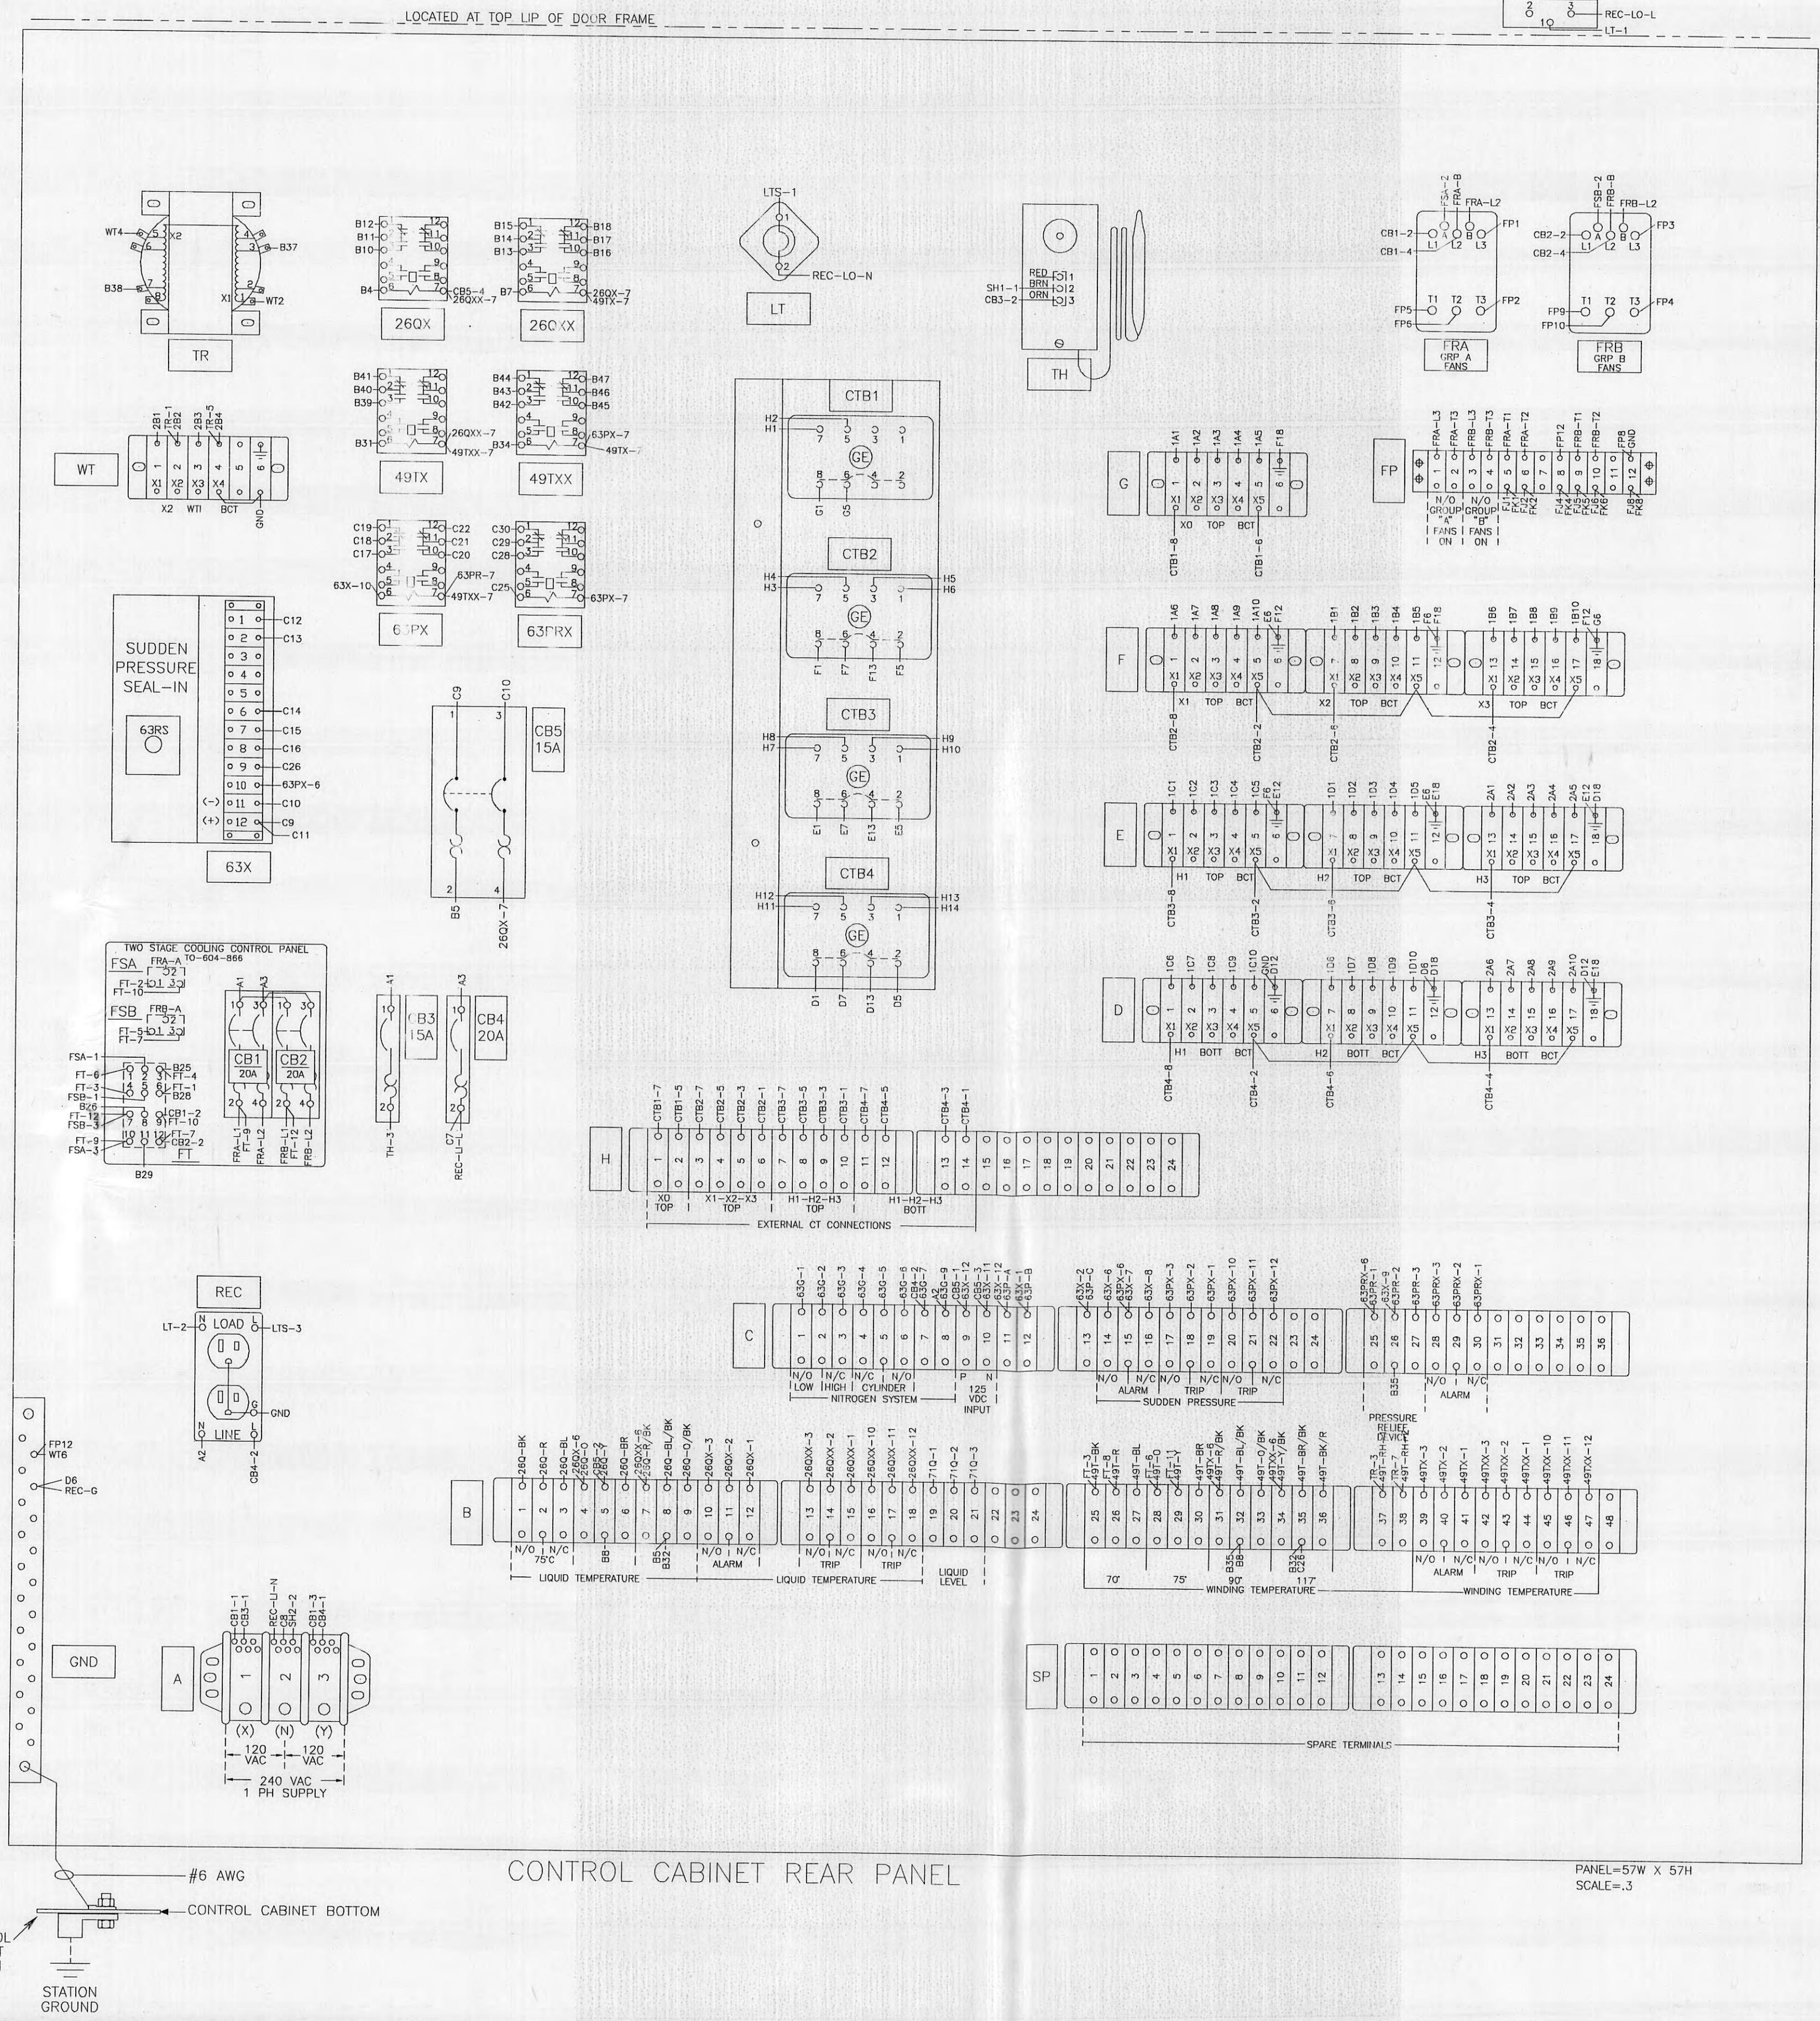


CONTROL CABINET BOTTOM

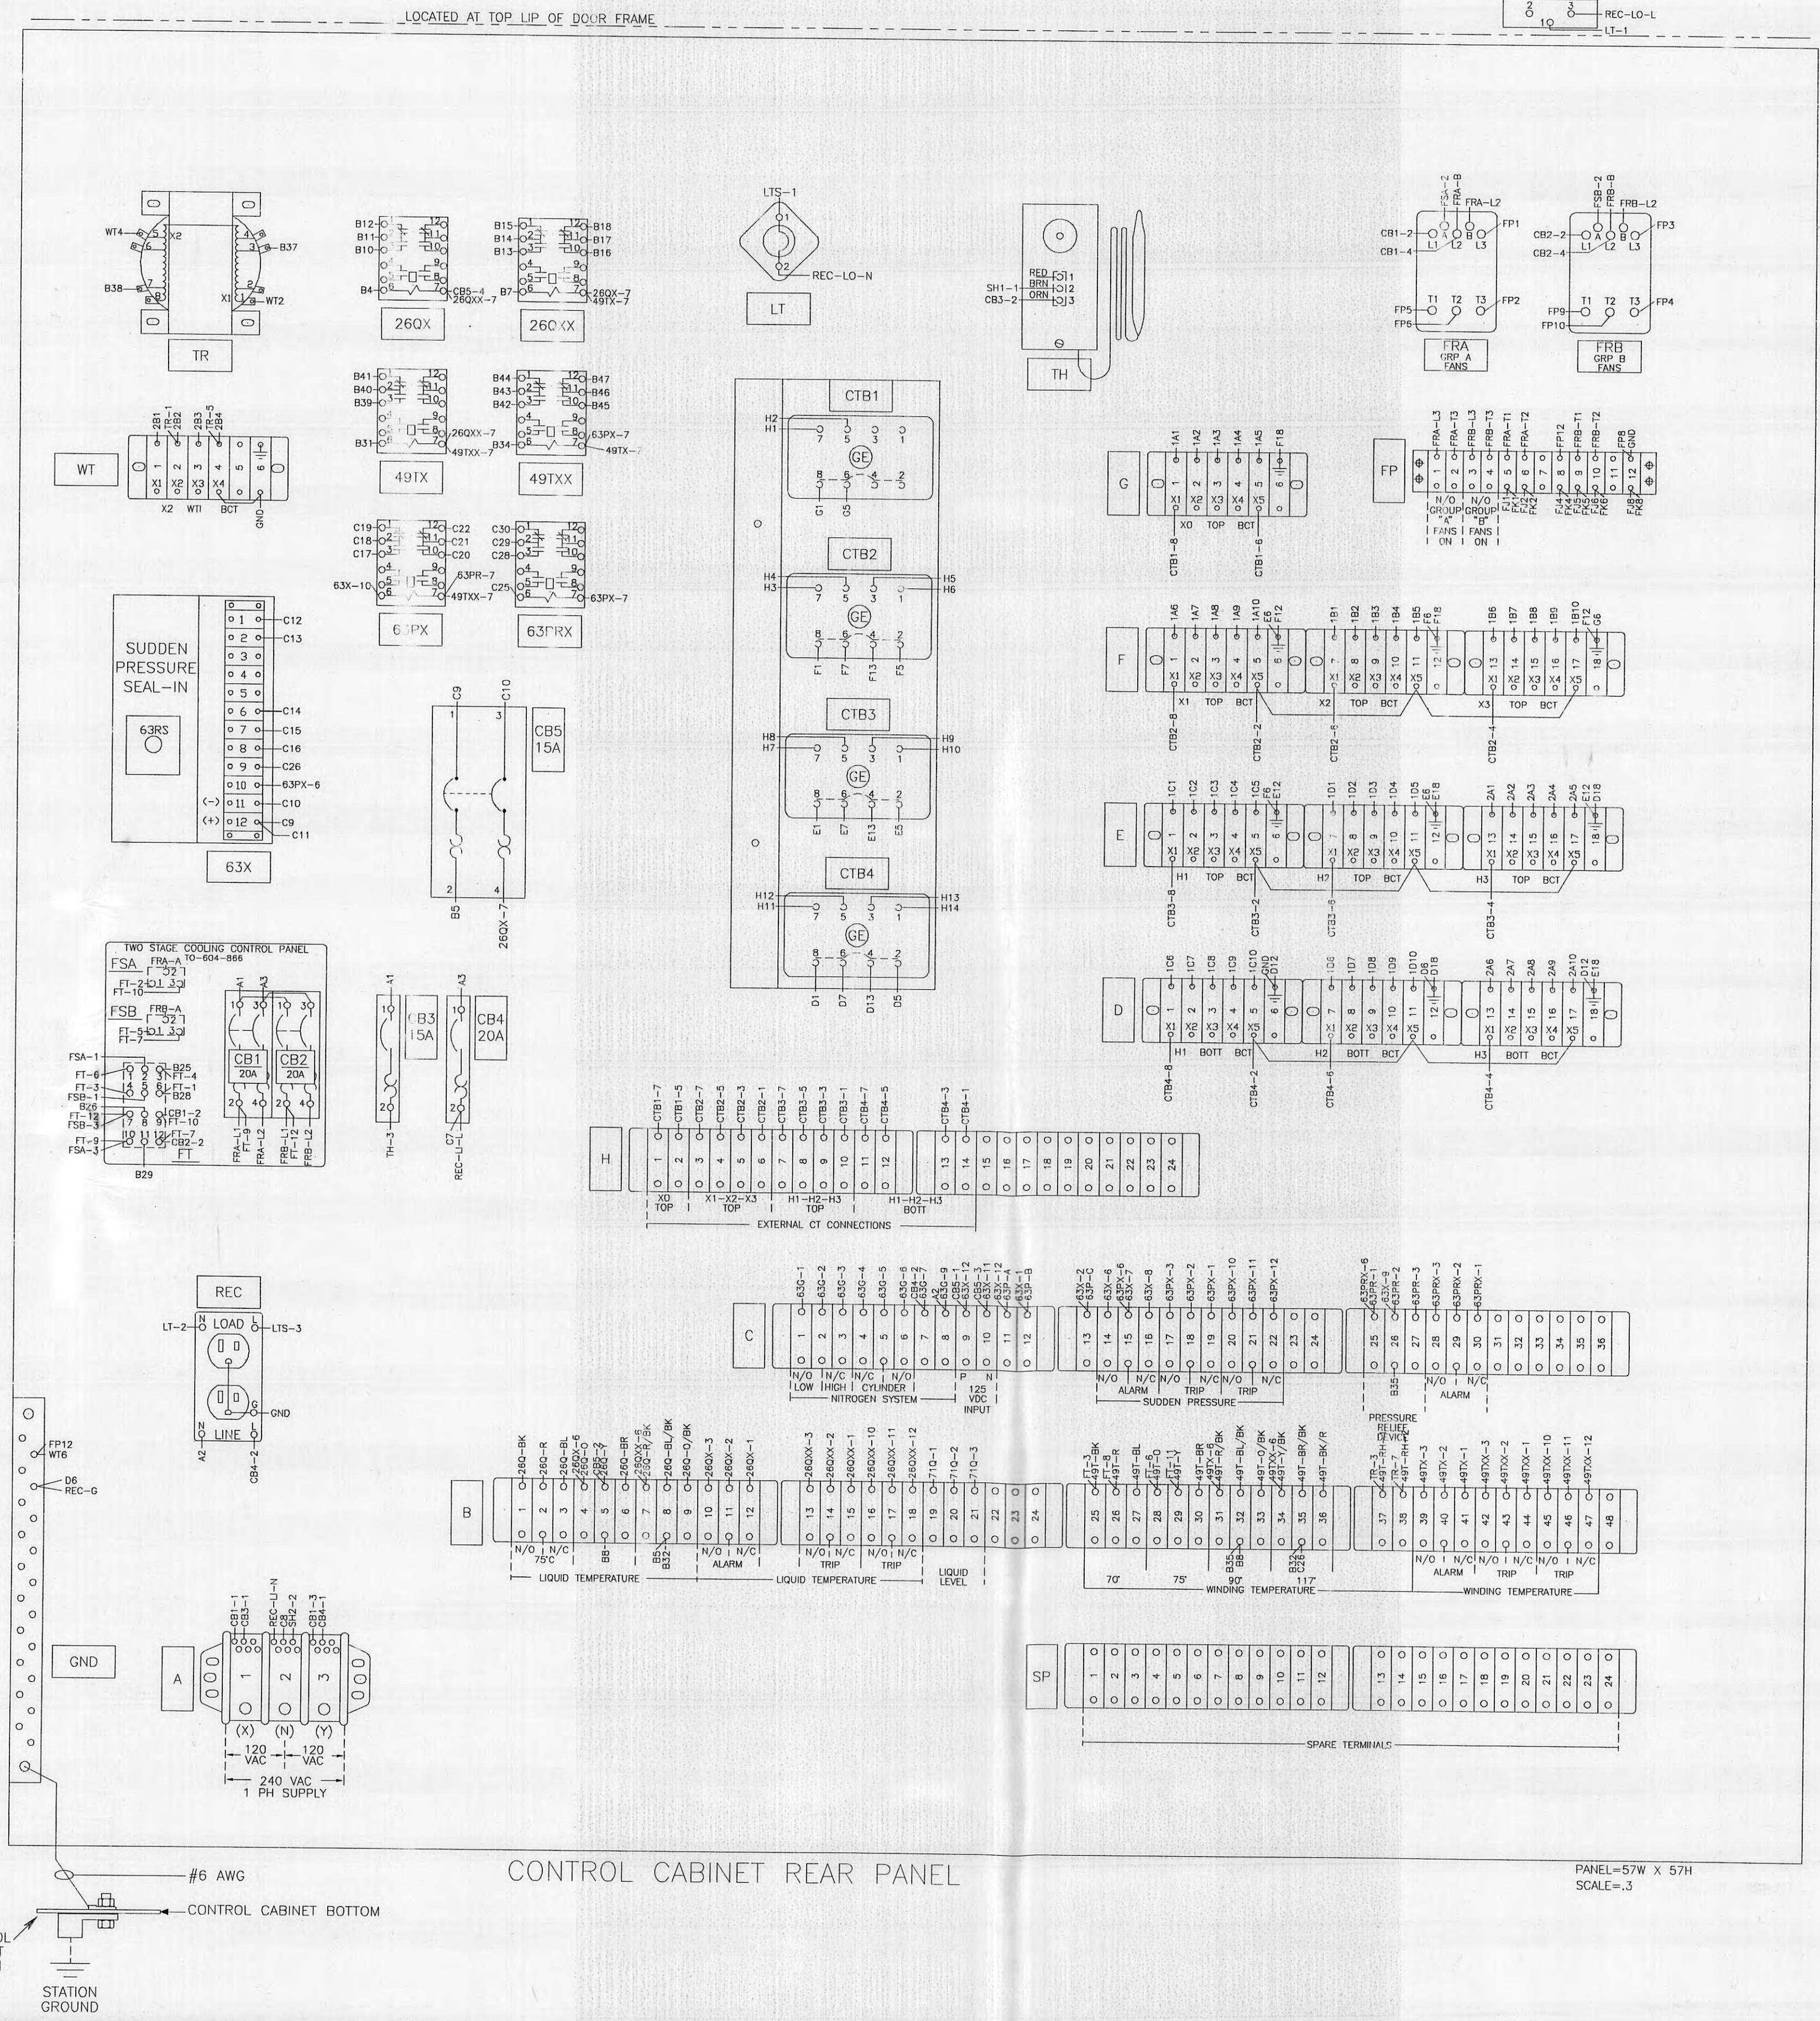


CONTROL CABINET BOTTOM

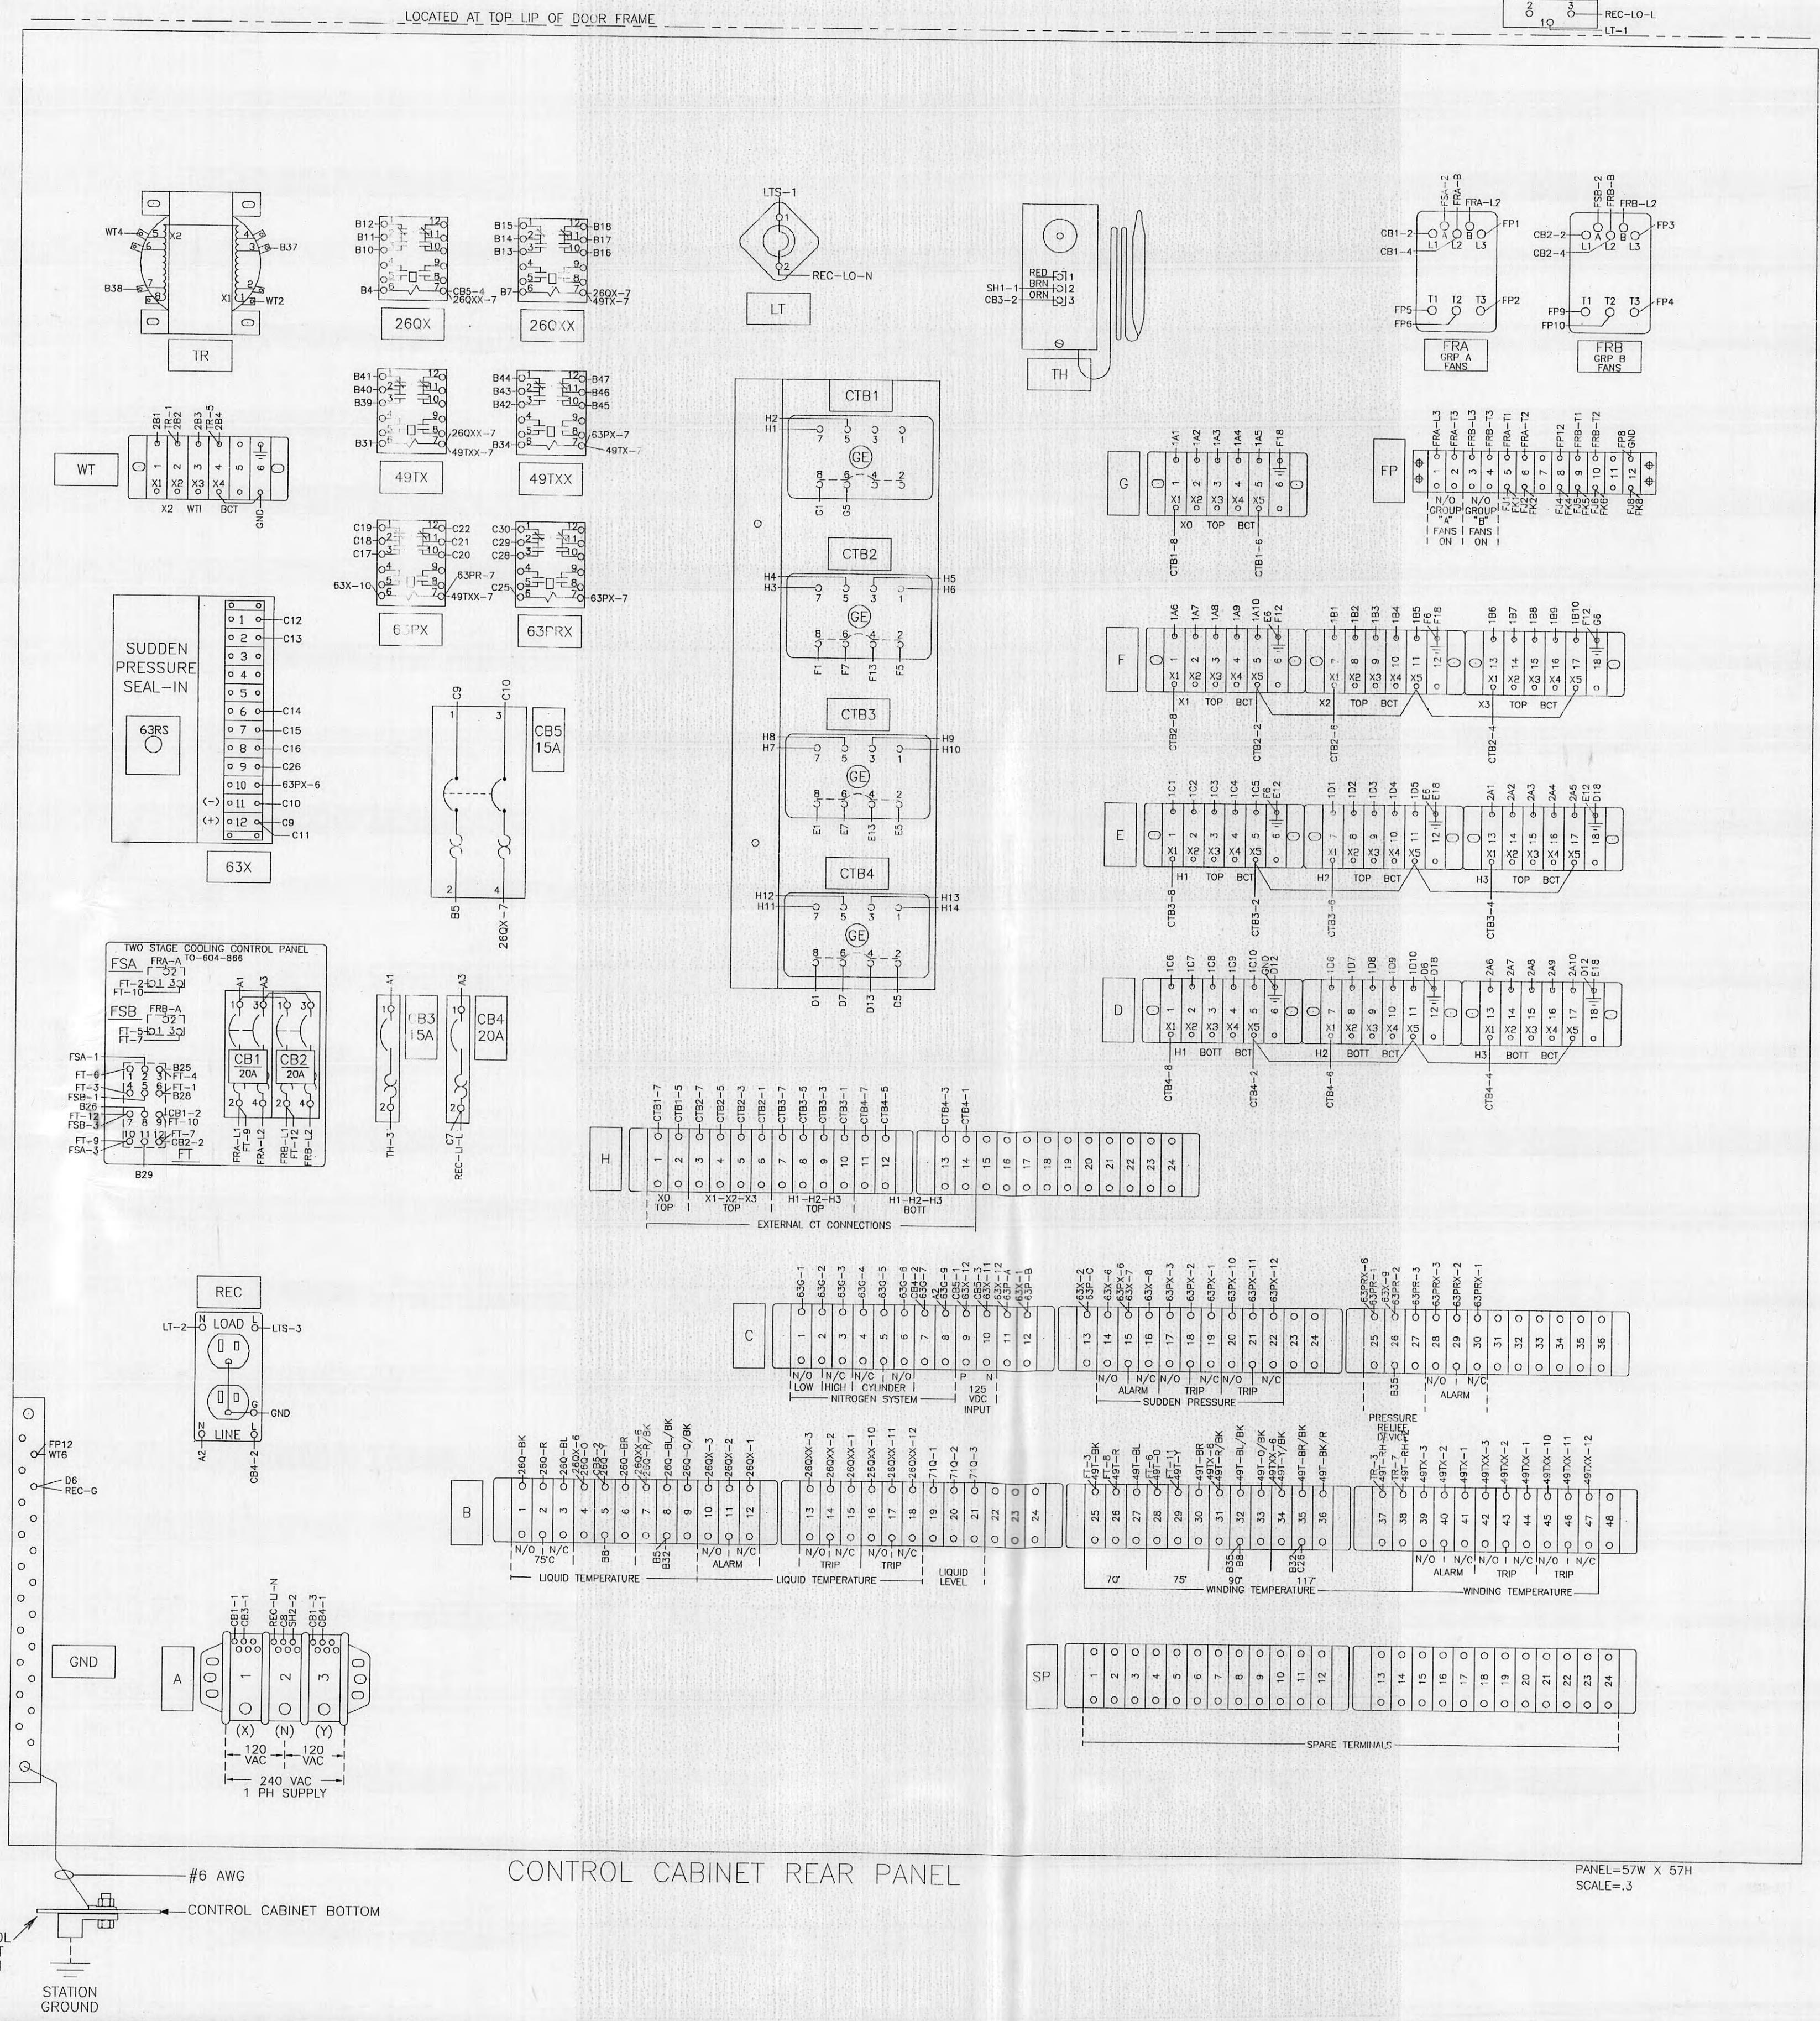


CONTROL CABINET BOTTOM

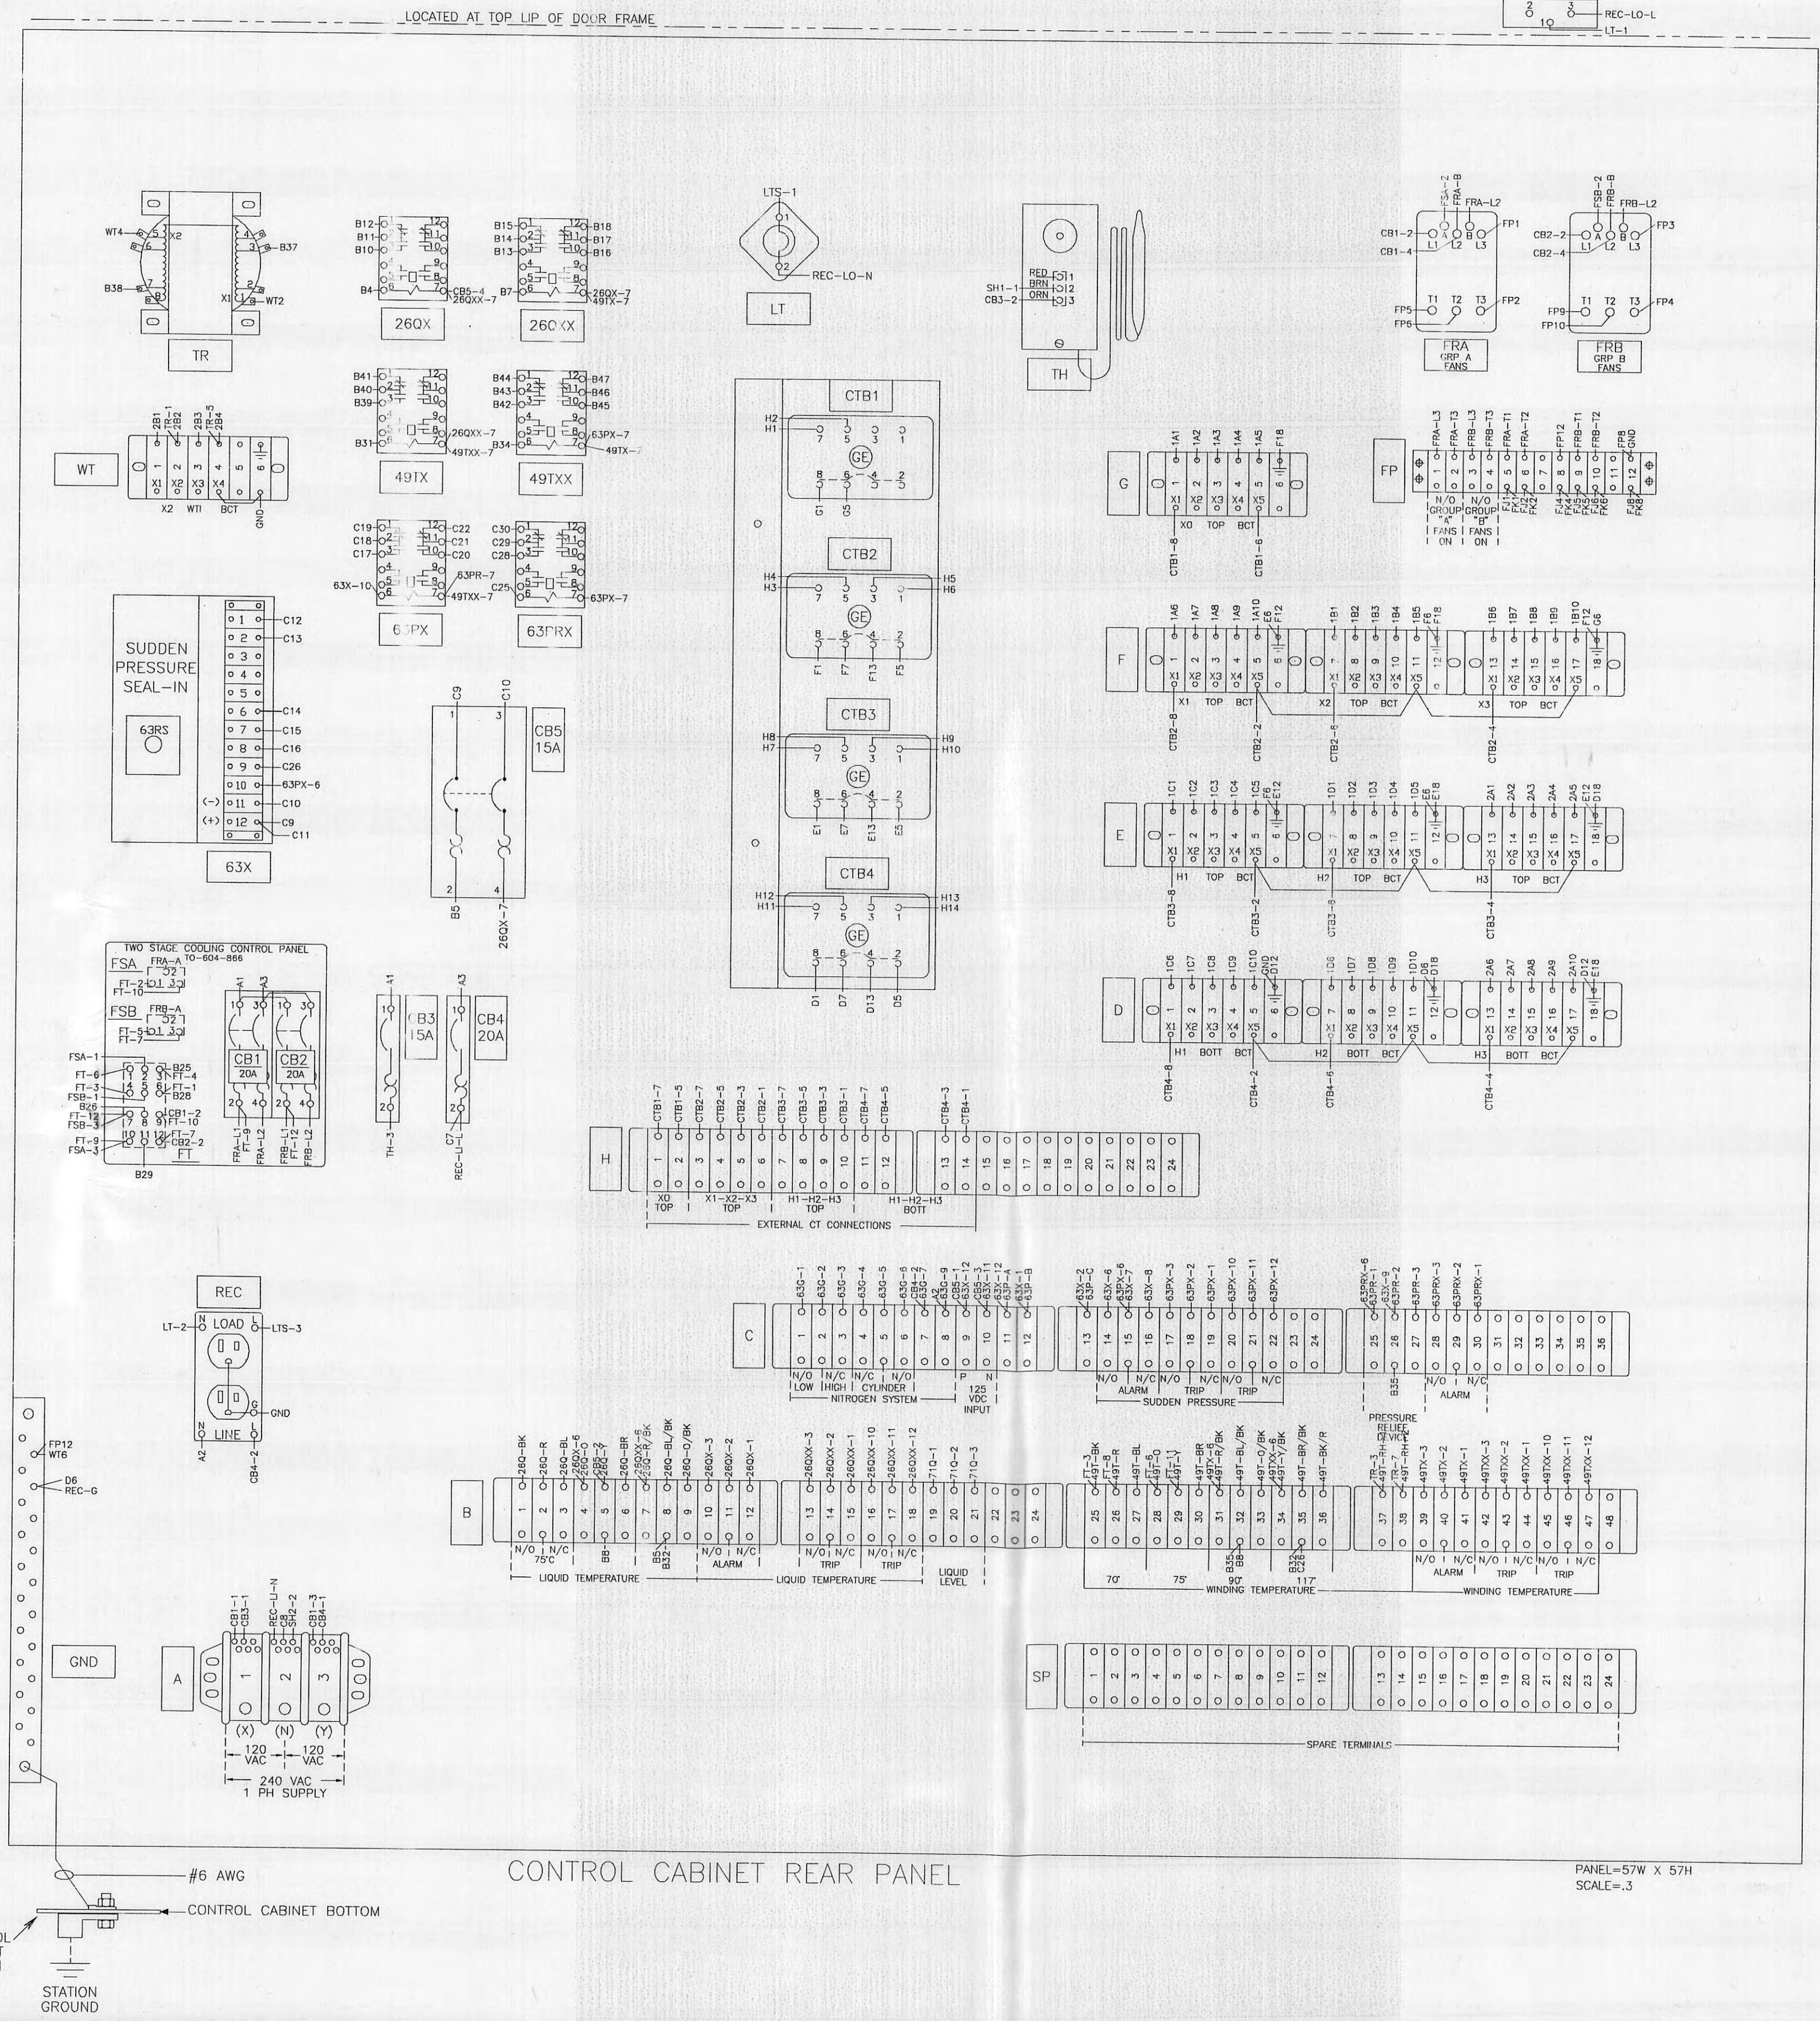


CONTROL CABINET BOTTOM

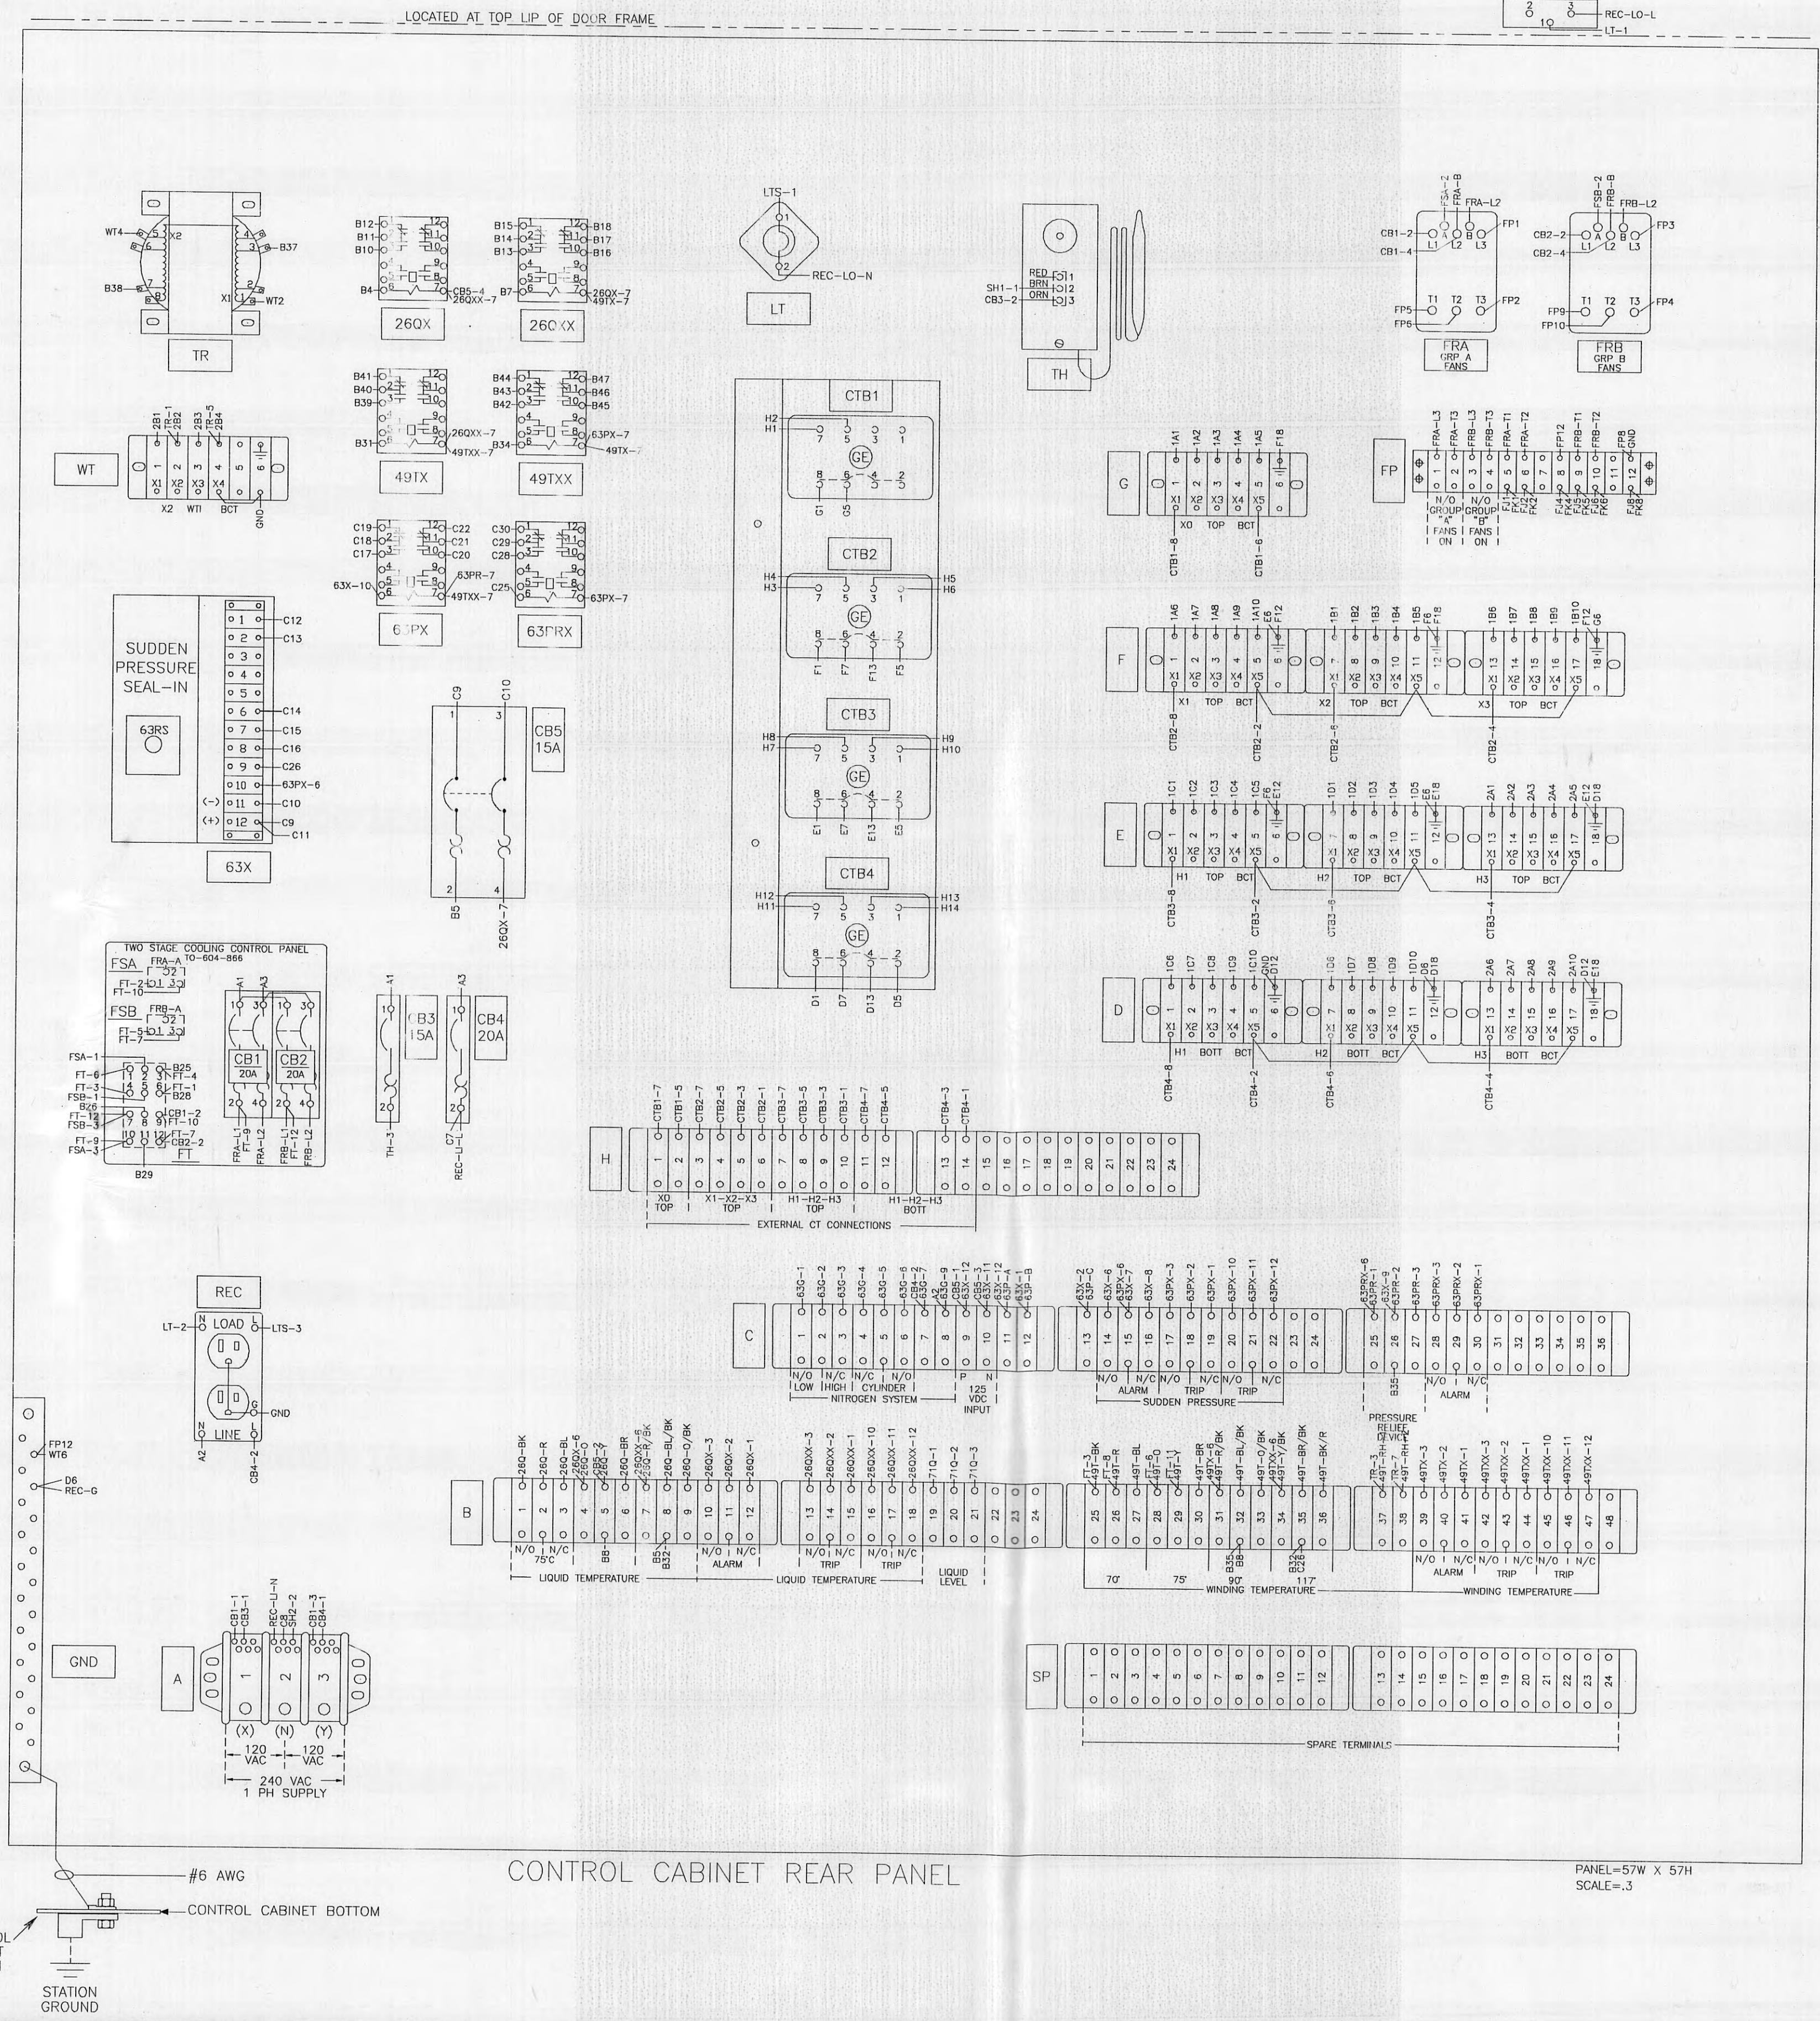


CONTROL CABINET BOTTOM

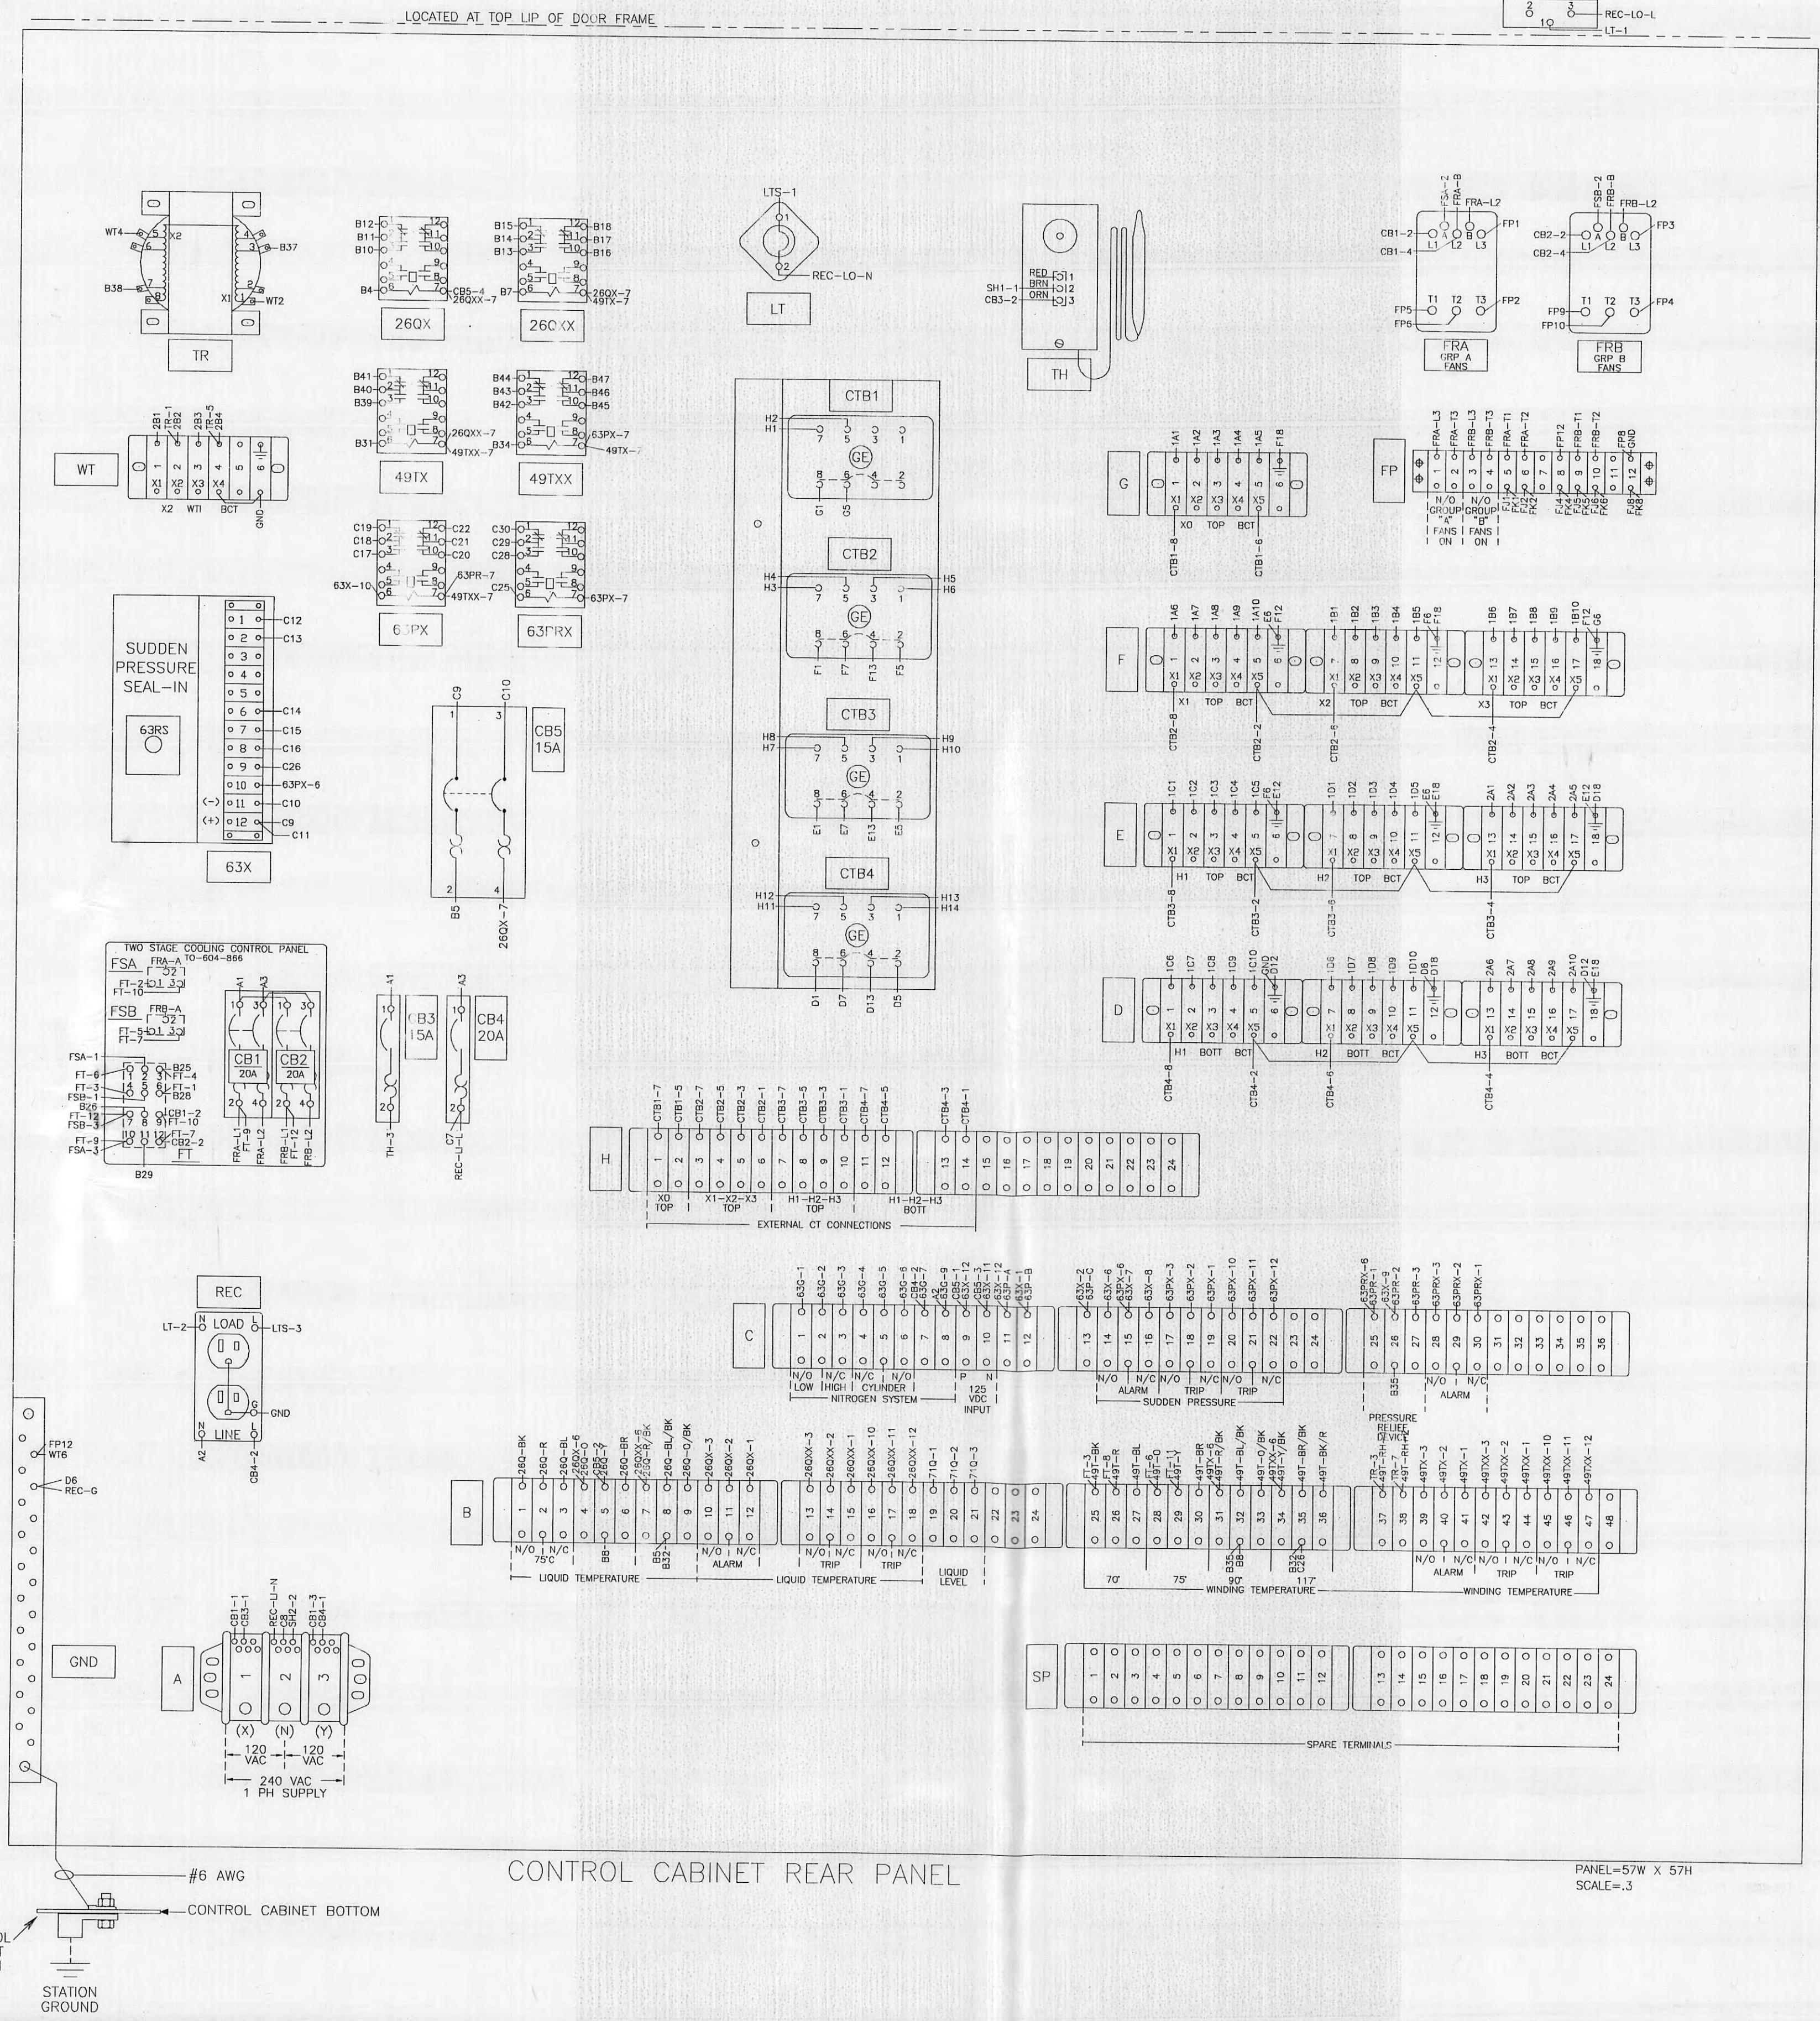


CONTROL CABINET BOTTOM

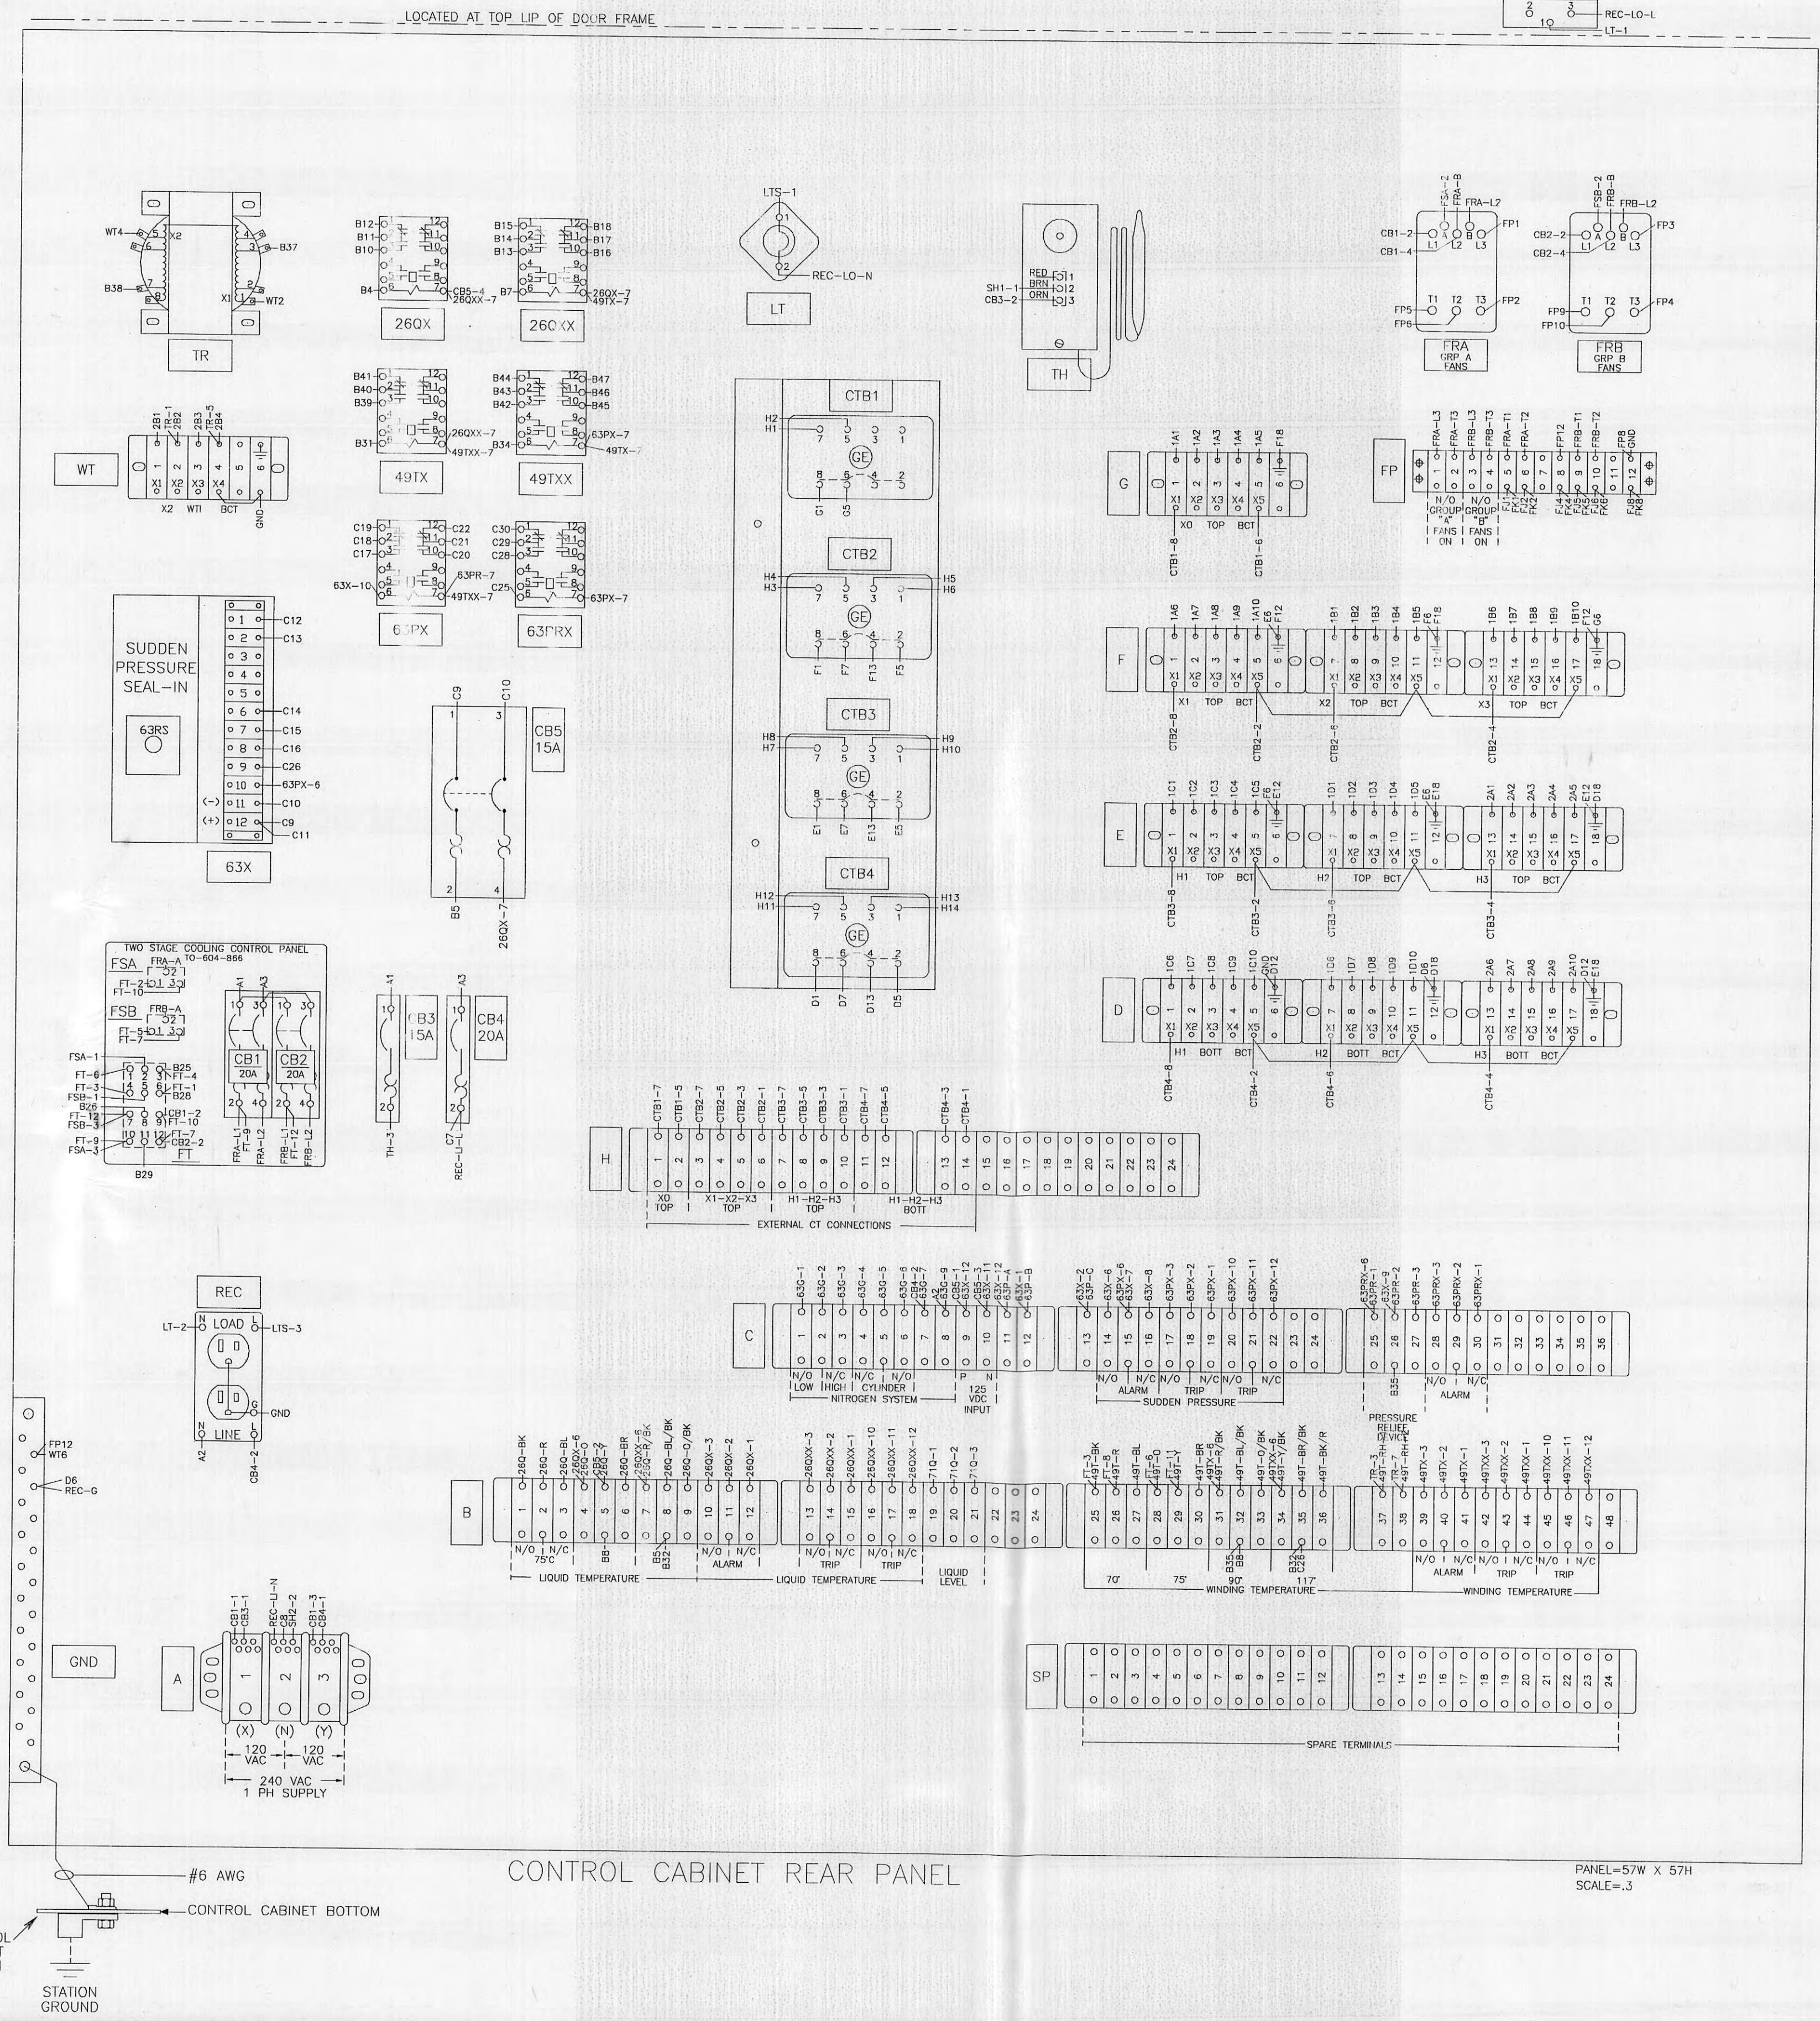


CONTROL CABINET BOTTOM

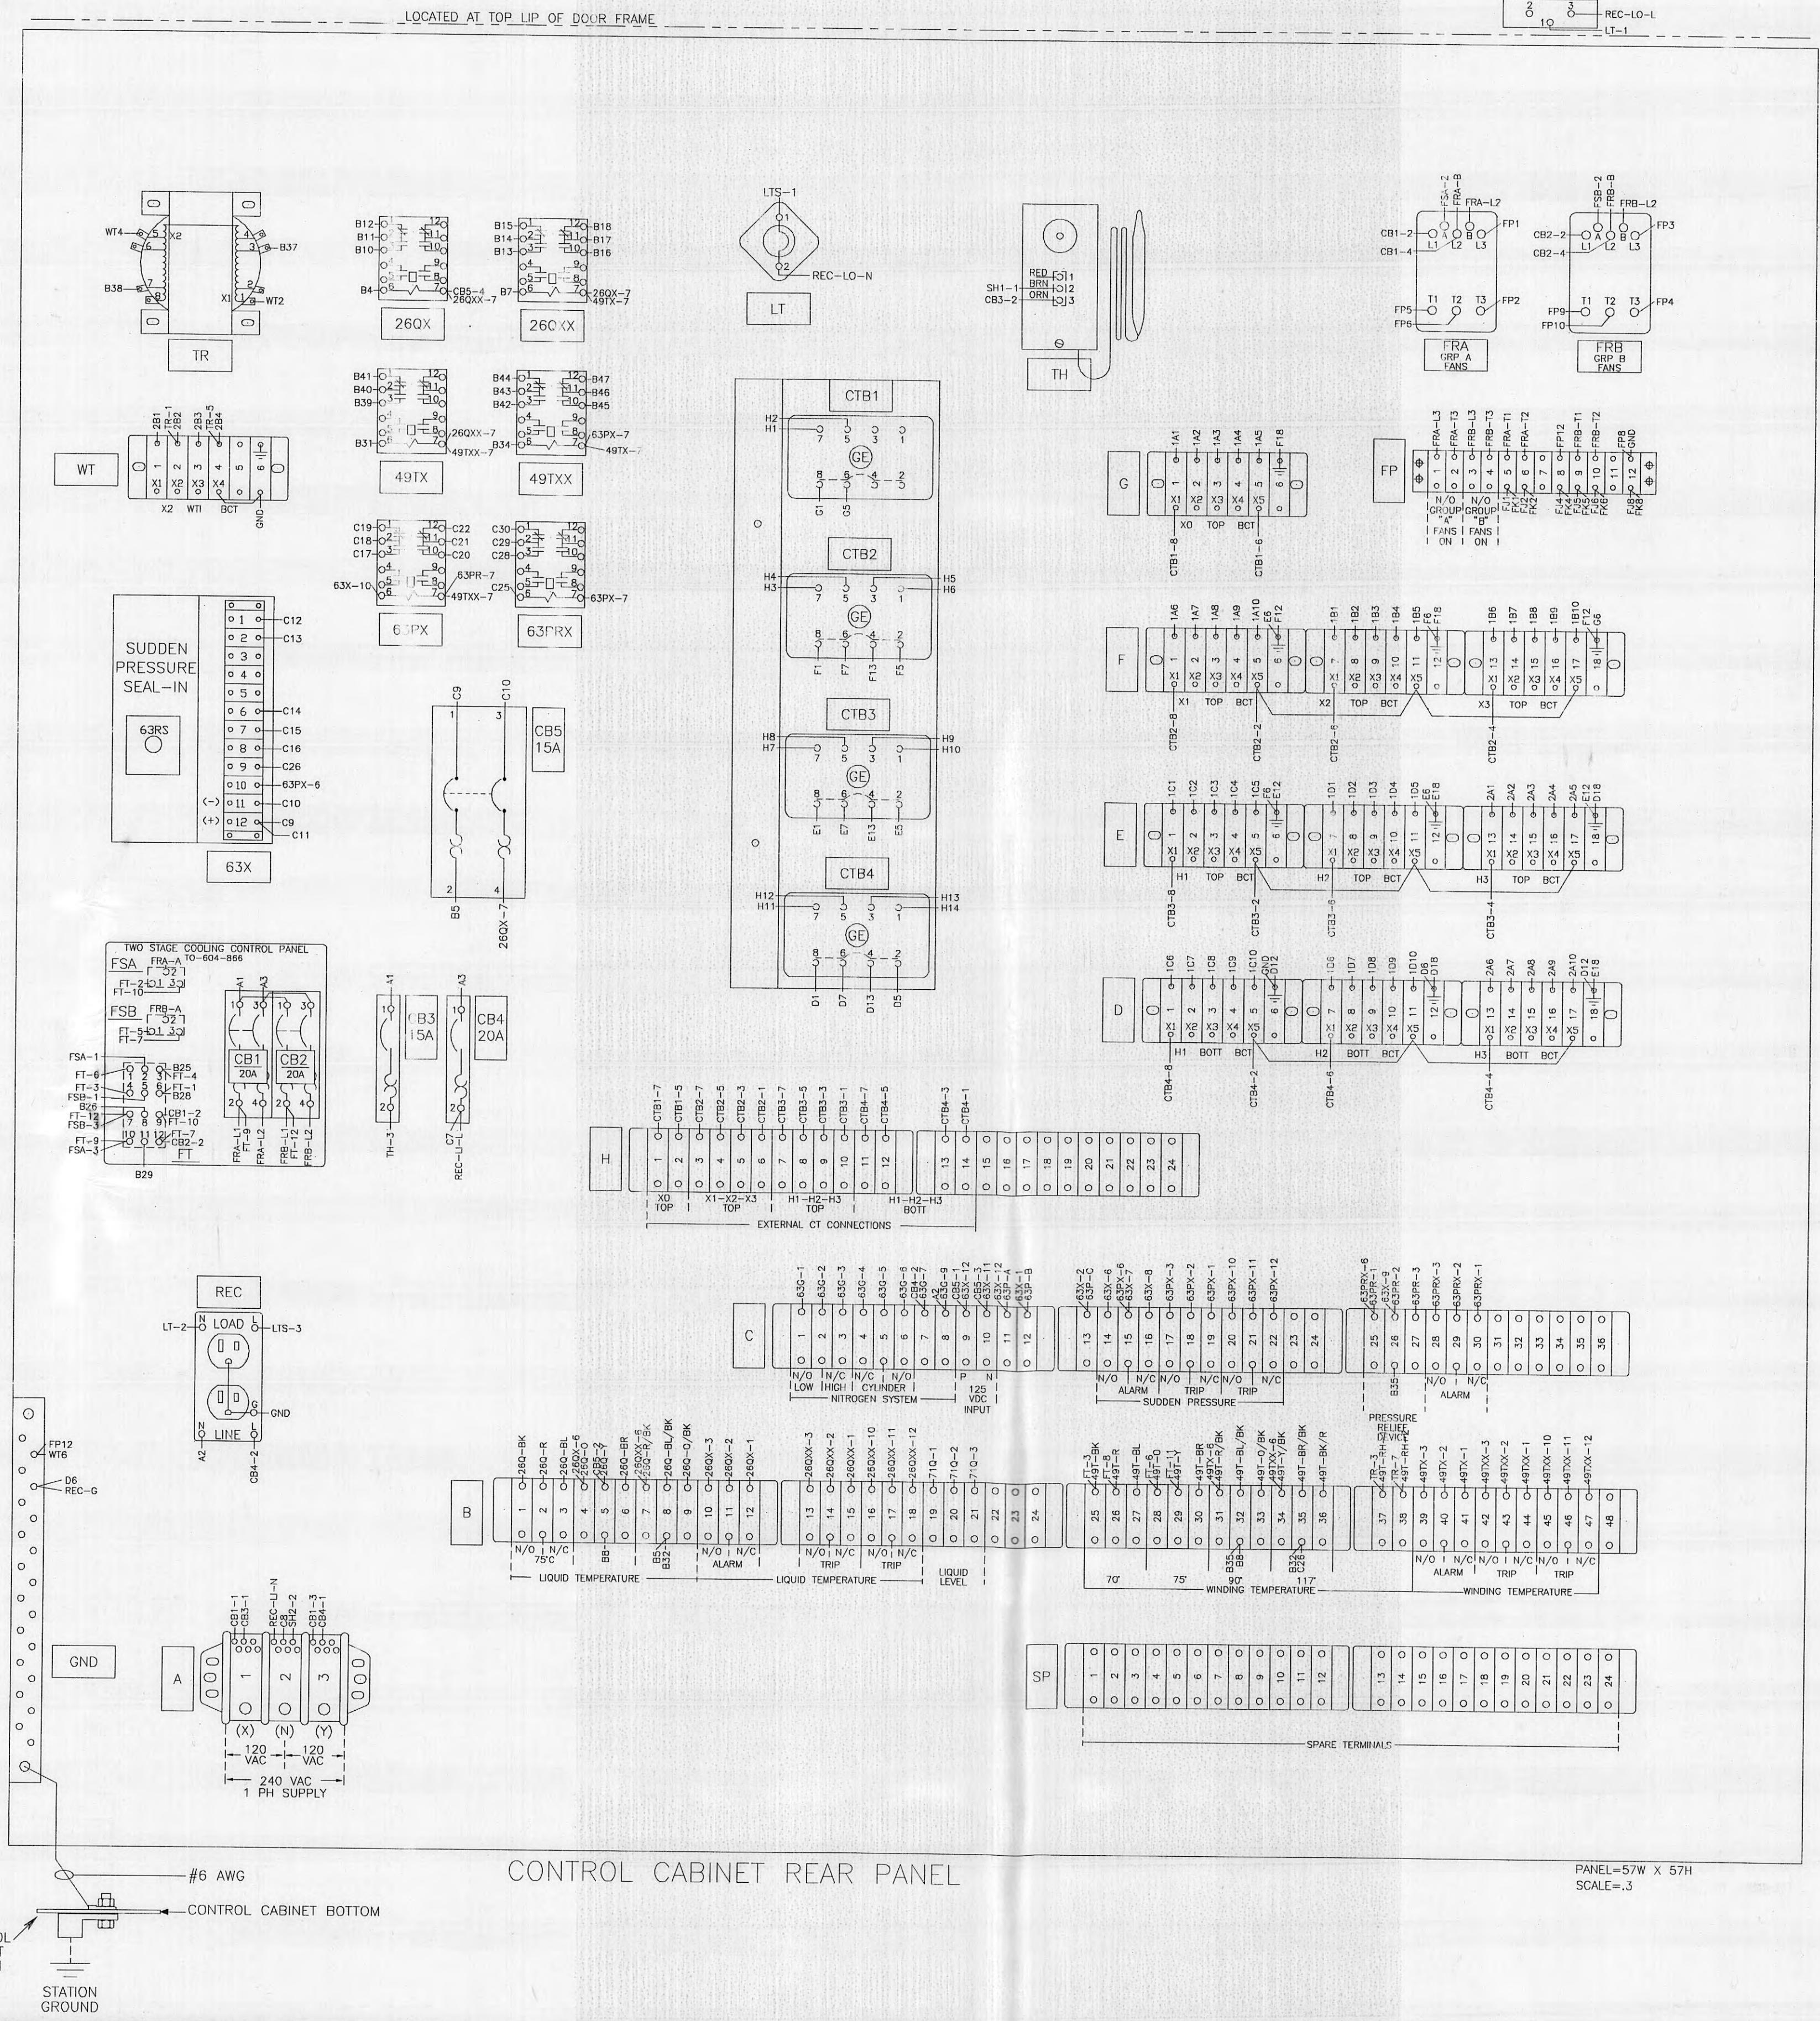


CONTROL CABINET BOTTOM

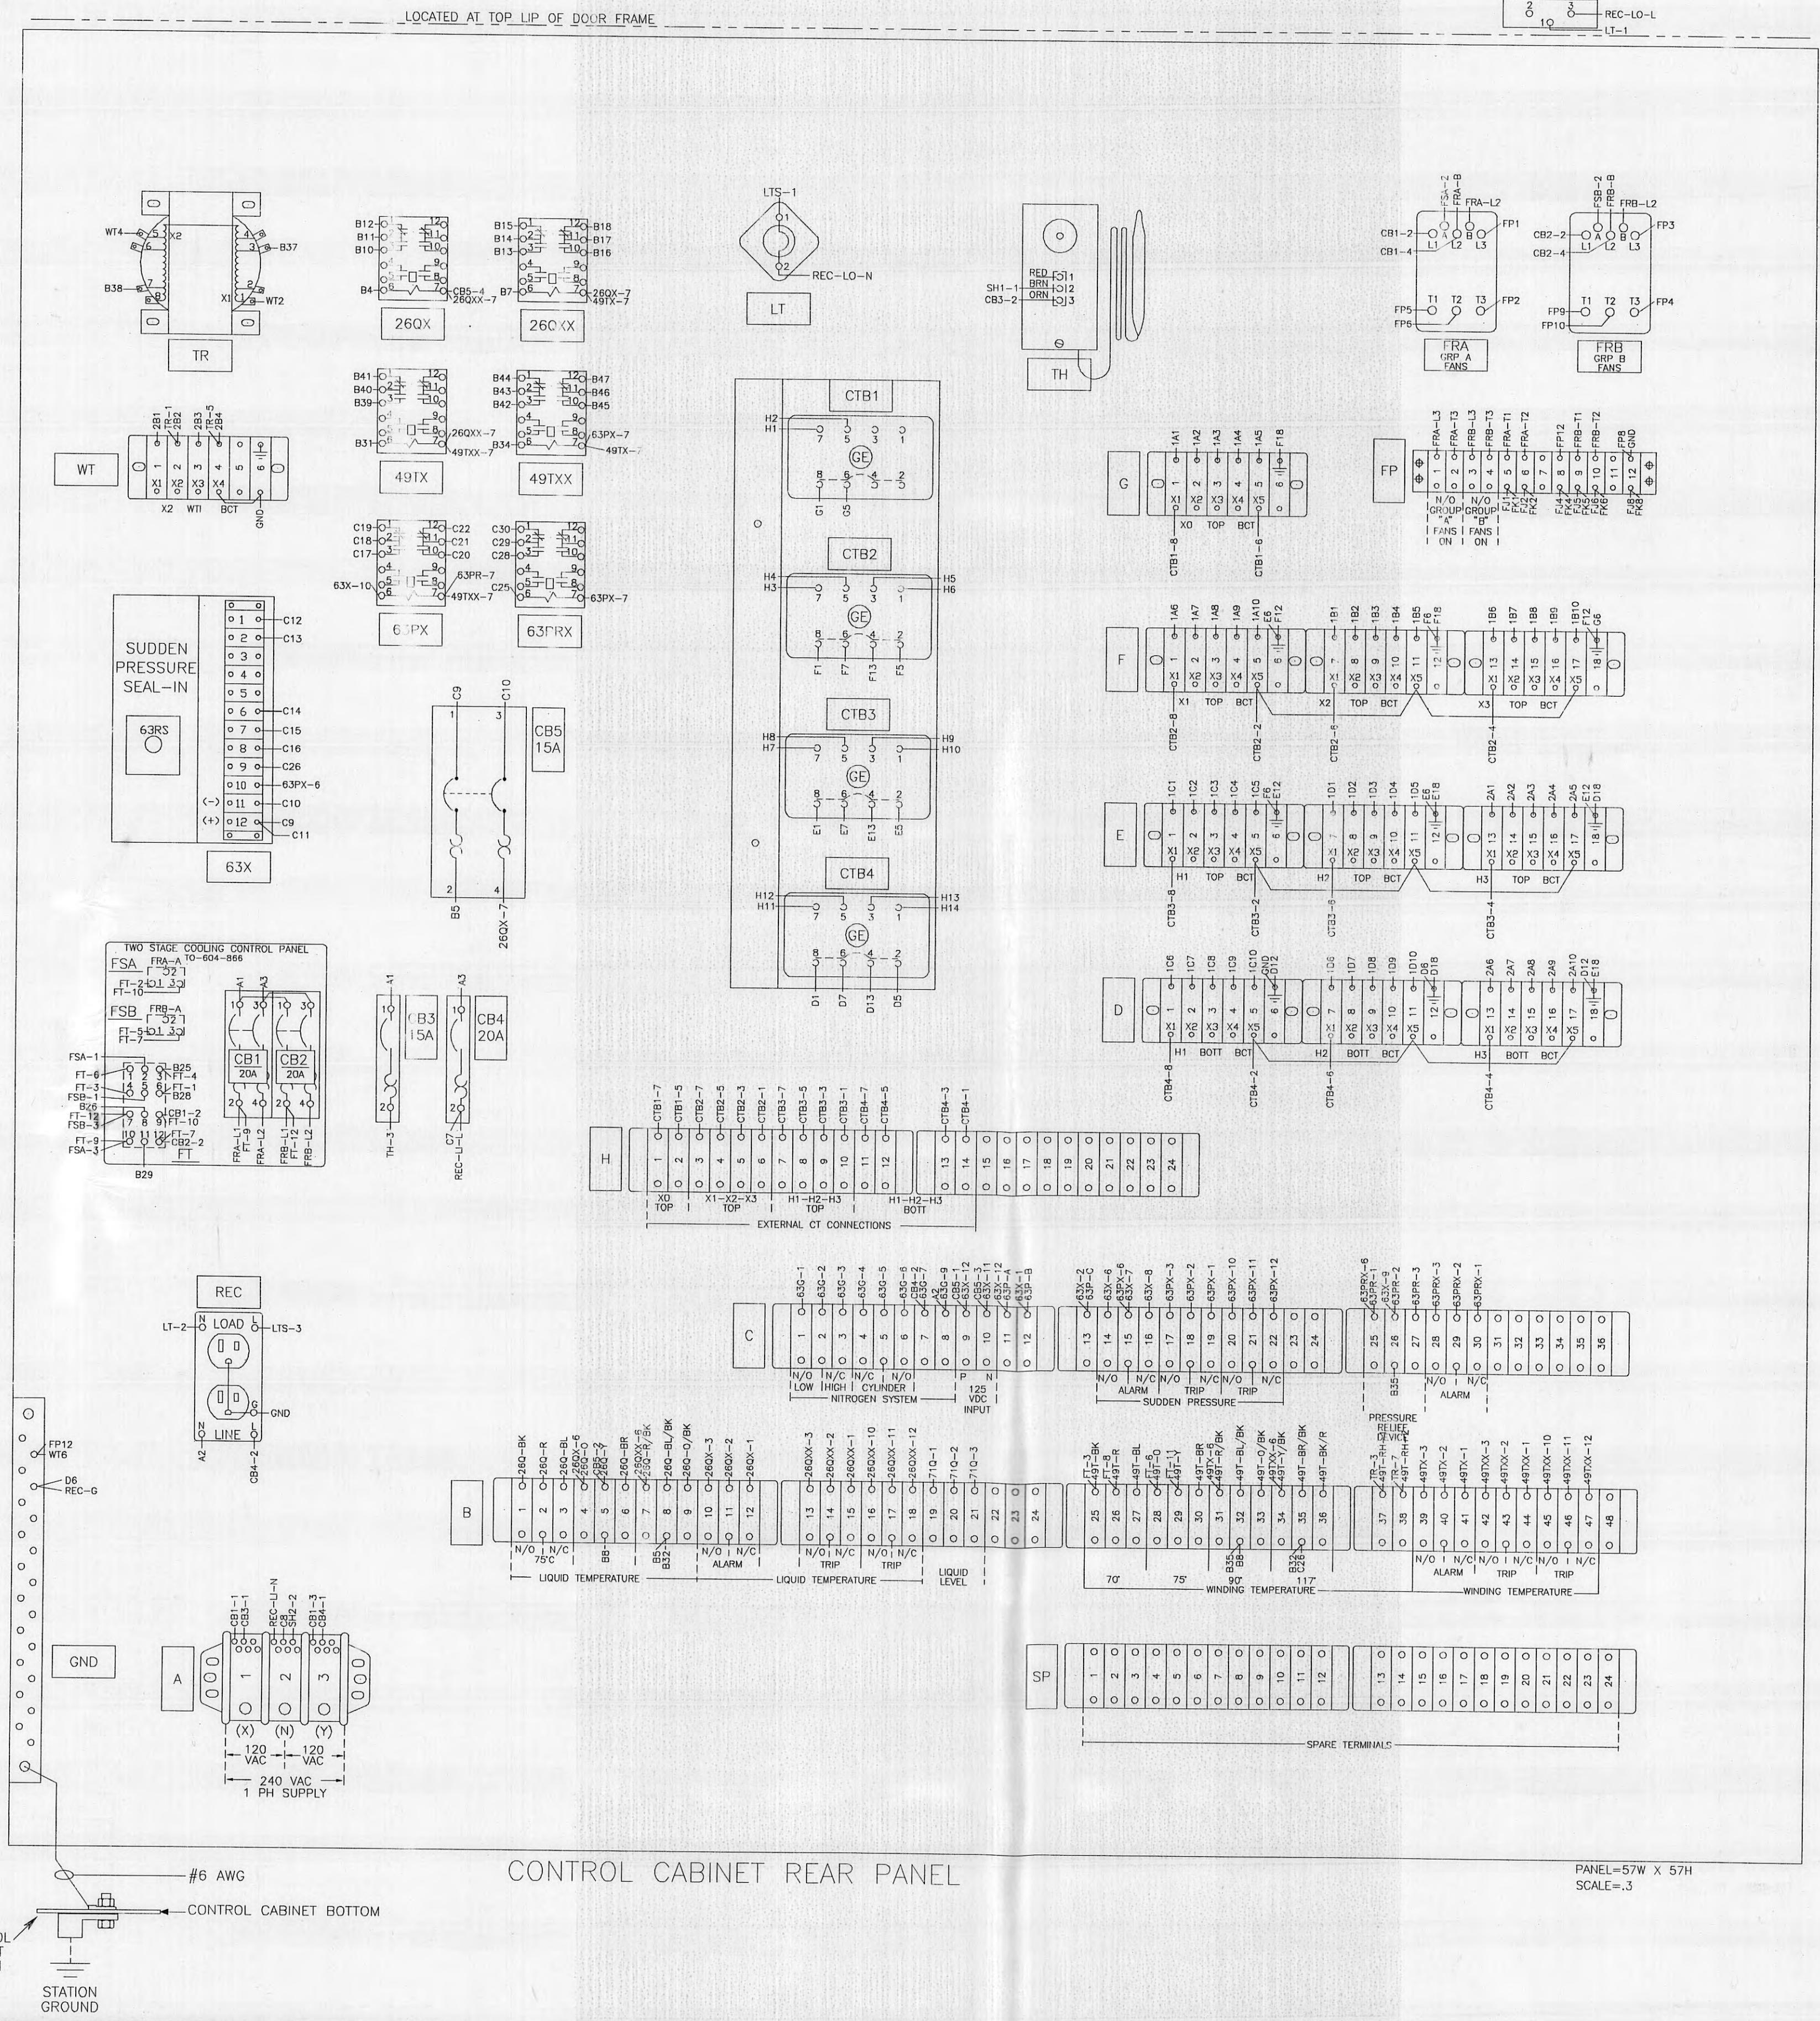


CONTROL CABINET BOTTOM

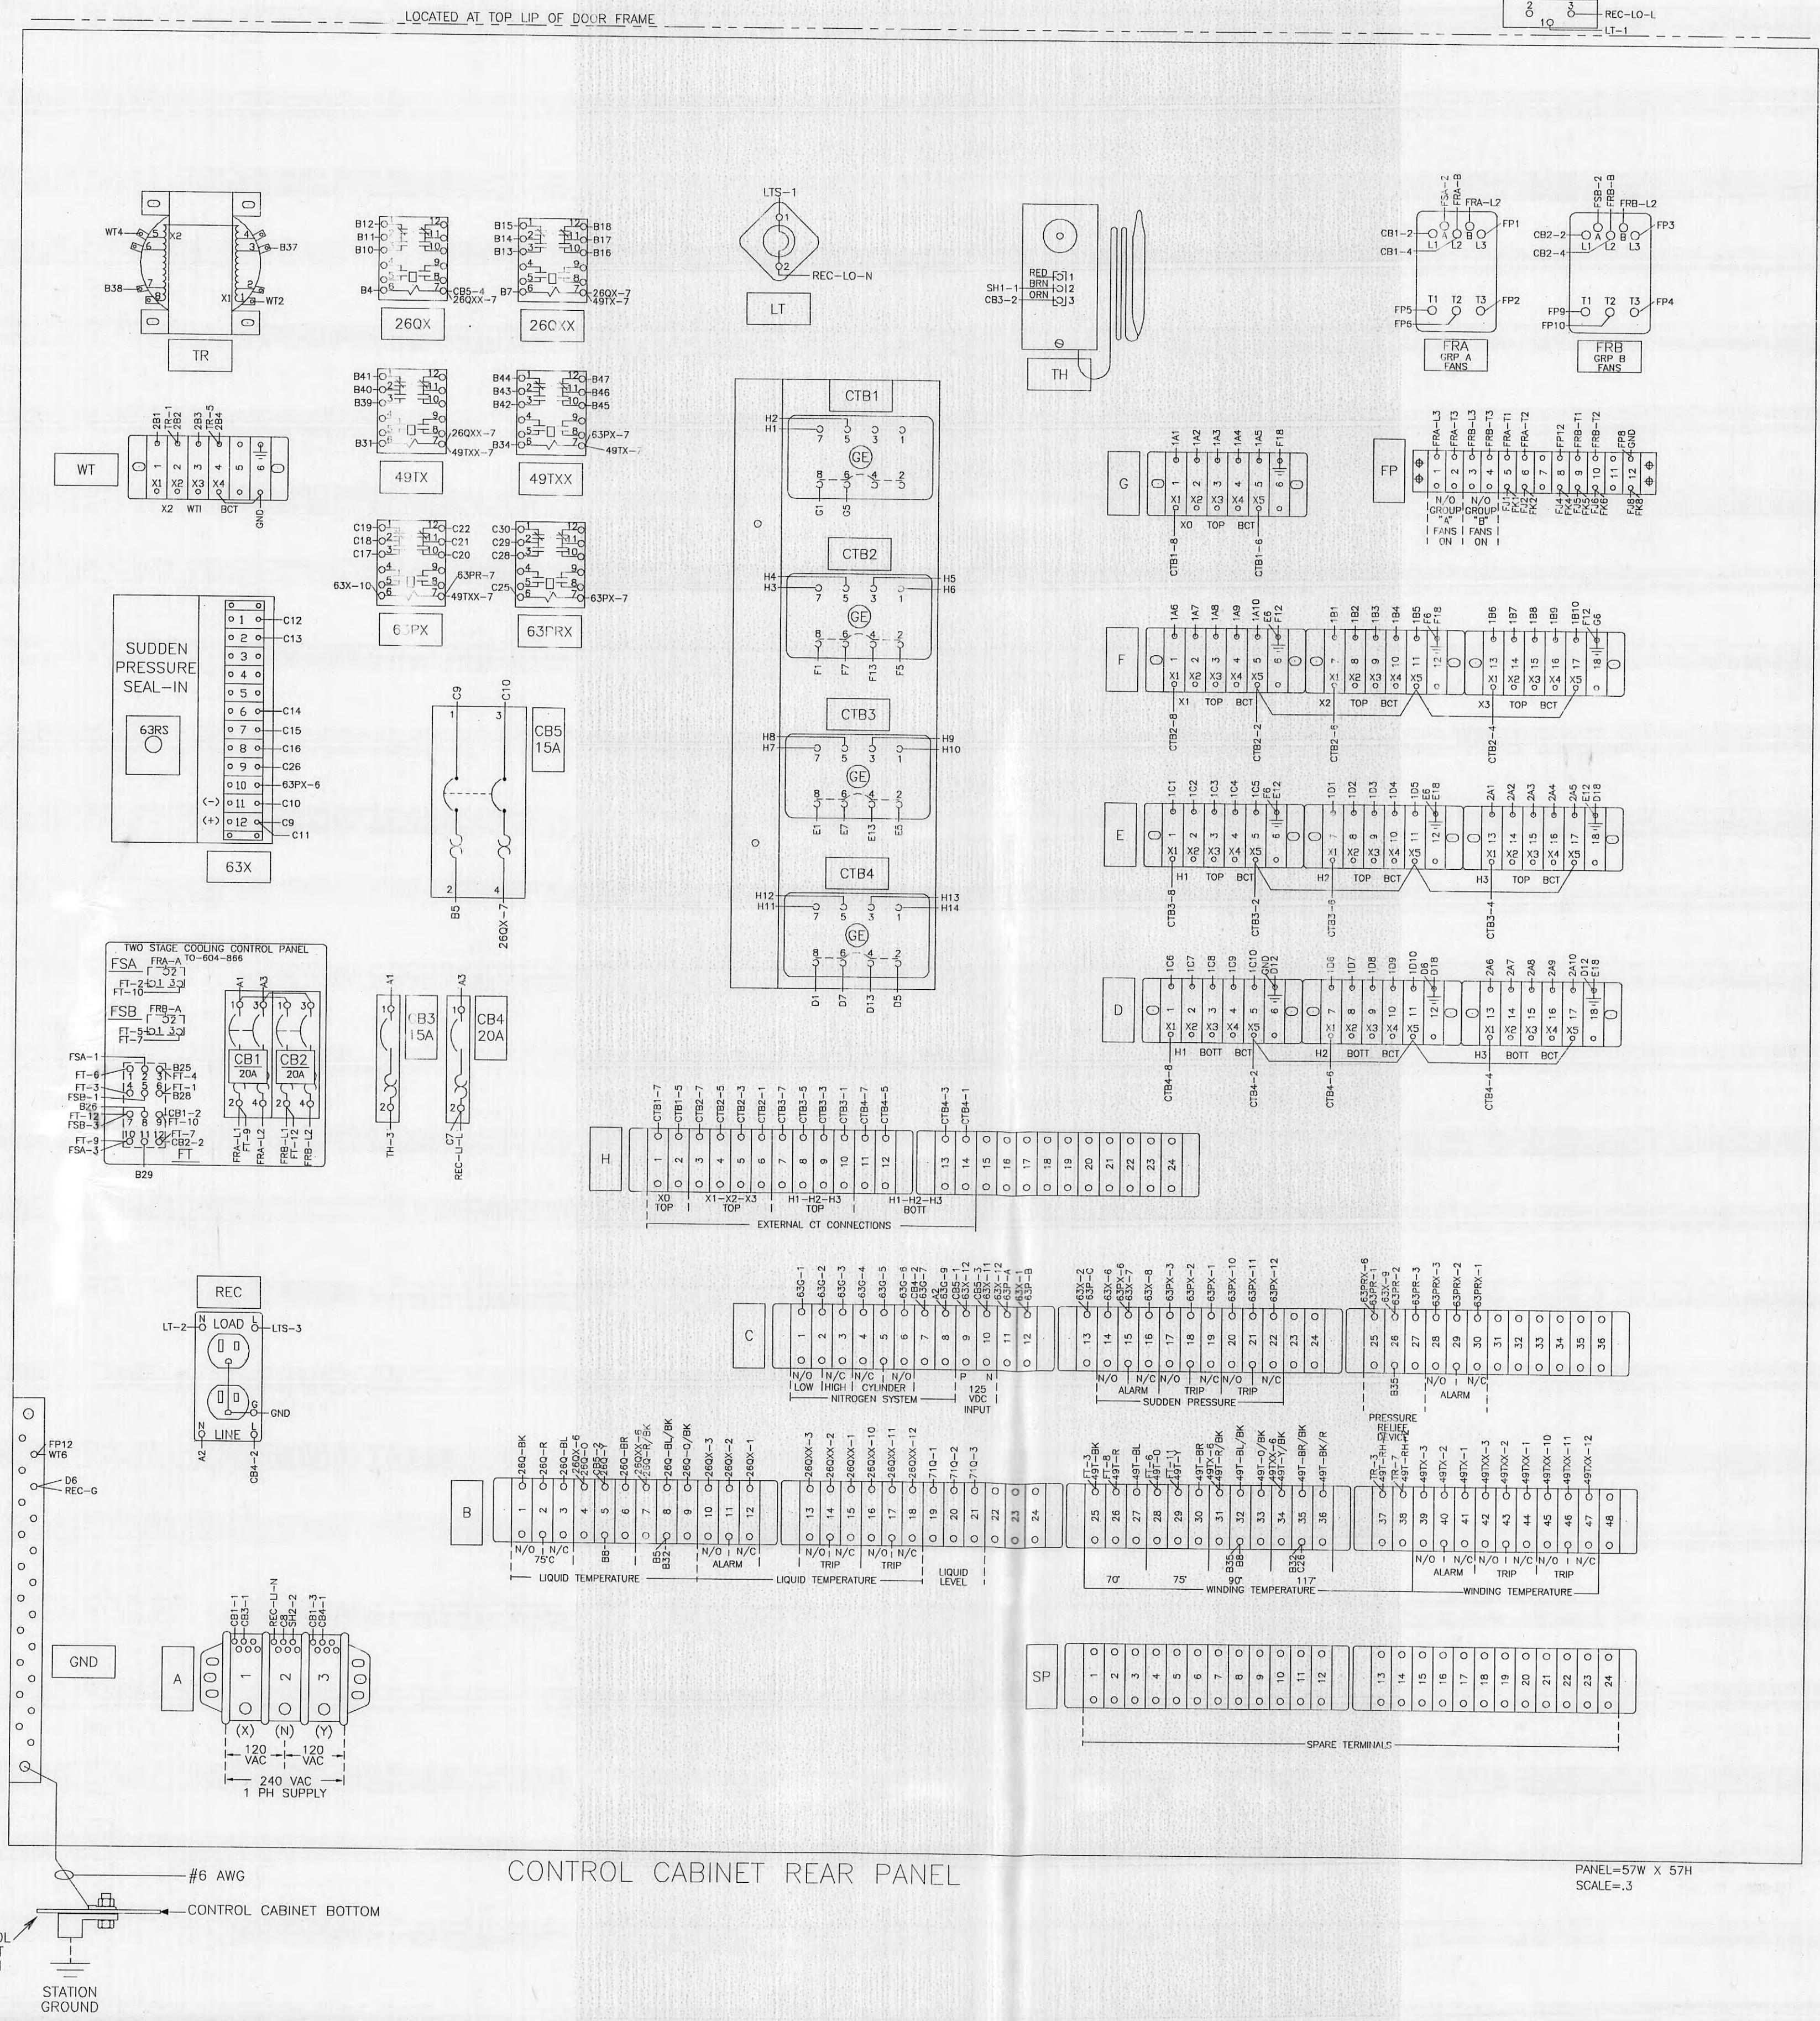


CONTROL CABINET BOTTOM

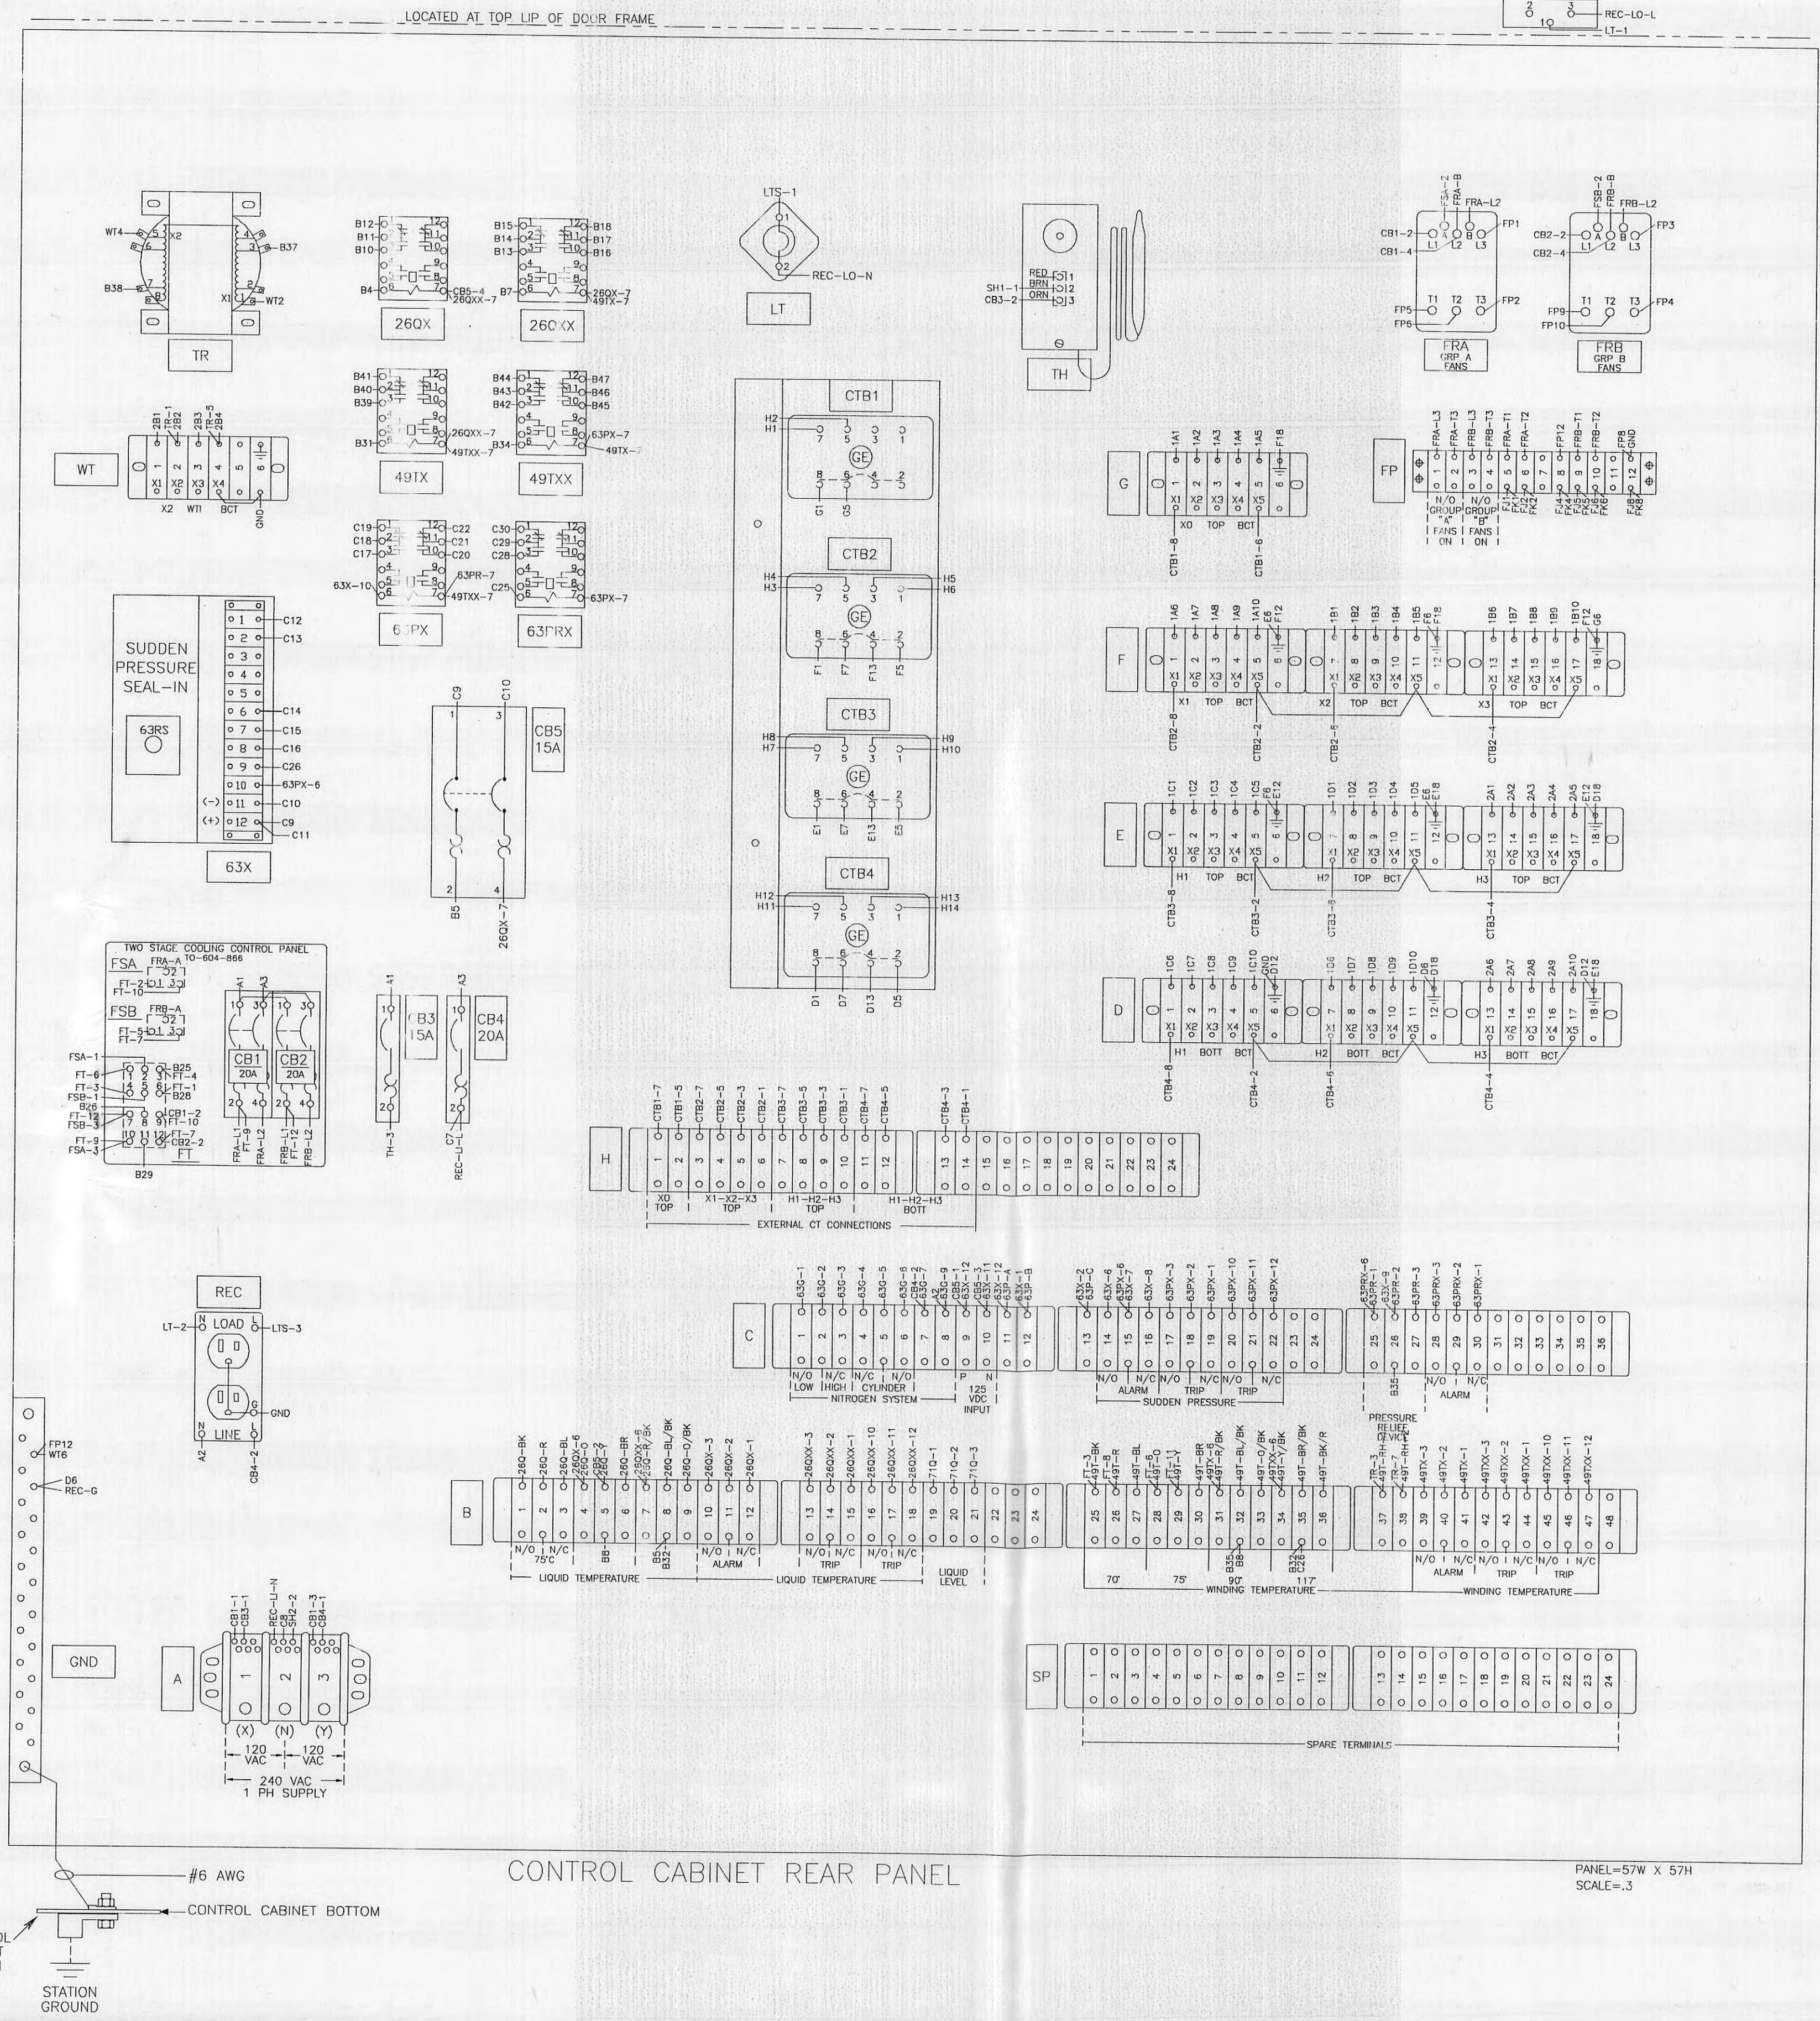


CONTROL CABINET BOTTOM

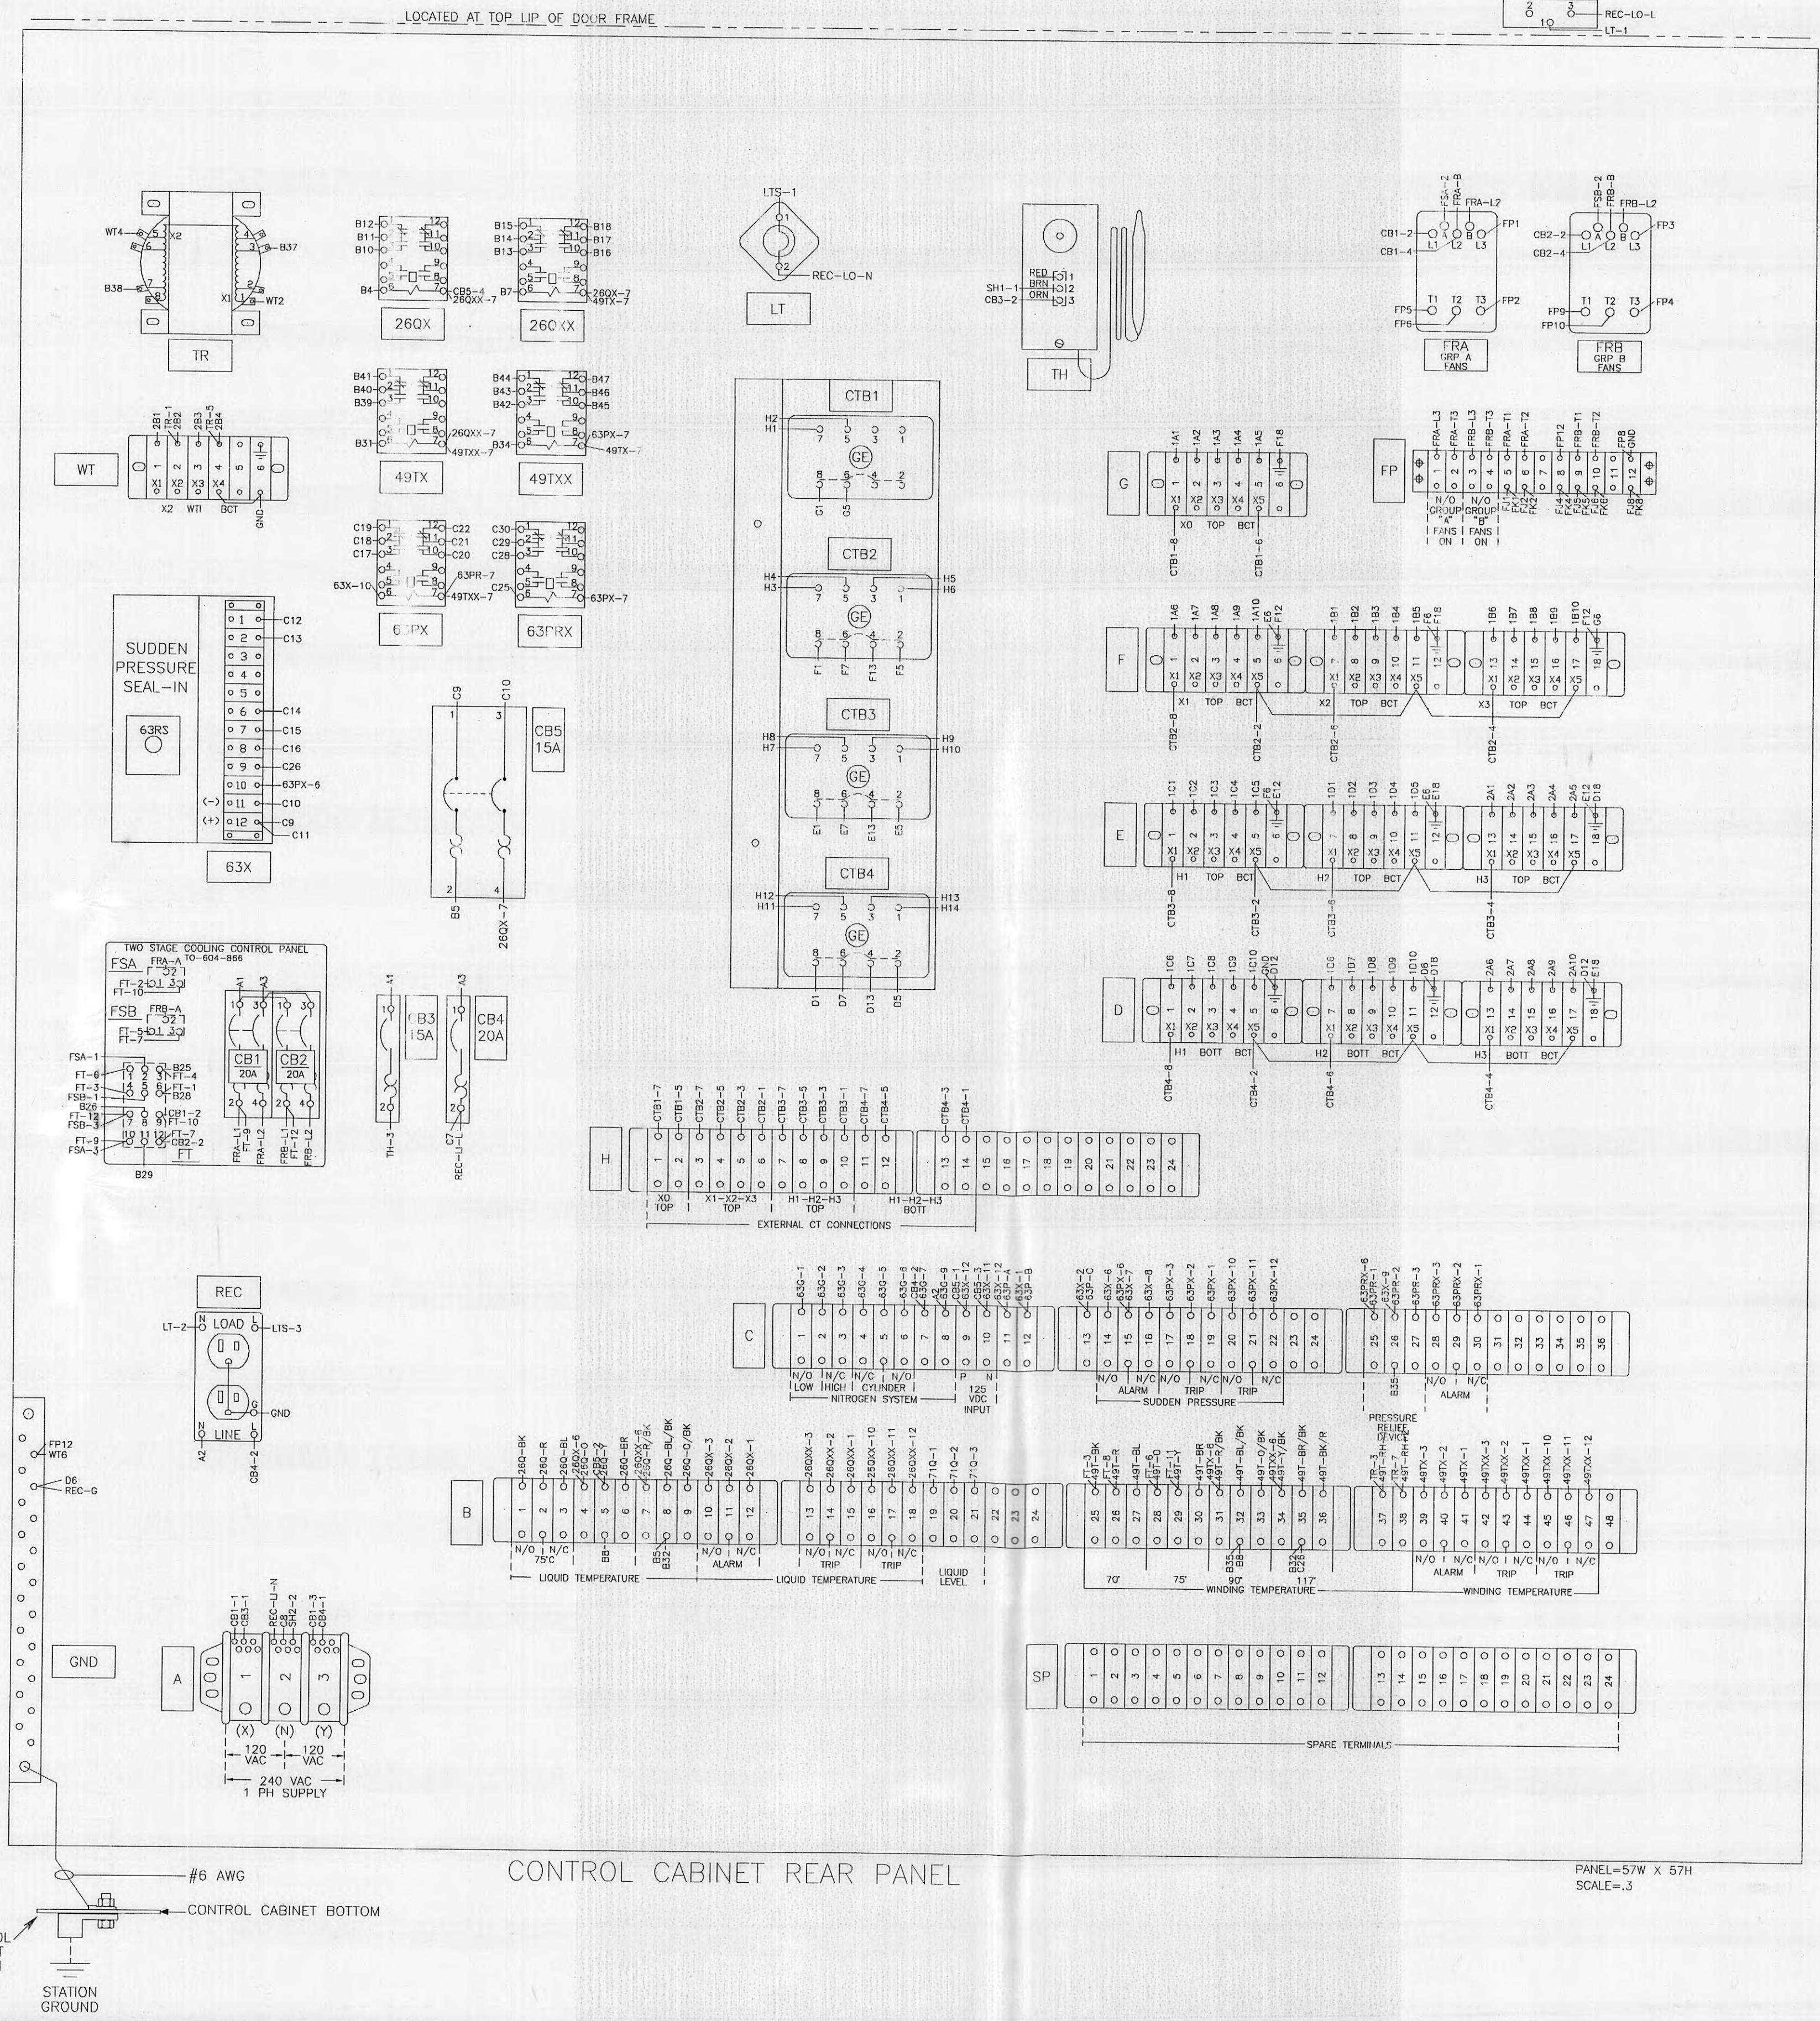


CONTROL CABINET BOTTOM

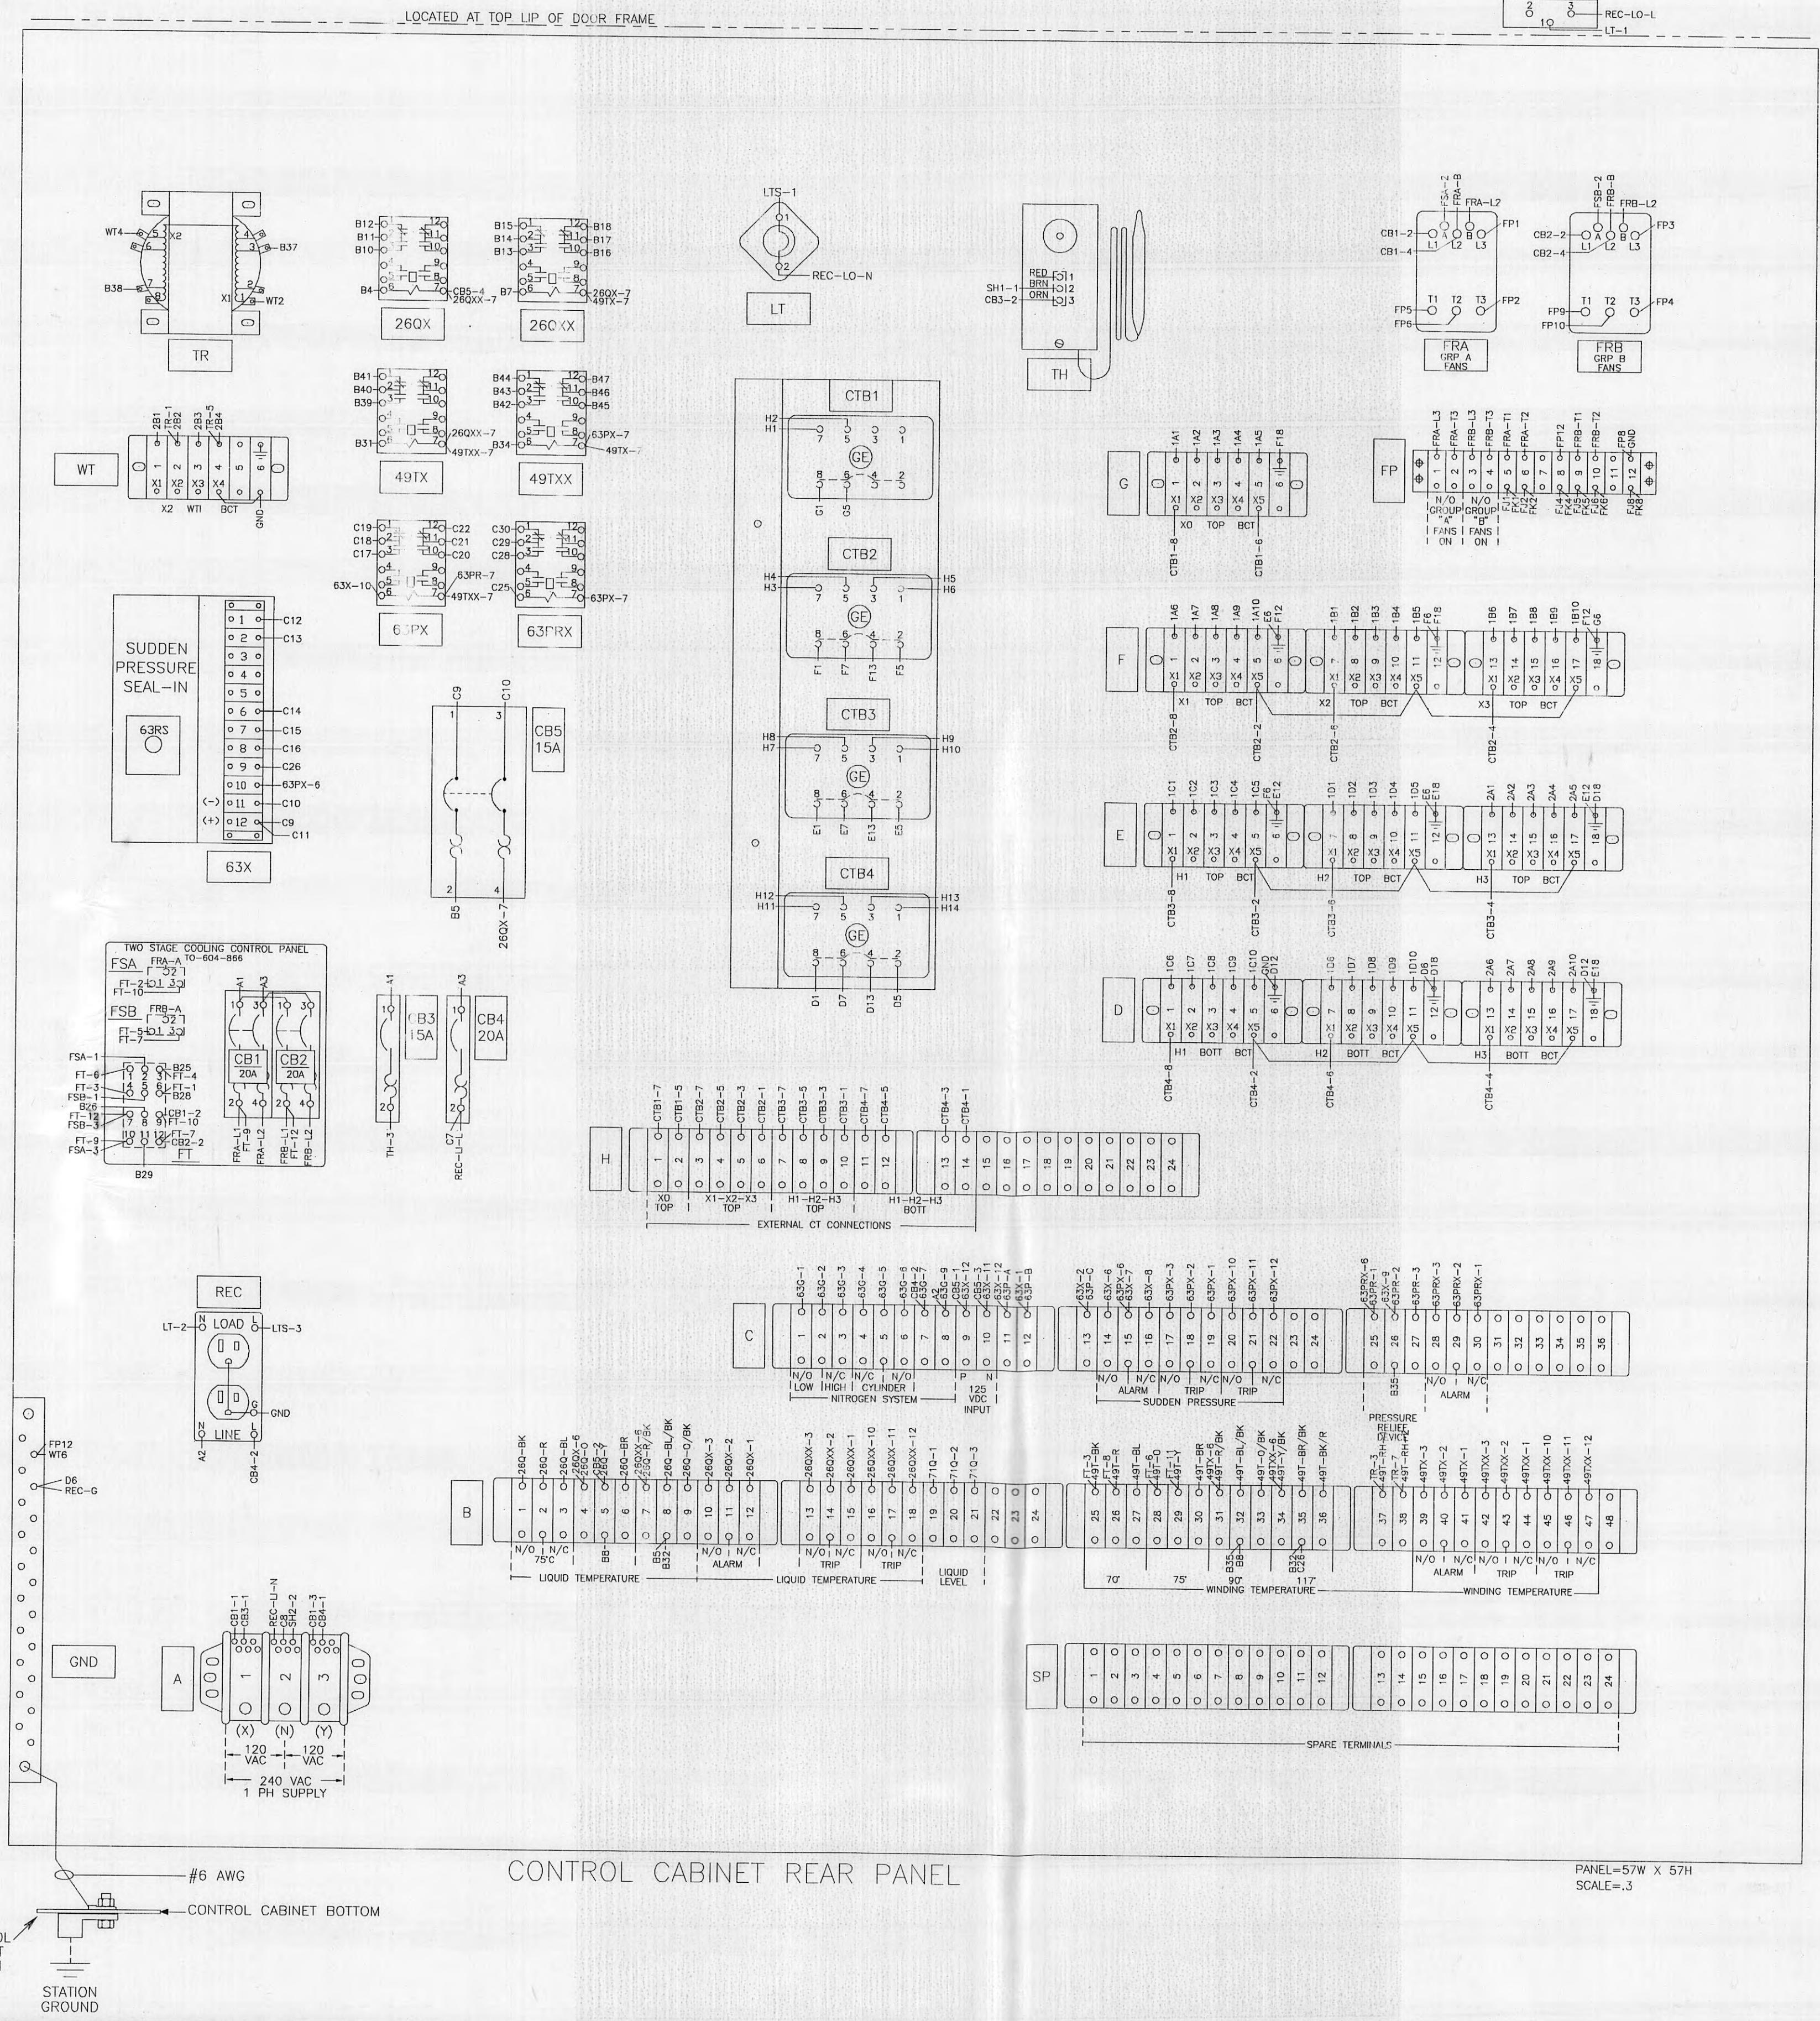


CONTROL CABINET BOTTOM

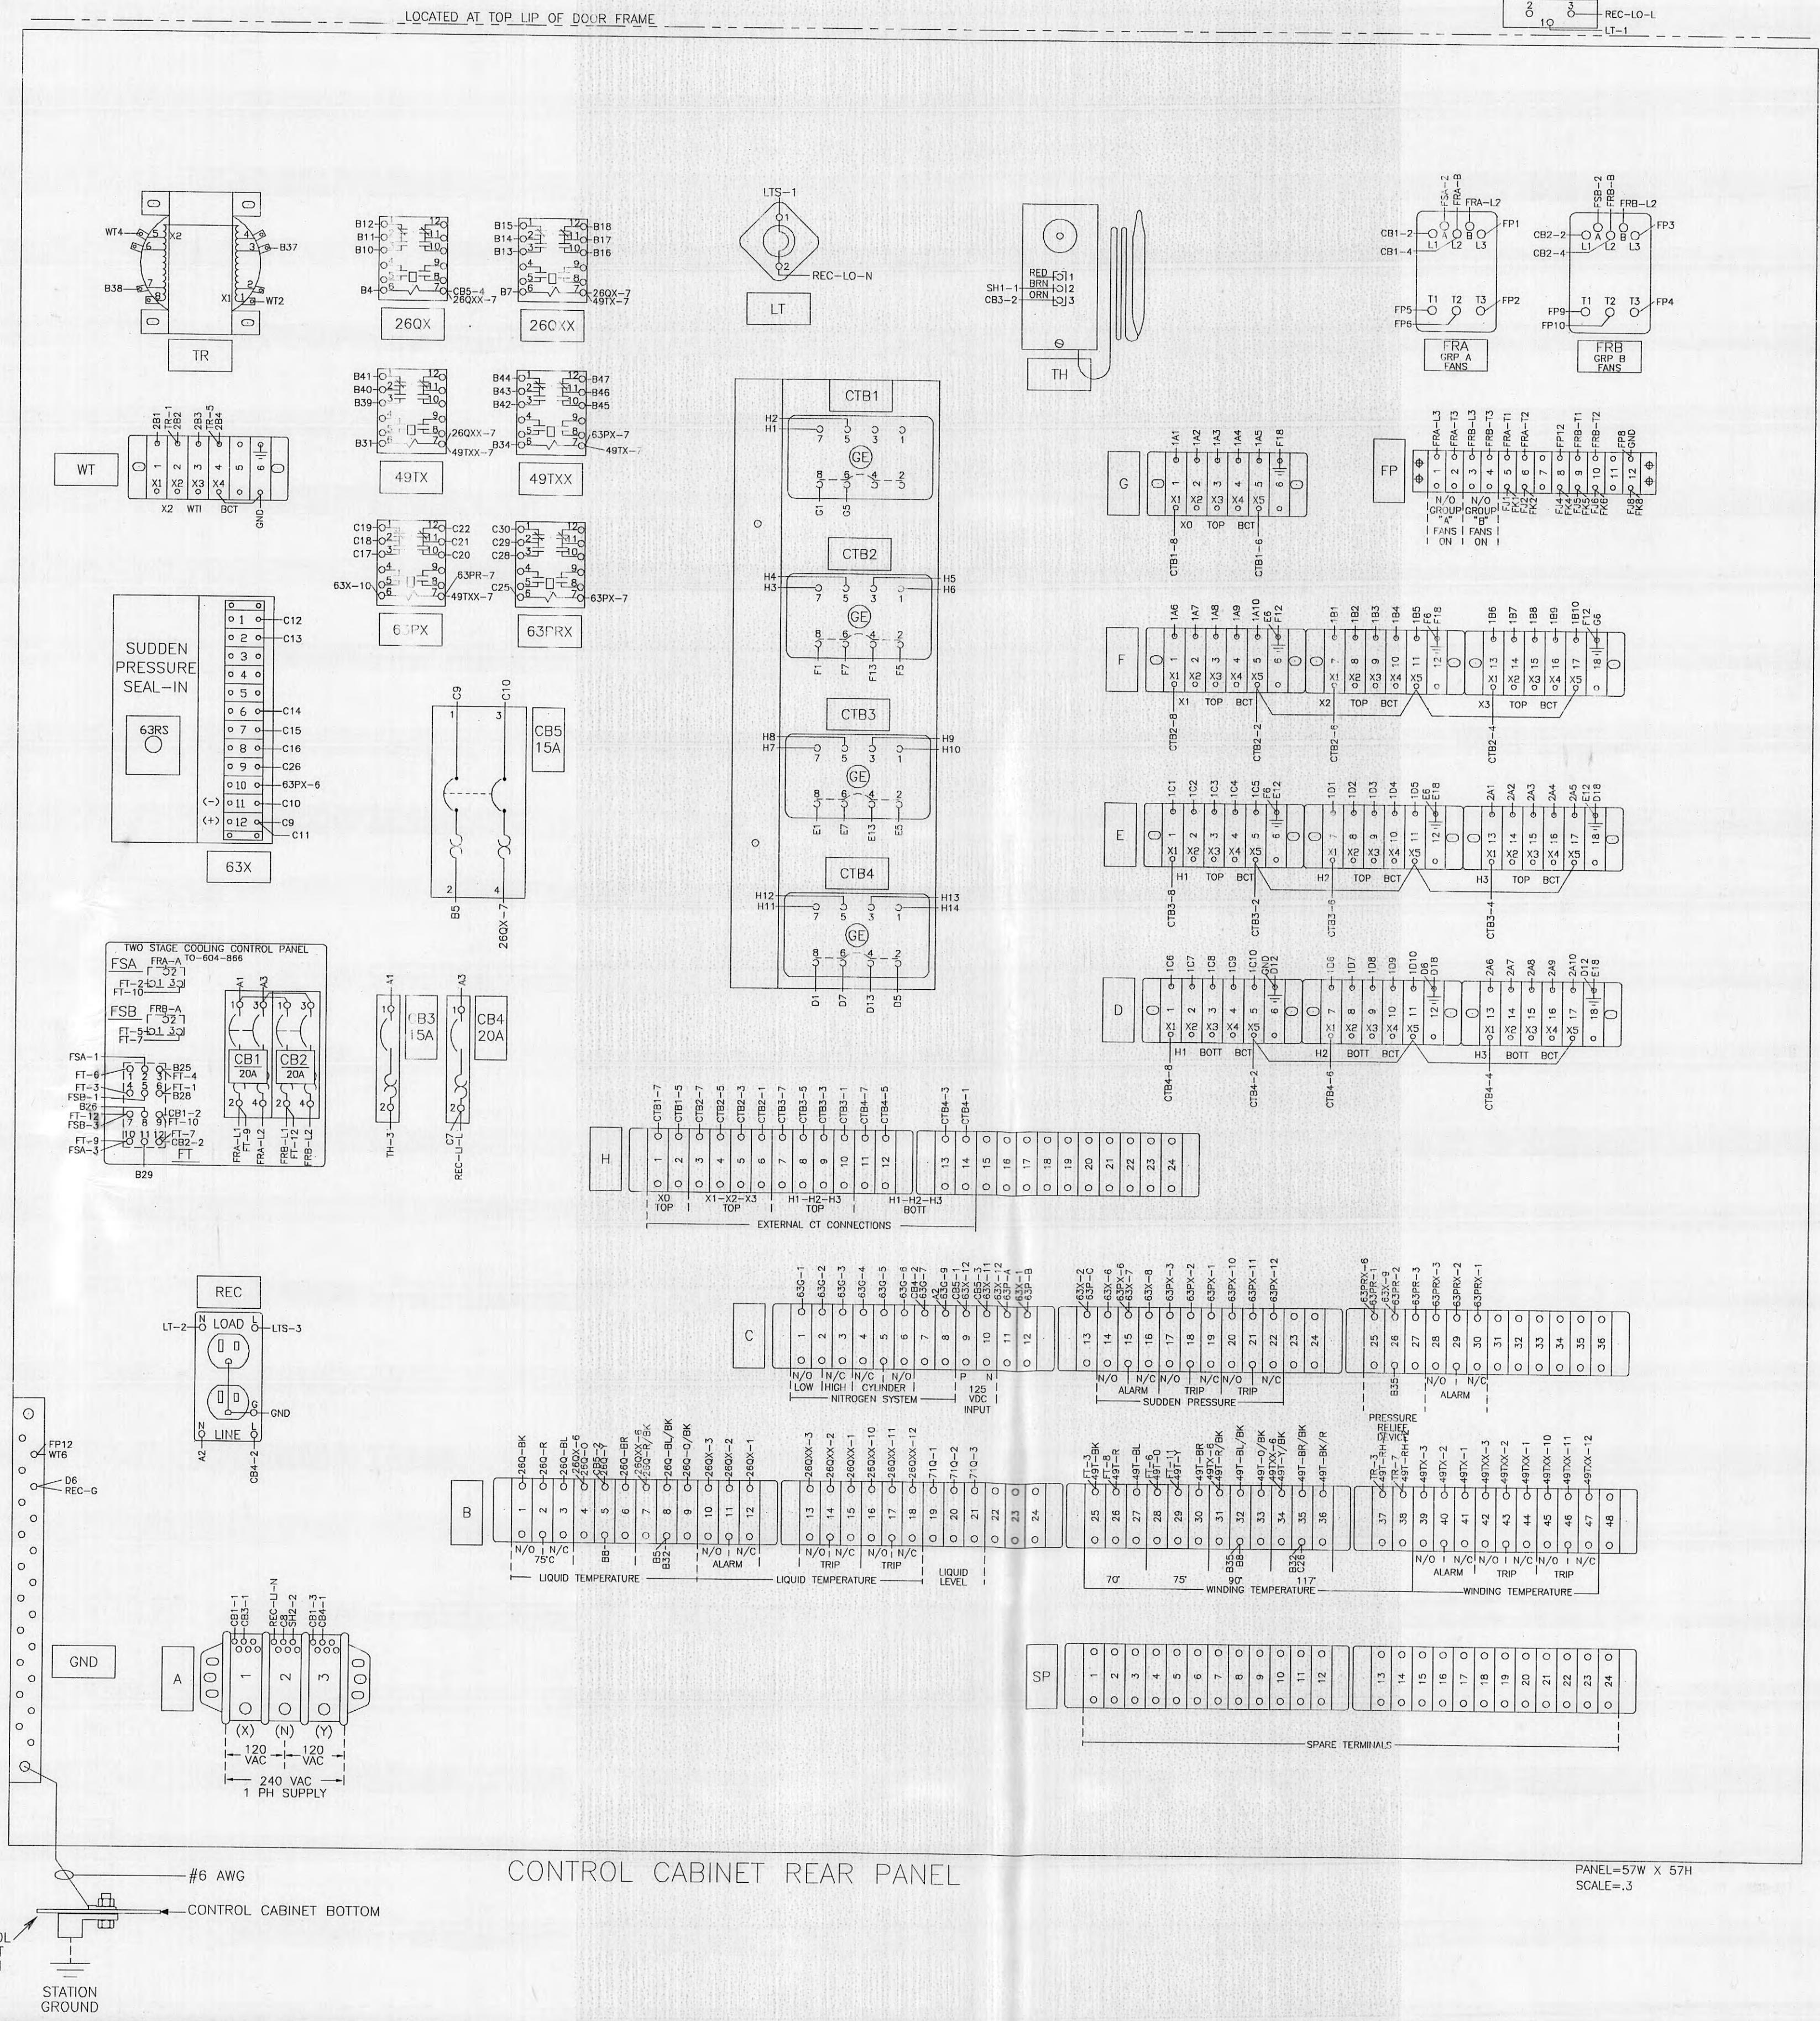


CONTROL CABINET BOTTOM

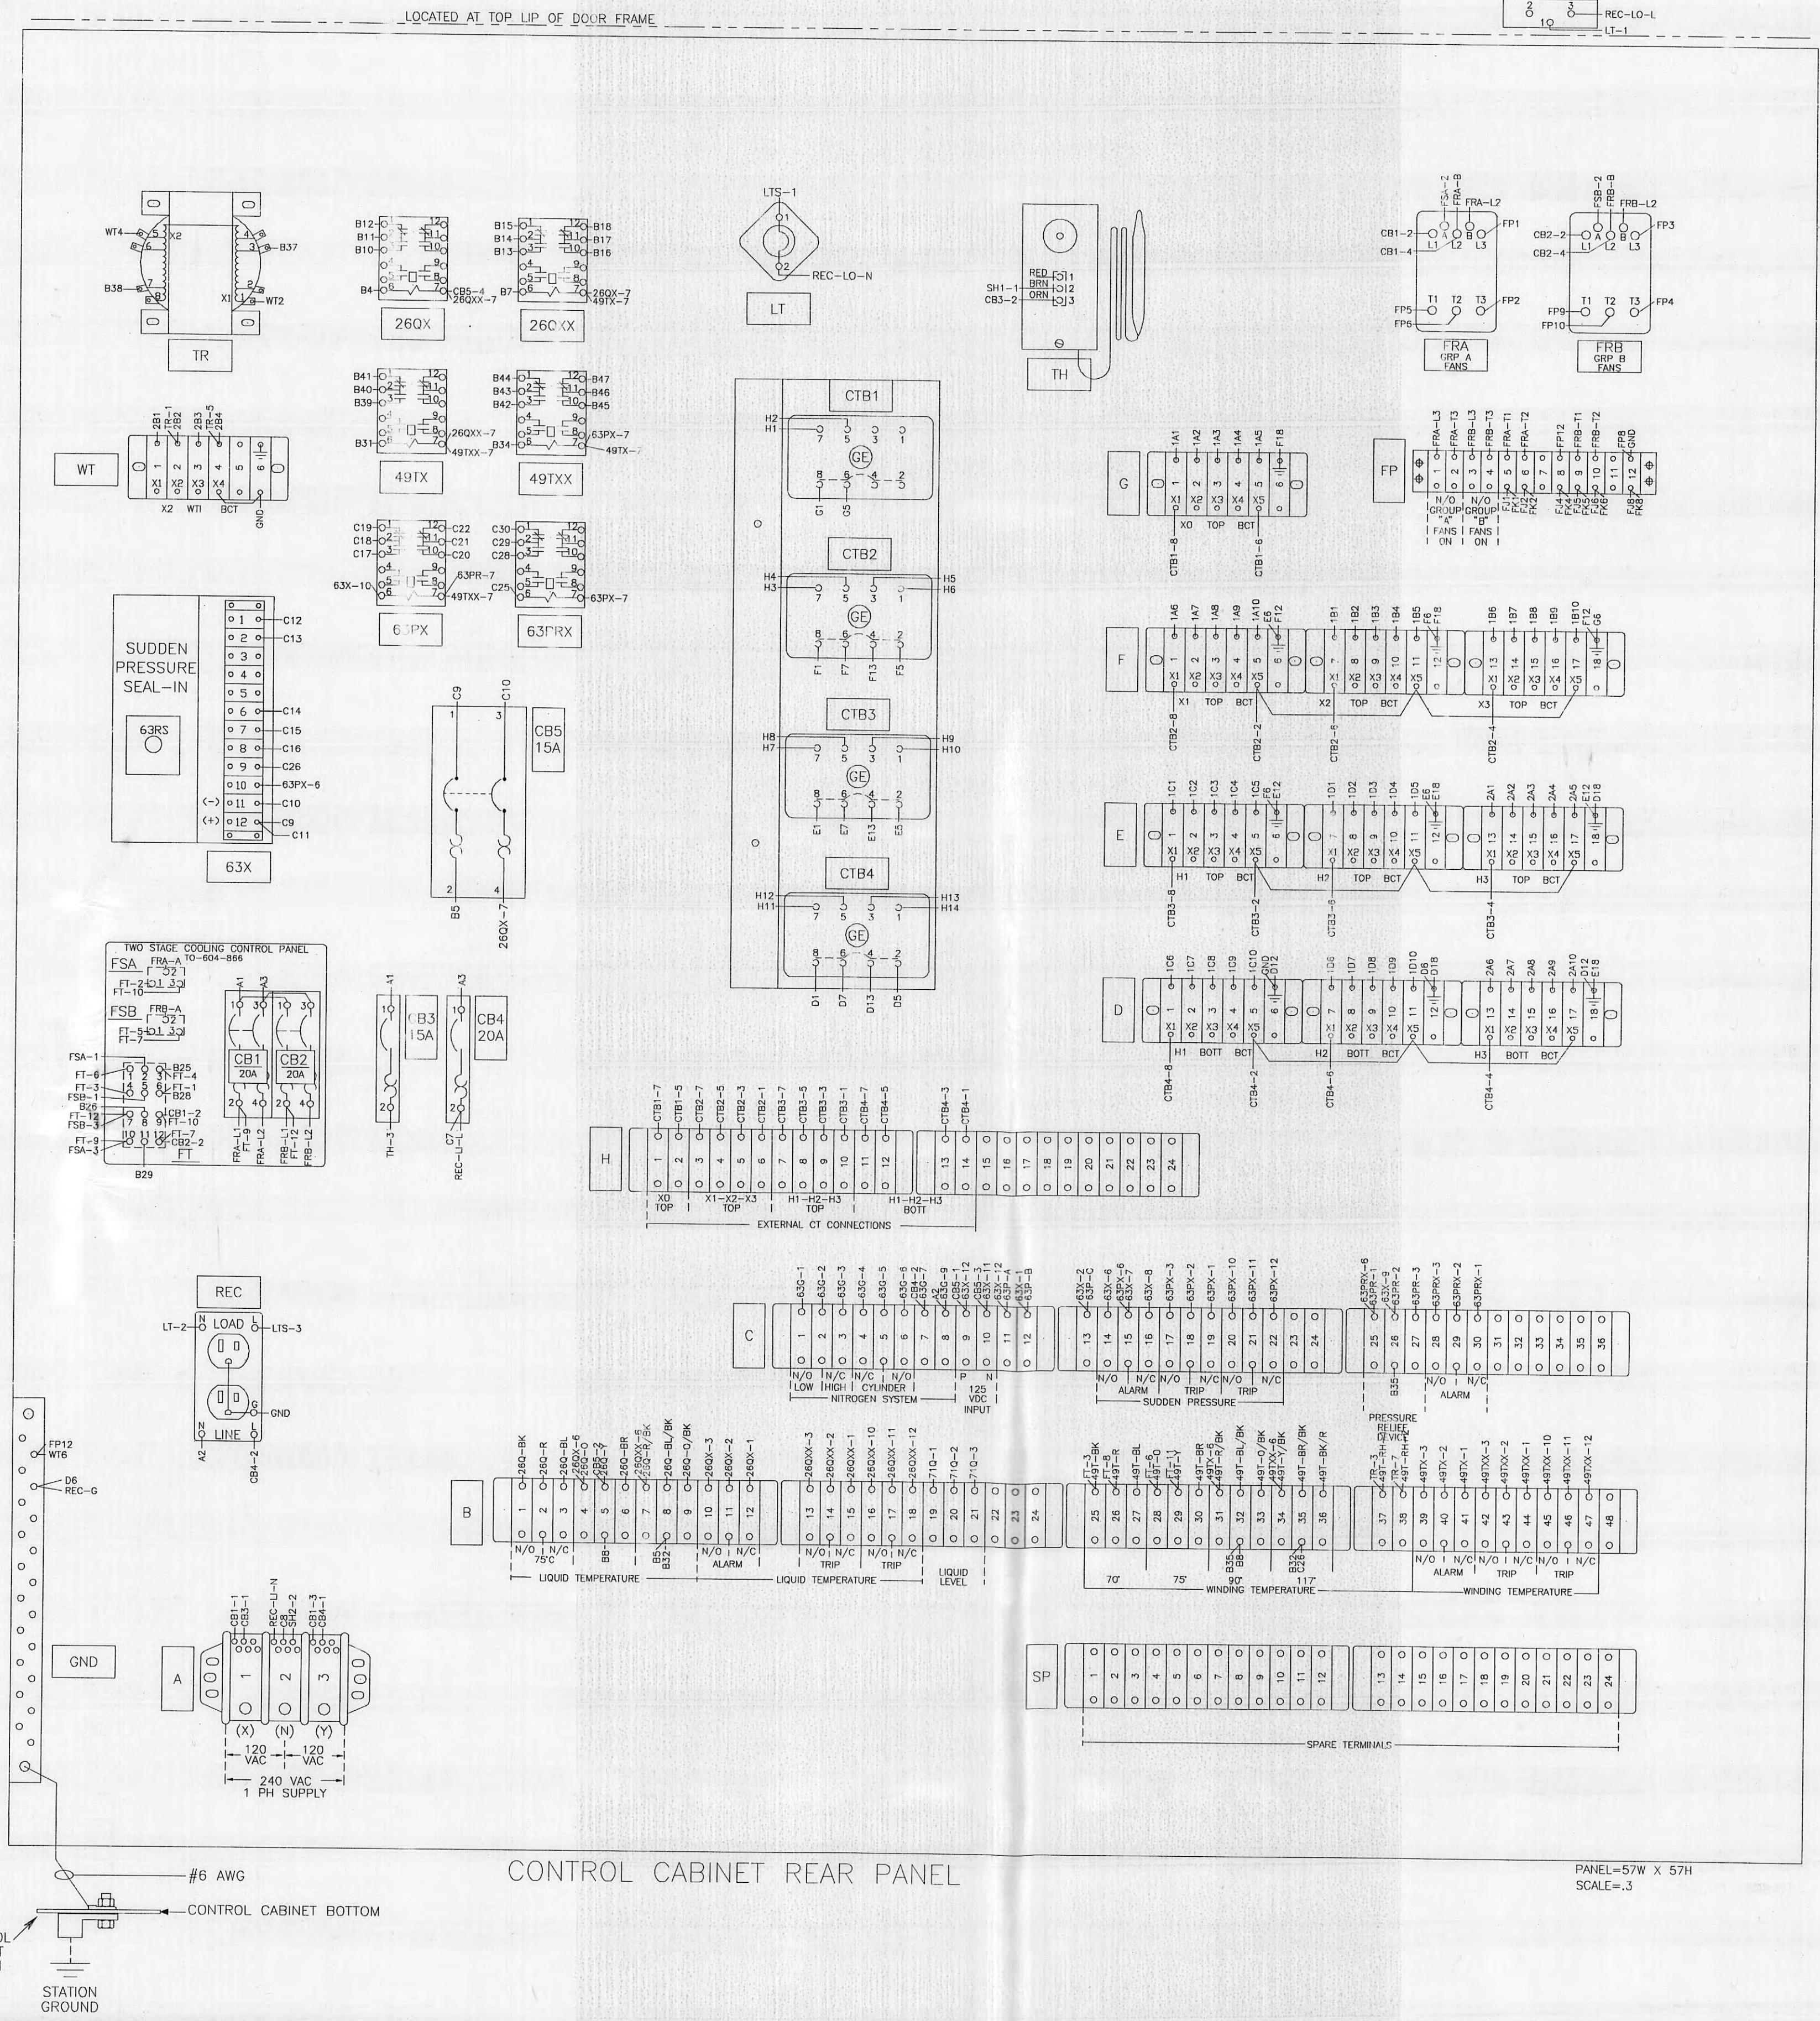


CONTROL CABINET BOTTOM

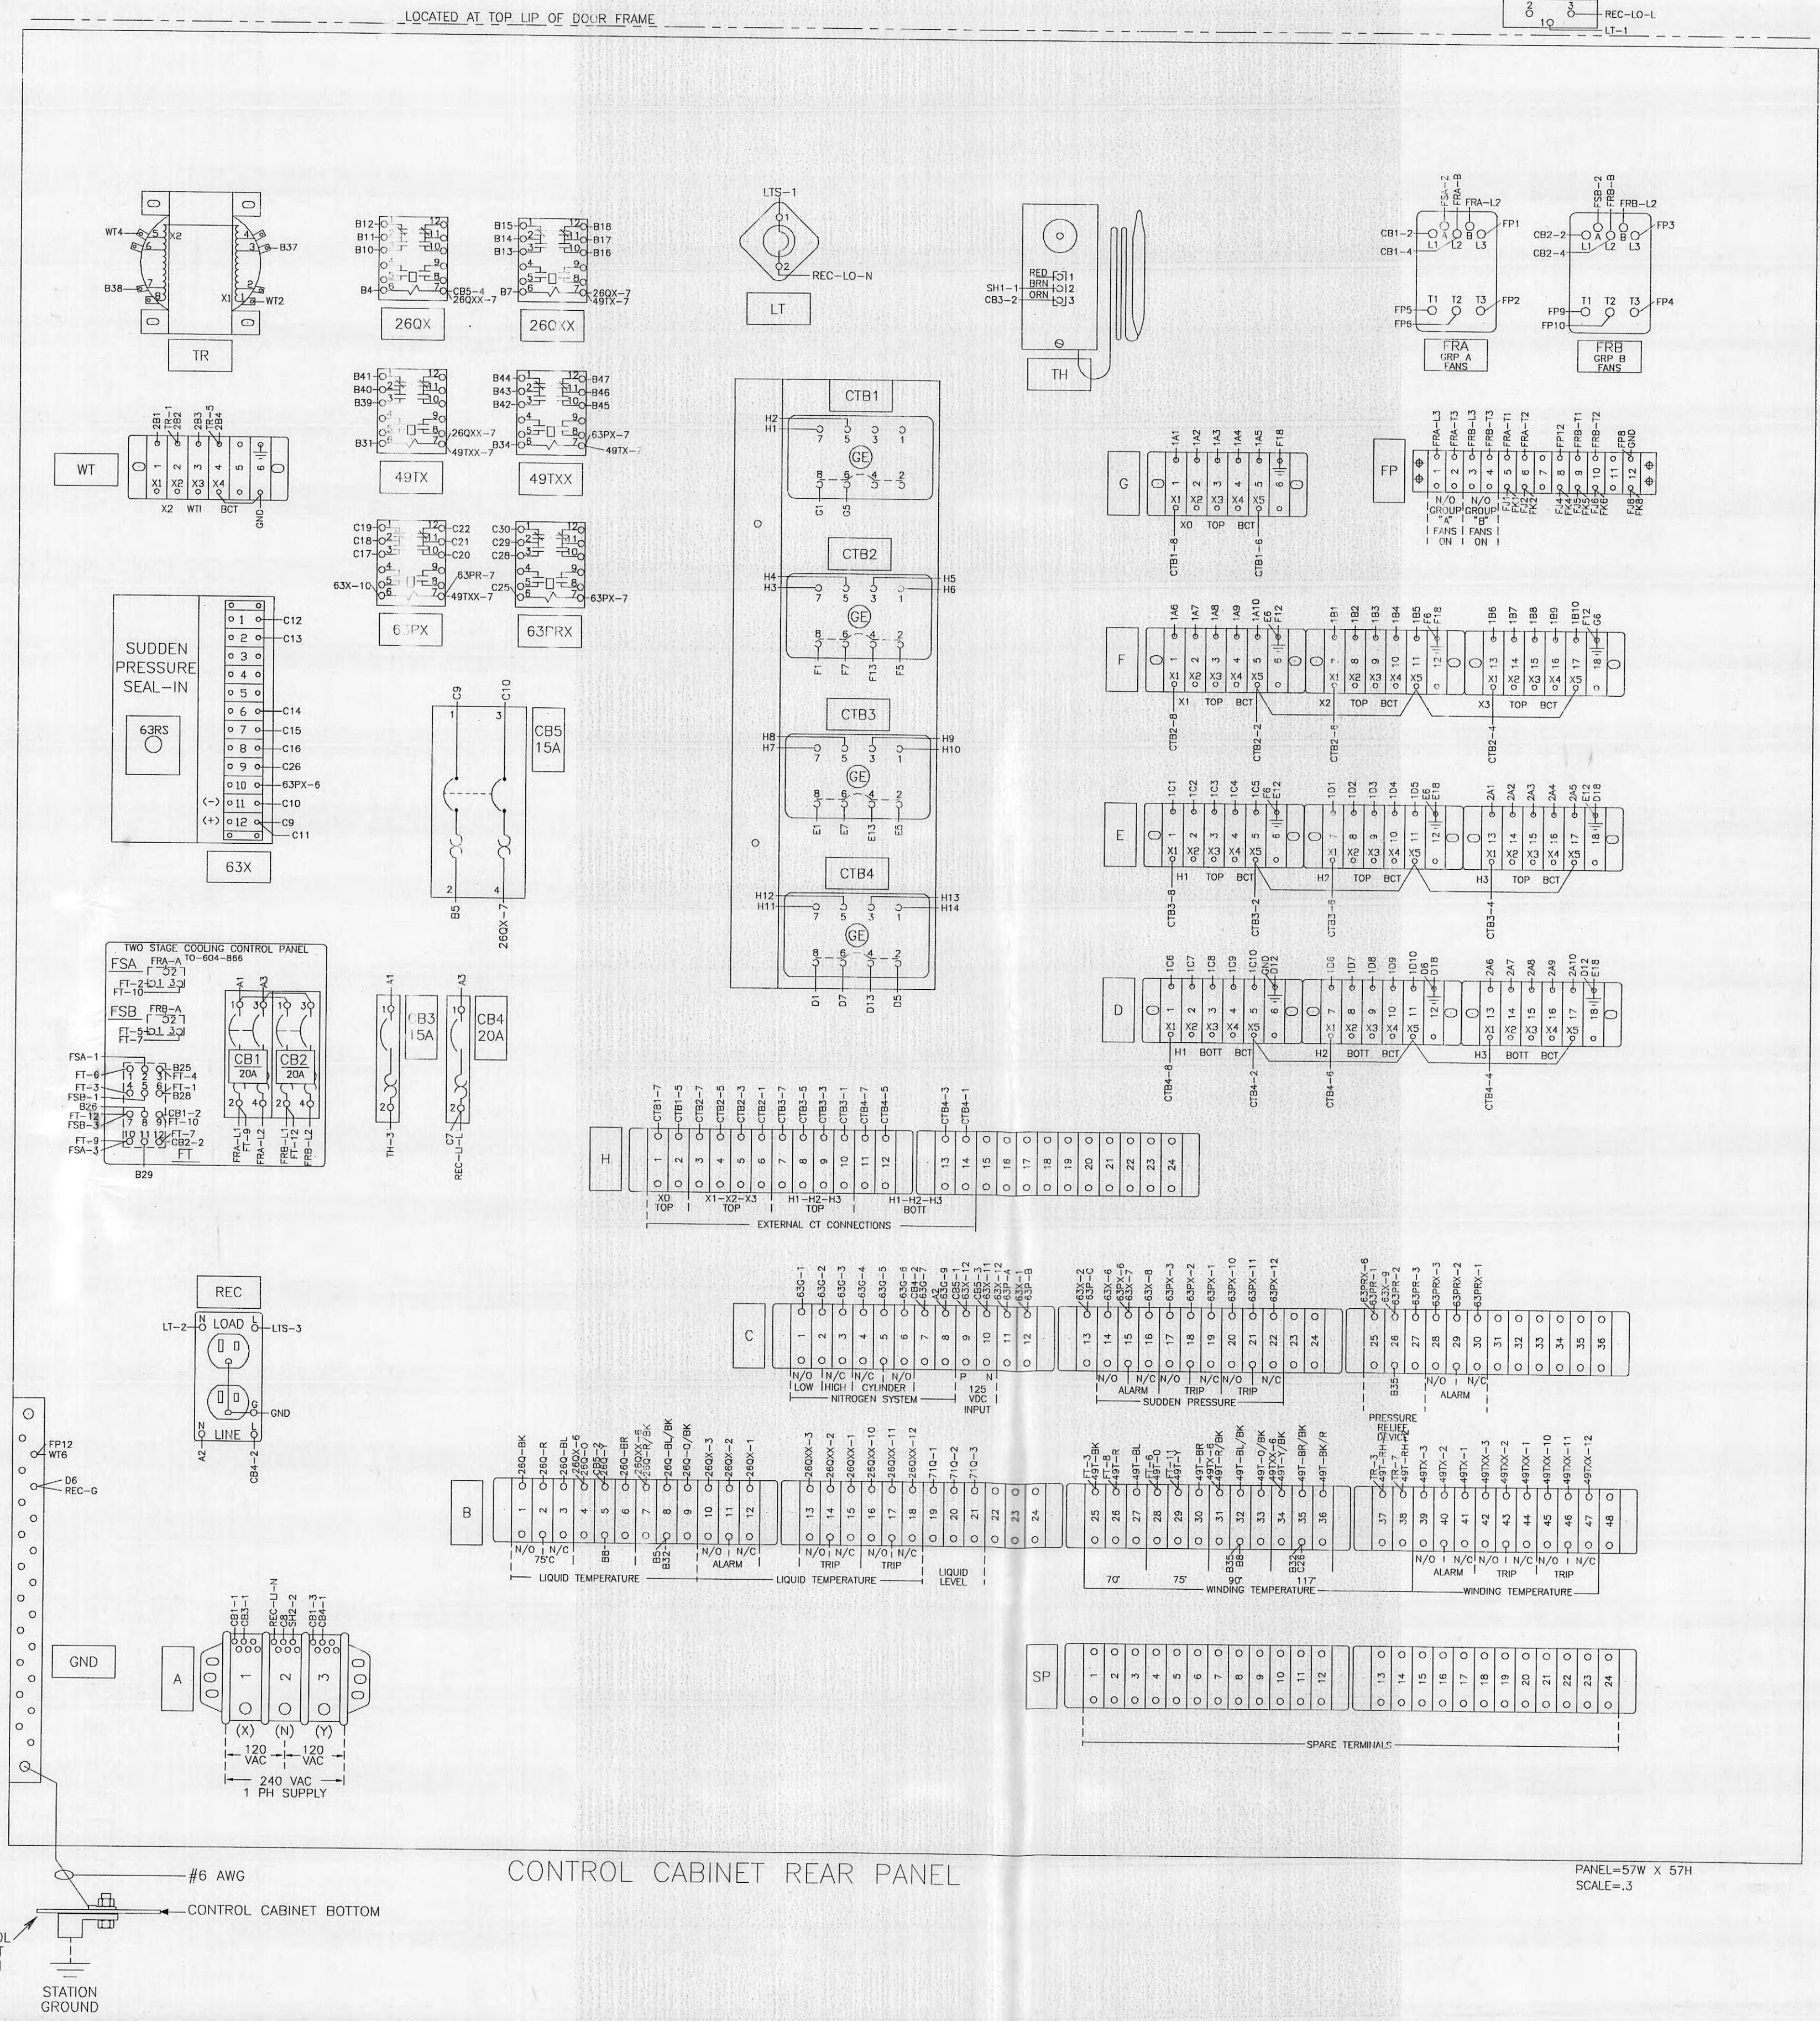


CONTROL CABINET BOTTOM

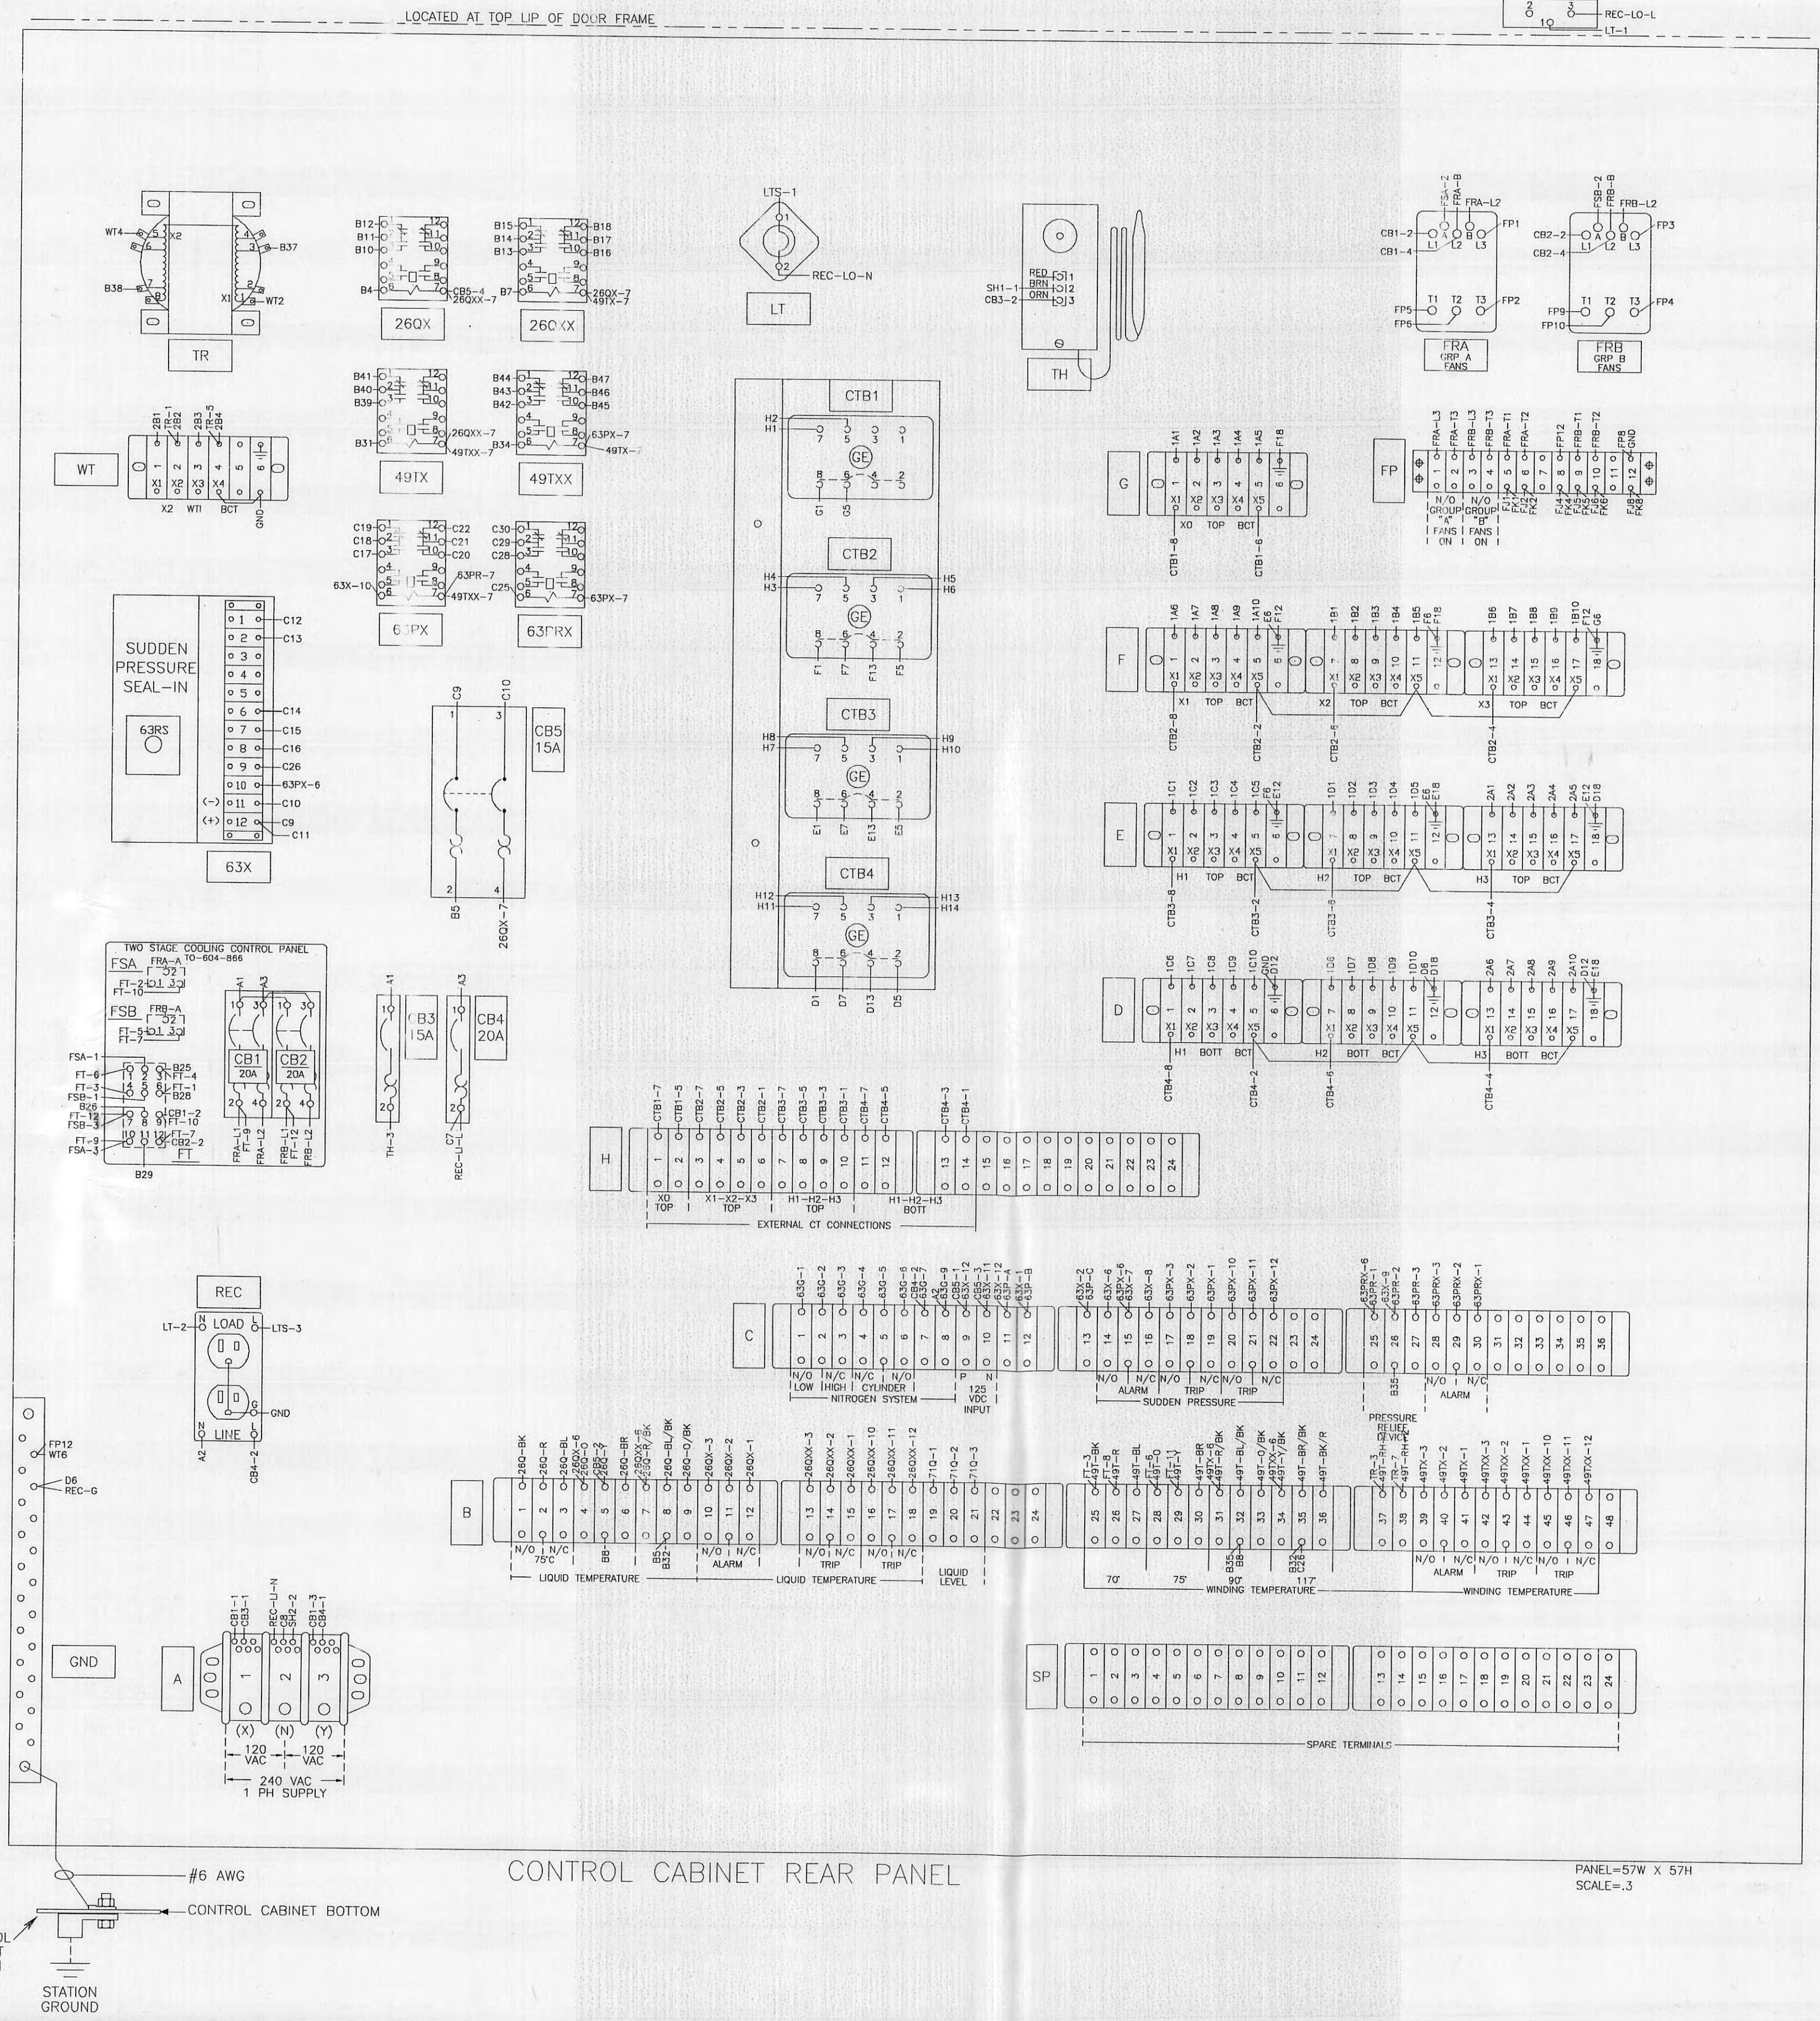


CONTROL CABINET BOTTOM

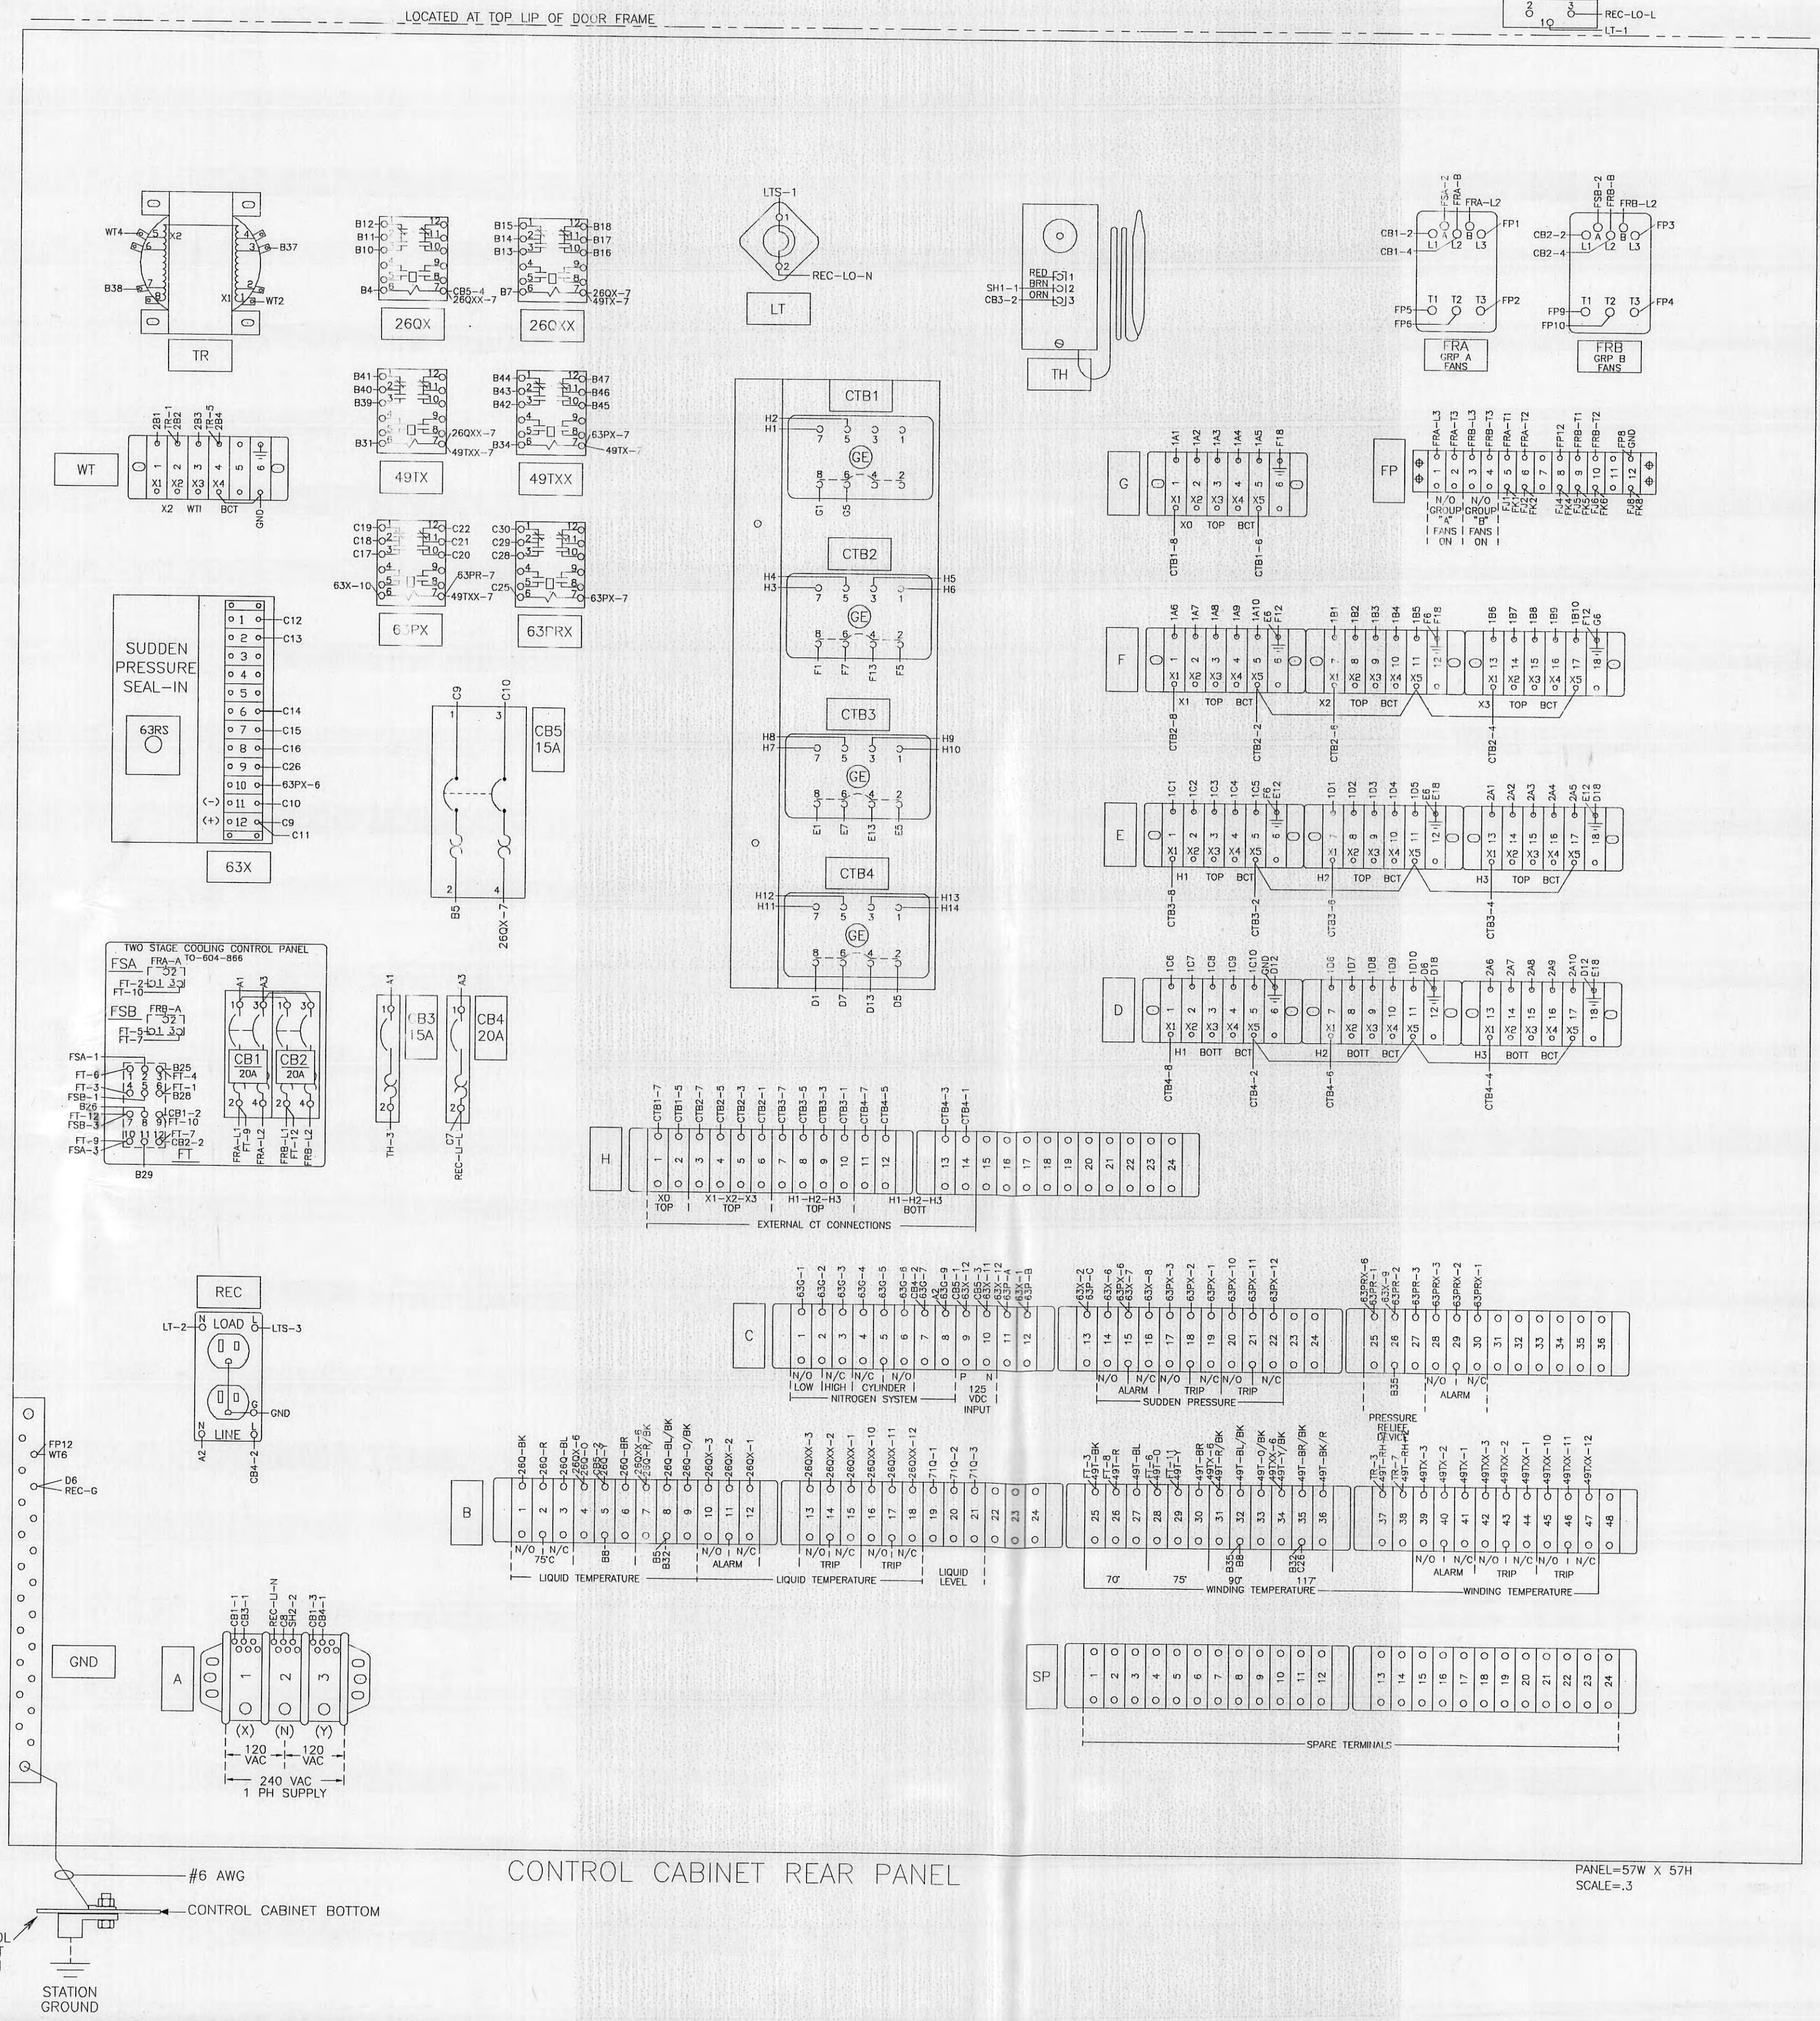


CONTROL CABINET BOTTOM

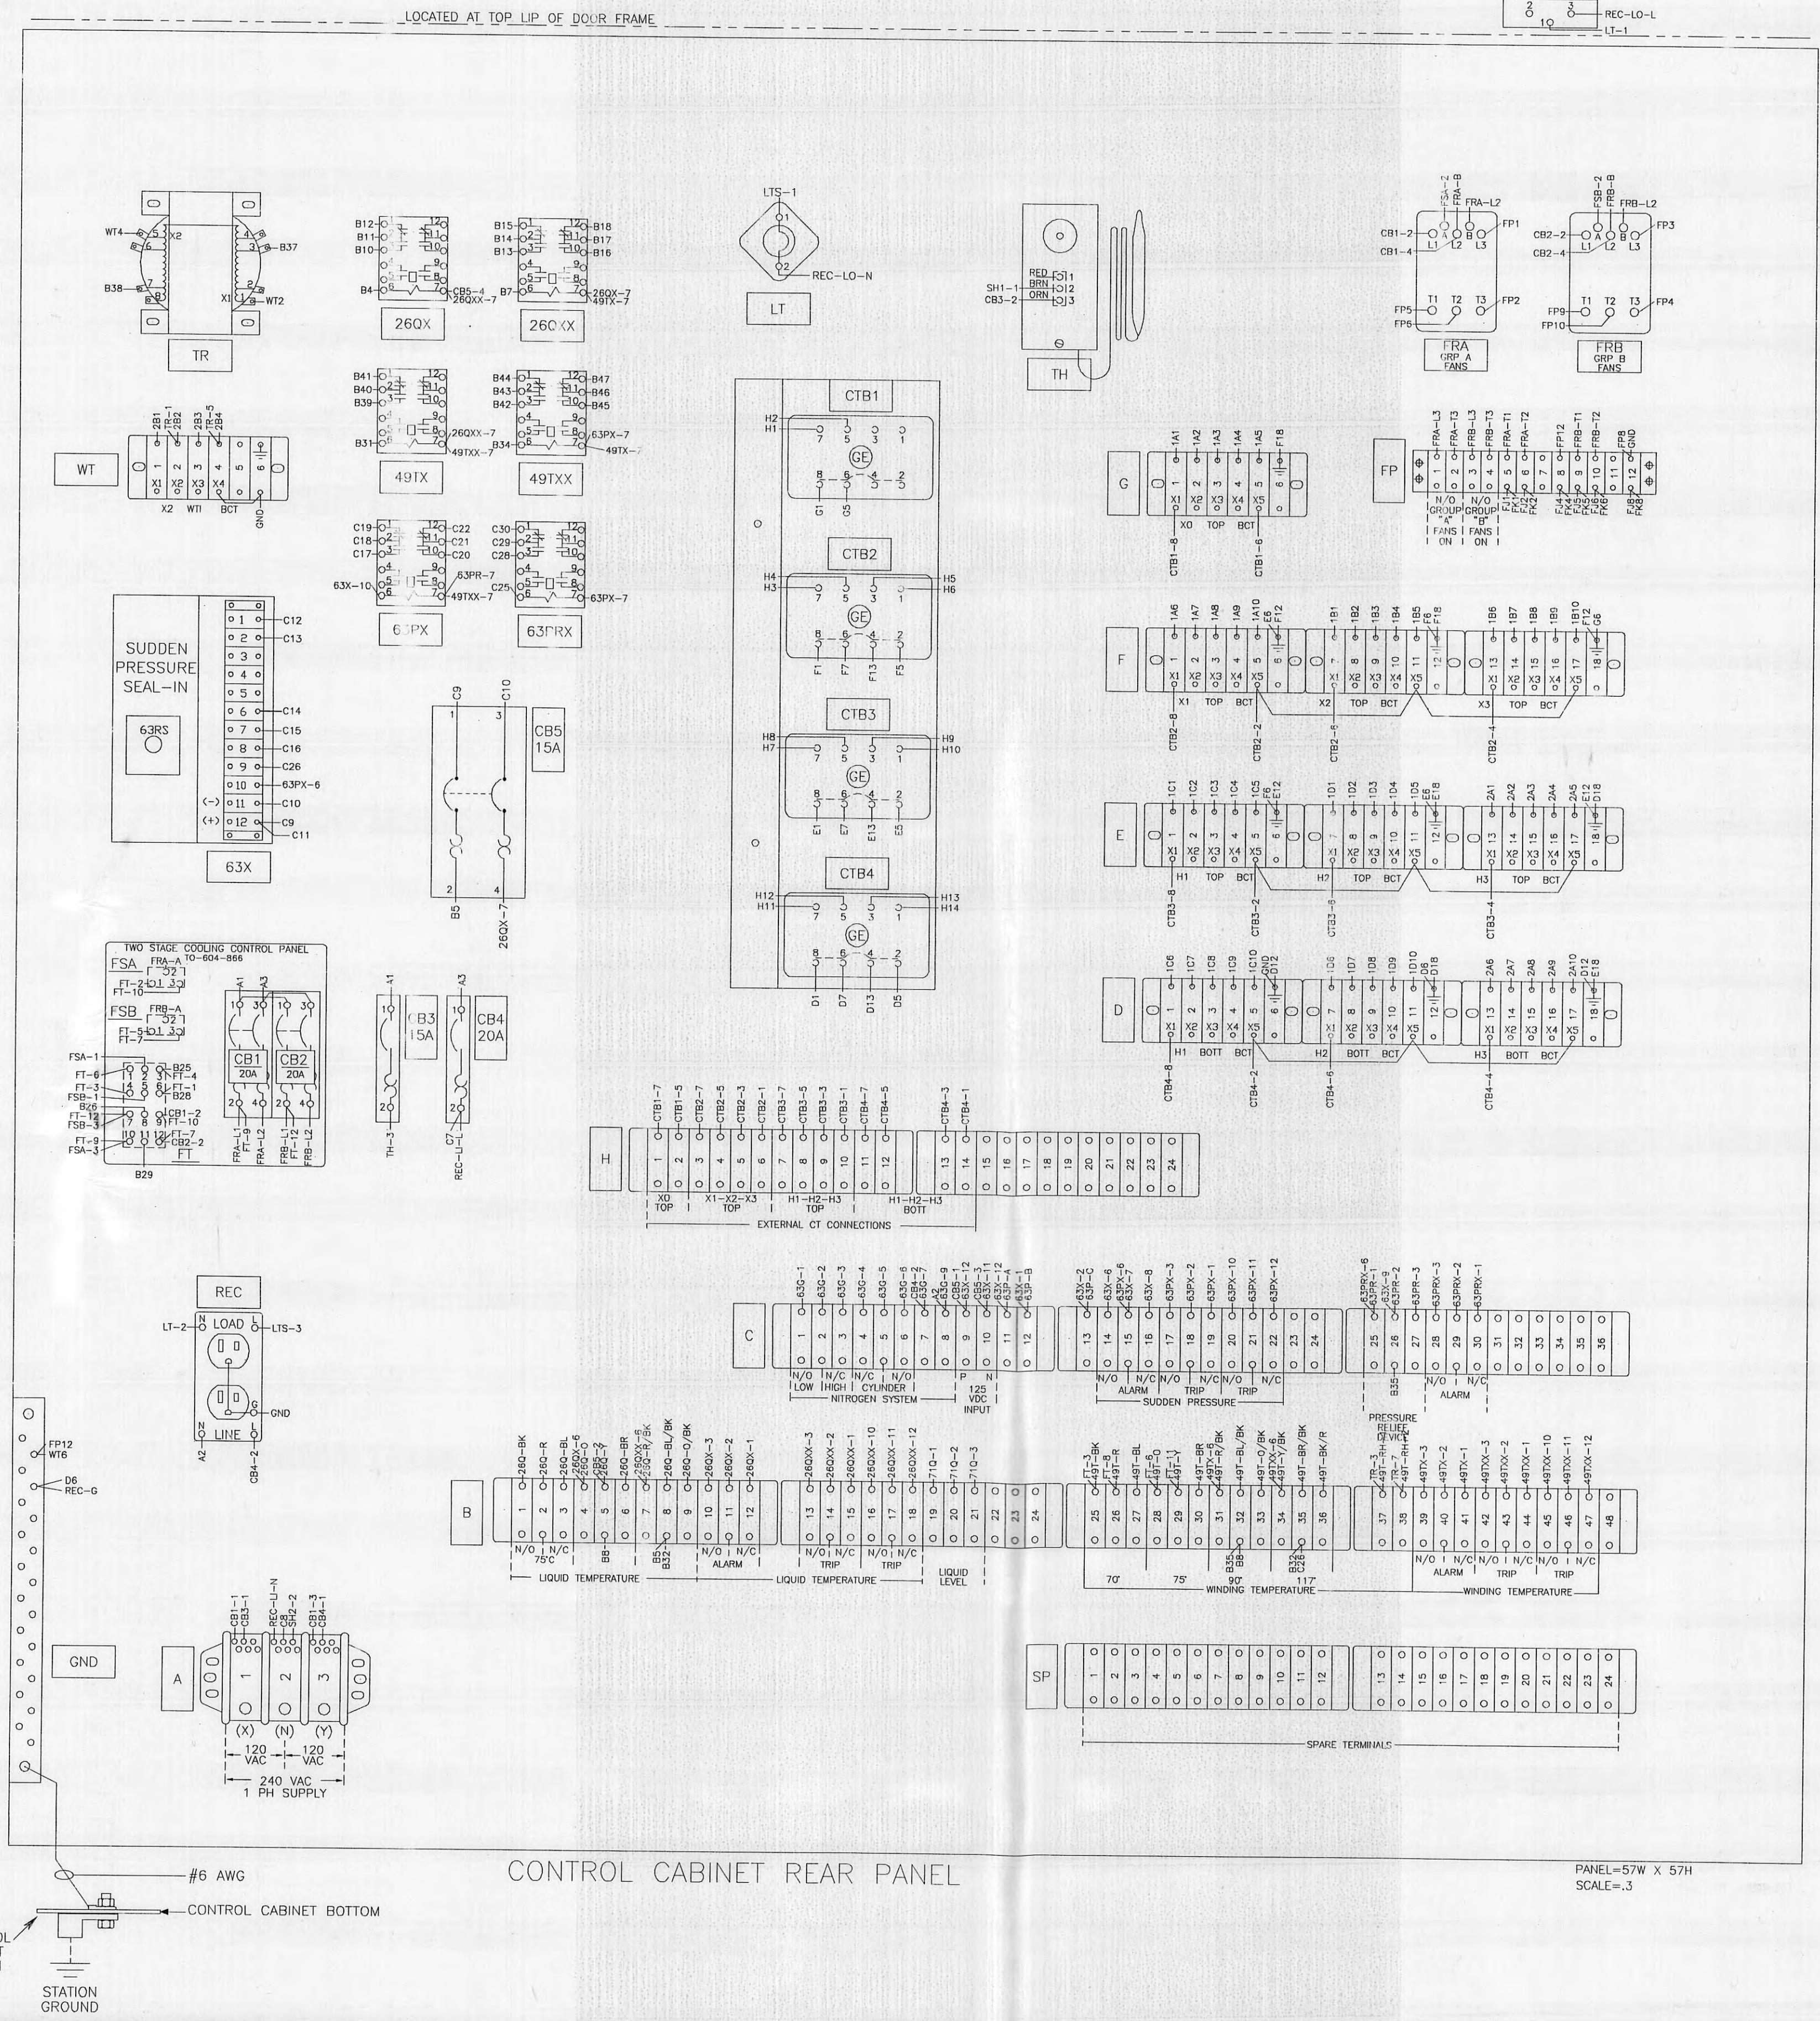


CONTROL CABINET BOTTOM

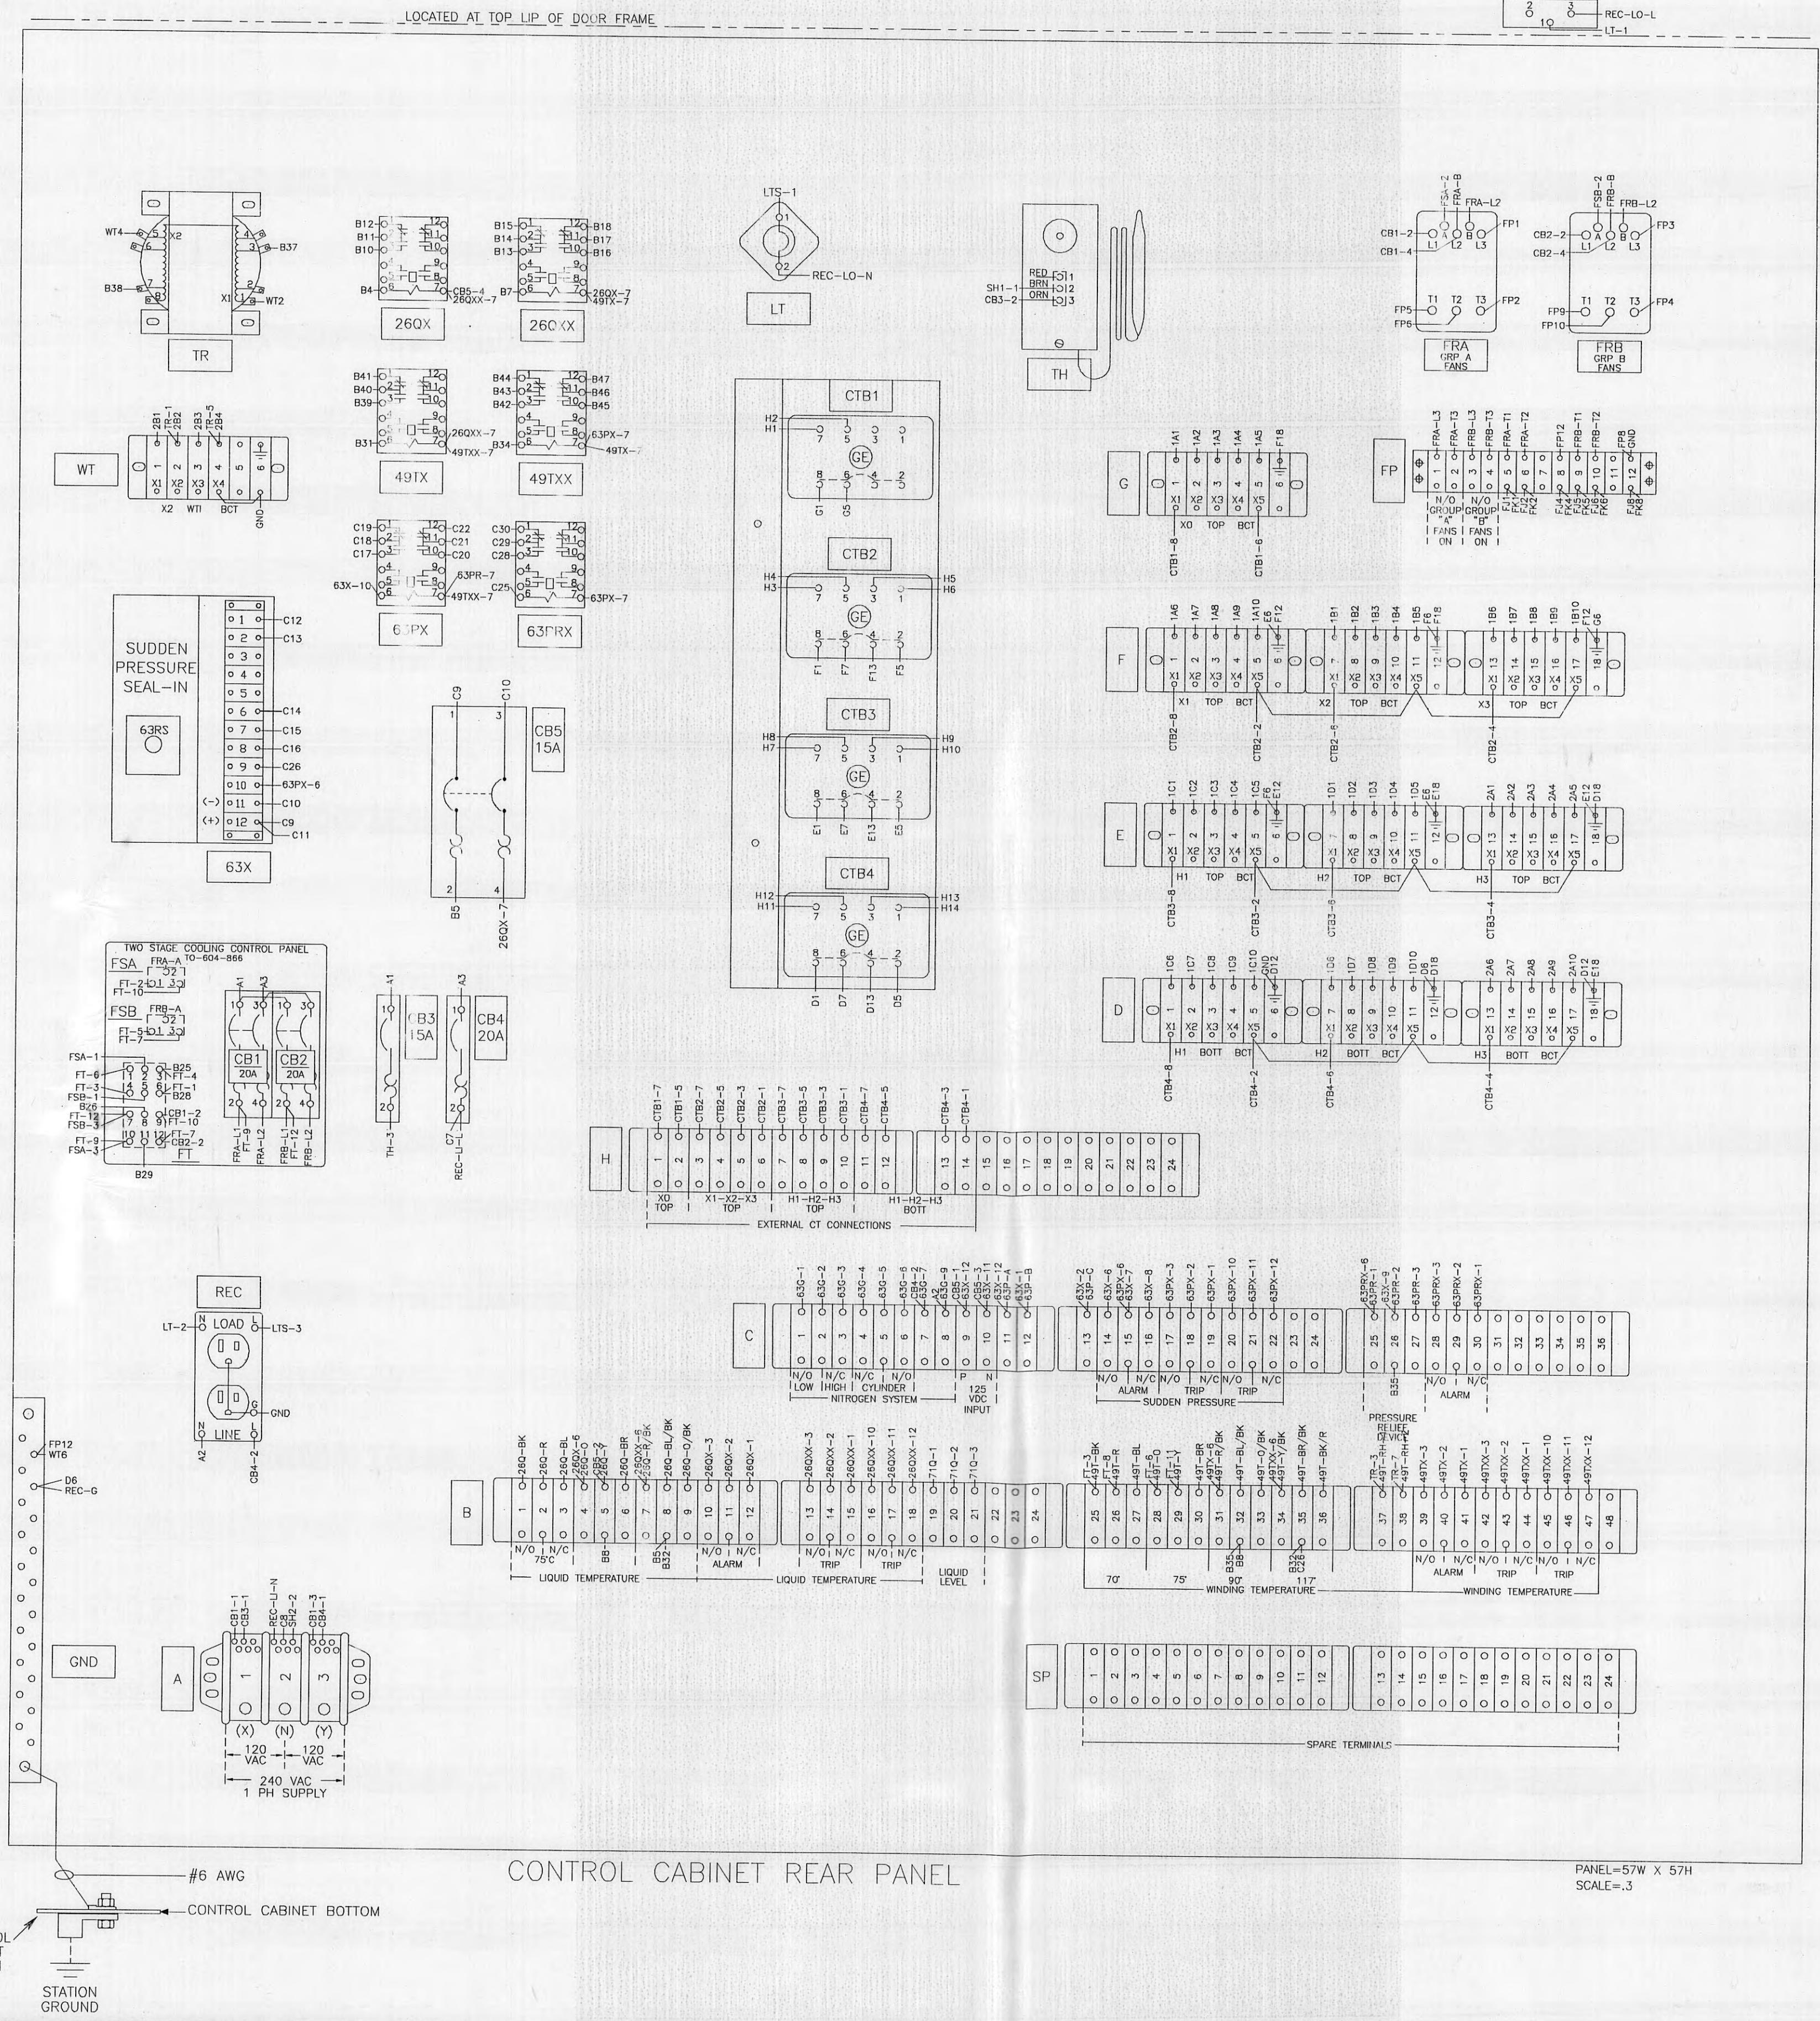

CONTROL CABINET BOTTOM

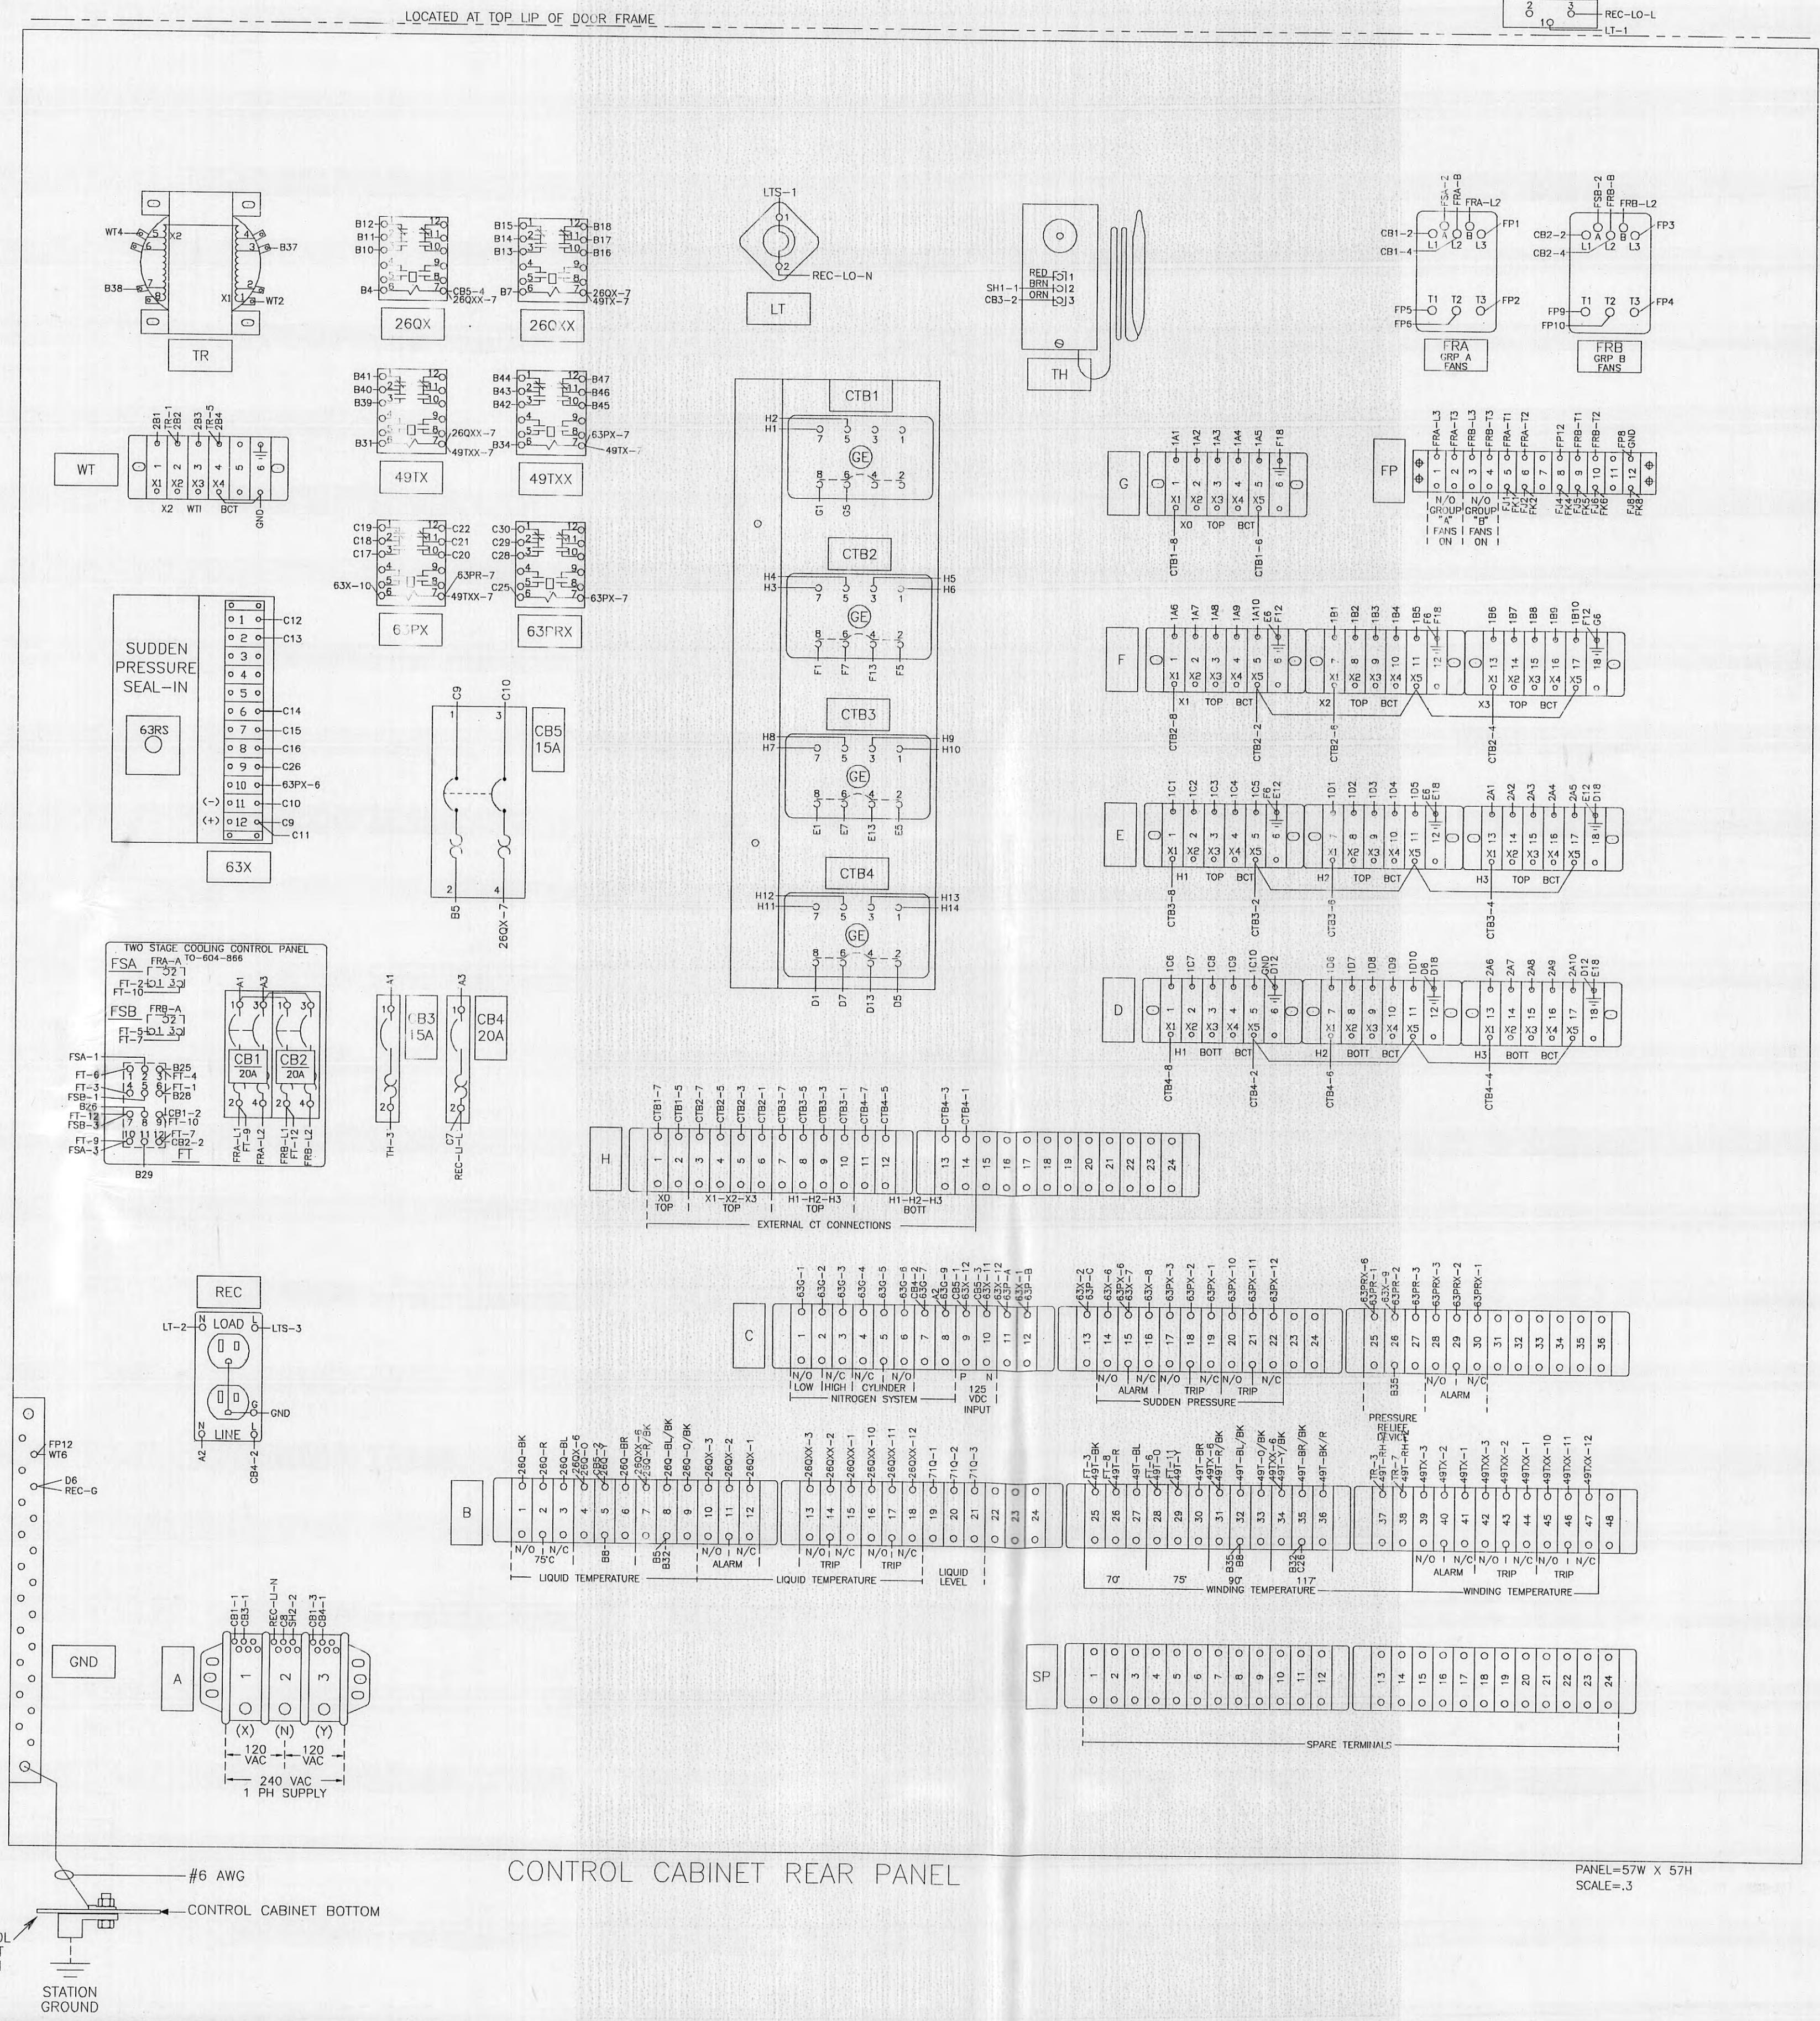

CONTROL CABINET BOTTOM

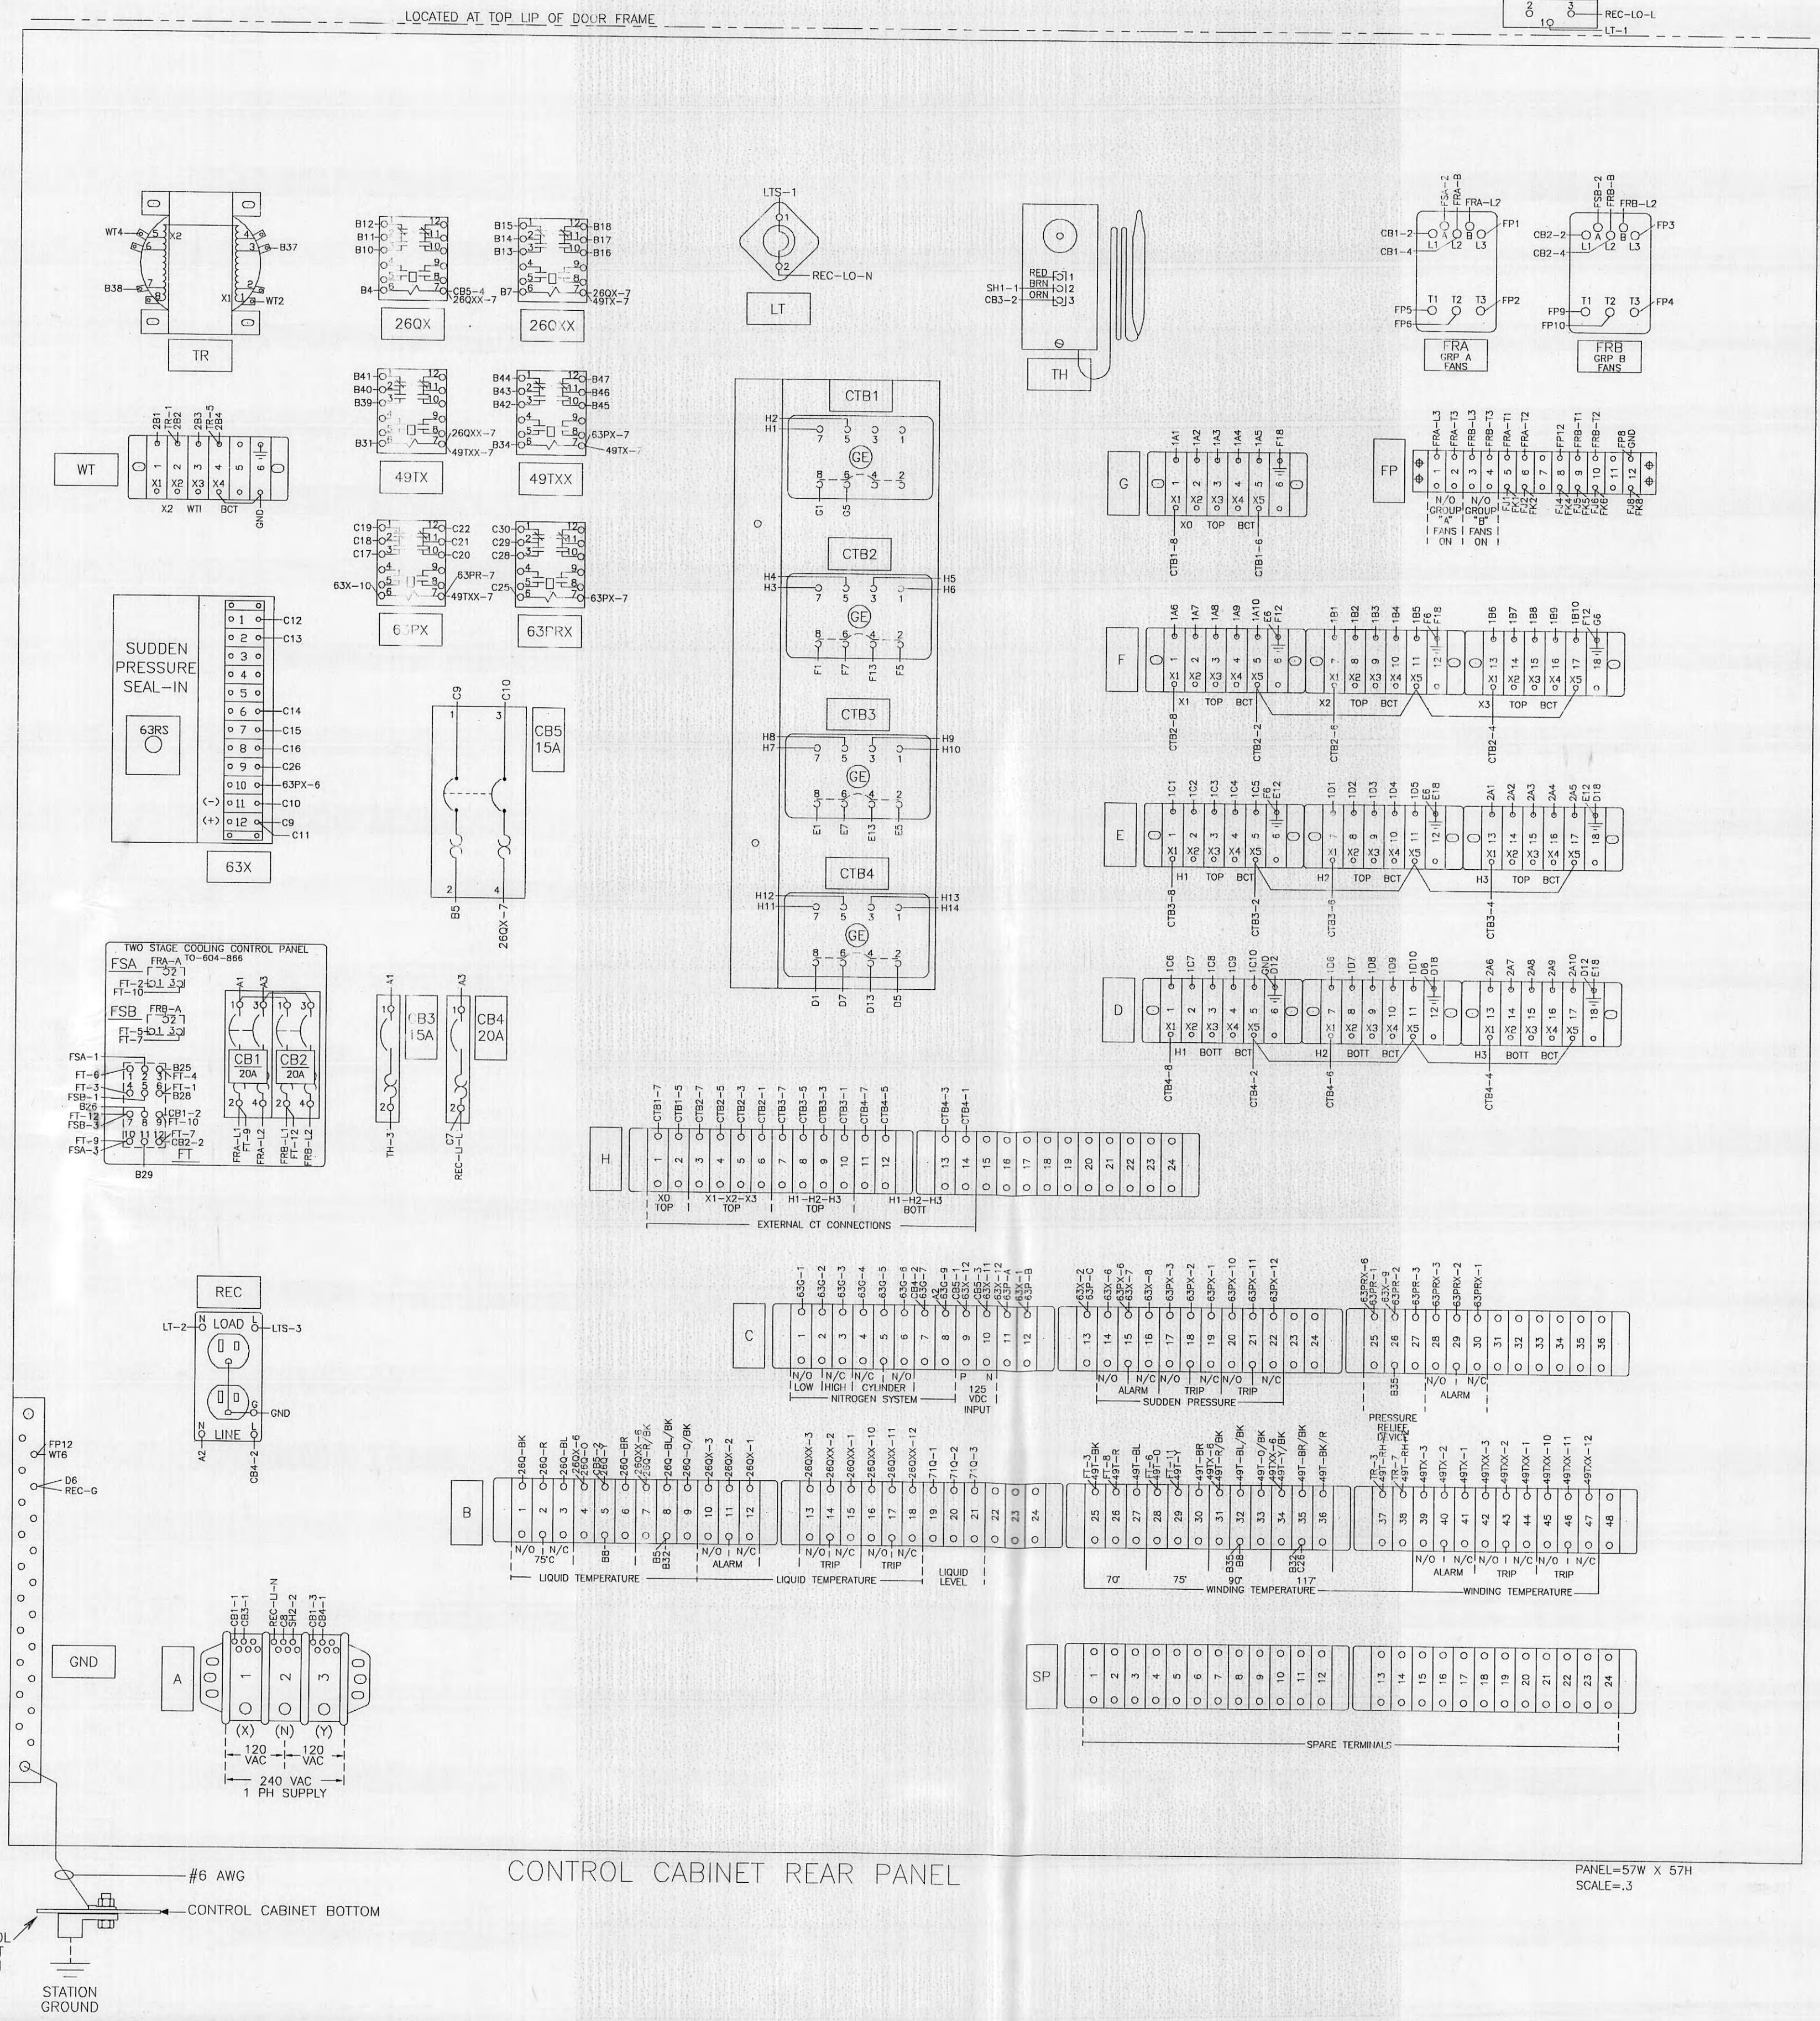

8

7

6

5

4

3

2


Item #	Qty	Description
1	1	1 in. upper filter press valve w/pipe plug.
2	1	1 inch vacuum flange with pipe plug in top cover
3	1	2 in. filter press/drain valve w/.375 sampler and plug.
4	2	Bolted manhole (20 inch opening) with gasket in groove with mechanical stops.
5	2	Center of gravity (assembled).
6	2	Center of gravity (shipping).
7	1	Channel bracing members.
8	1	Control box w/ padlock provisions and removable gasketed bottom plate
9	1	CT junction box.
10	1	Dial type liquid temperature indicator.
11	1	Enclosed inert gas system for oil preservation.
12	1	Fault pressure relay - ABB 4432A95G02
13	1	Flat base w/beveled edges for sliding both directions.
14	7	Ground clamp connector for 1/0 solid to 500 MCM copper cable.
15	8	Ground clamp connector for 4/0 solid to 500 MCM copper cable.
16	2	Grounding connector for #1/0 to 500 MCM copper cable.
17	1	Impact recorder (3 axis) mounted in removable enclosure.
18	4	Jacking plate with pulling provisions.
19	6	Lightning arrester mtg bkt. (3-.56in holes on 10 in bc).
20	1	Liquid level gauge.
21	4	Main cover lifting lug.
22	9	NEMA 2 hole s/stl ground pads.
23	7	NEMA 4 hole bronze tinned bushing spade connector for 1.5 in. stud.
24	1	No-load tap changer w/position indicator and padlock provisions.
25	1	Pressure relief device.
26	1	Pressure vacuum gauge with bleeder device.
27	2	Removable radiators w/shutoff valves, vent and drain (Left).
28	4	Removable radiators w/shutoff valves, vent and drain (Rear).
29	1	Stainless steel BCT and power nameplate.
30	4	Unit lifting lug (with chamfered edges) for lifting entire unit
31	1	Well for liquid temperature indicator probe
32	1	Well for winding temperature indicator probe
33	1	Winding temperature indicator.

TRANSFORMER EQUIPPED WITH INERT GAS SYSTEM FOR CONSTANT OIL PRESERVATION INCLUDING:  
 (A) PRESSURE VACUUM SWITCH  
 (B) GAS SAMPLING VALVE WITH HOSE BARB FITTING FOR .25" I.D. HOSE  
 (C) PRESSURE VACUUM GAUGE  
 (D) CYLINDER PRESSURE GAUGE WITH LOW PRESSURE ALARM  
 (E) PADLOCKABLE HINGED DOOR  
 (F) 220 CU. FT NITROGEN CYLINDERS  
 (G) CABINET IS DESIGNED WITH SPACE FOR TWO NITROGEN BOTTLES

ADDITIONAL DRAWING INFORMATION:  
 SEE LAPP DRAWING B88023-70 FOR COMPLETE HV BUSHING INFORMATION  
 SEE LAPP DRAWING B89123-70 FOR COMPLETE LV BUSHING INFORMATION  
 SEE LAPP DRAWING B89123-70 FOR COMPLETE NEUTRAL BUSHING INFORMATION  
 SEE OHIO BRASS DRAWING S007438-00 FOR COMPLETE HV ARRESTER INFORMATION  
 SEE OHIO BRASS DRAWING S007433-00 FOR COMPLETE LV ARRESTER INFORMATION  
 SEE WES DRAWING A547436890 FOR COMPLETE NAMEPLATE INFORMATION

## NOTES -


- (1) EXTERIOR TANK FINISH ANSI #70 LIGHT GRAY.
- (2) SEALED TANK CONSTRUCTION WITH WELDED MAIN TOP COVER.
- (3) ALL EXTERNAL CONTROL WIRING ROUTED THROUGH RIGID METAL CONDUIT EXCEPT FOR SHORT RUNS OF FLEXIBLE LIQUID TIGHT CONDUIT TO GAUGES AND FANS.
- (4) TANK AND FITTINGS DESIGNED FOR VACUUM FILLING IN THE FIELD.
- (5) ALL EXTERNAL REMOVABLE AND/OR UN-PAINTED HARDWARE CORROSION RESISTANT.
- (6) TRANSFORMER DESIGNED FOR TRUCK SHIPMENT.
- (7) TRANSFORMER SHIPPED FILLED WITH OIL.
- (8) SEE CONTROL WIRING FOR ALL ALARM CONTACT INFORMATION.
- (9) FANS - 26"-1/3 HP-230V-1 PH-60 HZ-1140 RPM-7400 CFM.  
 STAGE "A" REAR - (3) FANS  
 STAGE "B" REAR - (3) FANS  
 STAGE "A" END - (2) FANS  
 STAGE "B" END - (2) FANS

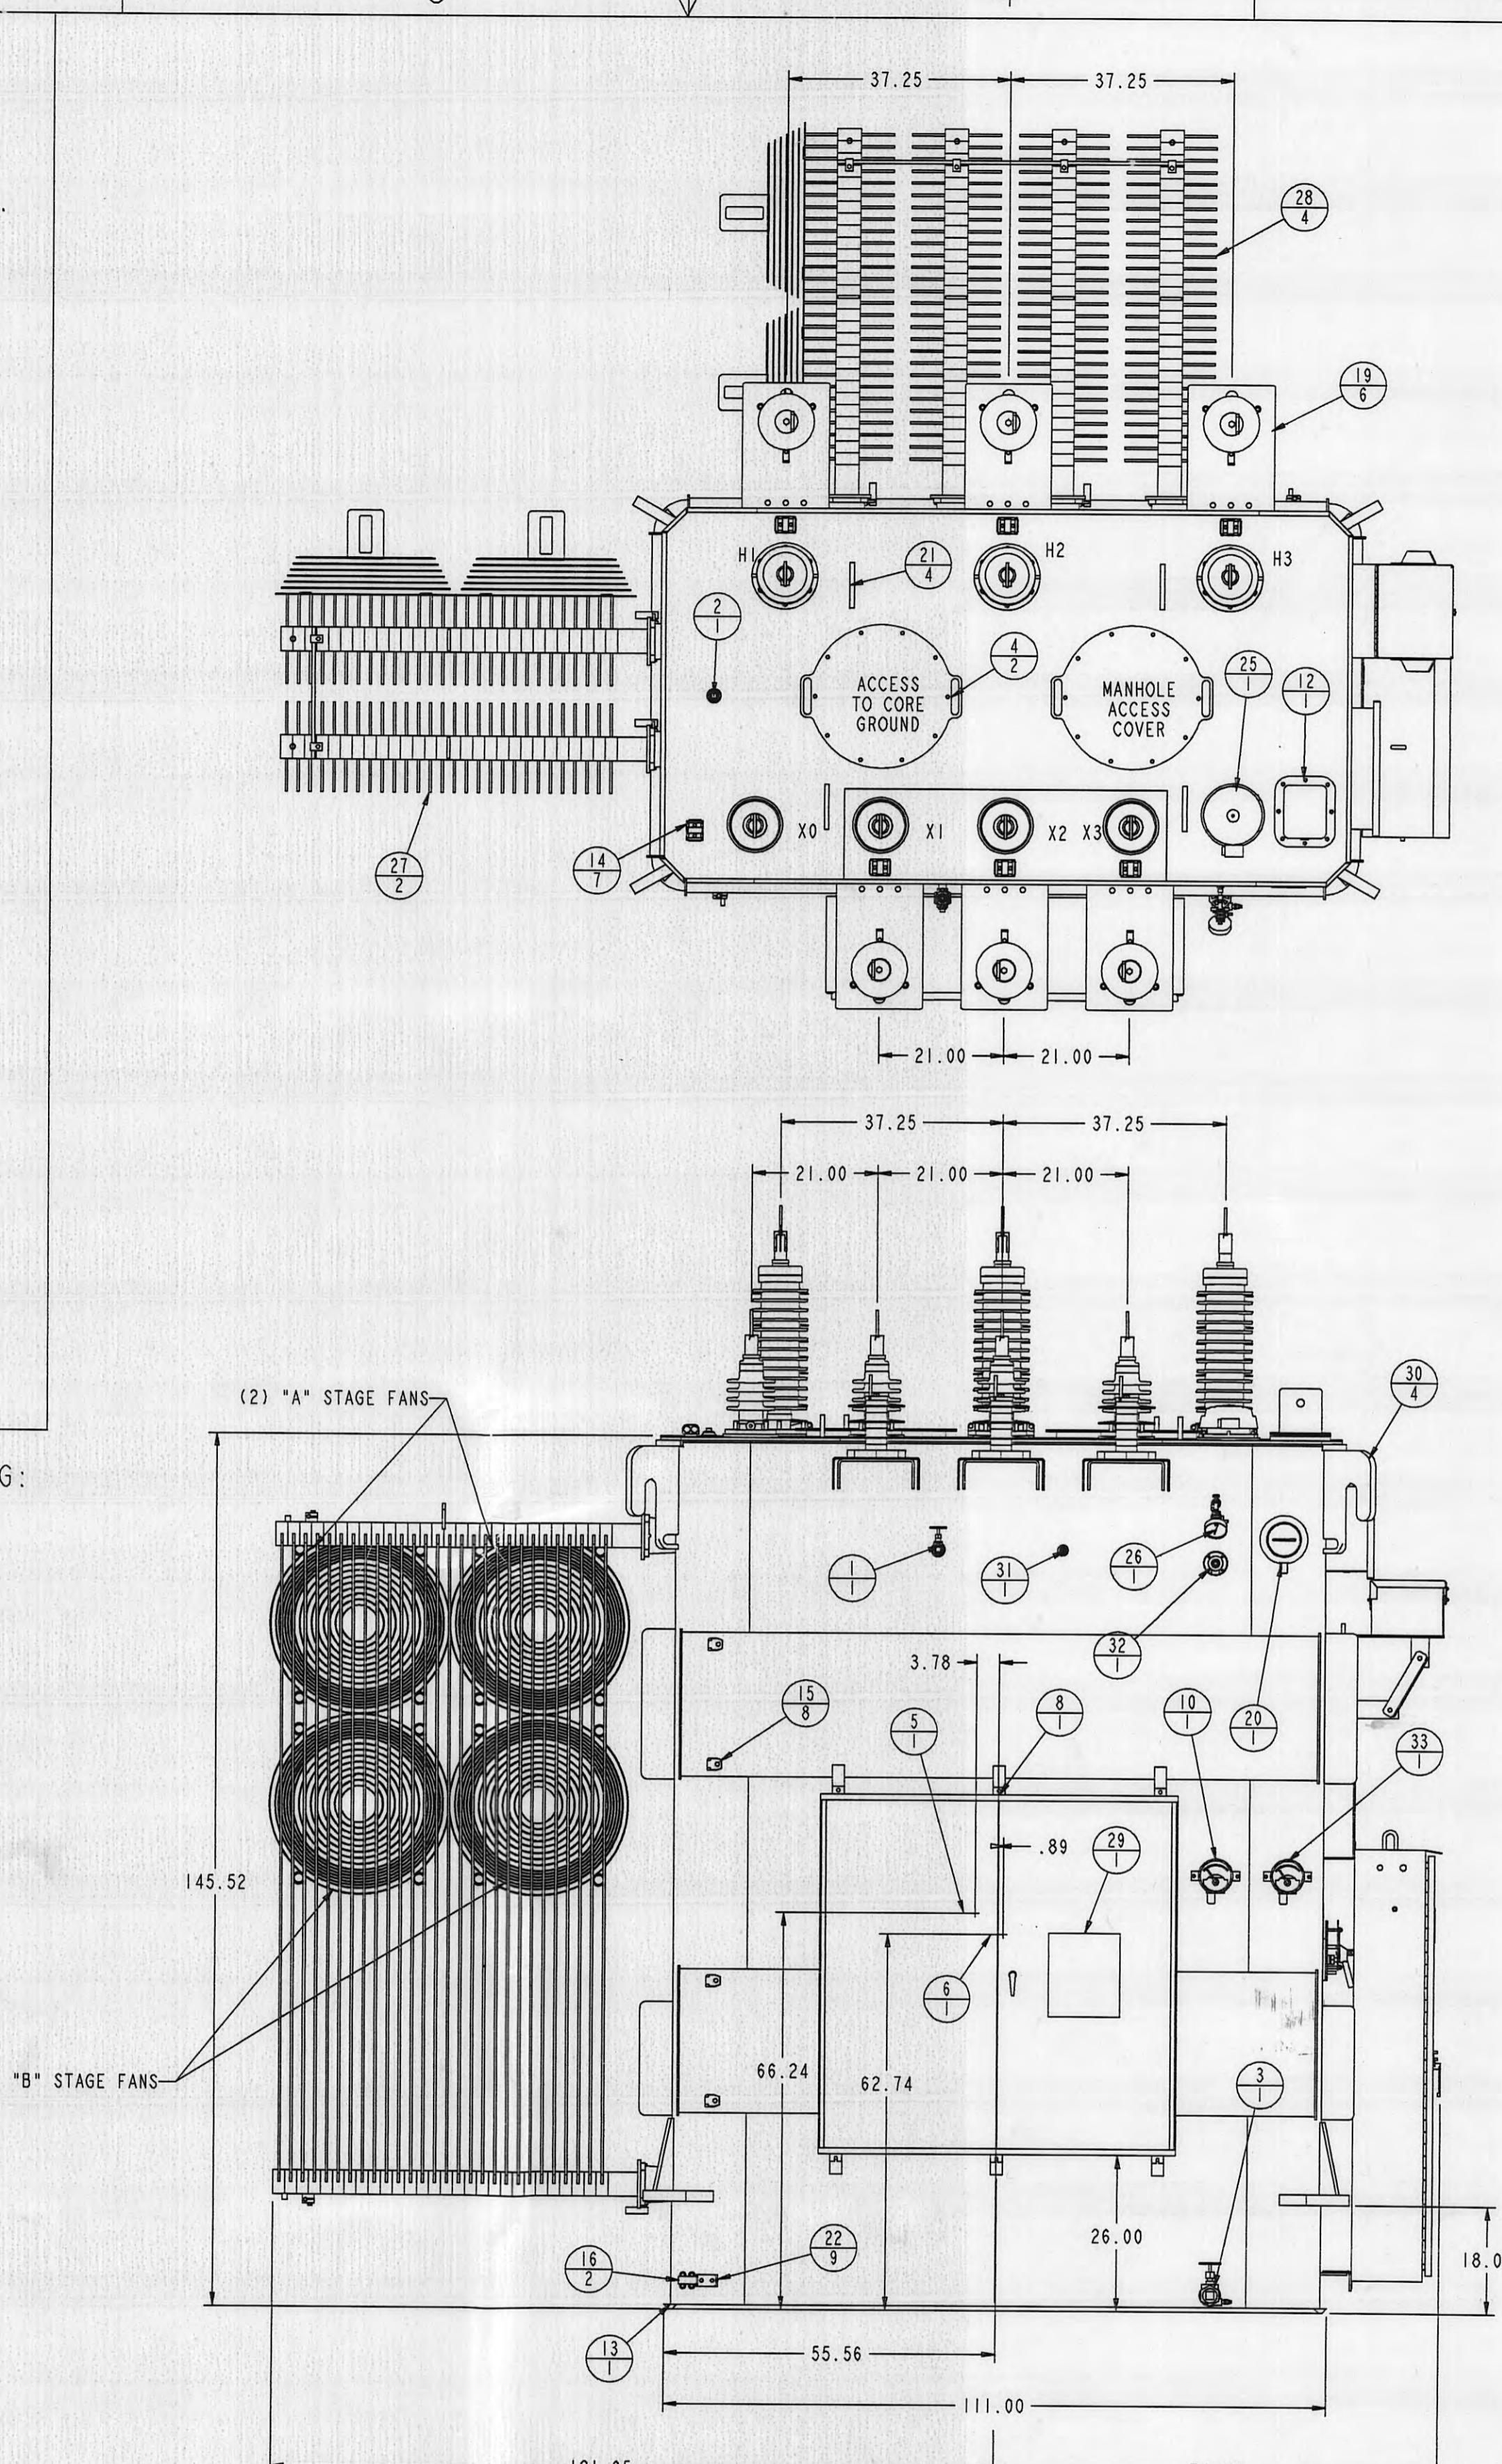

22.5/30.0/37.5/42.0 M.V.A. TYPE OISC OA/FA/FA/FA  
 3 PHASE 60 HERTZ 55/55/55/65 DEGREES C RISE  
 HV - 68800 DELTA 350 KV BIL  
 LV - 13090Y/7560 110 KV BIL  
 NEUTRAL 110 KV BIL  
 UNTANKING HEIGHT = 280"  
 HV TAPS - 72400  
 70600  
 68800  
 67000  
 65200  
 CORE AND COIL WT. = 50000  
 TANK AND FITTING WT. = 26950  
 OIL WT. = 20850  
 TOTAL WT. = 97800  
 SHIPPING WT. = 85200  
 TOTAL GALLONS OIL = 2780

SHIPPING DIMENSIONS: HEIGHT= 154" WIDTH= 139" DEPTH= 91"

NOTE - THE FOLLOWING ITEMS ARE REMOVED FOR SHIPMENT:  
 PRIMARY BUSHINGS AND SPADES  
 PRIMARY LIGHTNING ARRESTERS  
 PRIMARY LIGHTNING ARRESTER MOUNTING BRACKETS  
 SECONDARY BUSHINGS AND SPADES  
 SECONDARY LIGHTNING ARRESTERS  
 SECONDARY LIGHTNING ARRESTER MOUNTING BRAKETS  
 RADIATORS INCLUDING FANS  
 ONE BARREL OIL - 50 GALLONS

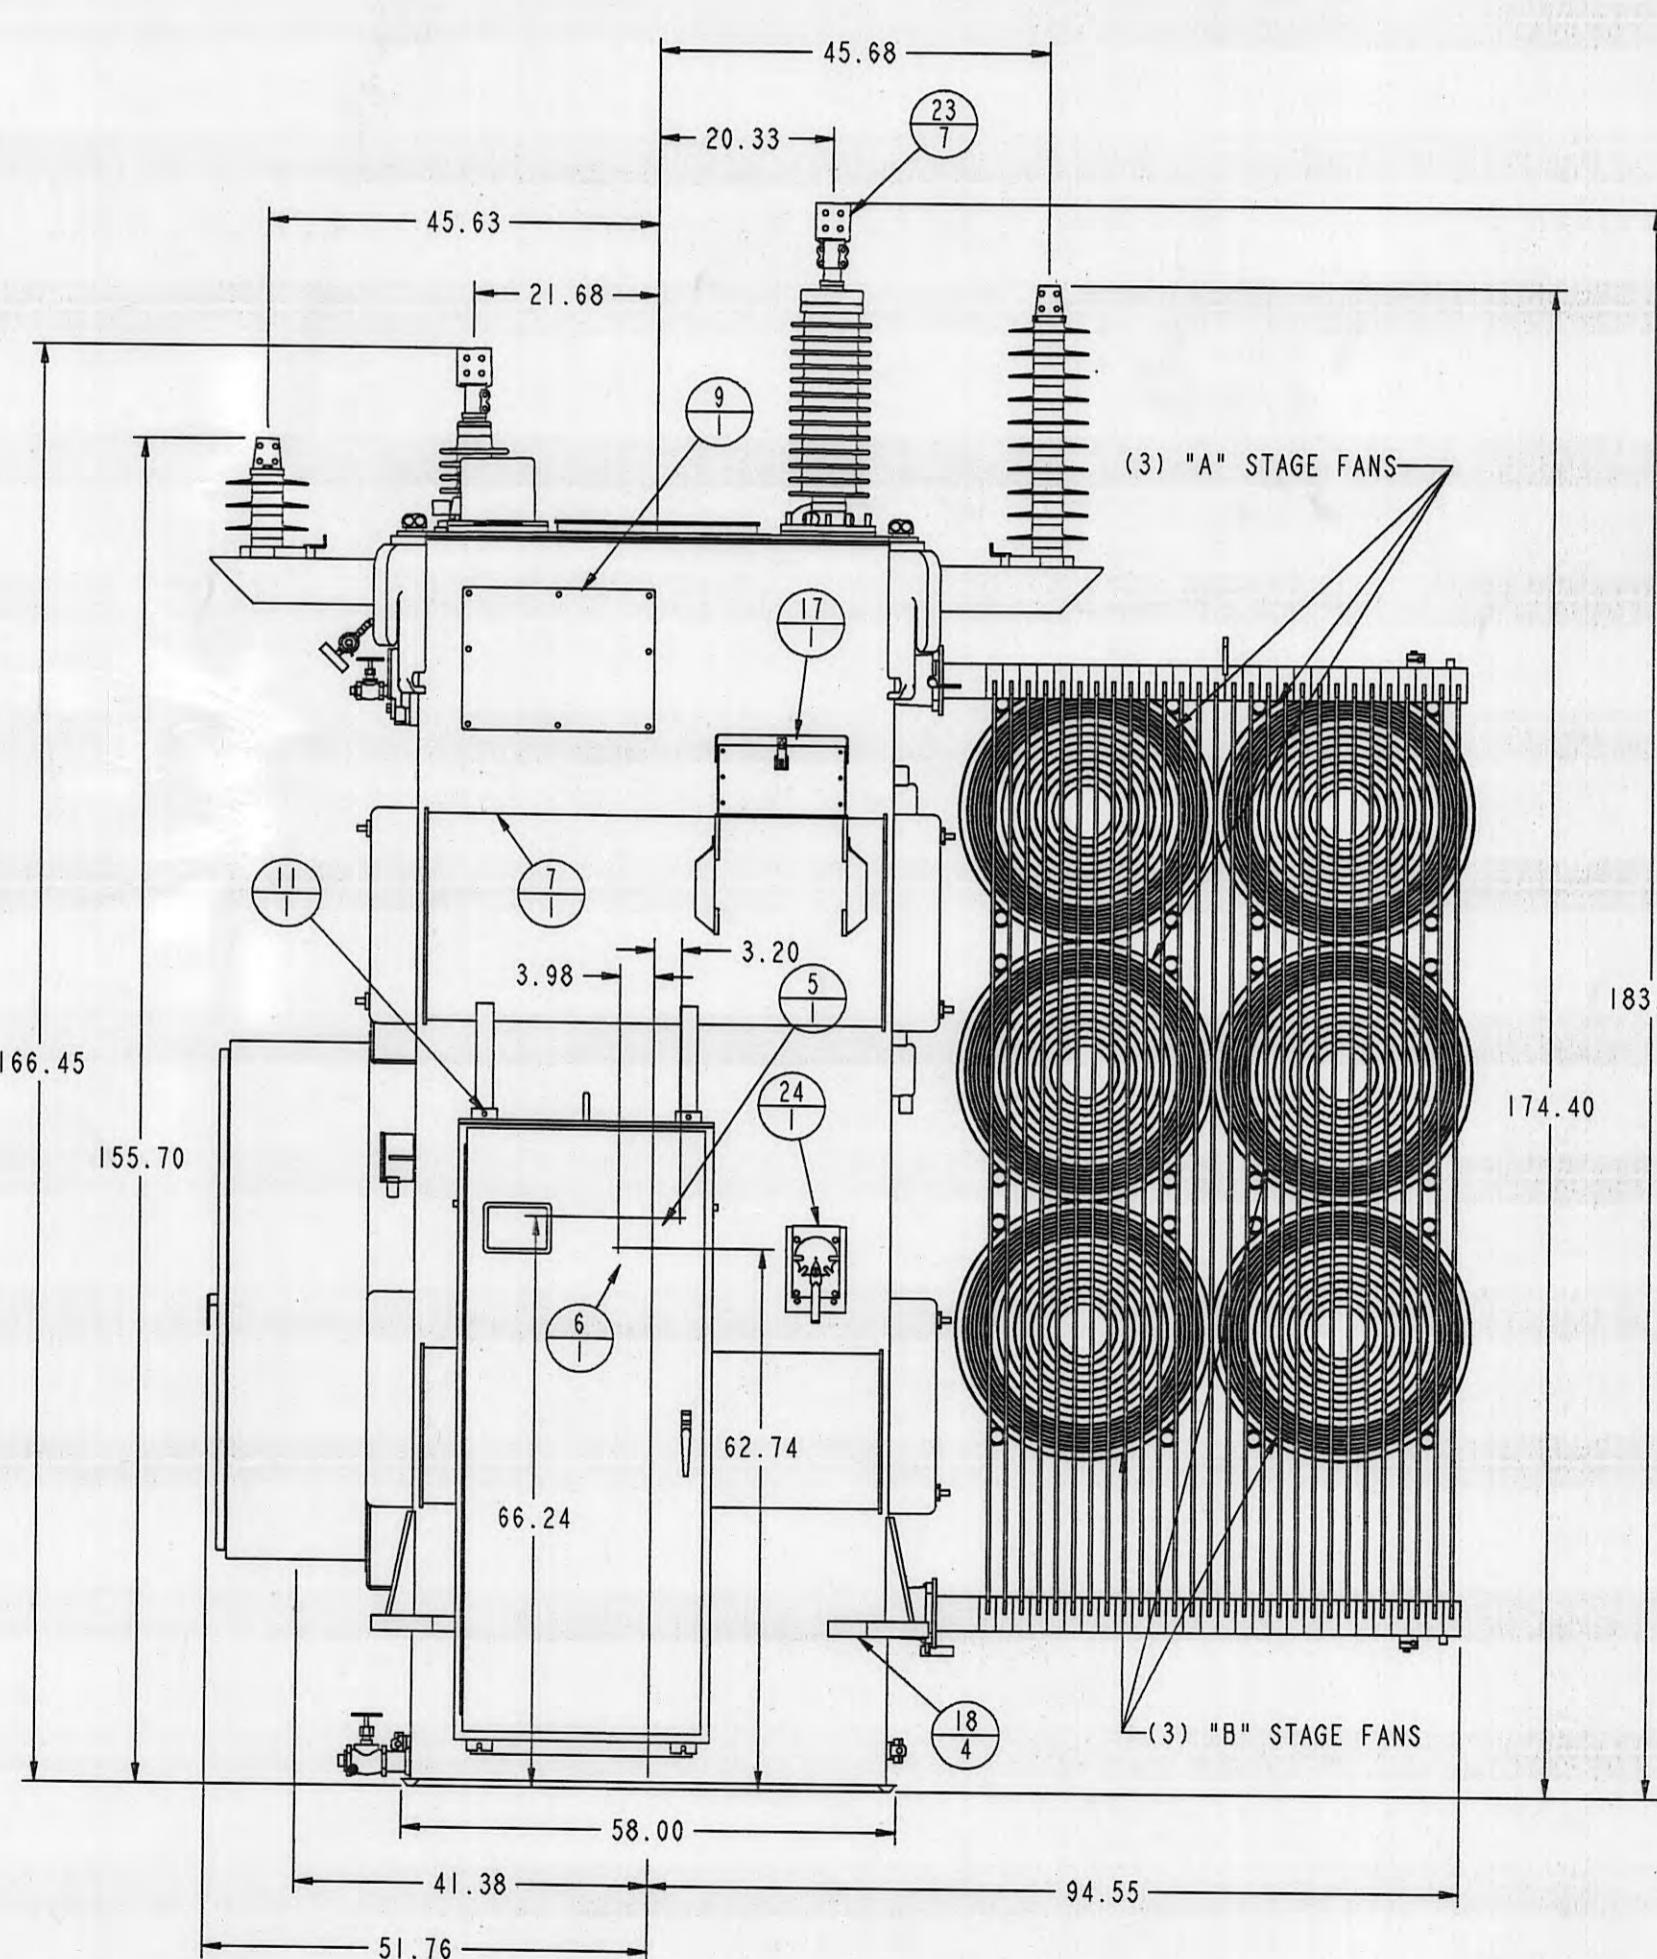

DRAWN JWF  
 DATE 22-OCT-97  
 APPROVED MBS

GS Waukesha Electric Systems  
 A UNIT OF GENERAL SIGNAL  
 P.O. BOX 268 GOLDSBORO, N.C. 27530

UNLESS OTHERWISE SPECIFIED  
 DIMENSIONS ARE IN INCHES

HARRIMAN UTILITY BOARD  
 PO# 12701 (A) & (B)  
 NEW HARRIMAN SUBSTATION  
 SERIAL/MFG. NO. GM971382 & GM971383

All information contained herein is confidential and the exclusive property of Waukesha Electric Systems, a division of General Signal Corporation. Recipient agrees: (1) not to divulge any of such information to others; (2) not to reproduce this document in whole or in part except as required for the internal evaluation of this proposal or for the resubmittal of this document to Waukesha Electric Systems; (3) not to copy or use such information in any manner as directed by Waukesha Electric Systems; (4) upon request to return all copies of this document to Waukesha Electric Systems. Copyright © 1996 Waukesha Electric Systems, a unit of General Signal Corporation.

OUTLINE  
 SIZE FSCM NO DWG NO  
 D P547436880

SCALE 0.045"=1.00"  
 SHEET 1 Of 1

TRANSFORMER																																																											
MVA	22.5	CLASS	OA	RISE	55 °C	COND HV	CU																																																				
MVA	30.0	CLASS	FA	RISE	55 °C	LV	CU																																																				
MVA	37.5	CLASS	FA	RISE	55 °C	PHASE	3																																																				
MVA	42.0	CLASS	FA	RISE	65 °C	MAX OPERATING PRESSURE 0.5 LBS. POS. 5.0 LBS. POS.																																																					
				TANK DESIGNED FOR 14.7 PSI VACUUM FILLING																																																							
				ALTITUDE	3300 FEET	ABOVE SEA LEVEL																																																					
SERIAL NO.				APPROXIMATE WEIGHTS POUNDS																																																							
5474368700				CORE AND COILS 50000																																																							
HV 68800 DELTA				TANK AND FITTINGS 26200																																																							
LV 13090 GRDY/7560				BIL	110 KV	2560 GALLONS OF OIL *	19200																																																				
IMPEDANCE % @ 22.5 MVA YEAR OF MFR				TOTAL WEIGHT WITHOUT OIL * 76200																																																							
LIQUID LEVEL 16.0 INCHES BELOW MANHOLE FLANGE AT 25°C				TOTAL WEIGHT WITH OIL * 95400																																																							
LIQUID LEVEL CHANGE 0.67 INCHES PER 10°C LIQUID TEMP.				UNTANKING (HEAVIEST PIECE) 50000																																																							
INSTR BOOK 9300				* INHIBITED OIL MEETS ASTM D3487 TYPE II NON-DETECTABLE LEVEL (LESS THAN 2 PPM) OF PCB PER FEDERAL REGISTER (44FR31514) MAY 31, 1979																																																							
<table border="1"> <thead> <tr> <th>HV</th> <th>TAP CHANGER POSITION</th> <th>VOLTAGE</th> <th>AMPS @ 22.5 MVA</th> <th>AMPS @ 30.0 MVA</th> <th>AMPS @ 37.5 MVA</th> <th>AMPS @ 42.0 MVA</th> <th></th> </tr> </thead> <tbody> <tr> <td rowspan="5">DE-ENERGIZE TRANSFORMER BEFORE CHANGING TAPS</td> <td>1</td> <td>72400</td> <td>179</td> <td>239</td> <td>299</td> <td>335</td> <td></td> </tr> <tr> <td>2</td> <td>70600</td> <td>184</td> <td>245</td> <td>307</td> <td>343</td> <td></td> </tr> <tr> <td>3</td> <td>68800</td> <td>189</td> <td>252</td> <td>315</td> <td>352</td> <td></td> </tr> <tr> <td>4</td> <td>67000</td> <td>194</td> <td>259</td> <td>323</td> <td>362</td> <td></td> </tr> <tr> <td>5</td> <td>65200</td> <td>199</td> <td>266</td> <td>332</td> <td>372</td> <td></td> </tr> <tr> <td>LV</td> <td>ANY</td> <td>13090</td> <td>992</td> <td>1323</td> <td>1654</td> <td>1852</td> <td></td> </tr> </tbody> </table>								HV	TAP CHANGER POSITION	VOLTAGE	AMPS @ 22.5 MVA	AMPS @ 30.0 MVA	AMPS @ 37.5 MVA	AMPS @ 42.0 MVA		DE-ENERGIZE TRANSFORMER BEFORE CHANGING TAPS	1	72400	179	239	299	335		2	70600	184	245	307	343		3	68800	189	252	315	352		4	67000	194	259	323	362		5	65200	199	266	332	372		LV	ANY	13090	992	1323	1654	1852	
HV	TAP CHANGER POSITION	VOLTAGE	AMPS @ 22.5 MVA	AMPS @ 30.0 MVA	AMPS @ 37.5 MVA	AMPS @ 42.0 MVA																																																					
DE-ENERGIZE TRANSFORMER BEFORE CHANGING TAPS	1	72400	179	239	299	335																																																					
	2	70600	184	245	307	343																																																					
	3	68800	189	252	315	352																																																					
	4	67000	194	259	323	362																																																					
	5	65200	199	266	332	372																																																					
LV	ANY	13090	992	1323	1654	1852																																																					
<table border="1"> <thead> <tr> <th colspan="4">BUSHING CURRENT TRANSFORMER MULTI-RATIO ACC. CLASS C400 H1-H2-H3 - TOP AND BOTTOM DESIGN 7617982T00</th> </tr> </thead> <tbody> <tr> <td>CURRENT RATIO</td> <td>TAP</td> <td>CURRENT RATIO</td> <td>TAP</td> </tr> <tr> <td>50:5</td> <td>X2-X3</td> <td>300:5</td> <td>X2-X4</td> </tr> <tr> <td>100:5</td> <td>X1-X2</td> <td>400:5</td> <td>X1-X4</td> </tr> <tr> <td>150:5</td> <td>X1-X3</td> <td>450:5</td> <td>X3-X5</td> </tr> <tr> <td>200:5</td> <td>X4-X5</td> <td>500:5</td> <td>X2-X5</td> </tr> <tr> <td>250:5</td> <td>X3-X4</td> <td>600:5</td> <td>X1-X5</td> </tr> </tbody> </table>								BUSHING CURRENT TRANSFORMER MULTI-RATIO ACC. CLASS C400 H1-H2-H3 - TOP AND BOTTOM DESIGN 7617982T00				CURRENT RATIO	TAP	CURRENT RATIO	TAP	50:5	X2-X3	300:5	X2-X4	100:5	X1-X2	400:5	X1-X4	150:5	X1-X3	450:5	X3-X5	200:5	X4-X5	500:5	X2-X5	250:5	X3-X4	600:5	X1-X5																								
BUSHING CURRENT TRANSFORMER MULTI-RATIO ACC. CLASS C400 H1-H2-H3 - TOP AND BOTTOM DESIGN 7617982T00																																																											
CURRENT RATIO	TAP	CURRENT RATIO	TAP																																																								
50:5	X2-X3	300:5	X2-X4																																																								
100:5	X1-X2	400:5	X1-X4																																																								
150:5	X1-X3	450:5	X3-X5																																																								
200:5	X4-X5	500:5	X2-X5																																																								
250:5	X3-X4	600:5	X1-X5																																																								
<table border="1"> <thead> <tr> <th colspan="4">BUSHING CURRENT TRANSFORMER MULTI-RATIO ACC. CLASS C800 X1-X2-X3 - TOP DESIGN 7617983T00</th> </tr> </thead> <tbody> <tr> <td>CURRENT RATIO</td> <td>TAP</td> <td>CURRENT RATIO</td> <td>TAP</td> </tr> <tr> <td>300:5</td> <td>X3-X4</td> <td>1200:5</td> <td>X1-X3</td> </tr> <tr> <td>400:5</td> <td>X1-X2</td> <td>1500:5</td> <td>X1-X4</td> </tr> <tr> <td>500:5</td> <td>X4-X5</td> <td>1600:5</td> <td>X2-X5</td> </tr> <tr> <td>800:5</td> <td>X2-X3</td> <td>2000:5</td> <td>X1-X5</td> </tr> <tr> <td>1100:5</td> <td>X2-X4</td> <td></td> <td></td> </tr> </tbody> </table>								BUSHING CURRENT TRANSFORMER MULTI-RATIO ACC. CLASS C800 X1-X2-X3 - TOP DESIGN 7617983T00				CURRENT RATIO	TAP	CURRENT RATIO	TAP	300:5	X3-X4	1200:5	X1-X3	400:5	X1-X2	1500:5	X1-X4	500:5	X4-X5	1600:5	X2-X5	800:5	X2-X3	2000:5	X1-X5	1100:5	X2-X4																										
BUSHING CURRENT TRANSFORMER MULTI-RATIO ACC. CLASS C800 X1-X2-X3 - TOP DESIGN 7617983T00																																																											
CURRENT RATIO	TAP	CURRENT RATIO	TAP																																																								
300:5	X3-X4	1200:5	X1-X3																																																								
400:5	X1-X2	1500:5	X1-X4																																																								
500:5	X4-X5	1600:5	X2-X5																																																								
800:5	X2-X3	2000:5	X1-X5																																																								
1100:5	X2-X4																																																										
<table border="1"> <thead> <tr> <th colspan="4">BUSHING CURRENT TRANSFORMER MULTI-RATIO ACC. CLASS C400 X0 - TOP DESIGN 7617984T00</th> </tr> </thead> <tbody> <tr> <td>CURRENT RATIO</td> <td>TAP</td> <td>CURRENT RATIO</td> <td>TAP</td> </tr> <tr> <td>50:5</td> <td>X2-X3</td> <td>300:5</td> <td>X2-X4</td> </tr> <tr> <td>100:5</td> <td>X1-X2</td> <td>400:5</td> <td>X1-X4</td> </tr> <tr> <td>150:5</td> <td>X1-X3</td> <td>450:5</td> <td>X3-X5</td> </tr> <tr> <td>200:5</td> <td>X4-X5</td> <td>500:5</td> <td>X2-X5</td> </tr> <tr> <td>250:5</td> <td>X3-X4</td> <td>600:5</td> <td>X1-X5</td> </tr> </tbody> </table>								BUSHING CURRENT TRANSFORMER MULTI-RATIO ACC. CLASS C400 X0 - TOP DESIGN 7617984T00				CURRENT RATIO	TAP	CURRENT RATIO	TAP	50:5	X2-X3	300:5	X2-X4	100:5	X1-X2	400:5	X1-X4	150:5	X1-X3	450:5	X3-X5	200:5	X4-X5	500:5	X2-X5	250:5	X3-X4	600:5	X1-X5																								
BUSHING CURRENT TRANSFORMER MULTI-RATIO ACC. CLASS C400 X0 - TOP DESIGN 7617984T00																																																											
CURRENT RATIO	TAP	CURRENT RATIO	TAP																																																								
50:5	X2-X3	300:5	X2-X4																																																								
100:5	X1-X2	400:5	X1-X4																																																								
150:5	X1-X3	450:5	X3-X5																																																								
200:5	X4-X5	500:5	X2-X5																																																								
250:5	X3-X4	600:5	X1-X5																																																								
<table border="1"> <thead> <tr> <th colspan="4">BUSHING CURRENT TRANSFORMER MULTI-RATIO ACC. CLASS C50 FOR WINDING TEMP. INDICATOR LOCATED ON X2 BUSHING RATIO 2400:5 CONN (X2-X4) 2200:5 DESIGN 7613756T00</th> </tr> </thead> <tbody> <tr> <td>X1</td> <td>X0</td> <td>X2</td> <td>X3</td> </tr> </tbody> </table>								BUSHING CURRENT TRANSFORMER MULTI-RATIO ACC. CLASS C50 FOR WINDING TEMP. INDICATOR LOCATED ON X2 BUSHING RATIO 2400:5 CONN (X2-X4) 2200:5 DESIGN 7613756T00				X1	X0	X2	X3																																												
BUSHING CURRENT TRANSFORMER MULTI-RATIO ACC. CLASS C50 FOR WINDING TEMP. INDICATOR LOCATED ON X2 BUSHING RATIO 2400:5 CONN (X2-X4) 2200:5 DESIGN 7613756T00																																																											
X1	X0	X2	X3																																																								
<p>GS WAUKESHA ELECTRIC SYSTEMS A UNIT OF GENERAL SIGNAL P.O. BOX 268 GOLDSBORO, N.C. 27533</p>																																																											

REVISIONS		
ZONE	REV	DESCRIPTION
		DATE APPROVED

MATERIAL: 12.25 X 10.00 STAINLESS STEEL USS. STD. GA. NO. 22 (.0299)  
MTG. HOLES: 11.75 X 9.5 C TO C 4-5/32 DIA HOLES  
LETTERING AND NUMERALS SUNKEN BLACK ON A POLISHED  
STAINLESS STEEL BACKGROUND  
PAINT: SPRAYED BLACK ENAMEL  
PADS: ALL RAISED PADS ARE 7/32 WIDE AND LENGTH SHOWN

NOTE:  
THE DESIGN IMPEDANCE IS:

7.0 @ 22.5 MVA

THE SERIAL NUMBER, YEAR OF MANUFACTURE,  
AND MEASURED IMPEDANCE OF EACH UNIT  
OF THIS DESIGN WILL BE STAMPED ON ITS  
NAMEPLATE PRIOR TO SHIPMENT.

### Harriman Utility Board

Approved *Roddy Blewitt*

Date 11-19-97

HARRIMAN UTILITY BOARD  
PO# 12701 (A) & (B)  
NEW HARRIMAN SUBSTATION  
SERIAL/MFG. NO. GM971382 & GM971383

DRAWN	RDN	GS	WAUKESHA ELECTRIC SYSTEMS	
DATE	10/22/97		A UNIT OF GENERAL SIGNAL	
APPROVED	MBS		P.O. BOX 268 GOLDSBORO NC 27533	
UNLESS OTHERWISE SPECIFIED DIMENSIONS ARE IN INCHES		TRANSFORMER NAMEPLATE DRAWING		
		SIZE C	FSCM NO	DWG NO A547436890
		SCALE 1:0		SHEET

All information contained herein is confidential and the exclusive property of Waukesha Electric Systems, a division of General Signal Corporation. Recipient agrees (1) not to disclose such information to others; (2) not to reproduce this document in whole or in part except as authorized by the sender; (3) to return this document or its submission of this document to Waukesha Electric Systems; (4) to use such information only as directed by Waukesha Electric Systems; and (5) upon request, to return all copies of this document to General Signal Corporation.

Copyright © 1989, Waukesha Electric Systems, a division of General Signal Corporation.

8

7

6

5

4

3

2


1

## NOTES:

- 1- CONTROL WIRE #14 AWG, 600V, 90°C, TYPE SIS (W-W)
- 2- BCT WIRE #10 AWG, 600V, 90°C, TYPE SIS (W-W)
- 3- POWER WIRING TO ALL CIRCUIT BREAKERS #8 AWG, 600V, 90°C, TYPE SIS (W-W)
- 4- WIRING TO HEATER TERMINALS #12 AWG, 600V, 150°C, TYPE FEP TEFLO
- 5- CONTROL TERMINAL BLOCKS 30 AMP, 600V, MARATHON SERIES 300.
- 6- BCT TERMINAL BLOCKS 30 AMP, 600V, MARATHON SERIES 600SC.
- 7- POWER TERMINALS 175 AMP, 600V, MARATHON SERIES 140.
- 8- BCT TEST BLOCKS 10 AMP, 250V, 4 POLE, GENERAL ELECTRIC TYPE PK-2.
- 9- LABEL ALL TERMINAL WIRES PER "OPPOSITE END" DESIGNATION.
- 10- ALL LUGS ARE NON-INSULATED, AMP SOLISTRAND, RING-TYPE CRIMP #10-12 AWG LUGS, & BUTT SPLICES, WITH AMP #49935-Y TOOL. CRIMP #8 AWG LUGS, & BUTT SPLICES, WITH AMP #69355 TOOL.


REVISIONS

ZONE	REV	DESCRIPTION	DATE	AF

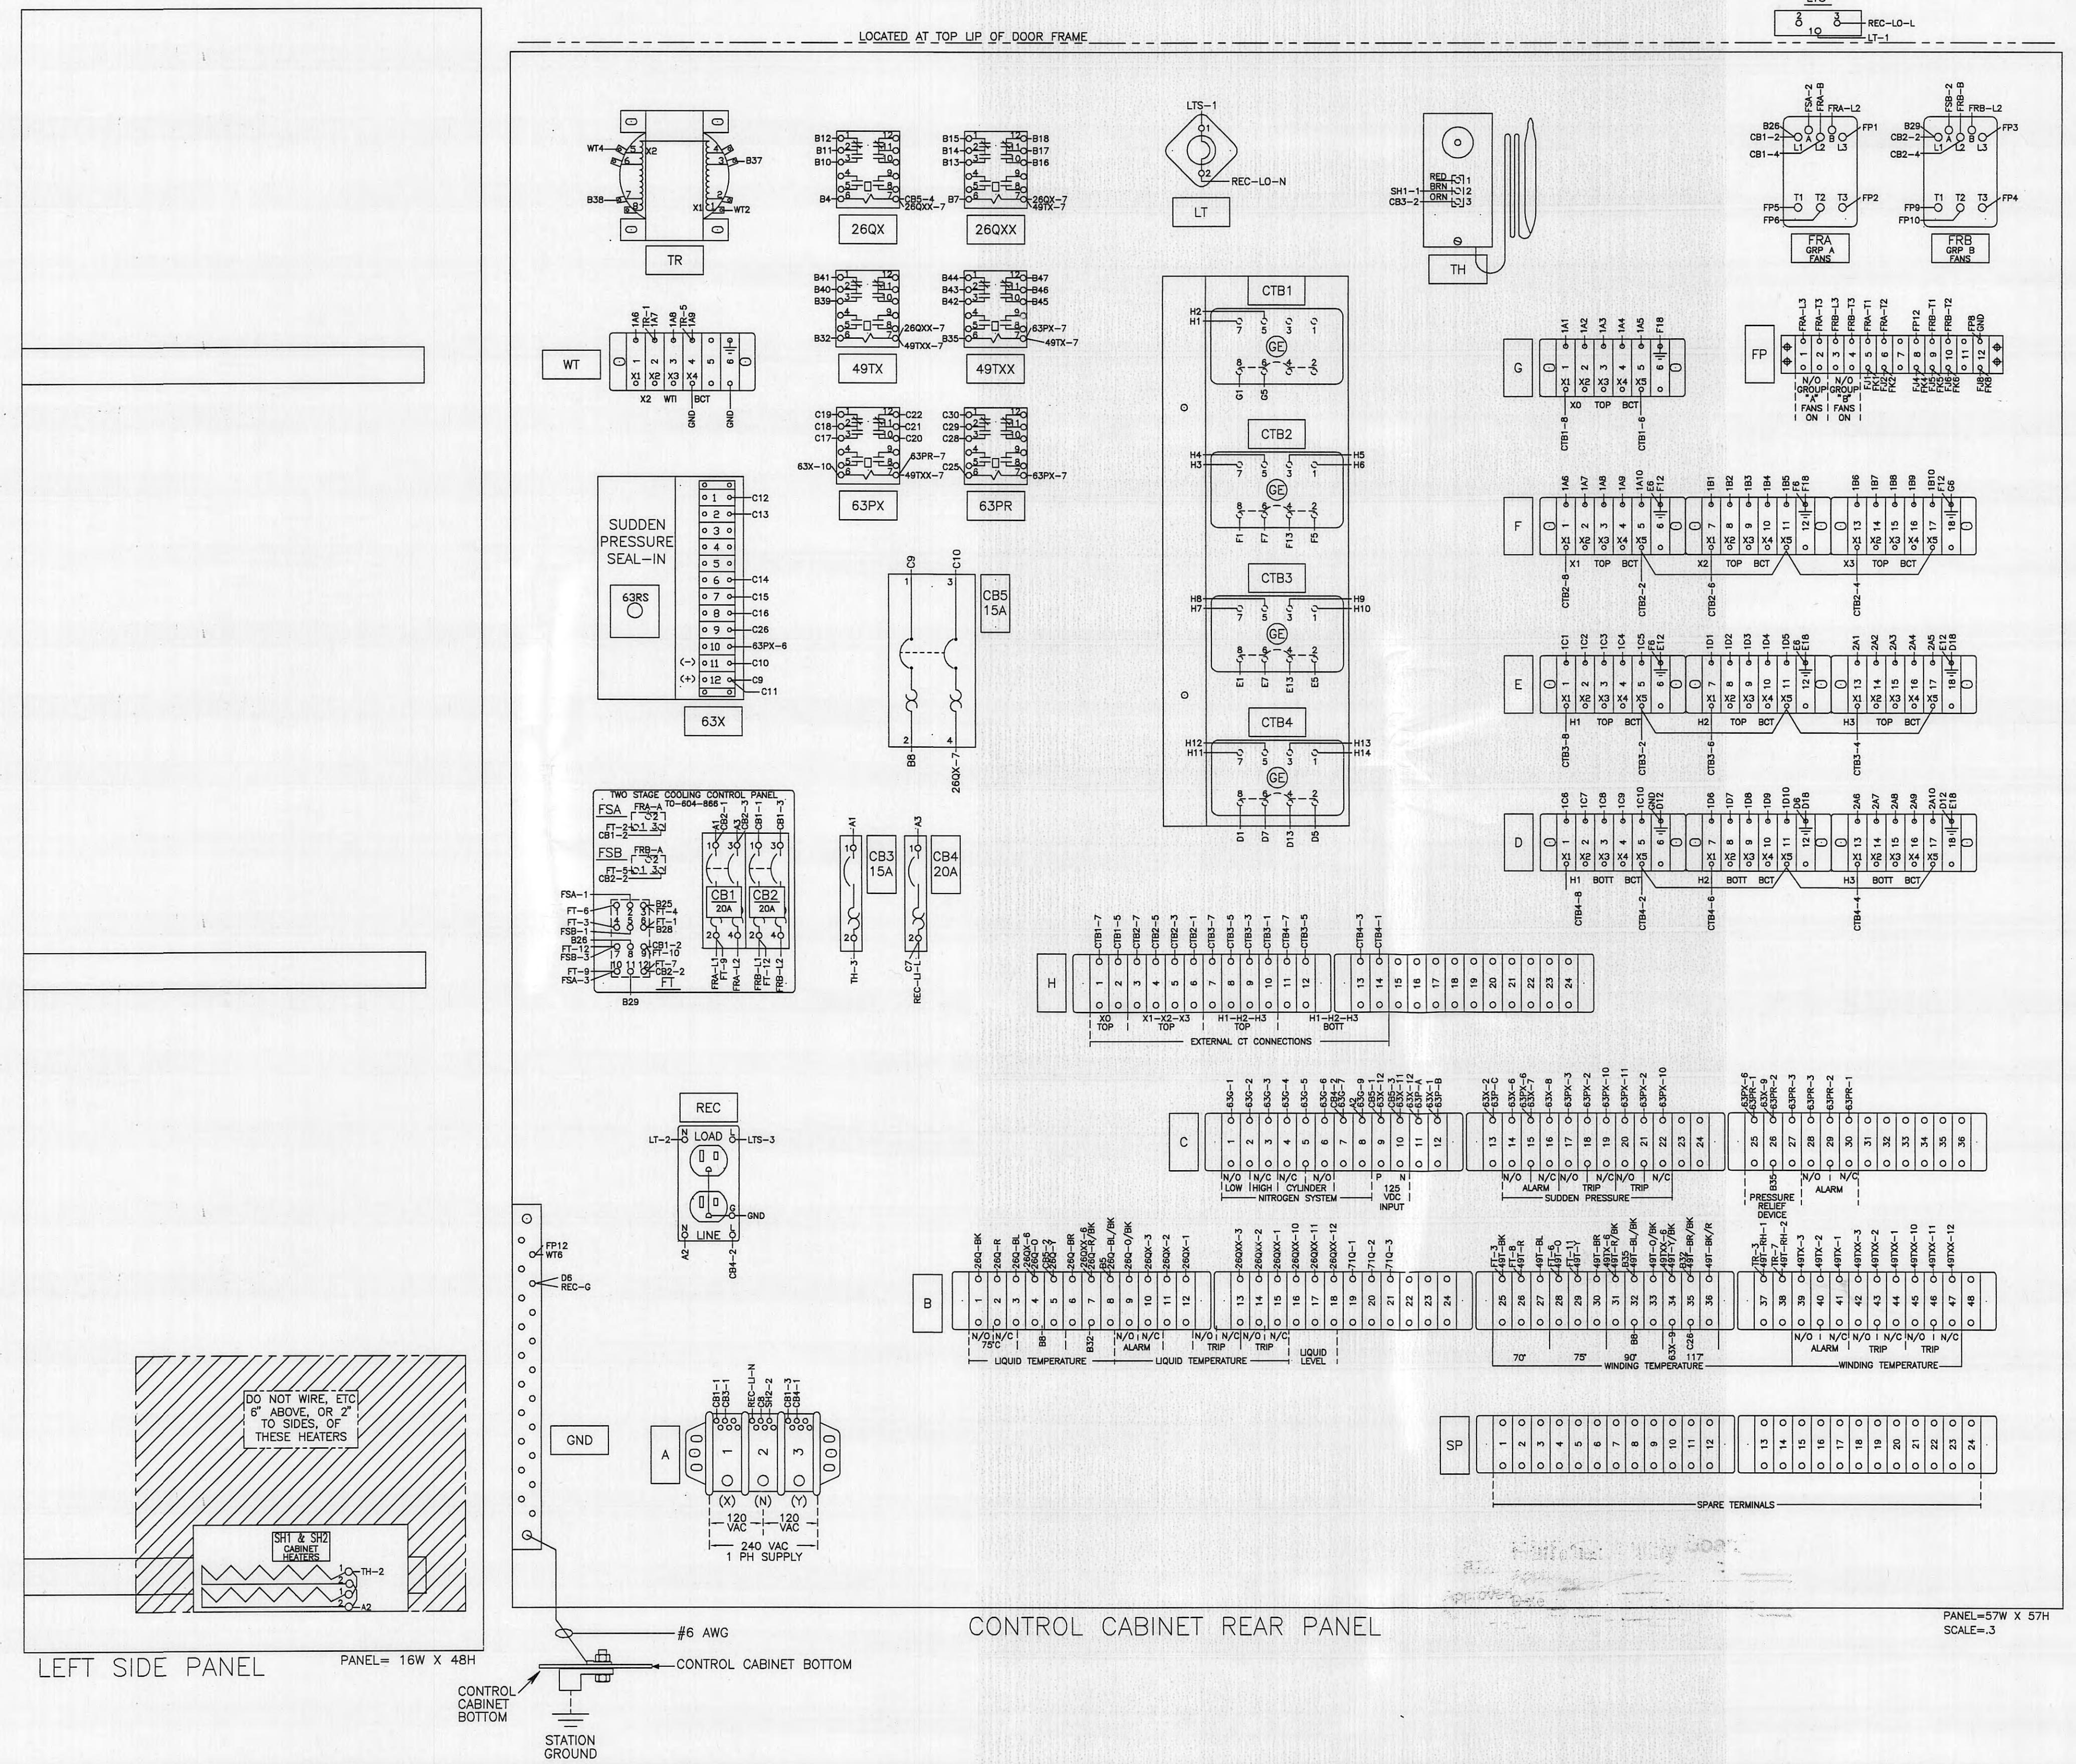



REVISIONS		ZONE	REV	DESCRIPTION	DATE	APPROVED
1						

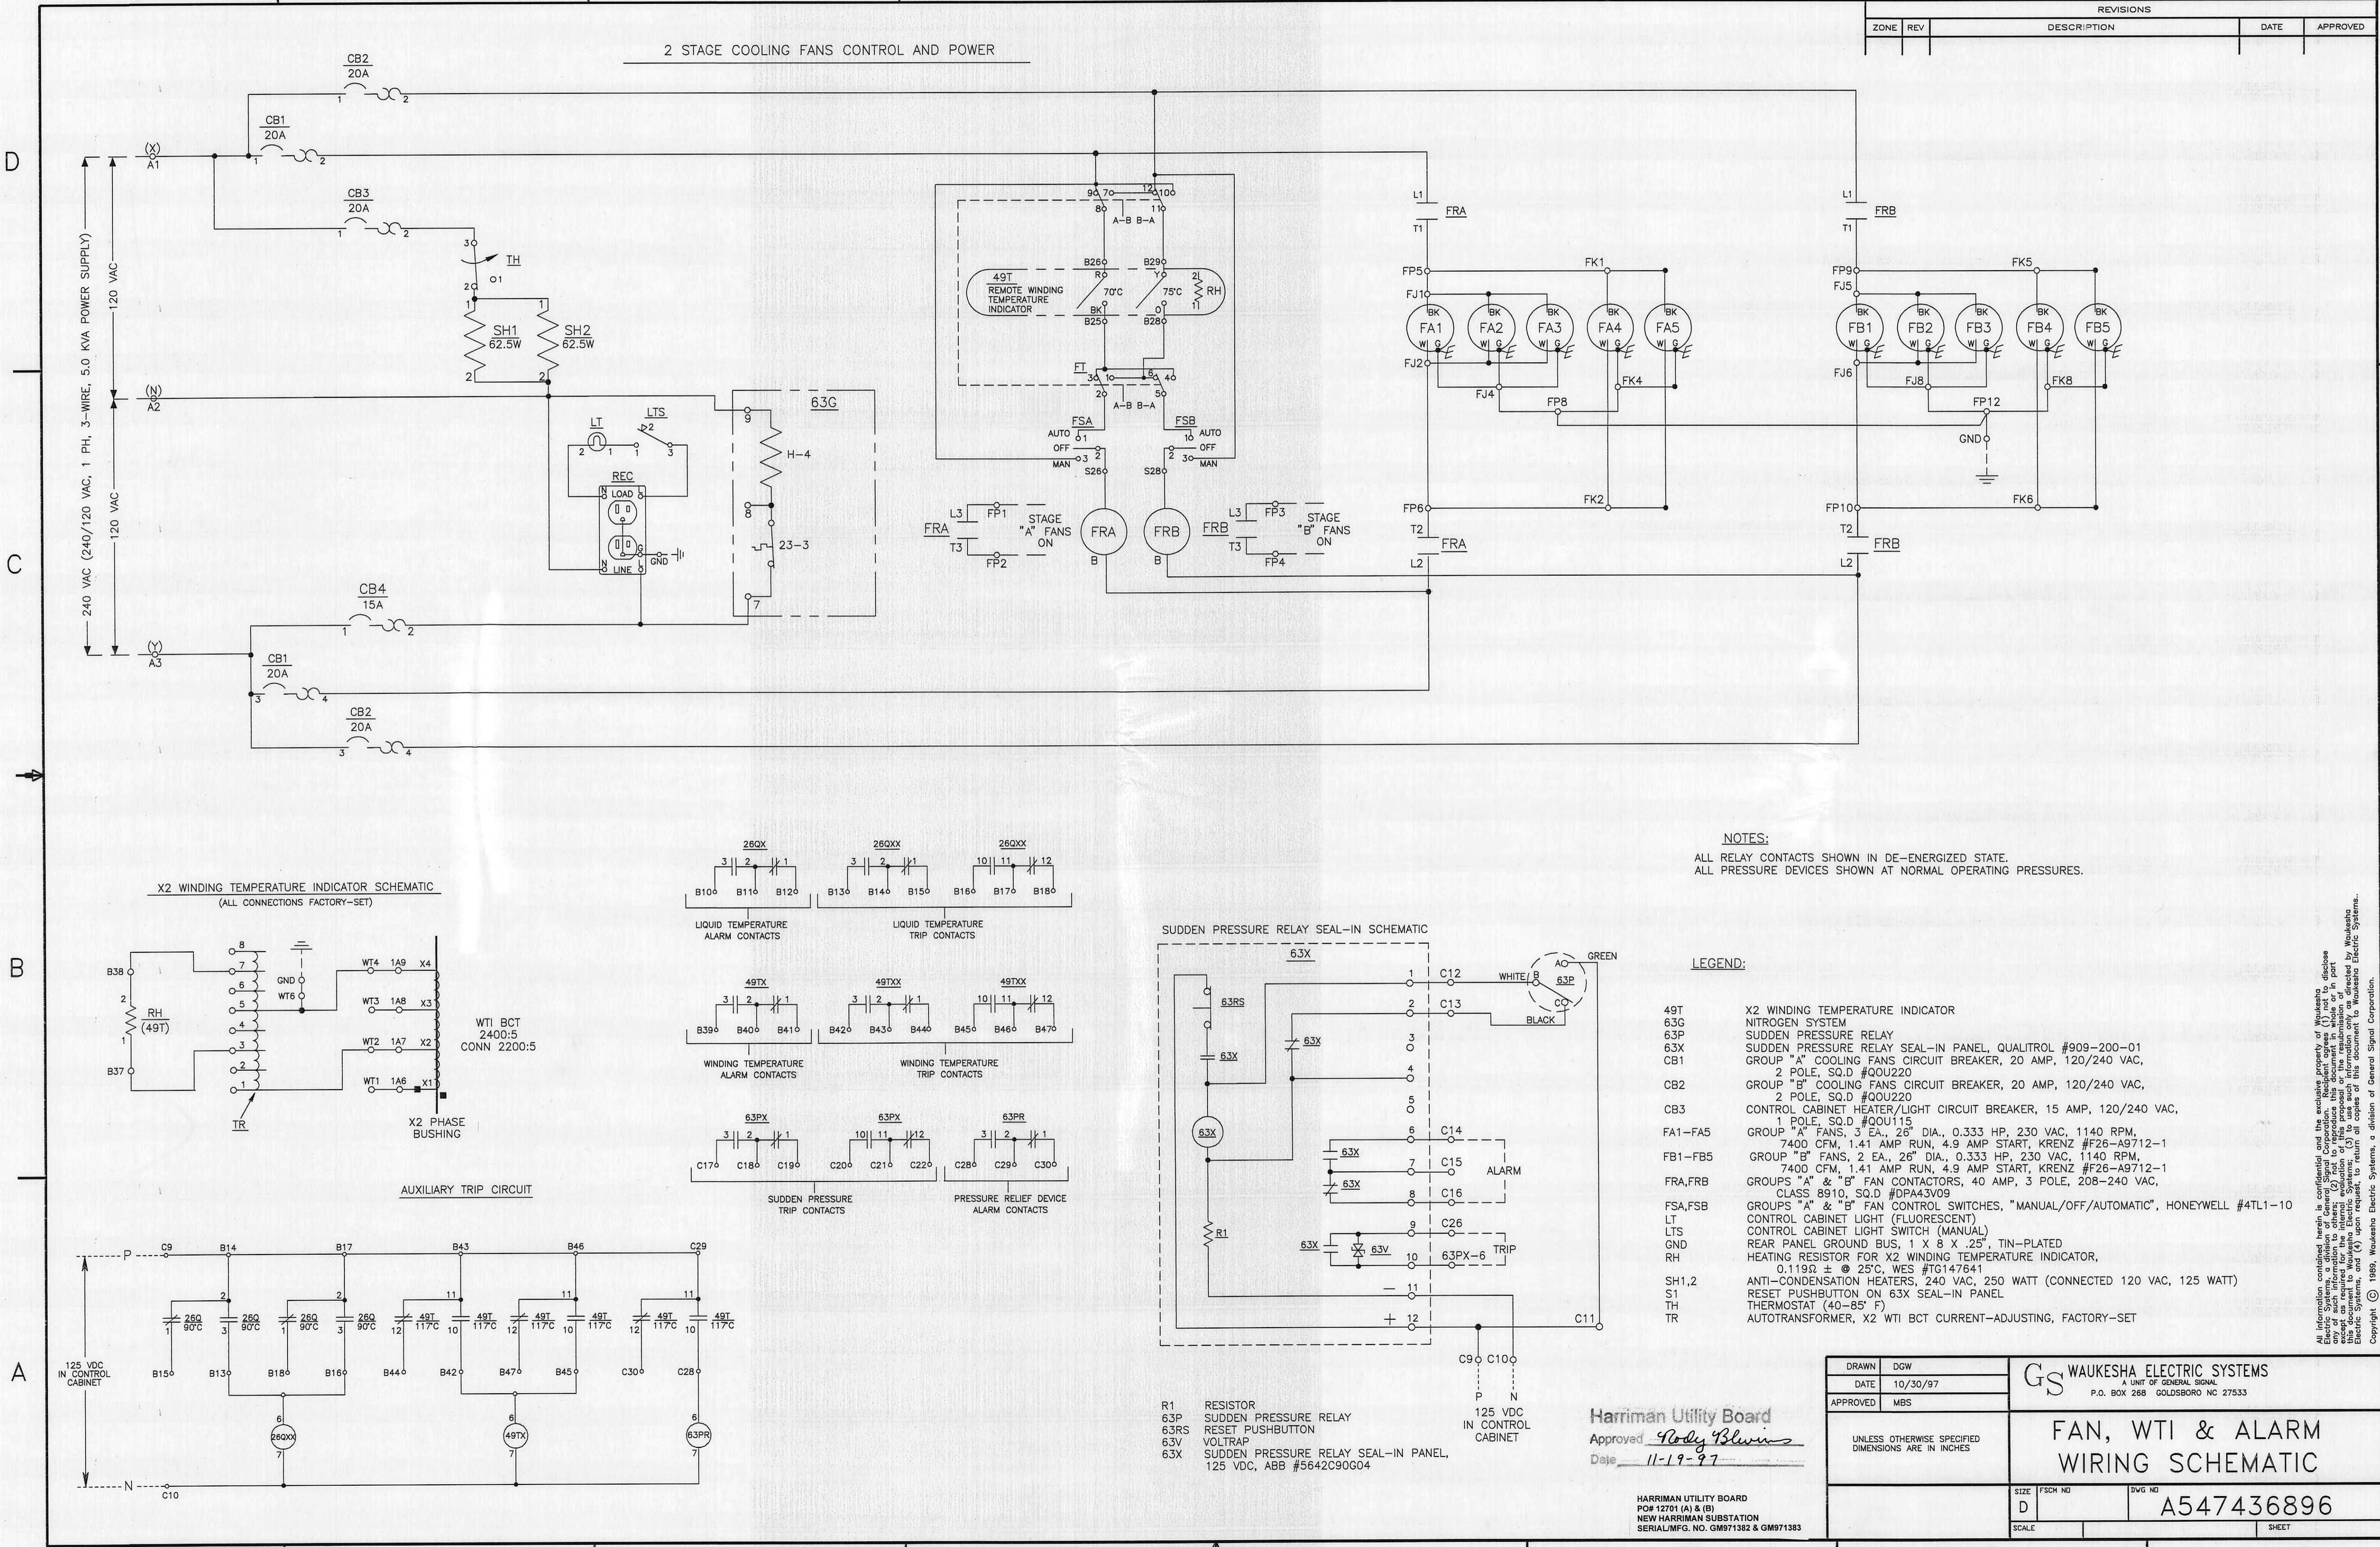


It#	Qty	Description
1	1	1 in. upper filter press valve w/pipe plug.
2	1	1 inch vacuum flange with pipe plug in top cover
3	1	2 in. filter press/drain valve w/.375 sampler and plug.
4	2	Bolted manhole (20 inch opening) with gasket in groove with mechanical stops.
5	2	Center of gravity (assembled).
6	2	Center of gravity (shipping).
7	1	Channel bracing members.
8	1	Control box w/padlock provisions and removable gasketed bottom plate
9	1	CT junction box.
10	1	Dial type liquid temperature indicator.
11	1	Enclosed inert gas system for oil preservation.
12	1	Fault pressure relay - ABB 4432A95G02
13	1	Flat base w/beveled edges for sliding both directions.
14	7	Ground clamp connector for 1/0 solid to 500 MCM copper cable.
15	8	Ground clamp connector for 4/0 solid to 500 MCM copper cable.
16	2	Grounding connector for #1/0 to 500 MCM copper cable.
17	1	Impact recorder (3 axis) mounted in removable enclosure.
18	4	Jacking plate with pulling provisions.
19	6	Lightning arrester mtg bkt. (3-.56in holes on 10 in bc).
20	1	Liquid level gauge.
21	4	Main cover lifting lug.
22	9	NEMA 2 hole s/stl ground pads.
23	7	NEMA 4 hole bronze tinned bushing spade connector for 1.5 in. stud.
24	1	No-load tap changer w/position indicator and padlock provisions.
25	1	Pressure relief device.
26	1	Pressure vacuum gauge with bleeder device.
27	2	Removable radiators w/shutoff valves, vent and drain (Left).
28	4	Removable radiators w/shutoff valves, vent and drain (Rear).
29	1	Stainless steel BCT and power nameplate.
30	4	Unit lifting lug (with chamfered edges) for lifting entire unit
31	1	Well for liquid temperature indicator probe
32	1	Well for winding temperature indicator probe
33	1	Winding temperature indicator.

TRANSFORMER EQUIPPED WITH INERT GAS SYSTEM FOR CONSTANT OIL PRESERVATION INCLUDING:  
 (A) PRESSURE VACUUM SWITCH  
 (B) GAS SAMPLING VALVE WITH HOSE BARB FITTING FOR .25" I.D. HOSE  
 (C) PRESSURE VACUUM GAUGE  
 (D) CYLINDER PRESSURE GAUGE WITH LOW PRESSURE ALARM  
 (E) PADLOCKABLE HINGED DOOR  
 (F) 220 CU. FT NITROGEN CYLINDERS  
 (G) CABINET IS DESIGNED WITH SPACE FOR TWO NITROGEN BOTTLES

ADDITIONAL DRAWING INFORMATION:  
 SEE LAPP DRAWING B88023-70 FOR COMPLETE HV BUSHING INFORMATION  
 SEE LAPP DRAWING B89123-70 FOR COMPLETE LV BUSHING INFORMATION  
 SEE LAPP DRAWING B89123-70 FOR COMPLETE NEUTRAL BUSHING INFORMATION  
 SEE OHIO BRASS DRAWING S007438-00 FOR COMPLETE HV ARRESTER INFORMATION  
 SEE OHIO BRASS DRAWING S007433-00 FOR COMPLETE LV ARRESTER INFORMATION  
 SEE WES DRAWING A547436890 FOR COMPLETE NAMEPLATE INFORMATION



#### NOTES -

- (1)- EXTERIOR TANK FINISH ANSI #70 LIGHT GRAY.
- (2)- SEALED TANK CONSTRUCTION WITH WELDED MAIN TOP COVER.
- (3)- ALL EXTERNAL CONTROL WIRING ROUTED THROUGH RIGID METAL CONDUIT EXCEPT FOR SHORT RUNS OF FLEXIBLE LIQUID TIGHT CONDUIT TO GAUGES AND FANS.
- (4)- TANK AND FITTINGS DESIGNED FOR VACUUM FILLING IN THE FIELD.
- (5)- ALL EXTERNAL REMOVABLE AND/OR UN-PAINTED HARDWARE CORROSION RESISTANT.
- (6)- TRANSFORMER DESIGNED FOR TRUCK SHIPMENT.
- (7)- TRANSFORMER SHIPPED FILLED WITH OIL.
- (8)- SEE CONTROL WIRING FOR ALL ALARM CONTACT INFORMATION.
- (9)- FANS - 26"-1/3 HP-230V-1 PH-60 HZ-1140 RPM-7400 CFM.  
 STAGE "A" REAR - (3) FANS  
 STAGE "B" REAR - (3) FANS  
 STAGE "A" END - (2) FANS  
 STAGE "B" END - (2) FANS

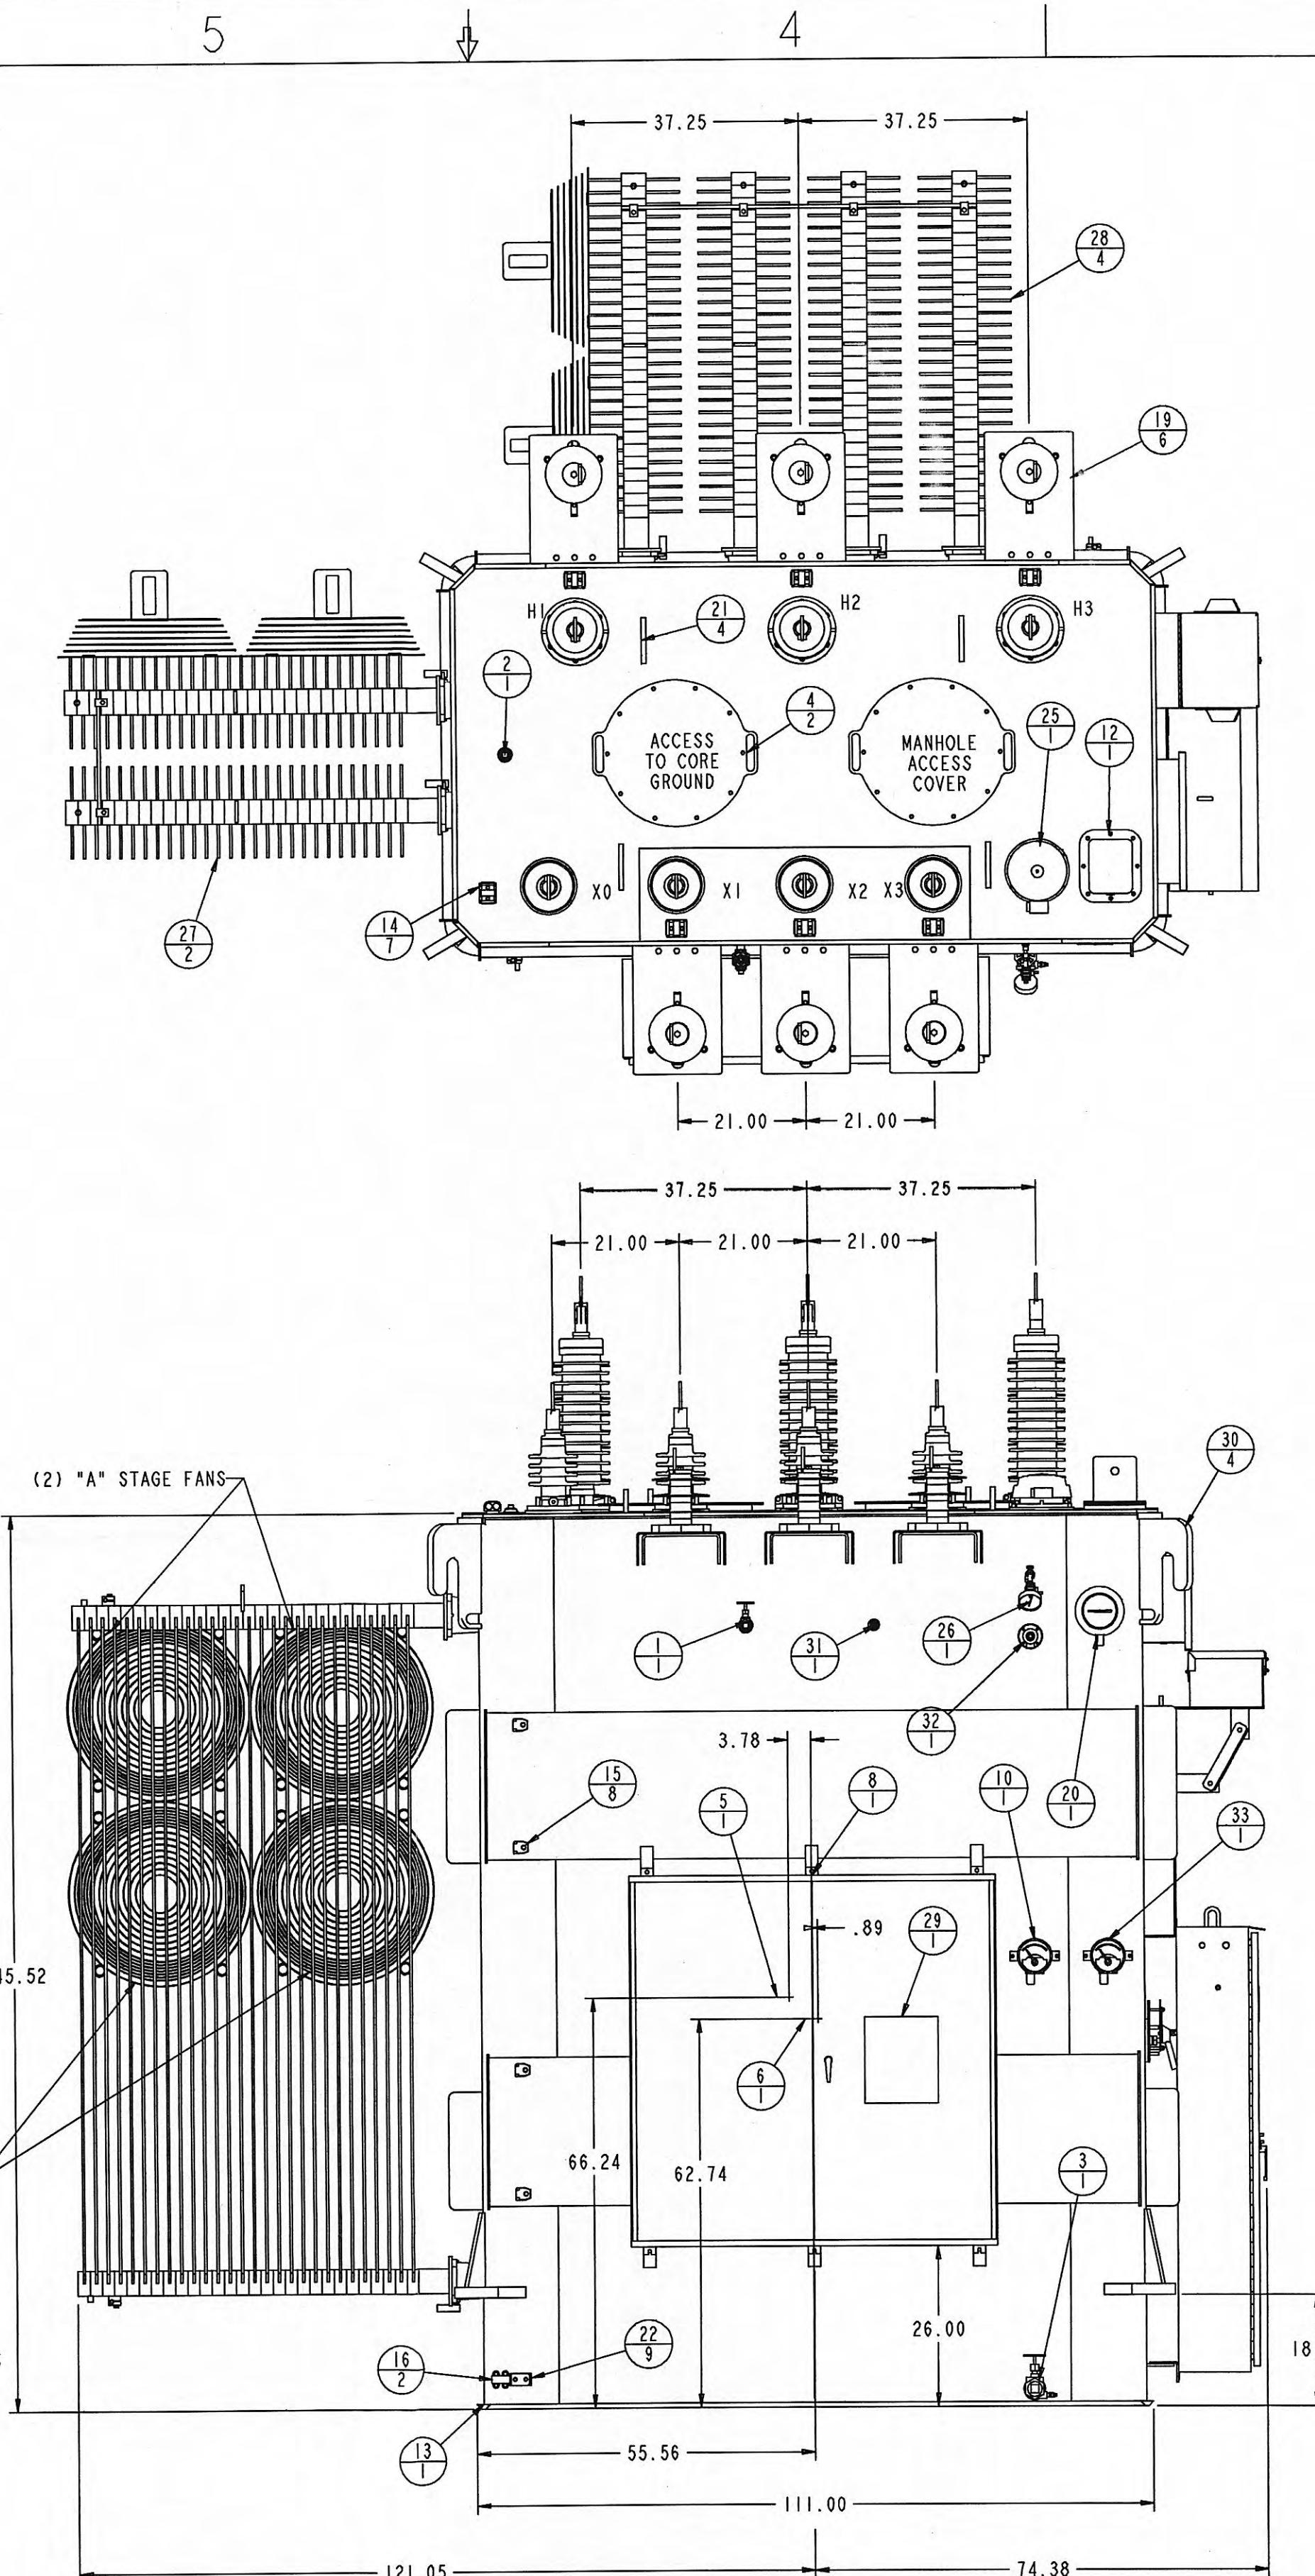


## H.U.B. WATER PLANT


MARGRAVE ST.

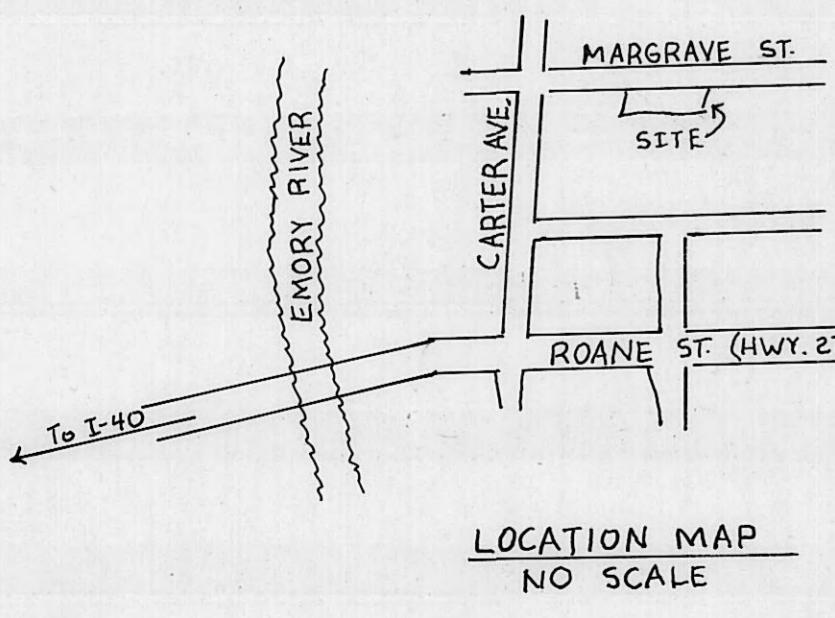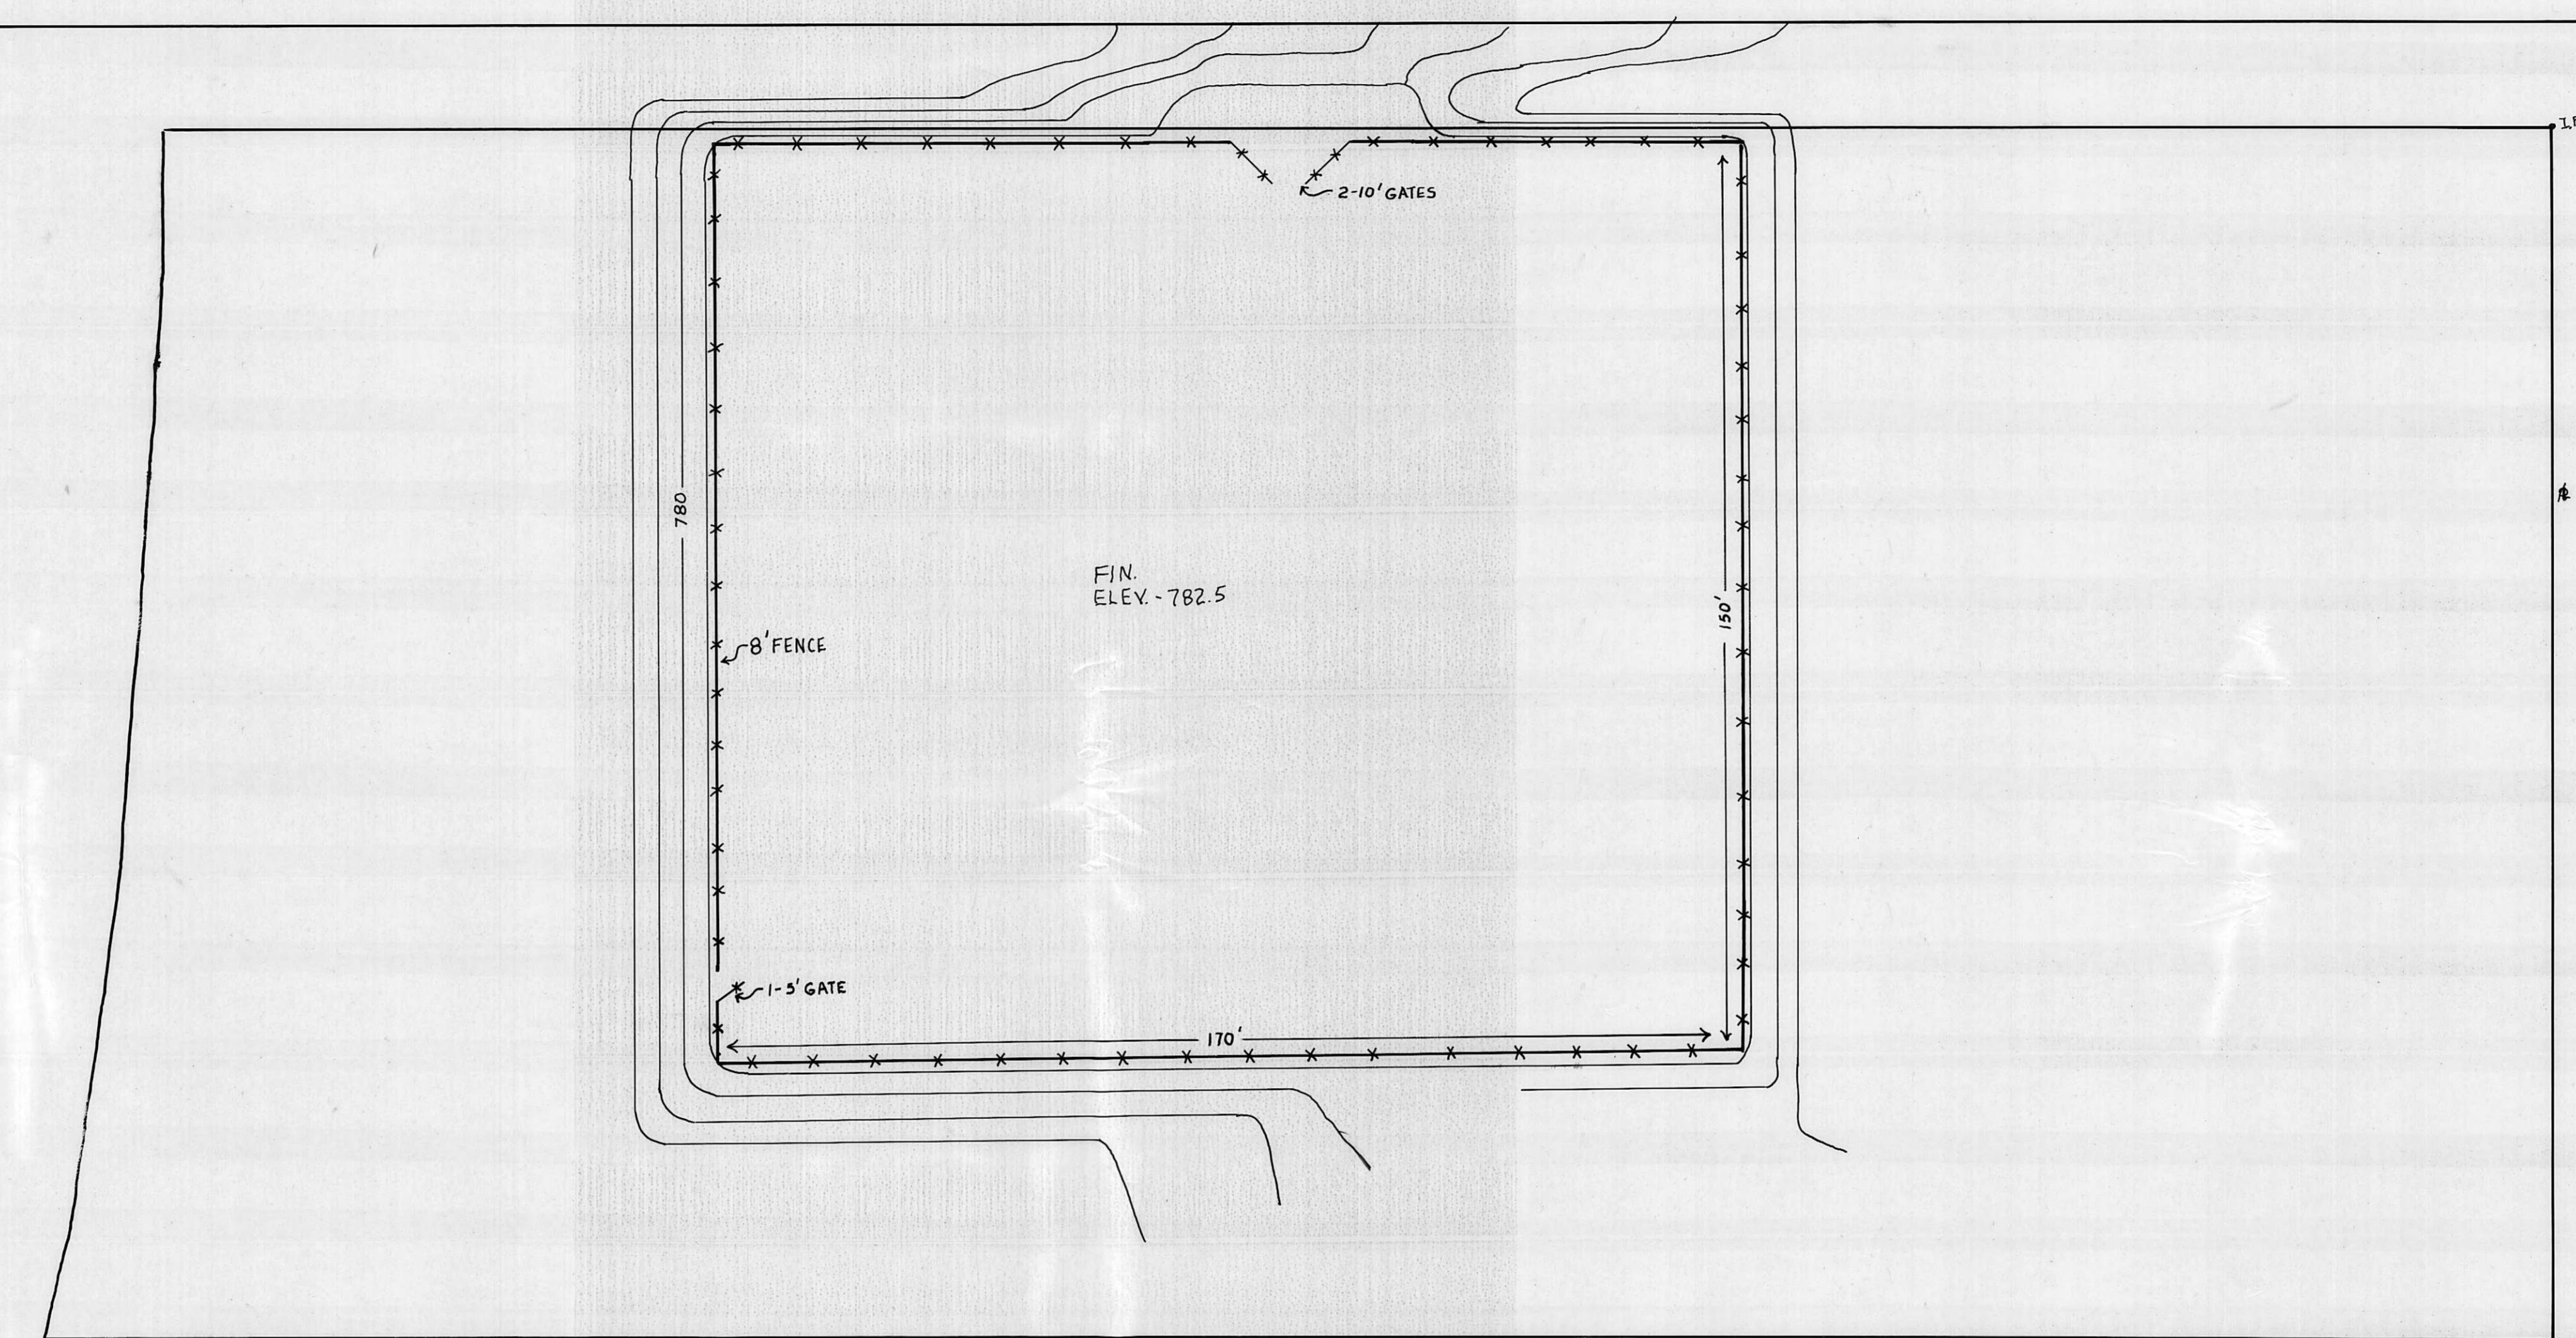

HARRIMAN UTILITY BOARD HARRIMAN, TENNESSEE	
SCALE: 1"=20'	APPROVED BY
DATE: 7/2/97	DRAWN BY R.B.
HARRIMAN DISTRICT SUBSTATION	
FENCE PLAN	DRAWING NUMBER 1 of 1

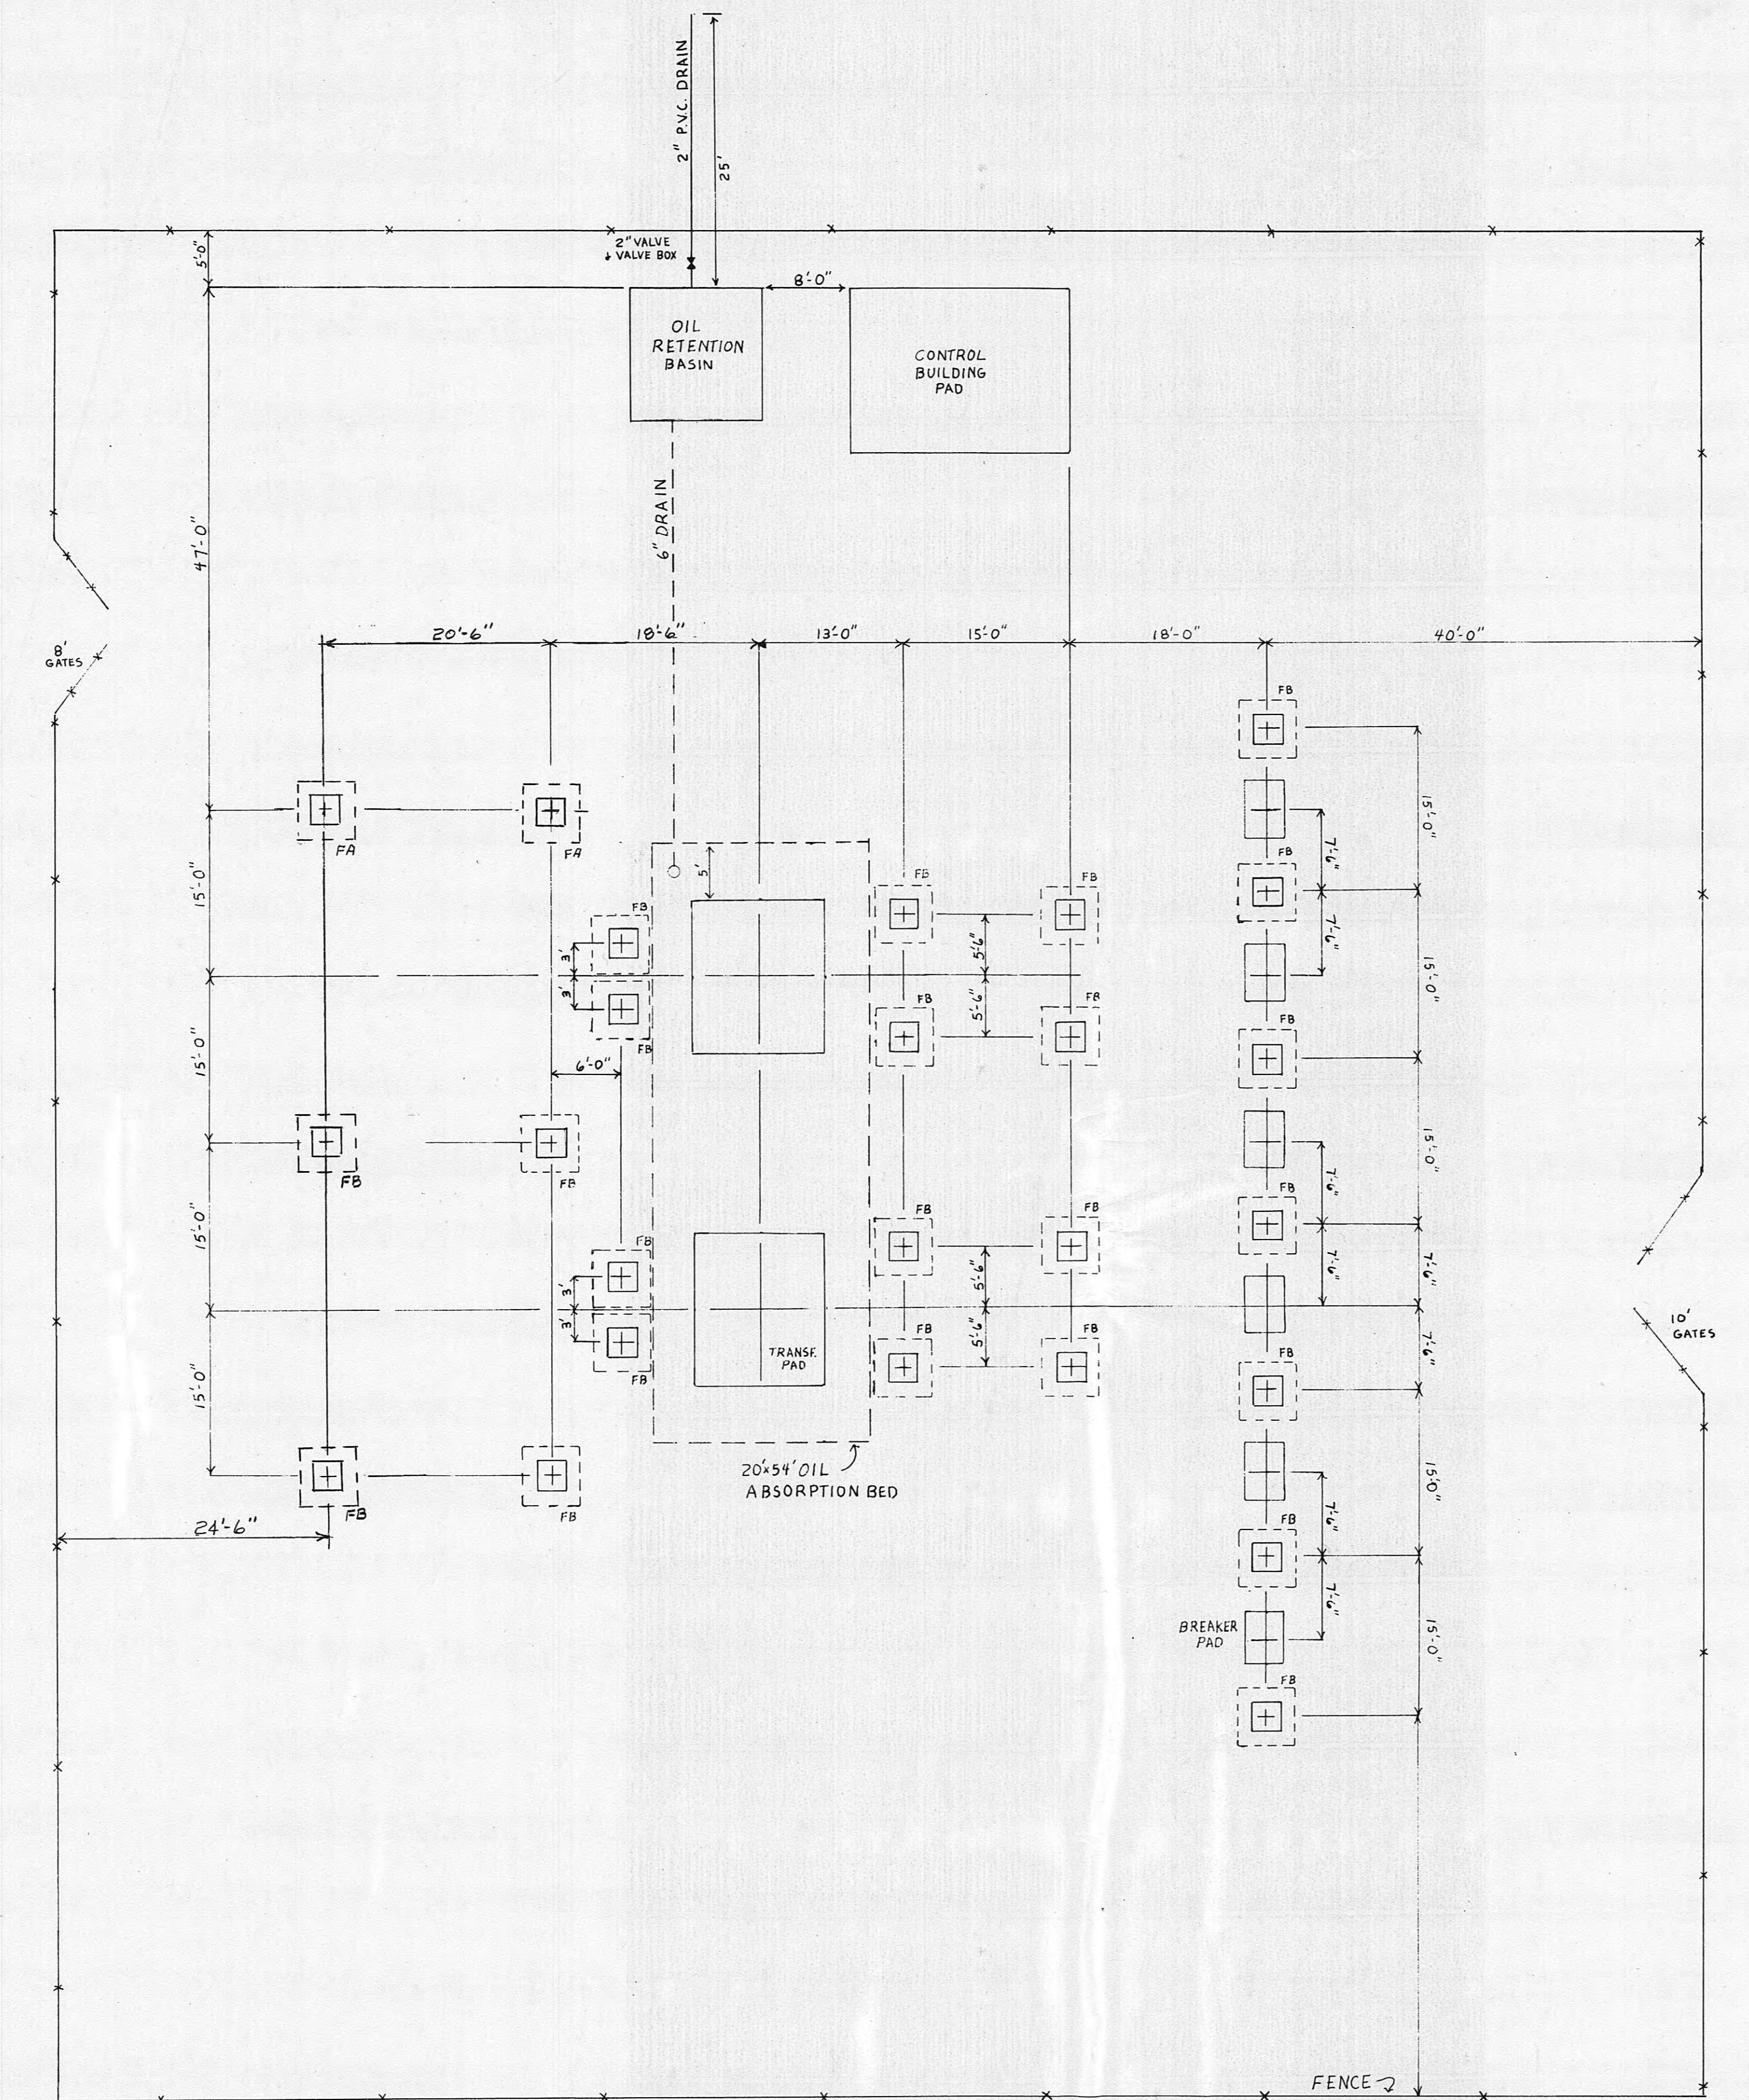

REV:  
1, 10-10-97 REVISED LOCATION OF 4 H.S. FOUNDATIONS

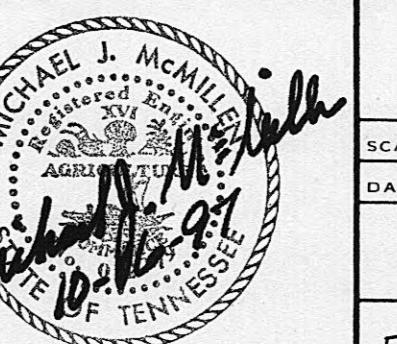

HARRIMAN UTILITY BOARD HARRIMAN, TENNESSEE		
SCALE: 1/8" = 10'	APPROVED BY	DRAWN BY
DATE: 5/13/97	R. BLEVINS	
HARRIMAN DISTRICT SUBSTATION		
FOUNDATION & FENCE PLAN		DRAWING NUMBER 10252-D


NOTES:

- 1- CONTROL WIRING #14 AWG, 600 VOLT, TYPE SIS (WV-1).
- 2- BCT WIRING #10 AWG, 600 VOLT, TYPE SIS (WV-1).
- 3- POWER WIRING FROM FANS TO TERMINAL BLOCK FP ON CONTROL CABINET REAR PANEL #12 AWG, 600 VOLT, TYPE SIS (WV-1).
- 4- ALL WIRING INSIDE CONTROL CABINETS AND LUGGED WIRES INSIDE JUNCTION BOXES TO BE LABELED AT BOTH ENDS WITH OPPOSITE END DESIGNATIONS.


REVISIONS		DESCRIPTION		DATE	APPROVED
ZONE	REV	1 CORRECTED PRD CONNECTIONS		1/20/98	DGW
ZONE	REV	2 CORRECTED FAN CONNECTIONS		1/26/98	DGW

D


TERMINAL BOXES AND FANS LOCATED ON REAR RADIATOR BANK

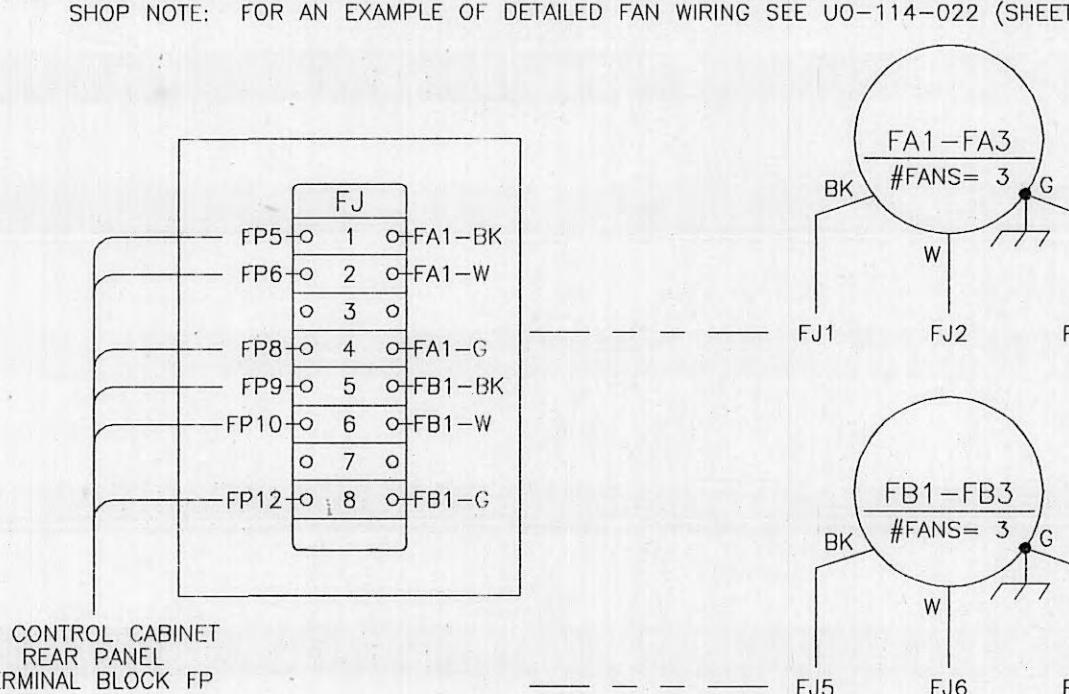TO CONTROL CABINET  
REAR PANEL  
TERMINAL BLOCK FP


TERMINAL BOX AND FANS LOCATED ON SIDE RADIATOR BANK

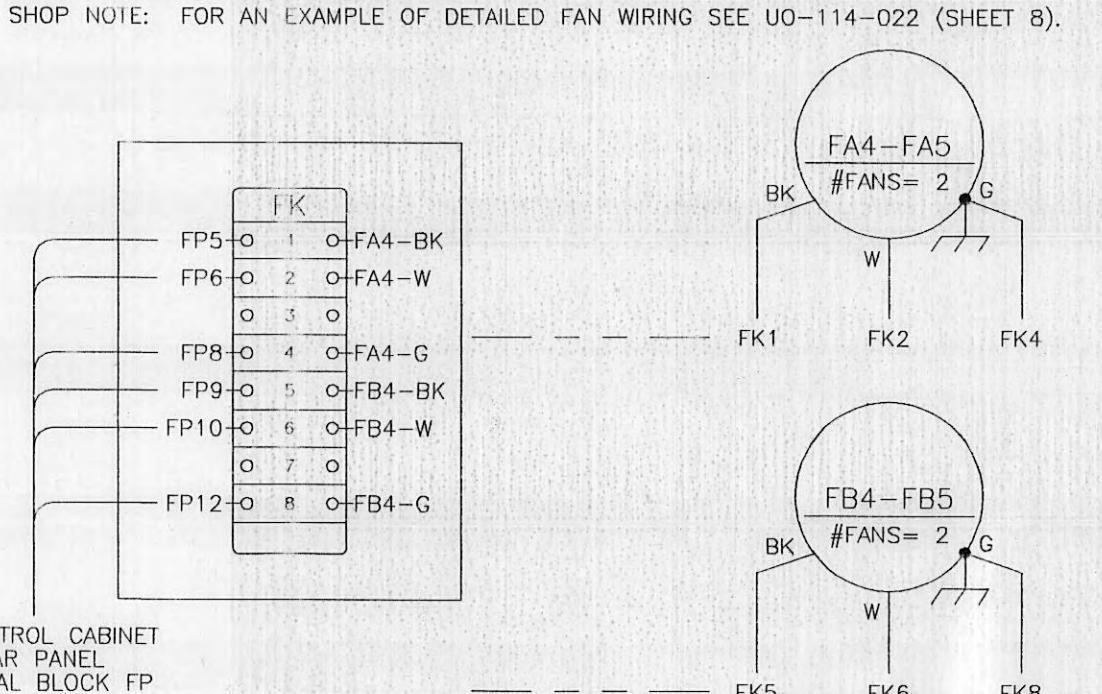TO CONTROL CABINET  
REAR PANEL  
TERMINAL BLOCK FP

DEVICES LOCATED ON MAIN CONTROL CABINET WALL

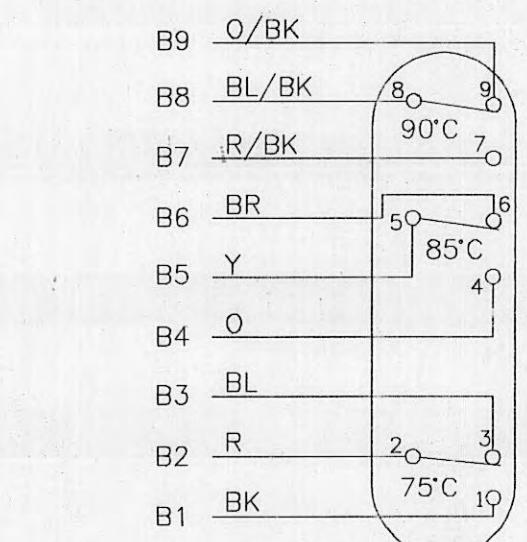

26Q

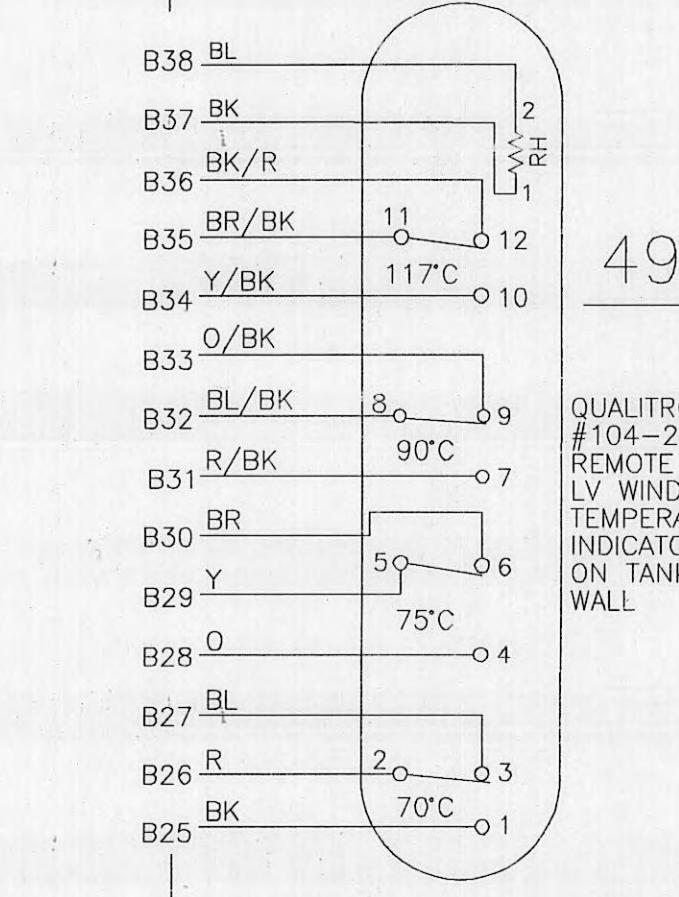TO 602-438A  
REMOTE  
LIQUID  
TEMPERATURE  
INDICATOR  
ON TANK  
WALL

49T

QUALITROL  
#104-224-01(CS-11737)  
REMOTE  
LIQUID  
TEMPERATURE  
INDICATOR  
ON TANK  
WALL

63PR

63P

ARB #8524A42G03  
SUDDEN  
PRESSURE  
RELAY  
ON TOP  
COVERC13 BK  
C12 W  
C11 GB21 BL  
B20 R  
B19 BKC27 BL  
C26 R  
C25 BKB21 BL  
B20 R  
B19 BKC27 BL  
C26 R  
C25 BK

B

A

C

→

3

8

7

6

5




4

3

2

1

BUSHING CURRENT TRANSFORMERS LOCATED INSIDE TANK

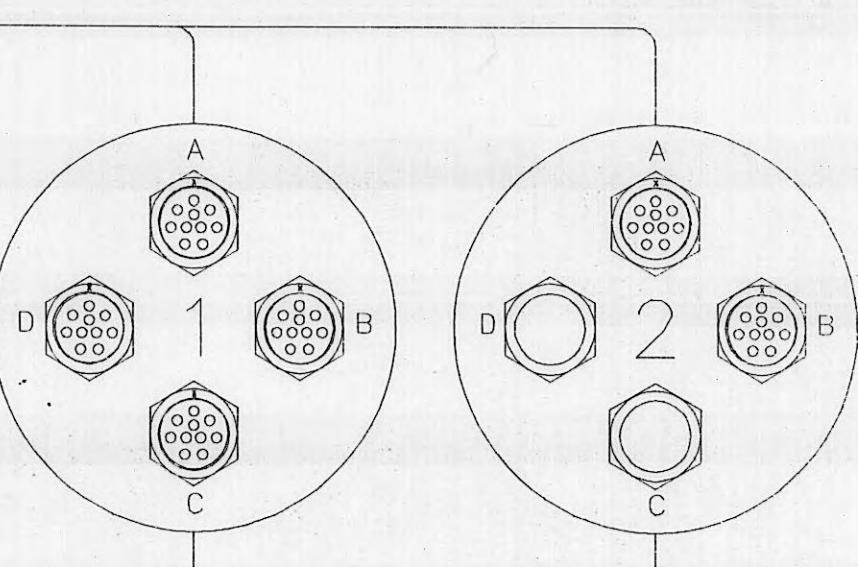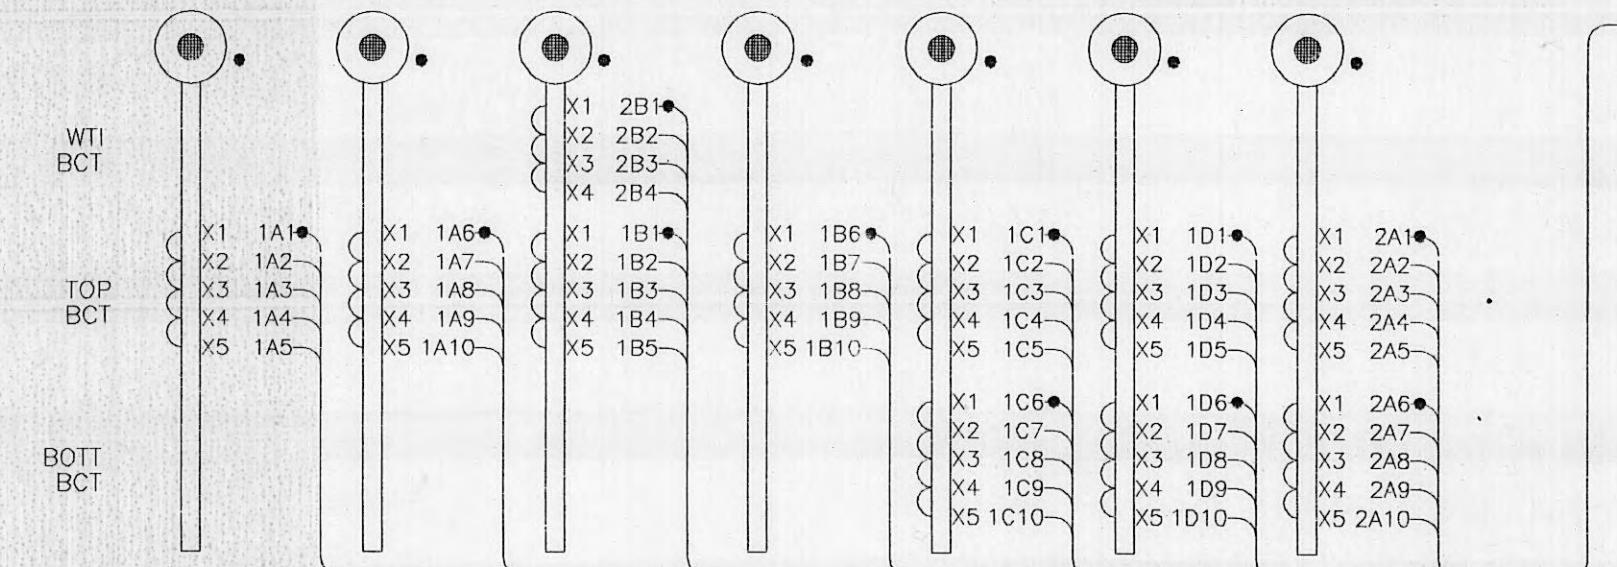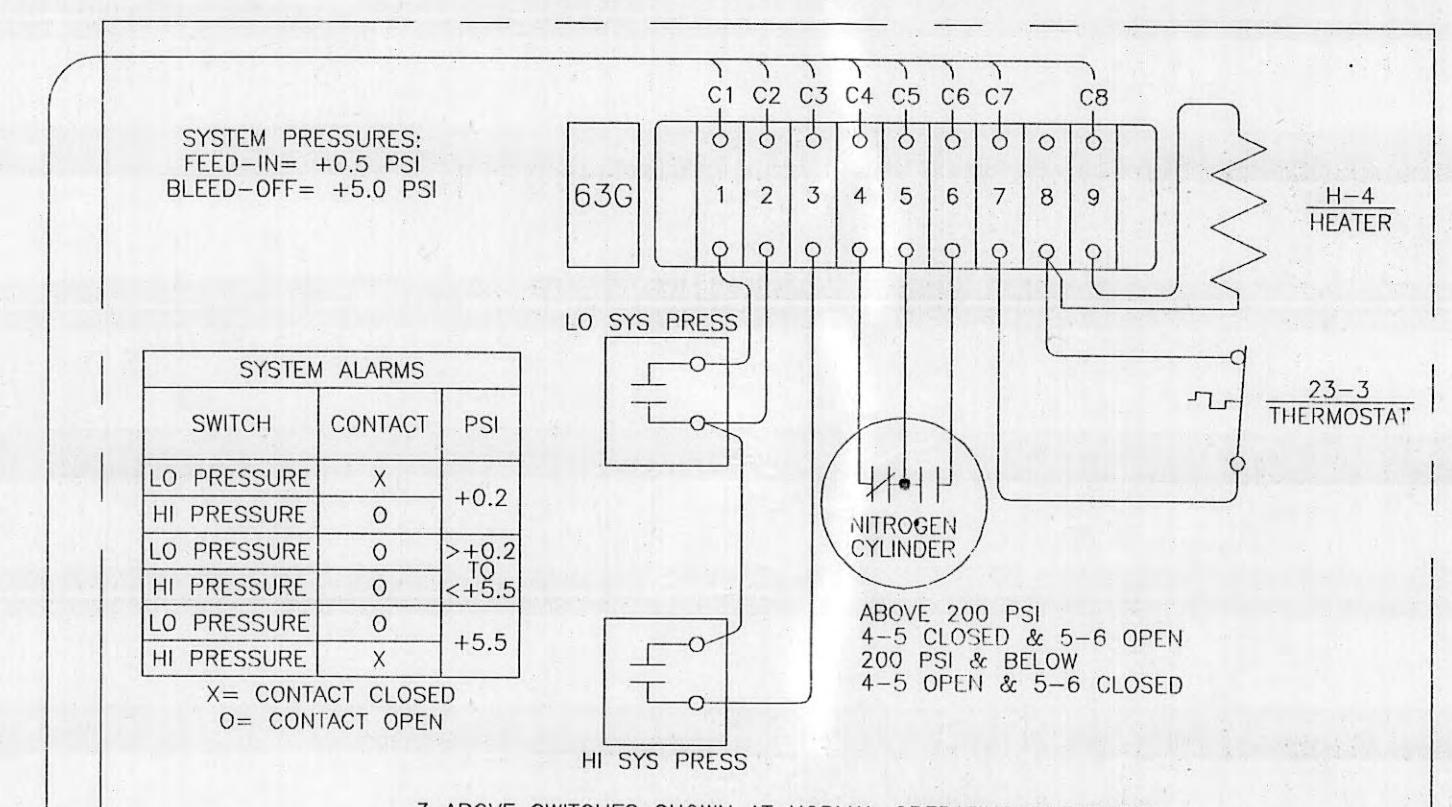BCT JUNCTION  
BLOCK CONNECTION  
ON TANK SIDEWALLBCT JUNCTION  
BLOCK CONNECTION  
ON TANK SIDEWALLTO CONTROL CABINET  
REAR PANEL  
TERMINAL BLOCKS D, E, F, G & WTNITROGEN SYSTEM  
LOCATED IN NITROGEN CABINET3 ABOVE SWITCHES SHOWN AT NORMAL OPERATING PRESSURES  
TO CONTROL CABINET  
REAR PANEL  
TERMINAL BLOCK C

All information contained herein is confidential and the exclusive property of Waukesha Electric Systems, a division of General Signal Corporation. Technical drawings (1) not to disclose to unauthorized persons. (2) do not copy or publish. (3) do not use such information only as reference by Waukesha Electric Systems. (4) do not distribute to others. (5) do not copy or publish. Copyright © 1999, Waukesha Electric Systems, a division of General Signal Corporation.

HARRIMAN UTILITY  
NEW HARRIMAN SUBSTATION  
P.O. NO. 12701 (A)  
SERIAL/MFG NO. GM971382  
"FINAL AS-BUILT"

GS WAUKESHA ELECTRIC SYSTEMS  
A UNIT OF GENERAL SIGNAL  
P.O. BOX 268 GOLDSBORO NC 27553

BCT/EXT. DEVICE  
WIRING DIAGRAM

SIZE F.SCH NO DWG NO  
D A547436894  
SCALE SHEET

1

DRAWN	BIGW
DATE	9/23/97
APPROVED	MBS
UNLESS OTHERWISE SPECIFIED DIMENSIONS ARE IN INCHES	

## REVISIONS

ZONE	REV	DESCRIPTION	DATE	APPROVED
C-3	△	CORRECTED WEIGHTS	11/25/97	MBS

**TRANSFORMER**

MVA	22.5	CLASS	OA	RISE	55 °C	COND HV	CU	LV	CU	PHASE	3
MVA	30.0	CLASS	FA	RISE	55 °C				MAX OPERATING PRESSURE 0.5 LBS. POS. 5.0 LBS. POS.		
MVA	37.5	CLASS	FA	RISE	55 °C				TANK DESIGNED FOR 14.7 PSI VACUUM FILLING		
MVA	42.0	CLASS	FA	RISE	65 °C				ALTITUDE 3300 FEET ABOVE SEA LEVEL		
SERIAL NO.	DESIGN NO. 5474368T00			HZ	60				APPROXIMATE WEIGHTS POUNDS		
HV	68800 DELTA			BIL	350 KV				CORE AND COILS 50000		
LV	13090 GRDY/7560			BIL	110 KV	2780 GALLONS OF OIL *			TANK AND FITTINGS 26950		
IMPEDANCE	% @ 22.5	MVA YEAR OF MFR							TOTAL WEIGHT WITHOUT OIL * 76950		
LIQUID LEVEL	17.0	INCHES BELOW MANHOLE FLANGE AT 25°C							TOTAL WEIGHT WITH OIL * 97800		
LIQUID LEVEL CHANGE	0.67	INCHES PER 10°C LIQUID TEMP.							UNTANKING (HEAVIEST PIECE) 50000		
INSTR BOOK	9300										

\*INHIBITED OIL MEETS ASTM D3487 TYPE II  
NON-DETECTABLE LEVEL (LESS THAN 2 PPM)  
OF PCB PER FEDERAL REGISTER (44FR31514)  
MAY 31, 1979

HV	TAP CHANGER POSITION	VOLTAGE	AMPS @ 22.5 MVA	AMPS @ 30.0 MVA	AMPS @ 37.5 MVA	AMPS @ 42.0 MVA
DE-ENERGIZE TRANSFORMER BEFORE CHANGING TAPS	1	72400	179	239	299	335
	2	70600	184	245	307	343
	3	68800	189	252	315	352
	4	67000	194	259	323	362
	5	65200	199	266	332	372
LV	ANY	13090	992	1323	1654	1852

**BUSHING CURRENT TRANSFORMER MULTI-RATIO ACC. CLASS C400 H1-H2-H3 - TOP AND BOTTOM DESIGN 7617982T00**

CURRENT RATIO	TAP	CURRENT RATIO	TAP
50:5	X2-X3	300:5	X2-X4
100:5	X1-X2	400:5	X1-X4
150:5	X1-X3	450:5	X3-X5
200:5	X4-X5	500:5	X2-X5
250:5	X3-X4	600:5	X1-X5

**BUSHING CURRENT TRANSFORMER MULTI-RATIO ACC. CLASS C800 X1-X2-X3 - TOP DESIGN 7617983T00**

CURRENT RATIO	TAP	CURRENT RATIO	TAP
300:5	X3-X4	1200:5	X1-X3
400:5	X1-X2	1500:5	X1-X4
500:5	X4-X5	1600:5	X2-X5
800:5	X2-X3	2000:5	X1-X5
1100:5	X2-X4		

**BUSHING CURRENT TRANSFORMER MULTI-RATIO ACC. CLASS C400 XO - TOP DESIGN 7617984T00**

CURRENT RATIO	TAP	CURRENT RATIO	TAP
50:5	X2-X3	300:5	X2-X4
100:5	X1-X2	400:5	X1-X4
150:5	X1-X3	450:5	X3-X5
200:5	X4-X5	500:5	X2-X5
250:5	X3-X4	600:5	X1-X5

**BUSHING CURRENT TRANSFORMER MULTI-RATIO ACC. CLASS C50 FOR WINDING TEMP. INDICATOR LOCATED ON X2 BUSHING RATIO 2400:5 CONN (X2-X4) 2200:5 DESIGN 7613756T00**

**WAUKEsha ELECTRIC SYSTEMS**  
A UNIT OF GENERAL SIGNAL  
P.O. BOX 268 GOLDSBORO, N.C. 27533

MATERIAL: 12.25 X 10.00 STAINLESS STEEL USS. STD. GA. NO. 22 (.0299)  
MTG. HOLES: 11.75 X 9.5 C TO C 4-5/32 DIA HOLES  
LETTERING AND NUMERALS SUNKEN BLACK ON A POLISHED STAINLESS STEEL BACKGROUND  
PAINT: SPRAYED BLACK ENAMEL  
PADS: ALL RAISED PADS ARE 7/32 WIDE AND LENGTH SHOWN

NOTE:  
THE DESIGN IMPEDANCE IS:

7.0 @ 22.5 MVA

THE SERIAL NUMBER, YEAR OF MANUFACTURE, AND MEASURED IMPEDANCE OF EACH UNIT OF THIS DESIGN WILL BE STAMPED ON ITS NAMEPLATE PRIOR TO SHIPMENT.

HARRIMAN UTILITY  
NEW HARRIMAN SUBSTATION  
P.O. NO. 12701 (B)  
SERIAL/MFG NO. GM971383  
"FINAL-AS-BUILT"

DRAWN	RDN	
DATE	10/22/97	
APPROVED	MBS	
UNLESS OTHERWISE SPECIFIED DIMENSIONS ARE IN INCHES		
SIZE	FSCM NO	DWG NO
C		A547436890
SCALE	1.0	SHEET

**TRANSFORMER NAMEPLATE DRAWING**

All information contained herein is confidential and the exclusive property of Waukesha Electric Systems, a division of General Signal Corporation. Recipient agrees (1) not to disclose any of such information to others; (2) not to reproduce this document in whole or in part except as required for the internal evolution of this system; (3) to use such information only, directed by Waukesha Electric Systems, and (4) upon request, to return all copies of this document to Waukesha Electric Systems.

Copyright © 1989, Waukesha Electric Systems, a division of General Signal Corporation.


Line #	Qty	Description	8	7	6	5	4	3	2	1
1	1	1 in. upper filter press valve w/pipe plug.								
2	1	1 inch vacuum flange with pipe plug in top cover								
3	1	2 in. filter press/drain valve w/.375 sampler and plug.								
4	2	Bolted manhole (20 inch opening) with gasket in groove with mechanical stops.								
5	2	Center of gravity (assembled).								
6	2	Center of gravity (shipping).								
7	1	Channel bracing members.								
8	1	Control box w/ padlock provisions and removable gasketed bottom plate								
9	1	CT junction box.								
10	1	Dial type liquid temperature indicator.								
11	1	Enclosed inert gas system for oil preservation.								
12	1	Fault pressure relay - ABB 4432A95G02								
13	1	Flat base w/beveled edges for sliding both directions.								
14	7	Ground clamp connector for 1/0 solid to 500 MCM copper cable.								
15	8	Ground clamp connector for 4/0 solid to 500 MCM copper cable.								
16	2	Grounding connector for #1/0 to 500 MCM copper cable.								
17	1	Impact recorder (3 axis) mounted in removable enclosure.								
18	4	Jacking plate with pulling provisions.								
19	6	Lightning arrester mtg bkt. (3-.56in holes on 10 in bc).								
20	1	Liquid level gauge.								
21	4	Main cover lifting lug.								
22	9	NEMA 2 hole s/stl ground pads.								
23	7	NEMA 4 hole bronze tinned bushing spade connector for 1.5 in. stud.								
24	1	No-load tap changer w/position indicator and padlock provisions.								
25	1	Pressure relief device.								
26	1	Pressure vacuum gauge with bleeder device.								
27	2	Removable radiators w/shutoff valves, vent and drain (Left).								
28	4	Removable radiators w/shutoff valves, vent and drain (Rear).								
29	1	Stainless steel BCT and power nameplate.								
30	4	Unit lifting lug (with chamfered edges) for lifting entire unit								
31	1	Well for liquid temperature indicator probe								
32	1	Well for winding temperature indicator probe								
33	1	Winding temperature indicator.								

TRANSFORMER EQUIPPED WITH INERT GAS SYSTEM FOR CONSTANT OIL PRESERVATION INCLUDING:  
 (A) PRESSURE VACUUM SWITCH  
 (B) GAS SAMPLING VALVE WITH HOSE BARB FITTING FOR .25" I.D. HOSE  
 (C) PRESSURE VACUUM GAUGE  
 (D) CYLINDER PRESSURE GAUGE WITH LOW PRESSURE ALARM  
 (E) PADLOCKABLE HINGED DOOR  
 (F) 220 CU. FT NITROGEN CYLINDERS  
 (G) CABINET IS DESIGNED WITH SPACE FOR TWO NITROGEN BOTTLES

ADDITIONAL DRAWING INFORMATION:  
 SEE LAPP DRAWING B88023-70 FOR COMPLETE HV BUSHING INFORMATION  
 SEE LAPP DRAWING B89123-70 FOR COMPLETE LV BUSHING INFORMATION  
 SEE LAPP DRAWING B89123-70 FOR COMPLETE NEUTRAL BUSHING INFORMATION  
 SEE OHIO BRASS DRAWING S007438-00 FOR COMPLETE HV ARRESTER INFORMATION  
 SEE OHIO BRASS DRAWING S007433-00 FOR COMPLETE LV ARRESTER INFORMATION  
 SEE WES DRAWING A547436890 FOR COMPLETE NAMEPLATE INFORMATION

#### NOTES -

- (1)- EXTERIOR TANK FINISH ANSI #70 LIGHT GRAY.
- (2)- SEALED TANK CONSTRUCTION WITH WELDED MAIN TOP COVER.
- (3)- ALL EXTERNAL CONTROL WIRING ROUTED THROUGH RIGID METAL CONDUIT  
EXCEPT FOR SHORT RUNS OF FLEXIBLE LIQUID TIGHT CONDUIT TO GAUGES AND FANS.
- (4)- TANK AND FITTINGS DESIGNED FOR VACUUM FILLING IN THE FIELD.
- (5)- ALL EXTERNAL REMOVABLE AND/OR UN-PAINTED HARDWARE CORROSION RESISTANT.
- (6)- TRANSFORMER DESIGNED FOR TRUCK SHIPMENT.
- (7)- TRANSFORMER SHIPPED FILLED WITH OIL.
- (8)- SEE CONTROL WIRING FOR ALL ALARM CONTACT INFORMATION.
- (9)- FANS - 26"-1/3 HP-230V-1 PH-60 HZ-1140 RPM-7400 CFM.  
STAGE "A" REAR - (3) FANS  
STAGE "B" REAR - (3) FANS  
STAGE "A" END - (2) FANS  
STAGE "B" END - (2) FANS

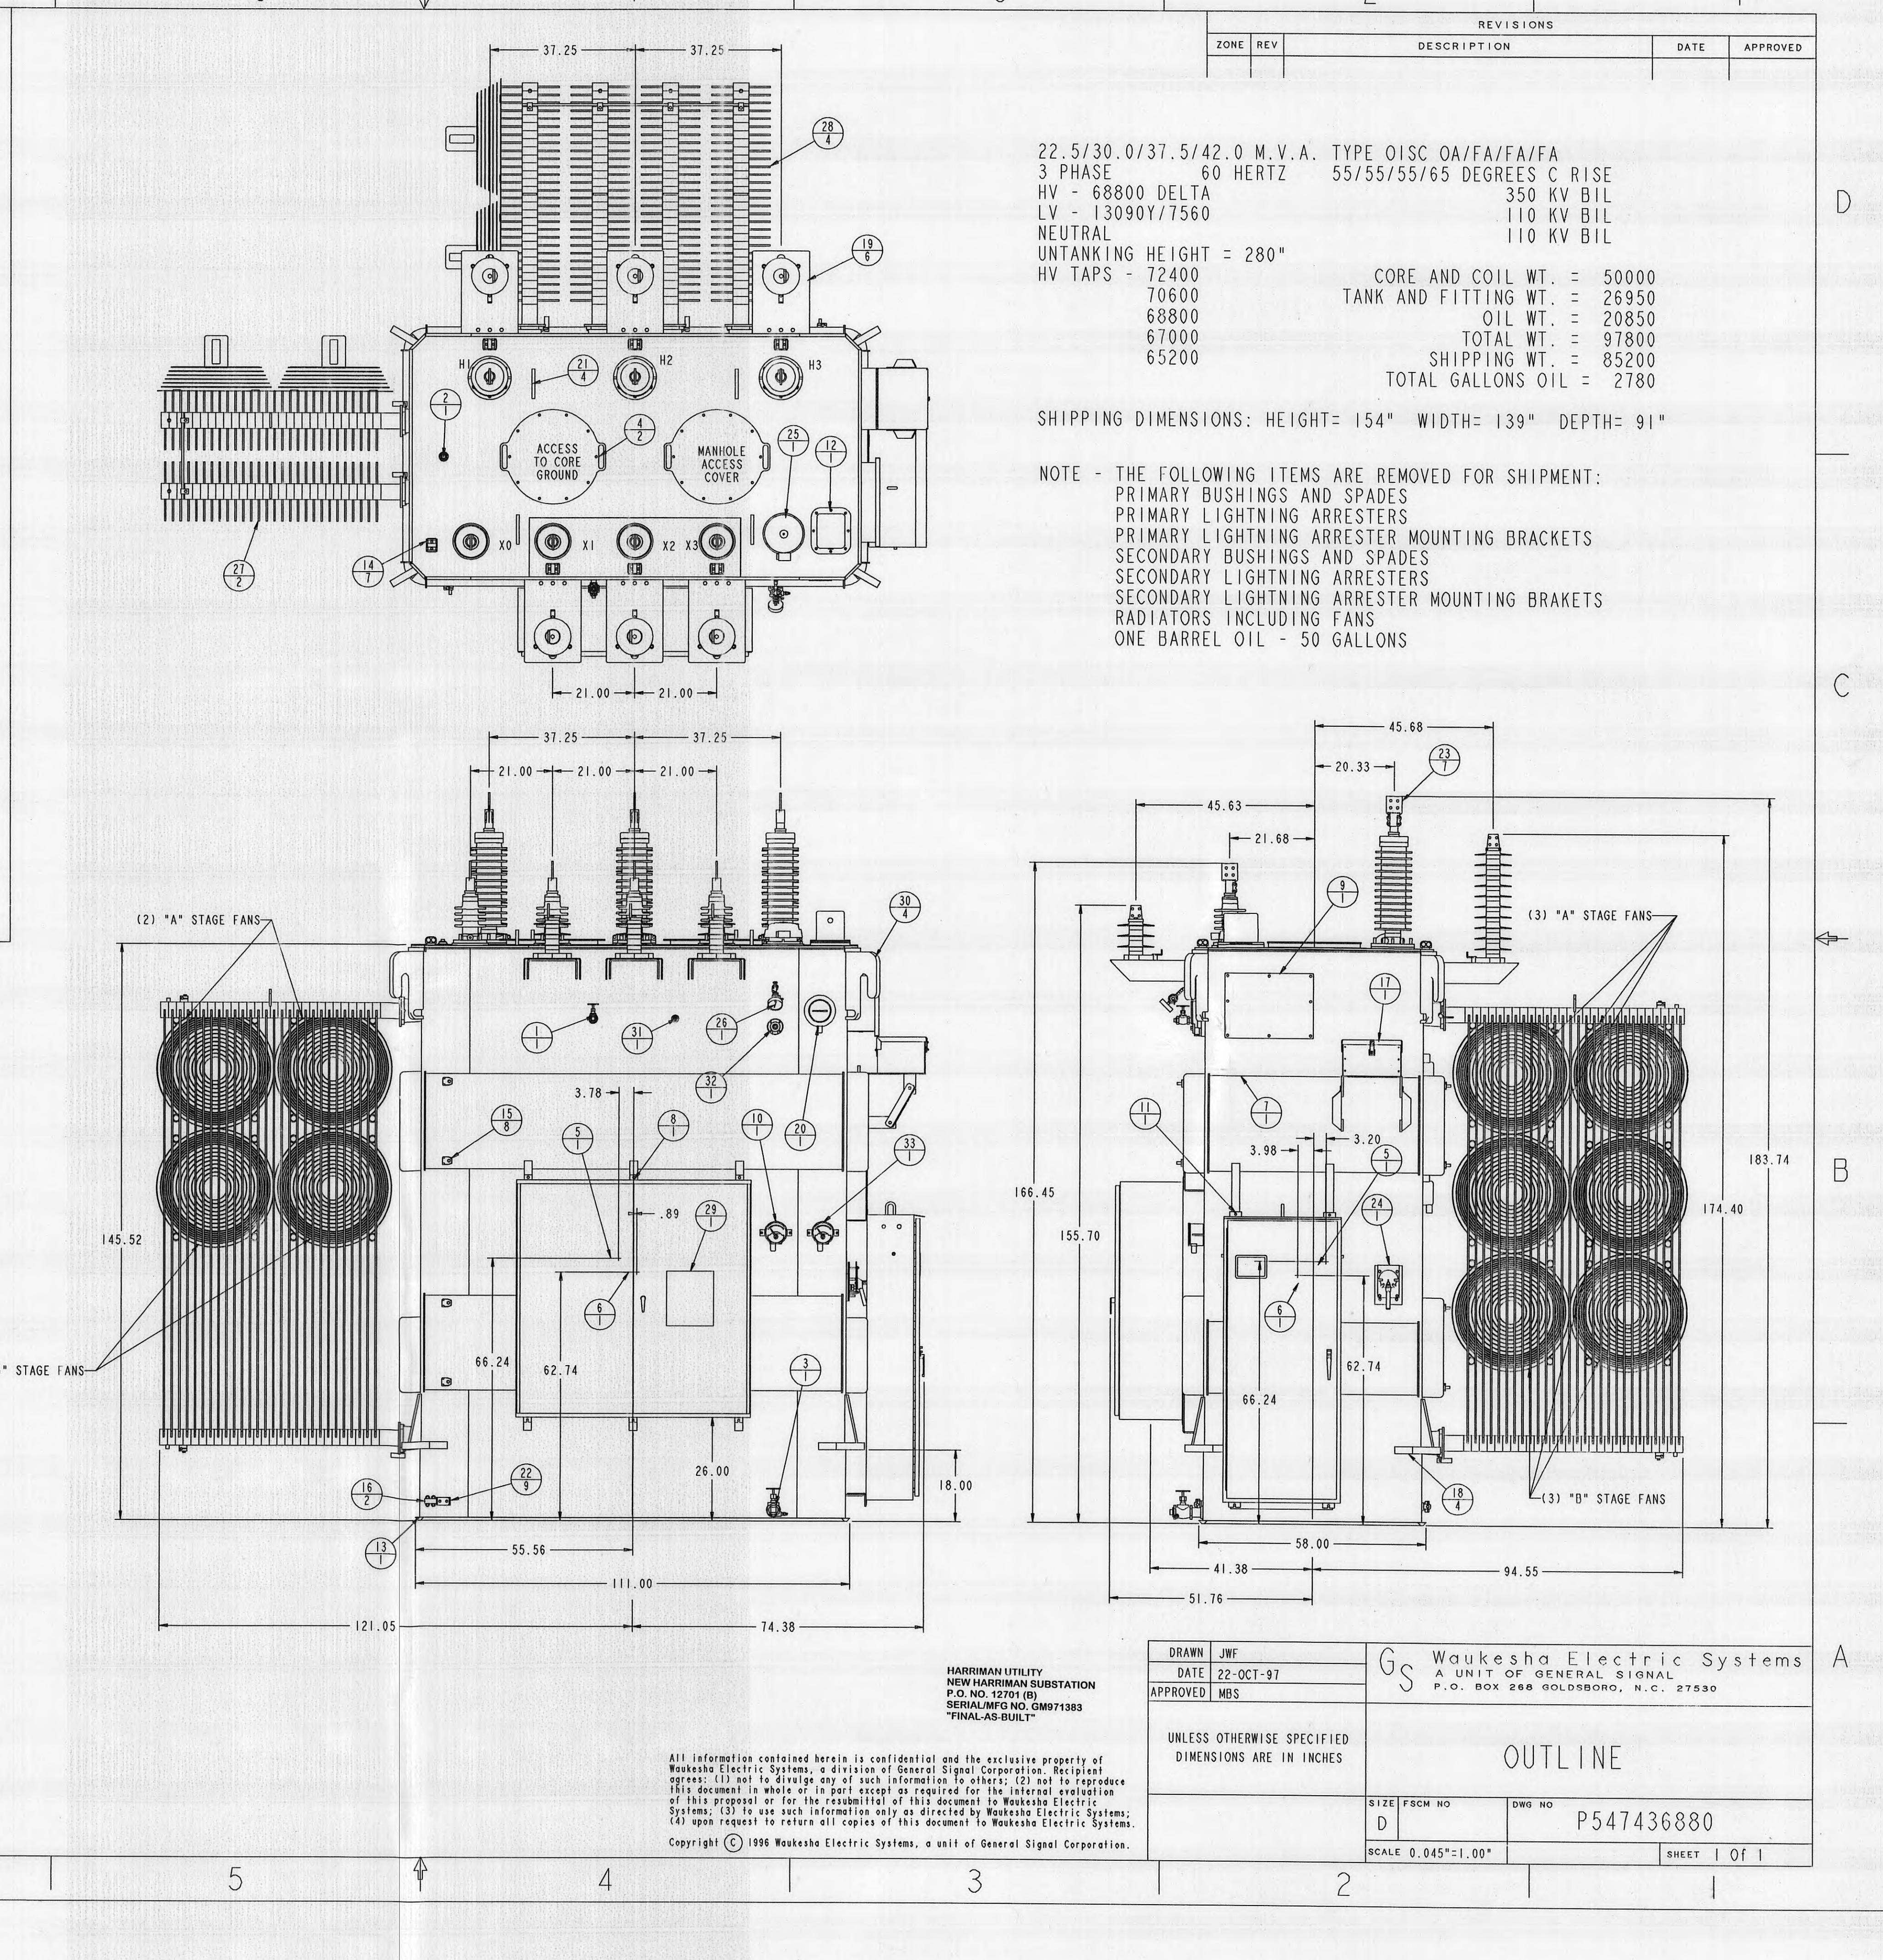

It#	Qty	Description
1	1	1 in. upper filter press valve w/pipe plug.
2	1	1 inch vacuum flange with pipe plug in top cover
3	1	2 in. filter press/drain valve w/.375 sampler and plug.
4	2	Bolted manhole (20 inch opening) with gasket in groove with mechanical stops.
5	2	Center of gravity (assembled).
6	2	Center of gravity (shipping).
7	1	Channel bracing members.
8	1	Control box w/ padlock provisions and removable gasketed bottom plate
9	1	CT junction box.
10	1	Dial type liquid temperature indicator.
11	1	Enclosed inert gas system for oil preservation.
12	1	Fault pressure relay - ABB 4432A95G02
13	1	Flat base w/beveled edges for sliding both directions.
14	7	Ground clamp connector for 1/0 solid to 500 MCM copper cable.
15	8	Ground clamp connector for 4/0 solid to 500 MCM copper cable.
16	2	Grounding connector for #1/0 to 500 MCM copper cable.
17	1	Impact recorder (3 axis) mounted in removable enclosure.
18	4	Jacking plate with pulling provisions.
19	6	Lightning arrester mtg bkt. (3-.56in holes on 10 in bc).
20	1	Liquid level gauge.
21	4	Main cover lifting lug.
22	9	NEMA 2 hole s/stl ground pads.
23	7	NEMA 4 hole bronze tinned bushing spade connector for 1.5 in. stud.
24	1	No-load tap changer w/position indicator and padlock provisions.
25	1	Pressure relief device.
26	1	Pressure vacuum gauge with bleeder device.
27	2	Removable radiators w/shutoff valves, vent and drain (Left).
28	4	Removable radiators w/shutoff valves, vent and drain (Rear).
29	1	Stainless steel BCT and power nameplate.
30	4	Unit lifting lug (with chamfered edges) for lifting entire unit
31	1	Well for liquid temperature indicator probe
32	1	Well for winding temperature indicator probe
33	1	Winding temperature indicator.

## TRANSFORMER EQUIPPED WITH INERT GAS SYSTEM FOR CONSTANT OIL PRESERVATION INCLUDING:




- (A) PRESSURE VACUUM SWITCH
- (B) GAS SAMPLING VALVE WITH HOSE BARB FITTING FOR .25" I.D. HOSE
- (C) PRESSURE VACUUM GAUGE
- (D) CYLINDER PRESSURE GAUGE WITH LOW PRESSURE ALARM
- (E) PADLOCKABLE HINGED DOOR
- (F) 220 CU. FT NITROGEN CYLINDERS
- (G) CABINET IS DESIGNED WITH SPACE FOR TWO NITROGEN BOTTLES

## ADDITIONAL DRAWING INFORMATION:

- SEE LAPP DRAWING B88023-70 FOR COMPLETE HV BUSHING INFORMATION
- SEE LAPP DRAWING B89123-70 FOR COMPLETE LV BUSHING INFORMATION
- SEE LAPP DRAWING B89123-70 FOR COMPLETE NEUTRAL BUSHING INFORMATION
- SEE OHIO BRASS DRAWING S007438-00 FOR COMPLETE HV ARRESTER INFORMATION
- SEE OHIO BRASS DRAWING S007433-00 FOR COMPLETE LV ARRESTER INFORMATION
- SEE WES DRAWING A547436890 FOR COMPLETE NAMEPLATE INFORMATION

## NOTES -

- (1) EXTERIOR TANK FINISH ANSI #70 LIGHT GRAY.
  - (2) SEALED TANK CONSTRUCTION WITH WELDED MAIN TOP COVER.
  - (3) ALL EXTERNAL CONTROL WIRING ROUTED THROUGH RIGID METAL CONDUIT EXCEPT FOR SHORT RUNS OF FLEXIBLE LIQUID TIGHT CONDUIT TO GAUGES AND FANS.
  - (4) TANK AND FITTINGS DESIGNED FOR VACUUM FILLING IN THE FIELD.
  - (5) ALL EXTERNAL REMOVABLE AND/OR UN-PAINTED HARDWARE CORROSION RESISTANT.
  - (6) TRANSFORMER DESIGNED FOR TRUCK SHIPMENT.
  - (7) TRANSFORMER SHIPPED FILLED WITH OIL.
  - (8) SEE CONTROL WIRING FOR ALL ALARM CONTACT INFORMATION.
  - (9) FANS - 26"-1/3 HP-230V-1 PH-60 HZ-1140 RPM-7400 CFM.
- STAGE "A" REAR - (3) FANS  
 STAGE "B" REAR - (3) FANS  
 STAGE "A" END - (2) FANS  
 STAGE "B" END - (2) FANS

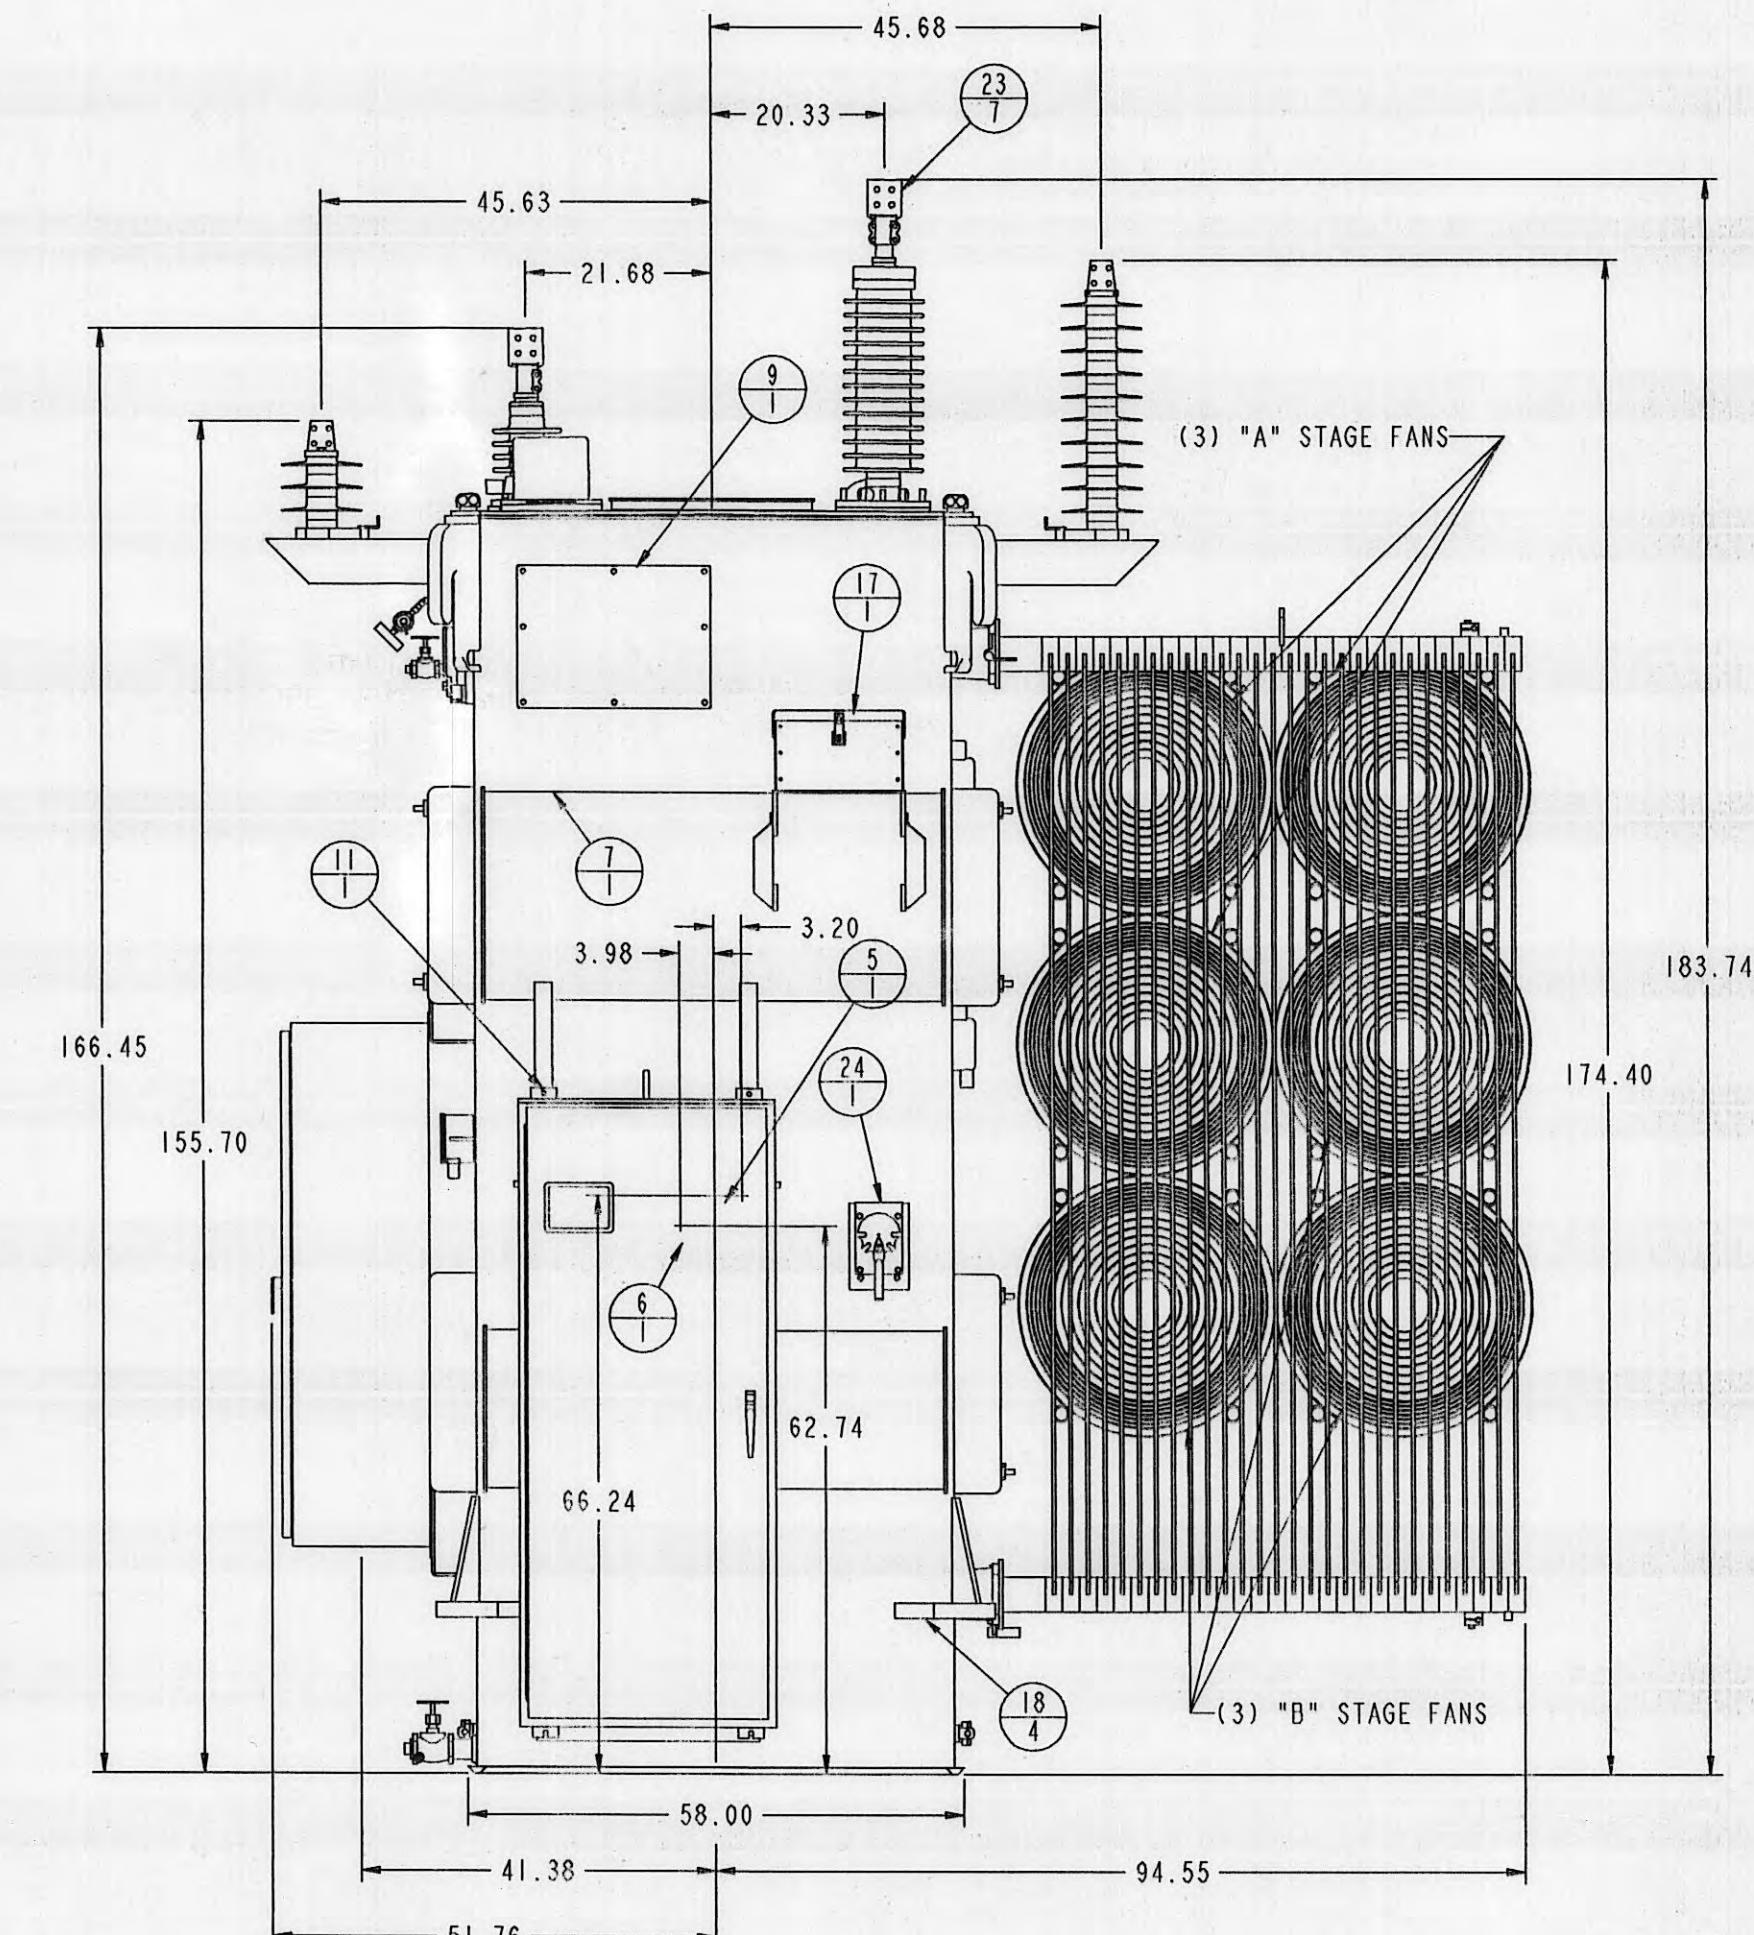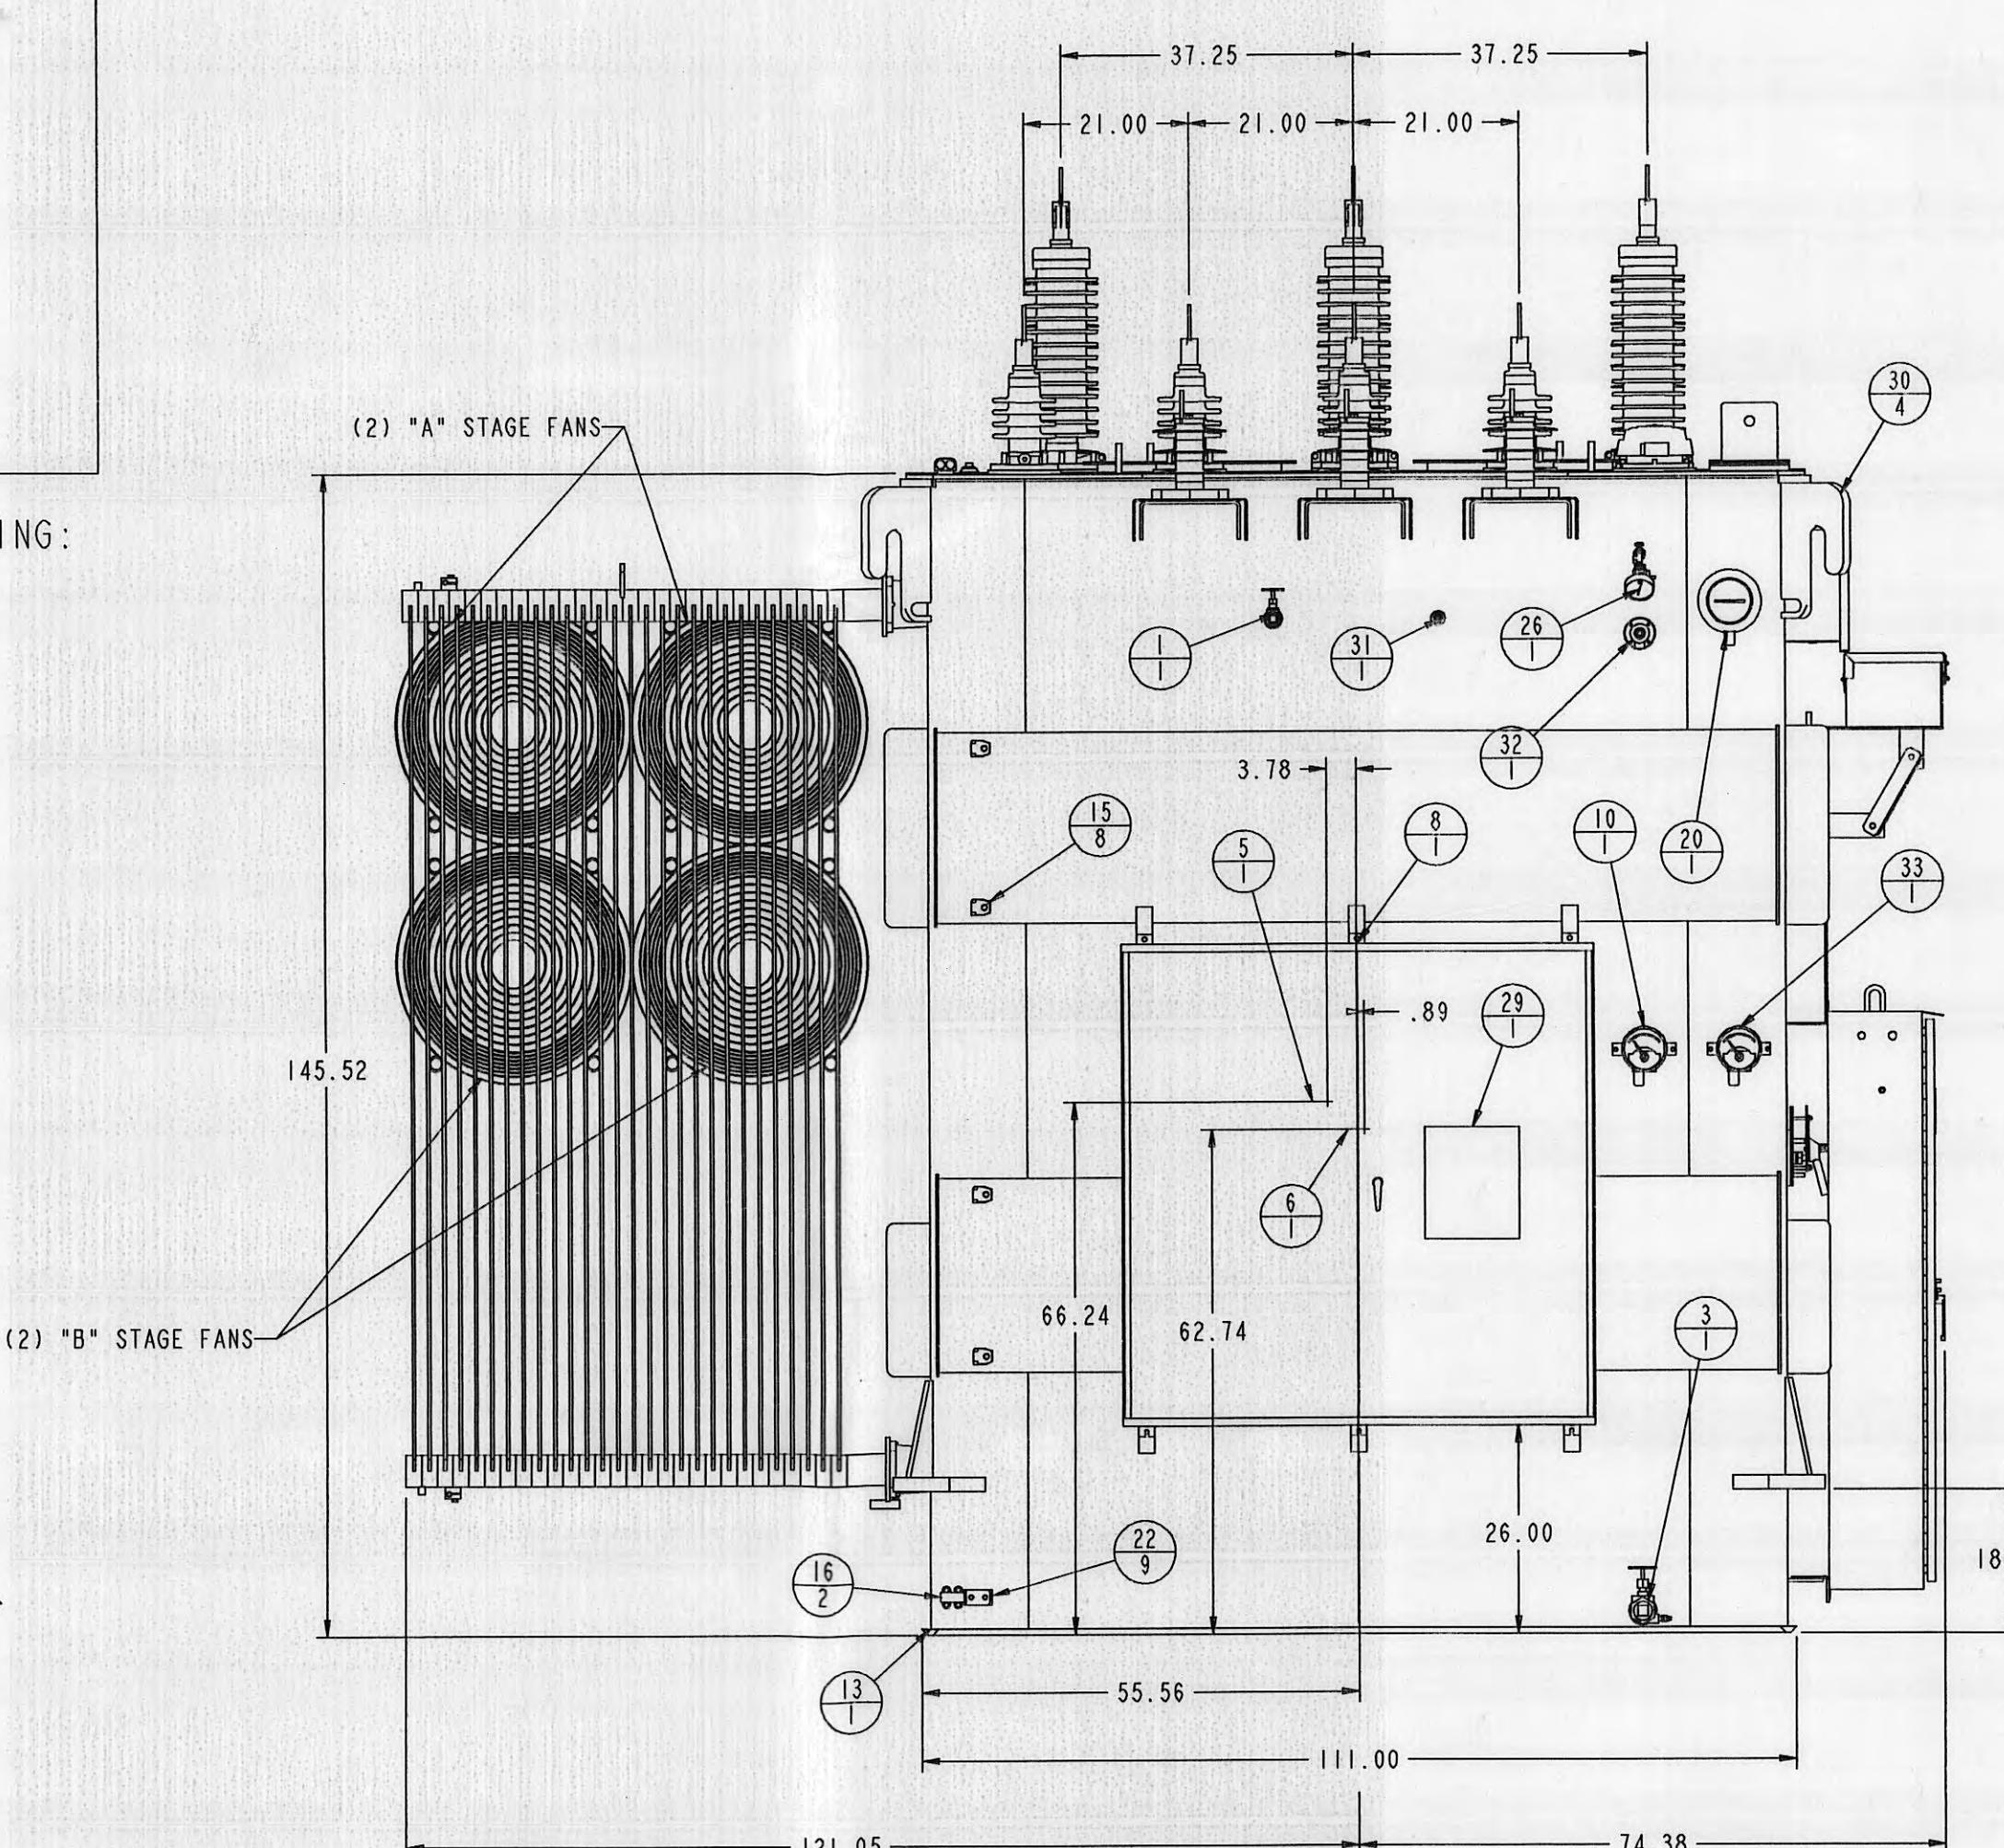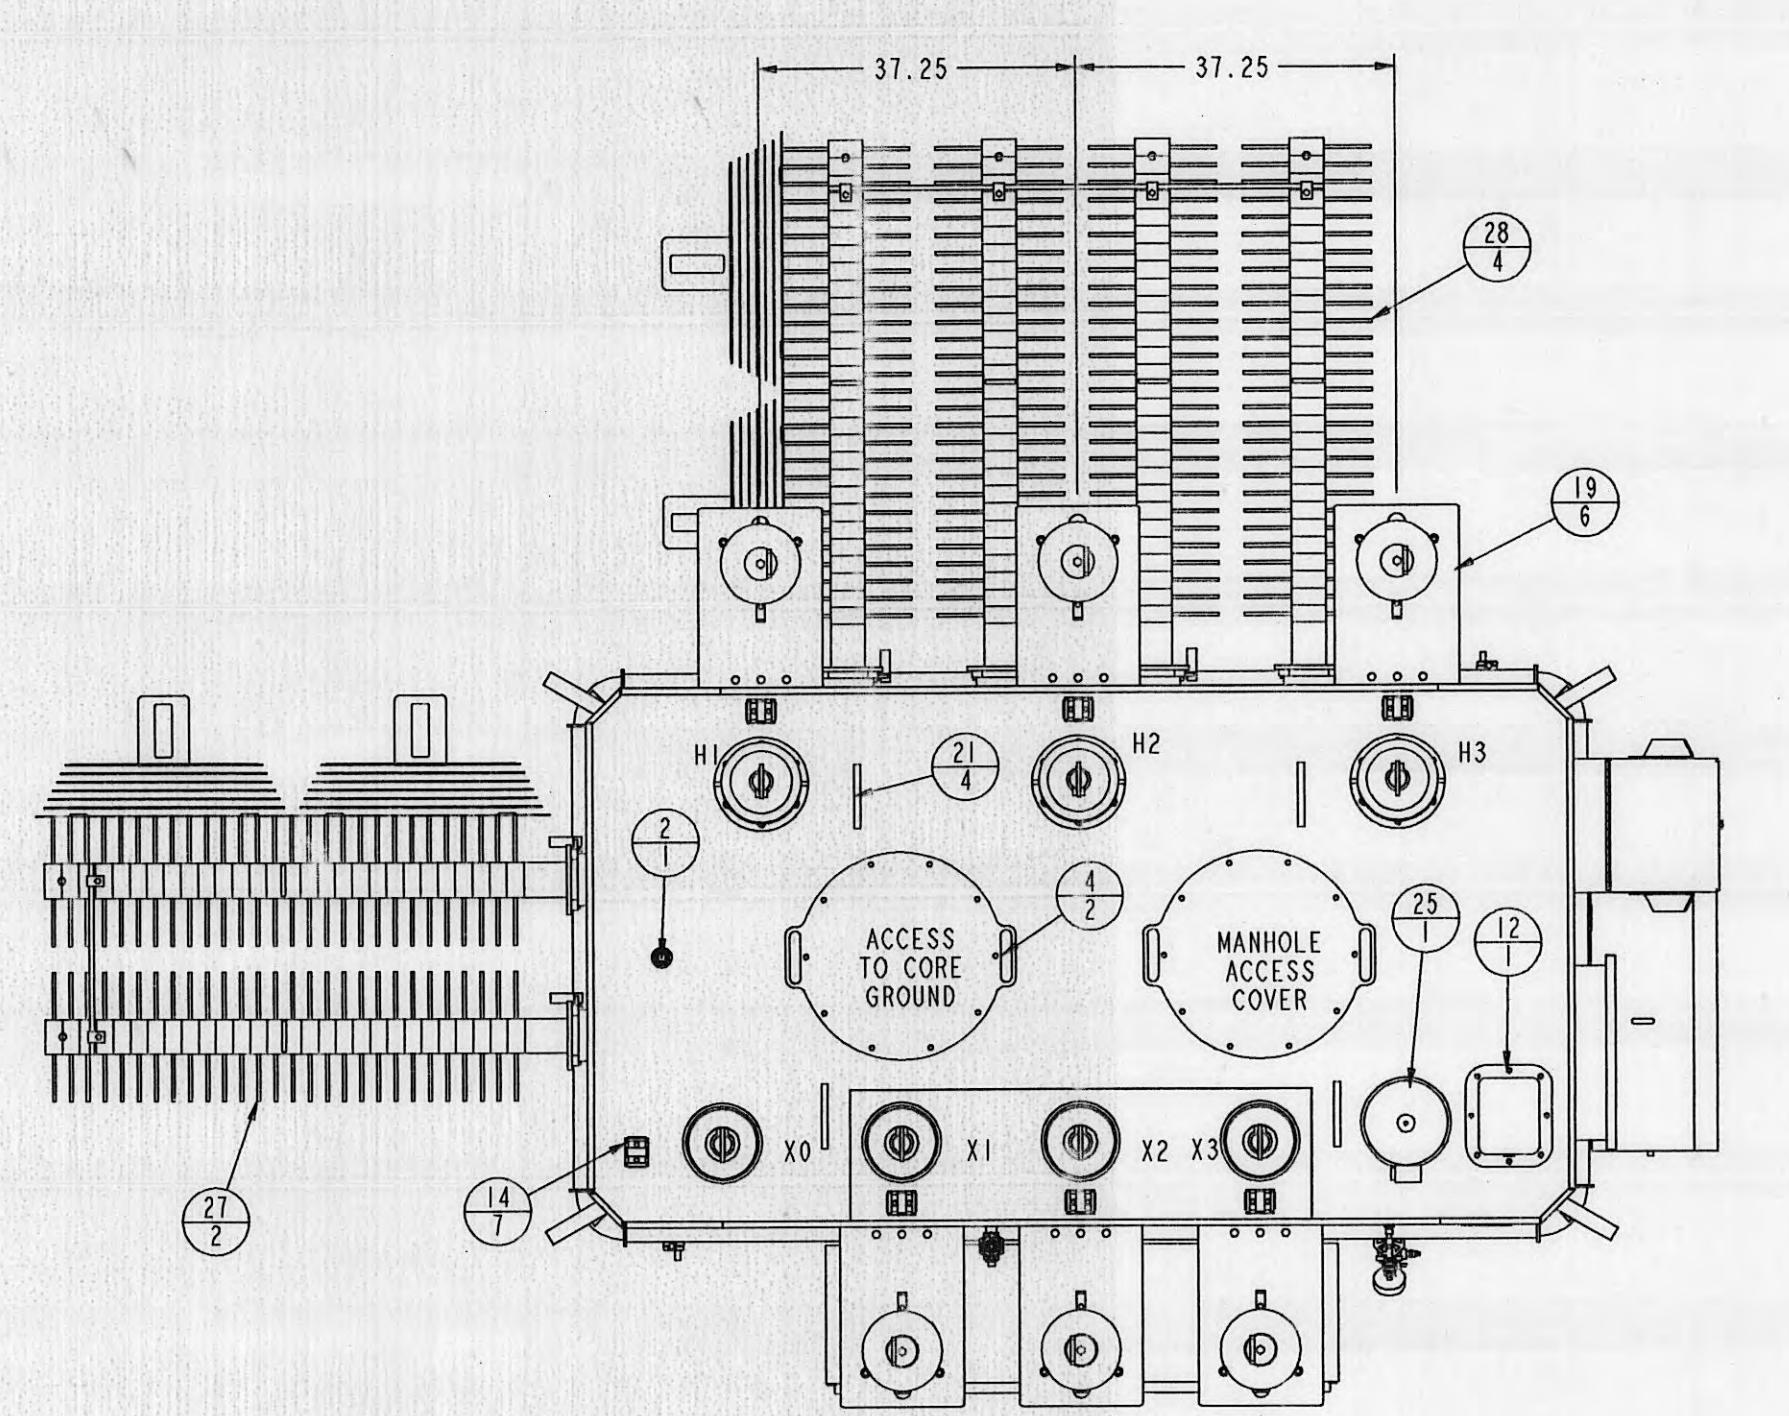

HARRIMAN UTILITY  
 NEW HARRIMAN SUBSTATION  
 P.O. NO. 12701 (A)  
 SERIAL/MFG NO. GM971382  
 "FINAL-AS-BUILT"

UNLESS OTHERWISE SPECIFIED  
 DIMENSIONS ARE IN INCHES


GS Waukesha Electric Systems  
 A UNIT OF GENERAL SIGNAL  
 P.O. BOX 268 GOLDSBORO, N.C. 27530

OUTLINE


SIZE	FSCM NO	DWG NO
D		P547436880
SCALE	0.045"=1.00"	
SHEET	1	OF 1

2 STAGE COOLING FANS CONTROL AND POWER

ZONE	REV	DESCRIPTION	DATE	APPROVED
1	1	CORRECTED LABELING OF THE WTI AUX RELAY	12/4/97	DGW
2	2	CORRECTED CIRCUIT BREAKER LABELING	1/19/98	DGW

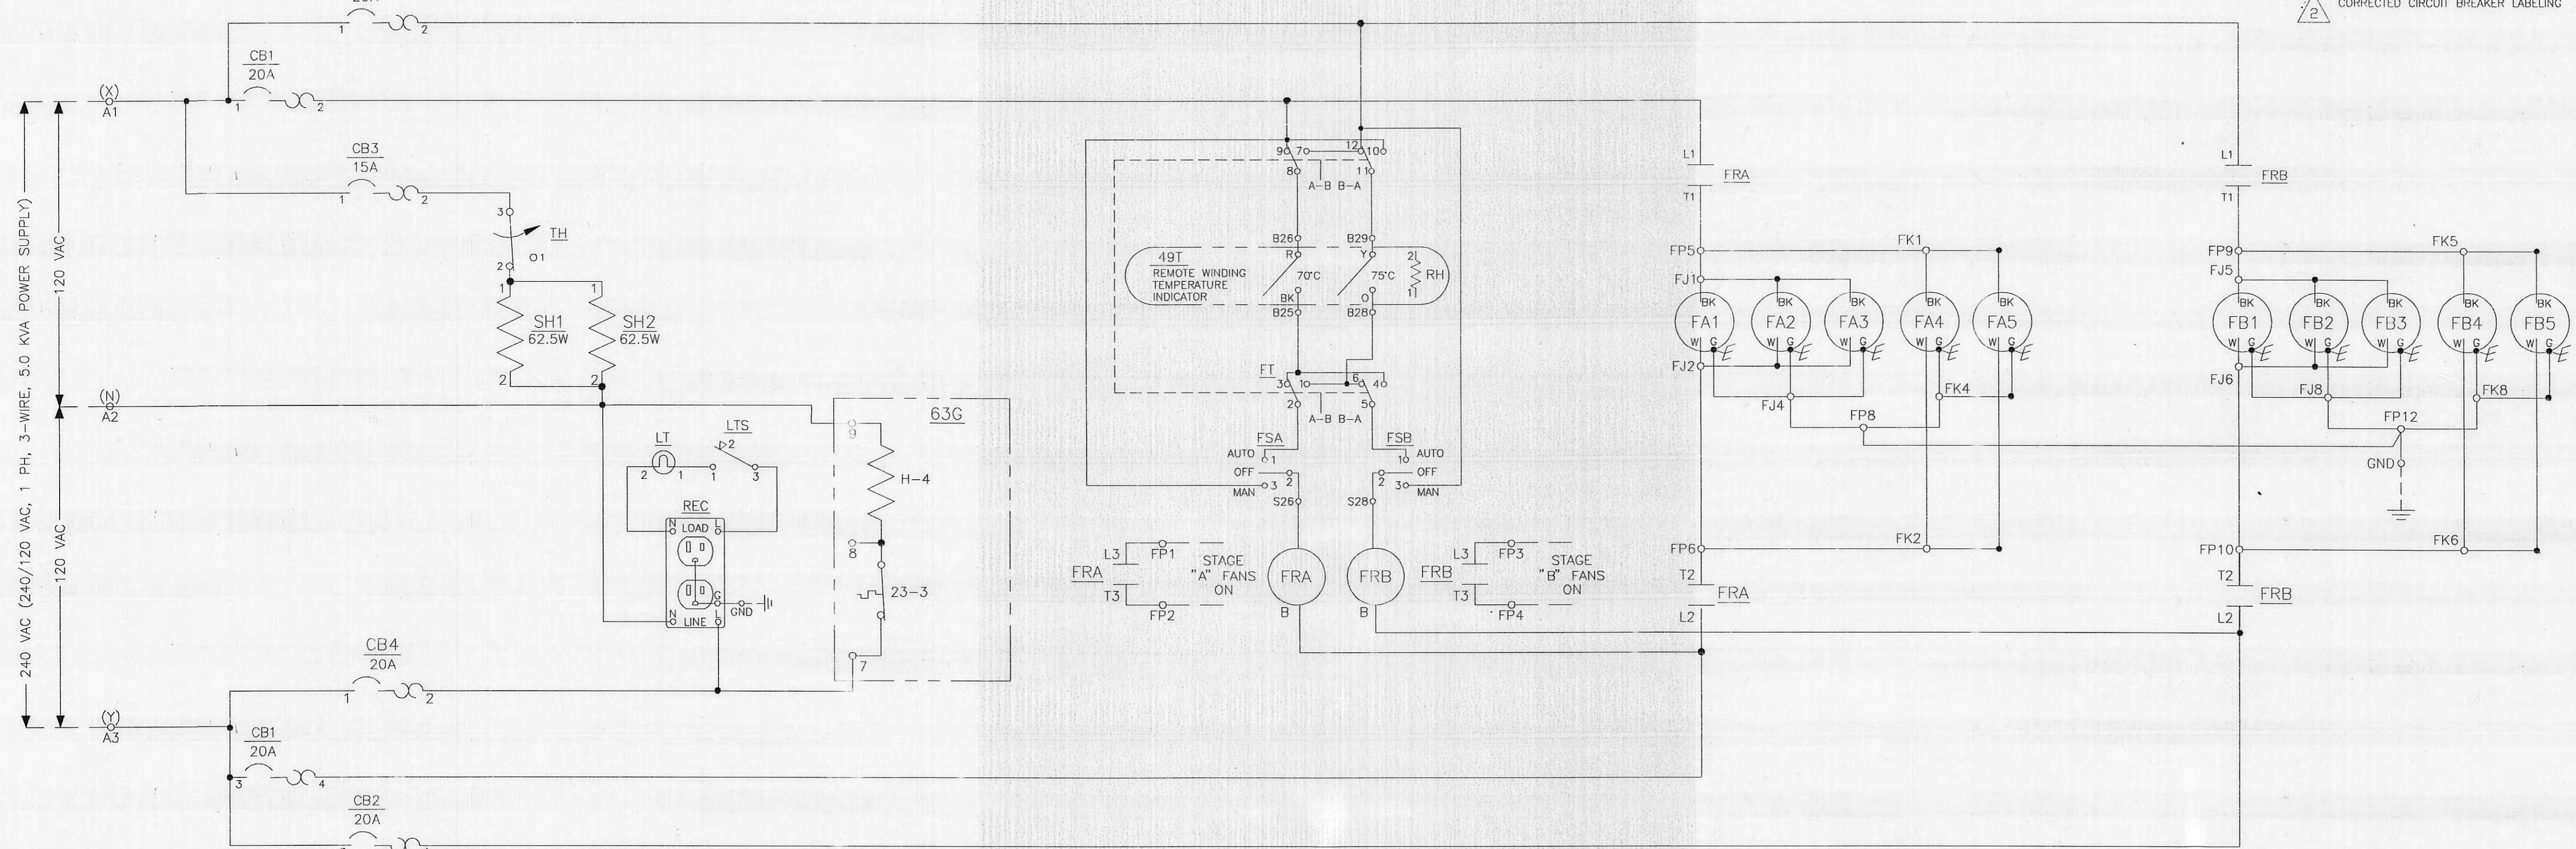


X2 WINDING TEMPERATURE INDICATOR SCHEMATIC  
(ALL CONNECTIONS FACTORY-SET)

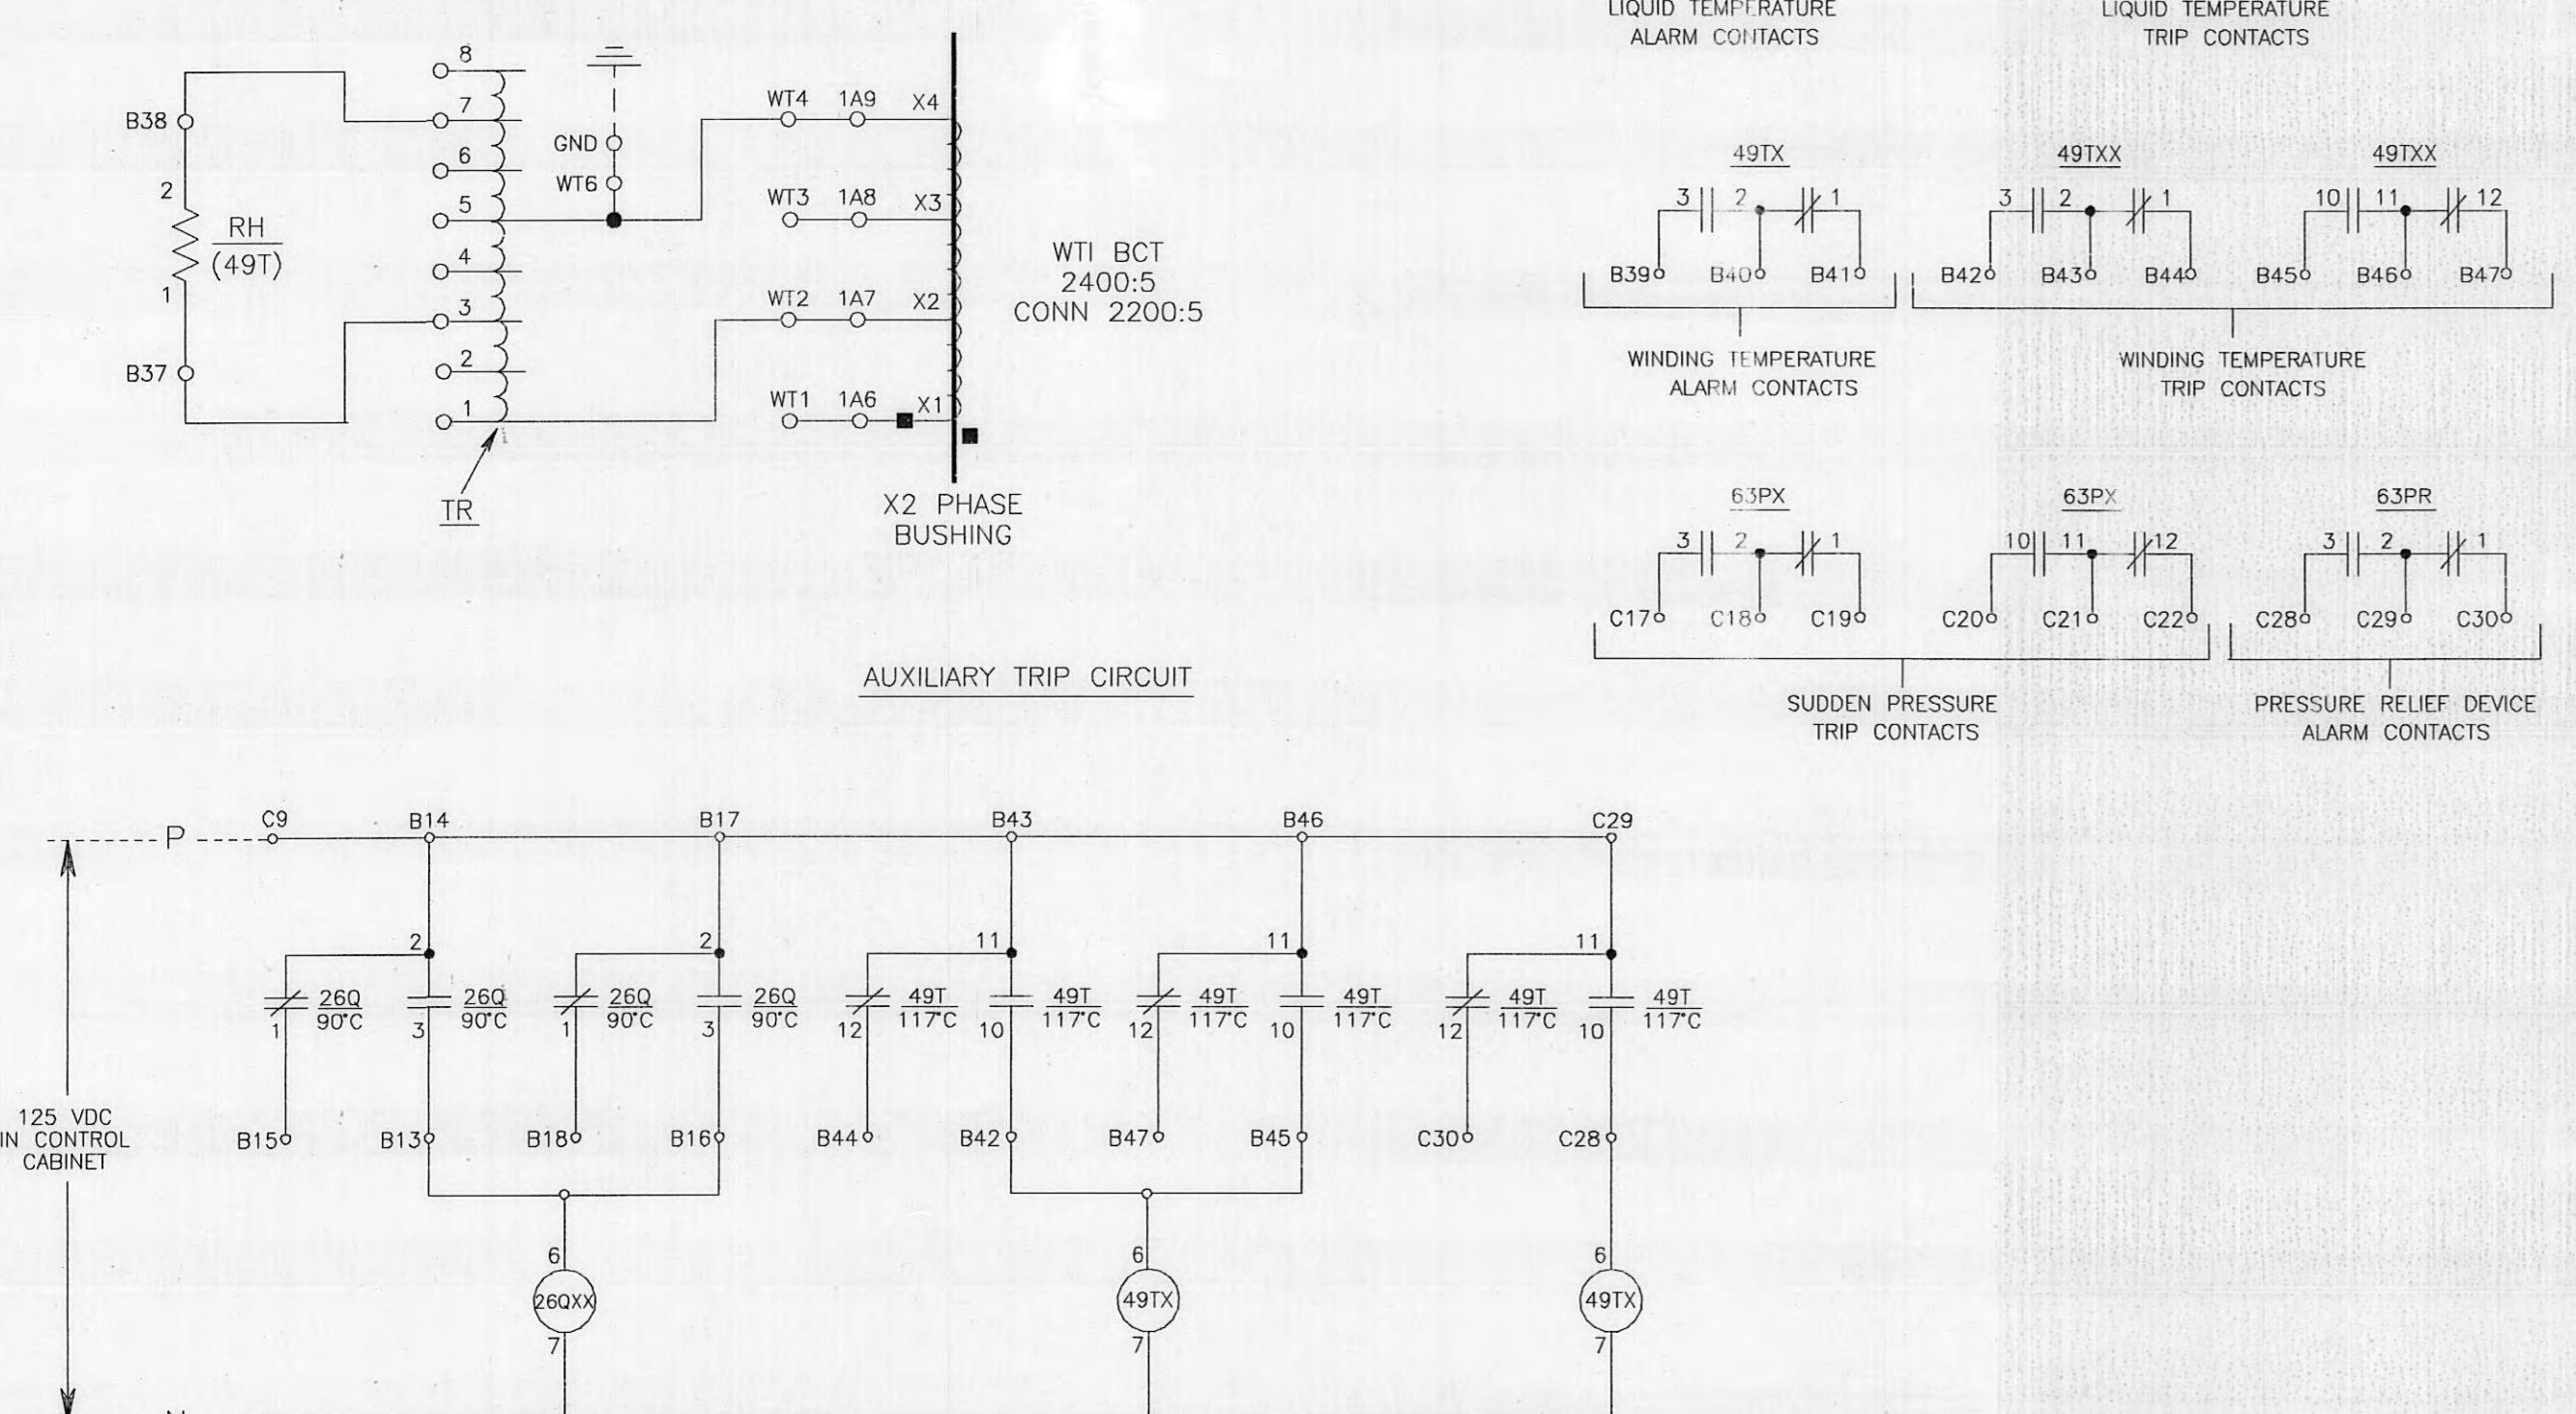

NOTES:  
ALL RELAY CONTACTS SHOWN IN DE-ENERGIZED STATE.  
ALL PRESSURE DEVICES SHOWN AT NORMAL OPERATING PRESSURES.

SUDDEN PRESSURE RELAY SEAL-IN SCHEMATIC

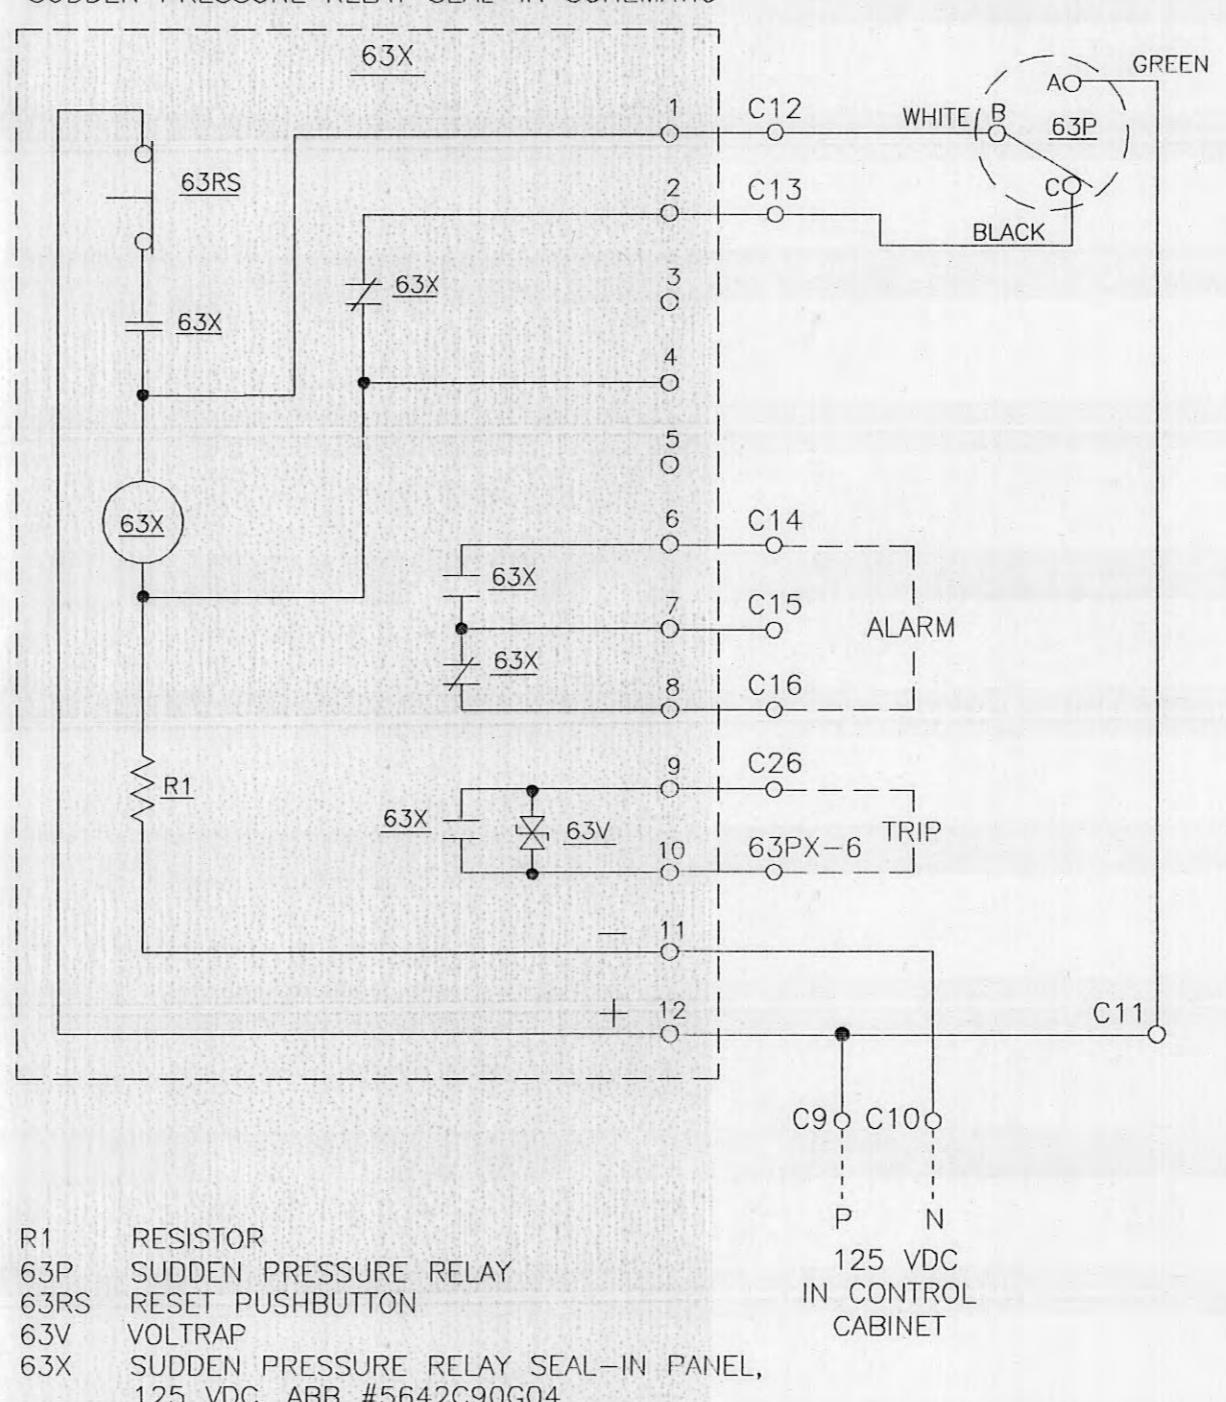

LEGEND:

49T	X2 WINDING TEMPERATURE INDICATOR
63P	NITROGEN SYSTEM
63RS	SUDDEN PRESSURE RELAY
63X	SUDDEN PRESSURE RELAY SEAL-IN PANEL, QUALITROL #909-200-01
CB1	GROUP "A" COOLING FANS CIRCUIT BREAKER, 20 AMP, 120/240 VAC,
CB2	2 POLE, SQ.D #QOU220
CB3	GROUP "B" COOLING FANS CIRCUIT BREAKER, 20 AMP, 120/240 VAC,
FA1-FA5	2 POLE, SQ.D #QOU220
FB1-FB5	CONTROL CABINET HEATER/LIGHT CIRCUIT BREAKER, 15 AMP, 120/240 VAC,
FRA,FRB	1 POLE, SQ.D #QOU115
FSA,FSB	GROUP "A" FANS, 3 EA, 26" DIA., 0.333 HP, 230 VAC, 1140 RPM,
LT	7400 CFM, 1.41 AMP RUN, 4.9 AMP START, KRENZ #F26-A9712-1
LTS	GROUP "B" FANS, 2 EA, 26" DIA., 0.333 HP, 230 VAC, 1140 RPM,
GND	7400 CFM, 1.41 AMP RUN, 4.9 AMP START, KRENZ #F26-A9712-1
RH	GROUPS "A" & "B" FAN CONTACTORS, 40 AMP, 3 POLE, 208-240 VAC,
SH1,2	CLASS 8910, SQ.D #DPA43V09
S1	GROUPS "A" & "B" FAN CONTROL SWITCHES, "MANUAL/OFF/AUTOMATIC", HONEYWELL #4TL1-10
TH	CONTROL CABINET LIGHT (FLUORESCENT)
TR	CONTROL CABINET LIGHT SWITCH (MANUAL)
	REAR PANEL GROUND BUS, 1 X 8 X .25", TIN-PLATED
	HEATING RESISTOR FOR X2 WINDING TEMPERATURE INDICATOR,
	0.1193 ± @ 25°C, WES #TG147641
	ANTI-CONDENSATION HEATERS, 240 VAC, 250 WATT (CONNECTED 120 VAC, 125 WATT)
	RESET PUSHBUTTON ON 63X SEAL-IN PANEL
	TEROSTAT (40-85°F)
	AUTOTRANSFORMER, X2 WTI BCT CURRENT-ADJUSTING, FACTORY-SET

DRAWN	DGW
DATE	10/30/97
APPROVED	MBS
UNLESS OTHERWISE SPECIFIED DIMENSIONS ARE IN INCHES	
SIZE F SCH NO DWG NO	
D	
SCALE	
GS WAUKESHA ELECTRIC SYSTEMS A UNIT OF GENERAL SIGNAL P.O. BOX 268 GOLDSBORO NC 27533	
FAN, WTI & ALARM WIRING SCHEMATIC	
A547436896	

HARRIMAN UTILITY  
NEW HARRIMAN SUBSTATION  
P.O. NO. 12701 (A)  
SERIAL/MFG NO. GM971382  
"FINAL-AS-BUILT"

All information contained herein is confidential and the exclusive property of Waukesha Electric Systems, a division of General Signal Corporation. Access to this information is restricted to employees of Waukesha Electric Systems who have a valid reason to access it. It is the responsibility of the recipient to protect this information and not to disclose it to anyone outside Waukesha Electric Systems, and to return it to Waukesha Electric Systems, or destroy it, upon request of Waukesha Electric Systems.

Copyright © 1995, Waukesha Electric Systems, a division of General Signal Corporation.

## NOTES:


- 1- CONTROL WIRING #14 AWG, 600 VOLT, TYPE SIS (W-1).
- 2- BCT WIRING #10 AWG, 600 VOLT, TYPE SIS (W-1).
- 3- POWER WIRING FROM FANS TO TERMINAL BLOCK FP ON CONTROL CABINET REAR PANEL #12 AWG, 600 VOLT, TYPE SIS (W-1).
- 4- ALL WIRING INSIDE CONTROL CABINETS AND LUGGED WIRES INSIDE JUNCTION BOXES TO BE LABELED AT BOTH ENDS WITH OPPOSITE END DESIGNATIONS.

REV		DESCRIPTION		DATE	APPROVED
1		CORRECTED PRD CONNECTIONS		1/20/98	DGW
2		CORRECTED FAN CONNECTIONS		1/26/98	DGW

D


TERMINAL BOXES AND FANS LOCATED ON REAR RADIATOR BANK

SHOP NOTE: FOR AN EXAMPLE OF DETAILED FAN WIRING SEE UO-114-022 (SHEET 8).

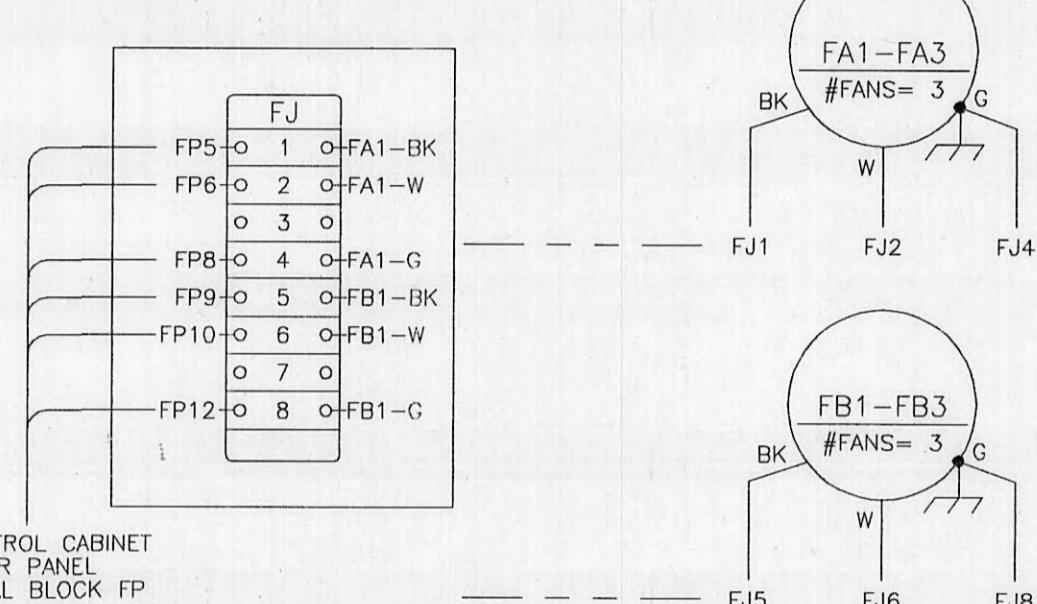
TO CONTROL CABINET  
REAR PANEL  
TERMINAL BLOCK FP

TERMINAL BOX AND FANS LOCATED ON SIDE RADIATOR BANK

SHOP NOTE: FOR AN EXAMPLE OF DETAILED FAN WIRING SEE UO-114-022 (SHEET 8).

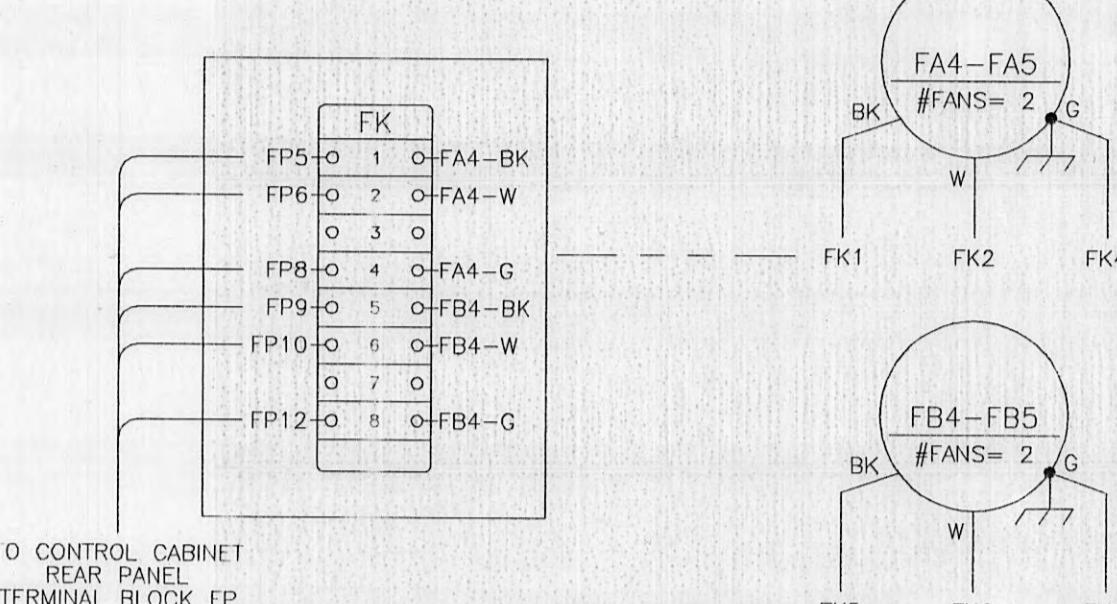TO CONTROL CABINET  
REAR PANEL  
TERMINAL BLOCK FP

DEVICES LOCATED ON MAIN CONTROL CABINET WALL

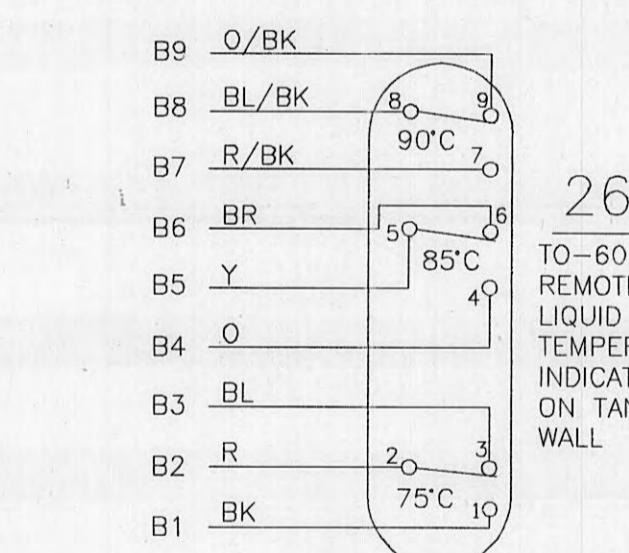

26Q

TO -602-438A  
REMOTE  
LIQUID  
TEMPERATURE  
INDICATOR  
ON TANK  
WALL

63P

AR# #8524A42C03  
SWITCH  
JUDGEN  
PRESSURE  
RELAY  
ON TOP  
COVER

71Q

QUALITROL  
#032-50-01  
LIQUID LEVEL  
GAUGE ON  
MAIN TANK WALL


63PR

QUALITROL  
#208-009-01  
PRESSURE RELIEF  
DEVICE ON  
TANK WALLTO CONTROL CABINET  
REAR PANEL  
TERMINAL BLOCK B & C

B

A

DEVICES EXTERNAL TO MAIN CONTROL CABINET

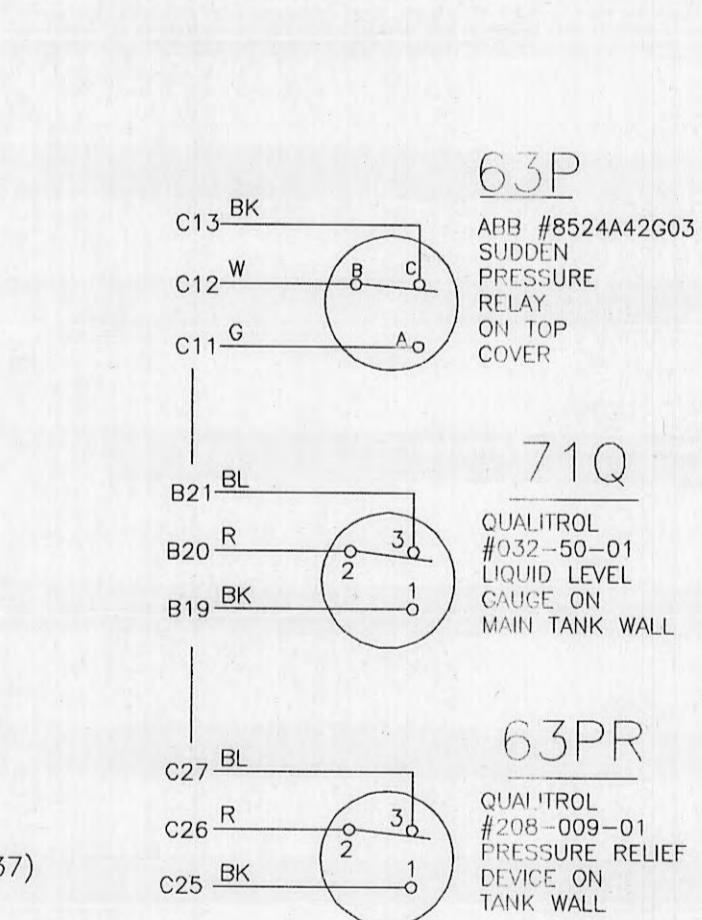

49T

QUALITROL  
#104-224-01(CS-11737)REMOTE  
LV WINDING  
TEMPERATURE  
INDICATOR  
ON TANK  
WALL

63P

AR# #8524A42C03  
SWITCH  
JUDGEN  
PRESSURE  
RELAY  
ON TOP  
COVER

71Q



QUALITROL  
#032-50-01  
LIQUID LEVEL  
GAUGE ON  
MAIN TANK WALL

63PR

QUALITROL  
#208-009-01  
PRESSURE RELIEF  
DEVICE ON  
TANK WALL


C

BUSHING CURRENT TRANSFORMERS LOCATED INSIDE TANK

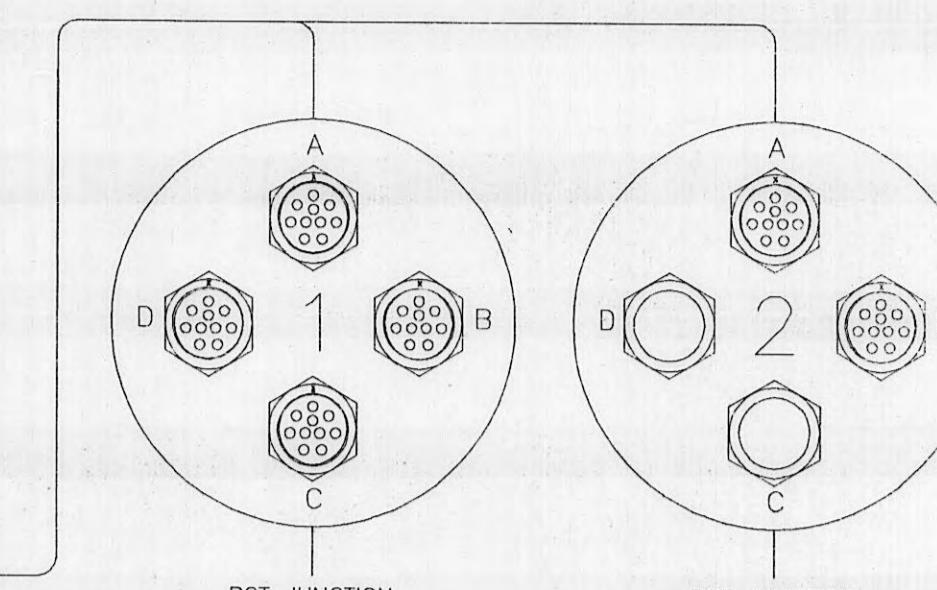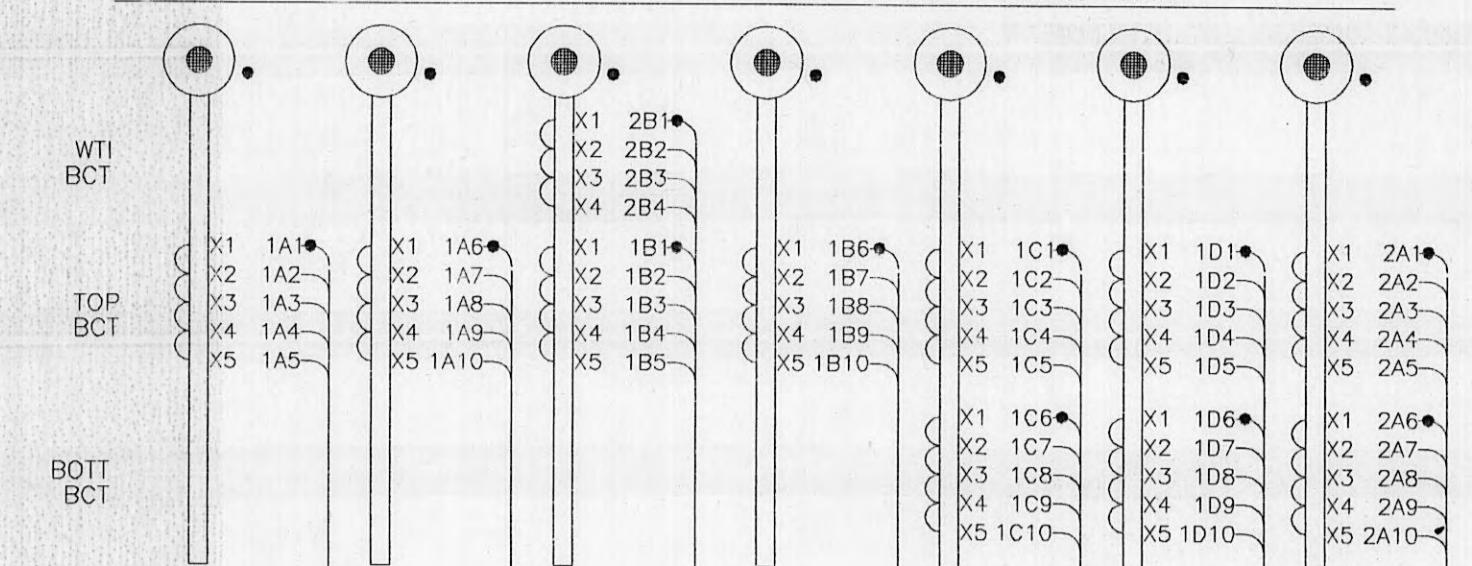BCT JUNCTION  
BLOCK CONNECTION  
ON TANK SIDEWALLBCT JUNCTION  
BLOCK CONNECTION  
ON TANK SIDEWALLTO CONTROL CABINET  
REAR PANEL  
TERMINAL BLOCKS D, E, F, G & WT

WTI MAX RATIO WTI CONN RATIO WTI CLASS	2400:5(WTI) 2200:5(X2-X4) C50
TOP RATIO TOP CLASS	2000:5 C400
BOTT RATIO BOTT CLASS	2000:5 C400
600:5 C400	600:5 C400
600:5 C400	600:5 C400

WTI MAX RATIO WTI CONN RATIO WTI CLASS	2400:5(WTI) 2200:5(X2-X4) C50
TOP RATIO TOP CLASS	2000:5 C400
BOTT RATIO BOTT CLASS	2000:5 C400
600:5 C400	600:5 C400
600:5 C400	600:5 C400

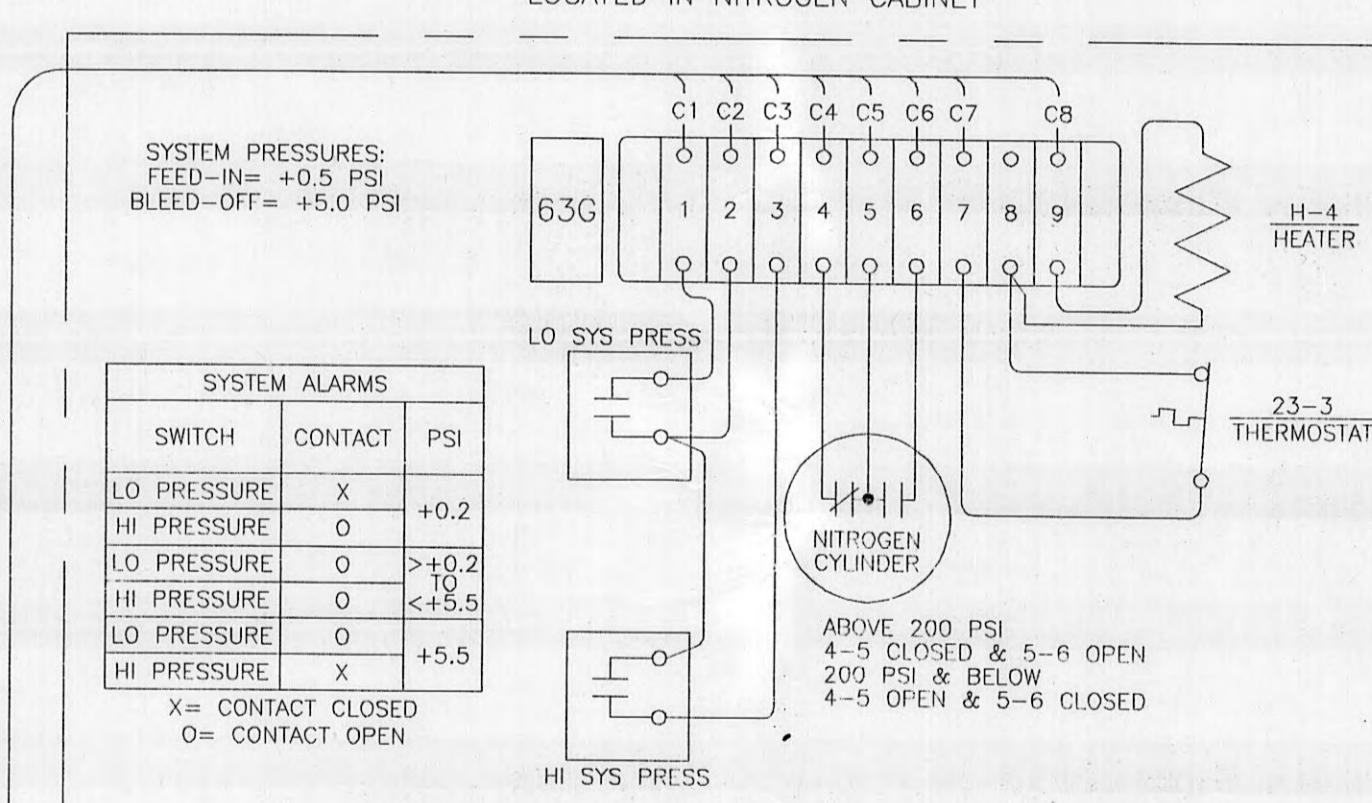NITROGEN SYSTEM  
LOCATED IN NITROGEN CABINET

3 ABOVE SWITCHES SHOWN AT NORMAL OPERATING PRESSURES

TO CONTROL CABINET  
REAR PANEL  
TERMINAL BLOCK C

DRAWN	DGW
DATE	9/23/97
APPROVED	MBS

GS WAUKEEHA ELECTRIC SYSTEMS  
A UNIT OF GENERAL SIGNAL  
P.O. BOX 260 GOLDSBORO NC 27533

UNLESS OTHERWISE SPECIFIED  
DIMENSIONS ARE IN INCHES

HARRIMAN UTILITY  
NEW HARRIMAN SUBSTATION  
P.O. NO. 12701 (B)  
SERIAL/MFG NO. GM971383  
"FINAL AS-BUILT"

BCT/EXT. DEVICE  
WIRING DIAGRAM

A547436894

SIZE	FSM NO	DWG NO
D		
SCALE		SHEET

All information contained herein is confidential and the exclusive property of Waukesha Electric Systems, Inc. It is to be used only by those employees or contractors who have a legitimate business need to know its contents. It is to be treated as a trade secret and is not to be disclosed to anyone outside the company without the express written consent of Waukesha Electric Systems, Inc. Any unauthorized disclosure or use of this information is a violation of law and will result in the criminal prosecution of the individual and/or the organization employing him/her. This drawing is the property of Waukesha Electric Systems, Inc. It is to be returned to Waukesha Electric Systems, Inc. upon completion of its purpose. It is to be handled and stored in accordance with Waukesha Electric Systems, Inc. procedures.

Copyright © 1993, Waukesha Electric Systems, a division of General Signal Corporation.

CJ


8 | 7 | 6 | 5 ↓ 4 | 3 | 2 | 1

REVISIONS			
REV	DESCRIPTION	DATE	APPROVED
1	CORRECTED SPR CONNECTIONS	1/20/98	DGW

NOTES: CORRECTED FAN CONNECTIONS 1/26/97 DGW

2

1- CONTROL WIRE #14 AWG, 600V, 90°C, TYPE SIS (VW-1)  
2- BCT WIRE #10 AWG, 600V, 90°C, TYPE SIS (VW-1)  
3- POWER WIRING TO ALL CIRCUIT BREAKERS #8 AWG, 600V, 90°C, TYPE SIS (VW-1).  
4- WIRING TO HEATER TERMINALS #12 AWG, 600V, 150°C, TYPE FEP TEFILON.  
5- CONTROL TERMINAL BLOCKS 30 AMP, 600V, MARATHON SERIES 300.  
6- BCT TERMINAL BLOCKS 30 AMP, 600V, MARATHON SERIES 1600SC.  
7- POWER TERMINAL BLOCK 175 AMP, 600V, MARATHON SERIES 140.  
8- BCT TEST BLOCKS 10 AMP, 250V, 4 POLE, GENERAL ELECTRIC TYPE PK-2.  
9- LABEL ALL TERMINAL WIRES PER "OPPOSITE-END" DESIGNATION.  
10- ALL LUGS ARE NON-INSULATED, AMP SOLISTRAND, RING-TYPE. CRIMP #10-12 AWG LUGS, & BUTT SPLICES, WITH AMP #49935-Y TOOL. CRIMP #8 AWG LUGS, & BUTT SPLICES, WITH AMP #69355 TOOL.

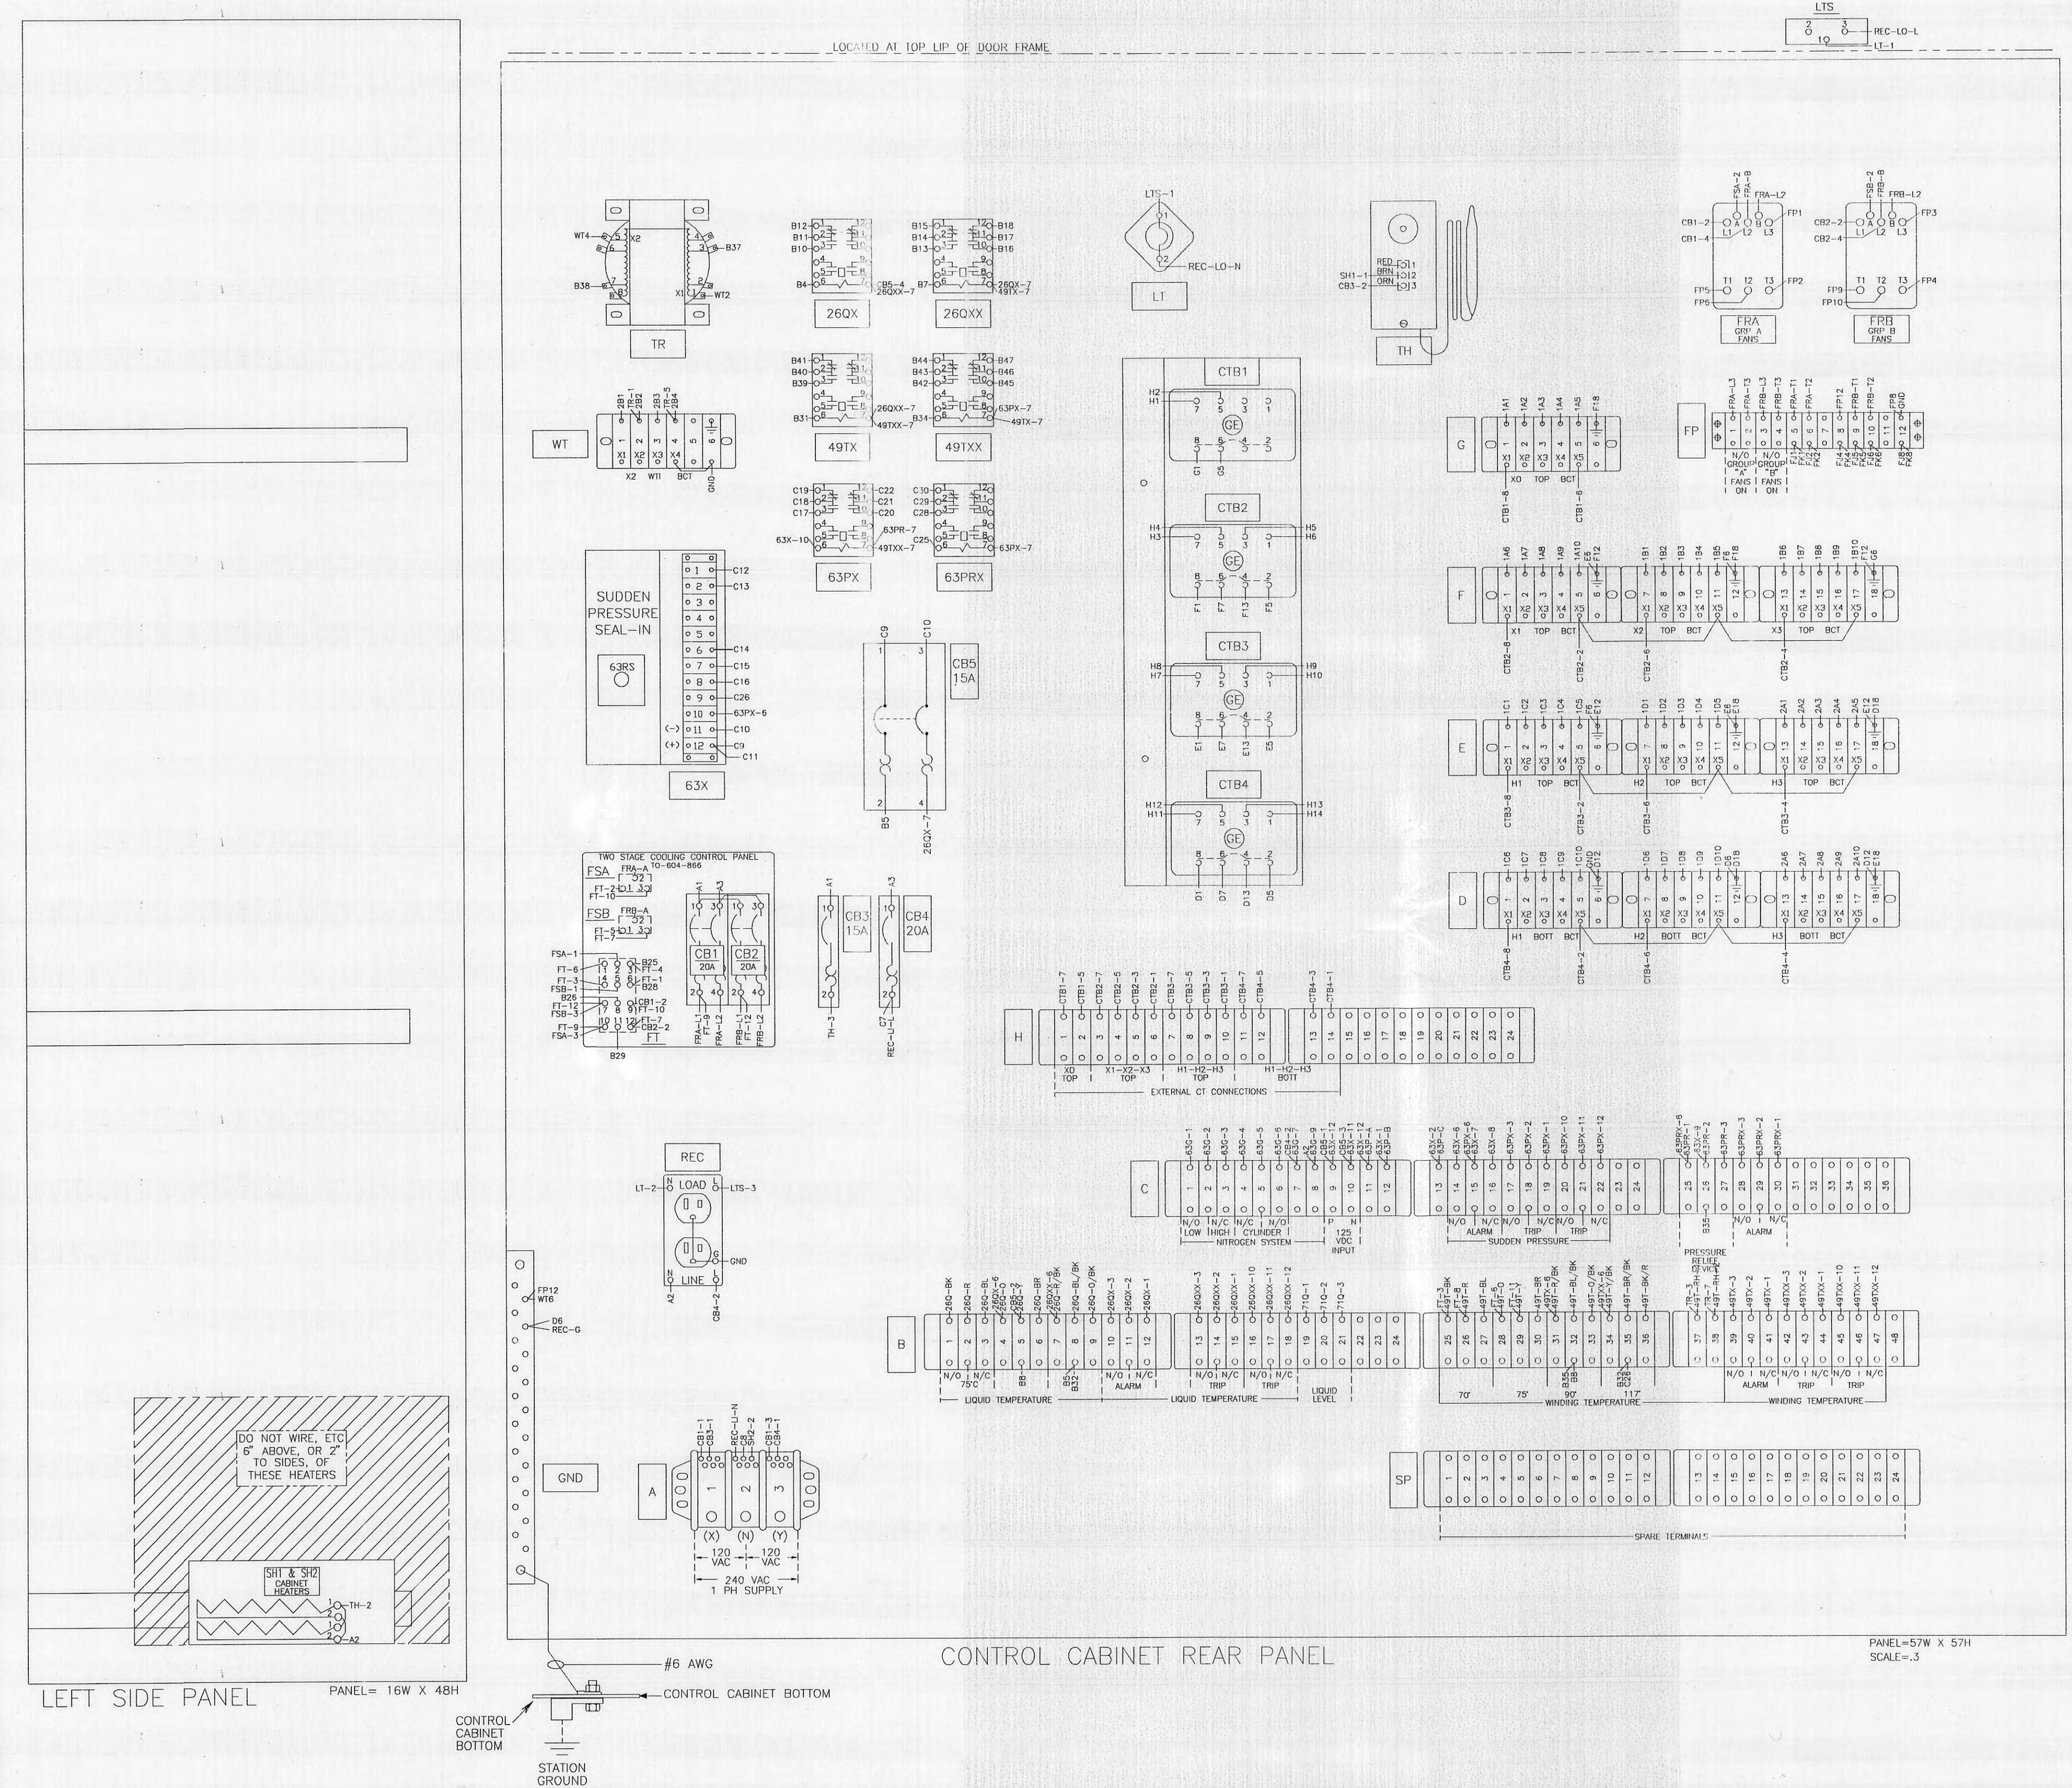


All information contained herein is confidential and the exclusive property of Waukesha Electric Systems, a division of General Signal Corporation. Recipient agrees (1) not to disclose any of such information to others; (2) not to reproduce this document in whole or in part except as required for the internal evaluation of this proposal or the resubmission of this document to Waukesha Electric Systems; (3) to use such information only as directed by Waukesha Electric Systems, and (4) upon request, to return all copies of this document to Waukesha Electric Systems.

MAN UTILITY  
HARRIMAN SUBSTATION  
O. 12701 (B)  
L/MFG NO. GM971383  
AS BUILT

AUKESHA ELECTRIC SYSTEMS  
A UNIT OF GENERAL SIGNAL  
P.O. BOX 268 GOLDSBORO NC 27533

# CONTROL CABINET WIRING DIAGRAM

DWG NO	A547436895	SHEET
--------	------------	-------

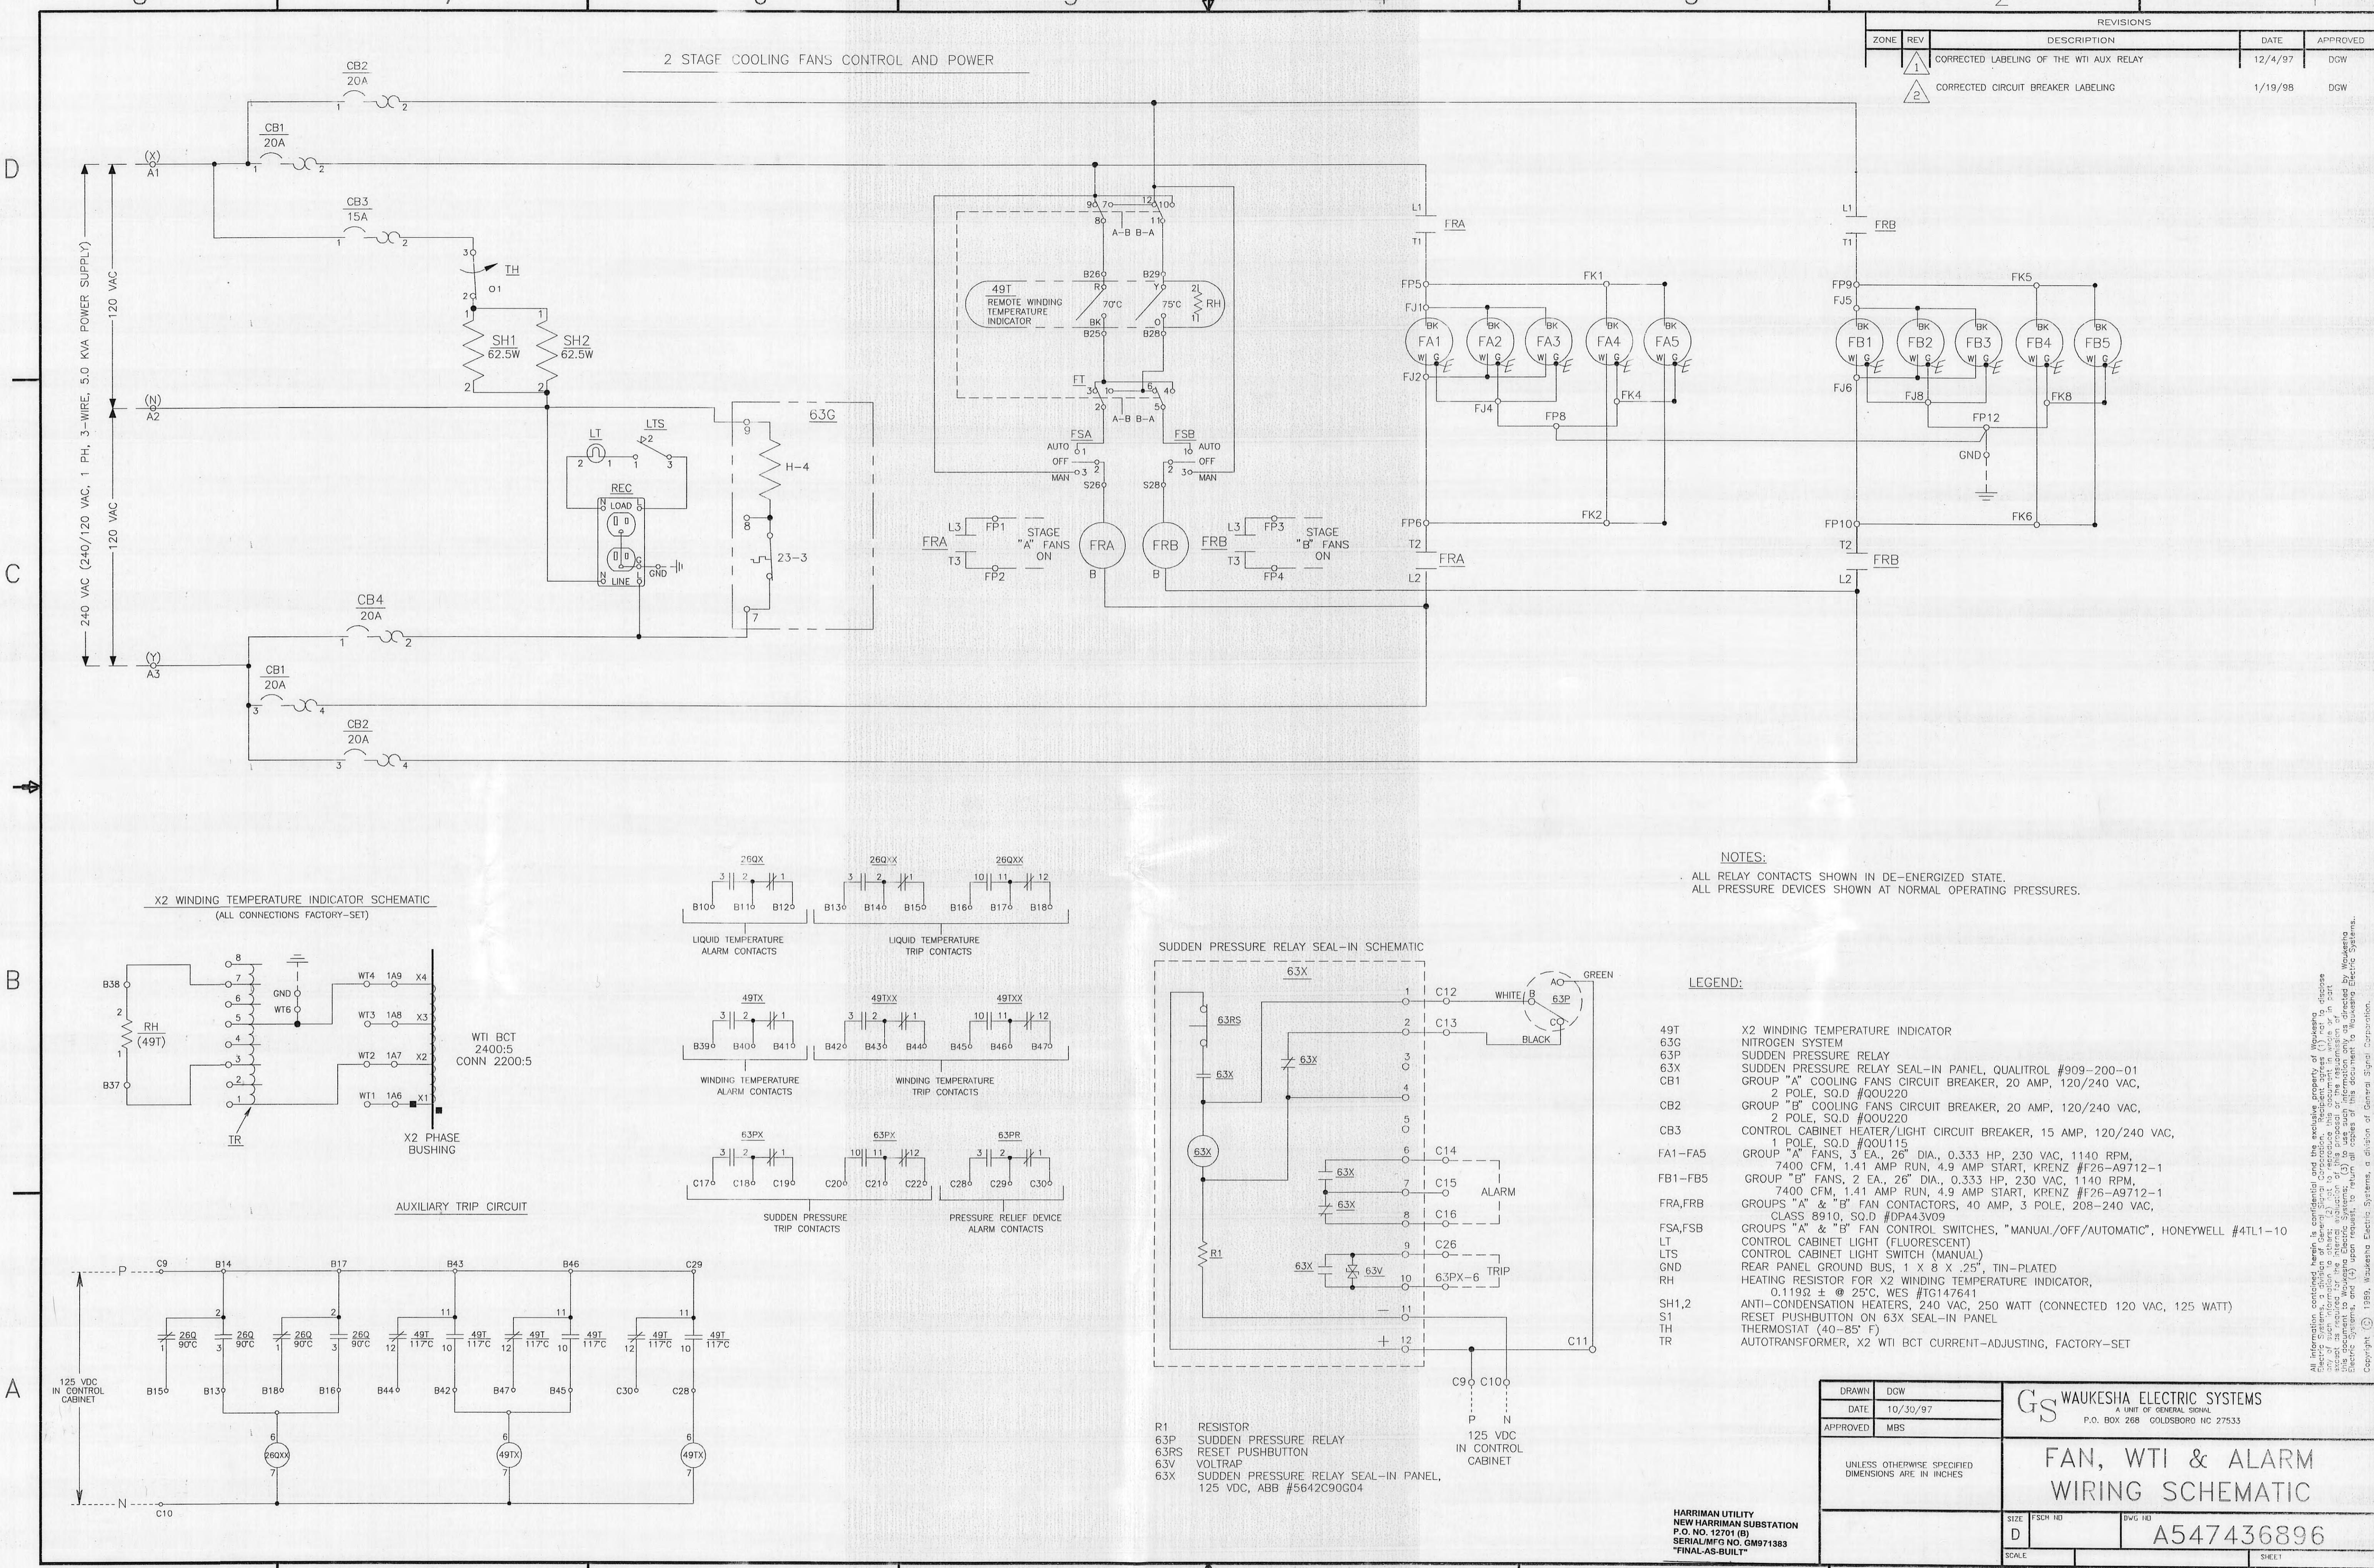

All information contained herein is confidential and the exclusive property of Waukesha Electric Systems, a division of General Signal Corporation. Recipient agrees (1) not to disclose any of such information to others; (2) not to reproduce this document in whole or in part except as required for the internal evaluation of this proposal or the resubmission of this document to Waukesha Electric Systems; (3) to use such information only as directed by Waukesha Electric Systems, and (4) upon request, to return all copies of this document to Waukesha Electric Systems.