


CONSTRUCTION PLANS
FOR
WATER SYSTEM IMPROVEMENTS
FOR
HARRIMAN UTILITIES BOARD
HARRIMAN, TENNESSEE

CONTRACT W00-01
PINE RIDGE ROAD
WATER LINE RELOCATION


JULY, 2000

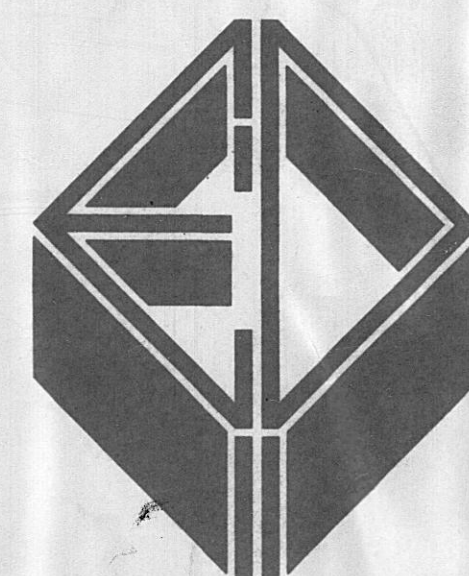

ELROD · DUNSON, INC.
CONSULTING ENGINEERS


Nashville · Knoxville
Bowling Green, Ky.

" AS BUILT "

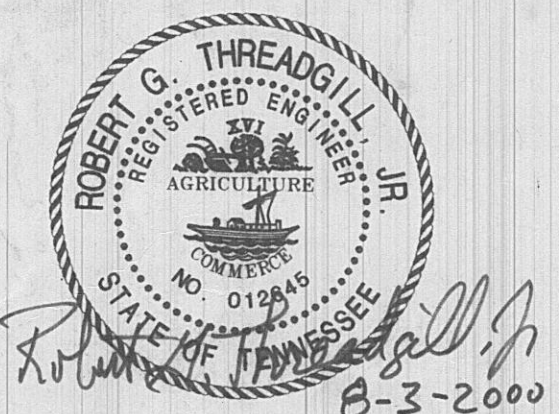


Accepted By: Richard G. Bell
Title: General Manager
For: Harriman Utility Board
Date: August 3, 2000

PROJECT NO. 0700
SET NO.

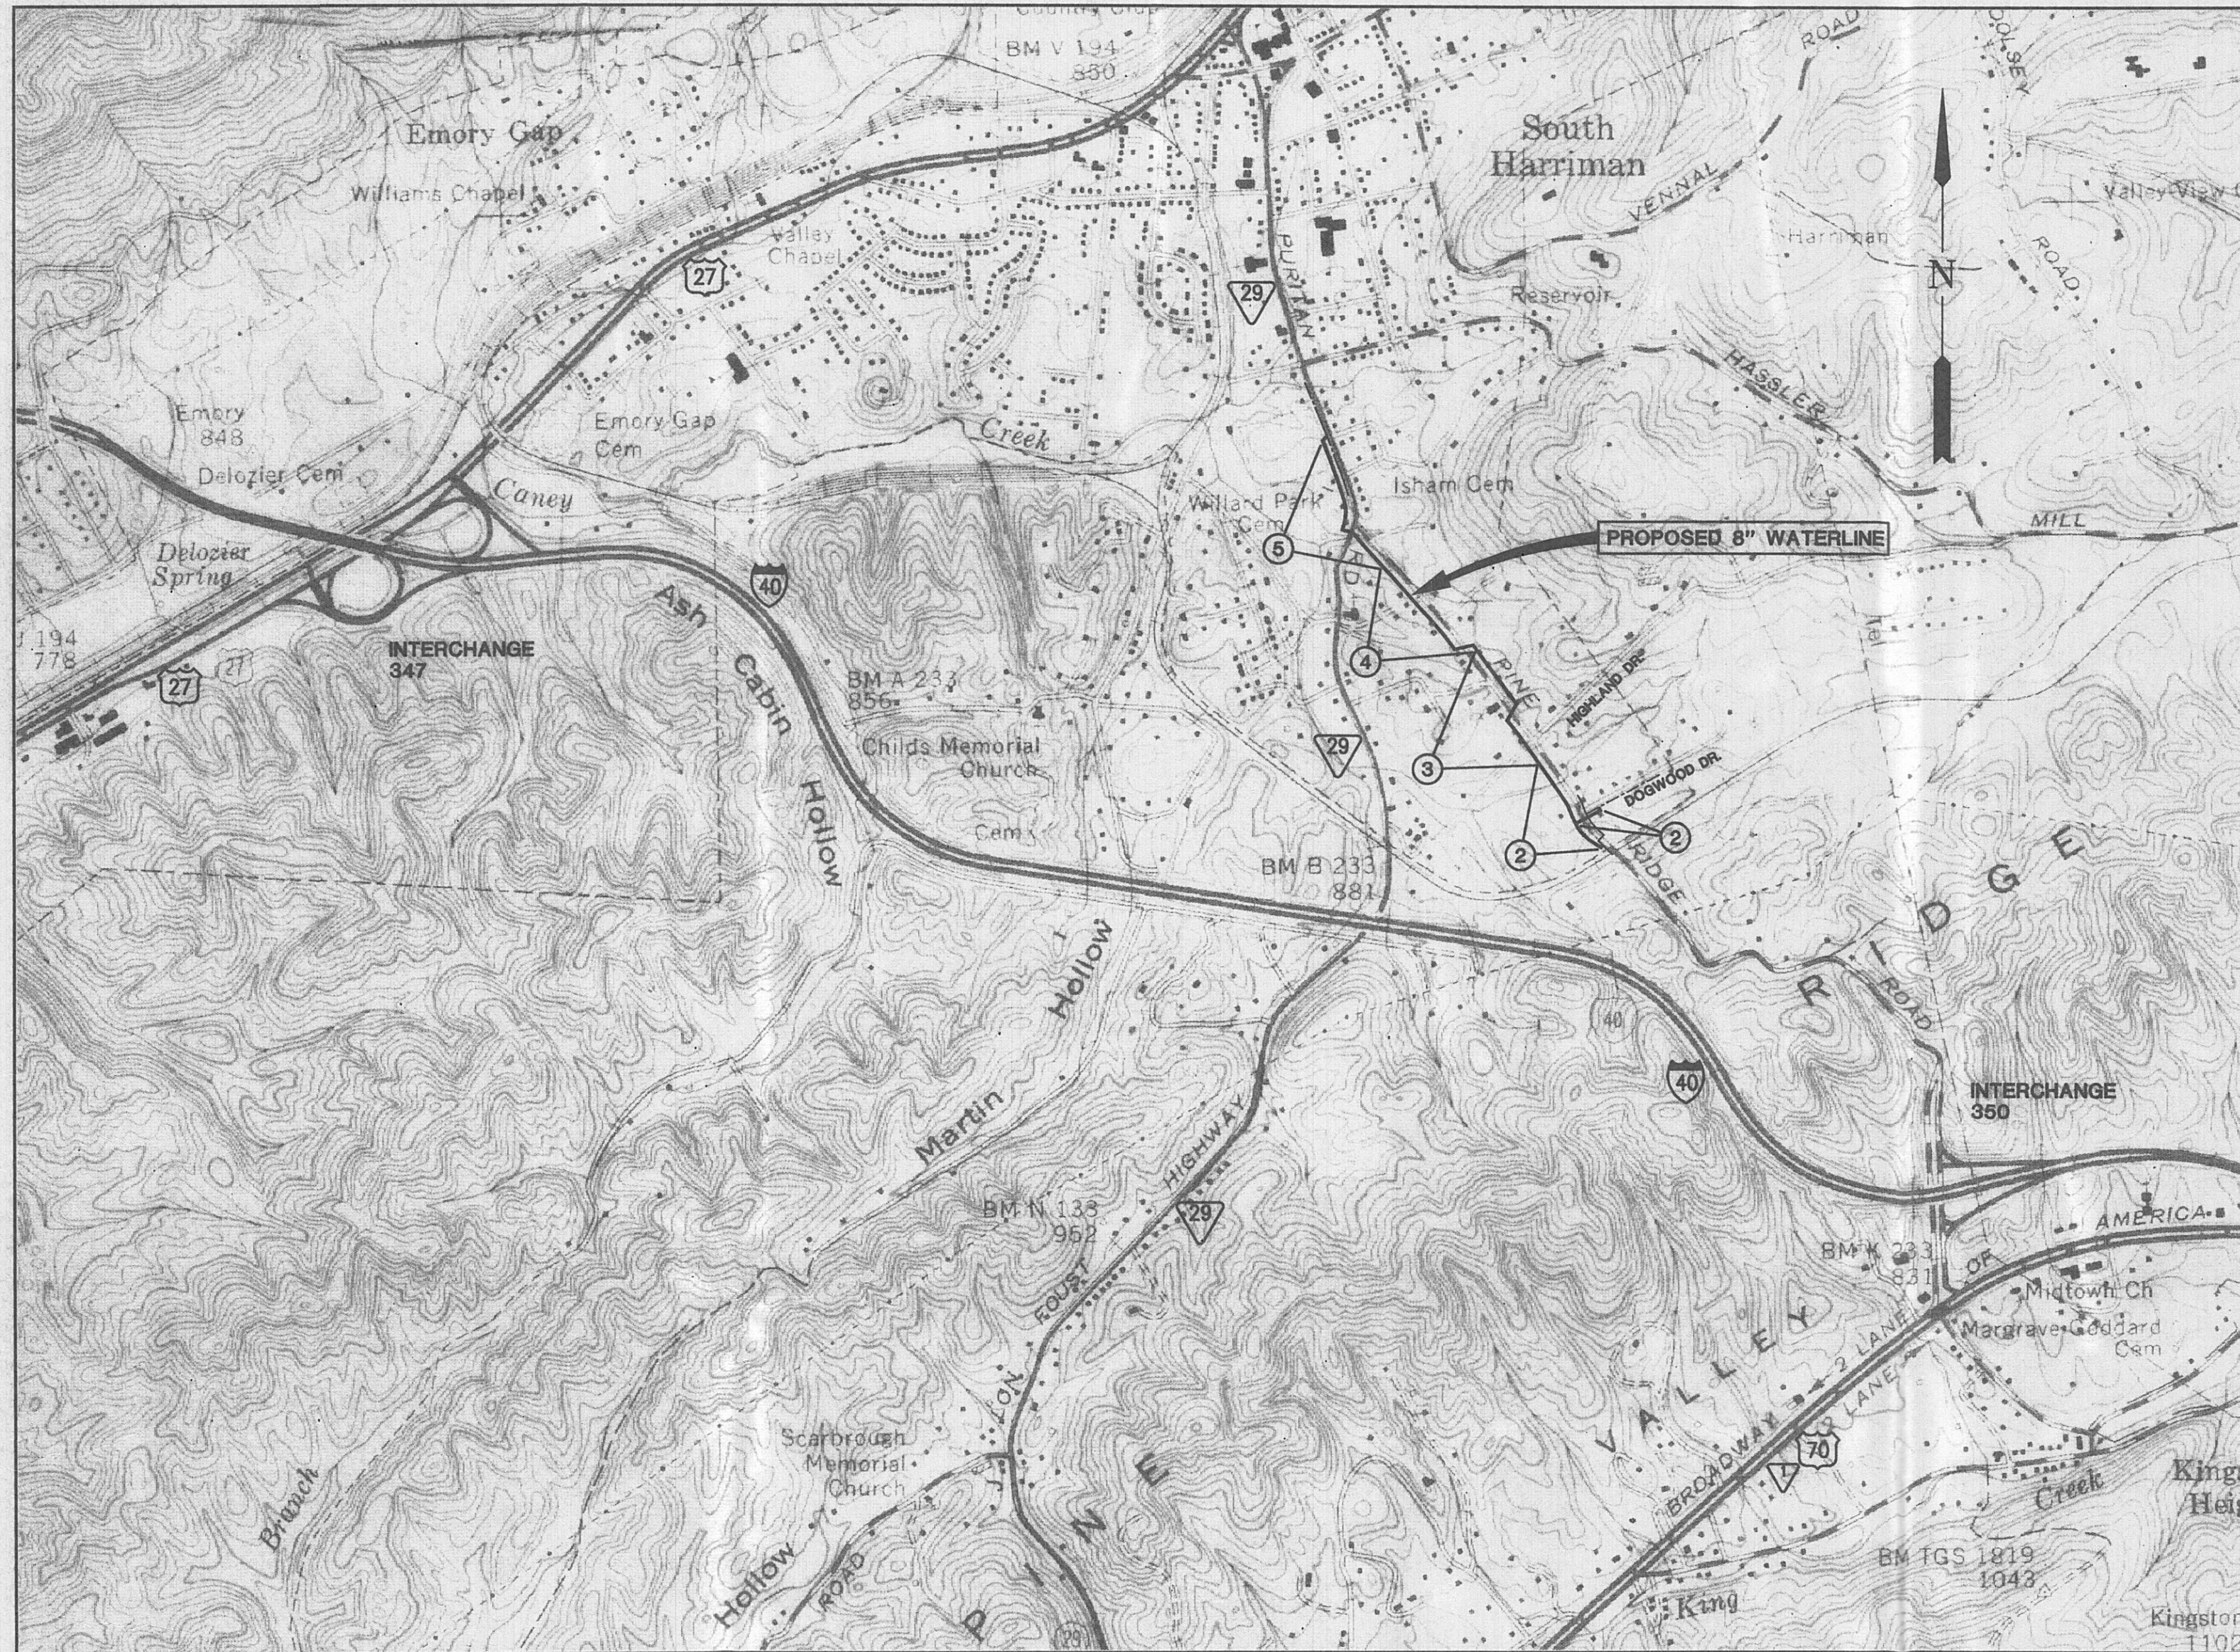

PROJECT LOCATION MAP
SCALE: 1"=1000'

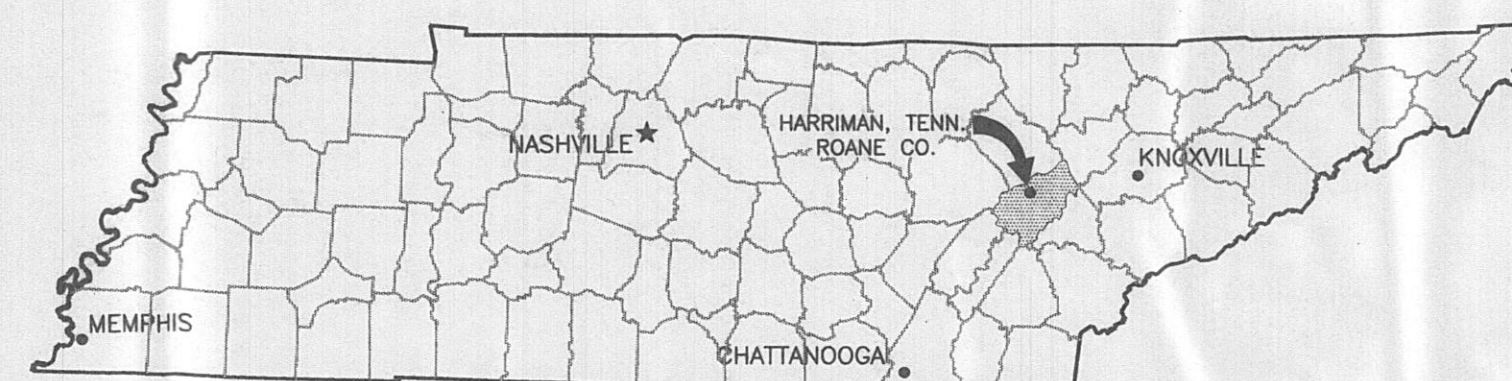



TENNESSEE VICINITY MAP
NOT TO SCALE

INDEX OF SHEETS

<u>SHEET</u>	<u>DESCRIPTION</u>
1	LEGEND, INDEX OF SHEETS, VICINITY MAP, PROJECT LOCATION MAP
2	8" D.I. - PINE RIDGE RD. - STA. 0+000 (0+00) TO STA. 0+253 (8+30) 6" D.I. - DOGWOOD DR. - STA. 0+000 (0+00) TO STA. 0+050 (1+64) E.O.L.
3	8" D.I. - PINE RIDGE RD. - STA. 0+253 (8+30) TO STA. 0+578 (18+96)
4	8" D.I. - PINE RIDGE RD. - STA. 0+578 (18+96) TO STA. 0+882 (28+94)
5	8" D.I. - PINE RIDGE RD. - STA. 0+882 (28+97) TO STA. 1+000 (32+81) E.O.L. 8" D.I. - PURITAN RD. (S.R. 29) STA. 0+000 (0+00) TO STA. 0+187 (6+14) E.O.L.
6	STANDARD WATER LINE CONSTRUCTION DETAILS

LEGEND

EXISTING	NEW	
SA		CASING PIPE
6"W		SEWER LINE & MANHOLE
		WATER LINE
		WATER LINE VALVE
		PLUG
WM		WATER METER
FP		FIRE HYDRANT
G		GAS LINE
GM		GAS METER
OHE		OVERHEAD ELECTRICAL LINE
P/T		POWER POLE
		HEADWALL OR INLET WALL
		CREEK OR DITCH
		CULVERT PIPE
		FENCE ROW
		PROPERTY LINE
		EDGE OF HEAVY FOLIAGE
		TREE
		SHRUB
		SIGN

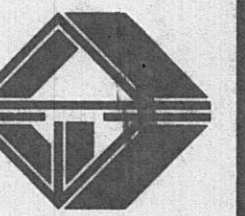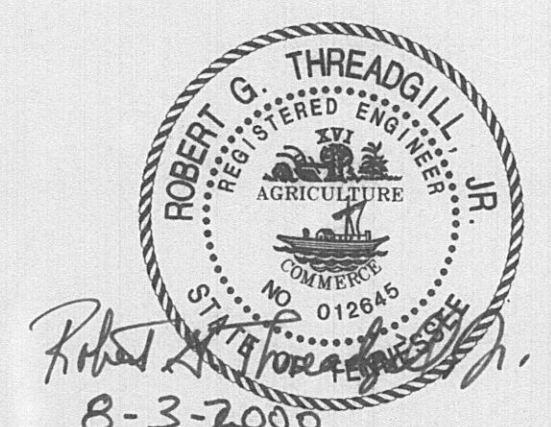



- NOTES TO CONTRACTOR**
1. ALL EXISTING UNDERGROUND UTILITIES SUCH AS WATER, SEWER, GAS, ELECTRIC, TELEPHONE AND T.V. CABLE MUST BE FIELD LOCATED AND MARKED BY UTILITY COMPANY BEFORE CONSTRUCTION BEGINS.
 2. CONTRACTOR SHALL INSTALL NEW WATER METERS WHERE SHOWN ON PLANS. UNUSED WATER METERS SHALL BE REMOVED AND RETURNED TO OWNER AFTER NEW WATER LINE IS IN SERVICE.
 3. NEW WATER LINE SHALL BE LAID WITH 0.76m (30") COVER EXCEPT WHERE EXTRA COVER IS SHOWN ON PLANS.
 4. CONTRACTOR SHALL CONNECT EXISTING WATER METERS TO NEW WATER LINE AFTER NEW WATER LINE IS IN SERVICE.
 5. RAISE OR LOWER TOP OF MANHOLE BY ADDING OR REMOVING GRADE RINGS AND/OR M.H. BARRELS AS REQUIRED.

BEGIN BASELINE (B) AT CENTER OF TRACKS AND MEASURE ALONG WEST EDGE OF PAVEMENT FOR APPROX. 1000 METERS (3,281 FEET)

NEW WATER LINE LOCATION SCHEDULE				
DIMENSION MARK	BASELINE STA. ALONG WEST EDGE OF ROAD		DISTANCE FROM EDGE OF ROAD	
	METRIC	ENGLISH	METRIC	ENGLISH
A	22.0m	72.2'	7.0m	23.0'
B	41.5m	136.2'	11.9m	39.0'
C	61.7m	202.4'	14.9m	48.9'
D	82.9m	272.0'	13.6m	44.6'
E	117.7m	386.2'	7.1m	23.3'
F	123.2m	404.2'	7.7m	25.3'
G	128.6m	421.9'	8.4m	27.6'
H	209.0m	685.7'	8.6m	28.2'
I	214.0m	702.1'	5.5m	18.0'
J	220.8m	724.4'	2.2m	7.2'
K	243.3m	798.2'	2.0m	6.6'

ELROD · DUNSON, INC.
CONSULTING ENGINEERS
NASHVILLE · KNOXVILLE
BOWLING GREEN

CONTRACT W00-01

HARRIMAN, TENNESSEE

8" D.I. - PINE RIDGE RD. - STA. 0+000 (0+00) TO STA. 0+253 (8+30)
6" D.I. - DOGWOOD DR. STA. 0+000 (0+00) TO STA. 0+050 (1+64) E.O.L.

REVISIONS

DESIGNED: R.G.T.
DRAWN: S.C.G.
CHECKED: R.G.T.
DATE: JULY, 2000
SCALE: 1:500
PROJ. NO. 0700

SHEET 2
OF 6

METRIC

ROBERT G. THREADGILL
REGISTERED ENGINEER
AGRICULTURE
NO. 012849
STATE OF TENNESSEE


8-3-2000



- NOTES TO CONTRACTOR**
1. ALL EXISTING UNDERGROUND UTILITIES SUCH AS WATER, SEWER, GAS, ELECTRIC, TELEPHONE AND T.V. CABLE MUST BE FIELD LOCATED AND MARKED BY UTILITY COMPANY BEFORE CONSTRUCTION BEGINS.
 2. CONTRACTOR SHALL INSTALL NEW WATER METERS WHERE SHOWN ON PLANS. UNUSED WATER METERS SHALL BE REMOVED AND RETURNED TO OWNER AFTER NEW WATER LINE IS IN SERVICE.
 3. NEW WATER LINE SHALL BE LAID WITH 0.76m (30") COVER EXCEPT WHERE EXTRA COVER IS SHOWN ON PLANS.
 4. CONTRACTOR SHALL CONNECT EXISTING WATER METERS TO NEW WATER LINE AFTER NEW WATER LINE IS IN SERVICE.

RELOCATE EXISTING FIRE HYDRANT
INSTALL:
1- 200mm x 150mm (8"x6") TEE
1- 150mm (6") GATE VALVE ASSEMBLY

NEW WATER LINE LOCATION SCHEDULE					
DIMENSION MARK	BASELINE STA. ALONG WEST EDGE OF ROAD		DISTANCE FROM EDGE OF ROAD		
	METRIC	ENGLISH	METRIC	ENGLISH	
A	288.0m	944.9'	2.0m	6.6'	
B	329.0m	1079.4'	2.0m	6.6'	
C	343.3m	1126.3'	1.2m	3.9'	
D	395.0m	1295.9'	2.2m	7.2'	
E	422.1m	1384.8'	7.4m	24.3'	
F	501.3m	1644.7'	7.5m	24.6'	
G	558.0m	1830.7'	7.4m	24.3'	

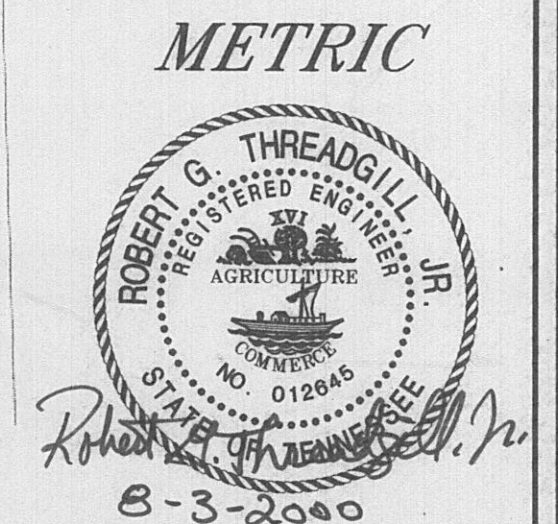

EXISTING M.H.
TOP=268.624m
INV.=264.874m

MATCH LINE W.L. STA. 0+578 (18+96) SEE SHEET 3

RICHARD WAYNE
BARNETT,
et ux
(33)

WILMA
FINK
(18)

JOSEPH W.
MORRIS,
et ux
(19)

RAYMOND
JAMES,
et ux
(19)

CHARLES E.
LOWERY,
et ux
(19)

MELVIN D.
BLAKE,
et ux
SEE NOTE #4

JACKIE DEAN
HAMILTON
c/o
MARGARET LARGEN
et al
(22)

EXISTING M.H.
TOP=261.373m
INV.=259.913m
LOWER M.H. 0.4m (1.3')
SEE NOTE 5

THOMAS PAUL
SEXTON,
et ux
(16)

GEORGE D.
WHALEY,
et ux
(17)

RELOCATE EXISTING
FIRE HYDRANT
INSTALL:
1- 200mm x 150mm (8"x6") TEE
1- 150mm (6") GATE VALVE ASSEMBLY

CECIL BLAYLOCK,
et ux
(20)

R. ALLEN
WILLIAMS,
et ux
(21)

HARRIMAN HOME
CENTER, INC.
(23)

BRUCE E.
WALKER,
et ux
(21)

DIMENSION MARK	NEW WATER LINE LOCATION		SCHEDULE	
	BASELINE WEST EDGE OF ROAD	STA. ALONG WEST EDGE OF ROAD	DISTANCE FROM EDGE OF ROAD	
A	METRIC	ENGLISH	METRIC	ENGLISH
A	595.8m	1954.8'	7.5m	24.6'
B	615.5m	2019.5'	3.8m	12.5'
C	652.4m	2140.5'	2.7m	8.9'
D	674.9m	2214.3'	3.2m	10.5'
E	687.5m	2255.7'	3.3m	10.8'
F	771.6m	2531.6'	4.7m	15.4'
G	784.6m	2574.3'	5.0m	16.4'
H	844.8m	2771.8'	5.4m	17.7'
I	865.1m	2838.4'	6.9m	22.6'

NOTES TO CONTRACTOR

1. ALL EXISTING UNDERGROUND UTILITIES SUCH AS WATER, SEWER, GAS, ELECTRIC, TELEPHONE AND T.V. CABLE MUST BE FIELD LOCATED AND MARKED BY UTILITY COMPANY BEFORE CONSTRUCTION BEGINS.
2. CONTRACTOR SHALL INSTALL NEW WATER METERS WHERE SHOWN ON PLANS. UNUSED WATER METERS SHALL BE REMOVED AND RETURNED TO OWNER AFTER NEW WATER LINE IS IN SERVICE.
3. NEW WATER LINE SHALL BE LAID WITH 0.76m (30") COVER EXCEPT WHERE EXTRA COVER IS SHOWN ON PLANS.
4. CONTRACTOR SHALL CONNECT EXISTING WATER METERS TO NEW WATER LINE AFTER NEW WATER LINE IS IN SERVICE.
5. RAISE OR LOWER TOP OF MANHOLE BY ADDING OR REMOVING GRADE RINGS AND/OR M.H. BARRELS AS REQUIRED.

PROPOSED HIGHWAY
CONSTRUCTION EASEMENT

METRIC



ELROD-DUNSON, INC.
CONSULTING ENGINEERS
NASHVILLE • KNOXVILLE
BOWLING GREEN

CONTRACT W00-01

HARRIMAN, TENNESSEE

REVISIONS

DESIGNED: R.G.T.
DRAWN: S.C.G.
CHECKED: R.G.T.
DATE: JULY, 2000
SCALE: 1:500
PROJ. NO. 0700

SHEET 4
OF 6

NOTES TO CONTRACTOR


1. ALL EXISTING UNDERGROUND UTILITIES SUCH AS WATER, SEWER, GAS, ELECTRIC, TELEPHONE AND T.V. CABLE MUST BE FIELD LOCATED AND MARKED BY UTILITY COMPANY BEFORE CONSTRUCTION BEGINS.
2. CONTRACTOR SHALL INSTALL NEW WATER METERS WHERE SHOWN ON PLANS. UNUSED WATER METERS SHALL BE REMOVED AND RETURNED TO OWNER AFTER NEW WATER LINE IS IN SERVICE.
3. NEW WATER LINE SHALL BE LAID WITH 0.76m (30") COVER EXCEPT WHERE EXTRA COVER IS SHOWN ON PLANS.
4. CONTRACTOR SHALL CONNECT EXISTING WATER METERS TO NEW WATER LINE AFTER NEW WATER LINE IS IN SERVICE.
5. RAISE OR LOWER TOP OF MANHOLE BY ADDING OR REMOVING GRADE RINGS AND/OR M.H. BARRELS AS REQUIRED.


PROPOSED HIGHWAY CONSTRUCTION EASEMENT



NEW WATER LINE LOCATION SCHEDULE				
DIMENSION MARK	BASELINE STA. ALONG WEST EDGE OF ROAD		DISTANCE FROM EDGE OF ROAD	
	METRIC	ENGLISH	METRIC	ENGLISH
A	905.5m	2970.8'	7.0m	23.0'
B	948.6m	3112.2'	7.1m	23.3'
C	975.8m	3201.4'	7.4m	24.28'


METRIC

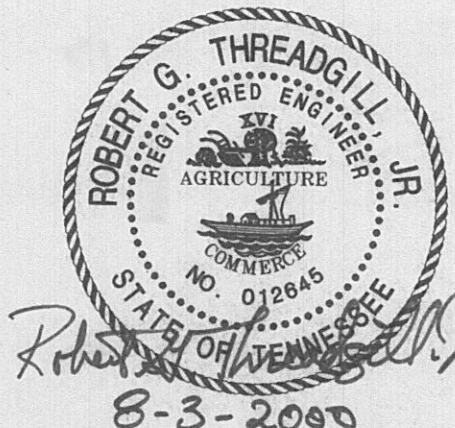

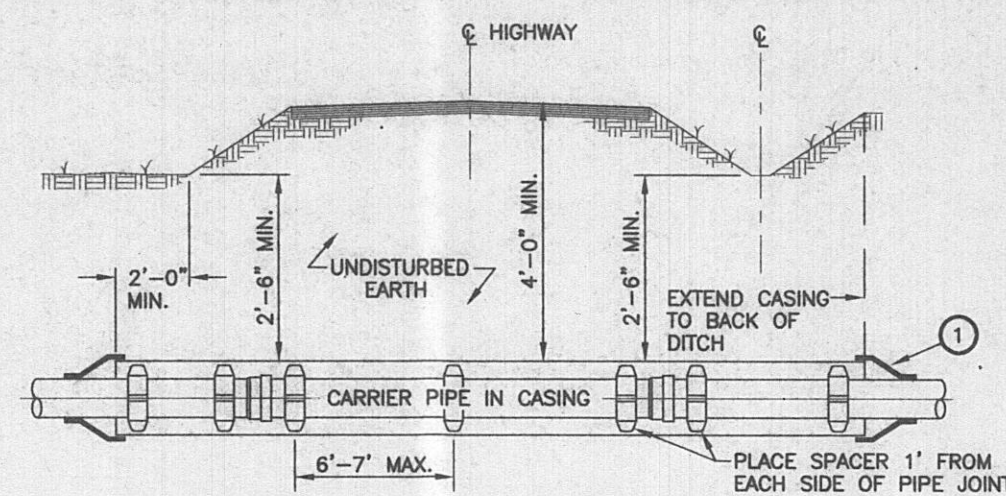

TYPICAL DETAIL OF HIGHWAY CROSSING
W/CASING AND CARRIER PIPE


NOT TO SCALE

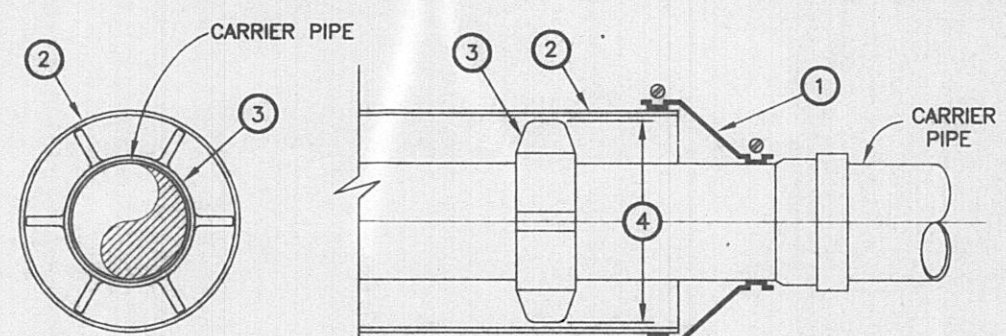

CASING PIPE W/CARRIER PIPE DETAIL


NOT TO SCALE

- USE WATERTIGHT WRAP AROUND END SEALS WITH STAINLESS STEEL BANDS.
- SMOOTH WALL STEEL CASING PIPE BITUMINOUS COATING INSIDE & OUT.
- USE PSI RANGER AZ CASING SPACERS FOR 4" THRU 12" DIA. CARRIER PIPE. USE PSI RANGER GZK CASING SPACERS FOR 14" THRU 24" DIA. CARRIER PIPE.
- SPACER SKIDS SHALL BE SIZED AND TRIMMED TO MAINTAIN 1/2" MAXIMUM CLEARANCE BETWEEN SKID AND CASING PIPE.
- RESTRAIN PIPE IN ALL CASING OVER 60 FEET IN LENGTH.

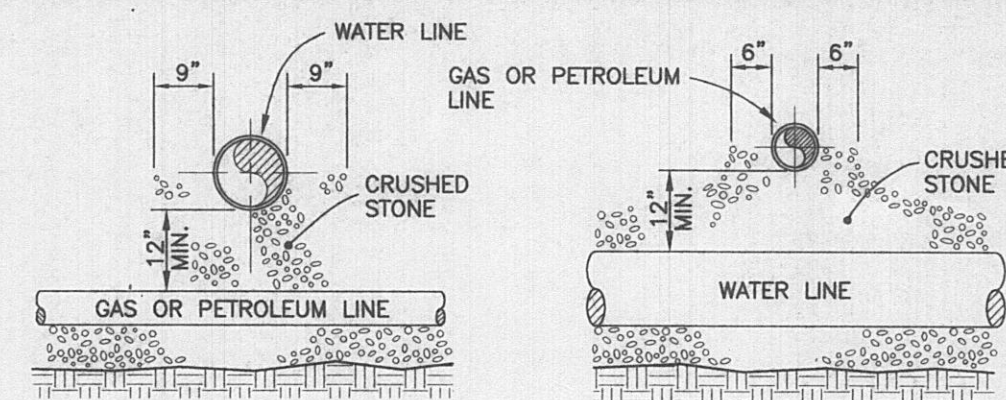

PIPE CROSSING
FOR WATER LINE & GAS MAIN


NOT TO SCALE

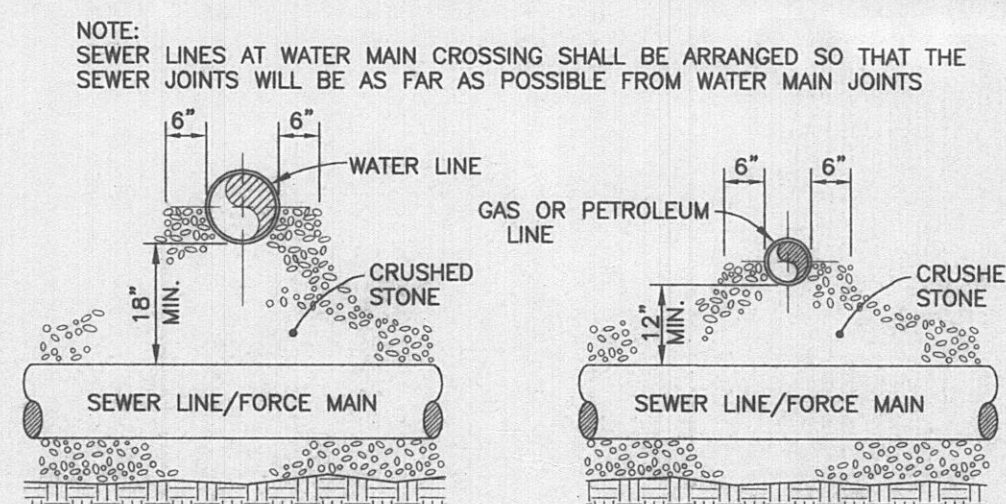

PIPE CROSSING
FOR SEWER LINE/FORCE MAIN


NOT TO SCALE

- NOTES:
- USE TRAFFIC MANHOLE FRAME & COVER WHEN IN ROADWAY (I.B.S. 1311 OR EQUAL).
 - PIPE GRADE SHALL BE LOWERED, IF REQUIRED, WHEN APPROACHING AIR RELEASE VALVE TO GIVE VERTICAL SPACE FOR AIR RELEASE APPURTENANCES. (SEE SHOP DWGS.)
 - SEAL PIPE THROUGH MANHOLE OPENINGS W/NON-SHRINK GROUT.

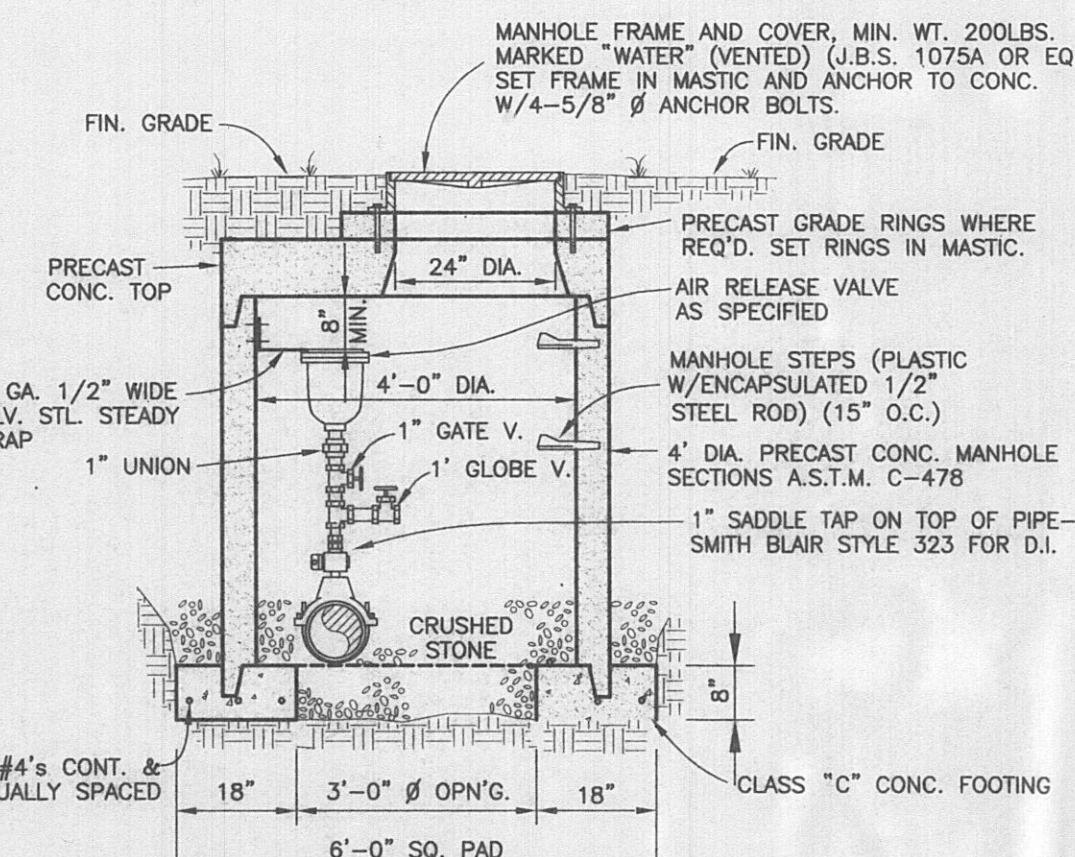

AIR RELEASE/AIR VACUUM VALVE

NOT TO SCALE

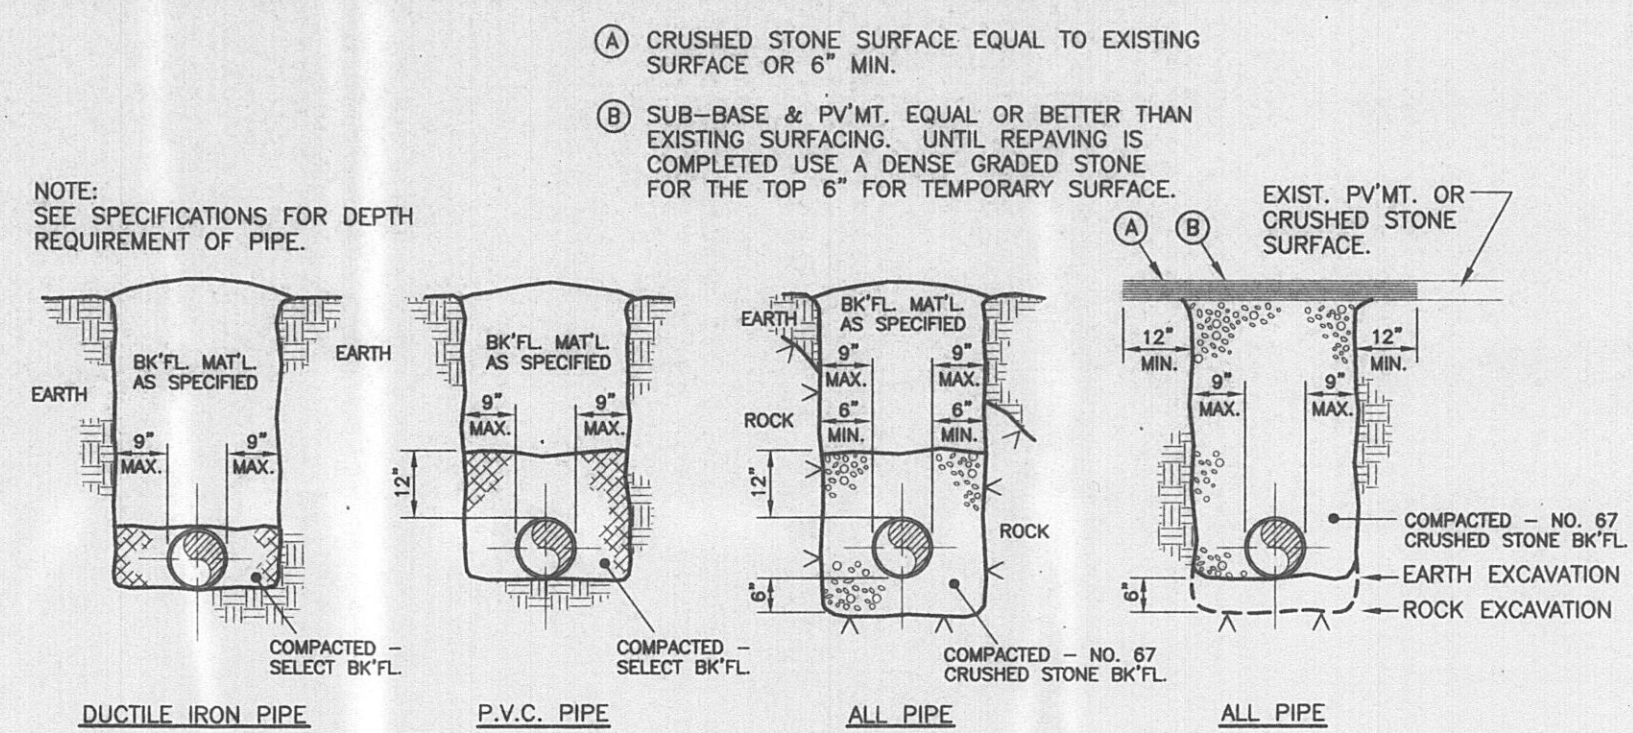

STANDARD WATER LINE BEDDING AND BACKFILLING


NOT TO SCALE

90° BEND							45° BEND								
SIZE	18"	12"	10"	8"	6"	4"	2"	SIZE	18"	12"	10"	8"	6"	4"	2"
A	60	54	48	42	36	30		A	56	50	44	38	32	28	
B	48	42	36	30	24	18		B	42	38	32	26	20	16	
C	44	38	32	26	20	14		C	38	34	28	22	16	10	
D	40	34	28	22	16	10		D	40	36	30	24	18	12	

22 1/2° BEND							11 1/4° BEND								
SIZE	18"	12"	10"	8"	6"	4"	2"	SIZE	18"	12"	10"	8"	6"	4"	2"
A	50	44	38	34	30	22		A	34	30	26	24	22	18	
B	34	30	26	22	16	12		B	26	24	18	16	12	8	
C	30	26	22	18	12	8		C	26	24	18	16	12	8	
D	32	28	24	20	14	10		D	30	26	24	18	12	10	

NOTES:


- POUR CLASS B CONCRETE ANCHOR AGAINST UNDISTURBED EARTH OR ROCK.
- IF EXACT SIZE PIPE IS NOT SHOWN, USE NEXT LARGER SIZE.

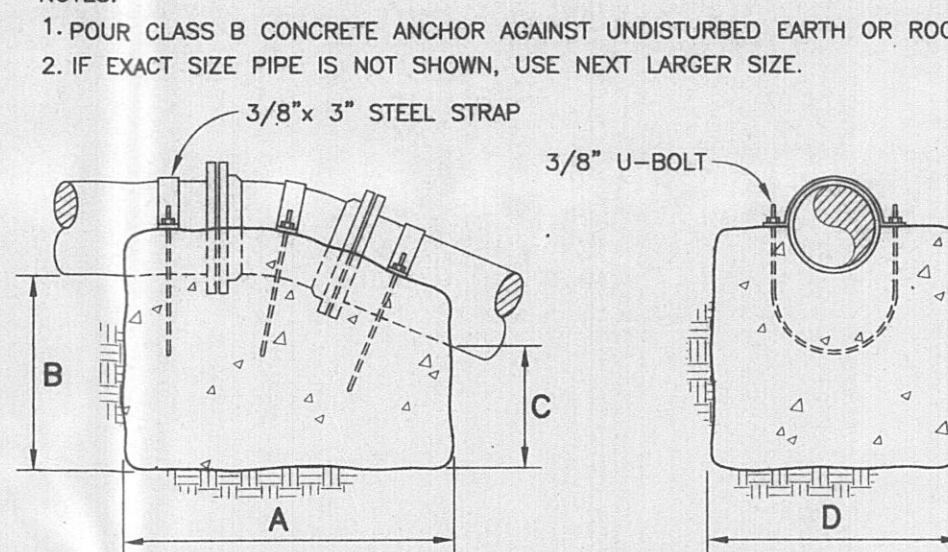

VERTICAL CONCRETE ANCHOR

NOT TO SCALE


- SERVICE CONNECTION NOT UNDER ROADWAY LUMP SUM BID ITEM INCLUDES:
- METER BOX INSTALLATION AND APPURTENANCES
 - WATER MAIN CONNECTION AND APPURTENANCES

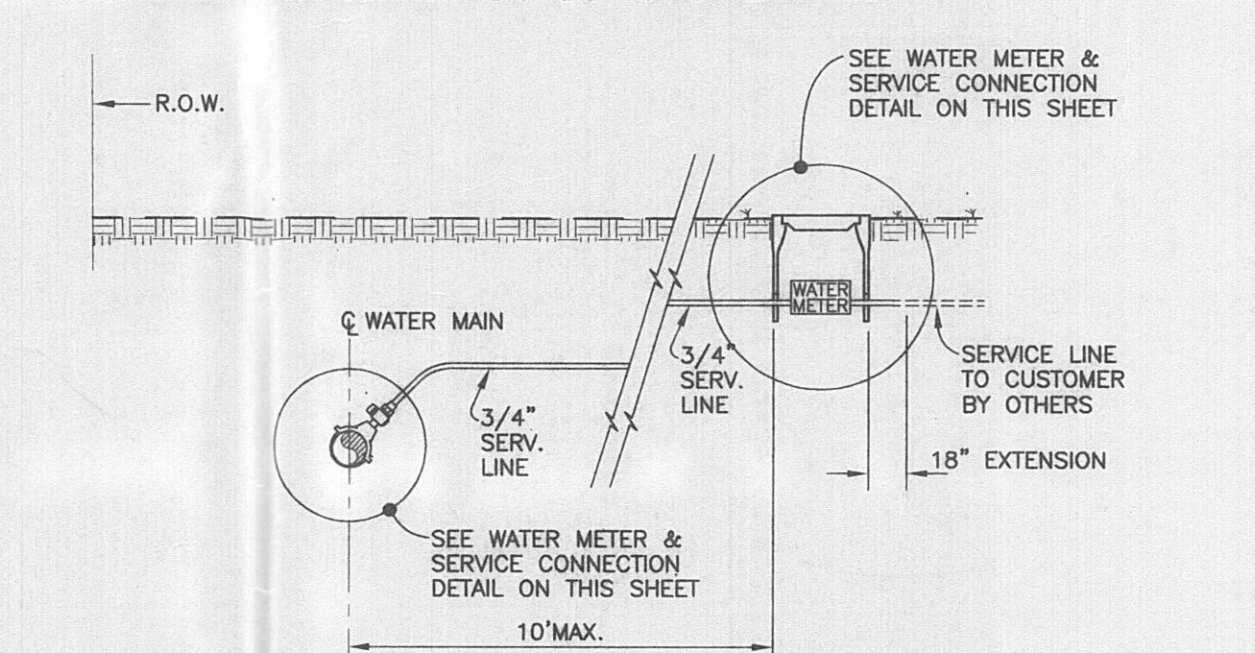

TYPE "A"
SERVICE CONNECTION NOT UNDER ROADWAY


NOT TO SCALE

- SERVICE CONNECTION UNDER ROADWAY LUMP SUM BID ITEM INCLUDES:
- METER BOX INSTALLATION AND APPURTENANCES
 - BORE & JACK UNDER ROADWAY NO CASING REQUIRED
 - WATER MAIN CONNECTION AND APPURTENANCES

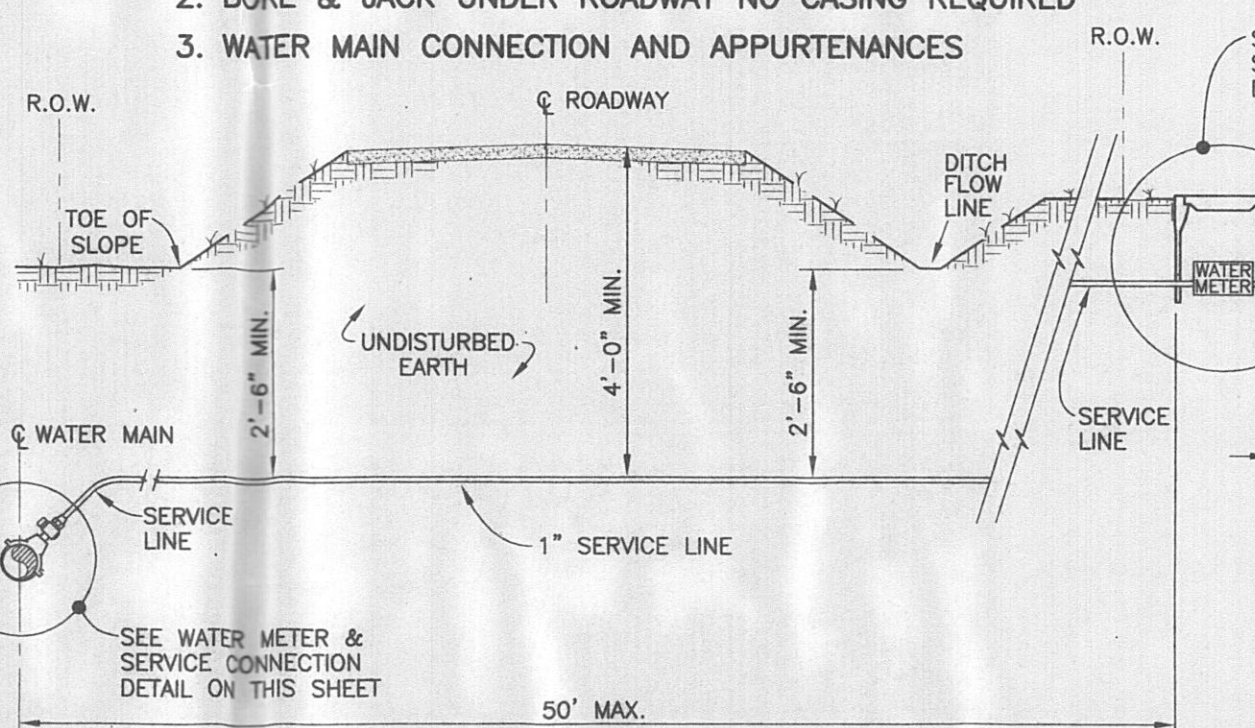


TYPE "B"
SERVICE CONNECTION UNDER ROADWAY

NOT TO SCALE

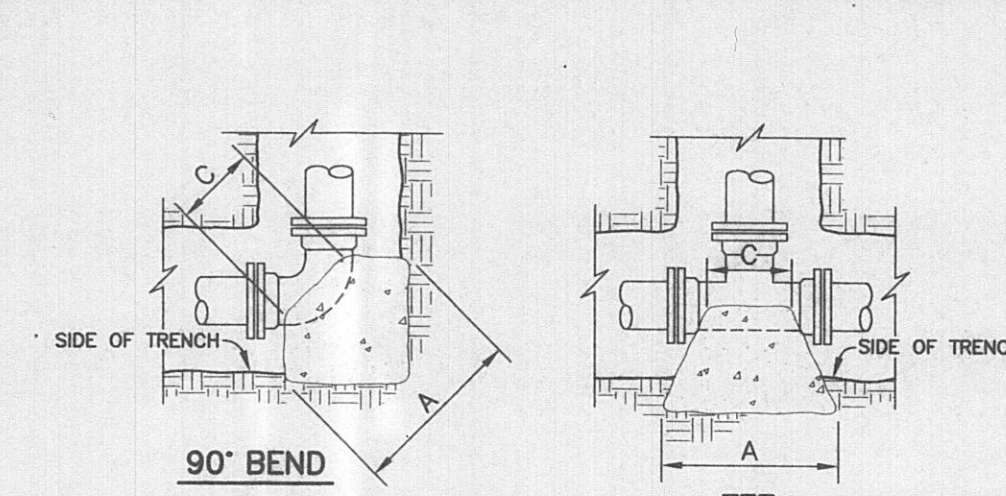


THRUST BLOCKING DETAIL

NOT TO SCALE

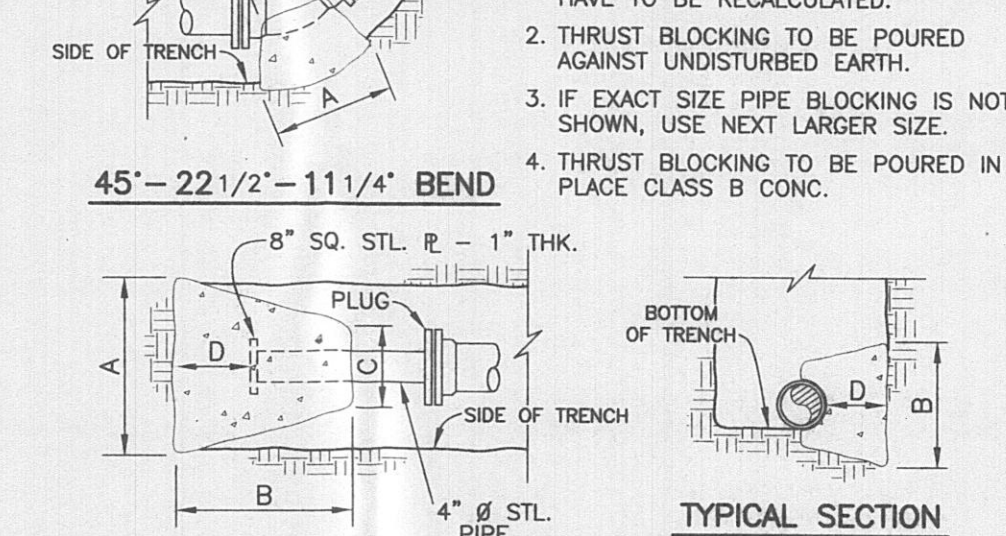


THRUST BLOCKING DETAIL

NOT TO SCALE

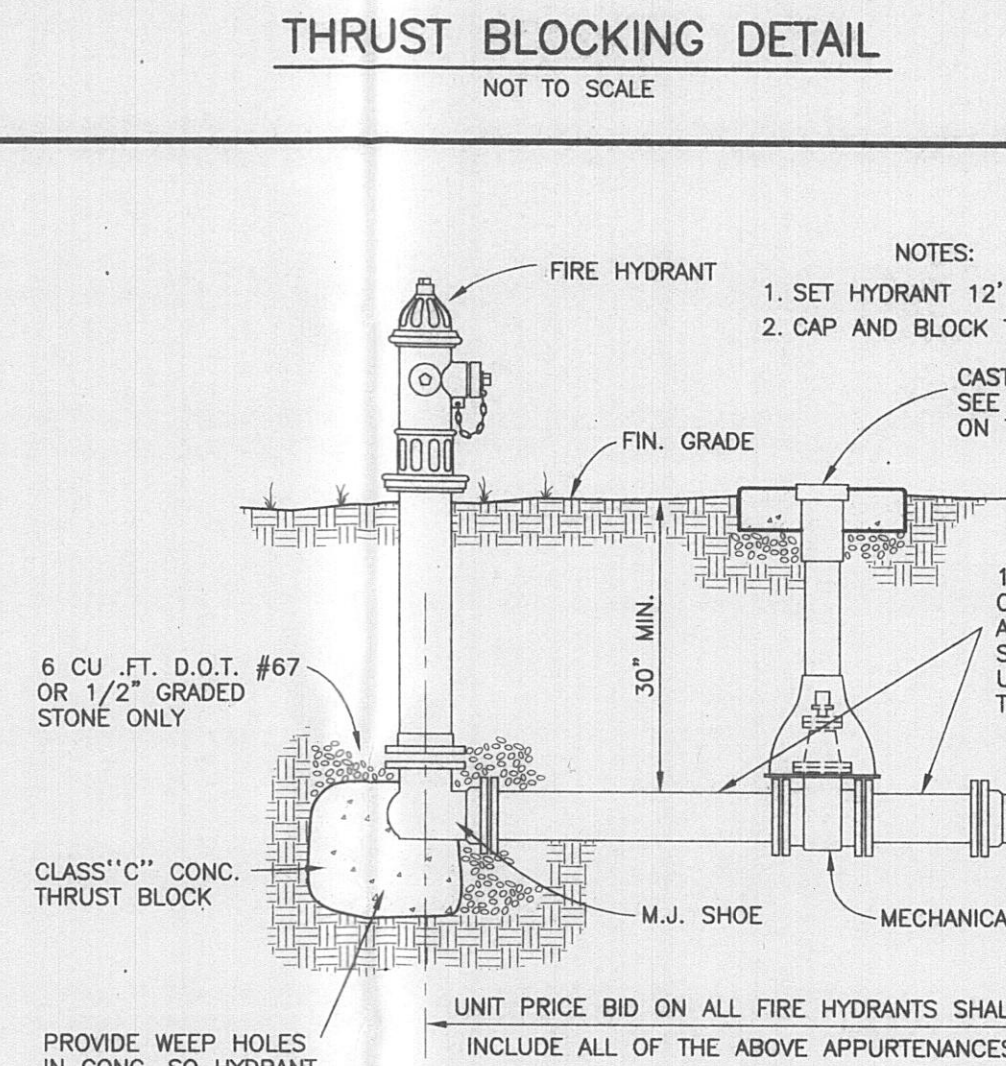


FIRE HYDRANT INSTALLATION

NOT TO SCALE

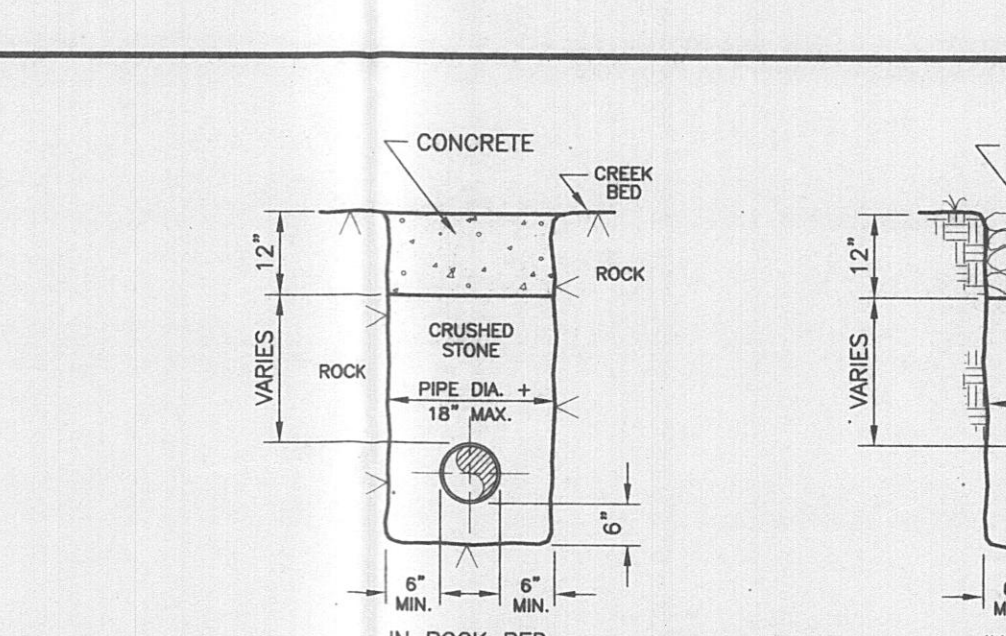

DITCH CROSSING DETAIL

NOT TO SCALE

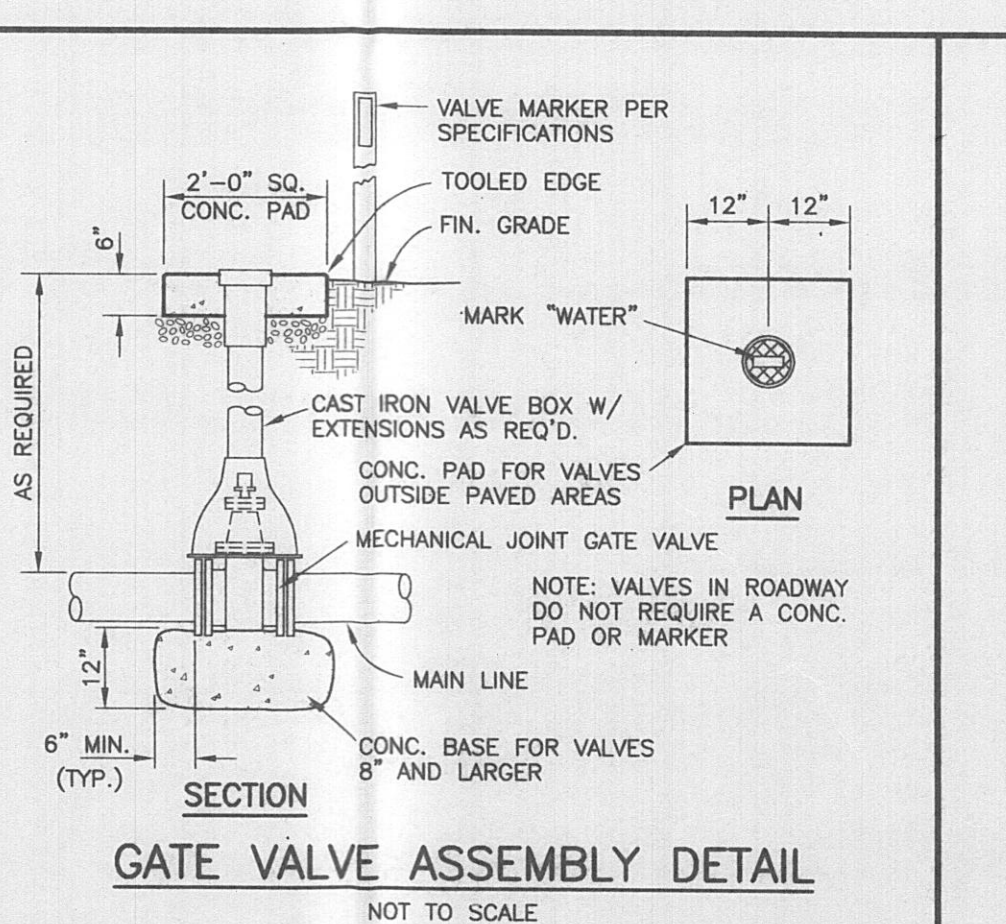

GATE VALVE ASSEMBLY DETAIL

NOT TO SCALE

90° BEND							
SIZE	16"	12"	10"	8"	6"	4"	2"
A	64	50	40	33	26	16	16
B	64	50	40	33	24	16	16
C	30	16	15	12	12	9	9
D	32	25	20	16	12	8	9

45° BEND							
SIZE	16"	12"	10"	8"	6"	4"	2"
A	48	37	31	24	18	12	12
B	48	37	31	24	18	12	12
C	18	16	14	12	12	8	8
D	22	18	15	12	9	6	6

22 1/2° BEND							
SIZE	16"	12"	10"	8"	6"	4"	2"
A	34	26	23	18	13	9	9
B	34	26	23	18	13	9	9
C	18	16	14	12	10	8	8
D	16	13	11	9	6	4	4

11 1/4° BEND							
SIZE	16"	12"	10"	8"	6"	4"	2"
A	24	18	16	13	11	9	9
B	24	18	16	13	11	9	9
C	18	16	14	12	10	8	8
D	12	9	8	6	5	4	4

PLUG							
SIZE	16"	12"	10"	8"	6"	4"	2"
A	54	52	43	34	26	26	26
B	54	52	43	34	26	26	26
C	12	12	12	12	12	12	12
D	44	32	22	15	11	11	11

TEE									
SIZE	MAIN	16"	12"	12"	12"	8"-10"	8"-12"	2"-6"	
	BRANCH	16"	12"	8"-10"	2"-8"	8"-10"	2"-6"	2"-6"	
A		54	52	42	26	43	26	26	
B		54	52	43	26	43	26	26	
C		30	12	12	12	12	12	12	

DIMENSIONS ARE IN INCHES

