
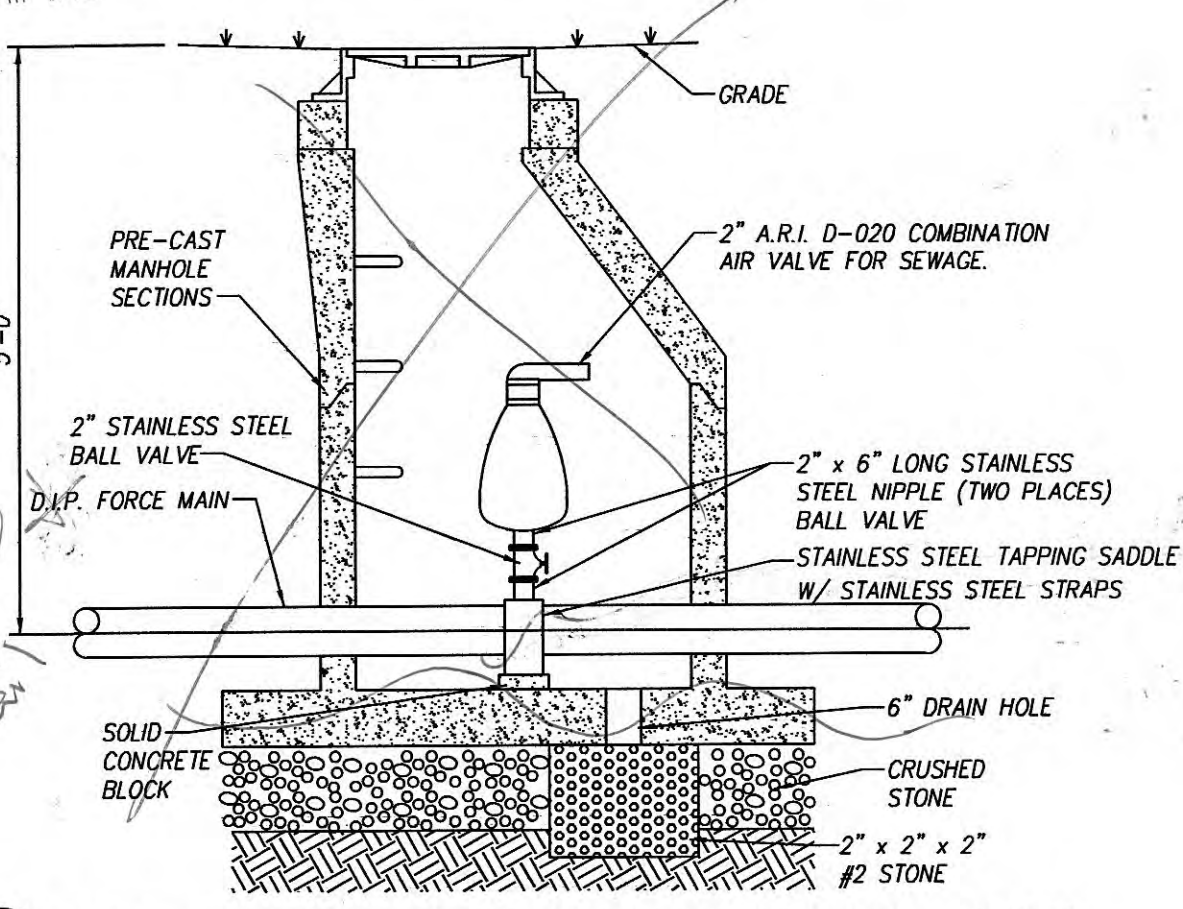
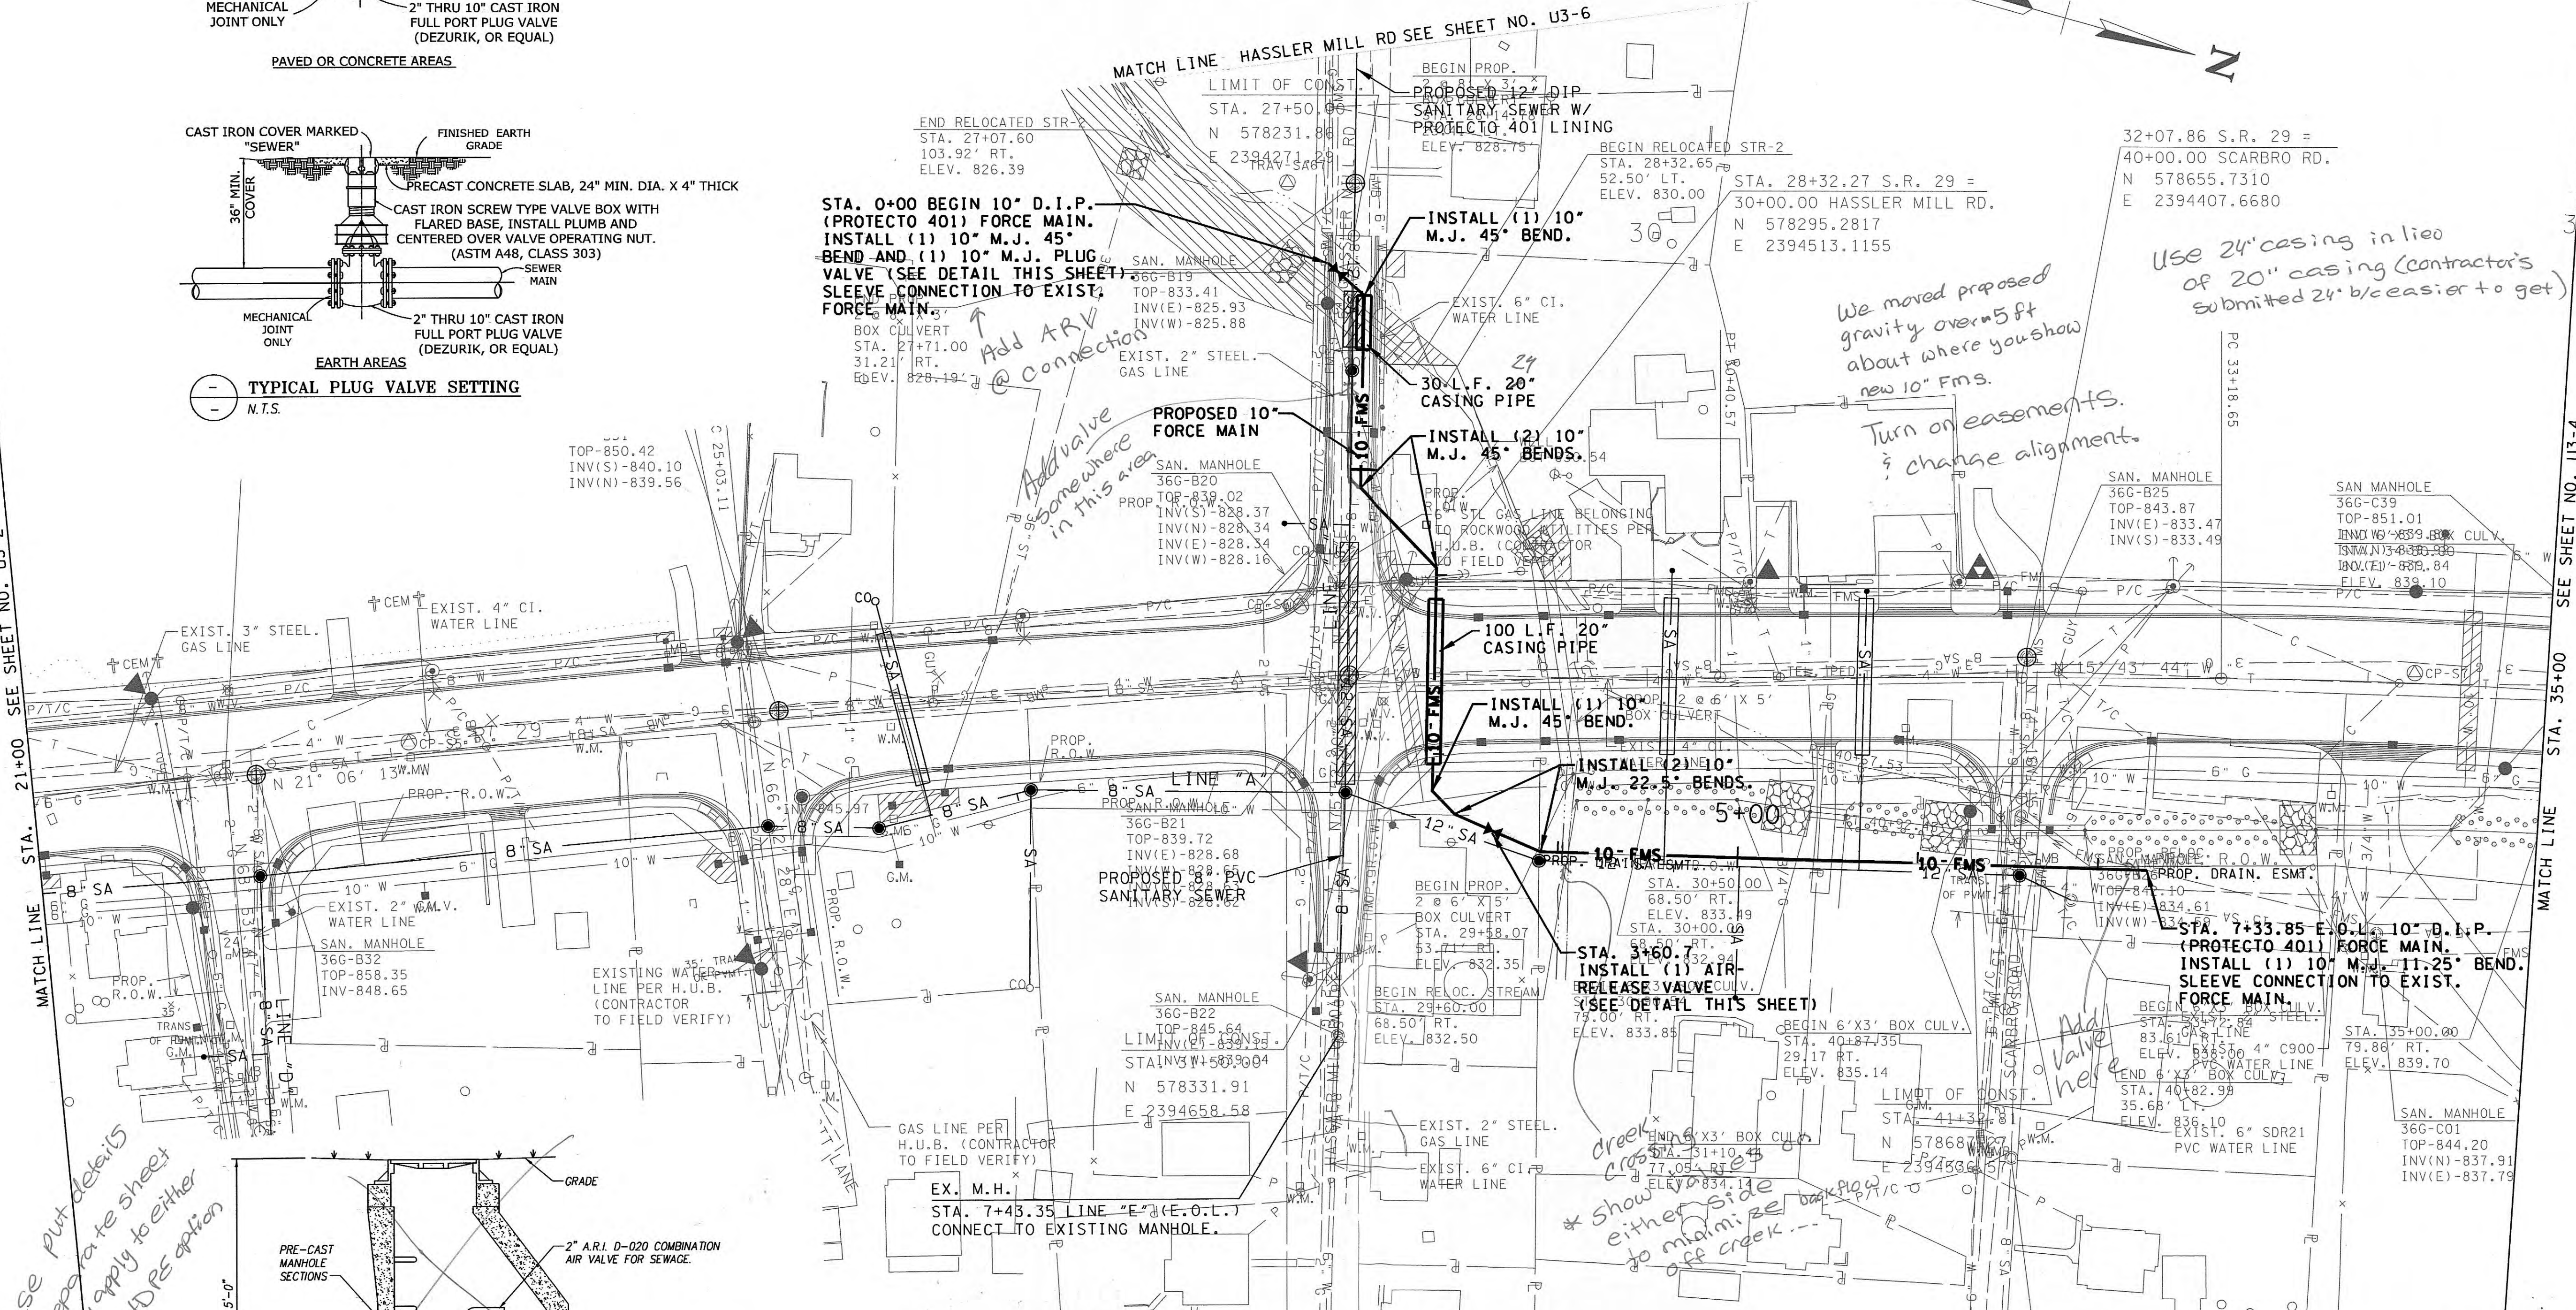
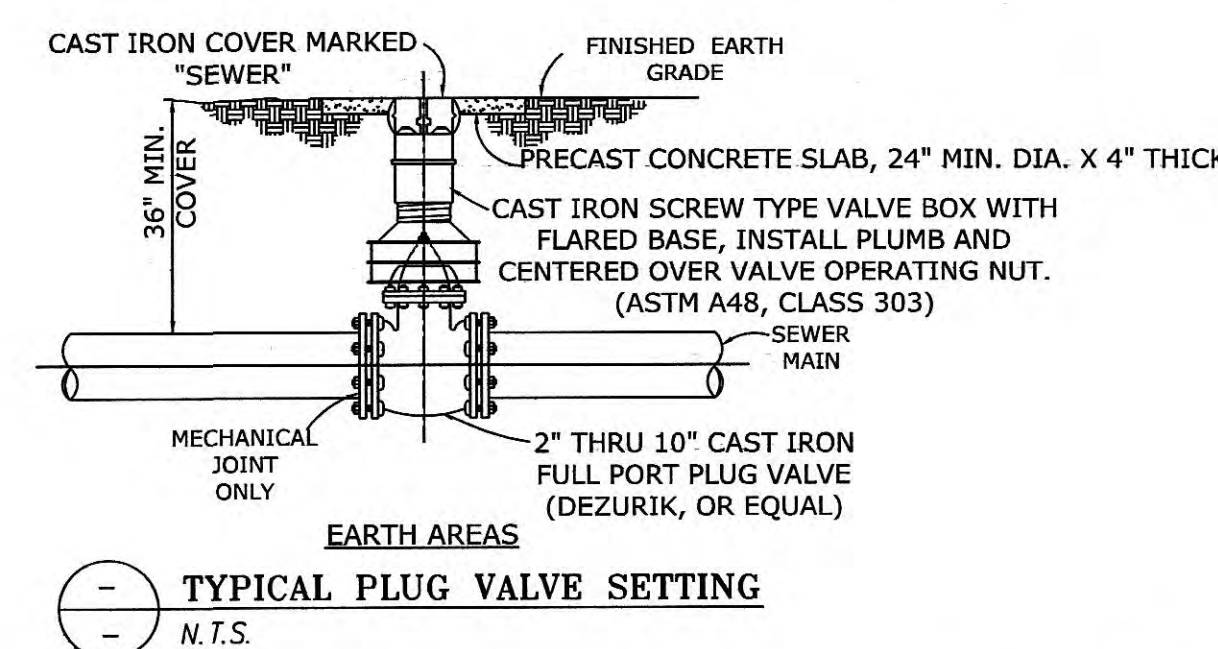


TYPE	YEAR	PROJECT NO.	NO.
CONST.	2014	STP-29(58)	U3-10
		73035-3209-14	
ROANE CO.			

↑
We already have a
U3-10...

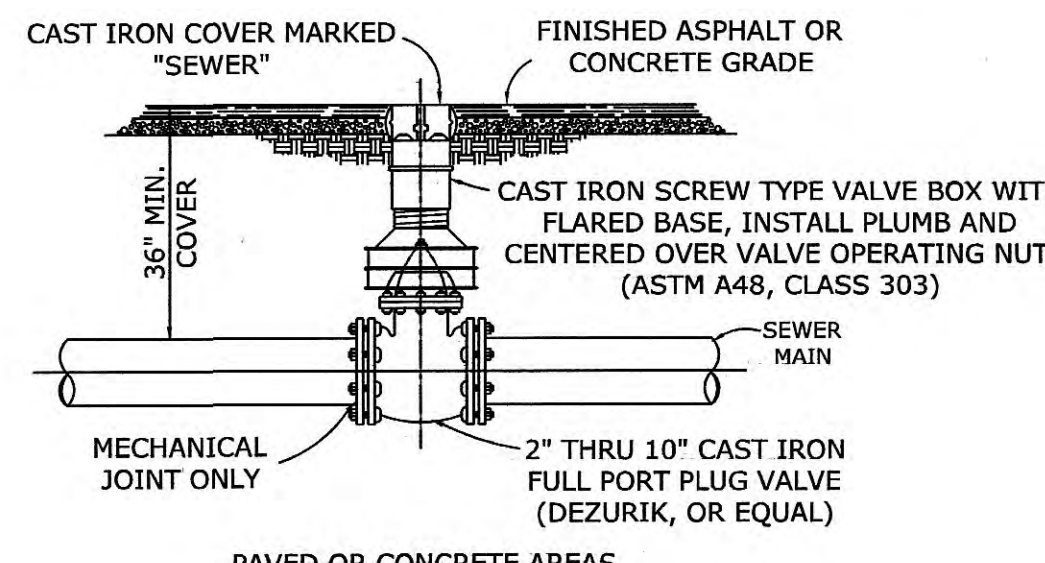

NOTE:
1. CONTRACTOR TO VERIFY LOCATION AND ELEVATION OF PRIVATE SEWER LATERALS PRIOR TO CONSTRUCTION TO ENSURE PROPER GRADE & LOCATION OF SEWER LATERAL EXTENSION TO PROPOSED SEWER MAIN.

HARRIMAN
UTILITY
BOARD

SANITARY
SEWER LINE
RELOCATION



STA. 21+00.00 TO STA. 35+00.00
SCALE: 1"=50'

please put details
on separate sheet
so they apply to either
DIP or HDES option
See attached
detail




We moved proposed
gravity over 5 ft
about where you show
new 10" Fms.
Turn on easements.
& change alignment.

Use 24" casing in lieu
of 20" casing (contractor's
submitted 24" b/c easier to get)

* Show
either side
to minimize
off creek...

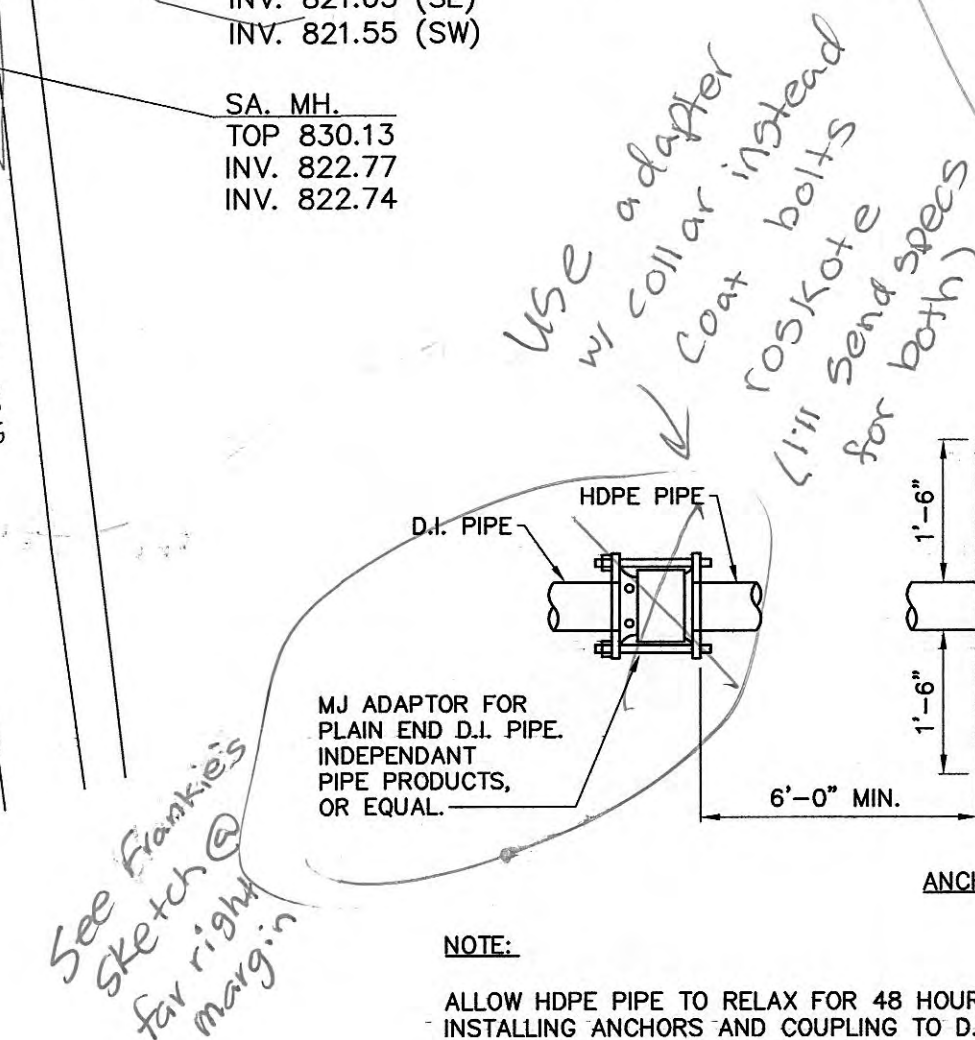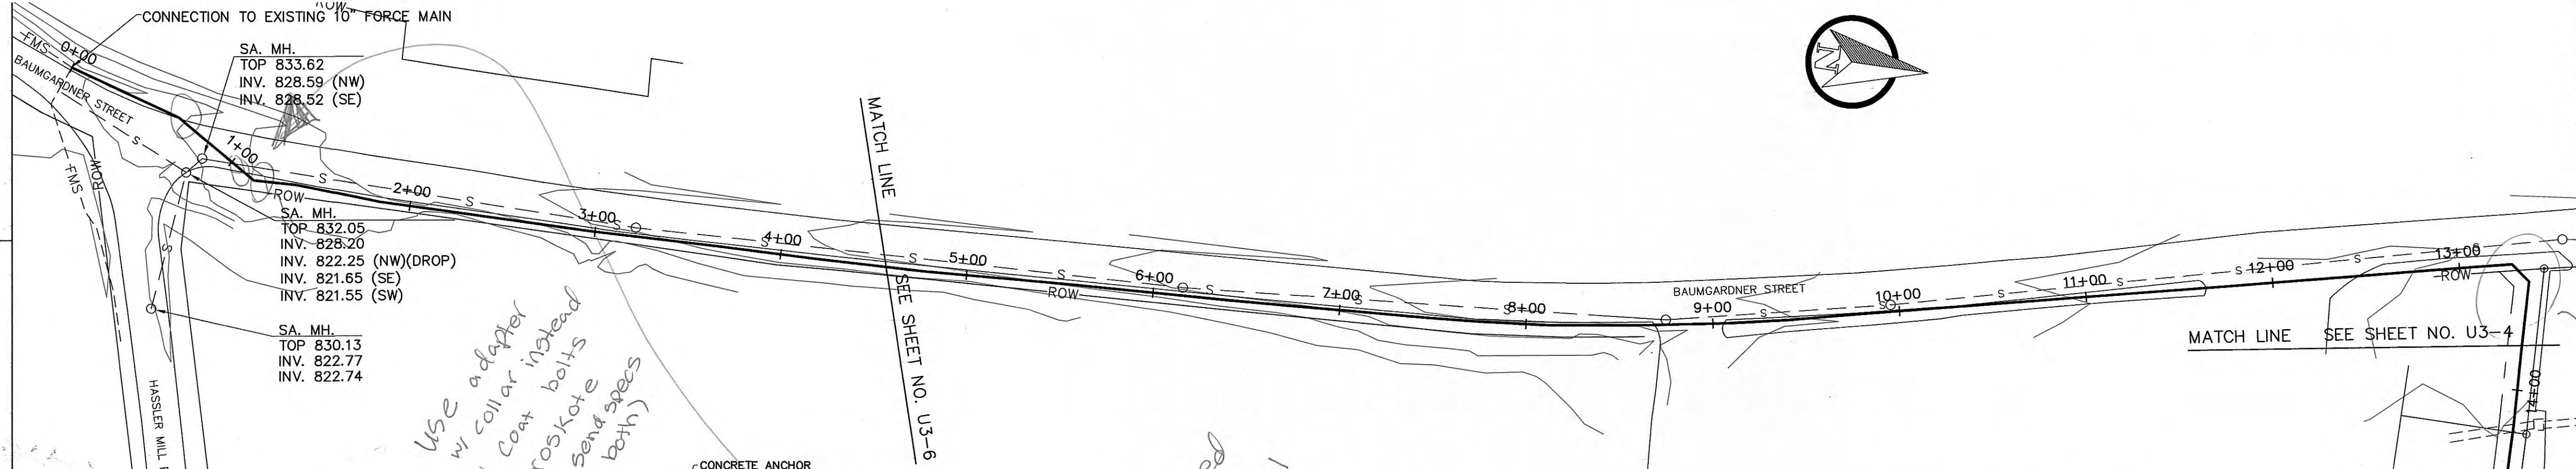

ANCHOR AND PIPE TRANSITION DETAIL
NOT TO SCALE

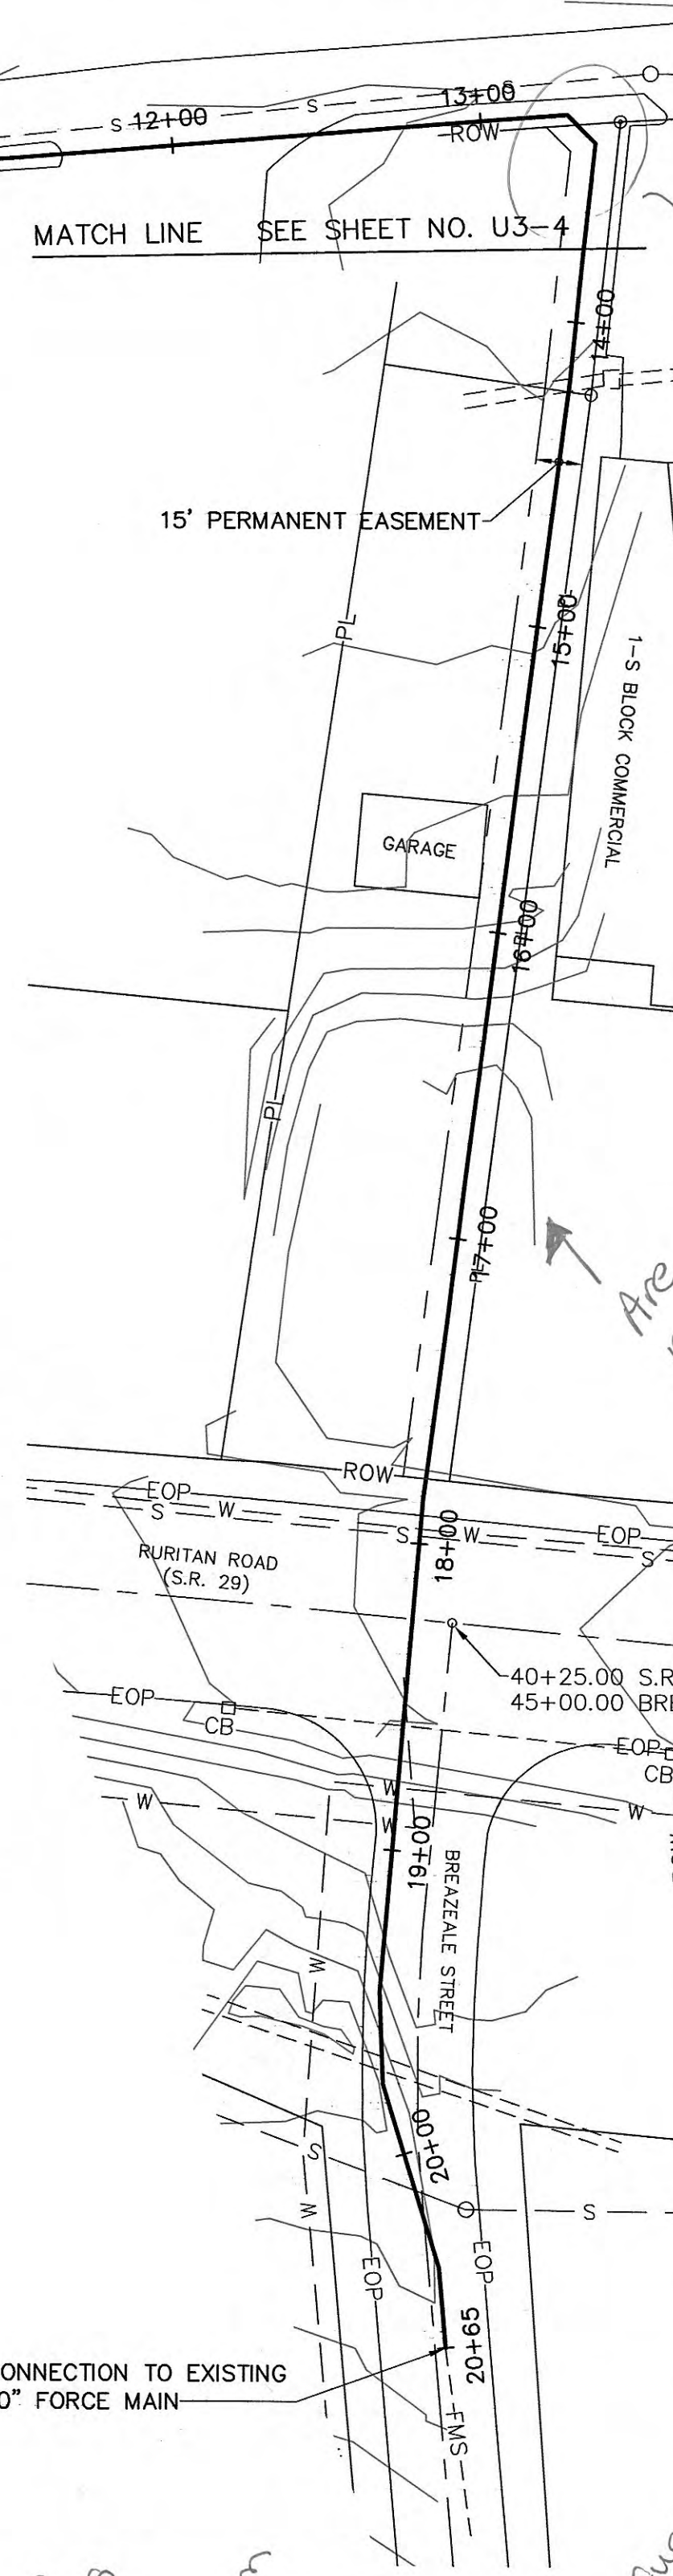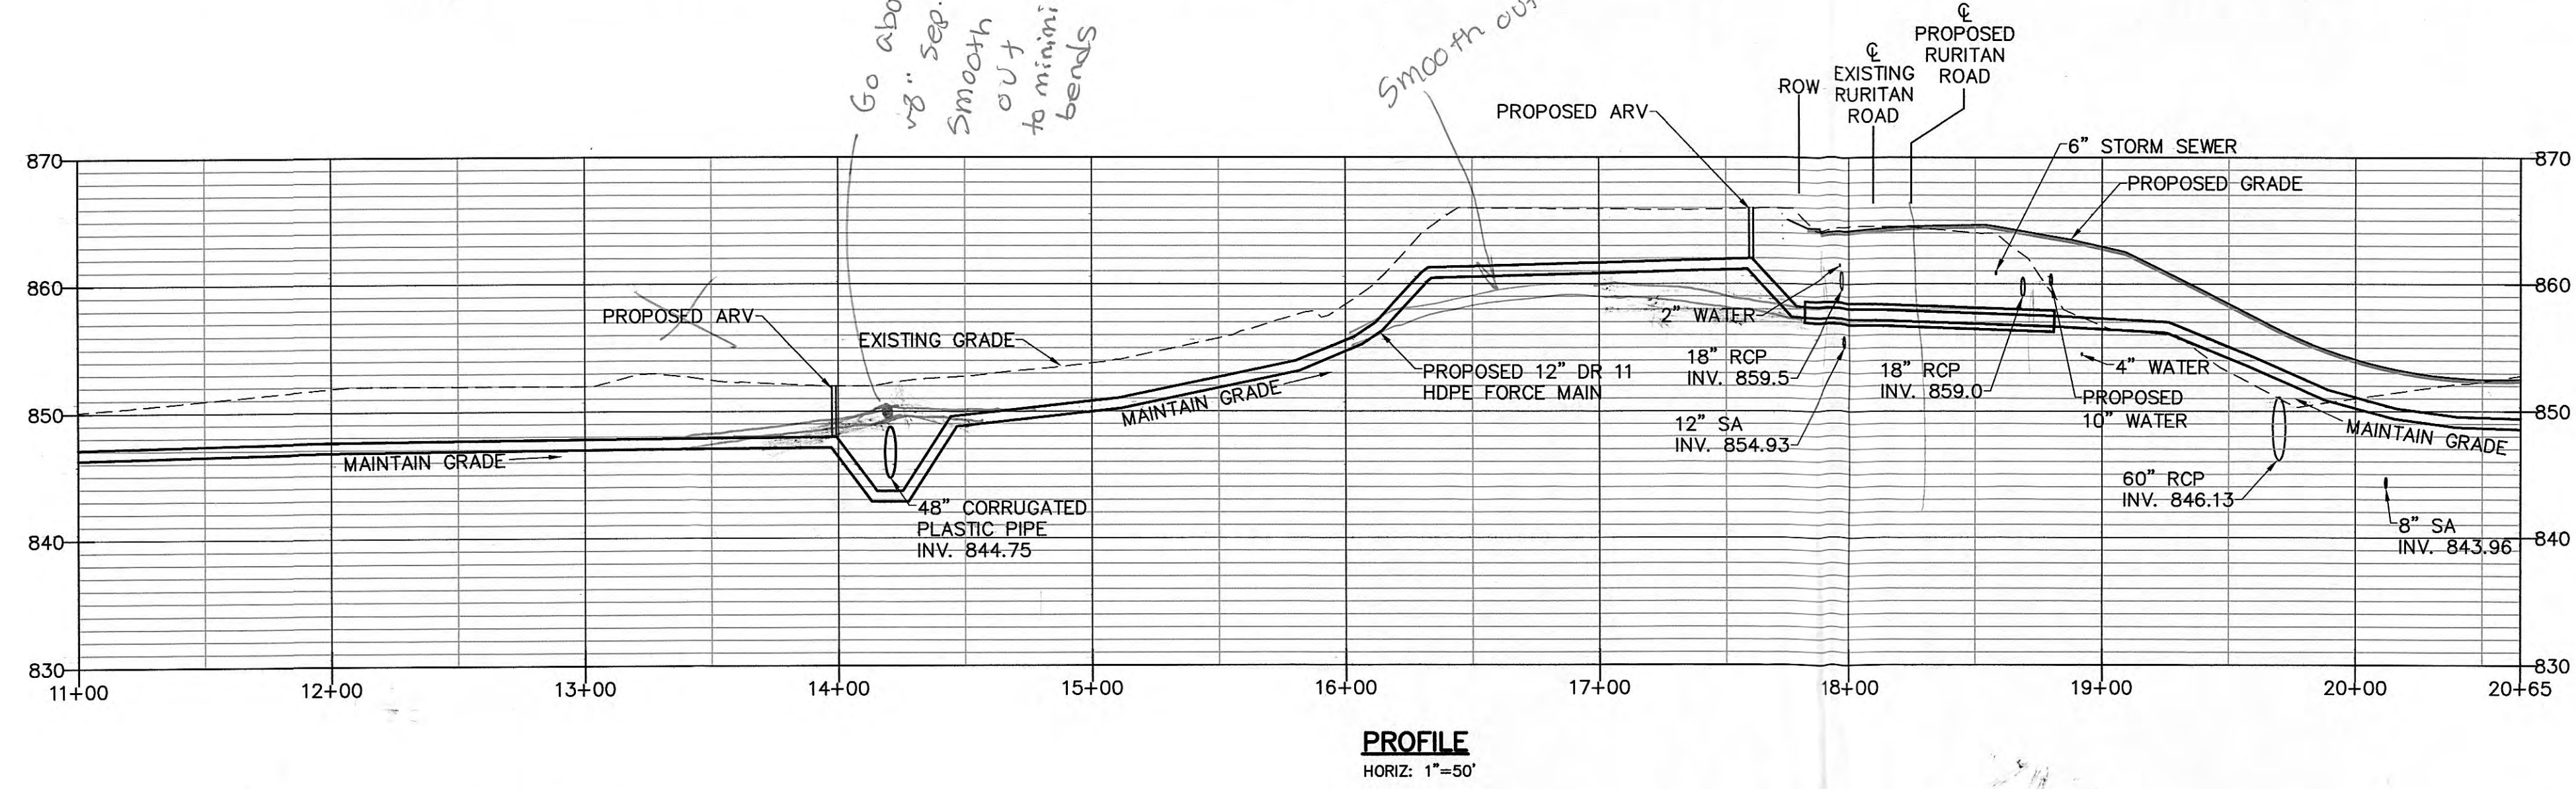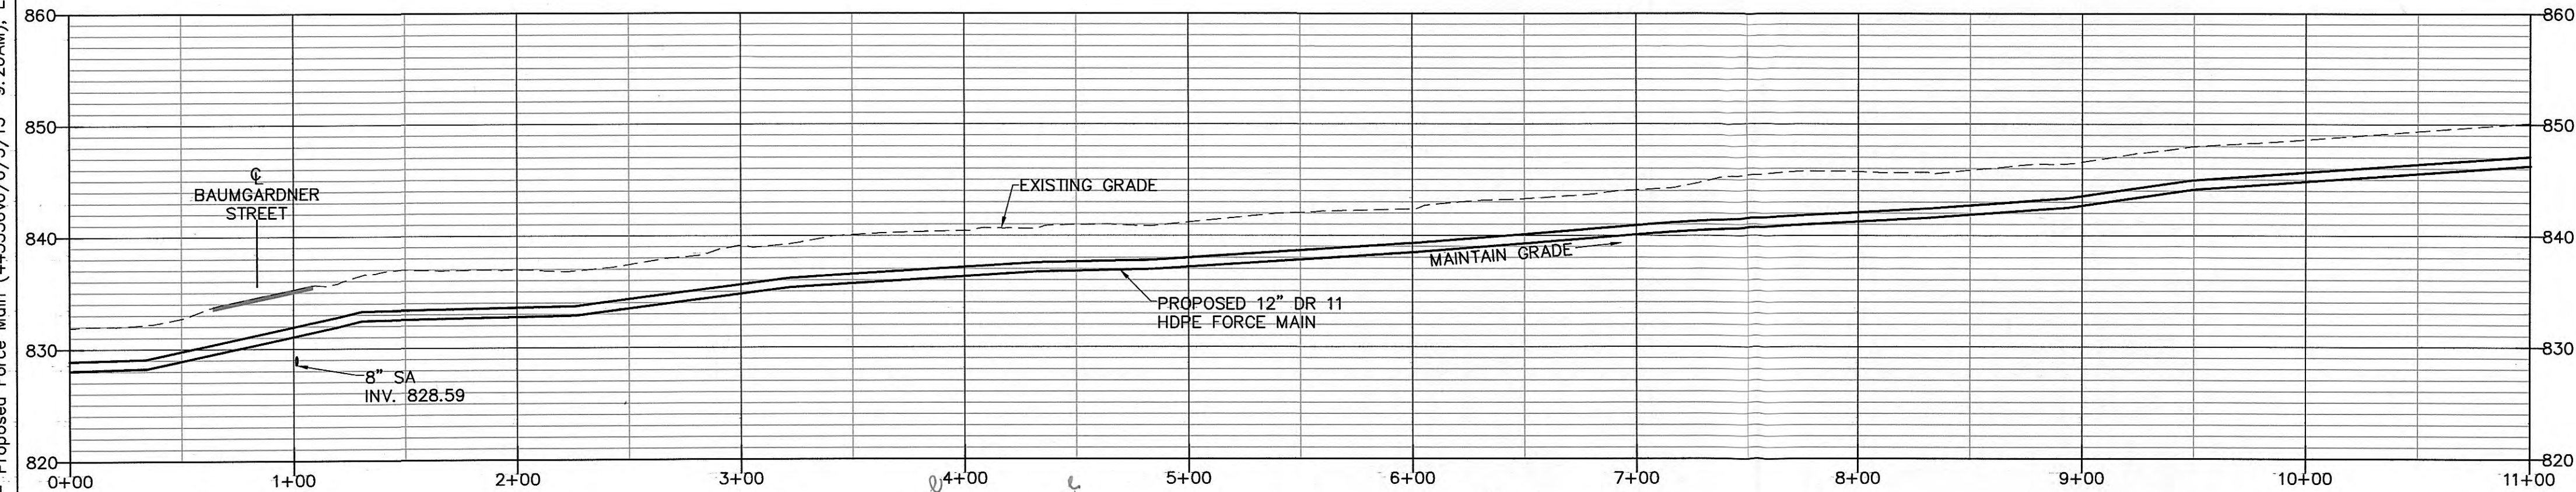

TYPE	YEAR	PROJECT NO.	SHEET NO.
CONST.	2015	STP-29(58)	U3-13
		73035-3209-14	

HARRIMAN UTILITY BOARD
FORCE MAIN INSTALLATION
BAUMGARDNER STREET TO BREEZEALE STREET

Do you need
any horizontal
fittings?
Can we smooth
out?


Call out
fittings.


Are we on Church
property or grocery
store?

Call out all
horizontal/
vertical fittings
that are needed
No electro fuse
couplings

7
distinguish
b/w existing
& proposed
utilities & storm
lines we know which
lines will "go away"

Need fusing
specs (large diameter for us...)
check JWS
certification.

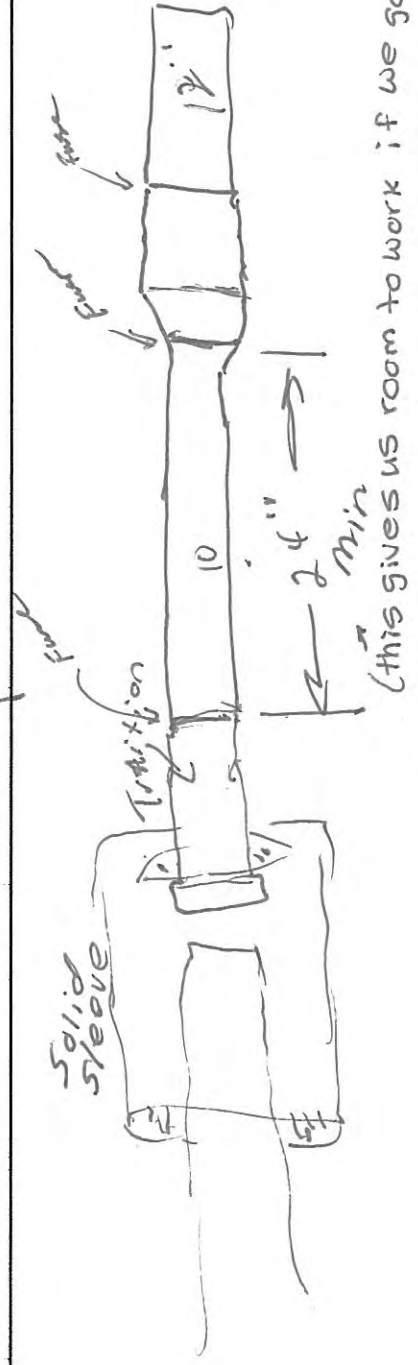

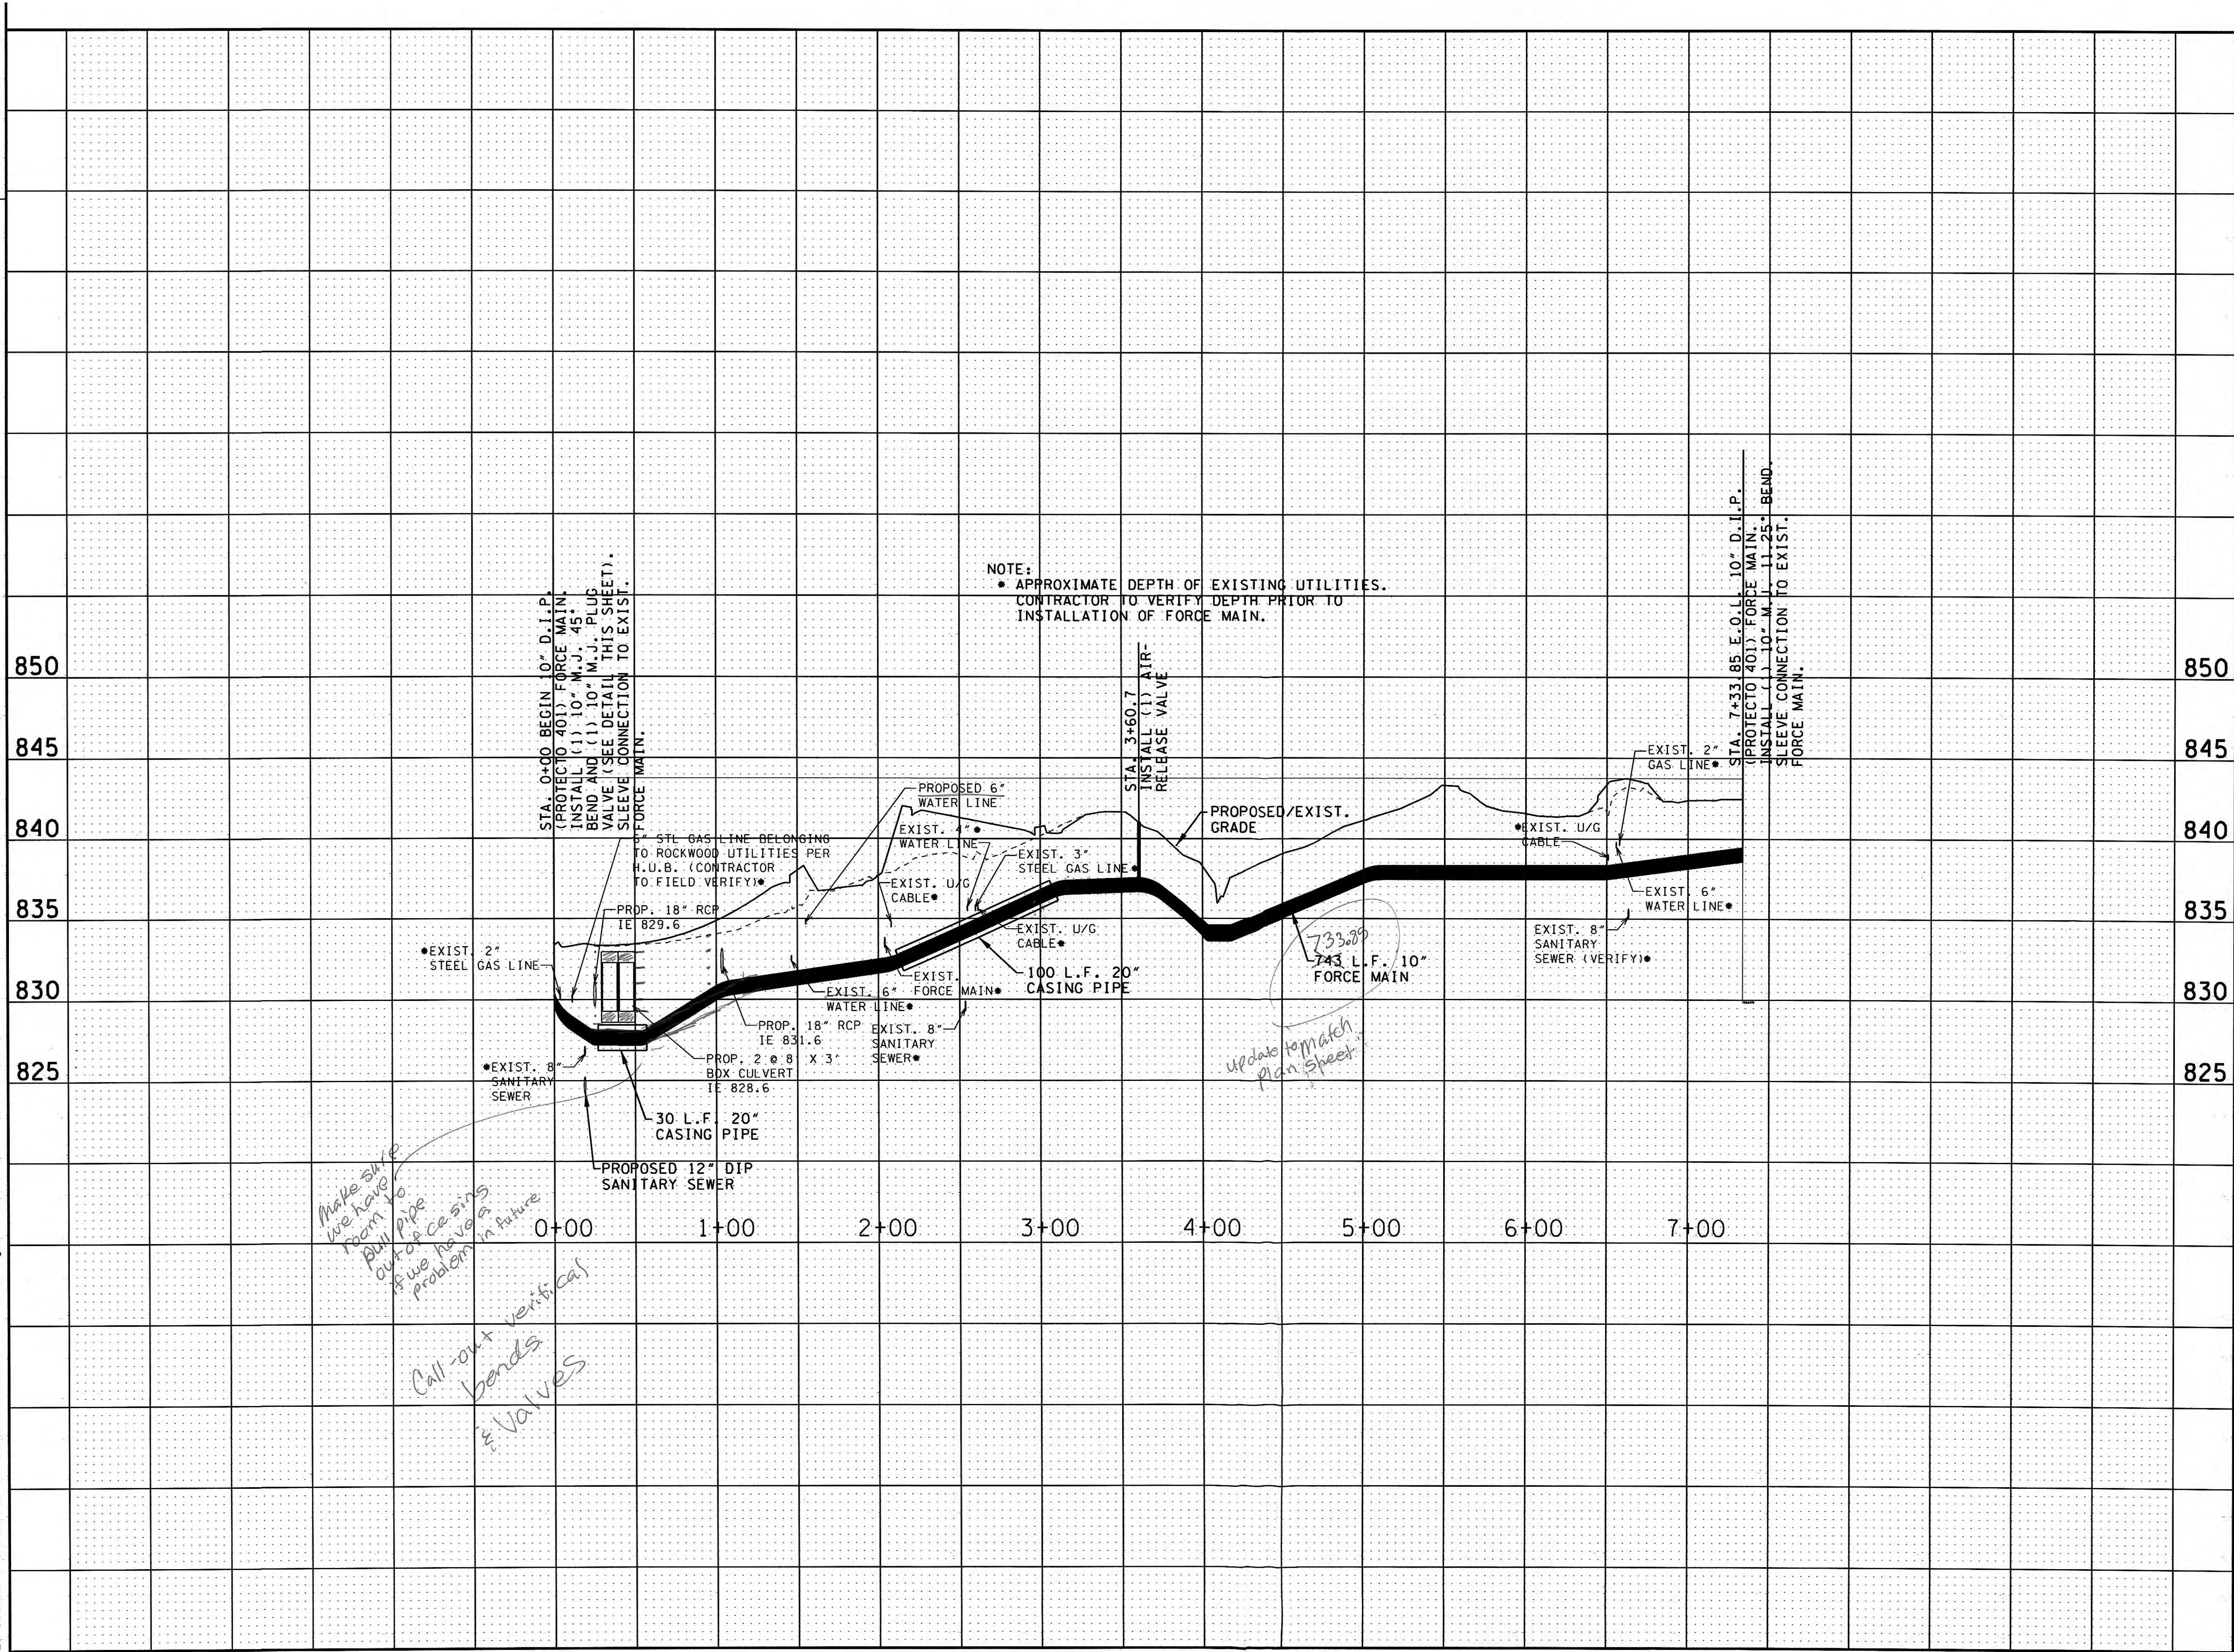

TYPE	YEAR	PROJECT NO.	NO.
CONST.	2014	STP-29(58)	U3-14
		73035-3209-14	

ROANE CO.

12

HARRIMAN
UTILITY
BOARD

10" FORCE MAIN
RELOCATION

PROFILES
SCALE AS SHOWN