


NOTE:

1. CONTRACTOR TO VERIFY LOCATION AND ELEVATION OF PRIVATE SEWER LATERALS PRIOR TO CONSTRUCTION TO ENSURE PROPER GRADE & LOCATION OF SEWER LATERAL EXTENSION TO PROPOSED SEWER MAIN. SEWER LATERALS THAT CROSS RURI TAN ROAD SHALL BE DUCTILE IRON WITH PROTECTO 401 LINING.
2. CONTRACTOR TO VERIFY FORCE MAIN DEPTH BY POTHOLING PRIOR TO RELOCATION. IF CROWN OF FORCE MAIN IS BELOW 825.5', NO WORK SHALL BE DONE ON FORCE MAIN.

ADDITIONAL CONSTRUCTION NOTES PER EASEMENT DOCUMENTS	
PROPERTY OWNER	NOTES
REBECCA A. BROWN (839 RURITAN ROAD)	CONTACT BECKY BROWN 2 WEEKS PRIOR TO WORKING ON PROPERTY. TRY TO WORK ON PROPERTY DURING TIMES THE BUSINESS IS CLOSED (JANUARY - FEBRUARY OR JULY - AUGUST). BE CAREFULL NOT TO DAMAGE FRENCH DRAIN/NEAR NEW PROPERTY LINE. NO EQUIPMENT IS TO BE DRIVEN ON CONCRETE PARKING AREA OUTSIDE OF EASEMENT.
NEW WILLARD PARK CEMETARY (RURITAN ROAD)	CARE MUST BE TAKEN TO ENSURE THAT NO GRAVES WILL BE DISTURBED.
GEORGE D. & HELEN W. WHALEY (814 RURITAN ROAD)	MAINTAIN ACCESS TO DRIVEWAY (RENTAL PROPERTY)


—REV. 12-23-13:
REVISED TO CHANGE 6" LATERALS
CROSSING RURITAN RD. FROM
PVC TO DIP.

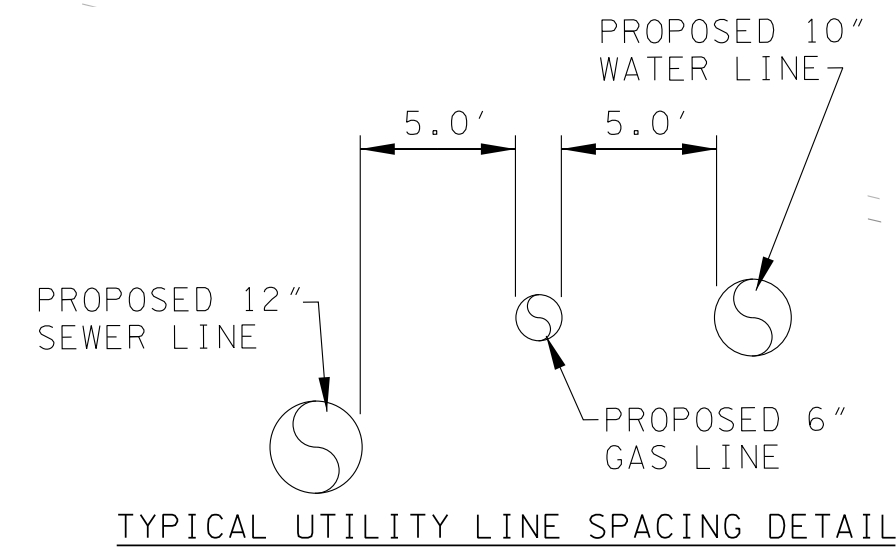

TYPE	YEAR	PROJECT NO.	SHEET NO.
CONST.	2014	STP-29(58)	U3-3
		73035-3209-14	

ROANE CO.

REV. 12-23-13:
REVISED TO ADD 12" STEEL
CASINGS, 6" & 12" PIPE
MATERIAL FROM PVC TO DIP.

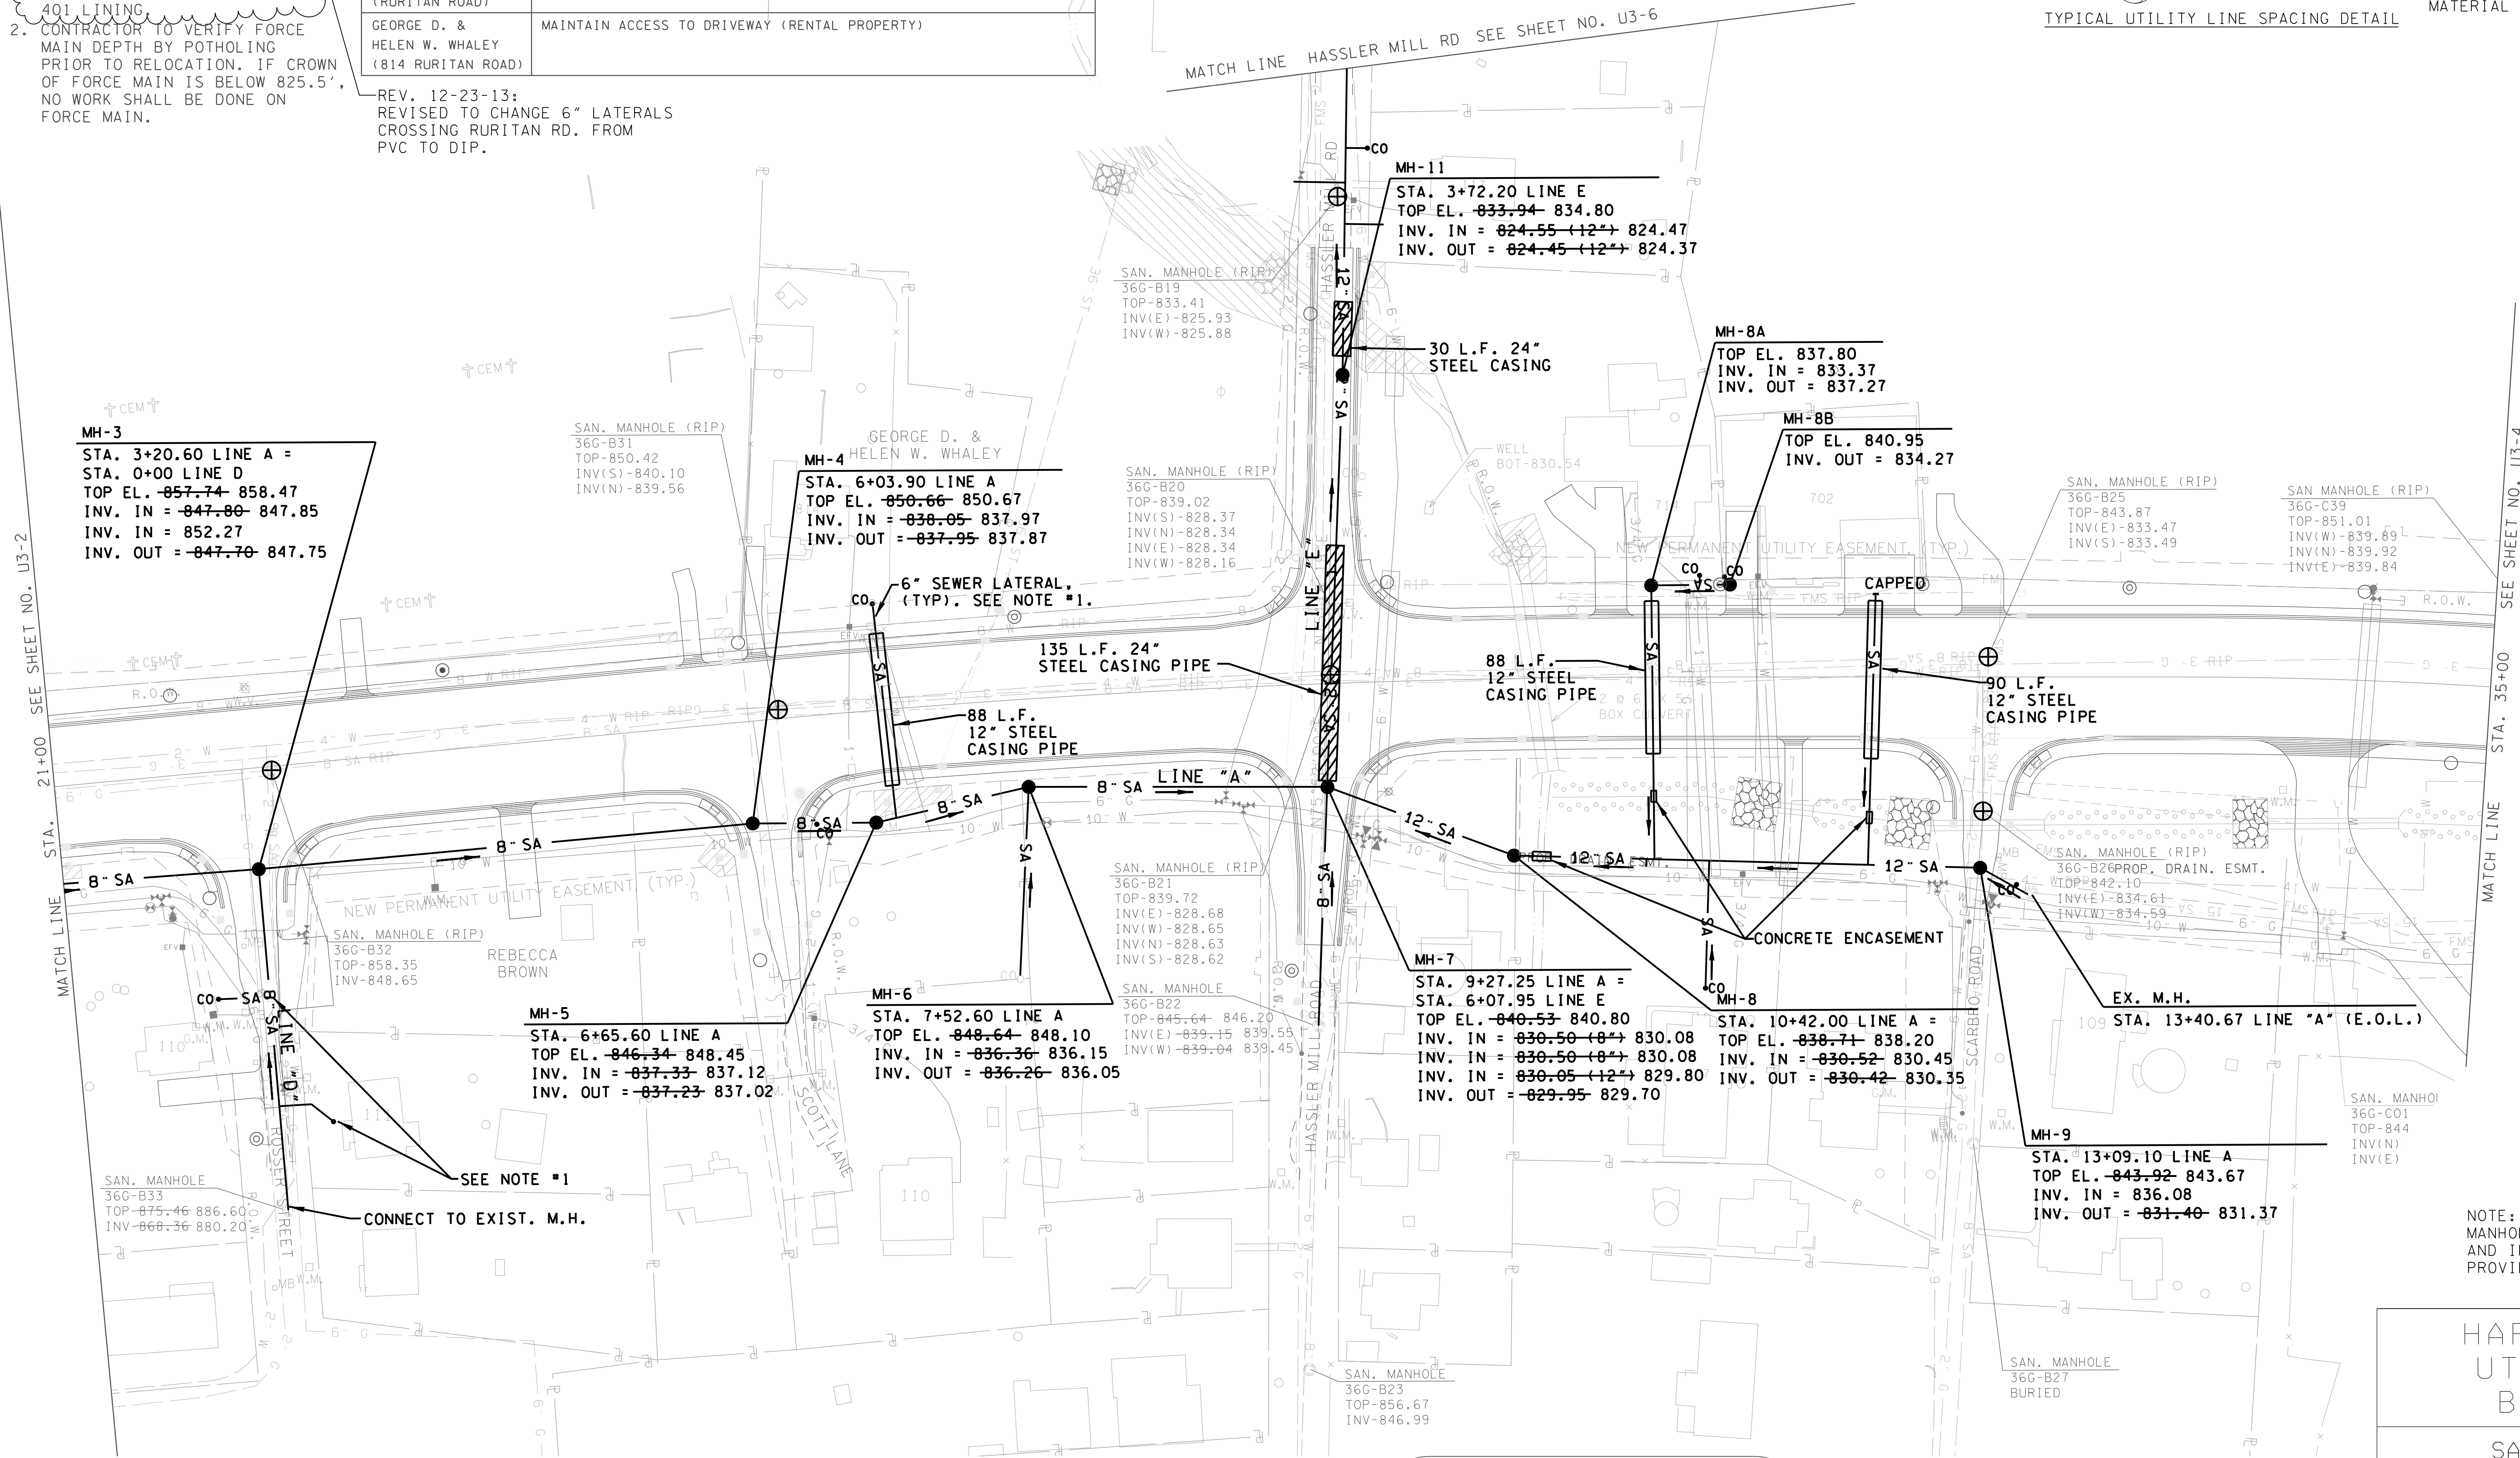



NOTE:
MANHOLE LOCATIONS, TOPS,
AND INVERT INFORMATION
PROVIDED BY ROGERS GROUP.

HARRIMAN
UTILITY
BOARD

SANITARY
SEWER LINE
RELOCATION

STA. 21+00.00 TO STA. 35+00.00
SCALE: 1"=50'

RECORD DRAWING
03/10/2017

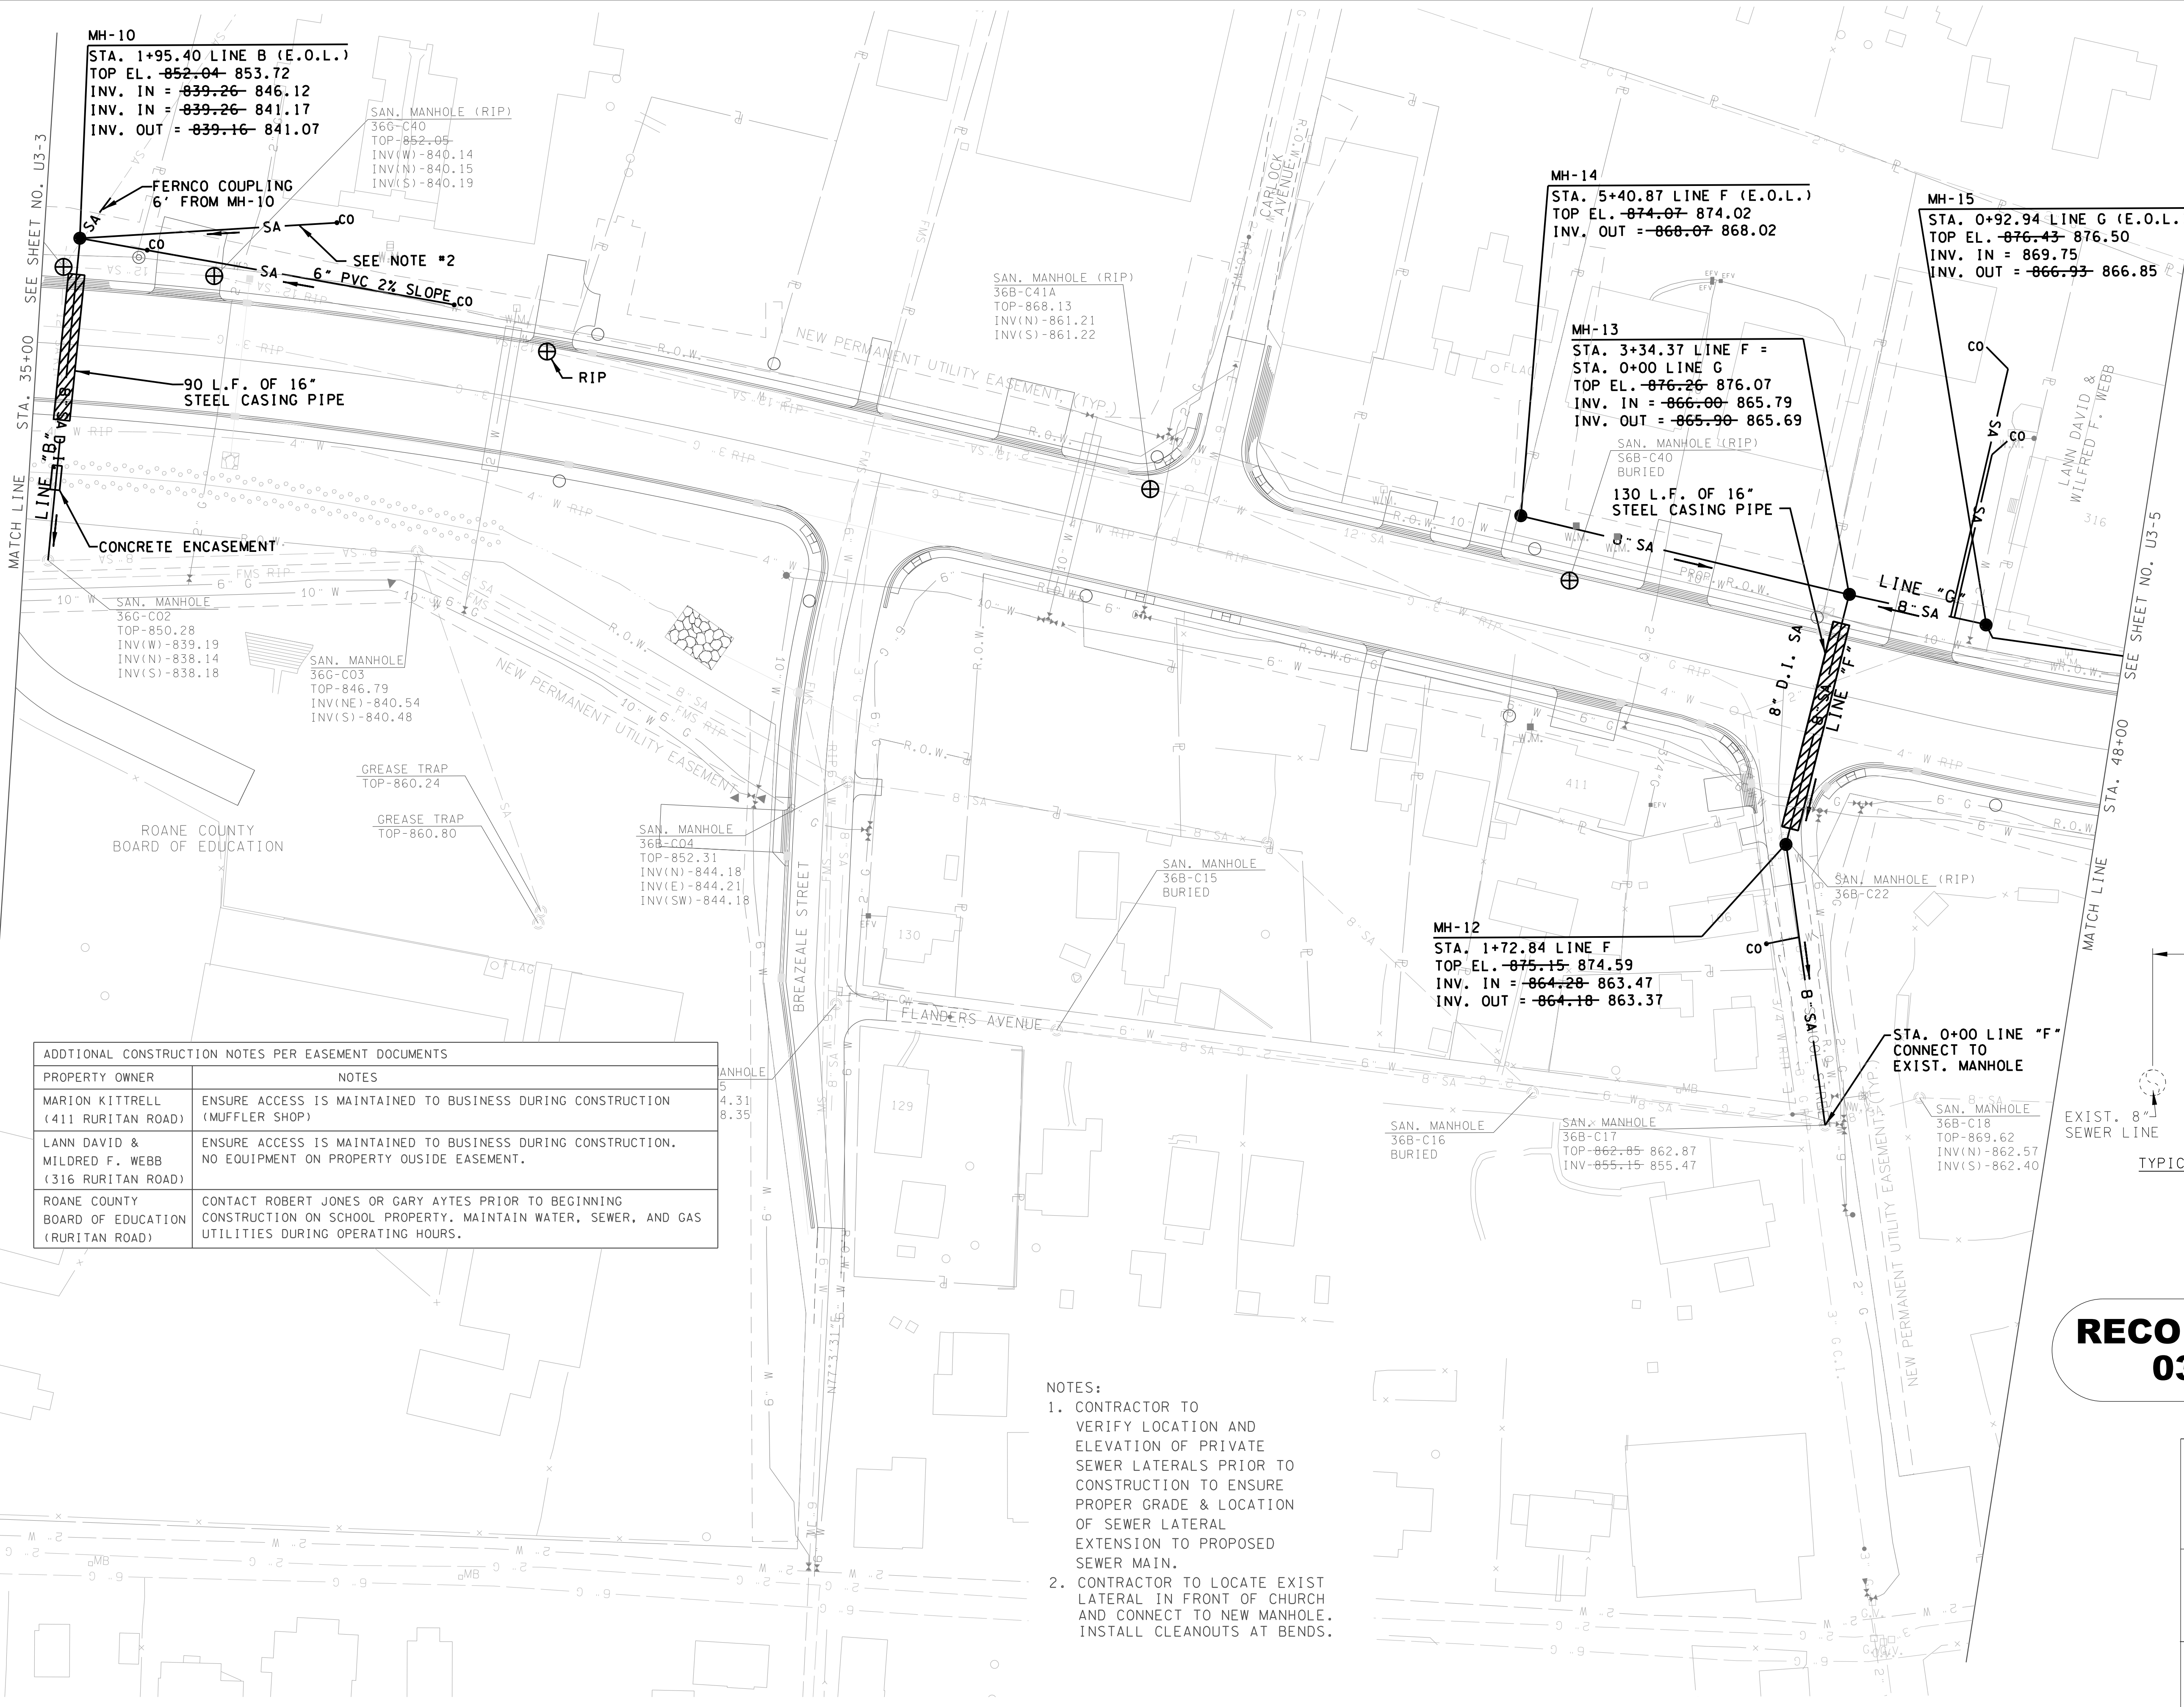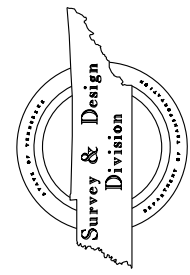

ADDITIONAL CONSTRUCTION NOTES PER EASEMENT DOCUMENTS	
PROPERTY OWNER	NOTES
MARION KITTRELL (411 RURITAN ROAD)	ENSURE ACCESS IS MAINTAINED TO BUSINESS DURING CONSTRUCTION (MUFFLER SHOP)
LANN DAVID & MILDRED F. WEBB (316 RURITAN ROAD)	ENSURE ACCESS IS MAINTAINED TO BUSINESS DURING CONSTRUCTION. NO EQUIPMENT ON PROPERTY OUTSIDE EASEMENT.
ROANE COUNTY BOARD OF EDUCATION (RURITAN ROAD)	CONTACT ROBERT JONES OR GARY AYTES PRIOR TO BEGINNING CONSTRUCTION ON SCHOOL PROPERTY. MAINTAIN WATER, SEWER, AND GAS UTILITIES DURING OPERATING HOURS.

- NOTES:
- CONTRACTOR TO VERIFY LOCATION AND ELEVATION OF PRIVATE SEWER LATERALS PRIOR TO CONSTRUCTION TO ENSURE PROPER GRADE & LOCATION OF SEWER LATERAL EXTENSION TO PROPOSED SEWER MAIN.
 - CONTRACTOR TO LOCATE EXIST LATERAL IN FRONT OF CHURCH AND CONNECT TO NEW MANHOLE. INSTALL CLEANOUTS AT BENDS.


RECORD DRAWING
03/10/2017

HARRIMAN UTILITY BOARD
SANITARY SEWER LINE RELOCATION
STA. 35+00.00 TO STA. 48+00.00 SCALE: 1"=50'


TYPE	YEAR	PROJECT NO.	SHEET NO.
CONST.	2014	STP-29(58)	U3-4
		73035-3209-14	

ROANE CO.

REV. 12-23-13:
REVISED 8" PIPE MATERIAL FROM
PVC TO DIP.

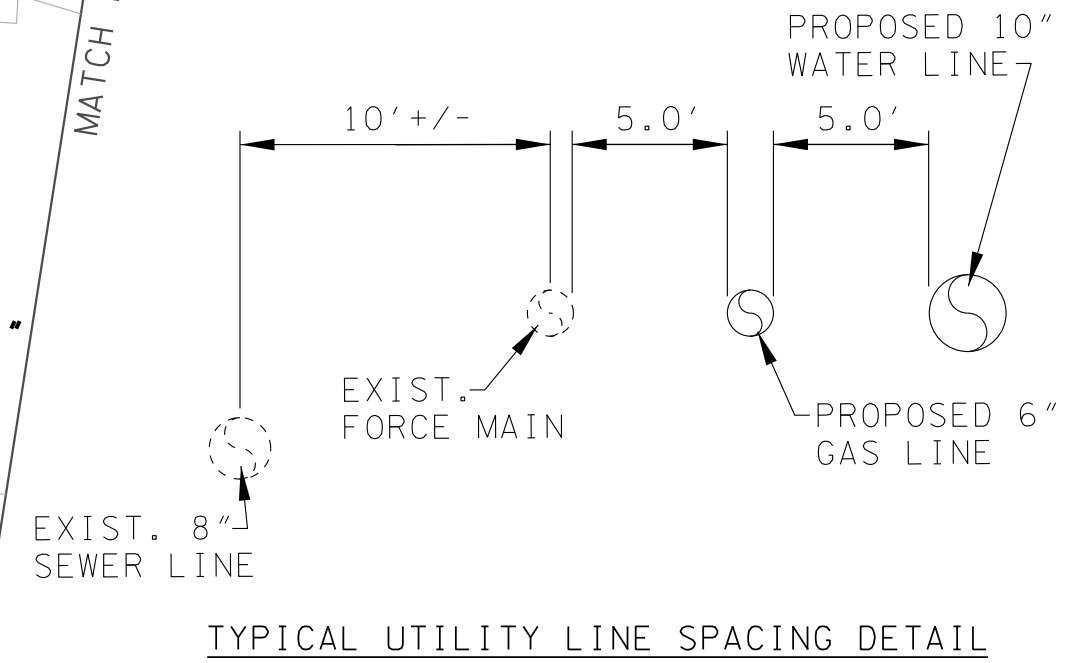

NOTE:
MANHOLE LOCATIONS, TOPS,
AND INVERT INFORMATION
PROVIDED BY ROGERS GROUP.

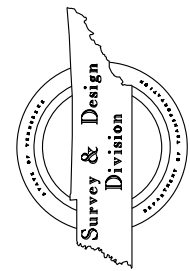

ADDITIONAL CONSTRUCTION NOTES PER EASEMENT DOCUMENTS	
PROPERTY OWNER	NOTES
ANN MCKINNEY & SHELBY SIKES (107 PANSY HILL RD)	BEAUTY SHOP IS CLOSED ON SATURDAYS, SUNDAYS, AND MONDAYS. CONTRACTOR SHALL NOTIFY PROPERTY OWNERS BEFORE BEGINNING WORK IN FRONT OF THE SALON SO THEY CAN DIRECT CUSTOMERS WHERE TO PARK (TUESDAY - FRIDAY).
HASKELL HILL (230 RURITAN ROAD)	CONTRACTOR TO ENSURE TENANTS HAVE ACCESS TO THE BACK OF THE BUILDING DURING CONSTRUCTION.
DONALD & PRECILLA LOMBARD (182 STATE STREET)	CONTRACTOR TO MAINTAIN ACCESS TO BARBER SHOP AND PARKING LOT DURING CONSTRUCTION.

NOTE:
1. CONTRACTOR TO VERIFY LOCATION AND ELEVATION OF PRIVATE SEWER LATERALS PRIOR TO CONSTRUCTION TO ENSURE PROPER GRADE & LOCATION OF SEWER LATERAL EXTENSION TO PROPOSED SEWER MAIN.

RECORD DRAWING
03/10/2017

NOTE:
MANHOLE LOCATIONS, TOPS, AND INVERT INFORMATION PROVIDED BY ROGERS GROUP.

HARRIMAN
UTILITY
BOARD

SANITARY
SEWER LINE
RELOCATION

STA. 48+00.00 TO END OF PROJ.
SCALE: 1"=50'


TYPE	YEAR	PROJECT NO.	SHEET NO.
CONST.	2014	STP-29(58)	U3-5
		73035-3209-14	

ROANE CO.

TYPE	YEAR	PROJECT NO.	SHEET NO.
CONST.	2014	STP-29(58)	U3-6
		73035-3209-14	

ROANE CO.

REV. 12-23-13:
REVISED DETAIL SHEET NUMBER,
ADDED PROTECTO 401 LINING
TO DIP.

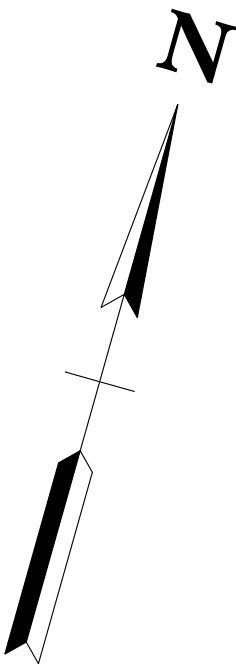

- NOTE:
- CONTRACTOR TO VERIFY LOCATION AND ELEVATION OF PRIVATE SEWER LATERALS PRIOR TO CONSTRUCTION TO ENSURE PROPER GRADE & LOCATION OF SEWER LATERAL EXTENSION TO PROPOSED SEWER MAIN.
 - CONTRACTOR TO REROUTE 6" DIP SERVICE LATERAL AROUND PROPOSED BOX CULVERT. INSTALL CLEANOUTS AT BENDS.

NOTE:
NO CONSTRUCTION ACTIVITY OF ANY KIND IS TO BE ALLOWED ON TRACT #100 - TENNESSEE VALLEY AUTHORITY (TVA)

NOTE:
MANHOLE LOCATIONS, TOPS,
AND INVERT INFORMATION
PROVIDED BY ROGERS GROUP.


RECORD DRAWING
03/10/2017

HARRIMAN
UTILITY
BOARD

SANITARY
SEWER LINE
RELOCATION

HASSLER MILL ROAD AND
BAUMGARTNER ROAD
SCALE: 1"=50'

M:\CTIN\Projects (A)\X\K\K4007 (Harriman Utility Board) TD0T Relocation\04.Design and Production\CAD Drawing\K4007 HUB Record Drawings (ID 495659)\RoSR2908-SEWER (NEW).shp

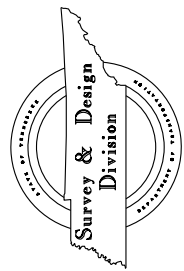

4/20/2017

