
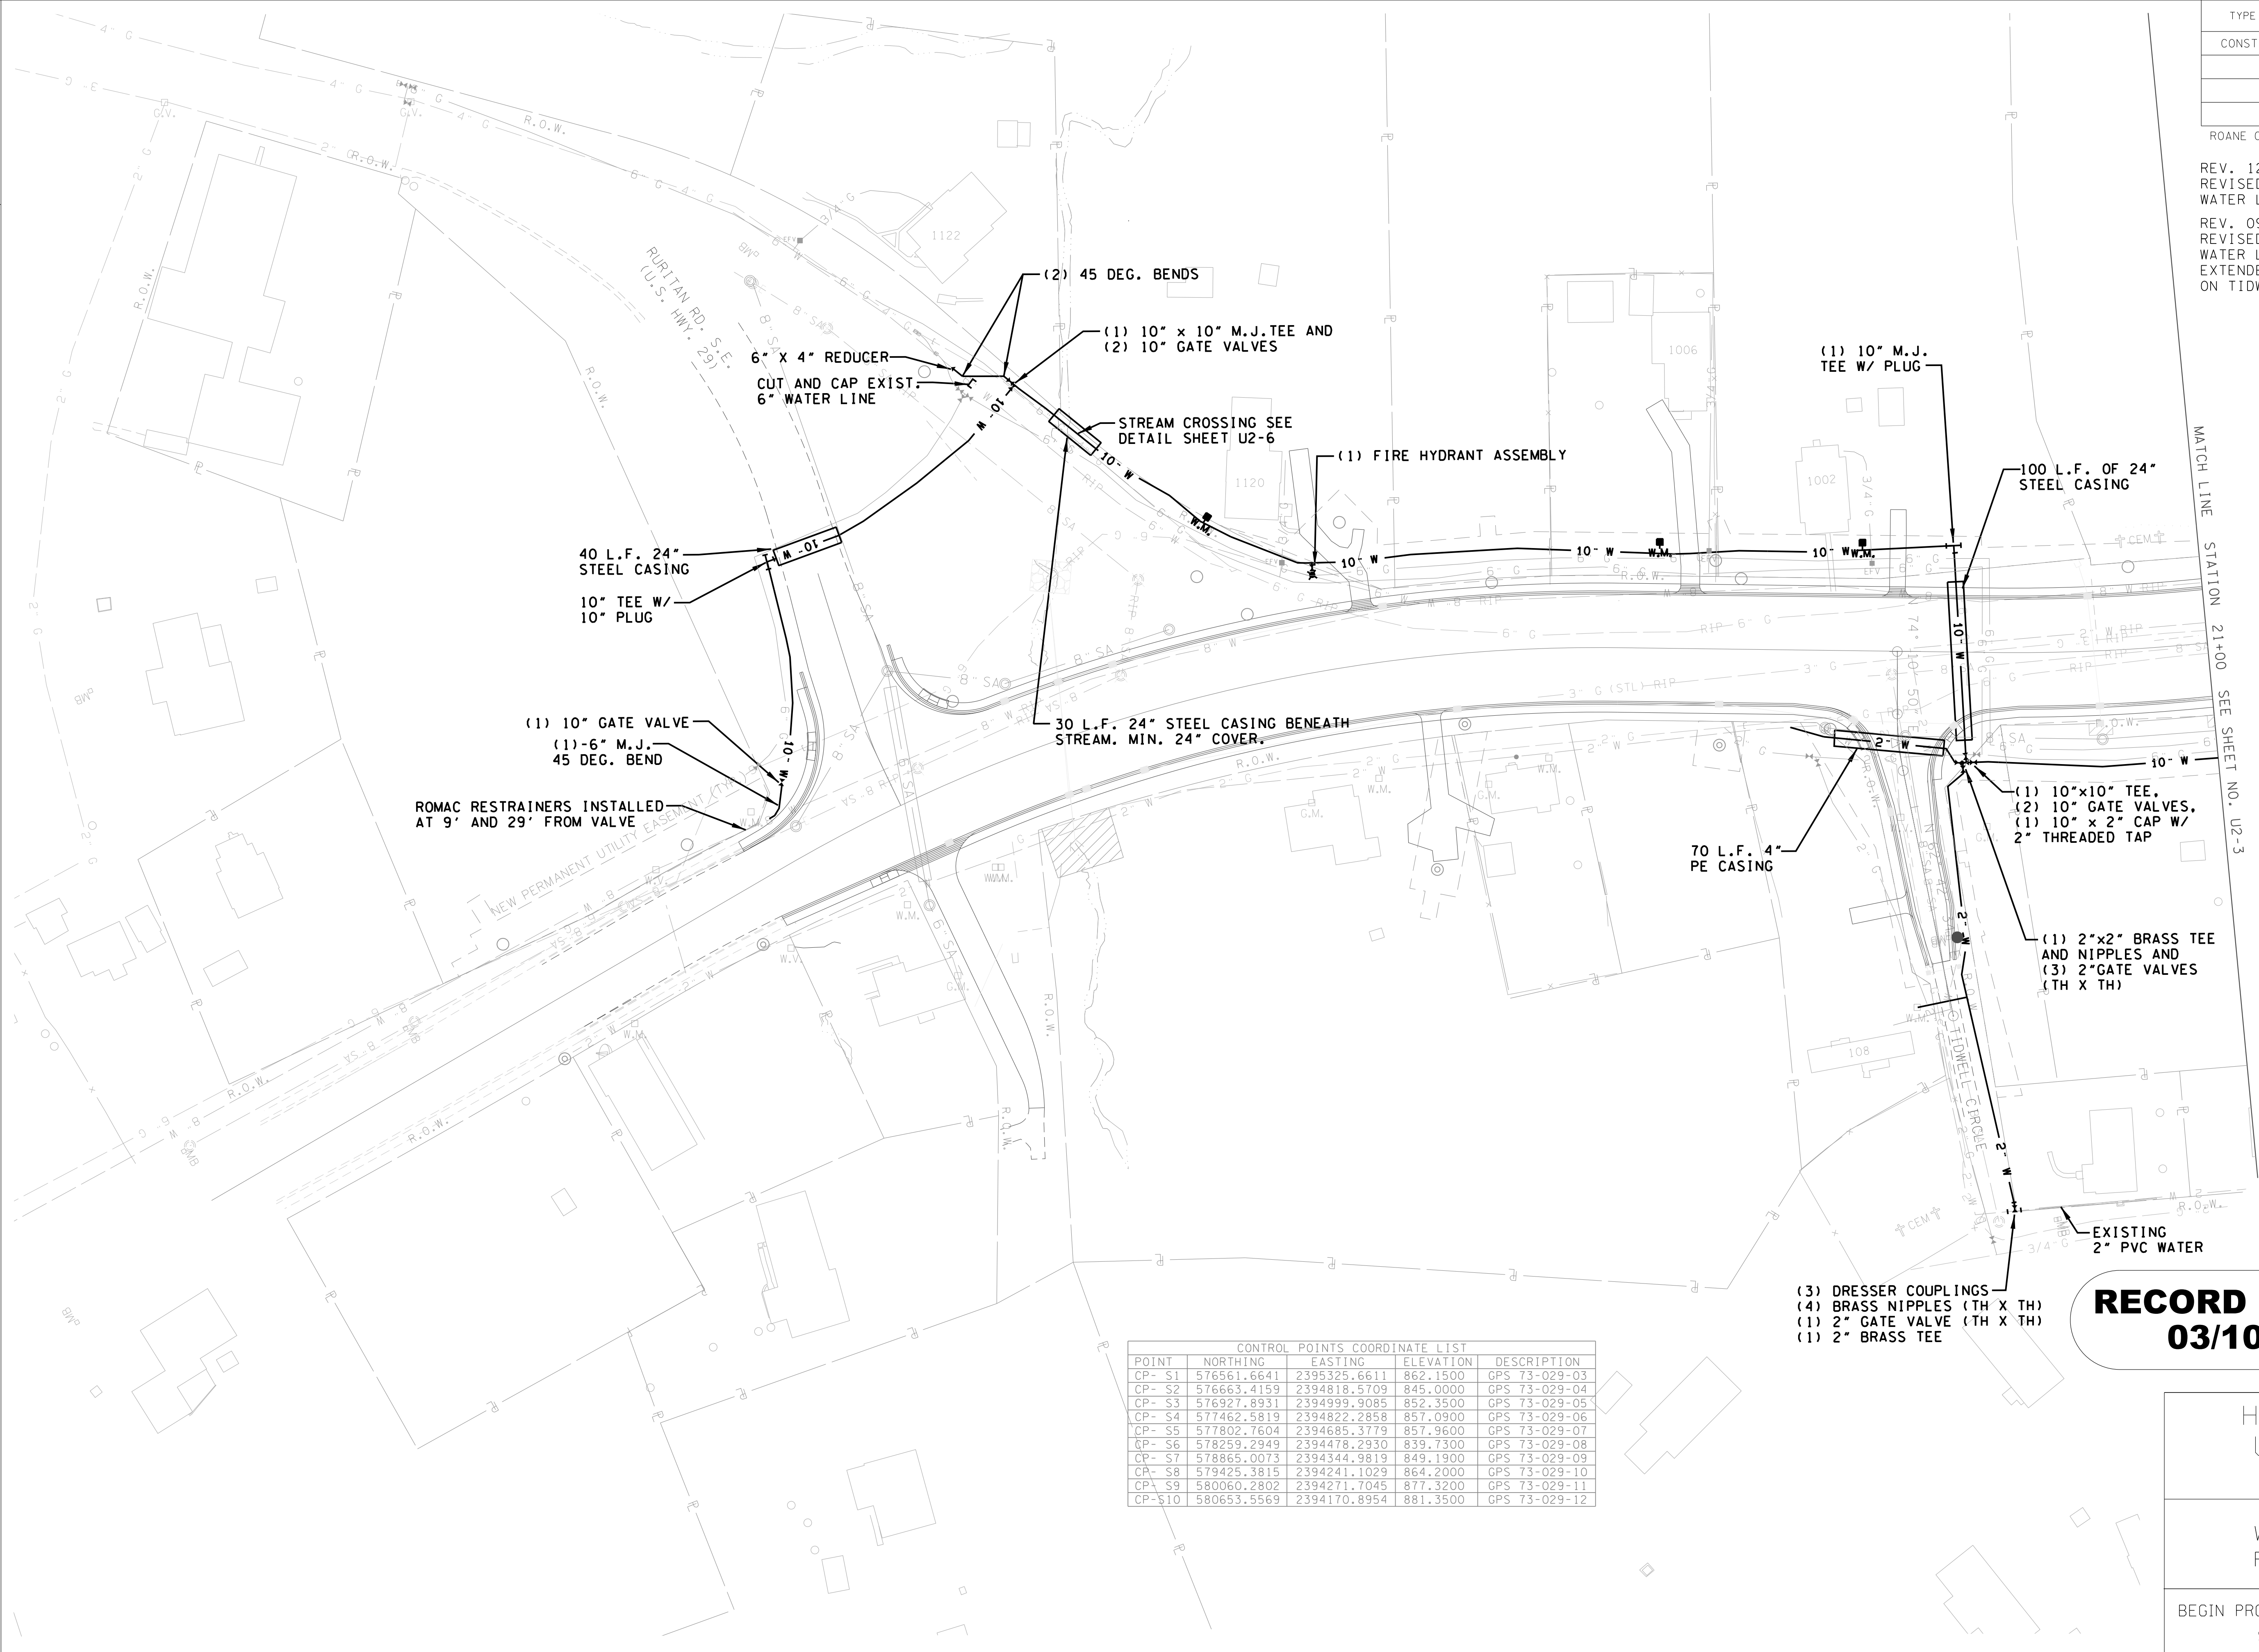


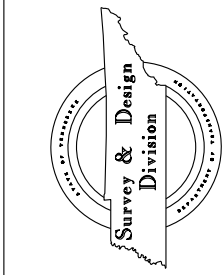

CONTROL POINTS COORDINATE LIST				
POINT	NORTHING	EASTING	ELEVATION	DESCRIPTION
CP- S1	576561.6641	2395325.6611	862.1500	GPS 73-029-03
CP- S2	576663.4159	2394818.5709	845.0000	GPS 73-029-04
CP- S3	576927.8931	2394999.9085	852.3500	GPS 73-029-05
CP- S4	577462.5819	2394822.2858	857.0900	GPS 73-029-06
CP- S5	577802.7604	2394685.3779	857.9600	GPS 73-029-07
CP- S6	578259.2949	2394478.2930	839.7300	GPS 73-029-08
CP- S7	578865.0073	2394344.9819	849.1900	GPS 73-029-09
CP- S8	579425.3815	2394241.1029	864.2000	GPS 73-029-10
CP- S9	580060.2802	2394271.7045	877.3200	GPS 73-029-11
CP- S10	580653.5569	2394170.8954	881.3500	GPS 73-029-12

TYPE	YEAR	PROJECT NO.	SHEET NO.
CONST.	2014	STP-29(58)	U2-2
		73035-3209-14	

ROANE CO.

REV. 12-23-13:
REVISED TO ADD 8" DIA.
WATER LINE.

REV. 09-04-15:
REVISED LOCATION OF 8" DIA.
WATER LINE AND REVISED NOTES.
EXTENDED 2" DIA. WATER LINE
ON TIDWELL CIRCLE.

RECORD DRAWING
03/10/2017

HARRIMAN
UTILITY
BOARD

WATER LINE
RELOCATION

BEGIN PROJ. TO STA. 21+00.00
SCALE: 1"=50'

ADDITIONAL CONSTRUCTION NOTES PER EASEMENT DOCUMENTS	
PROPERTY OWNER	NOTES
REBECCA A. BROWN (839 RURITAN ROAD)	CONTACT BECKY BROWN 2 WEEKS PRIOR TO WORKING ON PROPERTY. TRY TO WORK ON PROPERTY DURING TIMES THE BUSINESS IS CLOSED (JANUARY - FEBRUARY OR JULY - AUGUST). BE CAREFULL NOT TO DAMAGE FRENCH DRAIN NEAR NEW PROPERTY LINE. NO EQUIPMENT IS TO BE DRIVEN ON CONCRETE PARKING AREA OUTSIDE OF EASEMENT.
NEW WILLARD PARK CEMETARY (RURITAN ROAD)	CARE MUST BE TAKEN TO ENSURE THAT NO GRAVES WILL BE DISTURBED.
GEORGE D. & HELEN W. WHALEY (814 RURITAN ROAD)	MAINTAIN ACCESS TO DRIVEWAY (RENTAL PROPERTY)


TYPE	YEAR	PROJECT NO.	SHEET NO.
CONST.	2014	STP-29(58)	U2-3
		73035-3209-14	

ROANE CO.

REV. 08-27-12:
REVISED PER T.D.O.T COMMENTS.

REV. 09-21-12:
REVISED PER T.D.O.T
CONSTRUCTION NUMBER CHANGE.

REV. 04-25-13:
REVISED PER T.D.O.T
ROADWAY REVISION.

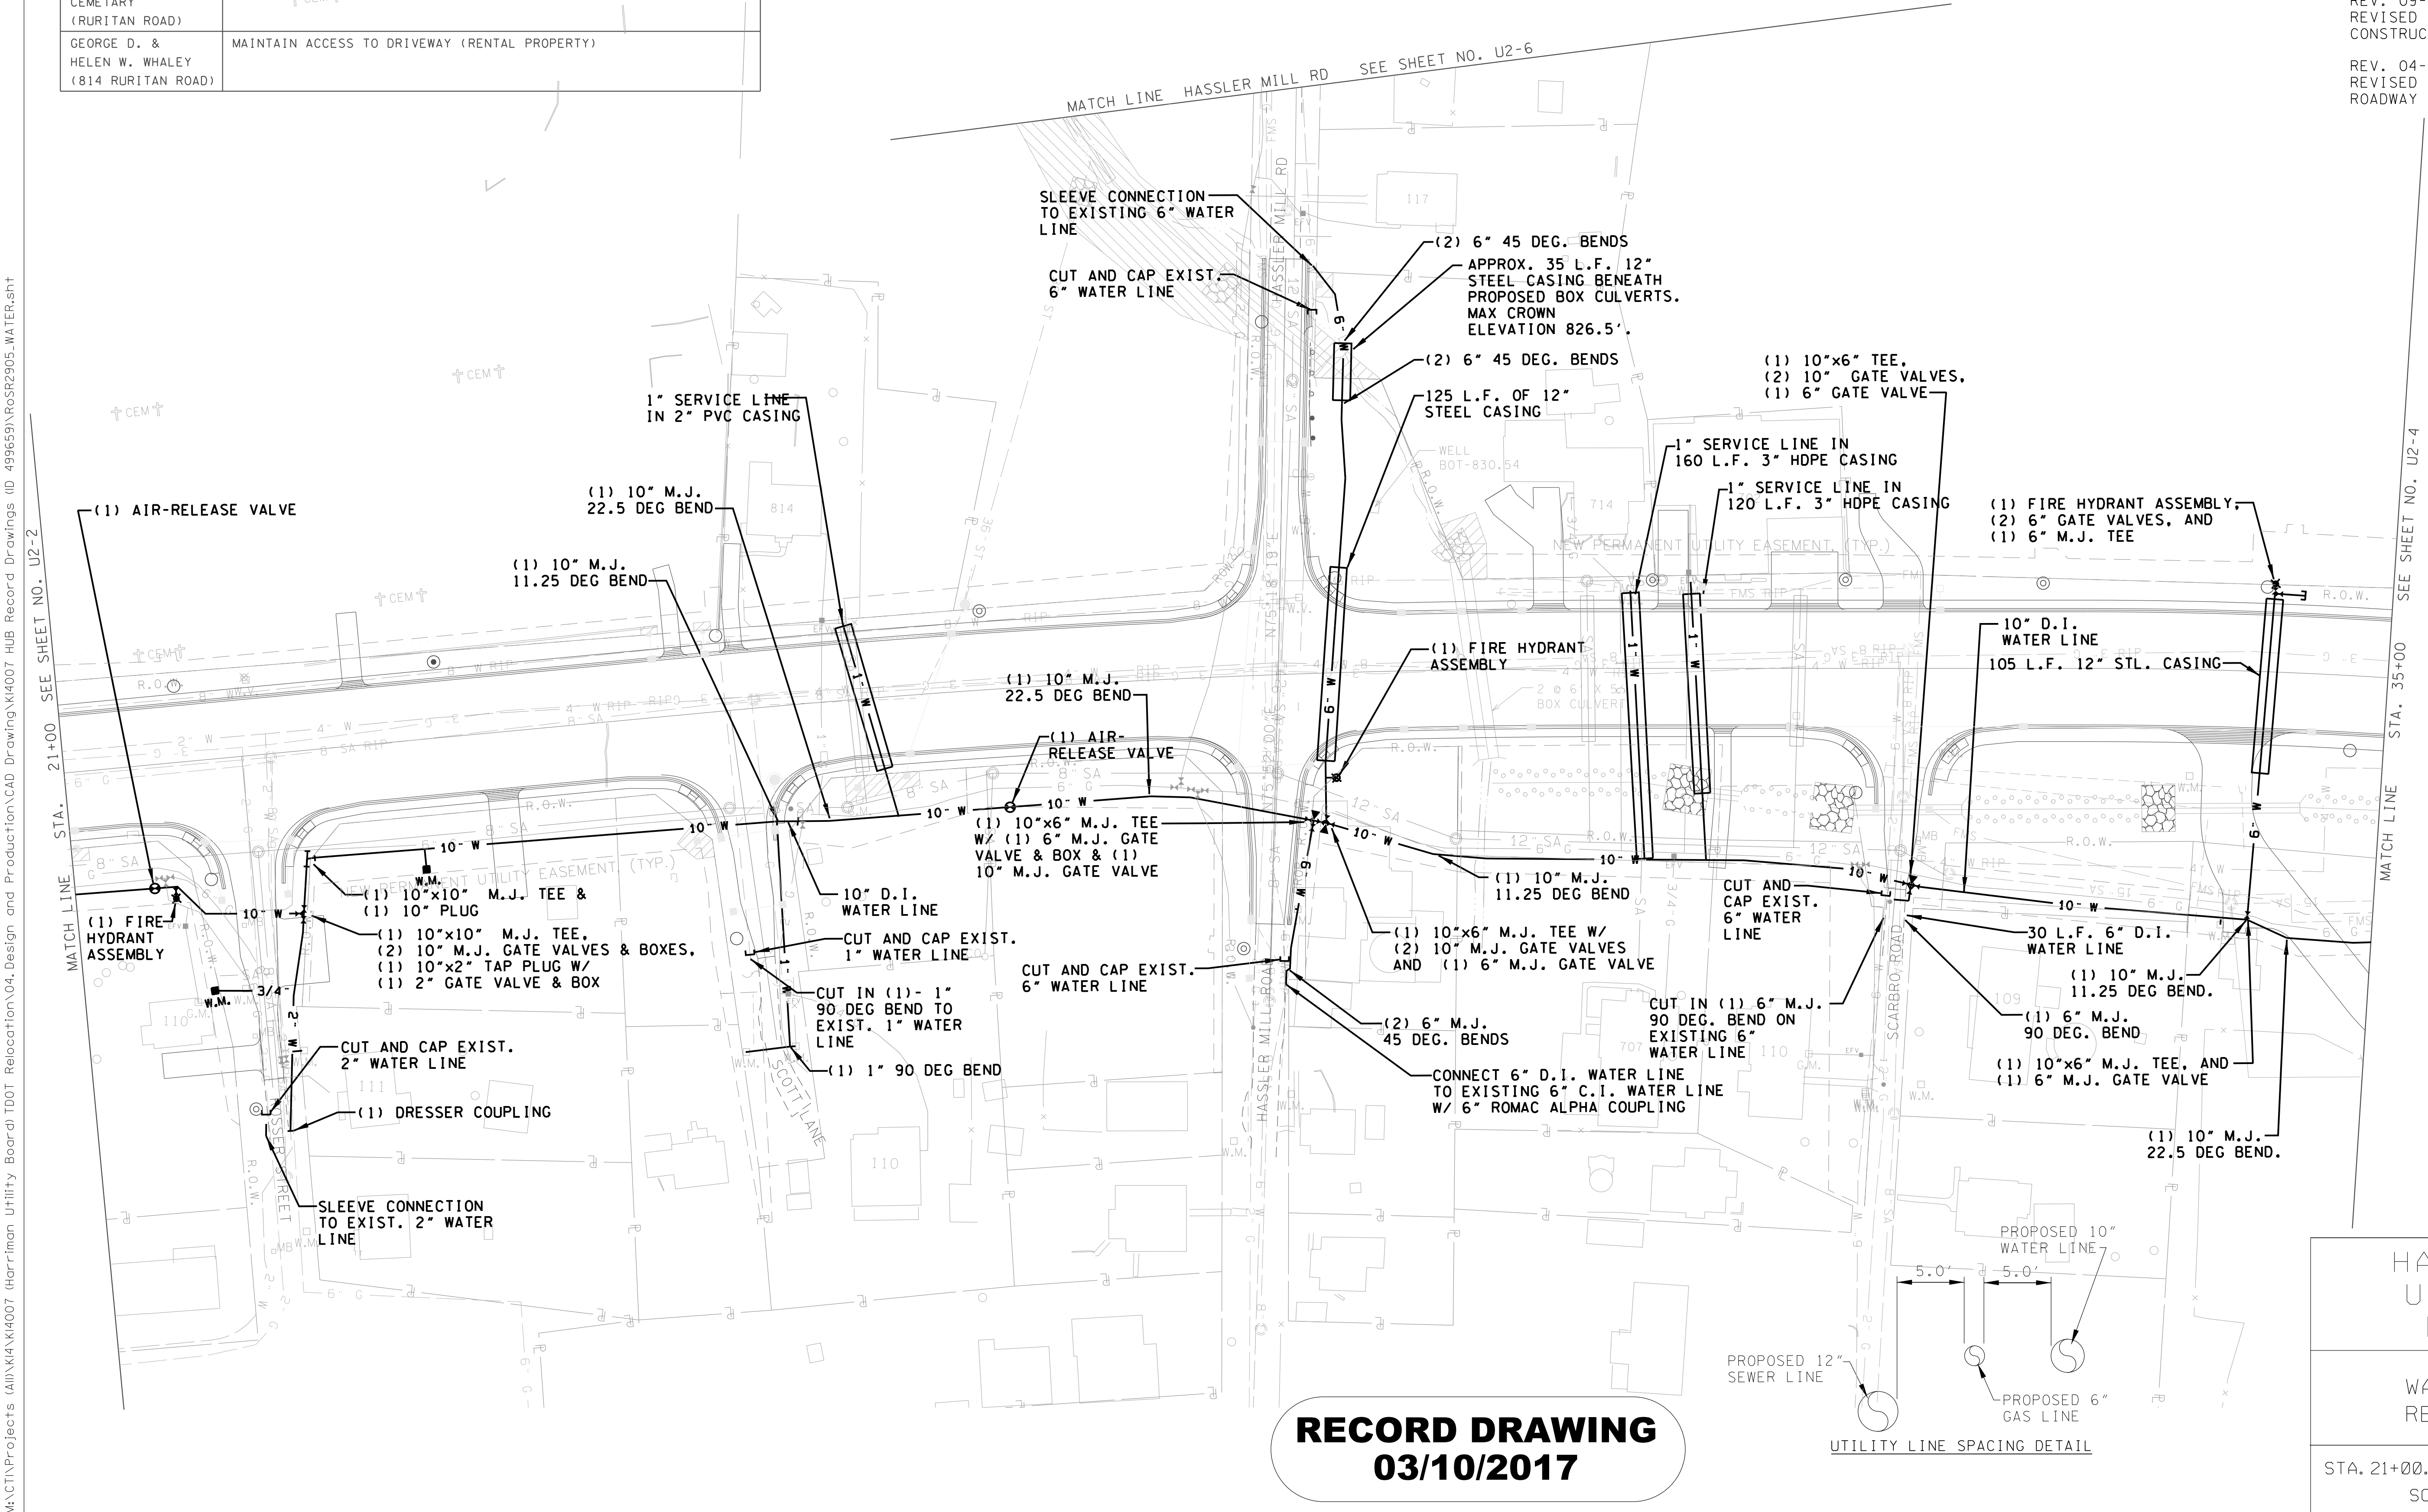



RECORD DRAWING
03/10/2017

UTILITY LINE SPACING DETAIL

HARRIMAN
UTILITY
BOARD

WATER LINE
RELOCATION

STA. 21+00.00 TO STA. 35+00.00
SCALE: 1"=50'

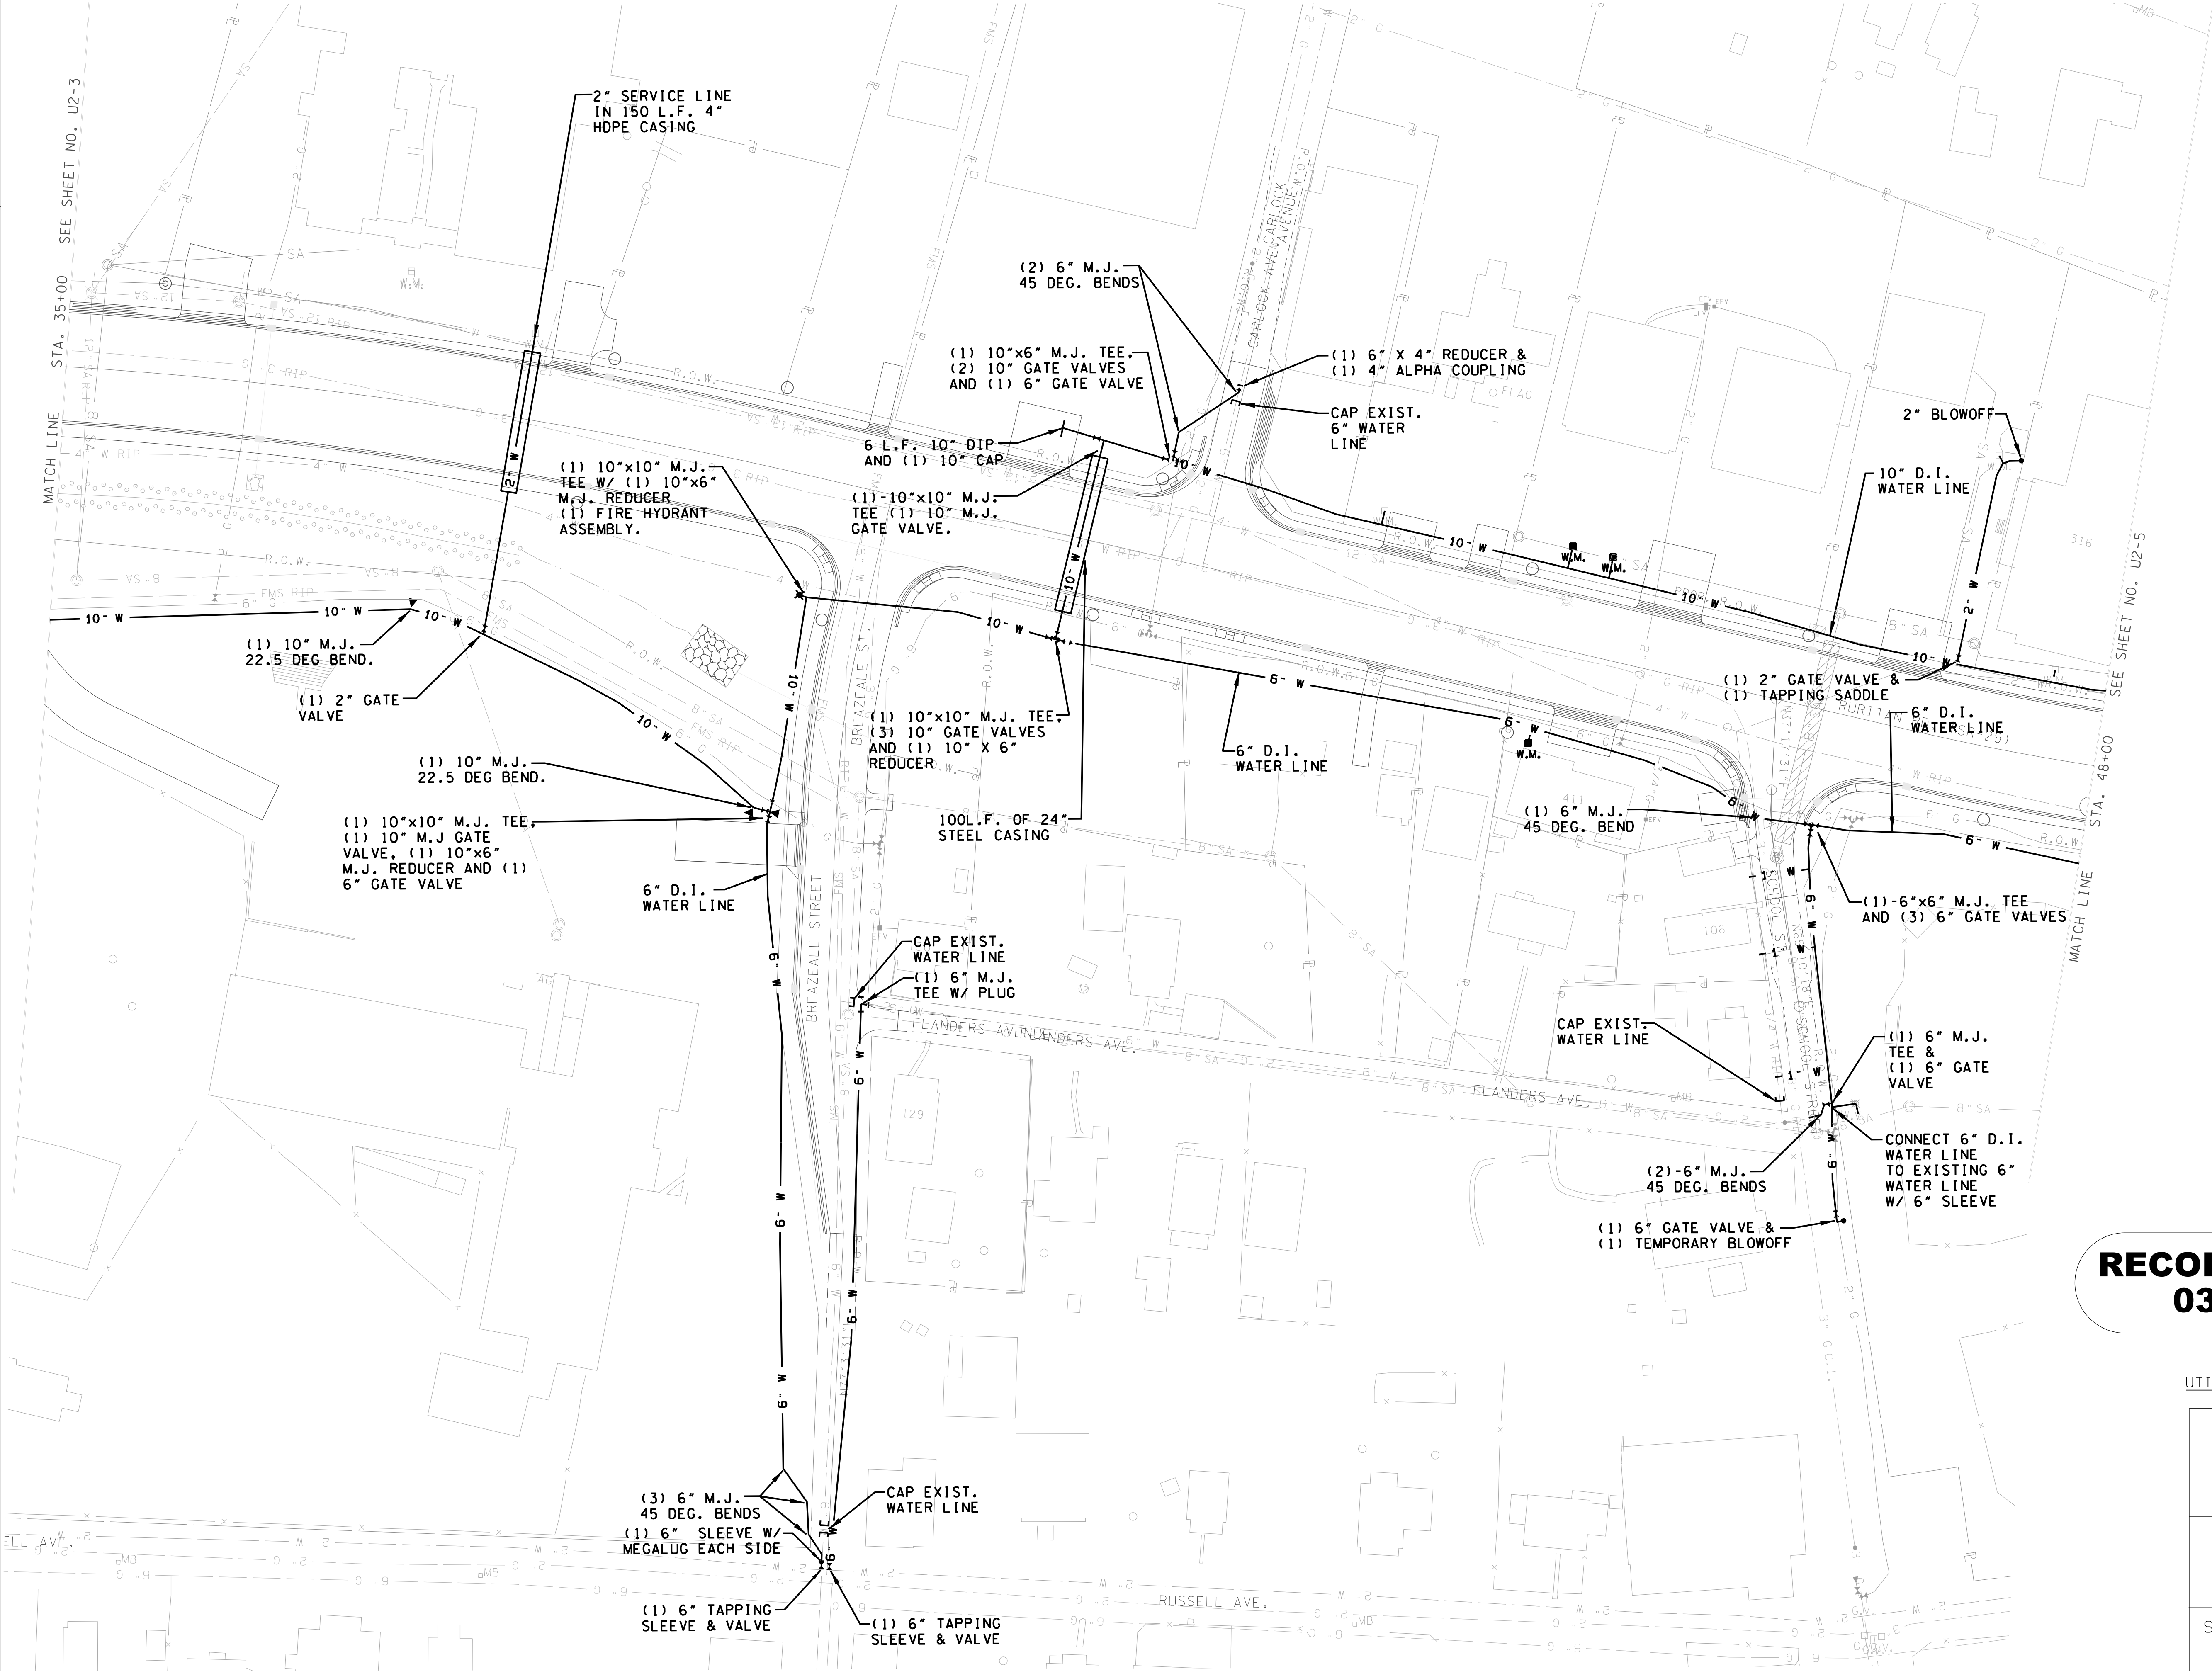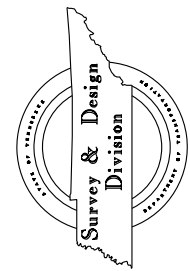

TYPE	YEAR	PROJECT NO.	SHEET NO.
CONST.	2014	STP-29(58)	U2-4
		73035-3209-14	

ROANE CO.

REV. 08-27-12:
REVISED PER T.D.O.T COMMENTS.

REV. 09-21-12:
REVISED PER T.D.O.T
CONSTRUCTION NUMBER CHANGE.

REV. 04-25-13:
REVISED PER T.D.O.T.
ROADWAY REVISION

REV. 08-21-15:
EXTENDED WATERLINES EACH SIDE
OF BREAZEALE ST TO RUSSELL
AVE.


RECORD DRAWING
03/10/2017

UTILITY LINE SPACING DETAIL

HARRIMAN
UTILITY
BOARD

WATER LINE
RELOCATION

STA. 35+00.00 TO STA. 48+00.00
SCALE: 1"=50'

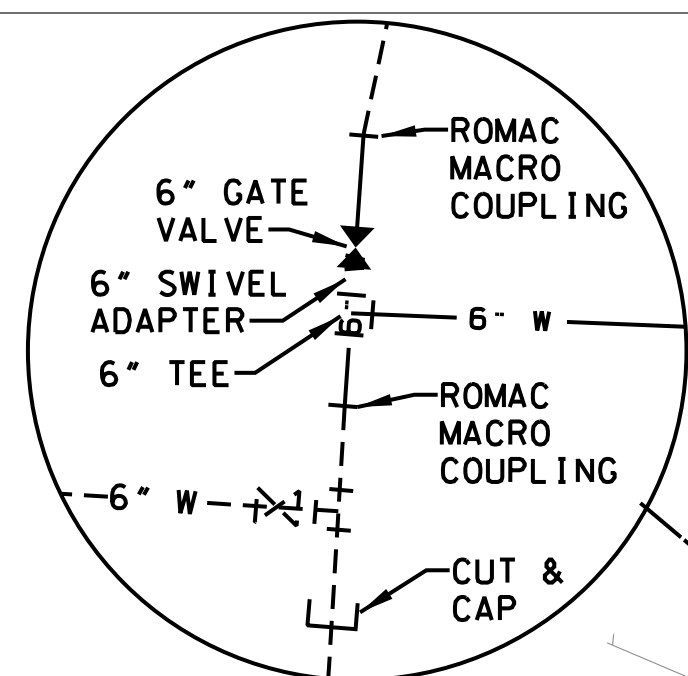

TYPE	YEAR	PROJECT NO.	SHEET NO.
CONST.	2014	STP-29(58)	U2-5
		73035-3209-14	

ROANE CO.

REV. 08-27-12:
REVISED PER T.D.O.T COMMENTS.

REV. 09-21-12:
REVISED PER T.D.O.T
CONSTRUCTION NUMBER CHANGE.

REV. 04-25-13:
REVISED PER T.D.O.T.
ROADWAY REVISION

REV. 10-20-15:
REVISED CONNECTION TO EXISTING
WATERLINE AT INTERSECTION OF
PANSY HILL ROAD & RUSSELL
AVENUE.

REV. 02-02-16:
REVISED CONNECTION TO EXISTING
WATERLINE AT INTERSECTION OF
STATE STREET & BAUMGARDNER
AVENUE.

HARRIMAN UTILITY BOARD

WATER LINE RELOCATION

A.48+00.00 TO END OF PROJ.
SCALE: 1"=50'


REV. 02-02-16:
REVISED CONNECTION TO EXISTING
WATERLINE AT INTERSECTION OF
STATE STREET & BAUMGARDNER
AVENUE.

RECORD DRAWING
03/10/2017

TYPE	YEAR	PROJECT NO.	SHEET NO.
CONST.	2014	STP-29(58)	U2-6
		73035-3209-14	

ROANE CO.

REV. 04-25-13:
REVISED PER T.D.O.T
ROADWAY REVISION.

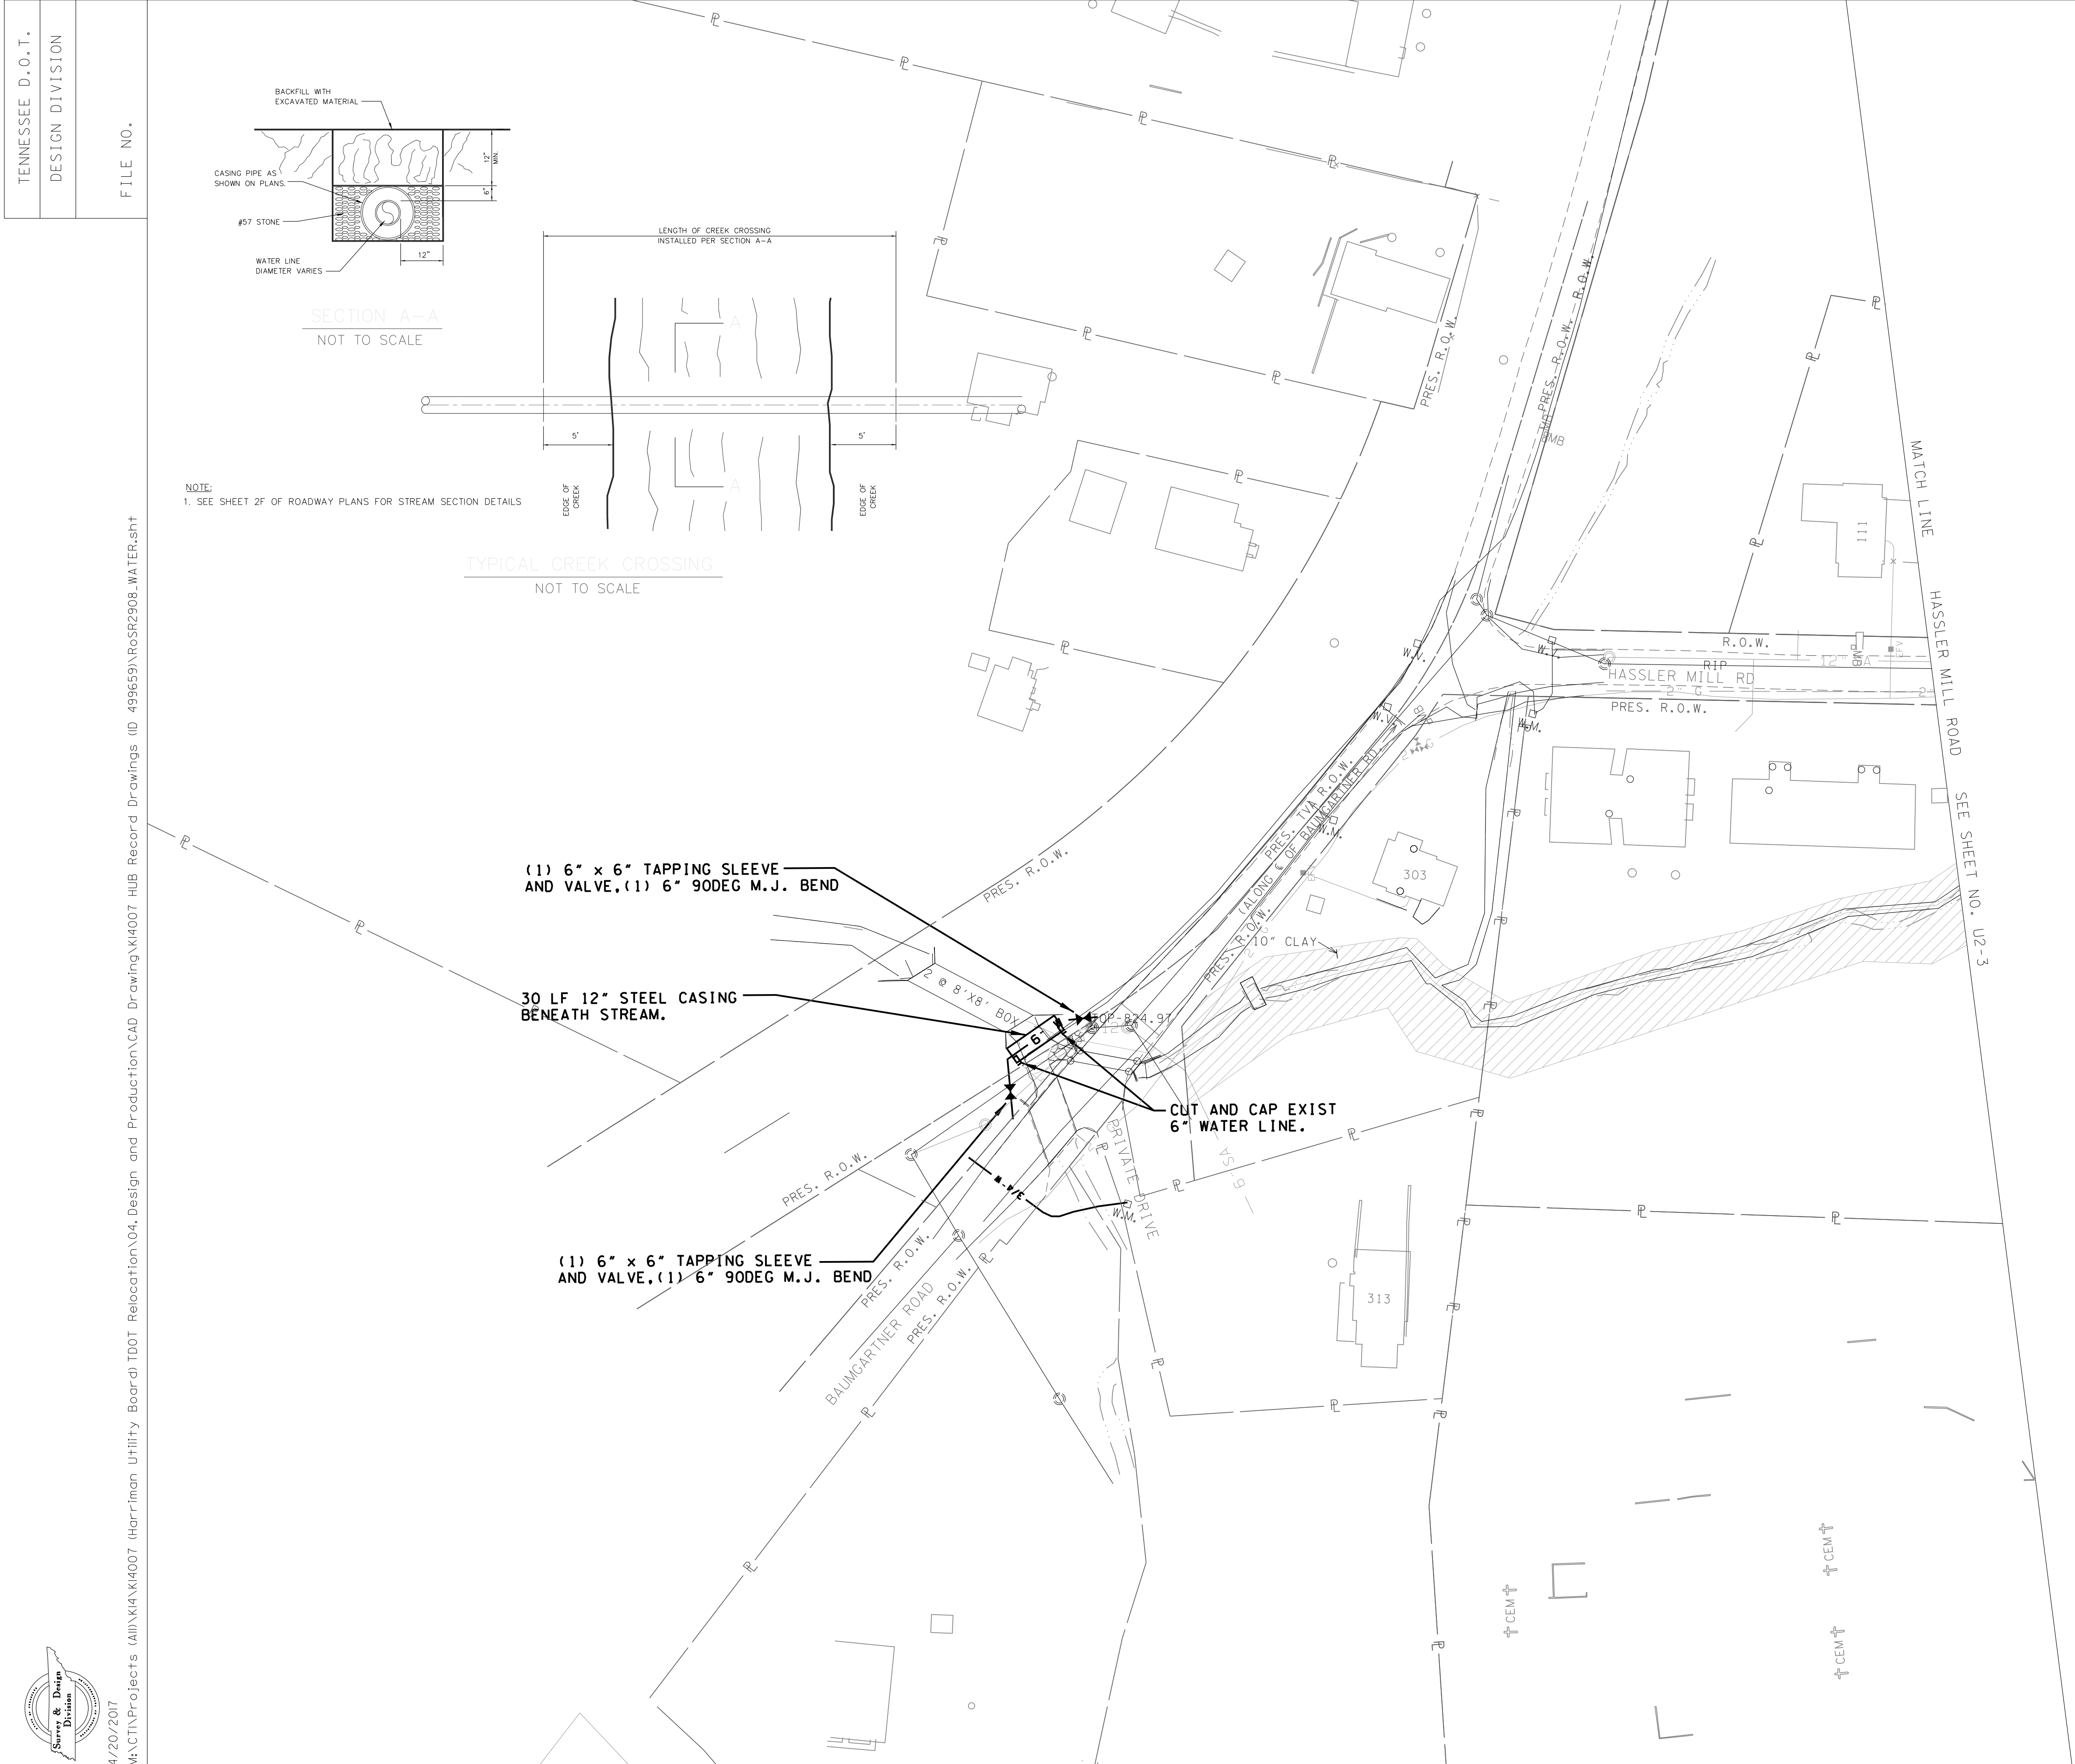

NOTE:
NO CONSTRUCTION ACTIVITY OF ANY KIND
IS TO BE ALLOWED ON TRACT #100 -
TENNESSEE VALLEY AUTHORITY (TVA)

RECORD DRAWING
03/01/2017

HARRIMAN
UTILITY
BOARD

WATER LINE
RELOCATION

HASSLER MILL ROAD AND
BAUMGARTNER ROAD
SCALE: 1"=50'

