

MO1 C 9C

2

3

4

5

6

7

8

9

10

11

12

KIF - UTILITY RESTORATION HARRIMAN UTILITY BOARD - GAS


DRAWING INDEX

670-HG001	TITLE SHEET
670-HG002	PLAN AND SECTIONS SHEET 1 OF 3
670-HG003	PLAN AND SECTIONS SHEET 2 OF 3
670-HG004	PLAN AND SECTIONS SHEET 3 OF 3
670-HG005	DETAIL SHEET

"TVA"
Ash Spill



SITE MAP

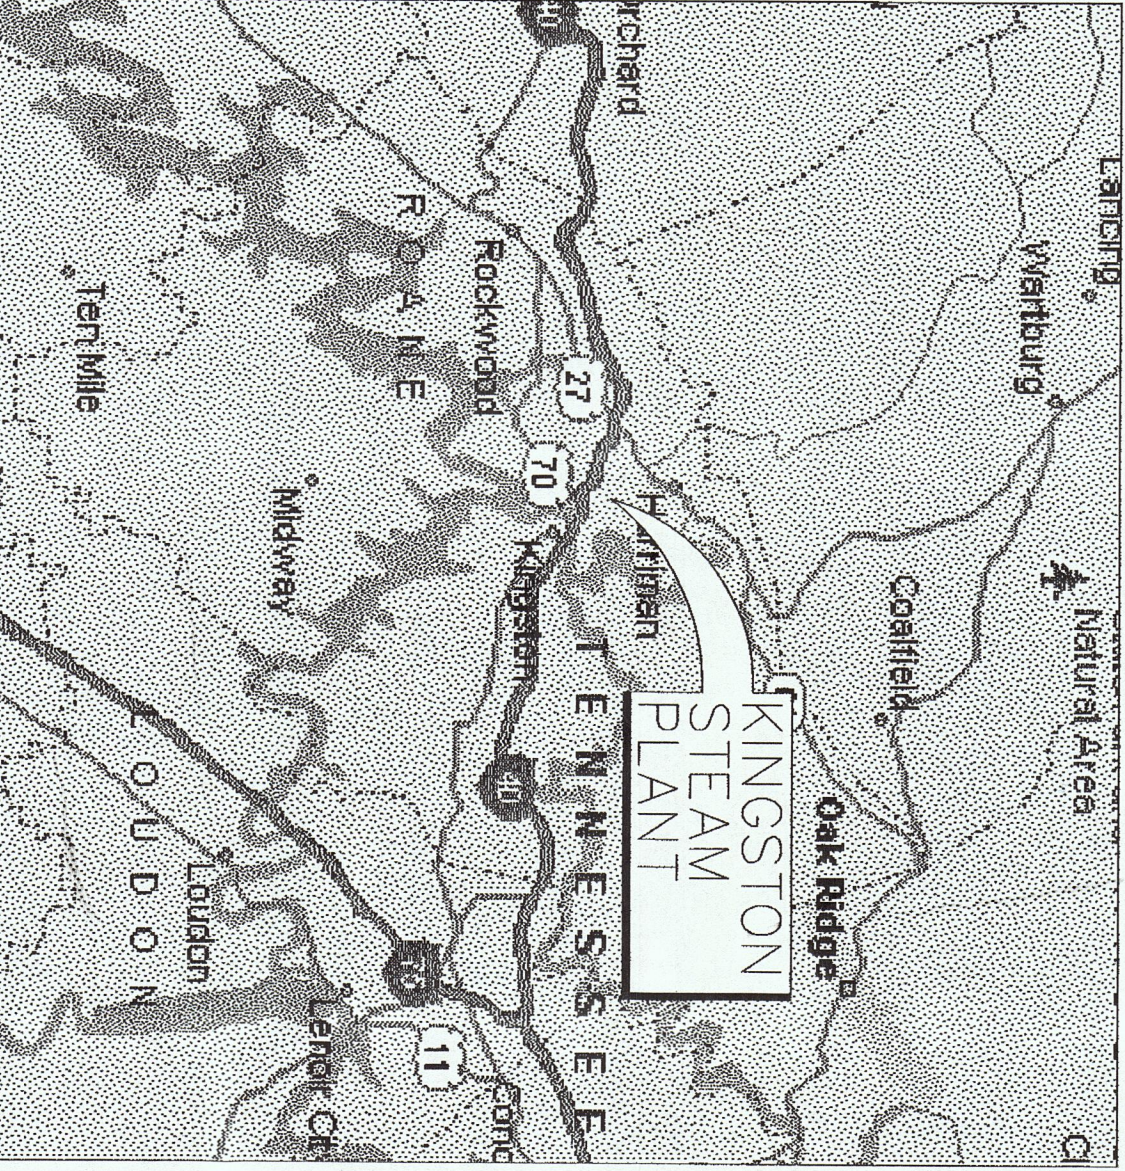

VICINITY MAP

PREPARED BY:



CTI ENGINEERS, INC.
112 DUNWOOD ROAD SUITE A
KNOXVILLE, TN 37922
606-596-5700

JOHN L. KING, P.E.
TENNESSEE LICENSE NO. 103702

7/31/09
DATE

NOTE:
THESE RECORD DRAWINGS PREPARED BY CTI ARE BASED UPON THE REPRESENTATIONS OF OTHERS (MAYBE CONSTRUCTION COMPANY, OF CHATTANOOGA, TENNESSEE) AND ARE NOT FOR BIDDING, PERMIT OR CONSTRUCTION PURPOSES. THESE DRAWINGS HAVE BEEN REVIEWED BY CTI AND ARE BELIEVED TO REFLECT TO THE BEST OF OUR KNOWLEDGE, AN ACCURATE RECORD OF THE WORK AS CONSTRUCTED. THE INFORMATION CONTAINED HEREIN SHOULD BE FIELD-VERIFIED PRIOR TO BEING USED FOR FUTURE DESIGN AND/OR CONSTRUCTION.

RECORD DRAWING
12-17-2010

R 1	12/17/10	JLK	JMG	JLK	-	-	JLK	-	-	-	-	D
RECORD DRAWING	NO.	DATE	SCALE	DATE	SCALE	DATE	SCALE	DATE	SCALE	DATE	SCALE	DATE
SCALE: NOT TO SCALE	EXCEPT AS NOTED											

YARD
CIVIL

KIF - UTILITY RESTORATION
HARRIMAN UTILITY BOARD - GAS
TITLE SHEET




KINGSTON FOSSIL PLANT
TENNESSEE VALLEY AUTHORITY
FOSSIL AND HYDRO ENGINEERING

AUTOCAD R07 3/17/09 36 C 670-HG001.1 R 1

CONSOLIDATED TECH., INC. TASK COMPLETED BY: REV NO. C.A.D. DRAWING DO NOT ALTER MANUALLY

CIVIL
YARD



**C.A.D. DRAWING
DO NOT ALTER MANUA**

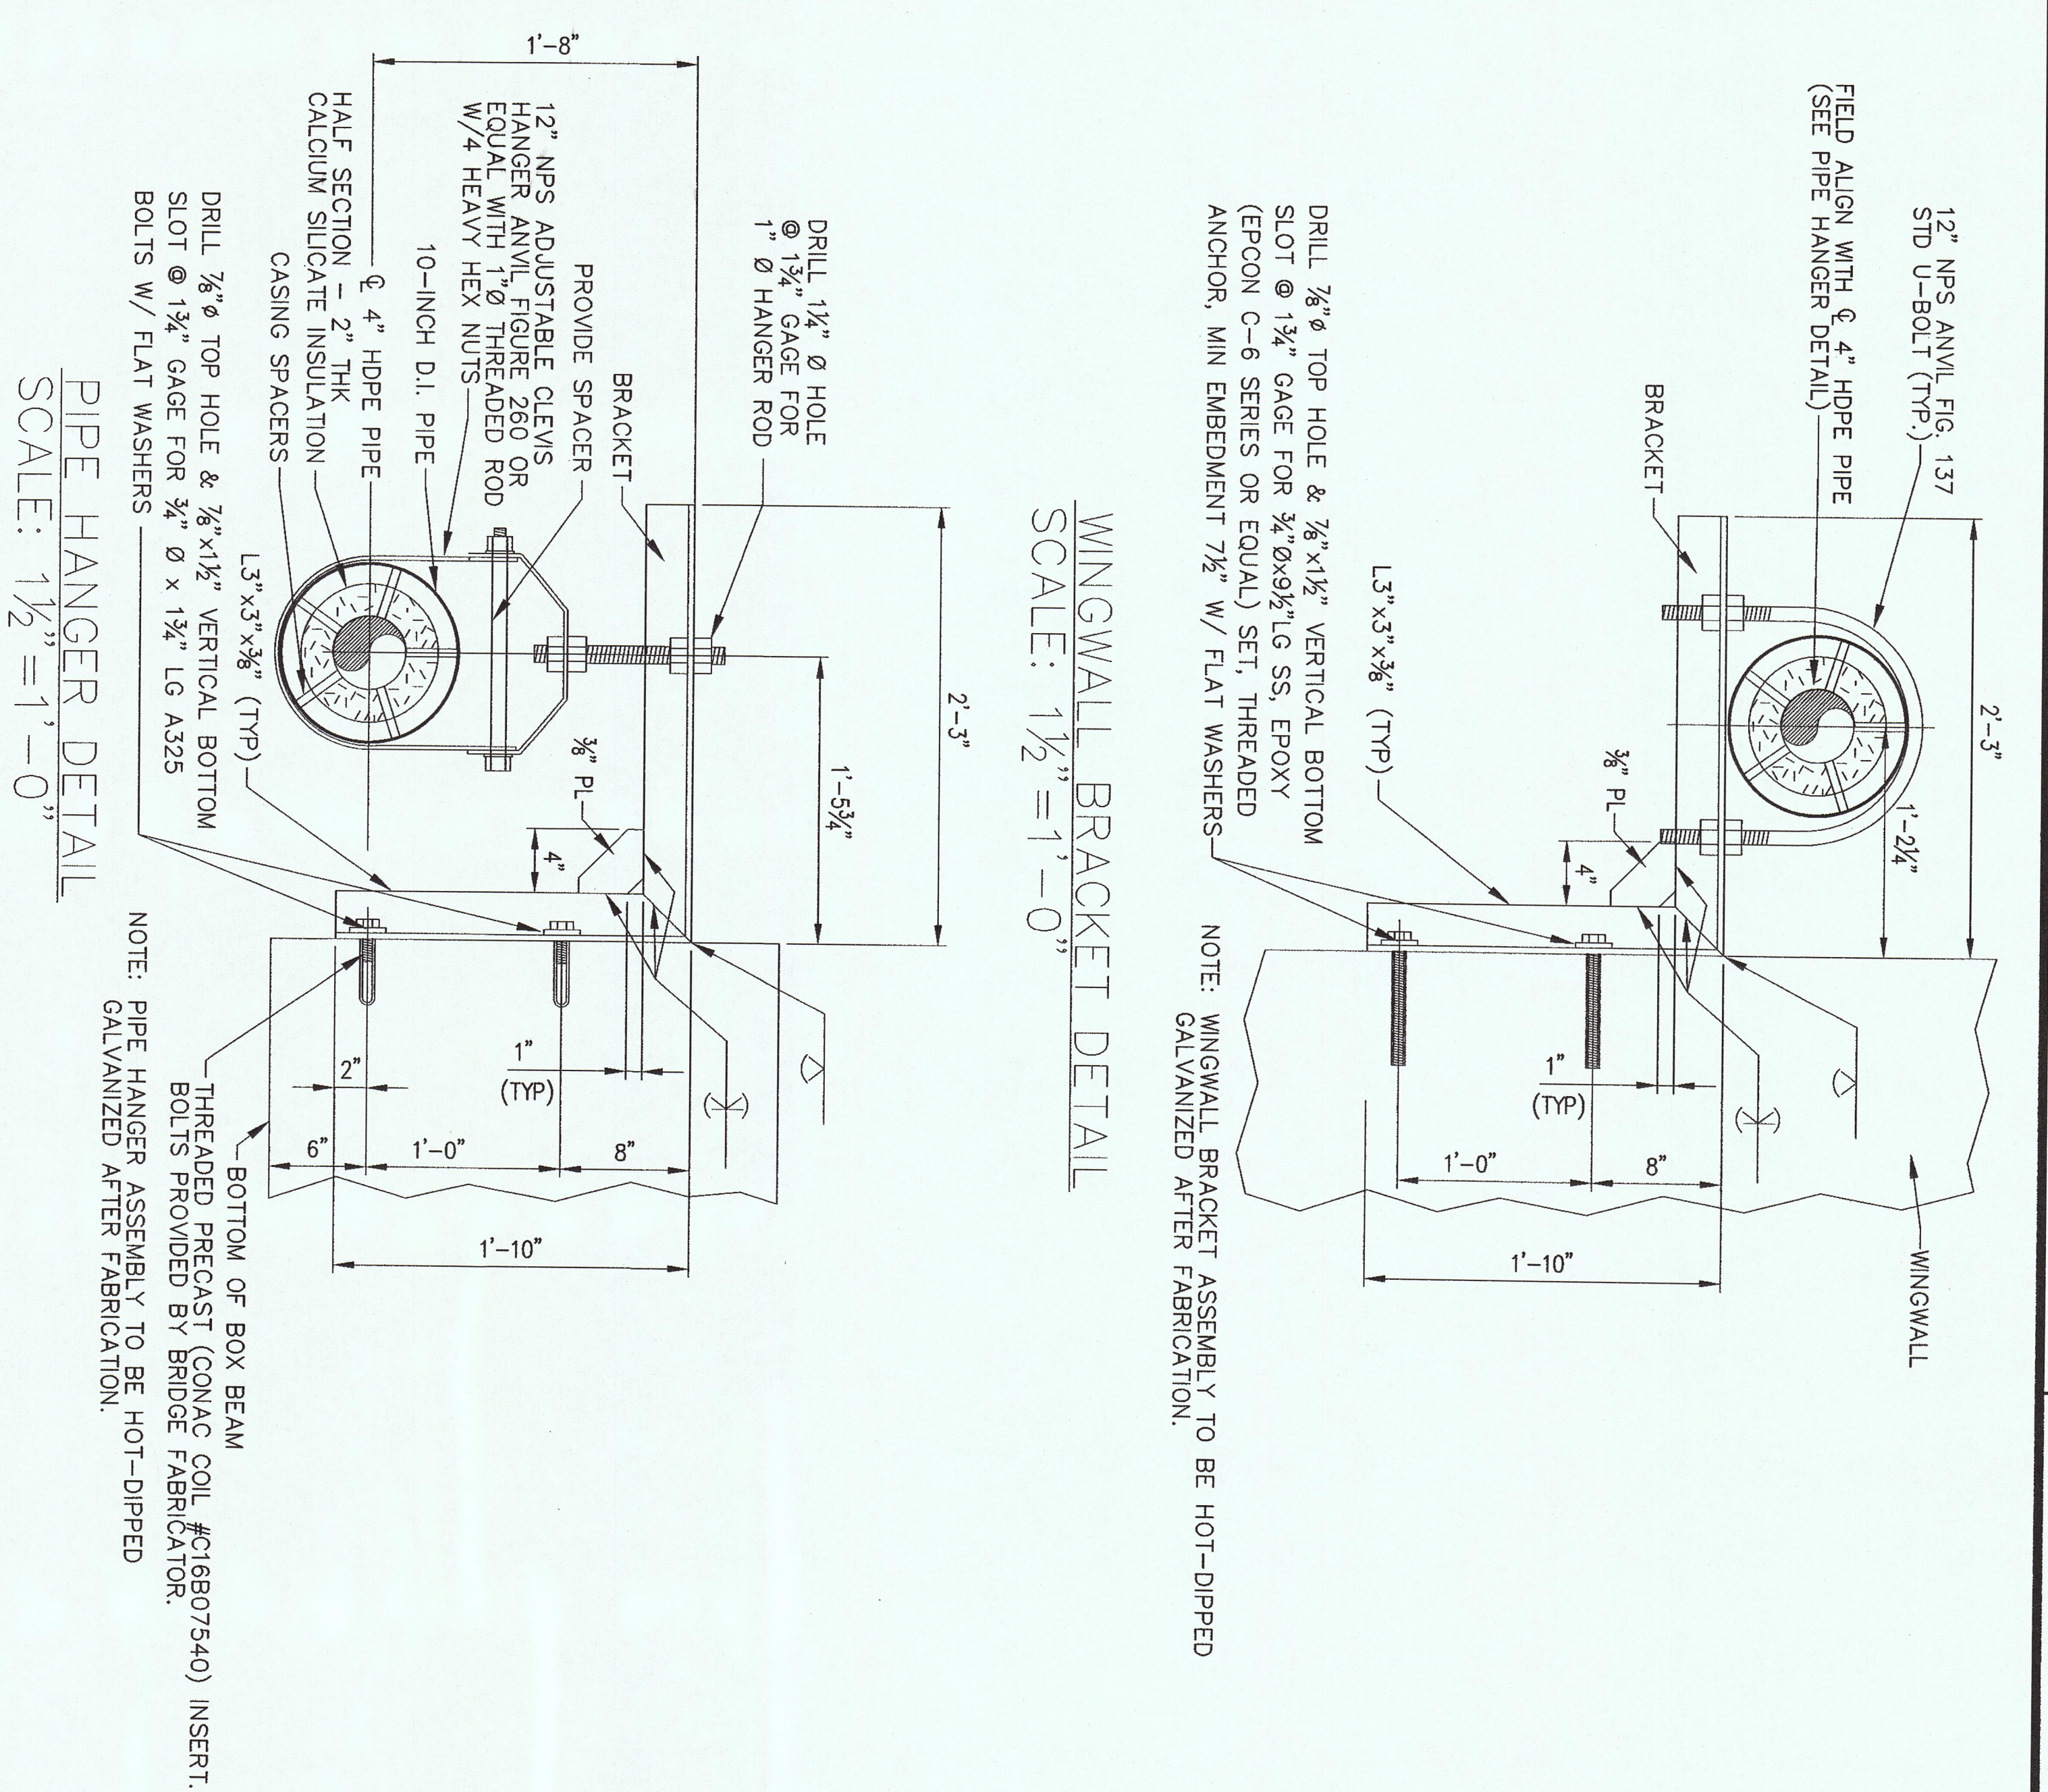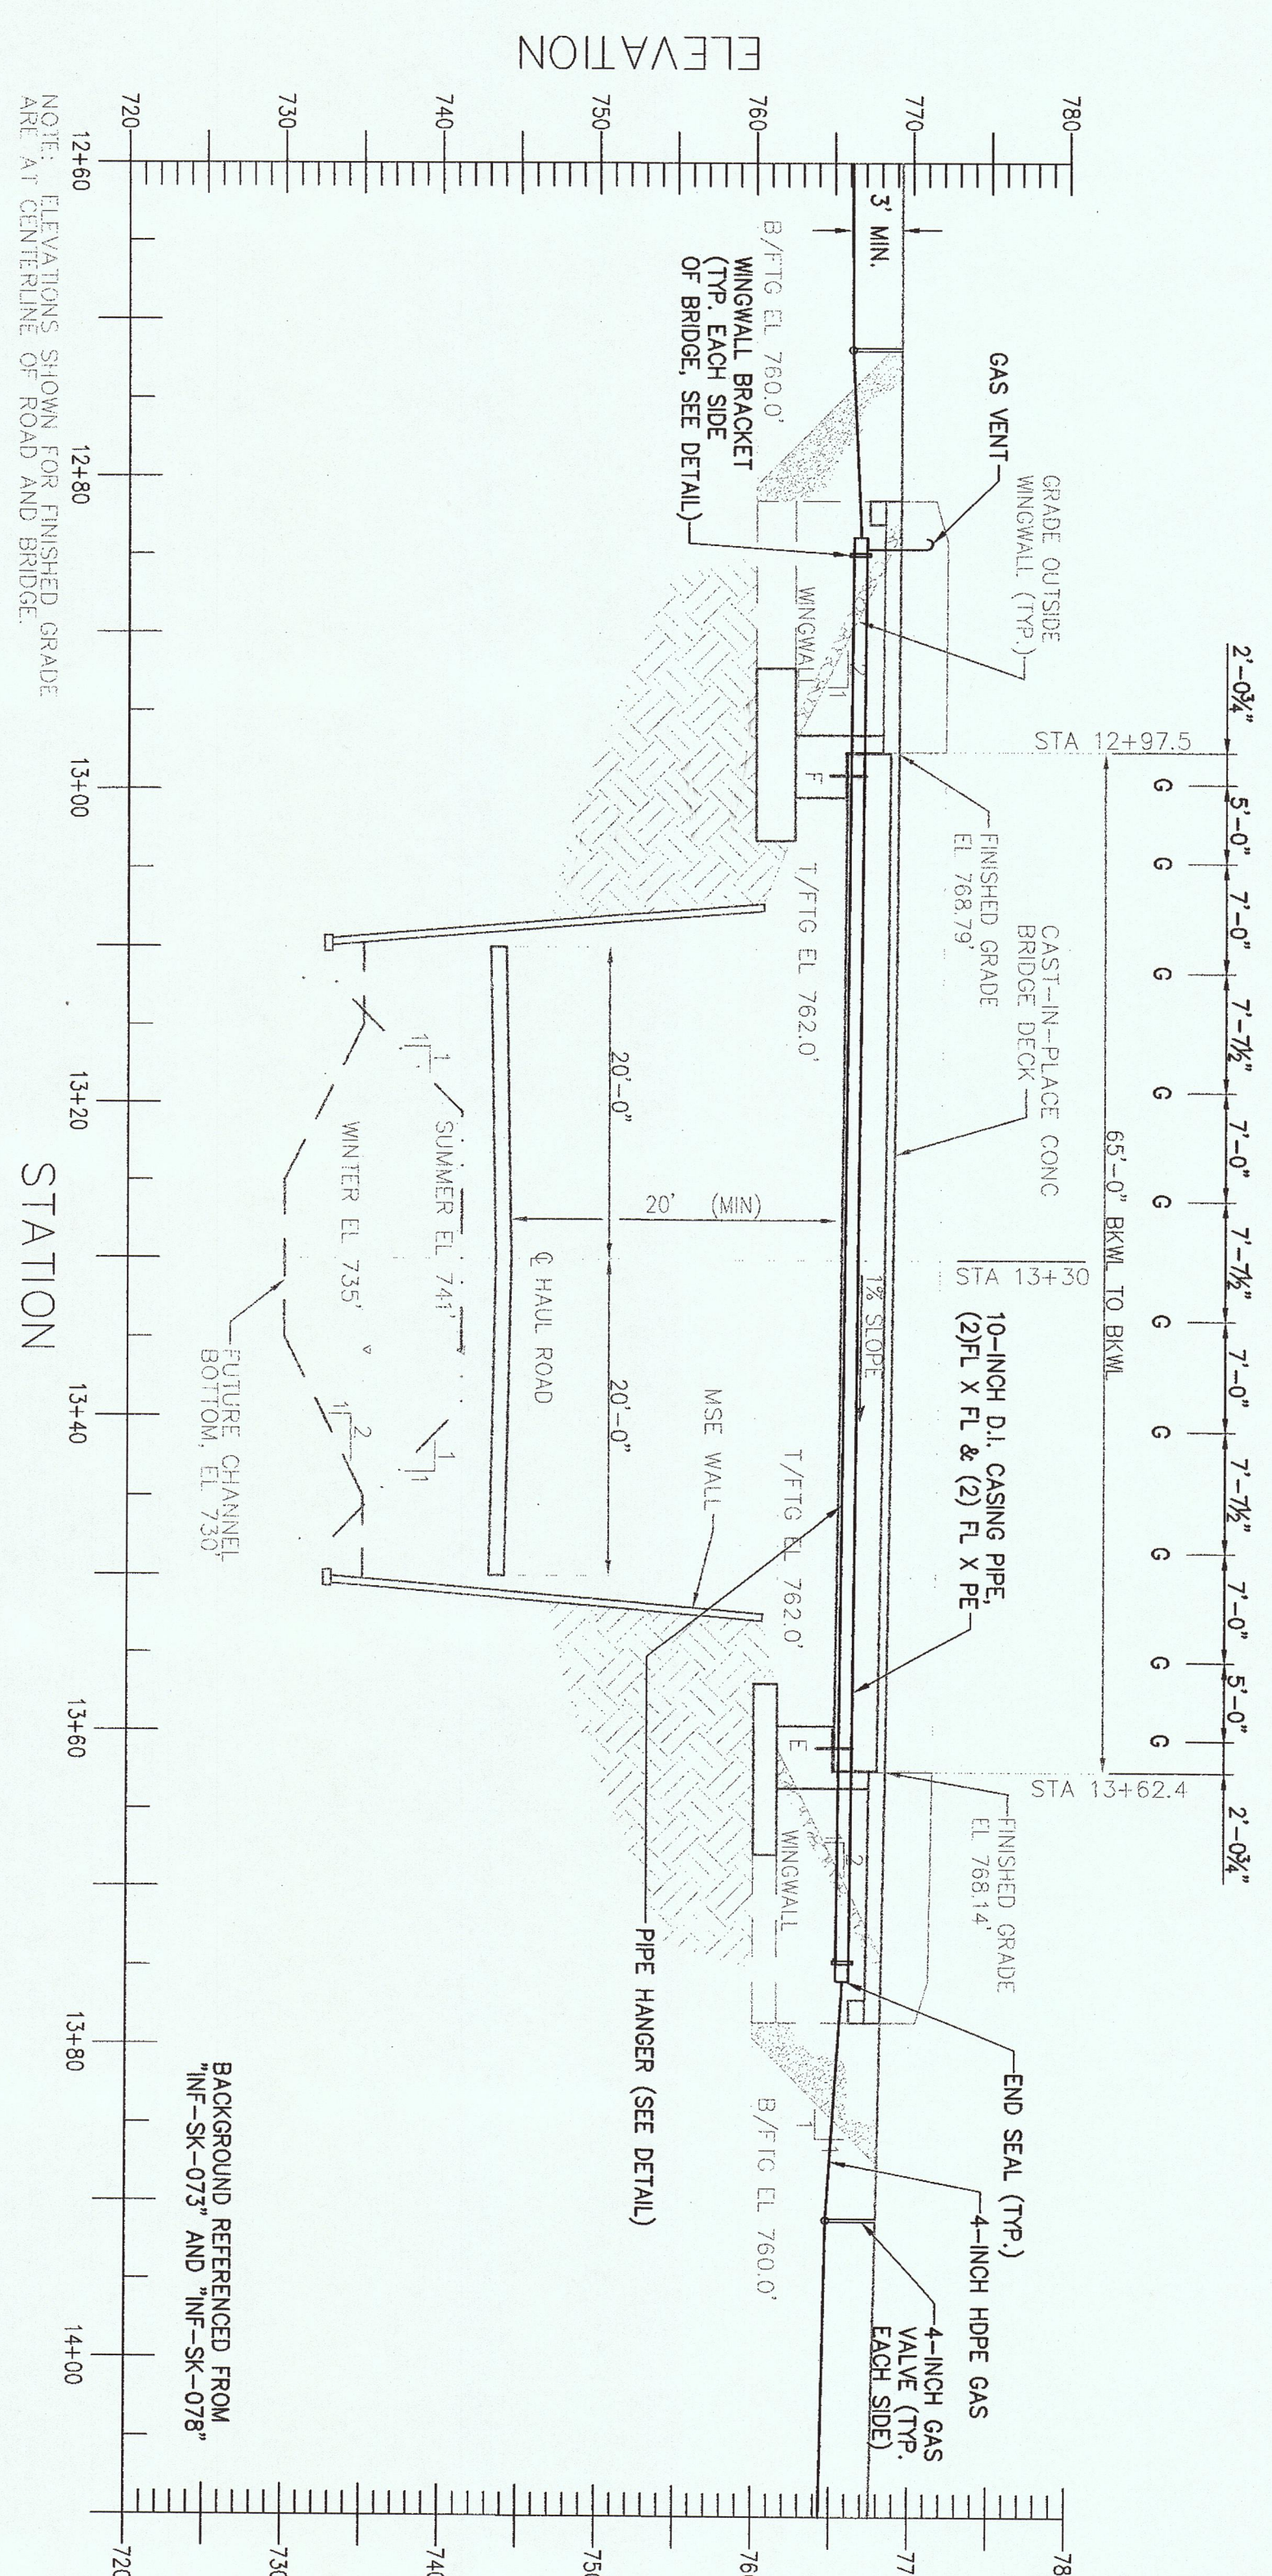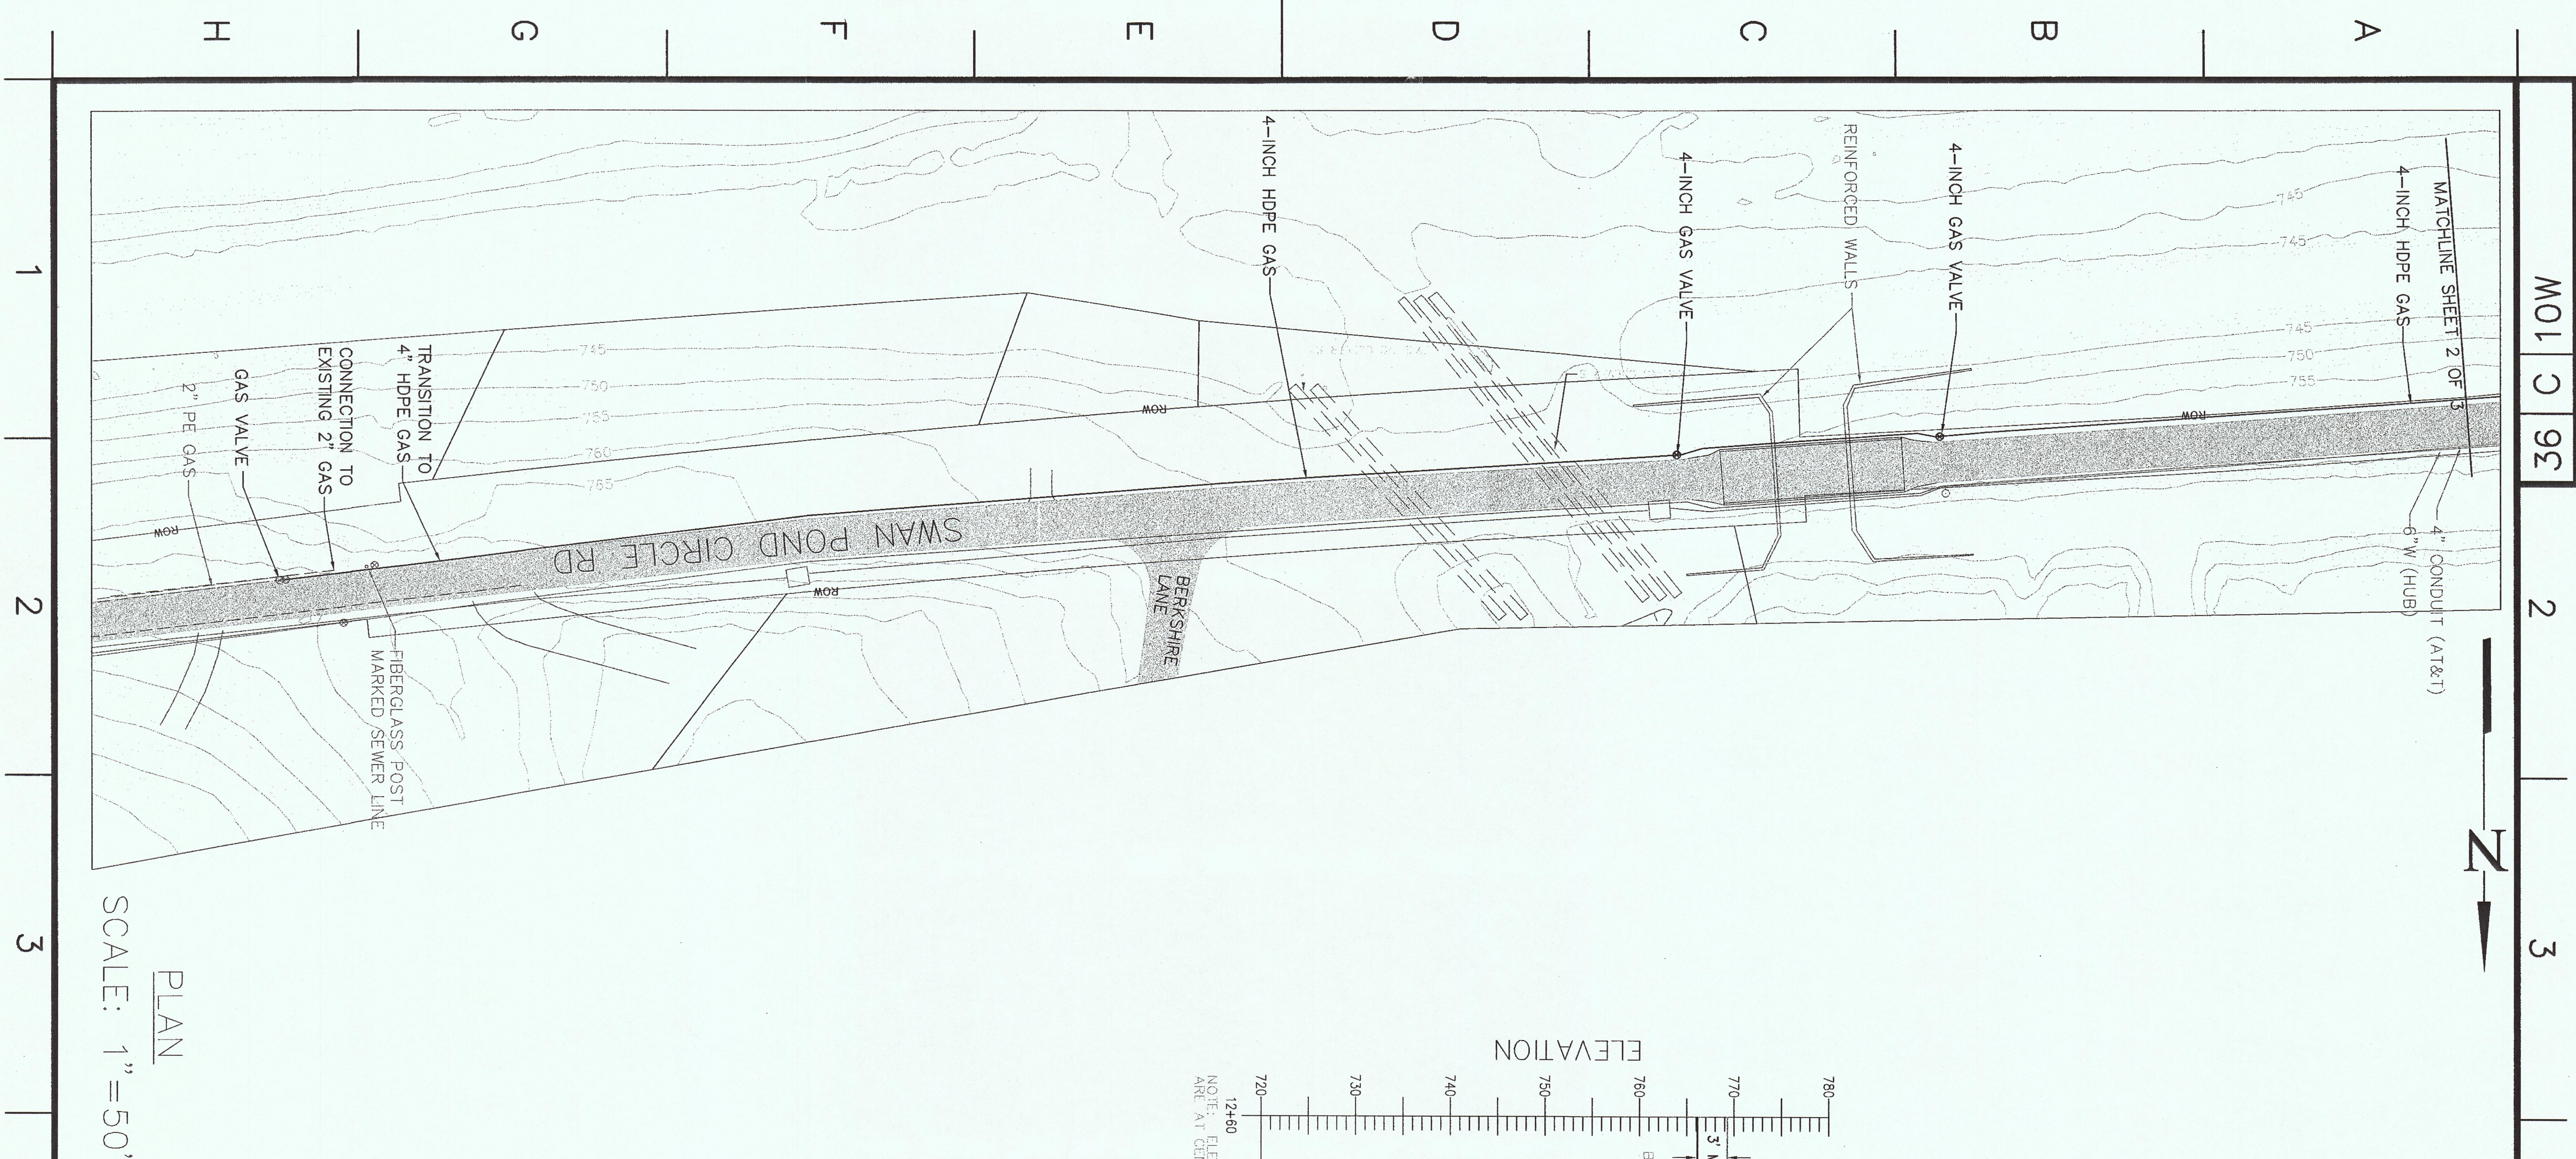

RECORD DRAWING	DATE	BY	CHKD	BY	REVISION
A 1	8/18/75	J.L.K.	N.A.F.	J.L.K.	
B 2	8/22/75	J.L.K.	N.A.F.	J.L.K.	
C 3	8/22/75	J.L.K.	N.A.F.	J.L.K.	
REMOVED GAS LINE ALONG BENSINGER LANE. ADDED BRIDGE CROSSING, NOTES AND DETAILS					
CHANGED PLAIN LIMITS AND REVISED ROAD					
D 1	8/17/75	J.L.K.	N.A.F.	J.L.K.	
SHIPPED INFORMATION					
NO.	DATE	BY	DATE	BY	REVISION
SCALE: 1" = 50'	EXCEPT AS NOTED				
CIVIL YARD					
KIF - UTILITY RESTORATION					
HARRIMAN UTILITY BOARD - GAS					
PLAN & PROFILE SHEET 3 OF 3					
DATE	BY	CHKD	BY	DATE	BY
3/17/08	J.M.G.	D.L.L.			
KANSAS FOSSIL PLANT					
MISSOURI VALLEY AUTHORITY					
FOSSIL AND MINING ENGINEERING					
PROJECT NO.	DATE	BY	CHKD	BY	REVISION
670-AH0004.5	3/6	C			
R 5					

RECORD DRAWING
12-17-2010

PLOT FACTOR:1:1	
W_TUA	
C.A.D. DRAWING	
DO NOT ALTER MANUALLY	
CT ENGINEERS, INC.	
TASK COMPLETED BY:	REV NO.

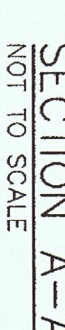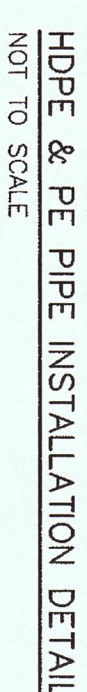

-

CONSOLIDATED TECH., INC.	
TASK COMPLETED BY:	REV NO

[illegible]

PLOT FACTOR:1:1
W_TVA
C.A.D. DRAWING
DO NOT ALTER MANUALL