



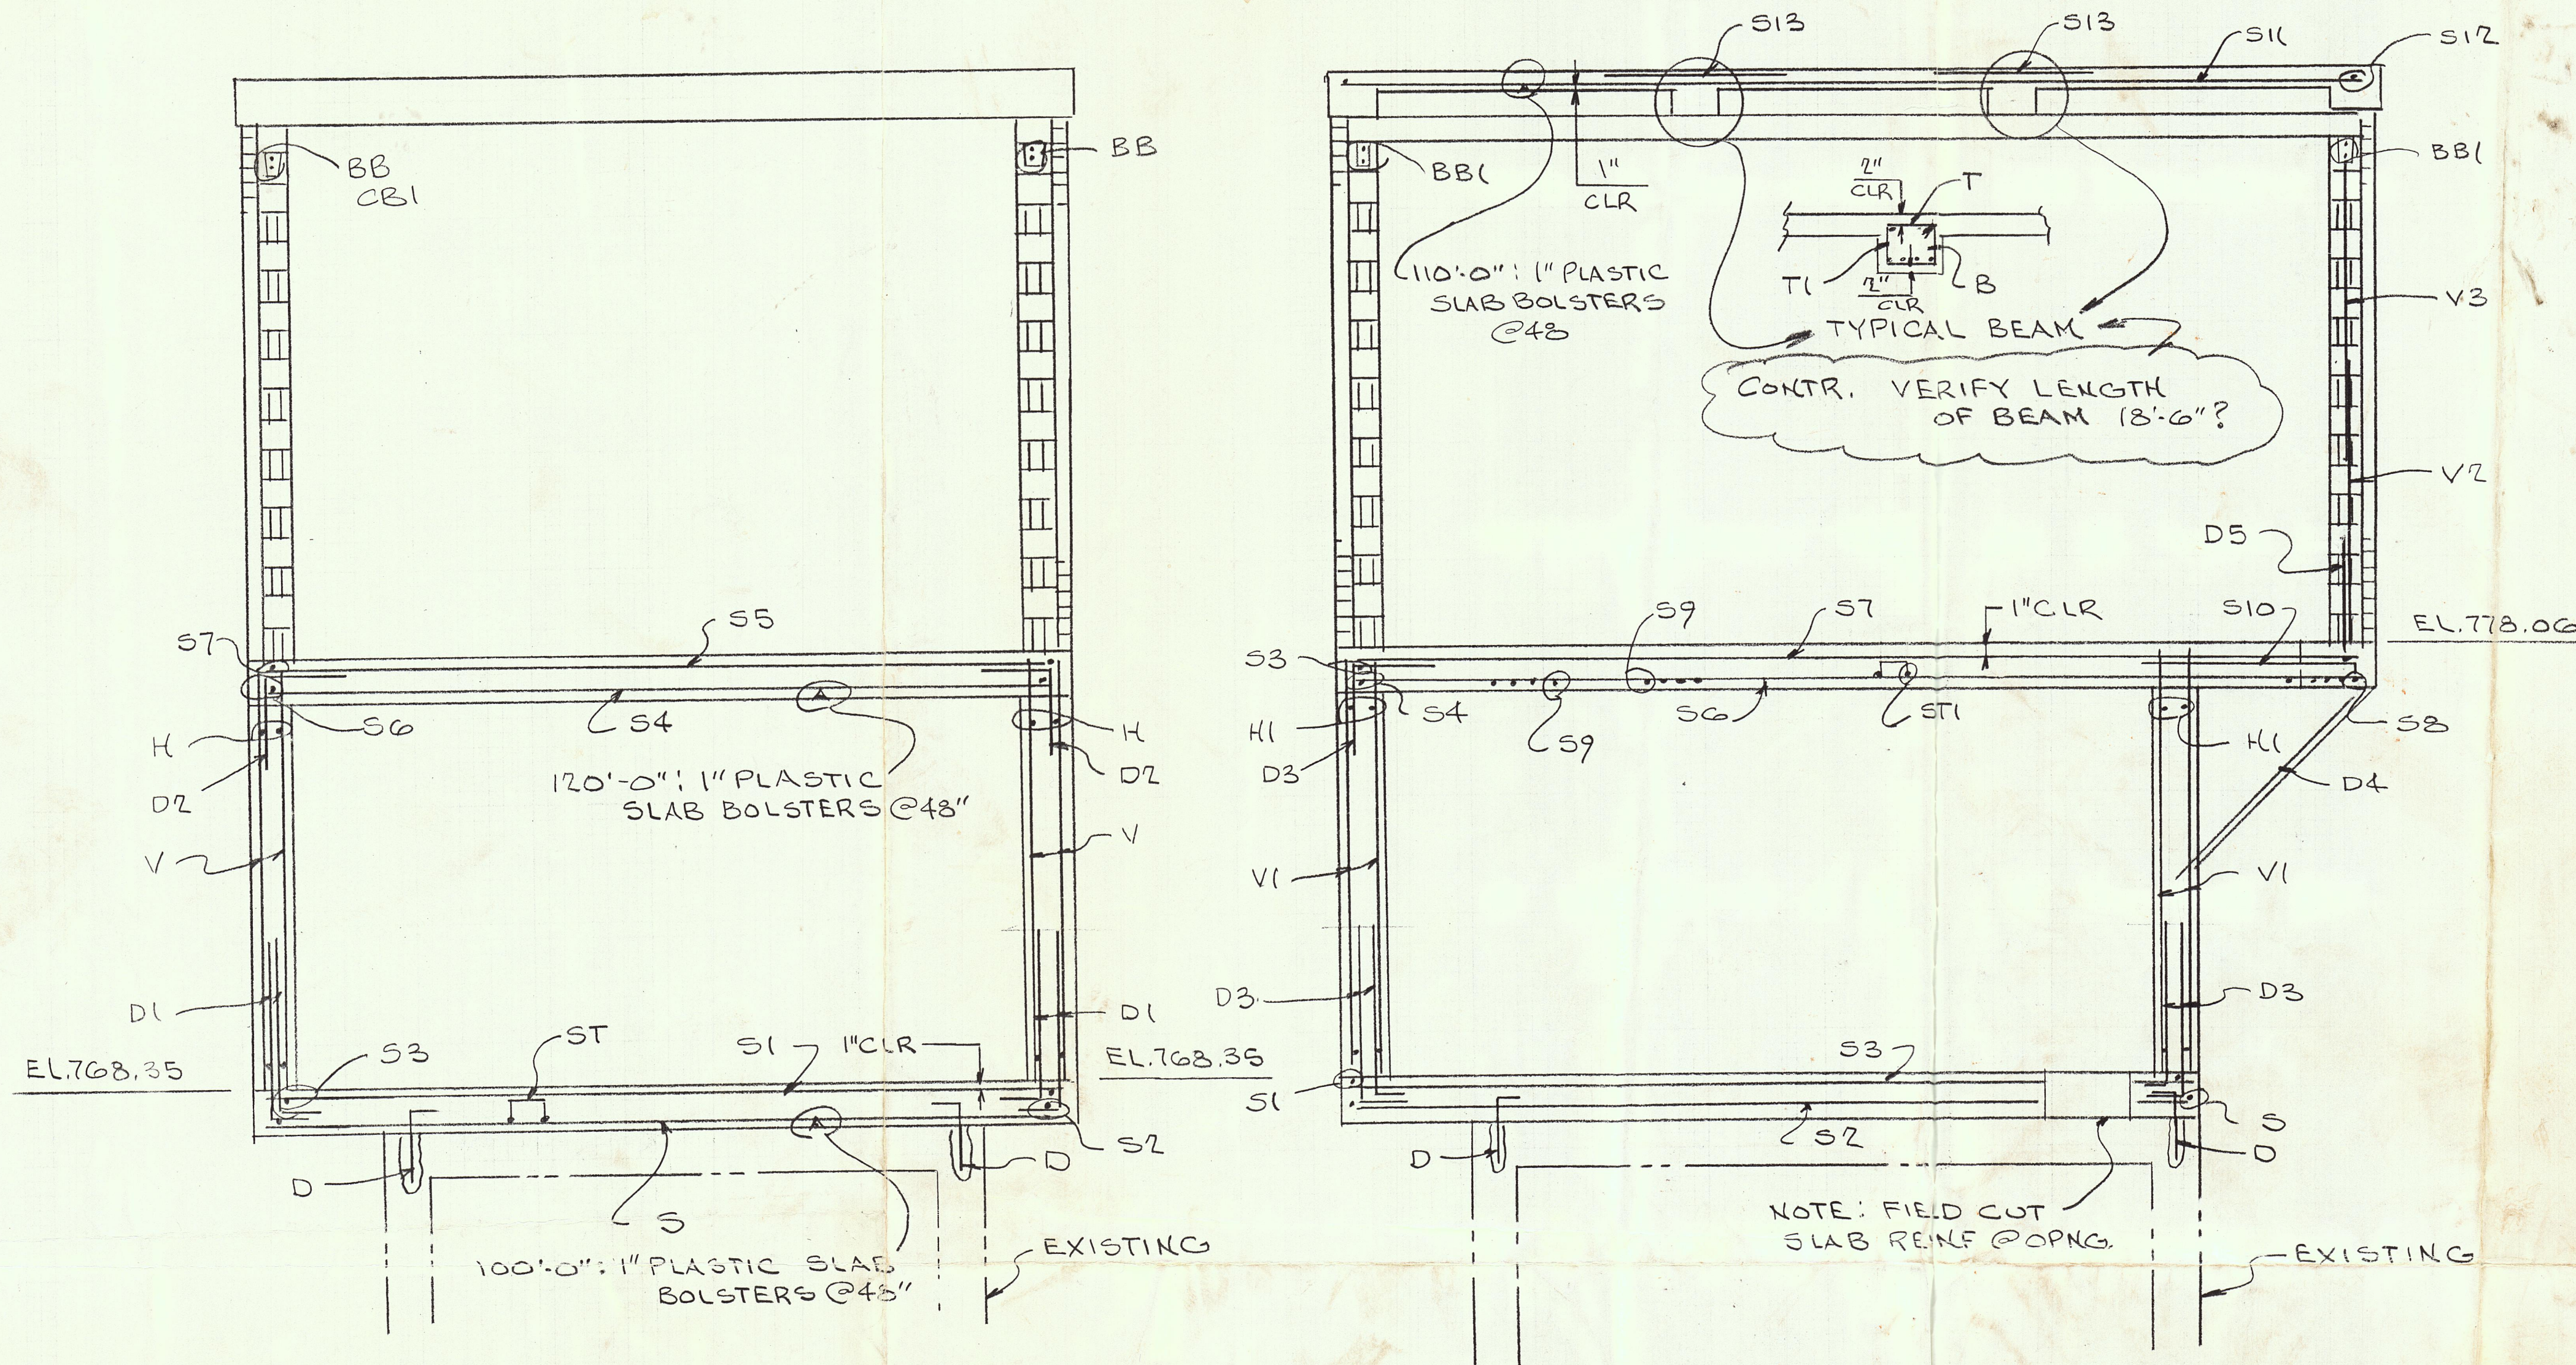


SECTION ①

SECTION ②

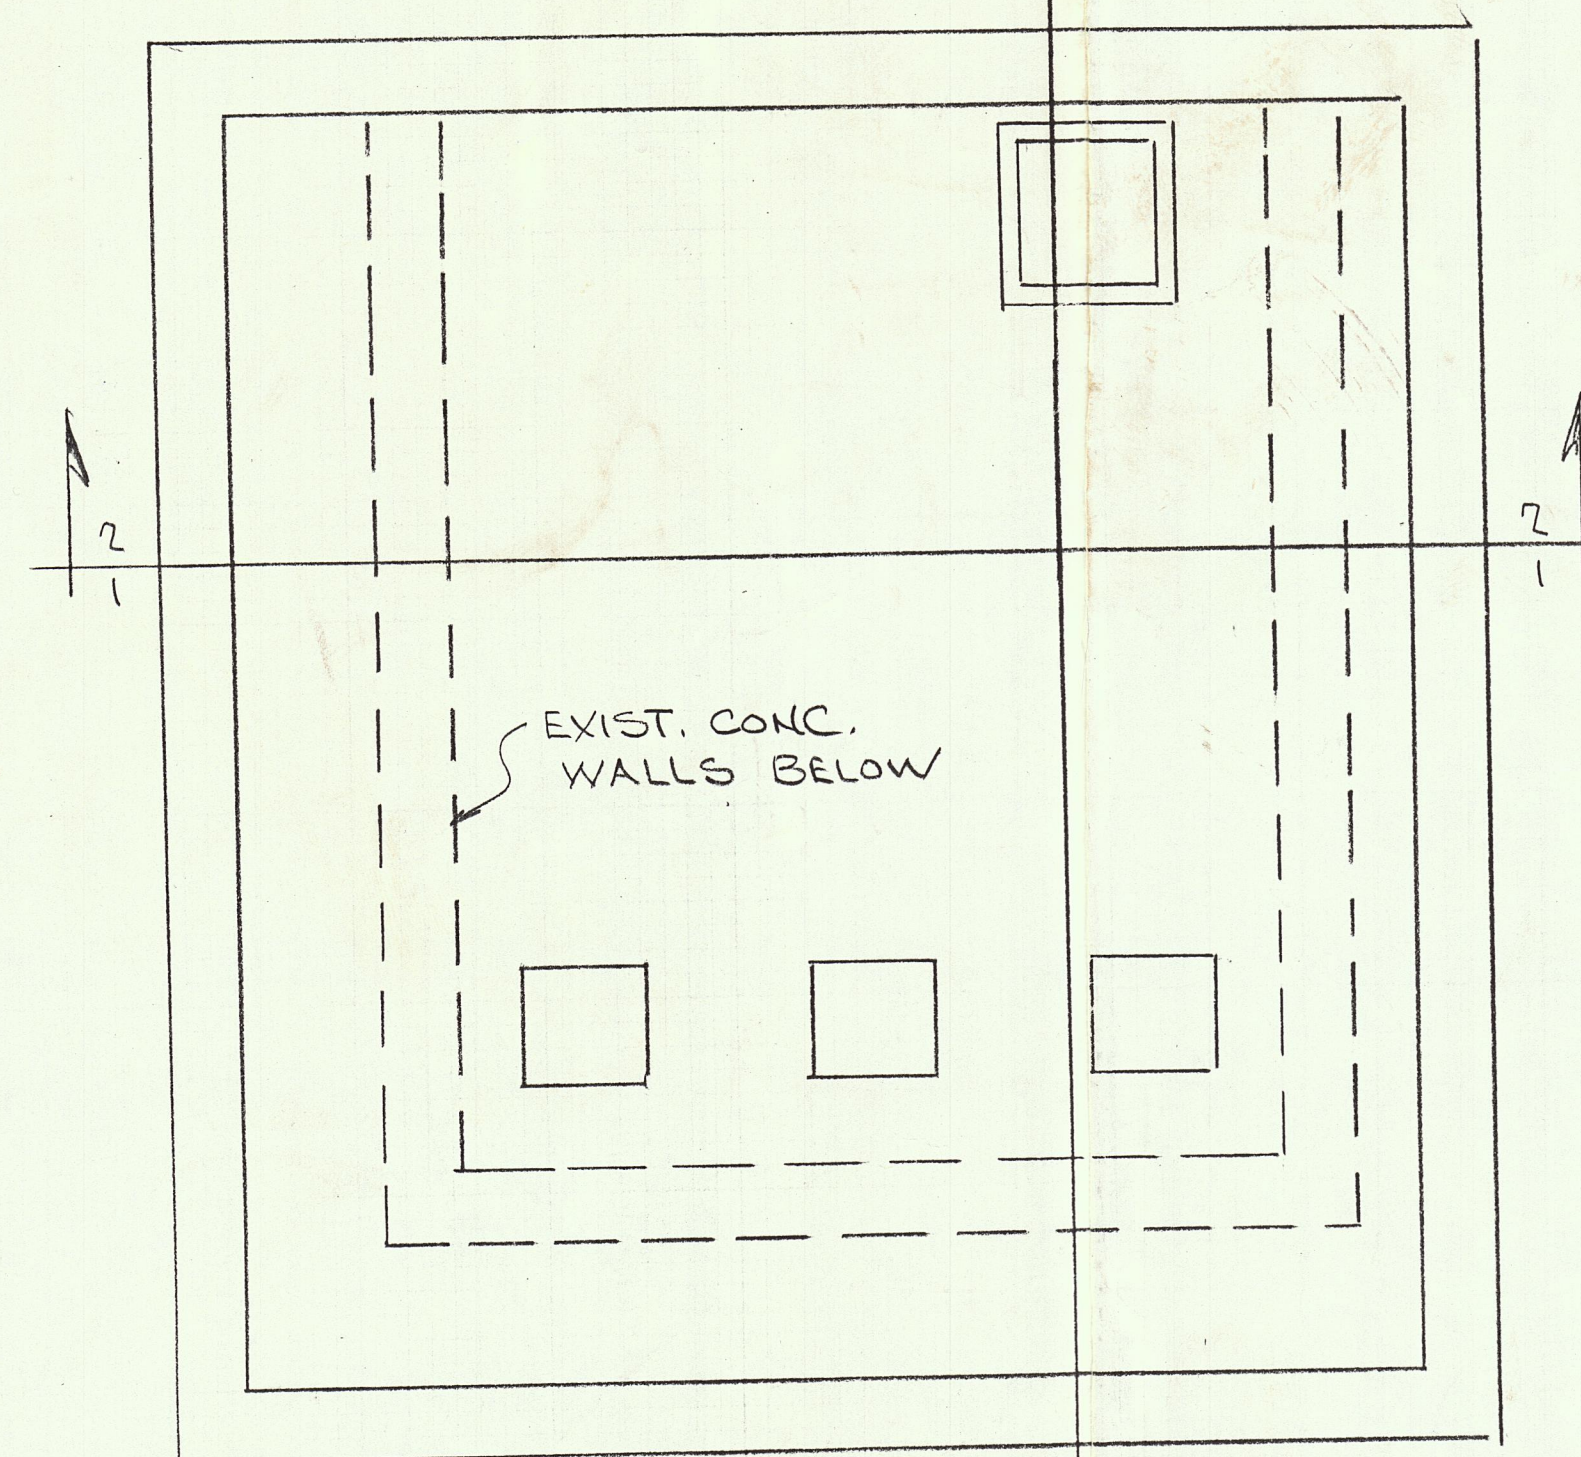

PLAN FLOOR ELEVATION 768.35

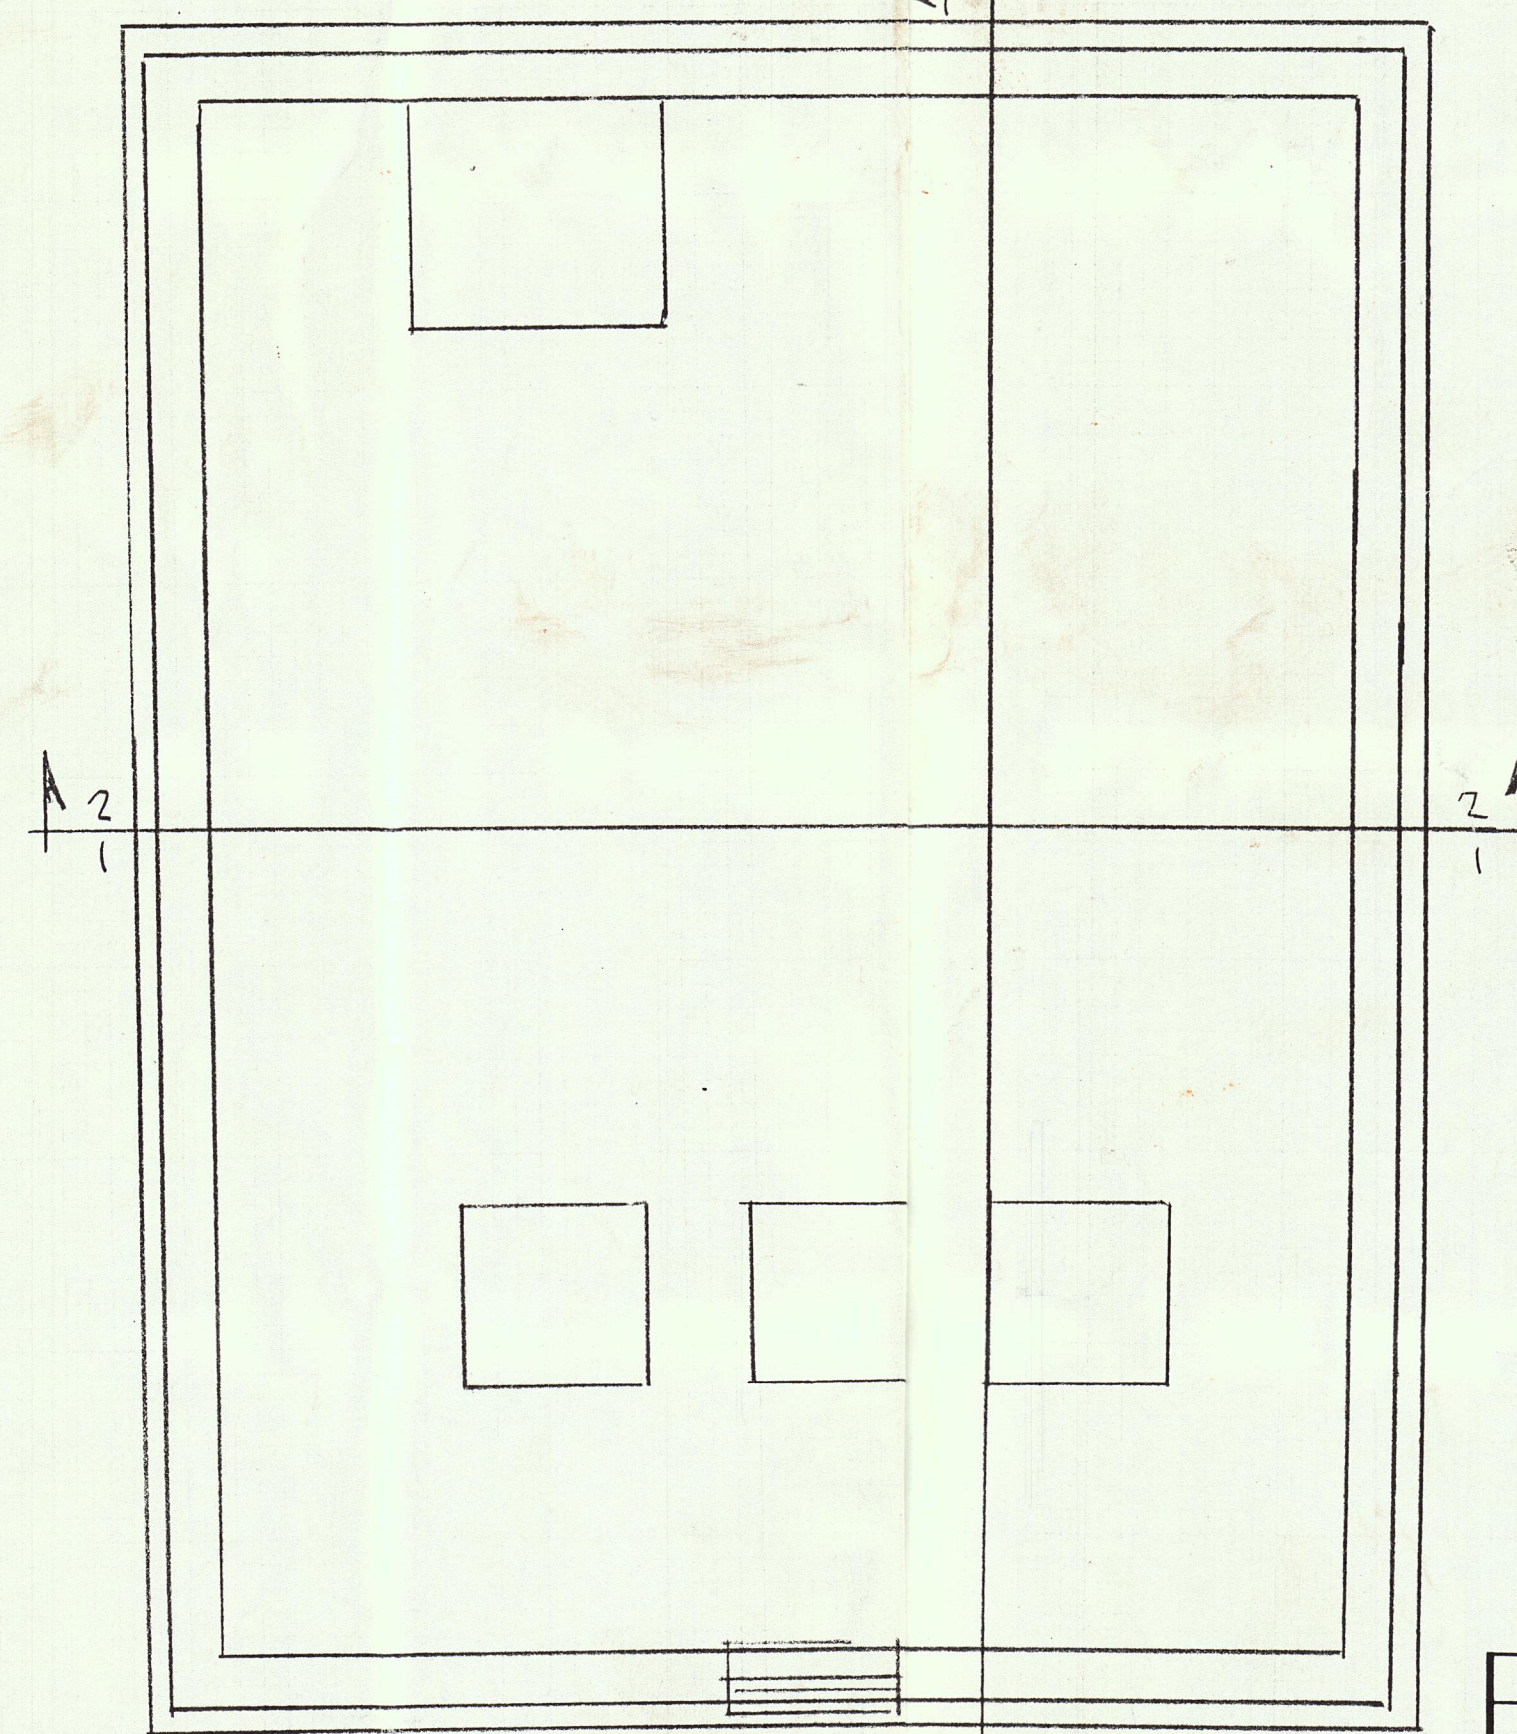

PLAN FLOOR ELEVATION 778.06

JOB: 1026 WATER SYSTEM PLANT
DRAWING: 1026-1R FOUNDATION AND SLAB

LABEL	RD	PL	QTY	SZ	LENGTH	BAR	MARK	PLAN LOCATION: FDN/WALL	EC	REMARK	LABEL
SECTION: SLAB/WALL											
S	:	:	20	#	5	18-02		:	:	SLAB @12" BOT.	S
S1	:	:	30	#	7	18-02		:	:	SLAB @8" TOP	S1
S2	:	:	19	#	5	19-04		:	:	SLAB @12" BOT.	S2
S3	:	:	19	#	7	19-04		:	:	SLAB @12" TOP	S3
D	:	:	23	#	6		6A1	:	:	D	D
ST	:	:	25	#	4		4A2	:	:	STANDEE @48" E.W:ST	ST
D1	:	:	2	X	40	#	4	:	:	DWLS. @12" 20 E.F:D1	D1
V	:	:	2	X	40	#	4	:	:	VERT. @12" 20 E.F:V	V
H	:	:	2	X	18	#	4	:	:	HZ @12" 9 E.F. :H	H
CB	:	:	4	X	9	#	4	:	:	CB @12" O.F. :CB	CB
D2	:	:	2	X	20	#	4	:	:	DWLS. @12" O.F. :D2	D2
D3	:	:	2	X	34	#	4	:	:	DWLS. @12" 17 EF :D3	D3
V1	:	:	2	X	34	#	4	:	:	VERT @12" 17 EF:V1	V1
H1	:	:	2	X	18	#	4	:	:	HZ @12" 9 E.F. :H1	H1
D3	:	:	2	X	17	#	4	:	:	DWLS. @12" O.F. :D3	D3
S4	:	:	24	#	5	18-02		:	:	SLAB @12" BOT.	S4
S5	:	:	19	#	5	23-04		:	:	SLAB @12" TOP	S5
S6	:	:	19	#	5	23-04		:	:	SLAB @12" BOT.	S6
S7	:	:	19	#	5	23-04		:	:	SLAB @12" TOP	S7
S8	:	:	4	#	7	18-02		:	:	SLAB @4" BOT.	S8
S9	:	:	2	X	4	#	7	:	:	@6" EA. SIDE PUMP:S9	S9
S10	:	:	2	X	4	#	7	:	:	SLAB TOP	S10
ST1	:	:	30	#	4		4A7	:	:	STANDEE @48" E.W:ST1	ST1
D4	:	:	2	X	5		5A8	:	:	HAUNCH	D4
D5	:	:	17	X	1	#	5	:	:	DWLS. CMU	D5
V2	:	:	17	X	1	#	5	:	:	VERT. CMU	V2
V3	:	:	17	X	1	#	5	:	:	VERT. CMU	V3
BB	:	:	2	X	2	#	5	:	:	BOND BEAM	BB
BB1	:	:	2	X	2	#	5	:	:	BOND BEAM	BB1
CB1	:	:	4	X	2	#	5	:	:	BOND BEAM C.B.	CB1
S11	:	:	19	#	4	23-04		:	:	ROOF SLAB @12"	S11
S12	:	:	24	#	4	18-02		:	:	ROOF SLAB @12"	S12
S13	:	:	2	X	19	#	4	:	:	SLAB @12" TOP	S13
T	:	:	2	X	4	#	7	:	:	BEAM BOT.	T
B	:	:	2	X	2	#	7	:	:	BEAM TOP	B
T1	:	:	2	X	19	#	3	:	:	BEAM TIES @12"	T1

NOTE: FIELD CUT
SLAB REINF @OPNG.

JOB: 1026 WATER SYSTEM PLANT
DWG: 1026-1R FOUNDATION AND SLAB

SZ	EP	BAR	BND	V	TYP	C	A	B	C	D	E	F/R	G	H	J	K	O
7	:	7A6	:	2	:	0-00	:	5-00	:	:	:	:	:	:	:	:	:
6	:	6A1	:	2	:	1-09	:	1-00	:	:	:	:	:	:	:	:	:
5	:	5A8	:	3	:	0-08	:	6-04	:	:	:	:	4-06	:	:	4-052	:
5	:	5A9	:	2	:	0-10	:	3-00	:	:	:	:	:	:	:	:	:
5	:	5A10	:	2	:	3-00	:	3-00	:	:	:	:	:	:	:	:	:
4	:	4A2	:	26	:	1-06	:	0-071	:	1-06	:	0-071	:	1-06	:	:	:
4	:	4A3	:	2	:	0-08	:	2-00	:	:	:	:	:	:	:	:	:
4	:	4A4	:	2	:	3-00	:	3-00	:	:	:	:	:	:	:	:	:
4	:	4A5	:	2	:	2-00	:	2-00	:	:	:	:	:	:	:	:	:
4	:	4A7	:	26	:	1-06	:	0-07	:	1-06	:	0-07	:	1-06	:	:	:
3	:	3A11	:	T	:	0-04	:	0-10	:	0-08	:	0-10	:	0-08	:	:	:

☒ NO EXCEPTION TAKEN
☐ REJECTED
☐ MAKE CORRECTIONS NOTED
☐ REVISE AND RESUBMIT

Checking is only for general conformance with the design concept of the project and general compliance with the information given in the contract documents. Any action shown is subject to the requirements of the plans and specifications. Contractor is responsible for coordination of his work with that of all other trades and the satisfactory performance of his work.

Date: 4-1-74
By: S. G. G. G.

Ward & Dunson, Inc.

Judy Construction Co.
BY: S. G. G. G. DATE: 2-2-74
☒ Reviewed
☐ Reviewed As Noted

HARRIMAN, TN

PLAN RAW PUMP BUILDING

1	@	SPACING CENTER TO CENTER
2	→	DIRECTION IN WHICH BARS EXTEND
3	→	LIMITS OF AREA COVERED BY BARS
4	IF	INSIDE FACE 11 T & B TOP & BOTTOM
5	OF	OUTSIDE FACE 12 EW EACH WAY
6	NF	NEAR FACE 13 CB CORNER BAR
7	FF	FAR FACE 14 TB TOP TO BOTTOM
8	EF	EACH FACE 15 L-R LEFT TO RIGHT
9	BOT.	BOTTOM 16 + ACI STD. HOOK
10	T	TOP OR COMP. CAL. DIM.

FLORIDA STEEL CORPORATION	STEEL SERVICE REGION
JOHNSON CITY, TN	NASHVILLE, TN
COLLIERSVILLE, TN	KNOXVILLE, TN
INDIANAPOLIS, IN	LOUISVILLE, KY
ST. LOUIS, MO	ST. ALBANS, WV
REINFORCING STEEL PLACING PLAN	
JOB: WATER SYSTEM IMPROVEMENTS	
CONTR: JUDY CONST CO	
ARCH: ELROD - DUNSON, INC	
DRAWN BY: J. FORSYTH	
DATE:	
DRAWING NO 1026-1R	
INSPECTOR'S COPY	

REV.	DATE	DESCRIPTION