



ENTRANCE SIGN DETAIL
SCALE: 1/2" = 1'-0"


SECTION	THICKNESS	FINISH	REMARKS
1	1/2"	AS BUILT	SEE DETAIL
2	1/2"	AS BUILT	SEE DETAIL
3	1/2"	AS BUILT	SEE DETAIL
4	1/2"	AS BUILT	SEE DETAIL
5	1/2"	AS BUILT	SEE DETAIL
6	1/2"	AS BUILT	SEE DETAIL
7	1/2"	AS BUILT	SEE DETAIL
8	1/2"	AS BUILT	SEE DETAIL
9	1/2"	AS BUILT	SEE DETAIL
10	1/2"	AS BUILT	SEE DETAIL

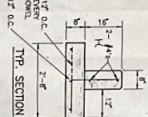


TYPICAL SECTION - RETAINING WALL
SCALE: 1/2" = 1'-0"

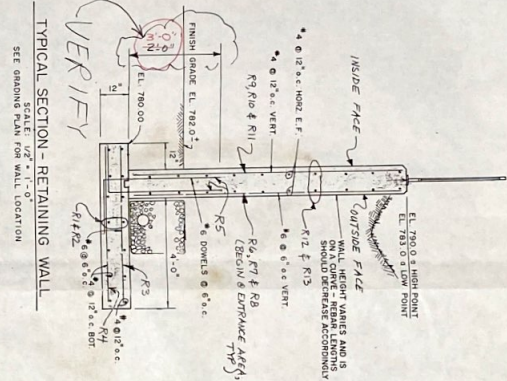

SECTION	THICKNESS	FINISH	REMARKS
1	1/2"	AS BUILT	SEE DETAIL
2	1/2"	AS BUILT	SEE DETAIL
3	1/2"	AS BUILT	SEE DETAIL
4	1/2"	AS BUILT	SEE DETAIL
5	1/2"	AS BUILT	SEE DETAIL
6	1/2"	AS BUILT	SEE DETAIL
7	1/2"	AS BUILT	SEE DETAIL
8	1/2"	AS BUILT	SEE DETAIL
9	1/2"	AS BUILT	SEE DETAIL
10	1/2"	AS BUILT	SEE DETAIL

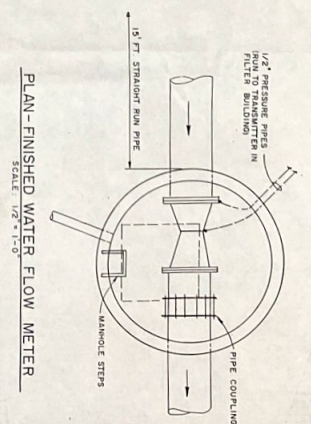


PLAN-FINISHED WATER FLOW METER
SCALE: 1/2" = 1'-0"

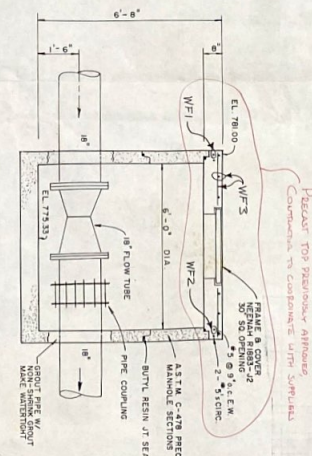


TYPICAL SECTION - FINISHED WATER METER
SCALE: 1/2" = 1'-0"

SECTION	THICKNESS	FINISH	REMARKS
1	1/2"	AS BUILT	SEE DETAIL
2	1/2"	AS BUILT	SEE DETAIL
3	1/2"	AS BUILT	SEE DETAIL
4	1/2"	AS BUILT	SEE DETAIL
5	1/2"	AS BUILT	SEE DETAIL
6	1/2"	AS BUILT	SEE DETAIL
7	1/2"	AS BUILT	SEE DETAIL
8	1/2"	AS BUILT	SEE DETAIL
9	1/2"	AS BUILT	SEE DETAIL
10	1/2"	AS BUILT	SEE DETAIL

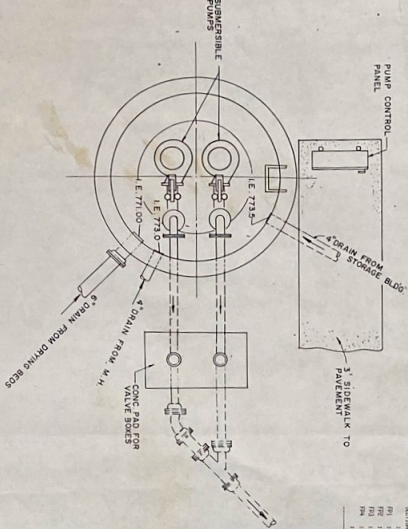


PLAN - FILTRATE PUMP STATION
SCALE: 1/2" = 1'-0"

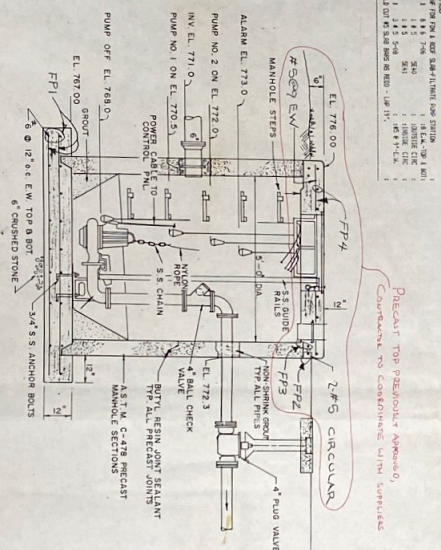

TYPICAL SECTION - FILTRATE PUMP STATION
SCALE: 1/2" = 1'-0"

REV.	DATE	DESCRIPTION
1		
2		
3		
4		
5		
6		
7		
8		
9		
10		

13-5-93
13-5-93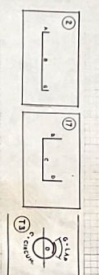
SECTION	THICKNESS	FINISH	REMARKS
1	1/2"	AS BUILT	SEE DETAIL
2	1/2"	AS BUILT	SEE DETAIL
3	1/2"	AS BUILT	SEE DETAIL
4	1/2"	AS BUILT	SEE DETAIL
5	1/2"	AS BUILT	SEE DETAIL
6	1/2"	AS BUILT	SEE DETAIL
7	1/2"	AS BUILT	SEE DETAIL
8	1/2"	AS BUILT	SEE DETAIL
9	1/2"	AS BUILT	SEE DETAIL
10	1/2"	AS BUILT	SEE DETAIL