


A.F.E. No.	DATE	DESCRIPTION
590	3-9-21	Fill Br.*163.96 and install 36" reinf. conc. pipe 72' long and 42" 9:1 pipe 10' long.
581	3-16-21	Fill 90' of east end of Br. 163.82. New length 113'.
564	4-30-21	Replace 60" Angle Bars with 60"x24" Conf. Jts. Mile 165=124. Mile 166=276.
701	1-31-22	Retire all roadway property by sale to T.C. R.R. Co.
53	2-1-22	Addition of all roadway property by purchase from T.C. R.R. Co.
22	6-22-23	Apply 2207 add. T"x3" tie plates - Mile 166.
242	12-13-23	Apply 1648 add. T"x3" tie plates - Mile 166.
1020	12-31-23	Apply 55 Cu.Yd. Slag ballast and convert 3 Cu.Yd. Cinder ballast to embankment - Mile 166.
382	9-23-25	Construct 6'9" O.D. pile trestle and 45'7" thru girder beam bridge replacing Br.*165.43.
1171	12-31-25	Assessment for curb, gutter and paving on Carter St. affecting parcels #17 and #19.
1366	1925	Retire cross ties from Main Track. Mile 165=87. Mile 166=134
399	10-2-26	Apply add. T"x3" tie plates. Mile 165=270. Mile 166=1623.
532	6-11-26	Construct rail type highway crossings on Nye Tracks #183 and #184.
435	6-12-26	Apply 37 add. 5 1/2"x8" tie plates - Trk.*183.
516	12-20-26	Construct thru plate girder span 53' long and creos. B.D. trestle 350' long replacing 55' I beam span and east App. of Br.*165.23.
1020	12-31-26	Apply add. Slag ballast. Mile 165=832 Cu.Yd. Mile 166=450 Cu.Yd. Convert Cinder ballast to embankment. Mile 165=141 Cu.Yd. Mile 166=46 Cu.Yd.
61	8-31-27	Apply add. tie plates. Mile 165=876-T"x3". Sinclair Oil spur=100-T"x3"; 71-T"x8"; 55-S"x8"; and 4-5 1/2"x8". Trk. #183=212-S"x8". Trk. #185=5-T"x3".
503	12-20-28	Lay 90" rail, Main Track - sta. 8648+10 to 8752+29. Trk. #183 -192' and shorten 11'. Trk. #184 -160' and extend 20'. Trk. #185 -122'.
968	12-31-28	Place creos. cross ties in Main Track. Mile 165=171. Mile 166=25.
693	2-10-29	Apply add. T"x3" tie plates. Mile 165=342. Mile 166=50.
975	5-25-29	Construct 367' spur track to serve Sinclair Refining Co. P.S. on Trk. #184.
959	8-13-29	Replace W. App. of Br.*165.23 with creos. B.D. trestle 350' long.
952	8-15-29	Replace intermediate trestle of Br.*165.23, E. of steel span, with creos. B.D. trestle 475' long.
1069	Oct., 1929	Place dbl 8" guard rail across Br. #164.14.
997	Dec., 1929	Install dbl 8" guard rail. Sta. 8718+37 to 8730+67 and sta. 8735+26 to 8737+36.
1085	Dec., 1929	Retire cattle guard at sta. 8683+50.
1170	12-12-29	Replace 1 set unt. with creos. switch ties in Trk. #186.
992	12-31-29	Place 37 Cu.Yd. add. ballast - Mile 166.
1063	1-20-30	Construct Team Track 275' long. P.S. sta. 6+80 on Trk. #183.
1114	12-31-30	Apply add. ballast. Mile 165=37 Cu.Yd. Stone. Mile 166=33 Cu.Yd. Screenings.
1240	12-31-31	Apply 34 Cu.Yd. add. Screenings ballast - Mile 166.
1009	1931	Apply add. tie plates. Mile 165=268-T"x3" and 36-T"x10". Mile 166=36-T"x3".
1474	12-31-31	Replace unt. cross ties with creos. cross ties. Mile 165=409. Mile 166=50. Trk. #184=5.
1572	4-12-34	Place one add. post in bents 34&35 of Br.*165.67 and move bent 35 east 5' and apply Z add. chords under each rail between bents 34&35.
1547	12-31-34	Apply 10 Cu.Yd. add. Stone ballast - Mile 165.
1242	2-1-35	Trans. Comb. Station to acct. #705 - for Asph. only. Included in Pak. 705 for Val. on inventory.
1698	Apr. 1935	Apply add. tie plates. Mile 165=770. Mile 166=468.
1683	5-1-35	Extend double 8" guard rail on Bridge 1644.14 Westwley 90'.
1722 Aug.	5-24-35	Replace Bridge 1644.14.
1761	5-1-36	Install derail in Tr.*183 to protect tank cars.
1736	12-1-36	Apply 68 C.Y. stone ballast in M.T. Mile 165 & 34 C.Y. in Mile 166.
1737	12-31-36	Place tie plates in M.T. Mile 165.
1732 Final	5-24-37	Replace Bridge 1644.14.
1870 F.	12-31-37	Place 68 C.Y. stone ballast in M.T. Mile 165 and 34 C.Y. Mile 166.
2037	9-1-38	Install 12"x21" C.G. pipe at bent of Br. 165.67 East of Queen St. to prevent churning.
2132	5-27-39	Lay 90" rail in 31T of Tr. 185 and 29S of Tr. 186.
2145	6-29-39	Lay 90" rail in 109T of Tr. 183, 800T of Tr. 184, 130.5' of Team Tr. & 216.5' of Sinclair Spur.

THIS MAP WAS NOT PREPARED OR INTENDED FOR USE AS A REAL ESTATE TITLE MAP. THE RAILWAY COMPANY DOES NOT REPRESENT OR SUGGEST THAT THE PROPERTY LINES AND RIGHT-OF-WAY LINES SHOWN ON THE MAP ARE ACCURATE, OR THAT ANY OTHER INFORMATION ON THE MAP IS CORRECT. THE COMPANY DOES NOT REPRESENT THAT IT HAS CHECKED THIS MAP FOR ACCURACY.

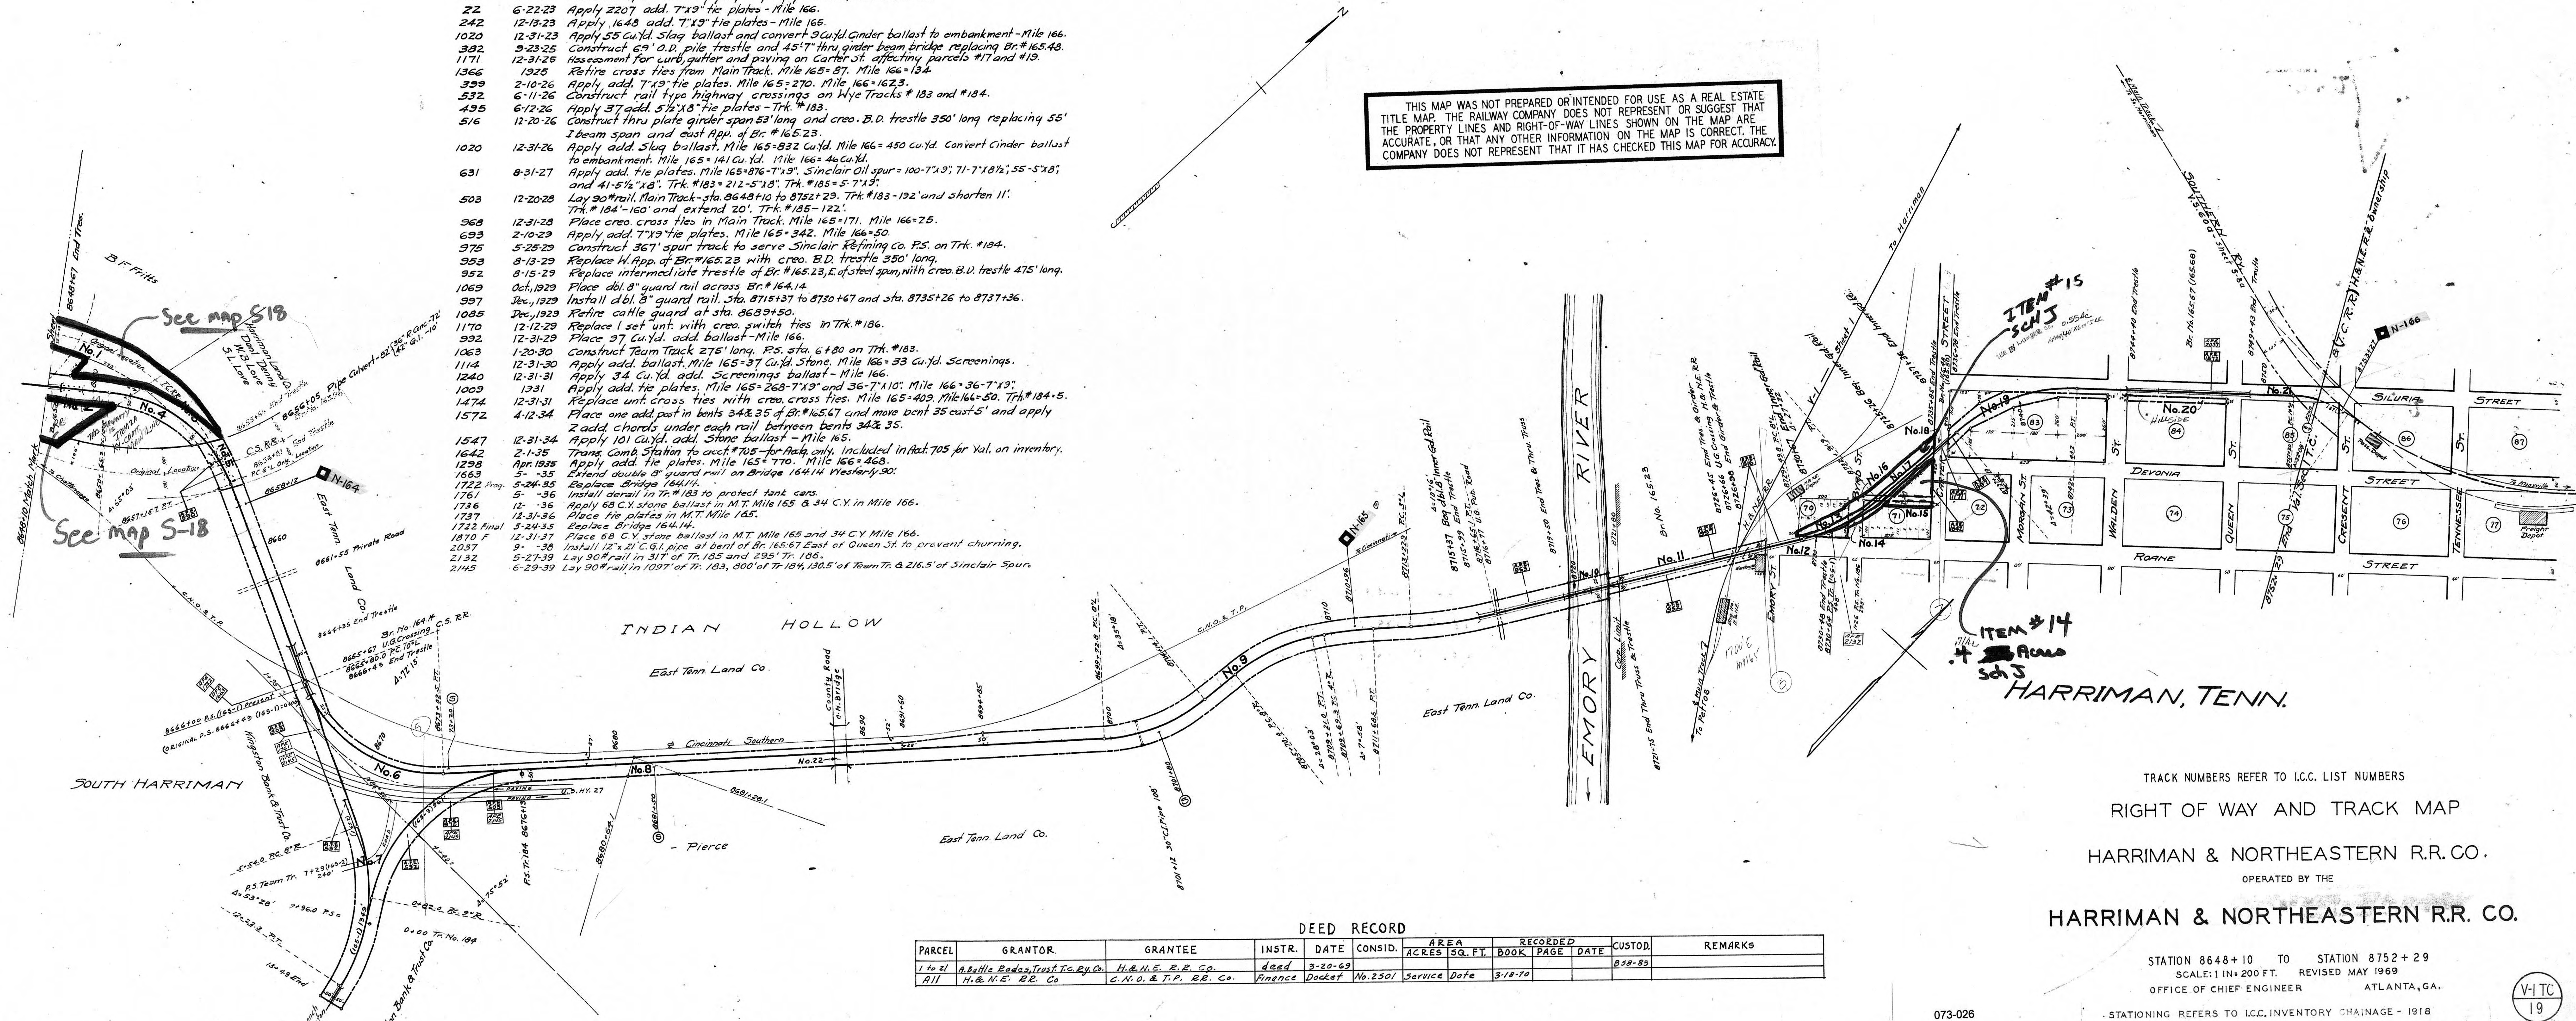

TRACK NUMBERS REFER TO I.C.C. LIST NUMBERS

RIGHT OF WAY AND TRACK MAP

HARRIMAN & NORTHEASTERN R.R. CO.

OPERATED BY THE

HARRIMAN & NORTHEASTERN R.R. CO.

STATION 8648+10 TO STATION 8752+29

SCALE: 1 IN. = 200 FT. REVISED MAY 1969

OFFICE OF CHIEF ENGINEER ATLANTA, GA.


STATIONING REFERS TO I.C.C. INVENTORY CHAINAGE - 1918

DEED RECORD											
PARCEL	GRANTOR	GRANTEE	INSTR.	DATE	CONSID.	AREA		RECORDED		CUSTOD.	REMARKS
						ACRES	SQ. FT.	BOOK	PAGE		
1 to 21	A. Bathle Easday Trust & Co. Ry. Co.	H. & N. E. R. R. Co.	deed	3-20-69							
all	H. & N. E. R. R. Co.	C. N. O. & T. P. R. R. Co.	finence	Docket No. 2501	Service Date	3-18-70				858-83	

073-026

V-1 TC
19

THIS MAP WAS NOT PREPARED OR INTENDED FOR USE AS A REAL ESTATE TITLE MAP. THE RAILWAY COMPANY DOES NOT REPRESENT OR SUGGEST THAT THE PROPERTY LINES AND RIGHT-OF-WAY LINES SHOWN ON THE MAP ARE ACCURATE, OR THAT ANY OTHER INFORMATION ON THE MAP IS CORRECT. THE COMPANY DOES NOT REPRESENT THAT IT HAS CHECKED THIS MAP FOR ACCURACY.

 

A.F.E.No.	DATE	DESCRIPTION
1015	8-28-29	Install 36" Cor. G.I. pipe culvert 30' long. & sta. 8487+83.
1085	Dec. 1929	Retire cattle guards at stas. 8441+93, 8461+10, 8497+12, 8508+68, and 8524+90.
992	12-31-29	Apply add. ballast. Mile 161-97 Cu.Yd. Mile 162-271 Cu.Yd.
1114	12-31-30	Apply 33 Cu.Yd. add. screenings ballast - Mile 162.
1247	9-15-31	Place dbl. B' inner guard rail - sta. 8517+51 to 8519+61.
1003	1931	Apply add. 7"x9" tie plates. Mile 161-207. Mile 162-68.
1474	12-31-31	Replace unt. cross ties with crec. cross ties. Mile 161-310. Mile 162-432.
1353	12-31-32	Apply 34 Cu.Yd. add. Stone ballast - Mile 162.
1506	10-9-33	Retire 1319' of East end of Track #172.
1493	12-31-33	Apply 68 Cu.Yd. add. Stone ballast - Mile 162.
1547	12-31-34	Apply add. Stone ballast. Mile 161-203 Cu.Yd. Mile 162-134 Cu.Yd.
1298	Apr. 1935	Apply add. tie plates. Mile 161-60-7"x9" & 130-7"x10". Mile 162-990.
1628	10-31-35	Construct R/W fence N. side Sta. 8475+25 to Sta. 8498+35 and retire fence N. side Sta. 8475+25 to Sta. 8483+00.
1662	12-31-35	Place 34 C.Y. stone ballast in M.T. Mile 161 & 68 C.Y. Stone Mile 162.
1666	12-31-35	Place tie plates in M.T. Mile 162.
1736	12-31-36	Place 68 C.Y. Stone ballast in M.T. Mile 161.
1873	12-31-37	Place tie plates in M.T. Mile 162.
2008	12-31-38	Construct R/W fence N. side Sta. 8508+90 to Sta. 8534+90, retire Sta. 8508+68 to same.
2006	12-31-38	Place tie plates in M.T. Mile 162.

A.F.E.No.	DATE	DESCRIPTION
371	4-30-19	Replace 60" Angle Bars with 60" 24" Cont. Jts. Mile 161-352.
576	3-31-21	Construct R/W Fence. N. side, sta. 8508+68 to sta. 8524+90.
701	1-31-22	Retire all roadway property by sale to T.C.R.R. Co.
53	2-1-22	Addition of all roadway property by purchase from T.C.R.R. Co.
22	6-22-23	Apply 700 add. 7"x9" tie plates - Mile 162.
1524	10-2-23	Remove 2 K-irg Traps from Main Track at C.N.O. & T.P.R.R. Co. spur trks crossing.
242	12-13-23	Apply 1156 add. 7"x9" tie plates - Mile 162.
1020	12-31-23	Apply 385 Cu.Yd. Slag ballast and convert 65 Cu.Yd. Cinders to emb. - Mile 161.
328	5-28-24	Retire Track #173.
1020	12-31-24	Apply add. Slag ballast. Mile 161-51 Cu.Yd. Mile 162-539 Cu.Yd. Convert Cinder ballast to embankment. Mile 161-9 Cu.Yd. Mile 162-31 Cu.Yd.
381	4-4-25	Replace Br #161.31 with crec. B.D.T. 107' long.
380	5-14-25	Replace Br #161.21 with fill and 24" metal pipe culvert 30' long - 8487+65.
1020	12-31-25	Apply 54 Cu.Yd. Slag ballast and convert 9 C.Y. Cinders to embankment - Mile 162.
1366	1925	Retire cross ties from Main Track. Mile 161-153. Mile 162-157.
495	6-12-26	Apply add. 7"x9" tie plates. Mile 161-2185. Mile 162-514. Trk #172-260.
543	8-12-26	Fill Br #161.67 and install 36" reinf. concrete pipe culvert 32' long.
1020	12-31-26	Apply 956 Cu.Yd. Slag ballast and convert 163 C.Y. Cinders to emb. - Mile 161.
1423	12-31-26	Construct R/W Fence. N. side, sta. 8436+90 to 8483+00. S. side, sta. 8439+32 to 8445+100. S. side, sta. 8450+00 to 8470+13. Retire R/W Fence. N. side, sta. 8436+90 to 8470+13. S. side, sta. 8436+90 to 8445+100 and sta. 8447+18 to 8470+13.
503	12-20-28	Lay 90' trail. Main Track - sta. 8436+90 to 8542+50. Trk #172-205' End & 170'E. end.
1020	12-31-28	Apply 95 C.Y. Stone ballast and convert 16 C.Y. Cinders to embankment - Mile 162.


DEED RECORD									
PARCEL	GRANTOR	GRANTEE	INSTR.	DATE	CONSID.	AREA ACRES	SQ. FT.	RECORDED BOOK	REMARKS
1,2,4,5,6	ABO H. R. & E. TRUST, T.C. Ry. Co.	H. & N.E. R.R. Co.	deed	3-20-09					
7,8,9,10	"	"	"	"					
11	H. & N.E. R.R. Co.	C.N.O. & T.P. R.R. Co	Finance Docket	No. 2501	Service Date	3-18-70			

TRACK NUMBERS REFER TO I.C.C. LIST NUMBERS
RIGHT OF WAY AND TRACK MAP
HARRIMAN & NORTHEASTERN R.R. CO.
OPERATED BY THE
HARRIMAN & NORTHEASTERN R.R. CO.

STATION 8436+90 TO STATION 8542+50
SCALE: 1 IN.=200 FT. REVISED MAY 1969
OFFICE OF CHIEF ENGINEER ATLANTA, GA.
STATIONING REFERS TO I.C.C. INVENTORY CHAINAGE - 1918

A.F.E. No.	DATE	DESCRIPTION
701	1-31-22	Retire all roadway property by sale to T.C.Ry. Co.
53	2-1-22	Addition of all roadway property by purchase from T.C.R.R. Co.
22	6-22-23	Apply 321 add. 7"x9" tie plates - Mile 163.
242	12-13-23	Apply 650 add. 7"x9" tie plates - Mile 163.
1020	12-31-24	Apply 735 C.Y. Slog ballast and convert 125 C.Y. Cinder ballast to emb - Mile 163.
379	4-14-25	Replace Br. # 162.46 with crea. B.D. trestle 87' long.
1366	1925	Add 52 cross ties - Mile 163.
590	8-10-26	Replace Br. # 162.01 with fill and 30" Metal Pipe 30' long. & sta. 8553+39
631	8-31-27	Apply 335 add. tie plates - Mile 163.
503	12-20-28	Lay 90# rail, Main Track - sta. 8542+50 to 8648+10.
568	12-31-28	Apply 31 crea. cross ties - Mile 163.
1015	8-18-29	Install 36" metal pipe culvert 30' long at sta. 8553+20.
1085	Dec. 1929	Retire cattle guards at sta. 8547+60, 8564+35, 8593+56.
1191	8-19-30	Const. timber Scour Wall 4' high x 32' long opp. Br. 162.46.
1247	9-15-31	Place dbl. 8" Inner Gd. Rail - sta. 8576+10 to 8578+20.
693	2-10-29	Apply 42 tie plates - Mile 163.
1474	12-31-31	Replace 346 unt. cross ties with crea. cross ties - Mile 163.
1009	1931	Apply 366 tie plates - Mile 163.
1499	12-31-33	Apply 102 Cu. Yd. Stone ballast - Mile 163.
1547	12-31-34	Apply 263 Cu. Yd. Stone ballast - Mile 163.
1298	Apr. 1935	Apply 850 tie plates - Mile 163.
1731	12-31-36	Construct B.W. Fence, N. side Sta. 8549+97 to Sta. 8561+52.
2006	12-31-38	Place tie plates in M.T. Mile 162 and Tracks 174, 175 & 176.
3064	11-23-44	Retiring Water Station At Cardiff & Lay Water Line From City Main To Tank At Emory Gap
2593	4- -42	Installing Dearborn Chemical Co. Water Treating Plants. 2 Tanks At Emory Gap.

THIS MAP WAS NOT PREPARED OR INTENDED FOR USE AS A REAL ESTATE TITLE MAP. THE RAILWAY COMPANY DOES NOT REPRESENT OR SUGGEST THAT THE PROPERTY LINES AND RIGHT-OF-WAY LINES SHOWN ON THE MAP ARE ACCURATE, OR THAT ANY OTHER INFORMATION ON THE MAP IS CORRECT. THE COMPANY DOES NOT REPRESENT THAT IT HAS CHECKED THIS MAP FOR ACCURACY.

 

DEED RECORD									
PARCEL	GRANTOR	GRANTEE	INSTR.	DATE	CONSID.	AREA ACRES	RELOCATED BOOK	RELOCATED PAGE	RELOCATED DATE
1 to 19	A. B. H. Rodes Trust T.C. Ry. Co.	H. & N.E. R.R. Co.	Deed	3-29-29					
All	H. & N.E. R.R. Co.	C.H.O. & T.P. R.R. Co.	Finance Docket	No. 2501	Service Date	3-18-70			

TRACK NUMBERS REFER TO I.C.C. LIST NUMBERS

RIGHT OF WAY AND TRACK MAP

HARRIMAN & NORTHEASTERN R.R. CO.

OPERATED BY THE

HARRIMAN & NORTHEASTERN R.R. CO.

STATION 8542+50 TO STATION 8648+10

SCALE: 1 IN = 200 FT. REVISED MAY 1969

OFFICE OF CHIEF ENGINEER ATLANTA, GA.

STATIONING REFERS TO I.C.C. INVENTORY CHAINAGE - 1918

ROANE COUNTY, TENN.

073-024

VTC 18

A.F.E.No.	DATE	DESCRIPTION
378	2-26-19	Replace 40' 60 ton track scale with a 40' 80 ton track scale in concrete pit.
369	4-25-19	Apply 2841 add. 7"x18 1/2" tie plates - Mile 164.
563	4-7-20	Refire Coal Station at Emory Gap.
547	5-13-20	Construct spur track, 549' long, to serve Emory Gap Coal Mining Co. P.S. sta. 8641+25.
583	6-9-20	Refire Oil House at Emory Gap.
582	6-15-20	Construct box car body Supply House.
588	11-6-20	Construct 153' Pull-In Track. P.S. 8623+34 on Trk. #176 and 8608+04 on Trk. #174.
581	3-16-21	Fill 50' of E. end of Trk. #163.82. New length = 119'.
701	1-31-22	Refire all roadway property by sale to T.C.R.R. Co.
53	2-1-22	Addition of all roadway property by purchase from T.C.R.R. Co.
22	6-22-23	Apply 646 add. 7"x9" tie plates - Mile 164.
249	10-2-23	Relay 1246' of Trk. #183 and 882' of Trk. #184 with 70' rail and ext. Trk. #184.
242	12-13-23	Apply add. tie plates. Mile 164 = 2681. Trk. #177-12. Trk. #178-326. Trk. #179-175. Trk. #181-499. Trk. #182-426. Trk. #183-431. Trk. #184-280. Trk. #186-110.
369	12-18-24	Install electric lights in Scale Shelter, For. Off. & Supply House, Repair Shop, Wash Room, Sand House, Oil House, and in Yards.
1020	12-31-24	Apply 204 C.Y. Slag ballast and convert 35 C.Y. Cinder ballast to embankment - Mile 164.
443	8-26-25	Refire Main Line and construct in new location - sta. 8635+45 to 8643+20. Extend Trk. #175 east 186' by trans. 30' to Trk. #182; absorbing 186' of old Main and const. 30'. Extend Trk. #182 east 536' by absorbing 506' of Main Track and 30' of Trk. #175. Change turnout of Trk. #181 from Trk. #175 to Trk. #182 and extend 162' by retiring 120' and constructing 282'.
1366	1925	Refire 110 cross ties from Main Track - Mile 164.
517	2-3-26	Refire 549' spur track serving Emory Gap Coal Mining Co.
399	2-10-26	Apply 573 add. 7"x9" tie plates - Mile 164.
442	3-9-26	Replace Br. #163.82 with fill and 42" reinf. conc. pipe culvert 80' long.
522	4-14-26	Lay 80' rail. Trk. #175 = 100' W. end. Trk. #176 = 447'. Trk. #179-93'. Trk. #180-19' W. end.
463	6-1-26	Move W. end Trk. #175 from Main Track to Trk. #176 and shorten 219'. Extend Trk. #176 1377' west by retiring 128' W. end and conn. to and absorbing Pull-In Trk. 1505' long. Refire E. frog and switch of Pull-In Track.
495	6-12-26	Apply tie plates. Pull-In Trk. = 566. Trk. #174-315. Trk. #177-163. Old Main Trk. = 432. Refire 2841 tie plates. Mile 164.
583	6-19-26	Refire and replace Blacksmith and Repair Shop. New bldg. 16' x 11'.
586	7-12-26	Lay 80' rail. Trk. #175 = 252'. Trk. #176 = 947'. Trk. #180 = 105'. Trk. #182 = 110'.
461	7-19-26	Construct 347' Crossover, 463' Transfer Trk., 8' x 8' Transfer. Plat. and 8' x 8' Office.
506	7-20-26	Ext. Trk. #174 W. 172'. P.S. 8605+44. Ext. Trk. #176 W. 301'. P.S. 3+46 on Trk. #174.
538	9-16-26	Construct 1199' Pull-In Track. P.S. 1+34 on Trk. #174 and on Trk. #176.
578	10-1-26	Replaces Tool House with 12' x 15' frame Tool House.
618	10-26-26	Construct 12' x 24' wood frame galv. metal siding shelter for Mtl. Storage Platform.
1020	12-31-26	Apply 627 C.Y. Slag L. ballast and convert 107 C.Y. Cinder to emb. - Mile 164.
694	7-30-27	Ext. Transfer Pl. form 96' westerly. Total length = 192'.
631	8-31-27	Apply tie plates on Trks. #174, 175, 176, 180, Transfer Trk. and Pull-In Trk.
302	5-29-40	Constructing 12 toilets of various locations replacing old toilets. Work done by W.R.A.

PARCEL	GRANTOR	GRANTEE	INSTR.	DATE	CONSID.	AREA ACRES	RECORDED BOOK	RECORDED PAGE	CUSTOD.	REMARKS
4 to 23	A. Battle, Rodes, Trust T.C.R.R. Co.	H. & N.E. R.R. Co.	deed	3-20-69					858-83	
111	H. & N.E. R.R. Co.	C.N.O. & T.P. R.R. Co.	Finance	Docket No. 2501	Service Date	3-19-70				
166, 186, 224	C.N.O. & T.P. R.R. Co.	Emory Golf & Country Club Inc.	Ease.	3-22-70	#7195.00	13.27			#2	With recapture clause.

